
# STATE OF ILLINOIS DEPARTMENT OF TRANSPORTATION **DIVISION OF HIGHWAYS**

# PLANS FOR PROPOSED FEDERAL AID HIGHWAY

**SOUTH SUBURBAN MAYORS AND MANAGERS ASSOCIATION** TRAFFIC SIGNAL PRIORITY PREEMPTION IMPROVEMENTS

CITY OF CALUMET CITY, VILLAGE OF CALUMET PARK, CITY OF CHICAGO HEIGHTS, CITY OF COUNTRY CLUB HILLS, VILLAGE OF GLENWOOD, VILLAGE OF HAZEL CREST, VILLAGE OF HOMEWOOD, VILLAGE OF LANSING, VILLAGE OF LYNWOOD, VILLAGE OF MIDLOTHIAN, CITY OF OAK FOREST, VILLAGE OF POSEN, VILLAGE OF RIVERDALE, VILLAGE OF SAUK VILLAGE, **VILLAGE OF SOUTH CHICAGO HEIGHTS, VILLAGE OF STEGER, VILLAGE OF THORNTON** 

> PROJECT: M-8003 (867) **SECTION NO.:08-00146-00-TL** C-91-022-08 **COOK COUNTY & WILL COUNTY**

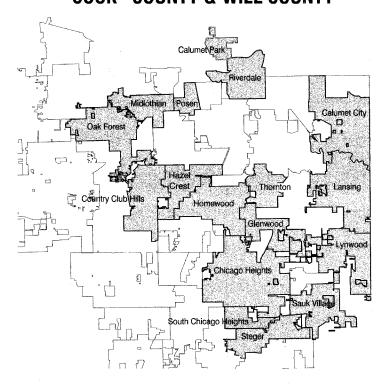


**LOCATION MAP** NO SCALE **LENGTH OF PROJECT - 130 INTERSECTIONS** 

LICENSE EXPIRES: 11/30/09 SHEETS 1-115, 124-135, 147-208,



SHEETS 116-123, 209-215



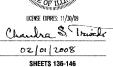




**CONTRACT NO. 63003** 

TO STA 1+4=277

LLINGIS PED. AD PROJECT

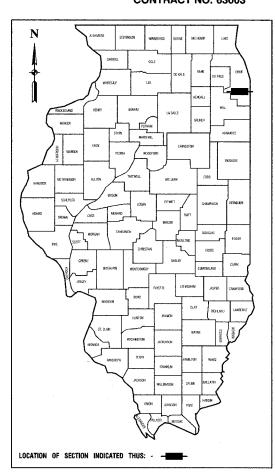



# PRINTED BY THE AUTHORITY OF THE STATE OF ILLINOIS



02/06/08 SHEETS 242-257

# INDEX OF SHEETS

COVER SHEET, INDEX OF SHEETS, STATE STANDARDS LOCATION MAPS **SUMMARY OF QUANTITIES** 13-18 CITY OF CALUMET CITY 19-84 85-98 **VILLAGE OF CALUMET PARK** 99-115 CITY OF CHICAGO HEIGHTS CITY OF COUNTRY CLUB HILLS 116-123 124-135 **VILLAGE OF GLENWOOD VILLAGE OF HAZEL CREST** 147-184 VILLAGE OF HOMEWOOD **VILLAGE OF LANSING** 185-192 VILLAGE OF LYNWOOD 193-202 203-208 VILLAGE OF MIDLOTHIAN 209-215 CITY OF OAK FOREST **VILLAGE OF POSEN VILLAGE OF RIVERDALE** 226-231 **VILLAGE OF SAUK VILLAGE** 232-241 **VILLAGE OF SOUTH CHICAGO HEIGHTS** 242-251 VILLAGE OF STEGER 252-257 258-273 VILLAGE OF THORNTON 274-277 DISTRICT 1 DETAILS

# **STATE STANDARDS**

701301-02 LANE CLOSURE, 2L, 2W, SHORT TIME OPERATION 701701-05 URBAN LANE CLOSURE MULTILANE INTERSECTION

TRAFFIC CONTROL DEVICES 701901 STANDARD PHASE DESIGNATION DIAGRAMS AND PHASE SEQUENCES 857001

878001-06 CONCRETE FOUNDATION DETAILS


TRAFFIC SIGNAL MOUNTING DETAILS


FULL SIZE PLANS HAVE BEEN PREPARED USING STANDARD ENGINEERING SCALES, REDUCED SIZED PLANS WILL NOT CONFORM TO STANDARD SCALES, IN MAKING MEASUREMENTS ON REDUCED PLANS, THE ABOVE SCALES MAY BE USED.

JOINT UTILITY LOCATION INFORMATION FOR EXCAVATION

1 - 800 - 892 - 0123


CONTRACT NO. 63003

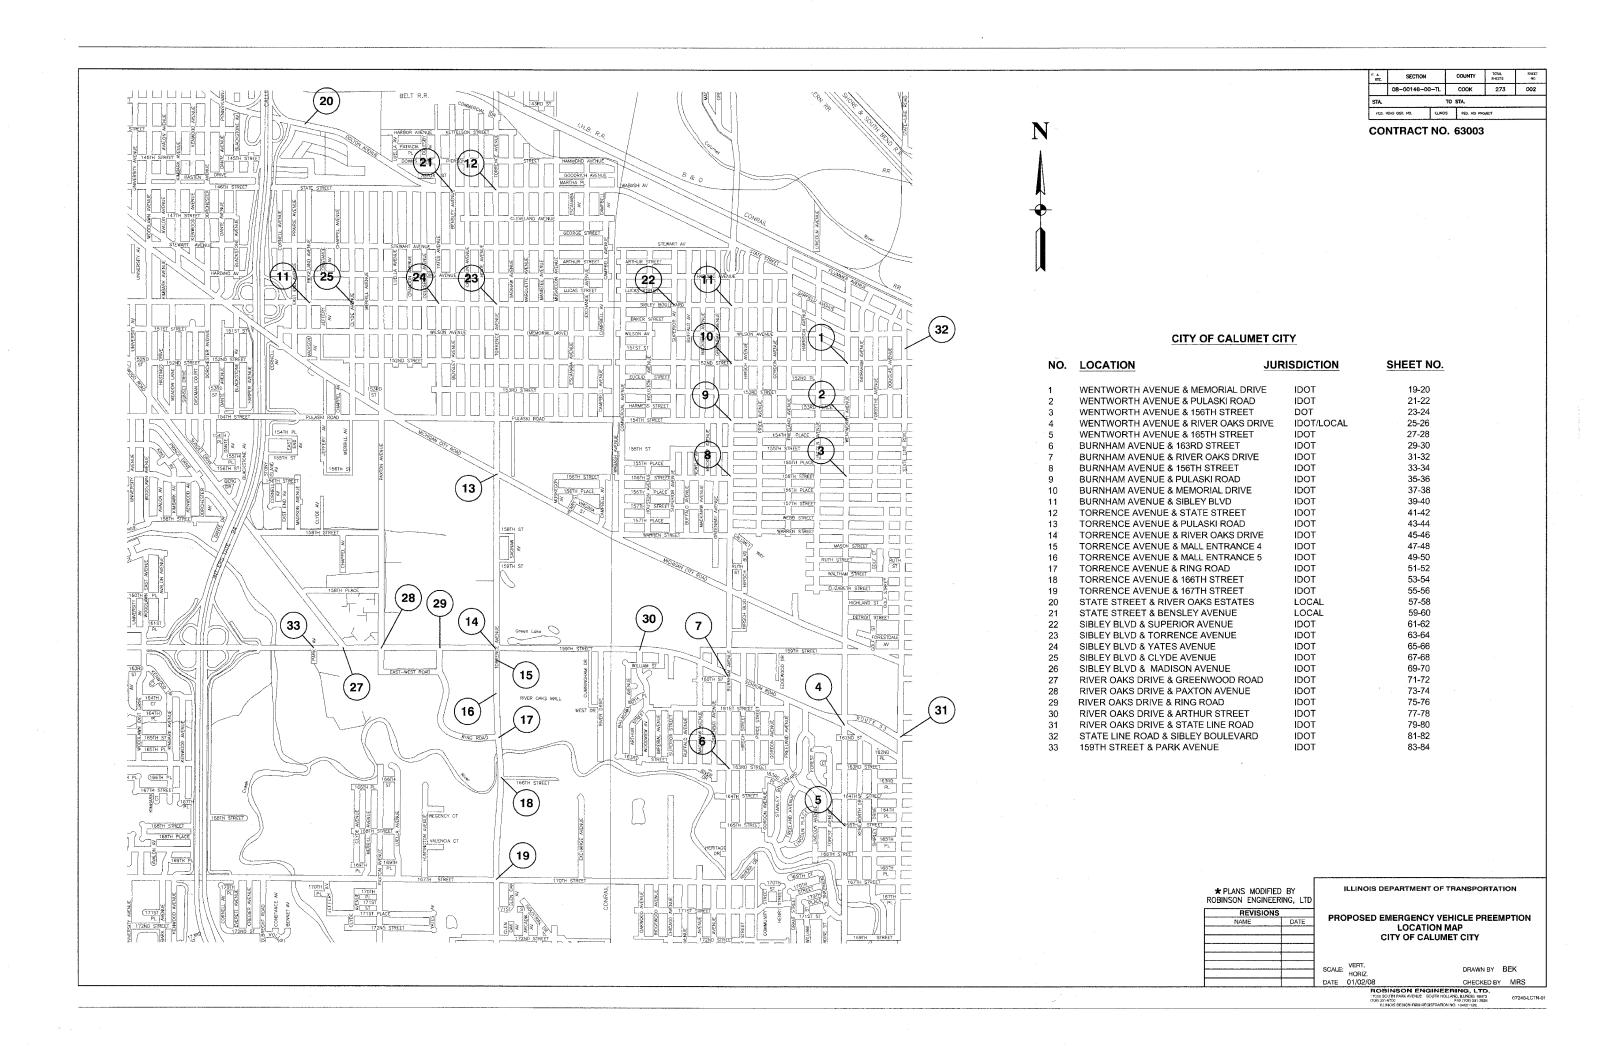

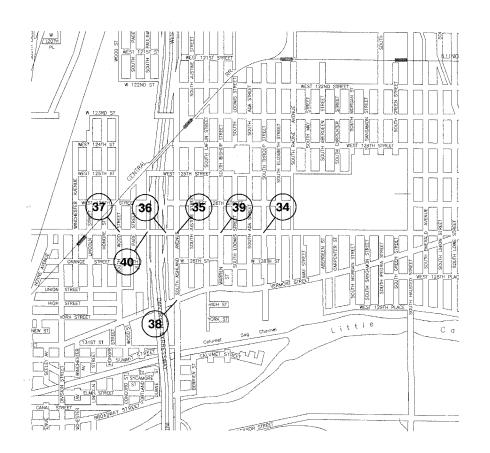

# VILLAGE OF CALUMET PARK

NO.	LOCATION	JURISDICTION	SHEET NO.
34 35 36 37 38 39	127TH STREET & THROOP 127TH STREET & ASHLAND AVENUE 127TH STREET & MARSHFIELD 127TH STREET & WOOD STREET ASHLAND AVENUE & VERMONT AVENUE 127TH STREET & BISHOP	IDOT (LOCAL MAINT)	85-86 87-88 89-90 91-92 93-94 95-96
40	127TH STREET & PAULINA	IDOT (LOCAL MAINT)	97-98

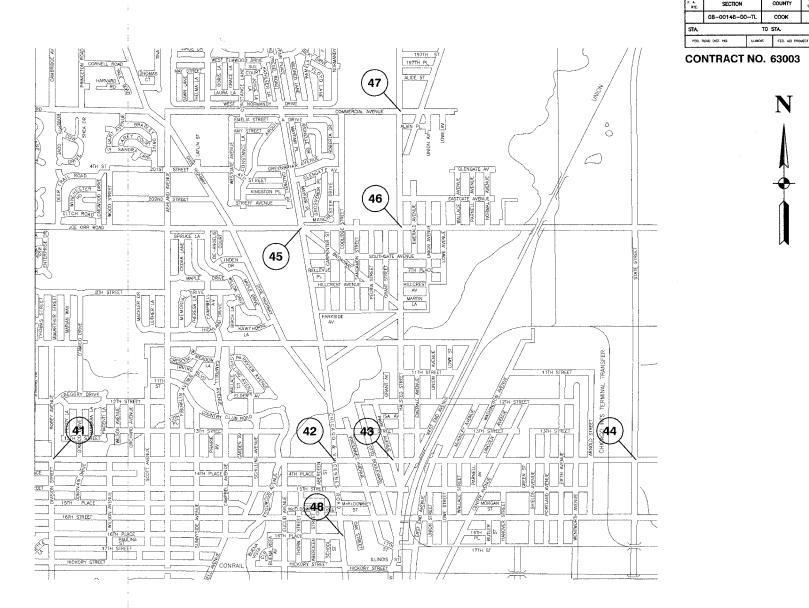

# CITY OF CHICAGO HEIGHTS

NO.	LOCATION	JURISDICTION	SHEET NO.
41	ROUTE 30 (LINCOLN HIGHWAY) & DIVISION STREET	IDOT	99-100
42	ROUTE 30 (LINCOLN HIGHWAY) & CHICAGO ROAD	IDOT	101-102
43	ROUTE 30 (LINCOLN HIGHWAY) & HALSTED STREET	IDOT	103-104
44	ROUTE 30 (LINCOLN HIGHWAY) & STATE STREET	IDOT/COOK	105-106
45 :	JOE ORR ROAD & CHICAGO ROAD (RIEGEL ROAD)	IDOT	107-109
46	JOE ORR ROAD & HALSTED STREET	IDOT	110-111
47	HALSTED STREET & VOLLMER ROAD	IDOT	112-113
48	CHICAGO ROAD & 16TH STREET	IDOT	114-115

\*PLANS MODIFIED BY ROBINSON ENGINEERING, LTD

REVISIONS
NAME DATE
PROPOSED EMERGENCY VEHICLE PREEMPTION
LOCATION MAP
VILLAGE OF CALUMET PARK


SCALE: VERT.
HORIZ.
DATE 01/02/08
CHECKED BY MRS

POBINSON ENGINEERING, LTD

17000 SOUTH PARK AVENUE SOUTH HOLLAND, ILLINOIS 80473
(708) 331-6700 FRANCE SOUTH FRANCE SOUTH HOLLAND, ILLINOIS 80473
(108) 331-6700 FRANCE SOUTH FRANCE SOUTH

07248-LCTN-

COOK 273 003

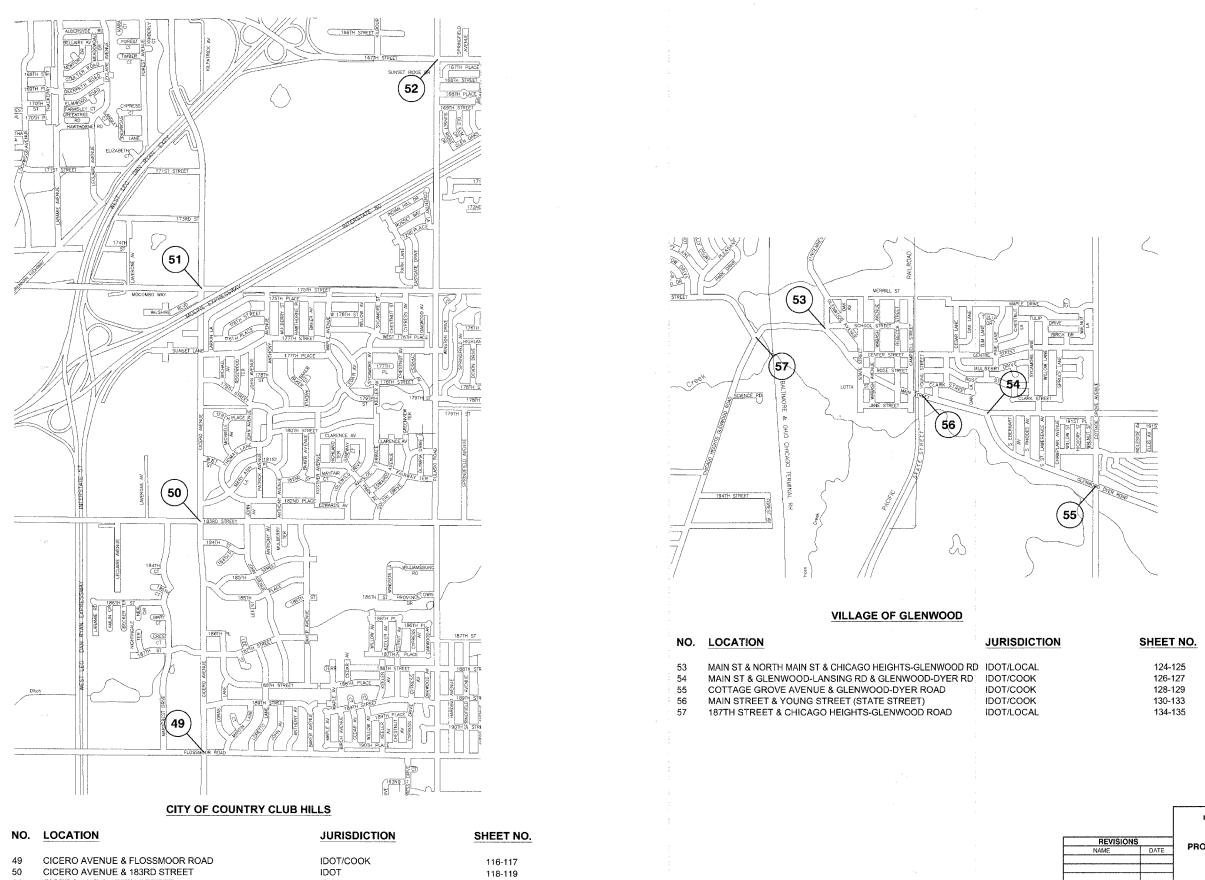

CICERO AVE & 175TH STREET

PULASKI ROAD (CRAWFORD AVENUE) & 167TH STREET

IDOT/COOK

IDOT/COOK

120-121

122-123

SECTION


#### CONTRACT NO. 63003




ILLINOIS DEPARTMENT OF TRANSPORTATION

PROPOSED EMERGENCY VEHICLE PREEMPTION LOCATION MAP CITY OF CHICAGO HEIGHTS CITY OF COUNTRY CLUB HILLS

SCALE: VERT. HORIZ.

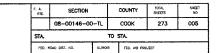



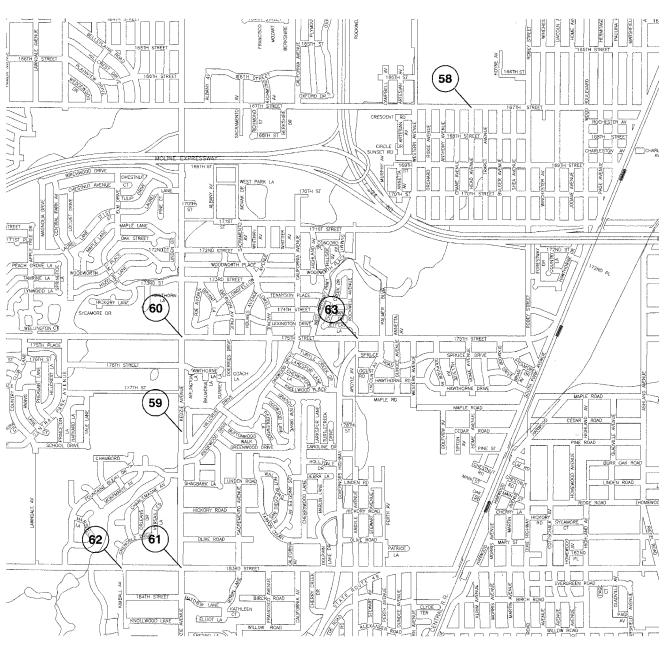

# **VILLAGE OF HAZEL CREST**


NO.	LOCATION	JURISDICTION	SHEET NO.
58	167TH STREET & HEAD AVENUE	соок	136-137
59	178TH STREET & KEDZIE AVENUE	COOK	138-139
60	175TH STREET & KEDZIE AVENUE	ÇOOK	140-141
61	183RD STREET & KEDZIE AVENUE	соок	142-143
62	183RD STREET & GRENOBLE DRIVE	IDOT/COOK	144-144
63	175TH STREET & GOVERNORS HIGHWAY	IDOT	145-146


ILLINOIS DEPARTMENT OF TRANSPORTATION


PROPOSED EMERGENCY VEHICLE PREEMPTION LOCATION MAP VILLAGE OF LANSING VILLAGE OF LYNWOOD

SCALE: VERT. HORIZ. DATE 01/02/08

DRAWN BY BEK

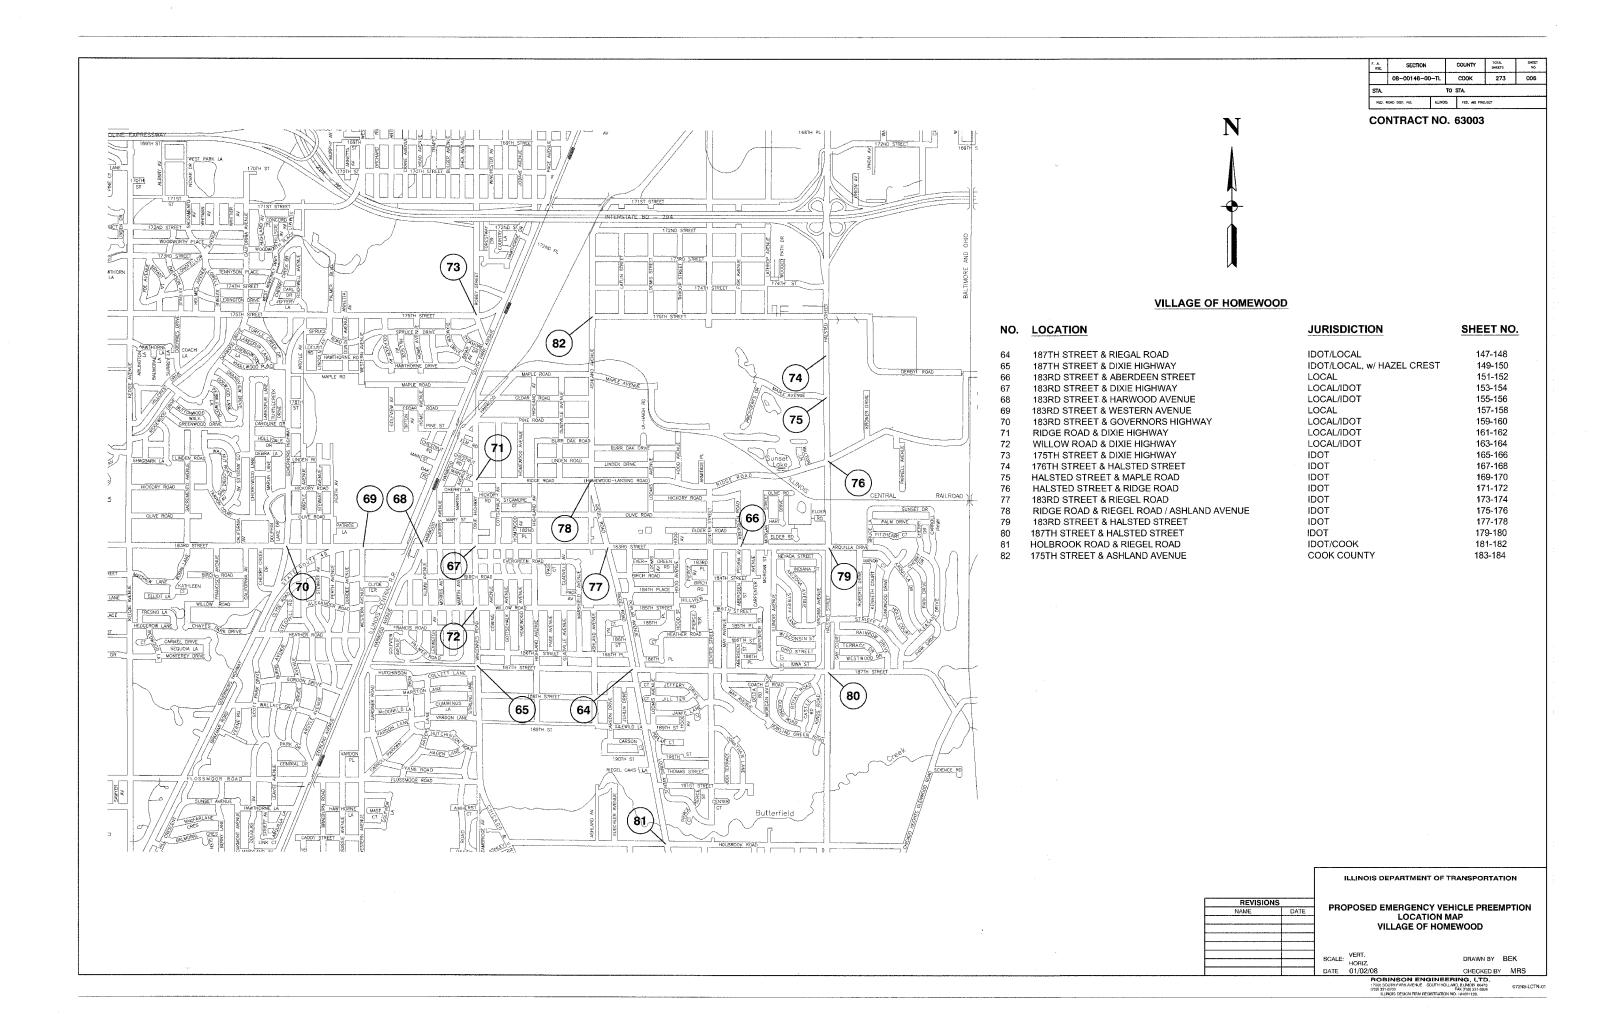


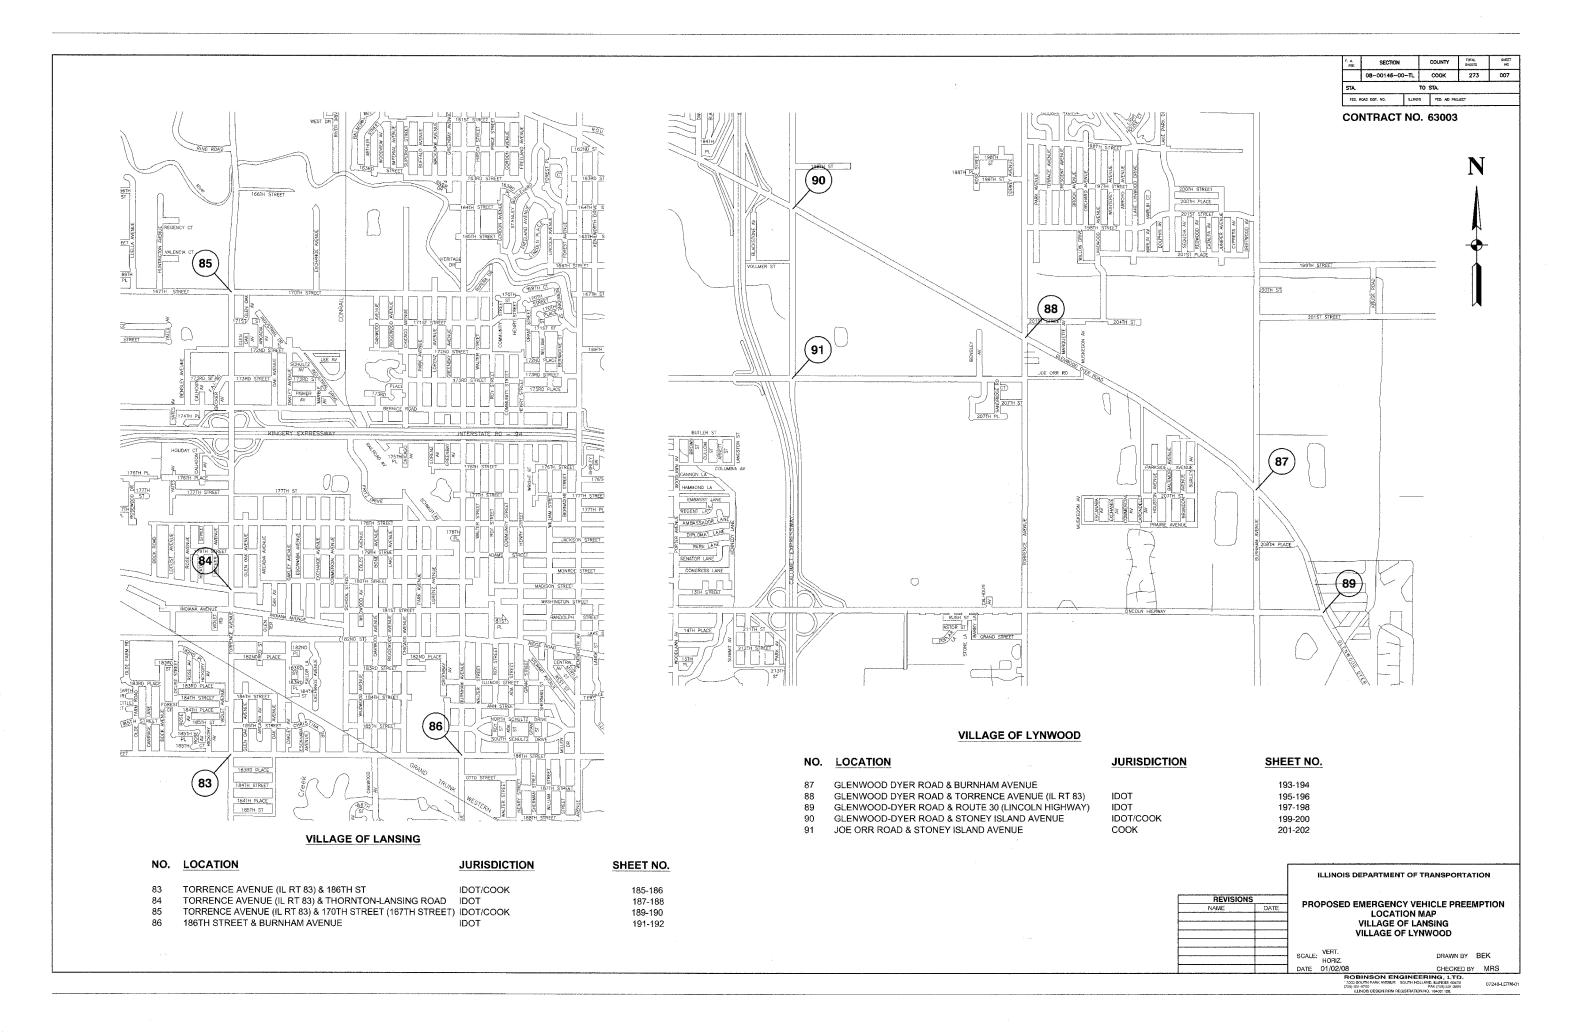

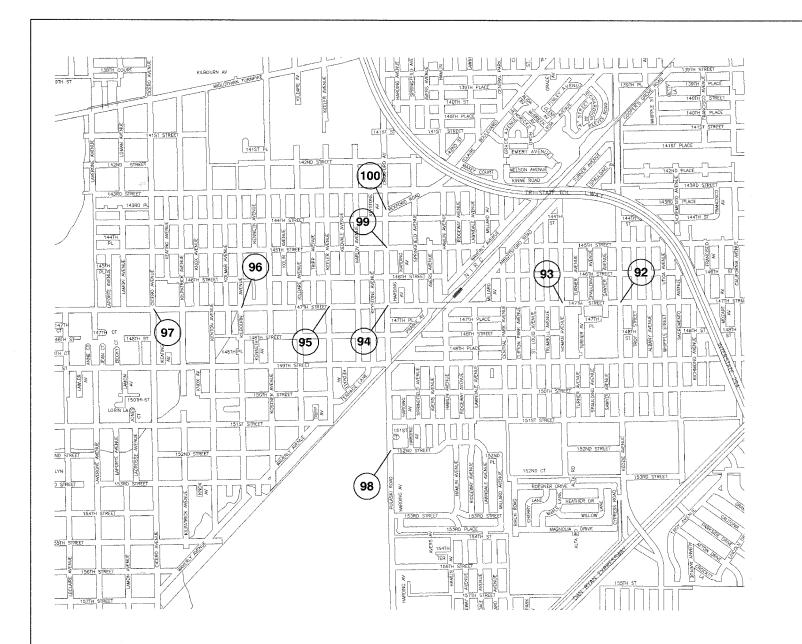


# VILLAGE OF MIDLOTHIAN

NO.	LOCATION	JURISDICTION	SHEET NO.
92	ROUTE 83 (147TH STREET) & KEDZIE AVENUE	IDOT/COOK	202 204
93	ROUTE 83 (147TH STREET) & HOMAN AVENUE	IDOT	203-204
94	ROUTE 83 (147TH STREET) & PULASKI ROAD	IDOT/COOK	
95	ROUTE 83 (147TH STREET) & KEELER AVENUE	IDOT	
96	ROUTE 83 (147TH STREET) & KILBOURN AVENUE	IDOT	
97	ROUTE 83 (147TH STREET) & CICERO AVENUE	IDOT	
98	152ND STREET & PULASKI ROAD	COOK	205-206
99	145TH STREET & PULASKI ROAD	COOK	207-208
100	CLAIRE BOULEVARD & PULASKI ROAD	IDOT/COOK	

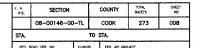

# CONTRACT NO. 63003




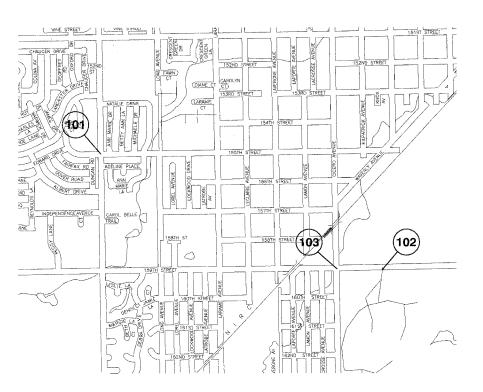


# CITY OF OAK FOREST

NO.	LOCATION	JURISDICTION	SHEET NO.
101	155TH STREET & CENTRAL AVENUE	COOK	209-210
102	159TH STREET & OAK FOREST HOSPITAL ENTRANCE	IDOT	211-212
103	159TH STREET & CICERO AVENUE	IDOT	213-215

ILLINOIS DEPARTMENT O	OF TRANSPORTATION
PROPOSED EMERGENCY VEHICLE PREEMPTION LOCATION MAP VILLAGE OF MIDLOTHIAN	
VERT	
SCALE: HORIZ.	DRAWN BY BEK
DATE 01/02/08	CHECKED BY MRS
	PROPOSED EMERGENCY LOCATIO VILLAGE OF M CITY OF OAK  SCALE: VERT. HORIZ.

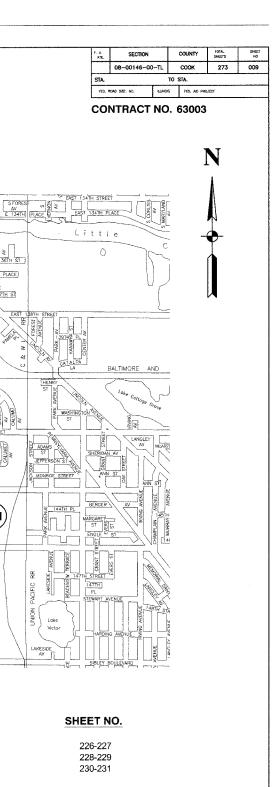

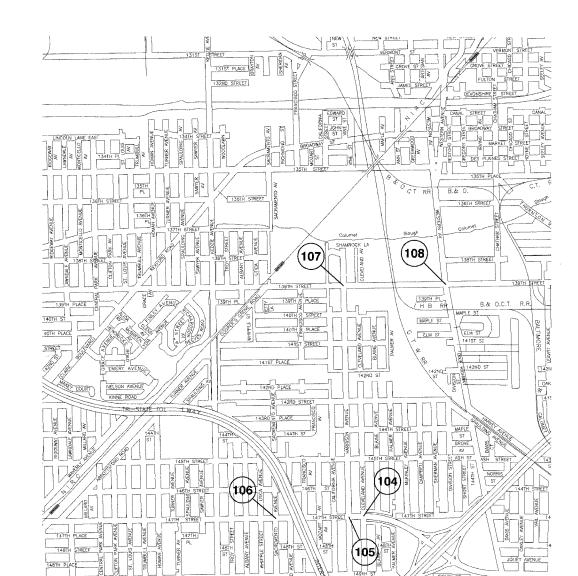


# VILLAGE OF POSEN


NO.	LOCATION	JURISDICTION	SHEET NO.
104	147TH STREET & CLEVELAND AVENUE	IDOT	216-217
105	147TH STREET & HARRISON AVENUE	IDOT	218-219
106	147TH STREET & SACREMENTO AVENUE	IDOT	220-221
107	139TH STREET & HARRISON AVENUE	IDOT/COOK	222-223
108	139TH STREET & WESTERN AVENUE	IDOT/COOK	224-225

## **VILLAGE OF RIVERDALE**

LOCATION	JURISDICTION	SHEET NO.
138TH STREET & SCHOOL STRÉET	соок	226-227
144TH STREET & HALSTED STREET	IDOT	228-229
144TH STREET & INDIANA AVENUE	IDOT	230-231
	138TH STREET & SCHOOL STREET 144TH STREET & HALSTED STREET	138TH STREET & SCHOOL STREET COOK 144TH STREET & HALSTED STREET IDOT

ILLINOIS DEPARTMENT OF TRANSPORTATION PROPOSED EMERGENCY VEHICLE PREEMPTION LOCATION MAP VILLAGE OF THORNTON VILLAGE OF POSEN

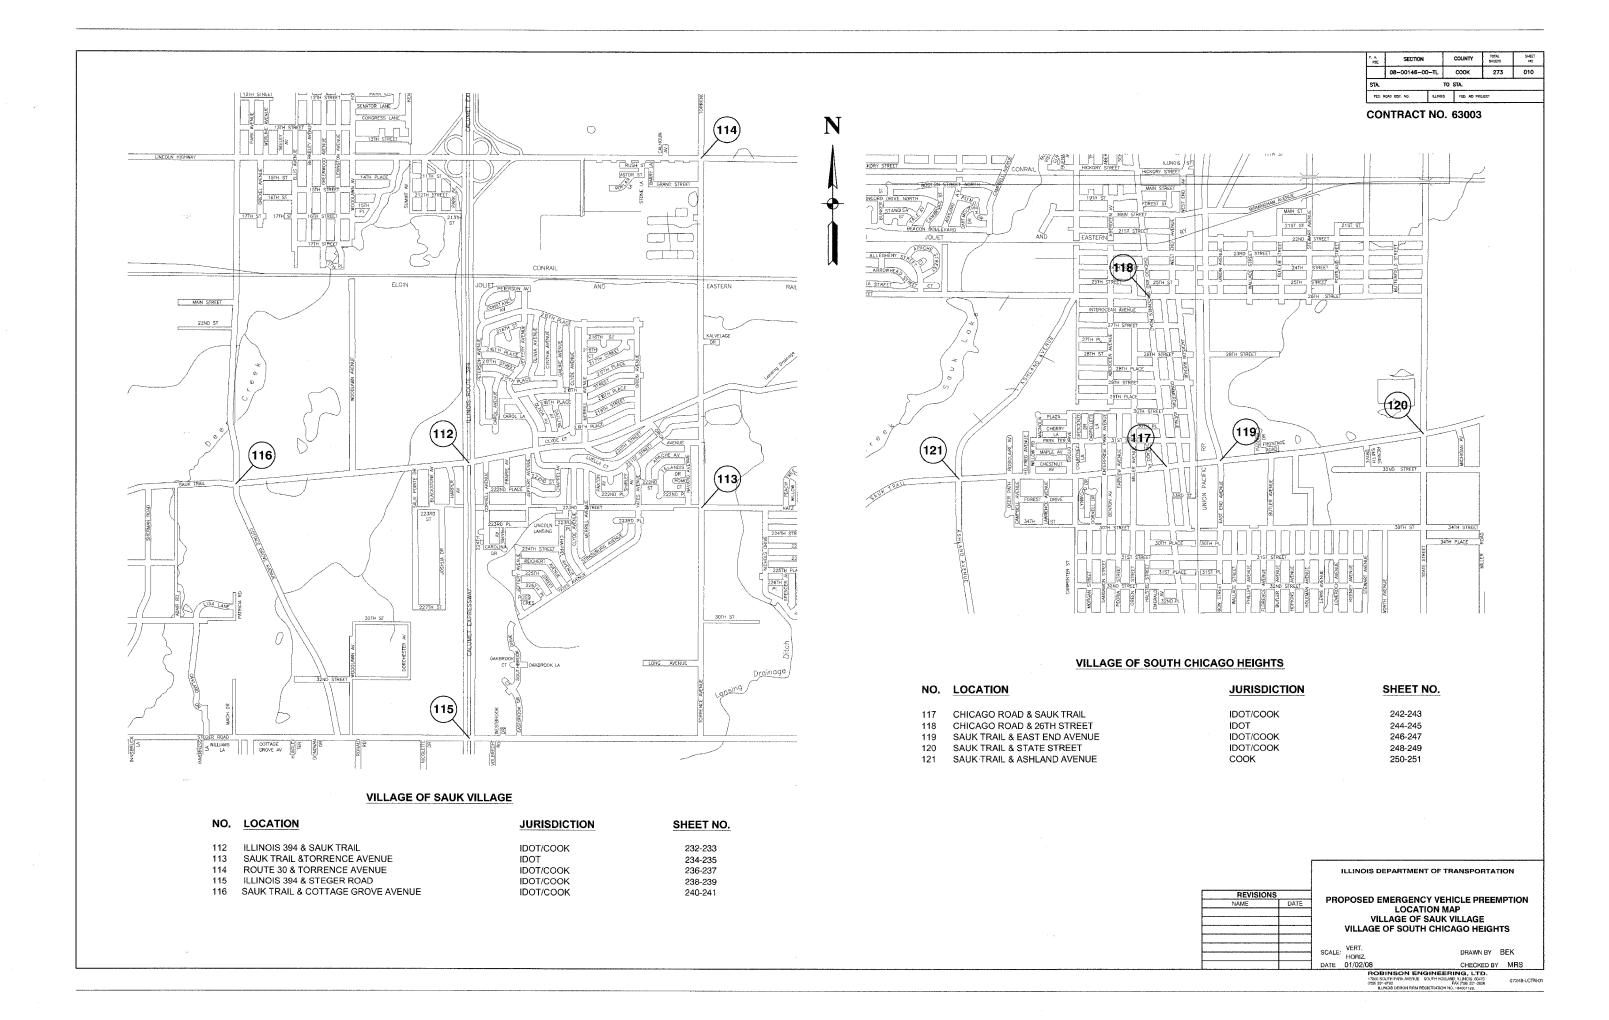

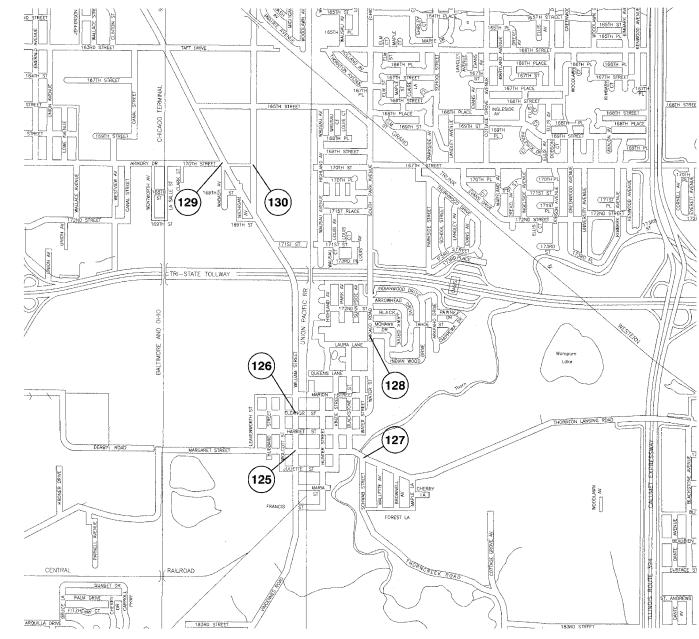

-			-	
C	CONTRACT	NO.	63003	

N

# VILLAGE OF STEGER

<del>(124)</del>

NO.	LOCATION	JURISDICTION	SHEET NO.
122	STEGER ROAD & UNION AVENUE	IDOT/COOK	252-253
123	STEGER ROAD & CHICAGO ROAD	IDOT	254-255
124	STEGER ROAD & ASHLAND AVENUE	COOK	256-257

## VILLAGE OF THORNTON

258-261
262-265
266-267
268-269
270-271
272-273

ILLINOIS DEPARTMENT OF TRANSPORTATION

PROPOSED EMERGENCY VEHICLE PREEMPTION LOCATION MAP VILLAGE OF STEGER VILLAGE OF HAZEL CREST

SCALE: VERT. HORIZ. DATE 01/02/08

REVISIONS

DATE

DRAWN BY BEK
CHECKED BY MRS

ROBINSON ENGINEERING, LTD.

17003 SOLITH PARK AVENUE SOUTH HOLLAND, LUNGIS 60473
[708) 331-577 BAX 7093 31-578 BAX 7093 31-589

ILLINGIS DESIGN FIRM REGISTRATION NO. 164001128.

F. A. RIE.	SECTION		COUNTY	TOTAL SHEETS	SHEET NO
08-00146-00-TL		)-TL	COOK	273 012	012
STA. TO STA.					
FED. 6	ROAD DIST. NO.	ILUNCI	S FED. AID PE	ROJECT	

UNLESS OTHERWISE SPECIFIED ON THE PLANS OR IN THE SPECIAL PROVISIONS, ALL WORK INSTALLED UNDER THIS CONTRACT INVOLVING TRAFFIC CONTROL DEVICES SHALL BE IN STRICT ACCORDANCE WITH ANY AND ALL APPLICABLE REQUIREMENTS OF THE ILLINOIS DEPARTMENT OF TRANSPORTATION'S "MANUAL OF UNIFORM TRAFFIC CONTROL DEVICES FOR STREETS AND HIGHWAY", LATEST ADDITION.

ANY REFERENCE TO STANDARDS THROUGHOUT THE PLANS OR SPECIAL PROVISIONS SHALL BE INTERPRETED TO BE THE LATEST STANDARDS OF THE ILLINOIS DEPARTMENT OF TRANSPORTATION.

THE CONTRACTOR MUST CONTACT IDOT BUREAU OF CONSTRUCTION (847) 705-4300 AND ROBINSON ENGINEERING 72 HOURS PRIOR TO THE START OF ANY WORK ON THIS PROJECT. IDOT BUREAU OF LOCAL ROADS COORDINATOR, (847) 705-4189, SHALL BE NOTIFIED OF ALL MAINTENANCE TRANSFERS.

THE CONTRACTOR SHALL TEST AND ADJUST ALL EMERGENCY VEHICLE PREEMPTION EQUIPMENT WITH THE LOCAL FIRE DEPARTMENT PRIOR TO THE FINAL INSPECTION. THE CONTRACTOR SHALL NOTIFY THE LOCAL FIRE DEPARTMENTS 48 HOURS PRIOR TO THE TESTING.

THE CONTRACTOR SHALL NOTIFY THE LOCAL POLICE DEPARTMENTS 24 HOURS PRIOT TO ANY TRAFFIC LANE CLOSURES FOR THE INSTALLATION OF EVP EQUIPMENT.

THE REMOVAL OF ANY DRIVEWAYS, PAVEMENT, CURB, SIDEWALK, ETC., SHALL BE ACCOMPLISHED BY MEANS OF A SAW CUT JOINT, AT THE DIRECTION OF THE ENGINEER. THIS WORK SHALL NOT BE PAID FOR SEPARATELY, BUT SHALL BE INCLUDED IN THE UNIT PRICE BID FOR THE VARIOUS ITEMS.

THE APPROXIMATE LOCATION OF KNOW PUBLIC UTILITES ARE SHOWN ON THE PLANS. HOWEVER, THE COMMUNITIES DO NOT GUARANTEE ITS ACCURACY. PRIOR TO COMMENCING OPERATIONS ON THE PROJECT, WHICH MAY IN ANY WAY CREATE THE POSSIBILITY OF INVOLVEMENT WITH EXISTING UTILITIES, THE CONTRACTOR SHALL CONTACT THE UTILITY INVOLVED. THE RESPECTIVE OWNERS, WITH THE EXCEPTION OF THOSE OWNED BY THE COMMUNITIES WILL DO ADJUSTMENT OF ALL PUBLIC UTILITIES WITHIN THE LIMITS OF THIS IMPROVEMENT. NO ADDITIONAL COMPENSATION WILL BE ALLOWED DUE TO DELAYS OR INCOVENIENCES CAUSED BY THESE ADJUSTMENTS. IT SHALL BE THE CONTRACTOR'S RESPONSIBILITY TO VERIFY LOCATIONS OF UNDERGROUND INSTALLATION BEFORE STARTING CONSTRUCTION OPERATIONS.

ADDITIONAL COMPENSATION WILL BE ALLOWED DUE TO DELAYS OR INCOVENIENCES CAUSED BY THESE ADJUSTMENTS. IT SHALL BE THE CONTRACTOR'S RESPONSIBILITY TO VERIFY LOCATIONS OF UNDERGROUND INSTALLATION BEFORE STARTING CONSTRUCTION OPERATIONS.

ALL EXCAVATED AND UNNEEDED EXCAVATED MATERIAL SHALL BE REMOVED FROM THE JOB SITE THE SAME DAY THAT IT WAS EXCAVATED. FAILURE TO ABIDED BY THIS WILL RESULT IN THE CONTRACTOR BEING ACCESSED TRAFFIC CONTROL DEFICIENCY DEDUCTIONS AS INCLUDED IN THE SPECIAL PROVISIONS.

WHEN, IN THE CONSTRUCTION OPERATION, ANY LOOSE MATERIAL IS DEPOSITED IN THE FLOW LINE OF DITCHES, GUTTERS, OR OTHER DRAINAGE STRUCTURES SO THAT THE NATERAL FLOW OF WATER IS OBSTRUCTED, THE CONTRACTOR AT HIS EXPENSE SHALL REMOVE THIS MATERIAL AT THE CLOSE OF EACH DAY.

ALL TRENCHES AND AREAS OF DISTRUBED GROUND ADJACENT TO CONCRETE FOUNDATIONS AND HANHOLES SHALL BE RESTORED BY SODDING THE SURFACE IN ACCORDANCE WITH SECTION 252 OF THE STANDARD SPECIFICATIONS WITH 2 WEEKS OF COMPLETION OF UNDERGROUND WORK. THIS WORK SHALL BE INCLUDED IN THE COST OF RELATED TRENCHES, CONCRETE FOUNDATIONS, AND HANDHOLES.

3M OPTICOM 700 SERIES PHASE SELECTORS AND THE MOST RECENT MODEL OF OPTICAL DETECTOR SHALL BE INSTALLED AT INTERSECTIONS LOCATED WITHIN THESE COMMUNITIES.

VILLAGE OF MIDLOTHIAN, VILLAGE OF HOMEWOOD

3M OPTICOM 400 SERIES PHASE SELECTORS AND THE MOST RECENT MODEL OF THE OPTICAL DETECTOR SHALL BE INSTALLED AT INTERSECTIONS LOCATED WITHIN THESE COMMUNITIES.

CITY OF CALUMET CITY, VILLAGE OF CALUMET PARK, CITY OF CHICAGO HEIGHTS, CITY OF COUNTRY CLUB HILLS, VILLAGE OF GLENWOOD, VILLAGE OF HAZEL CREST, VILLAGE OF LANSING, VILLAGE OF LYNWOOD, CITY OF OAK FOREST, VILLAGE OF POSEN, VILLAGE OF RIVERDALE, VILLAGE OF SAUK VILLAGE, VILLAGE OF SOUTH CHICAGO HEIGHTS, VILLAGE OF STEGER, VILLAGE OF THORNTON.

	*PLANS MODIFIED   ROBINSON ENGINEERIN		!	ILLINOIS I	DEPARTMENT OF TRANSPORTATION
	REVISIONS		800	DACER	FMEDOENOV VELUOLE DOCEMBEION
	NAME	DATE	PHC	PUSED	EMERGENCY VEHICLE PREEMPTION
*					GENERAL NOTES
			SCALE:	VERT. HORIZ.	DRAWN BY
			DATE	01/02/08	CHECKED BY
	· · · · · · · · · · · · · · · · · · ·				BINSON ENGINEERING, LTD.

F. A. RTE.	SECTION		COUNTY	TOTAL. SHEETS	SHEET
	08-00146-00	3-TL	COOK	273	013
STA.		TO	STA.		
FED. F	ROAD DIST. NO.	ILLNOIS	FED. AID PR	OJECT	

			Y031-10	1								* * * * * * *						CONS		N TYPE F CALUN	CODE Y	031-1F		· · · · · · · · · · · · · · · · · · ·										****		
CODED PAY ITEM	PAY ITEM DESCRIPTION	UNIT	TOTAL QUANTITY	Wentworth Avenue & Memorial Drive	Wentworth Avenue & Pulaski Road	Wentworth Avenue & 156th Street	Wentworth Avenue & River Oaks Drive	Wentworth Avenue & 165th Street	Burnham Avenue & 163rd Street	Burnham Avenue & River Oaks Drive	Bumham Avenue & 156th Street	Bumham Avenue & Pulaski Road	Burnham Avenue & Memorial Drive	Burnham Avenue & Sibley Blvd	Torrence Avenue & State Street	Torrence Avenue & Pulaski Road	Torrence Avenue & River Oaks Drive	Torrence Avenue & Mall Entrance 4	Torrence Avenue & Mall Entrance 5	Tomence Avenue & S	Torrence Avenue & Olive Garden	Torrence Avenue & Bally's	State Street & River Oaks Estates	State Street & Bensley Avenue	Sibley Blvd & Superior Avenue	Sibley Blvd & Torrence Avenue	Sibley Blvd & Yates Avenue	Sibley Blvd & Clyde Avenue	Sibley Blvd & Madison Avenue	River Oaks Drive & Greenwood Road	River Oaks Drive & Paxton Averue	River Oaks Drive & Ring Road	River Oaks Drive & Arthur Street	River Oaks Drive & State Line Road	State Line Road & Sibley Boulevard	199th Street & Park Avenue
	INTERSECTION NUMBER>			1	2	3	4	5	6	7	8	9	10	11	12	13	14	15	16	17	18	19	20	21	22	23	24	25	26	27	28	29	9 30	31	32	33
42400200 *	PORTLAND CEMENT CONCRETE SIDEWALK 5 INCH	SQFT	635											1				İ	l														<u> </u>			
	SIDEWALK REMOVAL	SQFT	635																																	
67000400	ENGINEER'S FIELD OFFICE, TYPE A	CAL MO	13																																L	
	MOBILIZATION	LSUM	1																																	
70102635	TRAFFIC CONTROL AND PROTECTION, STANDARD 701701	LSUM	1																												1		'			
81000600	CONDUIT IN TRENCH, 2" DIA., GALVANIZED STEEL	FOOT	344																																	
81018500	CONDUIT PUSHED, 2" DIA., GALVANIZED STEEL	FOOT	56																																	
85000200	MAINTENANCE OF EXISTING TRAFFIC SIGNAL INSTALLATION	EACH	124	1	1	1	1	1	1	1	1	1	1	1	1	1	1	1	1	1	1	1	1	1	1	1	1	1	1	1	1	1	1 1	1	1	1
85700200	FULL-ACTUATED CONTROLLER AND TYPE IV CABINET	EACH	2			T					1	1		]																	I		1			
85700205	FULL-ACTUATED CONTROLLER AND TYPE IV CABINET, SPECIAL	EACH	10			1	1		1																1								1			
85700500	FULL-ACTUATED CONTROLLER IN EXISTING CABINET	EACH	3																1	[																
85700505	FULL-ACTUATED CONTROLLER IN EXISTING CABINET, SPECIAL	EACH	3								1			1																					1	
87301225	ELECTRIC CABLE IN CONDUIT, SIGNAL NO. 143C	FOOT	38113	344	209	223	361	149	236	316	216	275	219	320	285	345	703	500	193	376	263	305	12	292	177	324	458	204	280	138	328	459	366	268	541	362
87302225	ELECTRIC CABLE AERIAL SUSPENDED, SIGNAL, NO. 14 3C	FOOT	673																				240													
87502520	TRAFFIC SIGNAL POST, GALVANIZED STEEL 18 FT.	EACH	30			1		1	1		1		1			1		1	1		1	,			1		1	1	1	1 1		] 1	$\frac{1}{2}$	1	1	
87800100	CONCRETE FOUNDATION, TYPE A	FOOT	8	1													-		-																	
87900200	DRILL EXISTING HANDHOLE	EACH	3																																	
88500100	INDUCTIVE LOOP DETECTOR	EACH	57			6	10		4																5								5	4		
88700200	LIGHT DETECTOR	EACH	271	2	2	2	2	2	2	2	2	2	2	2	2	2	3	2	2	2	2	2	2	2	2	2	2	2 '	2	2	! 2	2	2 2	. 2	3	. 2
88700300	LIGHT DETECTOR AMPLIFIER	EACH	117	1	1	1	1	1	1	1	1	1	1	1	1	1	1	1	1	1	1	1	1	1	1	1	1	1	1	1	1	1	1	1	1	, 1
89500100	RELOCATE EXISTING SIGNAL HEAD	EACH	40			1		2	1		1		1			2		2	2		1				1		1	1	111	1		1	1 2	. 1		
89500200	RELOCATE EXISTING PEDESTRIAN SIGNAL HEAD	EACH	11					1	1																1		1	1	1						iT	
89500400	RELOCATE EXISTING PEDESTRIAN PUSH-BUTTON	EACH	11			T		1	1																1		1	1	1		I		Τ,		i = 1	
89502200	MODIFY EXISTING CONTROLLER	EACH	6																										T		T					, 7
89502300	REMOVE ELECTRIC CABLE FROM CONDUIT	FOOT	1075							1					1				1	1													T		Γ. Τ	,
	REMOVE AND REINSTALL ELECTRIC CABLE FROM CONDUIT	FOOT	930	1		15	T	60	45		15		15	1	Ī	30	T	30	30	T	15				45		45	45	45	15	1	15	5 30	15		-
89502375	REMOVE EXISTING TRAFFIC SIGNAL EQUIPMENT	EACH	66			1	1	1	1		1		1			1		1	1		1				1		1	1	1	1		1	1 1	1		,
X0301023	CONFIRMATION BEACON	EACH	2																1				1										T			$-\neg$
	EMERGENCY VEHICLE PREEMPTION PUSH BUTTON ASSEMBLY	EACH	1			T					<b>†</b>	1			1		1	1	T	1									1		1					, — —
	ELECTRIC CABLE IN CONDUIT NO. 20 3/C, TWISTED, SHIELDED	FOOT	33676	344	209	223	361	149	236	316	216	275	219	320	285	345	703	500	193	376	263	305	12	292	177	324	458	204	260	138	328	459	9 366	268	541	352
	ELECTRIC CABLE AERIAL SUSPENDED NO. 20 3/C, TWISTED, SHIELDED	FOOT	673					1						1	i -		1	1	1		1		240					1	T		T		T			
	MODIFY EXISTING TYPE "D" FOUNDATION	EACH	7					1	1		T		Ι	T	T		1	T	1	T	1		T		1				T		T		1			
	MAGNETIC DETECTOR AMPLIFIER	EACH	11	T			2	1	2	1	1	1	L																		I					
Z0076600 △		HOUR	500.0	3.8	3.8	3.8	3.8	3.8	3.8	3.8	3.8	3.8	3.8	3.8	3.8	3.8	3.8	3.8	3.8	3.8	3.8	3.8	3.8	3.8	3.8	3.8	3.8	3.8	3.8	3.8	3.8	3.6	3.8	3.8	3.8	3.8

\* SPECIALTY ITEMS

V 7080

\*NOTE: 3M OPTICOM 700 SERIES PHASE SELECTORS AND THE MOST RECENT MODEL OF OPTICAL DETECTOR SHALL BE INSTALLED AT INTERSECTIONS LOCATED WITHIN THESE COMMUNITIES:

VILLAGE OF MIDLOTHIAN, VILLAGE OF HOMEWOOD

3M OPTICOM 400 SERIES PHASE SELECTORS AND THE MOST RECENT MODEL OF OPTICAL DETECTOR SHALL BE INSTALLED AT INTERSECTIONS LOCATED WITHIN THESE COMMUNITIES:

CITY OF CALUMET CITY, VILLAGE OF CALUMET PARK, CITY OF CHICAGO HEIGHTS, CITY OF COUNTRY CLUB HILLS, VILLAGE OF GLENWOOD, VILLAGE OF HAZEL CREST, VILLAGE OF LINSING, VILLAGE OF LINWOOD, CITY OF OAK FOREST, VILLAGE OF SOEM, VILLAGE OF SOUTH CHICAGO HEIGHTS, VILLAGE OF STECK, VILLAGE OF SOUTH CHICAGO HEIGHTS, VILLAGE OF STECK, VILLAGE OF THORNTON.

*PLANS MODIFI		ILLINOIS DEPARTM	ENT OF TRANSFORTATION
REVISION	4S		
NAME	DATE		NCY VEHICLE PREEMPTION OF QUANTITIES
			CALUMET CIT!
		SCALE: VERT. HORIZ.	DRAWN BY JSZ
		DATE 01/02/08	CHECKED BY MRS

ROBINSON ENGINEERING, L. (7000 SOUTH PARK AVENUE SOUTH POLLAND, RLUNDS (708) 331-6700 PAK (708) 33: 16-708 ILLINOIS DESIGN FIRM REGISTRATION NO. 184001121.

97248-QUAN-01-01

F. A. RTE.	SECTION		COUNTY	TOTAL SHEETS	SHEET
	08-00146-00	⊢π.	соок	273	014
STA.		TO	STA.		
FED. R	OAD DIST. NO.	FLUNCES	FED. AID P	ROJECT	

ТТ		П			CONSTR	CUCTION	TYPE C	ODE YO	31-1F	
					VILL	AGE OF	CALUM	ET PARI	ζ .	
CODED PAY ITEM	PAY ITEM DESCRIPTION		UNIT	127th Street & Throop	127th Street & Ashland Avenue	127th Street & Marshfield	127th Street & Wood Street	Ashland Avenue & Vermont Avenue	127th Street & Bishop	127th Street & Paulina
	INTERSECTION NUMBER>	Г		34	35	36	37	38	39	40
42400200	PORTLAND CEMENT CONCRETE SIDEWALK 5 INCH		SQ FT							
44000600	SIDEWALK REMOVAL		SQ FT					Ī		
67000400	ENGINEER'S FIELD OFFICE, TYPE A	П	CAL MO							
67100100	MOBILIZATION		L SUM							
70102635	TRAFFIC CONTROL AND PROTECTION, STANDARD 701701	П	LSUM				1			
81000600	CONDUIT IN TRENCH, 2" DIA., GALVANIZED STEEL	П	FOOT							
81018500	CONDUIT PUSHED, 2" DIA., GALVANIZED STEEL	T	FOOT							
85000200	MAINTENANCE OF EXISTING TRAFFIC SIGNAL INSTALLATION	Т	EACH	1	1	1	1	1	1	1
85700200	FULL-ACTUATED CONTROLLER AND TYPE IV CABINET	T	EACH							
85700205	FULL-ACTUATED CONTROLLER AND TYPE IV CABINET, SPECIAL		EACH							
85700500	FULL-ACTUATED CONTROLLER IN EXISTING CABINET		EACH							
85700505	FULL-ACTUATED CONTROLLER IN EXISTING CABINET, SPECIAL		EACH				1			
87301225	ELECTRIC CABLE IN CONDUIT, SIGNAL NO. 14 3C		FOOT	131	259	391	146	294	228	301
87302225	ELECTRIC CABLE AERIAL SUSPENDED, SIGNAL, NO. 143C		FOOT							
87502520	TRAFFIC SIGNAL POST, GALVANIZED STEEL 18 FT.		EACH	1					1	
87800100	CONCRETE FOUNDATION, TYPE A	П	FOOT							
87900200	DRILL EXISTING HANDHOLE		EACH							
88500100	INDUCTIVE LOOP DETECTOR		EACH							
88700200	LIGHT DETECTOR	П	EACH	2	2	2	2	2	2	2
88700300	LIGHT DETECTOR AMPLIFIER		EACH	1	1	1	1	1	1	1
89500100	RELOCATE EXISTING SIGNAL HEAD		EACH	1					1	
89500200	RELOCATE EXISTING PEDESTRIAN SIGNAL HEAD		EACH	1					1	
89500400	RELOCATE EXISTING PEDESTRIAN PUSH-BUTTON		EACH	1					1	
89502200	MODIFY EXISTING CONTROLLER		EACH							
89502300	REMOVE ELECTRIC CABLE FROM CONDUIT		FOOT							
89502350	REMOVE AND REINSTALL ELECTRIC CABLE FROM CONDUIT		FOOT	45					45	
89502375	REMOVE EXISTING TRAFFIC SIGNAL EQUIPMENT	П	EACH	1					1 -	
XD301023	CONFIRMATION BEACON	П	EACH							
X0322131	EMERGENCY VEHICLE PREEMPTION PUSH BUTTON ASSEMBLY	П	EACH							
X8730250	ELECTRIC CABLE IN CONDUIT NO. 20 3/C, TWISTED, SHIELDED	П	FOOT	131	259	391	146	294	228	301
X8730350	ELECTRIC CABLE AERIAL SUSPENDED NO. 20 3/C, TWISTED, SHIELDED	П	FOOT							
X8780110	MODIFY EXISTING TYPE "D" FOUNDATION	П	EACH		1	T			T	
XX007286	MAGNETIC DETECTOR AMPLIFIER		EACH							
Z0076600	TRAINEES		HOUR	3.8	3.8	3.8	3.8	3.8	3.8	3.8

★ PLANS MODIFIED BY ROBINSON ENGINEERING, LTD

ILLINOIS DEPARTMENT OF TRANSPORTATION

PROPOSED EMERGENCY VEHICLE PREEMPTION SUMMARY OF QUANTITIES VILLAGE OF CALUMET PARK

F. A. RTE.	SECTION	T	COUNTY	TOTAL SHEETS	SHEET NO
	08-00146-00	-TL	COOK	273	015
STA.		то	STA.		
FED. F	IOAO DIST. NO.	KANOIS	FED. AID PRO	MECT	

												CONSTR	RUCTION	TYPE C	ODE YO	31-1F									
					CITY OF	FCHICA	30 HEIG	HTS			CITY O	F COUNT	TRY CLU	BHLLS		VILLAGE		DOOMN	)		VILLA	AGE OF I	HAZEL CI		
CODED PAY ITEM	PAY ITEM DESCRIPTION	UNIT	Rt. 30 & Division Street	Rt. 30 & Chicago Road	Rt. 30 & Halsted Street	Rt. 30 & S State Street	Joe Orr & Chicago Road	Joe Orr & Halsted Street	Halsted & Vollmer Road	Chicago Road & 15th Street	Cicero Avenue & Flossmoor Road	Cicero Avenue & 1 83rd Street	Cicero Avenue & 175th Street	Pulaski (Crawford) & 167th Street	Main & North Main	Glenwood Lansing & Glenwood Dyer Road	Gle	Main Street & Young	187th Street & Glerwood-Chicago Heights Road	167th Street & Head Avenue	South Suburban Hospital & Kedzie Avenue		183rd Street & Kedzie Awenue	183rd Street & Grenoble Avenue	175th Street & Governors Highway
	INTERSECTION NUMBER>		41	42	43	44	45	46	47	48	49	50	51	52	53	54	55	56	57	58	59	60	61	62	63
42400200	PORTLAND CEMENT CONCRETE SIDEWALK 5 INCH	SQ FT									<u> </u>					<u> </u>			100					$\sqcup$	
44000600	SIDEWALK REMOVAL	SQ FT																	100					igsquare	
67000400	ENGINEER'S FIELD OFFICE, TYPE A	CAL MO																							
67100100	MOBILIZATION	LSUM		L																					
70102635	TRAFFIC CONTROL AND PROTECTION, STANDARD 701701	LSUM														<u> </u>			l				$oxed{oxed}$		
81000600	CONDUIT IN TRENCH, 2" DIA., GALVANIZED STEEL	FOOT		l															5						
81018500	CONDUIT PUSHED, 2" DIA., GALVANIZED STEEL	FOOT																						Ĺ	
85000200	MAINTENANCE OF EXISTING TRAFFIC SIGNAL INSTALLATION	EACH	1	1	1	1	1	1	1	1	1	1	1	1	1	1	1	1	1	1	1	1	1	1	1
85700200	FULL-ACTUATED CONTROLLER AND TYPE IV CABINET	EACH		T																					
85700205	FULL-ACTUATED CONTROLLER AND TYPE IV CABINET, SPECIAL	EACH	***************************************									1	Ī												
85700500	FULL-ACTUATED CONTROLLER IN EXISTING CABINET	EACH		T										1									1		
85700505	FULL-ACTUATED CONTROLLER IN EXISTING CABINET, SPECIAL	EACH										1													
87301225	ELECTRIC CABLE IN CONDUIT, SIGNAL NO. 14 3C	FOOT	274	276	456	224	736	313	315	454	304	311	376	338	348	366	425	580	297	320	265	250	300	210	300
87302225	ELECTRIC CABLE AERIAL SUSPENDED, SIGNAL, NO. 143C	FOOT		1																					
87502520	TRAFFIC SIGNAL POST, GALVANIZED STEEL 18 FT.	EACH													1				2				,		
87800100	CONCRETE FOUNDATION, TYPE A	FOOT																	4						
87900200	DRILL EXISTING HANDHOLE	EACH		l		,		· · · · · · · · · · · · · · · · · · ·			T			-					1						
	INDUCTIVE LOOP DETECTOR	EACH		1															1						
	LIGHT DETECTOR	EACH	2	2	2	2	3	2	2	2	2	2	2	2	2	2	2	3	3	2	2	2	. 3	3	3
	LIGHT DETECTOR AMPLIFIER	EACH	1	1	1	1	1	1	1	1	1	1	1	1	1	1	1	1	1	1	1	1	1	1	. 1
	RELOCATE EXISTING SIGNAL HEAD	EACH		T											2				3						
89500200	RELOCATE EXISTING PEDESTRIAN SIGNAL HEAD	EACH		1			1						T			<u> </u>									
	RELOCATE EXISTING PEDESTRIAN PUSH-BUTTON	EACH								T		T	1						T						
89502200	MODIFY EXISTING CONTROLLER	EACH							1					1					1						
89502300	REMOVE ELECTRIC CABLE FROM CONDUIT	FOOT					T							1	T						265		300	210	300
89502350	REMOVE AND REINSTALL ELECTRIC CABLE FROM CONDUIT	FOOT							1						30				45						
89502375	REMOVE EXISTING TRAFFIC SIGNAL EQUIPMENT	EACH		<u> </u>			T			i –			1	1	1				1	i	1		1	1	1
X0301023	CONFIRMATION BEACON	EACH		1					1	1		Ī		T			l	T	1	l					
	EMERGENCY VEHICLE PREEMPTION PUSH BUTTON ASSEMBLY	EACH		1					<u> </u>			1	1					1	1	<u> </u>					
X8730250	ELECTRIC CABLE IN CONDUIT NO. 20 3/C, TWISTED, SHIELDED	FOOT	274	276	456	224	736	313	315	454	304	311	376	338	348	366	425	580	575	320	265	250	300	210	300
	ELECTRIC CABLE AERIAL SUSPENDED NO. 20 3/C, TWISTED, SHIELDED	FOOT		t	<b>†</b>	<b>†</b>	<b> </b>					T	1		1				1	T		1	,		
	MODIFY EXISTING TYPE "D" FOUNDATION	EACH		1	1	T						T					1					T			
	MAGNETIC DETECTOR AMPLIFIER	EACH		<u> </u>	<b>†</b>	t	<b> </b>	<b>†</b>	t	t	<u> </u>	i –	<del> </del>	t				T	<u> </u>	l					
	TRAINEES	HOUR	3.8	3.8	3.8	3.8	3.8	3.8	3.8	3.8	3.8	3.8	3.8	3.8	3.8	3.8	3.8	3.8	3.8	3.8	3.8	3.8	3.8	3.8	3.8

ILLINOIS DEPARTMENT OF TRANSPORTATION ★ PLANS MODIFIED BY ROBINSON ENGINEERING, LTD PROPOSED EMERGENCY VEHICLE PREEMPTION SUMMARY OF QUANTITIES SCALE: VERT. DRAWN D.
HORIZ
DATE 01/02/08 CHECKED BY

\*\*TOD SIGNIFICAN ENGLINEERING. LEVEL EDT
TYPE SIGNIFICAN ENGLINEERING. LEVEL EDT
TYPE SIGNIFICAN ENGLINEERING. SIGNIFICAN ENGLINEERING.

\*\*SIGNIFICAN ENGLINEERING.\*\*

\*\*TOTAL SIGNIFICAN ENGLIN

F. A. RYE.	SECTION		COUNTY	TOTAL SHEETS	SMEET NO
	08-00146-00	)—TL	COOK	273	016
STA.		т	STA.		
FED. I	ROAD DIST, NO.	ILLINOIS	FED. AD PR	KNECL	

		1												CON	ISTRUCT	ION TYP	E CODE	Y031-11	F											
										VI	LLAGE C	OF HOME	GOOM									VI	ILLAGE (	OF LANS	ING		VILLAG	E OF LYN	MMOOD	
CODED PAY ITEM	PAY ITEM DESCRIPTION	UNIT	187th Street & Riegal Road	187th Street & Diexie Highway	183rd Street & Aberdeen	183rd Street & Dixie Highway	183rd Street & Harwood Avenue	183rd Street & Western Avenue	183rd Street & Governors Highway	Ridge Road & Dixie Highway	Willow Road & Dixie Highway	175th Street & Halsted Street	176th Street & Halsted Street	Halsted Street & Maple Road	Halsted Street & Ridge Road	183rd Street & Riegal Road	Ridge Road & Riegal Road / Ashland Avenue	183rd Street & Halsted Street	187th Street & Halsted Street	Holbrook Road & Riegal Road	175th Street & Ashland Avenue	Torrence Ave. (IL 83) & 186th Street	Torrence Ave. (IL 83)  R Thornton-Lansing	Torrence Ave. (IL 83) & 170th Street	186th Street & Burnham Avenue	Glenwood Dyer Road & Burnham Avenue	Glenwood Dyer Road & Torrence Avenue	Glenwood Dyer Road & Route 30	Glenwood Dyer Road & Stony Ísland Avenue	Joe Orr Road & Stony Island Avenue
	INTERSECTION NUMBER>		64	65	66	67	68	69	70	71	72	73	74	75	76	77	78	79	80	81	82	83	84	85	86	87	88	89	90	91
42400200	PORTLAND CEMENT CONCRETE SIDEWALK 5 INCH	SQFT																											<u> </u>	
44000600	SIDEWALK REMOVAL	SQFT		1																				J						
67000400	ENGINEER'S FIELD OFFICE, TYPE A	CAL MO																												
67100100	MOBILIZATION	LSUM																						T						1
70102635	TRAFFIC CONTROL AND PROTECTION, STANDARD 701701	L SUM																												
81000600	CONDUIT IN TRENCH, 2" DIA., GALVANIZED STEEL	FOOT																							1		T			
81018500	CONDUIT PUSHED, 2" DIA., GALVANIZED STEEL	FOOT					Ī			***************************************	1	T																		
85000200	MAINTENANCE OF EXISTING TRAFFIC SIGNAL INSTALLATION	EACH	1	1	1	1	1	1	1	1	1	1	1	1	1	1	1	1	1	1	1	1	1	1	1	1	1	1	1	1
85700200	FULL-ACTUATED CONTROLLER AND TYPE IV CABINET	EACH																				1		1		1				1
85700205	FULL-ACTUATED CONTROLLER AND TYPE IV CABINET, SPECIAL	EACH	1									1													1					1
85700500	FULL-ACTUATED CONTROLLER IN EXISTING CABINET	EACH												T	<u> </u>								1				1			
85700505	FULL-ACTUATED CONTROLLER IN EXISTING CABINET, SPECIAL	EACH	······································	1												1	1						1					$\Box$		
87301225	ELECTRIC CABLE IN CONDUIT, SIGNAL NO. 143C	FOOT	223	240	274	260	664	135	269	253	305	300	279	304	341	266	257	262	563	252	286	237	357	300	399		248	327	329	252
87302225	ELECTRIC CABLE AERIAL SUSPENDED, SIGNAL, NO. 14 3C	FOOT																					1	1	T	239	T		1	
87502520	TRAFFIC SIGNAL POST, GALVANIZED STEEL 18 FT.	EACH		T																								1		
87800100	CONCRETE FOUNDATION, TYPE A	FOOT		1						1	1	1																		
87900200	DRILL EXISTING HANDHOLE	EACH		T																						1				
88500100	INDUCTIVE LOOP DETECTOR	EACH	4	1							<b>†</b>	1	1				İ						1		4					
88700200	LIGHT DETECTOR	EACH	2	2	2	2	4	2	2	3	2	2	2	2	2	2	2 2	2	2	2	2	2 2	2	2	2	2	2	2	2	2
88700300	LIGHT DETECTOR AMPLIFIER	EACH	1	1	1						1	1	1	1	1	1	1	1		1	1	1	1	1	1	1	1	1	1	1
89500100	RELOCATE EXISTING SIGNAL HEAD	EACH		<b>†</b>	<b> </b>								1		ļ				-									1		
89500200	RELOCATE EXISTING PEDESTRIAN SIGNAL HEAD	EACH		<b>†</b>	<b></b>			<b> </b>		<u> </u>		-	1				1					<b>†</b>			<b>T</b>		<b>†</b>	<del></del>		
89500400	RELOCATE EXISTING PEDESTRIAN PUSH-BUTTON	EACH													<b></b>								1	1	1	1	1			
89502200	MODIFY EXISTING CONTROLLER	EACH		1	<b>!</b>	<del> </del>		<b>!</b>		<b></b>	<b>†</b>					1	1				<del> </del>	1		·	İ		1	<del></del>		
89502300	REMOVE ELECTRIC CABLE FROM CONDUIT	FOOT		†	<b></b>	<del> </del>				-	<b>†</b>	<del> </del>	<b>!</b>				1											<del></del>		
89502350	REMOVE AND REINSTALL ELECTRIC CABLE FROM CONDUIT	FOOT								<b></b>															T			15		
89502375	REMOVE EXISTING TRAFFIC SIGNAL EQUIPMENT	EACH	1	1	1	1	1	1	1	1	1	1	1	1	1	1	1	1	1	1	1	1	1	1	1		1	1	,	
X0301023	CONFIRMATION BEACON	EACH		T						<u> </u>	1						1		1			T	1		1		T			
X0322131	EMERGENCY VEHICLE PREEMPTION PUSH BUTTON ASSEMBLY	EACH		1								1	<b></b>										1	1	<b>†</b>	T	1			
X8730250	ELECTRIC CABLE IN CONDUIT NO. 20 3/C, TWISTED, SHIELDED	FOOT									<u> </u>	ļ									286	237	357	300	399	<b>1</b>	248	327	329	252
X8730350	ELECTRIC CABLE AERIAL SUSPENDED NO. 20 3/C, TWISTED, SHIELDED	FOOT										<b></b>										1		1	1	239				
X8780110	MODIFY EXISTING TYPE "D" FOUNDATION	EACH											<del> </del>	<u> </u>			1							1	1	<b>†</b>	T			
XX007286	MAGNETIC DETECTOR AMPLIFIER	EACH		1						1						1							1	1	2	T	3 *		ļ	
Z0076600	TRAINEES	HOUR	3.8	3.8	3.8	3.8	3.8	3.8	3.8	3.8	3.8	3.8	3.8	3.8	3.8	3.8	3.8	3.8	3.8	3.8	3.8	3.8	3.8	3.8	3.8	3.8	3.8	3.8	3.8	3.8

\*PLANS MODIFIED BY ROBINSON ENGINEERING, LTD

REVISIONS

NAME
DATE
PROPOSED EMERGENCY VEHICLE PREEMPTION SUMMARY OF QUANTITIES

SCALE: HORIZ. DRAWN BY HORIZ. DATE 1/02/08 CHECKED BY

F. A. KTÉ.	SECTION			COUNTY	TOTAL SHEETS	SHEET NO
	08-00146-00	-TL		COOK	273	017
STA.			то	STA.		
FED. N	KOAD DIST. NO.	ELINO	5	FEO. AD PRO	JECT	

		1 1							CONSTR	RUCTION	TYPE C	ODE YÛ	31-1F						
					V	LLAGE	OF MIDL						FOAKF	OREST		VILLA	GE OF F	OSEN	
CODED PAY ITEM	PAY ITEM DESCRIPTION	UNIT	Rt. 83 (147th Street) & Kedzie Avenue	Rt. 83 (147th Street) & Hornan Avenue	Rt. 83 (147th Street) & Pulaski Avenue	Rt. 83 (147th Street) & Keeler Avenue	Rt. 83 (147th Street) & Kilbourn Avenue	Rt. 83 (147th Street) & Cicero Avenue	152nd Street & Pulaski Road	145th Street & Pulaski Road	Claire Boulevard & Pulaski Road	155th Street & Central Avenue	199th Street & Oak Forest Hospital Entrance	Cero	147th Street & Cleveland Avenue	147th Street & Harrison Avenue	147th Street & Sacremento Avenue	139th Street & Harrison Avenue	139th Street & Western Avenue
	INTERSECTION NUMBER ->		92	93	94	95	96	97	98	99	100	101	102	103	104	105	106	107	108
42400200	PORTLAND CEMENT CONCRETE SIDEWALK 5 INCH	SQFT										135							
44000600	SIDEWALK REMOVAL	SQFT										135							
67000400	ENGINEERS FIELD OFFICE, TYPE A	CAL MO																	
67100100	MOBILIZATION	LSUM																	
70102635	TRAFFIC CONTROL AND PROTECTION, STANDARD 701701	LSUM																	
81000600	CONDUIT IN TRENCH, 2" DIA., GALVANIZED STEEL	FOOT										334							
81018500	CONDUIT PUSHED, 2" DIA , GALVANIZED STEEL	FOOT		1				1				56							
85000200	MAINTENANCE OF EXISTING TRAFFIC SIGNAL INSTALLATION	EACH	1						1	1		1	1	1	1	1	1	1	1
85700200	FULL-ACTUATED CONTROLLER AND TYPE IV CABINET	EACH													Ī				
85700205	FULL-ACTUATED CONTROLLER AND TYPE IV CABINET, SPECIAL	EACH			1				T		T					1	1	1	
85700500	FULL-ACTUATED CONTROLLER IN EXISTING CABINET	EACH											1						1
85700505	FULL-ACTUATED CONTROLLER IN EXISTING CABINET, SPECIAL	EACH		1				T	1	1									-
87301225	ELECTRIC CABLE IN CONDUIT, SIGNAL NO. 143C	FOOT	305		1				141	1		329	471		413	185	280		229
87302225	ELECTRIC CABLE AERIAL SUSPENDED, SIGNAL, NO. 14 3C	FOOT			<u> </u>			T										194	
87502520	TRAFFIC SIGNAL POST, GALVANIZED STEEL 18 FT.	EACH					<b>1</b>				1		1			1	1		
87800100	CONCRETE FOUNDATION, TYPE A	FOOT			1			<u> </u>	1										
87900200	DRILL EXISTING HANDHOLE	EACH			<b>†</b>		<b></b>	<u> </u>		1	T	1	1						
88500100	INDUCTIVE LOOP DETECTOR	EACH					1	<b>T</b>								2	2		
88700200	LIGHT DETECTOR	EACH	2	2	2	2	2	2	2	2	2	2	2		2	2	2	2	2
88700300	LIGHT DETECTOR AMPLIFIER	EACH	1		<u> </u>			T	1	1	T	1	1		1	1	1	1	1
89500100	RELOCATE EXISTING SIGNAL HEAD	EACH			<u> </u>		<b>†</b>	1			1					1	2		
89500200	RELOCATE EXISTING PEDESTRIAN SIGNAL HEAD	EACH			1				1	<u> </u>			1	<b> </b>	1	1	1		$\Box$
89500400	RELOCATE EXISTING PEDESTRIAN PUSH-BUTTON	EACH		1	†	<u> </u>	†	1		<u> </u>	<b></b>					1	1		
89502200	MODIFY EXISTING CONTROLLER	EACH			1		<b></b>		<del> </del>		<b></b>		<del> </del>	<b></b>	<b></b>	·	·		
89502300	REMOVE ELECTRIC CABLE FROM CONDUIT	FOOT			<b></b>		t	<b> </b>											$\Box$
89502350	REMOVE AND REINSTALL ELECTRIC CABLE FROM CONDUIT	FOOT		1	†		<del>                                     </del>						†			45	60		
89502375	REMOVE EXISTING TRAFFIC SIGNAL EQUIPMENT	EACH	1	1 1	1 1	1	1	1	1	1	1		1			1	1	1	
X0301023	CONFIRMATION BEACON	EACH		+	<del></del>	<del> </del>	<del>                                     </del>	<del> </del>	<del>                                     </del>	<b></b>	1	<del> </del>		2		Ť			
X0322131	EMERGENCY VEHICLE PREEMPTION PUSH BUTTON ASSEMBLY	EACH		†	†	<b></b>	<del> </del>	†	<del> </del>	<b>†</b>	<del> </del>	1					l		
X8730250	ELECTRIC CABLE IN CONDUIT NO. 20 3/C, TWISTED, SHIELDED	FOOT	305		<b>├</b>				141	1	<b>†</b>	747	471	314	413	185	280		229
X8730350	ELECTRIC CABLE AERIAL SUSPENDED NO. 20 3/C, TWISTED, SHIELDED	FOOT			t				T	t	<del></del>		T	t	ti	t		194	
X8780110	MODIFY EXISTING TYPE "D" FOUNDATION	EACH		1	t		<del>                                     </del>	t	<del> </del>	<del> </del>	<b>†</b>		<del> </del>		-	t 1	1		
XX007296	MAGNETIC DETECTOR AMPLIFIER	EACH		<b></b>	<b>†</b>	<b></b>	<del> </del>	<b>†</b>	<del> </del>	<del> </del>	<del> </del>				<u> </u>	<b> </b>	7		$\overline{}$
Z0076600	TRANEES	HOUR	3.8	3.8	3.8	3.8	3.8	3.8	3.8	3.8	3.8	3.8	3.8	3.8	3.8	3.8	3.8	3.8	3.8

\*PLANS MODIFIED BY
ROBINSON ENGINEERING, LTD

REVISIONS

PROPOSED EMERGENCY VEHICLE PREEMPTION SUMMARY OF QUANTITIES

SCALE: VERT. HORIZ. DATE 01/02/0 DRAWN B

ROBINSON ENGINEERING, LTD.
17000 SOUTH PARK AVENUE SOUTH HOLLAND, RLINGIS 60473
(709) 331-6700 FAX (709) 331-3326
HUNGIS DESIGN FRIM REGISTRATION NO. 184001128.

ILLINOIS DEPARTMENT OF TRANSPORTATION

07248-QUAN-03-01

F. A RRE.	SECTION		COUNTY	TOTAL SHEETS	SHEET	
	08-00146-00	)—TL	COOK	273	018	
STA.		-	TO STA.			
PED. I	ROAD DIST. NO.	LUNOS	FED. AID PV	KNECT	<del></del>	

												ONSTRI	JCTION (	ODE Y	031-1F									
h		<del> </del>	VILLAGE	OF RIVE	RDALE	V	ILLAGE	OF SAU	C VILLAC	3E					EIGHTS	VILLAC	E OF S	STEGER	T	VIL	LAGE OF	FTHORN	TON	
CODED PAY ITEM	PAY ITEM DESCRIPTION	UNIT	138th Street & School Street	144th Street & Halsted Street	144th Street & Indiana Avenue	l-394 & Sauk Trail	Sauk Trail & Torrence Avenue	Route 30 & Torrence Avenue	1-394 & Steger Road	Sauk Trail & Cottage Grove Avenue	Chicago Road & Sauk Trail	Chicago Road & 26th Street	Sauk Trail & East End Avenue	Sauk Trail & State Street	Sauk Trail & Ashland Avenue	Steger Road & Union Avenue	Steger Road & Chicago Road	Steger Road &	1	William Street at Eleanor Street	Margaret Street at Schwab Street	ad at Drive	Vincennes Road at Armory (170th Street) Drive	Indiana Avenue at Armory (170th Street) Drive
	INTERSECTION NUMBER>		109	110	111	1 <b>1</b> 2	113	114	115	116	117	118	119	120	121	122	123	124	125	126	127	128	129	130
42400200	PORTLAND CEMENT CONCRETE SIDEWALK 5 INCH	SQ FT																				400	L'	
44000600	SIDEWALK REMOVAL	SQ FT																				400		
67000400	ENGINEER'S FIELD OFFICE, TYPE A	CAL MO																						
67100100	MOBILIZATION	LSUM																						
70102635	TRAFFIC CONTROL AND PROTECTION, STANDARD 701701	L SUM																						
81000600	CONDUIT IN TRENCH, 2" DIA., GALVANIZED STEEL	FOOT																				5		
81018500	CONDUIT PUSHED, 2" DIA., GALVANIZED STEEL	FOOT																						
85000200	MAINTENANCE OF EXISTING TRAFFIC SIGNAL INSTALLATION	EACH	1	1	1	1	1	1	1	1	1	1	1	1	1	1	1	1	1	1	1	1	1	1
85700200	FULL-ACTUATED CONTROLLER AND TYPE IV CABINET	EACH	1		1																1			
85700205	FULL-ACTUATED CONTROLLER AND TYPE IV CABINET, SPECIAL	EACH															1 48							
85700500	FULL-ACTUATED CONTROLLER IN EXISTING CABINET	EACH											<u> </u>									1		
85700505	FULL-ACTUATED CONTROLLER IN EXISTING CABINET, SPECIAL	EACH																						
87301225	ELECTRIC CABLE IN CONDUIT, SIGNAL NO. 14 3C	FOOT	234	164	183	779	297	331	620	290	275	255	250	333	499	417	267	222	347	348	723	228	343	348
87302225	ELECTRIC CABLE AERIAL SUSPENDED, SIGNAL, NO. 14 3C	FOOT																1						
87502520	TRAFFIC SIGNAL POST, GALVANIZED STEEL 18 FT.	EACH	1	1							1							1				1		1
87800100	CONCRETE FOUNDATION, TYPE A	FOOT					<b>†</b>							1				1				4		
87900200	DRILL EXISTING HANDHOLE	EACH								-	T					,		1	1			1		
88500100	INDUCTIVE LOOP DETECTOR	EACH	4		11													1						
88700200	LIGHT DETECTOR	EACH	2	2	2	3	2	2	3	2	2	2	2	2	2	2	2	2	2	2	2	2	2	2
88700300	LIGHT DETECTOR AMPLIFIER	EACH	1	1	1	1	1	1	1	1	1	1	1	1	1	1	1	1	1	1	1	1	1	1
89500100	RELOCATE EXISTING SIGNAL HEAD	EACH	2	3			1	1										1				1		1
89500200	RELOCATE EXISTING PEDESTRIAN SIGNAL HEAD	EACH		<u> </u>	<del>                                     </del>		<b> </b>	<b></b>										1				1		
89500400	RELOCATE EXISTING PEDESTRIAN PUSH-BUTTON	EACH		1														1	T			1		
89502200	MODIFY EXISTING CONTROLLER	EACH						1										<del>                                     </del>	1		-	1		
89502300	REMOVE ELECTRIC CABLE FROM CONDUIT	FOOT			<b></b>		<del> </del>											1			<u> </u>			
89502350	REMOVE AND REINSTALL ELECTRIC CABLE FROM CONDUIT	FOOT	30	45			<b>†</b>				1							<b>†</b>	1			45		15
89502375	REMOVE EXISTING TRAFFIC SIGNAL EQUIPMENT	EACH	1	1	1		l .			<u> </u>				<b></b>	<b></b>			1	<b>†</b>	<b>†</b>	1	1		1
X0301023	CONFIRMATION BEACON	EACH	<u> </u>	<b>†</b>	<b>†</b>		<b>†</b>	İ	<del> </del>	<b>†</b>	<del> </del>		1	1			<u> </u>	<b>†</b>	<b>†</b>	1	<u> </u>	<b>†</b>	·	
X0322131	EMERGENCY VEHICLE PREEMPTION PUSH BUTTON ASSEMBLY	EACH								t -			t	<b>†</b>	<b></b>	·	<b> </b>	1		1				
X8730250	ELECTRIC CABLE IN CONDUIT NO. 20 3/C, TWISTED, SHIELDED	FOOT	234	164	183	779	297	331	620	290	275	255	250	333	499	417	267	222	347	348	723	228	343	348
X8730350	ELECTRIC CABLE AERIAL SUSPENDED NO. 20 3/C, TWISTED, SHIELDED	FOOT	·	†	t	<b></b>	t	<del> </del>		<b>†</b>						<u> </u>		†	1	1	†	<b>†</b>		
X8780110	MODIFY EXISTING TYPE "D" FOUNDATION	EACH	1	<b> </b>	<b></b>		1	<b>†</b>	·	†		-	l	1				1		1	<b>†</b>	<b>†</b>	<u> </u>	
XX007286	MAGNETIC DETECTOR AMPLIFIER	EACH	<u> </u>	<b>†</b>			<u> </u>	<b>!</b>		<del>                                     </del>	<del>                                     </del>	1	t	<u> </u>	<b></b>	l	<b>-</b>	+	1	<b>†</b>	<del> </del>	<b>†</b>		-
Z0076600	TRAINEES	HOUR	3.8	3.8	3.8	3.8	3.8	3.8	3.8	3.8	3.8	3.8	3.8	3.8	3.8	3.8	3.8	3.8	3.8	3.8	3.8	3.8	3.8	3.8

\* PLANS MODIFIED BY
ROBINSON ENGINEERING, LTD

REVISIONS
NAME DATE


PROPOSED EMERGENCY VEHICLE PREEMPTION
SUMMARY OF QUANTITIES


SCALE: VERT. HORIZ. DATE 01/02/08

DRAWN BY


POBINSON ENGINEERING, LTE
17000 SOUTH PARK AVENUE SOUTH HOLLAND, ILLINOSS 0347
(708) 331-6700 FAX (709) 331-350
ILLINOSS DESIGN FIRM REGISTRATION NO. 184001128.


07248-QUAN-03-02

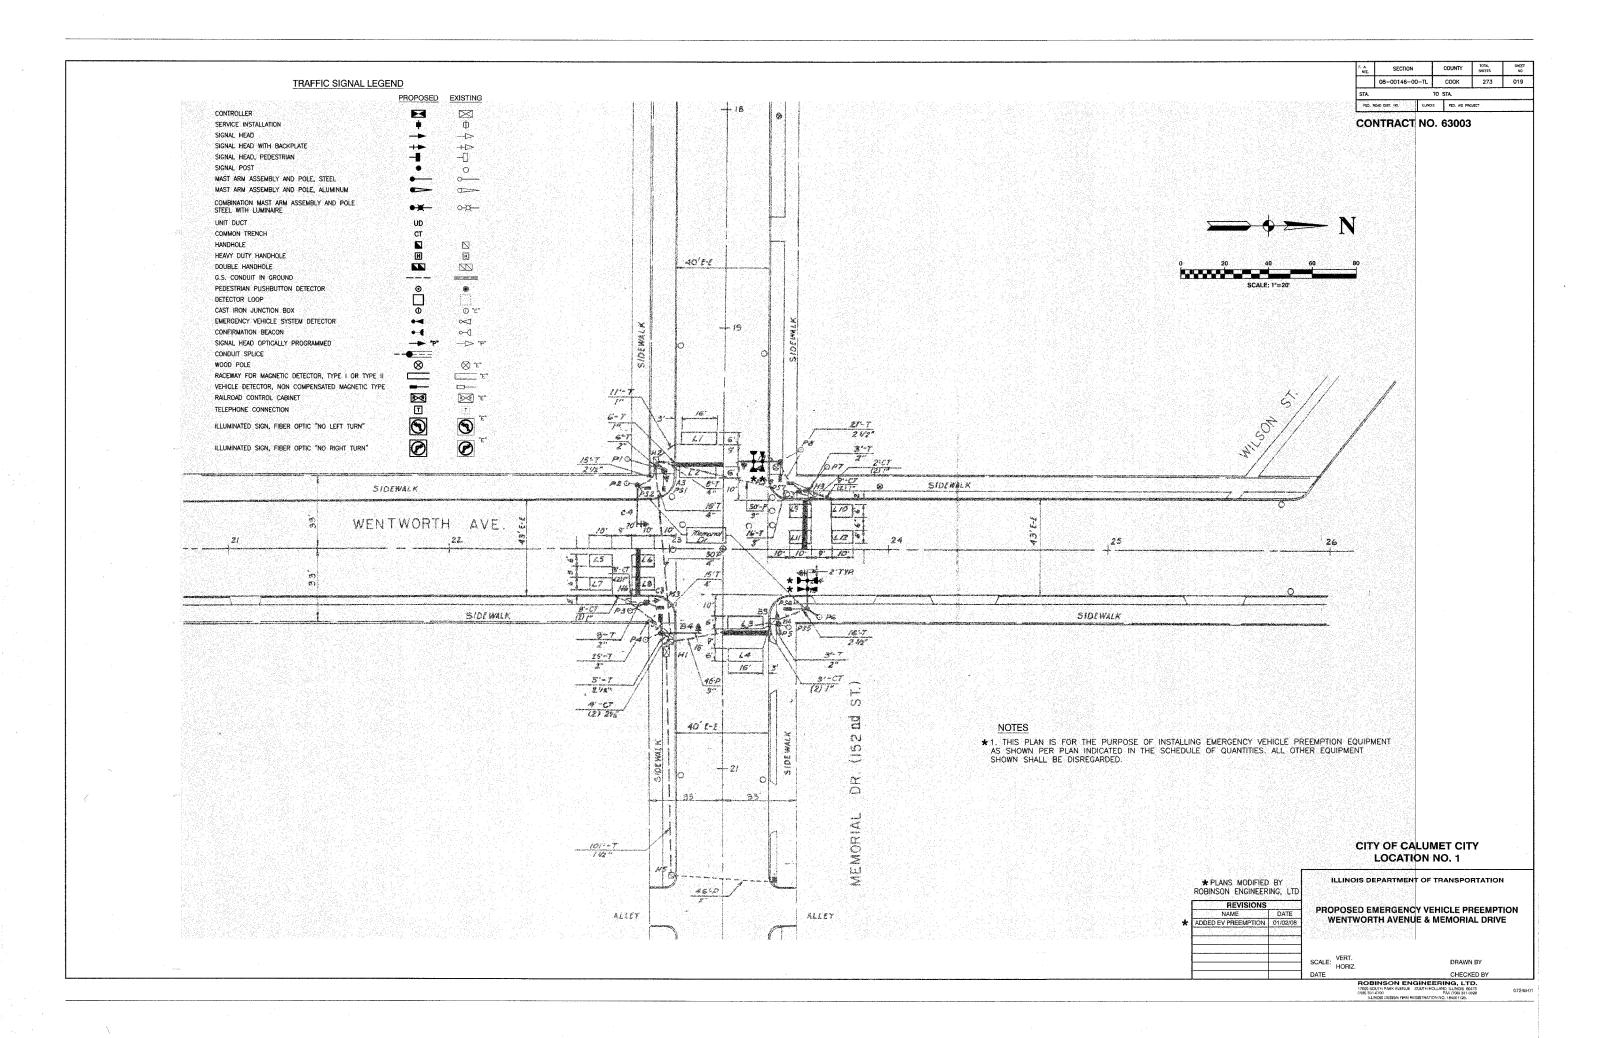

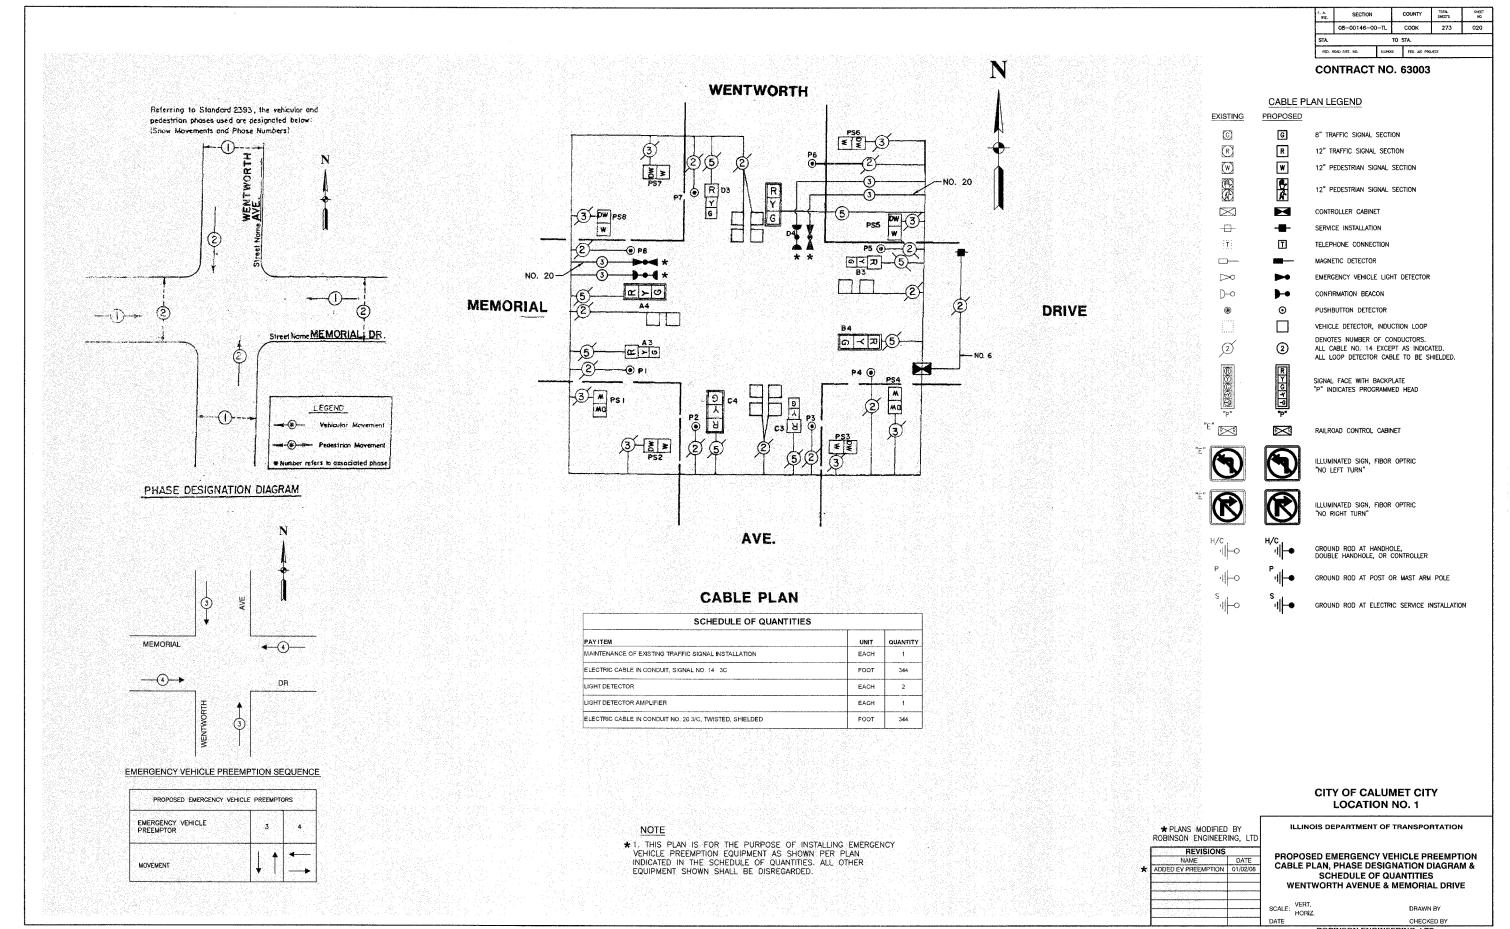

07248-01

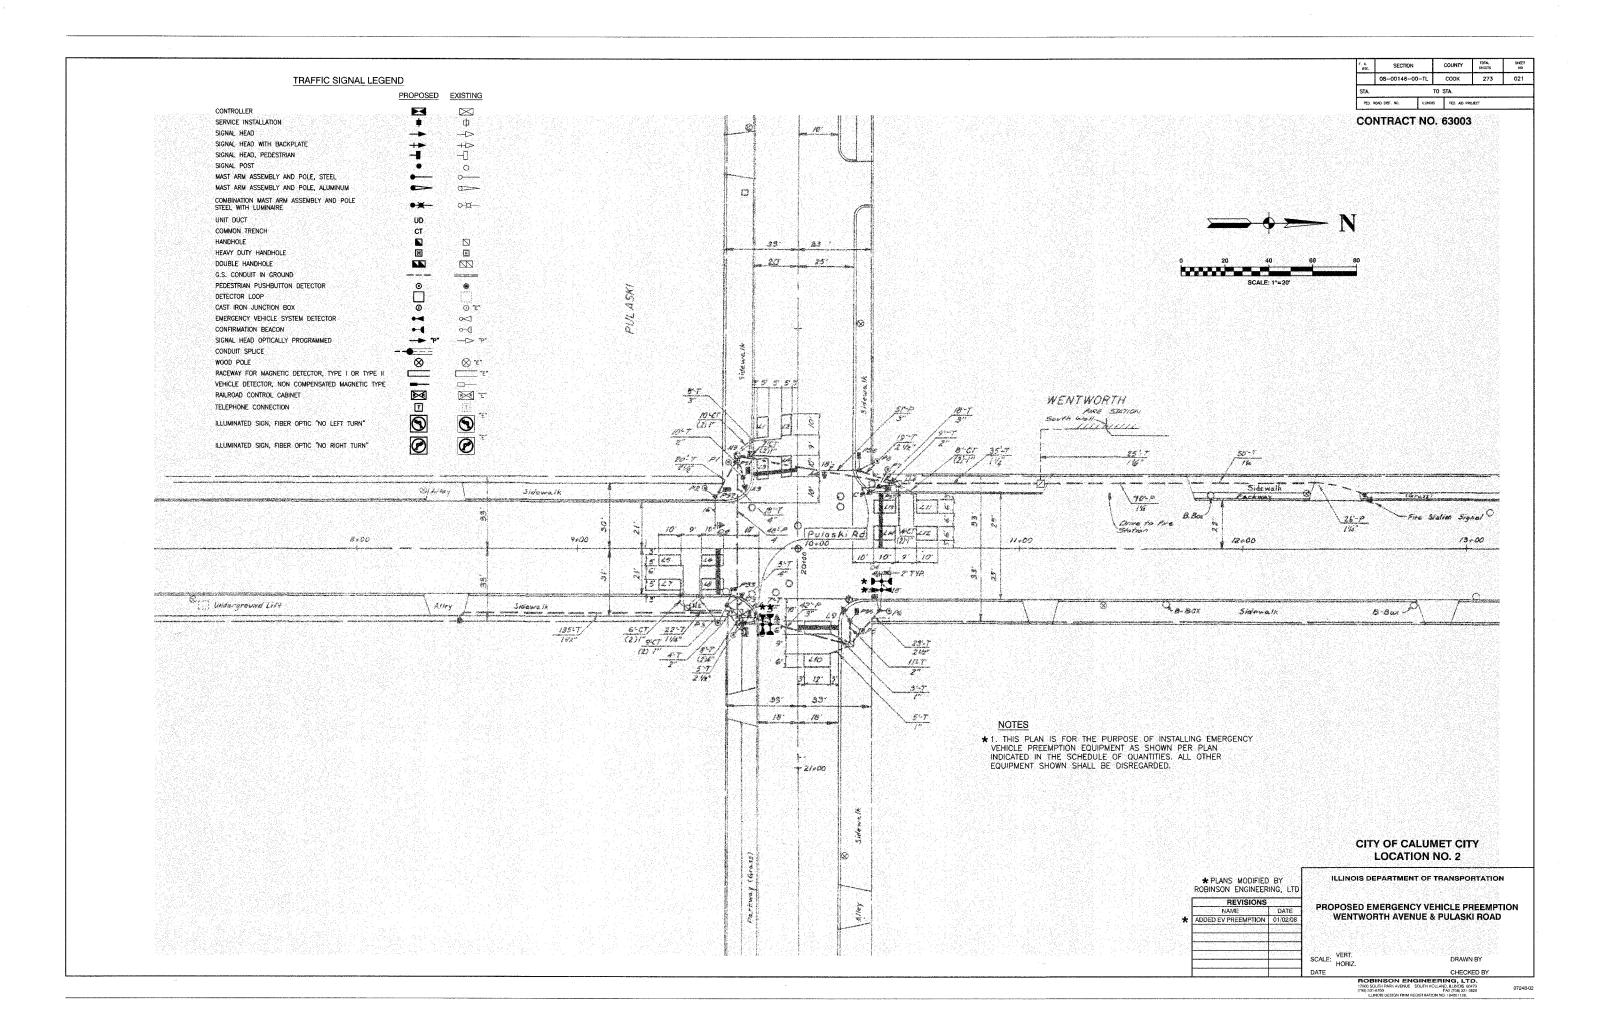

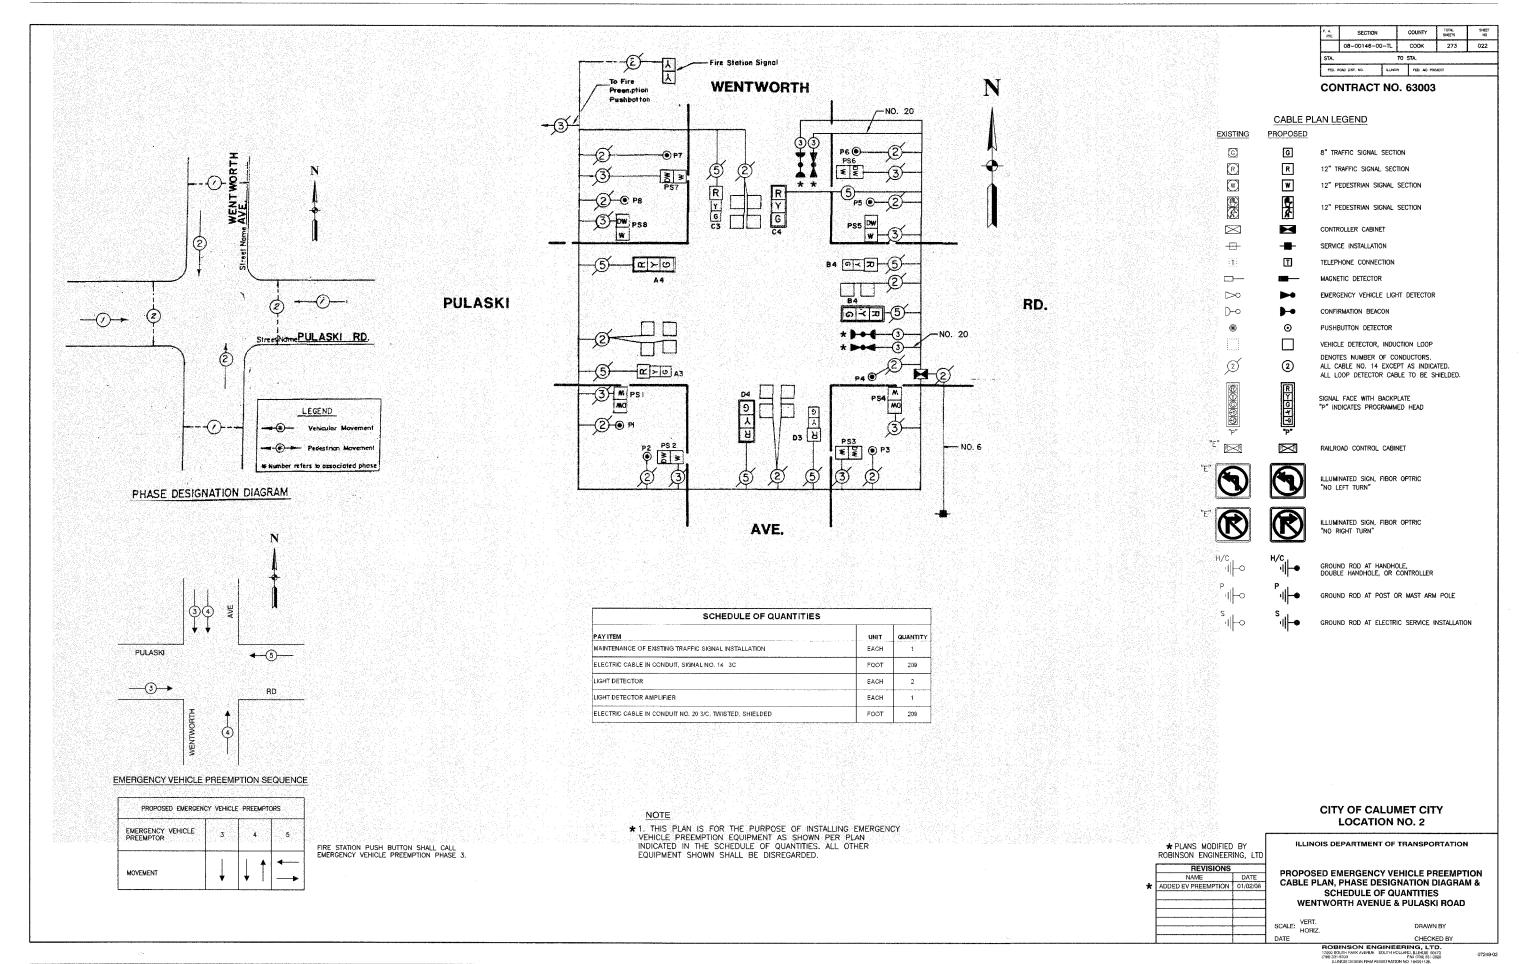

TOTAL SHEETS SECTION COUNTY TRAFFIC SIGNAL LEGEND COOK 273 PROPOSED EXISTING CONTROLLER  $\boxtimes$ **CONTRACT NO. 63003** SERVICE INSTALLATION ф SIGNAL HEAD  $-\triangleright$ + SIGNAL HEAD WITH BACKPLATE SIGNAL HEAD, PEDESTRIAN SIGNAL POST MAST ARM ASSEMBLY AND POLE, STEEL MAST ARM ASSEMBLY AND POLE, ALUMINUM 0 COMBINATION MAST ARM ASSEMBLY AND POLE STEEL WITH LUMINAIRE 0--;¤— UNIT DUCT UD COMMON TRENCH CT HANDHOLE HEAVY DUTY HANDHOLE H Ħ 156TH DOUBLE HANDHOLE  $\square$ G.S. CONDUIT IN GROUND -PEDESTRIAN PUSHBUTTON DETECTOR . DETECTOR LOOP O "E" CAST IRON JUNCTION BOX EMERGENCY VEHICLE SYSTEM DETECTOR ∞⊓ CONFIRMATION BEACON •---0-0 SIGNAL HEAD OPTICALLY PROGRAMMED —|> "P' CONDUIT SPLICE WOOD POLE 8 ⊗ "E" 0 RACEWAY FOR MAGNETIC DETECTOR, TYPE I OR TYPE II E F VEHICLE DETECTOR, NON COMPENSATED MAGNETIC TYPE \_\_\_\_ CONCRETE WENTWORTH AVENUE **▶⋖** RAILROAD CONTROL CABINET **®** ″E" TELEPHONE CONNECTION ⅎ  $\bar{\mathbf{Q}}$ **©** MAIN ILLUMINATED SIGN, FIBER OPTIC "NO LEFT TURN" CONC. APRON 0 0 ILLUMINATED SIGN, FIBER OPTIC "NO RIGHT TURN" STONE ALLEY -SEE NOTE NO. 4 5.10 CONC. APRON CONCRETE STONE ALLEY DRIVE CONCRETE OR **意**\* Ex -14' - Area and a second and a second and a second and a second and a second and a second and a second and a second \*\* ELL X BIT. DR CONCRETE ALLEY SEE NOTE NO. 2 BIT ALLEY CONC. APROM STONE ALLEY THE TRAFFIC SIGNAL CONTROLLER EQUIPMENT FOR THIS INTERSECTION SHALL BE ECONOLITE TO MATCH EXISTING ADJACENT SYSTEM. ★ 1. THIS PLAN IS FOR THE PURPOSE OF INSTALLING EMERGENCY VEHICLE PREEMPTION EQUIPMENT AS SHOWN PER PLAN INDICATED IN THE SCHEDULE OF QUANTITIES. ALL OTHER EQUIPMENT SHOWN CONCRETE 2. EXISTING SIGNAL POST SHALL BE REPLACED WITH NEW 18-FOOT SIGNAL POST ON EXISTING FOUNDATION.
RELOCATION OF ANY EXISTING SIGNAL HEADS, PEDESTRIAN SIGNAL HEADS OR PEDESTRIAN PUSHBUTTONS SHALL BE
PAID FOR SEPERATELY, RELOCATION OF ANY SIGNS BRACKETED TO THE POST SHALL BE INCIDENTAL. THE LIGHT
DETECTOR SHALL BE BRACKET MOUNTED TO THE TOP OF THE NEW POST. THE SALVAGE VALUE OF THE EXISTING POST
SHALL BE INCLUDED IN THE PRICE OF THE PAY ITEM. "TRAFFIC SIGNAL POST, GALVANIZED STEEL, 18 FT". 3. THE FOLLOWING ITEMS SHALL BE REMOVED BY THE CONTRACTOR AND SHALL BE DISPOSED OF BY THEM OUTSIDE. THE RIGHT-OF-WAY AT THEIR EXPENSE. THE SALVAGE VALUE OF THE REMOVED EQUIPMENT SHALL BE REFLECTED IN THE CONTRACTR BID PRICE: TRAFFIC SIGNAL POST, 16 FT EACH 1 4. THE FOLLOWING EXISTING TRAFFIC SIGNAL EQUIPMENT SHALL BE REMOVED BY THE CONTRACTOR, SHALL REMAIN THE PROPERTY OF IDOT, AND SHALL BE STORED AS STATED IN THE SPECIAL PROVISION FOR PICK UP BY THE IDOT FORCES AS DESIGNATED BY ENGINEER. CONTROLLER CABINET EACH 1 **LOCATION NO. 3** STREET ILLINOIS DEPARTMENT OF TRANSPORTATION \* PLANS MODIFIED BY ROBINSON ENGINEERING, LTD REVISIONS PROPOSED EMERGENCY VEHICLE PREEMPTION **WENTWORTH AVENUE & 156TH STREET** ★ ADDED EV PREEMPTION 01/02/08 ADDED 18" POST SCALE: VERT. HORIZ. DRAWN BY



## CARLE DI ANTI ECEND

	CABLE PL	AN LEGEND
EXISTING	PROPOSED	
	G	8" TRAFFIC SIGNAL SECTION
R	R	12" TRAFFIC SIGNAL SECTION
W	W	12" PEDESTRIAN SIGNAL SECTION
	G.	12" PEDESTRIAN SIGNAL SECTION
$\bowtie$		CONTROLLER CABINET
	-	SERVICE INSTALLATION
ΙΪ	Ī	TELEPHONE CONNECTION
	-	MAGNETIC DETECTOR
$\triangleright \!$	▶•	EMERGENCY VEHICLE LIGHT DETECTOR
D0	<b>}</b> →	CONFIRMATION BEACON
•	•	PUSHBUTTON DETECTOR
		VEHICLE DETECTOR, INDUCTION LOOP
2	2	DENOTES NUMBER OF CONDUCTORS. ALL CABLE NO. 14 EXCEPT AS INDICATED. ALL LOOP DETECTOR CABLE TO BE SHIELDED.
*P"	<b>R</b> YG补 <b>9</b> *p*	SIGNAL FACE WITH BACKPLATE "P" INDICATES PROGRAMMED HEAD





 $\bowtie$ 

ILLUMINATED SIGN, FIBOR OPTRIC "NO LEFT TURN"

RAILROAD CONTROL CABINET





ILLUMINATED SIGN, FIBOR OPTRIC










GROUND ROD AT POST OR MAST ARM POLE



GROUND ROD AT ELECTRIC SERVICE INSTALLATION

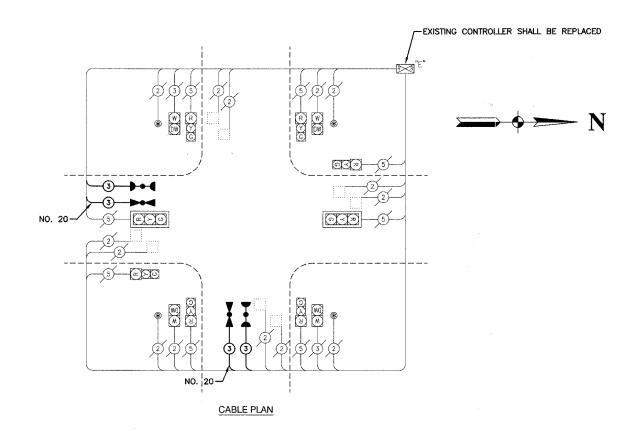

SCHEDULE OF QUANTITIES					
PAY ITEM	UNIT	QUANTITY			
MAINTENANCE OF EXISTING TRAFFIC SIGNAL INSTALLATION	EACH	1			
FULL-ACTUATED CONTROLLER AND TYPE IV CABINET, SPECIAL	EACH	1			
ELECTRIC CABLE IN CONDUIT, SIGNAL NO. 14 3C	FOOT	223			
TRAFFIC SIGNAL POST, GALVANIZED STEEL 18 FT.	EACH	1			
INDUCTIVE LOOP DETECTOR	EACH	6			
LIGHT DETECTOR	EAGH	2			
LIGHT DETECTOR AMPLIFIER	EACH	1			
RELOCATE EXISTING SIGNAL HEAD	EACH	1			
REMOVE AND REINSTALL ELECTRIC CABLE FROM CONDUIT	FOOT	15			
REMOVE EXISTING TRAFFIC SIGNAL EQUIPMENT	EACH	1			
ELECTRIC CABLE IN CONDUIT NO. 20 3/C, TWISTED, SHIELDED	FOOT	223			

#### NOTE

\*1. THIS PLAN IS FOR THE PURPOSE OF INSTALLING EMERGENCY VEHICLE PREEMPTION EQUIPMENT AS SHOWN PER PLAN INDICATED IN THE SCHEDULE OF QUANTITIES. ALL OTHER EQUIPMENT SHOWN SHALL BE DISREGARDED.

2

•---1

PHASE DESIGNATION DIAGRAM

4

WENTWORTH

EMERGENCY VEHICLE PREEMPTOR

MOVEMENT

LEGEND

NUMBER REFERS TO ASSOCIATED PHASE

AVE

3

4

EMERGENCY VEHICLE PREEMPTION SEQUENCE

PROPOSED EMERGENCY VEHICLE PREEMPTORS

WENTWORTH A

\* PLANS MODIFIED BY ROBINSON ENGINEERING, LTD

 
 REVISIONS

 NAME
 DATE

 ★ ADDED EV PREEMPTION
 01/02/08
 ADDED 18 POST ADDED CONTROLLER


# **LOCATION NO. 3** ILLINOIS DEPARTMENT OF TRANSPORTATION


CITY OF CALUMET CITY

PROPOSED EMERGENCY VEHICLE PREEMPTION CABLE PLAN, PHASE DESIGNATION DIAGRAM & SCHEDULE OF QUANTITIES **WENTWORTH AVENUE & 156TH STREET** 

SCALE: VERT. HORIZ.

DRAWN BY

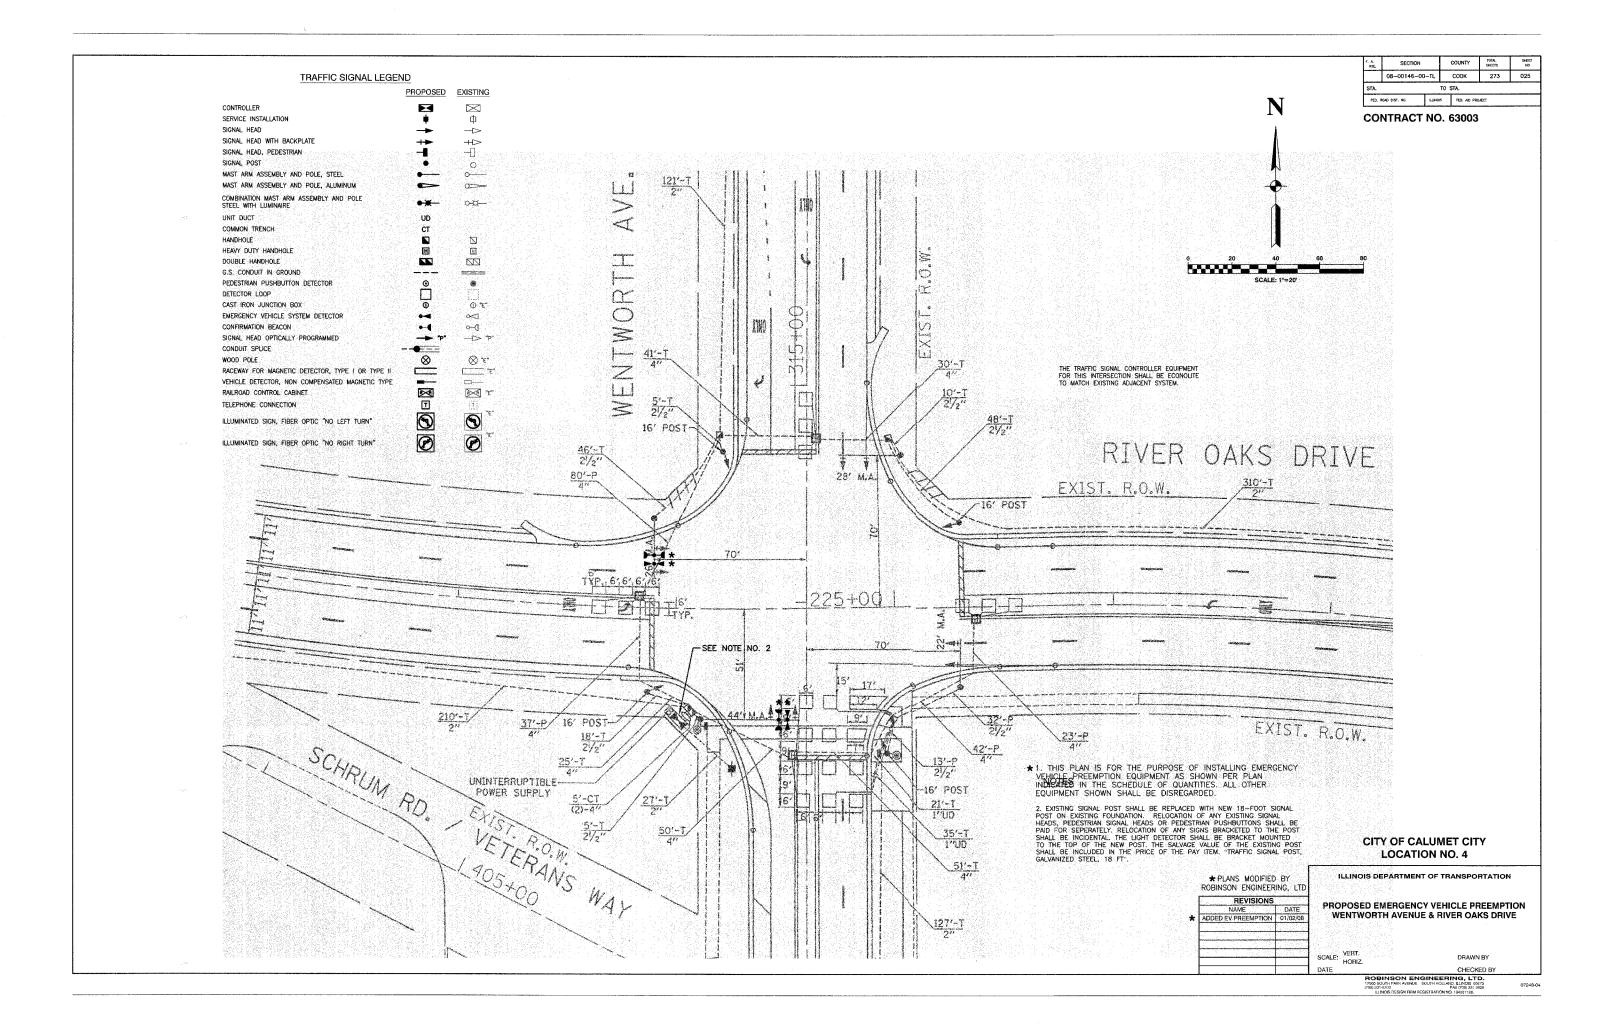


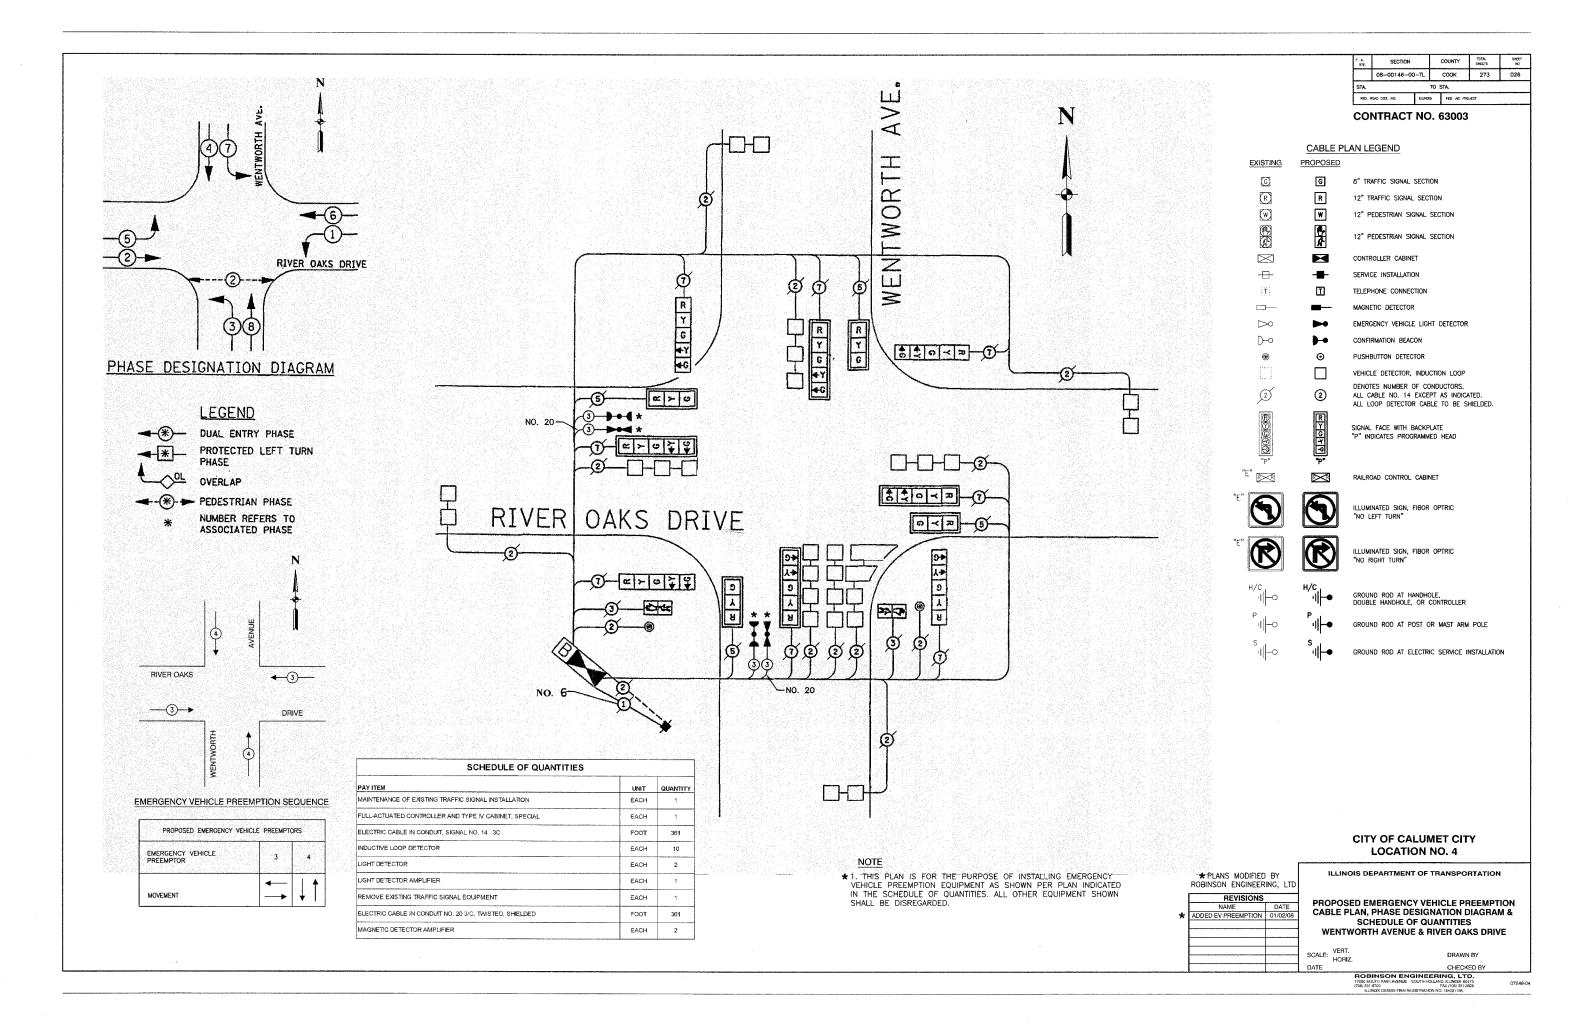


COUNTY TOTAL SHEETS SECTION COOK 273 027 08-00146-00-TL TRAFFIC SIGNAL LEGEND EXISTING PROPOSED KLINGIS FED. AID PROJECT **⊠** CONTROLLER **CONTRACT NO. 63003** SERVICE INSTALLATION SIGNAL HEAD \_> SIGNAL HEAD WITH BACKPLATE  $+\triangleright$ SIGNAL HEAD, PEDESTRIAN --SIGNAL POST 0 MAST ARM ASSEMBLY AND POLE, STEEL 0---MAST ARM ASSEMBLY AND POLE, ALUMINUM 0 COMBINATION MAST ARM ASSEMBLY AND POLE STEEL WITH LUMINAIRE 1 1/2" •×-0-D UD UNIT DUCT 10'-P COMMON TRENCH 1 1/2" HANDHOLE HEAVY DUTY HANDHOLE DOUBLE HANDHOLE  $\square$ G.S. CONDUIT IN GROUND -PEDESTRIAN PUSHBUTTON DETECTOR © | |-. DETECTOR LOOP CAST IRON JUNCTION BOX O "E" -SEE NOTE NO. 2 EMERGENCY VEHICLE SYSTEM DETECTOR • ∞⊲ CONFIRMATION BEACON SIGNAL HEAD OPTICALLY PROGRAMMED —⊳ "P" 40'-T CONDUIT SPLICE 72'-P 2 1/2" 8 ⊗ "E" WOOD POLE RACEWAY FOR MAGNETIC DETECTOR, TYPE I OR TYPE II VEHICLE DETECTOR, NON COMPENSATED MAGNETIC TYPE \_\_\_\_ 23' - CT .£... RAILROAD CONTROL CABINET TELEPHONE CONNECTION **(9**) 9 ILLUMINATED SIGN, FIBER OPTIC "NO LEFT TURN" 0 3'- CT **②** ILLUMINATED SIGN, FIBER OPTIC "NO RIGHT TURN" (2)1 190'-7 1 1/4" 78'-P H 321' 5 WENTHORTH AV 190 50'-T 10'-P 1 1/4" 28'-7 ROW NOTES 25'-7 ★1. THIS PLAN IS FOR THE PURPOSE OF INSTALLING EMERGENCY VEHICLE PREEMPTION EQUIPMENT AS SHOWN PER PLAN INDICATED IN THE SCHEDULE OF QUANTITIES. ALL OTHER EQUIPMENT SHOWN SHALL BE DISREGARDED. 2. EXISTING SIGNAL POST SHALL BE REPLACED WITH NEW 18-FOOT SIGNAL POST ON EXISTING FOUNDATION. RELOCATION OF ANY EXISTING SIGNAL HEADS, PEDESTRIAN SIGNAL HEADS OR PEDESTRIAN PUSHBUTTONS SHALL BE PAID FOR SEPERATELY RELOCATION OF ANY SIGNS BRACKTED 10 THE POST SHALL BE INCIDENTAL. THE LIGHT DETECTOR SHALL BE BRACKET MOUNTED TO THE TOP OF THE NEW POST. THE SALVAGE VALUE OF THE EXISTING POST SHALL BE INCLUDED IN THE PRICE OF THE PAY ITEM. "TRAFFIC SIGNAL POST, GALVANIZED STEEL, 18 FT". 50 - P 3. THE FOLLOWING ITEMS SHALL BE REMOVED BY THE CONTRACTOR AND SHALL BE DISPOSED OF BY THEM OUTSIDE THE RIGHT-OF-WAY AT THEIR EXPENSE. THE SALVAGE VALUE OF THE REMOVED EQUIPMENT SHALL BE REFLECTED IN THE CONTRACTR BID PRICE:

TRAFFIC SIGNAL POST, 16 FT EACH 1 CITY OF CALUMET CITY **LOCATION NO. 5** ILLINOIS DEPARTMENT OF TRANSPORTATION \* PLANS MODIFIED BY ROBINSON ENGINEERING, LTD REVISIONS NAME PROPOSED EMERGENCY VEHICLE PREEMPTION ADDED EV PREEMPTION 01/02/08 WENTWORTH AVENUE & 165TH STREET NEW 18' POST SCALE: VERT. HORIZ. DRAWN BY CHECKED BY DATE

F. A. RIE.	SECTION		COUNTY	TOTAL SHEETS	SHEET NO	
	08~00146~00-TL		соок	273	028	
STA.			TO STA.			
PED. S	ROAD DIST. NO.	ILLINOR	S FED. AID PR	KOJECT		

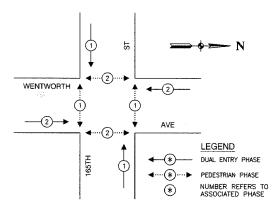


#### PHASE DESIGNATION DIAGRAM

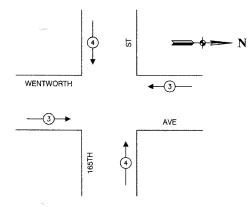

# EMERGENCY VEHICLE PREEMPTION SEQUENCE

PROPOSED EMERGENCY VEHICLE	PREEMPTO	ORS
EMERGENCY VEHICLE PREEMPTOR	3	4
MOVEMENT	<b>←</b>	11

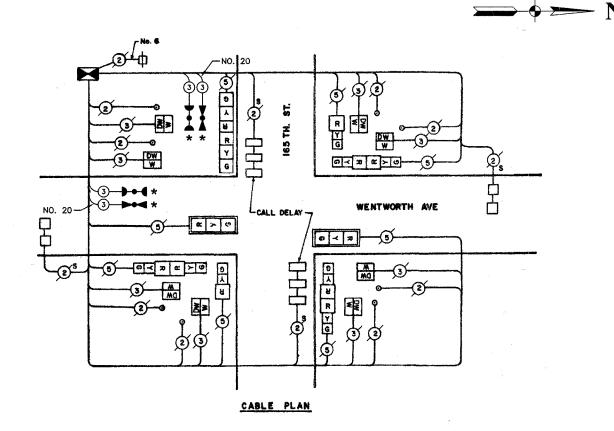

SCHEDULE OF QUANTITIES					
PAYITEM	UNIT	QUANTITY			
MAINTENANCE OF EXISTING TRAFFIC SIGNAL INSTALLATION	EACH	1			
ELECTRIC CABLE IN CONDUIT, SIGNAL NO. 14 3C	FOOT	149			
TRAFFIC SIGNAL POST, GALVANIZED STEEL 18 FT,	EACH	1			
LIGHT DETECTOR	EACH	2			
LIGHT DETECTOR AMPLIFIER	EACH	1			
RELOCATE EXISTING SIGNAL HEAD	EACH	2			
RELOCATE EXISTING PEDESTRIAN SIGNAL HEAD	EACH	1			
RELOCATE EXISTING PEDESTRIAN PUSH-BUTTON	EACH	1			
REMOVE AND REINSTALL ELECTRIC CABLE FROM CONDUIT	FOOT	15			
REMOVE EXISTING TRAFFIC SIGNAL EQUIPMENT	EACH	1			
ELECTRIC CABLE IN CONDUIT NO. 20 3/C, TWISTED, SHIELDED	FOOT	149			

#### NOTE

\*1. THIS PLAN IS FOR THE PURPOSE OF INSTALLING EMERGENCY VEHICLE PREEMPTION EQUIPMENT AS SHOWN PER PLAN INDICATED IN THE SCHEDULE OF QUANTITIES. ALL OTHER EQUIPMENT SHOWN SHALL BE DISREGARDED.

	CABLE PL	AN LEGEND
EXISTING	PROPOSED	
	G	8" TRAFFIC SIGNAL SECTION
R	R	12" TRAFFIC SIGNAL SECTION
W	W	12" PEDESTRIAN SIGNAL SECTION
	<del>\$</del>	12" PEDESTRIAN SIGNAL SECTION
$\bowtie$		CONTROLLER CABINET
-	-	SERVICE INSTALLATION
II	ⅎ	TELEPHONE CONNECTION
		MAGNETIC DETECTOR
$\triangleright$	<b>&gt;</b>	EMERGENCY VEHICLE LIGHT DETECTOR
D0	<b>)-•</b>	CONFIRMATION BEACON
•	⊙	PUSHBUTTON DETECTOR
		VEHICLE DETECTOR, INDUCTION LOOP
2	2	DENOTES NUMBER OF CONDUCTORS. ALL CABLE NO. 14 EXCEPT AS INDICATED. ALL LOOP DETECTOR CABLE TO BE SHIELDED.
*p*	*P*	SIGNAL FACE WITH BACKPLATE "P" INDICATES PROGRAMMED HEAD
"E"	$\bowtie$	RAILROAD CONTROL CABINET
"E"	9	ILLUMINATED SIGN, FIBOR OPTRIC "NO LEFT TURN"
"E"	<b>®</b>	ILLUMINATED SIGN, FIBOR OPTRIC "NO RIGHT TURN"
H/C -  -0	H/C -  -	GROUND ROD AT HANDHOLE, DOUBLE HANDHOLE, OR CONTROLLER
P 11 0	P-11 -	GROUND ROD AT POST OR MAST ARM POLE
s   -0	s III	GROUND ROD AT ELECTRIC SERVICE INSTALLATION

### CITY OF CALUMET CITY LOCATION NO. 5

\* PLANS MODIFIED BY ROBINSON ENGINEERING, LTD REVISIONS

\* ADDED EV PREEMPTION 01/02/08
NEW 18' POST

ILLINOIS DEPARTMENT OF TRANSPORTATION


PROPOSED EMERGENCY VEHICLE PREEMPTION CABLE PLAN, PHASE DESIGNATION DIAGRAM & SCHEDULE OF QUANTITIES WENTWORTH AVENUE & 165TH STREET

SCALE: VERT. HORIZ.


DRAWN BY CHECKED BY

ROBINSON ENGINEERING, LTD.
17000 SOUTH PARK AVENUE SOUTH HOLLAND, ILLINGE SOUTH
7000 301-3270 PARK AVENUE SOUTH HOLLAND, ILLINGE SOUTH
844 (7000 301-3400)


07040

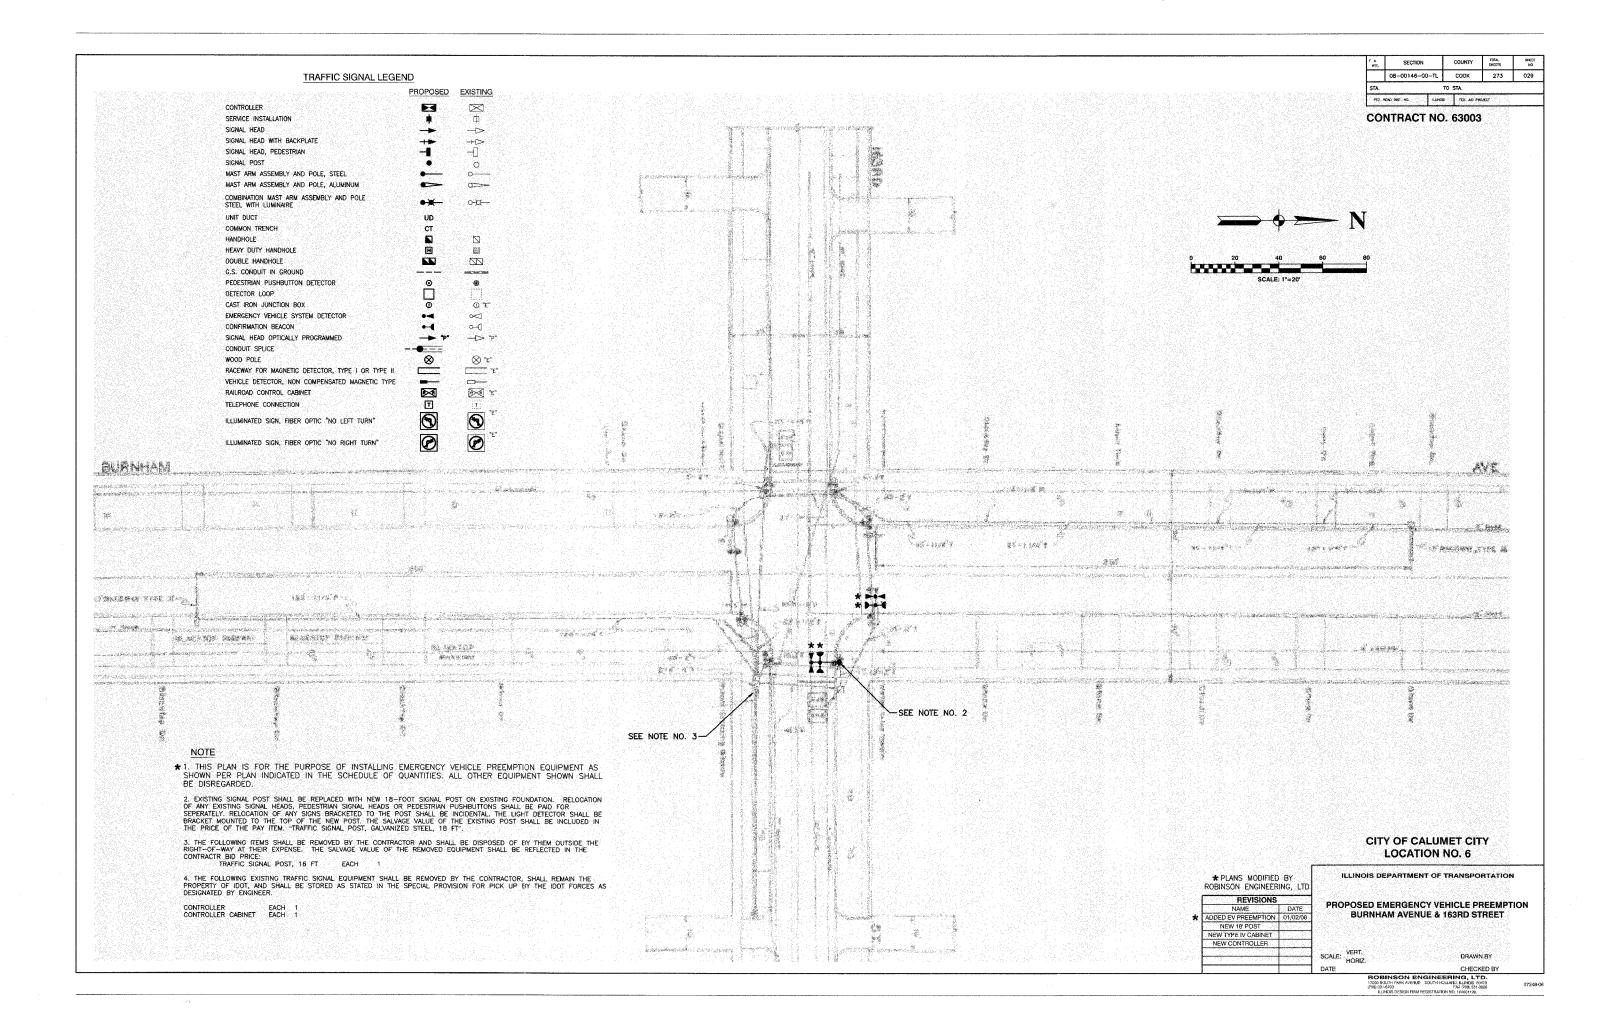

F. A. RTE.	SECTION		COUNTY	TOTAL SHEETS	SHEET
	08-00146-00-	-TL	COOK	273	030
STA.		TC	STA.		
FED. F	ROAD DIST. NO.	ILUNOIS	PED, AVD PRI	DUECT	

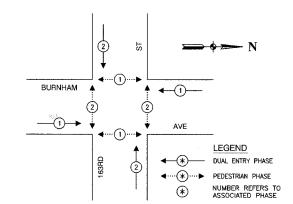


#### PHASE DESIGNATION DIAGRAM

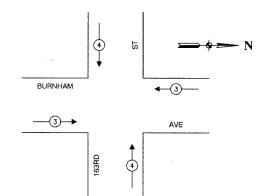

#### EMERGENCY VEHICLE PREEMPTION SEQUENCE

PROPOSED EMERGENCY VEHIC	LE PREEMPTO	ORS
EMERGENCY VEHICLE PREEMPTOR	3	4
MOVEMENT	<del></del>	↓ 1

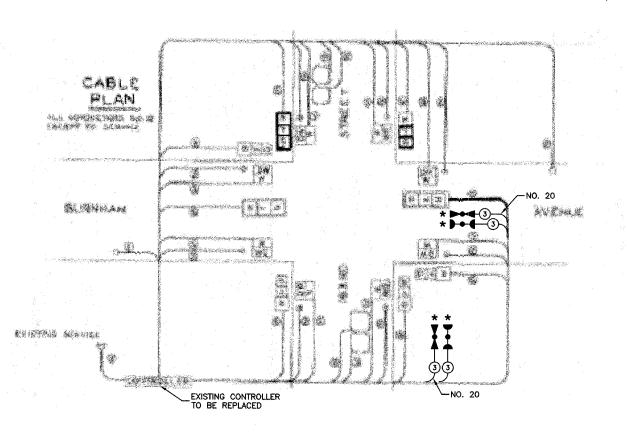

PAYITEM	UNIT	QUANTITY
ENGINEER'S FIELD OFFICE, TYPE A	CAL MO	0.1
TRAFFIC CONTROL AND PROTECTION, STANDARD 701701	LSUM	1
MAINTENANCE OF EXISTING TRAFFIC SIGNAL INSTALLATION	EACH	1
FULL-ACTUATED CONTROLLER AND TYPE IV CABINET, SPECIAL	EAGH	1
ELECTRIC CABLE IN CONDUIT, SIGNAL NO. 14 30	FOOT	236
TRAFFIC SIGNAL POST, GALVANIZED STEEL 18 FT.	EACH	1
NDUCTIVE LOOP DETECTOR	EACH	4
LIGHT DETECTOR	EACH	2
LIGHT DETECTOR AMPLIFIER	EACH	1.
RELOCATE EXISTING SIGNAL HEAD	EACH	1.
RELOCATE EXISTING PEDESTRIAN SIGNAL HEAD	EACH	1.
RELOCATE EXISTING PEDESTRIAN PUSH-BUTTON	EACH	1
REMOVE AND REINSTALL ELECTRIC CABLE FROM CONDUIT	FOOT	15
REMOVE EXISTING TRAFFIC SIGNAL EQUIPMENT	EACH	1
ELECTRIC CABLE IN CONDUIT NO. 20 3/C, TWISTED, SHIELDED	FOOT	236
MODIFY EXISTING TYPE "D" FOUNDATION	EACH	1
MAGNETIC DETECTOR AMPLIFIER	EACH	2

SCHEDULE OF QUANTITIES

# CABLE PLAN LEGEND

	CABLE PL	AN LEGEND
EXISTING	PROPOSED	
<b>©</b>	G	8" TRAFFIC SIGNAL SECTION
R	R	12" TRAFFIC SIGNAL SECTION
(w)	W	12" PEDESTRIAN SIGNAL SECTION
	g.	12" PEDESTRIAN SIGNAL SECTION
$\bowtie$		CONTROLLER CABINET
-	-	SERVICE INSTALLATION
iï.	Ŧ	TELEPHONE CONNECTION
<u> </u>		MAGNETIC DETECTOR
$\triangleright \!$	<b>&gt;</b>	EMERGENCY VEHICLE LIGHT DETECTOR
D-0	<b>)-•</b>	CONFIRMATION BEACON
•	•	PUSHBUTTON DETECTOR
		VEHICLE DETECTOR, INDUCTION LOOP
2	2	DENOTES NUMBER OF CONDUCTORS. ALL CABLE NO. 14 EXCEPT AS INDICATED. ALL LOOP DETECTOR CABLE TO BE SHIELDED.
"P"	R>04₹₽	SIGNAL FACE WITH BACKPLATE "P" INDICATES PROGRAMMED HEAD
"E" 🔀	$\bowtie$	RAILROAD CONTROL CABINET
"E"	9	ILLUMINATED SIGN, FIBOR OPTRIC "NO LEFT TURN"
"E"	<b>R</b>	ILLUMINATED SIGN, FIBOR OPTRIC "NO RIGHT TURN"
H/C 1 -0	H/C -   <b> </b> -	GROUND ROD AT HANDHOLE, DOUBLE HANDHOLE, OR CONTROLLER

\*1. THIS PLAN IS FOR THE PURPOSE OF INSTALLING EMERGENCY VEHICLE PREEMPTION EQUIPMENT AS SHOWN PER PLAN INDICATED IN THE SCHEDULE OF QUANTITIES. ALL OTHER EQUIPMENT SHOWN SHALL BE DISREGARDED.

### CITY OF CALUMET CITY **LOCATION NO. 6**

GROUND ROD AT POST OR MAST ARM POLE


GROUND ROD AT ELECTRIC SERVICE INSTALLATION

	RUBINSUN ENGINEER	ING, LID	
	REVISIONS	DDAD	
	NAME	DATE	PROP
*	ADDED EV PREEMPTION	01/02/08	CABLI
	NEW 18' POST		
	NEW TYPE IV CABINET		
	NEW CONTROLLER		
			SCALE: H
			DATE

\* PLANS MODIFIED BY

ILLINOIS DEPARTMENT OF TRANSPORTATION

DPOSED EMERGENCY VEHICLE PREEMPTION BLE PLAN, PHASE DESIGNATION DIAGRAM & SCHEDULE OF QUANTITIES BURNHAM AVENUE & 163RD STREET

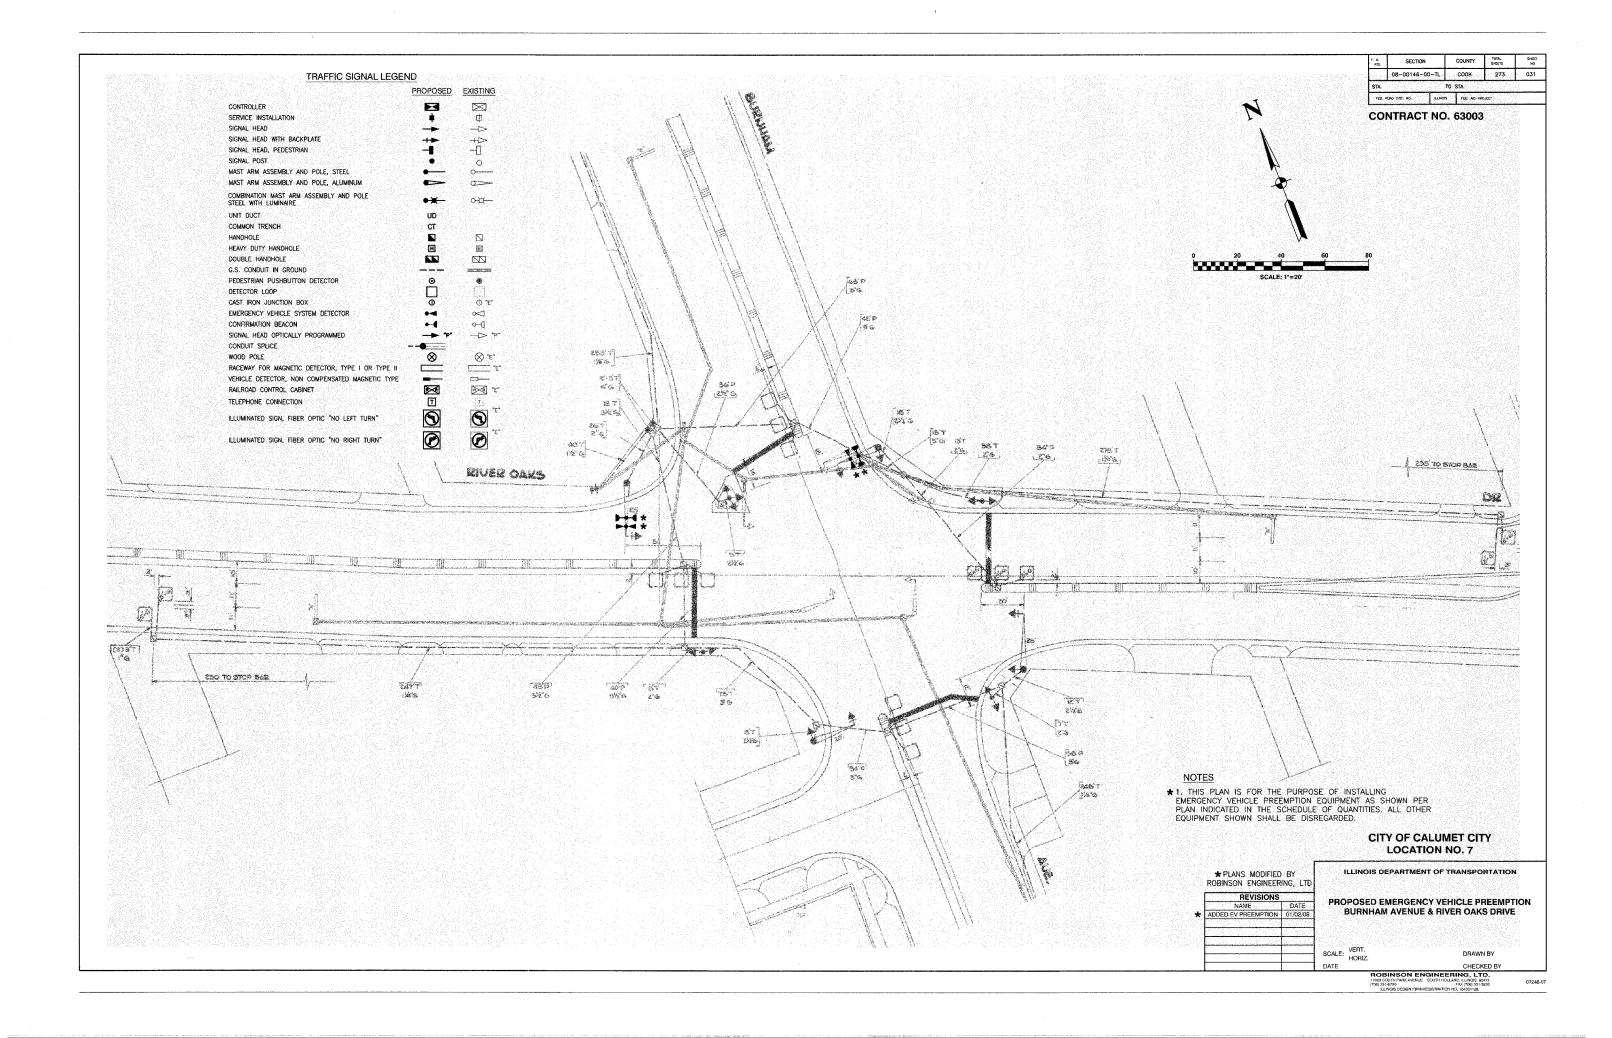





EXISTING PROPOSED W

0

R

W

 $\boxtimes$ 

-

\_\_

 $\triangleright$ 0

D--0

**(9)** 

2

<u>्</u>

8" TRAFFIC SIGNAL SECTION 12" TRAFFIC SIGNAL SECTION 12" PEDESTRIAN SIGNAL SECTION

12" PEDESTRIAN SIGNAL SECTION

lacksquareCONTROLLER CABINET SERVICE INSTALLATION

TELEPHONE CONNECTION MAGNETIC DETECTOR

EMERGENCY VEHICLE LIGHT DETECTOR CONFIRMATION BEACON

⊙ PUSHBUTTON DETECTOR VEHICLE DETECTOR, INDUCTION LOOP DENOTES NUMBER OF CONDUCTORS.

ALL CABLE NO. 14 EXCEPT AS INDICATED.
ALL LOOP DETECTOR CABLE TO BE SHIELDED. SIGNAL FACE WITH BACKPLATE

"P" INDICATES PROGRAMMED HEAD

"E" <u>▶</u>  $\bowtie$ 

ILLUMINATED SIGN, FIBOR OPTRIC "NO LEFT TURN"

RAILROAD CONTROL CABINET


ILLUMINATED SIGN, FIBOR OPTRIC

GROUND ROD AT HANDHOLE, DOUBLE HANDHOLE, OR CONTROLLER

111-0

GROUND ROD AT POST OR MAST ARM POLE

GROUND ROD AT ELECTRIC SERVICE INSTALLATION

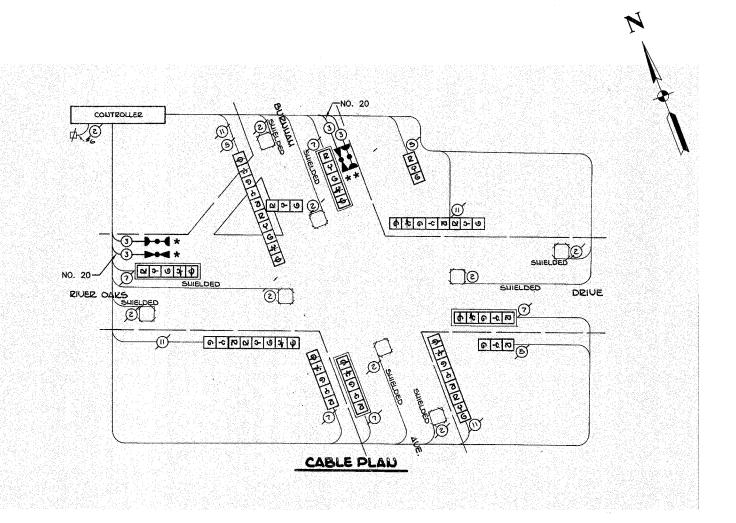

SCHEDULE OF QUANTITIES				
PAYITEM	UNIT	QUANTITY		
MAINTENANCE OF EXISTING TRAFFIC SIGNAL INSTALLATION	EACH	1		
ELECTRIC CABLE IN CONDUIT, SIGNAL NO. 14 3C	FOOT	316		
LIGHT DETECTOR	EACH	2		
LIGHT DETECTOR AMPLIFIER	EACH	1		
ELECTRIC CABLE IN CONDUIT NO. 20 3/C, TWISTED, SHIELDED	FOOT	316		

RIVER OAKS

**—\_\_\_**4**→** 

**€**--(8)---

\*

PHASE DESIGNATION DIAGRAM

3

**EMERGENCY VEHICLE PREEMPTION SEQUENCE** 

PROPOSED EMERGENCY VEHICLE PREEMPTORS

4-

MOVEMENT

LEGEND

NUMBER REFERS TO ASSOCIATED PHASE

◆····\* PEDESTRIAN PHASE

\*1. THIS PLAN IS FOR THE PURPOSE OF INSTALLING EMERGENCY VEHICLE PREEMPTION EQUIPMENT AS SHOWN PER PLAN INDICATED IN THE SCHEDULE OF QUANTITIES. ALL OTHER EQUIPMENT SHOWN SHALL BE DISREGARDED.

#### CITY OF CALUMET CITY **LOCATION NO. 7**

\* PLANS MODIFIED BY ROBINSON ENGINEERING, LTD REVISIONS SCALE: VERT. HORIZ.

ILLINOIS DEPARTMENT OF TRANSPORTATION

PROPOSED EMERGENCY VEHICLE PREEMPTION CABLE PLAN, PHASE DESIGNATION DIAGRAM & SCHEDULE OF QUANTITIES **BURNHAM AVENUE & RIVER OAKS DRIVE** 

CHECKED BY

SECTION TRAFFIC SIGNAL LEGEND PROPOSED EXISTING **⊠** Φ CONTROLLER  $\blacksquare$ SERVICE INSTALLATION CONTRACT NO. 63003 SIGNAL HEAD + SIGNAL HEAD WITH BACKPLATE SIGNAL HEAD, PEDESTRIAN SIGNAL POST 0 MAST ARM ASSEMBLY AND POLE, STEEL MAST ARM ASSEMBLY AND POLE, ALUMINUM 0 COMBINATION MAST ARM ASSEMBLY AND POLE STEEL WITH LUMINAIRE •\* 0-X-UNIT DUCT UD COMMON TRENCH CT HANDHOLE HEAVY DUTY HANDHOLE ▣ DOUBLE HANDHOLE G.S. CONDUIT IN GROUND PEDESTRIAN PUSHBUTTON DETECTOR DETECTOR LOOP CAST IRON JUNCTION BOX ① "E" EMERGENCY VEHICLE SYSTEM DETECTOR 0<1 CONFIRMATION BEACON 0-(1 SIGNAL HEAD OPTICALLY PROGRAMMED ---(> "P" CONDUIT SPLICE 8 ⊗ "E" WOOD POLE RACEWAY FOR MAGNETIC DETECTOR, TYPE I OR TYPE II 24'- CT <u>-</u> VEHICLE DETECTOR, NON COMPENSATED MAGNETIC TYPE \_\_\_ 2 V2 RAILROAD CONTROL CABINET **₽** "E" TELEPHONE CONNECTION Ŧ **9 (9)** ILLUMINATED SIGN, FIBER OPTIC "NO LEFT TURN" **@** 0 -23:T ILLUMINATED SIGN, FIBER OPTIC "NO RIGHT TURN" 216'-7 3'-CT (2) (\* CALL DELA: BURNHAM AVE SEE NOTE NO. 2-3 V2" 113-1 20'-1 / 12'-P NOTES (2) 1" 1 1/4" 1 1/4" 2 1/2" 2\* \*1. THIS PLAN IS FOR THE PURPOSE OF INSTALLING EMERGENCY VEHICLE PREEMPTION EQUIPMENT AS SHOWN PER PLAN INDICATED IN THE SCHEDULE OF QUANTITIES. ALL OTHER EQUIPMENT SHOWN SHALL BE DISREGARDED. 3'- CT\_ (214' 59- 8 2. EXISTING SIGNAL POST SHALL BE REPLACED WITH NEW 18—FOOT SIGNAL POST ON EXISTING FOUNDATION. RELOCATION OF ANY EXISTING SIGNAL HEADS, PEDESTRIAN SIGNAL HEADS OR PEDESTRIAN PUSHBUTTONS SHALL BE PAID FOR SPERATELY RELOCATION OF ANY SIGNS BRACKETED TO THE POST SHALL BE INCIDENTAL. THE LIGHT DETECTOR SHALL BE BRACKET MOUNTED TO THE TOP OF THE NEW POST. THE SALVAGE VALUE OF THE EXISTING POST SHALL BE INCLUDED IN THE PRICE OF THE PAY ITEM. "TRAFFIC SIGNAL POST, GALVANIZED STEEL, 18 FT". 3. THE FOLLOWING ITEMS SHALL BE REMOVED BY THE CONTRACTOR AND SHALL BE DISPOSED OF BY THEM OUTSIDE THE RIGHT-OF-WAY AT THEIR EXPENSE. THE SALVAGE VALUE OF THE REMOVED EQUIPMENT SHALL BE REFLECTED IN THE CONTRACTIR BID PRICE:

TRAFFIC SIGNAL POST, 16 FT EACH 1 CITY OF CALUMET CITY **LOCATION NO. 8** ILLINOIS DEPARTMENT OF TRANSPORTATION ★ PLANS MODIFIED BY ROBINSON ENGINEERING, LTD

CHECKED BY

SCALE: VERT. HORIZ.

NEW 18' POST

PROPOSED EMERGENCY VEHICLE PREEMPTION **BURNHAM AVENUE & 156TH STREET** 

DRAWN BY


COUNTY TOTAL SHEETS

TO STA.

C00K 273

F. A. RTE.	SECTION		COUNTY	TOTAL SHEETS	SHIDET NO
	08-00146-00	-TL	COOK	273	034
STA.		1	TO STA.		
FED. ROAD DIST. NO.   ELINGS			FED. AID PR	OJECT	

### CABLE PLAN LEGEND

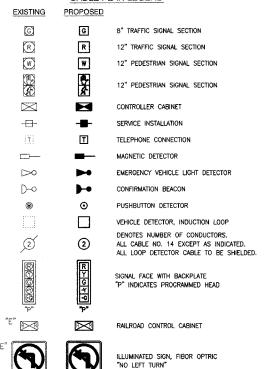





ILLUMINATED SIGN, FIBOR OPTRIC "NO RIGHT TURN"





GROUND ROD AT HANDHOLE, DOUBLE HANDHOLE, OR CONTROLLER






GROUND ROD AT POST OR MAST ARM POLE



GROUND ROD AT ELECTRIC SERVICE INSTALLATION

# CONTROLLER SEQUENCE IV

REFERRING TO STANDARD 2393-1, THE VEHICULAR AND PEDESTRIAN PHASES USED ARE DESIGNATED BELOW.

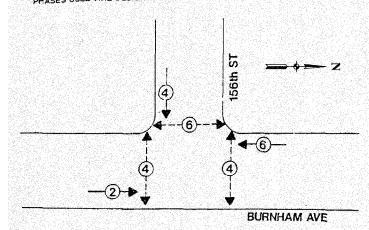


# LEGEND

\* VEHICULAR MOVEMENT 


\* NUMBER REFERS TO ASSOCIATED PHASE

# PHASE DESIGNATION DIAGRAM

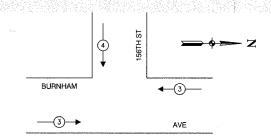

## **EMERGENCY VEHICLE PREEMPTION SEQUENCE**

PROPOSED EMERGENCY VEHICLE	PREEMPTO	ORS
EMERGENCY VEHICLE PREEMPTOR	3	4
MOVEMENT	<b>←</b>	<b>\</b>

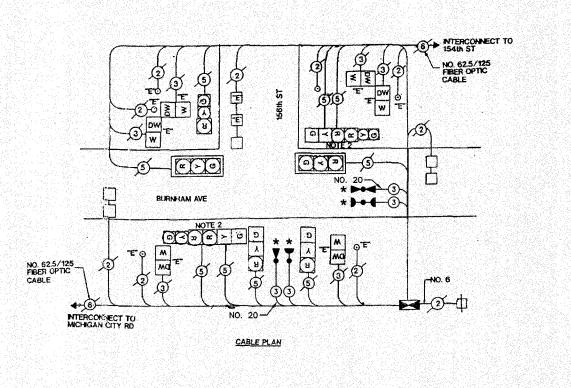


SCHEDULE OF QUANTITIES					
PAYITEM	UNIT	QUANTITY			
MAINTENANCE OF EXISTING TRAFFIC SIGNAL INSTALLATION	EACH	1			
ELECTRIC CABLE IN CONDUIT, SIGNAL NO. 14 3C	FOOT	216			
TRAFFIC SIGNAL POST, GALVANIZED STEEL 18 FT.	EACH	1			
LIGHT DETECTOR	EACH	2			
LIGHT DETECTOR AMPLIFIER	EACH	1			
RELOCATE EXISTING SIGNAL HEAD	EACH	1			
REMOVE AND REINSTALL ELECTRIC CABLE FROM CONDUIT	FOOT	15			
REMOVE EXISTING TRAFFIC SIGNAL EQUIPMENT	EACH	1			
ELECTRIC CABLE IN CONDUIT NO. 20 3/C, TWISTED, SHIELDED	FOOT	216			

\* 1. THIS PLAN IS FOR THE PURPOSE OF INSTALLING EMERGENCY VEHICLE PREEMPTION EQUIPMENT AS SHOWN PER PLAN INDICATED IN THE SCHEDULE OF QUANTITIES. ALL OTHER EQUIPMENT SHOWN SHALL BE DISREGARDED.

#### CITY OF CALUMET CITY **LOCATION NO. 8**


\* PLANS MODIFIED BY ILLINOIS DEPARTMENT OF TRANSPORTATION ROBINSON ENGINEERING, LTD PROPOSED EMERGENCY VEHICLE PREEMPTION CABLE PLAN, PHASE DESIGNATION DIAGRAM & 
 NAME
 DATE

 ★ ADDED EV PREEMPTION
 01/02/08
 SCHEDULE OF QUANTITIES NEW 18' POST **BURNHAM AVENUE & 156TH STREET** SCALE: VERT. HORIZ. DRAWN BY

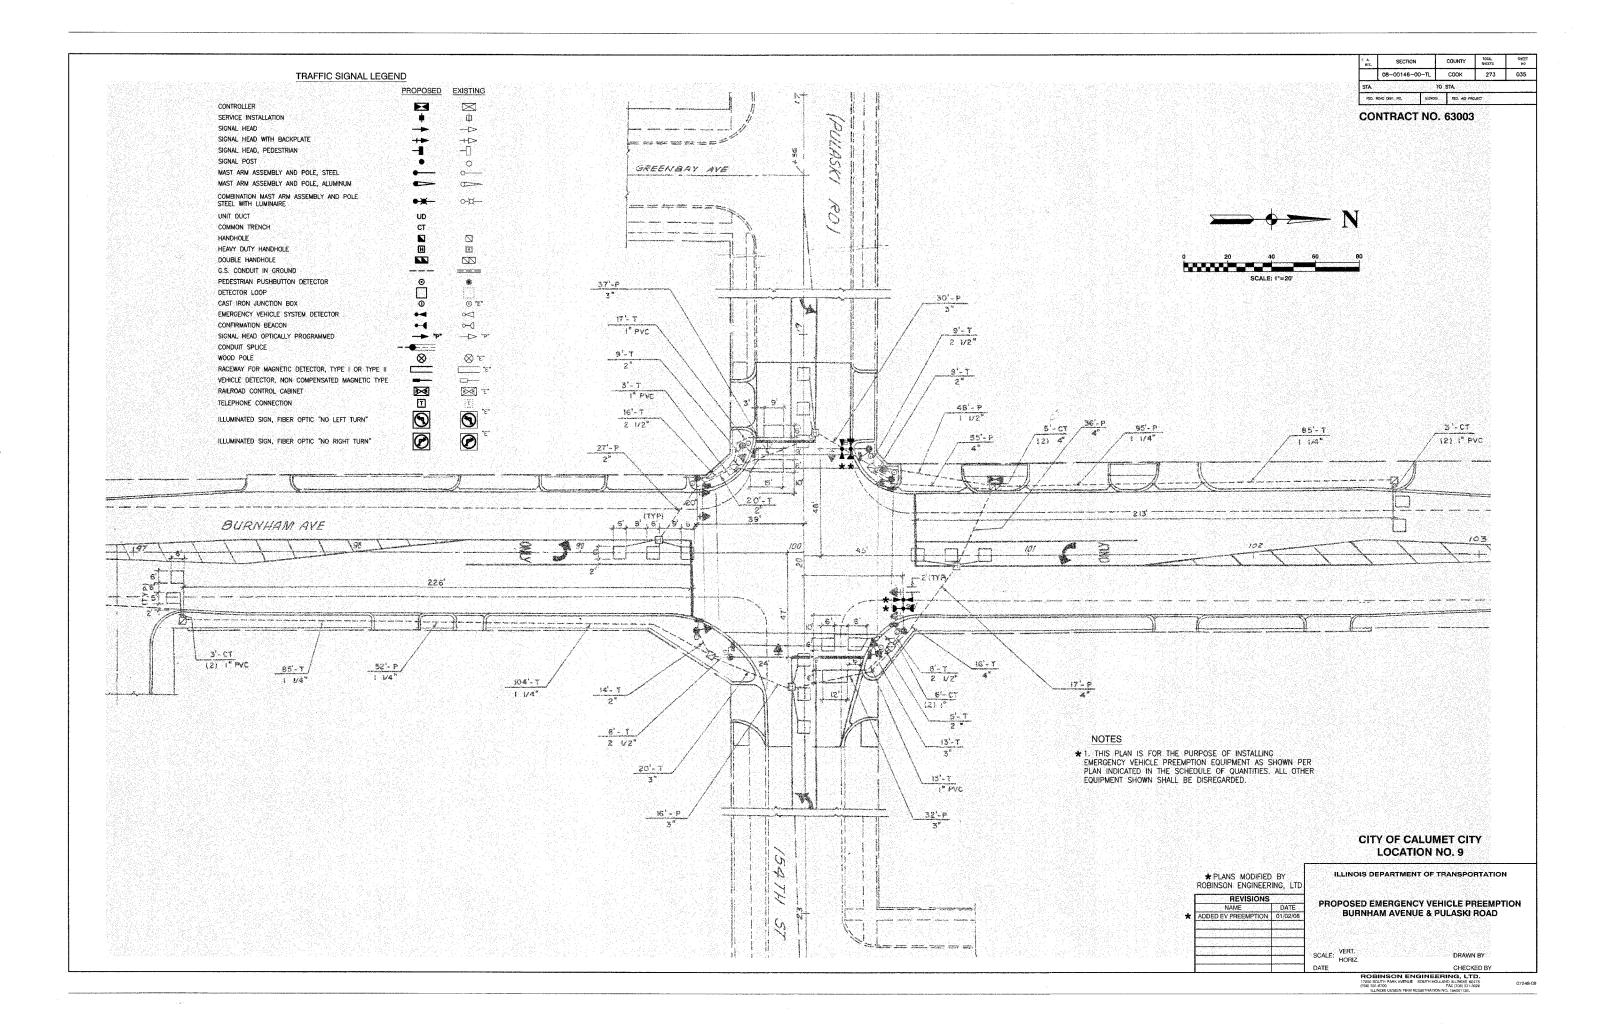


# CONTROLLER SEQUENCE IX

REFERRING TO STANDARD 2393, THE VEHICULAR AND PEDESTRIAN PHASES USED ARE DESIGNATED BELOW.

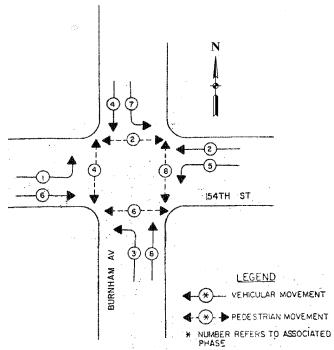


# PHASE DESIGNATION DIAGRAM

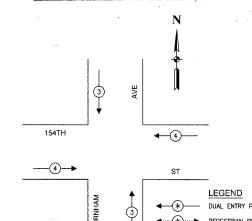

#### EMERGENCY VEHICLE PREEMPTION SEQUENCE

PROPOSED EMERGENCY VEHICLE PREEMPTORS					
EMERGENCY VEHICLE PREEMPTOR	3	4			
MOVEMENT	<b>↑</b> ↓	<b>→</b>			

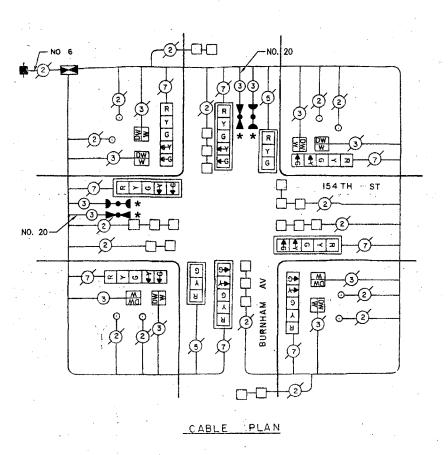

SCHEDULE OF QUANTITIES				
PAYITEM	UNIT	QUANTITY		
MAINTENANCE OF EXISTING TRAFFIC SIGNAL INSTALLATION	EACH	1		
ELECTRIC CABLE IN CONDUIT, SIGNAL NO. 14 3C	FOOT	275		
LIGHT DETECTOR	EACH	2		
LIGHT DETECTOR AMPLIFIER	EACH	1		
ELECTRIC CABLE IN CONDUIT NO. 20 3/C, TWISTED, SHIELDED	FOOT	275		

★ 1. THIS PLAN IS FOR THE PURPOSE OF INSTALLING EMERGENCY VEHICLE PREEMPTION EQUIPMENT AS SHOWN PER PLAN INDICATED IN THE SCHEDULE OF QUANTITIES. ALL OTHER EQUIPMENT SHOWN SHALL BE DISREGARDED.

F. A. HTE.	SECTION		COUNTY	TOTAL SHEETS	SHEET
	08-00146-00	-TL	соок	273	036
STA. TO STA.					
FED. ROAD DIST, NO. ILLINO		S FEG. AID PI	ROJECT		

#### CONTRACT NO. 63003

CABLE	PLAN	LEGEND

EXISTING PROPOSED G R R W  $\boxtimes$ 

(C)

W

 $\Box$ 

Ĭ.

\_\_

 $\triangleright$ 

D-0

Ø

8" TRAFFIC SIGNAL SECTION 12" TRAFFIC SIGNAL SECTION

12" PEDESTRIAN SIGNAL SECTION

12" PEDESTRIAN SIGNAL SECTION

CONTROLLER CABINET

SERVICE INSTALLATION Ī TELEPHONE CONNECTION

MAGNETIC DETECTOR

EMERGENCY VEHICLE LIGHT DETECTOR CONFIRMATION BEACON

VEHICLE DETECTOR, INDUCTION LOOP DENOTES NUMBER OF CONDUCTORS. ALL CABLE NO. 14 EXCEPT AS INDICATED.
ALL LOOP DETECTOR CABLE TO BE SHIELDED.

SIGNAL FACE WITH BACKPLATE "P" INDICATES PROGRAMMED HEAD

"E"

 $\bowtie$ 

ILLUMINATED SIGN, FIBOR OPTRIC "NO LEFT TURN"

RAILROAD CONTROL CABINET

ILLUMINATED SIGN, FIBOR OPTRIC "NO RIGHT TURN"

H/C -||**├**-0

GROUND ROD AT HANDHOLE, DOUBLE HANDHOLE, OR CONTROLLER

GROUND ROD AT ELECTRIC SERVICE INSTALLATION

#### CITY OF CALUMET CITY **LOCATION NO. 9**


\* PLANS MODIFIED BY ROBINSON ENGINEERING, LTD ADDED EV PREEMPTION 01/02/08

ILLINOIS DEPARTMENT OF TRANSPORTATION

PROPOSED EMERGENCY VEHICLE PREEMPTION CABLE PLAN, PHASE DESIGNATION DIAGRAM & SCHEDULE OF QUANTITIES BURNHAM AVENUE & PULASKI ROAD

CHECKED BY


ROBINSON ENGINEERING, LTD.
17000 SOUTH PARK AVENUE SOUTH HOLLAND, LILINOIS 80427
(708) 33+570 FAX (706) 331-3026
ILLINOIS DESIGN FIRM REGISTRATION NO. 184001128.

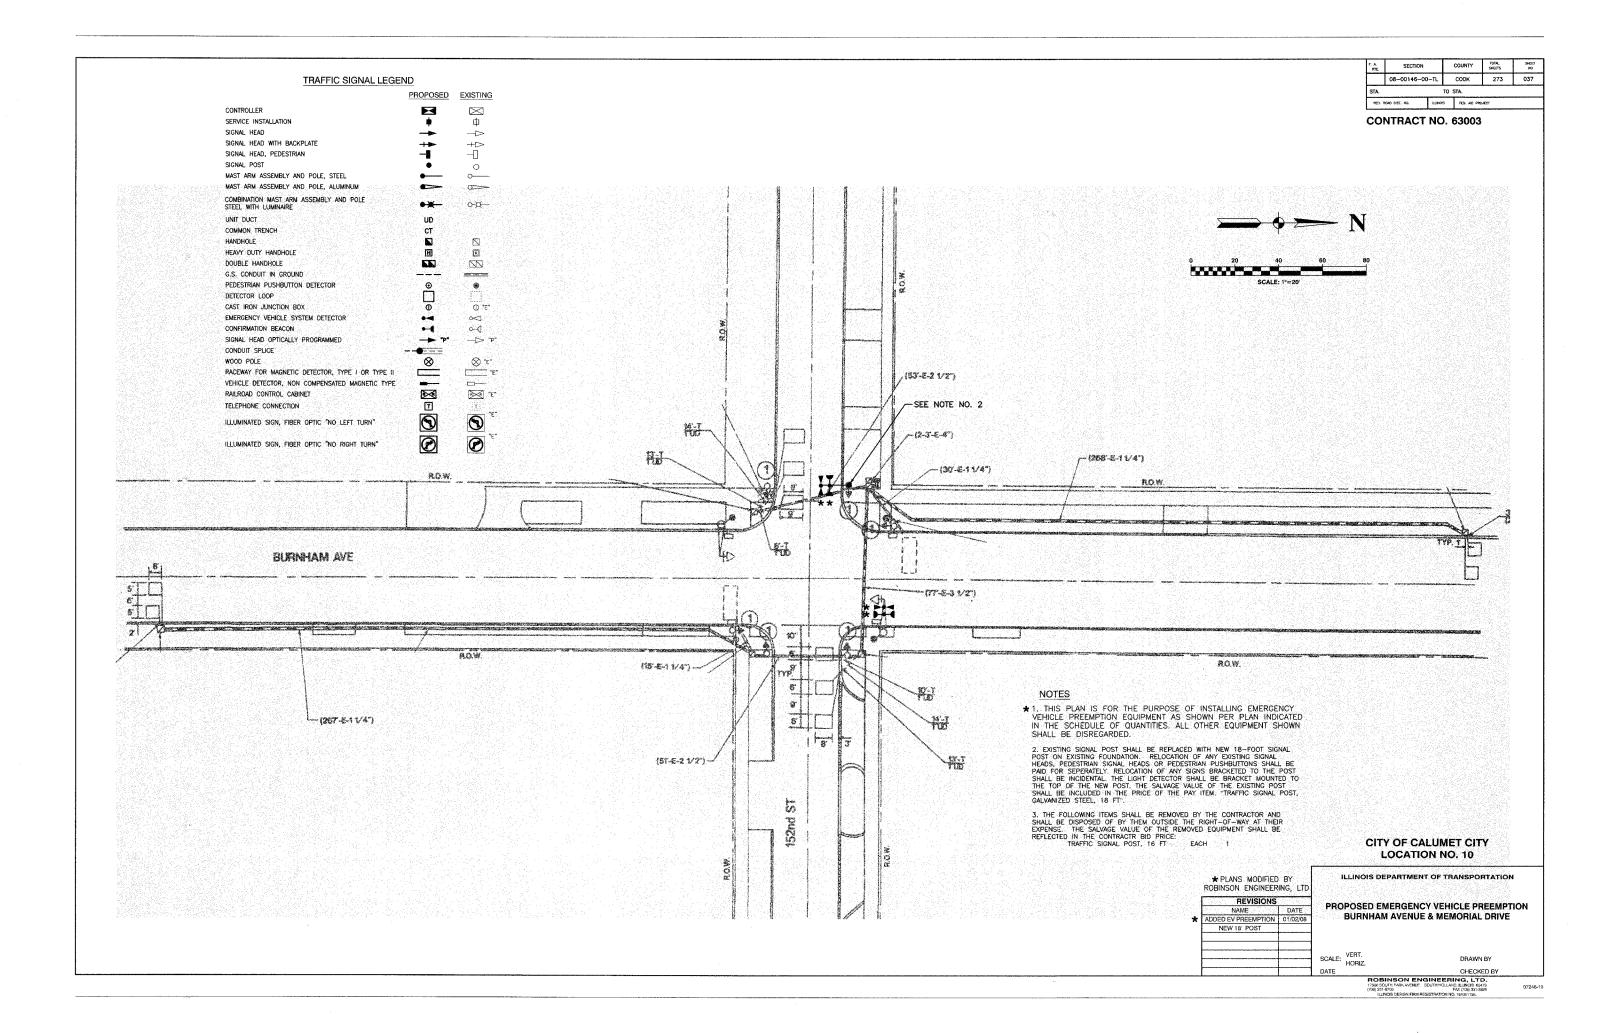


F. A. RTE.	SECTION		COUNTY	TOTAL SHEETS	SHEET
	08-00146-00-	-TL	COOK	273	038
STA.		T	STA.		
FED. 1	ROAD DIST. NO.	LUNCIS	FED. AID PR	OVECT	

#### **CONTRACT NO. 63003**

# CONTROLLER SEQUENCE IV REFERRING TO STANDARD 2393-1, THE VEHICULAR AND PEDESTRIAN

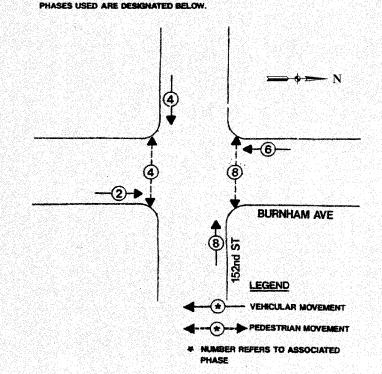


#### **PHASE DESIGNATION DIAGRAM**

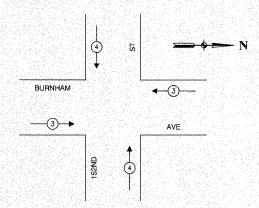

#### EMERGENCY VEHICLE PREEMPTION SEQUENCE

PROPOSED EMERGENCY VEHICLE	PREEMPTO	ORS
EMERGENCY VEHICLE PREEMPTOR	-3	4
	-	•
MOVEMENT	<b> </b> →	↓

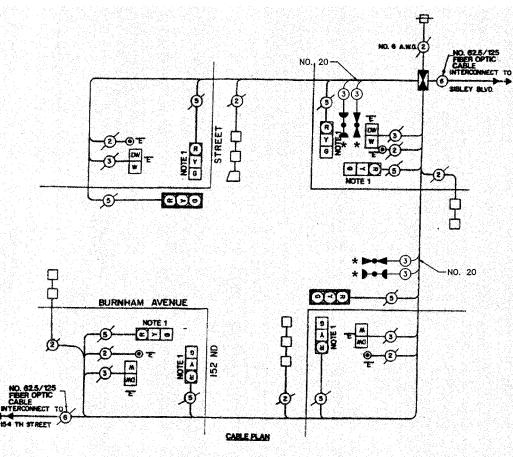

SCHEDULE OF QUANTITIES									
PAY ITEM	UNIT	QUANTITY							
MAINTENANCE OF EXISTING TRAFFIC SIGNAL INSTALLATION	EACH	1							
ELECTRIC CABLE IN CONDUIT, SIGNAL NO. 14 3C	FOOT	219							
TRAFFIC SIGNAL POST, GALVANIZED STEEL 18 FT.	EACH	1							
LIGHT DETECTOR	EACH	2							
LIGHT DETECTOR AMPLIFIER	EACH	1							
RELOCATE EXISTING SIGNAL HEAD	EACH	1							
REMOVE AND REINSTALL ELECTRIC CABLE FROM CONDUIT	FOOT	15							
REMOVE EXISTING TRAFFIC SIGNAL EQUIPMENT	EACH	1							
ELECTRIC CABLE IN CONDUIT NO. 20 3/C, TWISTED, SHIELDED	FOOT	219							

★ 1. THIS PLAN IS FOR THE PURPOSE OF INSTALLING EMERGENCY VEHICLE PREEMPTION EQUIPMENT AS SHOWN PER PLAN INDICATED IN THE SCHEDULE OF QUANTITIES. ALL OTHER EQUIPMENT SHOWN SHALL BE DISREGARDED.

# CABLE PLAN LEGEND

	CAPLETE	ANT LEGEND
EXISTING	PROPOSED	
0	G	8" TRAFFIC SIGNAL SECTION
R	R	12" TRAFFIC SIGNAL SECTION
W	W	12" PEDESTRIAN SIGNAL SECTION
	<u>A</u>	12" PEDESTRIAN SIGNAL SECTION
$\bowtie$		CONTROLLER CABINET
<del>-</del> D-		SERVICE INSTALLATION
iti	T	TELEPHONE CONNECTION
	-	MAGNETIC DETECTOR
⊳	▶•	EMERGENCY VEHICLE LIGHT DETECT

TELEPHONE CONNECTION MAGNETIC DETECTOR EMERGENCY VEHICLE LIGHT DETECTOR

CONFIRMATION BEACON PUSHBUTTON DETECTOR

VEHICLE DETECTOR, INDUCTION LOOP DENOTES NUMBER OF CONDUCTORS.
ALL CABLE NO. 14 EXCEPT AS INDICATED.
ALL LOOP DETECTOR CABLE TO BE SHIELDED.

SIGNAL FACE WITH BACKPLATE
"P" INDICATES PROGRAMMED HEAD



D⊸o

Ø

-¢. (COOCA)

"E"

 $\bowtie$ 

ILLUMINATED SIGN, FIBOR OPTRIC "NO LEFT TURN"

RAILROAD CONTROL CABINET



ILLUMINATED SIGN, FIBOR OPTRIC "NO RIGHT TURN"



GROUND ROD AT HANDHOLE, DOUBLE HANDHOLE, OR CONTROLLER



GROUND ROD AT POST OR MAST ARM POLE



GROUND ROD AT ELECTRIC SERVICE INSTALLATION

### CITY OF CALUMET CITY **LOCATION NO. 10**


\* PLANS MODIFIED BY ROBINSON ENGINEERING, LTD


NEW 18' POST


ILLINOIS DEPARTMENT OF TRANSPORTATION


PROPOSED EMERGENCY VEHICLE PREEMPTION CABLE PLAN, PHASE DESIGNATION DIAGRAM & ★ ADDED EV PREEMPTION 01/02/08 SCHEDULE OF QUANTITIES BURNHAM AVENUE & MEMORIAL DRIVE


SCALE: VERT. HORIZ.

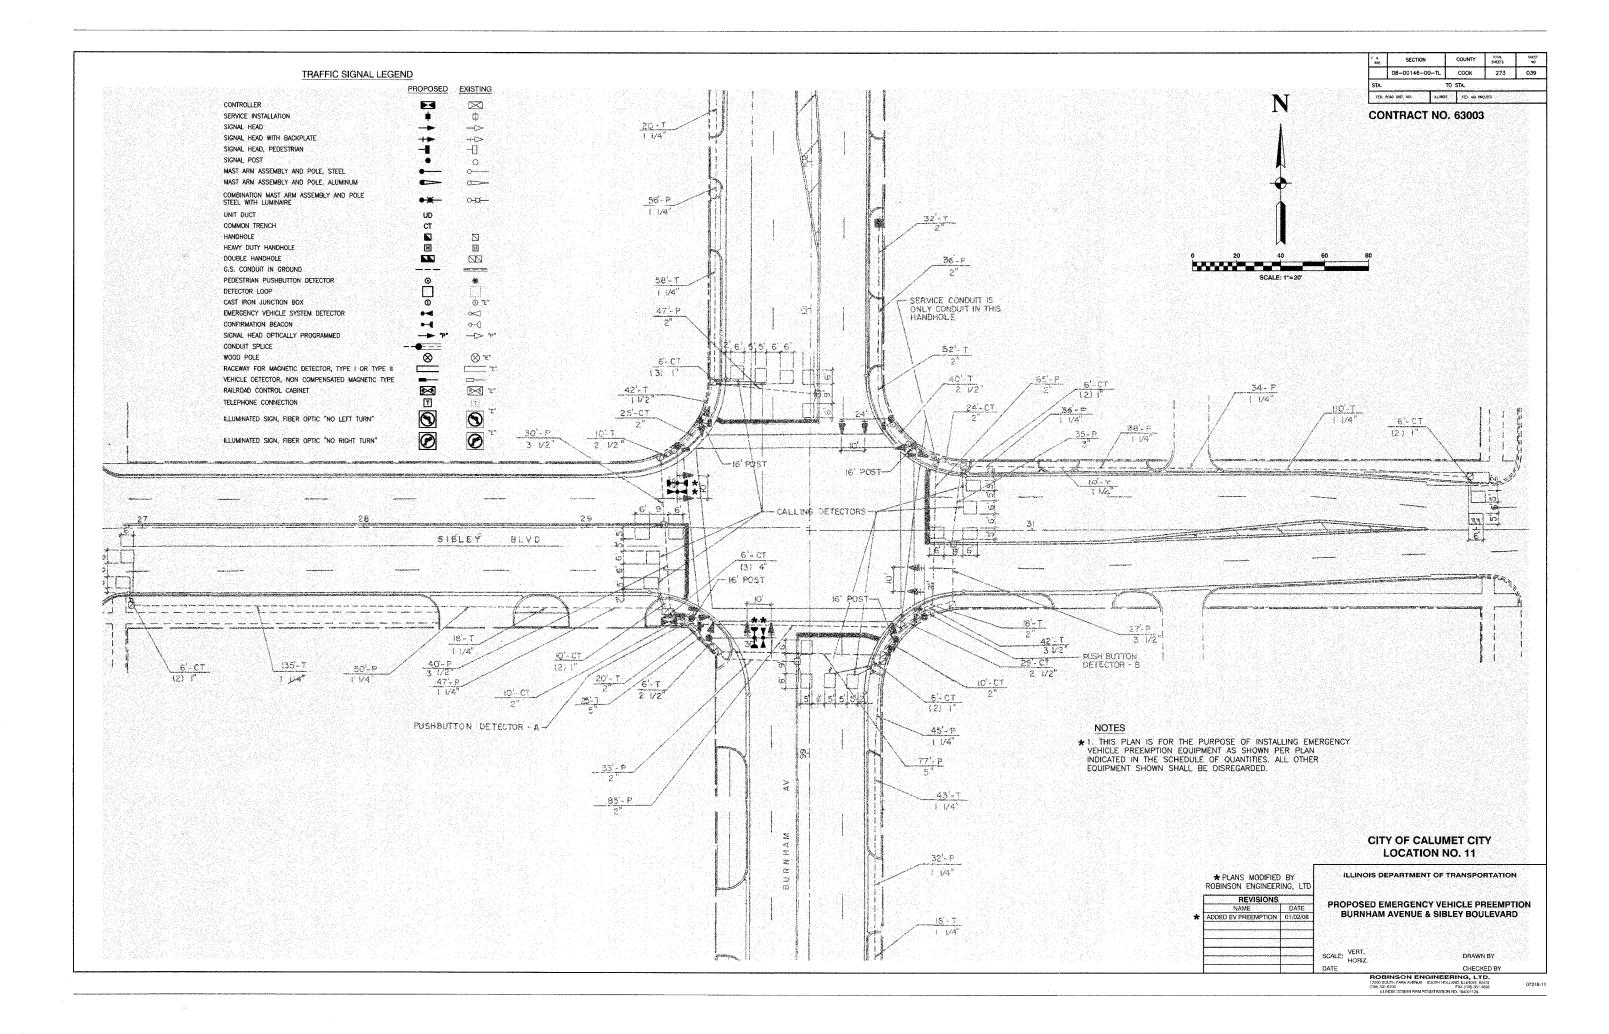


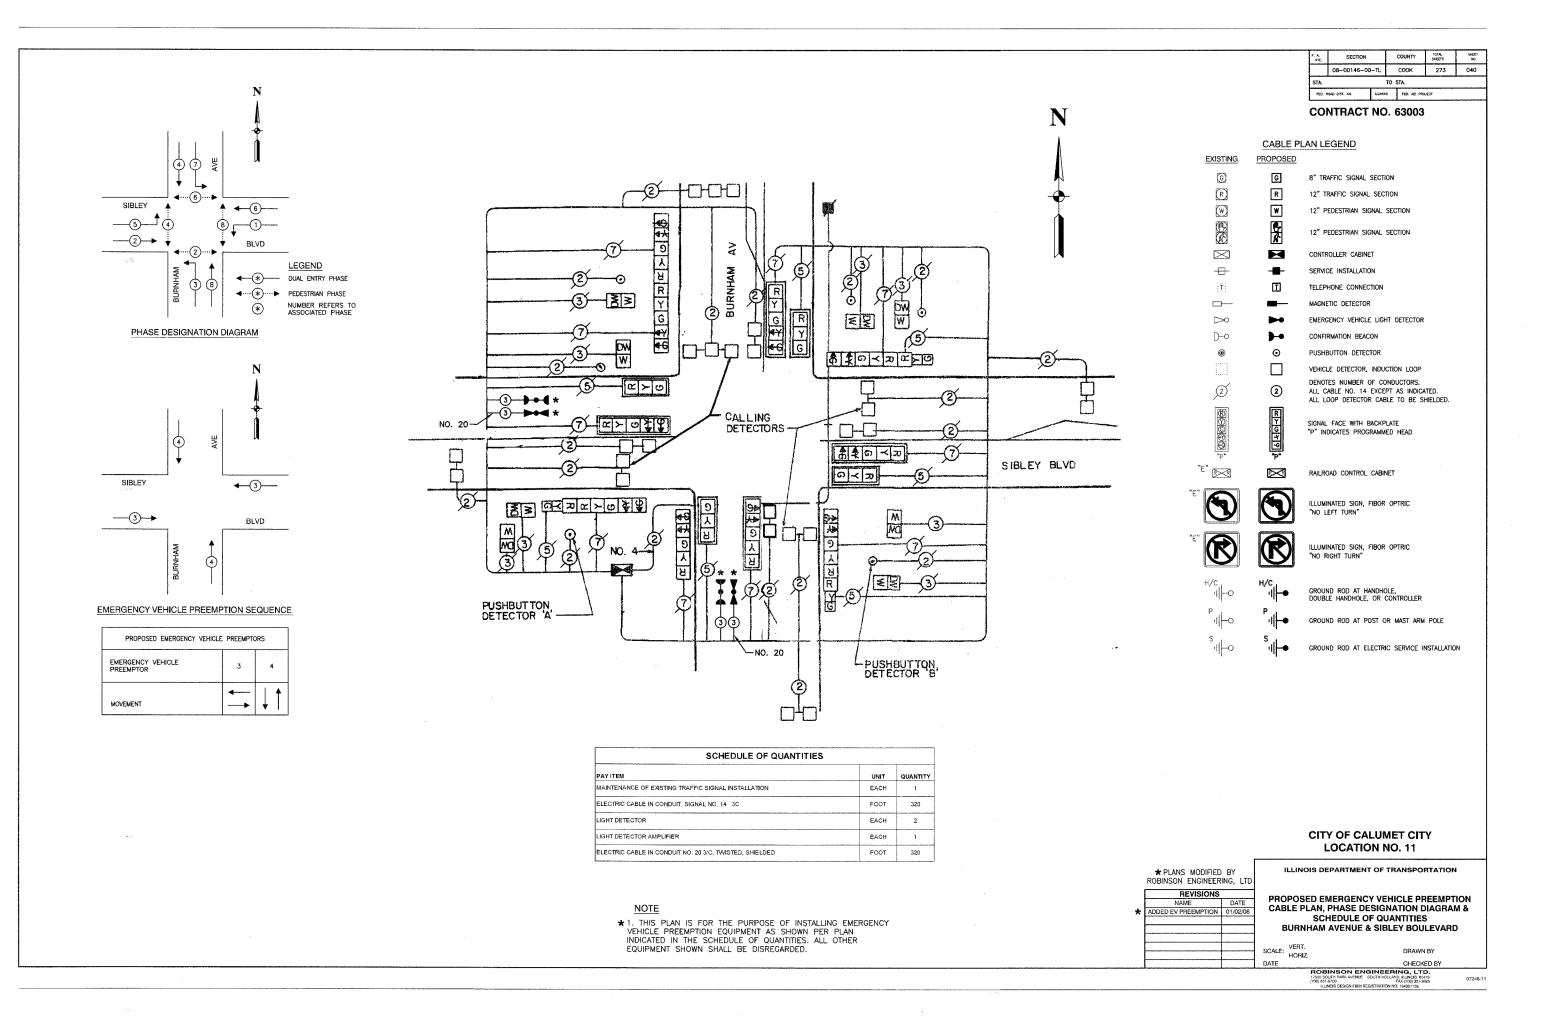


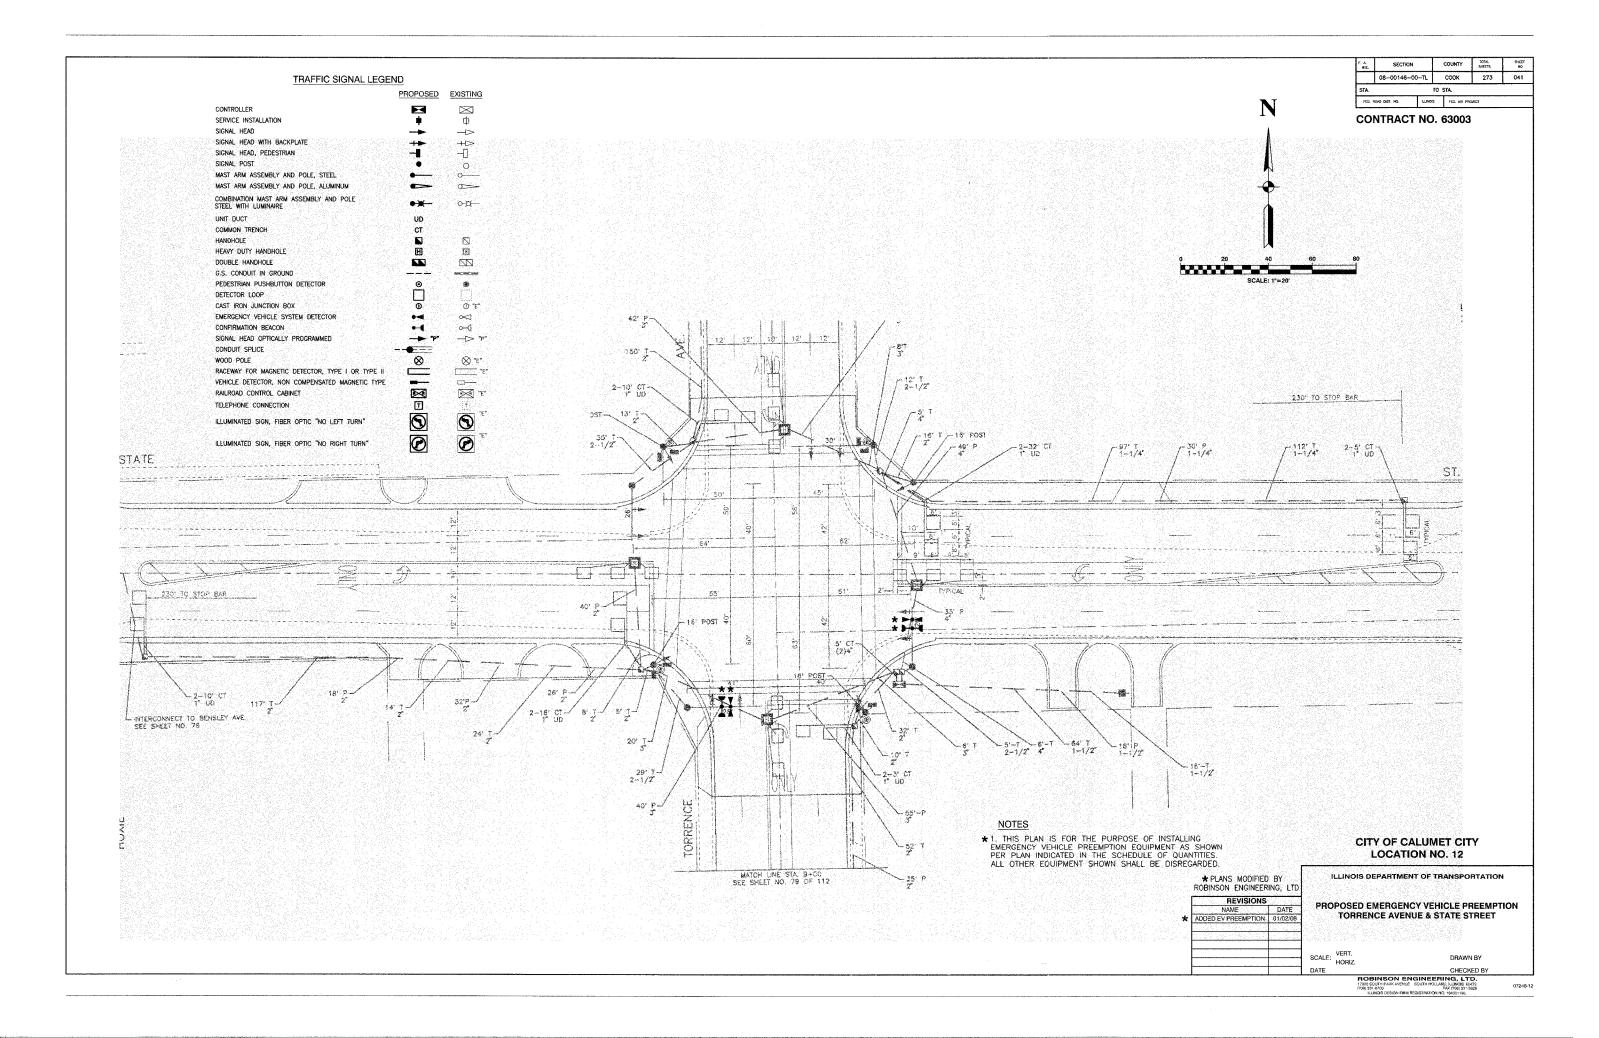


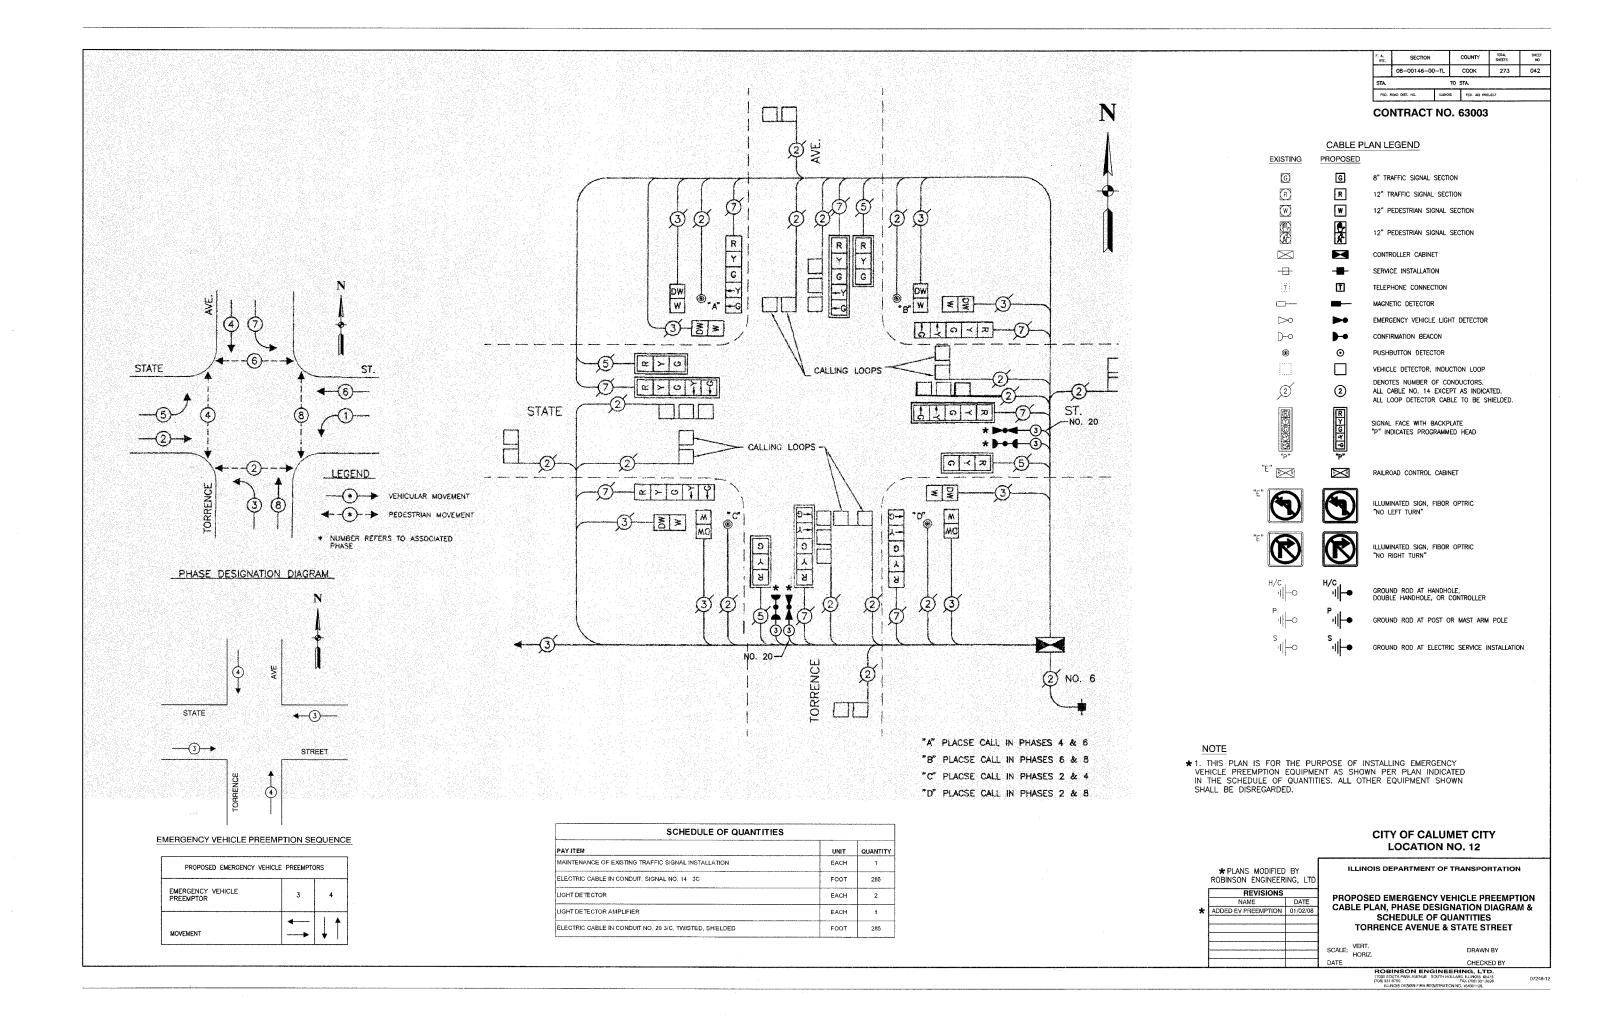


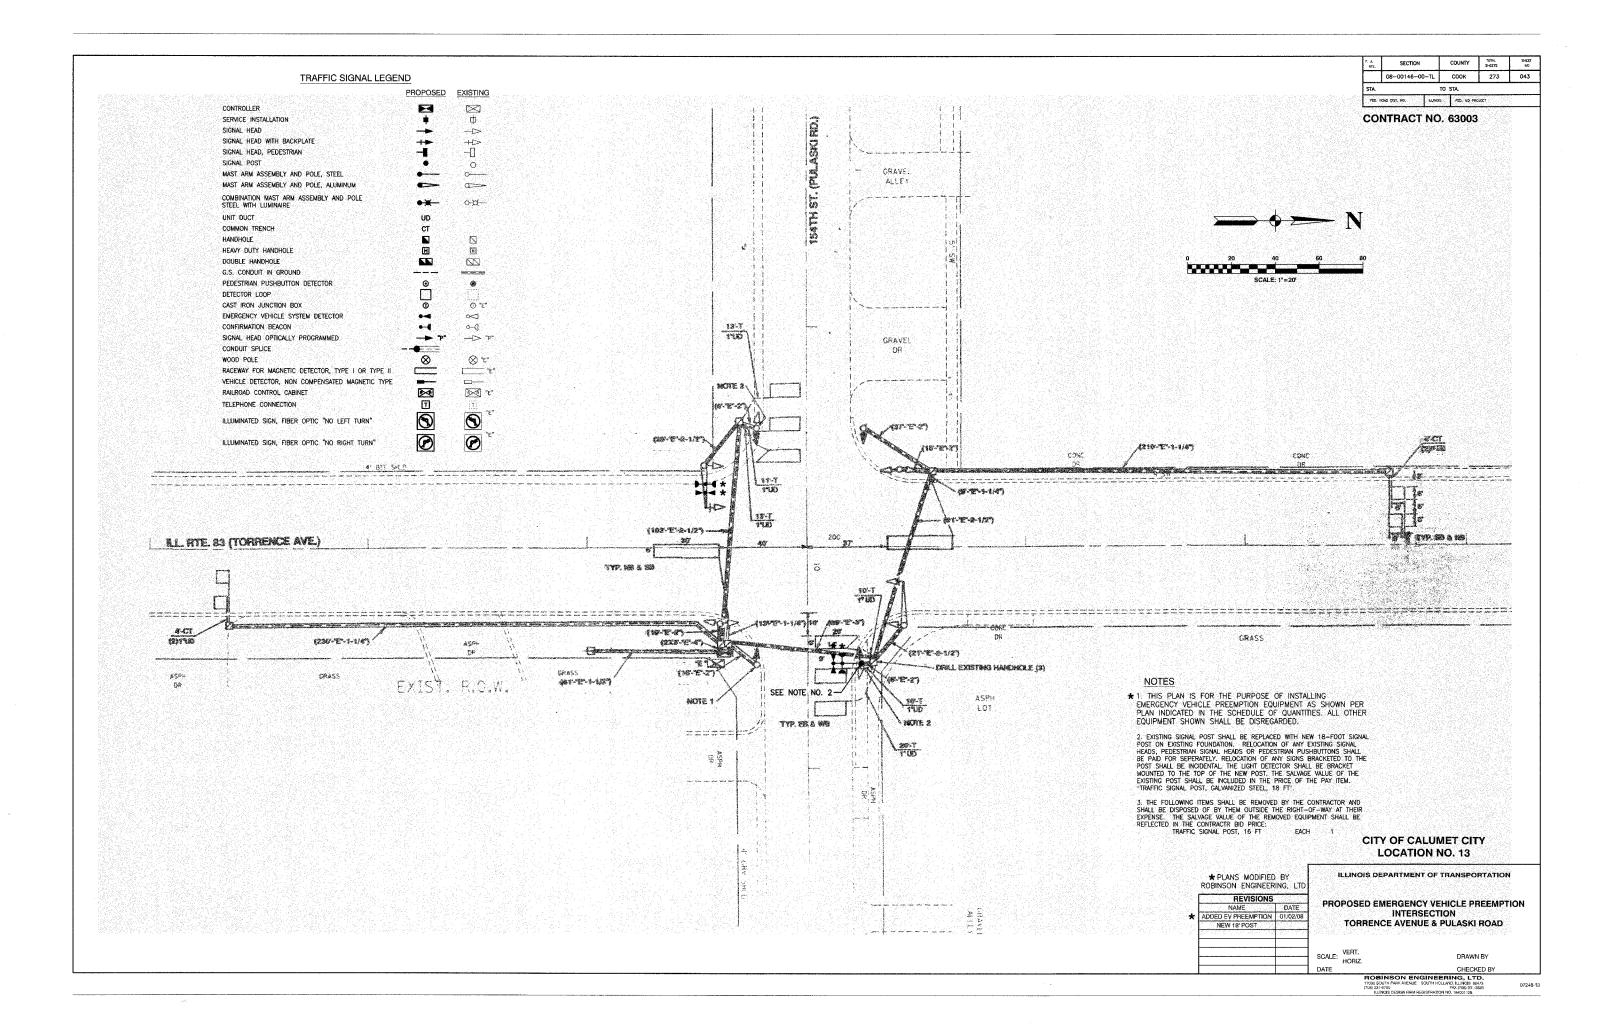


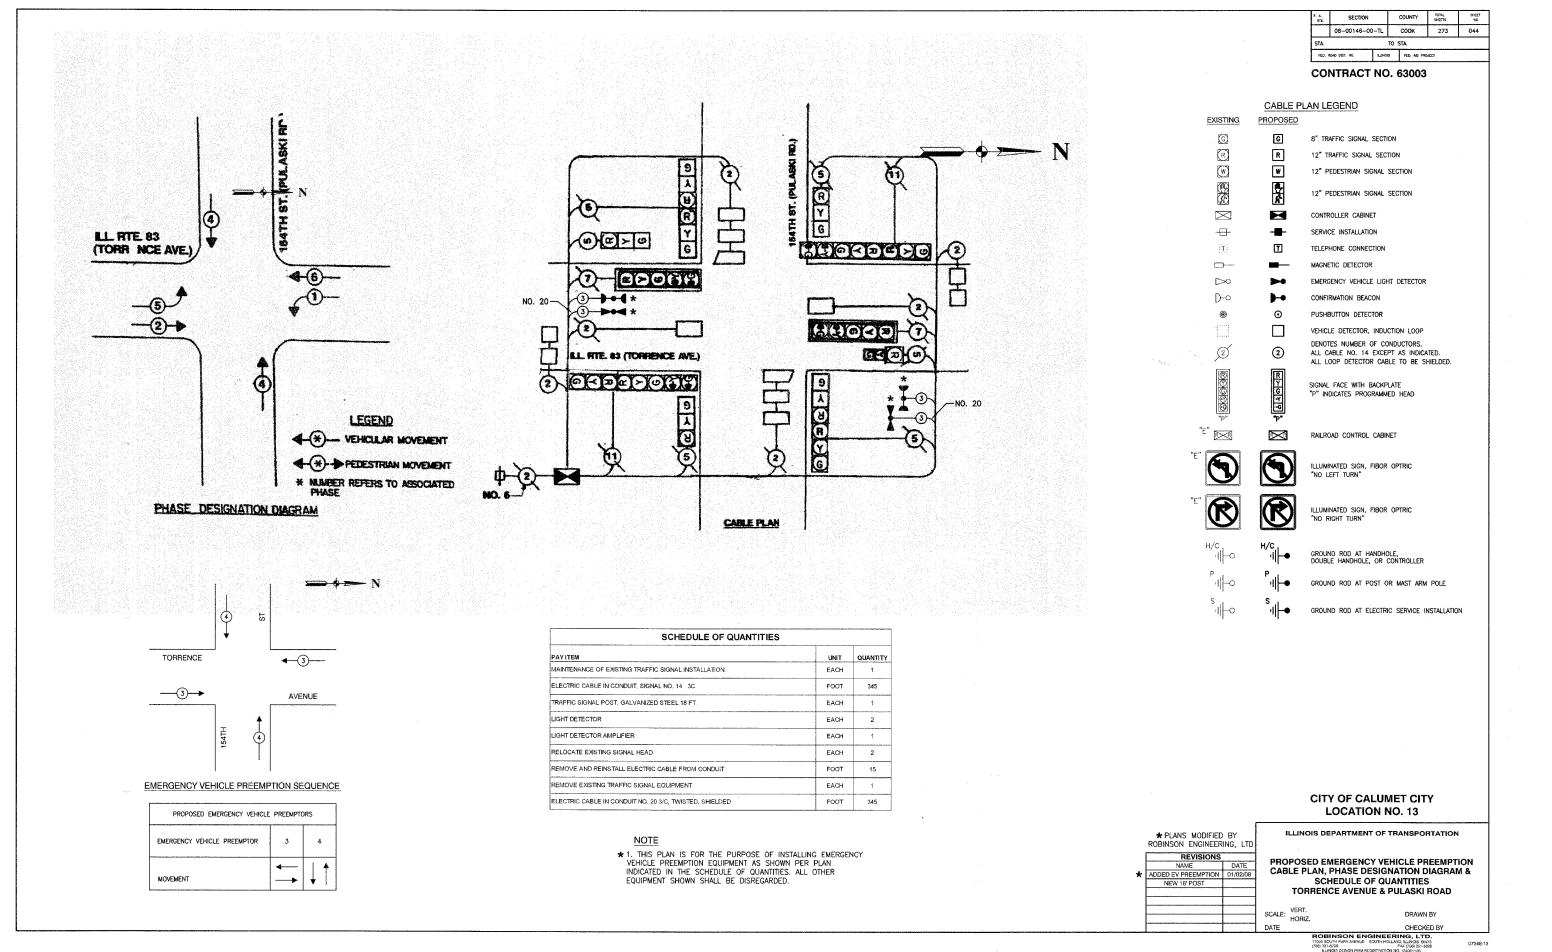


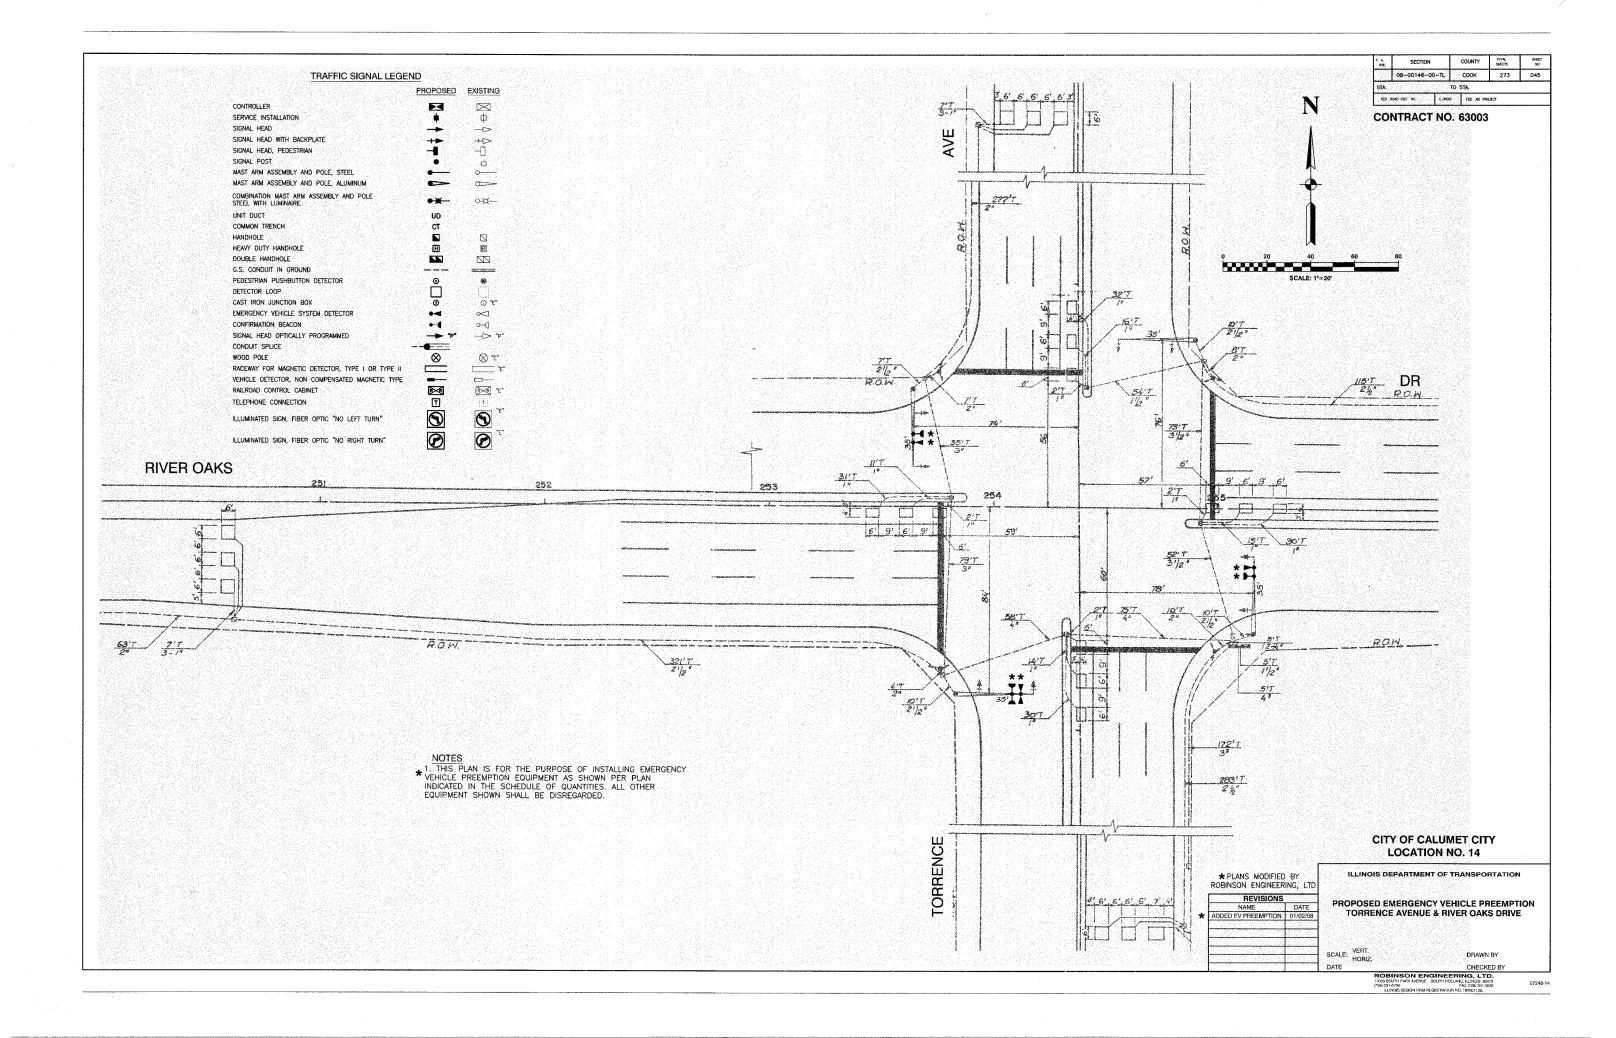

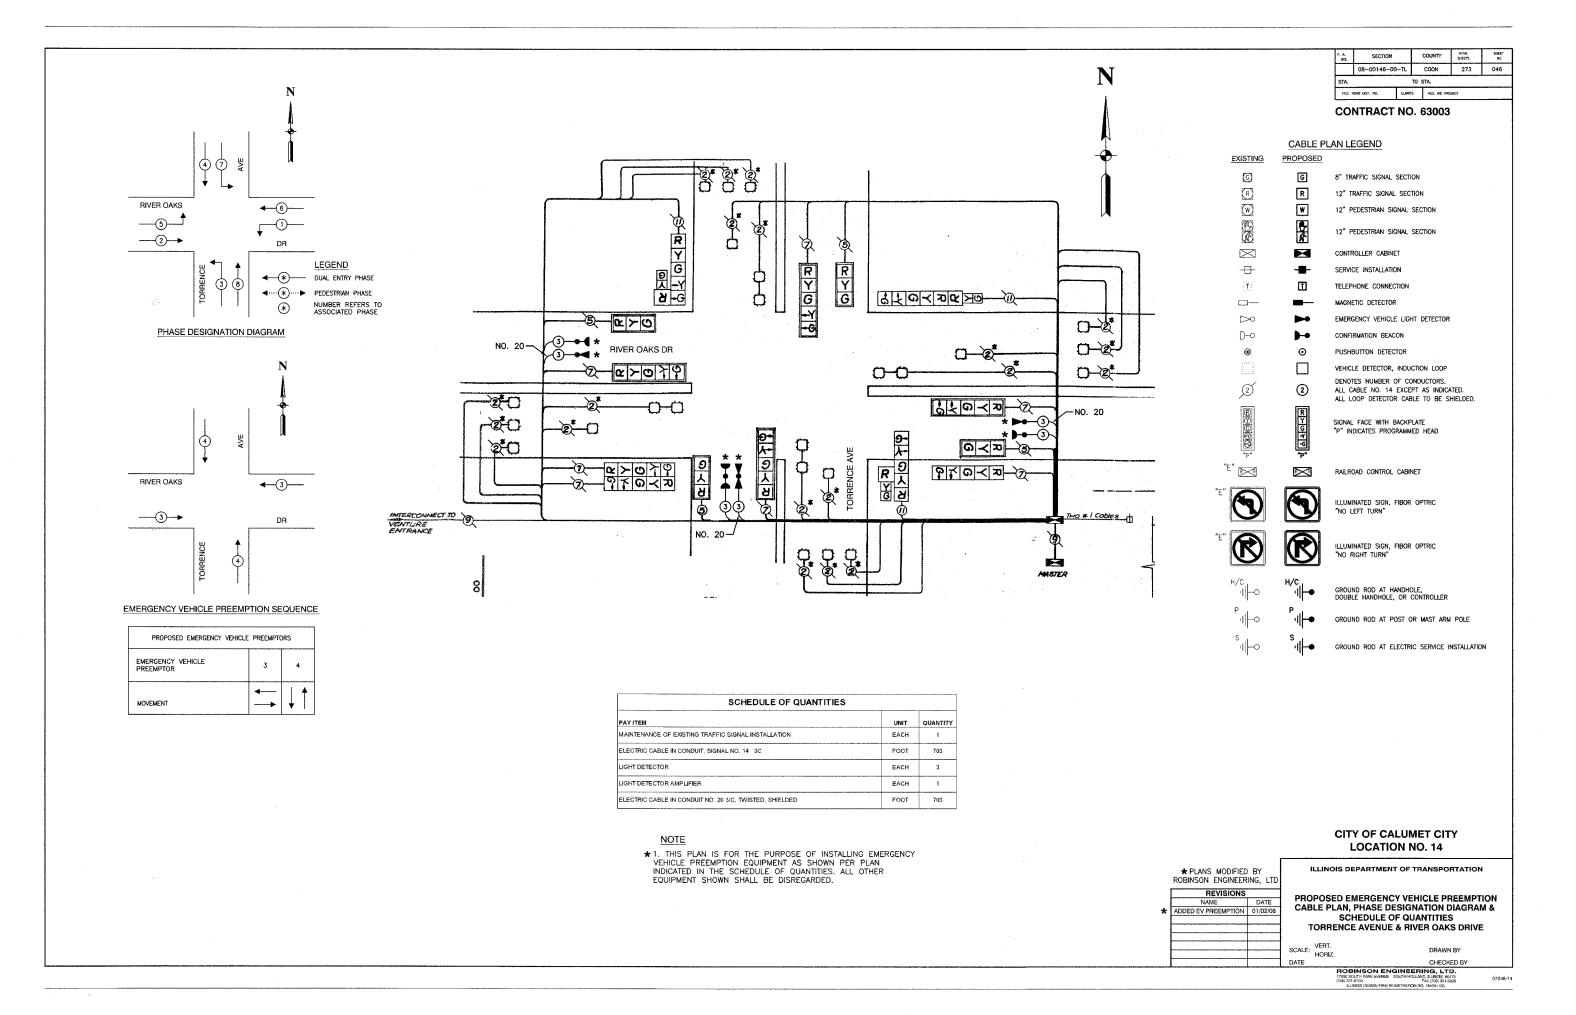

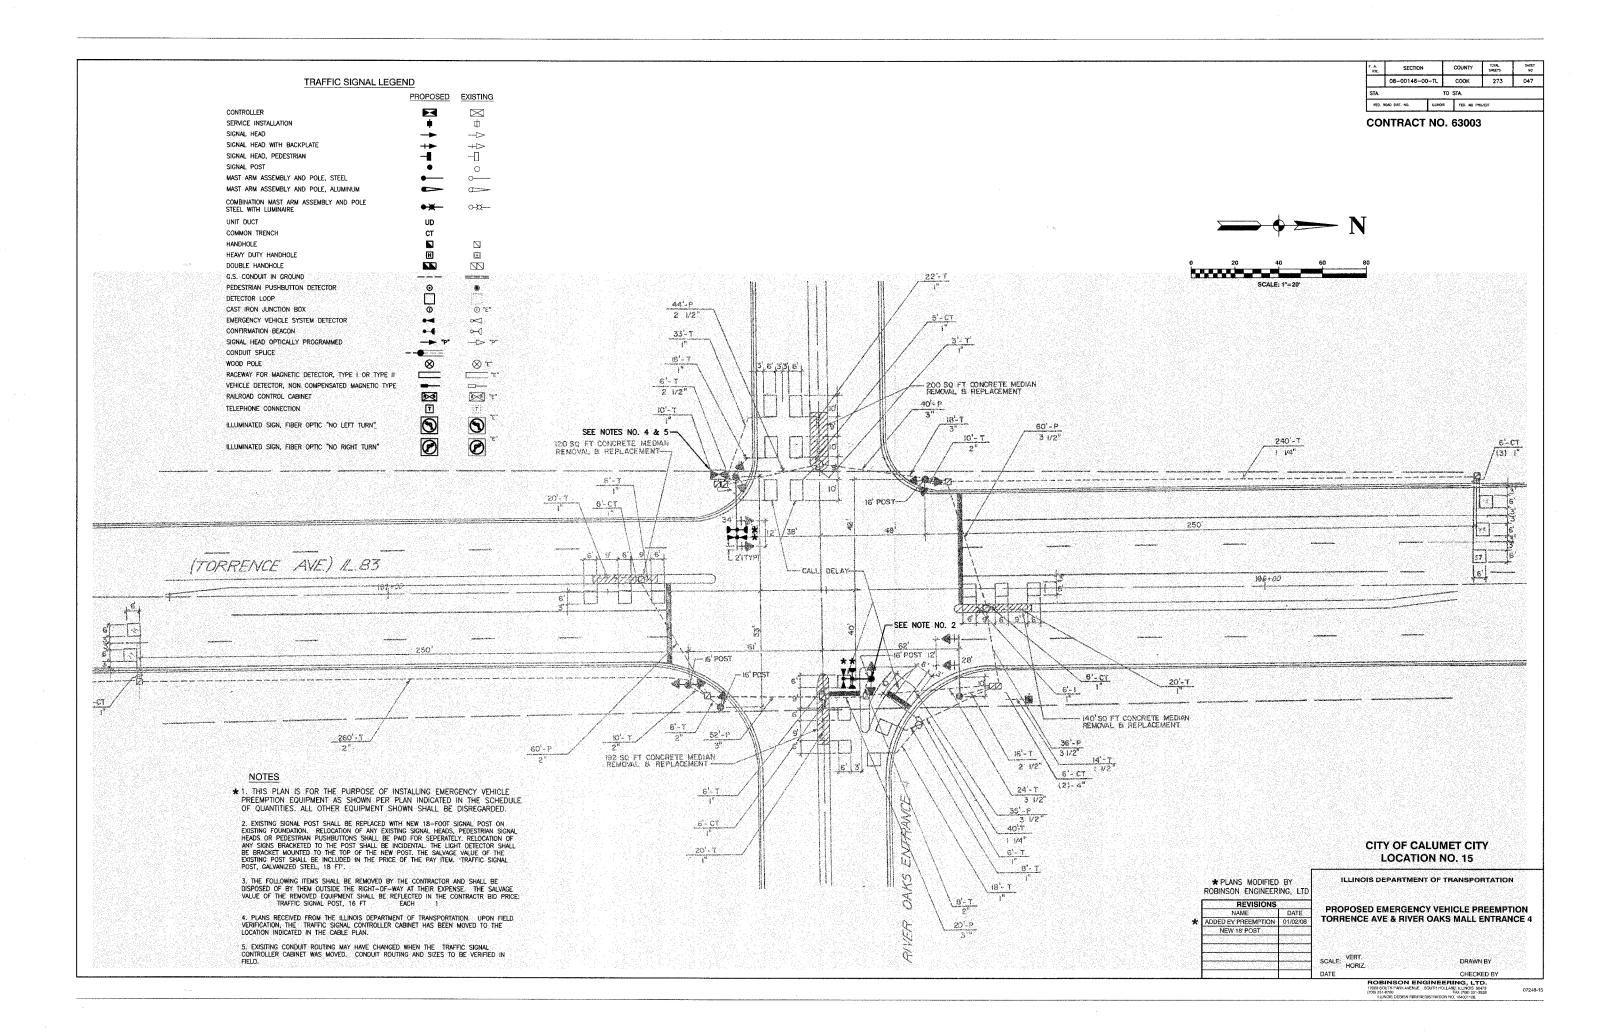

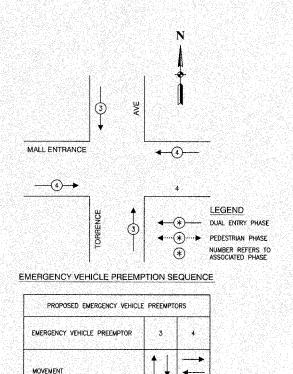

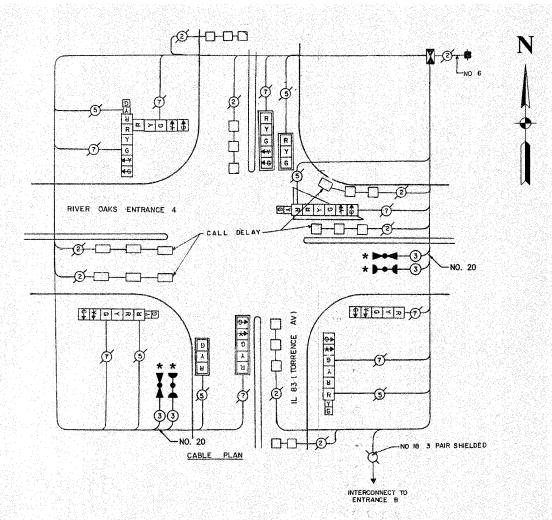

									NO	TAMS	SEQU	ENCE	OF O	PERAT	TIONS																			
MOVEMENT -				4 ]·	-				ij		6					2	, L	<u> </u>					2   '	A  6				., <b>4</b>	8	<u> </u>				F
PHASE		•	1 + 5						1	+ 6	······································						2 -	+ 5					2+1	5					8					A
INTERVAL	1	2	3	4	5	6	7 A	7 B	8 A	8.8	9	10 A	10 B	11	12 A	128	13 A	138	14	15 A	158	16	17A	178	18	19A	198	ZOA	20B	214	218	22A	228	l u
CHANGE TO		1+6	2+5	2+6	8		1	+5	2	+5	2+6		8	1	1	+5	1	+ 6	2+6	Ť	8	/	† <u>`</u>	8	17	17	+5	Τ.	÷ 6	7	+5	<del>                                     </del>	+6	
IL 83(TORRENCE AV) N/B NEAR AND MID-MOUNT SIGNALS	R	R	R	R	R	G	· v	R.	Y	R	G	Y	R	R	R	R	R	R	R	R	R	G	† <del>,</del> ,	Ī.	R	R	Ĭ R	+		R	Ť	R		6
IL 83 TORRENCE AV) N/8 FAR LEFT	R	R	R	R	R	G	Y,	R	Y	R	G Y	Y	R	R	R	R	R	R	R	R	R	G	ŤŸ	R	R	R	R	† <u>.</u>	<del>                                     </del>	R	R	R R	R	8
IL 83(TORRENCE AV) S/B NEAR RIGHT	R	R	R	R	R	R	R	R	R	R	R	R	R	G	Y	R	Y	R	G	· v	R	G	╎ᢏ	R	R	B	f R	IR	<del> </del>	R	R	R	R	-
IL 83(TORRENCE AV S/B FAR LEFT AND AND MAST ARM SIGNALS	R	R	R	R	R	R	R	R	R	R	R	R	R	G	TY	R	Ÿ	- a	G	Y	R	G	1	R	l i	R	R	+	·	R	-	R	-	<u>"</u>
ENTRANCE C E/B NEAR AND FAR RIGHT SIGNALS	I R	R	R	R	G R	R	R.	R.	,R	R	UR.	R.	R G—₽		_ R	₩-G R	B	R	<del>▼-Y</del>	R	R.	R	R	<del> </del>	G	1		G A	R	1.00	<del>                                     </del>	+:-	"   R	+-
ENTRANCE C E/B FAR LEFT SIGNAL		R	R	R		R	R	R	R	R	R	R	R	ล	R	R	l n	R	- B	R	R	R	R		╁	G	F G → R		G—Þ R	<del>  ;  </del>	<del>                                     </del>	+;-	Ĥ	Ë
ENTRANCE C W/B NEAR AND FAR RIGHT SIGNALS	G R	V.R.	R	V.R.	G R	R	R	R	R	R.	R	R				G R	R	-	R	R	R	-	R	+	G	G 🛧			R	<del>  </del>	R	1:	<u>"</u>	R
ENTRANCE C W/B + FAR LEFT SIGNAL	R	R	R	R	1 - 1 - 1	R	R	R	R	R	R	R	R	R	R	R	Y— <b>≯</b> R	R	Y— <b>≯</b>	G—≯ R	G—≱ R	R	R	R	G	G—▶	G - P	- -	n R	G-P	GĐ R	╁╬╣	R	F A

Phases 2 and 6 are to be volume density type
Phase 2+6 cannot clear to 1+5, 1+6, or 2+5
Single entry type traffic signal controller shall not be used
Left turn phases to have non-locking memory

NOTE

\* 1. THIS PLAN IS FOR THE PURPOSE OF INSTALLING EMERGENCY VEHICLE PREEMPTION EQUIPMENT AS SHOWN PER PLAN INDICATED IN THE SCHEDULE OF QUANTITIES. ALL OTHER EQUIPMENT SHOWN SHALL BE DISREGARDED.

F. A. RTE.	SECTION		COUNT	Y TOTAL SHEETS	SHEET NO			
	08-00146-00	I-TL	COOK	273	048			
STA.			TO STA.					
FED. I	ROAD DIST. NO.	LLINOR	ID PROJECT					

## CONTRACT NO. 63003

		0011111A01 110. 00000
	CABLE PL	AN LEGEND
EXISTING	PROPOSED	
<b>©</b>	G	8" TRAFFIC SIGNAL SECTION
R	R	12" TRAFFIC SIGNAL SECTION
W	W	12" PEDESTRIAN SIGNAL SECTION
	<u>o</u>	12" PEDESTRIAN SIGNAL SECTION
$\bowtie$		CONTROLLER CABINET
-	-	SERVICE INSTALLATION
111		TELEPHONE CONNECTION
		MAGNETIC DETECTOR
$\triangleright \!$	▶•	EMERGENCY VEHICLE LIGHT DETECTOR
D0	•	CONFIRMATION BEACON
•	•	PUSHBUTTON DETECTOR
		VEHICLE DETECTOR, INDUCTION LOOP
2	2	DENOTES NUMBER OF CONDUCTORS. ALL CABLE NO. 14 EXCEPT AS INDICATED. ALL LOOP DETECTOR CABLE TO BE SHIELDED.
*p."	<u> </u>	SIGNAL FACE WITH BACKPLATE "P" INDICATES PROGRAMMED HEAD
"E" <b>▶</b>	$\bowtie$	RAILROAD CONTROL CABINET
	9	ILLUMINATED SIGN, FIBOR OPTRIC "NO LEFT TURN"
	<b>R</b>	ILLUMINATED SIGN, FIBOR OPTRIC "NO RIGHT TURN"
H/C   -0	H/C -  -	GROUND ROD AT HANDHOLE, DOUBLE HANDHOLE, OR CONTROLLER
P 11-0	P       -	GROUND ROD AT POST OR MAST ARM POLE


GROUND ROD AT	ELECTRIC SERVICE INS	TALLATION						
SCHEDULE OF QUANTITIES								
PAYITEM	UNIT	QUANTIT						
MAINTENANCE OF EXISTING TRAFFIC SIGNAL INSTALLATION	EACH	1						
ELECTRIC CABLE IN CONDUIT, SIGNAL NO. 14 3C	FOOT	500						
TRAFFIC SIGNAL POST, GALVANIZED STEEL 18 FT.	EACH	1						
LIGHT DETECTOR	EACH	2						
LIGHT DETECTOR AMPLIFIER	EACH	1						
RELOCATE EXISTING SIGNAL HEAD	EACH	2						
REMOVE AND REINSTALL ELECTRIC CABLE FROM CONDUIT	FOOT	15						
REMOVE EXISTING TRAFFIC SIGNAL EQUIPMENT	EACH	1						
ELECTRIC CABLE IN CONDUIT NO. 20 3/C, TWISTED, SHIELDED	FOOT	500						


### CITY OF CALUMET CITY LOCATION NO. 15

	* PLANS MODIFIED ROBINSON ENGINEER		ı	illinois	DEPARTMENT OF TRANSPORTATION
	REVISIONS		nnc	DOCED	EMEROPING VEHICLE PREEMPTION
	NAME	DATE			EMERGENCY VEHICLE PREEMPTION
*	ADDED EV PREEMPTION	01/02/08	CAE		N, PHASE DESIGNATION DIAGRAM &
	NEW 18' POST			_	CHEDULE OF QUANTITIES
			TORE	RENCE A	IVE & RIVER OAKS MALL ENTRANCE 4
			SCALE:	VERT.	DRAWN BY
			SOALE.	HORIZ.	DRAWN B1
			DATE		CHECKED BY

IOBINSON ENGINEERING, LTD.
000 SOUTH PARK AVENUE SOUTH HOLLAND, LLINOIS 60473
(R) 331-6700 FAX (708) 831-9826


07248-15

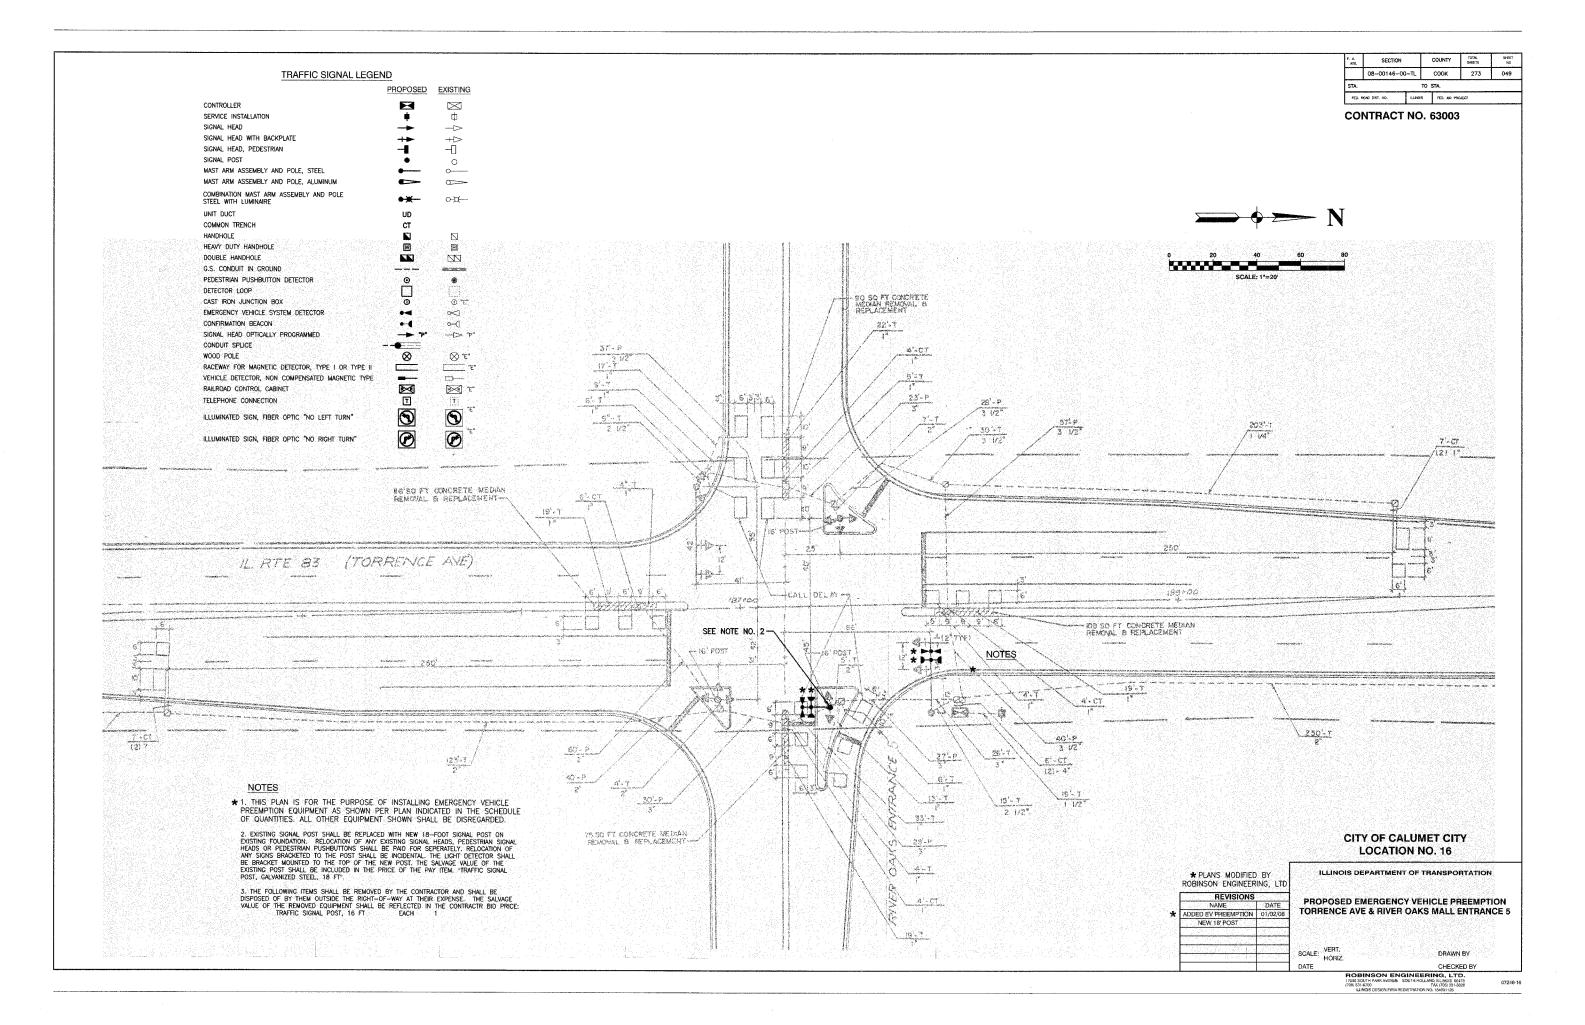


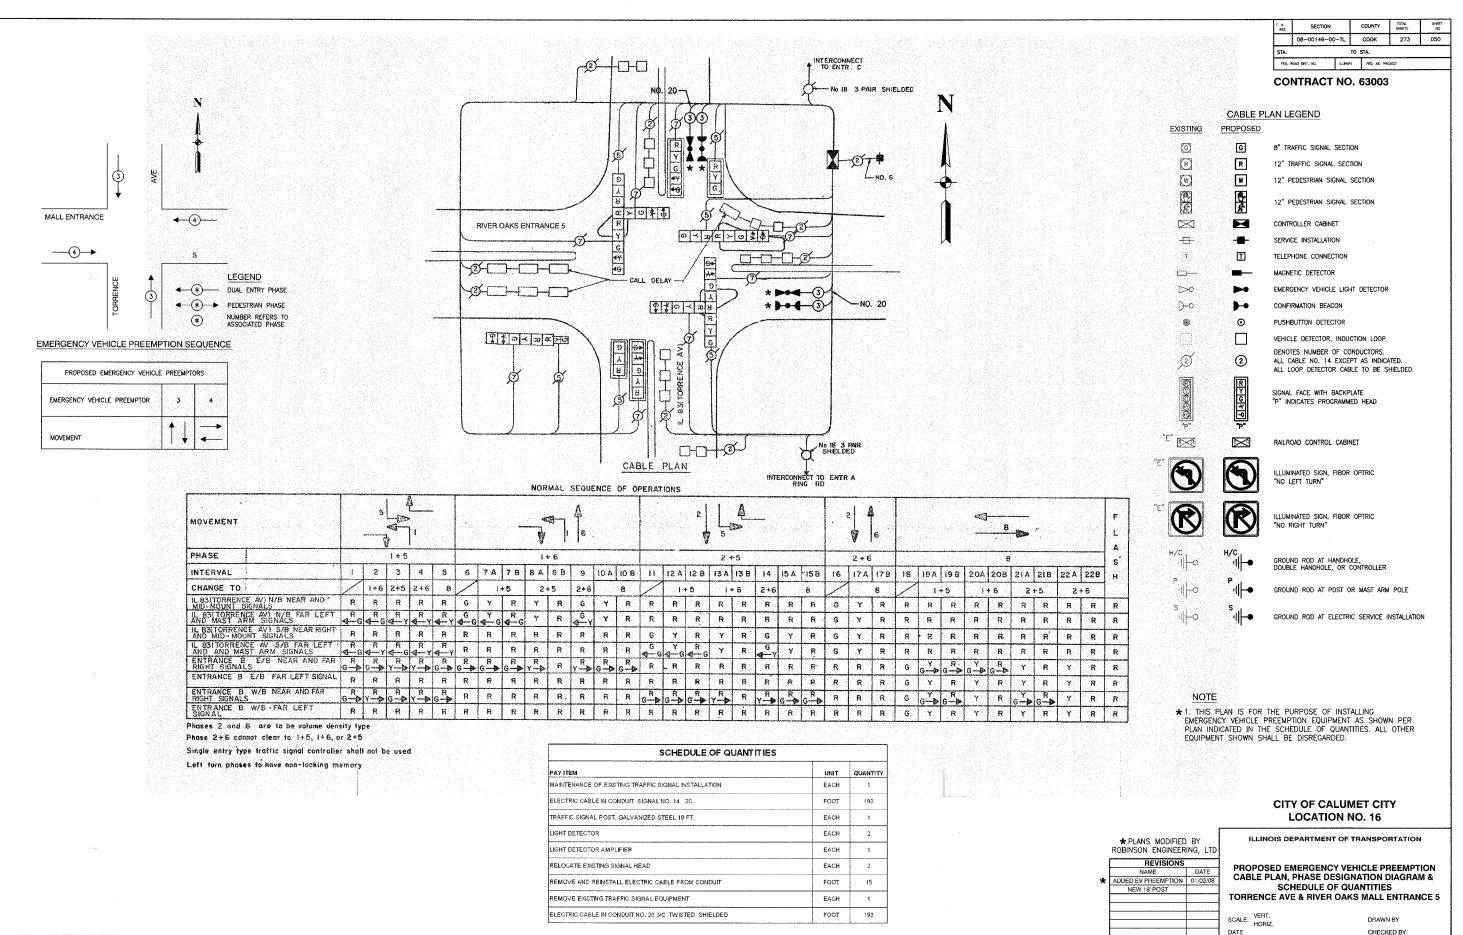



ROBINSON ENGINEERING, LTD. 7000 SOUTH PARK AVENUE SOUTH HOLLAND, ILLINCIS 60/73 09) 331-6700 FAX (708) 331-3626


07248-16

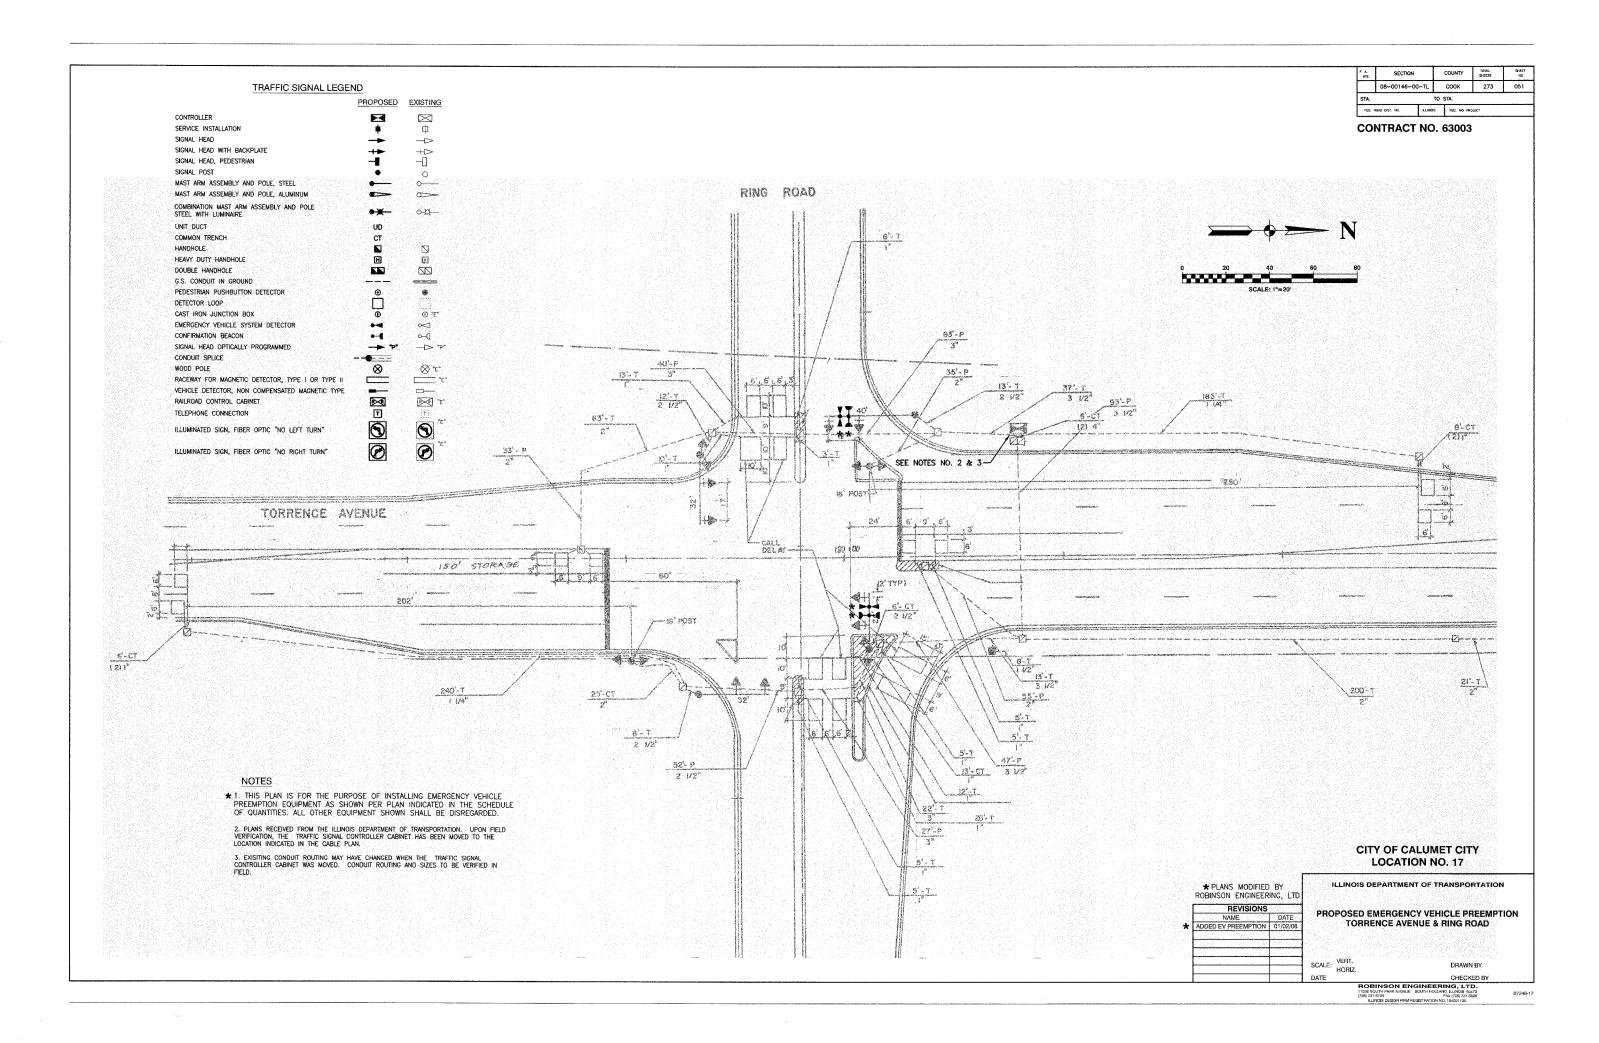


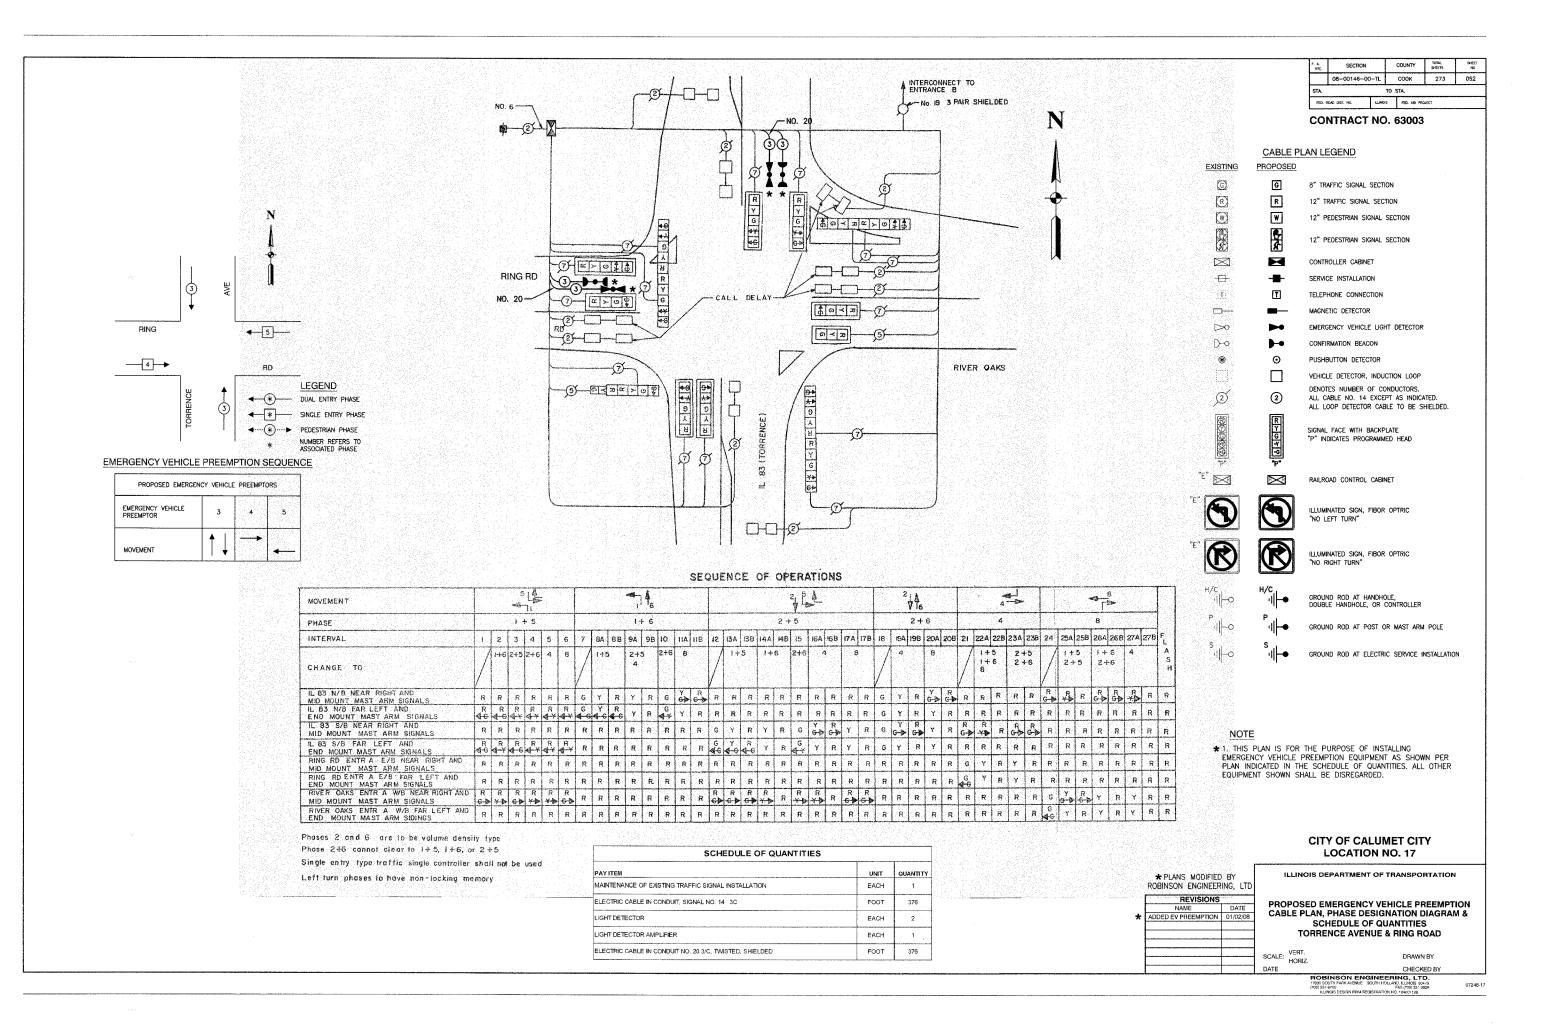

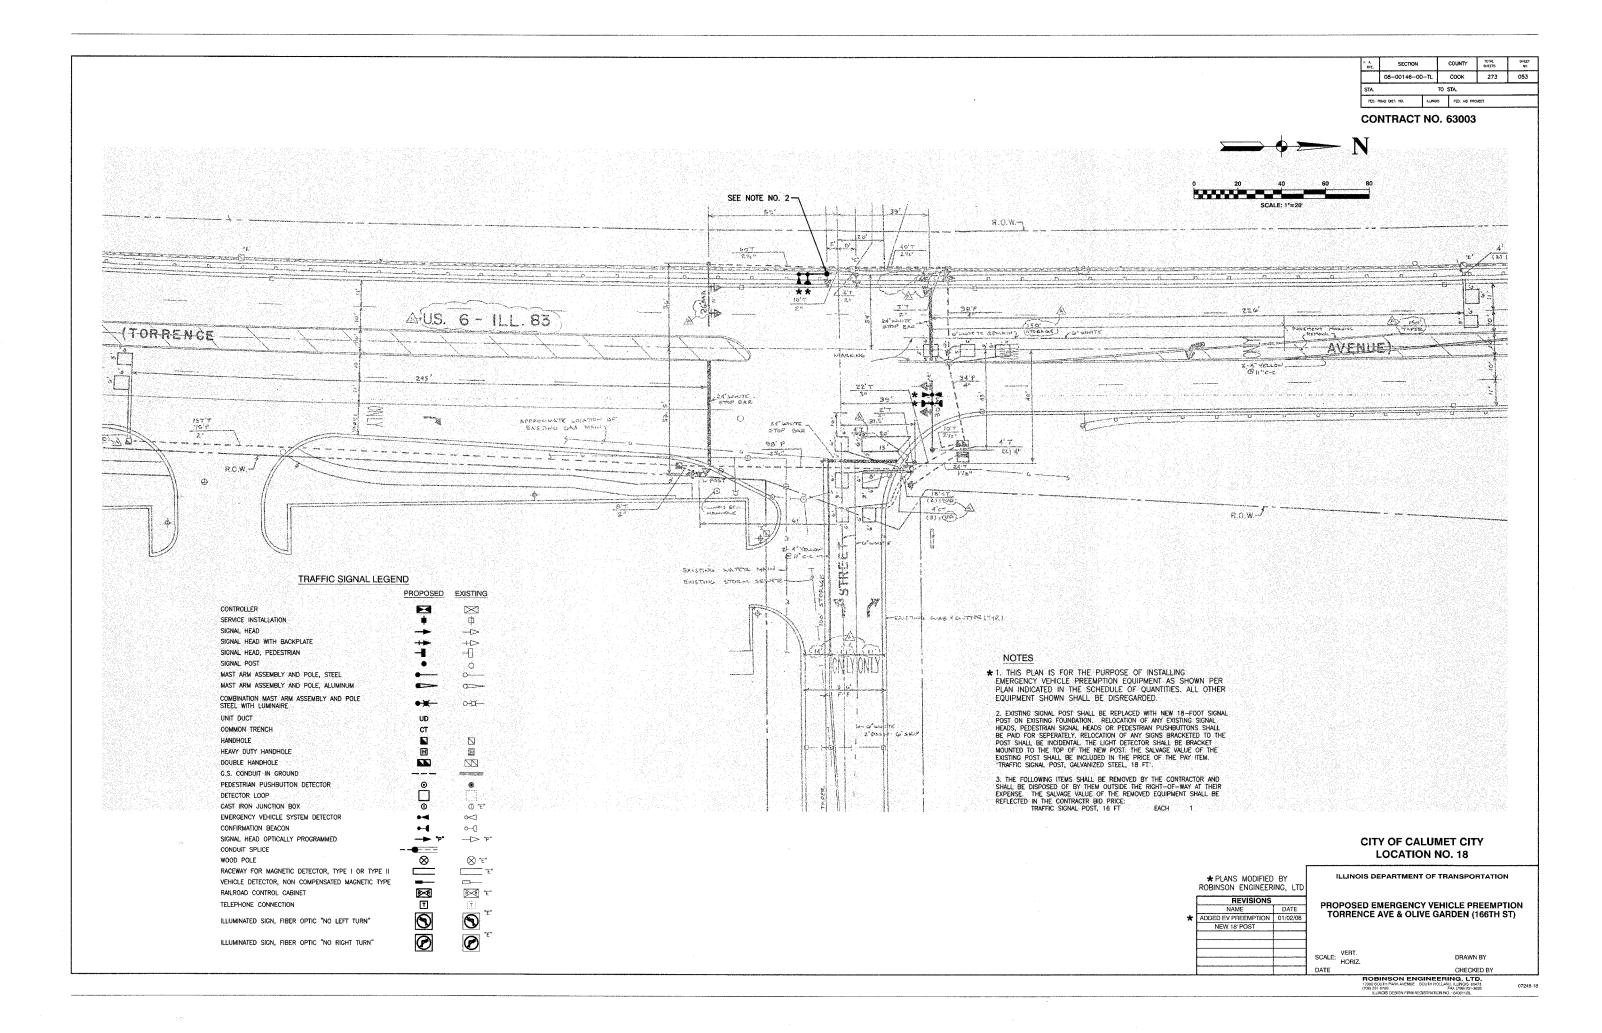

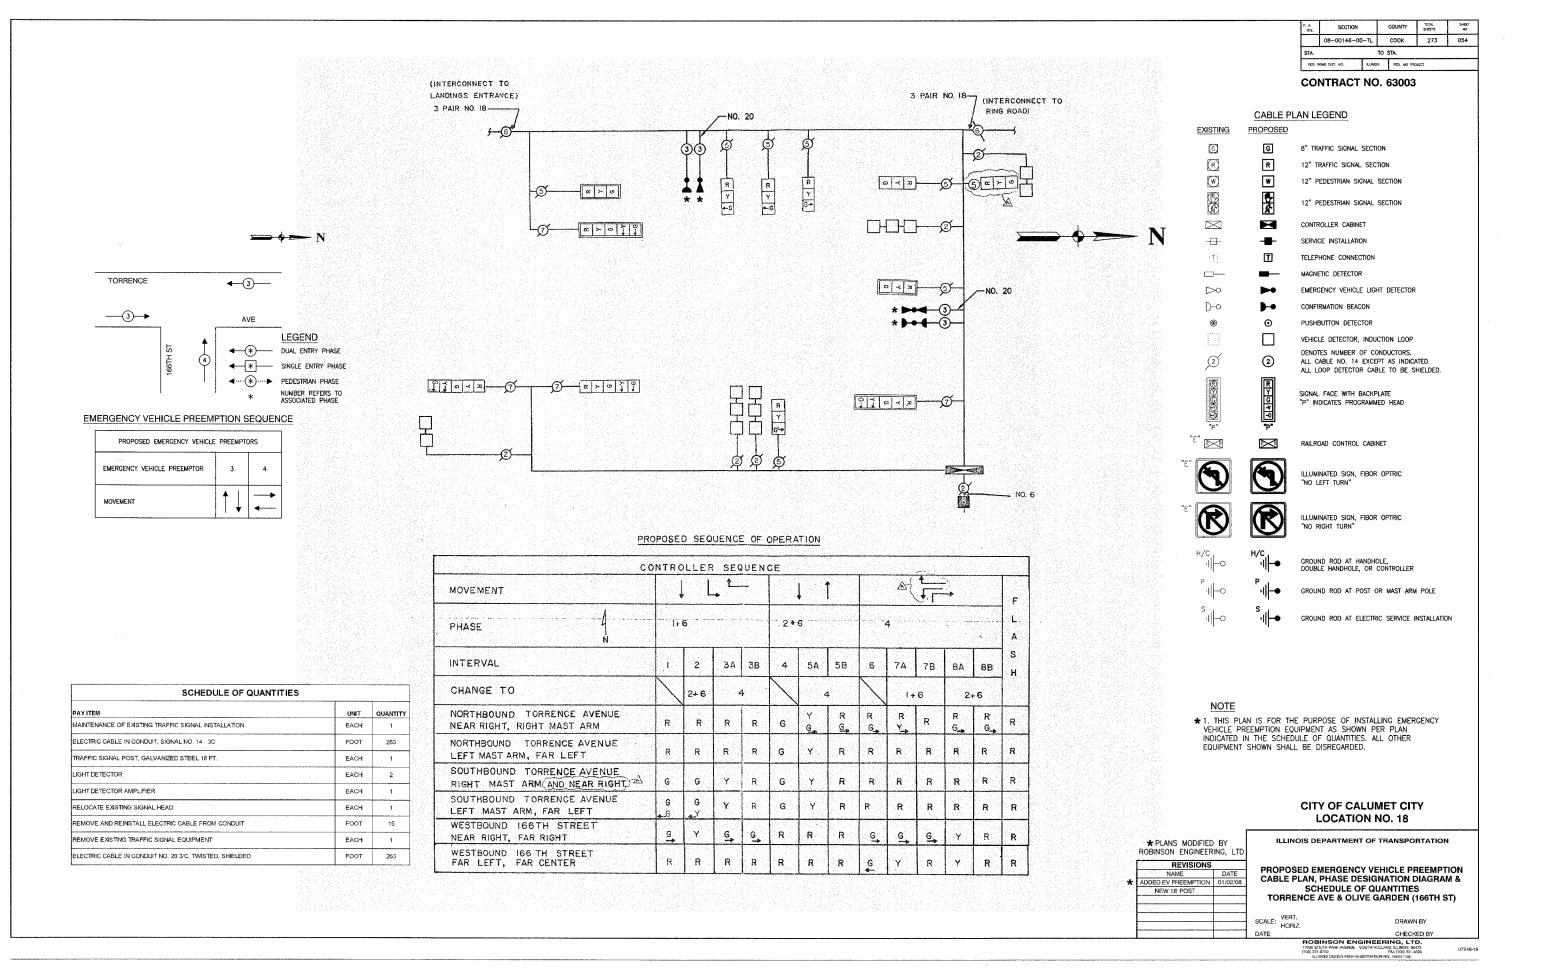


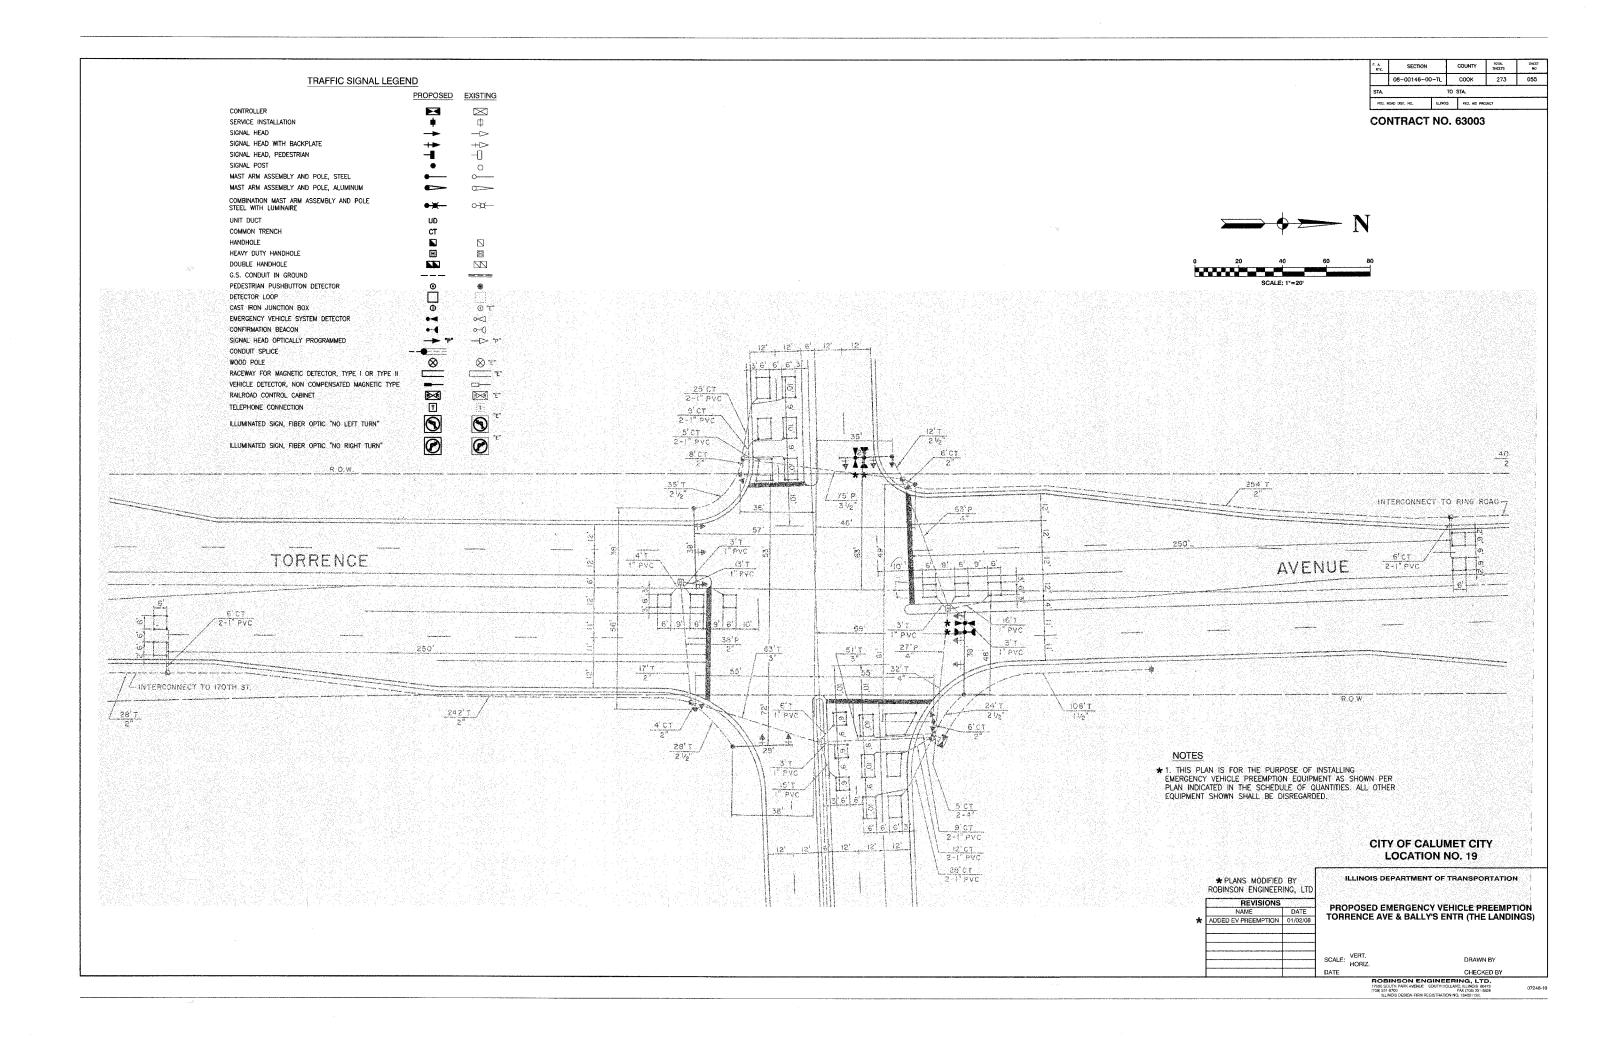

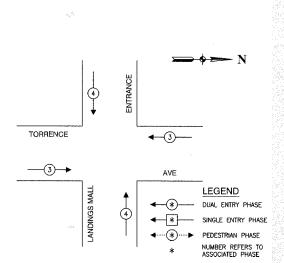

### **EMERGENCY VEHICLE PREEMPTION SEQUENCE**

PROPOSED EMERGENCY VEHICLE	PREEMPTO	ORS
EMERGENCY VEHICLE PREEMPTOR	3	4
MOVEMENT	<b>←</b>	<b>↑</b> ↓

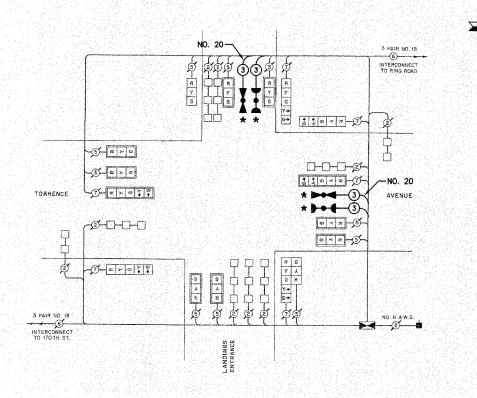

#### SEQUENCE OF OPERATION

MOVEMENT			4	7 3	<u>0</u> L.					3.44	8							<b> </b>	<b>≜</b> 0.1 <b>→</b> 7					1	<b>\</b>		4 6	<u>-</u> -	—² →		F
PHASE				3 + 7		10				3	+ 8			14.00				4	+ 7		-3,57			4 + 8	3			2 + 6	6		A
INTERVAL			2	3	4	5	6	7A	78	8 A	88	9	10 A	108	11	12 A	128	13.4	13 B	14	15A	158	16	.17A	178	18	19 A	198	20 A	208	H
CHANGE TO			3+8	4+7	4+8	2+6		3	+7	4	+7	4+8	2	+6	/	3	+7	3	+8	4+8	5	+6	/	2	+6	/		+7 +7		+8	
LANDINGS ENTRANCE E/B	Ť	R	R	R	R	R	R	R	R	R	R	R	R	R	В	R	R	R	R	R	R	R	R	R	R	G	Y	R	17	R	R
L'ANDINGS ENTRANCE W/E NEAR RIGHT AND FAR RIGHT SIGNALS		R 3- <b>≯</b>	R Y-₽	R G-≯	R Y- <b>≯</b>	R G→	R	R	R	R	Я	R	R	R	R G-₽	R G-	R G-▶	R Y-▶	R	R Y- <b>Þ</b>	R G-▶	R G-▶	R	R	R	G	γ 6- <b>&gt;</b>	R G-	Y	R	R
LANDINGS ENTRANCE W/E FAR LEFT AND MAST ARM SIGNALS		R.	R	R	R	R	R	R	R	R	ĸ	R	R	R	R	R	R	R	R	R	R	R	R	R	R	G	Y	R	Y	R	R
TORRENCE AVENUE N/B MID MAST ARM SIGNALS		R	R	R	R	R	G	Υ	R	Y	R	G	Y	R	R	R	R	Я	R	R	R	Ŕ	G	Υ	R	R	R	R	R	R	R
TORRENCE AVENUE N/B		R 4-G	R <b>4</b> -G	R <b>4-</b> Y	R <b>4</b> -Y	R <b>∢</b> Y	G <b>4</b> −G	γ <b>4</b> G	R <b>4</b> -G	Υ	R	G <b>∢</b> Y	Y	R	R	R	R	R	R	R	R	R	G	Y	R	R	R	R	R	R	R
TORRENCE AVENUE S/B MID MAST ARM SIGNALS		R	R	Ŗ	R	R	R	R	R	R	R	R	R	R	G	Υ	R	Υ	R	G	Υ	R	G	¥	R	R	R	R	R	Я	R
TORRENCE AVENUE S/B FAR LEFT AND END MAST ARM SIGNALS		R 4-6	R <b>∢</b> -Y	R <b>-4</b> -G	R <b>4</b> Y	R ◆Y	R	R	R	R	R	R	R	R	G <b>∢</b> -G	Y <b>4</b> -G	R <b>4</b> -G	Y	R	G <b>∢</b> Y	Υ	R	G	¥	R	R	R	R	R	R	R

UNIT QUANTITY

305

2

305

EACH

FOOT

EACH

EACH

FOOT

SCHEDULE OF QUANTITIES

PAYITEM

LIGHT DETECTOR

LIGHT DETECTOR AMPLIFIER

MAINTENANCE OF EXISTING TRAFFIC SIGNAL INSTALLATION

ELECTRIC CABLE IN CONDUIT NO. 20 3/C, TWISTED, SHIELDED

ELECTRIC CABLE IN CONDUIT, SIGNAL NO. 14 3C

### NOTES

- I. PHASE 4+8 SHALL NOT RETURN TO PHASES 3+7, 3+8 OR 4+7
- 2. SINGLE ENTRY TYPE TRAFFIC CONTROLLER SHALL NOT BE USED
- 3. LEFT TURN PHASES TO HAVE NON-LOCKING MEMORY

	ROAD DIST. NO.		UNOIS FED. AID PROJECT							
STA.			TO STA.							
	08-00146-00	)—TL	056							
E. A. IME.	SECTION		COUNTY	TOTAL SHEETS	SHEET					

#### CONTRACT NO. 63003

### CABLE PLAN LEGEND

EXISTING PROPOSED **©** G 8" TRAFFIC SIGNAL SECTION R R 12" TRAFFIC SIGNAL SECTION W W 12" PEDESTRIAN SIGNAL SECTION 12" PEDESTRIAN SIGNAL SECTION  $\boxtimes$ lacksquareCONTROLLER CABINET -TELEPHONE CONNECTION \_\_ MAGNETIC DETECTOR  $\triangleright$ 0 EMERGENCY VEHICLE LIGHT DETECTOR D-0 CONFIRMATION BEACON 0 PUSHBUTTON DETECTOR VEHICLE DETECTOR, INDUCTION LOOP DENOTES NUMBER OF CONDUCTORS.
ALL CABLE NO. 14 EXCEPT AS INDICATED. Ø ALL LOOP DETECTOR CABLE TO BE SHIELDED. SIGNAL FACE WITH BACKPLATE "E" <u>▼</u>  $\bowtie$ RAILROAD CONTROL CABINET





ILLUMINATED SIGN, FIBOR OPTRIC "NO LEFT TURN"





ILLUMINATED SIGN, FIBOR OPTRIC "NO RIGHT TURN"





GROUND ROD AT HANDHOLE, DOUBLE HANDHOLE, OR CONTROLLER



GROUND ROD AT POST OR MAST ARM POLE





GROUND ROD AT ELECTRIC SERVICE INSTALLATION


★ 1. THIS PLAN IS FOR THE PURPOSE OF INSTALLING EMERGENCY VEHICLE PREEMPTION EQUIPMENT AS SHOWN PER PLAN INDICATED IN THE SCHEDULE OF QUANTITIES. ALL OTHER EQUIPMENT SHOWN SHALL BE DISREGARDED.


#### CITY OF CALUMET CITY **LOCATION NO. 19**


ILLINOIS DEPARTMENT OF TRANSPORTATION ★ PLANS MODIFIED BY ROBINSON ENGINEERING, LTD REVISIONS PROPOSED EMERGENCY VEHICLE PREEMPTION CABLE PLAN, PHASE DESIGNATION DIAGRAM & **SCHEDULE OF QUANTITIES** TORRENCE AVE & BALLY'S ENTR (THE LANDINGS) SCALE: VERT, HORIZ. DRAWN BY DATE

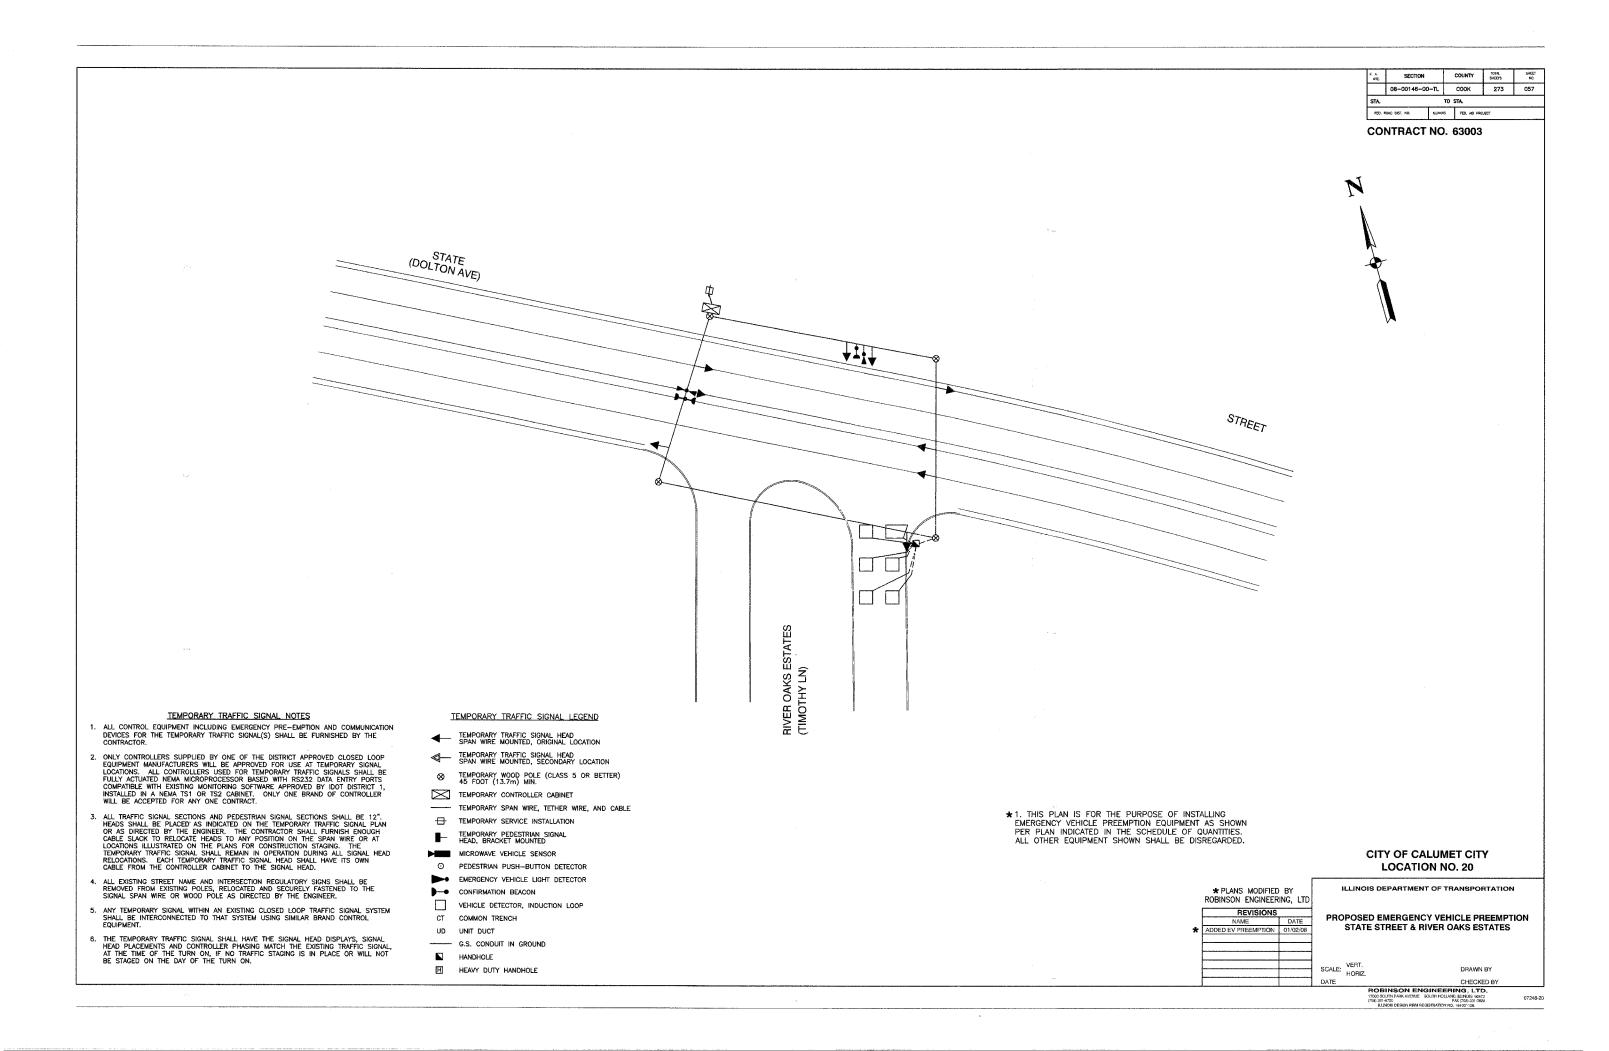


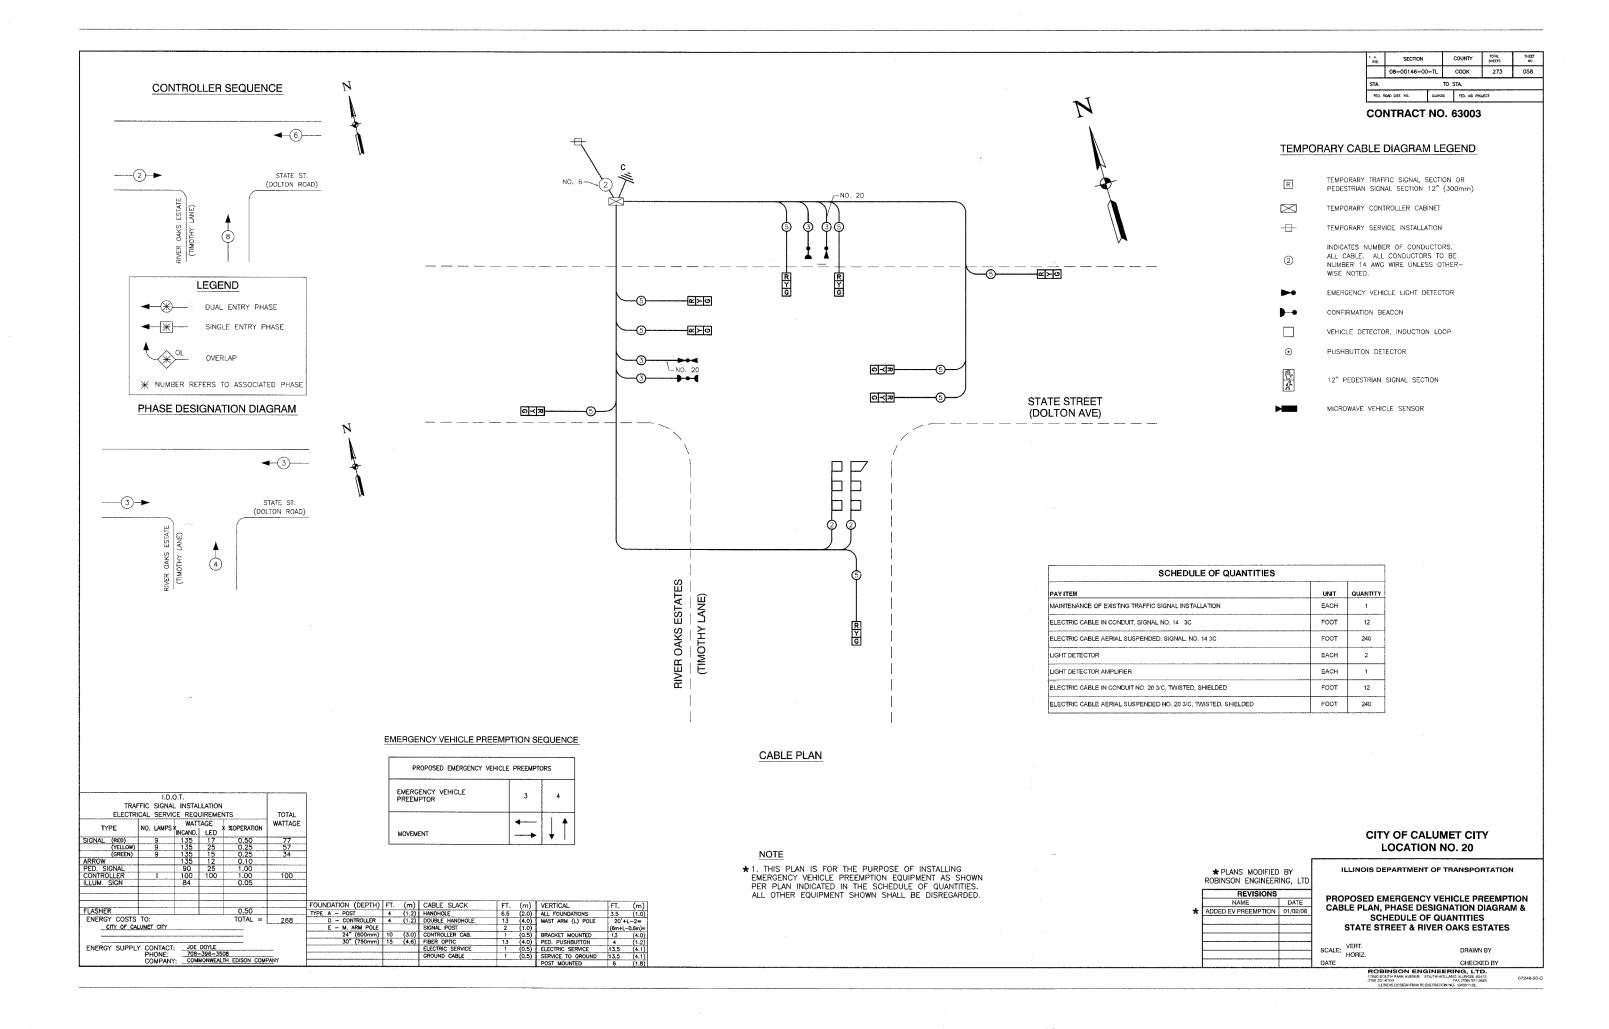


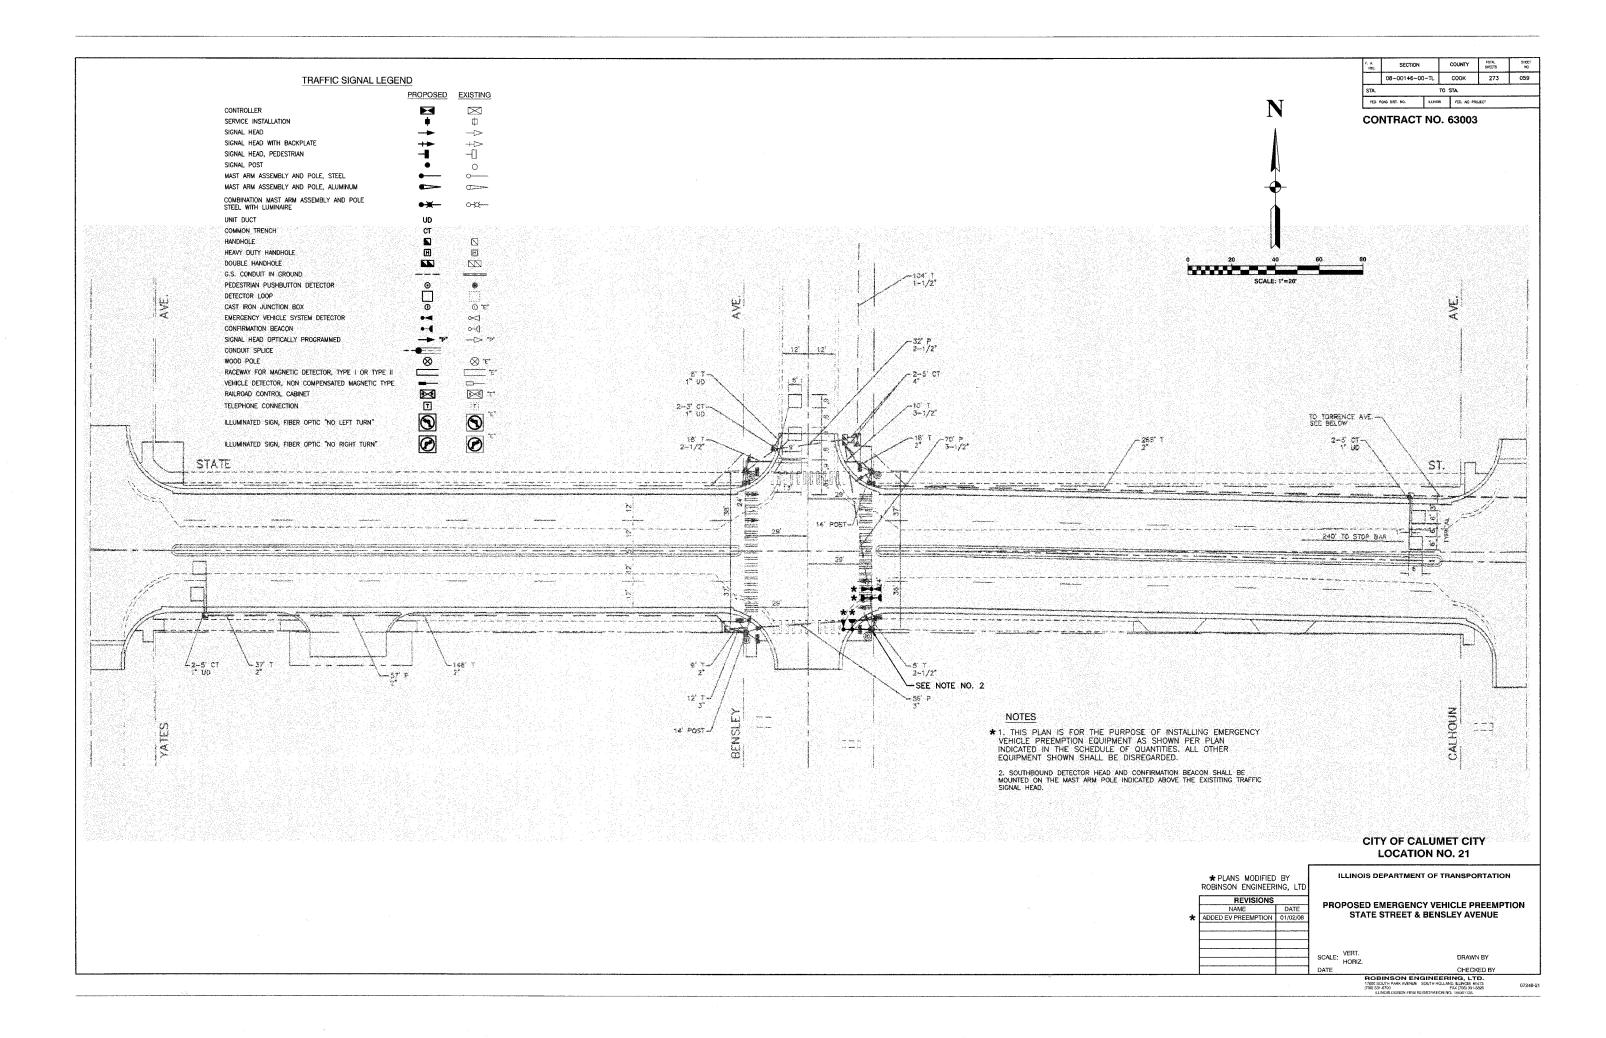

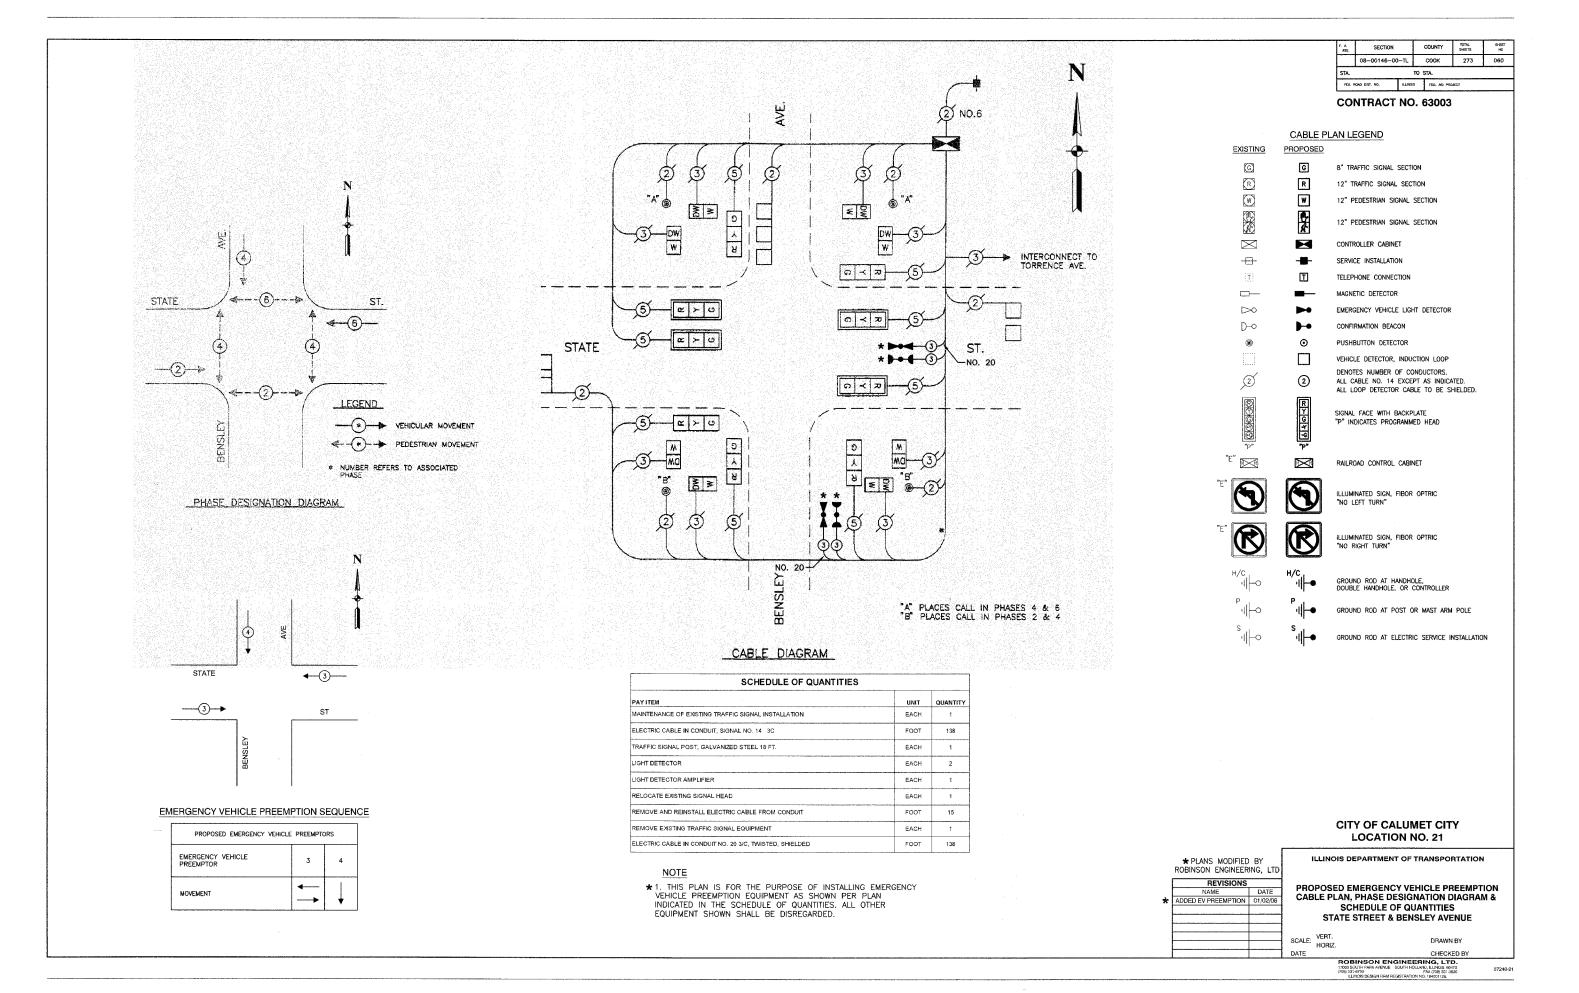


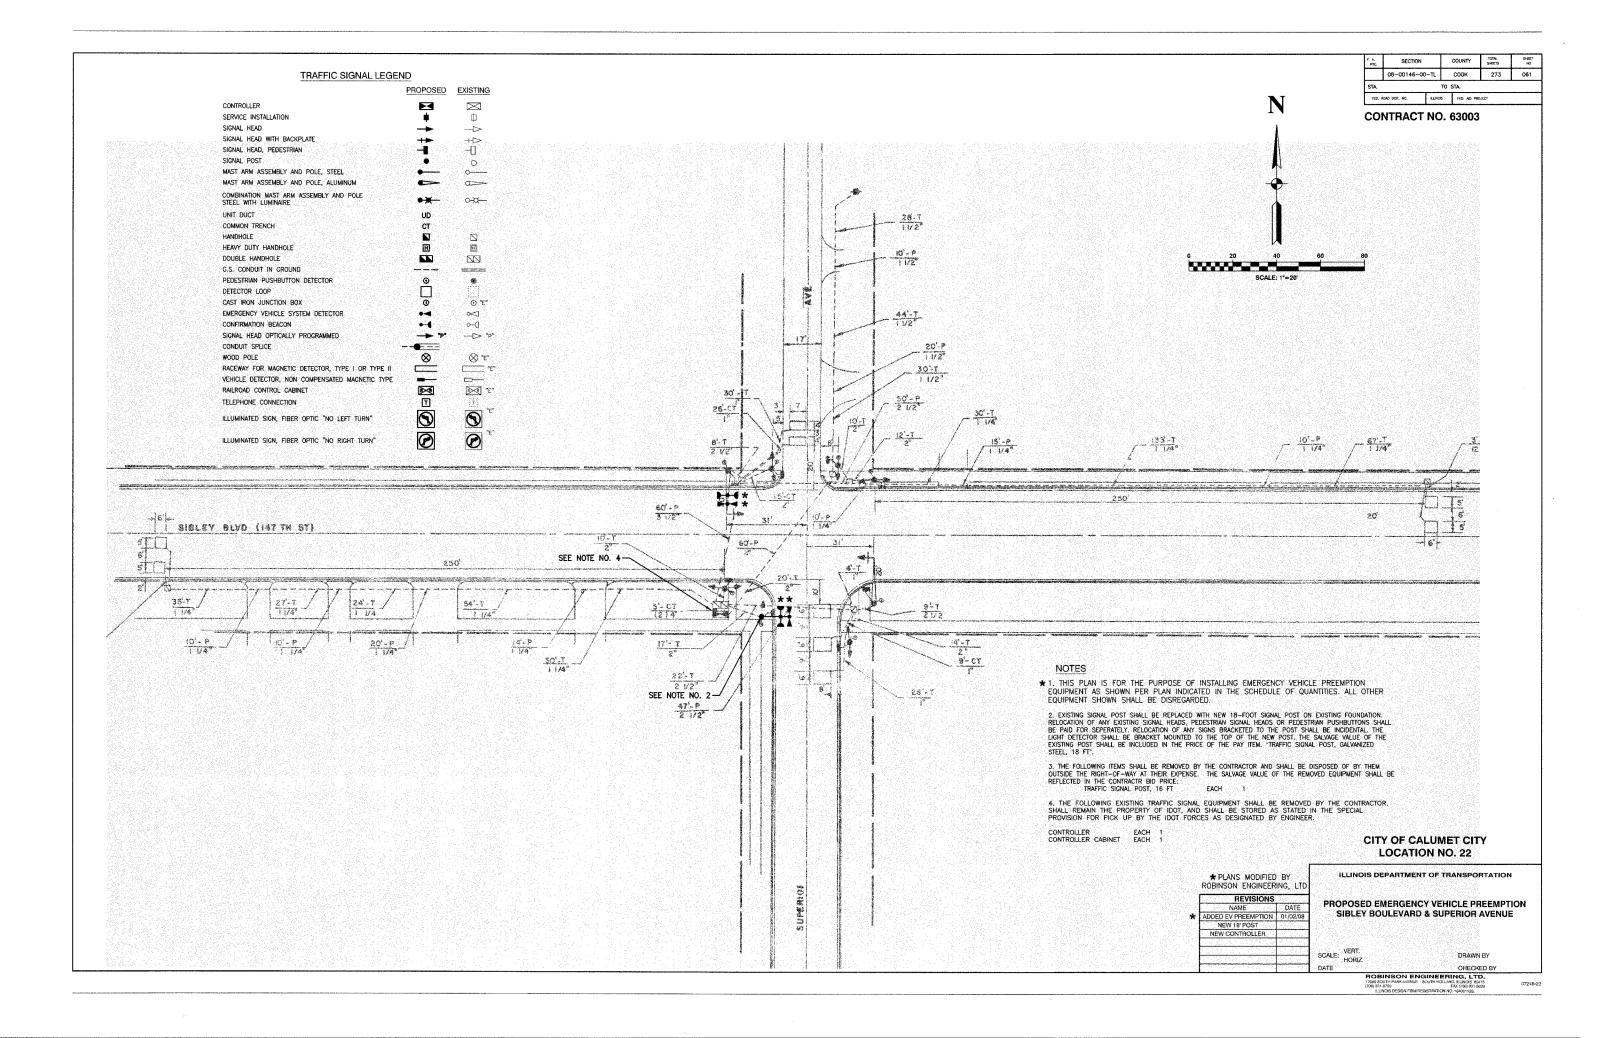

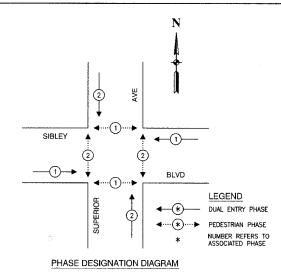

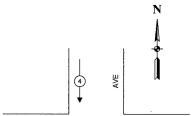

**←**③—

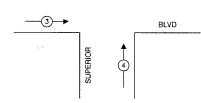


SIBLEY

# EMERGENCY VEHICLE PREEMPTION SEQUENCE

PROPOSED EMERGENCY VEHICLE	PREEMPTO	ORS
EMERGENCY VEHICLE PREEMPTOR	3	4
MOVEMENT	<b>←</b>	<b>↓</b> ↑

SCHEDULE OF QUANTITIES					
PAYITEM	UNIT	QUANTITY			
MAINTENANCE OF EXISTING TRAFFIC SIGNAL INSTALLATION	EACH	1			
FULL-ACTUATED CONTROLLER AND TYPE IV CABINET, SPECIAL	EACH	1			
ELECTRIC CABLE IN CONDUIT, SIGNAL NO. 14 3C	FOOT	177			
TRAFFIC SIGNAL POST, GALVANIZED STEEL 18 FT.	EACH .	1			
INDUCTIVE LOOP DETECTOR	EACH	5			
LIGHT DETECTOR	EACH	2			
LIGHT DETECTOR AMPLIFIER	EACH	1			
RELOCATE EXISTING SIGNAL HEAD	EACH	1			
RELOCATE EXISTING PEDESTRIAN SIGNAL HEAD	EACH	1			
RELOCATE EXISTING PEDESTRIAN PUSH-BUTTON	EACH	1			
REMOVE AND REINSTALL ELECTRIC CABLE FROM CONDUIT	FOOT	15			
REMOVE EXISTING TRAFFIC SIGNAL EQUIPMENT	EACH	1			
ELECTRIC CABLE IN CONDUIT NO. 20 3/C, TWISTED, SHIELDED	FOOT	177			
MODIFY EXISTING TYPE "D" FOUNDATION	EACH	1			

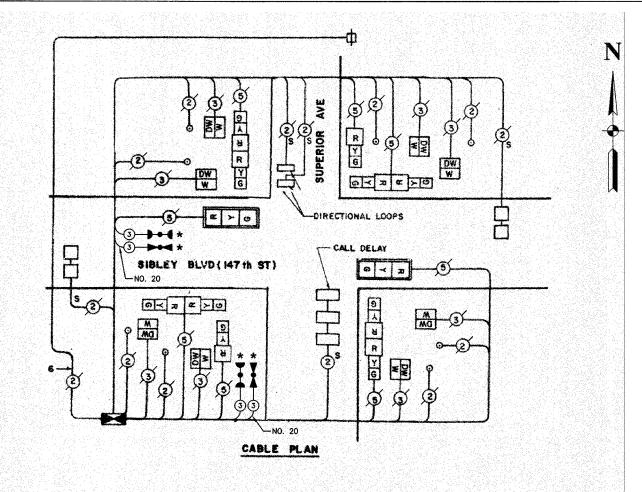

## SEQUENCE OF OPERATIONS

MOVEMENT	P		1	P IP		P —	-? •,		F
PHASE						•	7		1 %
INTERVAL	1	2	3 <b>A</b>	3B	4	5	6A	68	5
CHANGE TO				8	7	$\square$		Δ	*
SIBLEY BLVD(1471h ST) SIGNALS	G	G	Y	R	R	R	R	R	R
SUPERIOR AVE SIGNALS	R	R	R	R	G	G	Y	R	R
PED SIGNALS X-ING SUPERIOR AVE	¥	F.XX	DW	OW	DW	OW.	DW	DW	DARK
PED SIGNALS X-ING SIBLEY BLVD (147th ST)	DW	DW	DW	DW	w*	54**	DW	OW	DARK

- \* TO APPEAR ONLY UPON PUSHBUTTON ACTUATION
- \* \* FLASHING "DON'T WALK" IS TO TERMINATE AT THE COMPLETION OF PEDESTRIAN INTERVAL CL

F. A. RTE.	SECTION		COUNTY	SHEETS	SHEET NO
	08-00146-0	O-TL	соок	273	062
STA.			to sta.		
FED. 1	ROAD DIST. NO.	LUNO	FED. AID FR	OUECT	

#### CONTRACT NO. 63003

## CABLE PLAN LEGEND

EXISTING	PROPOSED	
<b>©</b>	G	8" TRAFFIC SIGNAL SECTION
R	R	12" TRAFFIC SIGNAL SECTION
W	W	12" PEDESTRIAN SIGNAL SECTION
	G. K	12" PEDESTRIAN SIGNAL SECTION
$\bowtie$		CONTROLLER CABINET
		SERVICE INSTALLATION
ŧΪŧ		TELEPHONE CONNECTION
<del></del>	-	MAGNETIC DETECTOR
$\triangleright \!$	<b>&gt;</b>	EMERGENCY VEHICLE LIGHT DETECTOR
D-0	•	CONFIRMATION BEACON
•	•	PUSHBUTTON DETECTOR
::		VEHICLE DETECTOR, INDUCTION LOOP
2	2	DENOTES NUMBER OF CONDUCTORS. ALL CABLE NO. 14 EXCEPT AS INDICATED. ALL LOOP DETECTOR CABLE TO BE SHIELDED.
<b>B0000</b>	<u> </u>	SIGNAL FACE WITH BACKPLATE "P" INDICATES PROGRAMMED HEAD





ILLUMINATED SIGN, FIBOR OPTRIC

RAILROAD CONTROL CABINET



"E"



ILLUMINATED SIGN, FIBOR OPTRIC "NO RIGHT TURN"





GROUND ROD AT HANDHOLE, DOUBLE HANDHOLE, OR CONTROLLER

GROUND ROD AT ELECTRIC SERVICE INSTALLATION

★ 1. THIS PLAN IS FOR THE PURPOSE OF INSTALLING EMERGENCY VEHICLE PREEMPTION EQUIPMENT AS SHOWN PER PLAN INDICATED IN THE SCHEDULE OF QUANTITIES. ALL OTHER EQUIPMENT SHOWN SHALL BE DISREGARDED.

#### CITY OF CALUMET CITY **LOCATION NO. 22**

\* PLANS MODIFIED BY ROBINSON ENGINEERING, LTD


NEW 18' POST NEW CONTROLLER


ILLINOIS DEPARTMENT OF TRANSPORTATION


PROPOSED EMERGENCY VEHICLE PREEMPTION **CABLE PLAN, PHASE DESIGNATION DIAGRAM &** ADDED EV PREEMPTION 01/02/08 SCHEDULE OF QUANTITIES SIBLEY BOULEVARD & SUPERIOR AVENUE


SCALE: VERT. HORIZ.


CHECKED BY

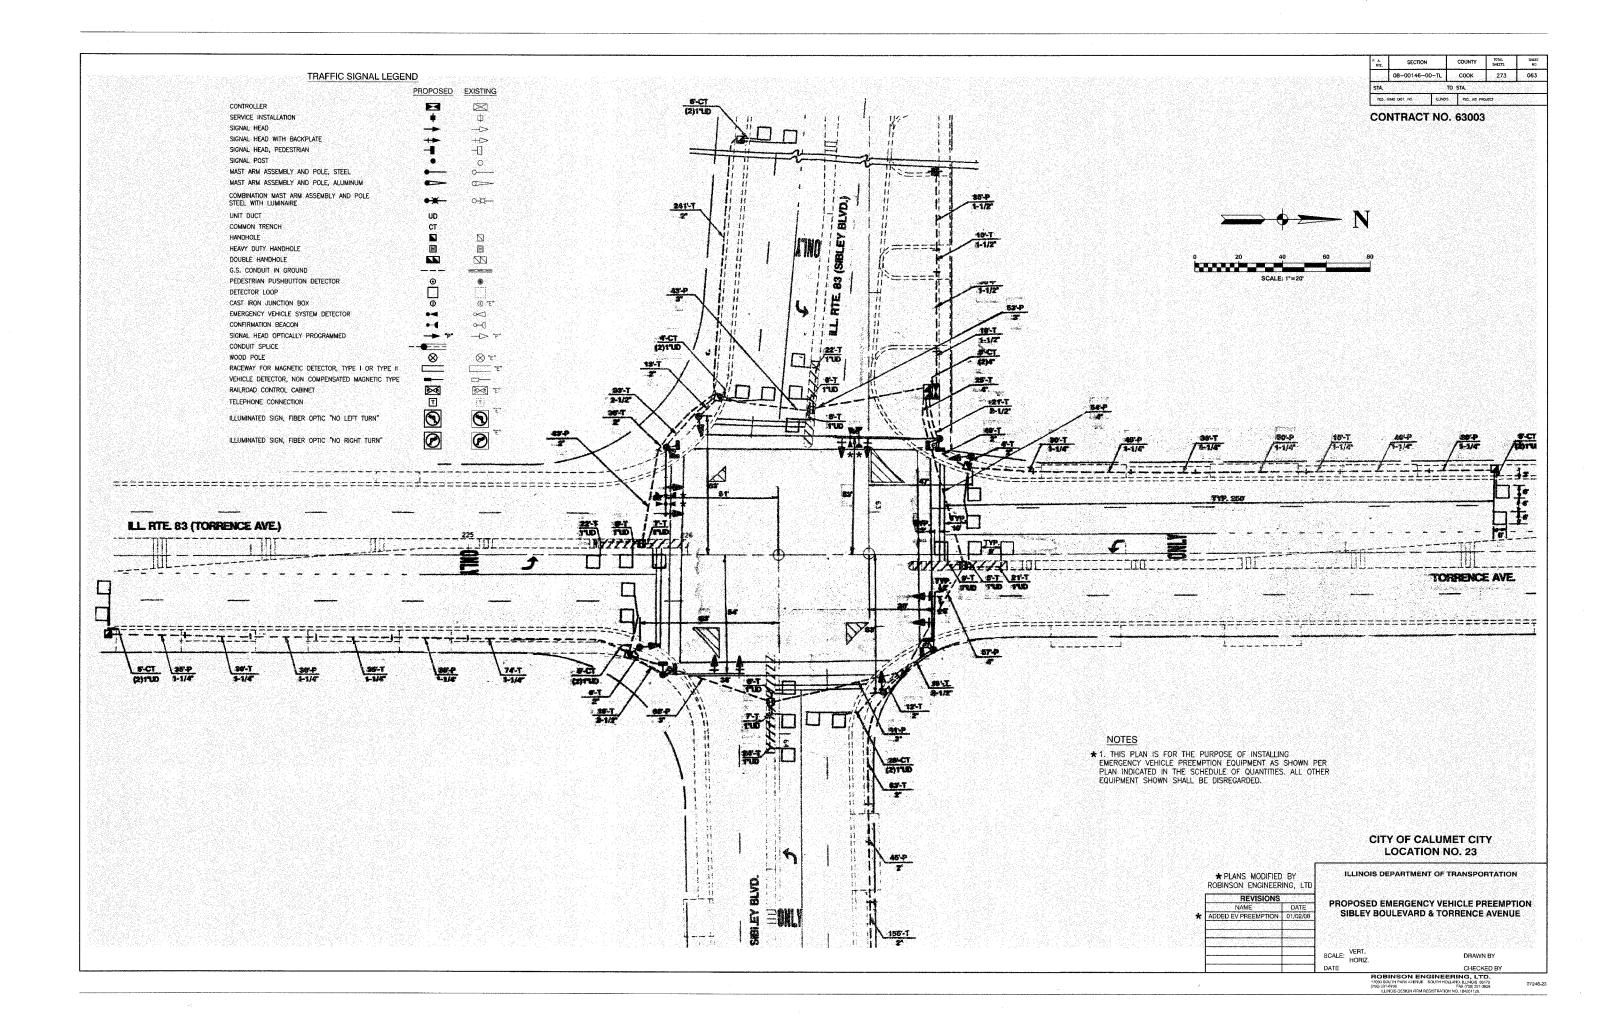

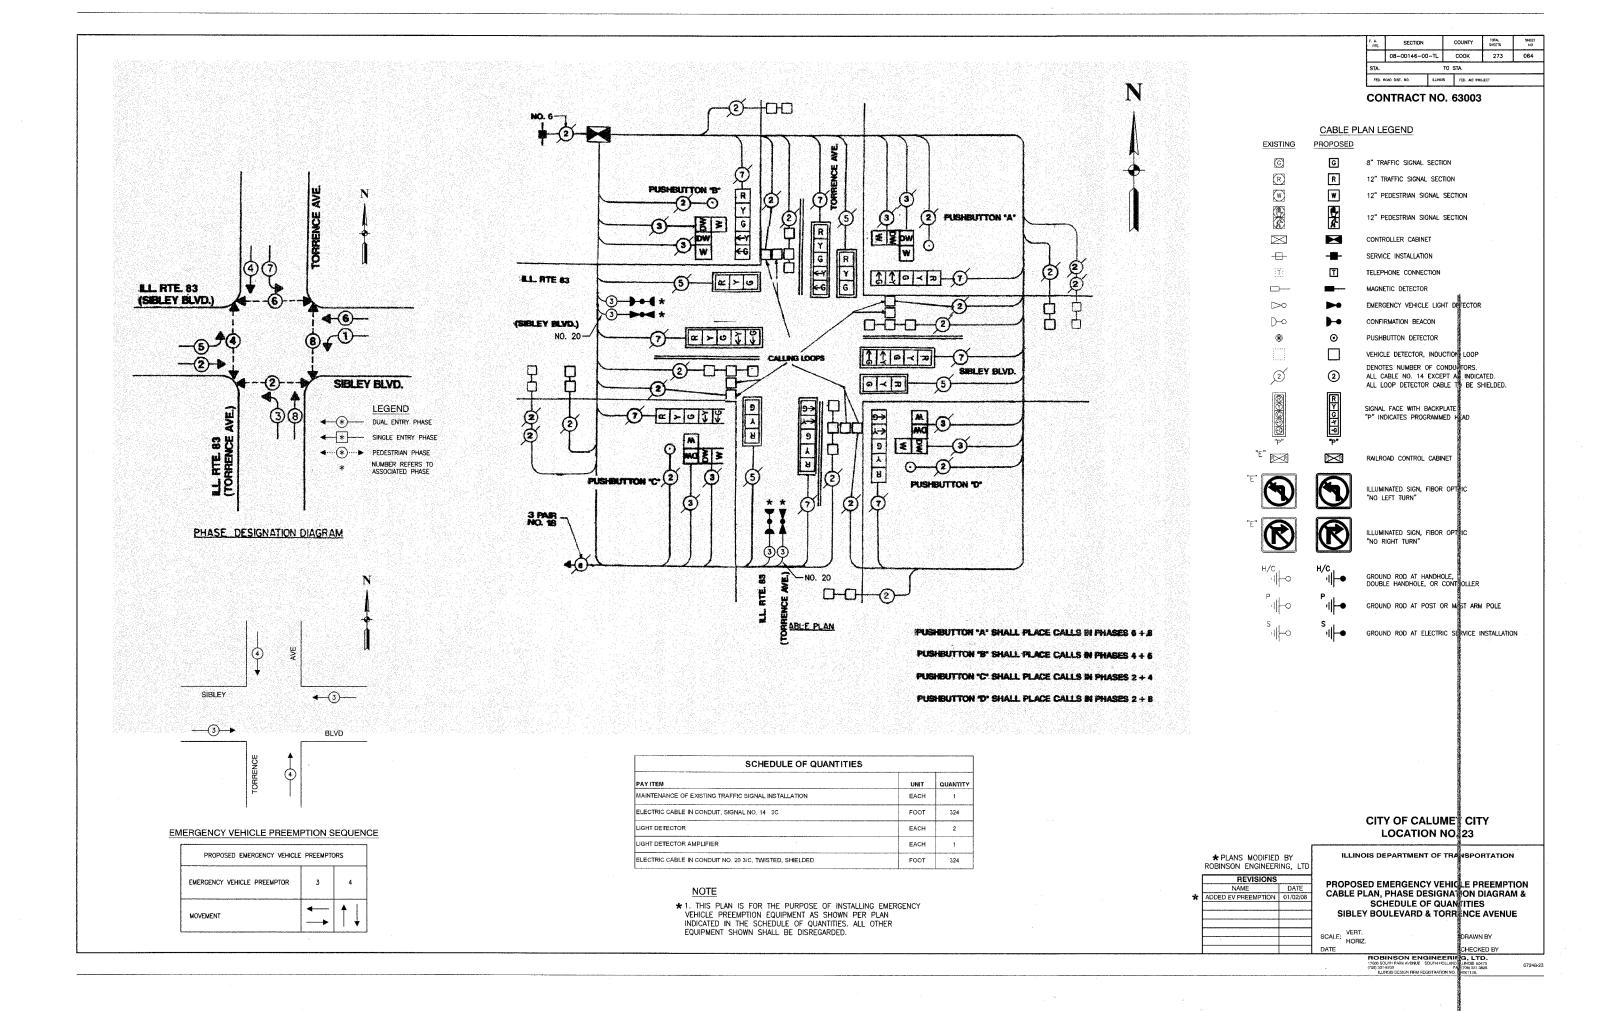

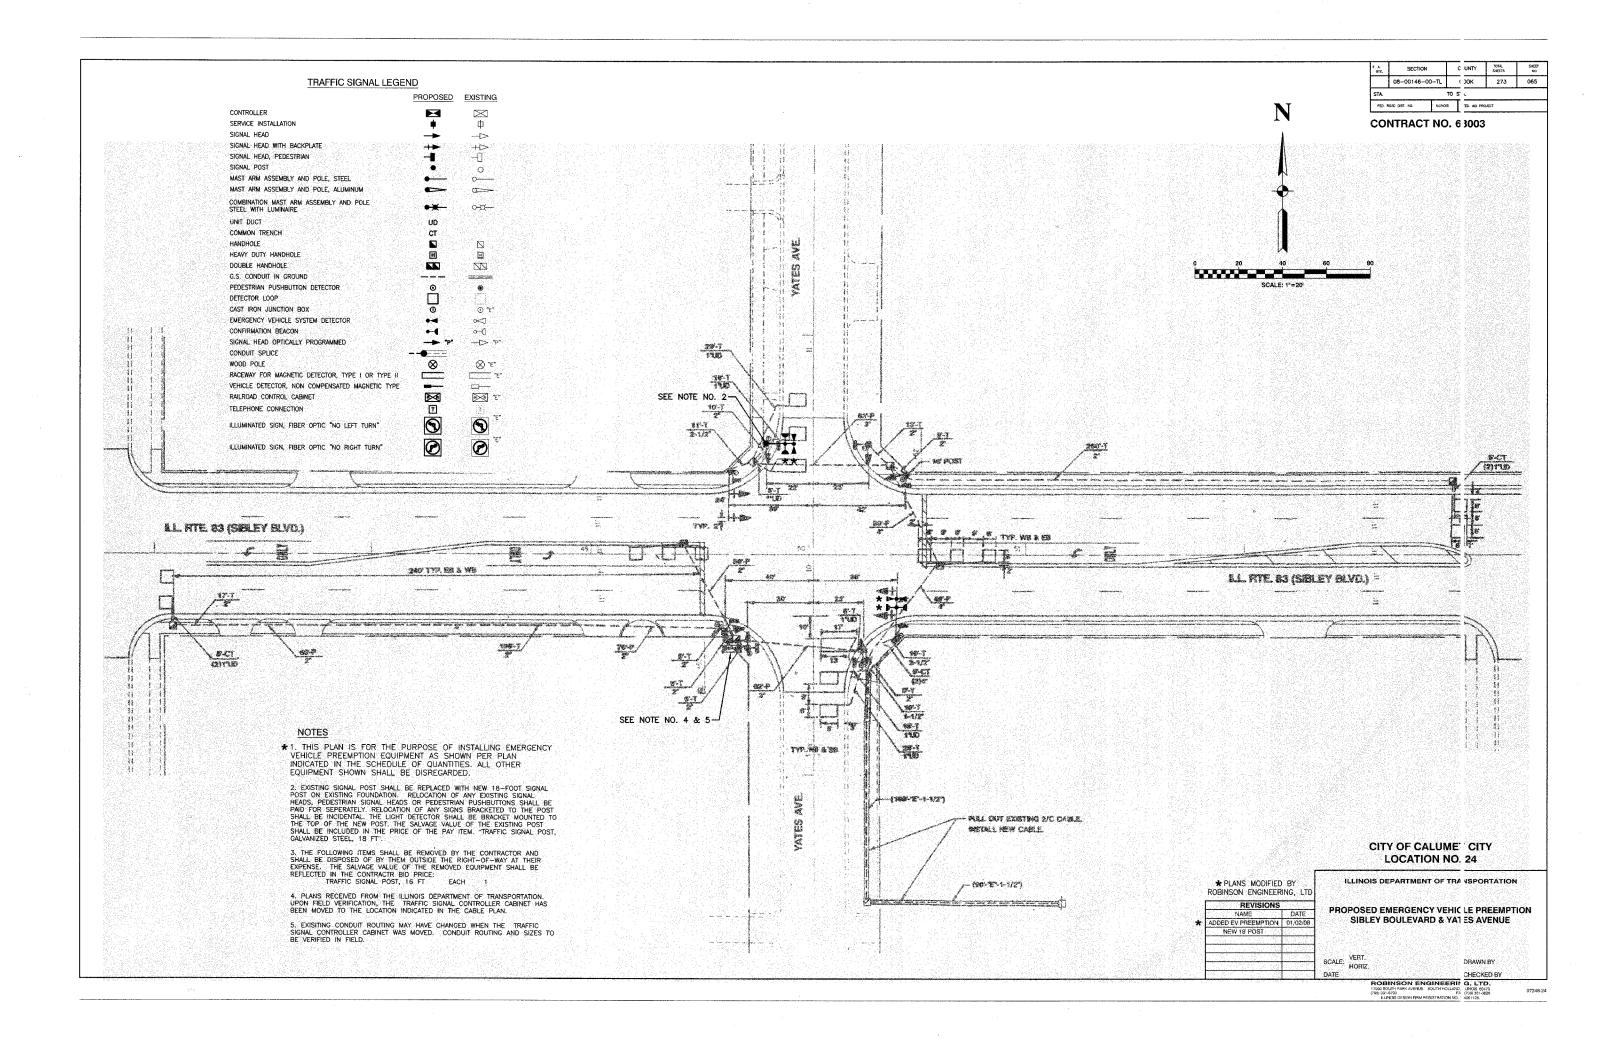


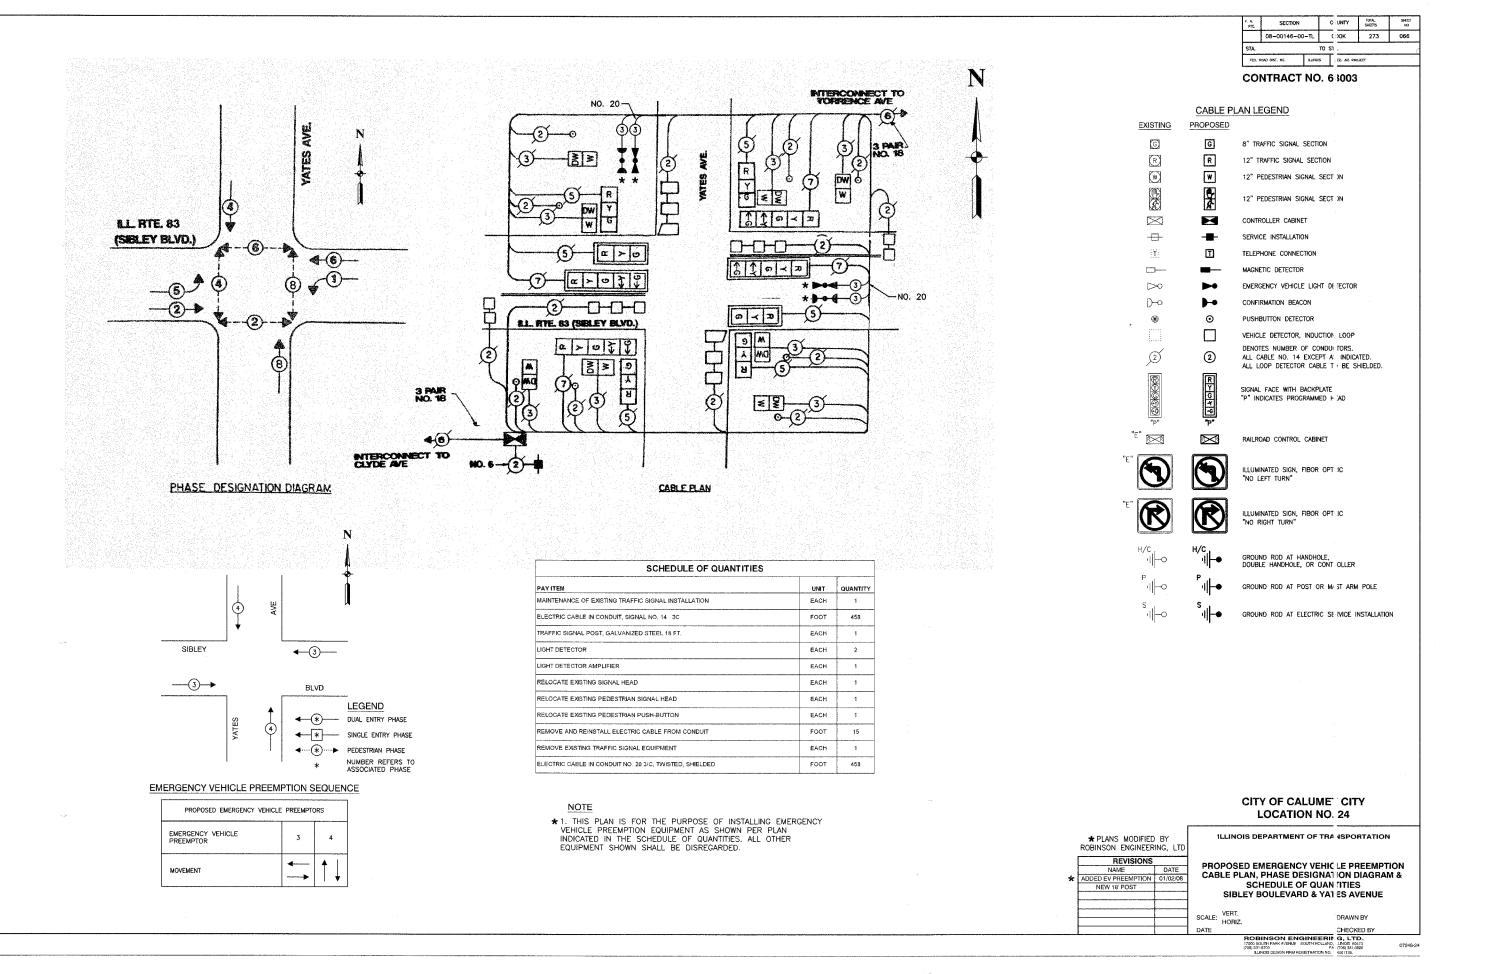

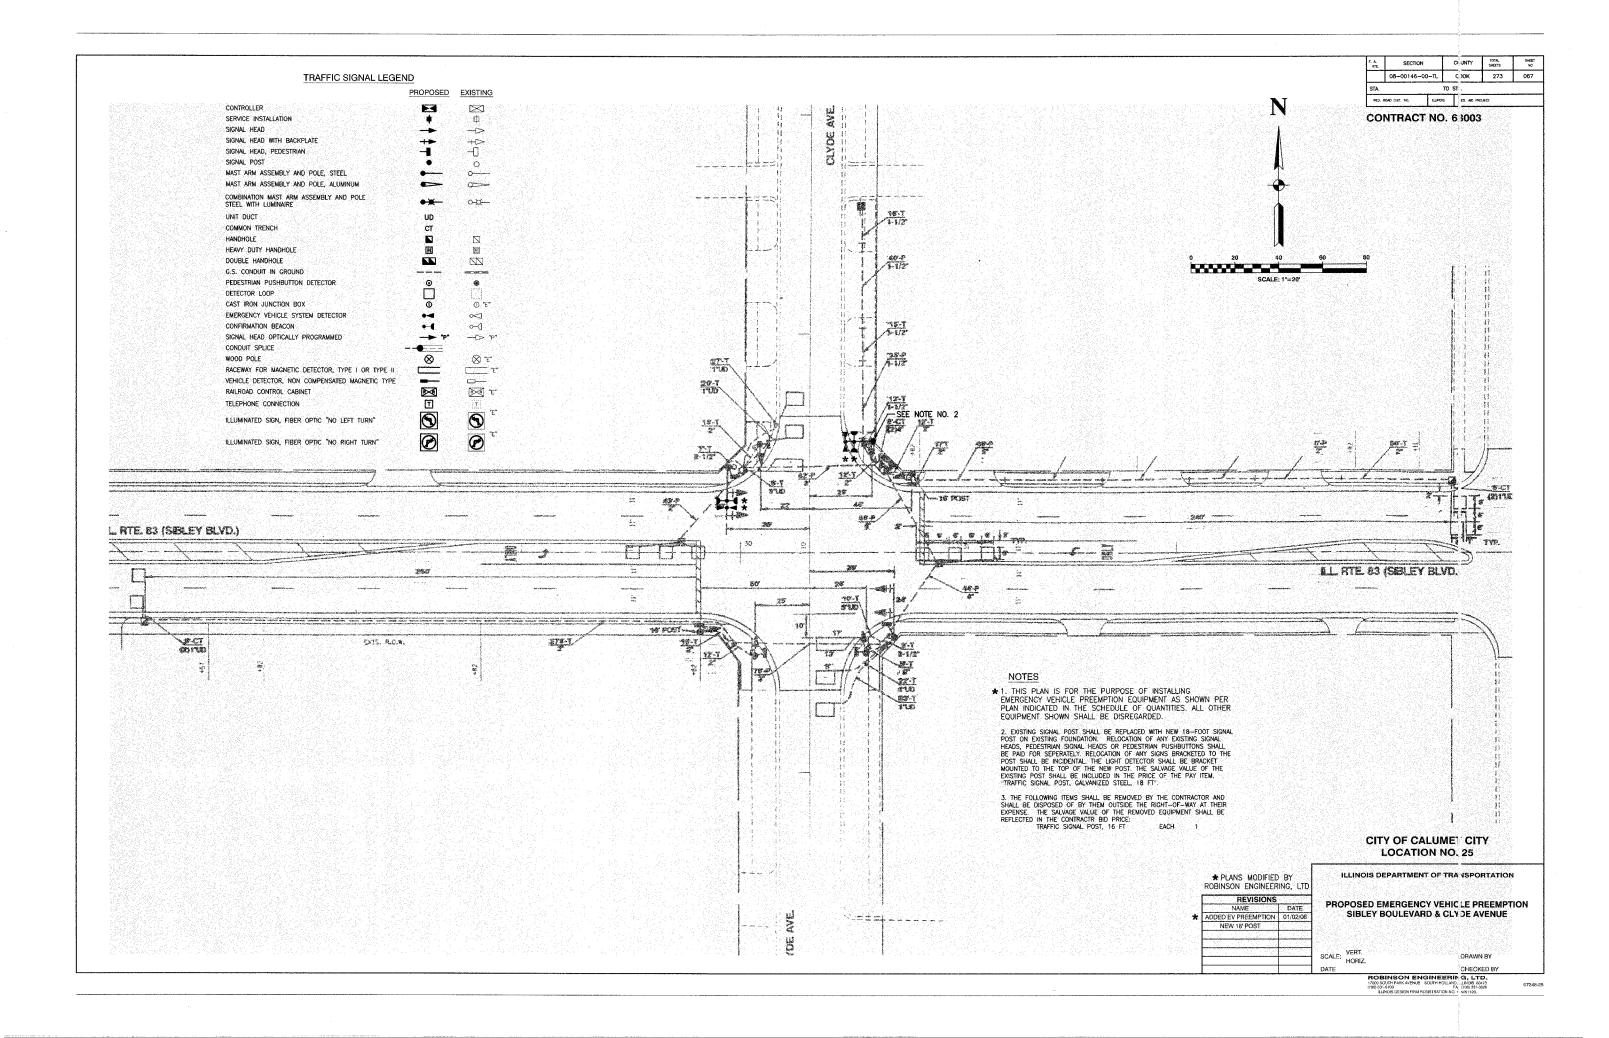




REFERRING TO STANDARD 23934, THE VEHICULAR AND PEDESTRIAN PHASES USED ARE DESIGNATED BELOW.

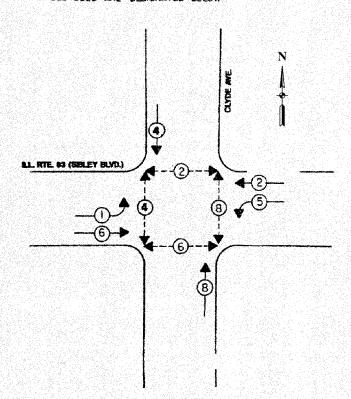


PHASE DESIGNATION DIAGRAM

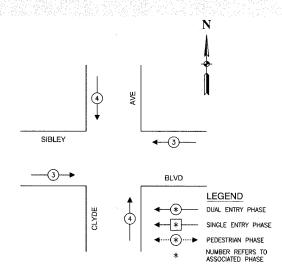

### **EMERGENCY VEHICLE PREEMPTION SEQUENCE**

PROPOSED EMERGENCY VEHICLE	PREEMPTO	ORS
EMERGENCY VEHICLE PREEMPTOR	3	4
MOVEMENT	<b>←</b>	1

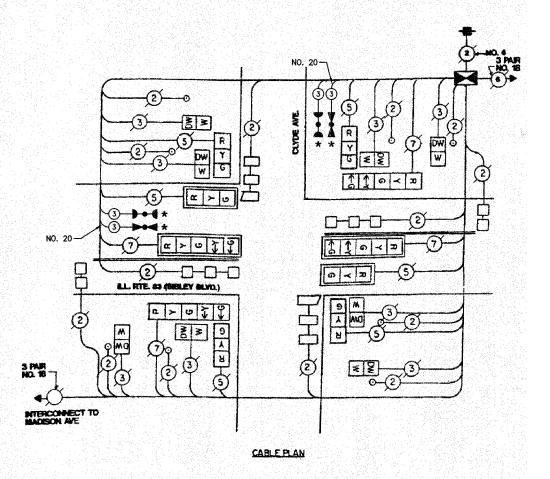

SCHEDULE OF QUANTITIE	S	
PAYITEM	TINU	QUANTITY
MAINTENANCE OF EXISTING TRAFFIC SIGNAL INSTALLATION	EACH	1
ELECTRIC CABLE IN CONDUIT, SIGNAL NO. 14 3C	FOOT	204
TRAFFIC SIGNAL POST, GALVANIZED STEEL 18 FT.	EACH	1
LIGHT DETECTOR	EACH	2
LIGHT DETECTOR AMPLIFIER	EACH	1
RELOCATE EXISTING SIGNAL HEAD	EACH	1
RELOCATE EXISTING PEDESTRIAN SIGNAL HEAD	EACH	1
RELOCATE EXISTING PEDESTRIAN PUSH-BUTTON	EACH	1
REMOVE AND REINSTALL ELECTRIC CABLE FROM CONDUIT	FOOT	15
REMOVE EXISTING TRAFFIC SIGNAL EQUIPMENT	EACH	1
ELECTRIC CABLE IN CONDUIT NO. 20 3/C, TWISTED, SHIELDED	FOOT	204

## NOTE

★ 1. THIS PLAN IS FOR THE PURPOSE OF INSTALLING EMERGENCY VEHICLE PREEMPTION EQUIPMENT AS SHOWN PER PLAN INDICATED IN THE SCHEDULE OF QUANTITIES. ALL OTHER EQUIPMENT SHOWN SHALL BE DISREGARDED.

F. A. RTE.	SECTION		c	UNTY	TOTAL SHEETS	SHEET NO		
	080014600	-TL	,	юк	273	068		
STA.			TO S					
FED. F	IOAD DIST. NO.	ID DIST. NO. LUNCIS			ED. AID PROJECT			

#### CONTRACT NO. 63003

12" PEDESTRIAN SIGNAL SECTION

EMERGENCY VEHICLE LIGHT DEFECTOR

CONTROLLER CABINET

SERVICE INSTALLATION

MAGNETIC DETECTOR

CONFIRMATION BEACON

TELEPHONE CONNECTION

# CABLE PLAN LEGEND

EXISTING PROPOSED G R W

8" TRAFFIC SIGNAL SECTION 12" TRAFFIC SIGNAL SECTION 12" PEDESTRIAN SIGNAL SECTION

 $\boxtimes$  $\Box$ 

(C)

R

W

0-0

; Ţ: I \_\_  $\triangleright$ 

PUSHBUTTON DETECTOR VEHICLE DETECTOR, INDUCTION LOOP DENOTES NUMBER OF CONDUCTORS. ALL CABLE NO. 14 EXCEPT AT INDICATED.
ALL LOOP DETECTOR CABLE TO BE SHIELDED.

2 · 00000

SIGNAL FACE WITH BACKPLATE "P" INDICATES PROGRAMMED H AD

 $\triangleright \triangleleft$ RAILROAD CONTROL CABINET

ILLUMINATED SIGN, FIBOR OPTRIC

"E" 🖂

ILLUMINATED SIGN, FIBOR OPTRIC

H/C 1110

GROUND ROD AT HANDHOLE, DOUBLE HANDHOLE, OR CONTROLLER

11-0

GROUND ROD AT ELECTRIC SERVICE INSTALLATION

GROUND ROD AT POST OR MAST ARM POLE


CITY OF CALUMET CITY **LOCATION NO. 25** 


ILLINOIS DEPARTMENT OF TRANSPORTATION


\* PLANS MODIFIED BY ROBINSON ENGINEERING, LTD


PROPOSED EMERGENCY VEHICLE PREEMPTION CABLE PLAN, PHASE DESIGNATION DIAGRAM & SCHEDULE OF QUANTITIES ADDED EV PREEMPTION 01/02/08 NEW 18' POST SIBLEY BOULEVARD & CLYDE AVENUE


CHECKED BY

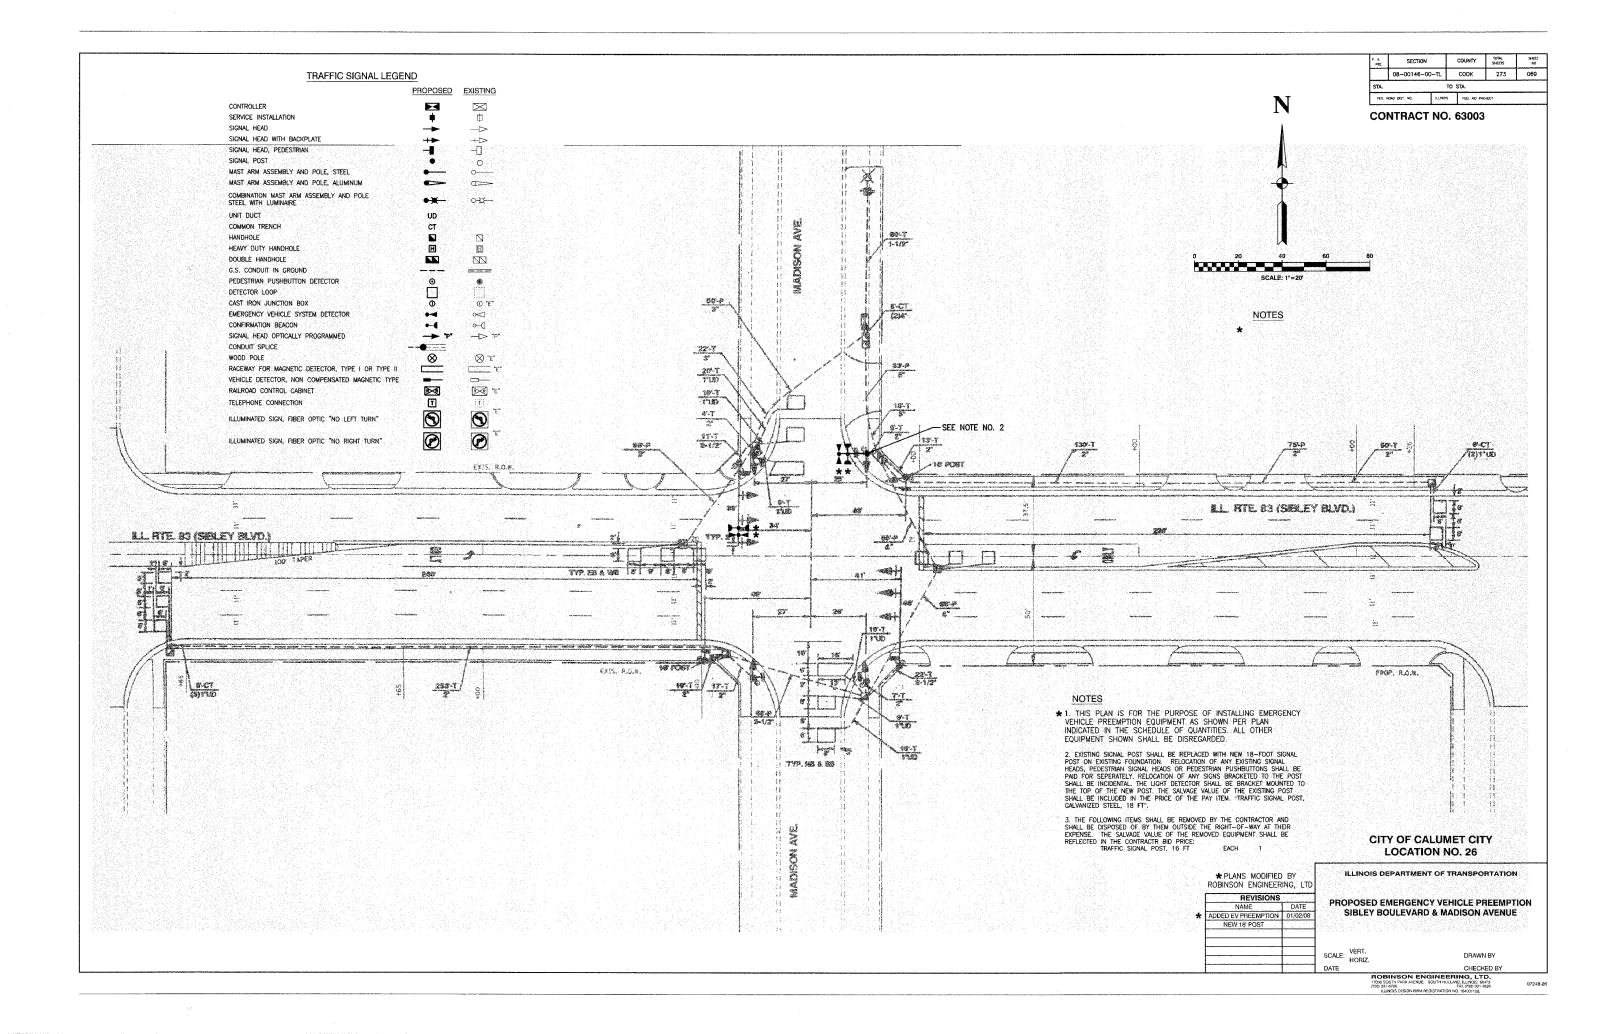


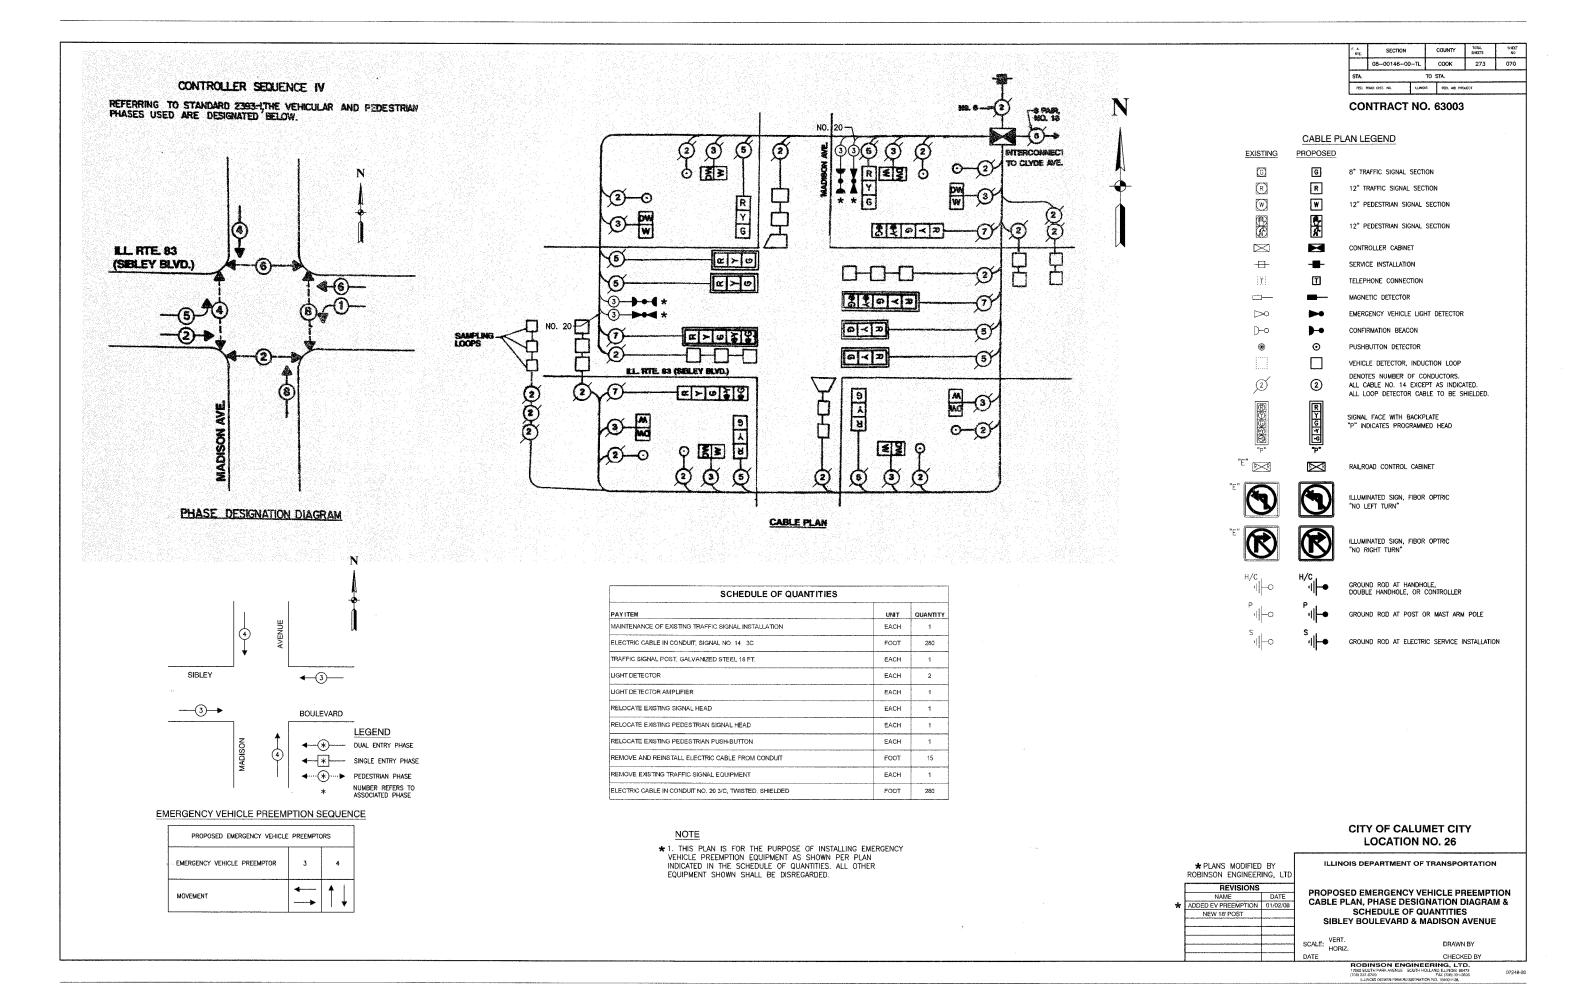

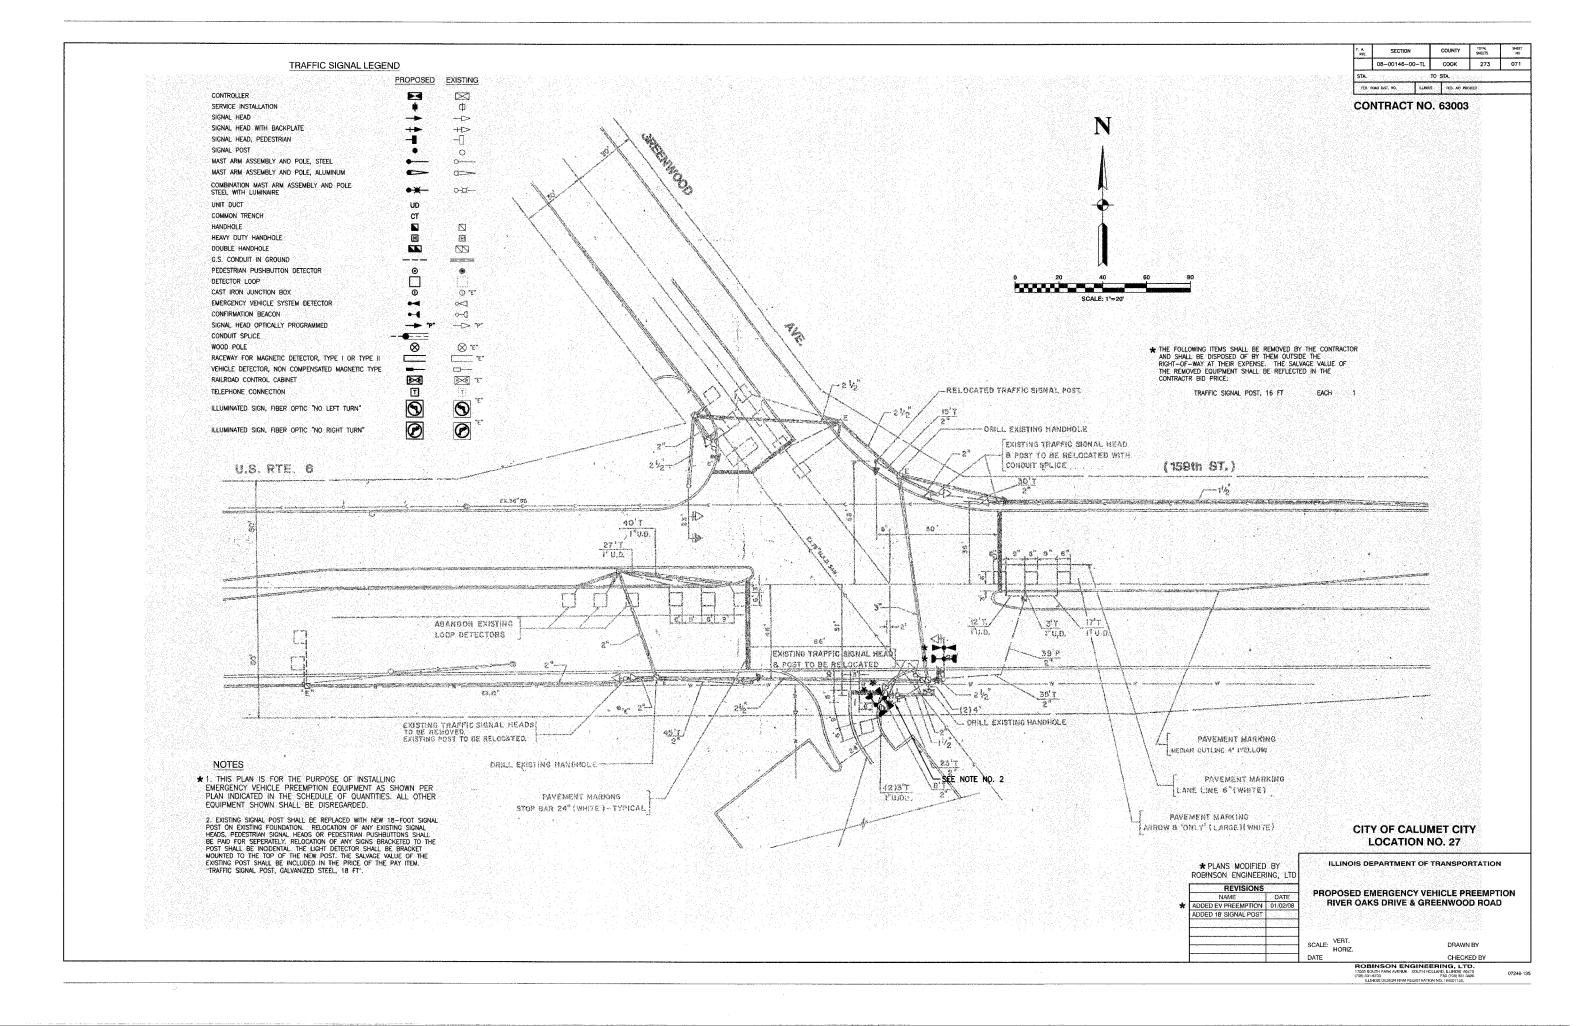

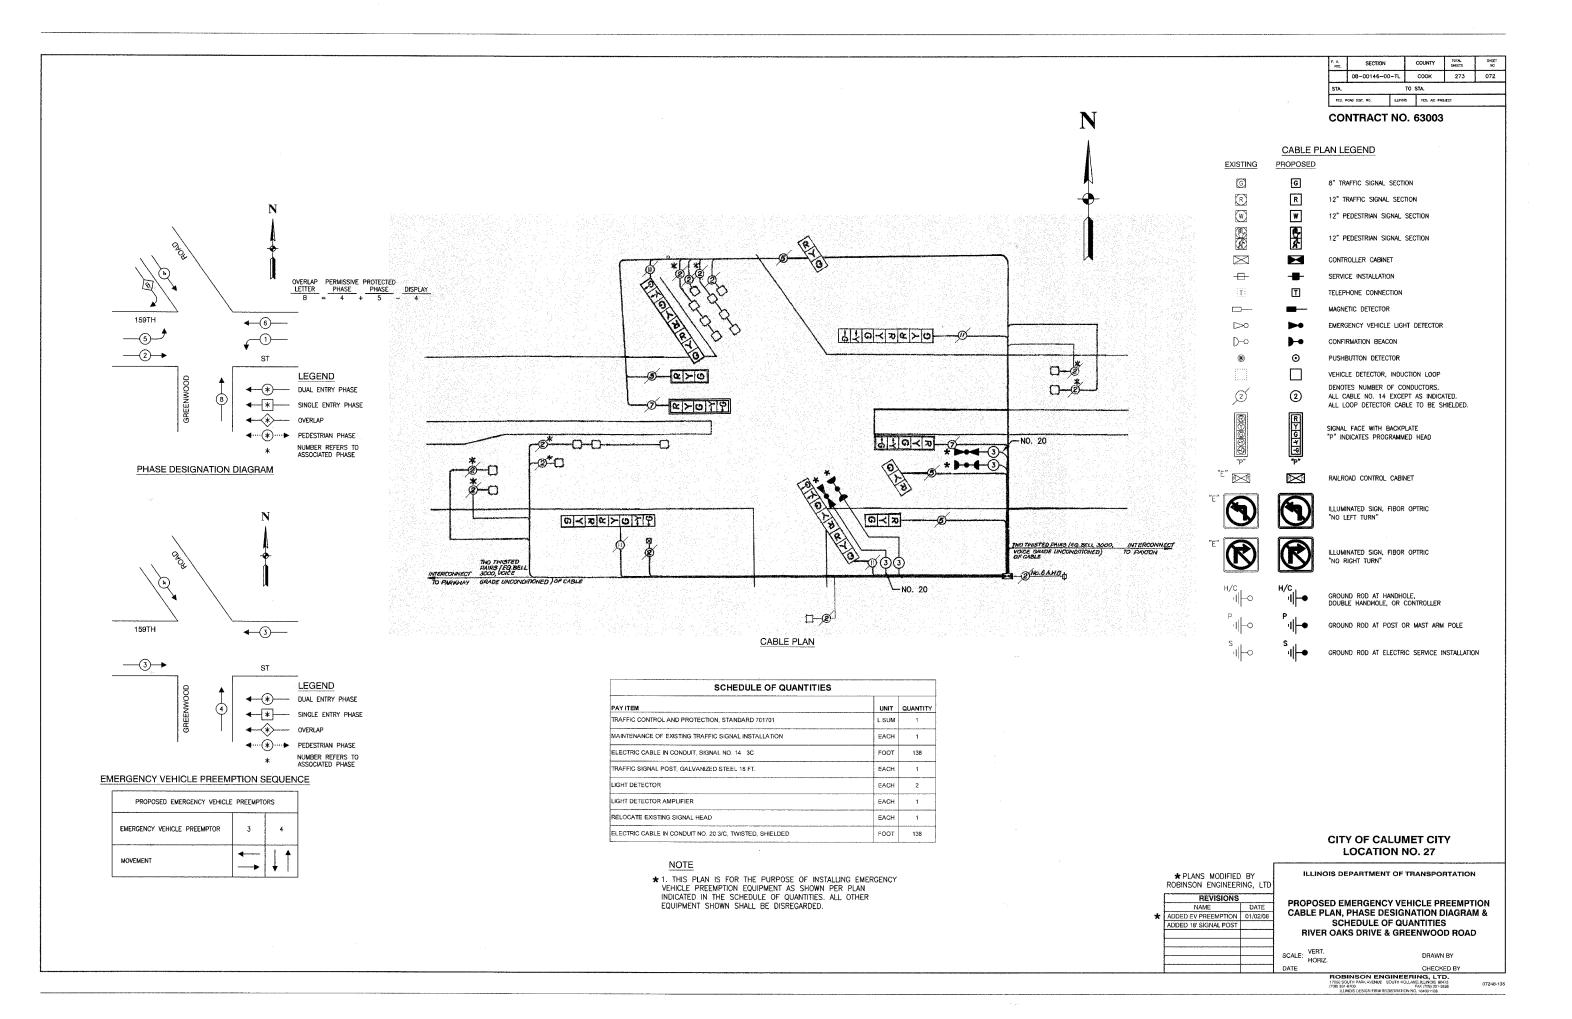

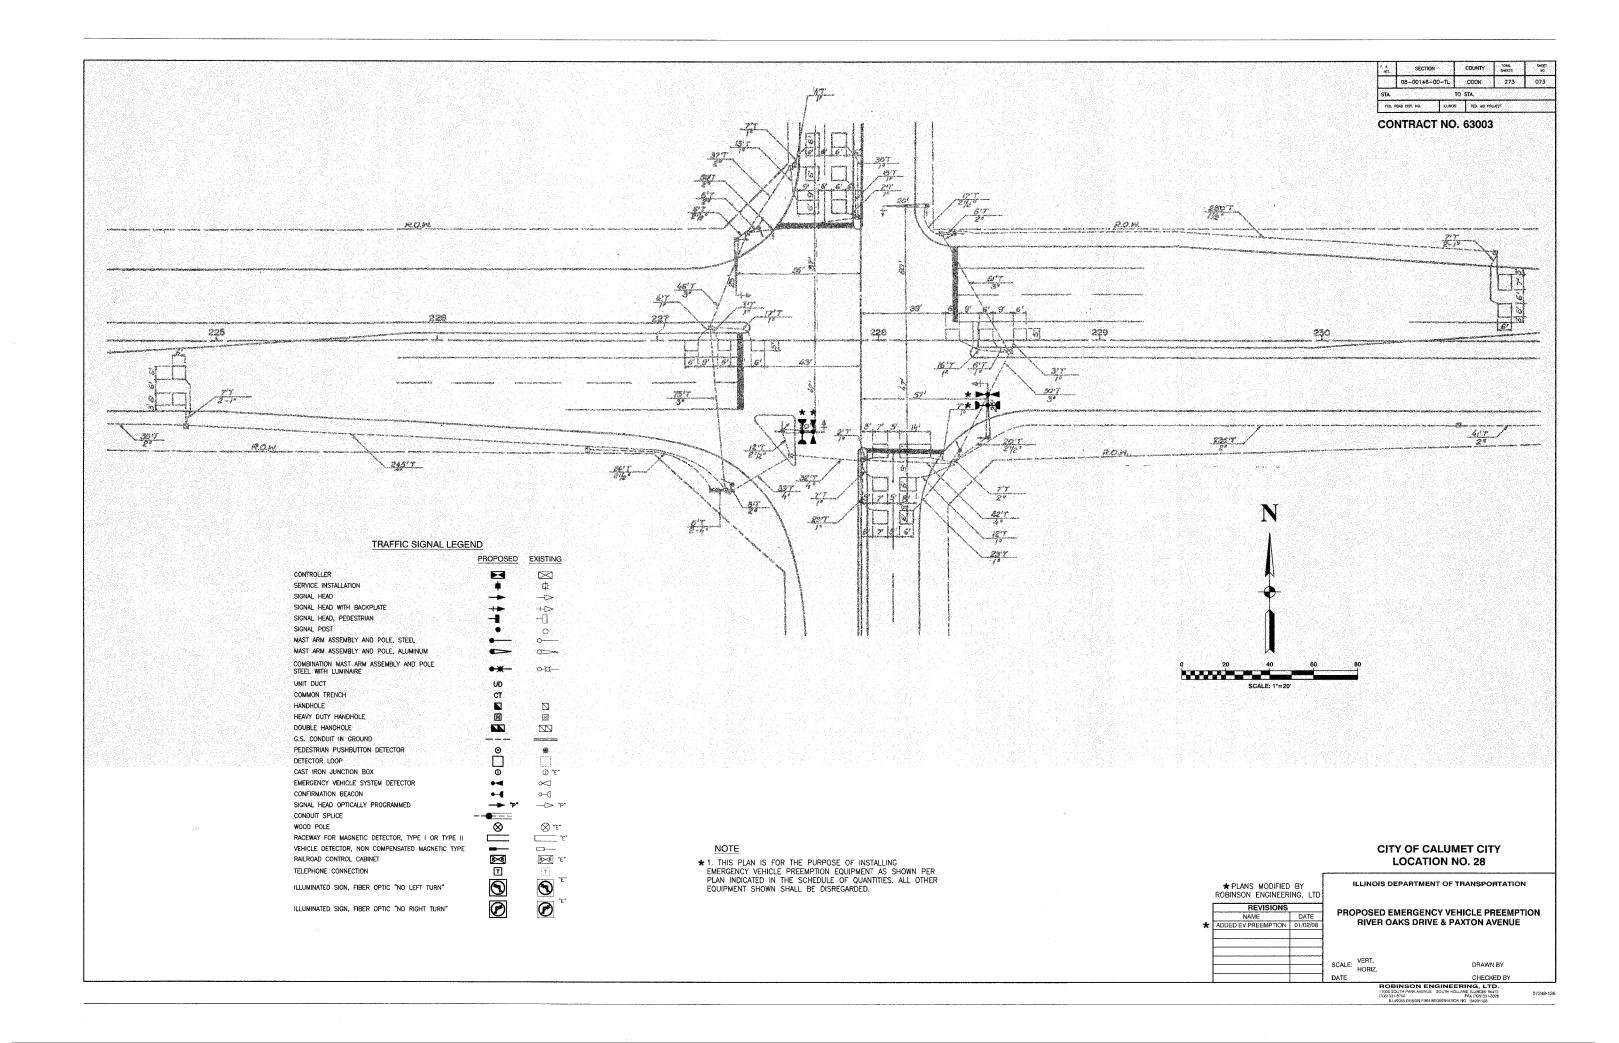

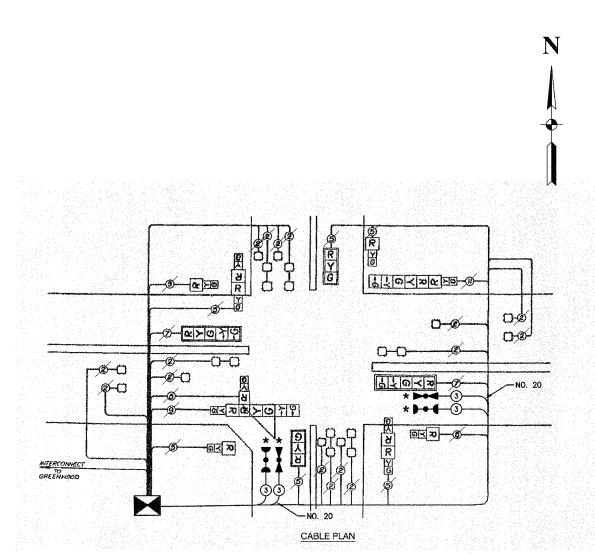

SCHEDULE OF QUANTITIES					
PAYITEM	UNIT	QUANTITY			
MAINTENANCE OF EXISTING TRAFFIC SIGNAL INSTALLATION	EACH	1			
ELECTRIC ÇABLE IN CONDUIT, SIGNAL NO. 14 3C	FOOT	328			
LIGHT DETECTOR	EACH	2			
LIGHT DETECTOR AMPLIFIER	EACH	1			
ELECTRIC CABLE IN CONDUITING, 20 3/C, TWISTED, SHIELDED	FOOT	328			

### NOTE

★ 1. THIS PLAN IS FOR THE PURPOSE OF INSTALLING EMERGENCY VEHICLE PREEMPTION EQUIPMENT AS SHOWN PER PLAN INDICATED IN THE SCHEDULE OF QUANTITIES. ALL OTHER EQUIPMENT SHOWN SHALL BE DISREGARDED.

F. A. RTE.	SECTION	COUNTY	TOTAL SHEETS	SHEET
	08-00146-00-TL	соок	273	074
STA.		TO STA.		

## CONTRACT NO. 63003

8" TRAFFIC SIGNAL SECTION

CABLE PLAN	LEGEND
PROPOSED	

-

Ť

 $\Box$ 

 $\triangleright$ 

D-0

2

12" TRAFFIC SIGNAL SECTION
12" PEDESTRIAN SIGNAL SECTION

12" PEDESTRIAN SIGNAL SECTION

CONTROLLER CABINET

CONTROLLER CABINET

SERVICE INSTALLATION

TELEPHONE CONNECTION

MAGNETIC DETECTOR

EMERGENCY VEHICLE LIGHT DETECTOR

CONFIRMATION BEACON

PUSHBUTTON DETECTOR

PUSHBUTTON DETECTOR
 VEHICLE DETECTOR, INDUCTION LOOP

DENOTES NUMBER OF CONDUCTORS.

ALL CABLE NO. 14 EXCEPT AS INDICATED.

ALL LOOP DETECTOR CABLE TO BE SHIELDED.

SIGNAL FACE WITH BACKPLATE

"P" INDICATES PROGRAMMED HEAD

"Y"



9

 $\triangleright\!\!<\!\!<$ 

ILLUMINATED SIGN, FIBOR OPTRIC
"NO LEFT TURN"

RAILROAD CONTROL CABINET

"E"

**R** 

ILLUMINATED SIGN, FIBOR OPTRIC "NO RIGHT TURN"

H/C -||-0

H/C -||**|**-•

GROUND ROD AT HANDHOLE, DOUBLE HANDHOLE, OR CONTROLLER

GROUND ROD AT POST OR MAST ARM POLE

°...||-•

GROUND ROD AT ELECTRIC SERVICE INSTALLATION

# CITY OF CALUMET CITY LOCATION NO. 28

\* PLANS MODIFIED BY ROBINSON ENGINEERING, LTD

\*\*REVISIONS\*\*

NAME DATE

ADDED BY PREEMPTION 01/02/08

ILLINOIS DEPARTMENT OF TRANSPORTATION


PROPOSED EMERGENCY VEHICLE PREEMPTION CABLE PLAN, PHASE DESIGNATION DIAGRAM & SCHEDULE OF QUANTITIES RIVER OAKS DRIVE & PAXTON AVENUE


SCALE: VERT.

DRAWN BY CHECKED BY

POBINSON ENGINEERING, LTD.
17000 SOUTH PARK AVENUE SOUTH HOLLAND ILLINOIS 60473
17081 331-6700 FAX (708) 331-3606

07248-13

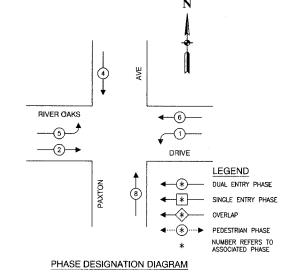


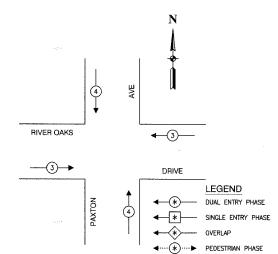


NUMBER REFERS TO ASSOCIATED PHASE

## EMERGENCY VEHICLE PREEMPTION SEQUENCE

PROPOSED EMERGENCY VEHICLE	PREEMPTO	ORS
EMERGENCY VEHICLE PREEMPTOR	3	4
MOVEMENT	<b>←</b>	<b>1</b>

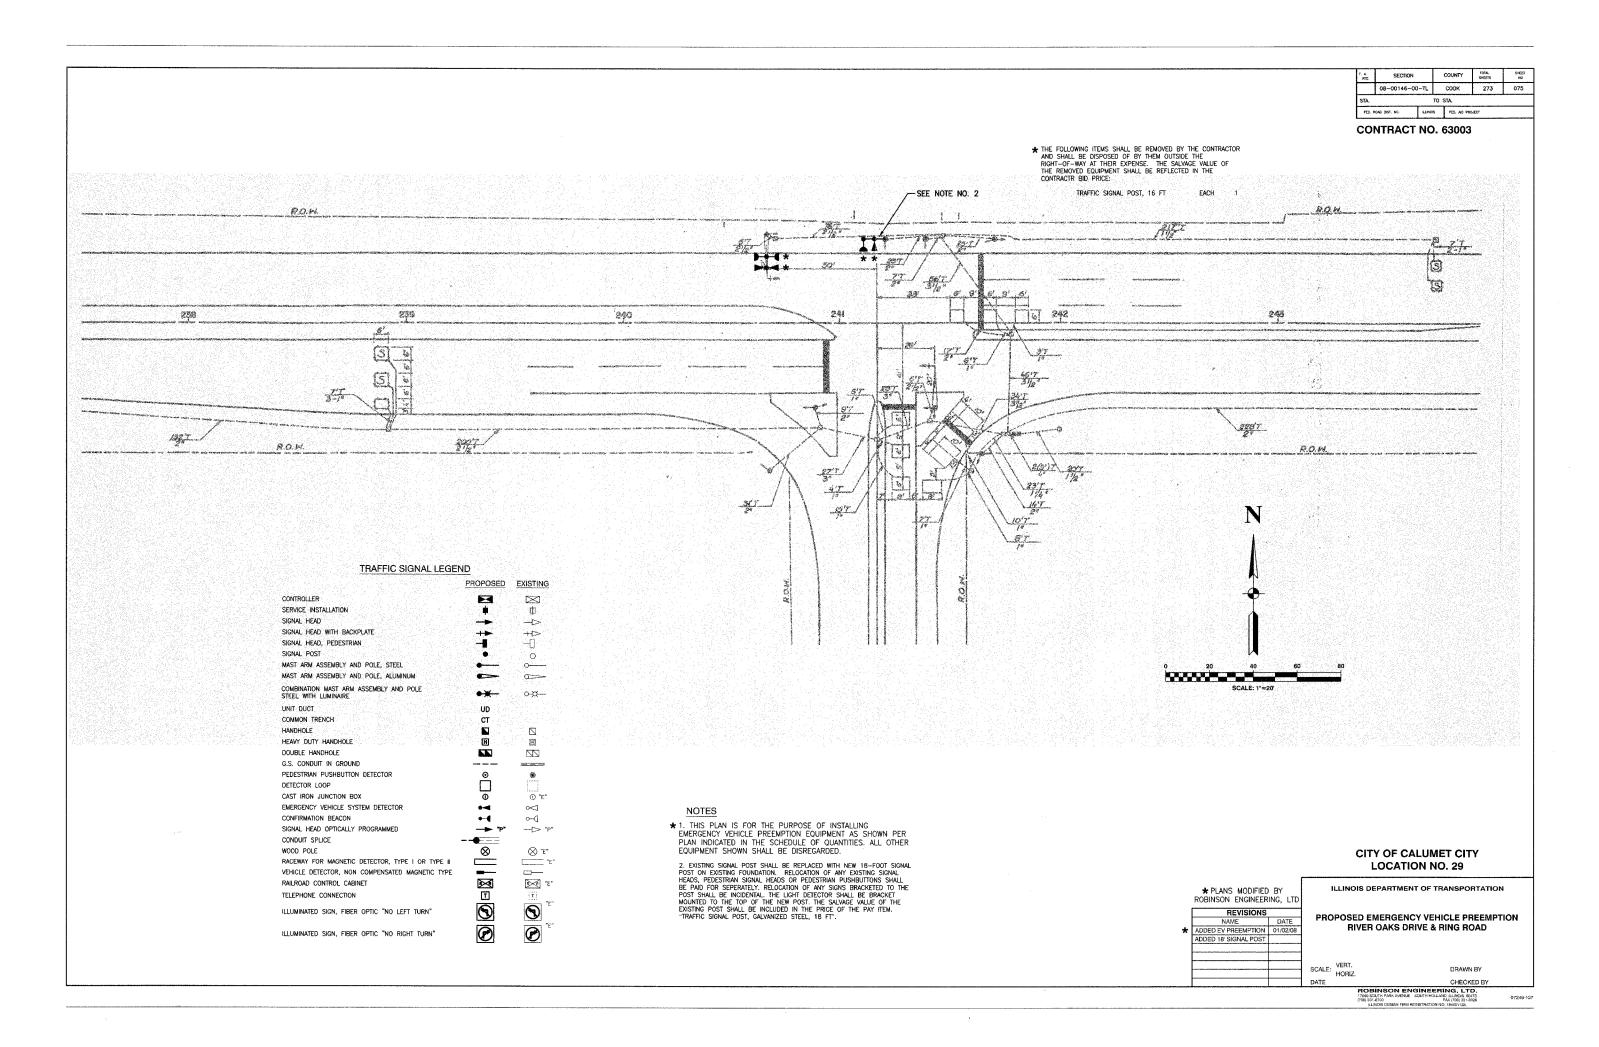

F. A. RTE.	SECTION		COUNTY	TOTAL SHEETS	SHEET NO
	08-0014600	TL	соок	273	076
STA.		TO STA.			
FRD. F	SOAD DIST. NO.	LUNGIS	FED. AID PR	MECT	

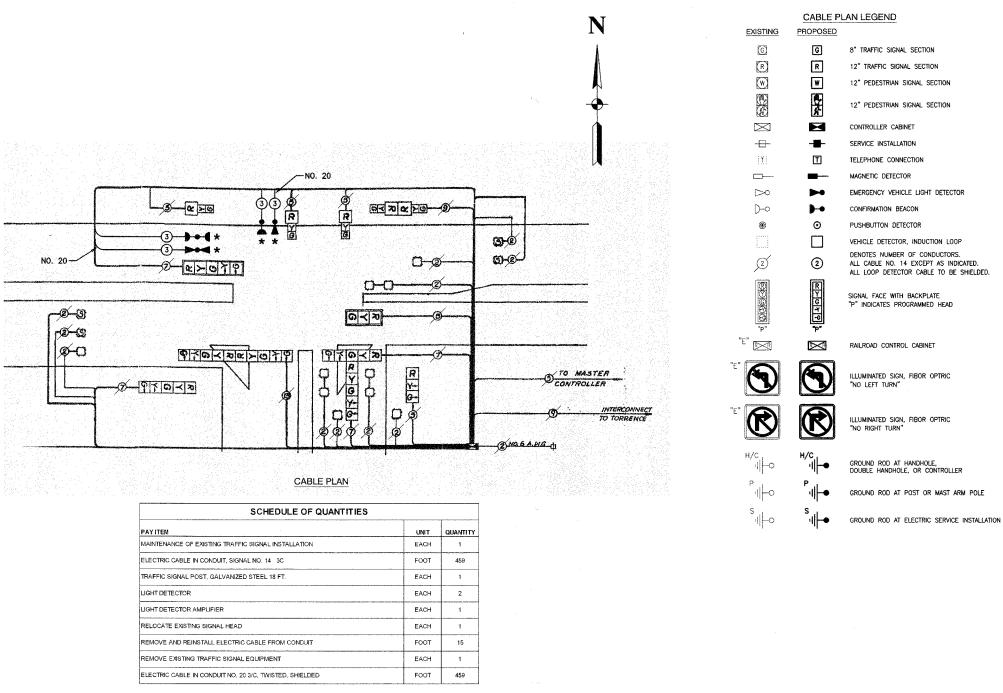

OVERLAP PERMISSIVE PROTECTED

LETTER PHASE PHASE DISPLAY

B = 8 + 1 - 8

LEGEND

OVERLAP

- DUAL ENTRY PHASE

PEDESTRIAN PHASE

NUMBER REFERS TO ASSOCIATED PHASE

RIVER OAKS

RIVER OAKS

**—**3→

**←**6

√-Ū---

DRIVE

**←**(3)—

DRIVE

**LEGEND** 

OVER! AF

→ … \* PEDESTRIAN PHASE

DUAL ENTRY PHASE

SINGLE ENTRY PHASE

NUMBER REFERS TO ASSOCIATED PHASE

PHASE DESIGNATION DIAGRAM

EMERGENCY VEHICLE PREEMPTION SEQUENCE


EMERGENCY VEHICLE PREEMPTOR


MOVEMENT

★ 1. THIS PLAN IS FOR THE PURPOSE OF INSTALLING EMERGENCY VEHICLE PREEMPTION EQUIPMENT AS SHOWN PER PLAN INDICATED IN THE SCHEDULE OF QUANTITIES. ALL OTHER EQUIPMENT SHOWN SHALL BE DISREGARDED.

### CITY OF CALUMET CITY LOCATION NO. 29

\* PLANS MODIFIED BY ILLINOIS DEPARTMENT OF TRANSPORTATION ROBINSON ENGINEERING, LTD REVISIONS PROPOSED EMERGENCY VEHICLE PREEMPTION CABLE PLAN, PHASE DESIGNATION DIAGRAM & ★ ADDED EV PREEMPTION 01/02/08 SCHEDULE OF QUANTITIES ADDED 18' SIGNAL POST RIVER OAKS DRIVE & RING ROAD SCALE: VERT. HORIZ. DRAWN BY CHECKED BY

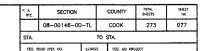

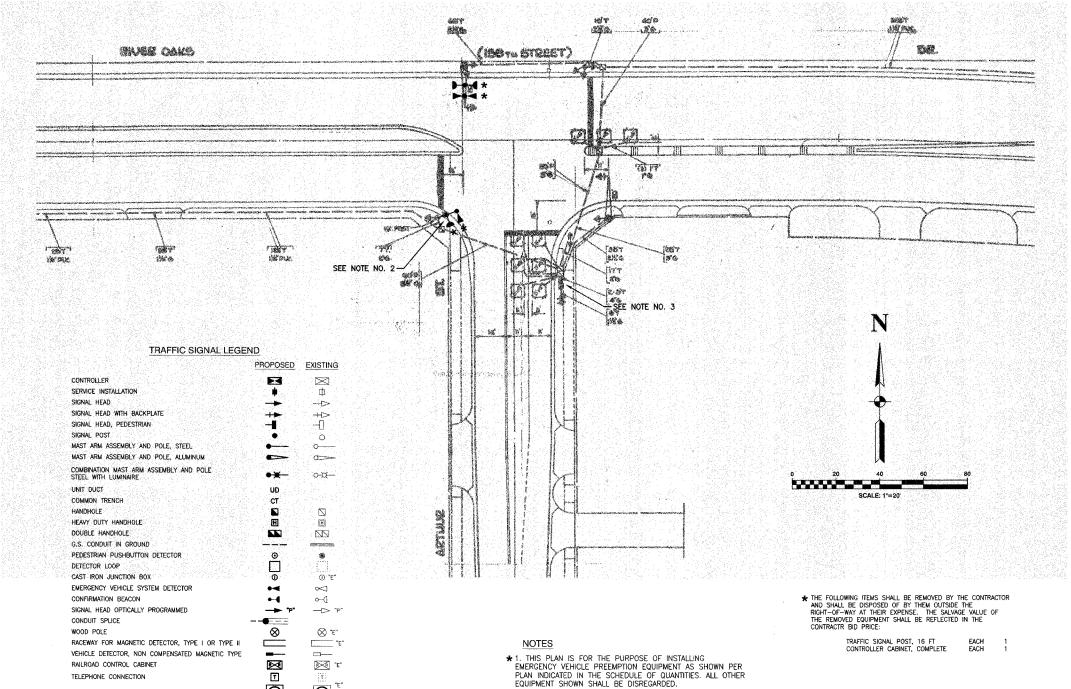

2. EXISTING SIGNAL POST SHALL BE REPLACED WITH NEW 18-FOOT SIGNAL POST ON EXISTING FOUNDATION. RELOCATION OF ANY EXISTING SIGNAL HEADS, PEDESTRIAN SIGNAL HEADS OR PEDESTRIAN PUSHBUTTONS SHALL BE PAID FOR SEPERATELY, RELOCATION OF ANY SIGNS BRACKETED TO THE POST SHALL BE INCIDENTAL. THE LIGHT DETECTOR SHALL BE BRACKET MOUNTED TO THE TOP OF THE NEW POST. THE SALVAGE VALUE OF THE EXISTING POST SHALL BE INCLUDED IN THE PRICE OF THE PAY ITEM. "TRAFFIC SIGNAL POST, GALVANIZED STEEL, 18 FT".

THE TRAFFIC SIGNAL CONTROLLER CABINET EQUIPMENT FOR THE INTERSECTION SHALL BE ECONOLITE TO MATCH EXISTING OR ADJACENT SYSTEM.

 $\bowtie$ 

T

0

₹**`**E"

**9** 

RAILROAD CONTROL CABINET

ILLUMINATED SIGN, FIBER OPTIC "NO LEFT TURN"

ILLUMINATED SIGN, FIBER OPTIC "NO RIGHT TURN"

TELEPHONE CONNECTION

## CITY OF CALUMET CITY LOCATION NO. 30


\* PLANS MODIFIED BY ROBINSON ENGINEERING, LTD REVISIONS 
 NAME
 DATE


 ADDED EV PREEMPTION
 01/02/08
 ADDED 18' SIGNAL POST ADDED NEW CONTROLLER

ILLINOIS DEPARTMENT OF TRANSPORTATION

PROPOSED EMERGENCY VEHICLE PREEMPTION RIVER OAKS DRIVE & ARTHUR STREET

SCALE: VERT. HORIZ. DRAWN BY CHECKED BY

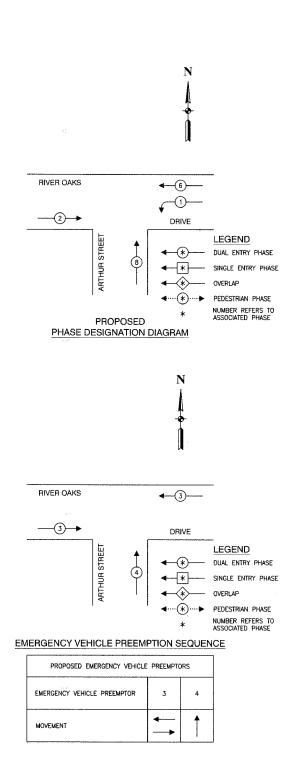

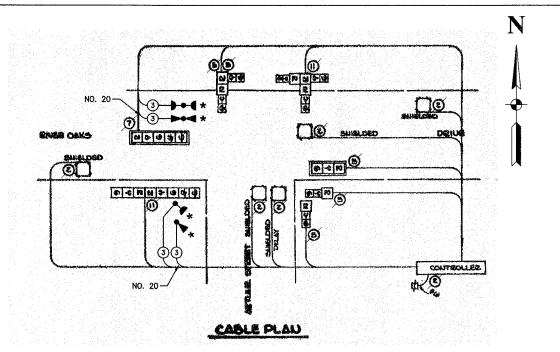

## ALL RED CLEARENCE TO SE PROVIDED FOR ALL PHASES FXISTING

CAIOTHY	<u> </u>	19		- 1			***************************************	
. SEQUENCE OF OF	ERAT	HON						
Phase	А		ŧ	3	C			
Movement	;-	+		-	1	1	LANI	
Change To	<b>/</b> E	3 C	Z	¢	$\mathbb{Z}$	8	,	
Interval	1 2	q 3	4	8	6	7		
WB. River Ooks Orive (M.AEL.)	G	V	G	Y	R	R	R	l

SCHEDULE OF QUANTITIES				
PAYITEM	UNIT	QUANTITY		
MAINTENANCE OF EXISTING TRAFFIC SIGNAL INSTALLATION	EACH	1		
FULL-ACTUATED CONTROLLER AND TYPE IV CABINET, SPECIAL	EACH	1		
ELECTRIC CABLE IN CONDUIT, SIGNAL NO. 14 3C	FOOT	366		
TRAFFIC SIGNAL POST, GALVANIZED STEEL 18 FT.	EACH	1		
INDUCTIVE LOOP DETECTOR	EACH	5		
LIGHT DETECTOR	EACH	2		
LIGHT DETECTOR AMPLIFIER	EACH	1		
RELOCATE EXISTING SIGNAL HEAD	EACH	2		
REMOVE AND REINSTALL ELECTRIC CABLE FROM CONDUIT	FOOT	15		
REMOVE EXISTING TRAFFIC SIGNAL EQUIPMENT	EACH	1		
ELECTRIC CABLE IN CONDUIT NO. 20 3/C. TWISTED, SHIELDED	FOOT	366		
MODIFY EXISTING TYPE "D" FOUNDATION	EACH	1		

## NOTE

\* 1. THIS PLAN IS FOR THE PURPOSE OF INSTALLING EMERGENCY VEHICLE PREEMPTION EQUIPMENT AS SHOWN PER PLAN INDICATED IN THE SCHEDULE OF QUANTITIES. ALL OTHER EQUIPMENT SHOWN SHALL BE DISREGARDED.

F. A. RTE.	SECTION		COUNTY	TOTAL SHEETS	SHEET NO
	08-00146-00-	-TL	COOK	273	078
STA.			TO STA.		
FED. F	OAD DIST. NO.	LLINO	S FED. AND PRO	NECT	

## CONTRACT NO. 63003

	CABLE PL	AN LEGEND
EXISTING	PROPOSED	
©	G	8" TRAFFIC SIGNAL SECTION
R	R	12" TRAFFIC SIGNAL SECTION
W	W	12" PEDESTRIAN SIGNAL SECTION
	Ž.	12" PEDESTRIAN SIGNAL SECTION
$\boxtimes$	$\blacksquare$	CONTROLLER CABINET
-	-	SERVICE INSTALLATION
: <u>T</u>	T	TELEPHONE CONNECTION
	-	MAGNETIC DETECTOR
$\triangleright$	▶•	EMERGENCY VEHICLE LIGHT DETECTOR
D0	<b>)-•</b>	CONFIRMATION BEACON
<b>©</b>	•	PUSHBUTTON DETECTOR
		VEHICLE DETECTOR, INDUCTION LOOP
<b>(2)</b>	2	DENOTES NUMBER OF CONDUCTORS. ALL CABLE NO. 14 EXCEPT AS INDICATED. ALL LOOP DETECTOR CABLE TO BE SHIELDED.
*p*	₽	SIGNAL FACE WITH BACKPLATE "P" INDICATES PROGRAMMED HEAD
"E" ▶	$\bowtie$	RAILROAD CONTROL CABINET
"E"	9	ILLUMINATED SIGN, FIBOR OPTRIC "NO LEFT TURN"
"E"	<b>®</b>	ILLUMINATED SIGN, FIBOR OPTRIC "NO RIGHT TURN"
H/C  -0	H/C :   <b>→</b>	GROUND ROD AT HANDHOLE, DOUBLE HANDHOLE, OR CONTROLLER
P 11 -0	P.  -	GROUND ROD AT POST OR MAST ARM POLE

## CITY OF CALUMET CITY **LOCATION NO. 30**

	ROBINSON ENGINEERING, LTD REVISIONS							
	NAME	DATE						
k	ADDED EV PREEMPTION	01/02/08						
	ADDED 18' SIGNAL POST							
	ADDED NEW CONTROLLER							

\* PLANS MODIFIED BY

ILLINOIS DEPARTMENT OF TRANSPORTATION


GROUND ROD AT ELECTRIC SERVICE INSTALLATION


PROPOSED EMERGENCY VEHICLE PREEMPTION CABLE PLAN, PHASE DESIGNATION DIAGRAM & SCHEDULE OF QUANTITIES
RIVER OAKS DRIVE & ARTHUR STREET


SCALE: VERT. HORIZ. DATE


CHECKED BY


ROBINSON ENGINEERING, LTD.
17006 SOUTH PARK AVENUE SOUTH HOLLAND, ILLINDIS 60173
(706) 331-307 FAX (706) 231-3620
ILLINDIS DESIGN FIRM REGIST RATION NO. 184001123.

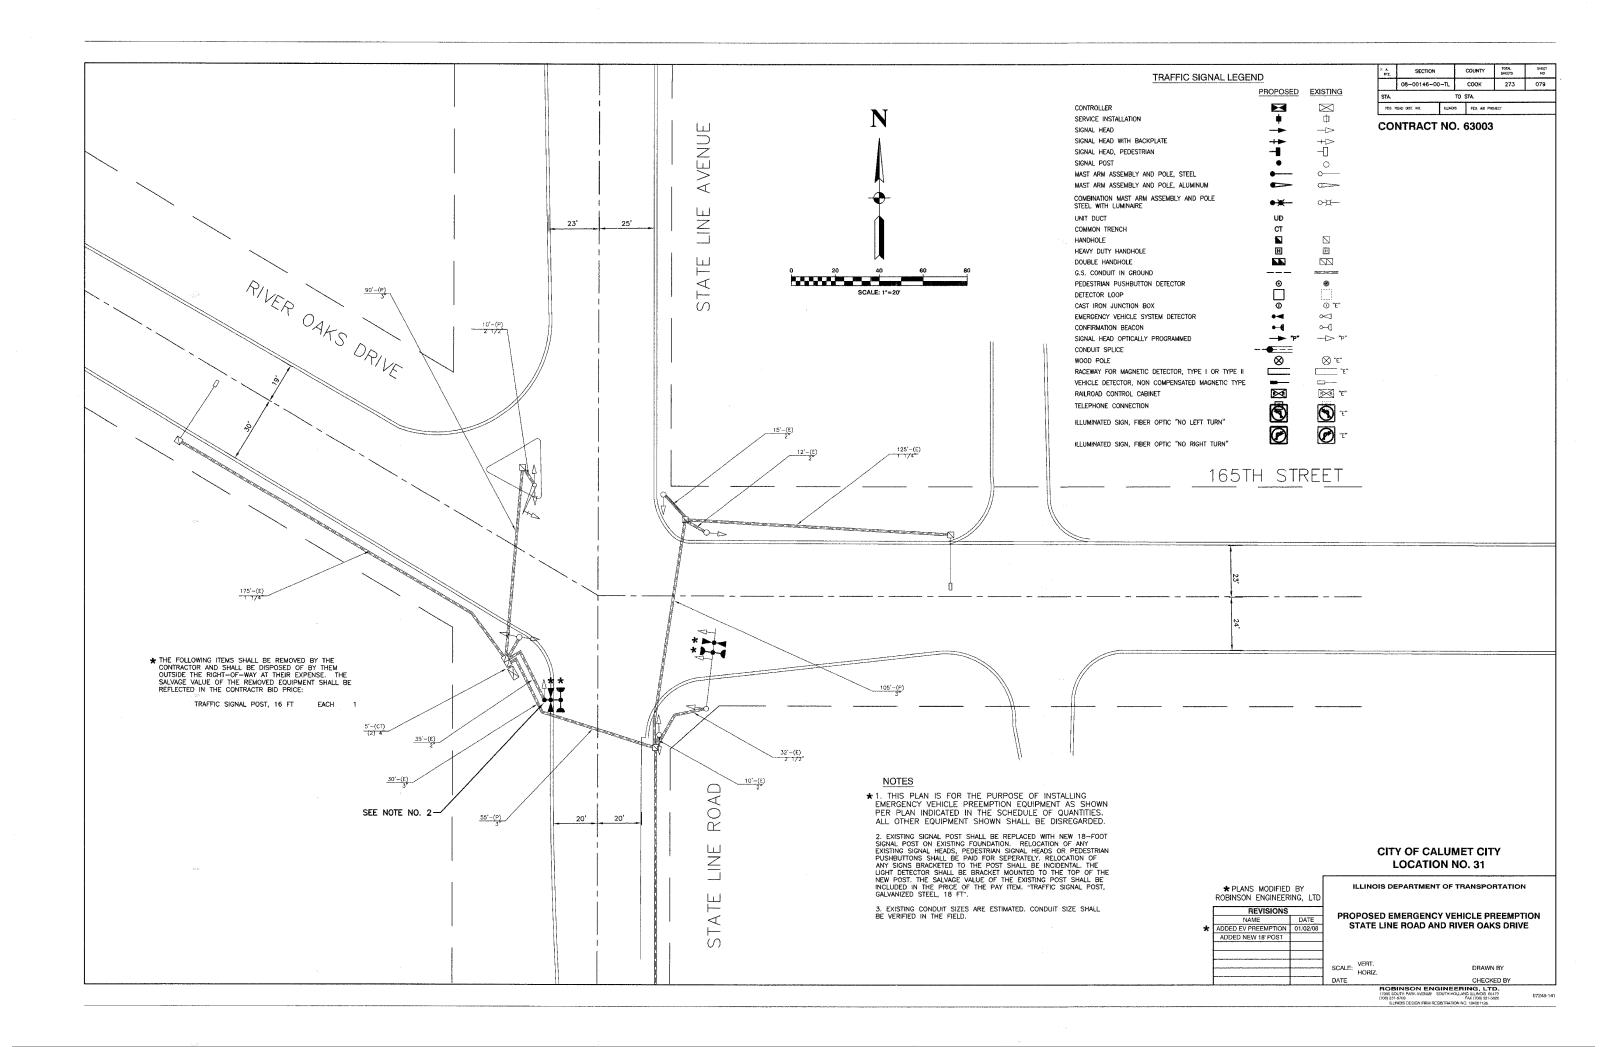

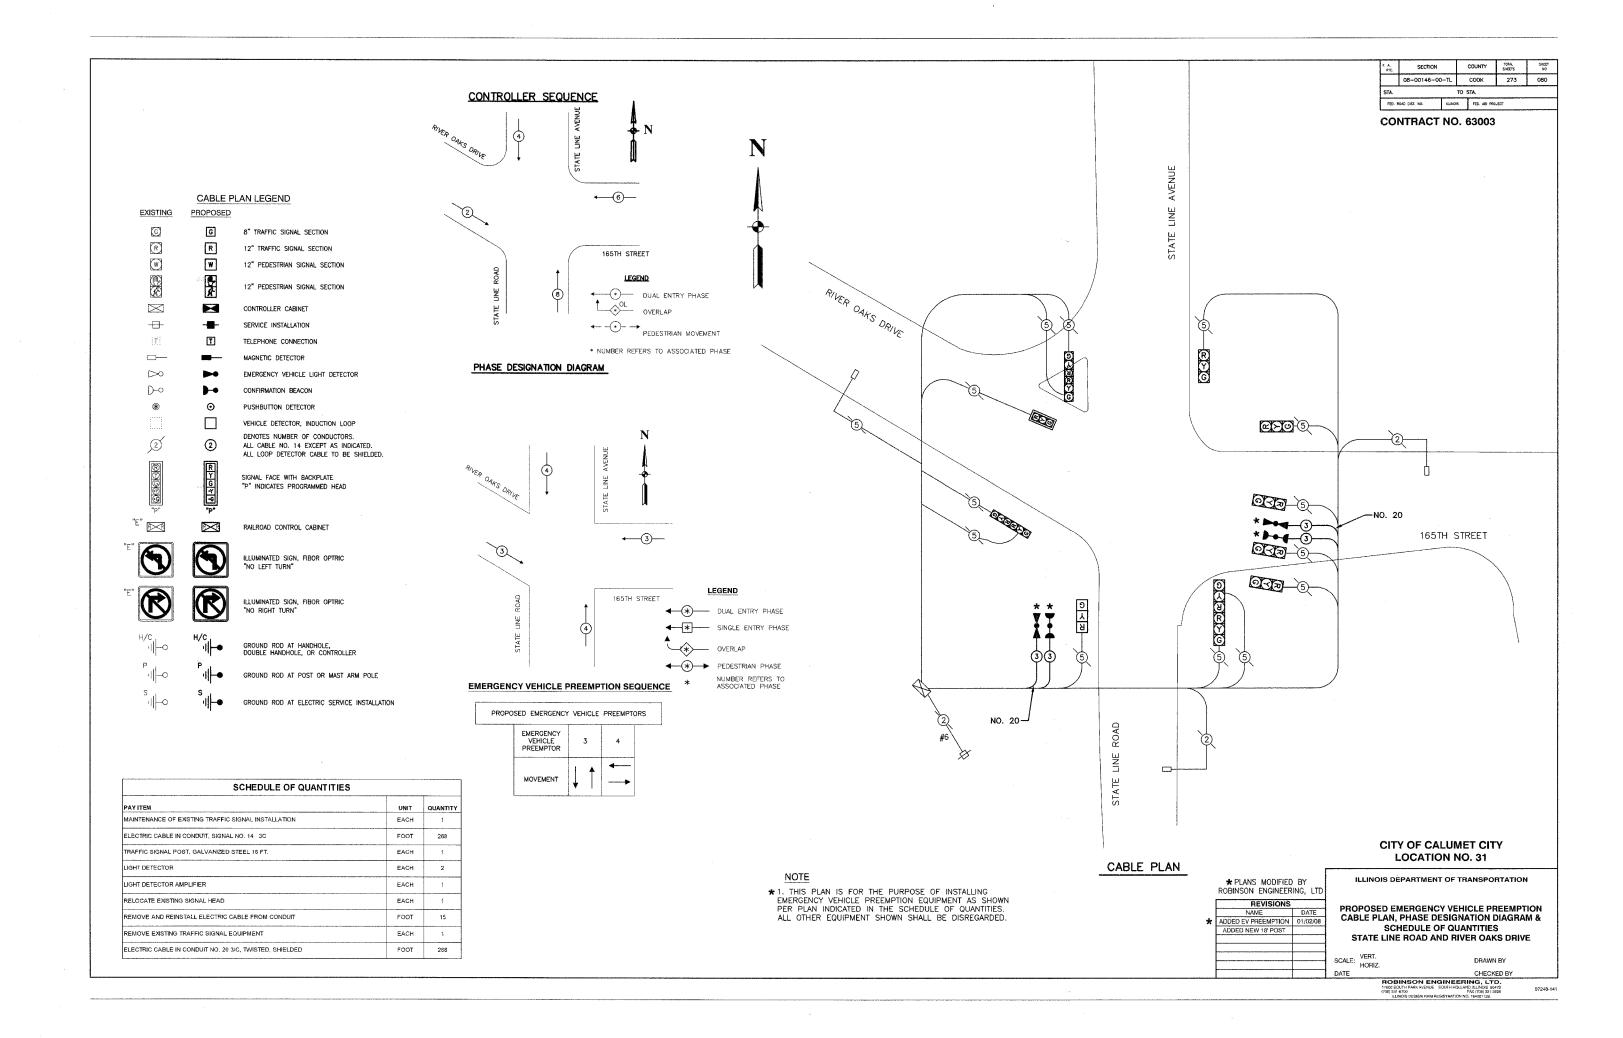


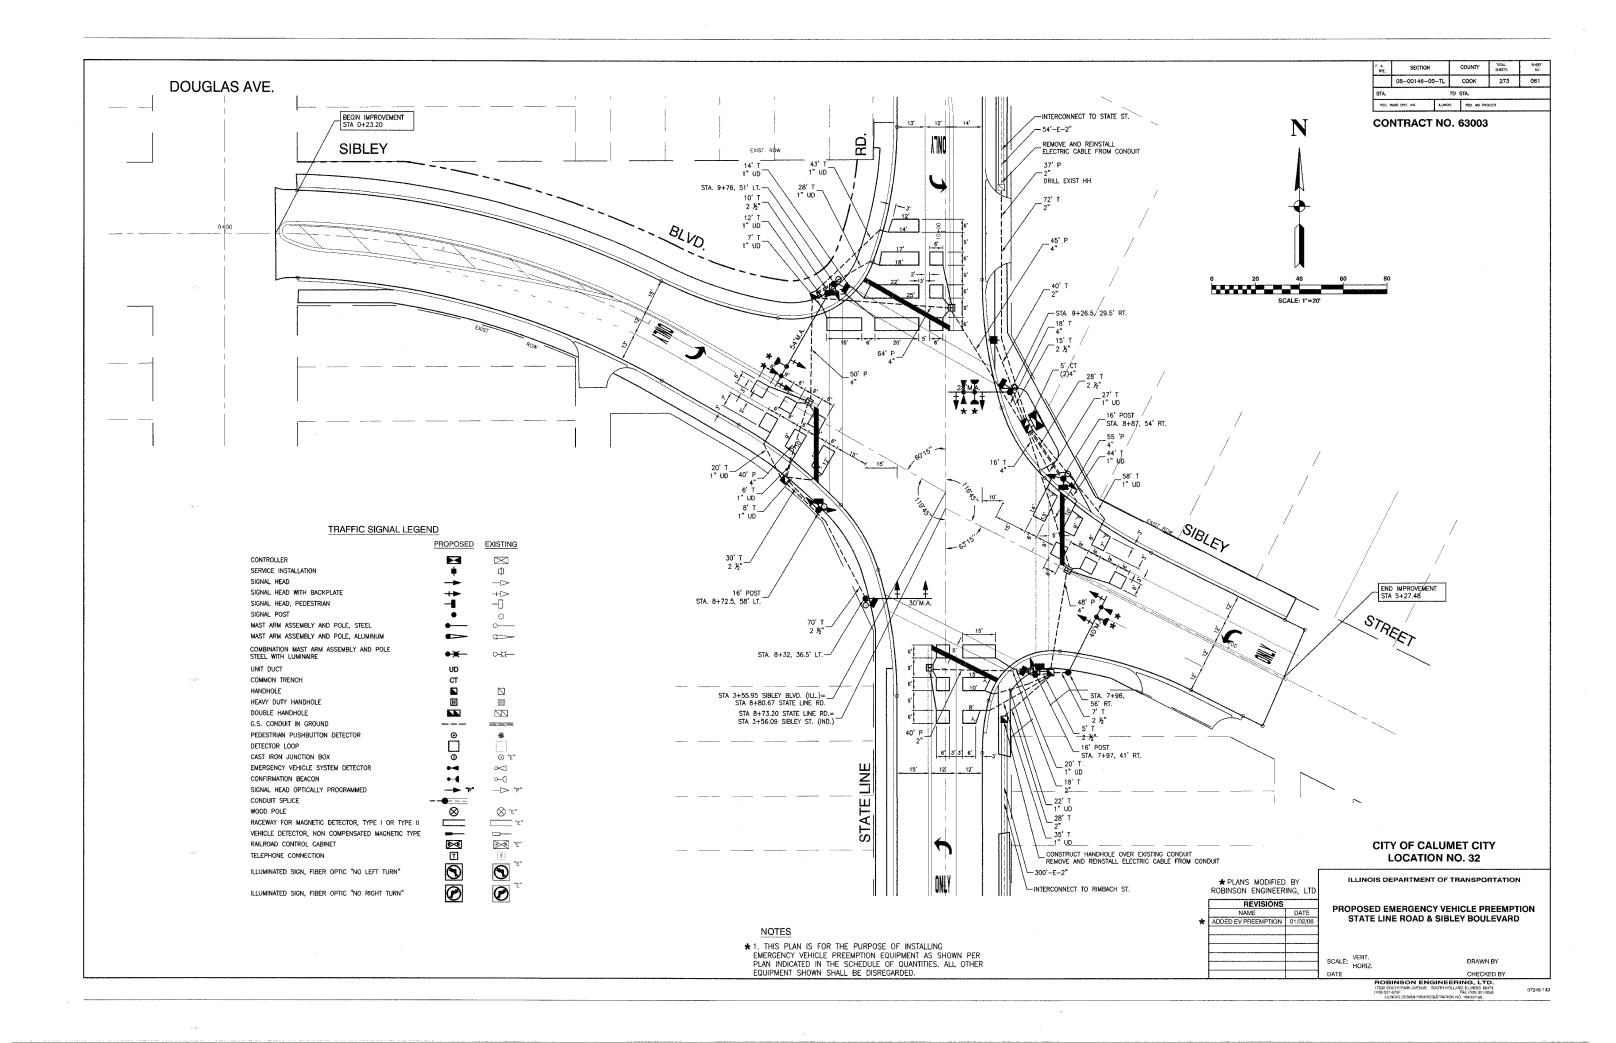


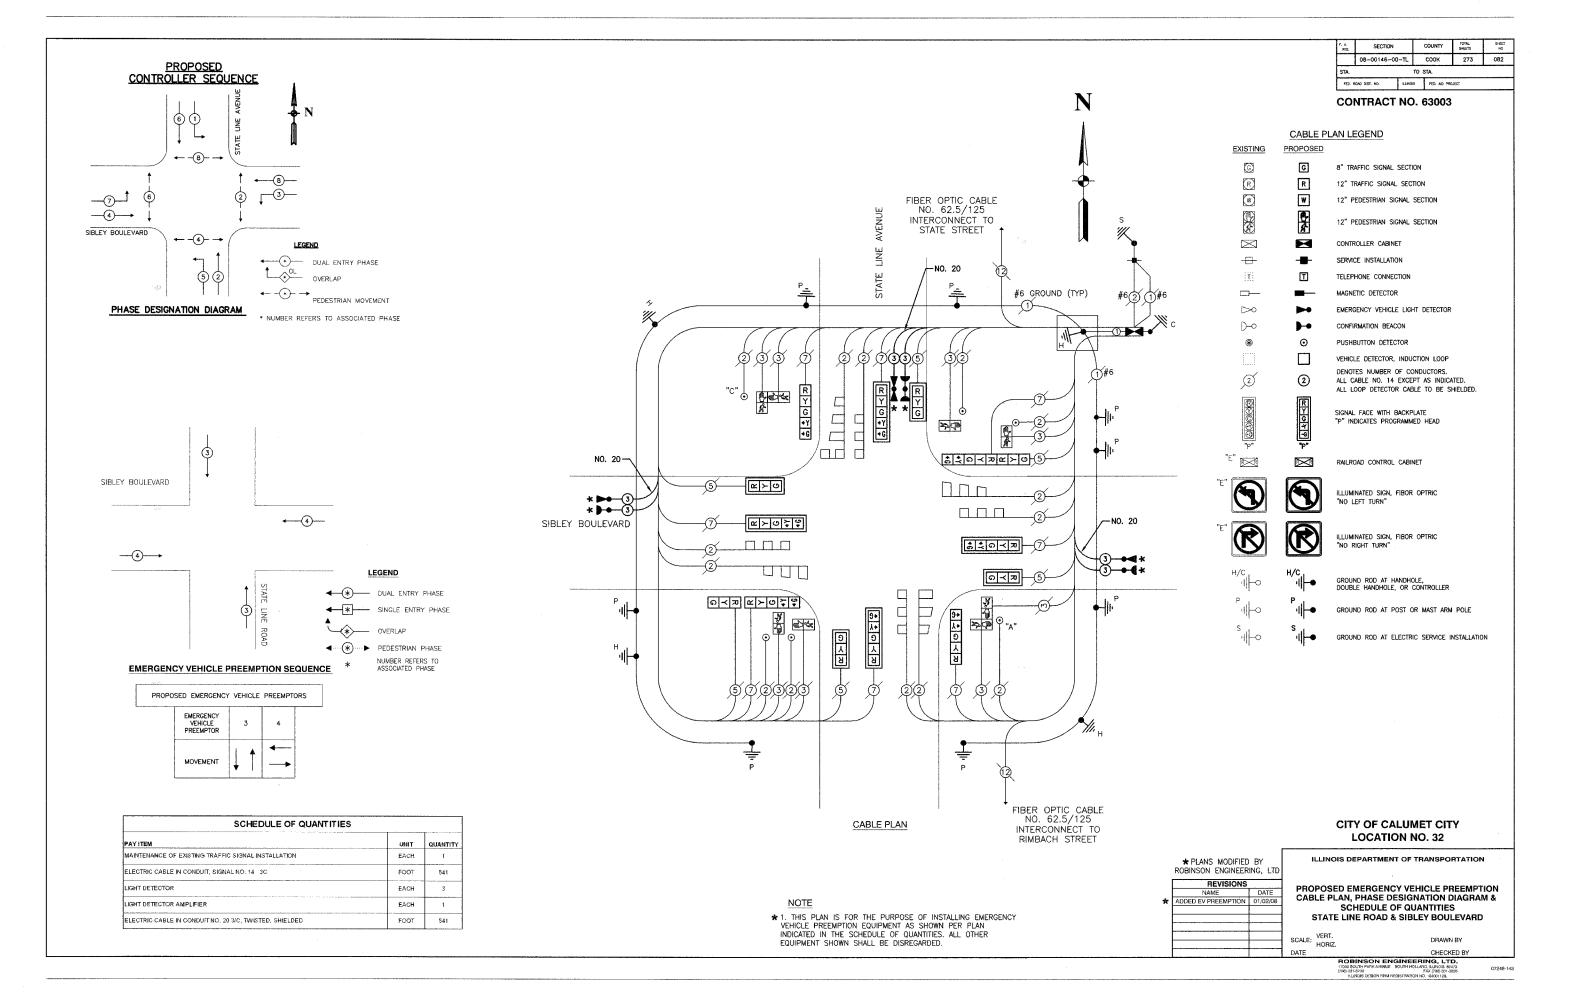

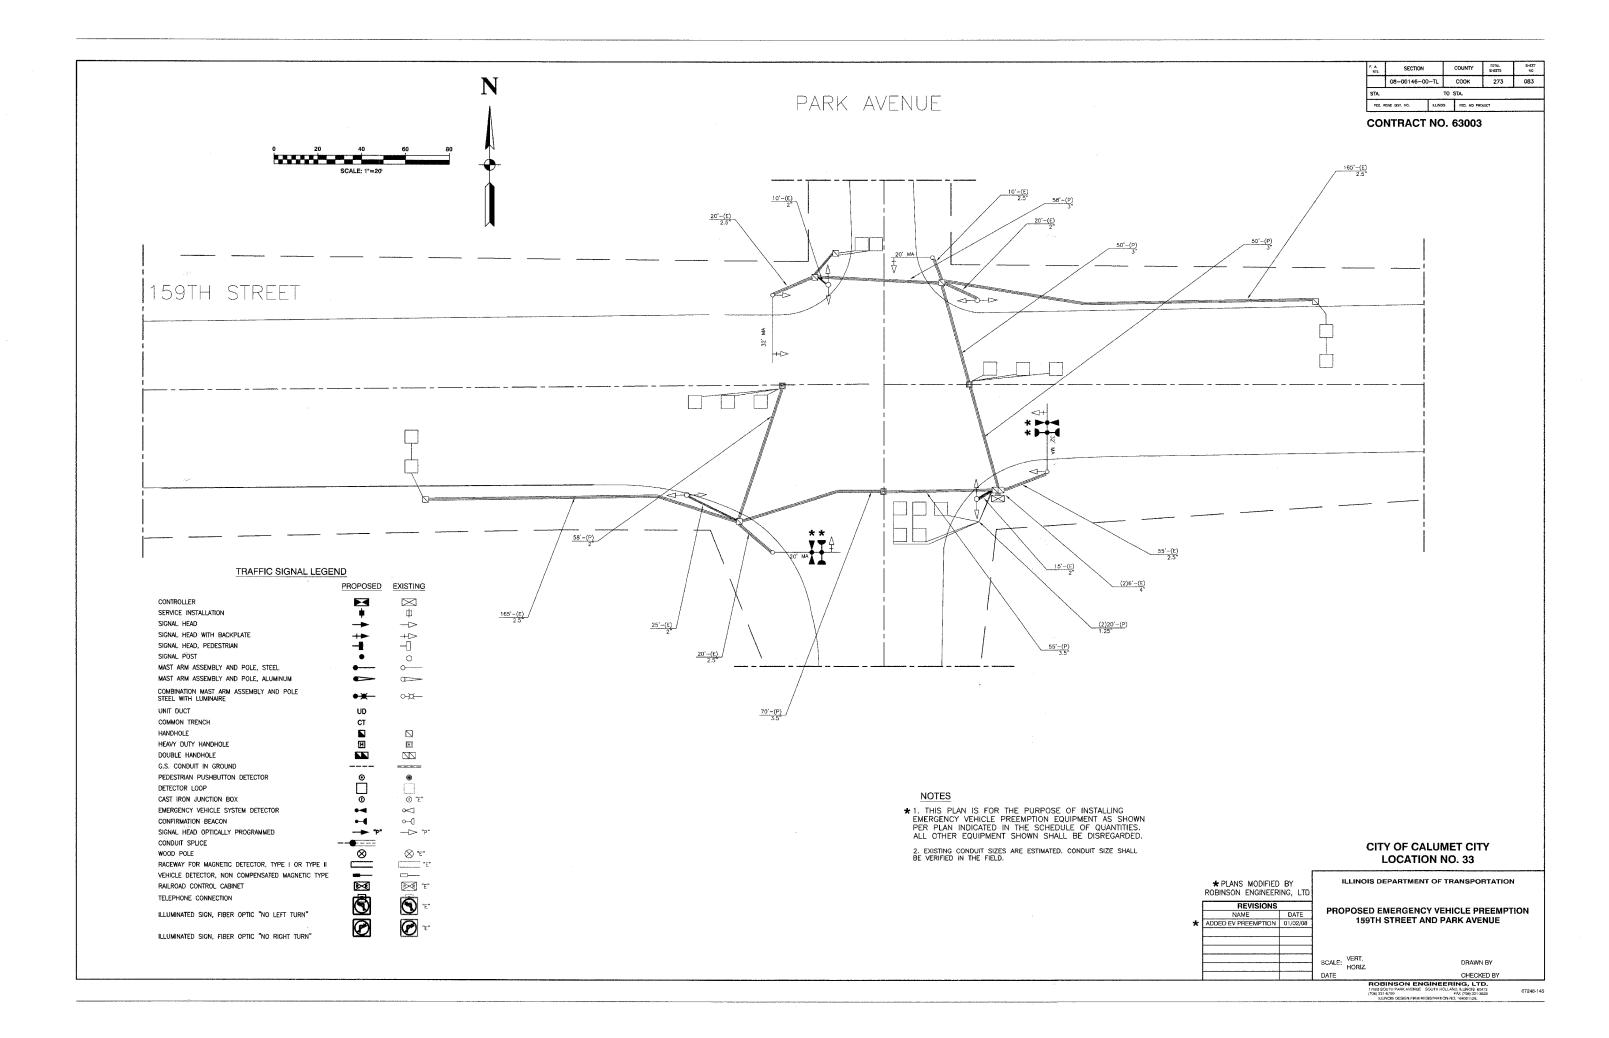

F. A. RTE.	SECTION		COUNTY	SHEETS	SHEET NO
	08-00146-	00-TL	соок	273	084
STA.		1	TO STA.		
FEO.	ROAD DIST. NO.	(LLINOIS	FEO. AID PR	OJECT	

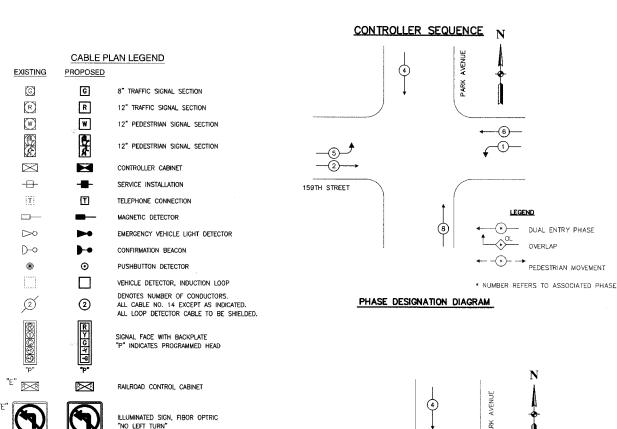

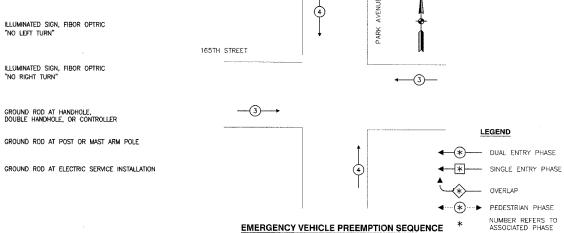

PROPOSED EMERGENCY VEHICLE PREEMPTORS

EMERGENCY VEHICLE PREEMPTOR

MOVEMENT

SCHEDULE OF QUANTITIES					
PAYITEM	UNIT	QUANTITY			
MAINTENANCE OF EXISTING TRAFFIC SIGNAL INSTALLATION	EACH	1			
ELECTRIC CABLE IN CONDUIT, SIGNAL NO. 14 3C	FOOT	352			
LIGHT DETECTOR	EACH	2			
LIGHT DETECTOR AMPLIFIER	EACH	1			
ELECTRIC CABLE IN CONDUIT NO. 20 3/C, TWISTED, SHIELDED	FOOT	352			

ILLUMINATED SIGN, FIBOR OPTRIC


GROUND ROD AT HANDHOLE, DOUBLE HANDHOLE, OR CONTROLLER

GROUND ROD AT POST OR MAST ARM POLE

"NO RIGHT TURN"

R

11-0

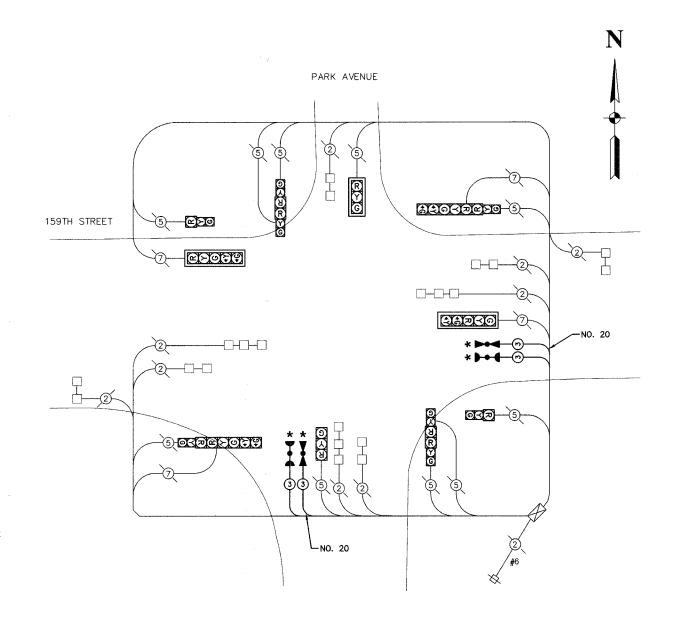

## CABLE PLAN

CITY OF CALUMET CITY **LOCATION NO. 33** 


★ 1. THIS PLAN IS FOR THE PURPOSE OF INSTALLING EMERGENCY VEHICLE PREEMPTION EQUIPMENT AS SHOWN PER PLAN INDICATED IN THE SCHEDULE OF QUANTITIES. ALL OTHER EQUIPMENT SHOWN SHALL BE DISREGARDED.

\* PLANS MODIFIED BY ILLINOIS DEPARTMENT OF TRANSPORTATION ROBINSON ENGINEERING, LTD REVISIONS


PROPOSED EMERGENCY VEHICLE PREEMPTION CABLE PLAN, PHASE DESIGNATION DIAGRAM & ★ ADDED EV PREEMPTION 01/02/08 SCHEDULE OF QUANTITIES 159TH STREET AND PARK AVENUE

SCALE: VERT. HORIZ.

DRAWN BY CHECKED BY

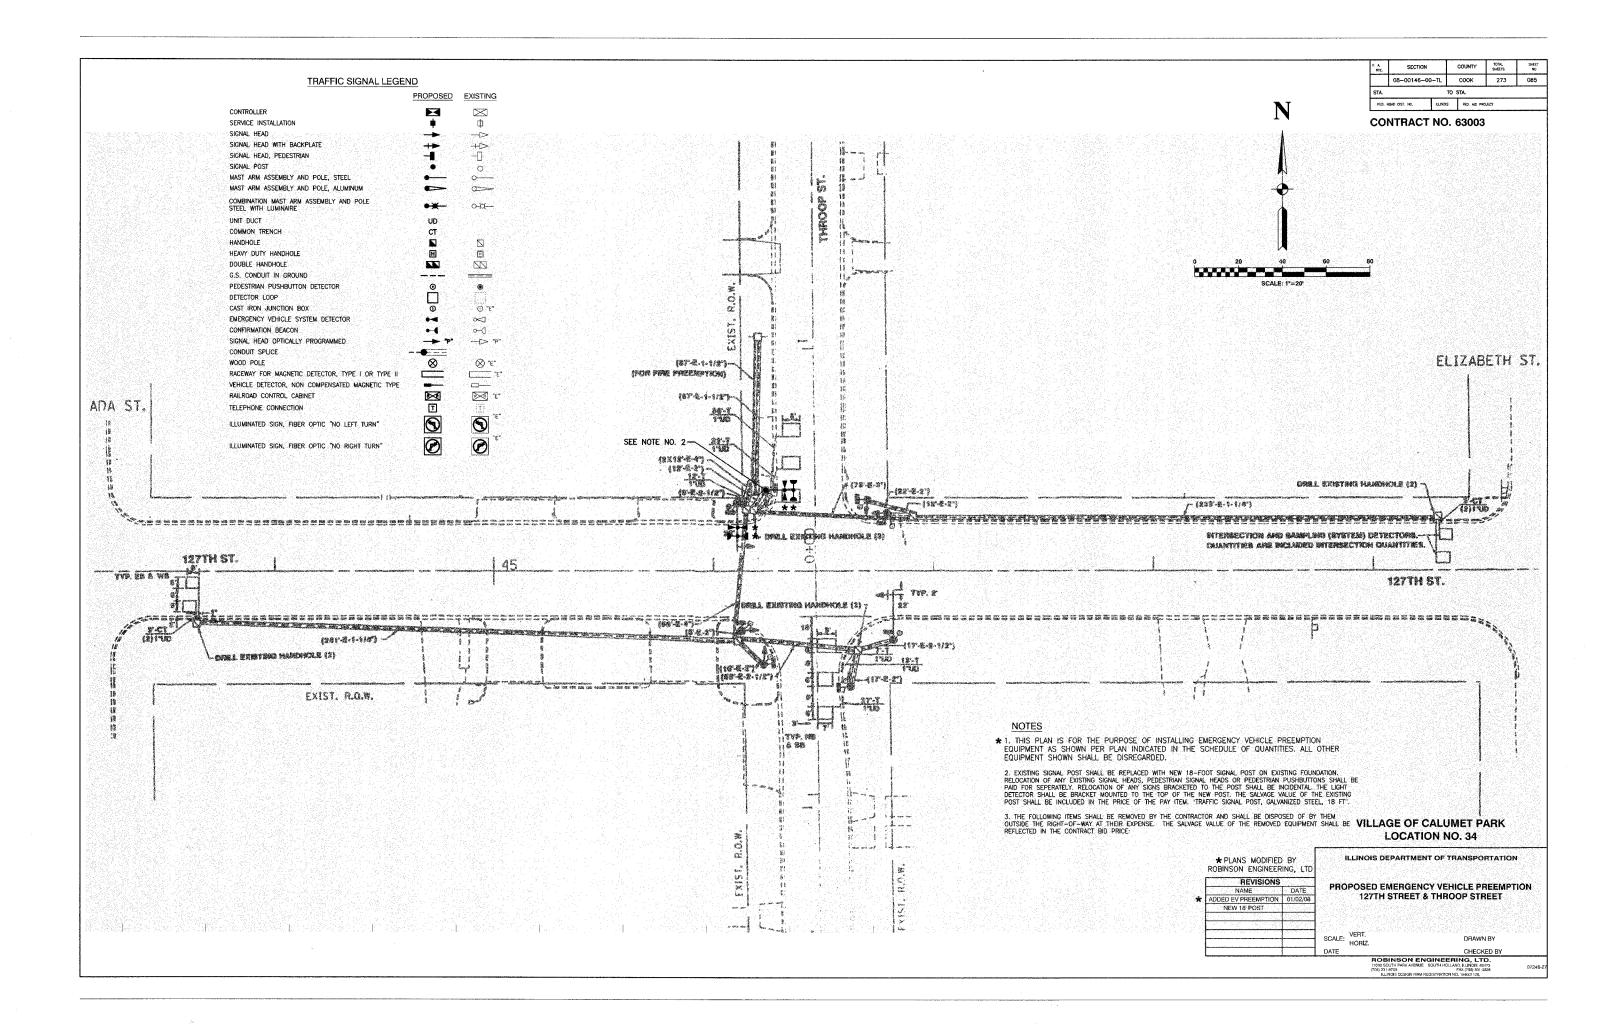


# CONTROLLER SEQUENCE IV

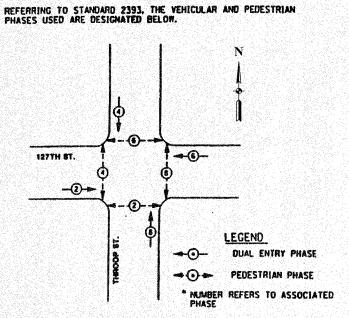


## PHASE DESIGNATION DIAGRAM

DUAL ENTRY - ALL LEGS PROTECTED/PERMITTED LEFT TURN PHASING

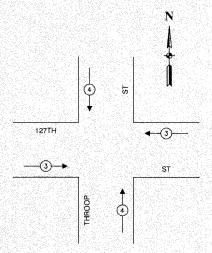

## **EMERGENCY VEHICLE PREEMPTION SEQUENCE**

PROPOSED EMERGENCY VEHICLE PREEMPTORS							
E	MERGENCY VEH	(ICLE PREE)	/PTOR	3	4		
N	OVENENT			<b>←</b>	11		

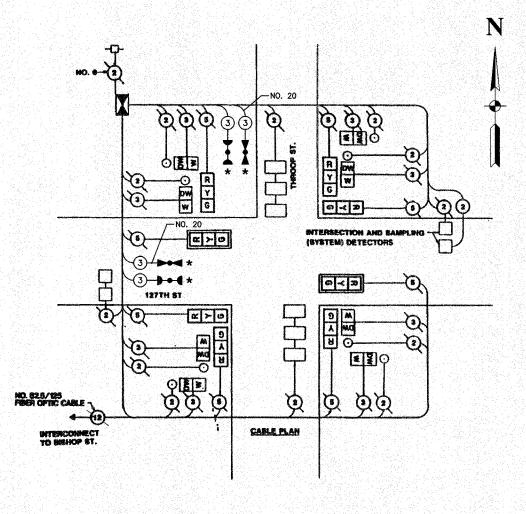

SCHEDULE OF QUANTITIES					
PAYITEM	UNIT	QUANTITY			
MAINTENANCE OF EXISTING TRAFFIC SIGNAL INSTALLATION	EACH	1			
ELECTRIC CABLE IN CONDUIT, SIGNAL NO. 14 3C	FOOT	131			
TRAFFIC SIGNAL POST, GALVANIZED STEEL 18 FT.	EACH	1			
LIGHT DETECTOR	EACH	2			
LIGHT DETECTOR AMPLIFIER	EACH	1			
RELOCATE EXISTING SIGNAL HEAD	EACH	1			
RELOCATE EXISTING PEDESTRIAN SIGNAL HEAD	EACH	1			
RELOCATE EXISTING PEDESTRIAN PUSH-BUTTON	EACH	1			
REMOVE AND REINSTALL ELECTRIC CABLE FROM CONDUIT	FOOT	15			
REMOVE EXISTING TRAFFIC SIGNAL EQUIPMENT	EACH	1			
ELECTRIC CABLE IN CONDUIT NO. 20 3/C, TWISTED, SHIELDED	FOOT	131			

★ 1. THIS PLAN IS FOR THE PURPOSE OF INSTALLING EMERGENCY VEHICLE PREEMPTION EQUIPMENT AS SHOWN PER PLAN INDICATED IN THE SCHEDULE OF QUANTITIES. ALL OTHER EQUIPMENT SHOWN SHALL BE DISREGARDED.

Ī	A RJE:	SECTION	COUNTY	TOTAL SHEETS	SHEET NO
7		08-00146-00-TL	COOK	273	086
•	STA.		TO STA.		
	FED. R	DAD DIST. NO. EUNO	S FED. AID PRO	UECT	

## CONTRACT NO. 63003

### CABLE PLAN LEGEND

G 8" TRAFFIC SIGNAL SECTION R 12" TRAFFIC SIGNAL SECTION 12" PEDESTRIAN SIGNAL SECTION 12" PEDESTRIAN SIGNAL SECTION

EXISTING **©** 

R

W

 $\boxtimes$ 

Ð

n  $\Box$ 

 $\triangleright$ 0

)-0

MAGNETIC DETECTOR EMERGENCY VEHICLE LIGHT DETECTOR

PUSHBUTTON DETECTOR VEHICLE DETECTOR, INDUCTION LOOP

Ø ( **(000000** 

SIGNAL FACE WITH BACKPLATE
"P" INDICATES PROGRAMMED HEAD

DENOTES NUMBER OF CONDUCTORS.

ALL CABLE NO. 14 EXCEPT AS INDICATED.
ALL LOOP DETECTOR CABLE TO BE SHIELDED.

CONTROLLER CABINET

SERVICE INSTALLATION

"E" 🗺



RAILROAD CONTROL CABINET ILLUMINATED SIGN, FIBOR OPTRIC

ILLUMINATED SIGN, FIBOR OPTRIC "NO RIGHT TURN"

GROUND ROD AT HANDHOLE, DOUBLE HANDHOLE, OR CONTROLLER

GROUND ROD AT POST OR MAST ARM POLE

GROUND ROD AT ELECTRIC SERVICE INSTALLATION

## VILLAGE OF CALUMET PARK **LOCATION NO. 34**


\* PLANS MODIFIED BY ROBINSON ENGINEERING, LTD

NAME DATE
ADDED EV PREEMPTION 01/02/08

ILLINOIS DEPARTMENT OF TRANSPORTATION

PROPOSED EMERGENCY VEHICLE PREEMPTION CABLE PLAN, PHASE DESIGNATION DIAGRAM & SCHEDULE OF QUANTITIES 127TH STREET & THROOP STREET

SCALE: VERT.

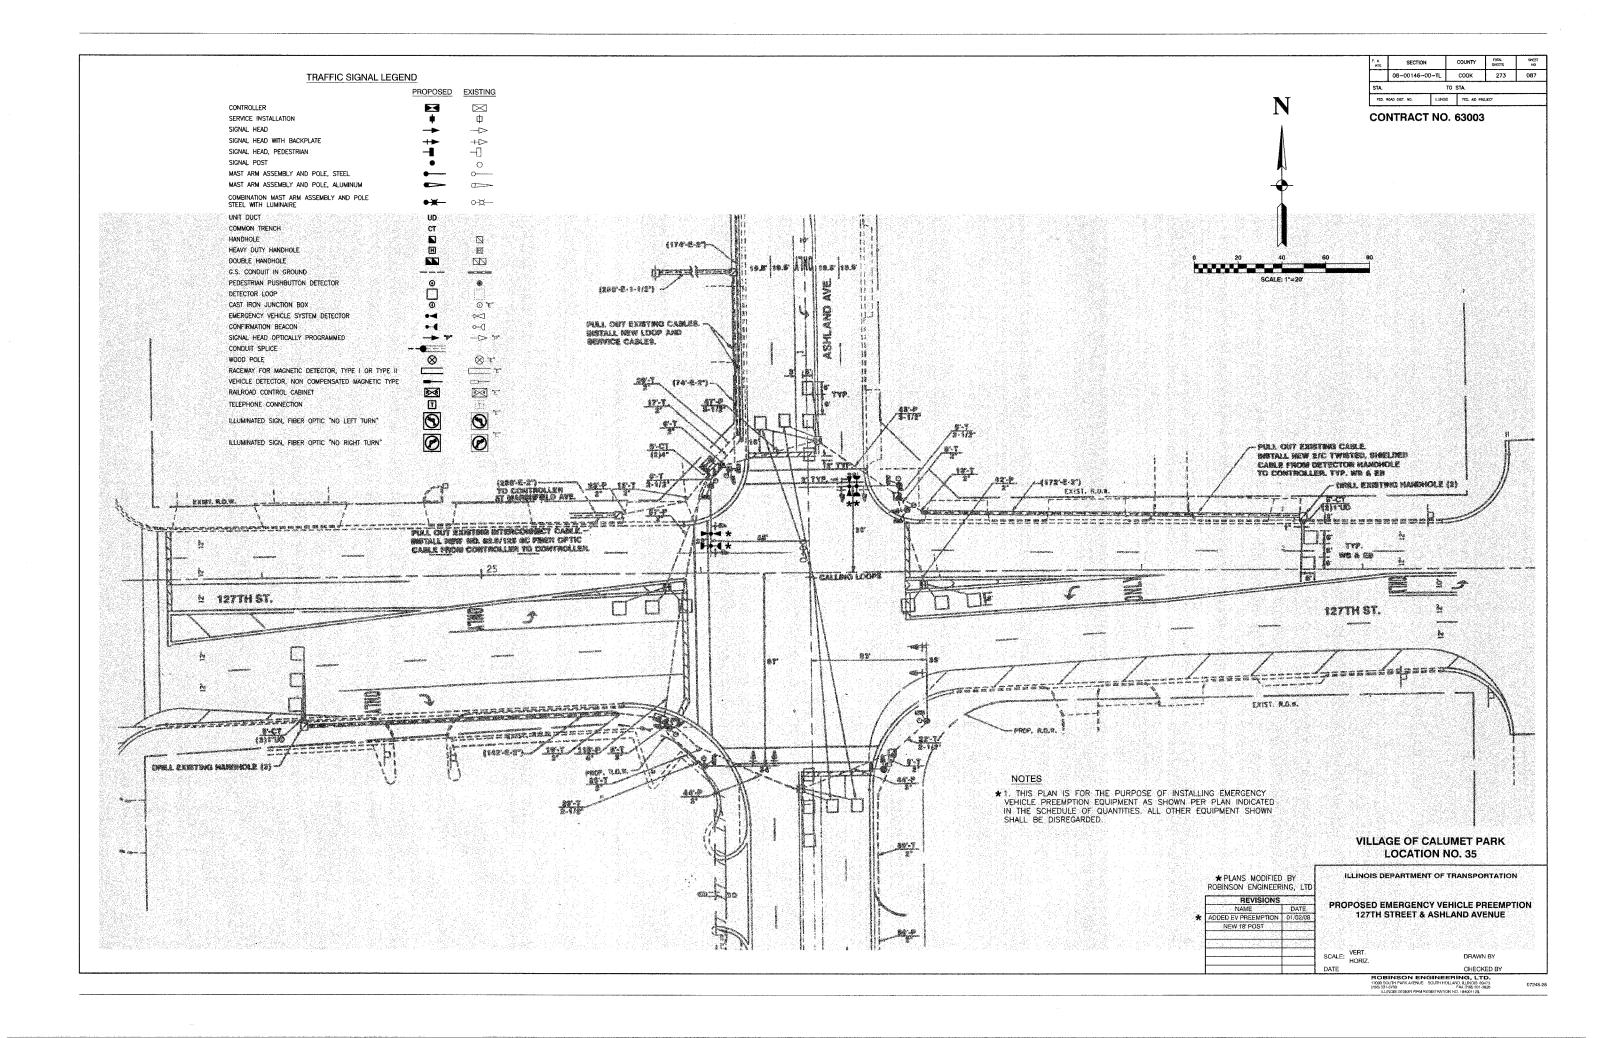



8" TRAFFIC SIGNAL SECTION

12" TRAFFIC SIGNAL SECTION

12" PEDESTRIAN SIGNAL SECTION

CABLE PLAN LEGEND

G

EXISTING


0

 $\mathbb{R}$ 

W

## CONTROLLER SEQUENCE IV

FERRING TO STANDARD 2393. THE VEHICULAR AND PEDESTRIAN IASES USED ARE DESIGNATED BELOW.

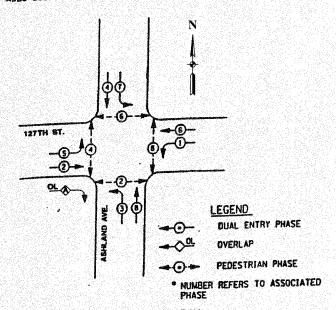

## PHASE DESIGNATION DIAGRAM

DUAL ENTRY - ALL LEGS PROTECTED/PERMITTED LEFT TURN PHASING WITH RIGHT TURN OVERLAPS


## RIGHT THEM OVERLAP PHASE DESIGNATION

OVERLAP DISPLAY LETTER 2 \*

DISPLAY - THE YELLOW RIGHT ARROW OF THE OVERLAP SHALL BE INHIBITED DURING THE PERMISSIVE PHASE'S YELLOW INTERVAL. THE GREEN RIGHT ARROW OF THE OVERLAP SHALL BE INHIBITED DURING THE PERIISSIVE PHASE'S GREEN INTERVAL.

## CLEARANCE MOTES FOR RIGHT TURN OVERLAPS WITH 5-SECTION RIGHT TURN SIGNAL HEAD DISPLAYS

- 1. CONTINUATION OF AN OVERLAP DURING ITS PERMISSIVE PHASE SHALL BE WITH A CIRCULAR YELLOW DISPLAYED TOGETHER WITH A GREEN RIGHT ARROW WHEN FOLLOWED BY THAT OVERLAP'S PROTECTED PHASE.
- 2. TERMINATION OF AN OVERLAP DURING ITS PERMISSIVE PHASE SHALL BE WITH A CIRCULAR YELLOW WHEN NOT FOLLOWED BY THAT OVERLAP'S
- 3. CONTINUATION OF AN OVERLAP DURING ITS PROTECTED PHASE SHALL BE WITH A CIRCULAR RED DISPLAYED TOGETHER WITH A GREEN RIGHT ARROW WHEN FOLLOWED BY THAT OVERLAP'S PERHISSIVE PHASE.
- 4. TERMINATION OF AN OVERLAP DURING ITS PROTECTED PHASE SHALL BE WITH A CIRCULAR RED DISPLAYED TOGETHER WITH A YELLOW RIGHT ARROW WHEN NOT FOLLOWED BY THAT OVERLAP'S PERMISSIVE PHASE.

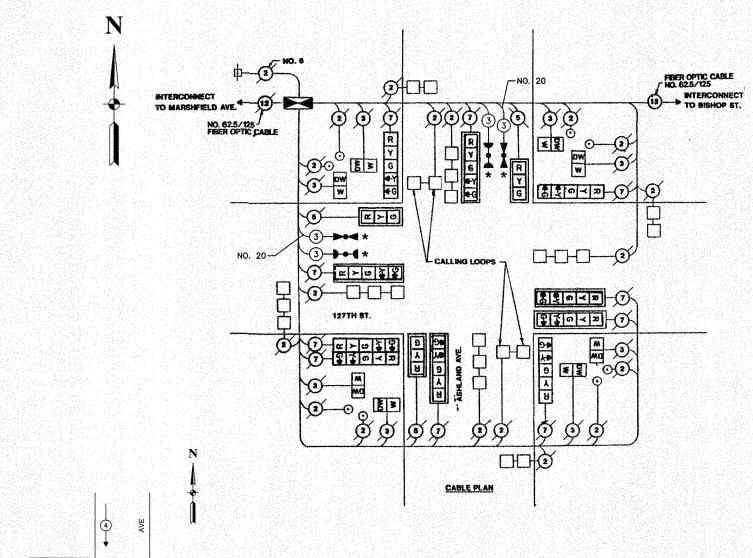

<del>-3-+</del>	1		ST
	CAND (	1	
	ASHL	Ϋ́	
	Hat Mary		

127TH

## EMERGENCY VEHICLE PREEMPTION SEQUENCE

PROPOSED EMERGENCT VEHICLE	ROPOSED EMERGENCY VEHICLE PREEMPTORS				
EMERGENCY VEHICLE PREEMPTOR	3	4			
MOVEMENT	<b>←</b>				

SCHEDULE OF QUANTITIES				
PAYITEM	UNIT	QUANTITY		
MAINTENANCE OF EXISTING TRAFFIC SIGNAL INSTALLATION	EACH	1		
ELECTRIC CABLE IN CONDUIT, SIGNAL NO. 14 3C	FOOT	259		
LIGHT DETECTOR	EACH	2		
IGHT DETECTOR AMPLIFIER	EACH	1		
ELECTRIC CABLE IN CONDUIT NO. 20 3/C, TWISTED, SHIELDED	FOOT	259		
		1 1120 110		

\*1. THIS PLAN IS FOR THE PURPOSE OF INSTALLING EMERGENCY VEHICLE PREEMPTION EQUIPMENT AS SHOWN PER PLAN INDICATED IN THE SCHEDULE OF QUANTITIES. ALL OTHER EQUIPMENT SHOWN SHALL BE DISREGARDED.

18432		
$\bowtie$	Ħ	CONTROLLER CABINET
-	-	SERVICE INSTALLATION
20	11	TELEPHONE CONNECTION
□—		MAGNETIC DETECTOR
⊳	<b>&gt;•</b>	EMERGENCY VEHICLE LIGHT DETECTOR
Do	<b>)-</b> •	CONFIRMATION BEACON
•	0	PUSHBUTTON DETECTOR
		VEHICLE DETECTOR, INDUCTION LOOP
<u></u> 2	2	DENOTES NUMBER OF CONDUCTORS. ALL CABLE NO. 14 EXCEPT AS INDICATED. ALL LOOP DETECTOR CABLE TO BE SHIELDED.
"b"	4 8 8 4 5 6 4 5	SIGNAL FACE WITH BACKPLATE "P" INDICATES PROGRAMMED HEAD
"E" 🔀	M	RAILROAD CONTROL CABINET
"E" <b>(5)</b>	9	ILLUMNATED SIGN, FIBOR OPTRIC "NO LEFT TURN"
"E" <b>(S</b> )		ILLUMINATED SIGN, FIBOR OPTRIC "NO RIGHT TURN"
H/¢ (∭-0	H/C -  ├ <b>-</b>	GROUND ROD AT HANDHOLE, DOUBLE HANDHOLE, OR CONTROLLER
°l⊬o	ீ <b>⊪•</b>	GROUND ROD AT POST OR MAST ARM POLE
\$ ⊮⊸	s∥⊷	GROUND ROD AT ELECTRIC SERVICE INSTALLATION


### VILLAGE OF CALUMET PARK LOCATION NO. 35

\* PLANS MODIFIED BY ILLINOIS DEPARTMENT OF TRANSPORTATION ROBINSON ENGINEERING, LTD ADDED EV PREEMPTION 01/02/08

PROPOSED EMERGENCY VEHICLE PREEMPTION CABLE PLAN, PHASE DESIGNATION DIAGRAM & SCHEDULE OF QUANTITIES 127TH STREET & ASHLAND AVENUE

SCALE: VERT. HORIZ.


CHECKED BY

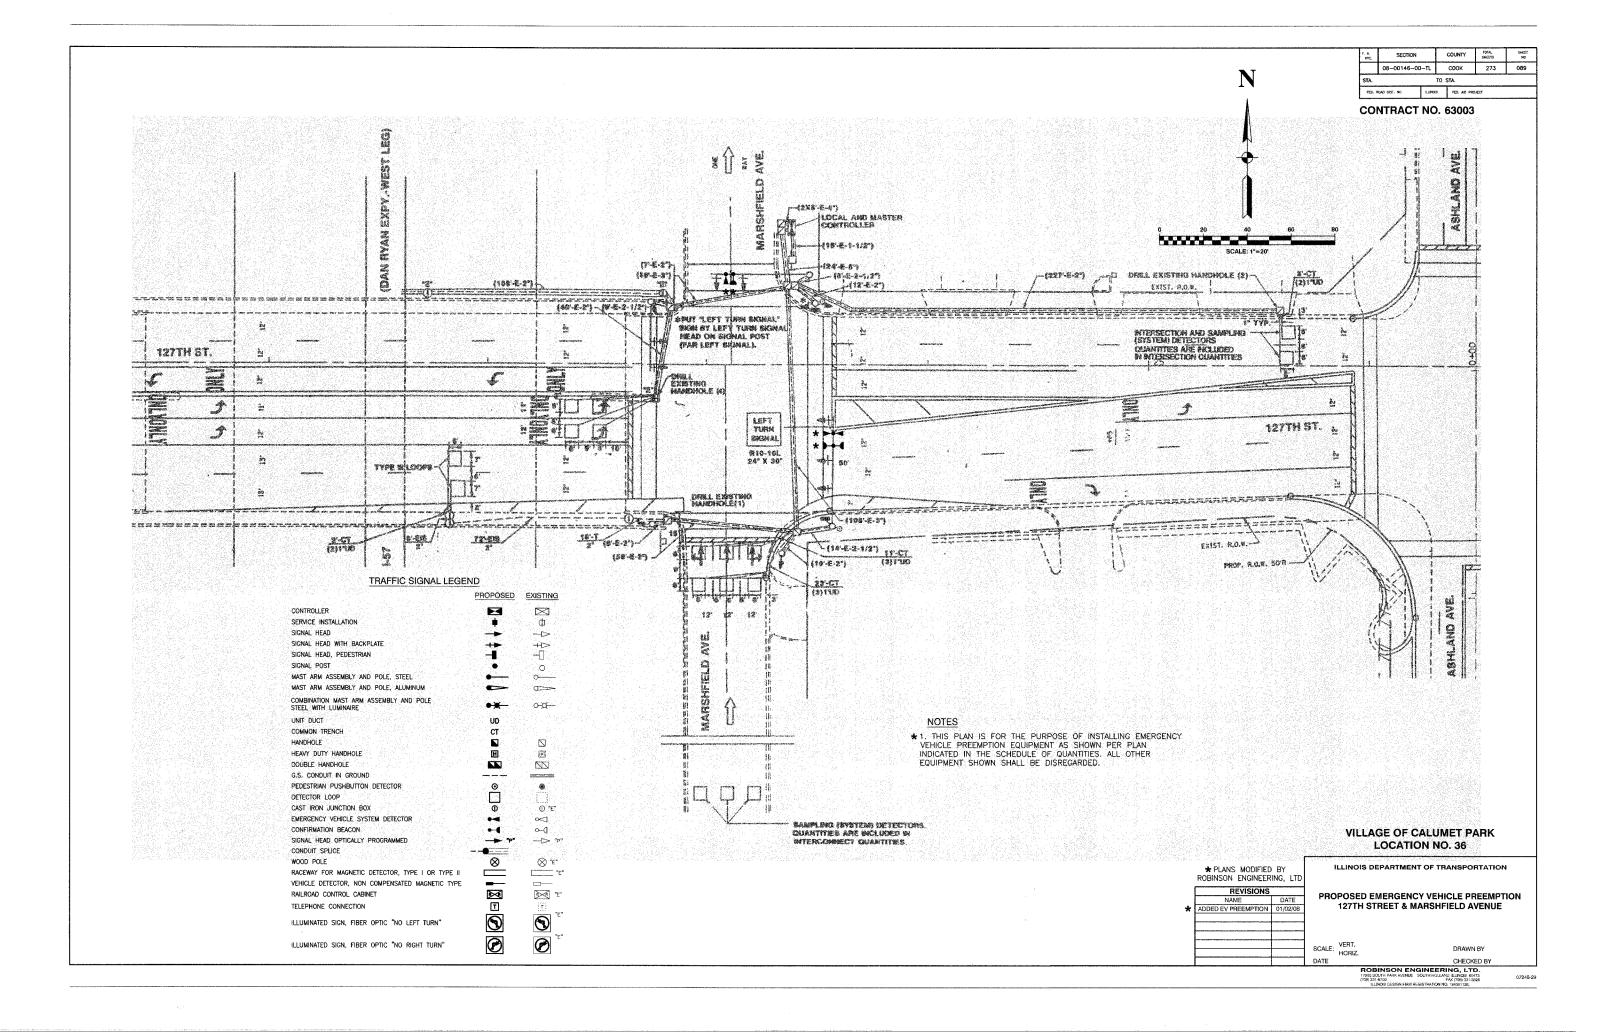




CABLE PLAN LEGEND

EXISTING

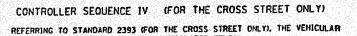

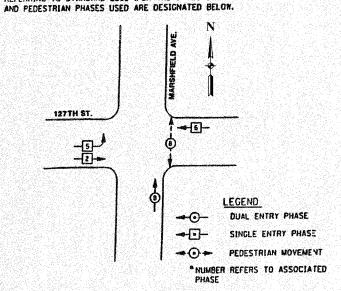


#### PHASE DESIGNATION DIAGRAM SINGLE ENTRY - ARTERIAL LEGS ONLY - PROTECTED ONLY LEFT TURN PHASING DUAL ENTRY - CROSS STREET LEGS ONLY - PROTECTED/PERMITTED LEFT TURN PHASING

## SINGLE ENTRY PHASING NOTES (FOR THE ARTERIAL LEGS ONLY)


- 1. A PHASE IN ONE RING CAN BE SELECTED AND TIMED ALONE IF THERE IS NO DEMAND FOR SERVICE IN A NON-CONFLICTING PHASE ON THE PARALLEL RING ONLY ON THE ARTERIAL'S SIDE OF THE BARRIER.
- 2. A SINGLE PHASE SELECTED AS STATED IN NOTE 1 SHALL ONLY TERMINATE TO THE CONFLICTING PHASE ON THE SAME SIDE OF THE BARRIER OR TO ANY CONCURRENT PHASES ON THE OTHER SIDE OF THE BARRIER.
- 3. ONCE CONCURRENT TIMING OF BOTH RINGS OCCURS ON THE ARTERIAL'S SIDE OF THE BARRIER. THE ASSOCIATED CONCURRENT PHASES SHALL ONLY CLEAR TO OTHER CONCURRENT PHASES ON THE SAME SIDE OF THE BARRIER OR TO ANY CONCURRENT PHASES ON THE OTHER SIDE OF THE BARRIER.
- 4. TERMINATION OF A PHASE SHALL BE WITH A YELLOW INDICATION FOLLOWED BY A RED INDICATION.
- 5. IN FLASHING MODE. ALL VEHICULAR SIGNAL FACES SHALL FLASH RED AND ALL PEDESTRIAN SIGNAL FACES SHALL BE DARK.

## - DUAL ENTRY PHASING NOTES (FOR THE CROSS STREET LEGS ONLY)

PHASES SHOWN ON THE CROSS STREET SHALL BE THE ONLY PHASES FOR WHICH STANDARD 2393 IS UTILIZED.

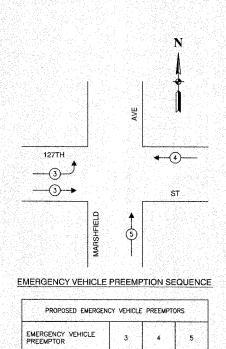

MOVEMENT

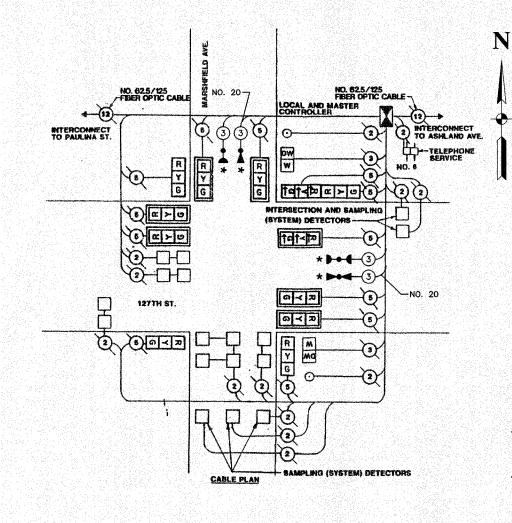

		게 돌아가지 뛰었습니다. 장사에 가게 하는 사람들이다.
<u>o</u>	<b>G</b>	8" TRAFFIC SIGNAL SECTION
<b>®</b>	R	12" TRAFFIC SIGNAL SECTION
W	W	12" PEDESTRIAN SIGNAL SECTION
	8	12" PEDESTRIAN SIGNAL SECTION
$\boxtimes$	H	CONTROLLER CABINET
+	-	SERVICE INSTALLATION
Œ	Ш	TELEPHONE CONNECTION
		MAGNETIC DETECTOR
⊳	- ▶	EMERGENCY VEHICLE LIGHT DETECTOR
D—≎	)-•	CONFIRMATION BEACON
•	0	PUSHBUTTON DETECTOR
		VEHICLE DETECTOR, INDUCTION LOOP
Ø	2	DENOTES NUMBER OF CONDUCTORS. ALL CABLE NO. 14 EXCEPT AS INDICATED. ALL LOOP DETECTOR CABLE TO BE SHIELDED.
, © (COC)	*P*	SIGNAL FACE WITH BACKPLATE "P" INDICATES PROGRAMMED HEAD
	M	RAILROAD CONTROL CABINET
9	9	ILLUMINATED SIGN, FIBOR OPTRIC "NO LEFT TURN"
R		ILLUMINATED SIGN, FIBOR OPTRIC "NO RIGHT TURN"

SCHEDULE OF QUANTITIES				
PAYITEM	UNIT	QUANTITY		
MAINTENANCE OF EXISTING TRAFFIC SIGNAL INSTALLATION	EACH	1		
ELECTRIC CABLE IN CONDUIT, SIGNAL NO. 14 3C	FOOT	391		
LIGHT DETECTOR	EACH	2		
LIGHT DETECTOR AMPLIFIER	EACH	1		
ELECTRIC CABLE IN CONDUIT NO. 20 3/C, TWISTED, SHIELDED	FOOT	391		

\* 1. THIS PLAN IS FOR THE PURPOSE OF INSTALLING EMERGENCY VEHICLE PREEMPTION EQUIPMENT AS SHOWN PER PLAN INDICATED IN THE SCHEDULE OF QUANTITIES, ALL OTHER EQUIPMENT SHOWN SHALL BE DISREGARDED.

## VILLAGE OF CALUMET PARK LOCATION NO. 36

GROUND ROD AT HANDHOLE, DOUBLE HANDHOLE, OR CONTROLLER


GROUND ROD AT POST OR MAST ARM POLE

 
GROUND ROD AT ELECTRIC SERVICE INSTALLATION

\* PLANS MODIFIED BY ILLINOIS DEPARTMENT OF TRANSPORTATION ROBINSON ENGINEERING, LTD PROPOSED EMERGENCY VEHICLE PREEMPTION CABLE PLAN, PHASE DESIGNATION DIAGRAM & SCHEDULE OF QUANTITIES 127TH STREET & MARSHFIELD AVENUE SCALE: VERT. HORIZ.


CHECKED BY

DRAWN BY

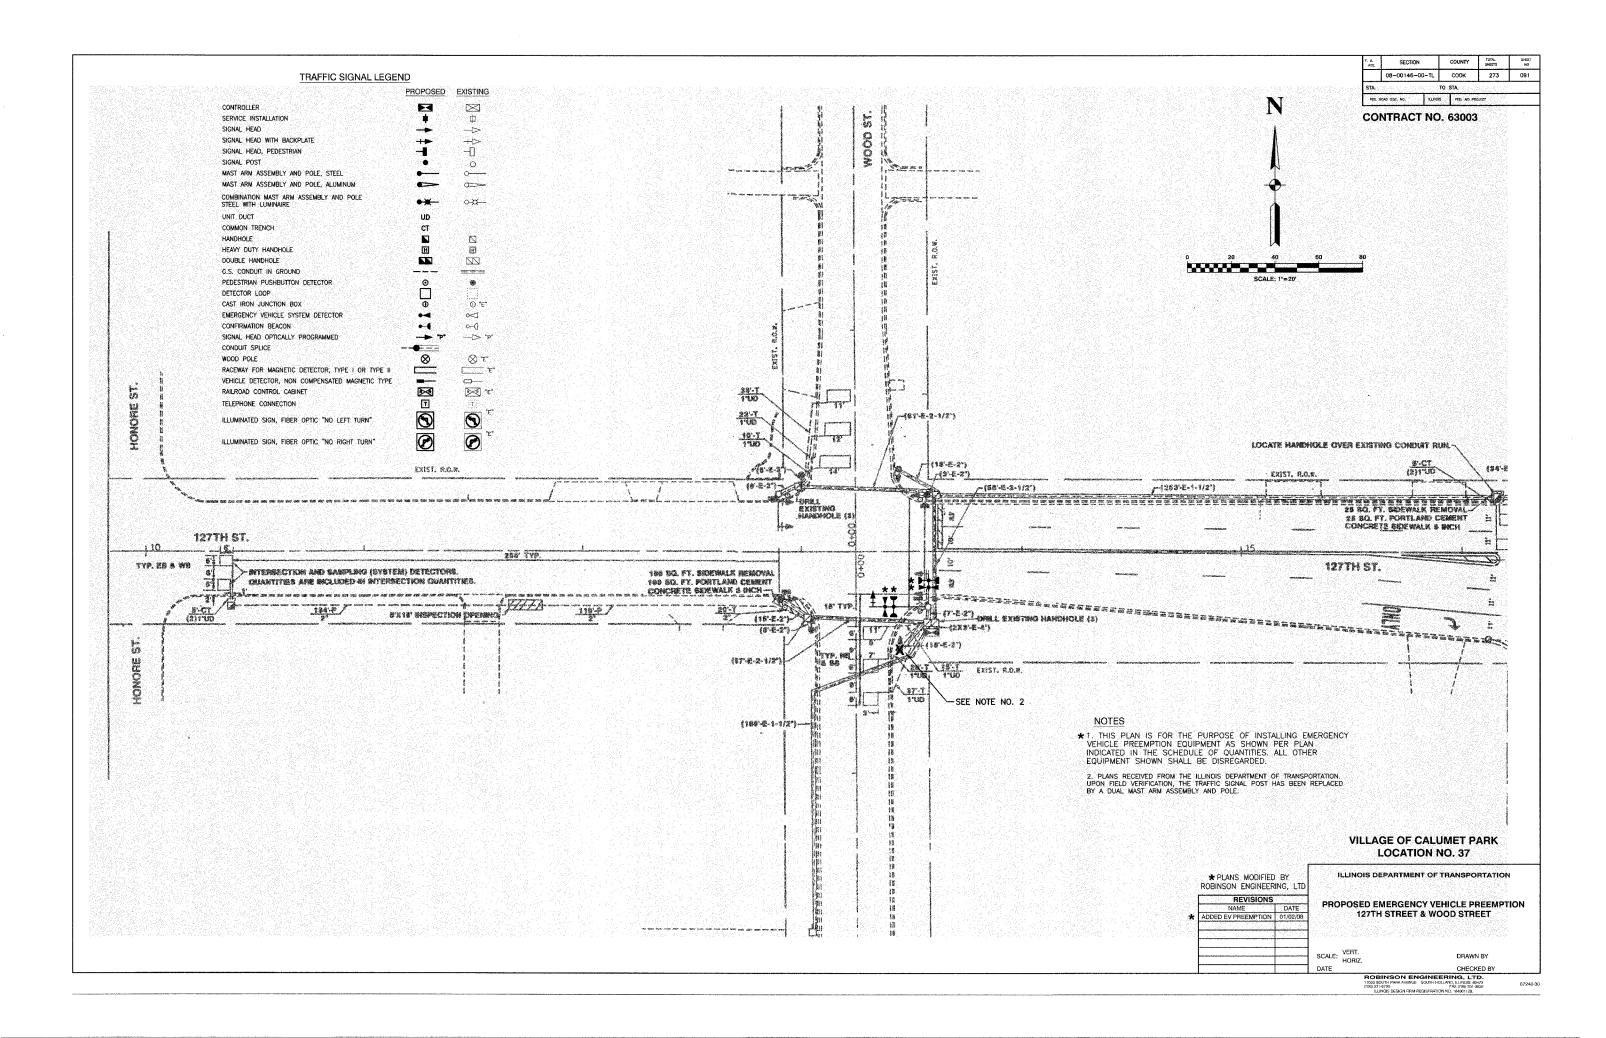





REFERRING TO STANDARD 2393, THE VEHICULAR AND PEDESTRIAN PHASES USED ARE DESIGNATED BELOW.

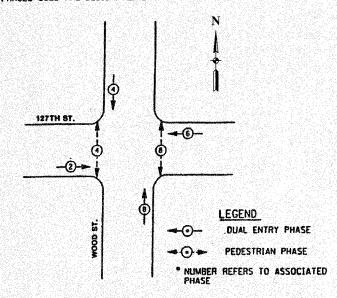

## PHASE DESIGNATION DIAGRAM

DUAL ENTRY - ALL LEGS PROTECTED/PERMITTED LEFT TURN PHASING

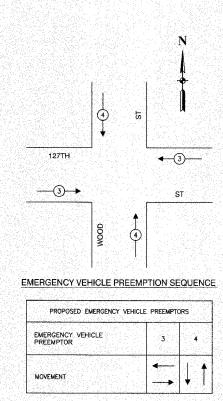

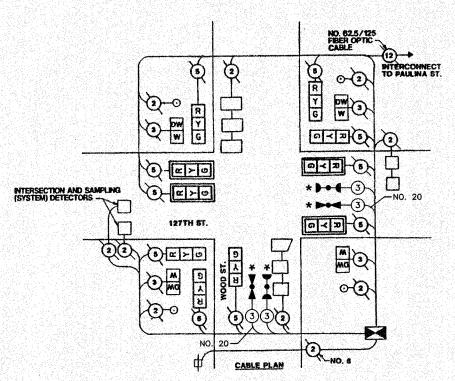

			NO 625/129 FIBER OPTIC CABLE	_}}_
	© RVG		O DW N	INTERCONNECT TO PAULINA ST.
INTERSECTION AND SAMPLING (SYSTEM) DETECTORS	\$ - E > O \$ - E > O 127TH ST.			
- QC		**************************************	# Q • Q	
	NO.	20 CABLE PLAN	Q-No. s	5

F. A. RIE.	SECTION	COUNTY	TOTAL SHEETS	SHEET NO
	08-00146-00-TL	COOK	273	092
STA.		TO STA.		
FED. F	ROAD DIST. NO	IS FEC. AID PRO	JECT	

## CONTRACT NO. 63003

## CABLE PLAN LEGEND

**G** 8" TRAFFIC SIGNAL SECTION 12" TRAFFIC SIGNAL SECTION 12" PEDESTRIAN SIGNAL SECTION

 $\mathbb{R}$ W W  $\boxtimes$ M -

EXISTING 0

Œ

 $\triangleright$ 0

D-0

Ø

CONTROLLER CABINET SERVICE INSTALLATION ◨ TELEPHONE CONNECTION

MAGNETIC DETECTOR EMERGENCY VEHICLE LIGHT DETECTOR CONFIRMATION BEACON

PUSHBUTTON DETECTOR VEHICLE DETECTOR, INDUCTION LOOP

DENOTES NUMBER OF CONDUCTORS. ALL CABLE NO. 14 EXCEPT AS INDICATED.
ALL LOOP DETECTOR CABLE TO BE SHIELDED.

12" PEDESTRIAN SIGNAL SECTION

SIGNAL FACE WITH BACKPLATE "P" INDICATES PROGRAMMED HEAD

"E" 🔀

 $\boxtimes$ 

ILLUMINATED SIGN, FIBOR OPTRIC "NO LEFT TURN"

RAILROAD CONTROL CABINET

"NO RIGHT TURN"

ILLUMINATED SIGN, FIBOR OPTRIC

11-0 11-0

GROUND ROD AT HANDHOLE, DOUBLE HANDHOLE, OR CONTROLLER

GROUND ROD AT POST OR MAST ARM POLE



GROUND ROD AT ELECTRIC SERVICE INSTALLATION

#### SCHEDULE OF QUANTITIES UNIT PAY ITEM QUANTITY MAINTENANCE OF EXISTING TRAFFIC SIGNAL INSTALLATION. EACH ELECTRIC CABLE IN CONDUIT, SIGNAL NO. 14 3C FOOT 146 LIGHT DETECTOR EACH 2 LIGHT DETECTOR AMPLIFIER FOOT ELECTRIC CABLE IN CONDUIT NO. 20 3/C, TWISTED, SHIELDED 146

## NOTE

\*1. THIS PLAN IS FOR THE PURPOSE OF INSTALLING EMERGENCY VEHICLE PREEMPTION EQUIPMENT AS SHOWN PER PLAN INDICATED IN THE SCHEDULE OF QUANTITIES. ALL OTHER EQUIPMENT SHOWN SHALL BE DISREGARDED.

## VILLAGE OF CALUMET PARK LOCATION NO. 37


ILLINOIS DEPARTMENT OF TRANSPORTATION


\* PLANS MODIFIED BY ROBINSON ENGINEERING, LTD REVISIONS


PROPOSED EMERGENCY VEHICLE PREEMPTION CABLE PLAN, PHASE DESIGNATION DIAGRAM & NAME DATE
ADDED EV PREEMPTION 01/02/08
NEW 18' POST SCHEDULE OF QUANTITIES 127TH STREET & WOOD STREET

SCALE: VERT. HORIZ.

DRAWN BY CHECKED BY

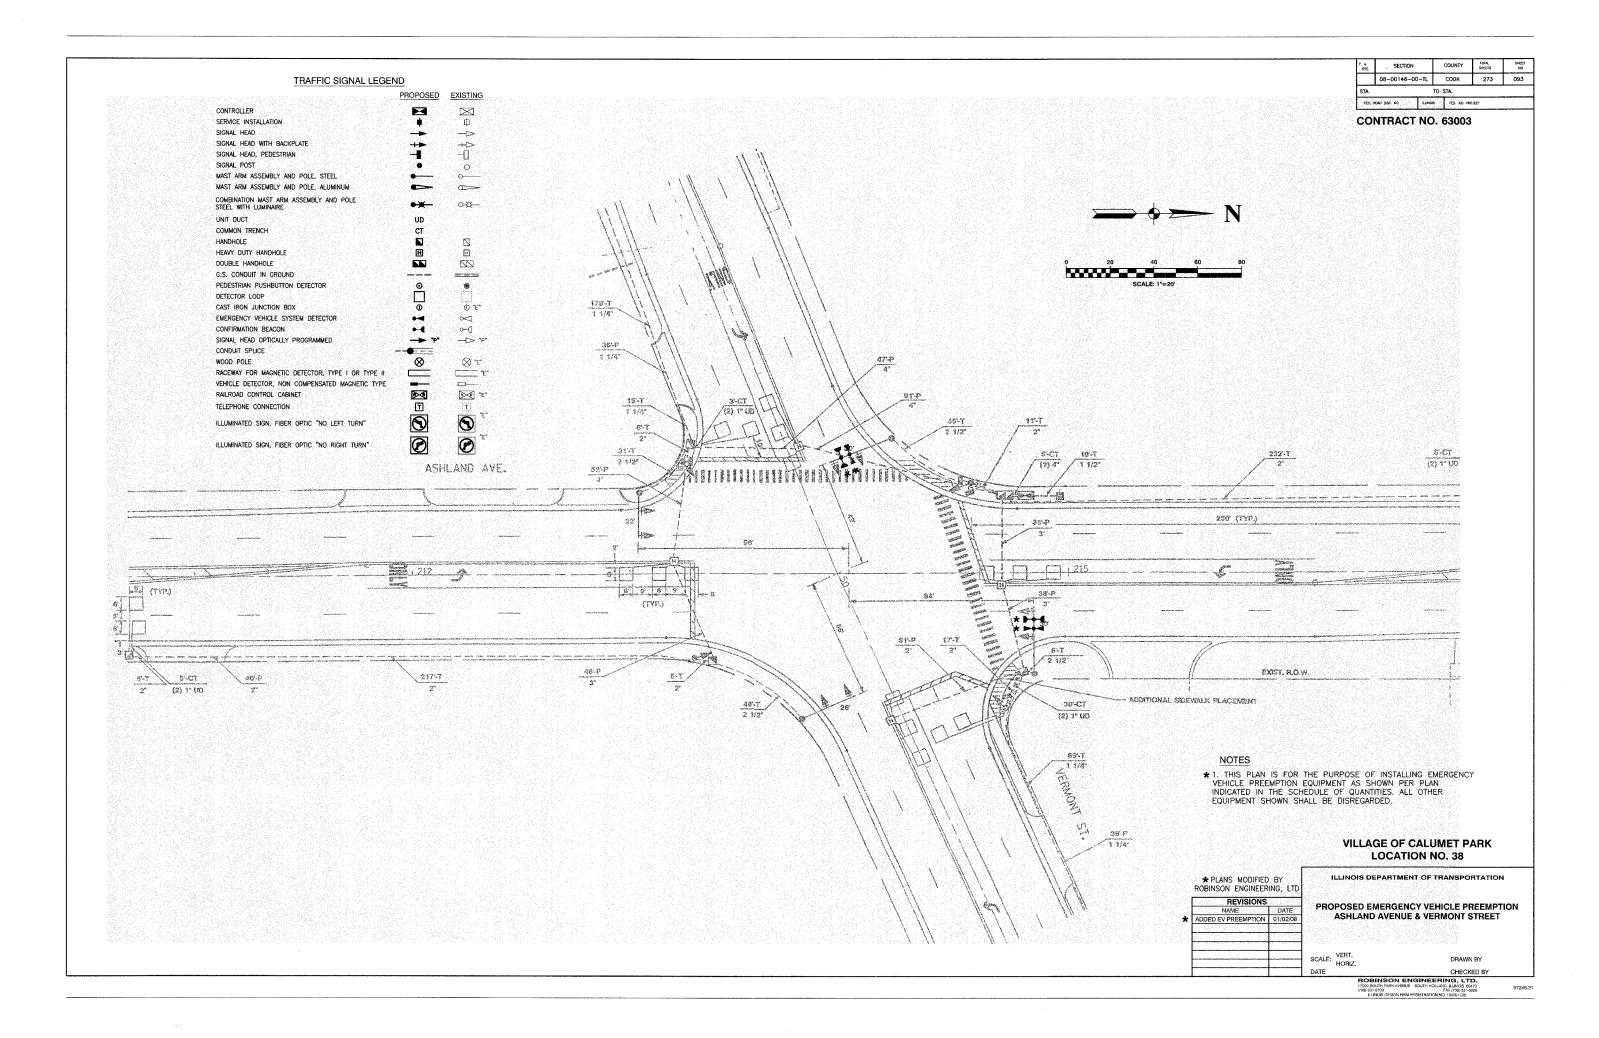

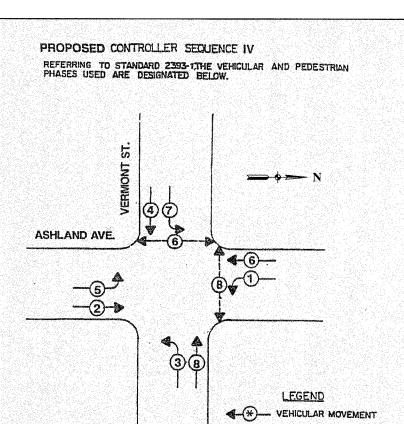

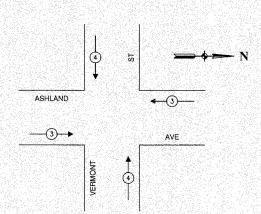


PHASE DESIGNATION DIAGRAM

\* NUMBER REFERS TO ASSOCIATED PHASE

## EMERGENCY VEHICLE PREEMPTION SEQUENCE

4	PROPOSED	EMERGENCY	VEHICLE	PREEMPTO	DRS
	EMERGENCY VE PREEMPTOR	EHICLE		3	4
	MOVEMENT			<b>←</b>	1

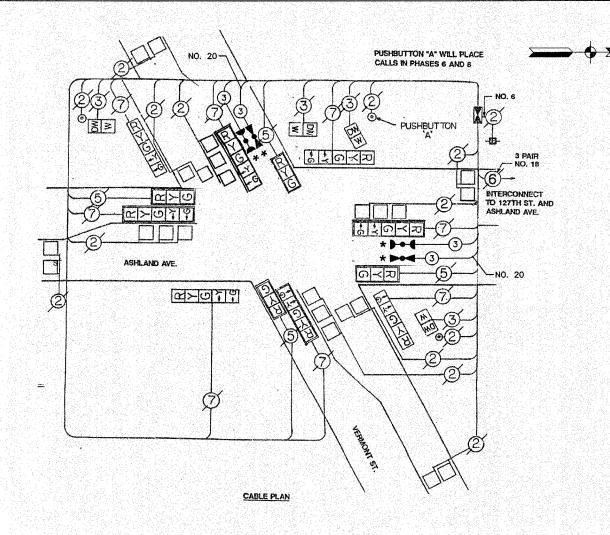

SCHEDULE OF QUANTITIES							
PAYITEM	UNIT	QUANTITY					
MAINTENANCE OF EXISTING TRAFFIC SIGNAL INSTALLATION	EACH	1					
ELECTRIC CABLE IN CONDUIT, SIGNAL NO. 14 3C	FOOT	294					
LIGHT DETECTOR	EACH	2					
LIGHT DETECTOR AMPLIFIER EACH		1					
ELECTRIC CABLE IN CONDUIT NO. 20 3/C, TWISTED, SHIELDED	FOOT	294					

## NOTE

★1. THIS PLAN IS FOR THE PURPOSE OF INSTALLING EMERGENCY VEHICLE PREEMPTION EQUIPMENT AS SHOWN PER PLAN INDICATED IN THE SCHEDULE OF QUANTITIES. ALL OTHER EQUIPMENT SHOWN SHALL BE DISREGARDED.

r. a. Rte.			COUNTY	TOTAL SHEETS	SHEET NO	
			COOK	273	094	
STA.	L TO STA.					
FED. ROAD DIST. NO. ILLINOI		ILLINOIS	PED. AID PROJECT			

CONTRACT NO. 63003

### CABLE PLAN LEGEND

EXISTING	PROPOSED
	<u></u>
R	R
W	W
	佩
(67A)	•
$\square$	
-74	-
Π	Ш
$\triangleright$	<b>&gt;•</b>

D-0

Ø

· (00000

"E" 🔯

8" TRAFFIC SIGNAL SECTION

12" TRAFFIC SIGNAL SECTION

12" PEDESTRIAN SIGNAL SECTION
12" PEDESTRIAN SIGNAL SECTION

CONTROLLER CABINET

SERVICE INSTALLATION

TELEPHONE CONNECTION

MAGNETIC DETECTOR

EMERGENCY VEHICLE LIGHT DETECTOR

CONFIRMATION BEACON

PUSHBUTTON DETECTOR

VEHICLE DETECTOR, INDUCTION LOOP
DENOTES NUMBER OF CONDUCTORS.
ALL CABLE NO. 14 EXCEPT AS INDICATED.
ALL LOOP DETECTOR CABLE TO BE SHIELDED.

SIGNAL FACE WITH BACKPLATE
"P" INDICATES PROGRAMMED HEAD

RAILROAD CONTROL CABINET

ILLUMINATED SIGN, FIBOR OPTRIC
"NO LEFT TURN"

ILLUMINATED SIGN, FIBOR OPTRIC
"NO RIGHT TURN"

GROUND ROD AT HANDHOLE, DOUBLE HANDHOLE, OR CONTROLLER

GROUND ROD AT POST OR MAST ARM POLE

GROUND ROD AT ELECTRIC SERVICE INSTALLATION

## VILLAGE OF CALUMET PARK LOCATION NO. 38

ILLINOIS DEPARTMENT OF TRANSPORTATION


PROPOSED EMERGENCY VEHICLE PREEMPTION CABLE PLAN, PHASE DESIGNATION DIAGRAM & SCHEDULE OF QUANTITIES ASHLAND AVENUE & VERMONT STREET


SCALE: VERT. HORIZ.


CHECKED BY


ROBINSON ENGINEERING, LTD.
17000 SOUTH PARK AVENUE SOUTH HOLLAND, BLINGIS 50473
17908 331-6700 FAX 77081 331-8288


07248-

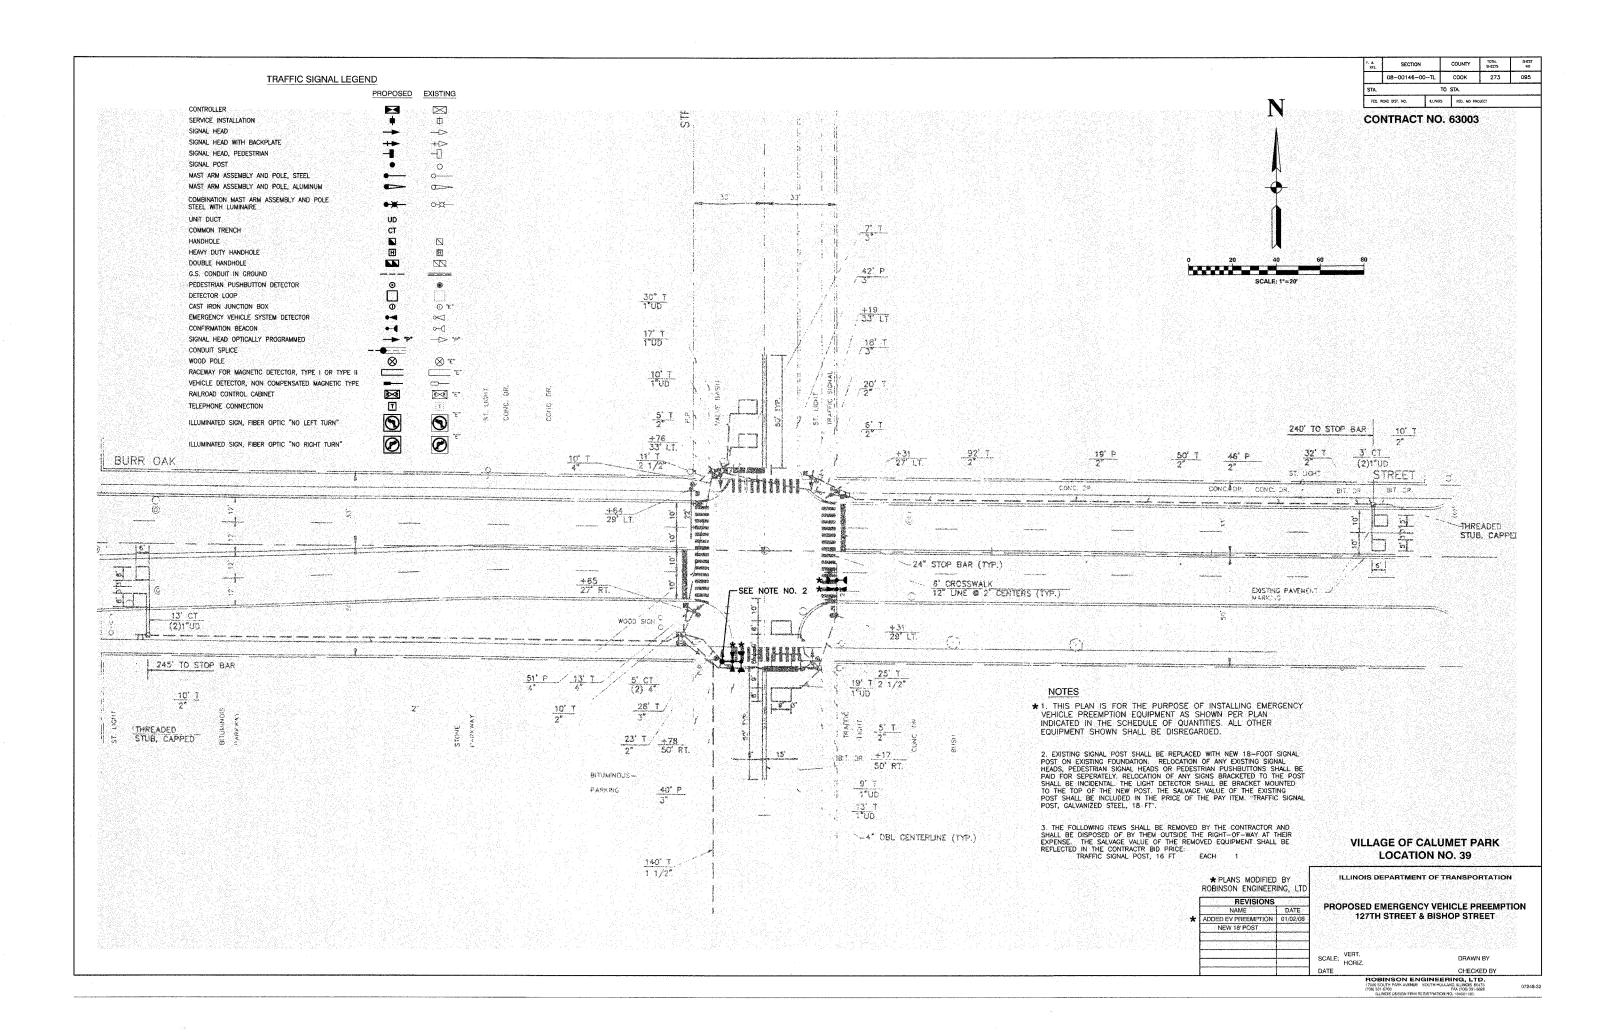


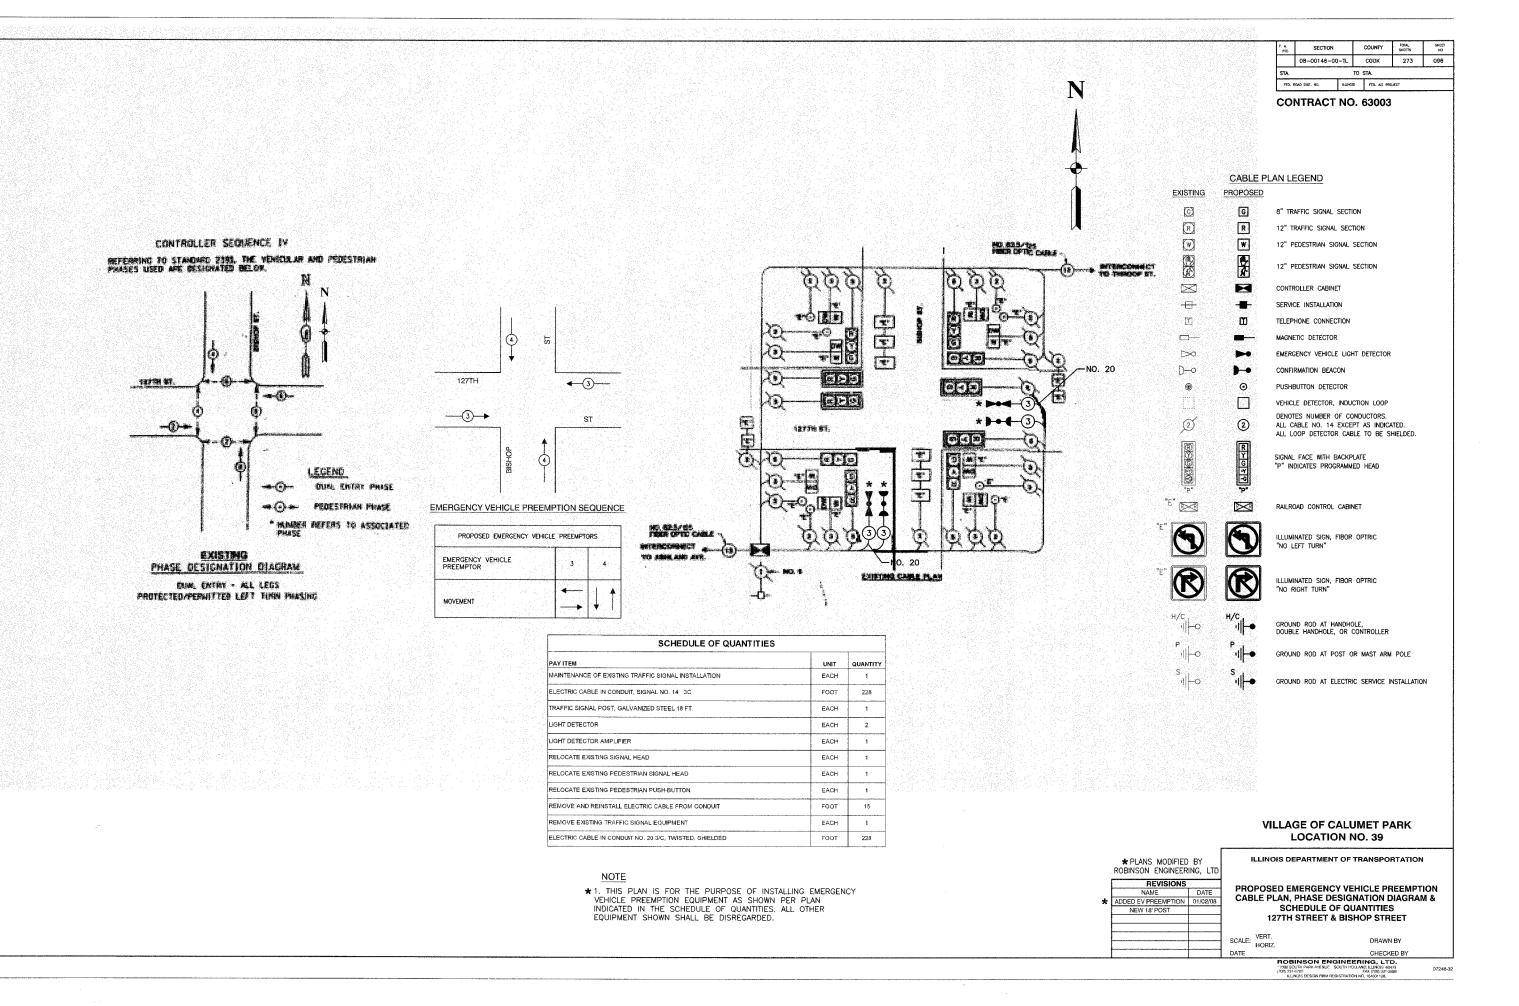

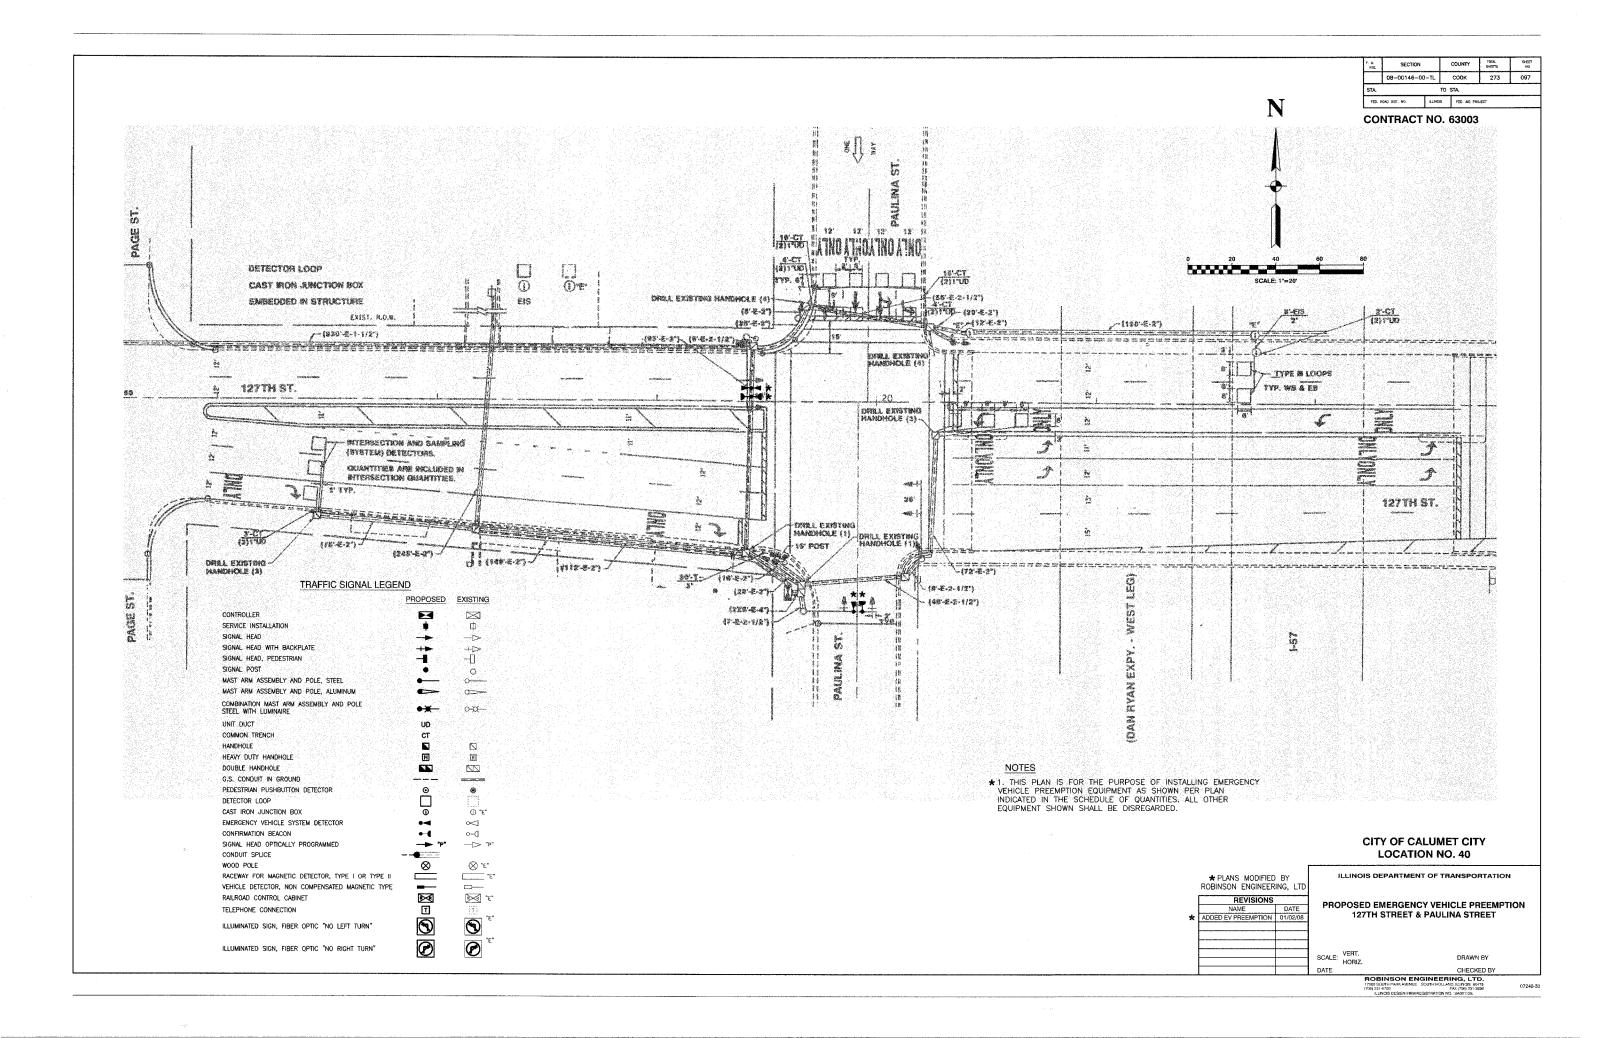

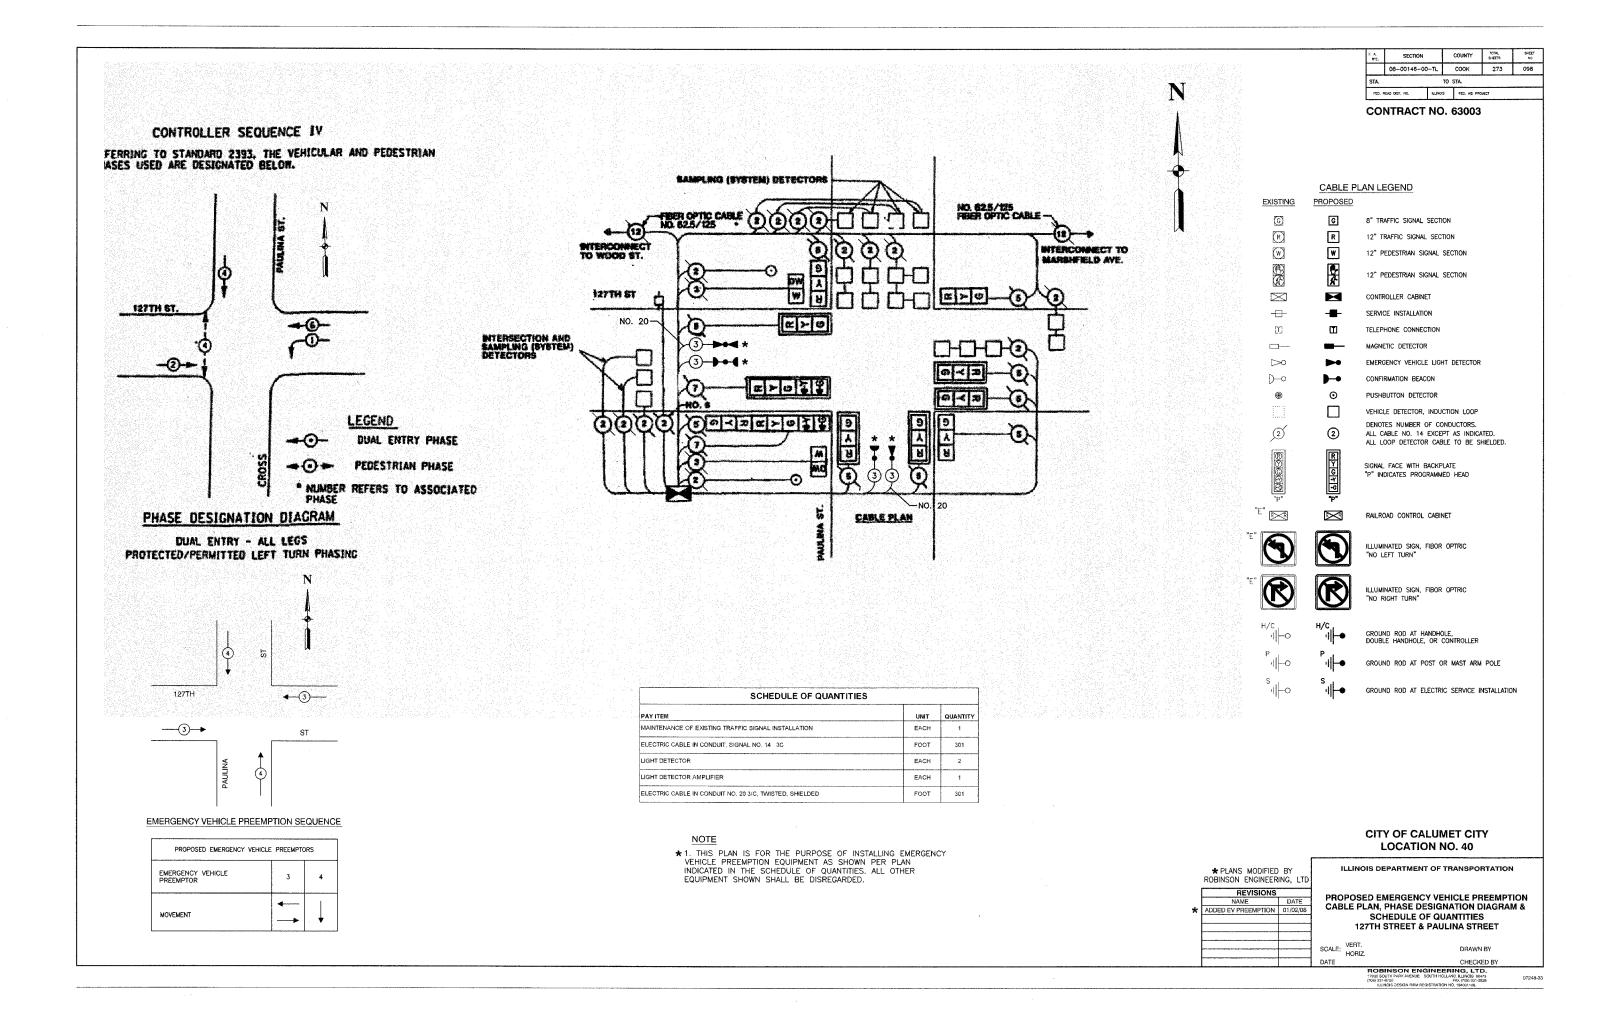

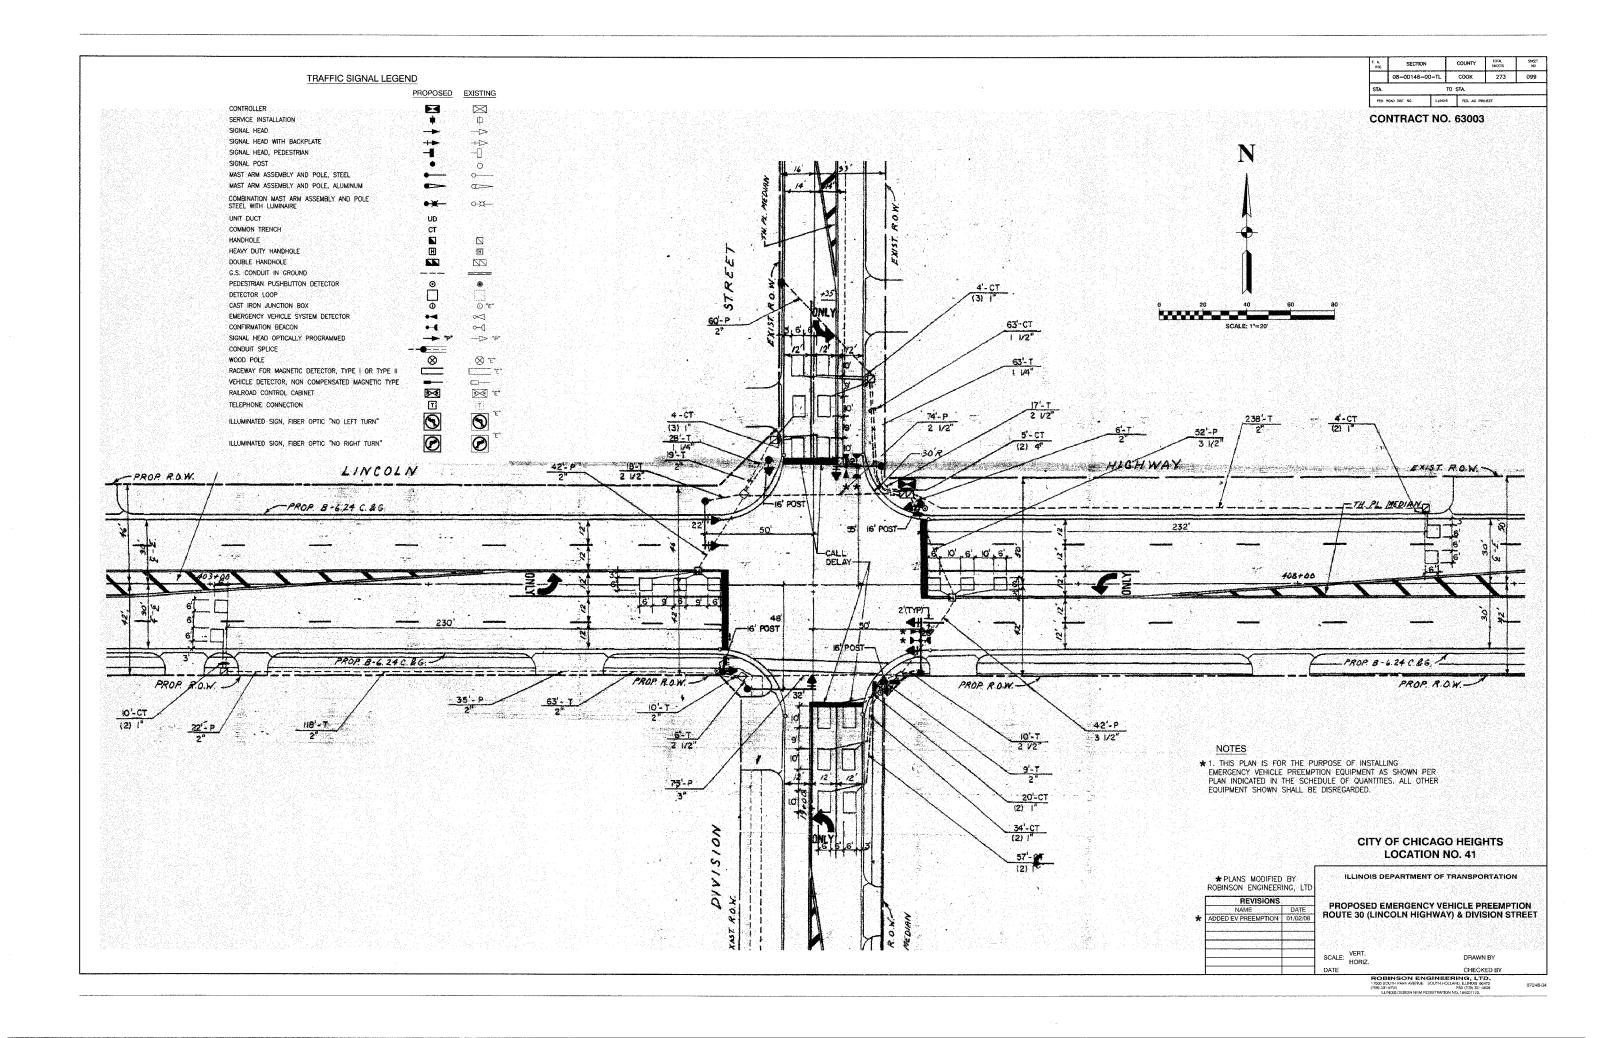

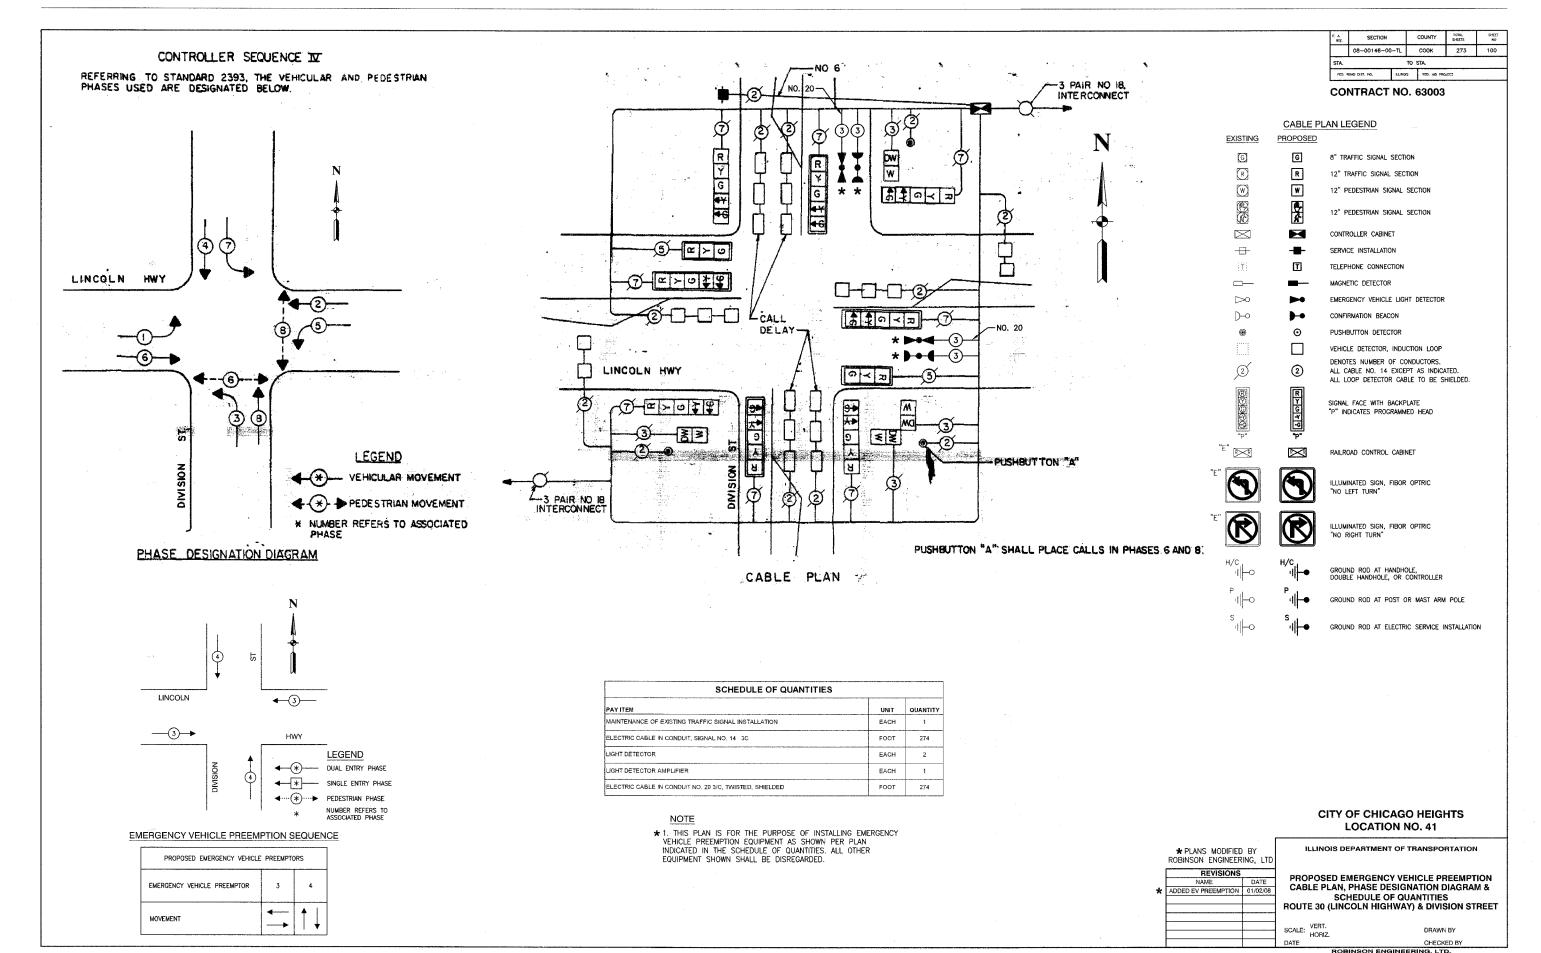

07248-34