TOTAL SHEET ROUTE **SECTION** COUNTY **SHEETS** NUMBER COOK & WILL **VARIOUS** 2010-069-I 34 X

FOR INDEX OF SHEETS SEE SHEET 2

STATE OF ILLINOIS **DEPARTMENT OF TRANSPORTATION DIVISION OF HIGHWAYS DISTRICT ONE** 

## **PROPOSED HIGHWAY PLANS**

**VARIOUS ROUTES VARIOUS LOCATIONS SECTION 2010-069-I CONCRETE BARRIER WALL AND BRIDGE PARAPET REPAIRS** COOKE WILL COUNTIES C-91-708-10

IMPROVEMENTS ARE LOCATED IN THE CITIES OF CHICAGO, PARK RIDGE, COUNTRY **CLUB HILLS AND IN THE VILLAGES OF NEW** LENOX, LANSING, INDIAN HEAD PARK AND MATTESON.

PROJECT ENGINEER: ROBERT BORO (847) 705-4178 PROJECT MANAGER: ISSAM RAYYAN


CONTRACT NO. 60L54

1 Rev. 6-2-11

¥ 34+5=39

CONTRACT NO. 60L54

D-91-708-10

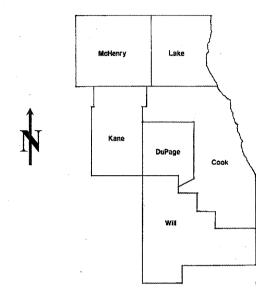

#### STATE OF ILLINOIS **DEPARTMENT OF TRANSPORTATION DIVISION OF HIGHWAYS**

SUBMITTED:

APRIL 7

DIEPUTY DIRECTOR OF HIGHWAYS, REGION ENGINEER

acting ENGINEER OF DESIGN AND ENVIR

# PRINTED BY THE AUTHORITY OF THE STATE OF ILLINOIS

J.U.L.I.E.: JOINT UTILITY LOCATION INFORMATION FOR EXCAVATION (800) 892-0123 OR 811

C.U.A.N CHICAGO UTILITY ALERT NETWORK (312) 744-7000

INDEX OF SHEETS
-----------------

SHEET NO	DESCRIPTION
1	TITLE SHEET
2	INDEX OF SHEETS
3	STATE STANDARDS
$\Lambda$ $(4-4A)$	GENERAL NOTES
5-6	SUMMARY OF QUANTITIES
7	SCHEDULE OF QUANTITIES
8	TYPICAL REPAIR FOR FULL DEPTH (BARRIER WALL)
9	TYPICAL REPAIR FOR HALF DEPTH (BARRIER WALL)
A 10	TYPICAL BRIDGE PARAPET REPAIR DETAILS
(11-12)	REPAIR DETAILS (LOCATION 1)
~~	
13	REPAIR DETAILS (LOCATION 2)
14	REPAIR DETAILS (LOCATION 3)
15	REPAIR DETAILS (LOCATION 4, SN 016-W432, RET. WALL)
16	REPAIR DETAILS (LOCATION 5)
17	REPAIR DETAILS (LOCATION 6)
18	REPAIR DETAILS (LOCATION 7)
19	REPAIR DETAILS (LOCATION 8)
20	LOCATION 9 THRU 12 MAP
21	REPAIR DETAILS (LOCATION 9)
22	REPAIR DETAILS (LOCATION 10-11)
23	REPAIR DETAILS (LOCATION 12)
24	REPAIR DETAILS (LOCATION 13)
25	REPAIR DETAILS (LOCATION 14, SN 016-0076)
26	REPAIR DETAILS (LOCATION 15)

·			TOTAL	SHEET	
ROUTE	SECTION	COUNTY	SHEETS	NUMBER	
VARIOUS	2010-069- l	VARIOUS	34	2	

- 27 REPAIR DETAILS (LOCATION 16, SN 016-0003)
- REPAIR DETAILS (LOCATION 17, SN 016-1084)
- REPAIR DETAILS (LOCATION 18, SN 099-0069)
- 30 REPAIR DETAILS (LOCATION 19, SN 016-1098)
  304. REPAIR DETAILS (LOCATION 20)
  31 TRAFFIC CONTROL & PROTECTION FOR SIDE ROADS, INTERSECTION AND DRIVEWAYS (TC-10)
- TRAFFIC CONTROL & PROTECTION OF TURN BAYS (TO REMAIN OPEN TO TRAFFIC) (TC-14)
- 33 TRAFFIC CONTROL DETAILS FOR FREEWAY SHOULDER CLOSURES AND PARTIAL RAMP CLOSURES (TC-17)
- ARTERIAL ROAD INFORMATION SIGN (TC-22)

34A., 34B. TRAFFIC DETAILS

34C. TC-25

ILLINOIS DEPARTMENT OF TRANSPORTATION

INDEX OF SHEETS

Rev.

		001111777	TOTAL	SHEET
ROUTE	SECTION	COUNTY	SHEETS	NUMBER
VARIOUS	2010-069-I	VARIOUS	34	3

# **STATE STANDARDS**

*	
STD NO	DESCRIPTION
637001 - <i>04</i>	CONCRETE BARRIER 32" HEIGHT
637006 <i>- 02</i>	CONCRETE BARRIER 42" HEIGHT
701101-02	OFF-ROAD OPERATIONS, MULTILANE, 15' TO 24" FROM PAVEMENT EDGE
701400-05	APPROACH TO LANE CLOSURE, FREEWAY/EXPRESSWAY
701401-06	LANE CLOSURE, FREEWAY/EXPRESSWAY
701411- <i>0</i> 7	LANE CLOSURE, MULTILANE, AT ENTRANCE OR EXIT RAMP, FOR SPEEDS ≥ 45 MPH
701601-07	URBAN LANE CLOSURE, MULTILANE, 1W OR 2W WITH NONTRAVERSABLE MEDIAN
701901-01	TRAFFIC CONTROL DEVICES

701446-02

701301-04

ILLINOIS DEPARTMENT OF TRANSPORTATION

STATE STANDARDS

A Rev. 6-2-11

# ROUTE SECTION COUNTY SHEETS NUMBER VARIOUS 2010-069-I VARIOUS 34 4

# **GENERAL NOTES**

BEFORE STARTING ANY EXCAVATION, THE CONTRACTOR SHALL CALL "J.U.L.I.E." AT (800) 892-0123 OR 811. FOR FIELD LOCATIONS OF BURIED ELECTRIC, TELEPHONE AND GAS UTILITIES. 48 HOURS NOTIFICATION IS REQUIRED.

BEFORE STARTING ANY EXCAVATION, THE CONTRACTOR SHALL CALL "C.U.A.N." (CHICAGO UTILITY ALERT NETWORK) AT (312) 744-7000 FOR FIELD LOCATIONS OF BURIED ELECTRIC, TELEPHONE AND GAS UTILITIES. 48 HOURS NOTIFICATION IS REQUIRED.

IT SHALL BE THE CONTRACTOR'S RESPONSIBILITY TO VERIFY ALL DIMENSIONS & CONDITIONS EXISTING IN THE FIELD PRIOR TO CONSTRUCTION & ORDERING OF MATERIALS.

THE CONTRACTOR WILL NOT BE ALLOWED TO SET UP A YARD OR FIELD OFFICE ON STATE PROPERTY WITHOUT WRITTEN PERMISSION FROM THE DEPARTMENT.

THE CONTRACTOR SHALL CONTACT THE DISTRICT ONE TRAFFIC CONTROL SUPERVISOR AT (847) 705-4470 FOR ARTERIALS OR (847)705-4151 FOR EXPRESSWAYS. A MINIMUM OF 72 HOURS IN ADVANCE OF BEGINNING WORK.

THE CONTRACTOR SHALL COORDINATE CONSTRUCTION ACTIVITIES WITH UTILITY COMPANIES.

THESE PLANS HAVE BEEN PREPARED FROM FIELD NOTES RECEIVED FROM MAINTENANCE ENGINEERS.

ALL WORK ASSOCIATED WITH THE REMOVAL AND REPLACEMENT OF THE BARRIER WALL IS INCIDENTAL TO THE PAY ITEM CONCRETE BARRIER WALL REMOVAL AND REPLACMENT.

THE "ARTERIAL ROAD INFORMATION SIGN (TC-22)" IS APPLICABLE ONLY TO ARTERIAL ROADS AND SHALL NOT BE APPLIED TO EXPRESSWAYS.

THE CONTRACTOR SHALL BE REQUIRED TO PROVIDE ACCESS TO ABUTTING PROPERTY AT ALL TIMES DURING THE CONSTRUCTION OF THIS PROJECT.

DO NOT SCALE PLANS FOR CONSTRUCTION DIMENSIONS.

IN SOME CASES, THERE IS A CONDUIT IN THE BASE OF THE BARRIER WALL AND BRIDGE PARAPET. THIS CONDUIT CONTAINS ELECTRICAL AND/OR FIBER OPTIC CABLE. CARE MUST BE TAKEN TO PREVENT DAMAGE TO THIS CONDUIT. IF IT IS DAMAGED, THEN THE CONDUIT WILL NEED TO BE REPAIRED. IF THE ELECTRICAL OR FIBER OPTIC CABLE IS DAMAGED, IT WILL HAVE TO BE REPLACED FROM JUNCTION BOX TO JUNCTION BOX (1500 FT. MIN.). FOR THE LOCATION OF THE CONDUITS, CONTACT ROY LAWSON AT THE TRAFFIC SYSTEMS CENTER AT (708) 524-2145.

WHEN EOGE OF BARRIER IS WITHIN 3' OF THE TRAFFIC LANE EOGE, REDUCE LANE TO II'LANE WITH TYPE III TEMPORARY TAPE AND TAPER IN 45:1.

# **GENERAL NOTES (BRIDGE)**

THE CONTRACTOR SHALL TAKE NECESSARY PRECAUTIONS TO INSURE THAT NO DEBRIS WILL ENDANGER OR INTERFERE WITH TRAFFIC ON THE ROADWAY BENEATH THE BRIDGE ACCORDING TO ARTICLE 107.09 OF THE STANDARD SPECIFICATIONS. THIS WORK WILL NOT BE PAID FOR SEPERATELY, BUT SHALL BE INCLUDED IN THE CONTRACT UNIT PRICE FOR THE APPROPRIATE PAYITEM INVOLVED AND NO ADDITIONAL COMPENSATION WILL BE ALLOWED.

EXISTING REINFORCEMENT BARS EXTENDING INTO THE REMOVAL AREA SHALL BE CLEANED, STRAIGHTENED AND INCORPORATED INTO THE NEW CONSTRUCTION. ANY REINFORCEMENT BARS THAT ARE DAMAGED DURING CONCRETE REMOVAL SHALL BE REPLACED WITH AN APPROVED BAR SPLICER OR ANCHORAGE SYSTEM. COST INCLUDED WITH CONCRETE REMOVAL.

PLAN DIMENTIONS AND DETAILS RELATIVE TO EXISTING PLANS ARE SUBJECT TO ROUTINE VARIATIONS. THE CONTRACTOR SHALL FIELD VERIFY EXISTING DIMENTIONS AND DETAILS AFFECTING NEW CONSTRUCTION AND MAKE NECESSARY APPROVED ADJUSTMENT PRIOR TO CONSTRUCTION OR ORDERING OF MATERIALS. SUCH VARIATIONS SHALL NOT BE CAUSE FOR ADDITIONAL COMPENSATION FOR A CHANGE IN SCOPE OF THE WORK, HOWEVER, THE CONTRACTOR WILL BE PAID FOR THE QUANTITY ACTUALLY FURNISHED BASED UPON THE UNIT PRICE BID FOR THE WORK.

REINFORCEMENT BARS SHALL CONFORM TO THE REQUIREMENT OF ASTM A 706 Gr 60 (IL MODIFIED). SEE SPECIAL PROVISIONS.

REINFORCEMENT BARS DESIGNATED (E) SHALL BE EPOXY COATED.

JOINTS ARE TO BE INSTALLED TO MATCH EXISTING.

IF A GAP IN THE PARAPET IS TO OCCUR FOR ANY PERIOD OF TIME, A TEMPORARY RAILING MUST BE INSTALLED SO THAT AT NO TIME SHALL THERE BE AN OPENING IN ANY PORTION OF THE EXISTING SYSTEM. IF THE GAP IS IN A BARRIER WALL SECTION, TEMPORARY RAILING OR BARRELS SHALL BE USED AT THE DISCRETION OF THE ENGINEER.

THE CONTRACTOR SHALL SALVAGE AND RETURN THE EXISTING GUARDRAIL TO:

DISTRICT BRIDGE OFFICE 1101 BIESTERFIELD RD. ELK GROVE VILLAGE, IL 60007

THIS WORK SHALL INCLUDE REMOVING, TRANSPORTING AND UNLOADING THE EXISTING CARRIER GUARDRAIL TO THE ABOVE YARD WHICH COST IS INCLUDED IN THE COST OF "CONCRETE BARRIER WALL REMOVAL AND REPLACE, LOCATION (NUMBER)".

SHEET 10FZ A

ILLINOIS DEPARTMENT OF TRANSPORTATION

Contract 60L54

**GENERAL NOTES** 

1 Rev. 6-2-11 Rev.

			TOTAL	SHEET
ROUTE	SECTION	COUNTY	SHEETS	NUMBER
VARIOUS	2010-069-1	VARIOUS	34	4A

SHEET 2 OF 2

Contract 60L54

# **GENERAL NOTES**

ANY CONDUIT RUSTED THRU, EXPOSED CABLES, PULL BOXES OR HANDHOLES FOR BRIDGE LIGHTING, TRAFFIC SIGNALS, COUNTERS, SURVEILLANCE EQUIPMENT FOUND IN DISREPAIR THE ENGINEER SHALL TAKE THE APPROPRIATE ACTION:

NO SAW CUTTING OR REMOVAL WILL BE MADE OR CONCRETE POURED UNTIL THE APPROPRIATE ACTION IS TAKEN TO RESOLVE EACH ISSUE;

ALL WORK REQUIRED TO REPAIR/REPLACE SIGNAL OR LIGHTING ITEMS WILL BE DOCUMENTED BY THE ENGINEER AND THE BUREAU OF TRAFFIC WILL BE NOTIFIED.

CONTACT JEFF GALAS AT TRAFFIC SYSTEMS CENTER TO ASCERTAIN IF THEY HAVE EQUIPMENT IN THE NEAR VICINITY OF THE LOCATION SHOWN.

Added sheet 5/27-2011 ARP

ILLINOIS DEPARTMENT OF TRANSPORTATION

**GENERAL NOTES** 

form date: 7/10/07

		\ <u>-</u>	TOTAL	SHEET	
ROUTE	SECTION	COUNTY	SHEETS	NUMBER	
VARIOUS	2010-069-I	VARIOUS	34	5	

	SUMMARY OF QUANTITIES					***************************************
			URBAN 100%. STATÉ	CONSTRUCT	TION TYPE CO	DE 0040
Code No	Description	Unit	Total Quantities	COOK CO.	WILL CO.	
42001300	PROTECTIVE COAT	SQ YD	155	138	17	
<del>-44200990</del>	CLASS B PATCHES, TYPE I, 12 INCH	SQ YD	3.6	3.6		
67000400	ENGINEER'S FIELD OFFICE, TYPE A	CAL MO	3	1.5	1.5	
67100100	MOBILIZATION	L SUM	1	0.5	0.5	
70102630	TRAFFIC CONTROL AND PROTECTION, STANDARD 701601	L SUM	1	14.	7	
X0323723	CONCRETE BARRIER WALL REMOVAL AND REPLACEMENT, LOCATION 1	L SUM	1	1		
X0323724	CONCRETE BARRIER WALL REMOVAL AND REPLACEMENT, LOCATION 2	L SUM	1	1		,
X0323725	CONCRETE BARRIER WALL REMOVAL AND REPLACEMENT, LOCATION 3	L SUM	1	1		
X0323726	CONCRETE BARRIER WALL REMOVAL AND REPLACEMENT, LOCATION 4	L SUM	1	1		
X0323727	CONCRETE BARRIER WALL REMOVAL AND REPLACEMENT, LOCATION 5	L SUM	1 .	1		
X0323728	CONCRETE BARRIER WALL REMOVAL AND REPLACEMENT, LOCATION 6	L SUM	1	1		
X0323729	CONCRETE BARRIER WALL REMOVAL AND REPLACEMENT, LOCATION 7	L SUM	1	1		
X0323730	CONCRETE BARRIER WALL REMOVAL AND REPLACEMENT, LOCATION 8	L SUM	1	1		
X0323731	CONCRETE BARRIER WALL REMOVAL AND REPLACEMENT, LOCATION 9	L SUM	1	1		
70300530 70301000 X7011015	PAVEMENT MARKING TAPE, TYPETIT, 5 INCH WORK ZONE PAVEMENT MARKING REMOVAL TRAFFIC CONTROL AND PROTECTION (EXPRESSWAYS)	FOOT SQ FT L SUM	500	500 210		

SHEET 1 OF 2 A

ILLINOIS DEPARTMENT OF TRANSPORTATION

SUMMARY OF QUANTITIES

Rev.

36			TOTAL	SHEET
ROUTE	SECTION	COUNTY	SHEETS	NUMBER
VARIOUS	2010-069-I	VARIOUS	34	6

	SUMMARY OF QUANTI	ΓIES				
			URBAN 1001. STATE	CONSTRUCT	TION TYPE CO	DE 0040
Code No	Description	Unit	Total Quantities	COOK CO.	WILL CO.	
X0323732 X0323733	CONCRETE BARRIER WALL REMOVAL AND REPLACEMENT, LOCATION 10  CONCRETE BARRIER WALL REMOVAL AND REPLACEMENT, LOCATION 11	L SUM L SUM	1	1 1		
X0323734 X0323735	CONCRETE BARRIER WALL REMOVAL AND REPLACEMENT, LOCATION 12  CONCRETE BARRIER WALL REMOVAL AND REPLACEMENT, LOCATION 13	L SUM	1	1 . 1		
X0323736 X0323737	CONCRETE BARRIER WALL REMOVAL AND REPLACEMENT, LOCATION 14  CONCRETE BARRIER WALL REMOVAL AND REPLACEMENT, LOCATION 15	L SUM	1	1 1		
X0323738 X0323739	CONCRETE BARRIER WALL REMOVAL AND REPLACEMENT, LOCATION 16  CONCRETE BARRIER WALL REMOVAL AND REPLACEMENT, LOCATION 17	L SUM	1	1 1		
X0323740 X0323741	CONCRETE BARRIER WALL REMOVAL AND REPLACEMENT, LOCATION 18  CONCRETE BARRIER WALL REMOVAL AND REPLACEMENT, LOCATION 19	L SUM	1		1	
Z0026346 Z0030850	NIGHTTIME WORK ZONE LIGHTING TEMPORARY INFORMATION SIGNING	L SUM SQ FT	154.2	0.5 51.4	0.5	<u></u>
Z0048665	RAILROAD PROTECTIVE LIABILITY INSURANCE	L SUM	1	0.5	0.5	
· · • · ·	CLASS BPATCH, TYPEII, 13 INCH  DOWEL BARS, 11/2"  SAW CUTS  FRAMES AND LIDS, TYPE 1, CLOSED LID	SQ YD EACH FOOT EACH	8 24 60 1	8 24 60	}	

ILLINOIS DEPARTMENT OF TRANSPORTATION

SUMMARY OF QUANTITIES

SHEET 2 OF 2

ARev. 6-2-11


			TOTAL	SHEET
ROUTE	SECTION	COUNTY	SHEETS	NUMBER
VARIOUS	2010-069-I	VARIOUS	34	7


			COOK COUNTY								WILL									
								I-90	/ 94					·	1-8	0	1-5		I-80 Over US 30 & RR	Vollmer Rd Over I-57
											,					*************************				
Code No.	Location	1	2	3	4	5	6	7	. 8	9	10	11	12	13	14	15	16	17	18	19
										·					Second .					
70102630	TRAFFIC CONTROL AND PROTECTION, STANDARD 701601													<b>E</b>	Х	}			Х	X
															تحسيخ					
X7011015	TRAFFIC CONTROL AND PROTECTION (EXPRESSWAYS)	Х	X,	Х	Х	Х	Х	Х	Х	Х	Х	Х	Х	x/	Х	X	Х	Х	Х	Х
																			"	
		,													~~	~~	~	~~	1	-
X0322256	TEMPORARY INFORMATION SIGNING (SQ. FT)													É	51.4				51.4	51.4
																			<del></del>	
X0325702	NIGHTTIME WORK ZONE LIGHTING	Х	Х	Х	Х	Х	Х	X	Х	Х	Х	Х	/x /	X	Х	. X	Х	Х	Х	Х
						<u> </u>		1		1	<u> </u>	\					L		_1	

ILLINOIS DEPARTMENT OF TRANSPORTATION

SCHEDULE OF QUANTITIES

1 Revised 5/27-2011 ARP

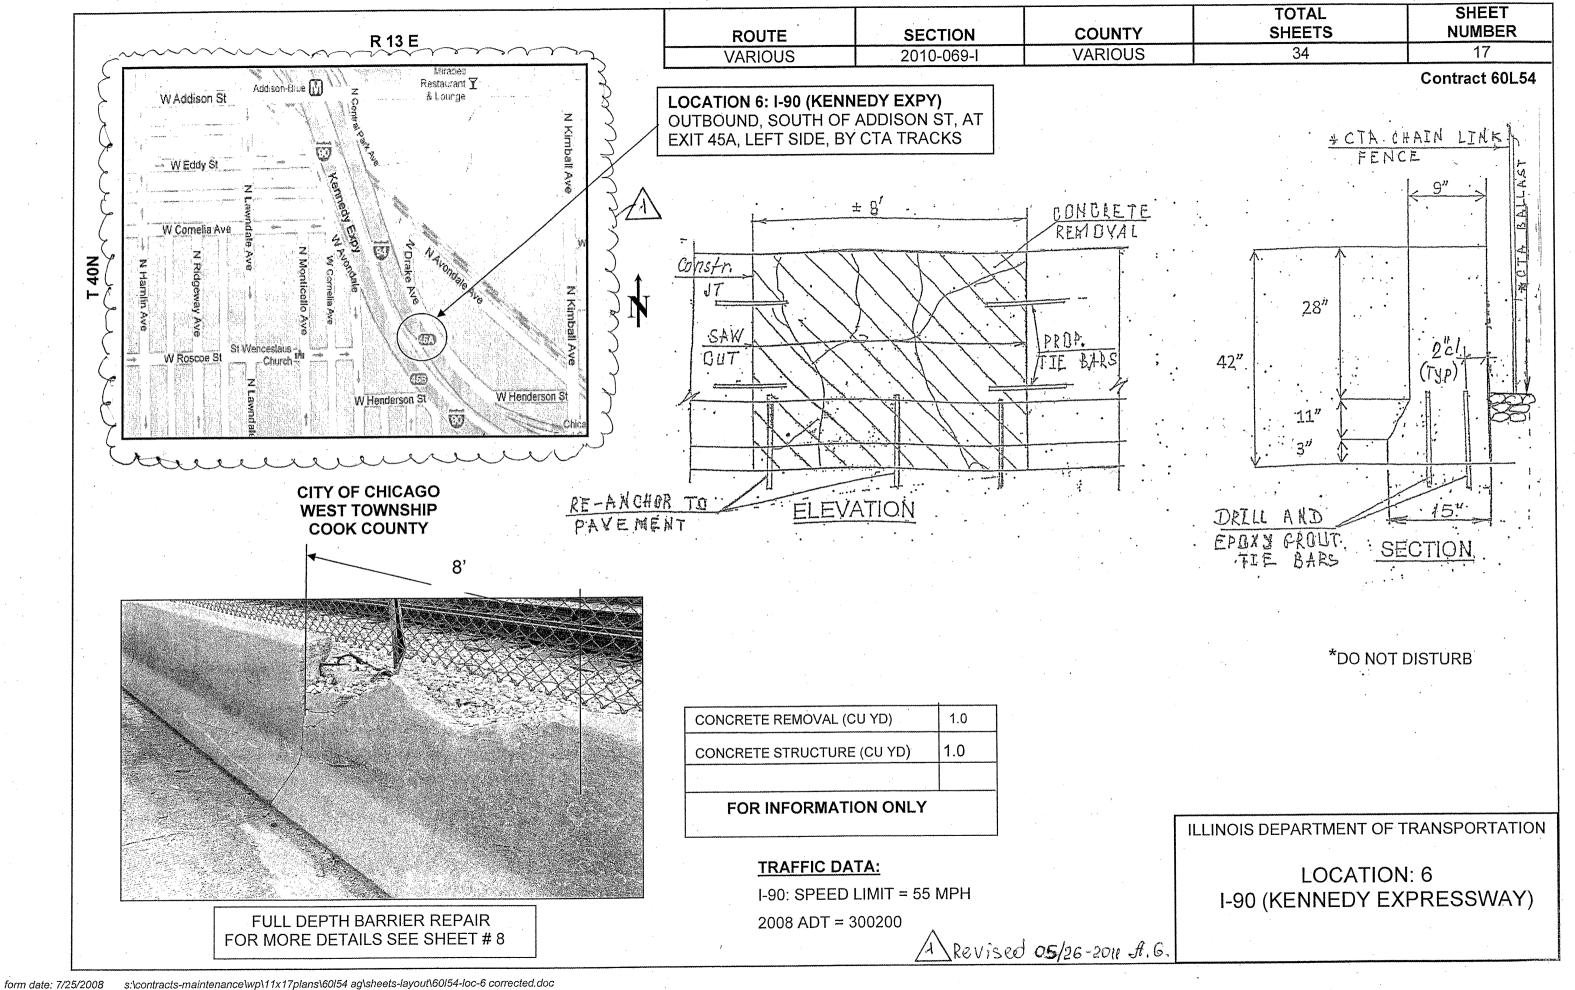

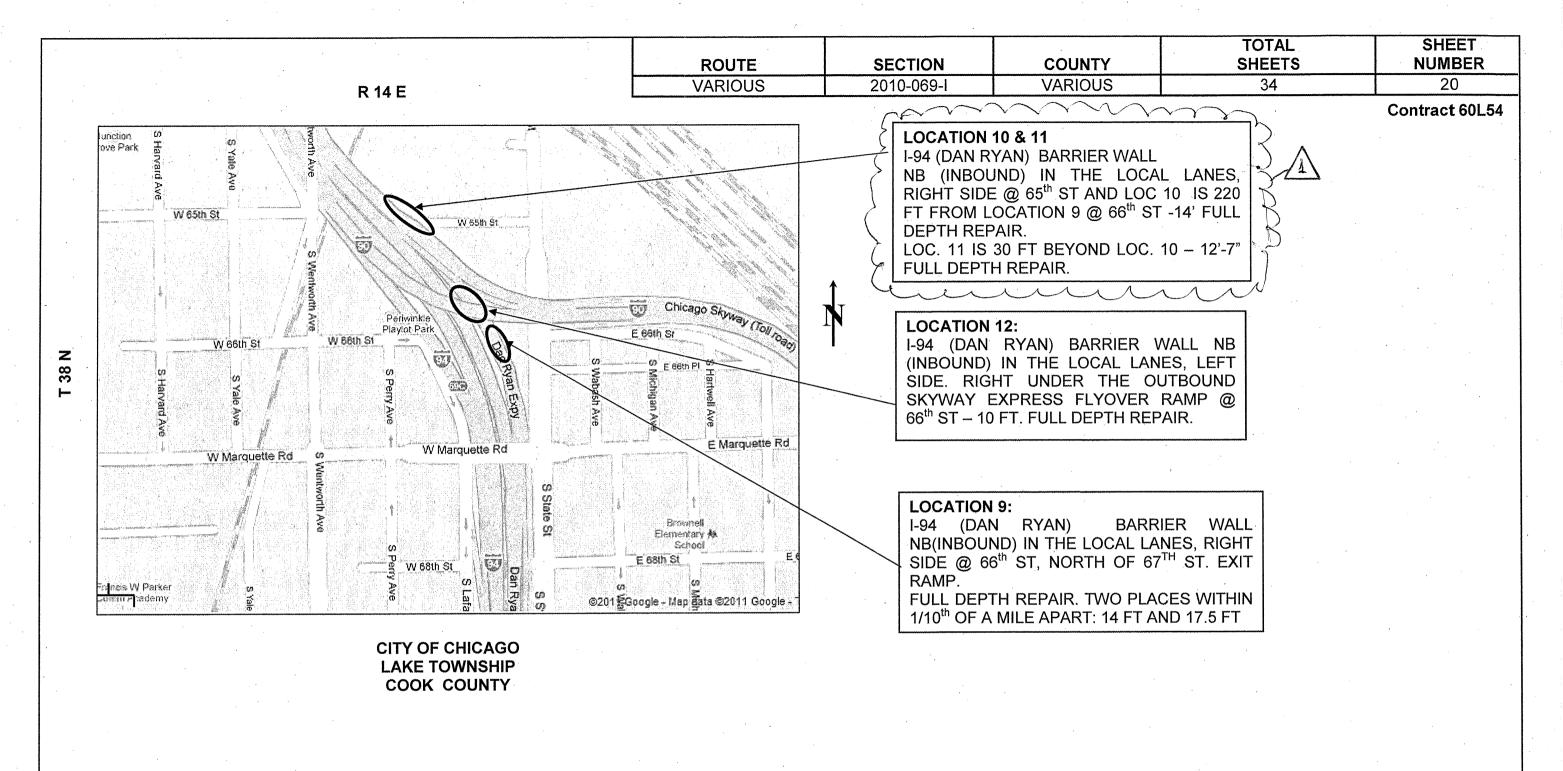

FOR DETAILS SEE SHTS # 21 thru 23


ILLINOIS DEPARTMENT OF TRANSPORTATION


MAP FOR LOCATIONS # 9; 10; 11,12, I-94 AT 65<sup>th</sup> and 66<sup>th</sup> STREETS

# TRAFFIC DATA

I-90/94 SPEED LIMIT = 55 MPH 2008 ADT = 231700


A Revised 05/26-2011 \$6.6.

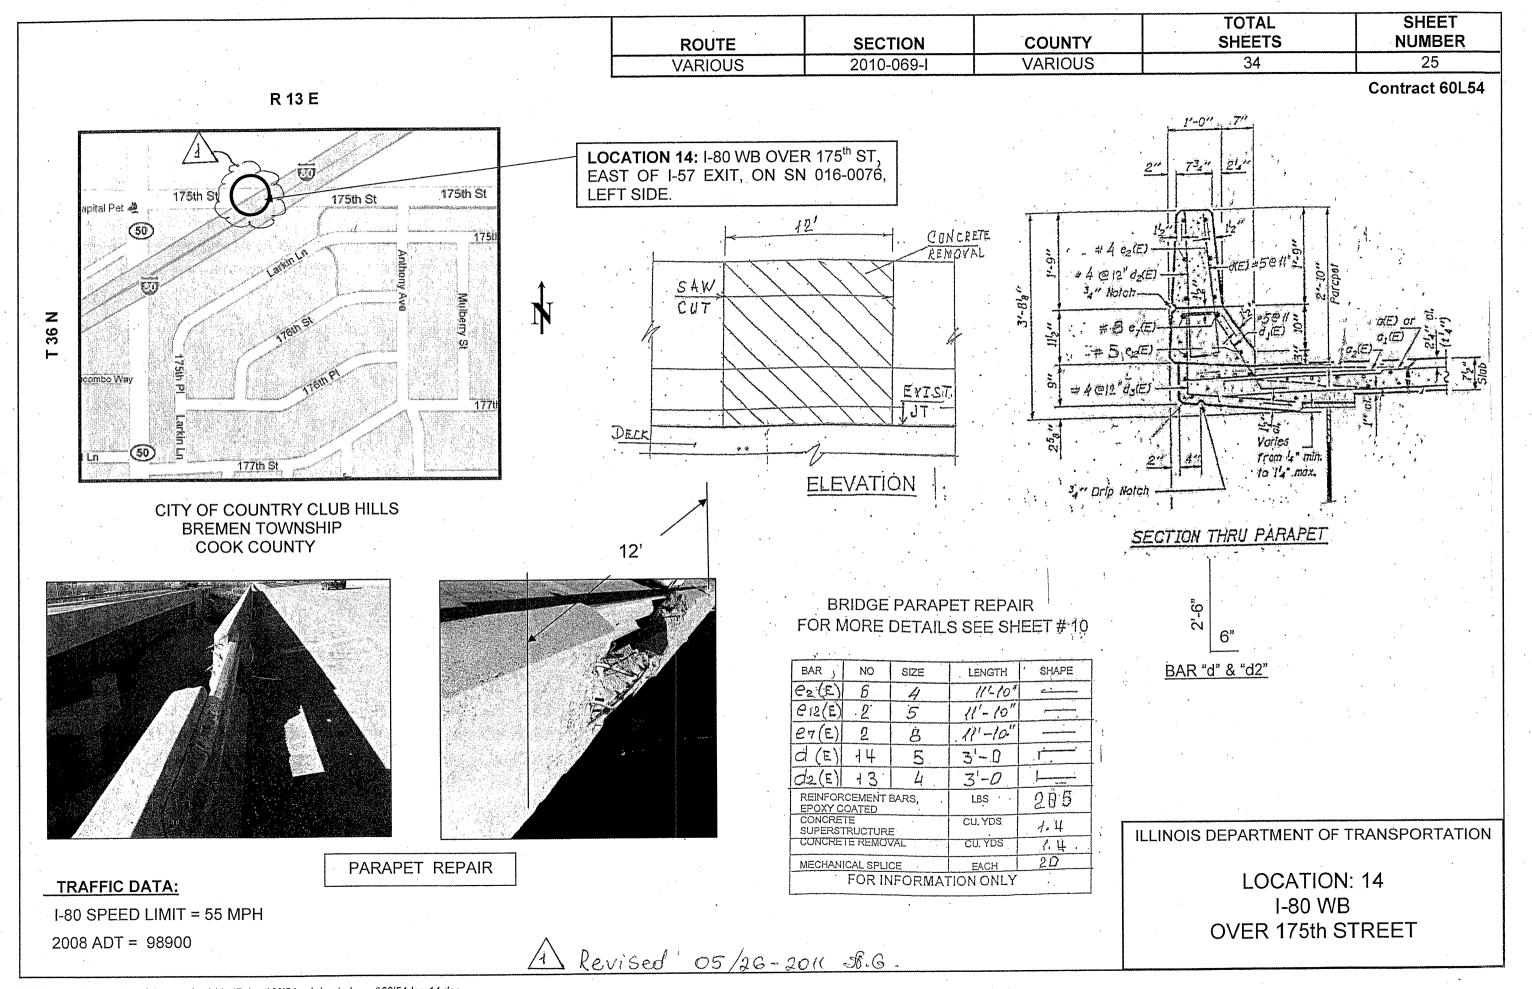

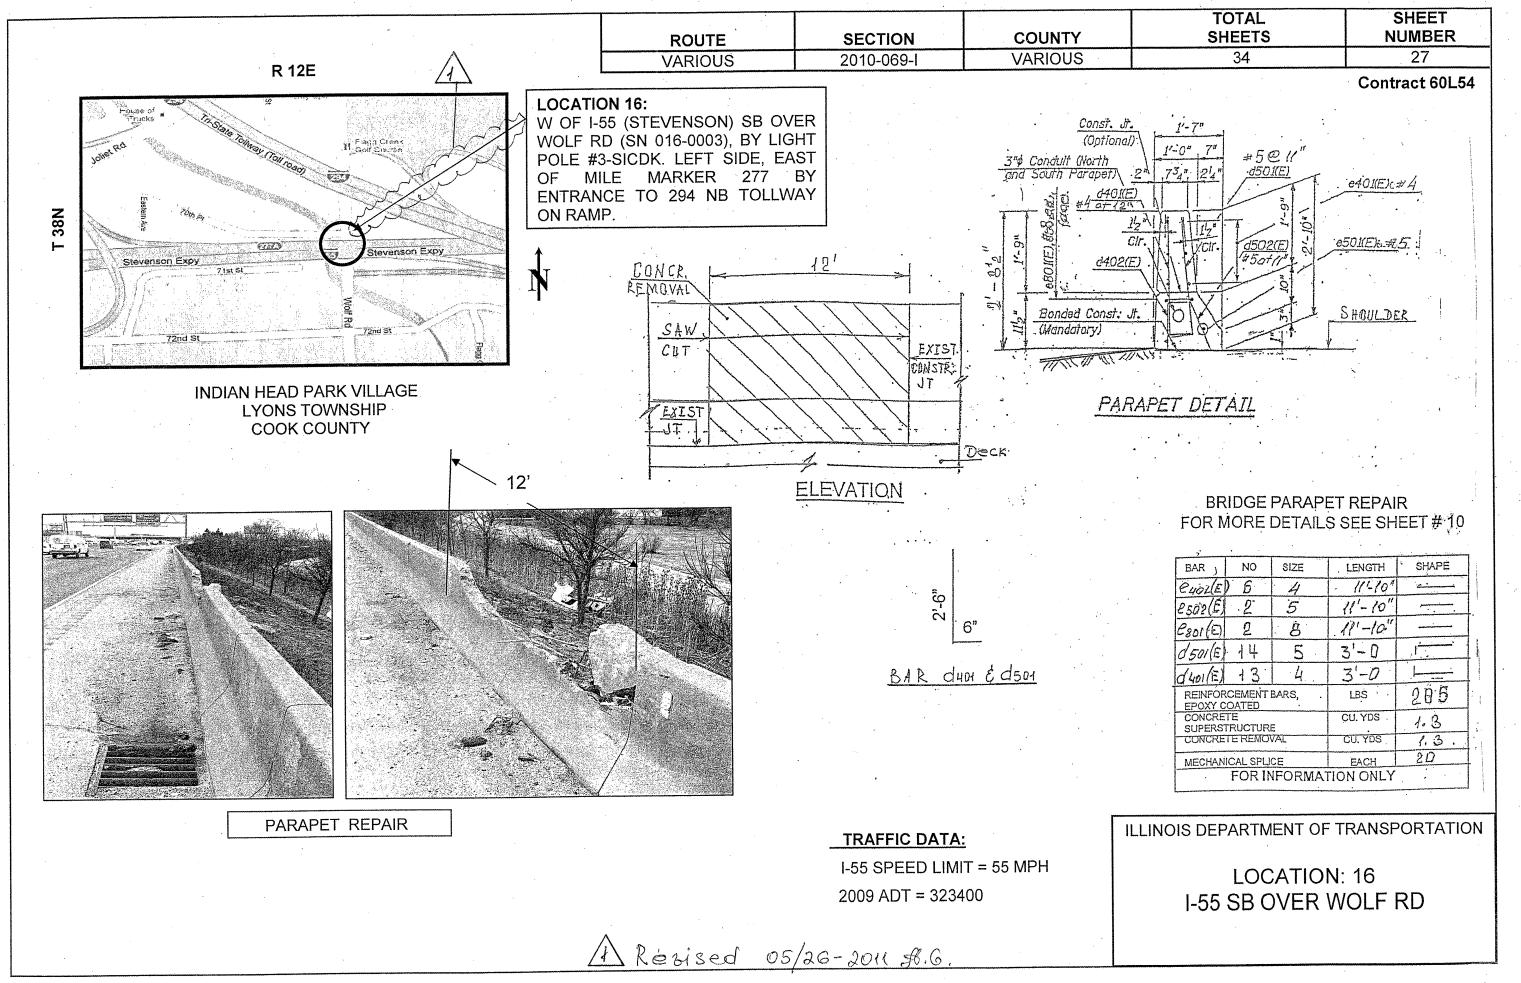


		· ·	TOTAL	SHEET		
ROUTE	SECTION	COUNTY	SHEETS	NUMBER		
VARIOUS	2010-069-I	VARIOUS	34	28		

#### R 11E

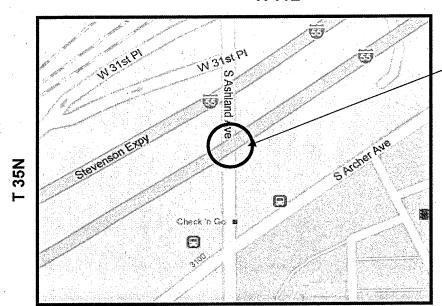

CHICAGO **SOUTH TOWNSHIP COOK COUNTY** 

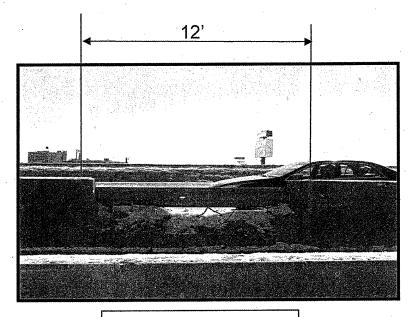


PARAPET REPAIR

## TRAFFIC DATA:

I-55 SPEED LIMIT = 55 MPH 2010 ADT = 84550

**LOCATION 17:** 

I-55 NB OVER ASHLAND AVE (SN 016-1084) REMOVE & REPLACE 12' SECTION OF THE NORTH PARAPET (LEFT SIDE)

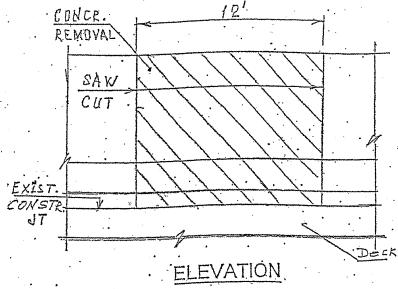

्रेगिटीक 18 क्षेत्रक अन्ति विजन २० वस दिस्तिकार

\* IN PARENTHESIS ARE SHOWN ENGLISH DIMENSIONS AND BAR DIAMETERS.

500 (1'-75/3")\*

## BRIDGE PARAPET REPAIR

#### FOR MORE DETAILS SEE SHEET # 10

<u>,,</u>			,,,,,,,,,,,,,,,,,,,,,,,,,,,,,,,,,,,,,,,					
BAR	)	NO	SIZE	. LENGTH	SHAPE			
·e(	E)	B	5	11-10	<u> </u>			
ei(	E)	. 2	8	11'-10"				
E21	(E)	2	5	18'-10"				
d (	( ع	14	5	3'-0				
d3	E	13	5	3'-0				
		CEMENT I		LBŞ · ·	271			
CON		TE RUCTURE	,	CU, YDS .	1.5			
CON	CRE	TE REMOV	AL .	CU, YDS	1.5.			
MEC	LANI	CAL SPLIC		EACH	. 2.4			
	FOR INFORMATION ONLY							

ILLINOIS DEPARTMENT OF TRANSPORTATION


Contract 60L54

-60 ct (15)

LOCATION: 17 OVER ASHLAND AVE

TOTAL SHEET NUMBER ROUTE SECTION COUNTY **SHEETS VARIOUS** 2010-069-1 **VARIOUS** 34 30A


Contract 60L54

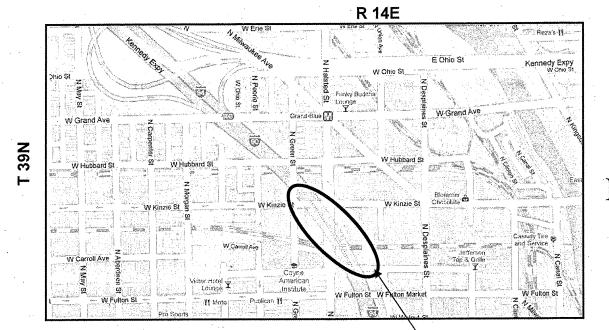

**CITY OF CHICAGO WEST TOWNSHIP COOK COUNTY** 

**LOCATION 20:** 

I-90/94 EB, TUNNEL BETWEEN KINZIE ST. & FULTON ST.

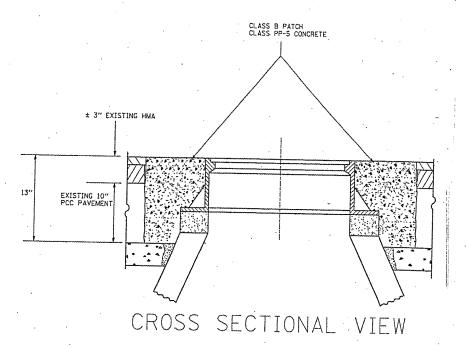

#### NOTES:

EXISTING BROKEN FRAMES AND LIDS SHALL BE REMOVED AND DISPOSED OF BY THE CONTRACTOR AND SHALL BE REPLACED AS DIRECTED BY THE ENGINEER.

REMOVAL OF EXISTING HMA INCLUDED IN COST OF CLASS B PATCH.


TOP OF CLASS B PATCH SHALL MATCH ELEVATION OF ADJACENT HMA.

## TRAFFIC DATA

I-90/94 SPEED LIMIT = 55 MPH 2009 ADT = 284,300

\_> - indicates direction of traffic.

\* Existing Frame & Lid to be removed & replaced.

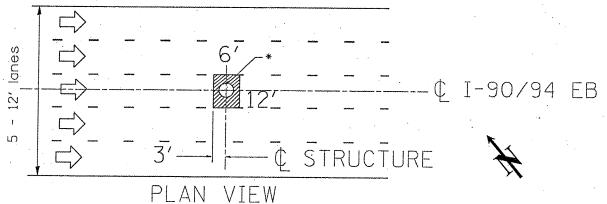



**BILL OF MATERIAL** QUANTITY UNIT SQ YD 8.0 60.0 FT

Added Sheet 5/27/11 ARP

ILLINOIS DEPARTMENT OF TRANSPORTATION

LOCATION: 20 I-90/94 EB

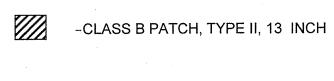


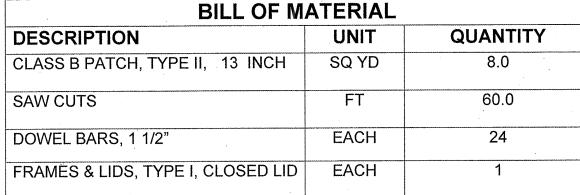



#### CÈNTER LANE CLOSURE TYPE I CHECK BARRICADES->DRUMS AT 50' (15 m) CENTERS AT 100' (30 m) CENTERS 11111 ARROW BOARD DISPLAYING DOUBLE ARROW PATTERN LANE CLOSED √\* w9-3-48 \* w9-3a-48 SIGNING & BARRICADING ACCORDING TO FREEWAY STANDARD FOR A ONE LANE CLOSURE INSTALLATION SEQUENCE 1. CLOSE LANES 1&2 ACTIVE SYMBOLS NOTES WORK AREA 1. DRUMS WITH STEADY BURN LIGHTS DIRECTION OF TRAFFIC SHALL BE USED AT 50' (15 m) CENTERS ON ALL TAPERS AND TANGENTS IN ARROWBOARD 2. ERECT INSIDE LANE 2 TAPER ADVANCE OF WORK AREA. ACTIVE WORK AREA 2. CLOSURE SHALL BE USED ONLY FOR OPERATIONS LASTING 72 HOURS OR LESS. 3. OPEN LANE 2 BY RELOCATING FIRST TAPER 3. CENTER LANE CLOSURE CONFIGURATION TYPE HBARRICADE, OR DRUM WITH MONO-DIRECTIONAL STEADY BURN LIGHT NON-ACTIVE IS NOT TO BE USED WITH WORKERS WORK AREA PRESENT. 4. REMOVE CLOSURE IN REVERSE ORDER USER NAME = leyse REVISED ~ J.A.F. 04-03 FILE NAME = DESIGNED -REVISED - S.P.B. 01-07 REVISED - S.P.B. 12-09 W:\d:ststd\22x34\tc25.dgn DRAWN PLOT SCALE = 50.000 '/ IN. CHECKED REVISED -PLOT DATE = 1/26/2010 DATE REVISED

# SHOULDER LANE

NOTE: CLOSURE SHALL BE USED ONLY FOR OPERATIONS LASTING 72 HOURS OR LESS.

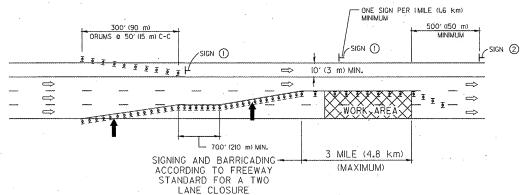

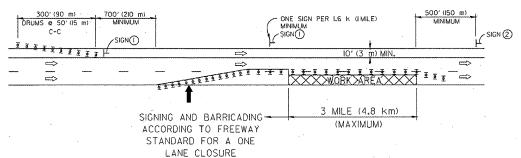

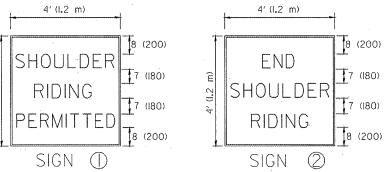

6 (I50) SERIES "C" LEGEND BLACK LEGEND WHITE REFLECT. BACKGROUND 1(25) BORDER

- ► SIGN ON PORTABLE OR PERMANENT SUPPORT \*

ALL DIMENSIONS ARE IN INCHES (MILLIMETERS) UNLESS OTHERWISE SHOWN

A Added Sheet 5/27/11 ARP

\* ALL SIGNS SHALL BE MOUNTED AT A MINIMUM HEIGHT OF 5' (1.5 m).

	TRAFFIC CONTROL DETAILS FOR FREEWAY			RTE.	SECTION	COUNTY	SHEETS	NO		
STATE OF ILLINOIS	CENTER LANE CLOSURE SHOULDER LANE			lat.	2010-069-1	Var.	34	34		
DEPARTMENT OF TRANSPORTATION					TC-25	CONTRAC	T NO.			
	SCALE: NONE	SHEET NO. 1 OF 1	SHEETS	STA.	TO STA.	FED. ROAD DIŞT. NO. 1   ILLINOIS FED. AID PROJECT				