
# STATE OF ILLINOIS

# DEPARTMENT OF TRANSPORTATION

**DIVISION OF HIGHWAYS** 

# **PROPOSED** HIGHWAY PLANS

FAI ROUTE 55 (I-55) OVER THE KANKAKEE RIVER SECTION 88(B&B-1)BR **BRIDGE REHABILITATION** WILL COUNTY PROJECT: ESP-055-6 (238) 241

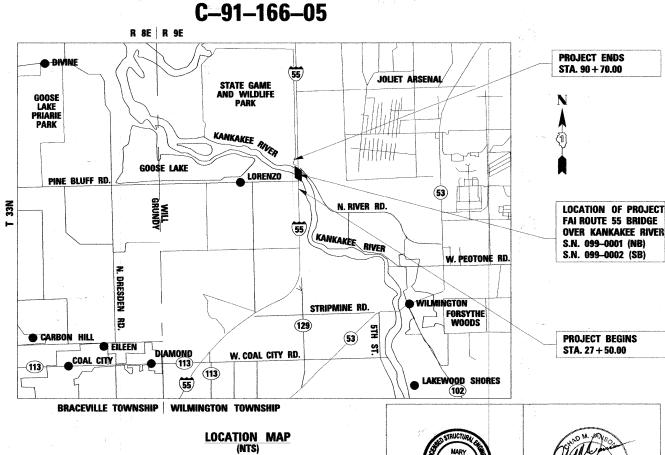



ringroup

Excellence through Ownership

200 West Front Street Wheaton, II 60187

License # 184-000813

CHAD M. JANSON ER DISCIPLINE — CIVIL ENGINEER LICENSE NO. 062-053980 LICENSE EXPIRES 11/30/2009

MARY COOMBE BLOXDORF DISCIPLINE: STRUCTURAL ENGI

DEPARTMENT OF TRANSPORTATION DIVISION OF HIGHWAYS


A Rev. 12-30-09

PRINTED BY THE AUTHORITY OF THE STATE OF ILLINOIS

TRAFFIC DATA

 $\bigcirc$ 

FUNCTIONAL CLASSIFICATION - INTERSTATE, CLASS I TRUCK ROUTE AT NEW RIVER RD. 2005 ADT = 55.000AT LORENZO RD. 2005 ADT = 40.900INTERSTATE 55 POSTED SPEED LIMIT = 65 MPH

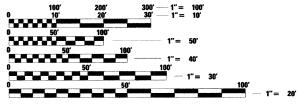

FOR INDEX OF SHEETS, SEE SHEET NO. 2

**IMPROVEMENTS LOCATED WITHIN** THE CITY OF WILMINGTON, IL

ENGINEERING SCALES. REDUCED SIZED PLANS WILL NOT CONFORM TO STANDARD SCALES. IN MAKING MEASUREMENTS ON REDUCED PLANS, THE ABOVE SCALES MAY BE USED.

JOINT UTILITY LOCATION INFORMATION FOR EXCAVATION 1-800-892-0123 OR 811

PROJECT ENGINEER: MICHELLE AQUINO (847) 705-4606 PROJECT MANAGER: RAJENDRA SHAH (847) 705-4555

**CONTRACT NO. 62930** 

FINAL PLANS

GROSS LENGTH = NET LENGTH = 6320 FEET = 1.20 MILES

#### **INDEX OF SHEETS**

```
SHEET TITLE
 SHEET NO.
            COVER SHEET
            INDEX OF SHEETS & STANDARDS
            GENERAL NOTES
            SUMMARY OF QUANTITIES
            ROADWAY TYPICAL SECTIONS
    5
            RAMP TYPICAL SECTIONS
    5A
    6
            CROSSOVER TYPICAL SECTIONS
            .....
            ALIGNMENT & TIES
    8-9
            DETOUR PLAN
   10-12
            TRAFFIC CONTROL CONSTRUCTION STAGING NOTES & DETAILS
            TRAFFIC CONTROL PLAN - STAGE II
   13-14
            TRAFFIC CONTROL PLAN - STAGE III
   15-16
   17-21
            PLAN & PROFILE
            △ ( 21A
            N. RIVER ROAD EXIT RAMPS - PLAN
            22-23
            DRAINAGE PLAN & PROFILE
    24
            EROSION CONTROL PLAN
   25-26
            PAYEMENT ELEVATION DETAILS
   27-28
            PAVEMENT MARKING PLANS
   29-47
            BRIDGE PLANS-SN 099-0001 (NB)
   48-56
            BRIDGE PLANS-SN 099-0002 (SB)
  57-64
            CROSS-SECTIONS
    65
66
            STORM SEWER CONNECTION TO EXISTING SEWERS (BD-08)
            BUTT JOINTS AND HMA TAPER (BD-32)
    67
            ENTRANCE AND EXIT RAMP CLOSURE DETAILS (TC-08)
    68
            FREEWAY SINGLE AND MULTI LANE WEAVE (TC-09)
    69
            RAISED REFLECTIVE PAVEMENT MARKERS (SNOW PLOW RESISTANT) (TC-11)
   70-71
            MULTI-LANE FREEWAY PAVEMENT MARKING (2 SHEETS) (TC-12)
    72
            ARTERIAL ROAD INFORMATION SIGN (TC-22)
            PAVEMENT PATCHING FOR HMA SURFACED PAVEMENT (BD-22)
   72A
 △₹72B
            TRAFFIC CLOSURE FOR SHOULDER CLOSURES AND PARTIAL RAMP
            CLOSURES (TC-17)
            SIGNING FOR FLAGGING OPERATIONS AT WORK ZONE OPENINGS (TC-18)
```

#### **HIGHWAY STANDARDS**

	STANDARD NO.	STANDARD TITLE
	000001-05	STANDARD SYMBOLS, ABBREVIATIONS AND PATTERNS
	280001-04 482001-02	TEMPORARY EROSION CONTROL SYSTEMS HMA SHOULDER ADJACENT TO ELEXIBLE PAVEMENT
	482011-03	HMA SHOULDER STRIPS/SHOULDERS WITH RESURFACING
	515001-03	NAME PLATE FOR BRIDGES
	601101-01	CONCRETE HEADWALL FOR PIPE DRAIN
	606401-01 630001-08	PAVED DITCH STEEL PLATE BEAM GUARDRAIL
		TRAFFIC BARRIER TERMINAL, TYPE 5 & 5A
		REFLECTOR AND TERMINAL MARKER PLACEMENT
	635011-02 701101-02	REFLECTOR MARKER AND MOUNTING DETAILS OFF-ROAD OPERATIONS, MULTILANE
		LANE CLOSURE, MULTI-LANE DIVIDED WITH CROSS OVER AND BARRIER
	701400-03	APPROACH TO LANE CLOSURE, FREEWAY/EXPRESSWAY
		LANE CLOSURE, FREEWAY/EXPRESSWAY
	701411-05 701416-06	LANE CLOSURE, MULTI-LANE AT ENTRANCE OR EXIT RAMP, FOR SPEEDS >= 45 MPH LANE CLOSURE. FREEWAY/EXPRESSWAY. WITH CROSSOVER AND BARRIER
		TRAFFIC CONTROL DEVICES
		TEMPORARY CONCRETE BARRIER
		SIGN PANEL MOUNTING DETAILS SIGN PANEL ERECTION DETAILS
		TYPICAL PAVEMENT MARKINGS
	781001-03	TYPICAL APPLICATIONS RAISED REFLECTIVE PAVEMENT MARKERS
^	<b>4</b> 42201-03	CLASS C & D PATCHES
<u> </u>		DELINEATORS }
	<b>{</b> 642001-01	SHOULDER RUMBLE STRIPS }

•	
ringro	up
	A
Excellence through Ov	vnership

West From	

DESIGNED	-	KSD	REVISED	- 🛆	ADD. NO. 1
DRAWN	_	KSD	REVISED	-	
CHECKED	-	CMJ	REVISED	-	
DATE	-	03-04-09	REVISED		

STATE OF ILLINOIS
DEPARTMENT OF TRANSPORTATION

SCALE:

	INDEX OF SHEETS										-	F.A.	T		SEC	TION			COUNTY	-
				Q.	G.	ΓΑΝΙΝΑ	RDC					55		. 88	3 (B&	B-1)	BR		WILL	_
& STANDARDS																			CONTRA	(
NTS	SHEET	NO.	1	OF	1	SHEETS	STA.		TO	STA.		FED.	ROAD	DIST.	NO. 1	ILLIN	IOIS FE	ED. AIC	PROJECT	

#### **GENERAL NOTES - ROADWAY**

- SAW CUTTING OF PAVEMENTS, SHOULDERS, ETC. SHALL BE FULL DEPTH AND SHALL RESULT IN A CLEAN, STRAIGHT EDGE ON THE PORTION REMAINING. ALL SAW CUTTING SHALL BE CONSIDERED INCLUDED IN THE COST OF THE ITEM REMOVED.
- TISE NO. 8 FROXY-COATED TIE BARS (OR DOWEL BARS) CONFORMING TO ARTICLE 1003.10(B)(2) OF THE STANDARD SPECIFICATIONS FOR LONGITUDINAL CONSTRUCTION JOINT GROUTED-IN-PLACE
  THE BAR AS SHOWN ON STATE STANDARD 420001 AND FOR TYING PORTLAND CEMENT CONCRETE PAVEMENT TO EXISTING CONCRETE PAVEMENT AS SHOWN ON THE PLANS. THE TIE BARS WILL NOT BE PAID FOR SEPARATELY BUT SHALL BE INCLUDED IN THE COST OF THE PAVEMENT ITEMS
- THE THICKNESS OF BITUMINOUS MIXTURES SHOWN ON THE PLANS IS THE NOMINAL THICKNESS. DEVIATIONS FROM THE NOMINAL THICKNESS WILL BE PERMITTED WHEN SUCH DEVIATIONS OCCUR DUE TO IRREGULARITIES IN THE BASE ON WHICH THE BITUMINOUS MIXTURE IS PLACED.
- 4. EXCEPT AS NOTED ON THE PLANS, PAVEMENT GRADES SHOWN ARE AT THE TOP OF PAVEMENT
- THE ENGINEER SHALL BE THE SOLE JUDGE CONCERNING CURING TIME FOR THE VARIOUS PAVEMENT

#### **GENERAL NOTES - TRAFFIC CONTROL & PROTECTION**

- STAGING PROCEDURES PRESENTED ARE THE SUGGESTED SEQUENCE OF OPERATIONS. AT HIS OPTION, THE CONTRACTOR MAY SUBMIT AN ALTERNATIVE STAGING PROPOSAL TO THE ENGINEER FOR HIS APPROVAL.
- TRAFFIC CONDITIONS, ACCIDENTS AND OTHER UNFORESEEN EMERGENCY CONDITIONS MAY REQUIRE ENGINEER TO RESTRICT, MODIFY OR REMOVE LANE CLOSURES OF CHANNELIZATION SHOWN IN THE PLANS. THE CONTRACTOR SHALL MAKE THE NECESSARY ADJUSTMENTS AS DIRECTED BY THE ENGINEER WITHOUT DELAY. THE CONTRACTOR SHALL RESPOND TO ANY REQUEST MADE BY THE ENGINEER FOR CORRECTION WITHIN TWO HOURS FROM THE TIME OF NOTIFICATION.
- ALL TEMPORARY PAVEMENT MARKINGS PROPOSED WITHIN THE WORK AREA SHALL BE COMPLETED PRIOR TO THE CONSTRUCTION PHASE CHANGE.
- BARRICADES: THE CONTRACTOR SHALL PROVIDE AND INSTALL TWO (2) WEIGHTED SAND BAGS ON EACH TYPE III BARRICADE USED - ONE (1) WEIGHTED SAND BAG ACROSS EACH BOTTOM RAIL.
- THE RESIDENT ENGINEER SHALL CONTACT MS. CORA MATHIS, AREA TRAFFIC ENGINEER AT (815) 485-6475, A MINIMUM OF TWO WEEKS PRIOR TO PLACEMENT OF PERMANENT PAVEMENT MARKINGS.
- THE MEDIAN CROSSOVERS SHALL BE CONSTRUCTED WITH DAILY LANE CLOSURES PER DISTRICT 1 STANDARDS.
- WHEN WORKERS ARE PRESENT, CONSTRUCTION SPEED LIMIT AND FLAGGER SIGNS SHALL BE PLACED PER DISTRICT 1 STANDARDS.
- VARIABLE MESSAGE SIGNS SHALL BE INSTALLED AS DIRECTED BY THE ENGINEER.
- TEMPORARY MOVEABLE CONCRETE BARRIER WALL SHALL BE LEASED BY IDOT FROM BARRIER SYSTEMS INC.
- THE CONTRACTOR SHALL REPLACE PRISMATIC BARRIER REFLECTORS ON THE NORTHBOUND I-55 BRIDGE STRUCTURE AS INDICATED ON THE TRAFFIC CONTROL PLAN. THIS WORK SHALL BE PAID FOR AT THE CONTRACT UNIT PRICE PER EACH FOR MONODIRECTIONAL PRISMATIC BARRIER REFLECTOR.
- 11. REMOVAL OF EXISTING PAVEMENT MARKINGS SHALL BE PAID FOR AS PAVEMENT MARKING REMOVAL. REMOVAL OF TEMPORARY PAVEMENT MARKING TAPE SHALL BE PAID FO AS WORK ZONE PAVEMENT MARKING REMOVAL.

#### **GENERAL NOTES – DRAINAGE & UTILITIES**

- BEFORE STARTING ANY EXCAVATION, THE CONTRACTOR SHALL CALL J.U.L.I.E. AT 1-800-892-0123 FOR FIELD LOCATIONS OF BURIED UTILITIES. (48 HOUR NOTIFICATION REQUIRED).
- THE CONTRACTOR SHALL COORDINATE CONSTRUCTION ACTIVITIES WITH UTILITY COMPANIES AND THE DEPARTMENT OF TRANSPORTATION

#### **GENERAL NOTES - LIGHTING**

1. CONTRACTOR SHALL RELAMP, CLEAN, AND SERVICE THE EXISTING LUMINAIRES ON THE LIGHT TOWERS NORTH OF WILMINGTON ROAD. NEW SPLICES, FUSES, FUSE HOLDERS, AND SURGE PROTECTORS SHALL ALSO BE PROVIDED FOR THESE LIGHT TOWERS. THIS WORK SHALL BE PAID FOR UNDER \*CLEAN AND RELAMP EXISTING LUMINAIRE\* AND COMPLETED TO THE SATISFACTION OF THE ENGINEER.

#### GENERAL NOTES - MISCELLANEOUS

- 1. ALL ELEVATIONS SHOWN ON THESE PLANS ARE ON THE U.S.G.S DATUM
- THE CONTRACTOR WILL NOT BE ALLOWED TO SET UP A YARD OR FIELD OFFICE ON STATE PROPERTY WITHOUT THE WRITTEN PERMISSION FROM THE DEPARTMENT
- ANY REFERENCE TO A STANDARD IN THESE PLANS SHALL BE INTERPRETED TO MEAN THE EDITION AS INDICATED BY THE SUBNUMBER LISTED ON THE INDEX OF SHEETS OR THE COPY OF THE STANDARD INCLUDED IN THESE PLANS.

4. BEFORE STARTING ANY EXCAVATION, THE CONTRACTOR SHALL CALL \*J.U.L.I.E.\* AT (800) 892-0123 OR 811 FOR FIELD LOCATIONS OF BURIED ELECTRIC, TELEPHONE AND GAS UTILITIES. 48 HOUR NOTIFICATION IS

- 5. RESERVED
- 6. RESERVED.
- 7. RESERVED

8. THE REMOVAL OF GUARDRAIL TERMINAL SECTIONS SHALL BE INCLUDED IN THE UNIT PRICE PER FOOT FOR \*GUARDRAIL REMOVAL.\*

9. WHEN ARTIFICIAL LIGHTING IS UTILIZED IN NIGHT OPERATIONS, THE CONTRACTOR SHALL EXERCISE THE UTMOST PRECAUTIONS IN PREVENTING ADVERSE VISIBILITY TO THE MOTORING PUBLIC AND ADJOINING RESIDENTIAL AREAS. .

10. RESERVED.

11. USE #8 EPOXY-COATED TIE BARS, CONFORMING TO ART. 1006.10 OF THE STANDARD SPECIFICATIONS, FOR ALL TIE BARS. USE THE \*LONGITUDINAL CONSTRUCTION JOINT (TIE BAR GROUTED IN PLACE)\* DETAIL SHOWN ON HIGHWAY STANDARD 420001 FOR ALL LONGITUDINAL JOINTS AND FOR TYING PCC PAVEMENT WIDENING TO EXISTING

12. USE #8 EPOXY-COATED TIE BARS, CONFORMING TO ART. 1006.10 OF THE STANDARD SPECIFICATIONS, FOR ALL TIE BARS. USE THE \*LONGITUDINAL CONSTRUCTION JOINT (TIE BAR GROUTED IN PLACE)\* DETAIL SHOWN ON HIGHWAY STANDARD 420001 FOR ALL LONGITUDINAL JOINTS.

13. ANY PAVEMENT MARKINGS AND RAISED REFLECTIVE PAVEMENT MARKERS OBLITERATED BY MILLING AND RESURFACING OPERATIONS ON SIDE STREETS AND ENTRANCES SHALL BE REPLACED AND PAID FOR IN KIND.

14. ALL DAMAGE TO EXISTING PAVEMENT MARKINGS OR RAISED REFLECTIVE PAVEMENT MARKERS OUTSIDE THE REMOVAL LINE SHOWN ON THE PLANS SHALL BE REPLACED AT NO ADDITIONAL COST TO THE DEPARTMENT.

15. BEFORE BEGINNING ANY WORK, THE CONTRACTOR SHALL RETAIN AND RECORD FOR FUTURE REFERENCE, ALL 15. BEFORE BEGINNING ANT WORK, THE CONTINUOUS STALL RETAIN AND RESCRIPTION FOR THE BEGINNING AND MARKED LINES (AND RAISED REFLECTIVE PAVEMENT MARKERS) IN ORDER THAT THESE LOCATIONS CAN BE RE-ESTABLISHED FOR STRIPING. EXACT LOCATIONS OF ALL PAVEMENT MARKINGS SHALL BE AS DIRECTED BY THE ENGINEER.

16. ALL PAVEMENT PATCHING LOCATIONS WILL BE DETERMINED IN THE FIELD BY THE ENGINEER.

- 18. DRAINAGE ADJUSTMENT OR RECONSTRUCTION LOCATIONS WILL BE DETERMINED IN THE FIELD BY THE ENGINEER.
- 19. IT SHALL BE THE CONTRACTOR\*S RESPONSIBILITY TO VERIFY ALL DIMENSIONS AND CONDITIONS EXISTING IN

20. FRAMES AND GRATES ADJUSTMENT OF PRIVATE UTILITIES WITHIN THE LIMITS OF THE IMPROVEMENTS SHALL BE DONE BY THEIR RESPECTIVE OWNERS AND ARE NOT PART OF THIS CONTRACT.

21. RESERVED.

- 22. THE CONTRACTOR SHALL CONTACT THE DISTRICT ONE TRAFFIC CONTROL SUPERVISOR AT (847)705-4151 A MINIMUM OF 72 HOURS IN ADVANCE OF BEGINNING WORK.
- 23. THE ENGINEER SHALL CONTACT MS. CORA MATHIS, TRAFFIC FIELD ENGINEER, AT (815) 485-6475 A MINIMUM OF TWO (2) WEEKS PRIOR TO THE PLACEMENT OF PERMANENT PAVEMENT MARKINGS.

24. WHERE SECTION OR SUB-SECTION MONUMENTS ARE ENCOUNTERED. THE ENGINEER SHALL BE NOTIFIED BEFORE SUCH MONUMENTS ARE REMOVED. THE CONTRACTOR SHALL PROTECT AND CAREFULLY PRESERVE ALL PROPERTY MARKERS AND MONUMENTS UNTIL THE OWNER, AN AUTHORIZED SURVEYOR OR AGENT HAS WITNESSED THEIR LOCATION.

THESE PLANS HAVE BEEN PREPARED FROM NOTES RECEIVED FROM THE BUREAU OF MAINTENANCE (or CONSTRUCTION or BRIDGE INSPECTORS).

26. STRIP REFLECTIVE CRACK CONTROL TREATMENT WILL BE INSTALLED IMMEDIATELY IN FRONT OF THE HMA SURFACING OPERATION SO TRAFFIC WILL NOT DISTURB IT BEFORE BEING COVERED BY HMA. ANY CRACK CONTROL TREATMENT DISTURBED BY TRAFFIC WILL BE REPLACED AT THE CONTRACTOR'S EXPENSE.

27. BEFORE BEGINNING ANY WORK, THE CONTRACTOR SHALL RETAIN AND RECORD (FOR FUTURE REFERENCES, ALL EXISTING PAVEMENT MARKING LINES IN ORDER THAT THESE LOCATIONS CAN BE RE-ESTABLISHED FOR STRIPING. EXACT LOCATIONS OF ALL STRIPING SHALL BE AS IRECTED BY THE ENGINEER

28. THE PROPOSED HOT-MIX ASPHALT RESURFACING SHALL BE TAPERED OUT AT A RATE OF TWENTY (20) FEET PER INCH OF THICKNESS AT MAINLINE AND MAJOR SIDE STREET LOCATIONS, EXCEPT WHERE BUTT JOINTS ARE INDICATED. AT MINOR STREETS AND ENTRANCES, TAPER OUT IN TEN (10) FEET EXCEPT WHERE BUTT JOINTS ARE INDICATED. AT SEAL COATED STREETS AND ENTRANCES, TAPER OUT IN THREE (3) FEET UNLESS OTHERWISE SHOWN

29. WHEN MILLED PAVEMENT IS OPEN TO TRAFFIC, THE MAXIMUM GRADE DIFFERENTIAL
BETWEEN PASSES OF THE MILLING MATCHING SHALL NOT EXCEED 1 1/2 INCHES WHERE THE
SPEED LIMIT IS 45 MPH OR LESS AND 1 INCH WHERE THE SPEED LIMIT IS GREATER THAN 45
MPH. WITH WRITTEN APPROVAL OF THE ENGINEER, A MAXIMUM GRADE DIFFERENTIAL OF SINCHES MAY BE ALLOWED IF THE FOGE OF THE MILLING IS SLOPED A MINIMUM 1.3 (V.H).

31. THE CONTRACTOR WILL BE REQUIRED TO KEEP A RECORD OF THE LOCATIONS OF PLATED STRUCTURES BY STATION AND OFFSET LEFT OR RIGHT OF THE CENTERLINE OF PAVEMENT.

32. THE CONTRACTOR WILL BE REQUIRED TO KEEP A RECORD OF THE LOCATIONS OF THE BURIED STRUCTURES ACCORDING TO THE STATION AND DISTANCE LEFT OR RIGHT OF THE CENTERLINE OF PAVEMENT. UPON COMPLETION OF THE WORK, THE CONTRACTOR WILL DELIVER THE RECORD TO THE ENGINEER.

33. EXISTING BROKEN FRAMES AND LIDS SHALL BE REMOVED AND DISPOSED OF BY THE CONTRACTOR AND SHALL BE REPLACED AS DIRECTED BY THE ENGINEER. REPLACEMENT FRAMES AND LIDS WILL BE PAID FOR IN ACCORDANCE WITH ARTICLE 109.04 OF THE STANDARD SPECIFICATIONS UNLESS A SEPARATE PAY ITEM HAS BEEN PROVIDED.

34. FOR FRAMES AND LIDS ADJUSTMENT WITHOUT MILLING, REUSE EXISTING FRAME AND LID UNLESS OTHERWISE SPECIFIED IN THE PLANS

35. ALL CLASS B PAVEMENT PATCHING WHICH REQUIRES FRAMES AND GRATES TO BE ADJUSTED SHALL BE CONSTRUCTED UTILIZING \*CAST IN PLACE\* ALTERNATE ACCORDING TO STATE HIGHWAY STANDARD 420111 FOR \*PCC

36. THE CONTRACTOR SHALL BE RESPONSIBLE FOR THE NOTIFICATION OF ALL EMERGENCY SERVICES, SCHOOL DISTRICTS, I.D.O.T.\*S COMMUNICATIONS CENTER, SPRINGFIELD TRUCK PERMIT SECTION AND OTHER AGENCIES AFFECTED BY THE CLOSURE. THE CONTRACTOR SHALL ALSO BE RESPONSIBLE FOR POSTING SIGNS THAT WILL INDICATE THE

37. THE ENGINEER SHALL OBTAIN APPROVAL FROM THE DISTRICT ONE BUREAU CHIEF OF MAINTENANCE FOR ANY PROPOSED REVISIONS IN THE SCHEDULED PAVEMENT PATCHING LOCATIONS

38. DO NOT SCALE PLANS FOR CONSTRUCTION DIMENSIONS.

39. RESERVED.

37.PAVEMENT MARKING TAPE, TYPE III SHALL BE USED FOR SHORT TERM PAVEMENT MARKINGS ON ALL FINAL SURFACES. THE COST OF THE PAVEMENT MARKING TAPE, TYPE III AND ITS REMOVAL SHALL BE INCLUDED IN THE COST OF SHORT TERM PAVEMENT MARKING.

38. THE \*ADVANCED WARNING SIGN DETAIL FOR ARTERIAL TRAFFIC\* LOCATED IN THE SPECIAL PROVISION FOR \*TEMPORARY INFORMATION SIGNING FOR LANE CLOSURES\* LAND THE SPECIAL PROVISION FOR \*PUBLIC CONVENIENCE AND SAFETY\*] IS/ARE APPLICABLE ONLY TO ARTERIAL ROADS AND SHALL NOT BE APPLIED TO EXPRESSWAYS/TOLLWAYS.

39. DISPOSAL OF SHOULDER CUTTING AND CLEAN SWEEPING OF THE SHOULDERS SHALL BE COMPLETED PRIOR OPENING OF THE SHOULDERS AND TRAFFIC. DISPOSAL AND SWEEPING SHALL BE INCLUDED IN THE COST OF "SHOULDER RUMBLE STRIPS 

#### GENERAL NOTES - EROSION CONTROL & LANDSCPING

- ALL EROSION CONTROL MEASURES SHALL BE IN ACCORDANCE WITH THE REQUIREMENTS OF THE STANDARD SPECIFICATIONS AND OF THE APPLICABLE STATE STANDARDS FOR THE ENTIRE DURATION OF THE CONTRACT, OR UNTIL SUCH TIME AS DIRECTED BY THE ENGINEER.
- 2. ALL AREAS DISTURBED AND RESTORED WITH SEEDING SHALL BE COVERED WITH AN EROSION CONTROL BLANKET IN ACCORDANCE WITH SECTION 251 OF THE STANDARD SPECIFICATIONS.
- SEEDING WILL NOT BE PERMITTED AT ANY TIME WHEN THE GROUND IS FROZEN, WET, OR IN AN UNTILLABLE CONDITION. LOCATIONS TO BE SEEDED ARE AS OUTLINED IN THESE PLANS. ANY ADDITIONAL AREAS SHALL BE DETERMINED BY THE ENGINEER.
- BEFORE STARTING CONSTRUCTION ON STAGE 2 OF THE PROJECT, EROSION CONTROL BLANKET AND SEEDING, CLASS 3 SHALL BE PLACED AFTER FINAL GRADING HAS BEEN COMPLETED ON THE FIRST PHASE OF
- THE CONTRACTOR SHALL TAKE ALL NECESSARY PRECAUTIONS FOR THE PROTECTION OF EXISTING PLANT MATERIAL FOR WHICH THE CONTRACT DOES NOT PROVIDE REMOVAL. THE PROTECTION OF EXISTING PLANT MATERIAL AND THE REPAIR OR REPLACEMENT OF EXISTING PLANT MATERIAL DAMAGED BY THE CONTRACTOR SHALL BE DONE IN ACCORDANCE WITH THE REQUIREMENTS OF SECTION 201 OF THE STANDARD SPECIFICATIONS
- LANDSCAPE CONTRACTOR SHALL STAKE THE LOCATION OF ALL SEEDING AND HAVE ALL PLANTING LAYOUTS APPROVED BY THE ENGINEER PRIOR TO INSTALLATION.
- APPROVED WATERING EQUIPMENT SHALL BE AT THE SITE OF THE WORK AND IN OPERATING CONDITION PRIOR TO STARTING THE SEEDING OPERATION AND DURING ALL SEEDING OPERATIONS OR SEEDING WILL
- 7. THE CONTRACTOR SHALL REPAIR IN KIND ANY AREAS DAMAGED AS A RESULT OF LANDSCAPING OPERATIONS
- THE FINISHED EARTHWORK SHALL HAVE A VEGETATION SUSTAINING SOIL COVERING THE TOP FOUR (4) INCHES IN AREAS TO BE SEEDED OR SODDED.

51



200 West Front Street Wheaton, II 60187

KSD REVISED // ADD. NO. 1 DESIGNED DRAWN KSD REVISED HECKED CMJ REVISED 03-04-09 REVISED

STATE OF ILLINOIS **DEPARTMENT OF TRANSPORTATION** 

SECTION COUNTY I-55 OVER THE KANKAKEE RIVER 55 88 (B&B-1) BB WILL **GENERAL NOTES** CONTRACT NO. 62930 SHEET NO. 1 OF 1 SHEETS STA. TO STA. FED ROAD DIST NO 1 THE INDIS FED AID PROJECT

SCALE: NTS

## SUMMARY OF QUANTITIES

		URBAN	CONS	TRUCTION TYPE					URBAN	CON	STRUCTION TYPE	
SUMMARY OF QUANTITIES		TOTAL YTITMAUC	ROADWAY		DGE SN 099-0002		SUMMARY OF QUANTITIES		TOTAL QUANTITY	ROADWAY	SN 099-0001	DGE   SN 099-000
		JOANTITT	I000-2A	X071-2A	X071-2A		93			I000-2A	X071-2A	X071-2A
CODE NO. ITEM DESCRIPTION 20200100 EARTH EXCAVATION	CU YD	3,610	QUANTITY 3,610	QUANTITY	QUANTITY	CODE NO. 70300240   TEMPORARY	ITEM DESCRIPTION PAVEMENT MARKING - LINE 6"	UNIT FOOT	12, 250	QUANTITY 12,250	QUANTITY	QUANTITY
-20201550 -SUB-BASE GRANULAR MATERIAL, TYPE B	CU YD	783	783-				PAVEMENT MARKING REMOVAL			12,370		
20201200 REMOVAL AND DISPOSAL OF UNSUITABLE MATERIAL	CU YD	500		<del></del>		70400100 TEMPORARY				6, 125		
20400800 FURNISHED EXCAVATION	CU YD	200	200				EMPORARY CONCRETE BARRIER	FOOT		6, 125		
20800150 TRENCH BACKFILL	CU YD	120	120				TIC PAVEMENT MARKING - LINE 4"			20,080		
25000210 SEEDING, CLASS 2A	ACRE	0,56	0,56				TIC PAVEMENT MARKING - LINE 8"			2,690		ļ
25000400 NITROGEN FERTILIZER NUTRIENT	POUND	50	50				TIC PAVEMENT MARKING - LINE 12"	FOOT				
25000500 PHOSPHORUS FERTILIZER NUTRIENT	POUND	50	50				PLASTIC PAVEMENT MARKING, TYPE B - LINE 5"	FOOT		4,450		
25000600 POTASSIUM FERTILIZER NUTRIENT	POUND	50	50			* 78005110 EPOXY PAVE		FOOT	5, 220			
25100630 EROSION CONTROL BLANKET		2,713	2, 713				LECTIVE PAVEMENT MARKER	EACH	350	350		
28000500 INLET AND PIPE PROTECTION	EACH	4	4			78300100 PAVEMENT N		SQ FT	6,430	6,430		
40600895 CONSTRUCTING TEST STRIP	EACH	~ <del>\</del>	$\frac{1}{2}$			78300200 RAISED REF	LECTIVE PAVEMENT MARKER REMOVAL	EACH	350	350		
40603340 HOT-MIX ASPHALT SURFACE COURSE, MIX "D", N70	TON	1524	1524			X0320887 POLYMER CO	NCRETE	CU FT	0.5			0.5
40603595 POLYMERIZED HOT-MIX ASPHALT SURFACE COURSE, MIX "F", N90	TON	72	72 }	$\Delta$		A	K LATEX CONCRETE OVERLAY, 2 1/4 INCHES	SQ YD			4, 162	4, 449
40800020 BITUMINOUS MATERIALS (PRIME COAT)	TON	245 245	45			X0322256 TEMPORARY	INFORMATION. SIGNING	5Q FT	14/4	1414	Δ	
42001300 PROTECTIVE COAT	SQ YD	8,802		4, 353	4,449		EXISTING PRECAST CONCRETE UNITS	SQ FT			180	
44000155 HOT MIX ASPHALT SURFACE REMOVAL, 1 1/2"	SQ YD	10, 680	10, 680	Α		X0325085 TEMPORARY	PAVEMENT (INTERSTATE)	SQ YD	7,044	7,044		
44000156 HOT-MIX ASPHALT SURFACE REMOVAL, 1 3/4"	SQ YD	2, 250	<del>2, 250 - 2</del>	) 🕰		X0325303 STRUCTURAL	REPAIR OF CONCRETE (DEPTH GREATER THAN 5 INCHES)	SQ FT	17		17	
44000156 HOT-MIX ASPHALT SURFACE REMOVAL, 1 3/4"  44004250 PAVED SHOULDER REMOVAL	SQ YD					X0325305 STRUCTURAL	REPAIR OF CONCRETE (DEPTH EQUAL TO OR LESS THAN 5	SQ FT	621		531	90
48203003 HOT-MIX ASPHALT SHOULDERS, 1 1/2''	SQ YD	10,680	10,680				CONCRETE BARRIER (TO REMAIN PERMANENTLY)			1,038		
50102400 CONCRETE REMOVAL	CU YD	93		85	8	X0325416 TRAFFIC CO	NTROL AND PROTECTION FOR DETOUR ROUTE	L SUM	ı	1		
50104400 CONCRETE HEADWALL REMOVAL	EACH	10	10				EMENT CONCRETE SURFACE REMOVAL, 1 3/4"	SQ YD	850	850		
50200100 STRUCTURE EXCAVATION	CU YD	10		10			ON CABLE MEDIAN BARRIER TERMINALS	EACH	4	4		
50300225 CONCRETE STRUCTURES	CU YD	46.8		17.3	29.5		TIVE TEMPORARY TAPE, TYPE III, 4 INCH			37,110		
50300255 CONCRETE SUPERSTRUCTURE	CU YD	90.8		90.8	23.3		D LEVELING BINDER (MACHINE METHOD), IL-4.75, N50	FOOT	56		Δ	
					4 210			COLET		56 }	468	
50300260 BRIDGE DECK GROOVING	li	8, 306		4,087	4,219	X5121800 PERMANENT		SQ FT	468		468	
50500505 STUD SHEAR CONNECTORS	EACH	19		19			NTROL AND PROTECTION (EXPRESSWAYS)	L SUM	1	1		
55039700 STORM SEWERS TO BE CLEANED	FOOT	850	850				NTROL SURVEILLANCE, EXPRESSWAYS	CAL DA	80	80		
50800205 REINFORCEMENT BARS, EPOXY COATED		18,740		15, 650	3,090		STING CONCRETE END SECTION	EACH	1	1		
52000110 PREFORMED JOINT STRIP SEAL	FOOT	92		92			RELAMP EXISTING LUMINAIRE	EACH	57	57		
52000325 NEOPRENE EXPANSION JOINT, 2 1/2"	FOOT	97			97	Z0002820 BARRIGADES		WEEK	60	60		
52000340 NEOPRENE EXPANSION JOINT, 4"	FOOT	191		94	97	Z0006201 BRIDGE DEC	K HYDRO-SCARIFICATION 1"	SQ YD	8,611		4, 162	4,449
542A0217 PIPE CULVERTS, CLASS A, TYPE 1 12"	FOOT	339	339			Z0013798 CONSTRUCT	ON LAYOUT	L SUM	1	1		
542A0220 PIPE CULVERTS, CLASS A, TYPE 1 15"	FOOT	475	475			NP Z0014700 CULVERT TO	BE CLEANED	EACH	14	14		
542A0223 PIPE CULVERTS, CLASS A, TYPE 1 18"	FOOT	30	30			Z0016001 DECK SLAB	REPAIR (FULL DEPTH, TYPE I)	SQ YD	6		5	1
54213657 PRECAST REINFORCED CONCRETE FLARED END SECTIONS 12"	EACH	2	2			Z0016002 DECK SLAB	REPAIR (FULL DEPTH, TYPE II)	SQ YD	238		238	
54213660 PRECAST REINFORCED CONCRETE FLARED END SECTIONS 15"	EACH	1	1			NP Z0018500 DRAINAGE S	TRUCTURES TO BE CLEANED	EACH	14	14		
54247090 GRATING FOR CONCRETE FLARED END SECTION 12"	EACH	2	2			Z0030150 IMPACT AT	ENUATORS (NON-REDIRECTIVE), TEST LEVEL 3	EACH	4	4		
54247100 GRATING FOR CONCRETE FLARED END SECTION 15"	EACH	1	1_			Z0030250 IMPACT ATT	ENUATORS, TEMPORARY (NON- REDIRECTIVE), TEST LEVEL 3	EACH	2_	2		
59000200 EPOXY CRACK INJECTION	FOOT	902		627	275	1 1	ENUATORS, RELOCATE (NON-REDIRECTIVE), TEST LEVEL 3	EACH	2	2		-
60100060 CONCRETE HEADWALL FOR PIPE DRAINS	EACH	4	4			Z0040530 PIPE UNDER		FOOT	4,000	4,000		
60107600 PIPE UNDERDRAINS 4"		4,000	4,000				RESTRESSED CONCRETE I-BEAM REPAIR	SQ FT			11.5	
60236200 INLETS, TYPE A, TYPE 8 GRATE	EACH	3	3				RAIN 12" WITH VARIABLE SLOT	FOOT	466	466	1 1111	
60615400 PAVED DITCH, TYPE A-15	FOOT	517	517			Z0063140 SE0TTED DF Z0076600 TRAINEES	VIAN AB HATTI TOMATOBLE SECT	HOUR				
63801200 MODULAR GLARE SCREEN SYSTEM		4, 300					CONNECTION TO STRUCTURE	EACH	1000	1000		
		1.0							4	4	1	<u> </u>
67000400 ENGINEER'S FIELD OFFICE, TYPE A	CAL MO	12	12				IRFACE SENSOR AND TEMPERATURE PROBE	L SUM	7	0.300	1	
67100100 MOBILIZATION	L SUM	1	. 1			* X0326677   REMOVE HI( 2000/050   AGGREGA	H TENSION CABLE MEDIAN BARRIER DTE GUBGRADE 1/2" RAIN 15" WITH VARIABLE SLOT	F00T <b>5Q YO</b> F00T	2, 590 7,044	2,390 7,044		
70100405 TRAFFIC CONTROL AND PROTECTION, STANDARD 701321	EACH					Z0065760   SLOTTED DF * SPECIALTY ITEM	RAIN 15" WITH VARIABLE SLOT  NP = NON - PARTICIPATING	I FOOT	573	573		L
70106800 CHANGEABLE MESSAGE SIGN	CAL MO	12	12			- SPECIALIT TIEM	@ = Y080			1 Rev. 12	-30-09	
DESIGNED - KSD RE	EVISED -						I-55 OVER THE KANKAKEE RIVER		F.A.I. RTE.	SECTI		JNTY TOTAL SHEETS
CHECKED ON DE	EVISED -			DED A DT	STATE OF	ILLINOIS RANSPORTATION	SUMMARY OF QUANTITIES		55	88 (B&B-		ILL 72
200 West Front Street CHECKED - CMJ RE	- * 13EU		ı	UEPAKI	write the l	DANSPURIATION	Johnson of Constitute		1		CON	ITRACT NO. 6

## SUMMARY OF QUANTITIES

				CONS	STRUCTION TYPE	CODE
	SUMMARY OF QUANTITIES		URBAN	ROADWAY		DGE
	33. MIN. (17. 37. 33. 43. 14. 17. 12. 3		TOTAL		SN 099-0001	SN 099-0002
CODE NO.	ITEM DESCRIPTION	LUNIT	QUANTITY	I000-2A QUANTITY	X071-2A QUÁNTITY	X071-2A QUANTITY
40600300	AGGREGATE (PRIME COAT)	TON	223	223	GOMITITI	GOMITTI
40600982	HOT-MIX ASPHALT SURFACE REMOVAL - BUTT JOINT	SQ YD	144	144		
40601005	HOT MIX ASPHALT REPLACEMENT OVER PATCHES	TON	530	530		
40603085	HOT-MIX ASPHALT BINDER COURSE, IL-19.0, N70	TON	2, 286	2, 286		
44000164	HOT-MIX ASPHALT SURFACE REMOVAL, 3 3/4"	SQ YD	18, 147	18,147		
44000165	HOT-MIX ASPHALT SURFACE REMOVAL, 4"	SQ YD	37, 548	37, 548		
44002216	HOT-MIX ASPHALT REMOVAL OVER PATCHES, 4"	SQ YD	2366	2366	1 .	
44201765	CLASS D PATCHES, TYPE II, 10 INCH	SQ YD	901	901		
442017 <b>6</b> 9	CLASS D PATCHES, TYPE III, 10 INCH	SQ YD	676	676	(	
44201771	CLASS D PATCHES, TYPE IV, 10 INCH	SQ YD	676	676		
44300900	STRIP REFLECTIVE CRACK CONTROL TREATMENT SYSTEM A	FOOT	10, 915	10, 915	2.59	
63500105	DELINEATORS	EACH	133	133		
64200105	SHOULDER RUMBLE STRIP	FOOT	16,053	16,053		
X0322729	MATERIAL TRANSFER DEVICE	TON	10, 138	10, 138		
X0324685	TEST STRIP (STONE MATRIX ASPHALT)	EACH	2	2		
40603153	POLYMERIZED HOT-MIX ASPHALT SURFACE COURSE, STONE MATRIX ASPHALT, N80	TON	5,069	5,069		
40603148	POLYMERIZED HOT-MIX ASPHALT BINDER COURSE, STONE MATRIX ASPHALT, N80	TON	5,069	5,069		

\* SPECIALTY ITEM

rjngroup

Evcellence through Ownership

200 West Front Street Wheaton, Il 60187


			/			
DESIGNED	-	KSD	REVISED	-	ADD. NO.	. 1
DRAWN	-	KSD	REVISED	-		
CHECKED	-	CMJ	REVISED	-		
DATE		03-04-09	REVISED	-		

STATE OF ILLINOIS
DEPARTMENT OF TRANSPORTATION

						,	KAKEE		}
	5	SUI	VII	VIA	RY	OF QU	JANTIT	IES	
NTS	SHEET N	10.	1	OF	1	SHEETS	STA.		TO ST

SCALE:

7	MUC	ien	2//	ee	7 /	6.	20	-0	9		
	F.A.I. RTE.	•		SE	CTION				COUNTY	TOTAL	SHEET NO.
	55		8	8 (B	&B-1)	BR			WILL	72	4A
_						٠.		T	CONTRACT	NO. (	52930
	FED.	ROAD	DIST.	NO. :	ILLI	OIS	FED.	AID	PROJECT		

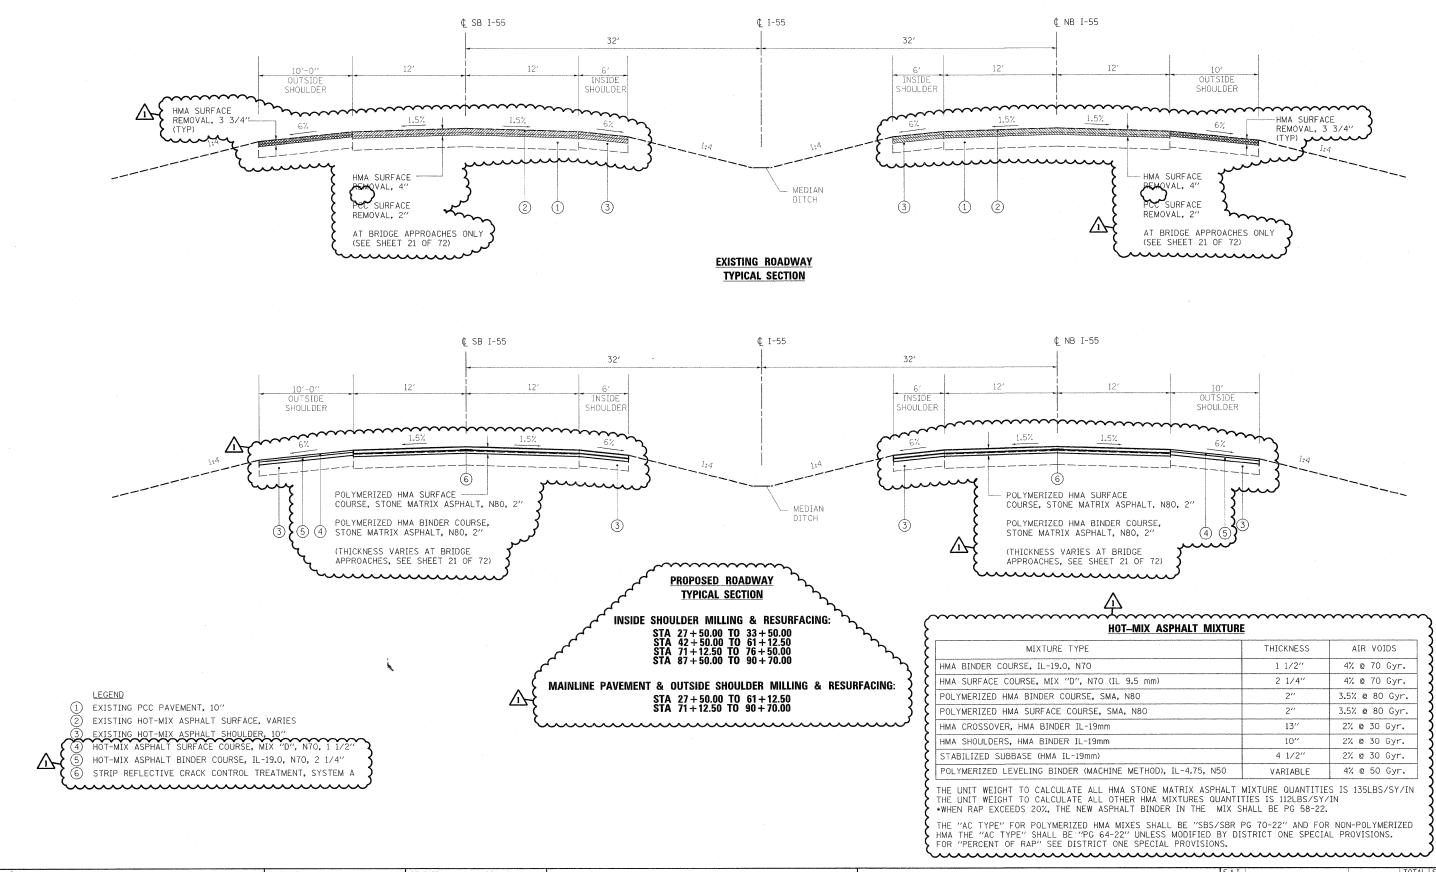

E = K/N]182518/ST LOUIS/06-18-09/N.0 CurrentN.2 Sheets/18 N.E = \$PLTSCALE\$ E = gwades

PLOT DATE = 1 TILE NAME = H PLOT SCALE = 4 SSER NAME = 6

rjngroup

Excellence through Ownership

200 West Front Street Wheaton, II 60187

 DESIGNED
 KSD
 REVISED
 ADD. NO. 1


 DRAWN
 KSD
 REVISED

 CHECKED
 CMJ
 REVISED

 DATE
 03-04-09
 REVISED

STATE OF ILLINOIS DEPARTMENT OF TRANSPORTATION

## EXISTING N. RIVER ROAD EXIT RAMP TYPICAL SECTION

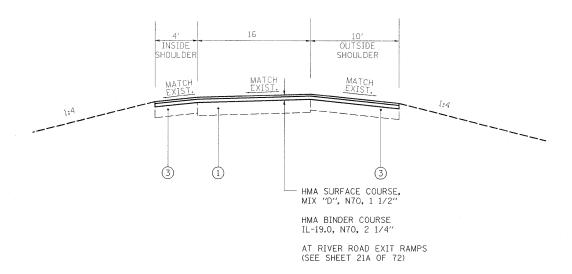

PROPOSED

N. RIVER ROAD EXIT RAMP

TYPICAL SECTION

LEGEND

1 EXISTING PCC PAVEMENT
2 EXISTING HOT-MIX ASPHALT SURFACE, VARIES
3 EXISTING HOT-MIX ASPHALT SHOULDER, VARIES

rjngroup

DRAWN CHECKED -CMJ 200 West Front Street Wheaton, II 60187 03-04-09

DESIGNED -

KSD

REVISED

REVISED


REVISED


REVISED


ADD. NO. 1

STATE OF ILLINOIS
DEPARTMENT OF TRANSPORTATION

SECTION I-55 OVER THE KANKAKEE RIVER WILL 72 88 (B&B-1) BR RAMP TYPICAL SECTIONS CONTRACT NO. 62930 SHEET NO. 2 OF 3 SHEETS STA. ----TO STA. ---

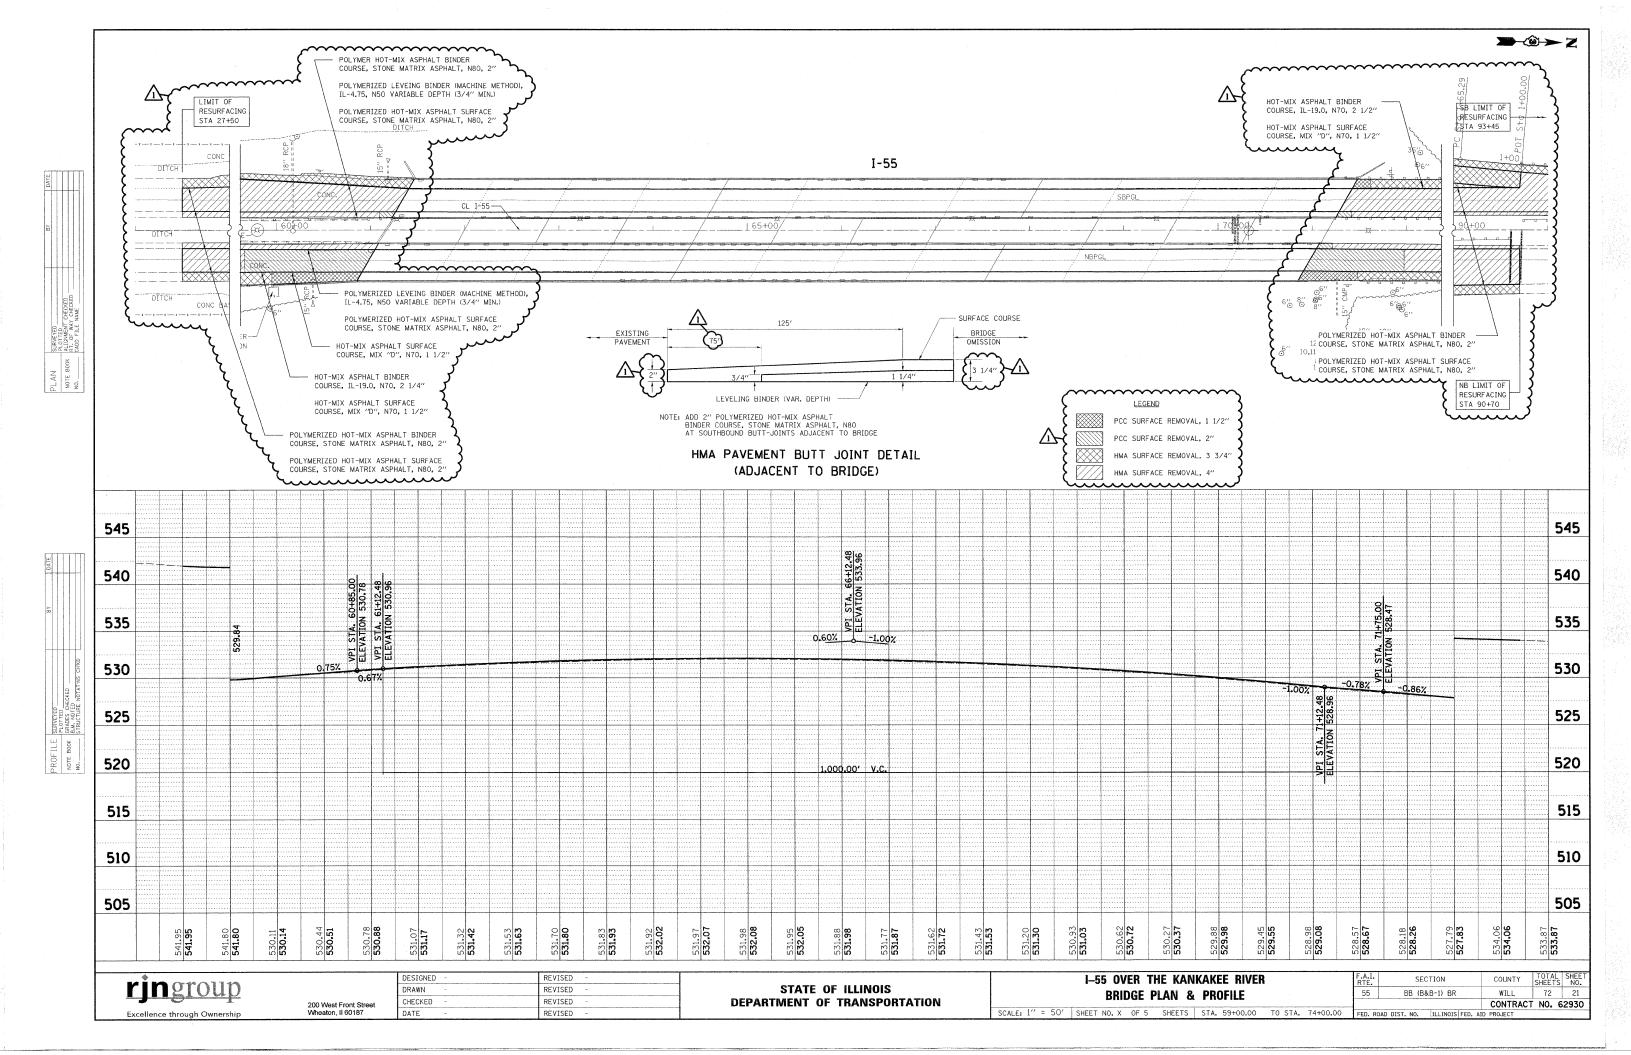

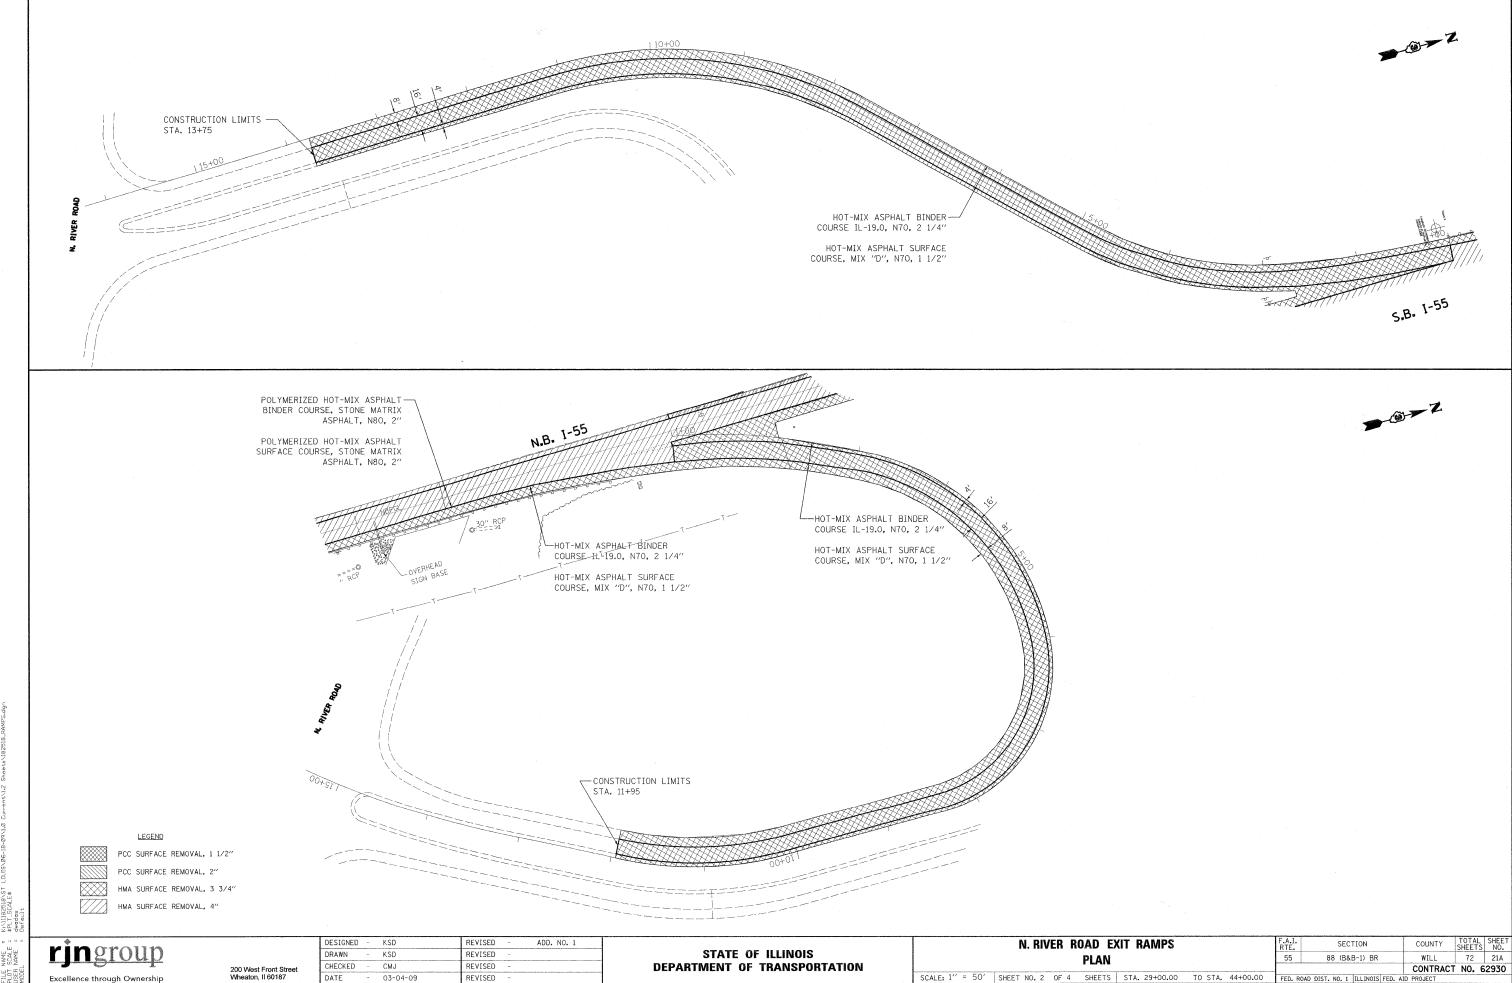

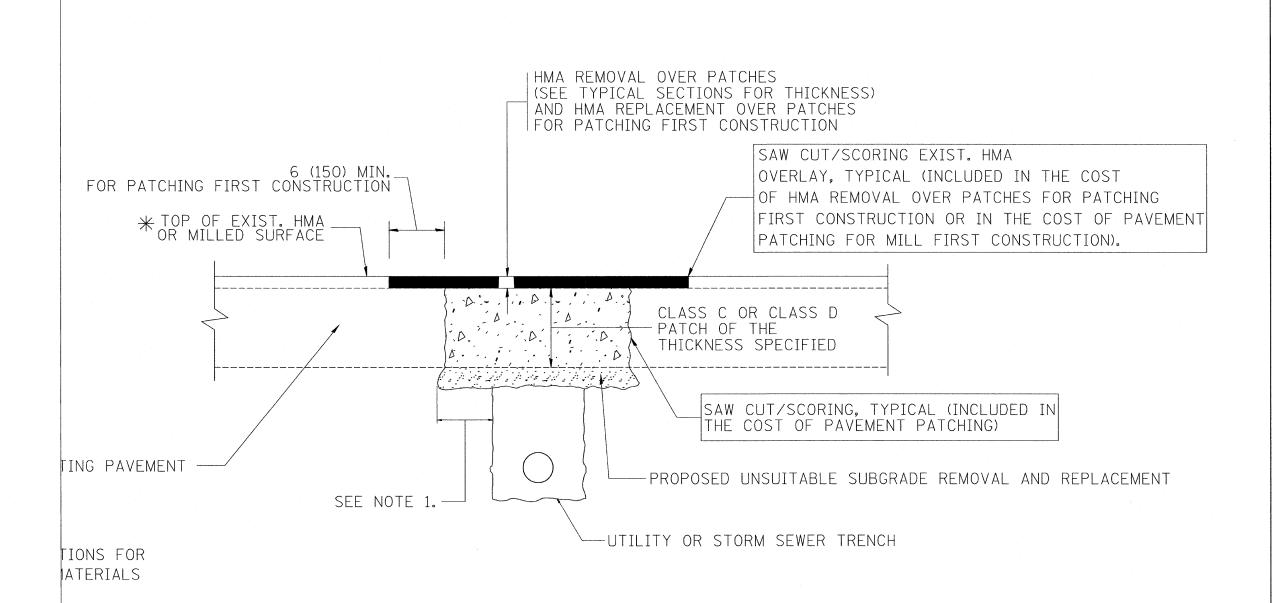

HE FULL DEPTH PATCH SHALL BE 12 (300) WIDER F THE TRENCH.

MEASUREMENT AND BASIS E RECURRING SPECIAL CHING WITH HOT-MIX Y REMOVAL".

#### SEQUENCE OF CONSTRUCTION (PATCHING FIRST)


- 1. REMOVE THE EXISTING HMA MATERIAL OVER THE AREA TO BE PATCHED.
- 2. REMOVE AND REPLACE WITH CLASS C OR D PATCH.
- 3. REPLACE HMA MATERIAL OVER THE AREA TO BE PATCHED.

### SEQUENCE OF CONSTRUCTION (MILLING FIRST)

- 1. MILL HMA FIRST IF THERE IS AT LEAST 41/2 INCHES OR MORE OF HMA MATERIAL ON TOP OF THE EXISTING PAVEMENT OR IF THE PAVEMENT IS FULL DEPTH HMA. A MINIMUM OF 2 INCHES OF HMA MATERIAL SHALL BE IN PLACE AFTER MILLING.
- 2. REMOVE AND REPLACE WITH FULL DEPTH CLASS D PATCHES TO TOP OF MILLED SURFACE.


ALL DIMENSIONS ARE IN INCHES (MILLIMETERS) UNLESS OTHERWISE SHOWN.


							$\Delta A$ 0080	SHEET 12-30-09
ərdl	DESIGNED - R. SHAH	REVISED - A. ABBAS 04-27-98			PAVEMENT PATCHING FOR		F.A.I. SECTION	COUNTY TOTAL SHEET SHEET NO.
	DRAWN -	REVISED - R. BORO 01-01-07	STATE OF ILLINOIS				55 881848-11BR	WILL 72 72A.
00 ′/ IN.	CHECKED -	REVISED - R. BORO 09-04-07	DEPARTMENT OF TRANSPORTATION		HMA SURFACED PAVEMENT		BD400-04 (BD-22)	
7/2008	DATE - 10-25-94	REVISED - K. ENG 10-27-08		SCALE: NONE	SHEET NO. 1 OF 1 SHEETS STA.	TO STA.	FED. ROAD DIST. NO. 1 ILLINOI	

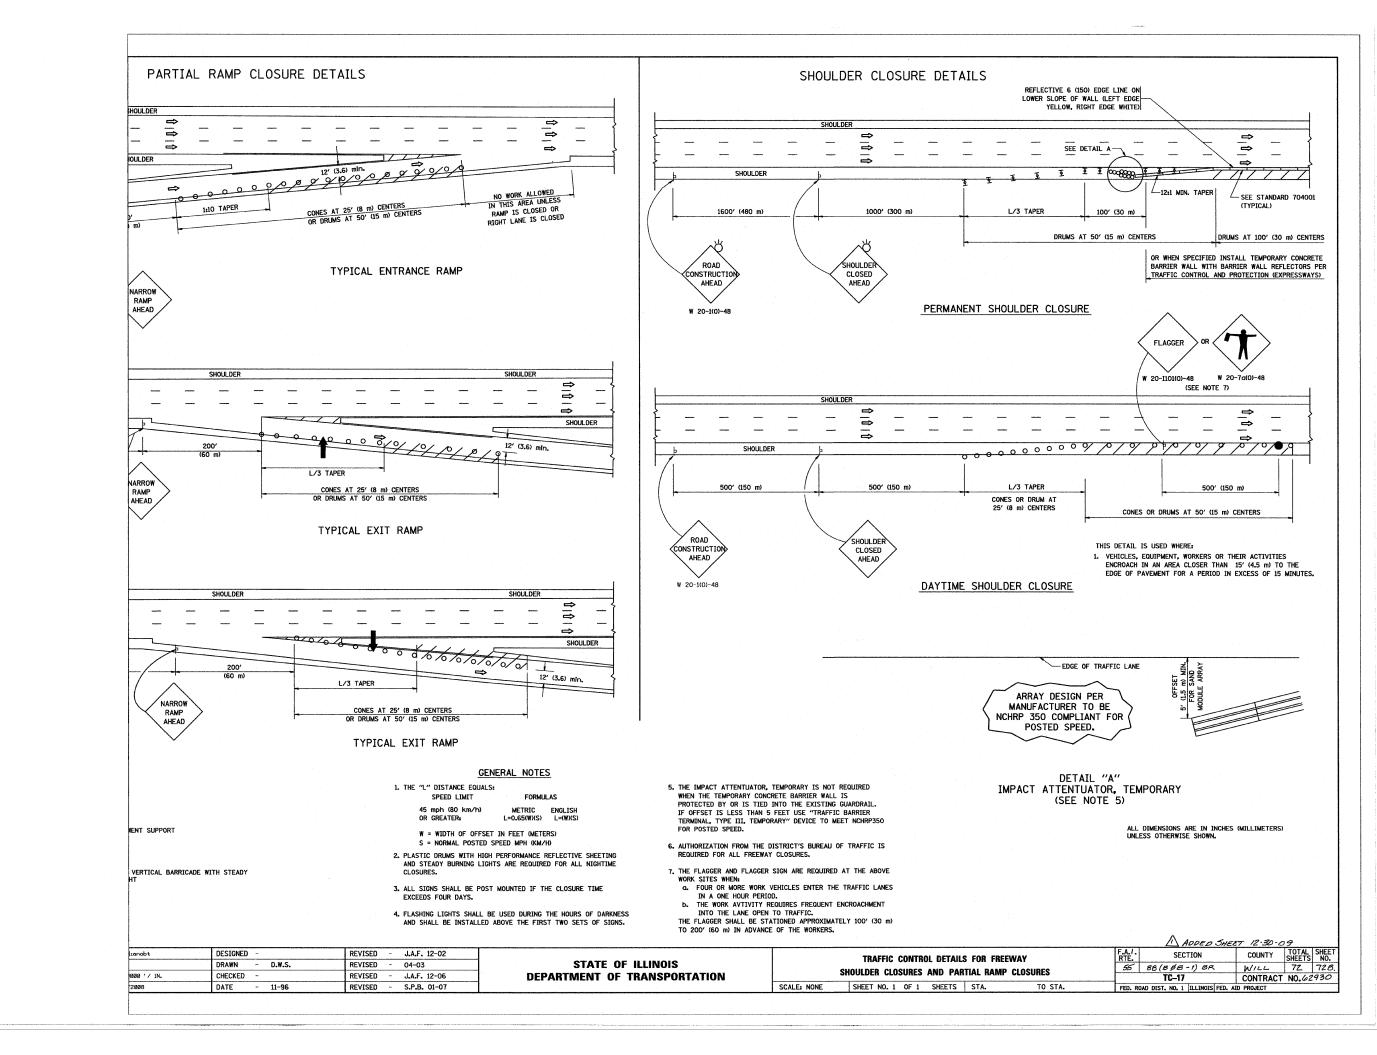

#### SIGNING FOR FLAGGING OPERATIONS AT WORK ZONE OPENINGS

#### WORK ZONE EXIT OPENING

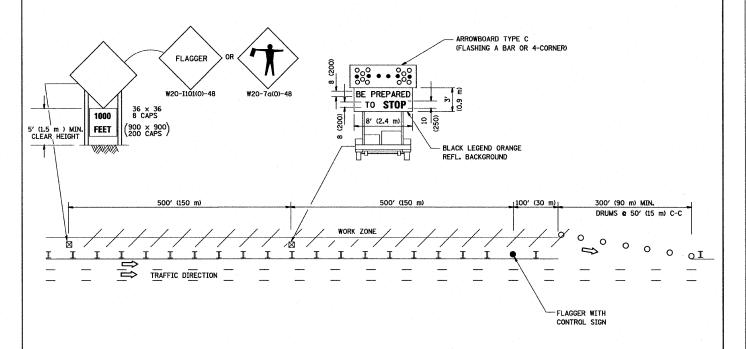

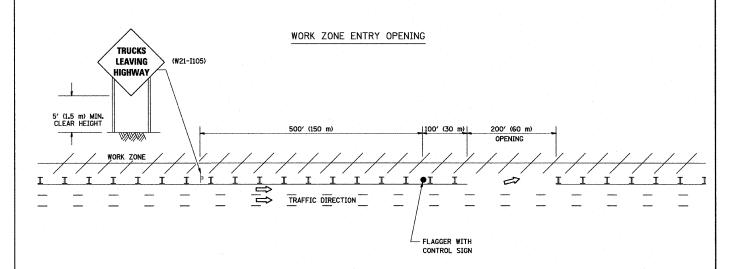

#### NOTES.

- The Arrowboard, the Flagger Ahead trailer mounted sign, and the Trucks Leaving Highway sign shall be removed or turned away from traffic and the exit and entry openings shall be closed when the flagging operation ceases.
- 2. Work Zone Exit Openings should be a minimum of one half mile apart.
- Exiting the work zone at any place other than at a Work Zone Exit Opening will be prohibited.
- 4. All vehicles shall enter the work zone at entry openings, using their turn signals to warn motorists

ALL DIMENSIONS ARE IN INCHES (MILLIMETERS) UNLESS OTHERWISE SHOWN

										LA ADDED SHEET TO	20-0	J9			
ıanobt	DESIGNED -	REVISED -	D.W.S. 08-98			SIGNING F	OR FLA	COINC	OPERATIONS		F.A./.	SECTION	COUNTY	TOTAL	SHEET NO.
	DRAWN -	REVISED -	J.A.F. 04-03	STATE OF ILLINOIS							55	88 (B \$B-1)BR	WILL	72	72C.
00 ′/ IN.	CHECKED -	REVISED -	J.A.F. 02-06	DEPARTMENT OF TRANSPORTATION		AI W	VORK ZO	UNE UP	ENINGS			TC-18	CONTRACT	NO. 62	2930
2008	DATE -	REVISED -	S.P.B. 01-07		SCALE: NONE	SHEET NO. 1 OF	1 SHE	EETS	STA.	TO STA.	FED. RO	OAD DIST. NO. 1 ILLINOIS FED.	AID PROJECT		