

R.E. - JAMES M. SULLIVAN

AS BUILT

STATE OF ILLINOIS
DEPARTMENT OF TRANSPORTATION
DIVISION OF HIGHWAYS

FOR INDEX OF SHEETS, SEE SHEET NO. 12

FOR SUMMARY OF QUANTITIES, SEE SHEET NO. 13 & 14

AS BUILT PLANS FOR PROPOSED
FEDERAL AID HIGHWAY


F.A. ROUTE 710, SECTION (48Z-2 & 3, 50Z-2 & 3) RS-2, PROJECT F-710(3)
F.A. ROUTE 741, SECTION 11RS-1, (10, 12) RS-2, PROJECT F-741(5)
MACON & PIATT COUNTIES

C-95-184-79

MILLING & RESURFACING PROJECT


C-95-012-80

F.A. RTE.	SECTION	COUNTY	TOTAL SHEET NO.
710 & 741	8	MACON & PIATT	38
PROJECT			
* F.A. 710 - (48Z-2 & 3, 50Z-2 & 3) RS-2			
* F.A. 741 - 11RS-1, (10, 12) RS-2			
P-95-054-79			

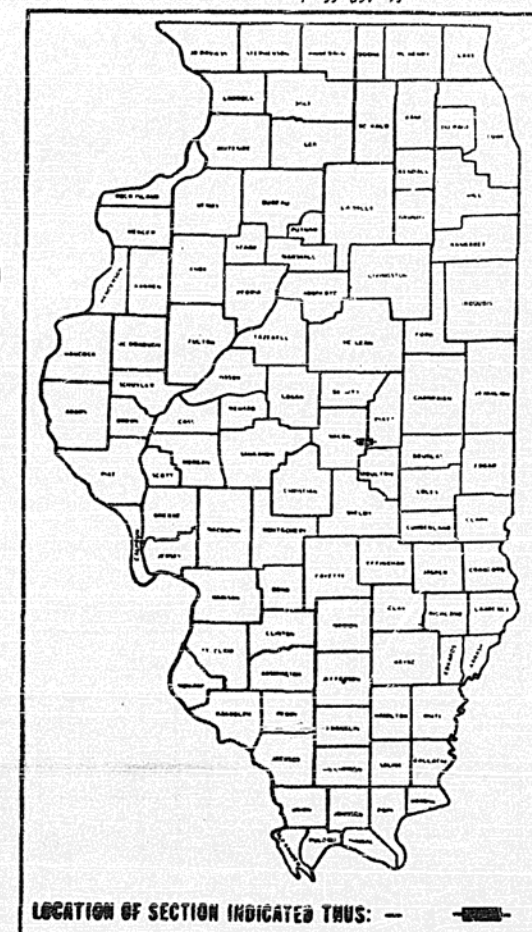

SECTION (48Z-2 & 3, 50Z-2 & 3) RS-2 AND
PROJECT F-710(3) ENDS
STATION 350+62.00

SECTION (48Z-2 & 3, 50Z-2 & 3) RS-2 AND
PROJECT F-710(3) BEGINS
STATION 200+09.00

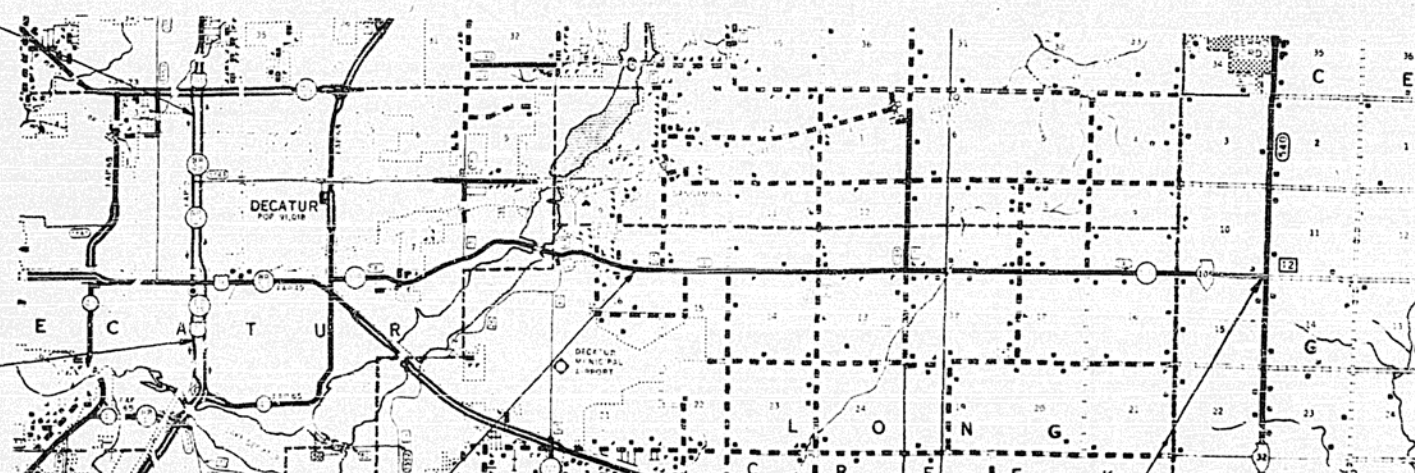

SECTION 11RS-1, (10, 12) RS-2 AND
PROJECT F-741(5) BEGINS
STATION 143+53

SECTION 11RS-1, (10, 12) RS-2 AND
PROJECT F-741(5) ENDS
STATION 520+91.65

TOTAL LENGTH OF SECTION AND PROJECT ON F.A.P. ROUTE 710 = 12,401.5 LIN. FT. = 2.349 MILES
NET LENGTH OF SECTION AND PROJECT ON F.A.P. ROUTE 710 = 12,381 LIN. FT. = 2.345 MILES

TOTAL LENGTH OF SECTION AND PROJECT ON F.A.P. ROUTE 741 = 36,730.65 LIN. FT. = 6.958 MILES
NET LENGTH OF SECTION AND PROJECT ON F.A.P. ROUTE 741 = 36,730.65 LIN. FT. = 6.958 MILES

CONTRACT NO. 34029

STATE OF ILLINOIS
DEPARTMENT OF TRANSPORTATION
DIVISION OF HIGHWAYS

SUBMITTER: _____

DESIGNED: Aug 28 1979 DISTRICT ENGINEER

ENGINEER OF PLANS AND CONTRACTS

PASSED: Aug 28 1979 Thomas R. Bryant

ENGINEER OF DESIGN

APPROVED: Aug 28 1979 John J. Thompson

DIRECTOR, DIVISION OF HIGHWAYS

U.S. DEPARTMENT OF TRANSPORTATION
FEDERAL HIGHWAY ADMINISTRATION

APPROVED _____

DIVISION ADMINISTRATOR DATE

Revised Set 9-7-79


MACON & PIATT COUNTY SECTION # F.A. ROUTES 710 & 741
* F.A.P. 710 - (48Z-2 & 3, 50Z-2 & 3) RS-2
F.A.P. 741 - 11RS-1, (10, 12) RS-2

TYPICAL CROSS SECTION
 MARION ST. TO PRAIRIE AVE. & NORTH ST. TO ELDORADO
 STA. 200+09 TO 213+75 & STA. 221+60 TO 225+62
 F.A.P. ROUTE 710 (U.S. 51 SOUTHBOUND)

1

ROUTE NO	SECTION	COUNTY	TOTAL SHEETS	SHEET NO
F.A.P. 710 & 741	*	MACON & PIATT	38	2

* F.A.P. 710 - (482-2(3), 502-2(3)) RS-2
 F.A.P. 741 - 11 RS-1, (10-12) RS-2

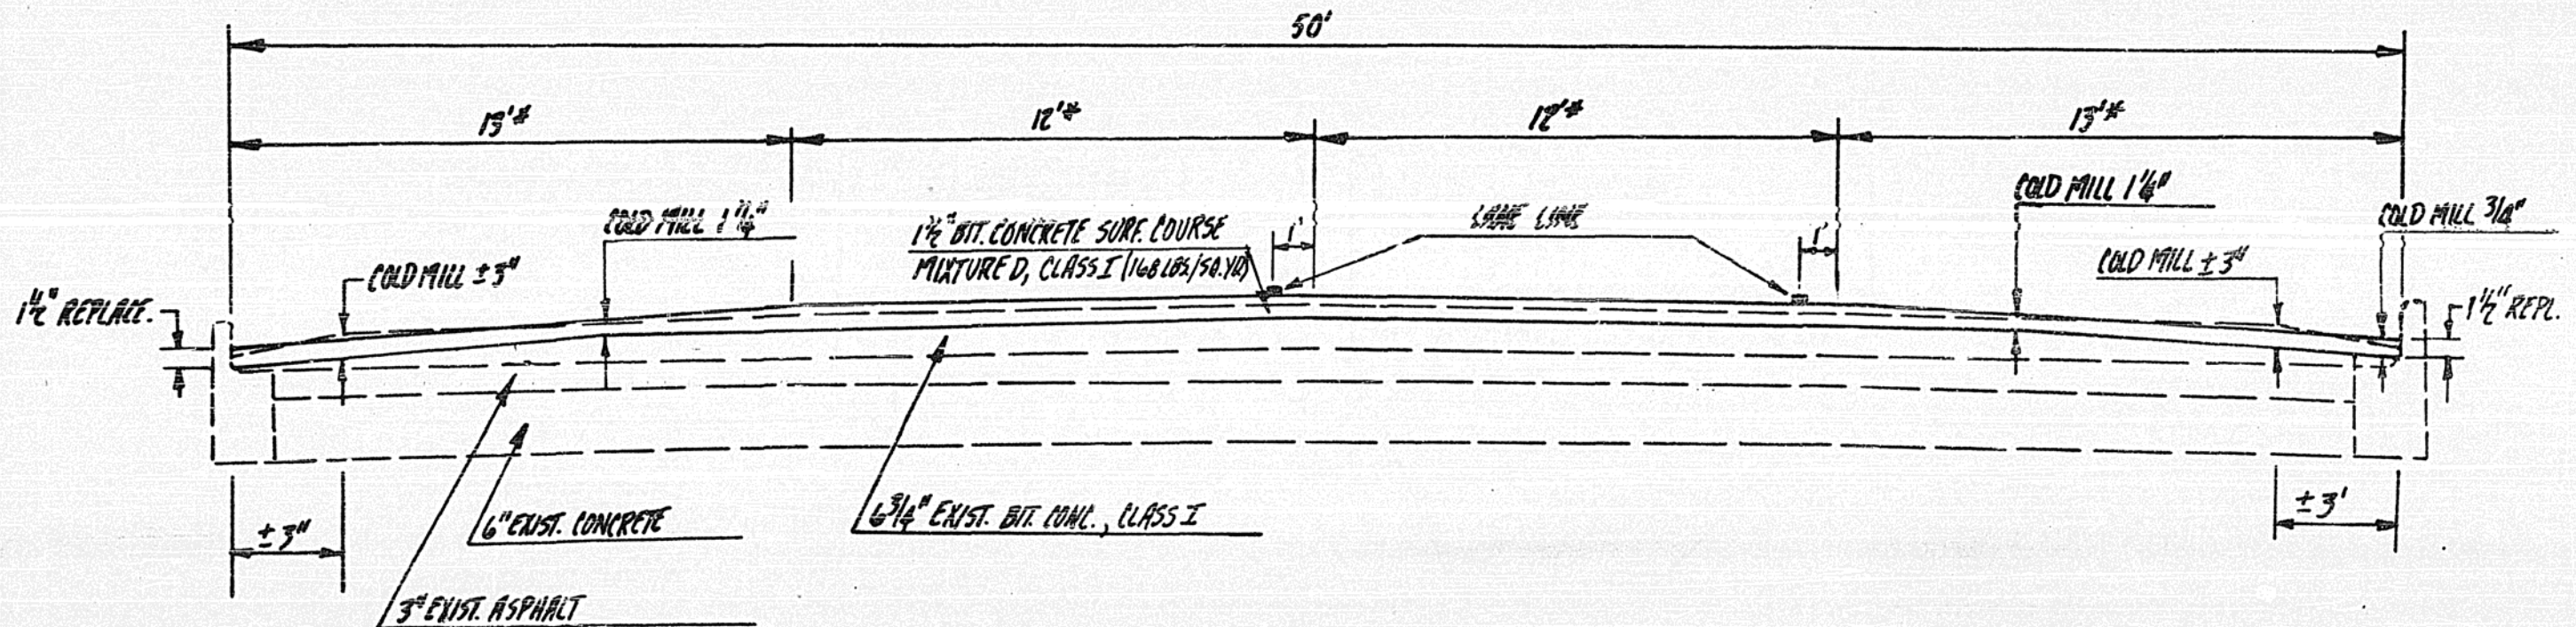


* TYPICAL REPLACEMENT WIDTH IS ONLY SUGGESTED WIDTHS
 SO THAT A SLOPE MAY BE MAINTAINED. OTHER WIDTHS
 MAY BE USED.

TYPICAL CROSS SECTION
PRAIRIE AVE. TO NORTH ST.
STA. 213+75 TO 221+60
F.A.P. 710 (U.S. 51 SOUTHBOUND)

2

ROUTE NO.	SECTION	COUNTY	TOTAL SHEETS	SHEET NO.
F.A.P. 710 & 741	X	MAHON & PIATT	38	3

* F.A.P. 710 - (482-213, 502-213) RS-2
F.A.P. 741 - 11RS-1 (10, 12) RS-2

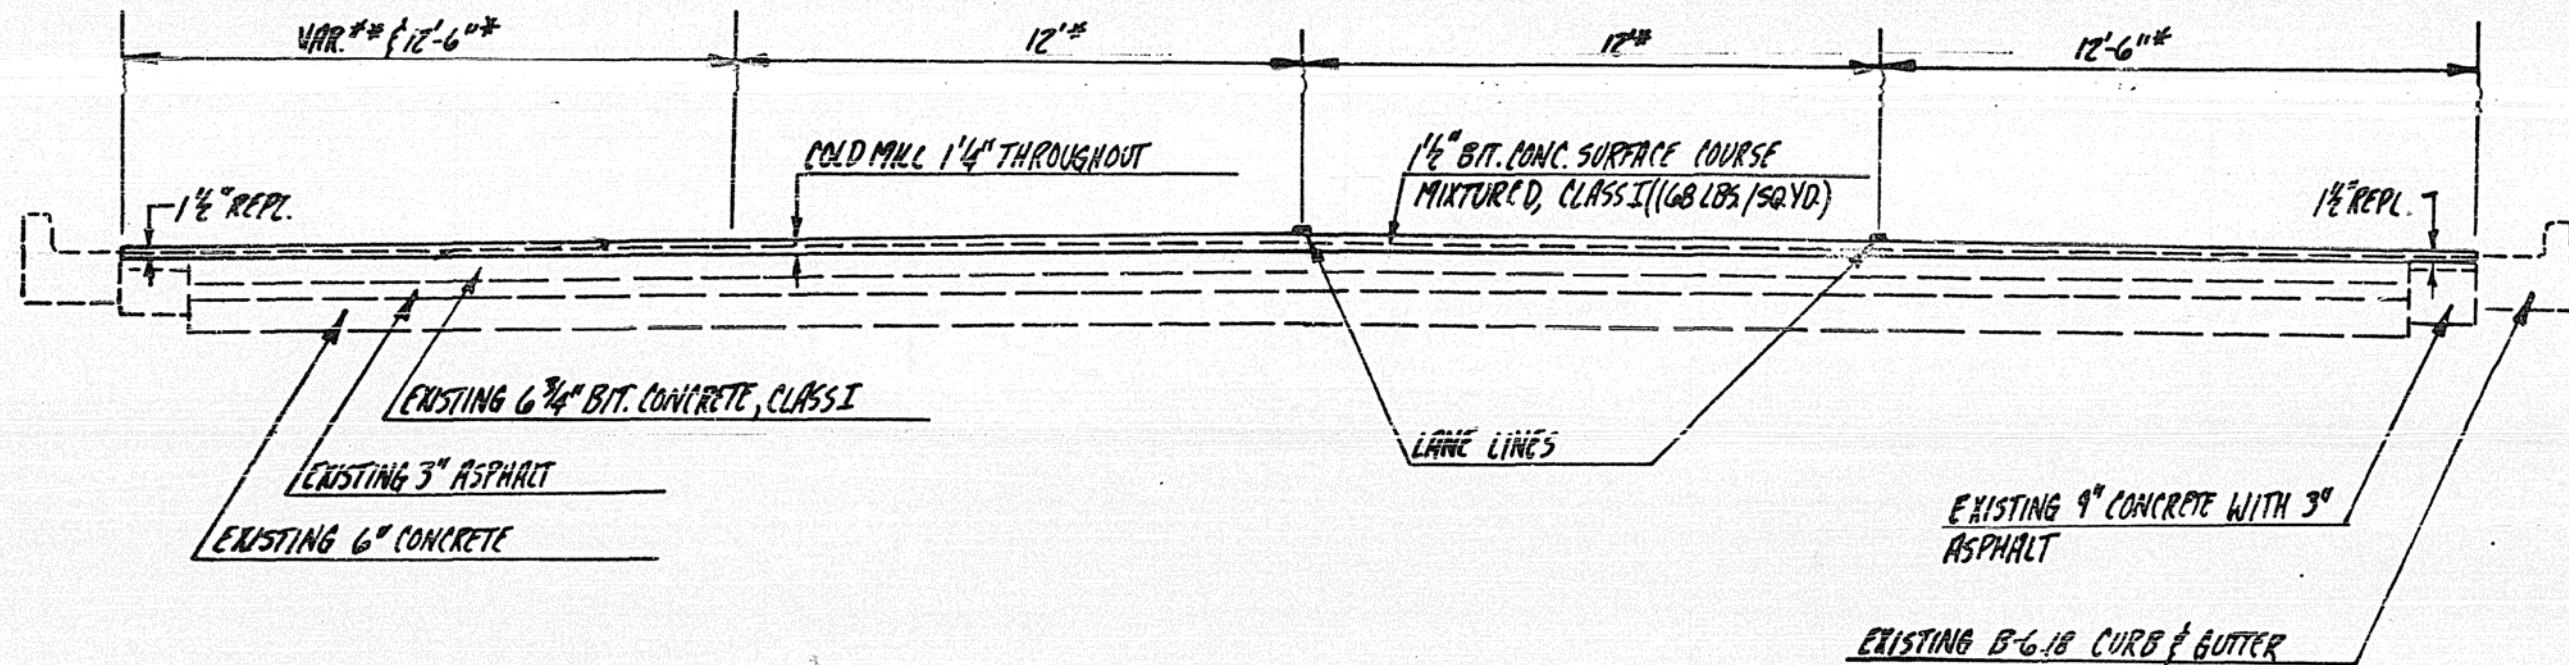


* TYPICAL REPLACEMENT WIDTH IS ONLY SUGGESTED
WIDTHS SO THAT A SLOPE MAY BE MAINTAINED.
OTHER WIDTHS MAY BE USED.

** WIDTH VARIES DUE TO CITY CURB & GUTTER
REHABILITATION PROJECT. SEE PLAN SHEETS.

TYPICAL CROSS SECTION
 ELDORADO ST. TO CERRO GORDO ST.
 STA. 225+62 TO STA. 229+71
 F.A.P. ROUTE 710 (U.S. 51 SOUTHBOUND)

3

ROUTE NO.	SECTION	COUNTY	TOTAL SHEETS	SHEET NO.
F.A.P. 710 # 741	#	MACON & PIATT	38	4
# F.A.P. 710 - (482-2(3), 502-2(3)) RS-2 F.A.P. 741- 11RS-1, (10,12) RS-2				

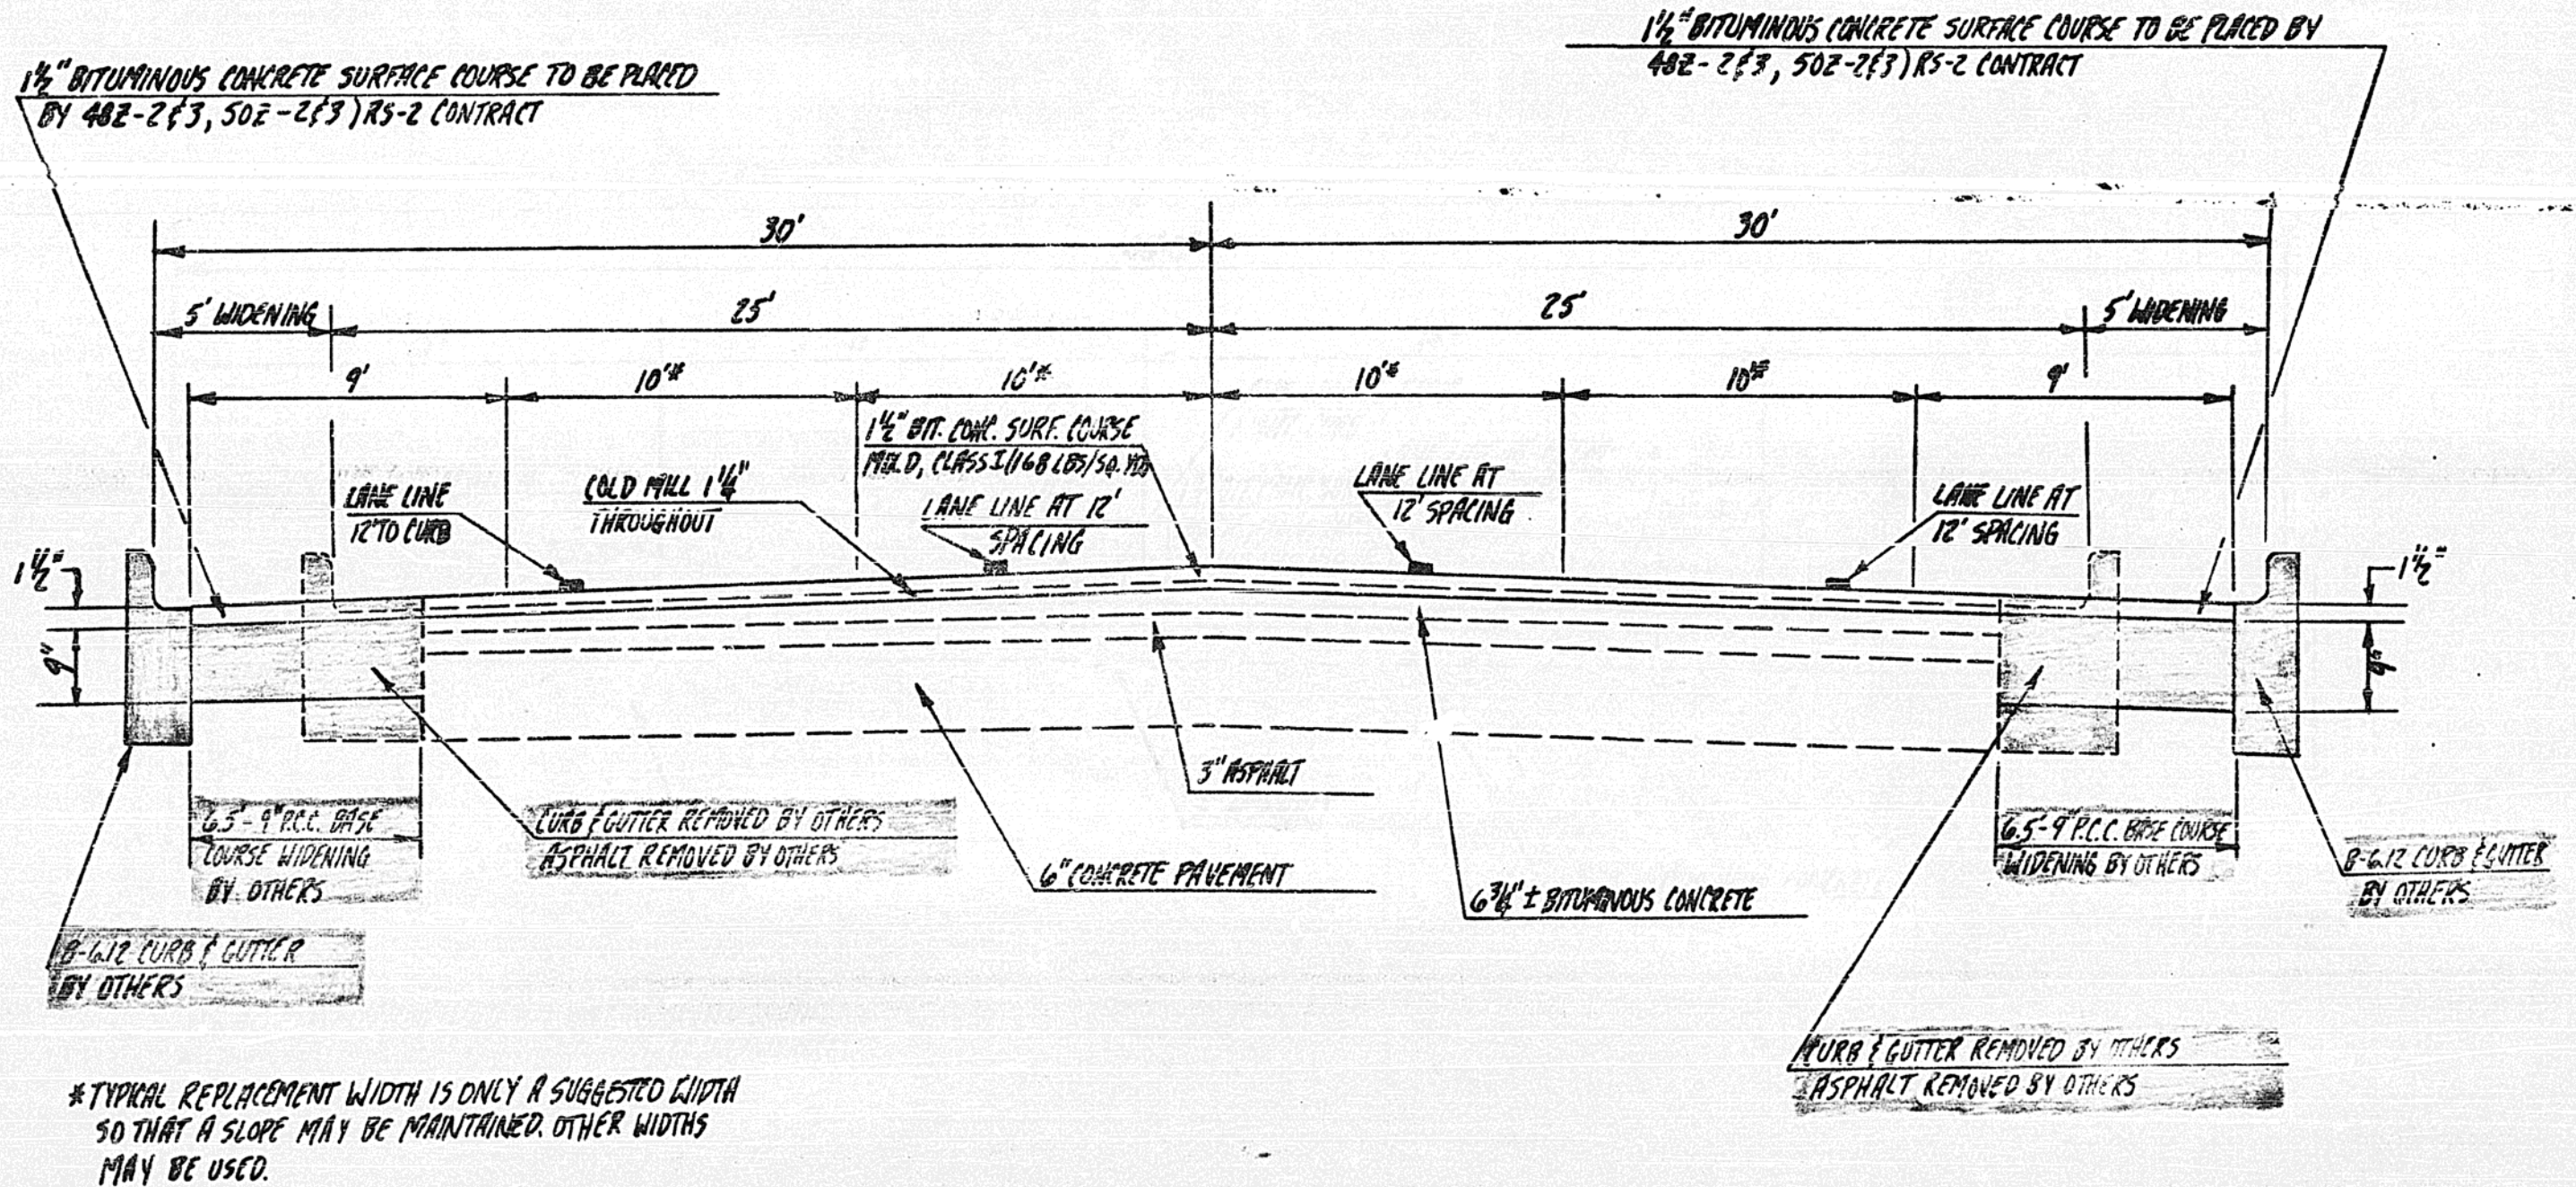


TYPICAL CROSS SECTION
 SOUTH OF GREEN ST. TO CERRO GORDO ST.
 STA. 229+71 TO 235+92
 F.A.P. ROUTE 710 (U.S. 51 SOUTHBOUND)

4

ROUTE NO	SECTION	COUNTY	TOTAL SHEETS	SHEET NO
F.A.P. 710 741	*	MACON & PIATT	38	5

* F.A.P. 710 - (482-253, 502-253) RS-2
 F.A.P. 741 - 11RS-1, (10-12) RS-2

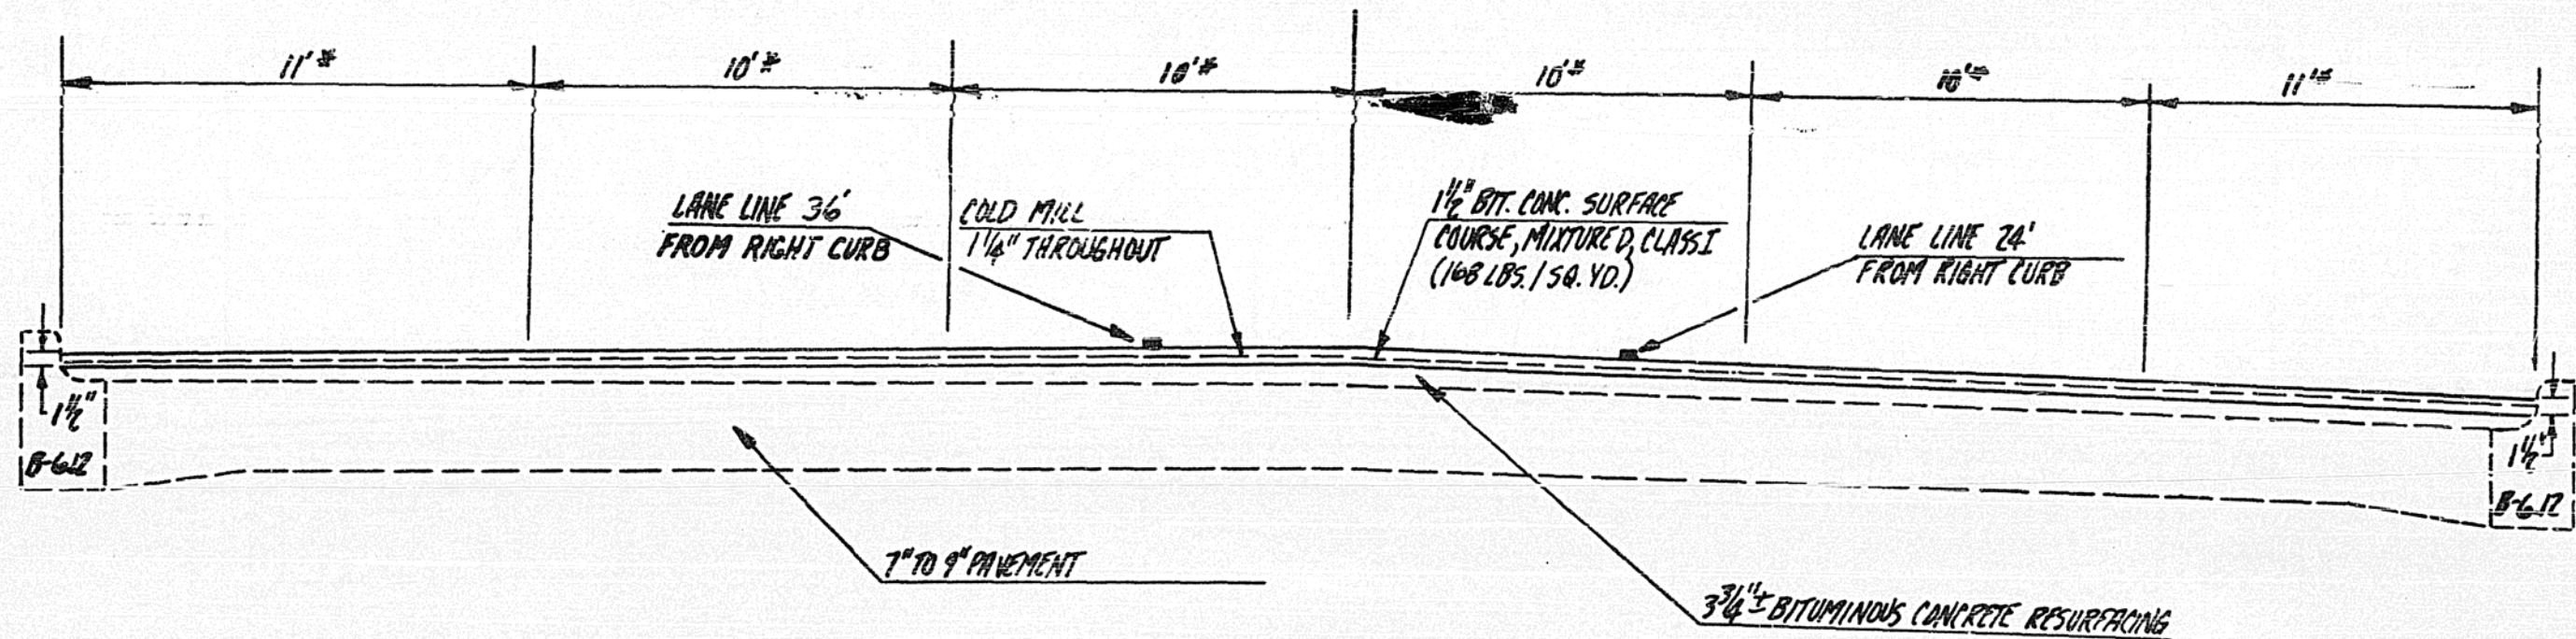

*TYPICAL REPLACEMENT WIDTH IS ONLY SUGGESTED WIDTH
 SO THAT A SLOPE MAY BE MAINTAINED.
 OTHER WIDTHS MAY BE USED.

WIDTH THROUGH SUBWAY IS 41'
 STATION 231+49 ~ 232+56


DESIGNED BY	
CHECKED BY	

TYPICAL CROSS SECTION
 GREEN ST. TO SOUTH OF GRAND
 STA. 235+92 TO STA. 257+28.09
 F.A.P. ROUTE 710 (U.S. 51 SOUTHBOUND)

5

ROUTE NO.	SECTION	COUNTY	TOTAL SHEETS	SHEET NO.
F.A.P. 710 & 741	*	MARION & PIATT	38	6

* F.A.P. 710 - (482-2(3), 502-2(3) RS-2
 F.A.P. 741 - 11RS4 (10, 12) RS-2

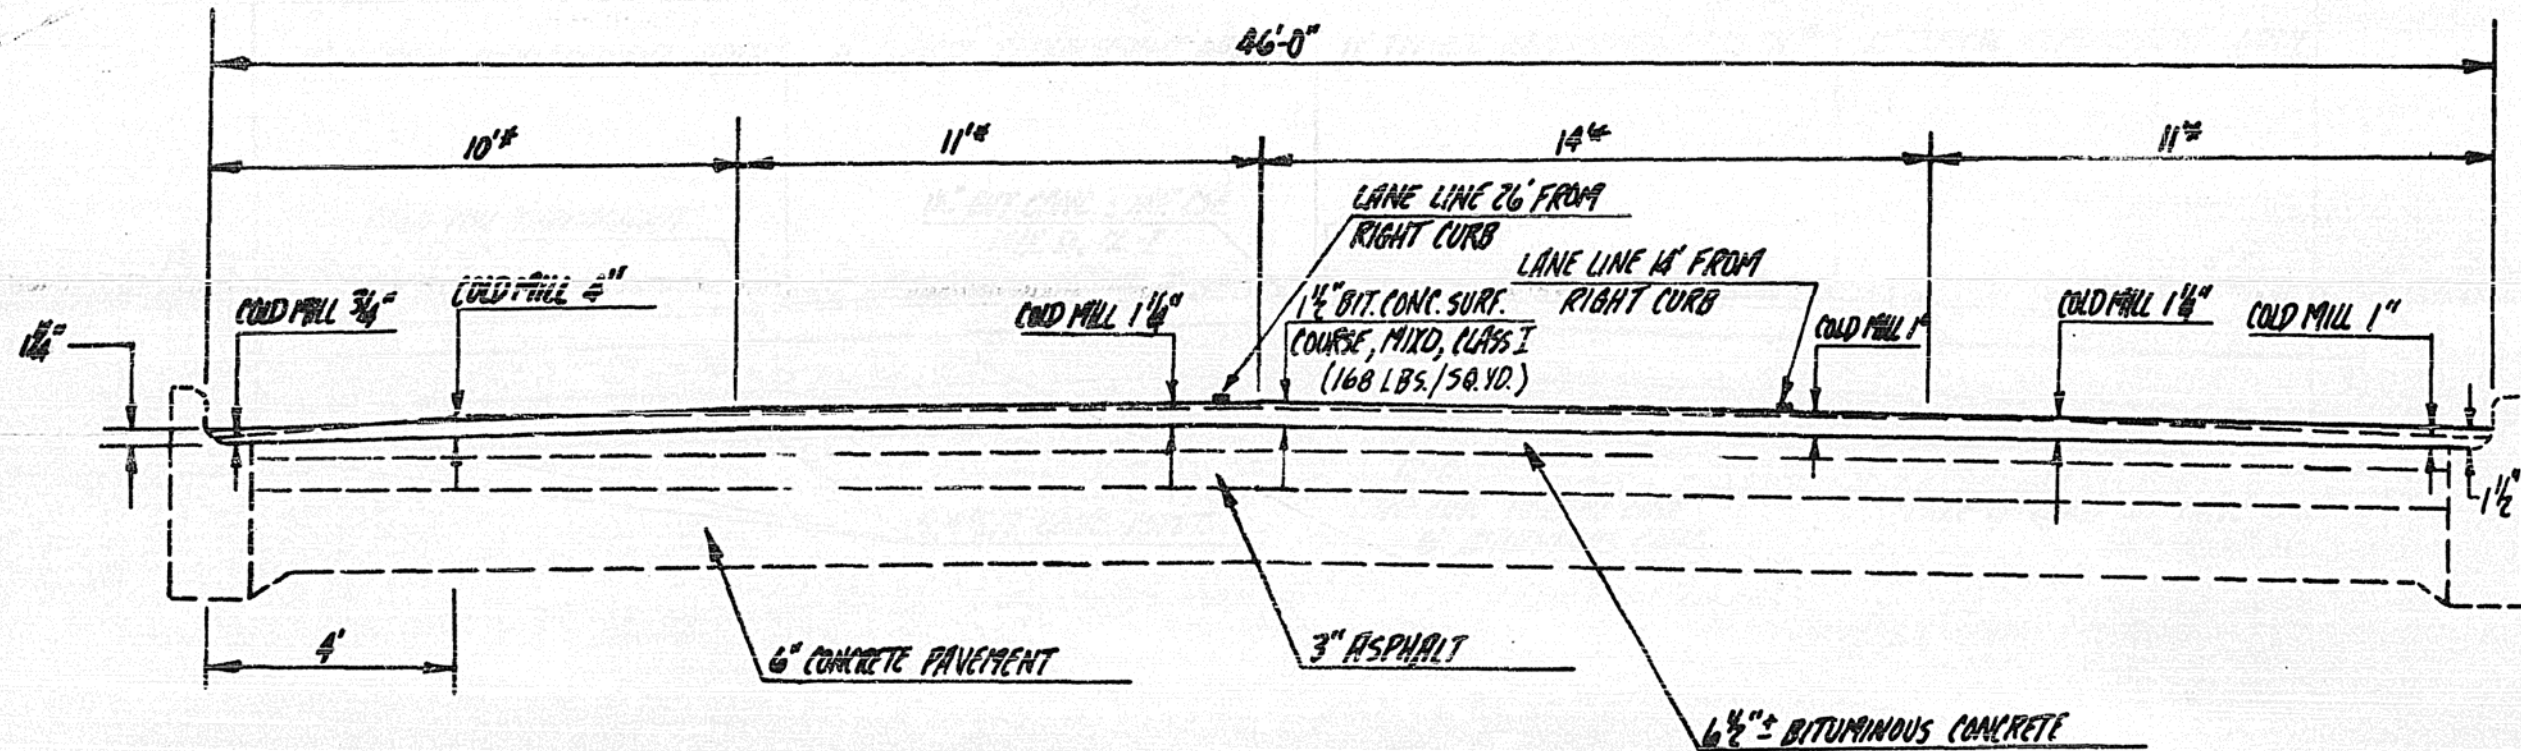


* TYPICAL REPLACEMENT WIDTH IS ONLY SUGGESTED WIDTHS
 SO THAT A SLOPE MAY BE MAINTAINED. OTHER WIDTHS MAY
 BE USED.

TYPICAL CROSS SECTION
 SOUTH OF GRAND TO SOUTH OF I.C.G. RAILROAD
 STA. 26476.28 TO 262+63 & STA. 265+90 TO 269+97.10
 STA. 300+00 TO 315+09
 E.A.P. ROUTE 710 (U.S. 51 SOUTHBOUND)

6

ROUTE NO.	SECTION	COUNTY	TOTAL SHEETS	SHEET NO.
F.A.P. 710 & 741	*	MACON & PIATT	38	7

(STATION EQUATION: 269+97.10 = 30000)
 * F.A.P. 710 - (482-2(3, 502-2(3) RS-2
 F.A.P. 741 - 11 RS-1, (10, 12) RS-2

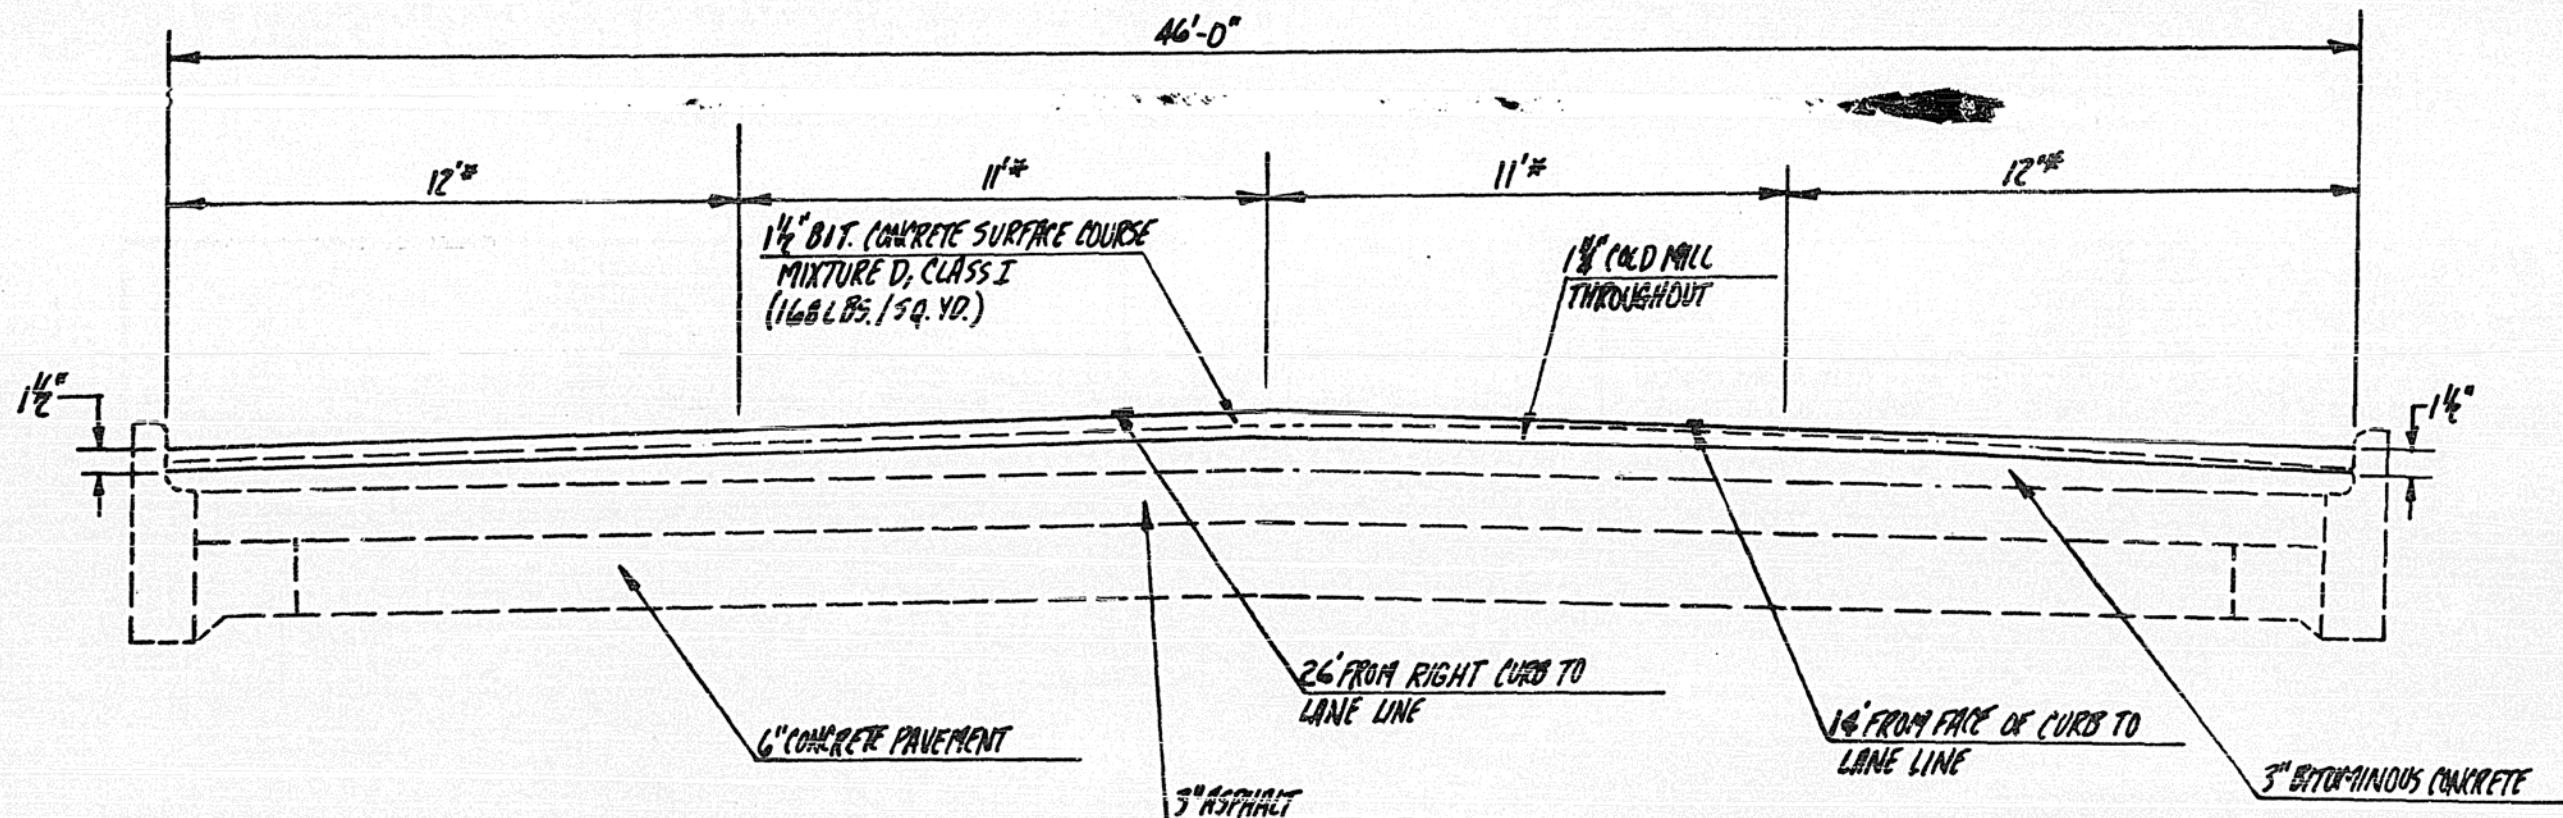


*TYPICAL REPLACEMENT WIDTH IS ONLY SUGGESTED WIDTH
 SO THAT A SLOPE MAY BE MAINTAINED
 OTHER WIDTHS MAY BE USED.

TYPICAL CROSS SECTION
GRAND AVE. INTERSECTION (NORTH)
STR 262+63 TO STR 265+90
F.A.P. ROUTE 710 (U.S. 51 SOUTHBOUND)

7

ROUTE NO	SECTION	COUNTY	TOTAL SHEETS	SHEET NO.
F.A.P. 710 § 741	*	MACON & PIATT	38	8

* F.A.P. 710 - (402-2(3), 502-2(3)) RS-2
 F.A.P. 741 - 11RS-1 (10, 12) RS-2

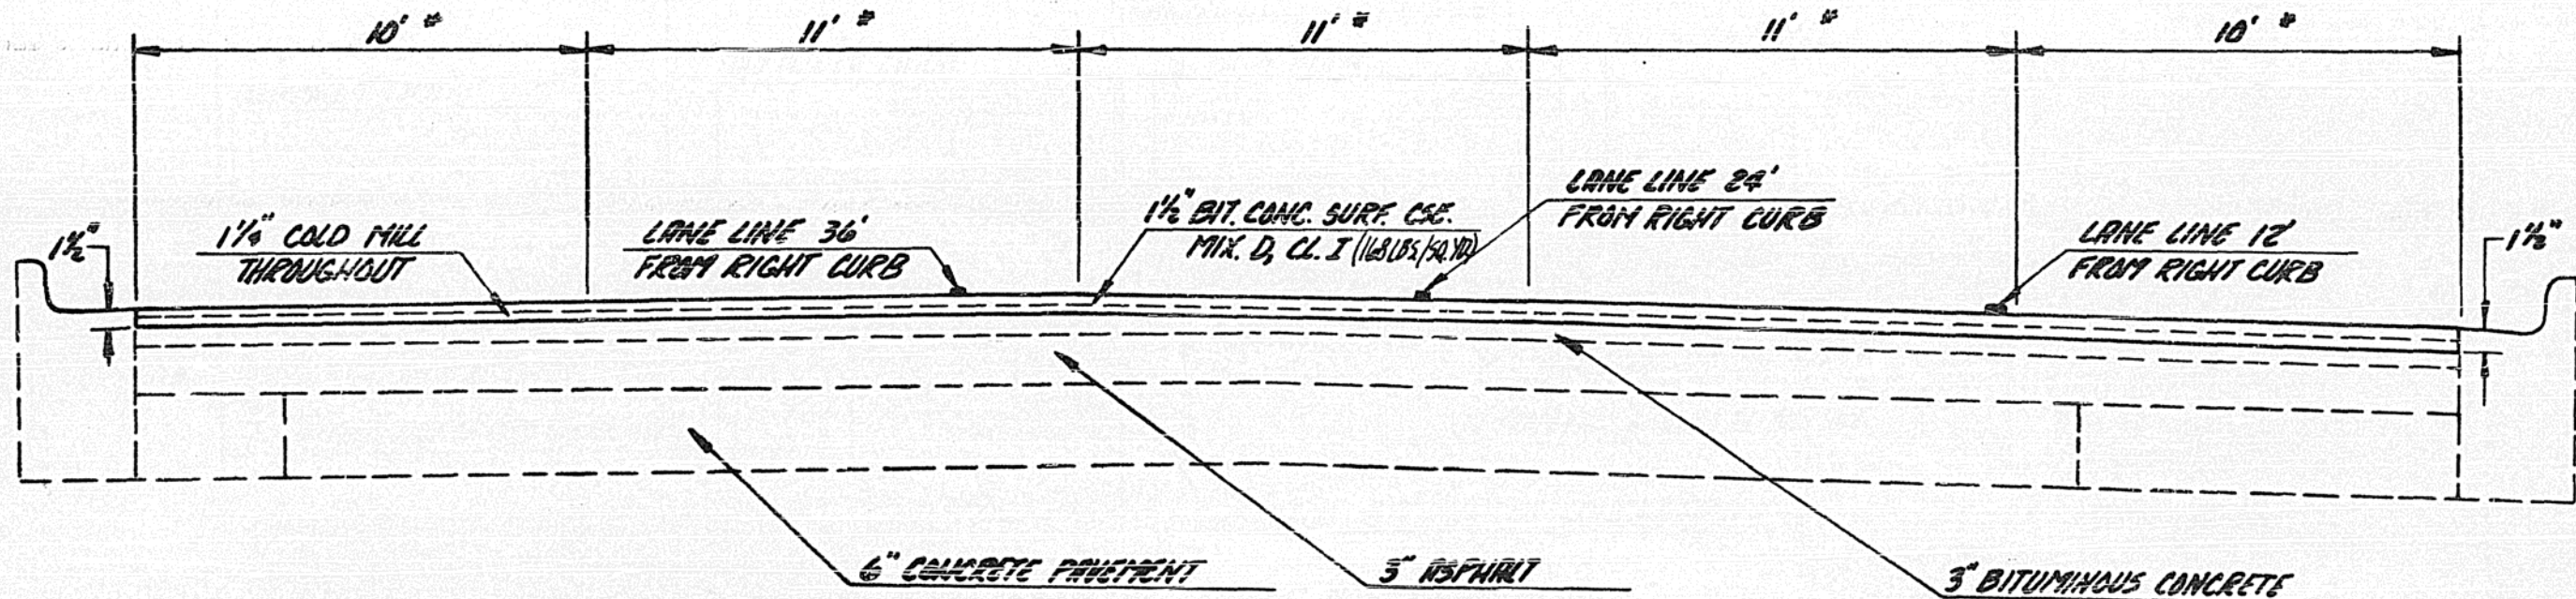

* TYPICAL REPLACEMENT WIDTH, IS ONLY SUGGESTED WIDTHS SO THAT A SLOPE MAY BE MAINTAINED. OTHER WIDTHS MAY BE USED.

TYPICAL CROSS SECTION

SOUTH OF ILL. CENTRAL GULF RAILROAD
TO GARFIELD AVE.


STA. 315+09 TO STA. 320+50

8

ROUTE NO.	SECTION	COUNTY	TOTAL SHEETS	SHEET NO.
S. D. I. #	*	MACON & PRATT	38	9
P. A. #	*			

* F.A.P. ROUTE 710 SEC. (462-2(3), 502-2(3)) RS-2

* F.A.P. ROUTE 741 SEC. 11 RS-1 (10, 12) RS-2

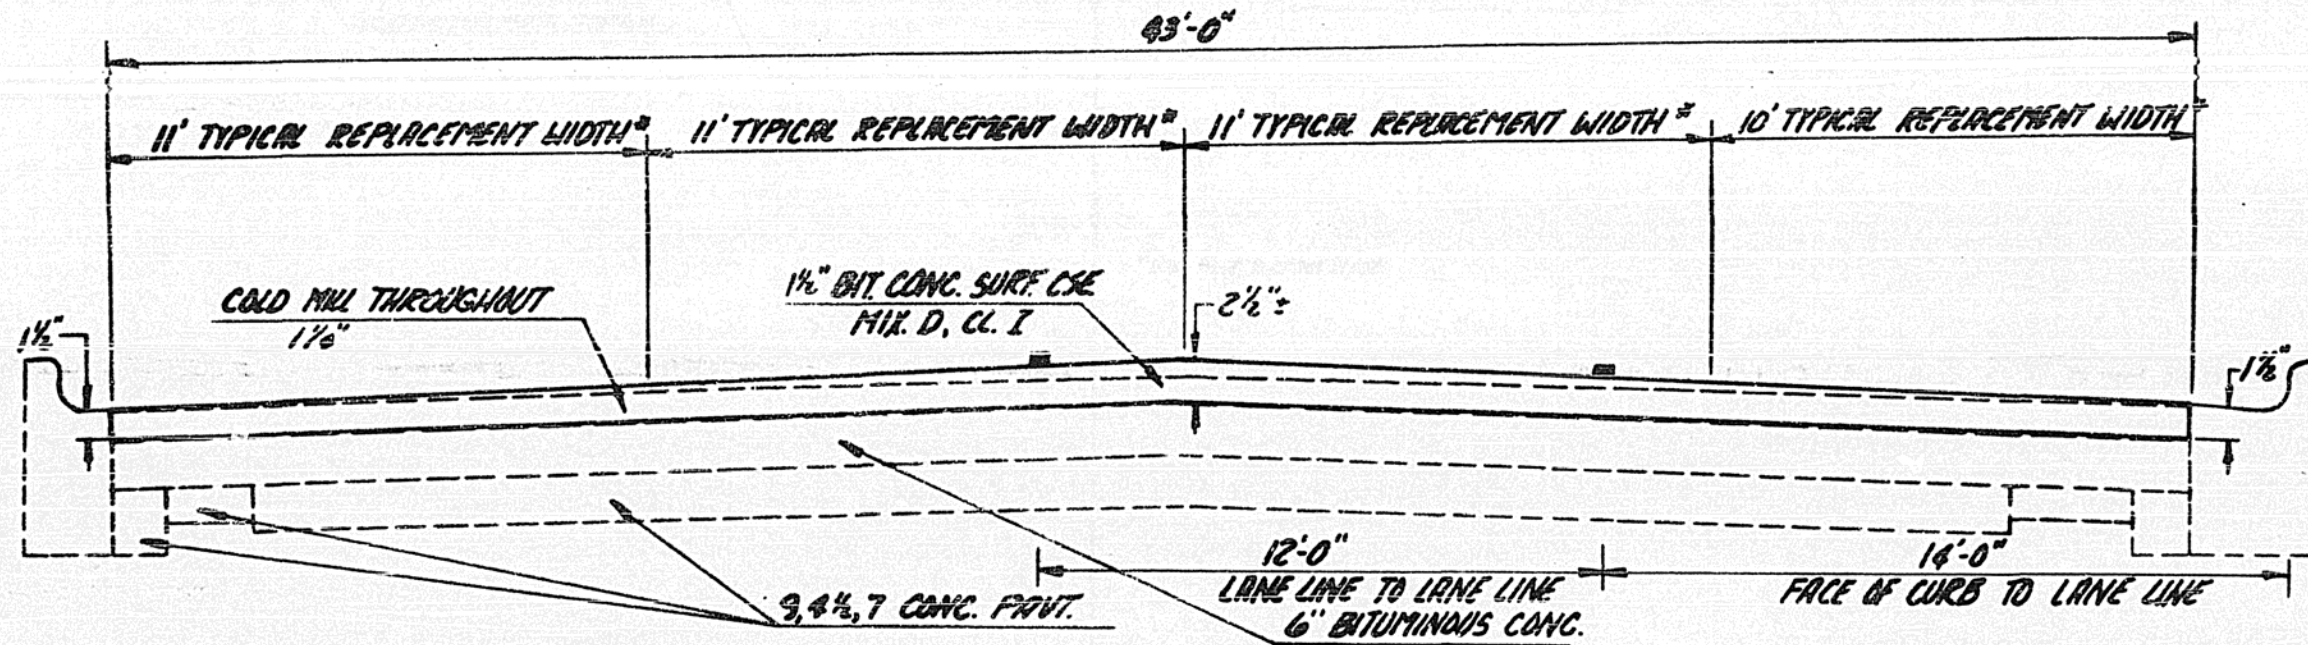


* TYPICAL REPLACEMENT WIDTH IS ONLY SUGGESTED
WIDTHS SO THAT A SLOPE MAY BE MAINTAINED.
OTHER WIDTHS MAY BE USED.

TYPICAL CROSS SECTION
 NORTH OF GARFIELD AVE. TO NORTH OF DAMON ST.
 STA. 320+50 TO STA. 358+25
 F.A.R. ROUTE 710 (U.S. 51 SOUTHBOUND)

9

ROUTE NO	SECTION	COUNTY	TOTAL SHEETS	SHEET NO
FAR 710 & 741	#	MACON / PIATT	38	10

* FAR 710 - (482-2(3), 502-2(3) RS-2
 FAR 741 - 11 RS-1, (10, 12) RS-2

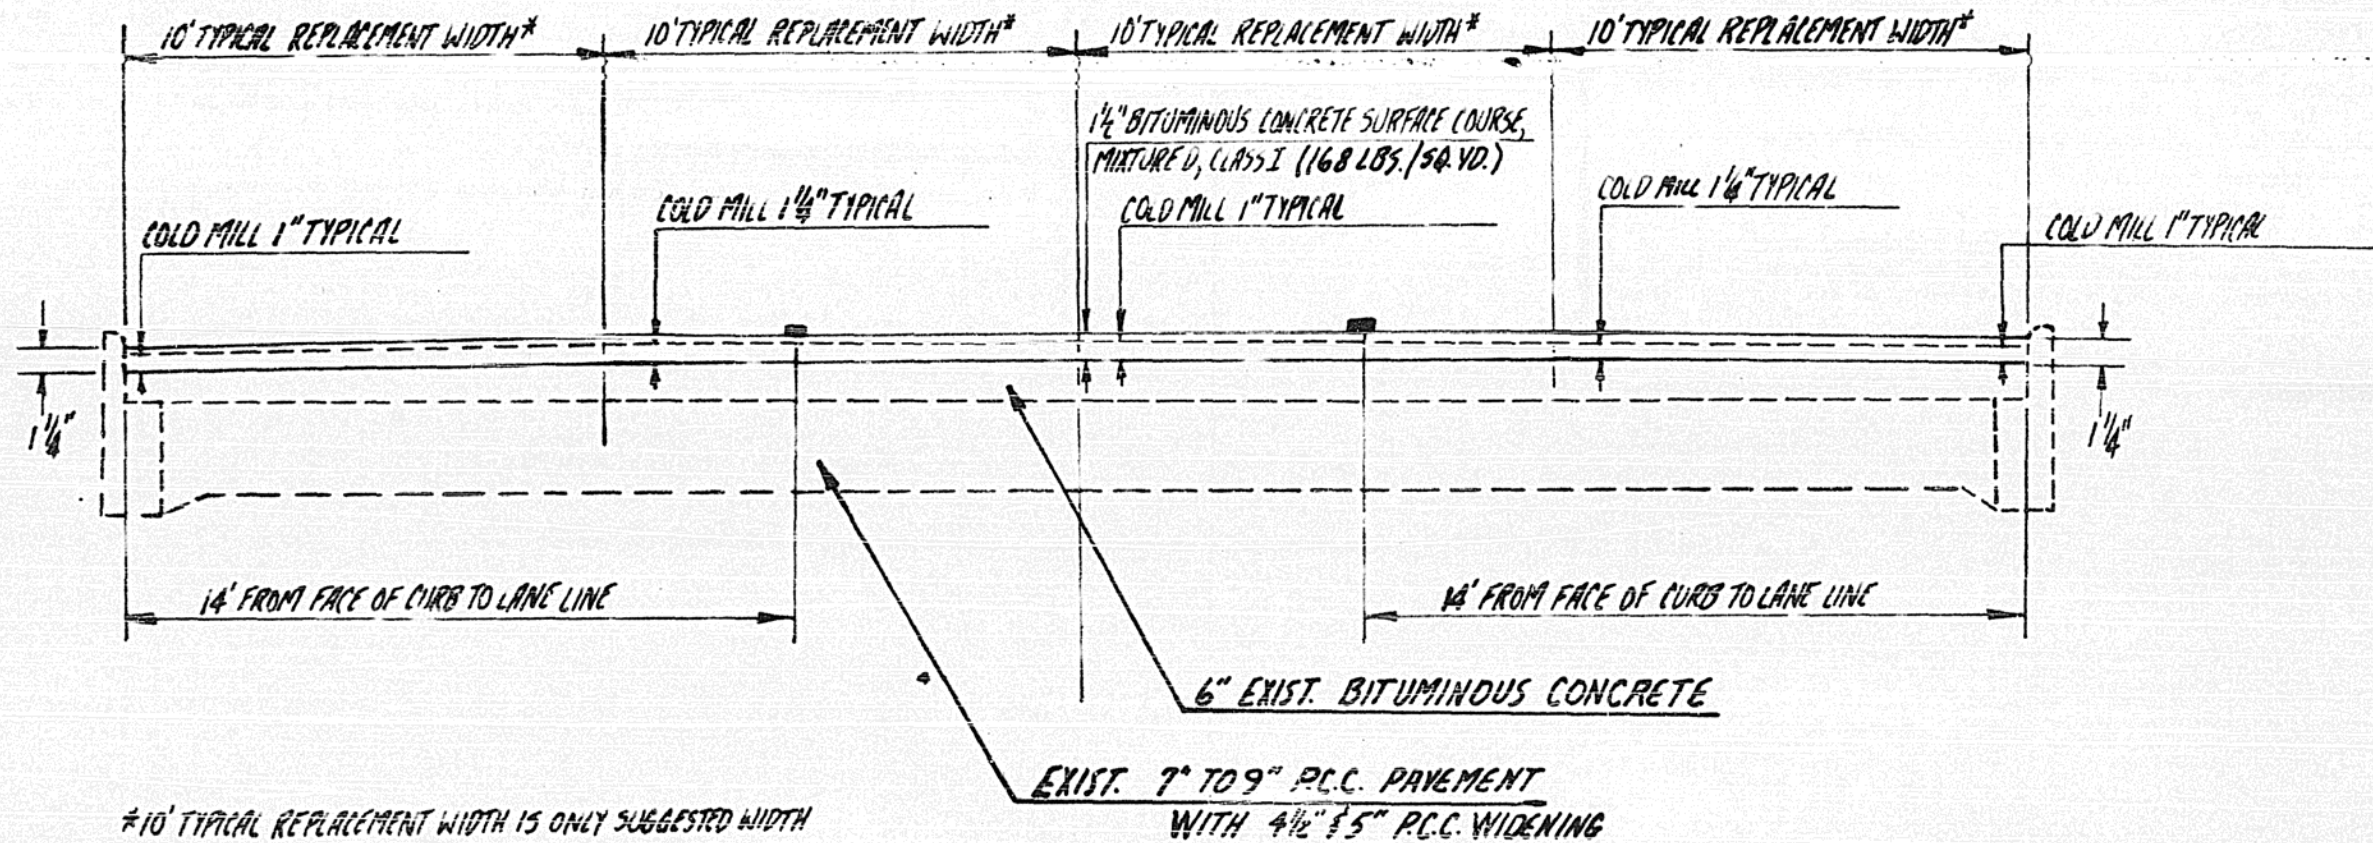


*10' TYPICAL REPLACEMENT WIDTH IS ONLY SUGGESTED WIDTH SO THAT A SLOPE MAY BE MAINTAINED. OTHER WIDTH MAY BE USED.

DESIGNED
CHECKED

TYPICAL CROSS SECTION FOR F.A.P. ROUTE 741

STA. 163+53 TO STA. 171+15
 STA. 171+15 TO STA. 182+19
 STA. 182+19 TO STA. 303+00
 STA. 303+00 TO STA. 335+00
 STA. 335+00 TO STA. 410+00

1

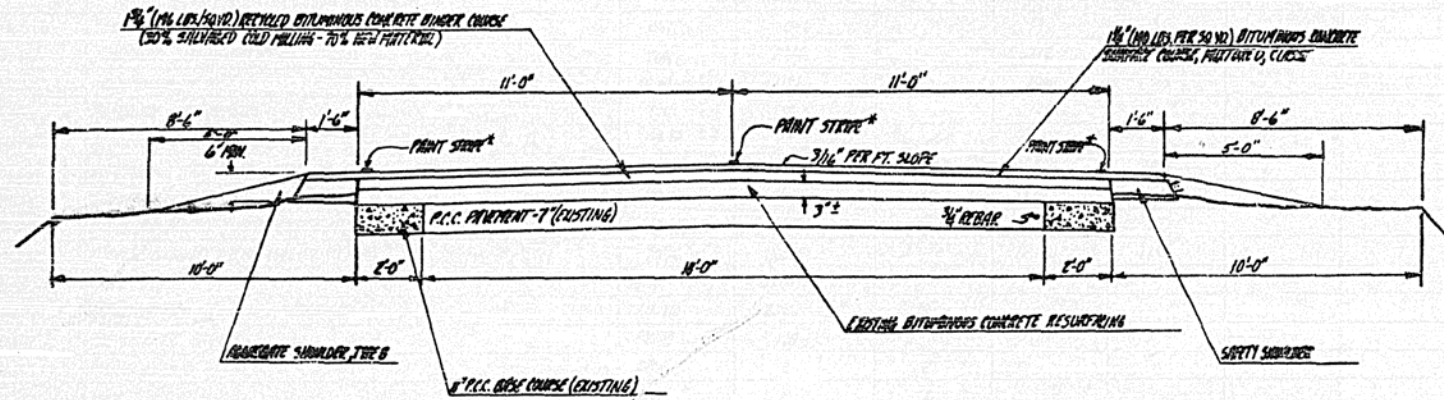


*PRINT STRIPS TO BE DONE BY OTHERS

TYPICAL CROSS SECTION FOR F.A.P. ROUTE 741

STA. 171+15 TO STA. 171+76
 STA. 171+76 TO STA. 182+19

2

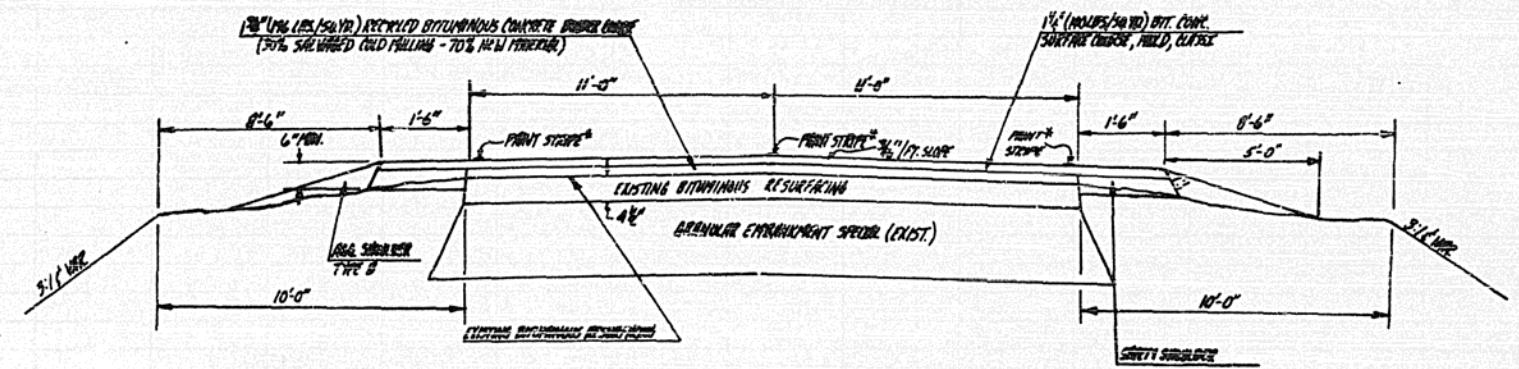

*PRINT STRIPS TO BE DONE BY OTHERS


ROUTE NO.	SECTION	COUNTY	TOTAL SHEETS	SHEET NO.
F.A.P. 741	#	PARSON & PATTY	38	11

* F.A.P. 741 - (402-243, 502-243) RS-2
 F.A.P. 741 - (129-1, 129-2) RS-2

TYPICAL CROSS SECTION FOR F.A.P. ROUTE 741

STA. 182+19 TO STA. 201+00
 STA. 201+00 TO STA. 317+00
 STA. 317+00 TO STA. 401+00
 STA. 401+00 TO STA. 530+91.65

3

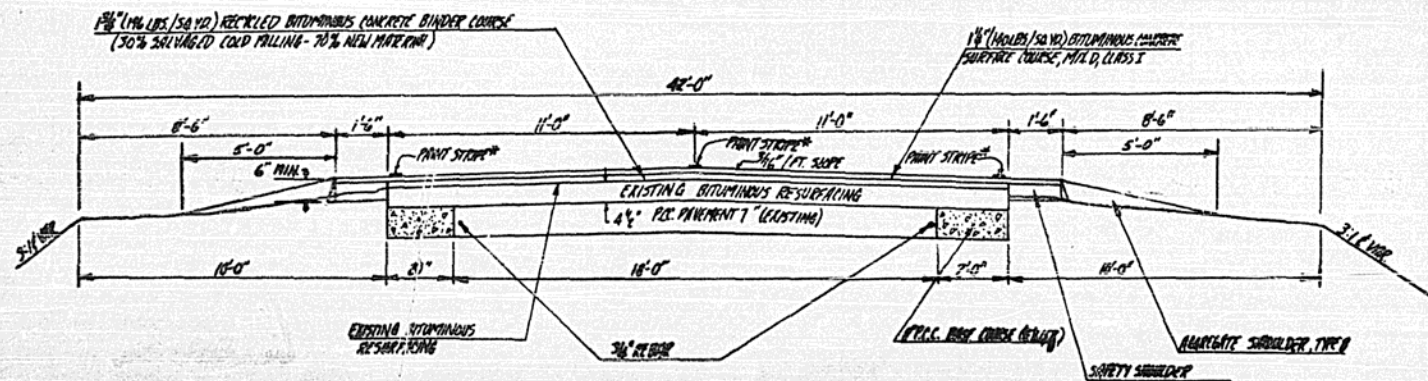


*PRINT STRIPS TO BE DONE BY OTHERS

TYPICAL CROSS SECTION FOR F.A.P. ROUTE 741

STA. 335+00 TO STA. 349+13.88 (BRIDGE)
 STA. 349+13.88 TO STA. 362+64

4

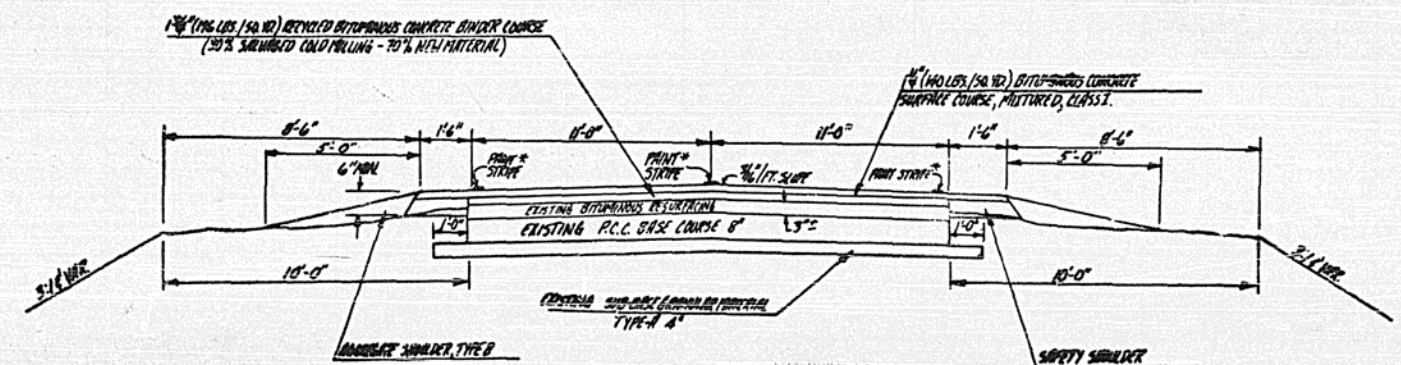

*PRINT STRIPS TO BE DONE BY OTHERS

ROUTE NO.	SECTION	COUNTY	TOTAL SHEETS	SHEET NO.
710	**	MACON & PIATT		

*FAP 710 ** (48Z-2&3, 50Z-2&3) RS-2
FAP 741 11RS-1, (10, 12) RS-2

GENERAL NOTES

PAVEMENT MARKING TAPE SHALL BE APPLIED TO THE BITUMINOUS MATERIALS (PRIME COAT) AND EACH SUBSEQUENT LIFT OF BITUMINOUS CONCRETE. RESURFACING TO DELINEATE THE CENTERLINE ON F.A.P. ROUTE 741 (1509 LIN. FT. YELLOW MARKING TAPE) AS DIRECTED BY THE ENGINEER. PAVEMENT MARKING TAPE SHALL BE APPLIED AFTER COLD-MILLING AND RESURFACING ON F.A.P. ROUTE 710 TO DELINEATE LANE LINES. DOUBLE YELLOW SKIP DASH MARKING SHALL BE USED TO MARK THE CENTER LINE OF ELDERADO STREET. ALSO THE ISLAND ON ELDERADO SHALL BE MARKED WITH YELLOW MARKING TAPE (1.094 LIN. FT. WHITE AND 224 LIN. FT. YELLOW MARKING TAPE).

ESTIMATED QUANTITIES:

2,827 LIN. FT. PAVEMENT MARKING TAPE

THE EXCAVATION RESULTING FROM COMBINATION CURB AND GUTTER REMOVAL AT OAKLEY ROAD SHALL BE FILLED WITH AGGREGATE, CONFORMING TO THE SPECIFICATIONS OF SHOULDER STONE. THE STONE WILL BE PAID FOR AT THE CONTRACT UNIT PRICE PER TON OF AGGREGATE SHOULDERS, TYPE B.

QUANTITIES HAVE BEEN INCLUDED IN THE PLANS FOR 22 MAILBOX TURNOUTS ON F.A.P. ROUTE 741. THE ACTUAL NUMBER OF MAILBOX TURNOUTS WILL BE DETERMINED BY THE ENGINEER.

ESTIMATED QUANTITIES:

165	GALLONS	BITUMINOUS MATERIAL (PRIME COAT)
112	TONS	BITUMINOUS BINDER SPECIAL (HOT MIX RECYCLING)
50	TONS	BITUMINOUS CONCRETE SURFACE COURSE, MIXTURE D, CLASS I

THE CROWN SLOPE OF THE FINISHED GRADE ON F.A.P. ROUTE 710 SHALL BE SIMILAR TO THE EXISTING CROWN TO MAINTAIN SUITABLE CROSS DRAINAGE.

AT THE LIMITS OF COLD MILLING ON SIDE STREETS ON F.A.P. ROUTE 710, A SAW CUT SHALL BE MADE OR A SMALL MILLING MACHINE SHALL BE USED TRANSVERSELY TO INSURE THAT A NEAT BUTT JOINT WILL BE MADE WITH THE EXISTING AND PROPOSED SURFACES.

THERE IS A TOTAL OF 31 PRIVATE AND COMMERCIAL ENTRANCES - 1,516 SQ. YDS., 52 FIELD ENTRANCES - 870 SQ. YDS., 13 SIDE ROADS - 2,373 SQ. YDS. ON FAP ROUTE 741.

ESTIMATED QUANTITIES:

1,665	GALLONS	BITUMINOUS MATERIALS (PRIME COAT)
432	TONS	BITUMINOUS BINDER SPECIAL (HOT MIX RECYCLING)
500	TONS	BITUMINOUS CONCRETE SURFACE COURSE, MIXTURE D, CLASS I

THE QUANTITY OF BITUMINOUS CONCRETE RESURFACING ON THE MAINLINE OF FAP 741 (ILL. ROUTE 105) IS APPROXIMATELY 103,311 SQ. YDS.

ESTIMATED QUANTITIES:

9,445	GALLONS	BITUMINOUS MATERIALS (PRIME COAT)
13,351	TONS	BITUMINOUS BINDER SPECIAL (HOT MIX RECYCLING)
7,609	TONS	BITUMINOUS CONCRETE SURFACE COURSE, MIXTURE D, CLASS I

THE QUANTITY OF COLD MILLING TO BE DONE ON THE MAINLINE OF FAP ROUTE 710 (U.S. 51 SOUTHBOUND) IS 62,636 SQ. YDS. COLD MILLING ON ELDERADO STREET 2,951 SQ. YDS. ON ALL OTHER SIDE STREETS 3,418 SQ. YD.

ESTIMATED QUANTITY:

69,005 SQ. YD. COLD-MILLING

QUANTITIES HAVE BEEN INCLUDED TO MARK PARKING DELINEATION LINES WITH THERMOPLASTIC PAVEMENT MARKING-LINE 4" AND PAINT PAVEMENT MARKING-LINE 4" ON F.A.P. ROUTE 710. FOR ACTUAL LAYOUT OF PARKING DELINEATION, CONSULT THE CITY ENGINEER. PARKING AREAS SHALL BE MARKED FROM MACON STREET TO GREEN STREET.

NOTE: DRIVEWAYS ON THE EAST SIDE OF RTE. 51 FROM GRAND ST. TO NORTH ST. RECEIVED A PARTIAL OVERLAY TO ELIMINATE STANDING WATER CAUSED BY THE ADDITION OF 1 1/2" OF SURFACE COURSE @ E.O.P..

REPLACED EXISTING STORM SEWER AT THE SUBWAY ON RTE. 51 FROM THE MANHOLE ON E TO THE RT. EDGE OF PAVEMENT. (15" CLASS IV R.C.C.P. STORM SEWER USED)

STATE OF ILLINOIS
DEPARTMENT OF TRANSPORTATION
DISTRICT FIVE

REVIEWED BY: *A. H. Mattar*
DISTRICT ENGINEER OF DESIGN
DATE: 7/17/79
EXAMINED BY: *Charles P. Patton*
DISTRICT ENGINEER OF CONST.
Donald J. Johnson
DISTRICT ENGINEER OF MAINT.
J. D. Benson
DISTRICT ENGINEER OF PLANNING
R. E. Engelhardt
DISTRICT ENGINEER OF TRAFFIC

ROUTE NO.	SECTION	COUNTY	TOTAL SHEETS	SHEET NO.
710	**	MACON & PIATT	38	12

*FAP 710- ** (48Z-2&3, 50Z-2&3) RS-2
FAP 741 - 11RS-1, (10, 12) RS-2

INDEX OF SHEETS

SHEET NO.	ITEM
1	COVER SHEET
2 -10.	TYPICAL CROSS SECTIONS FOR FAP ROUTE 710
11.	TYPICAL CROSS SECTIONS FOR FAP ROUTE 741
12.	INDEX OF SHEETS AND GENERAL NOTES
13.-14	SUMMARY OF QUANTITIES
15.	CITY MAP SHOWING COLD MILLING LIMITS
16 -19	PLANS FOR FAP ROUTE 710 (US 51 SOUTHBOUND)
20 -23.	PLANS FOR FAP ROUTE 741 (ILL. ROUTE 105)
24.	DETAIL OF BRIDGE REPAIR FAP ROUTE 741
25.	SIGNAL LAYOUT AND CABLE DIAGRAM AT WOOD STREET AND GRAND AVE
26.	DETAIL OF SHOULDER DETOUR FOR BRIDGE DECK REPAIR
27.	DETAIL OF SIDEROADS TO BE RECONSTRUCTED
28.	DETAIL OF ENTRANCES
29	DETAIL OF DEPRESSED CURB
30.	DETAIL OF ADJUSTMENT RINGS FOR C-11 FRAMES & GRATES
31.-33.	DETAIL OF THERMOPLASTIC PAVEMENT MARKINGS AT ELDERADO AND FAP 710 INTERSECTION
34.	DETAIL OF TYPICAL APPLICATION OF THERMOPLASTIC PAVEMENT MARKING
35.	TRAFFIC CONTROL AND PROTECTION, STANDARD 2306 (SPECIAL)
36	TRAFFIC CONTROL AND PROTECTION SPECIAL FOR FAP ROUTE 710
37	TRAFFIC CONTROL AND PROTECTION SPECIAL FOR MINOR SIDE STREETS
38.	TRAFFIC CONTROL AND PROTECTION, SPECIAL FOR MAJOR SIDE STREETS

THE FOLLOWING STANDARDS ARE A PART OF THESE PLANS AND ARE INCLUDED AFTER SHEET NO. 38

STANDARD NO.	DESCRIPTION
2116-2	P.C.C. PATCHING DETAILS
2117-1	BITUMINOUS PATCHING DETAILS
2171	BATTERY TURNOUT
2230-1B	STEEL PLATE BEAM GUARD RAIL
2239-6	WIDENING AND SHOULDERS FOR PAVEMENT RESURFACING
2268-4	TYPICAL APPLICATION OF TRAFFIC CONTROL DEVICES
2269-7	DESIGN OF TRAFFIC CONTROL DEVICES
2300-1	FLAGMAN TRAFFIC CONTROL SIGN
2301-3	TYPICAL APPLICATION OF TRAFFIC CONTROL DEVICES
2302-3	TYPICAL APPLICATION OF TRAFFIC CONTROL DEVICES
2303-4	TYPICAL APPLICATION OF TRAFFIC CONTROL DEVICES
2304-4	TYPICAL APPLICATION OF TRAFFIC CONTROL DEVICES
2305-3	TYPICAL APPLICATION OF TRAFFIC CONTROL DEVICES
2307-4	TYPICAL APPLICATION OF TRAFFIC CONTROL DEVICES
2309-3	TYPICAL APPLICATION OF TRAFFIC CONTROL DEVICES
2312-5	TYPICAL APPLICATION OF TRAFFIC CONTROL DEVICES
2326-2	TRAFFIC BARRIER TERMINAL TYPE 10
2336-1	TRAFFIC BARRIER TERMINAL TYPE 1 AND 1A
2371	DETAILS FOR MOUNTING TRAFFIC SIGNALS
2374	DETAILS OF STEEL MAST ARM ASSEMBLY AND POLE
2378	DETAILS OF CONCRETE FOUNDATIONS
2381	EROSION CONTROL

SUMMARY OF QUANTITIES

ROUTE NO.	SECTION	COUNTY	TOTAL QUANTITY	SHEET NO.
*** #	*	MICHIGAN	38	13

* F&P ROUTE 210 - SEC. (488-213, 502-213) RS-2
* F&P ROUTE 241 - SEC. 1185-1 (10, 11) RS-2

CODE NO.	ITEM	UNIT	TOTAL QUANTITY	STA. 200+09.40 TO STA. 258+62 (MARION CO.) URBAN	STA. 163+53 TO STA. 284+00 (MARION CO.) RURAL	STA. 484+00 TO STA. 571+56.65 (PIRTT CO.) RURAL	STA. 200+09.40 TO STA. 358+62 (MARION CO.) URBAN	STA. 163+53 TO STA. 284+00 (MARION CO.) RURAL	STA. 484+00 TO STA. 571+56.65 (PIRTT CO.) RURAL	STA. 200+09.40 TO STA. 358+62 (MARION CO.) URBAN	CONSTRUCTION TYPE CODE											
				6706	6706	6706	6706	6706	6706	1031												
202006	EXCAVATING AND GRADING EXISTING SHOULDER	UNIT	-691-734		596	95																
215412	AGGREGATE SHOULDER, TYPE B	TON	-5810-6409		5112	698																
307001	PREPARATION OF BASE	SQ. YD.	-3141-2755		3046	145																
307002	AGGREGATE BASE REPAIR	TON	-135-0		129	6																
402007	AGGREGATE SURFACE COURSE, TYPE A 8"	SQ. YD.	-44-43		44																	
406001	BITUMINOUS MATERIALS (PRIME COAT)	EMULSION	-15,520 12,742	7,245	9,920	1,355																
406003	AGGREGATE (PRIME COAT)	TON	-345-220	145	176	28																
406013	BITUMINOUS CONCRETE SURFACE COURSE, MIXTURE D, CLASS I	TON	-1445-13,567	608	7180	980																
X06769	BITUMINOUS SANDER SPECIAL (HOT MIX RECKUNG)	TON	0		12,160	1735																
X06770	COLD MILL	SQ. YD.	69,005	69,005																		
X06771	TRANSPORT COLD MILL SURVED AGGREGATE	CU. YD.	2396	2396																		
602001	VALVE BOXES 6"	EA	-110 162		170																	
602494	VALVE BOXES 12"	EA	-2-7	2																		
602497	VALVE BOXES 12"	EA	-2-0	2																		
602503	MANHOLES TO BE ADJUSTED	EA	-10-9	10																		
602666	VALVE BOXES TO BE ADJUSTED	EA	-20-10	20																		
603001	FRAMES AND GATES TO BE ADJUSTED	EA	-18-11	18																		
607005	COMBINATION CURB (BUTTER REMOVAL)	LIN. FT.	-141-133		141																	
607010	BITUMINOUS CONCRETE SURFACE REMOVAL	SQ. YD.	-44-147		147																	
607022	CURB REMOVAL / REPLACEMENT	LIN. FT.	-4-6		6																	
620010	PAVEMENT REMOVAL / REPLACEMENT, TYPE I	SQ. YD.	-10-5	10																		
620011	PAVEMENT REMOVAL / REPLACEMENT, TYPE II	SQ. YD.	-50-34	50																		
620012	PAVEMENT REMOVAL / REPLACEMENT, TYPE III	SQ. YD.	-200-179	200																		
620012	PAVEMENT REMOVAL / BITUMINOUS REPLACEMENT, TYPE I	SQ. YD.	-432-184		386	46																
620023	PAVEMENT REMOVAL / BITUMINOUS REPLACEMENT, TYPE II	SQ. YD.	-495-933		524	71																
620024	PAVEMENT REMOVAL / BITUMINOUS REPLACEMENT, TYPE III	SQ. YD.	-104-36		83	21																
646004	ENGINEERS FIELD OFFICE, TYPE A	CH. NO.	4	2	1.8	0.2																
647001	PAVEMENT MARKING TAPE	LIN. FT.	-2827 7736				1318	1328	181													
648004	TRAFFIC CONTROL / PROTECTION, STANDARD 2312	L. SUM	1		0.1	0.1																
648009	TRAFFIC CONTROL / PROTECTION, STANDARD 2301 (SPECIAL)	CH	1		1																	
648018	TRAFFIC CONTROL / PROTECTION (SPECIAL)	L. SUM	1	1																		
X62035	TRAFFIC BARRIER TERMINAL, TYPE 1A	CH	4		4																	
X62038	STEEL PLATE BEAM GUARD RAIL, TYPE B	LIN. FT.	100		100																	
X62038	TRAFFIC BARRIER TERMINAL, TYPE 10	CH	4		4																	
Z10167	CONCRETE CURB REPAIR	LIN. FT.	50 171	50																		
Z10180	DECK SLAB REPAIR (FULL DEPTH)	SQ. YD.	4 12		9																	
Z10181	DECK SLAB REPAIR (PARTIAL DEPTH)	SQ. YD.	40 17		40																	
Z10170	INTERSECTING PAVEMENT SYSTEM	SQ. YD.	163 167		163																	
T30101	THERMOPLASTIC PAVEMENT MARKING - LETTERS / SYMBOLS	SQ. FT.	-1084.2 1,364				1084.2															
T30102	THERMOPLASTIC PAVEMENT MARKING - LINE 4"	LIN. FT.	-9072-8490				9072															
T30104	THERMOPLASTIC PAVEMENT MARKING - LINE 6"	LIN. FT.	-2457.5 2150				2457.5															
T30106	THERMOPLASTIC PAVEMENT MARKING - LINE 12"	LIN. FT.	-709 360				709															
T30107	THERMOPLASTIC PAVEMENT MARKING - LINE 24"	LIN. FT.	-240 440				240															
T30201	PAINT PAVEMENT MARKING - LETTERS / SYMBOLS	SQ. FT.	-1084.2-0				1084.2															
T30202	PAINT PAVEMENT MARKING - LINE 4"	LIN. FT.	9072-992				9072															
T30204	PAINT PAVEMENT MARKING - LINE 6"	LIN. FT.	2457.5-0				2457.5															
T30206	PAINT PAVEMENT MARKING - LINE 12"	LIN. FT.	709-0				709															
T30207	PAINT PAVEMENT MARKING - LINE 24"	LIN. FT.	240-0				240															
T40053	SIGNAL HEAD, ALUMINUM, F&E, 3 SECTION, MAST ARM MOUNTED	EA	2				2															
T40301	TRAFFIC SIGNAL BACKPLATE	EA	2				2															
T40301	12-INCH SIGNAL ADAPTER	EA	11				11															
T40349	STEEL MAST ARM ASSEMBLY AND POLE, 30 FT	EA	2				2															
T42005	GALVANIZED STEEL CONDUIT IN TRENCH 2"	LIN. FT.	-28-29				28															
T42134	ELECTRIC CABLE IN CONDUIT NO. 12 SC	LIN. FT.	100-30				100															
T42204	CONCRETE FOUNDATION, TYPE E 30-INCH DIAMETER	LIN. FT.	16				16															
X04748	MOBILIZATION	L. SUM	1	0.5		0.5																

SUMMARY OF QUANTITIES

ROUTE NO.	SECTION	COUNTY	TOTAL SHEETS	SHEET NO.
710	2	MACON & PIATT	28	14

F.R.A. ROUTE 710 - SEC. 1402-2 (1, 502-2 (1) K1-2
F.R.A. ROUTE 711 - SEC. 1401-1, 10, 12) K5-2

CODE NO.	ITEM	UNIT	TOTAL QUANTITY	STA 200+09.40 TO STA 358+62 (MACON CO) URBAN	STA 143+53 TO STA 484+00 (MACON CO) RURAL	STA 484+00 TO STA 531+56.65 (PIATT CO) RURAL	STA 200+09.40 TO STA 358+62 (MACON CO) URBAN	STA 143+53 TO STA 484+00 (MACON CO) RURAL	STA 484+00 TO STA 531+56.65 (PIATT CO) RURAL	STA 200+09.40 TO STA 358+62 (MACON CO) URBAN	CONSTRUCTION TYPE CODE											
				6706	6706	6706	6706	6706	6706	Y031												
T42810	DRILL EXISTING HANDHOLE	EACH	2							2												
T43001	TRENCH AND BACKFILL	LIN FT	76 29							16												
T43901	MODIFY EXISTING CONTROLLER	EACH	1							1												
T44601	PULL AND REINSTALL ELECTRIC CABLE FROM CONDUIT	LIN FT	60 0							60												
617046	SIDEWALK REMOVAL AND REPLACEMENT	SQ FT	160 162							160												
X95390	BIT BIND SPEC (HOT MIX RECYCLE) W/REJUVENATION	TON	10,861		10,861																	
X95391	BIT BIND SPEC (HOT MIX RECYCLE) W/REJUVENATION	TON	782			782																
X95411	BIT BIND CSE (TYPE A)	TON	1,165		1,165																	
X95412	BIT BIND CSE (TYPE A)	TON	837			837																
X95410	LEVEL BINDER	TON	15	15																		
FR0005	POTHOLE & JT FILLING	DOL	9,017.00																			
FR0006	DRIVEWAY OVERLAY	DOL	3,108.09																			
FR0007	GUTTER RESHAPING	DOL	2,078.51																			
FR0008	STORM SEWER REPLACEMENT	DOL	1,088.78																			
FR0009	BIT CONC SURF REM	DOL	418.18																			
FR0010	WORK ZONE TRAFFIC CONTROL	DOL	4,563.77																			
FR0011	EMBANKMENT SPECIAL	DOL	1,959.88																			
FR0012	COLD MILLING	DOL	416.19																			
046916	SURFACE VARIATIONS	DOL	-212.45																			
* SPECIALTY ITEMS																						

POLYMER NO.	SECYCH	COUNTY	TOTAL INCHES	DEPTH FT.
681 P.A. #	#	ROCK & PLATT	38	15

SEC 402-275, SDE-213)RS-2
END WITHIN SUBYGE


LT RAILROAD OMIT PAYING
STM. 346+26.51 TO STM. 348+37.24

I.C.A. RAILROAD OMIT PAYING
STM. 315+94.41 TO STM. 315+40.03

STATION ELEVATION 269+97.10 BRK =
300+00.00 RCHRD

STATION ELEVATION 271+20.10 BRK =
261+70.21 RCHRD



SEC 402-275, SDE-213)RS-2
START STATION RD+10140

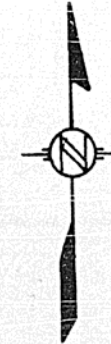

ROUTE NO.	SECTION	COUNTY	SHEET NO.	TOTAL SHEETS
710	16	PARSONS	30	16

PAR. 710 - SEC. (162-17), (162-18) RS-2
PAR. 710 - SEC. (162-19), (162-20) RS-2

NOTE: A CITY BEAUTIFICATION PROJECT HAS BEEN PERFORMED FROM WOOD ST. TO PRAIRIE ST. (NEW CURB & GUTTER, SIDEWALKS, ETC.).

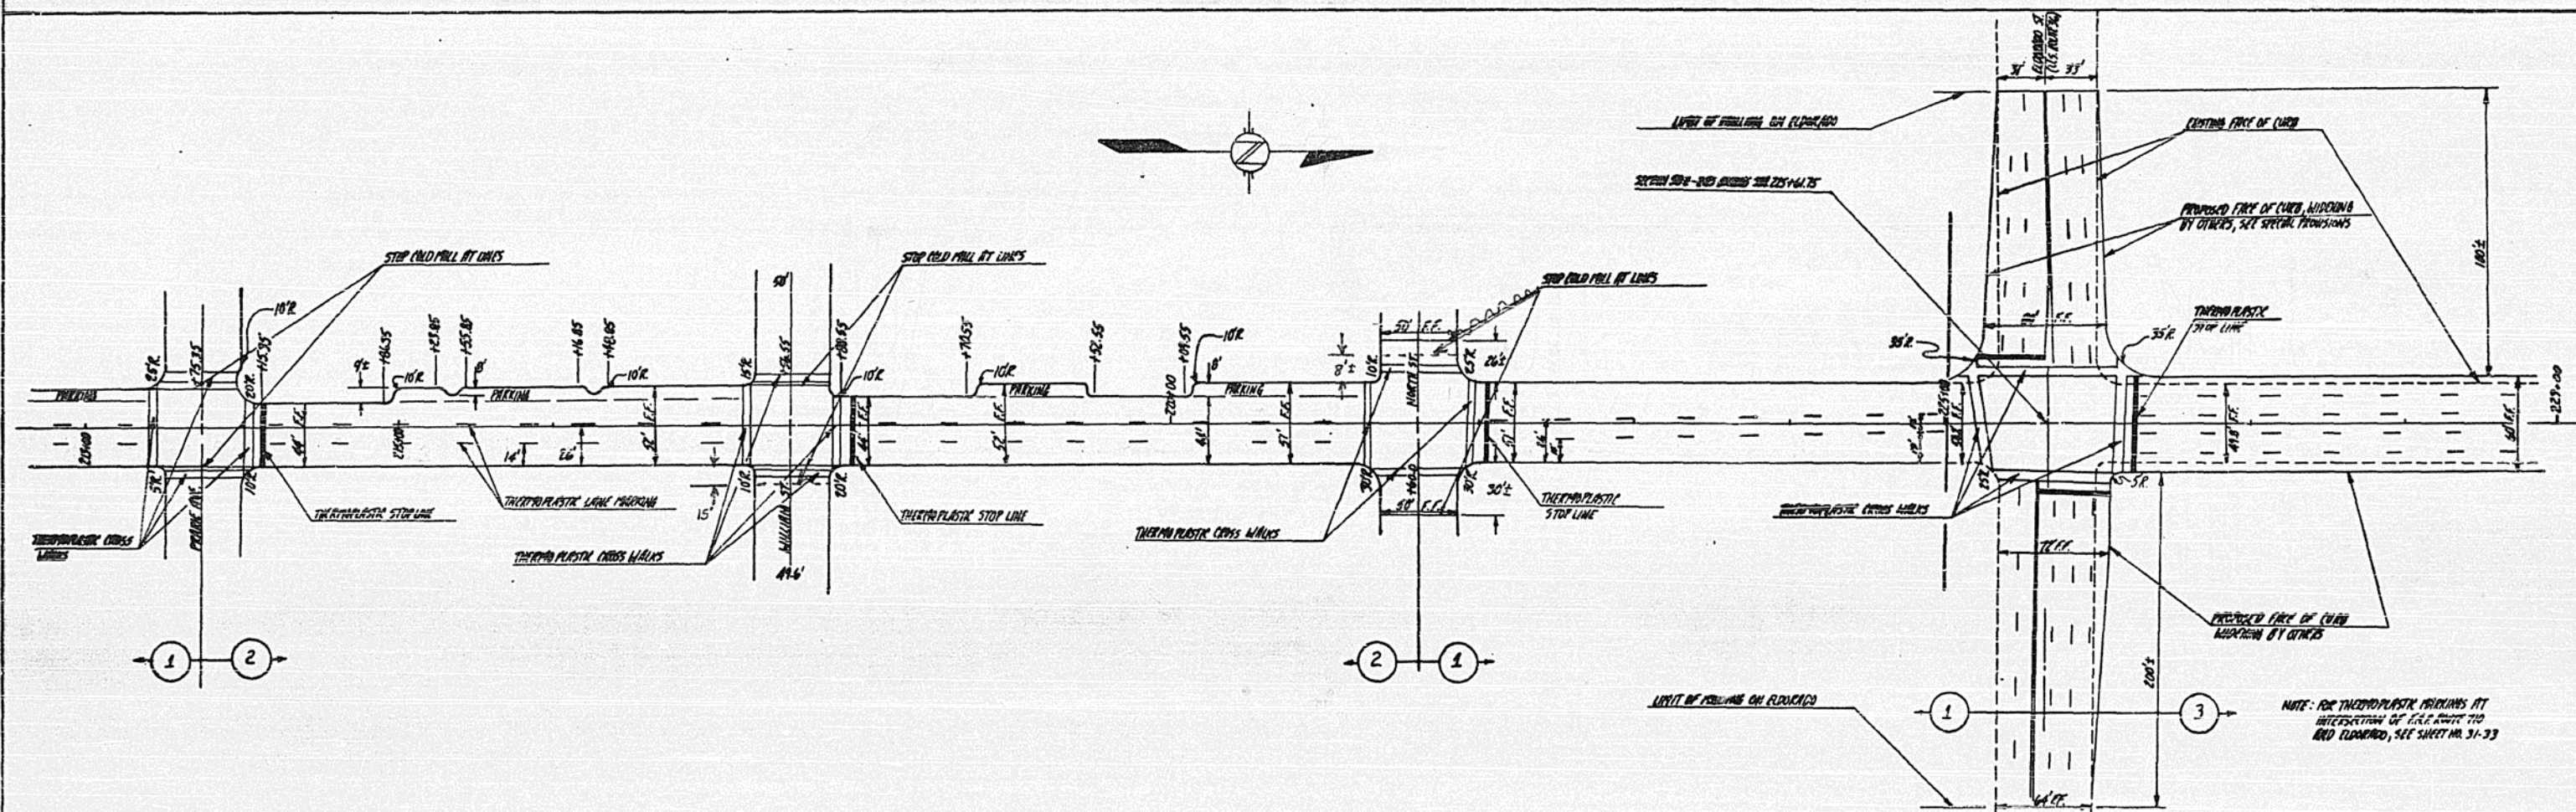
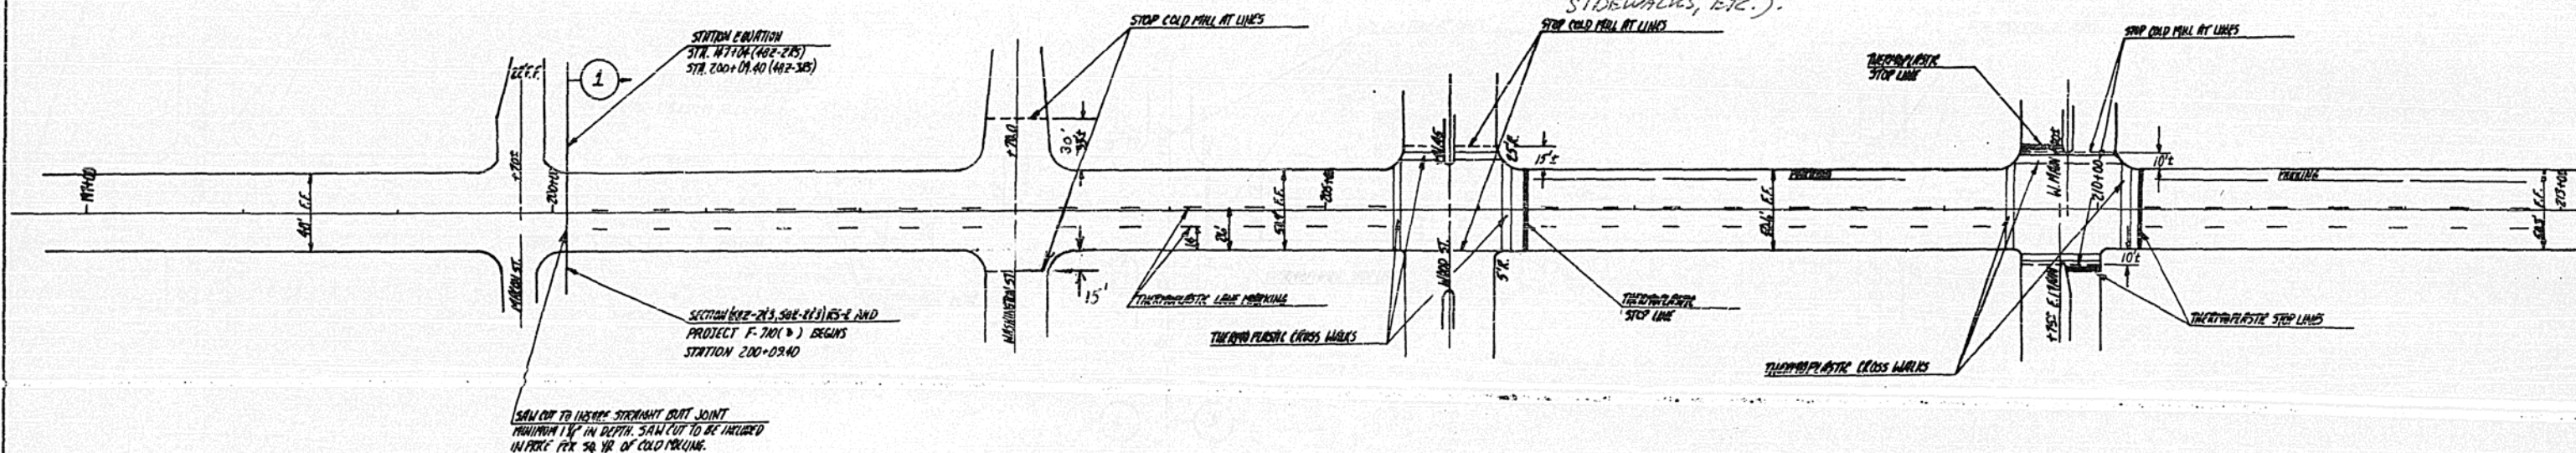


NOTE: FOR THERMOPLASTIC MARKINGS AT INTERSECTION OF PRAIRIE ST. AND FLOORING, SEE SHEET NO. 31-33

ROUTE NO.	SECTION	COUNTY	TOTAL SHEETS	SHEET NO.
1	1	MAHON & PIATT	238	17



* F.R.P. ROUTE 710 - SEC. (44E-21'S, 30E-21'S) R5-2
 * F.R.P. ROUTE 710 - SEC. (11E-1 (10,12), R5-2

EXP. ROUTE 710 (U.S. ST. SOUTHERLY)

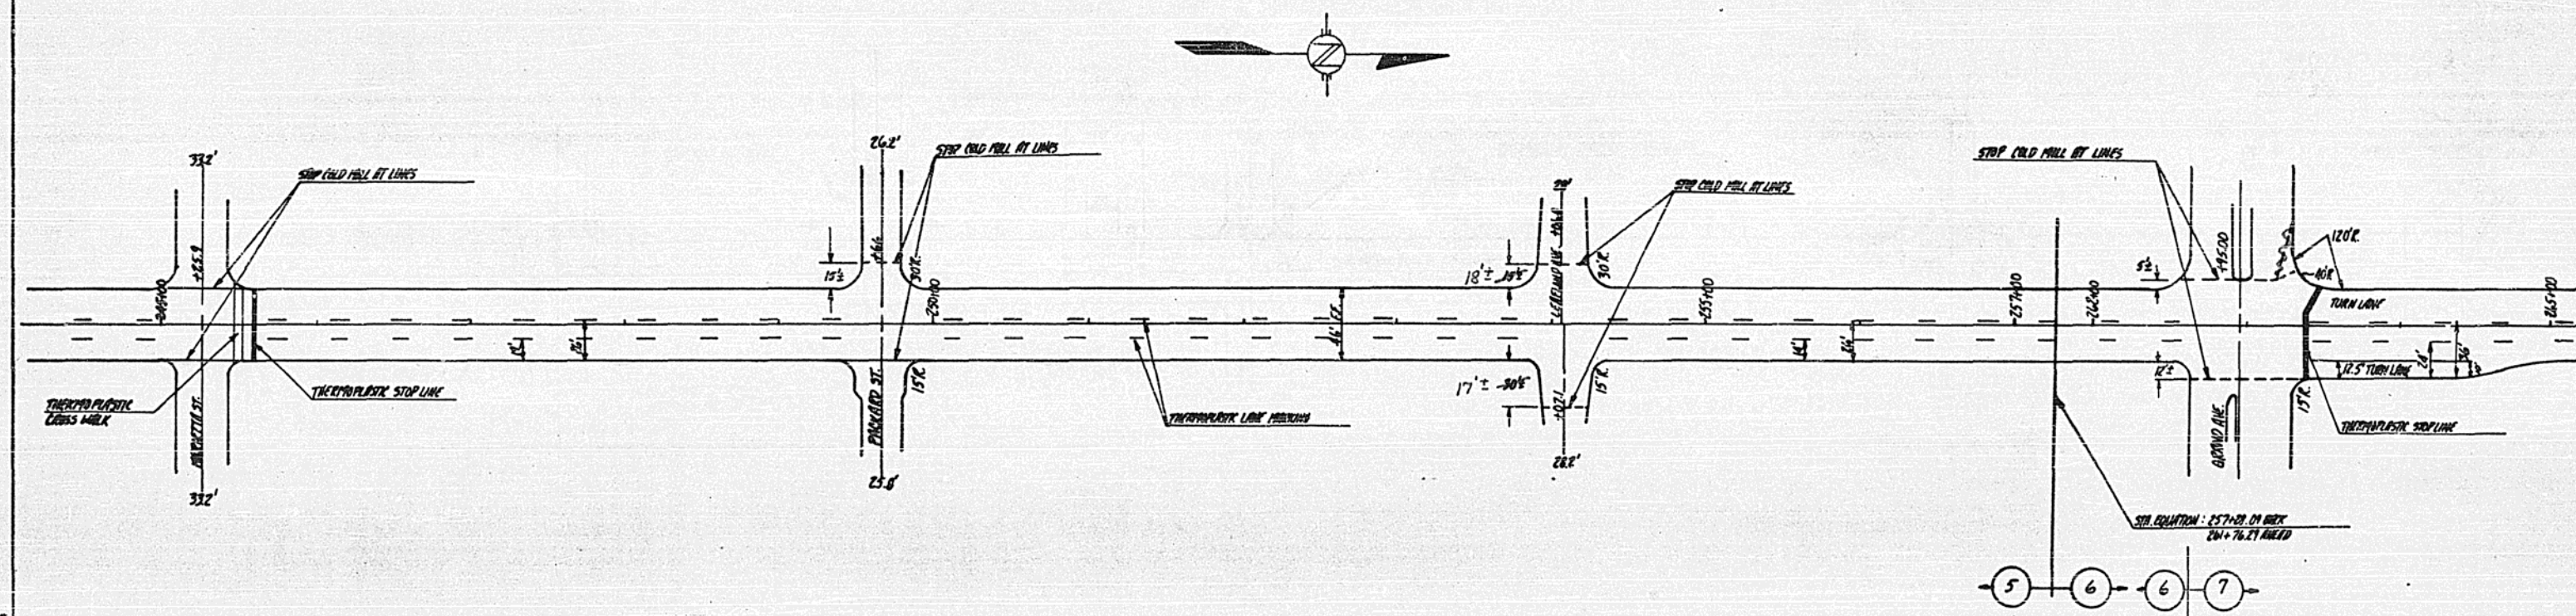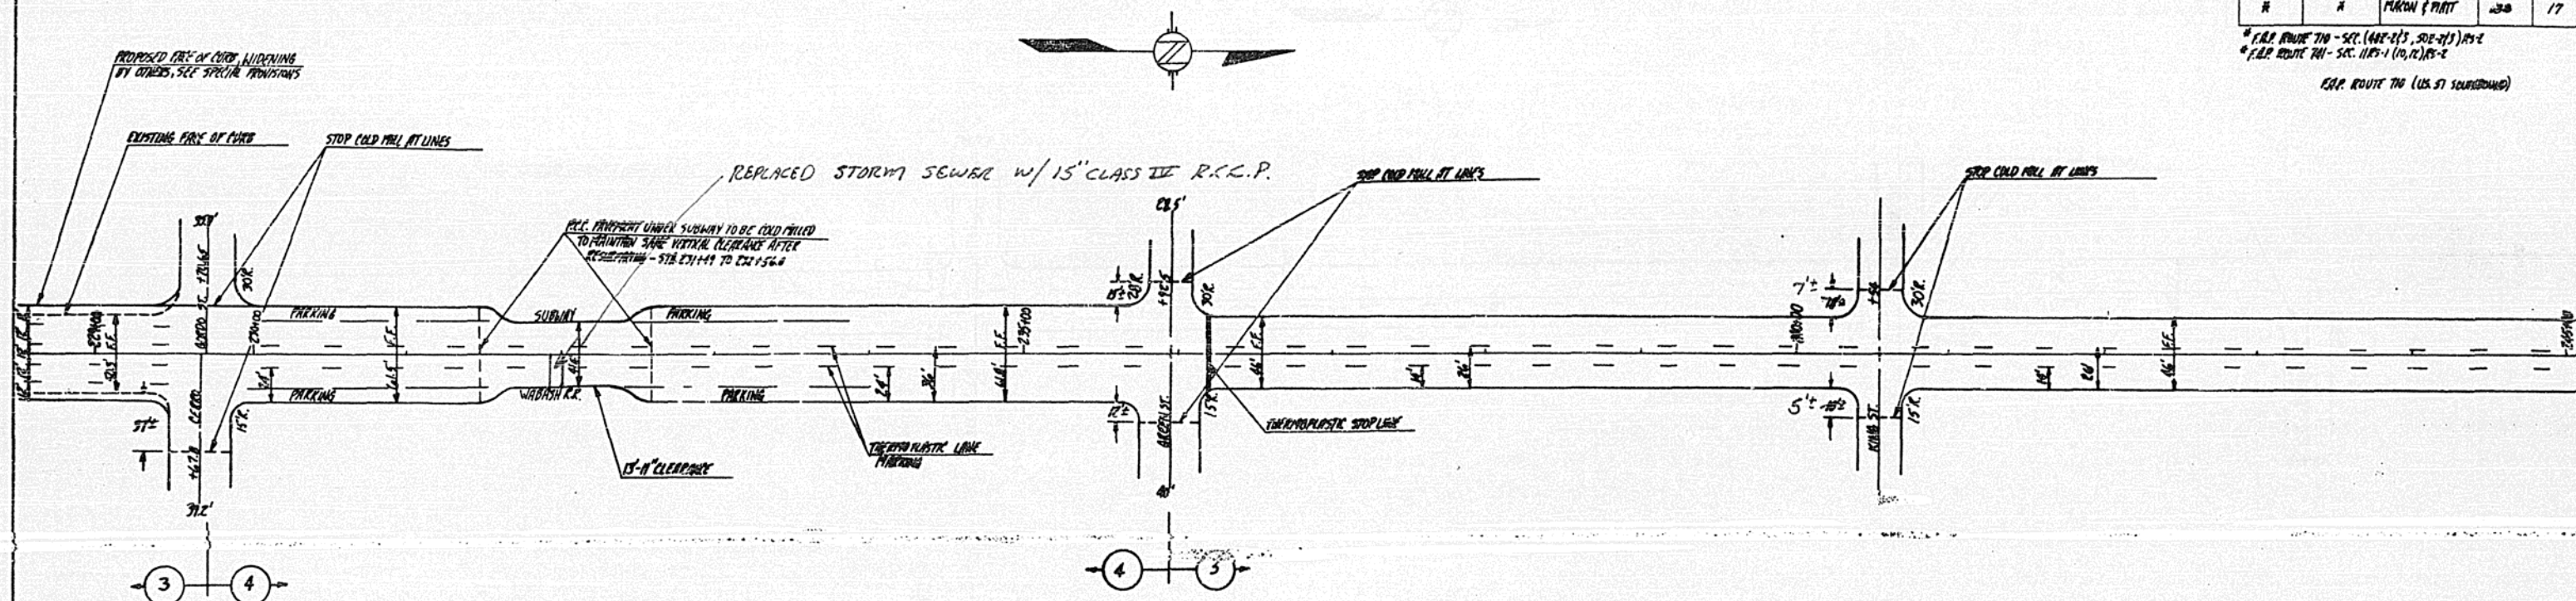

ROUTE NO.	SECTION	COUNTY	TOTAL SHEETS	SHEET NO.
74	2	PLATON & PART	25	15


F.A.R. ROUTE 74 - SEC. 102-2(1), 102-2(3) RS-2
 F.A.R. ROUTE 74 - SEC. 102-1, (10,12) RS-2
 F.A.R. ROUTE 74 (U.S. 51 SOUTHBOUND)

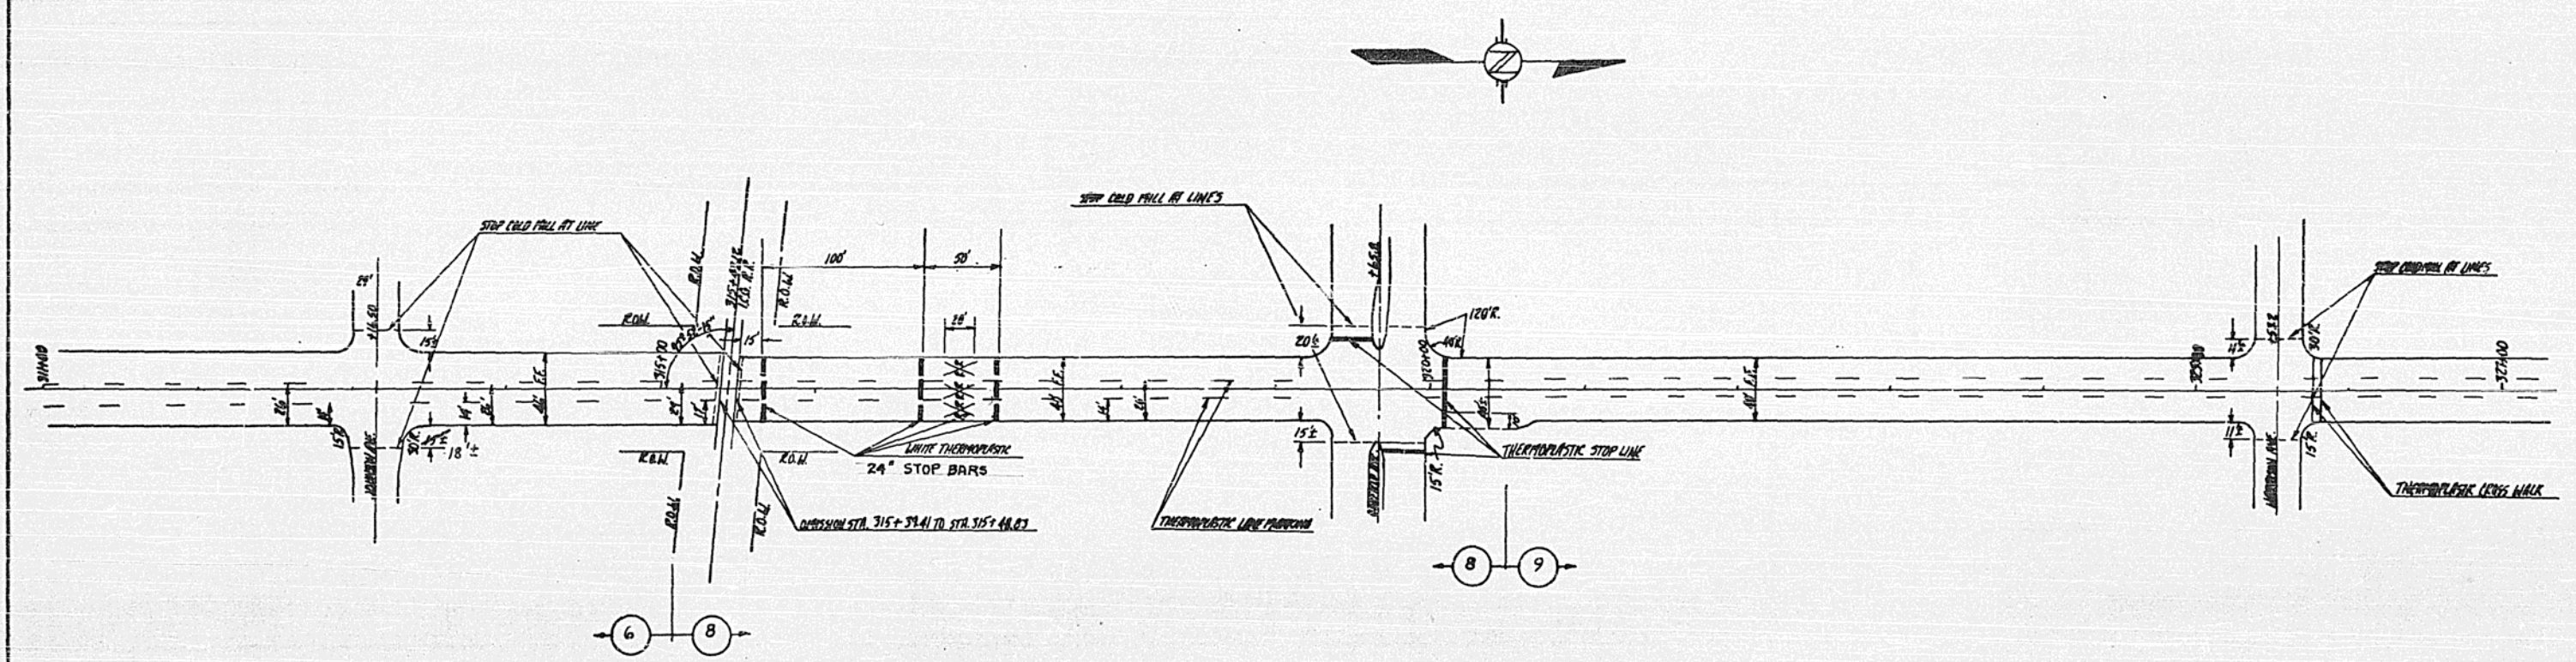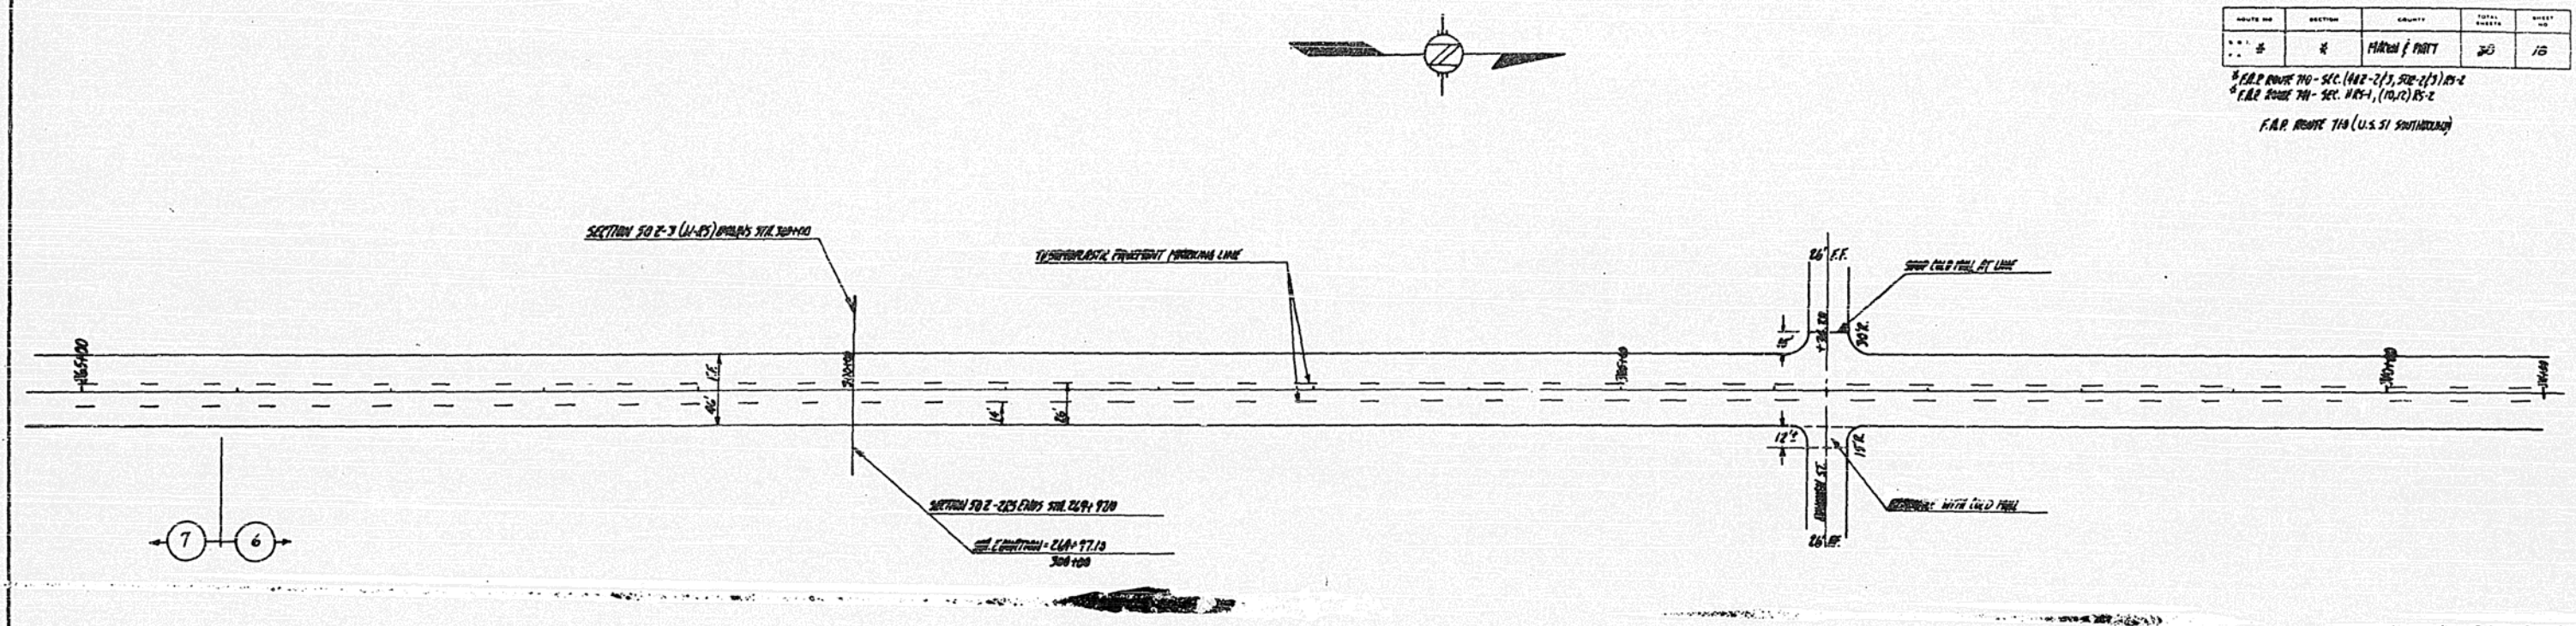

F.R.P. ROUTE 741 (ILL. ROUTE 105)

ROUTE NO.	SECTION	COUNTY	TOTAL SHEETS	SHEET NO.
#	#	JOHN F. RATT	30	20


F.R.P. ROUTE 741 - SEC. 1 (48E-2E3, 50E-2E3) R5-2
F.R.P. ROUTE 741 - SEC. 1 (48E-2E3, 50E-2E3) R5-2

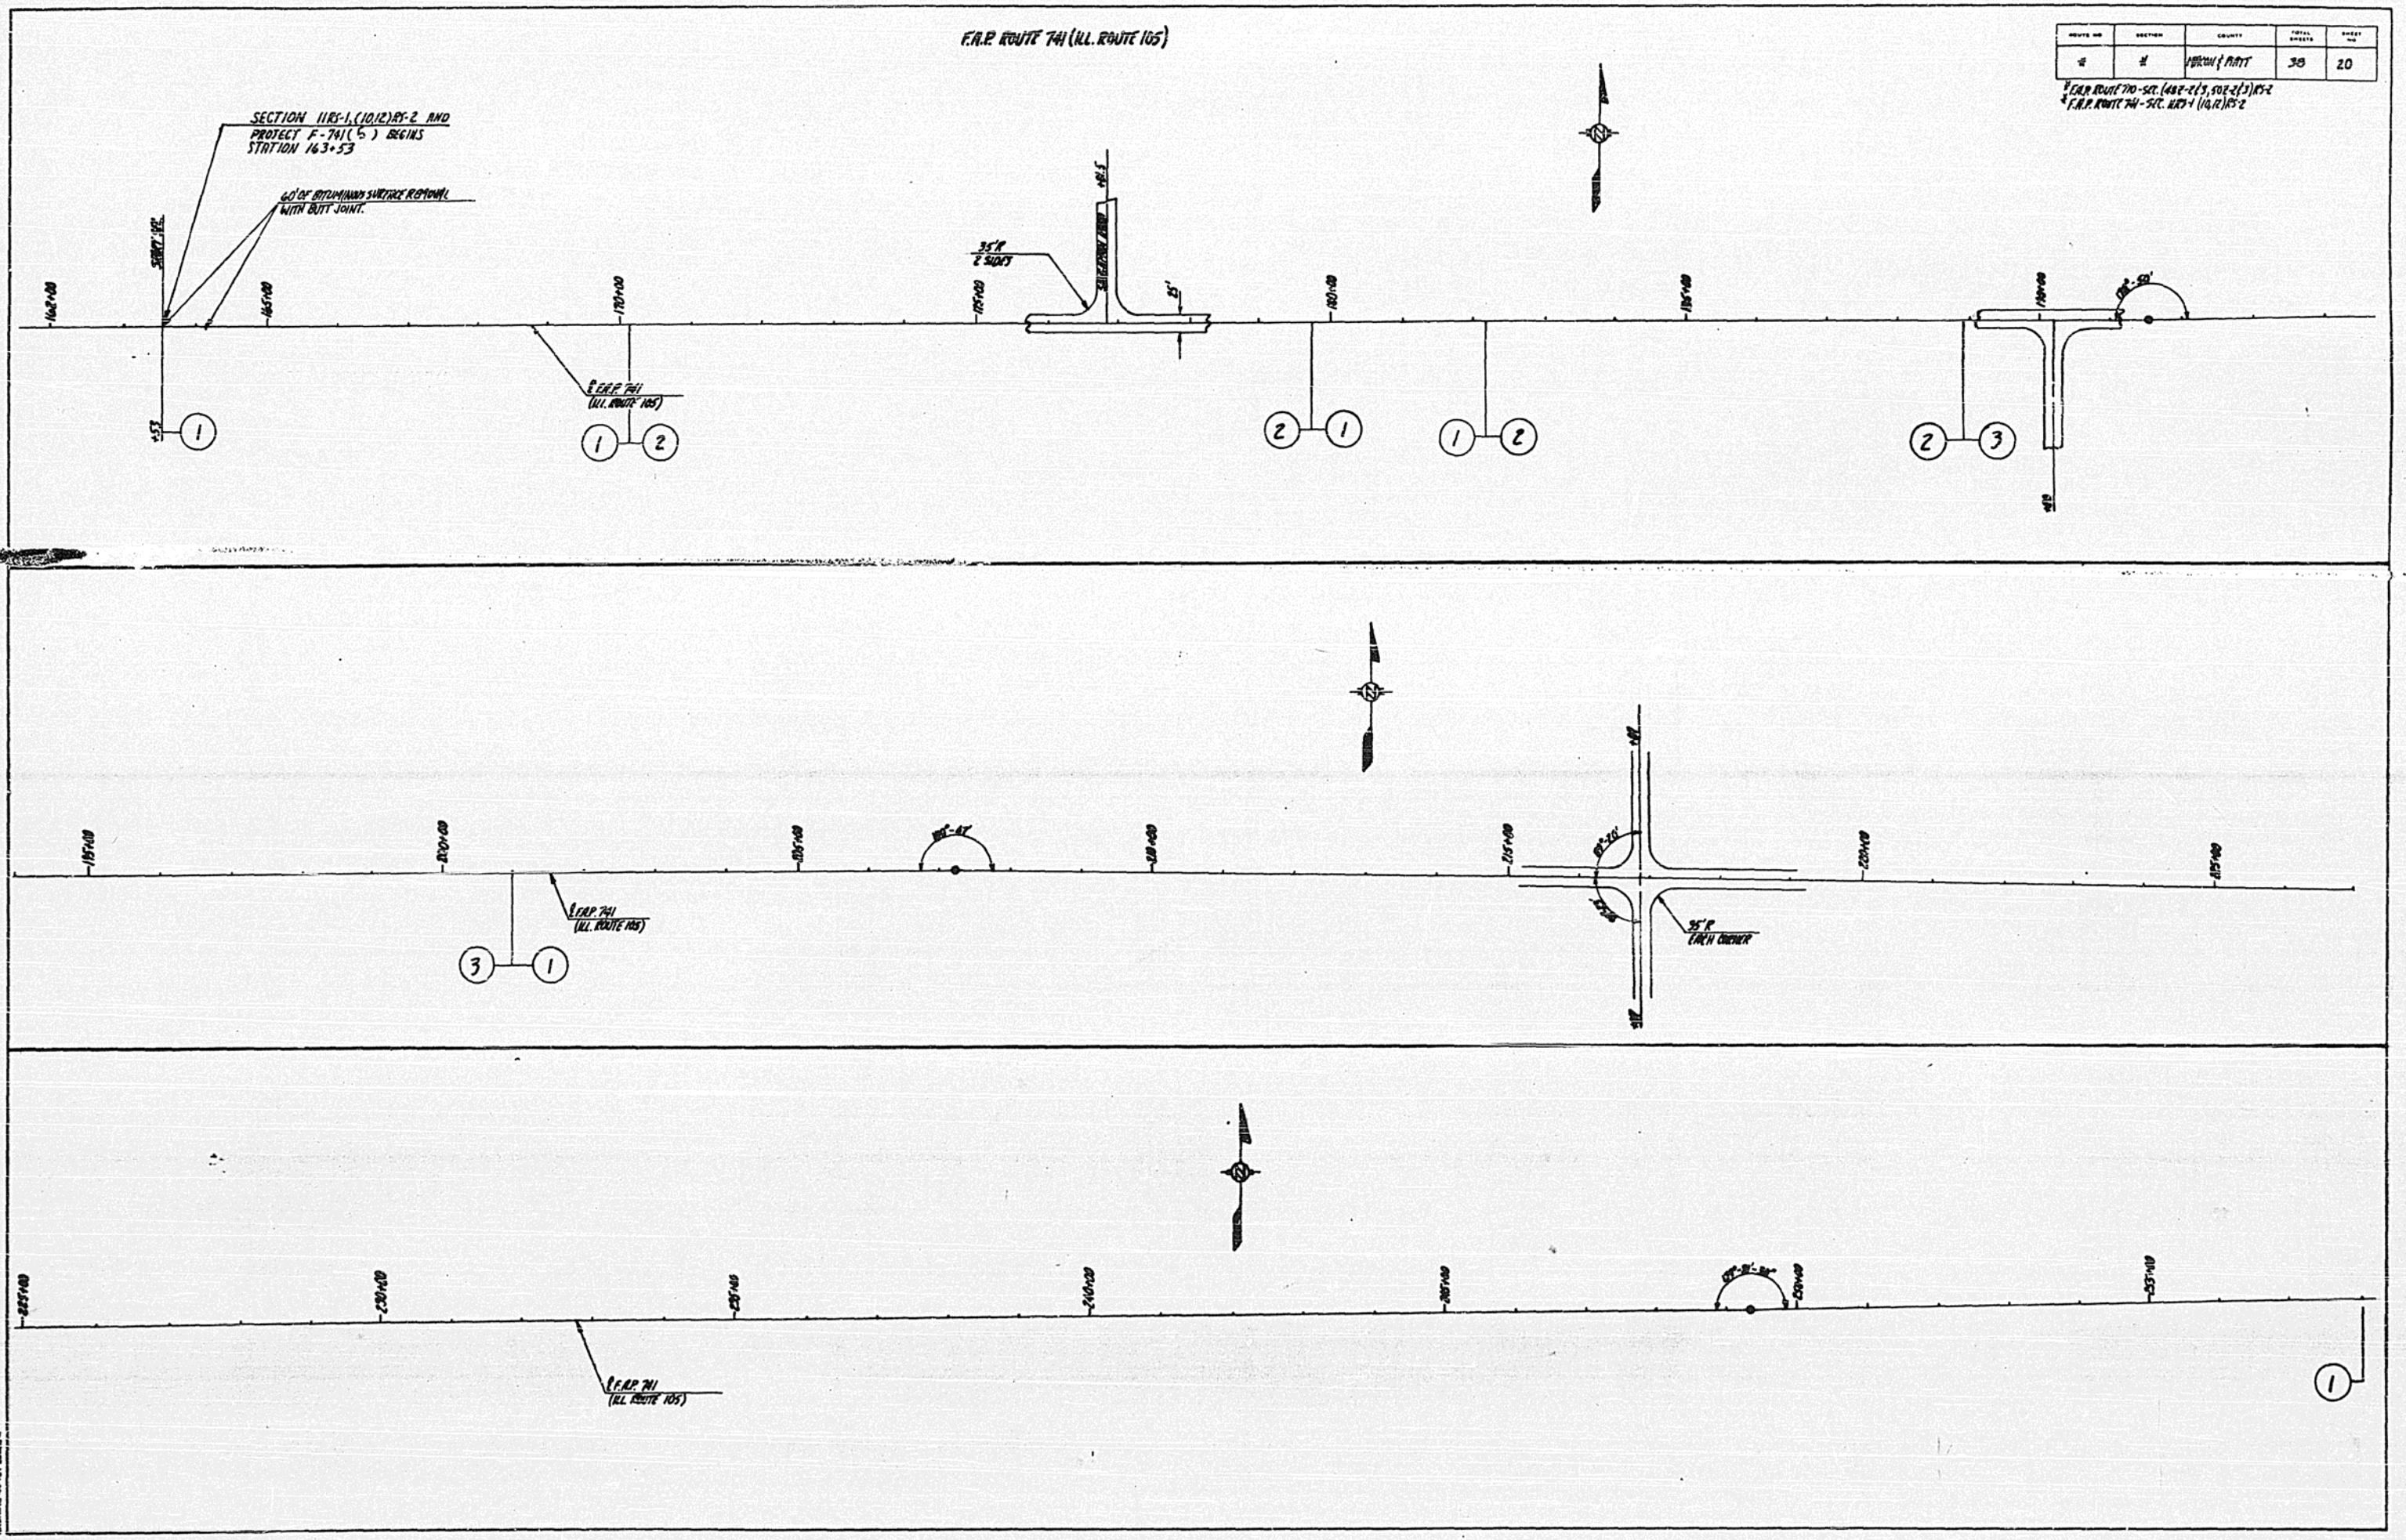

F.R.P. ROUTE 74 (ILL. ROUTE 105)

ROUTE NO.	SECTION	COUNTY	TOTAL SHEETS	SHEET NO.
74	2	MOON (PART)	38	21

* F.R.P. ROUTE 74 - SEC. (402-2/3, 502-2/3) RS-2
 * F.R.P. ROUTE 74 - SEC. 115-1 (11.12) RS-2

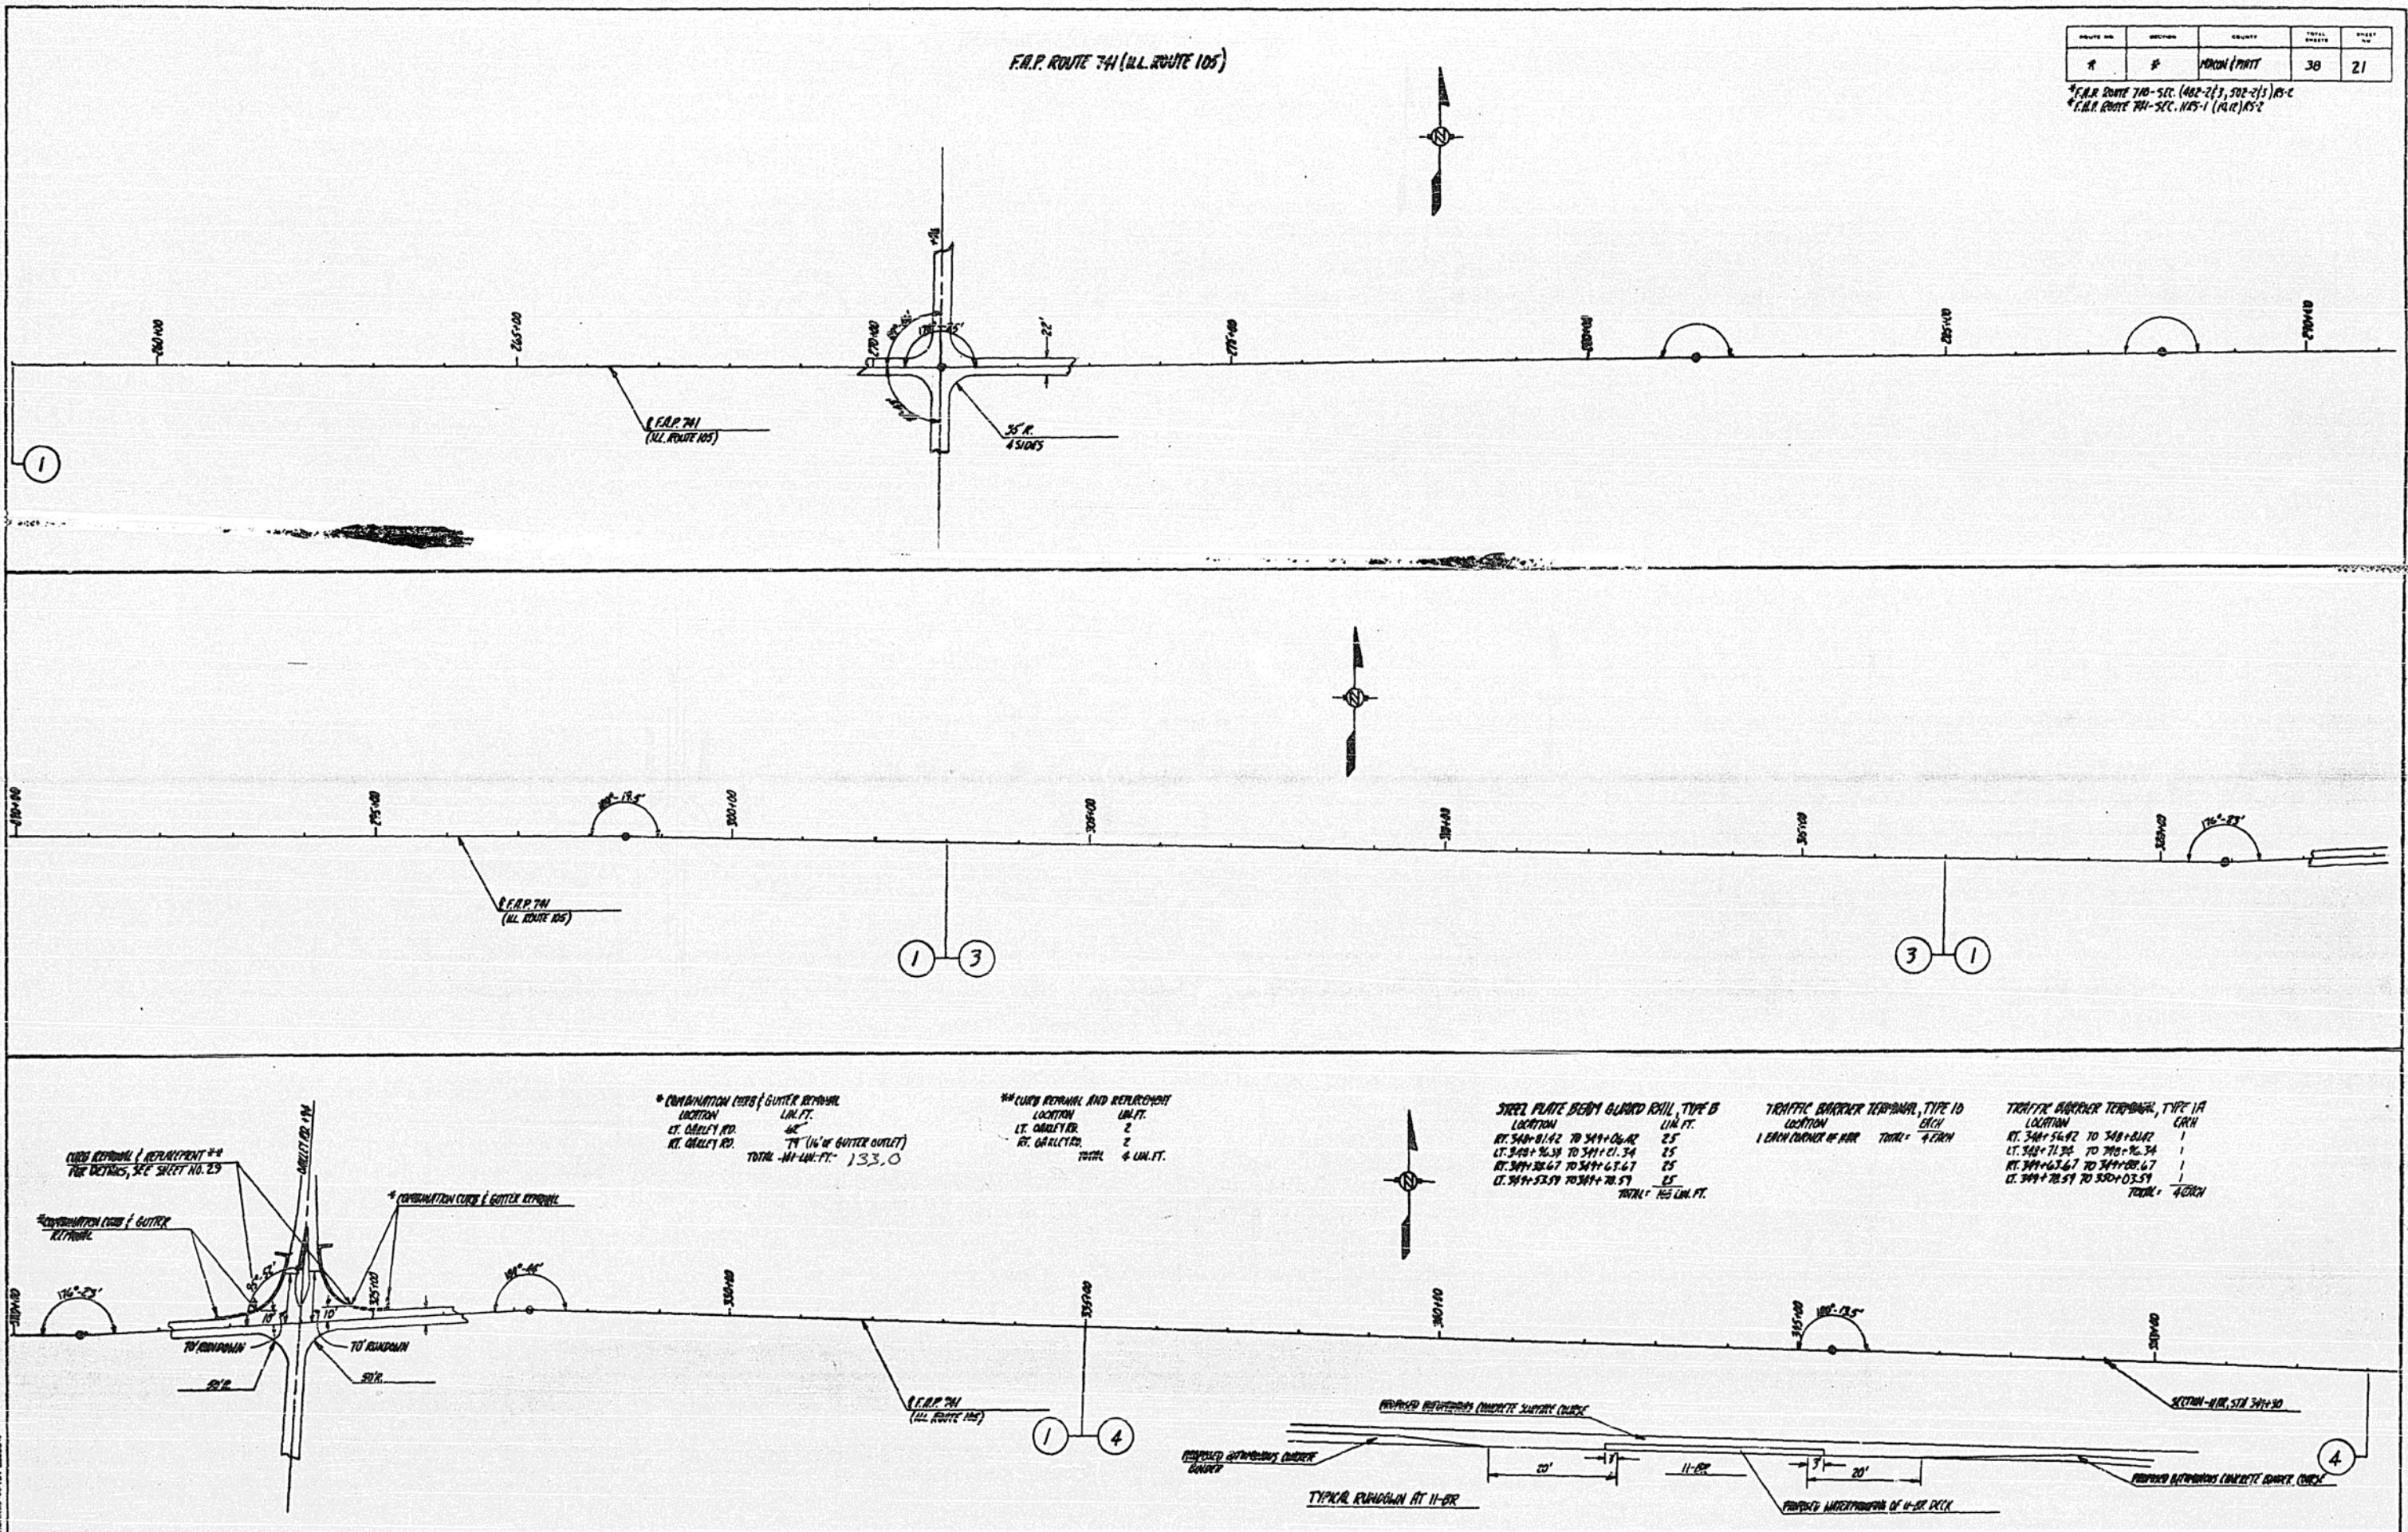

* CURBMENT CURB & GUTTER REPAIR
 LOCATION
 LT. GALLEY RD. 46'
 RT. GALLEY RD. 74' (1/4" OF GUTTER OUTLET)
 TOTAL - 120' LIN. FT.

** CURB REPAIR AND REPLACEMENT
 LOCATION
 LT. GALLEY RD. 2'
 RT. GALLEY RD. 2'
 TOTAL - 4' LIN. FT.

STEEL PLATE BEAM BLIND RAIL, TYPE B
 LOCATION
 RT. 340+01.62 TO 341+06.62 25'
 LT. 340+06.38 TO 341+01.34 25'
 RT. 341+03.67 TO 341+08.67 25'
 LT. 341+03.59 TO 341+08.59 25'
 TOTAL - 100' LIN. FT.

TRAFFIC BARRIER TERMINAL, TYPE 10
 LOCATION
 1 EACH CORNER OF HBR
 TOTAL - 4 EACH


TRAFFIC BARRIER TERMINAL, TYPE 1A
 LOCATION
 RT. 340+56.92 TO 340+61.92 1'
 LT. 340+71.38 TO 340+76.38 1'
 RT. 341+03.67 TO 341+08.67 1'
 LT. 341+03.59 TO 341+08.59 1'
 TOTAL - 4 EACH

CURB REPAIR & REPLACEMENT **
 SEE DETAIL, SEE SHEET NO. 29

* CURBMENT CURB & GUTTER REPAIR

* CURBMENT CURB & GUTTER REPAIR


F.R.P. 74
 (ILL. ROUTE 105)

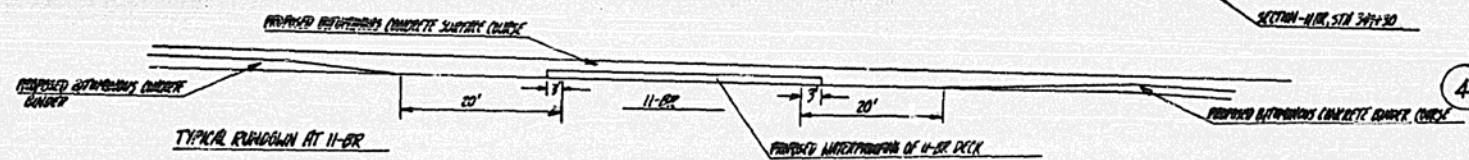

F.A.P. ROUTE 741 (ILL. ROUTE 105)

ROUTE NO.	SECTION	COUNTY	TOTAL SHEETS	SHEET NO.
741	1	MONROE (POWY)	38	22


* F.A.P. ROUTE 741 SEC. 14 & 21 (10, 12) R5-2
 * F.A.P. ROUTE 741 SEC. 11 & 21 (10, 12) R5-2

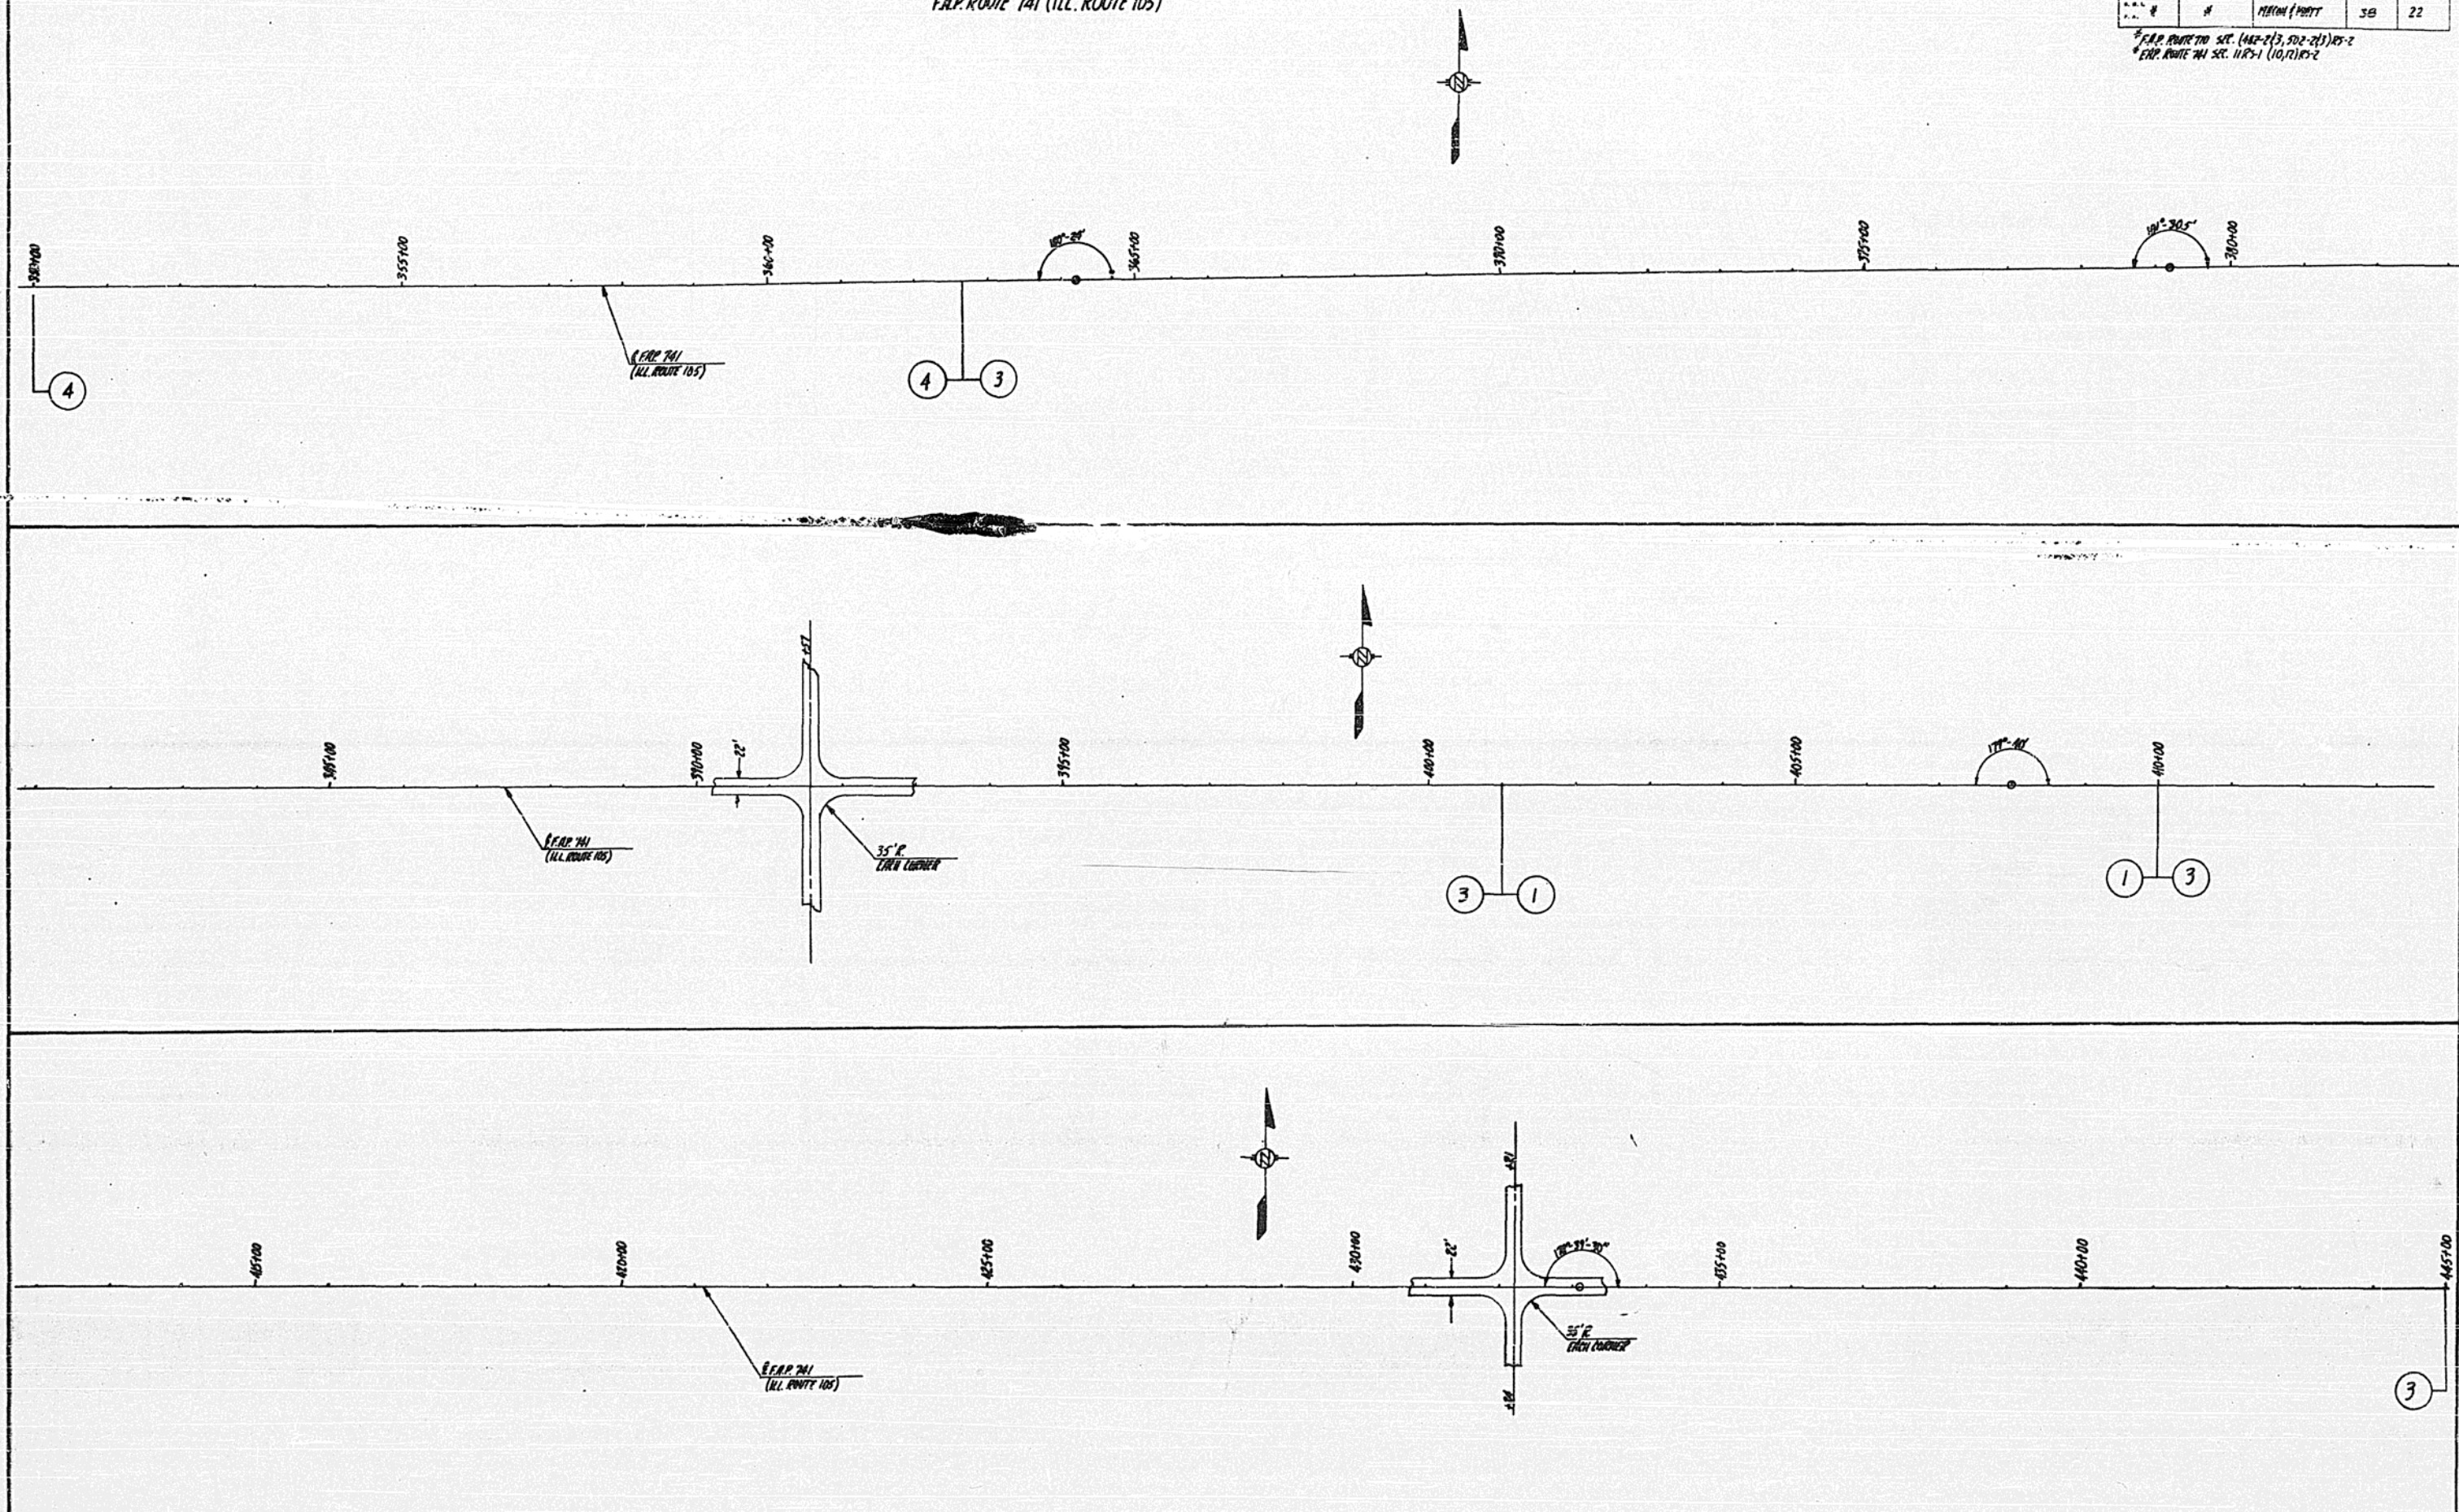

F.R.P. ROUTE 741 (ILL. ROUTE 105)

ROUTE NO.	SECTION	COUNTY	TOTAL SHEET	SHEET NO.
741	1	JEFFERSON	38	23






* F.R.P. ROUTE 741-SR. (402-2) (5,502-23) RS-2
* F.R.P. ROUTE 741-SR. 11RS-1 (10,2) RS-2

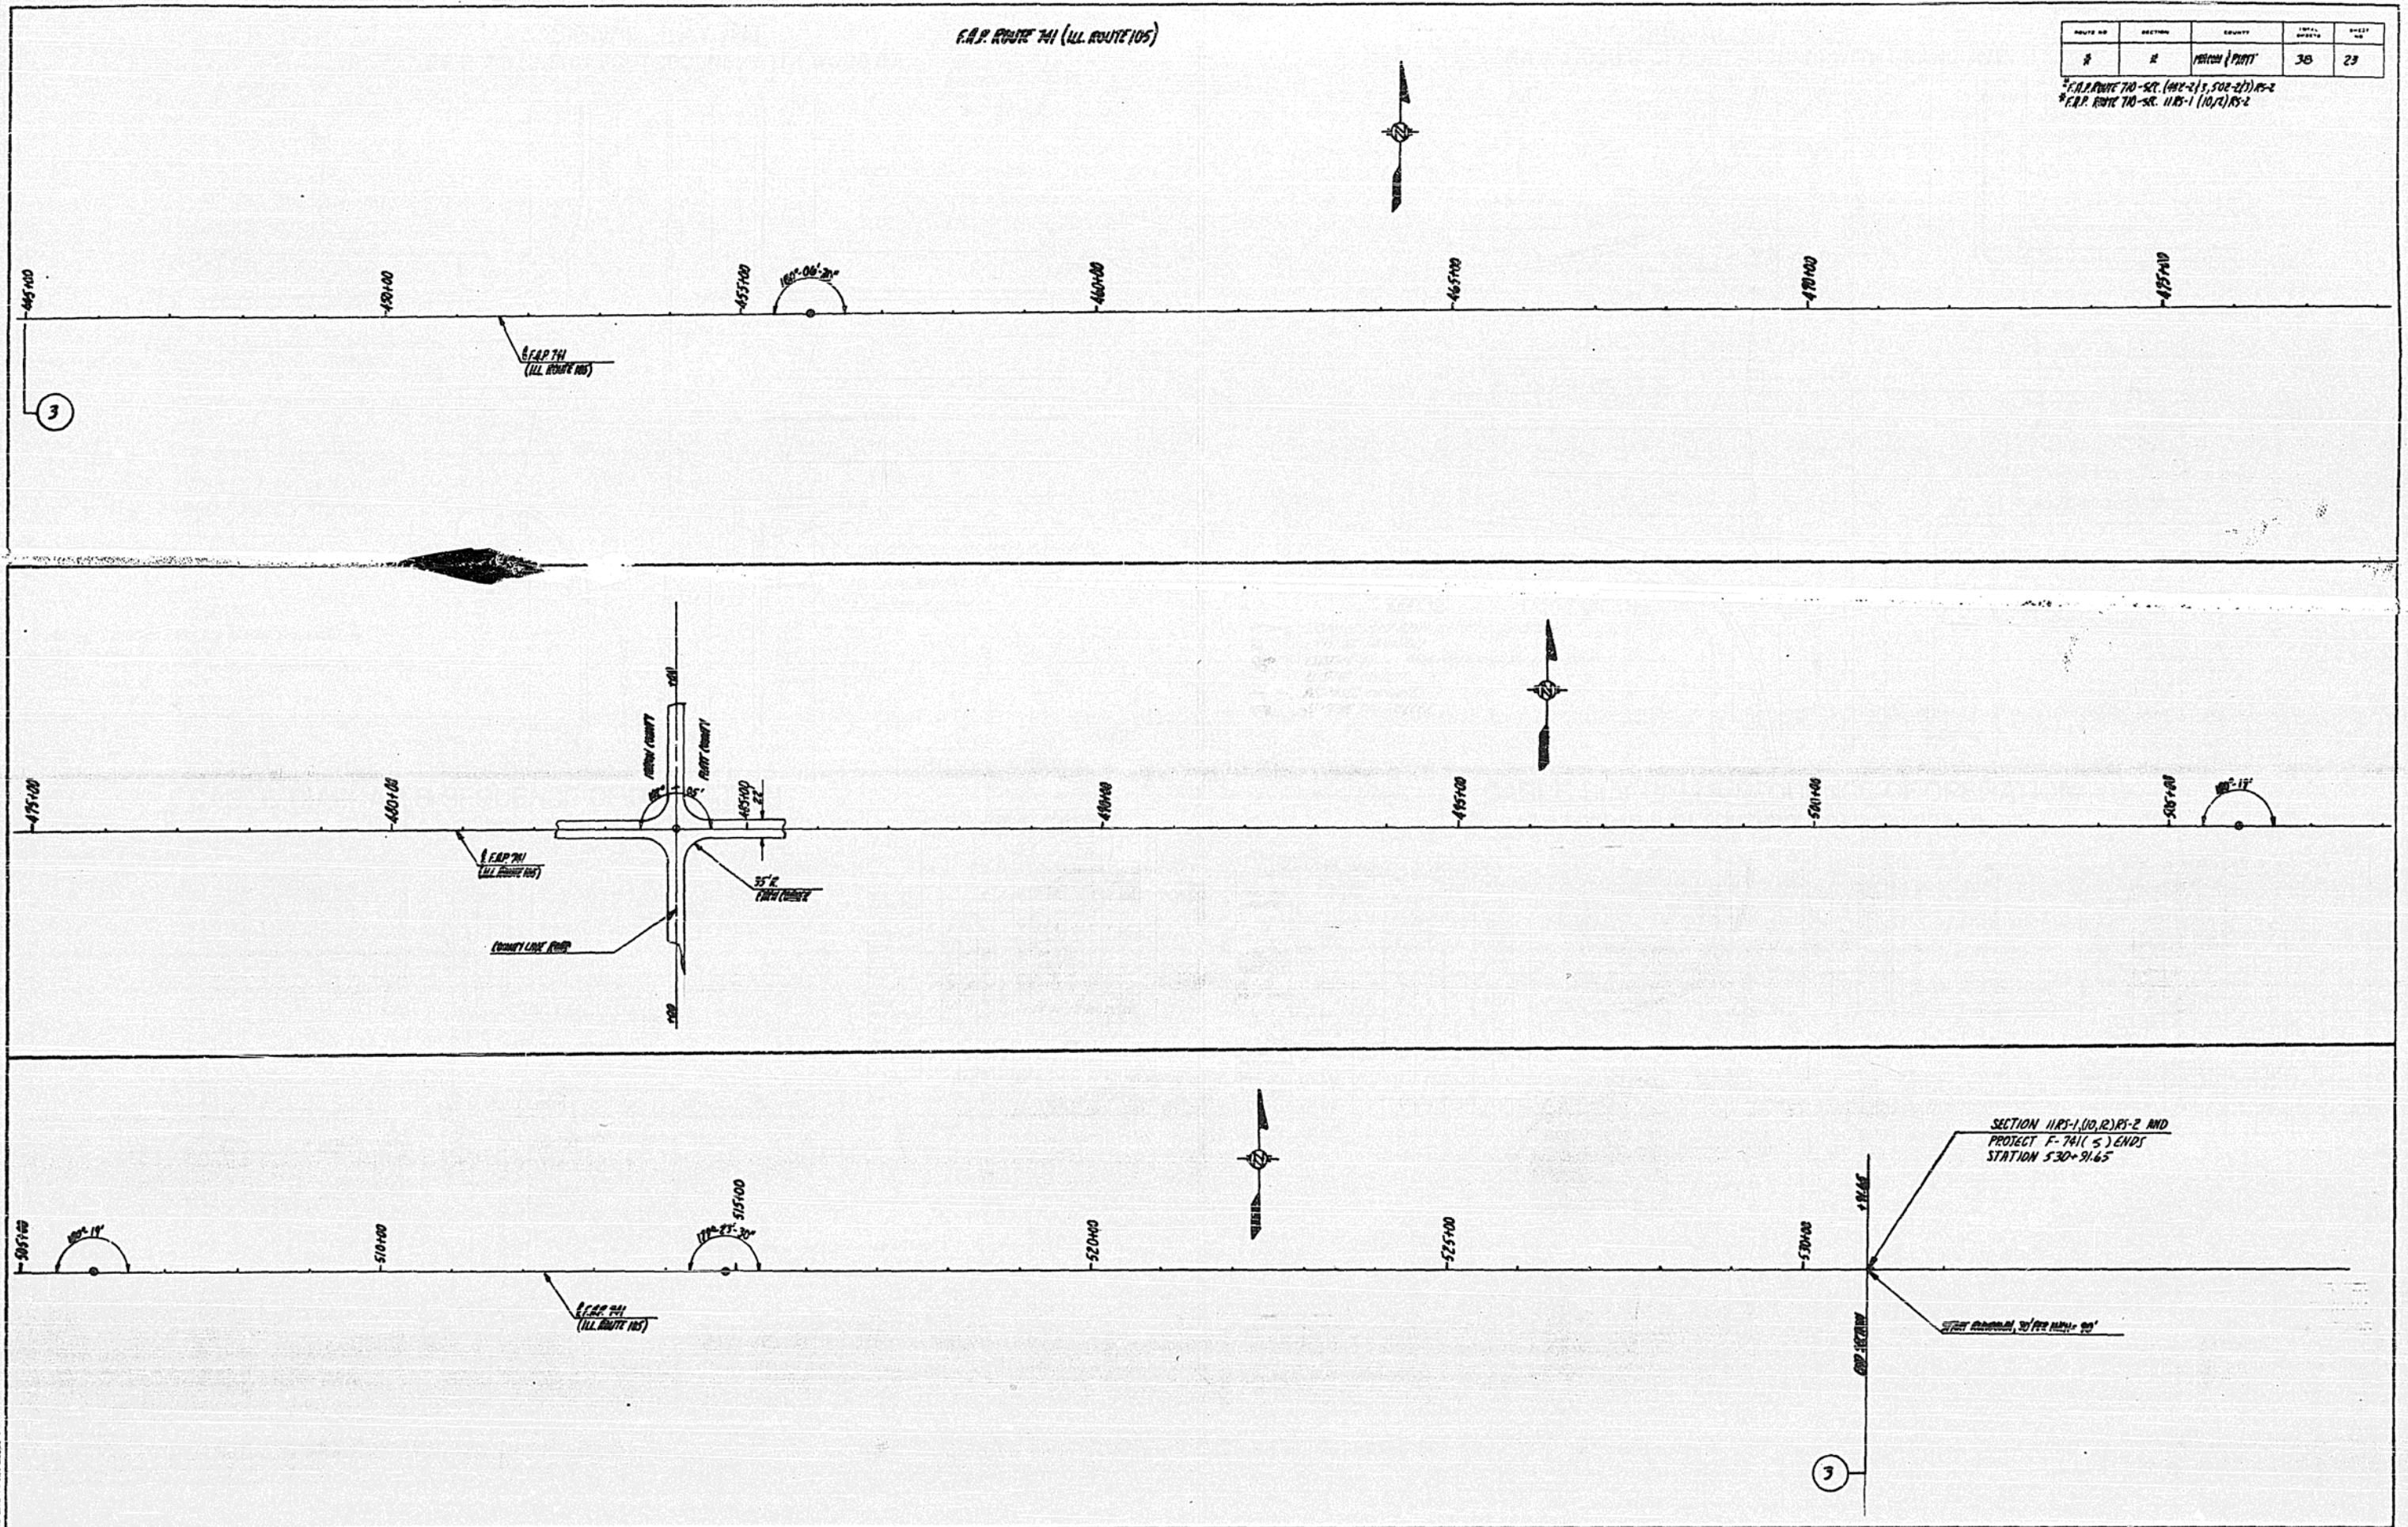

F.R.P. ROUTE 741 (ILL. ROUTE 105)
BRIDGE REPAIR
STATION 349+30
SECTION 11B2

ROUTE NO.	SECTION	COUNTY	TOTAL SHEET	SHEET NO.
#	#	NO. (PART)	30	24

* F.R.P. ROUTE 741 - SEC. 11B2-2 (11B2-2) (ILL. 105)
* F.R.P. ROUTE 741 - SEC. 11B2-1 (11B2-1) (ILL. 105)

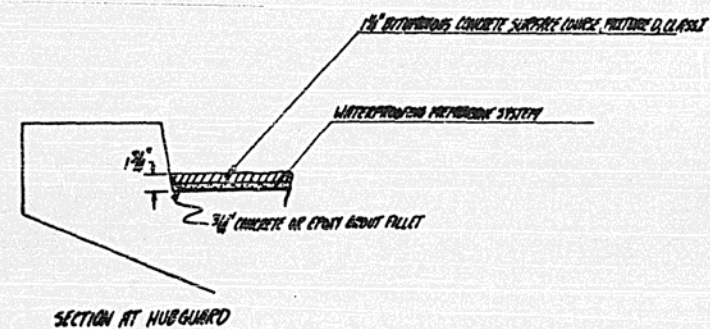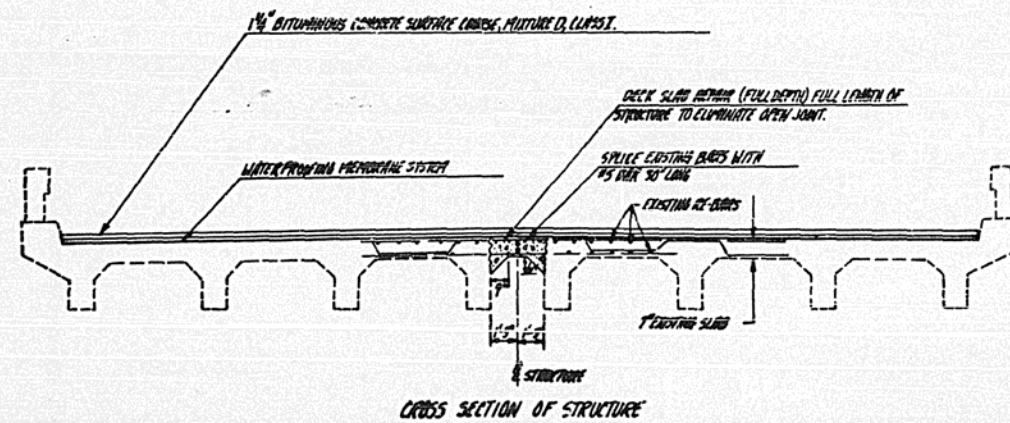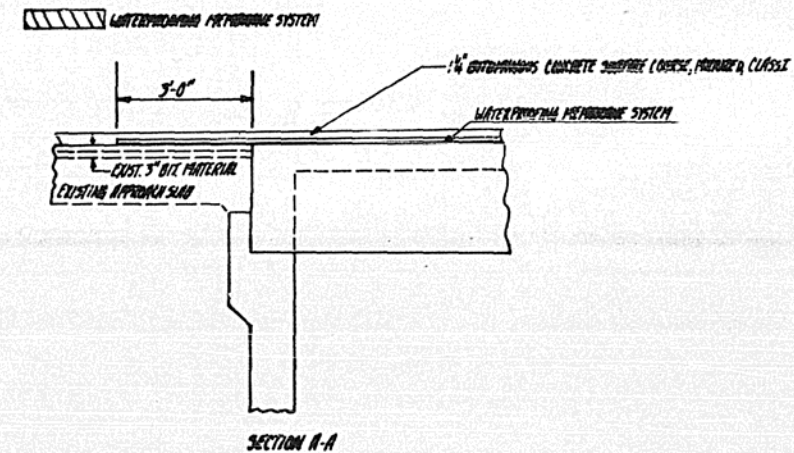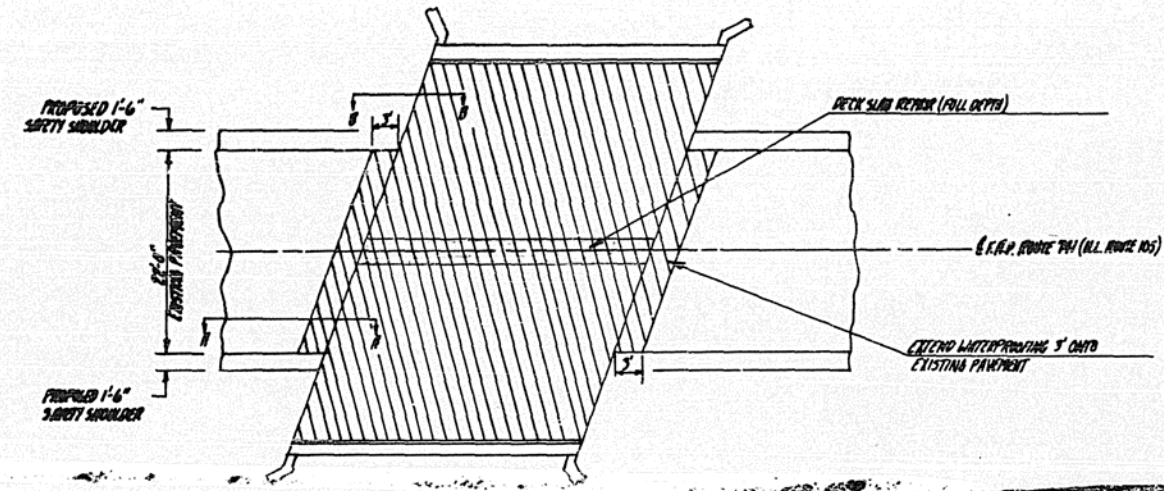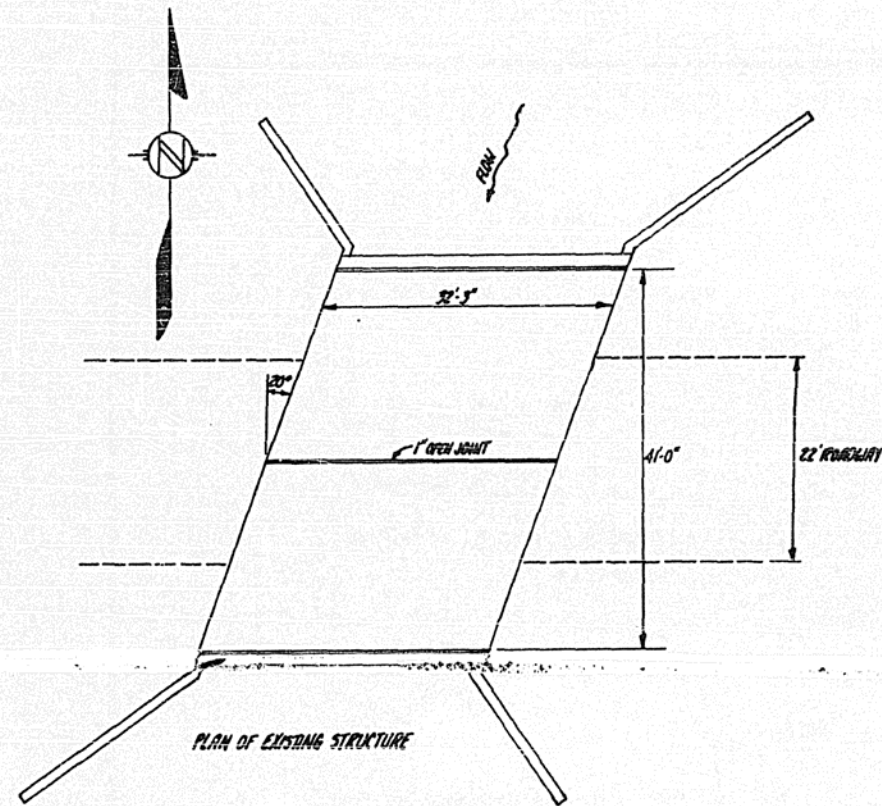


SUMMARY OF QUANTITIES			
LINE NUMBER	ITEM	UNIT	QUANTITY
210530	WATERPROOFING MEMBRANE SYSTEM	SQ. YD.	163 1/6
210180	DECK SLAB REPAIR (FULL DEPTH)	SQ. YD.	12
512001	REINFORCEMENT BARS	POUND	170 1/2
0448 001	PROTECTIVE CONTROL (PROTECTIVE COAT)	SQ. YD.	1
210181	DECK SLAB REPAIR (FILL)	SQ. YD.	17


SIGNAL LAYOUT



SIGNAL LAYOUT

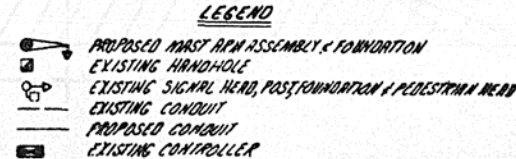


F.A.P. 710 (U.S. 51 SOUTHBOUND) WITH WOOD ST.

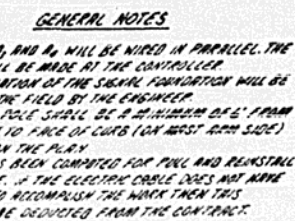

NOTE: EXISTING AND PROPOSED SEQUENCE OF OPERATION ARE THE SAME. ONLY SIGNAL R₆ HAS BEEN ADDED. SEE GENERAL NOTE #1

<u>CAGE NO</u>	<u>ITEM</u>	<u>UNIT</u>	<u>QUANTITY</u>
T00053	SIGNAL HEAD, ALUMINUM, 1-FACE 3-SECTION, MAST ARM MOUNTED	EACH	1
	R ₂ 1-FACE 3-SECTION WITH 6 LENSES		
T00301	TRAFFIC SIGNAL BACKPLATE	EACH	1
T00849	STEEL MAST ARM ASSEMBLY AND POLE, 30 FT.	EACH	1
T00005	GALVANIZED STEEL CONDUIT IN TRENCH 8'	LINE FT.	10-20
T02134	ELECTRIC CABLE IN CONDUIT NO. 12 50'	LINE FT.	40-30
T02810	CONCRETE FOUNDATION, TYPE 6 30-INCH DIAMETER	LINE FT.	8
T02810	DRILL EXISTING HANDMADE	EACH	1
T03001	TRENCH AND BACKFILL	LINE FT.	10-20
T04601	PULL AND REINSTALL ELECTRIC CABLE FROM CONDUIT	LINE FT.	10-10
470046	SIGNALS REMOVAL AND REPLACEMENT	SQ. FT.	100

F.A.P. 710 (U.S. 51 SOUTHBOUND) WITH GRAND AVE.

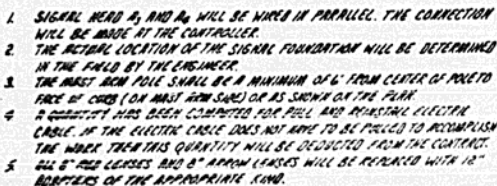


CORE NO.	ITEM	UNIT	QUANTITY
740053	SIGNAL HEAD, ALUMINUM 1-FACE 3-SECTION ARM ADJUSTED	EACH	1
	P-1-FACE 3-SECTION WITH A0-LEASERS		
740301	TRAFFIC SIGNAL SIGNAL PLATE	EACH	1
740501	10-INCH SIGNAL HOUSING	EACH	11
740805	STEEL W/STAINLESS-STEEL AND PAVE, 30 FT.	EACH	1
742005	GRAVELLED STEEL CONDUIT IN TRENCH 2"	LN. FT.	70 17.7
742130	ELECTRIC CABLE IN CONDUIT NO 14 46	LN. FT.	89 0.36
742700	CONCRETE FOUNDATION, TYPE C 30 INCH DIAMETER	LN. FT.	8
742810	DEATH EXISTING HANDWALK	EACH	1
743001	TRENCH AND BACKFILL	LN. FT.	149 17.7
743901	TRAFFIC EXISTING CONTROLLER	EACH	1
744001	PULL AND REINSTATE ELECTRIC CABLE FROM CONDUIT	LN. FT.	700 0
747046	SIDEWALK REPAIRS AND REPLACEMENT	50 FT	6 6.4

*NOTE: THE CITY OF DECATUR HAD HUBBARD ELECTRIC
REPLACE ALL THE ELCS @ THE GRAND & MAIN
INTERSECTION.

TYPICAL APPLICATION FOR BRIDGE DECK REPAIR
SHOULDER DETAIL
 F.A.P. ROUTE 741, STA. 349+30

ROUTE NO	SECTION	COUNTY	TOTAL SHEETS	SHEET NO
F.A.P. 710 # 741	X	MACON & PIATT	38	26

* F.A.P. 710 SEC. (482-2(3), 502-2(3)) RS-2
 * F.A.P. 741 SEC. 11RS-1 (10,12) RS-2

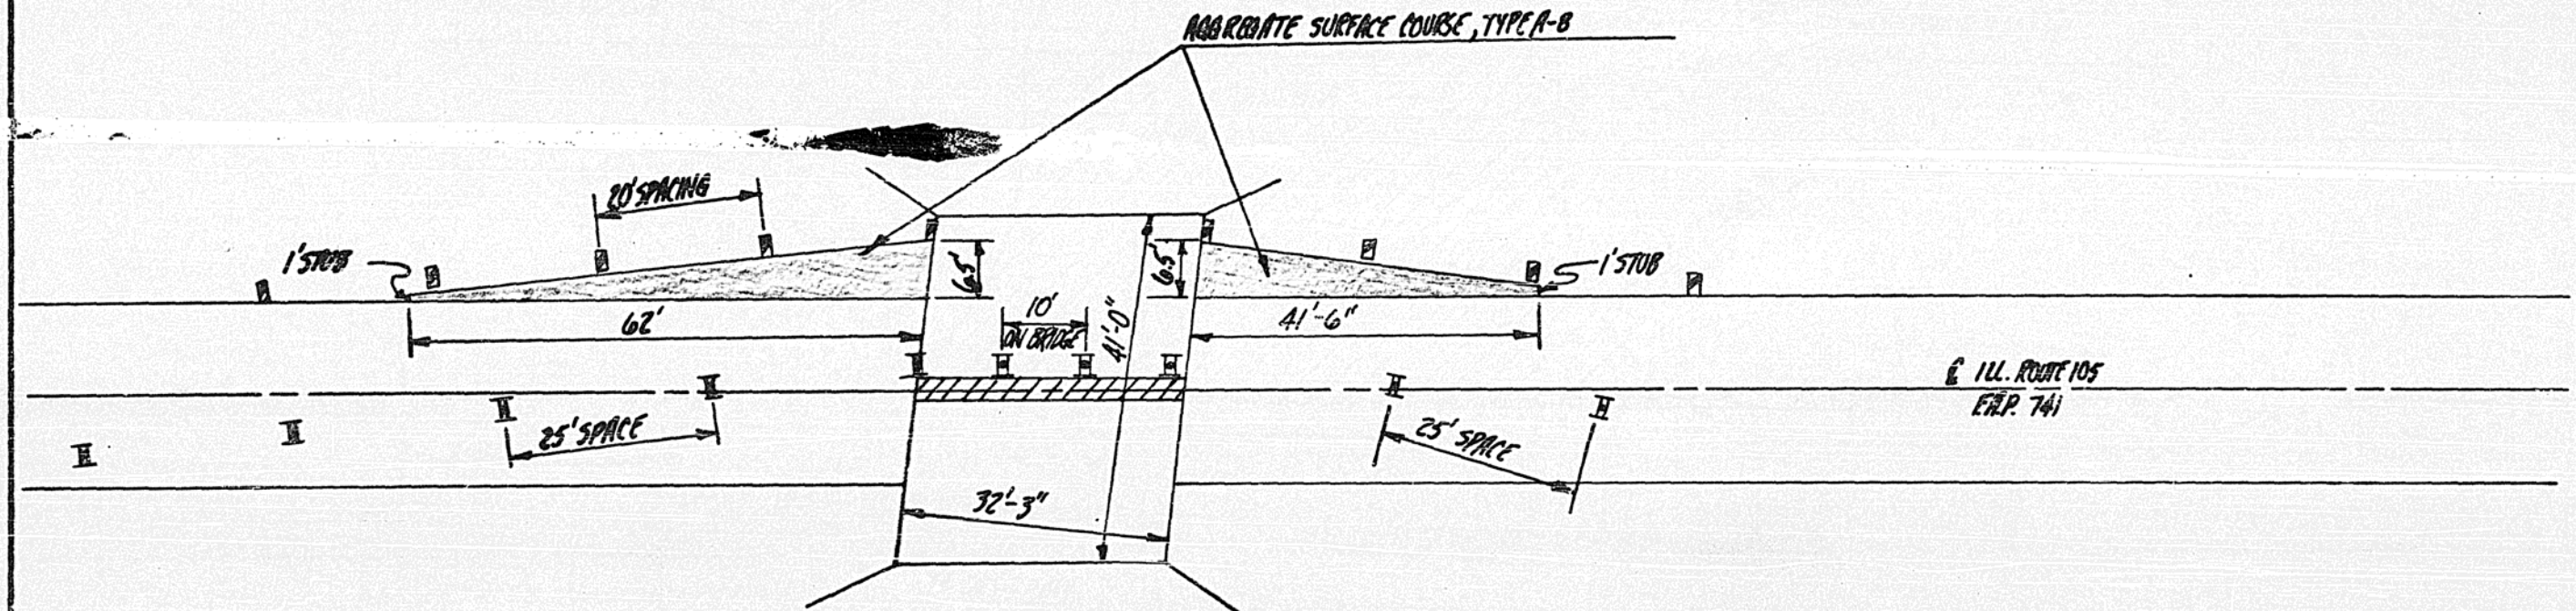

SYMBOLS

WORK AREA

TYPE I OR II BARRICADE WITH STEADY BURNING LIGHTS



VERTICAL PANEL (SEE STANDARD 2299)

DESIGNED BY
CHECKED BY

DETAIL OF SIDEROADS TO BE RECONSTRUCTED **F.A.P. ROUTE 741 (ILL. ROUTE 105)**

ROUTE NO.	SECTION	COUNTY	TOTAL SHEETS	SHEET NO.
S.D.I. * F.A. *	*	MACON & PIATT	38	27

* F.A.P. ROUTE 710 SEC. (482-213, 502-213) RS-2
 * F.A.P. ROUTE 741 SEC. 11 RS-1 (10, 12) RS-2

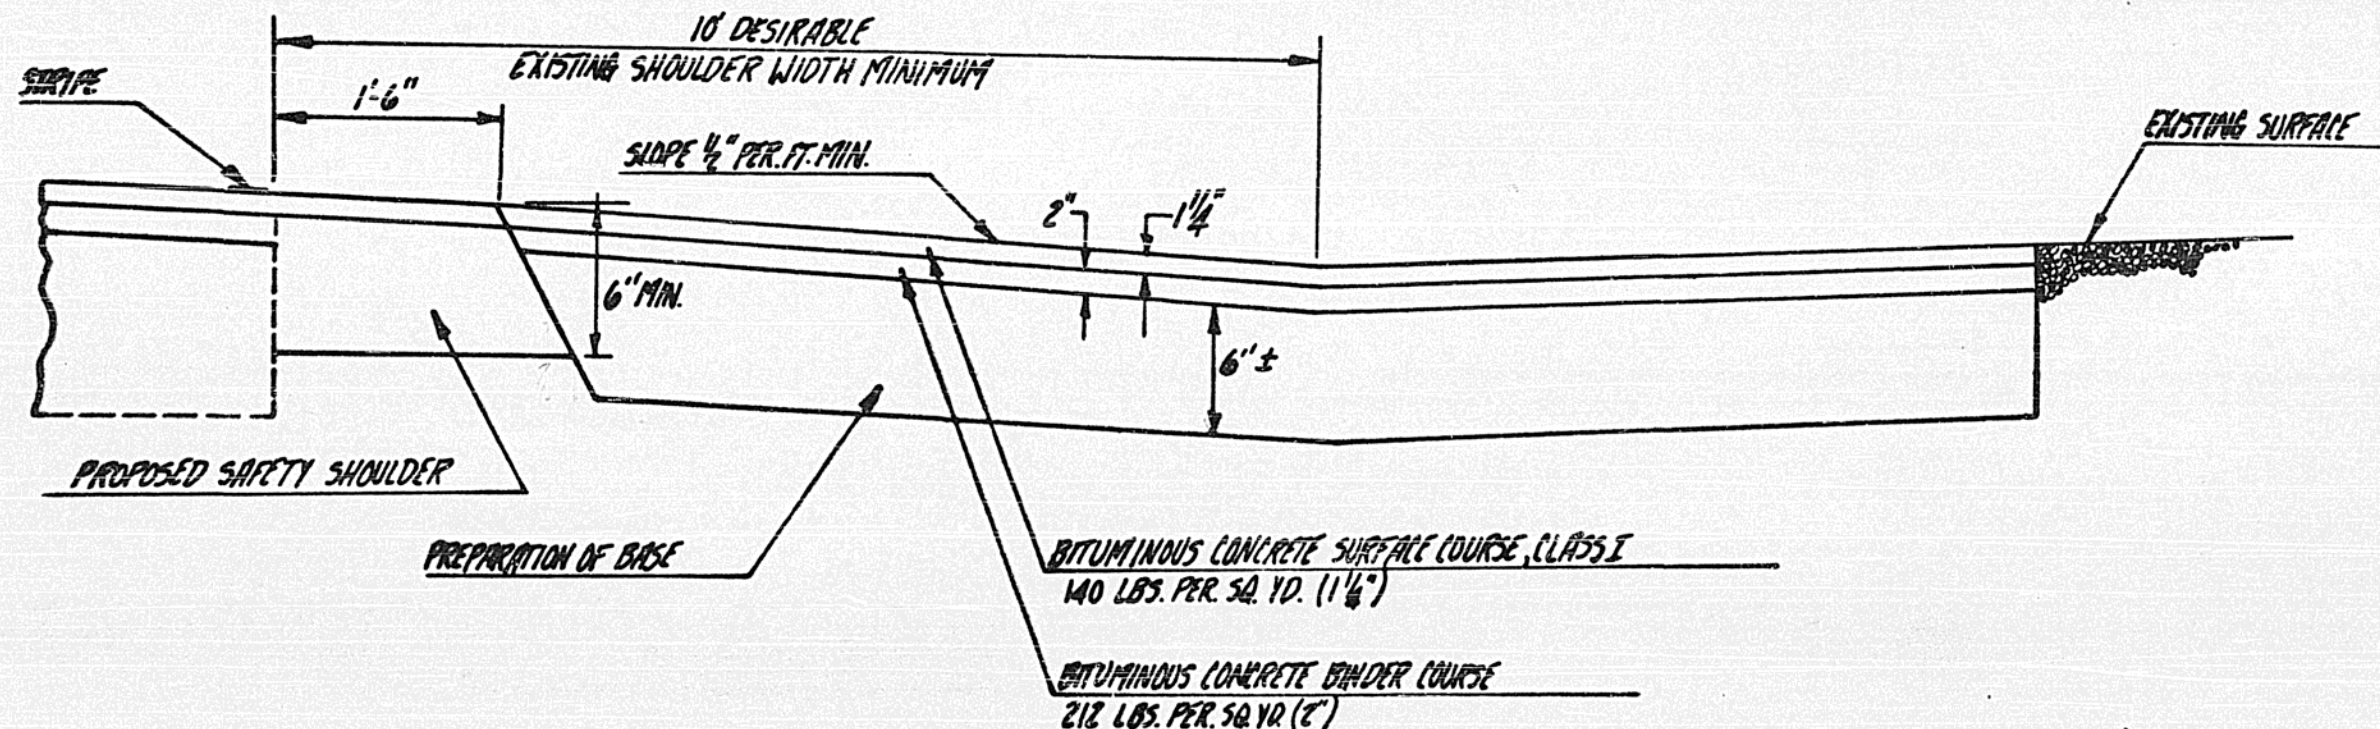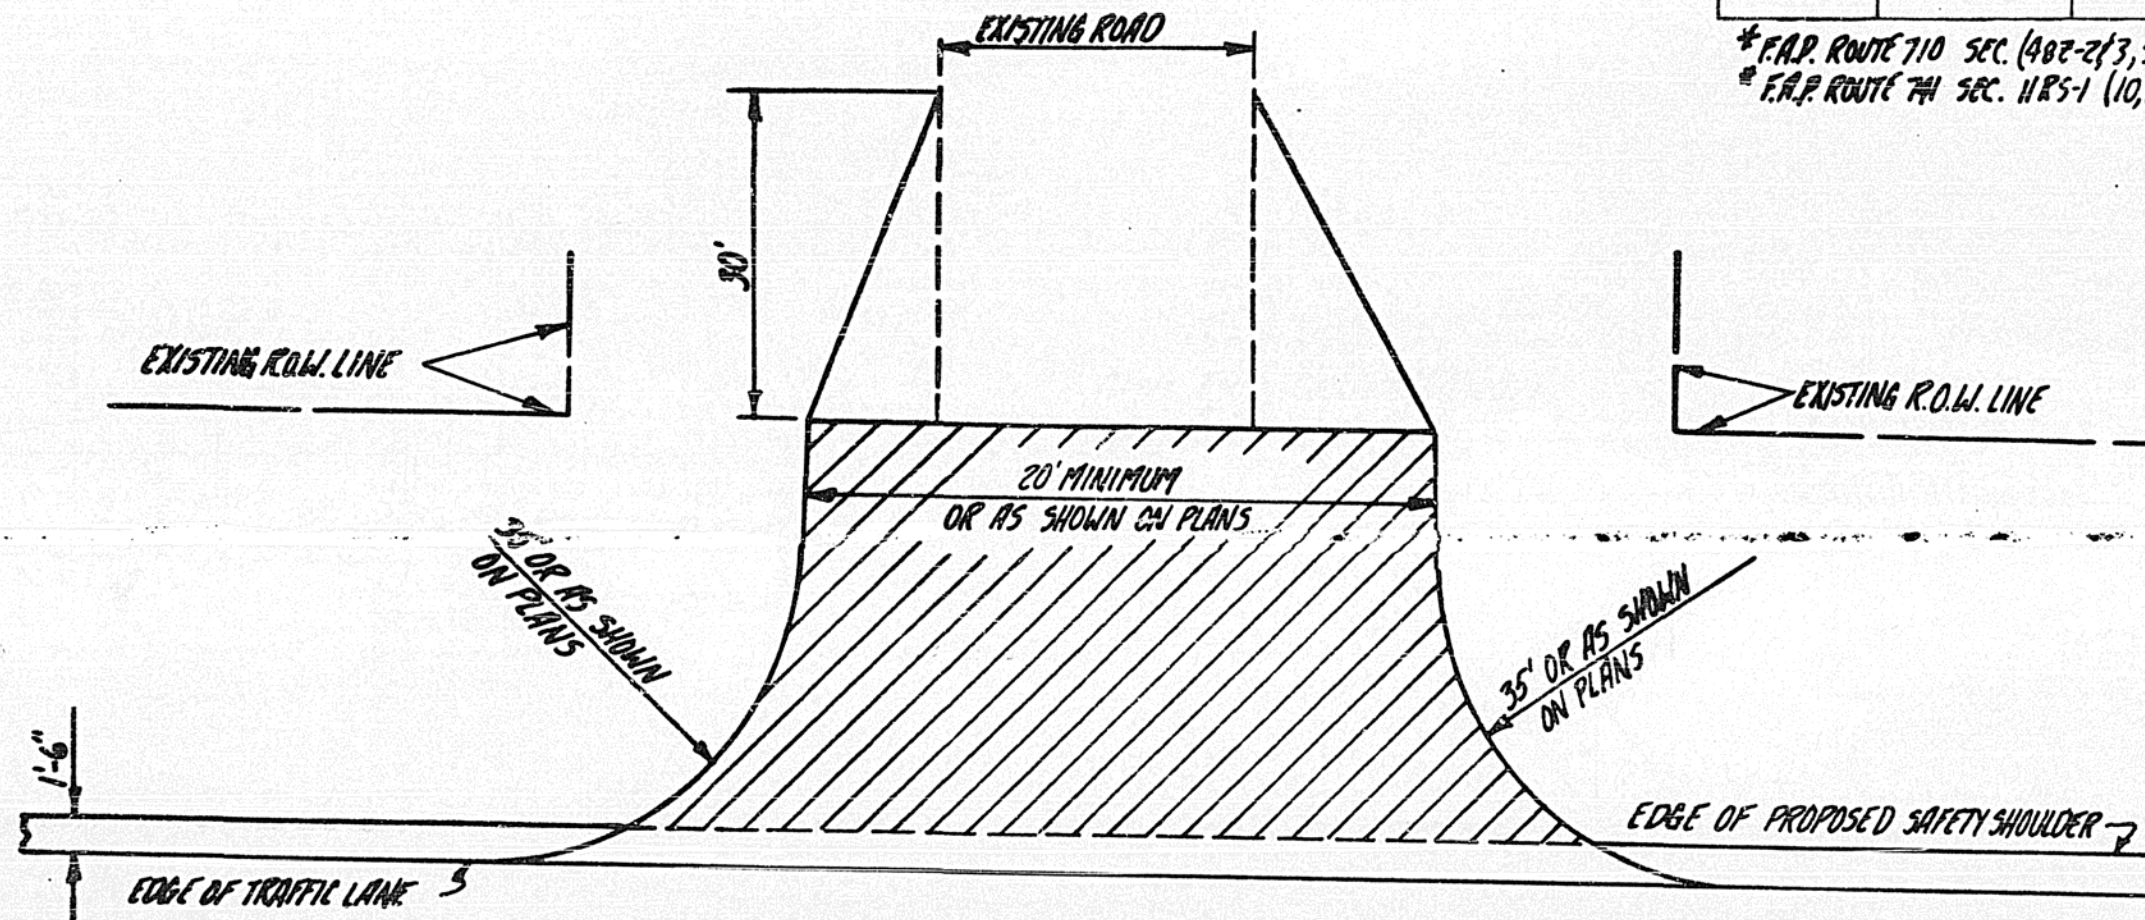

DESIGNED
 CHECKED

DETAIL OF ENTRANCES **F.A.P. ROUTE 741 (ILL. ROUTE 105)**



ROUTE NO.	SECTION	COUNTY	TOTAL SHEETS	SHEET NO.
S. D. I. P. A. #	#	PIACON (PIATT)	38	28

* F.A.P. ROUTE 710 SEC. (482-213, 502-213) RS-2
 * F.A.P. ROUTE 741 SEC. 11RS-1 (10,12) RS-2

PRIVATE & COMMERCIAL ENTRANCE WIDTH
 16'
 30'

*24'
 38'

FIELD ENTRANCE WIDTH
 16' *38'
 22' 44'
 30' 52'

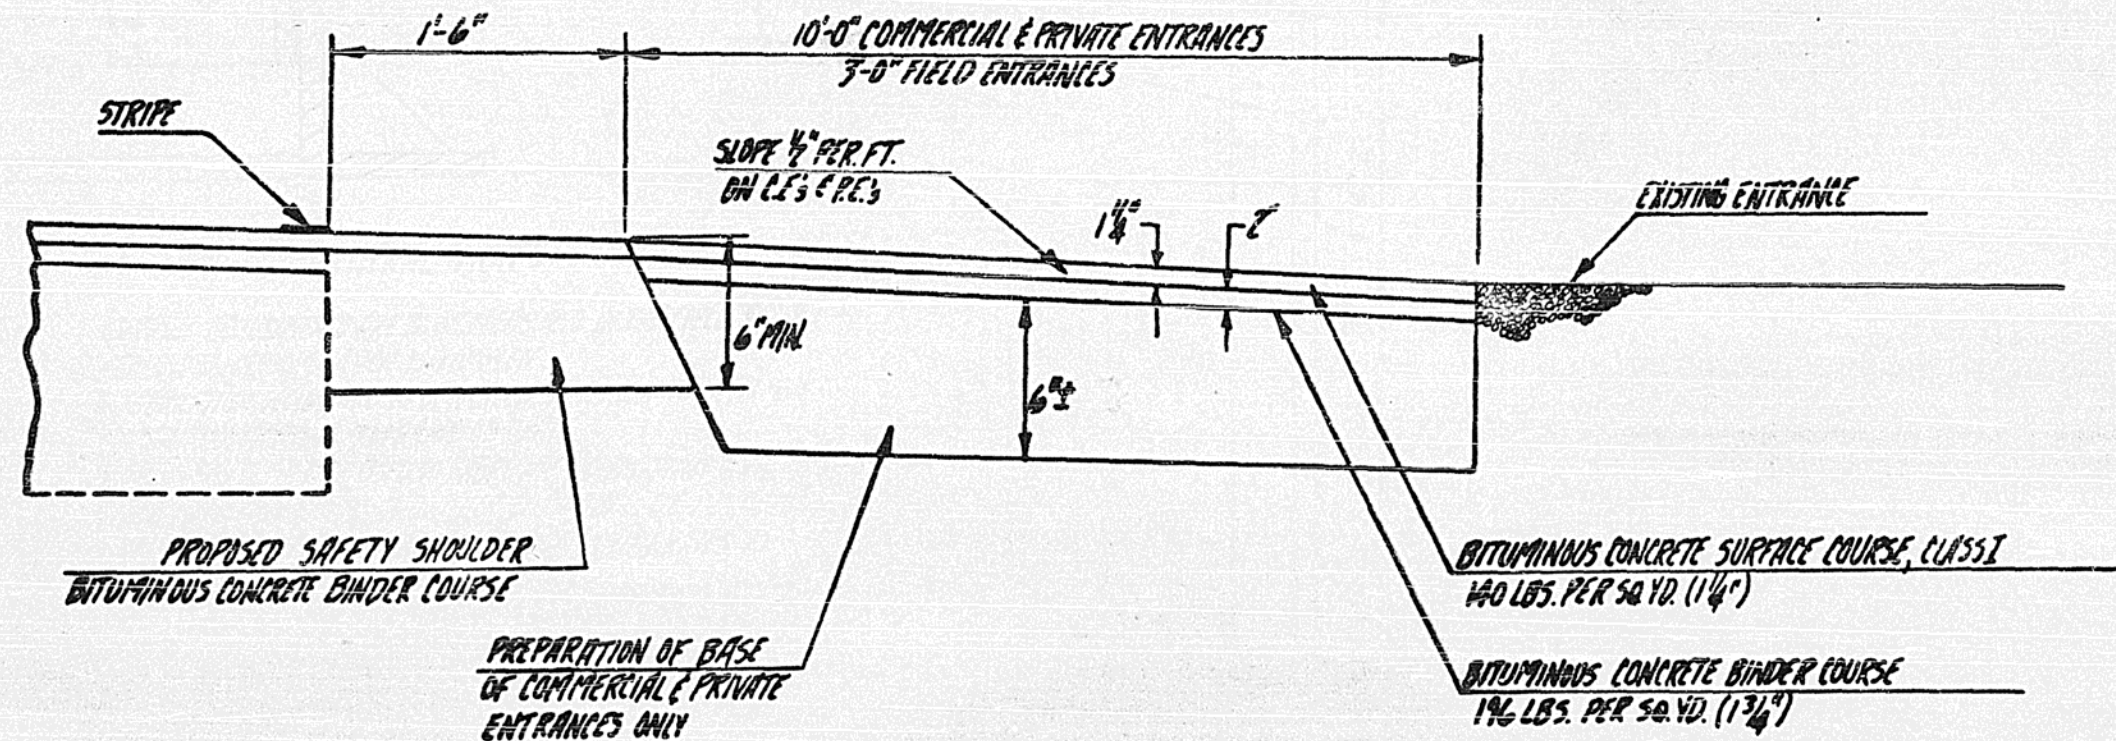
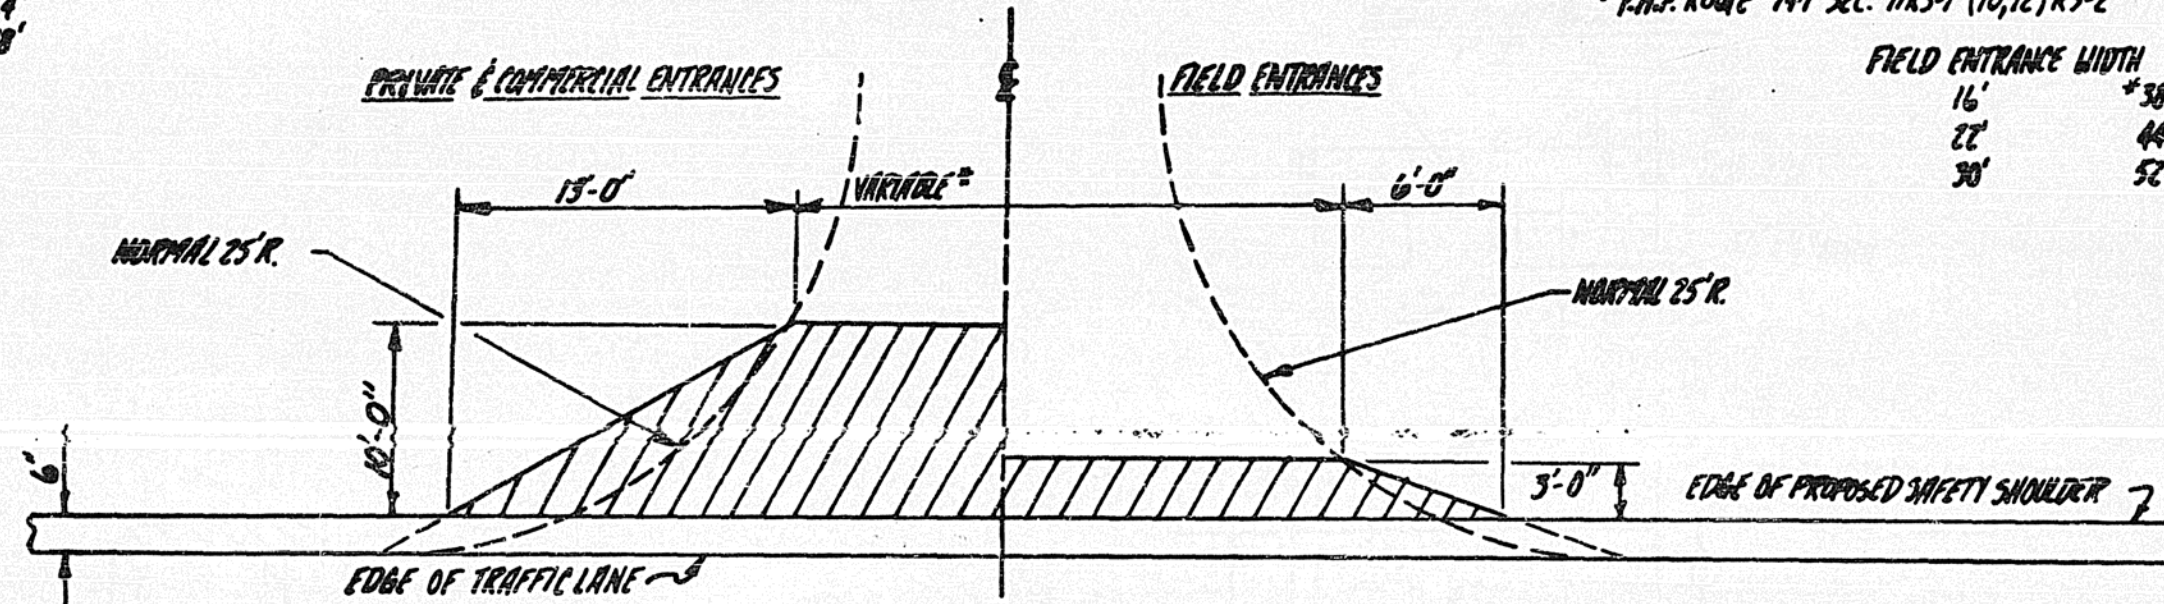


DESIGNED
CHECKED

TYPICAL DETAIL OF DEPRESSED CURB

PROJECT NO.	SECTION	COUNTY	SHEET NO.	TOTAL SHEETS
*	*	MAON & PIATT	38	29

* F.A.P. 710 - SEC. (402-2f3, 502-2f3) R52
 * F.A.P. 741 - SEC. 11R5-1 (10,12) R5-2

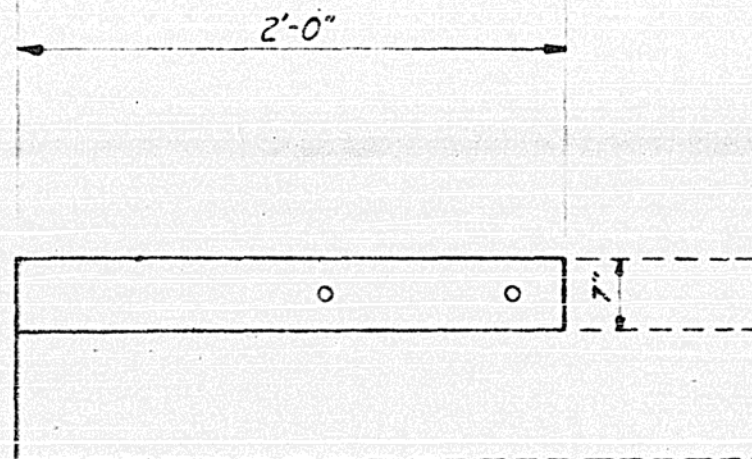
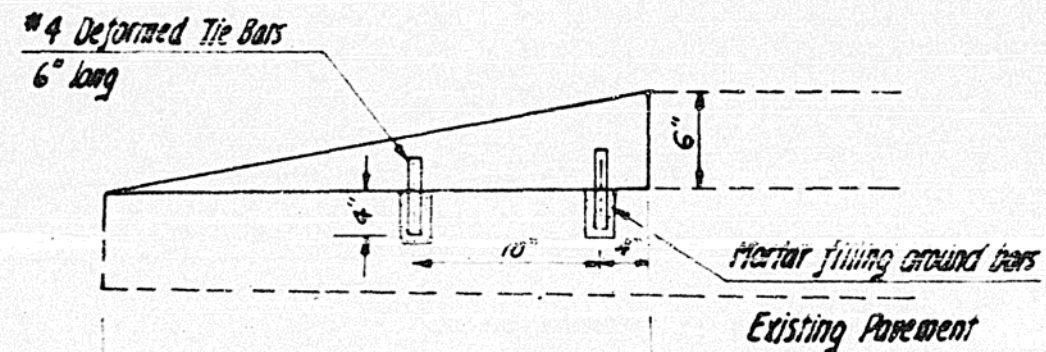


PLAN VIEW

NOTE: The cost of furnishing and installing Dowel Bars, Epoxy Concrete Adhesive, and Mortar Filling shall be included in the contract unit price per lin. ft. for CURB REMOVAL AND REPLACEMENT.

ISOMETRIC VIEW
 EXISTING CURB REMOVED

Apply Epoxy Concrete Adhesive to surface

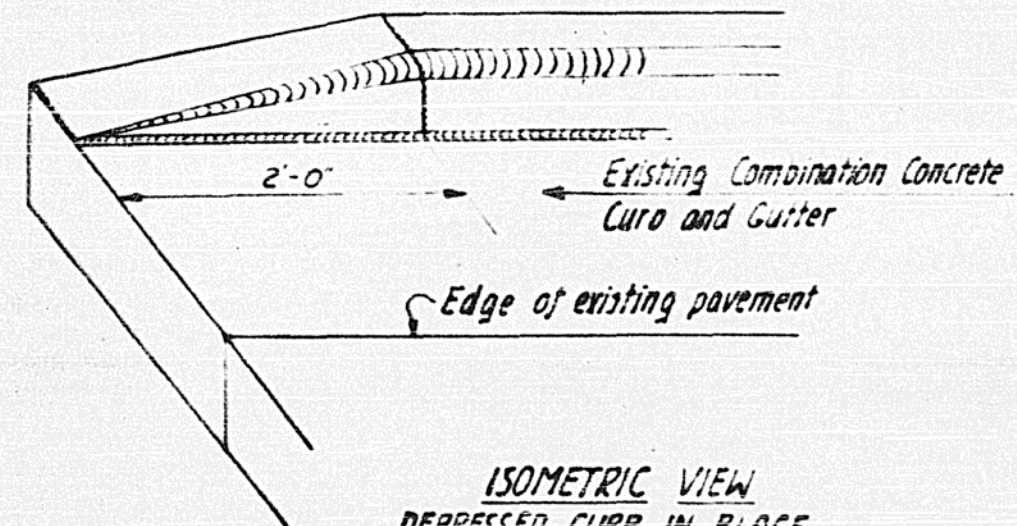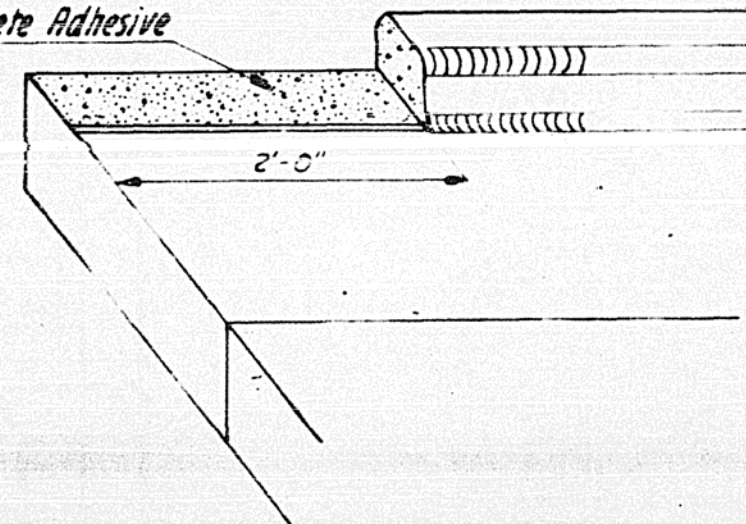



ISOMETRIC VIEW
 DEPRESSED CURB IN PLACE

DESIGNED
CHECKED

ADJUSTMENT RINGS FOR C-11 FRAMES & GRATES

ROUTE NO.	SECTION	COUNTY	TOTAL SHEETS	SHEET NO.
#	#	MAHON & PINTY	38	30


* F.A.P. ROUTE 710 - SEC. (40-22(3), 502-2(3)) RS-2
 * F.A.P. ROUTE 741 - 11 RS-1 (10,12) RS-2

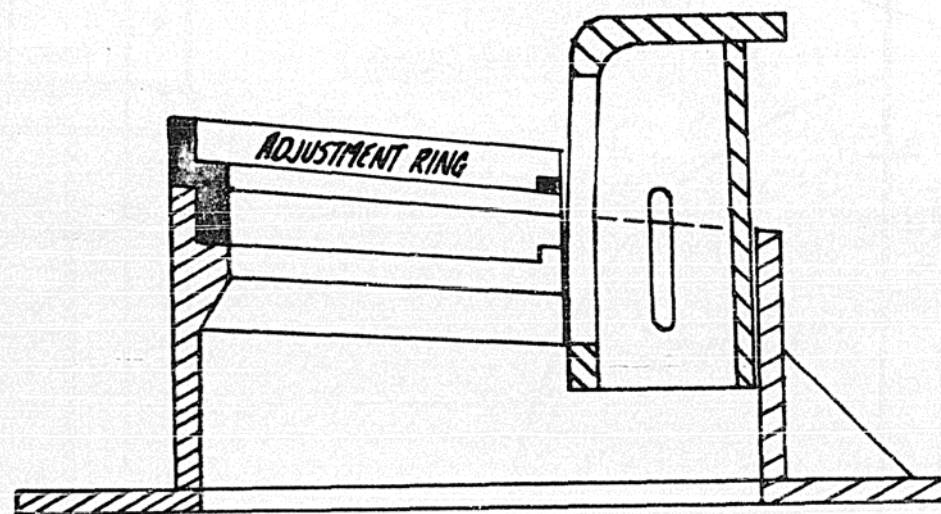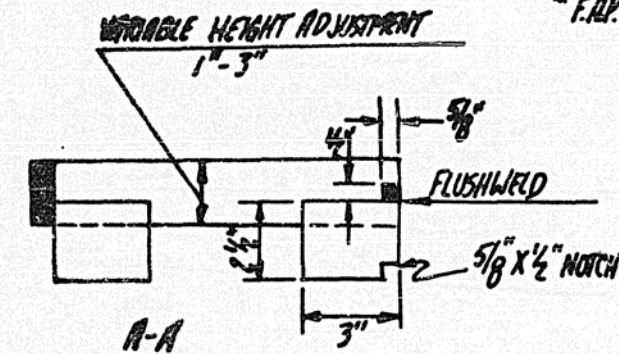

GENERAL NOTES:

1. HEIGHT ADJUSTMENTS ARE TO BE MEASURED IN THE FIELD AFTER COLD MILLING OPERATION IS COMPLETE.
2. FABRICATION WELDS ARE TO BE PLACED SO AS NOT TO INTERFERE WITH RING SEATING ON FRAME OR GRATE.
3. MILD STEEL MAY BE USED TO FABRICATE ADJUSTMENT RING.
4. ALL MATERIAL, LABOR AND OTHER COST SHALL BE INCLUDED IN THE UNIT PRICE, EACH, FOR FRAMES AND GRATES TO BE ADJUSTED.


TYPICAL 3/8" FILLET WELD ENDS ONLY

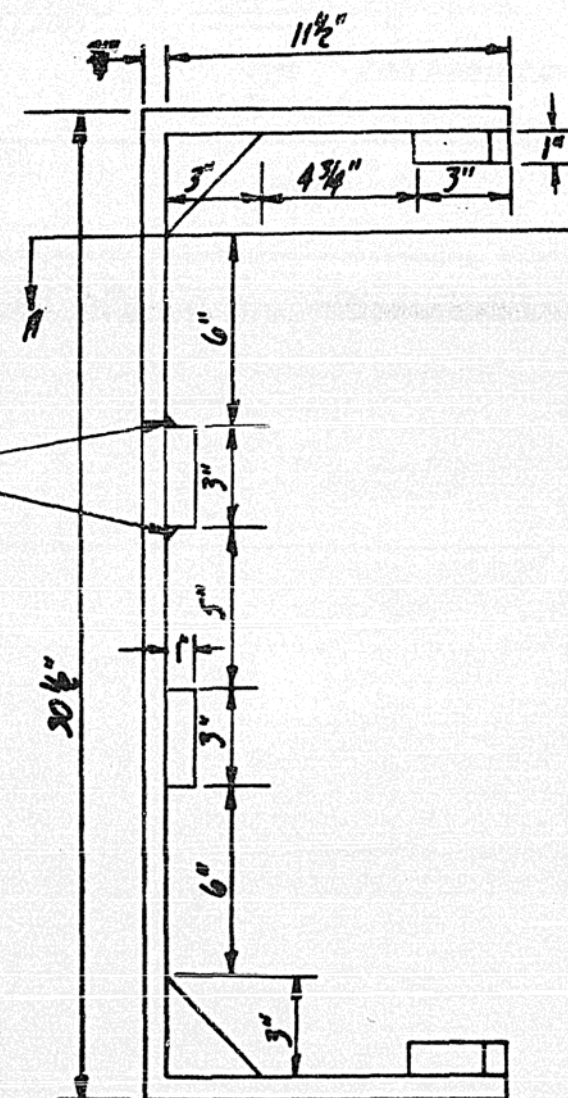

ADJUSTMENT RING

TYPICAL THERMOPLASTIC PAVEMENT LANE AND INTERSECTION MARKING SCALE: 1"=10'

ROUTE NO.	SEC.	COUNTY	TOTAL SHEETS	SHEET NO.
36	36	MACON & PIATT	38	31
FED. ROAD DIST. NO. 9 ILLINOIS			PROJECT	
* F.A.P. ROUTE 710 - SEC. 40-2-2 (3, 50-2-2 & 3) RS-2				
F.A.P. ROUTE 741 - SEC. 11-5-1, (10, 12) RS-2				

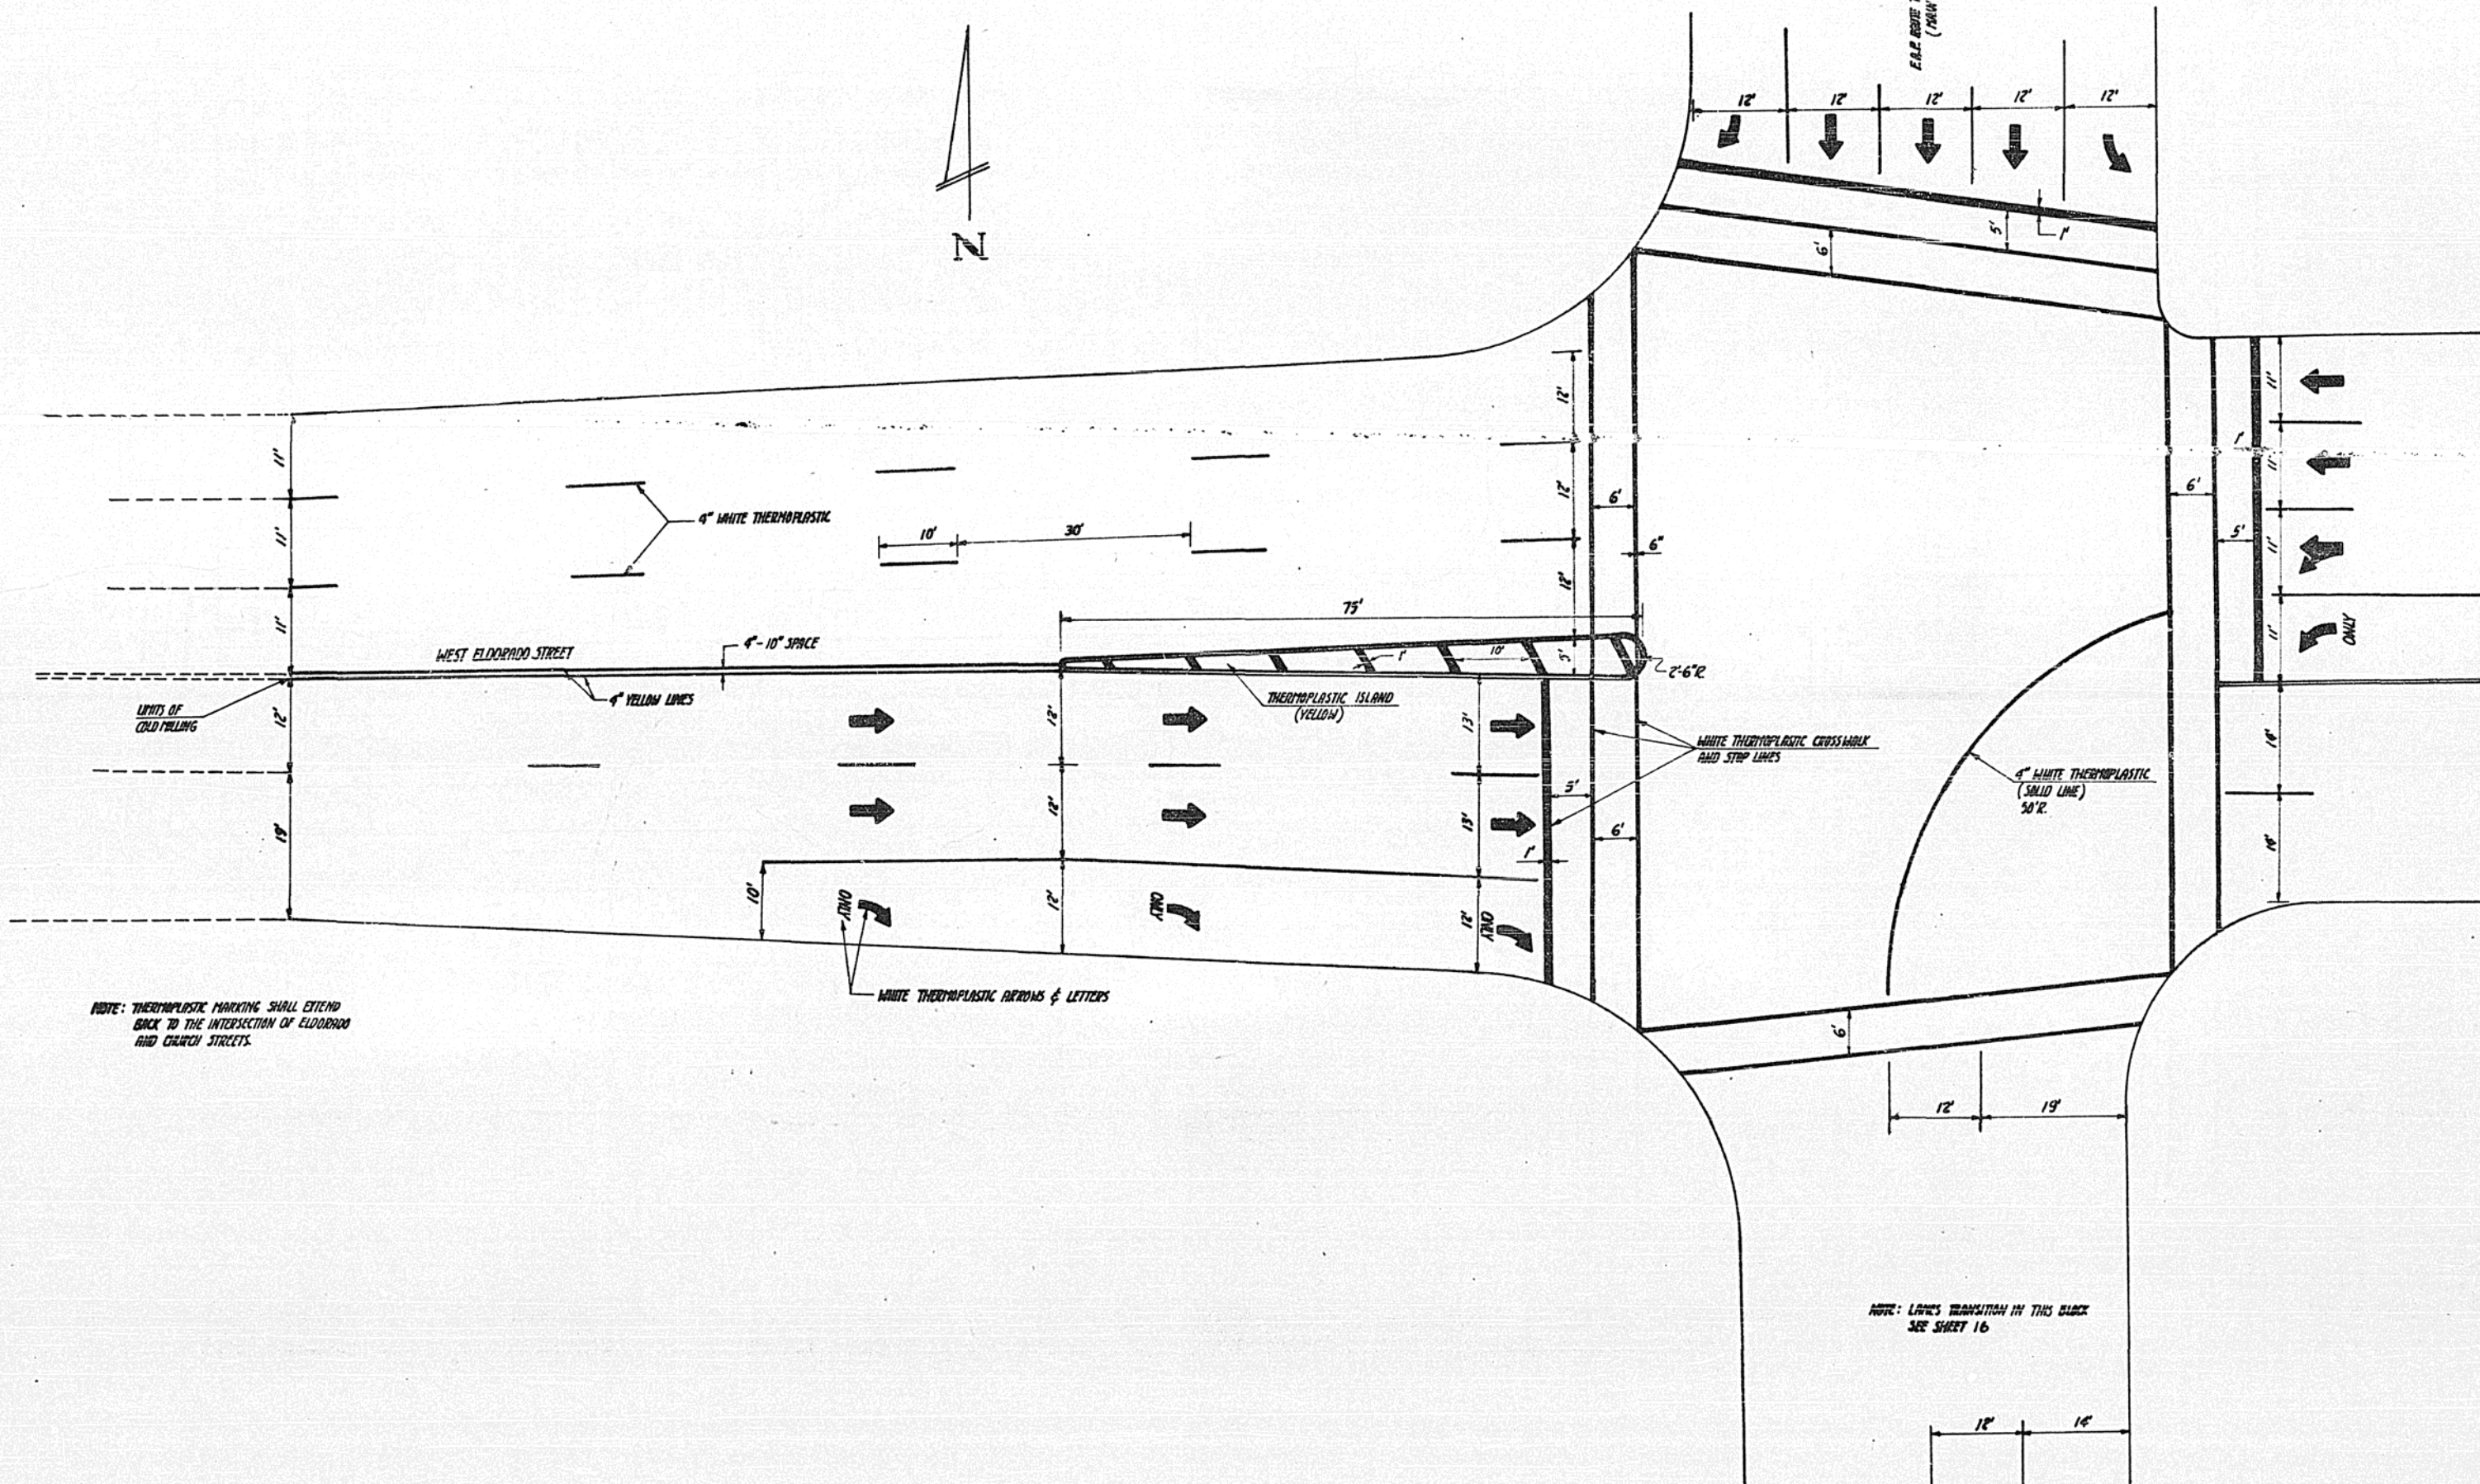

NOTE: THERMOPLASTIC MARKING SHALL EXTEND BACK TO THE INTERSECTION OF ELDORADO AND CHURCH STREETS.


NOTE: LANES TRANSITION IN THIS BLOCK SEE SHEET 16

TYPICAL THERMOPLASTIC PAVEMENT LANE AND INTERSECTION MARKING

SCALE: 1" = 10'

DATE	SECTION	COUNTY	THICK SHEETS	SHEET NO.
#	#	PARSONS & PARTN.	30	32



* P.R.P. NOTE 710 - SEC. (402-243, 502-243) RS-2
* P.R.P. NOTE 741 - SEC. 111K5-1, (A5,11) RS-2

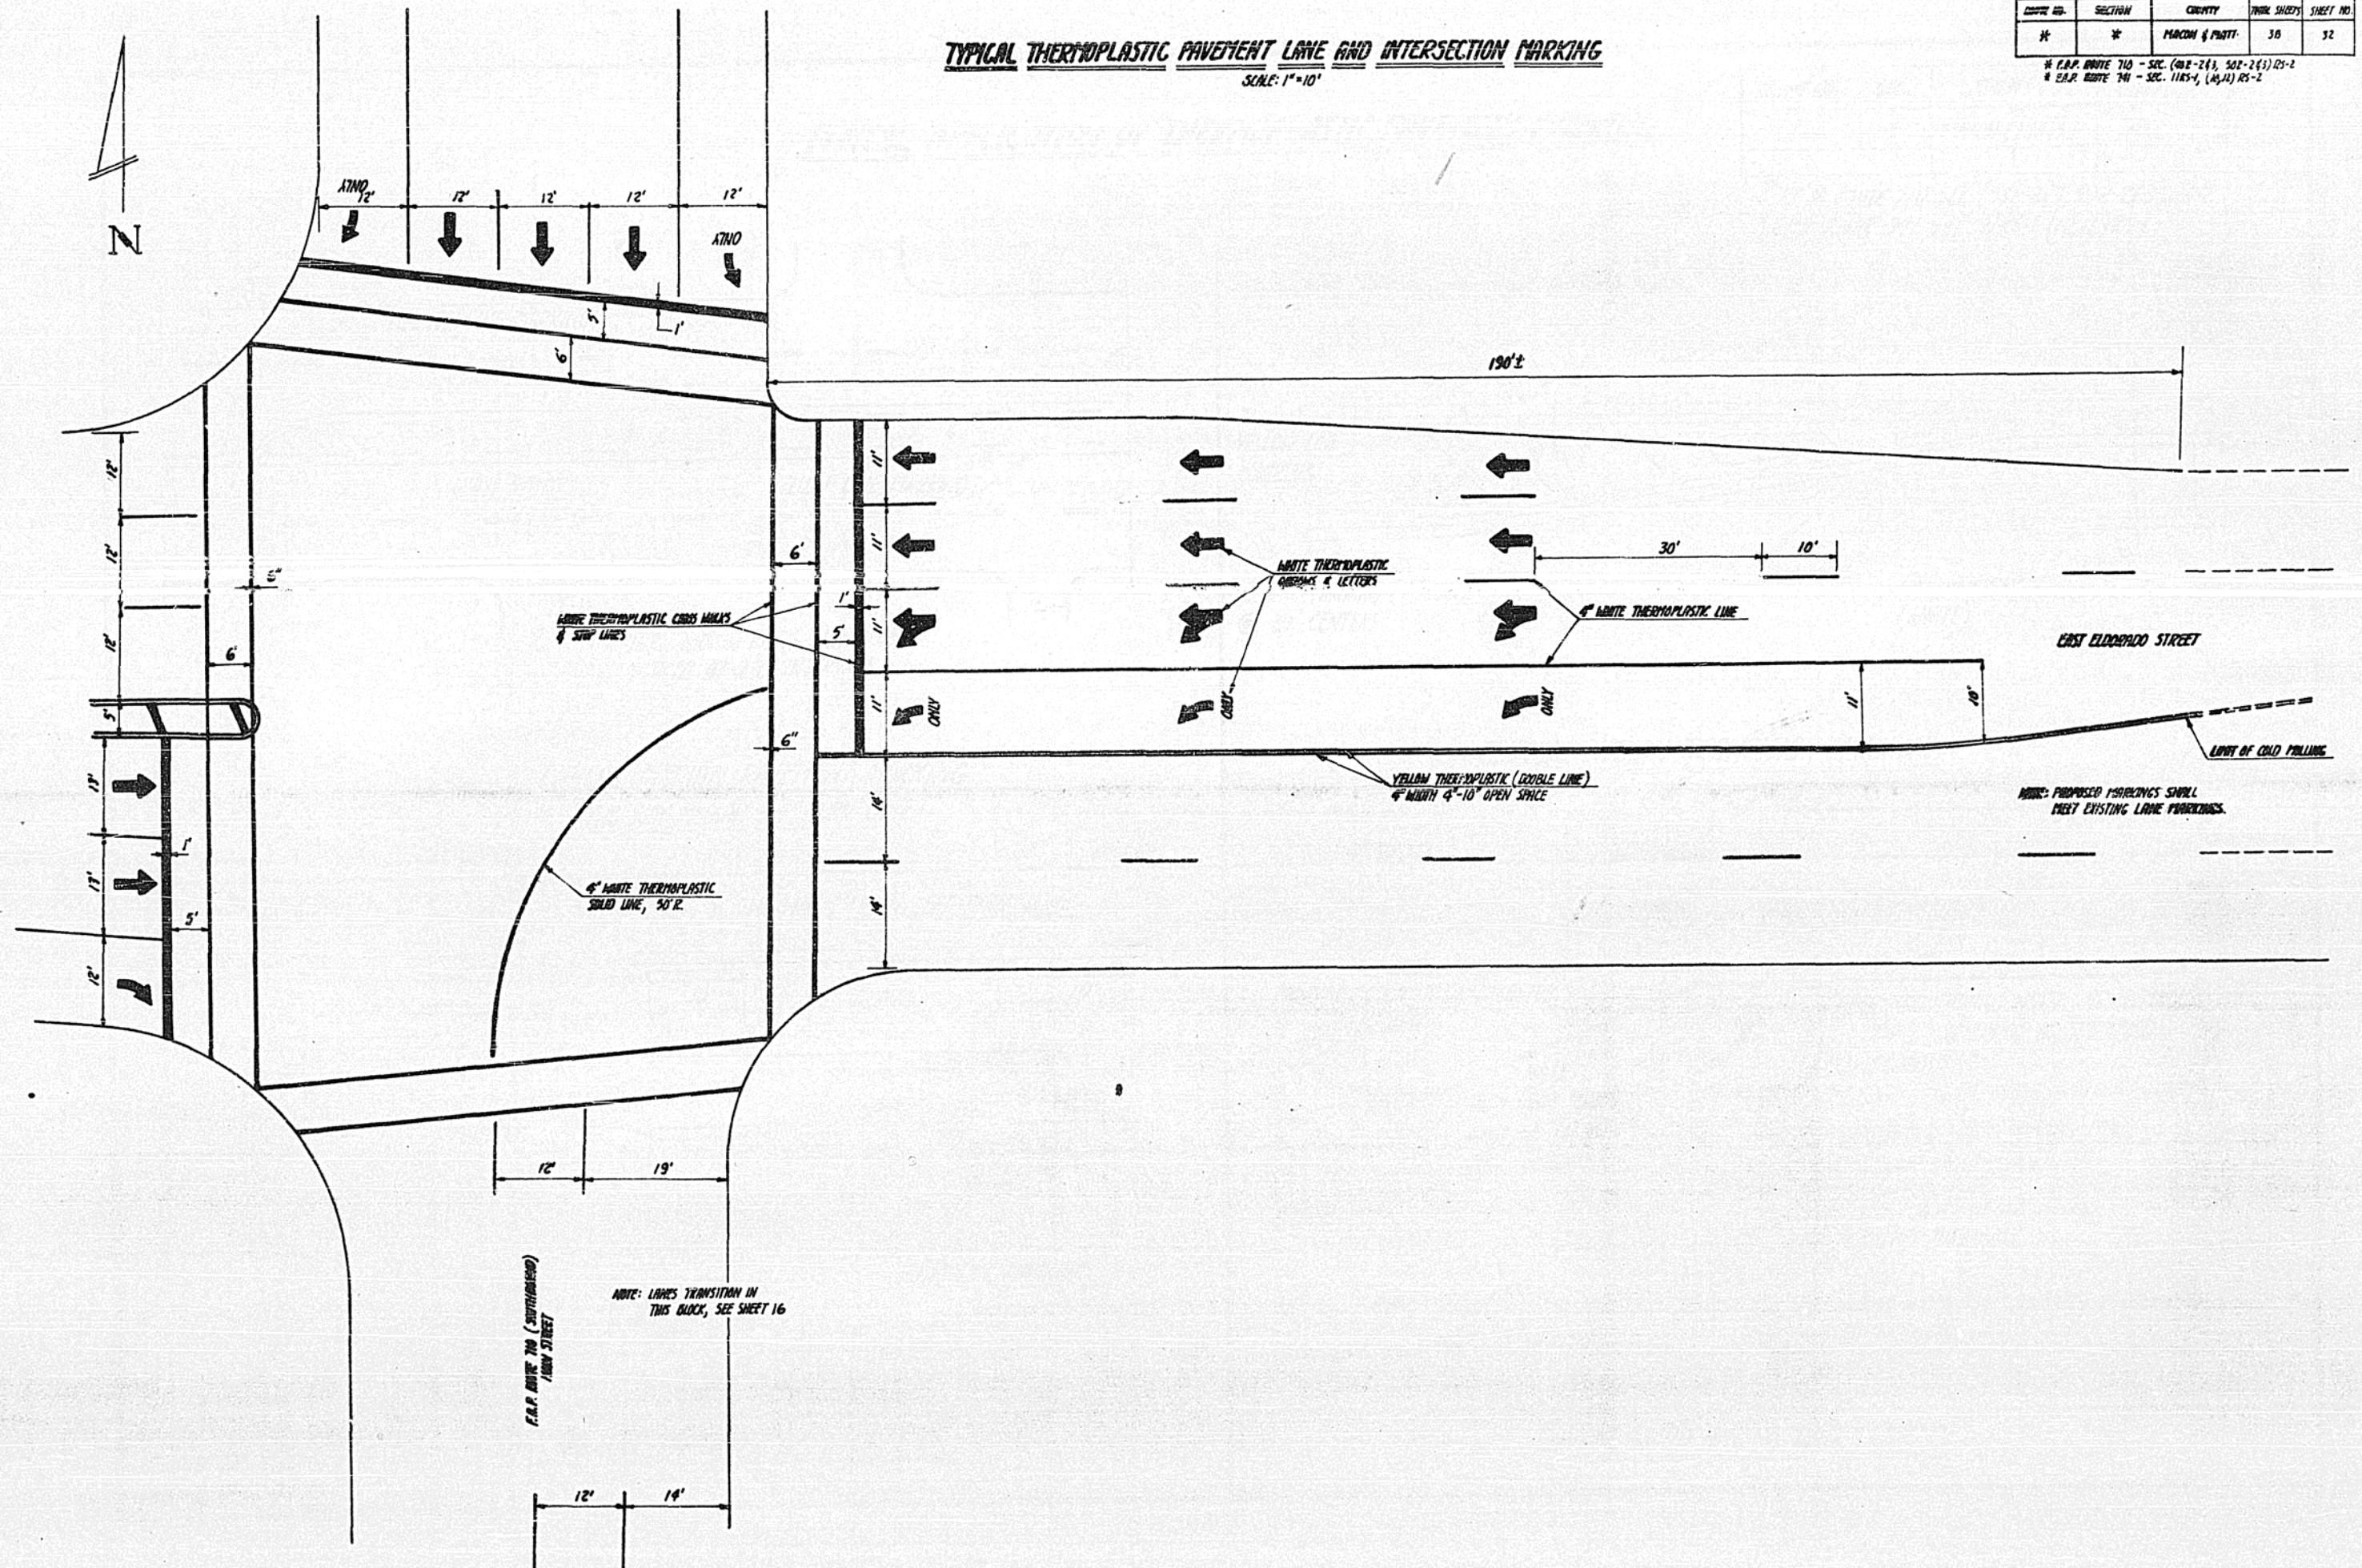

TYPICAL THERMOPLASTIC PAVEMENT LAINE & INTERSECTION MARKING

ROUTE NO.	SECTION	COUNTY	TOTAL SHEETS	SHEET NO.
#	#	MARK / PAINT	38	33


* EXH. ROUTE 70 - SEC. (40E-21), 50E-21) RS-2
 * EXH. ROUTE 74 - SEC. 11RS-1 (10/12) RS-2

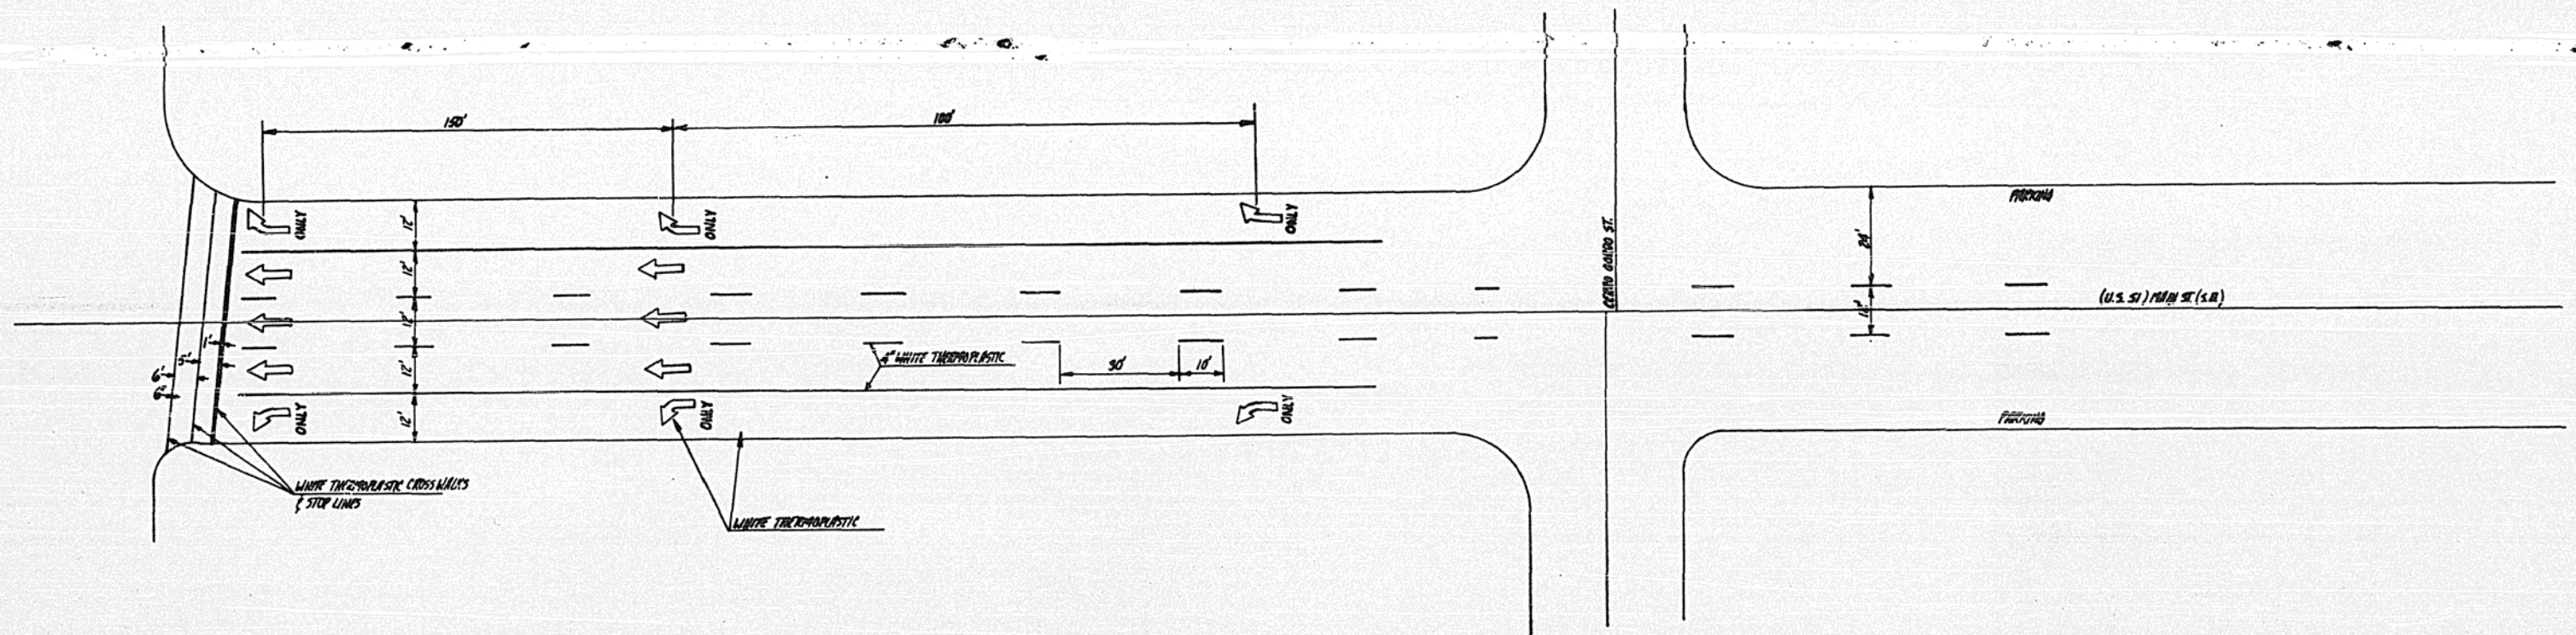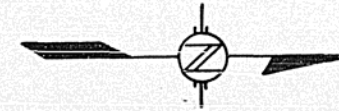

TYPICAL APPLICATION OF TRAFFIC CONTROL DEVICES FOR HIGHWAY CONSTRUCTION AND MAINTENANCE

ROUTE NO.	SECTION	COUNTY	TOTAL SHEETS	SHEET NO.
R.A. #	#	MAHON / PORT	38	35

* F.R.P. ROUTE 710 SEC. 11B-2 (1/2) 502-2/3/4/5-2
* F.R.P. ROUTE 741 SEC. 11B-1 (1/2) 85-2

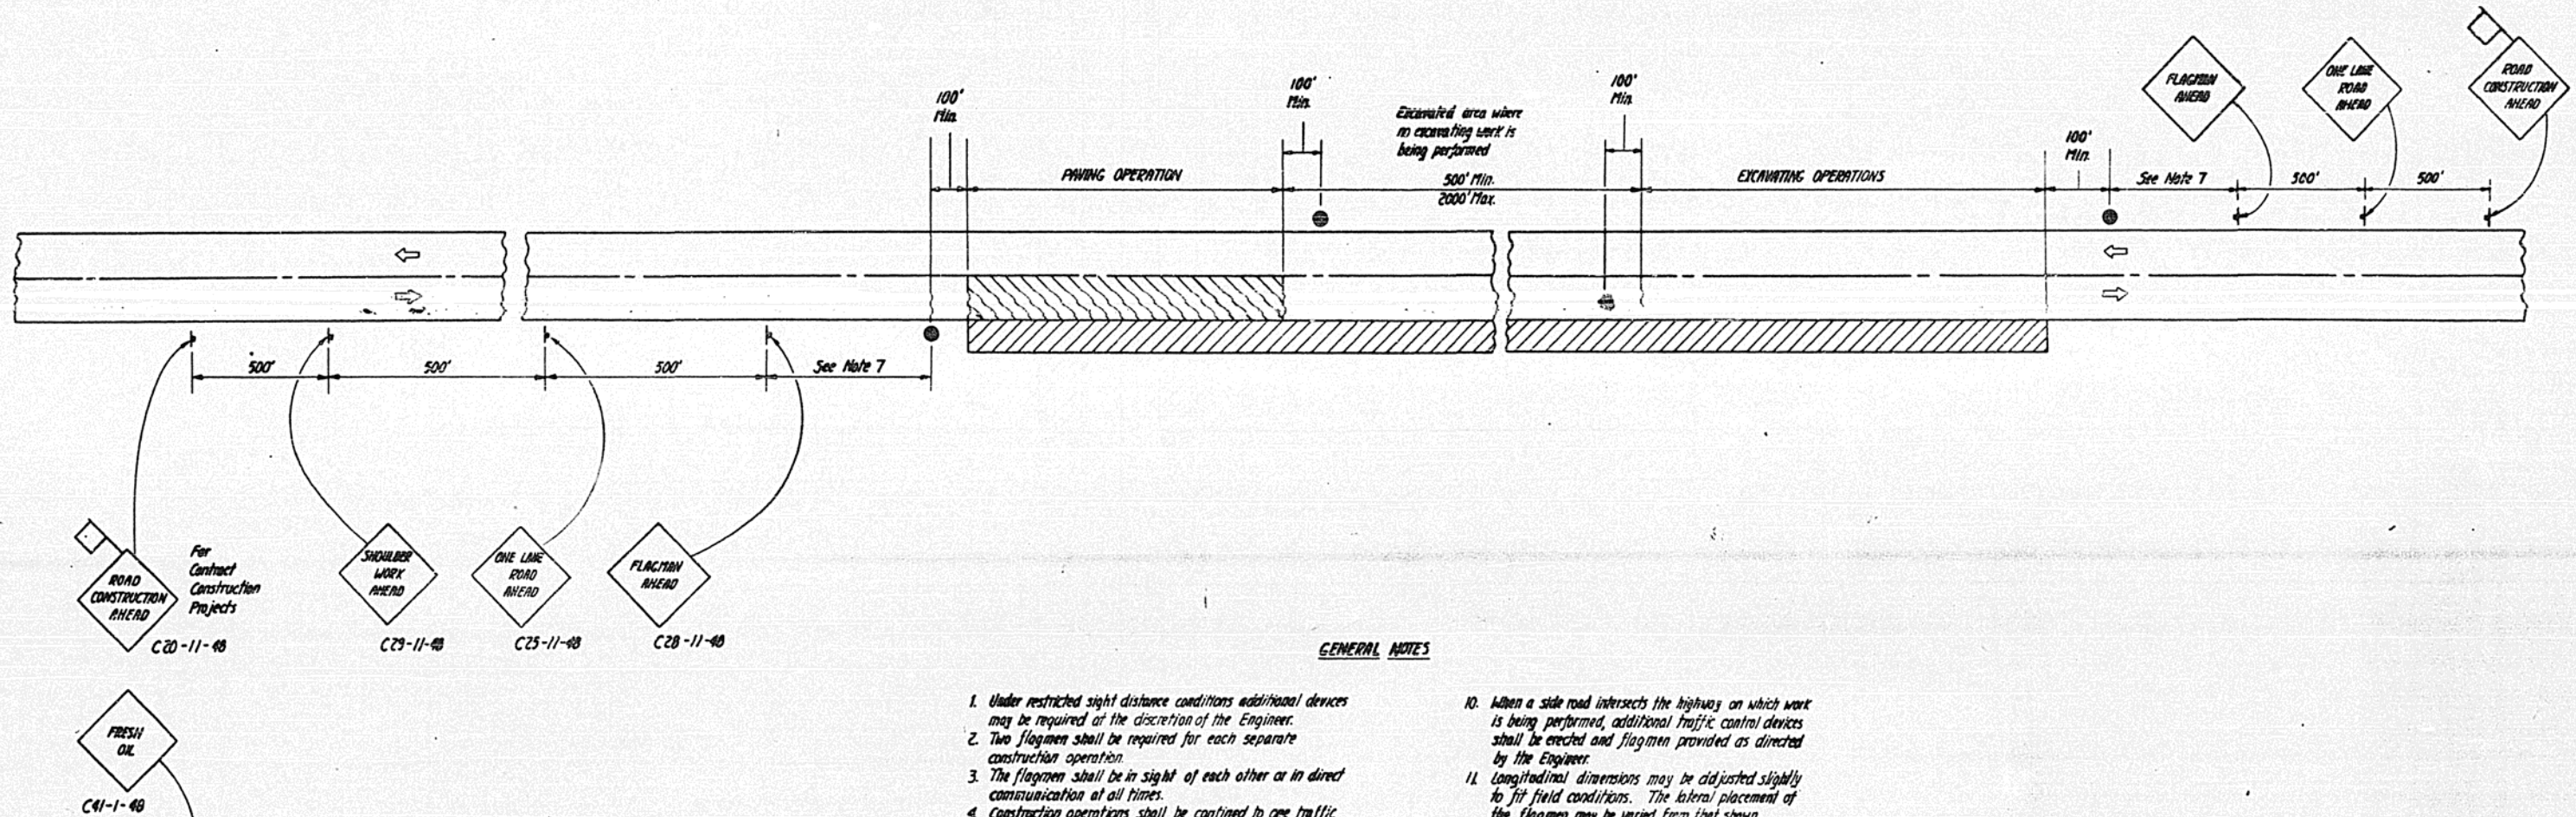

GENERAL NOTES

- Under restricted sight distance conditions additional devices may be required at the discretion of the Engineer.
- Two flagmen shall be required for each separate construction operation.
- The flagmen shall be in sight of each other or in direct communication at all times.
- Construction operations shall be confined to one traffic lane leaving the opposite lane open to traffic. At least 500 feet of both traffic lanes shall be available for traffic movement at intervals not greater than 1000 ft.
- No paving or excavating operations shall be performed at night unless authorized by the Engineer.
- When these operations are suspended, all vehicles and equipment, including traffic control and protective devices, shall be removed from the pavement and the excavated area shall be protected by Type I or Type II Barricades at 100 foot centers. ROAD CONSTRUCTION AHEAD AND SHOULDER WORK AHEAD signs shall be installed as shown to protect the curing operations. ROAD CONSTRUCTION AHEAD and ROAD CONSTRUCTION 500 FT. signs shall be installed for traffic in the opposite direction.
- Minimum distance is 200 ft. Maximum distance to be determined by the Engineer but in no case to exceed the length of 1/4 day's operation.
- All signs shall be post mounted if the working time exceeds four days.
- High intensity flashing lights shall be used on each approach in advance of the work area during hours of darkness and installed above the first two signs in each series.
- When a side road intersects the highway on which work is being performed, additional traffic control devices shall be erected and flagmen provided as directed by the Engineer.
- Longitudinal dimensions may be adjusted slightly to fit field conditions. The lateral placement of the flagmen may be varied from that shown.
- All warning signs shall have minimum dimensions of 48 in. by 36 in. and have black legend and border on an orange reflectorized background.
- All vehicles, equipment, men (except flagmen) and their activities are restricted at all times to one side of the pavement unless otherwise authorized by the Engineer.
- All barricade lights shall be monodirectional.
- Form BT 725 is required.
- At locations where construction operations result in a differential in elevation between the edge of pavement and the shoulders exceeding 3 inches, Type I or Type II barricades shall be placed at one hundred foot centers. If this condition is to exist during night time hours, barricades shall be equipped with monodirectional steady-burning lights. Cones may be substituted for barricades at half the spacing during daytime excavation operations.

CASE VI

RURAL MOVING OPERATIONS DAY OPERATIONS ONLY

Where, at any time, any vehicle, equipment, men or their activities require an intermittent or continuous moving operation on the pavement where the average speed of movement is less than four miles per hour.




SYMBOLS

- Work Area
- Sign with 18"x18" (minimum) orange flag attached
- Sign on portable or permanent support
- Flagman with Traffic Control sign
- Type I or Type II Barricade with steady burning light

TRAFFIC CONTROL AND PROTECTION (SPECIAL)
F.R.P. ROUTE 710 (US 51) SOUTH BOUND LANE

ROUTE NO.	SECTION	COUNTY	TOTAL SHEETS	SHEET NO.
710	2	PARSONS & ARMITT	38	36



* F.R.P. ROUTE 710, (US ROUTE 51) SEC. (2-2, 3, 502-2, 3) 45-2
* K.B.A. ROUTE 710, (IL. ROUTE 125) SEC. 11/25-1 (10, 12) 45-2

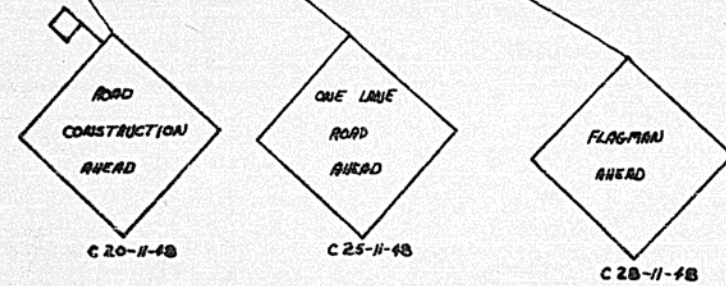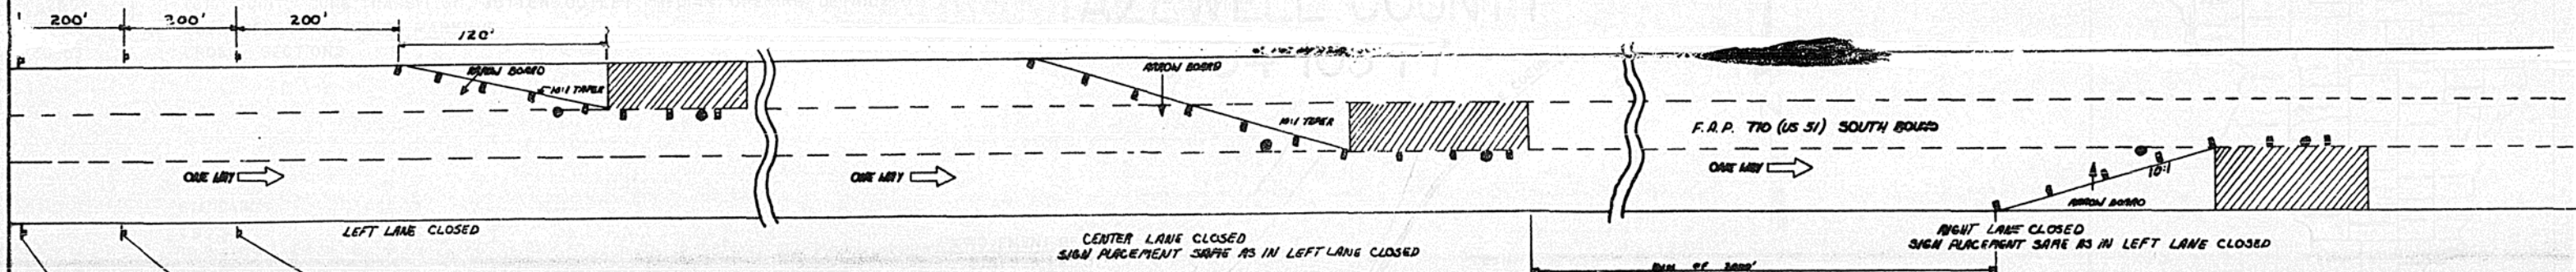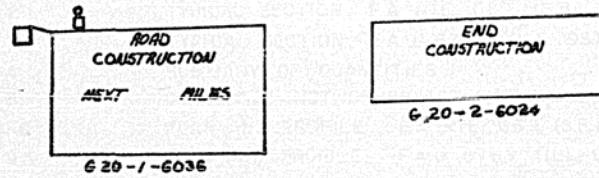

GENERAL NOTES

1. THE 10:1 TAPER SHALL BE FORMED BY PLACING ONE CONE FOR EACH FOOT OF LANE WIDTH OR A DRAPE OR BARRICADE FOR EACH TWO FEET OF LANE WIDTH UNLESS NOTED ON PLANS.
2. TYPE I OR TYPE II BARRICADES WITH STEADY BURNING LIGHTS SHALL BE USED IN LIEU OF CONES OR DRAPES FOR NIGHT OPERATIONS.
3. FOR OPERATIONS WITHIN AN INTERSECTION, TRAFFIC CONTROL PLANS SHALL BE APPROVED BY THE ENGINEER.
4. WHERE THE WORK AREA EXTENDS THROUGH THE INTERSECTION, BARRICADES AND ADEQUATE WARNING SIGNS SHALL BE ERECTED ON THE CROSS STREET.
- 4A. IF THE WORK AREA IS IN THE PARKING LANE AND PARKING EXISTS DURING WORK HOURS A ROAD CONSTRUCTION AHEAD SIGN SHALL BE INSTALLED 200 FT. IN ADVANCE OF THE WORK AREA AND THE AREA PROTECTED WITH CONES OR BARRICADES.
5. A MINIMUM OF ONE LANE TRAFFIC SHALL BE MAINTAINED AT ALL TIMES.
6. EACH WORK LOCATION SEPARATED BY 200 FT. OR MORE REQUIRES A FLAGMAN LOCATED NOT MORE THAN 100 FT. BEHIND MACHINES.
7. A ROAD CONSTRUCTION NEXT-MILE SIGN SHALL BE POST MOUNTED 1500 FT. PRECEDING THE JOB. (ONE SIGN EACH SIDE OF STREET)
8. WHEN TAPER CLOSING A LANE OR LANES ARE SEPARATED FROM THE WORK AREA BY 1500 TO 2000 FT. INTERVAL OR THEREON, THE TAPER SHALL BE MOVED FORWARD.
9. HIGH INTENSITY FLASHING LIGHT SHALL BE USED ON EACH ROAD CONSTRUCTION NEXT-MILE.
10. ALL WARNING SIGNS SHALL HAVE BLACK LEGEND AND BORDER ON ORANGE REFLECTORIZED BACKGROUND WHEN POSTED SPEED LIMIT IS 35, OR 40 MPH ALL WARNING SIGNS SHALL HAVE MINIMUM DIMENSIONS OF 18 IN. BY 48 IN.
11. ALL VEHICLES, EQUIPMENT, MEN (EXCEPT FLAGMAN) AND THEIR ACTIVITIES ARE RESTRICTED AT ALL TIMES TO ONE LANE OF TRAVEL, UNLESS THE CENTER AND LEFT LANE ARE BOTH CLOSED, UNLESS AUTHORIZED BY THE ENGINEER.
12. FORM 87-725 IS REQUIRED WHEN TRAVEL LANE IS CLOSED AT NIGHT.
13. ALL TRAFFIC CONTROL WORK WILL BE PAID FOR AT THE CONTRACT UNIT PRICE PER LUMP SUM FOR TRAFFIC CONTROL AND PROTECTION. (SPECIAL)

SYMBOLS

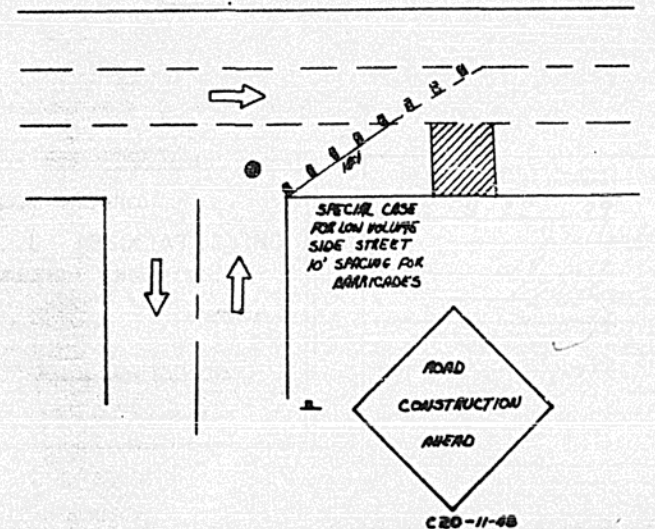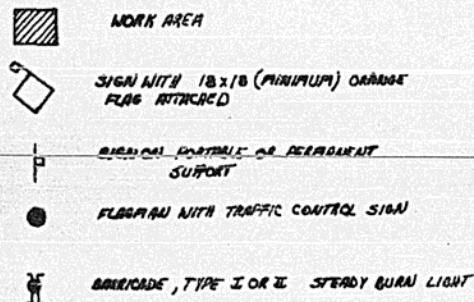


ROUTE NO.	SECTION	COUNTY	TOTAL SHEETS	SHEET NO.
4	*	PORTLAND	38	37

* E.A.P. ROUTE 700 (U.S. ROUTE 51) SEC. 4 (AZ-2/3, SEC. 7/8) RS-2
 * E.A.P. ROUTE 741 (U.S. ROUTE 105) SEC. 10 (AZ-2/3, SEC. 7/8) RS-2

TRAFFIC CONTROL AND PROTECTION (SPECIAL)

TYPICAL TRAFFIC CONTROL FOR SIDE STREET INTERSECTIONS

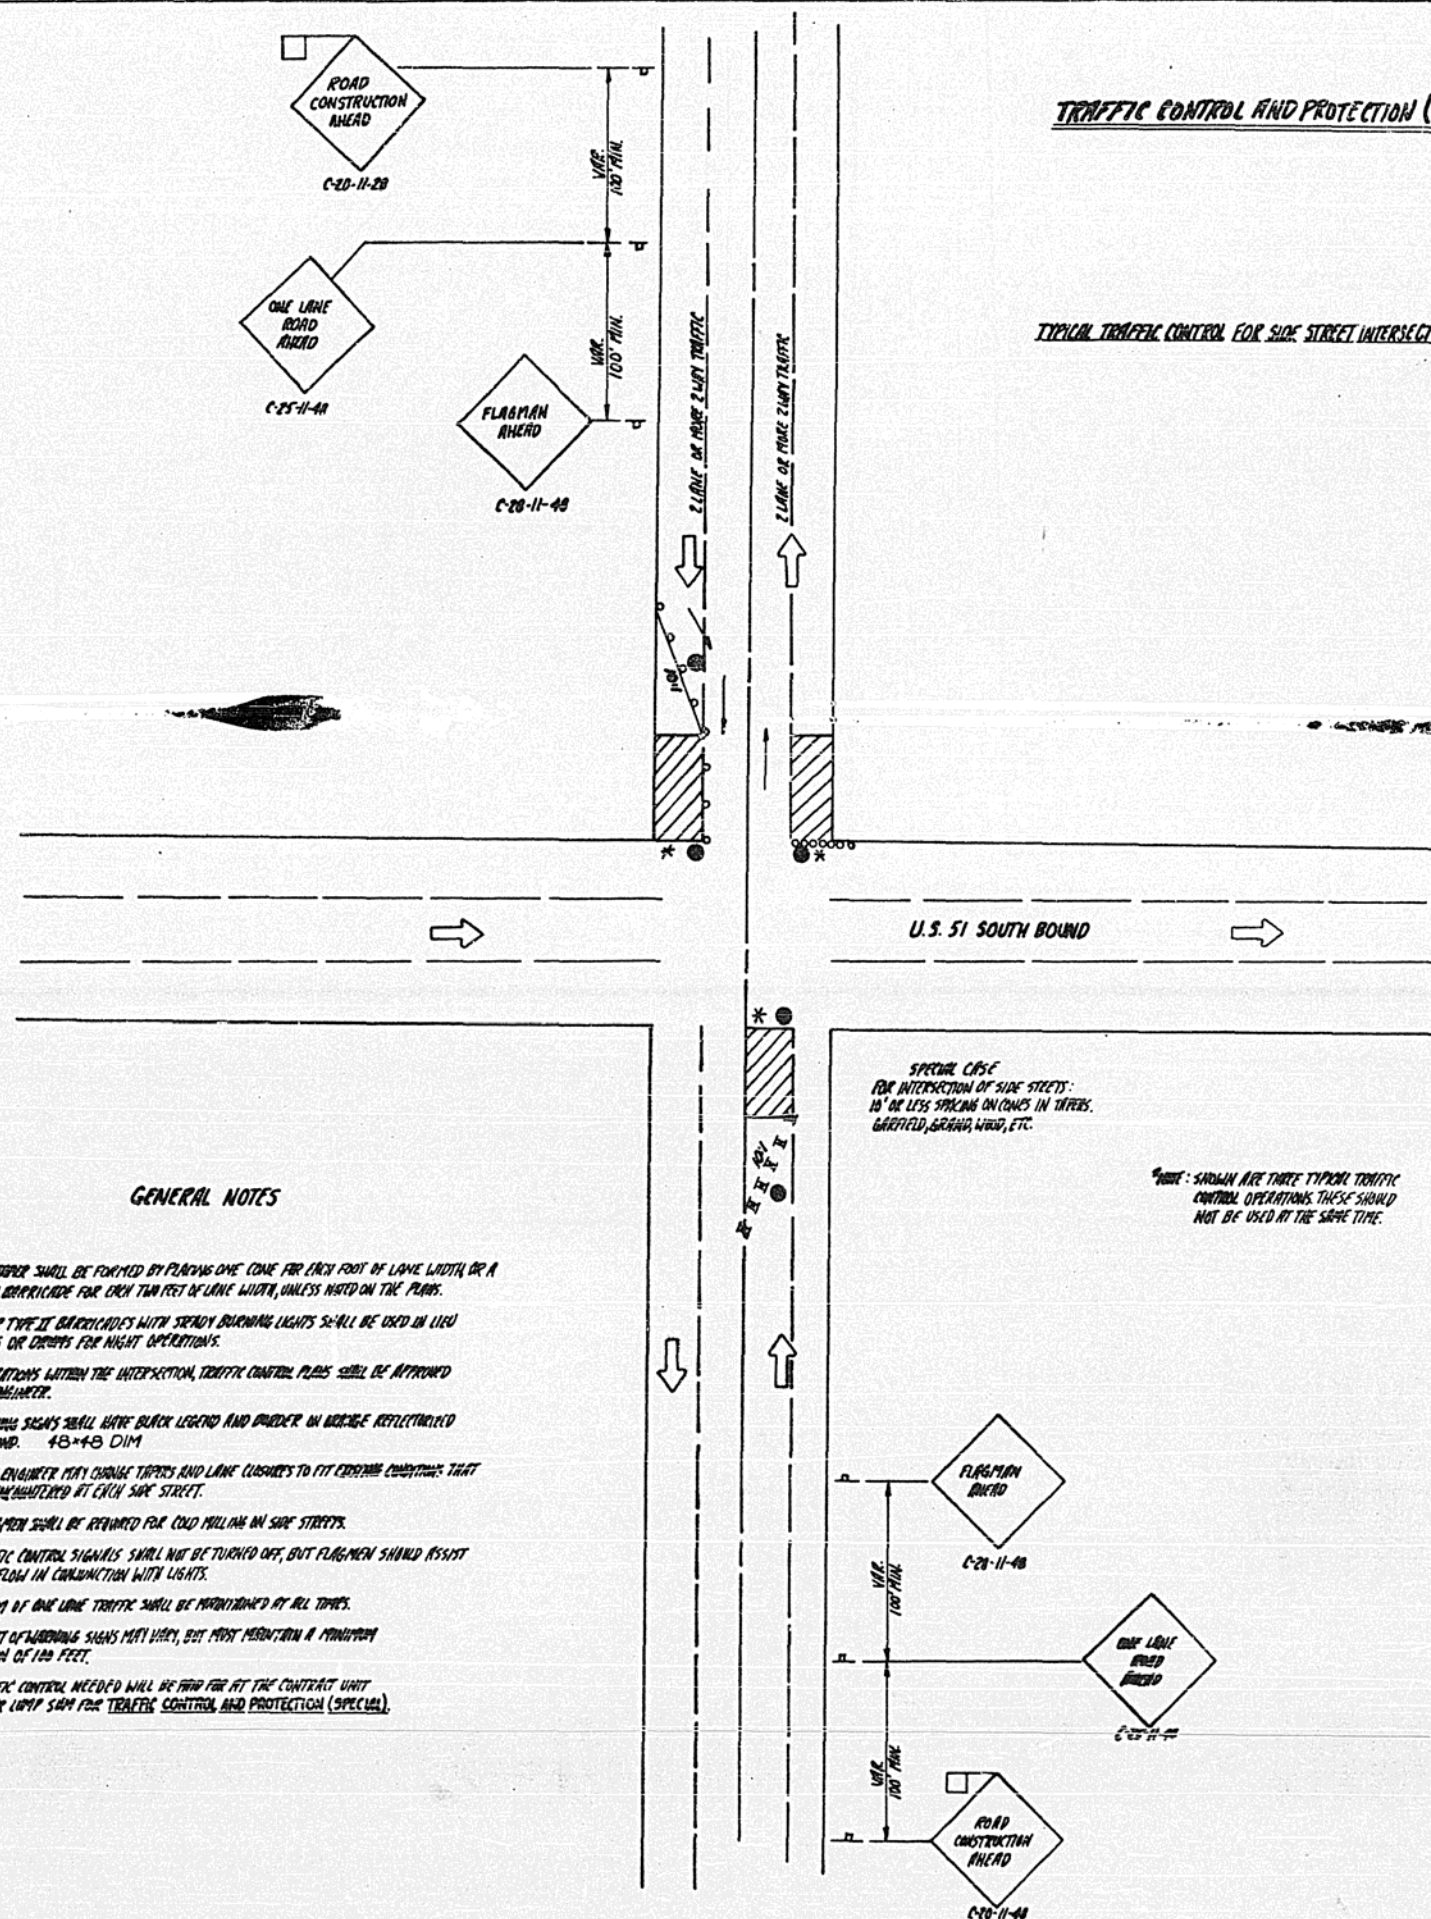

GENERAL NOTES

1. THE WORK AREA SHALL BE FORMED BY PLACING ONE CONE FOR EACH FOOT OF LANE WIDTH OR A GROUP OF BARRICADES FOR EACH TWO FEET OF LANE WIDTH, UNLESS NOTED ON THE PLANS.
2. TYPE I OR TYPE II BARRICADES WITH STROBY BURNING LIGHTS SHALL BE USED IN LIEU OF CONES OR GROUPS FOR NIGHT OPERATIONS.
3. FOR OPERATIONS WITHIN THE INTERSECTION, TRAFFIC CONTROL PLANS SHALL BE APPROVED BY THE ENGINEER.
4. ALL WARNING SIGNS SHALL HAVE BLACK LETTERS AND BORDERS ON ORANGE REFLECTORIZED BACKGROUND. 48" X 48" DIM.
5. RESIDENT ENGINEER MAY CHANGE TYPES AND LANE CLOSURES TO FIT EXISTING CONDITIONS THAT MAY BE ENCOUNTERED AT EACH SIDE STREET.
6. TWO FLAGMEN SHALL BE REQUIRED FOR COLD MILLING ON SIDE STREETS.
7. THE TRAFFIC CONTROL SIGNALS SHALL NOT BE TURNED OFF, BUT FLAGMEN SHOULD ASSIST TRAFFIC FLOW IN CONJUNCTION WITH LIGHTS.
8. A MINIMUM OF ONE LANE TRAFFIC SHALL BE MAINTAINED AT ALL TIMES.
9. PLACEMENT OF WARNING SIGNS MAY VARY, BUT MUST MAINTAIN A MINIMUM SEPARATION OF 100 FEET.
10. ALL TRAFFIC CONTROL NEEDED WILL BE SHOWN FOR AT THE CONTRACT UNIT PRICE PER LUMP SUM FOR TRAFFIC CONTROL AND PROTECTION (SPECIAL).

SYMBOLS


- Sign with 18" x 18" (min.) orange flag attached
- Work area
- Sign on portable or permanent support
- Flagman with traffic control sign
- Type I or Type II barricade with stroby burning light
- Safety cone or barrel

SPECIAL CASE
 FOR INTERSECTION OF SIDE STREETS:
 10' OR LESS SPACING ON CONES IN TURNS,
 GRAVELLED, GRAVEL, WIND, ETC.



NOTE: SHOWN ARE THREE TYPICAL TRAFFIC
 CONTROL OPERATIONS. THESE SHOULD
 NOT BE USED AT THE SAME TIME.

ROUTE NO.	SECTION	COUNTY	TOTAL SHEETS	SHEET NO.
* 11	*	ARIZONA	38	38





* F.R.P. ROUTE 110 (U.S. ROUTE 51 SB LANE) SEC. 9BZ-2(3), 20Z-2(3), 25Z-2
 ** F.R.P. ROUTE 110 (U.S. ROUTE 105) SEC. 11AS-1(12), 15-2

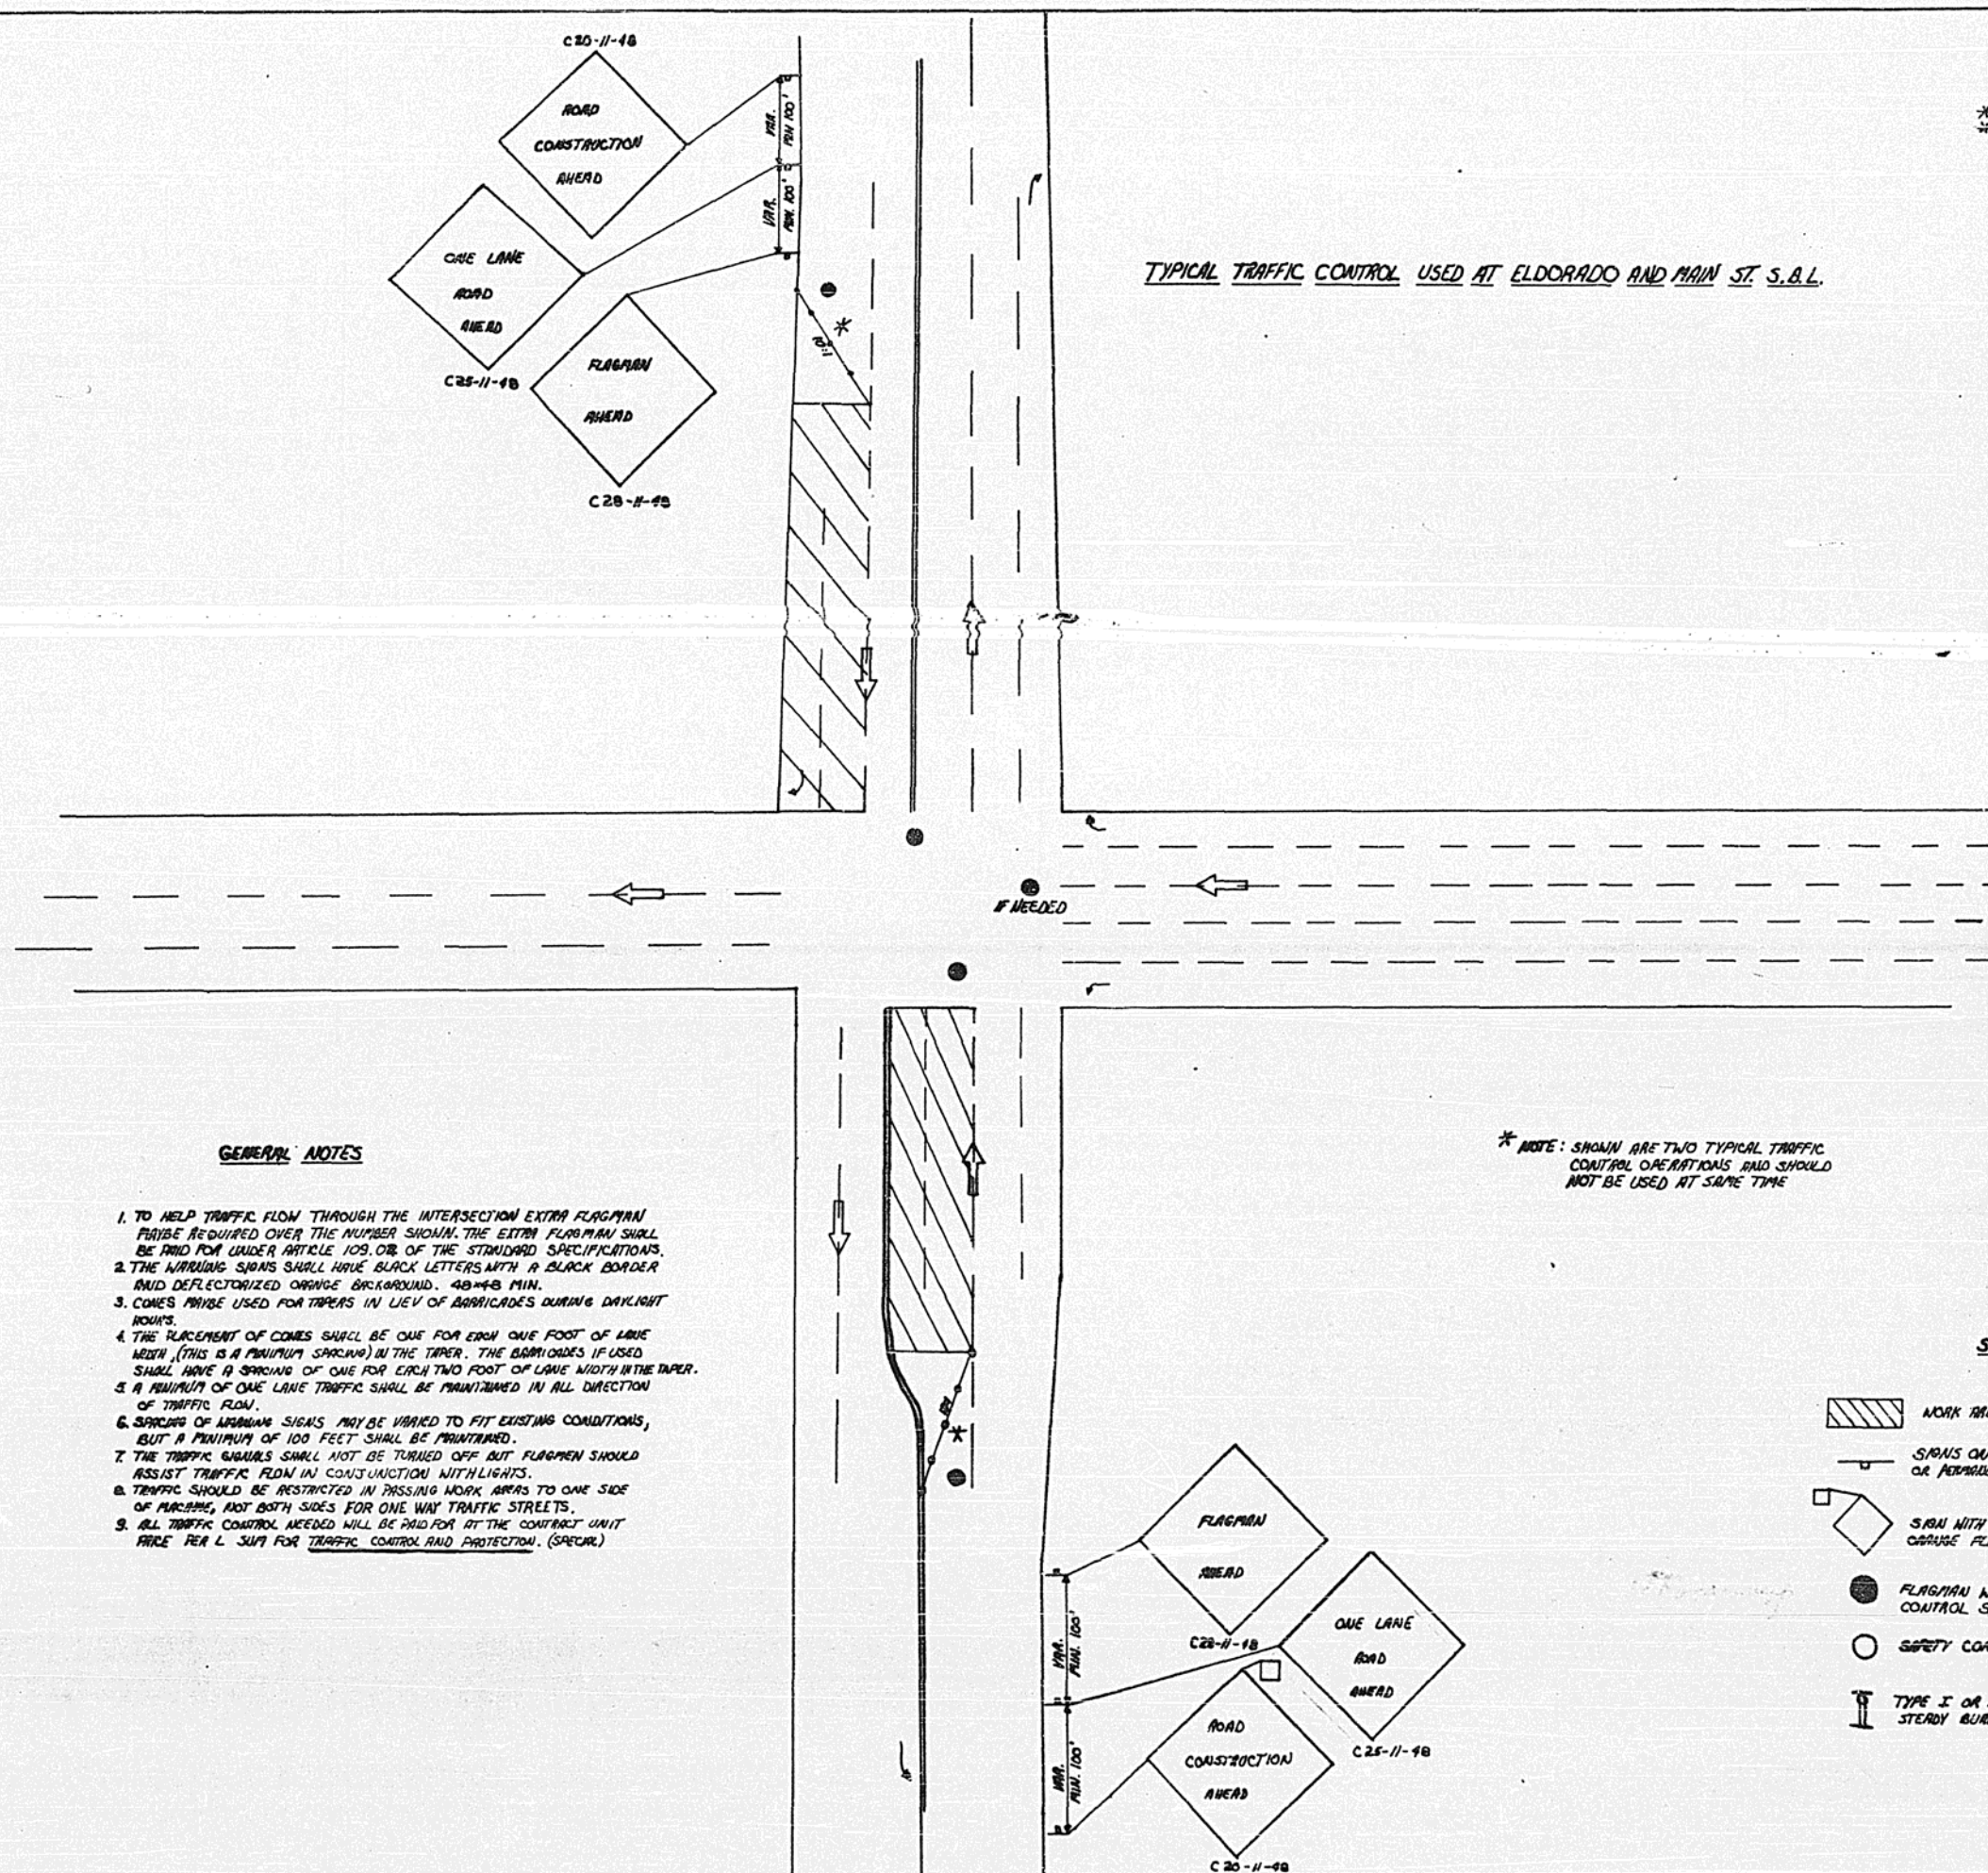

STANDARD DESIGN P.C.C. PATCHING DETAILS

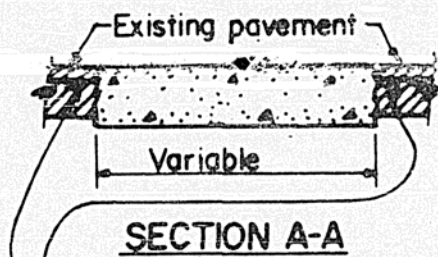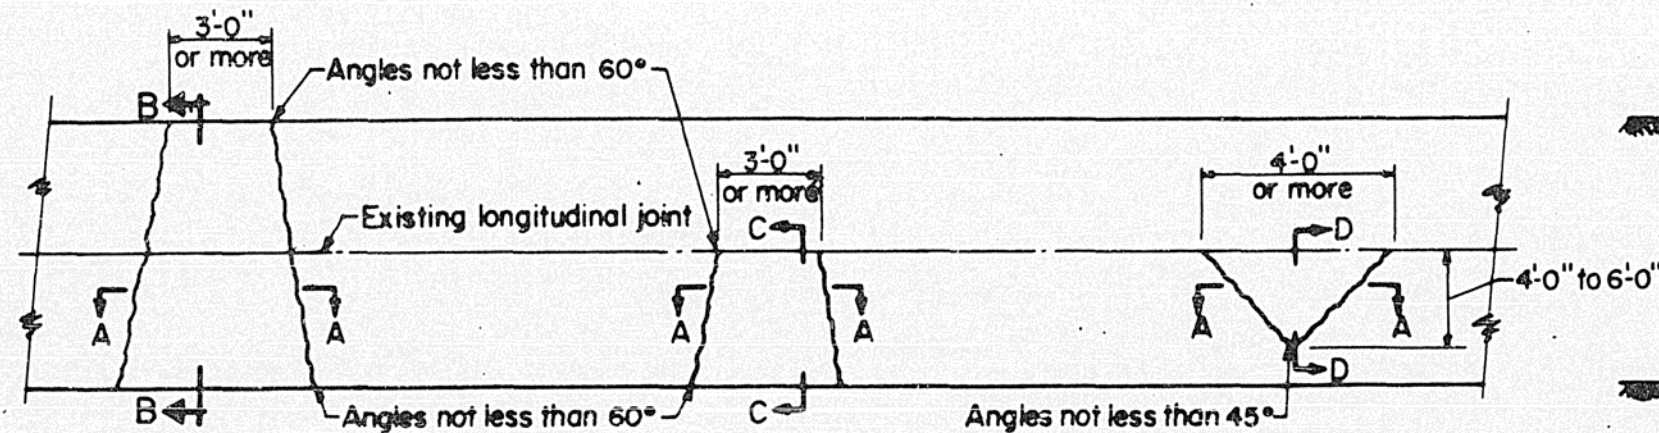

Existing marginal bars or pavement reinforcement to be cut at the patch face in the scoring operation.

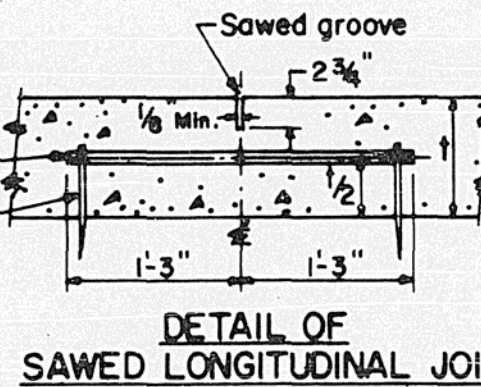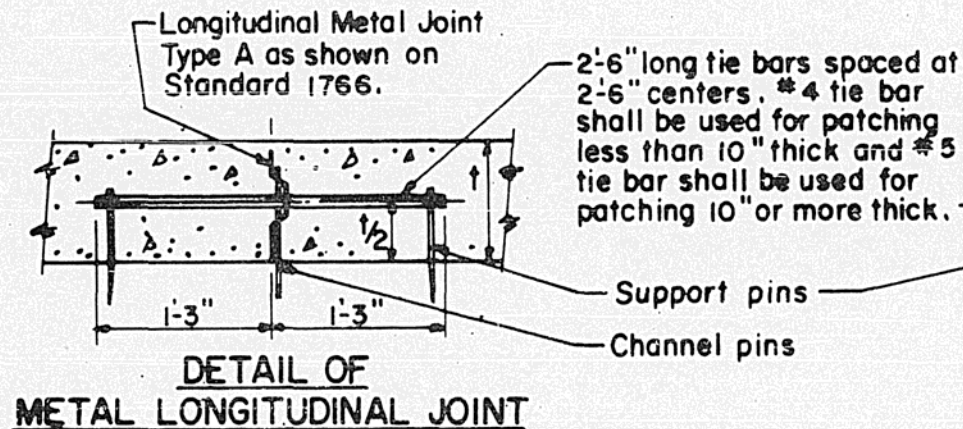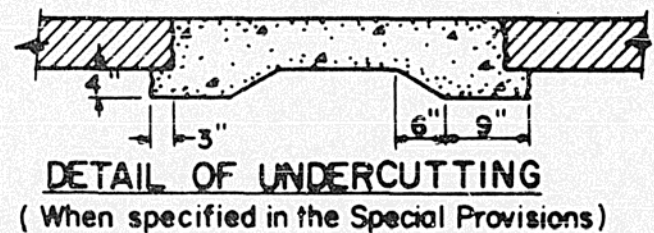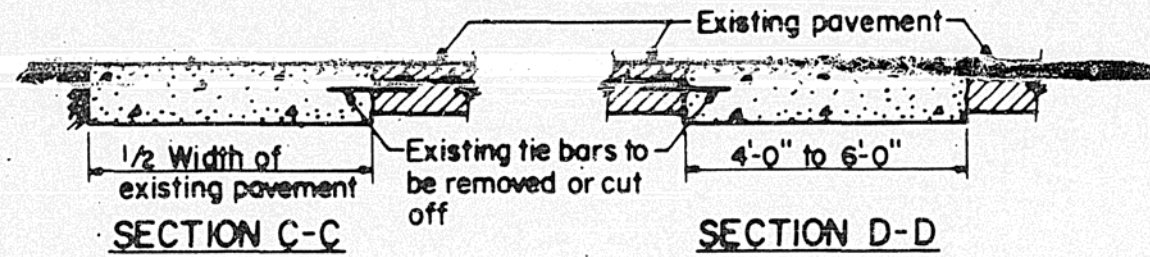

NOTES

DETAIL OF SAWED CONTRACTION JOINT

- For thickness of patches see special provisions or summary of quantities.
- CONTRACTION JOINTS:** When the patched pavement is not to be resurfaced, transverse contraction joints shall be sawed in all 20-foot, or longer, patches:
- At approximate 15 to 20-foot centers,
 - In prolongation of existing contraction or construction joints in the adjacent lane,
 - In accordance with the procedures specified in Art. 408.12 (c) of the Standard Specifications,
 - And be sealed in accordance with Articles 408.02 (h) and 408.17 (a) of the Standard Specifications.
- Where expansion joints exist in the portion of pavement to remain in place, the adjacent new pavement shall provide the same width and type of joint and joint filler in prolongation with the existing joint.

STATE OF ILLINOIS DEPARTMENT OF TRANSPORTATION		ISSUED 8-12-54	
PASSED <u>Jan 8</u> 1976		REVISIONS	
<u>W.E. Hemming</u> Engineer of Design Operations		W.F.	12-9-66
APPROVED <u>Jan 8</u> 1976		D.W.W.	1-8-76
<u>Thomas B. Bright</u> Engineer of Design			

STANDARD 2116-2

(1/4 Size)



Redrawn W.F.

C-75.6 g


STANDARD DESIGN

BITUMINOUS PATCHING DETAILS


NOTE
For thickness of patches see special provisions or the summary of quantities.

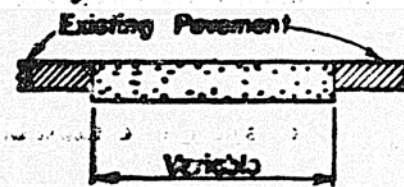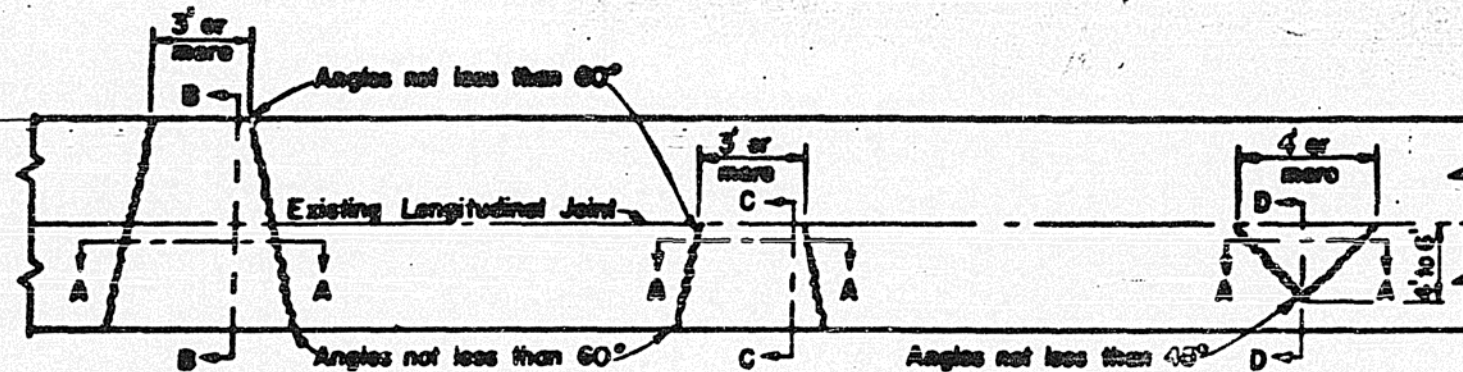


SECTION A-A

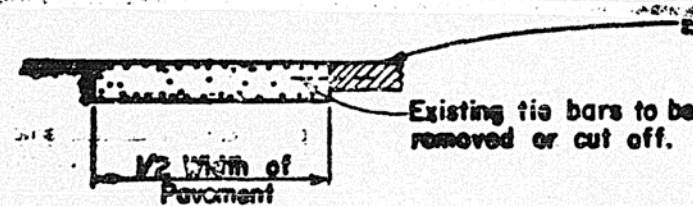



SECTION C-C

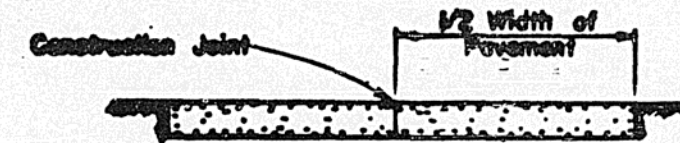


SECTION B-B
(Built in two operations)

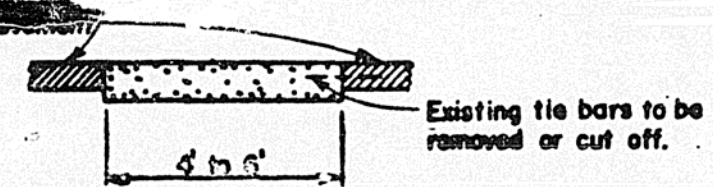


SECTION D-D

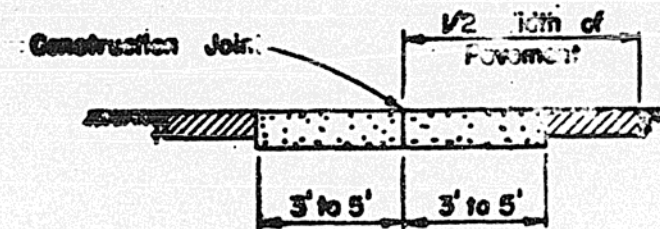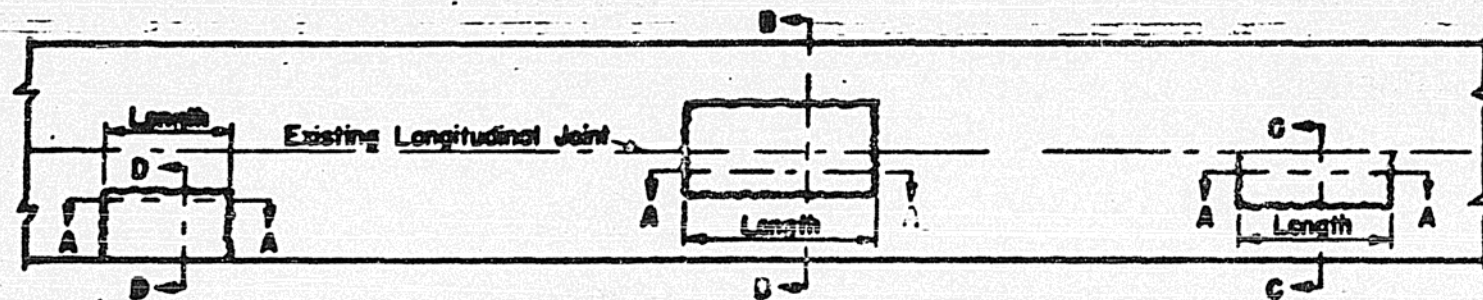


SECTION B-B
(Built in two operations)

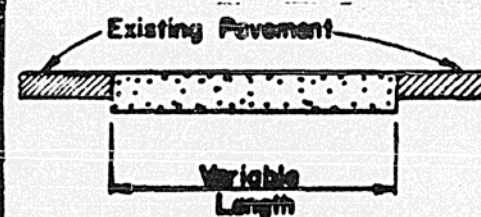

SECTION A-A

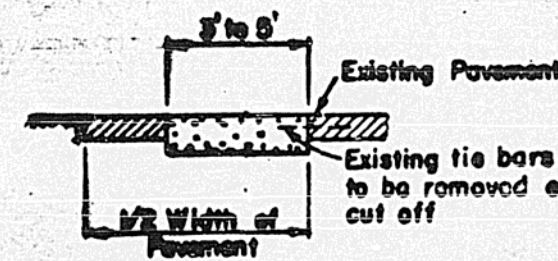

SECTION C-C

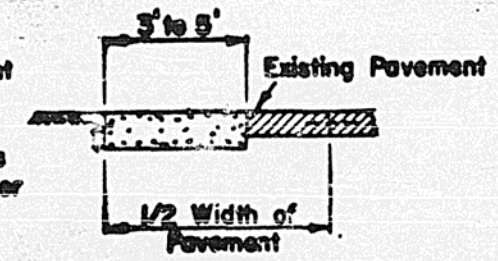

SECTION D-D

STATE OF ILLINOIS
DEPARTMENT OF PUBLIC WORKS AND BUILDINGS
DIVISION OF HIGHWAYS

DESIGNED BY Dec. 9, 1966
A. V. Vondruschall
ENGINEER OF ROAD PLANS AND CONTRACTS

APPROVED BY Dec. 9, 1966
W. E. Baumann
ENGINEER OF DESIGN


ISSUED 10-29-54

REVISIONS

WF 12-9-66

STANDARD 2117-1

STANDARD DESIGN MAILBOX TURNOUT

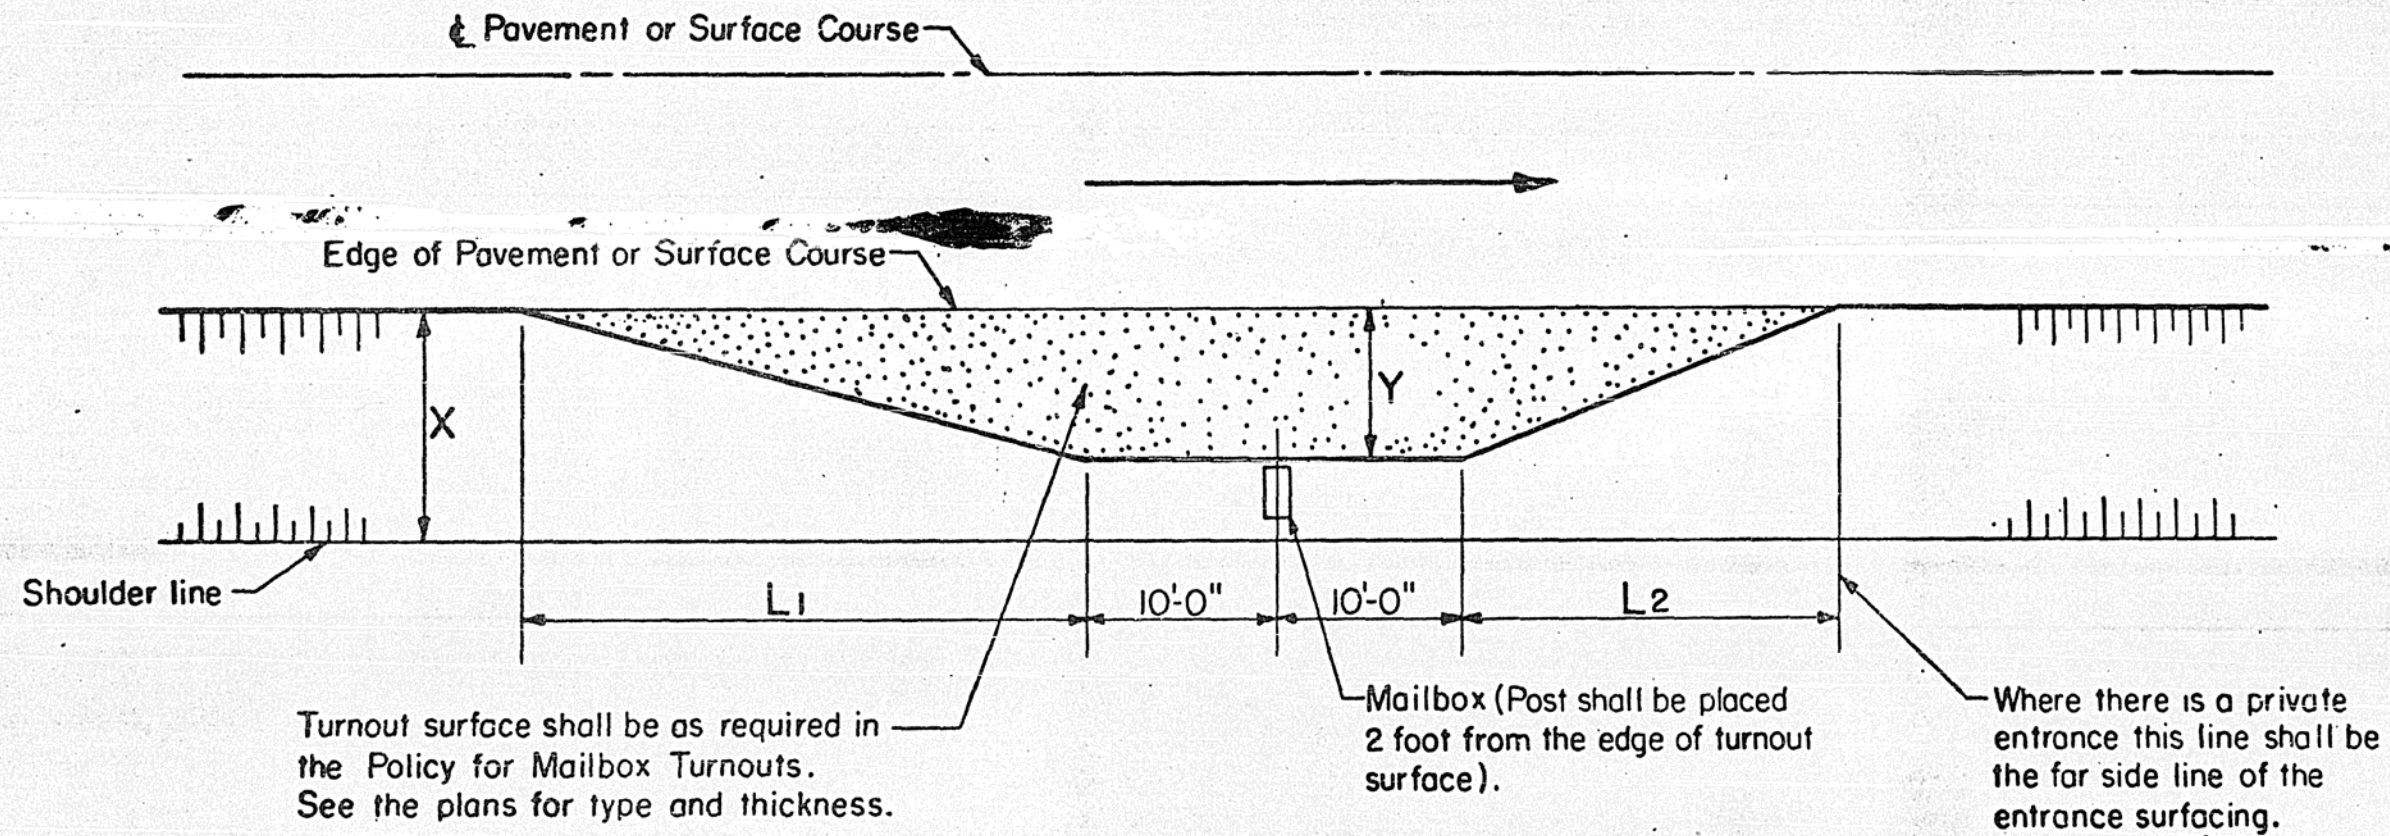

DIMENSIONS


"X" Width of Shoulder	12'	10'	8'	6'	5'	4'
"Y" Width of Turnout	8'	8'	6'	4'	3'	2'
"L1"	30'	30'	23'	15'	11'	8'
"L2"	20'	20'	15'	10'	8'	5'

NOTE: Dimensions for Township and District Roads may vary from the above dimensions.


STANDARD 2171

WHF. 10-26-62


STATE OF ILLINOIS DEPARTMENT OF PUBLIC WORKS & BUILDINGS DIVISION OF HIGHWAYS		REVISIONS	
		BY	DATE
PASSED <u>October 26, 1962</u>			
<u>A. Van Aushall</u> Engineer of Road Plans And Contracts			
APPROVED <u>October 26, 1962</u>			
<u>[Signature]</u> Engineer of Design			

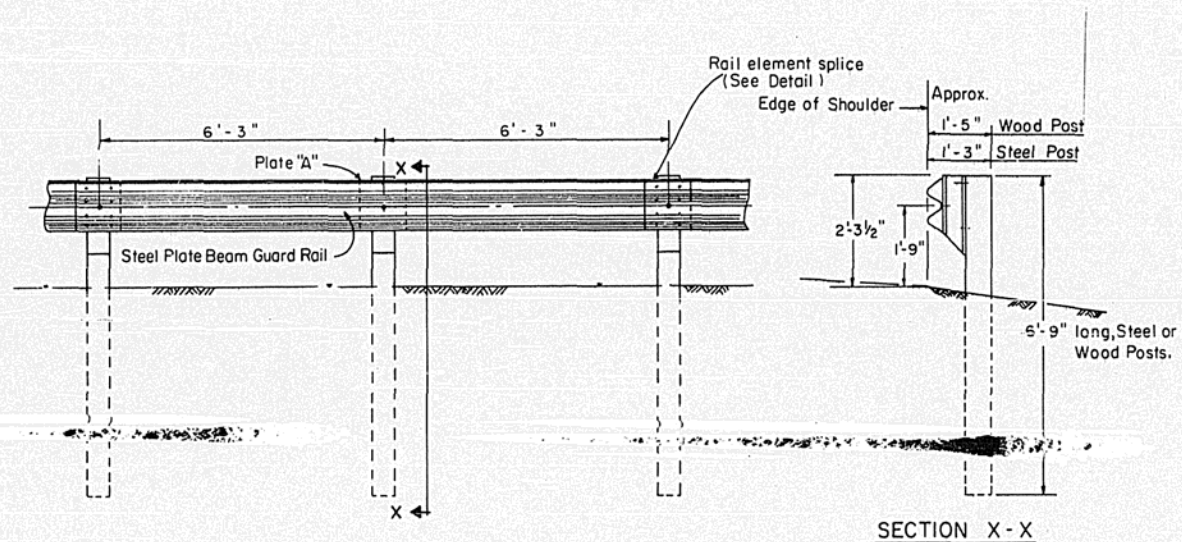


TYPE A
(6'-3" Typical Post Spacing)

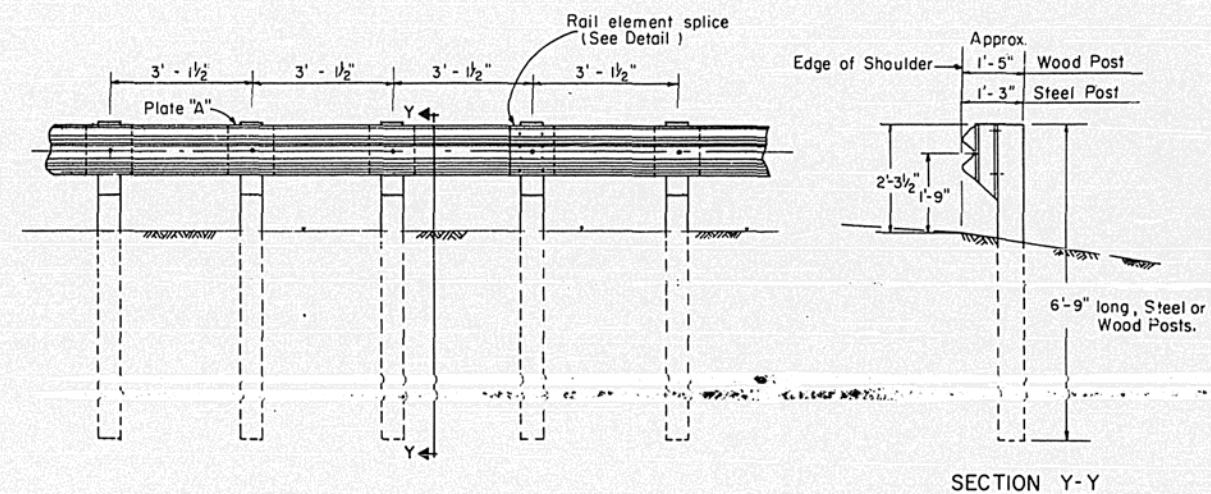


TYPE B
(3'-1 1/2" Closed Post Spacing)

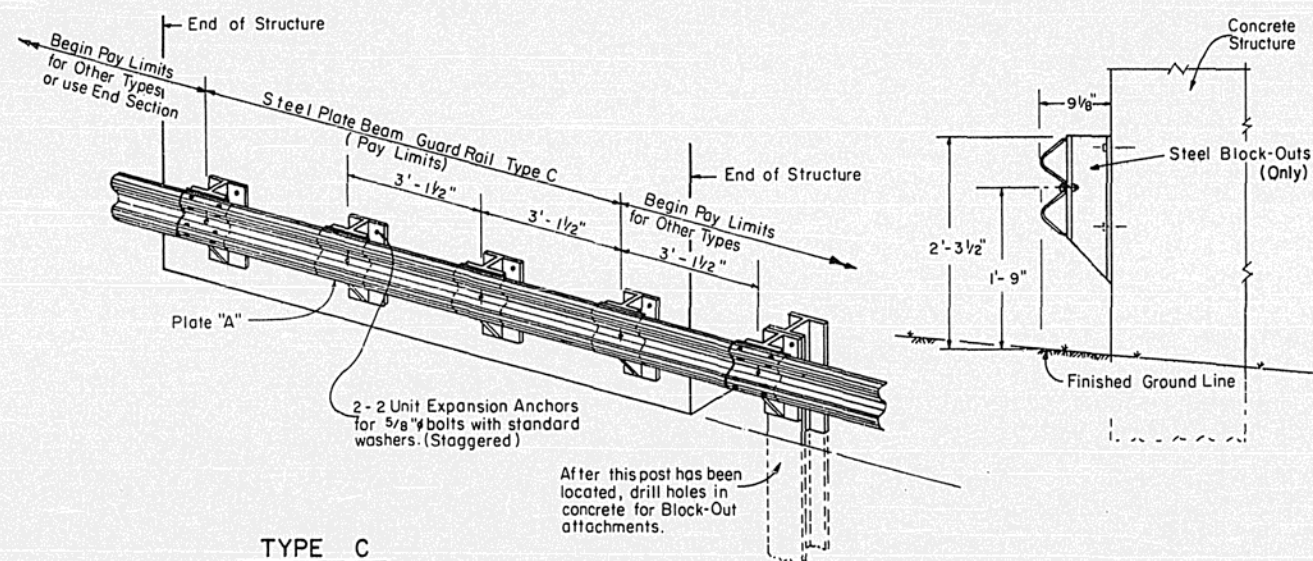


TYPE C
(3'-1 1/2" Block-Out Spacing)

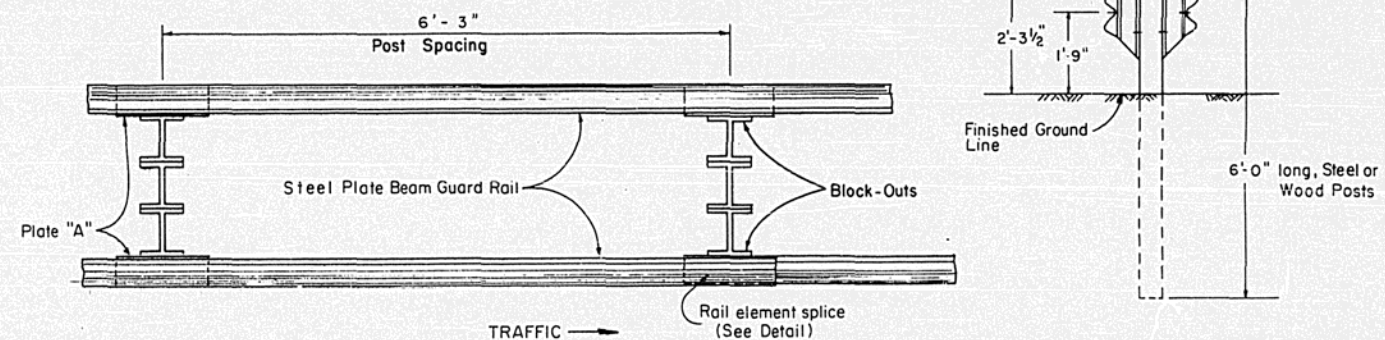


TYPE D
(Double Steel Plate Beam Guard Rail,
with 6'-3" Typical Post Spacing)

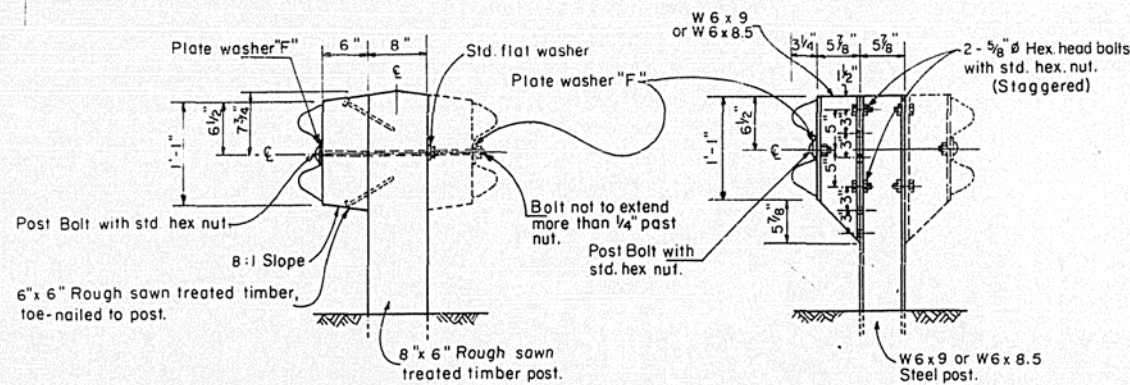


**TYPICAL DETAIL OF
WOOD POST CONSTRUCTION**

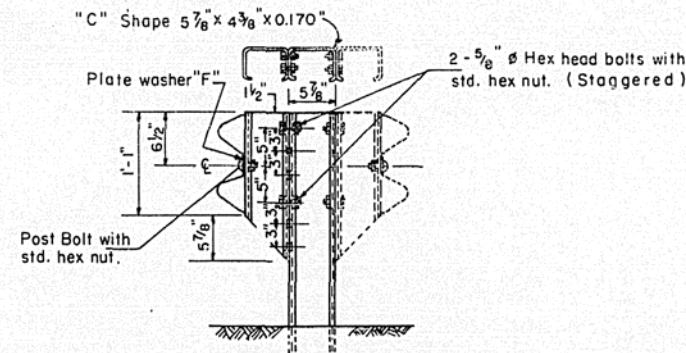


**TYPICAL DETAIL OF
STEEL POST CONSTRUCTION
(ALTERNATE "C" SHAPE)**

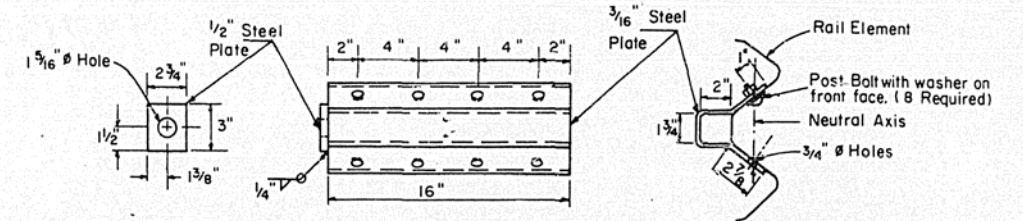

ANCHOR PLATE "T" DETAILS
Anchor Plate "T" shall be used to attach cable assembly to guard rail when required on Traffic Barrier Terminals.


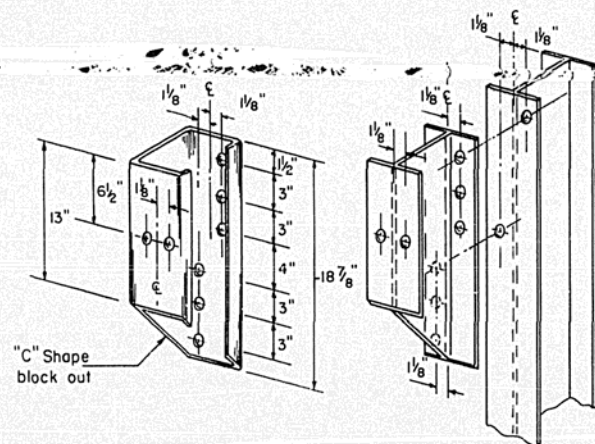


BLOCK-OUT DETAILS

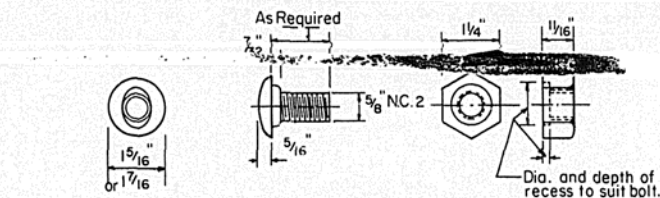


POST OR SPLICE BOLT & NUT

Place Standard End Shoe between Splice Plate and Rail Element.

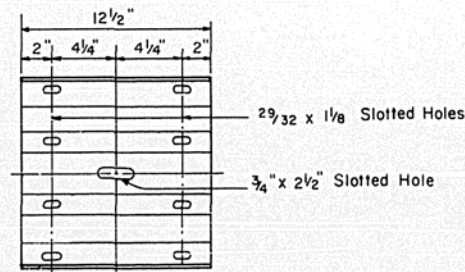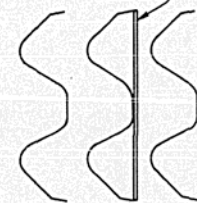


SPLICE PLATE

2 9/32 x 4 inch Slots for splice bolts with std. galv. washer placed under locknut.

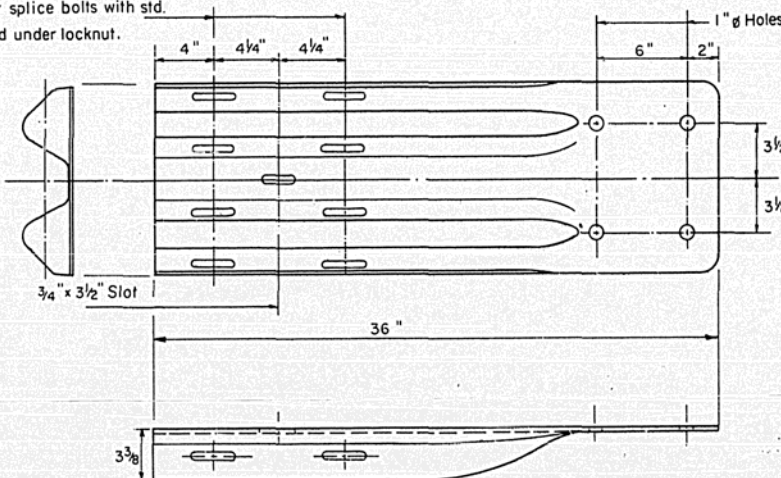


STANDARD END SHOE

When end shoe is attached to a bridge parapet which has an expansion joint, the bolts shall be provided with a locknut or double nut and shall be tightened only to a point that will allow guard rail movement.
The Standard End Shoe shall be attached to the concrete with Pre-drilled or Self-drilling anchor bolts. The anchor cone shall be set flush with the surface of the concrete.
Externally threaded studs protruding from the surface of the concrete will not be permitted.

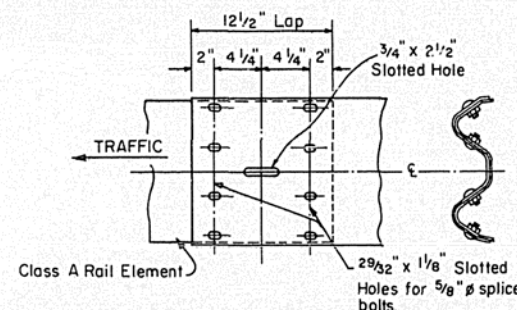

RAIL ELEMENT SPLICE

Class A Rail Element

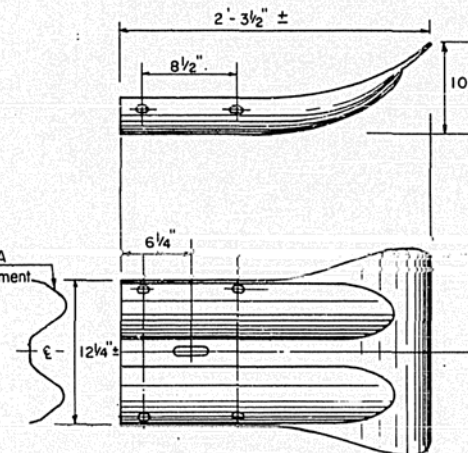

END SECTION

NOTE:
End Section shall be used only when specified on the contract plans.
Cost included in the bid unit price for Guard Rail.

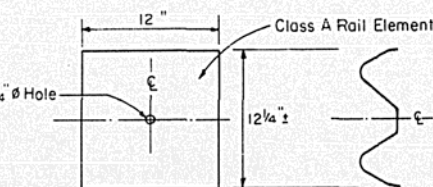


PLATE "A"

NOTE:
Plate "A" shall be placed between rail element and block-out at all non-splice mounting points.


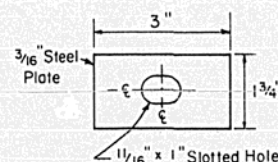


PLATE WASHER "F"


Plate Washer "F" shall be used at all locations where rail element is bolted to a block-out unless otherwise noted.

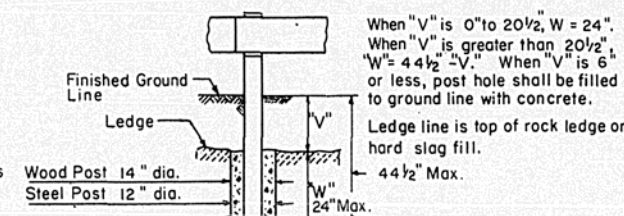

**FOOTING FOR POST WHEN IMPERVIOUS
MATERIAL IS ENCOUNTERED**

GENERAL NOTES


All rail element shall be Class A unless otherwise noted.
All holes in posts and block-outs shall be 3/4 inch.
All concrete, and accessories used in the placing of the guard rail shall be included in the bid unit price for guard rail.
Rail element may be furnished in nominal lengths of either 12'-6" or 25'-0".
All rail elements and accessories shall conform to AASHTO M-180 unless otherwise noted.
For steel block-outs attached to wood posts, use 2-5/8 inch lag bolts (staggered) in pre-drilled post holes.
The Contractor shall load test 10% of all expansion anchor bolts in guard rail installations in the presence of the Engineer. The equipment and method used shall meet the approval of the Engineer. The minimum test load shall be 8,000 pounds for 7/8 inch bolts and 3,000 pounds for 5/8 inch bolts in direct pull. For each anchor that fails the test requirements, two (2) more anchor bolts, picked by the Engineer shall be tested. Each anchor bolt that fails to meet the test requirement shall be reset or removed and the hole drilled deeper. All reset anchor bolts shall meet minimum test requirements.

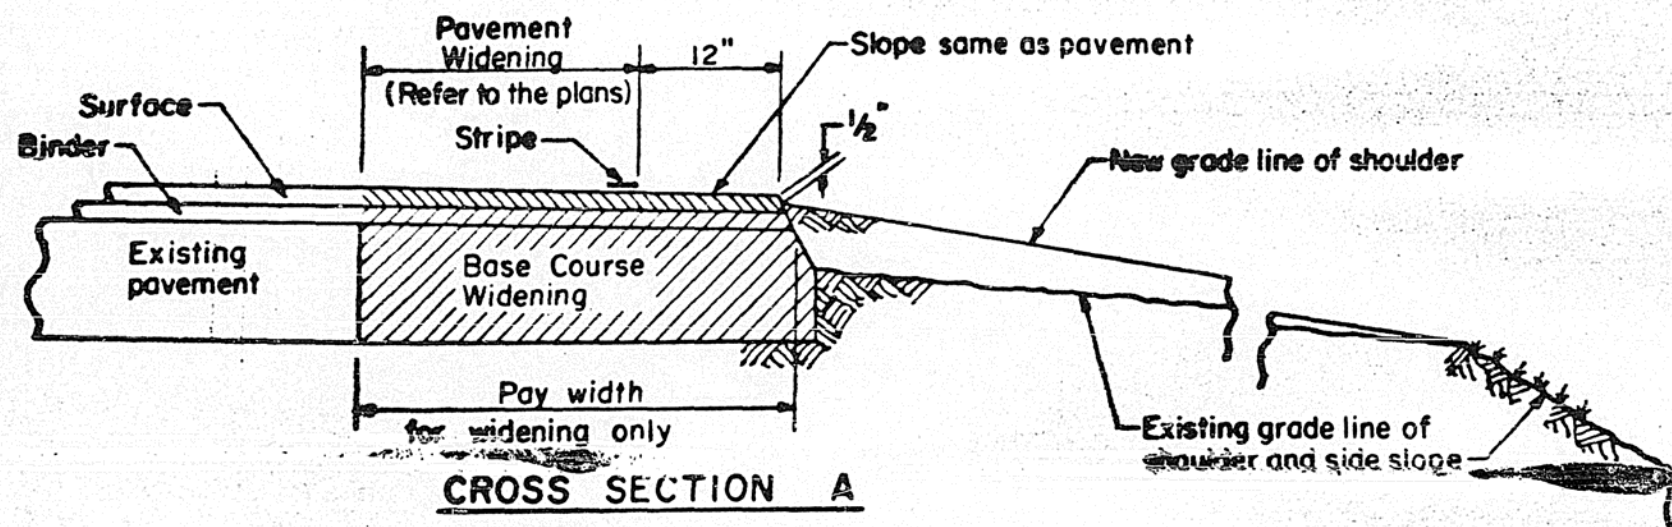

CROSS SECTION A
DETAIL OF WIDENING WITH SHOULDER

GENERAL NOTES

Refer to the plans for the thickness of the bituminous binder and surface on pavement.

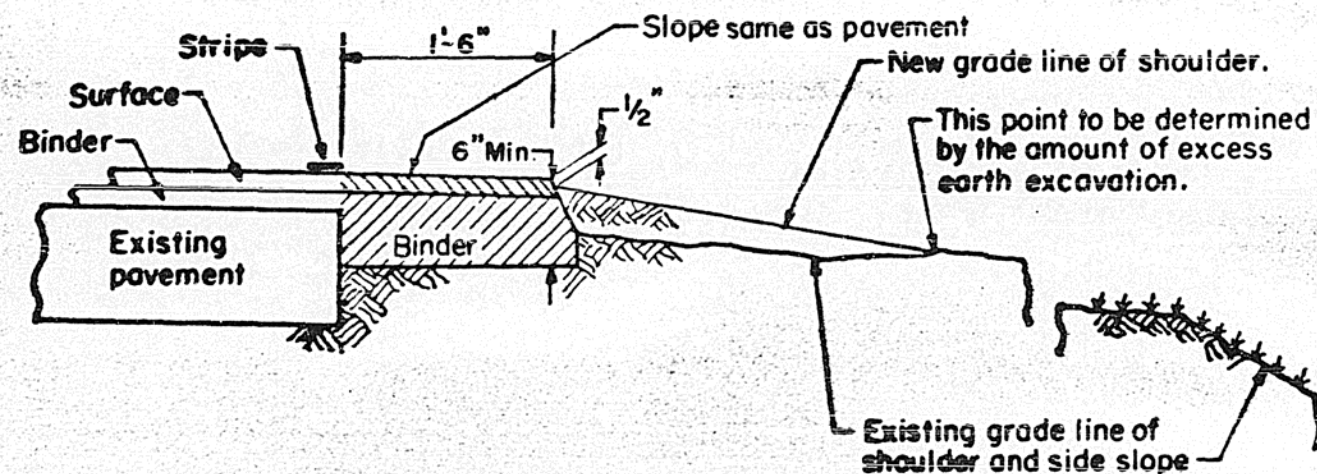

CROSS SECTION B
DETAIL OF BITUMINOUS SHOULDER

The Bituminous Binder shoulder material for Section B may be placed in one or two layers at the option of the Contractor.

The bituminous mixture for Section B shall be compacted to a density of not less than 85% of the theoretical density. The compaction equipment shall be as determined by the Engineer.

The bituminous binder and surface mixtures for shoulders will be paid for at the contract unit price per ton of the type specified for the adjacent resurfacing except that the thickness of surface course paid for will be limited to that specified for the resurfacing or 1/2 inch whichever is less. Surface course used in excess of this amount will be paid for as binder course.

The earthwork required as shown in Section A will be measured to the neat lines as shown and will be paid for at the contract unit price per cubic yard for EARTH EXCAVATION WIDENING which price shall include use of earth excavation to regrade the shoulders to the new grade line and disposal of excess as specified in the Standard Specifications.

The earthwork required as shown in Section B will be paid for at the contract unit price per unit (100 lineal feet) measured separately on the right and left hand sides for EXCAVATING AND GRADING EXISTING SHOULDER which price shall include use of excess earth excavation to regrade the shoulders to the new grade line.

Stripe at edge of pavement to be furnished by others.



Illinois Department of Transportation

ISSUED 5-10-67

REVISIONS

PASSED April 15 1977

A. E. Blum
Engineer of Design Operations

APPROVED April 15 1977

Thomas B. Bright
Engineer of Design

W.F. 12-1-69

W.F. 3-18-70

W.F. 1-18-71

W.F. 12-17-71

D.W.W. 4-15-77

Redrawn 12-1-69

**WIDENING AND SHOULDERS
FOR PAVEMENT RESURFACING**

STANDARD 2239-6

(1/4 Size)


W.F.

C-22.15

STANDARD DESIGN


TYPICAL APPLICATION OF TRAFFIC CONTROL DEVICES FOR HIGHWAY CONSTRUCTION AND MAINTENANCE

TYPICAL APPLICATIONS OF TYPE III BARRICADES CLOSING A ROAD

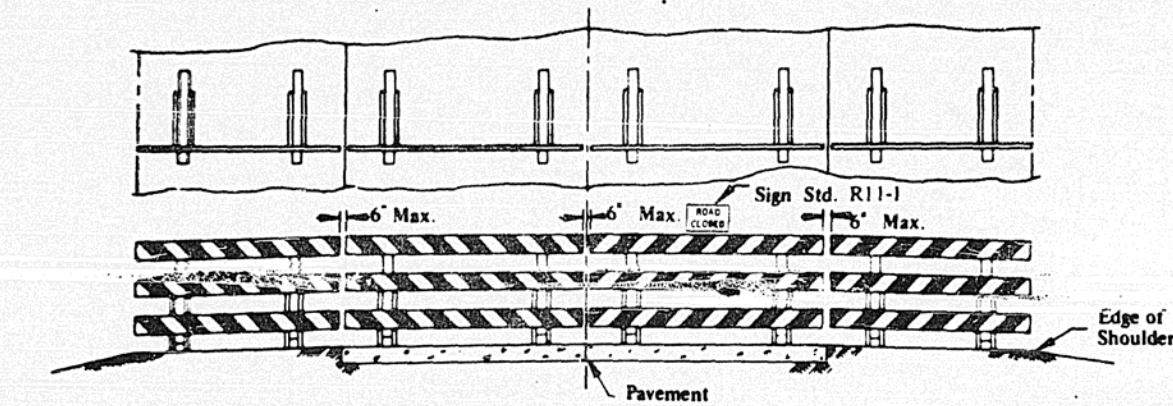

ROAD CLOSED TO ALL TRAFFIC





The barricades shall be to the edge of the shoulders except when otherwise directed by the Engineer or shown on the detailed construction plans.

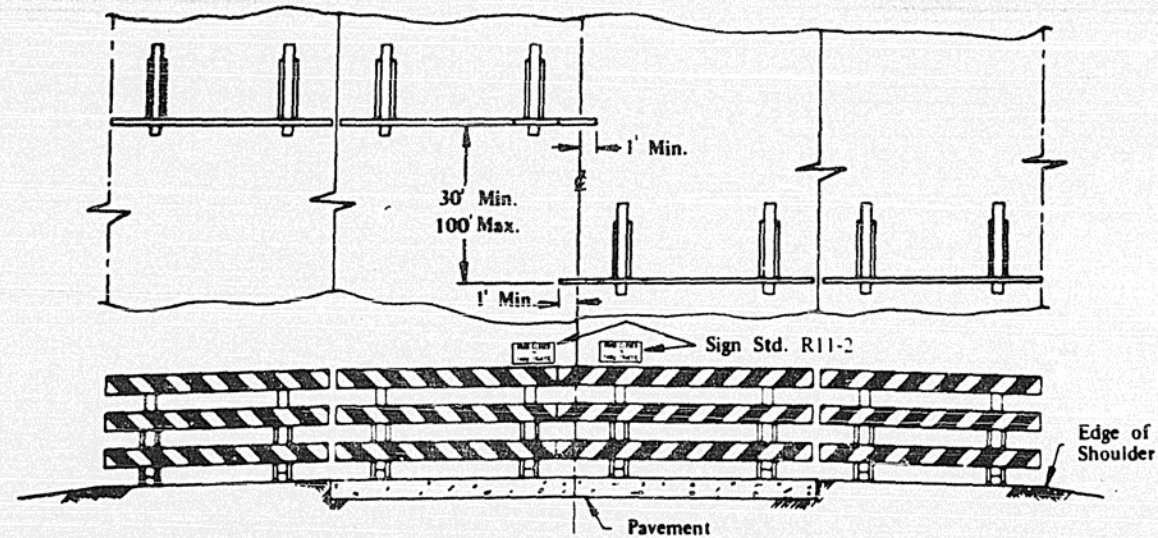

ROAD CLOSED TO THRU TRAFFIC

Reflectorized striping shall appear on both sides of barricades. The barricades shall be to the edge of the shoulders, except when otherwise directed by the Engineer or shown on the detailed construction plans.

TYPICAL SIGN INSTALLATIONS

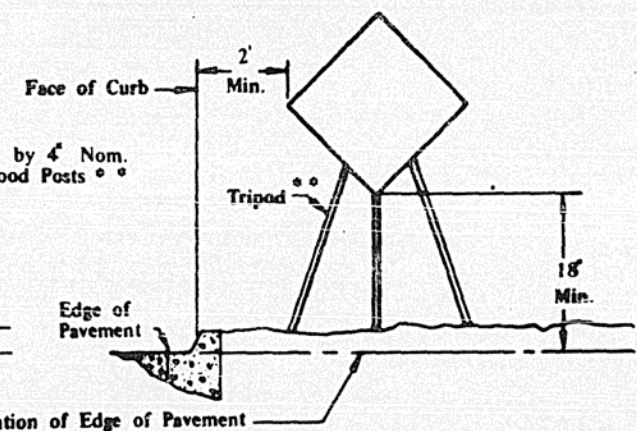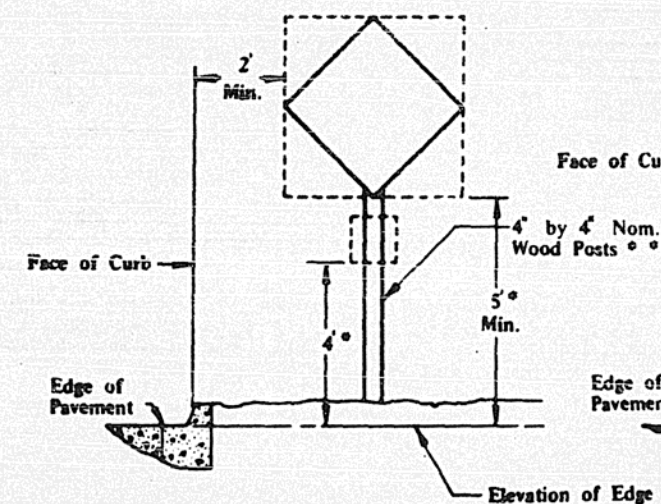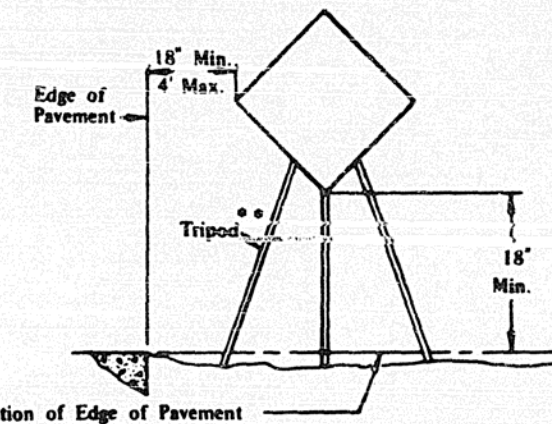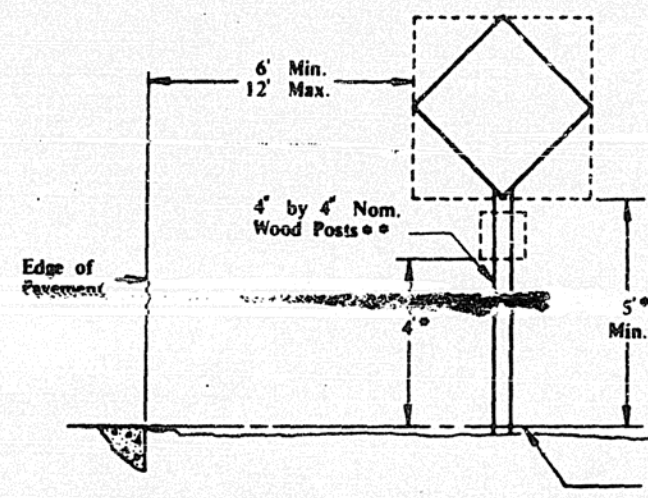

*Add 2 ft. if parking exists within 200 ft. in advance of the sign location at any time during the project.

**Alternate designs and/or materials may be permitted when authorized by the Engineer. All materials shall be substantial and durable.

Signs on temporary supports shall be within 20° of a vertical position.


Weights of concrete, stone, or brick will not be allowed and all weights used to stabilize signs other than sandbags must be rigidly attached to the sign support as close to the ground as possible.

STATE OF ILLINOIS DEPARTMENT OF TRANSPORTATION	ISSUED 4-3-69
APPROVED <i>L. E. McBerly</i> Engineer of Traffic	REVIS BY DATE
1973	

STANDARD 2298-4


STANDARD DESIGN DESIGN OF TRAFFIC CONTROL DEVICES FOR HIGHWAY CONSTRUCTION AND MAINTENANCE

TYPE I BARRICADES

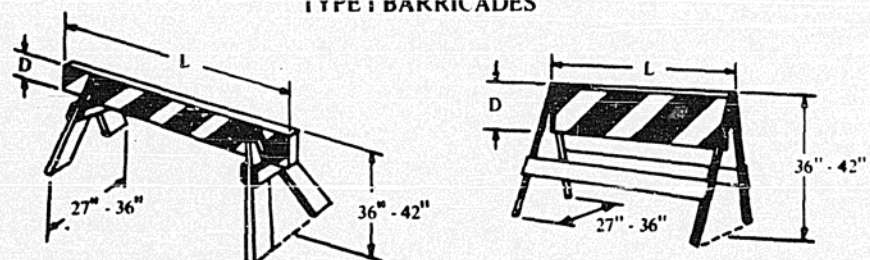


LENGTH (L)	DEPTH (D)
27' MIN.	36' MIN. (12" SLOPING RAIL)
36' MIN.	42' MIN. (12" SLOPING RAIL)

TYPE II BARRICADES

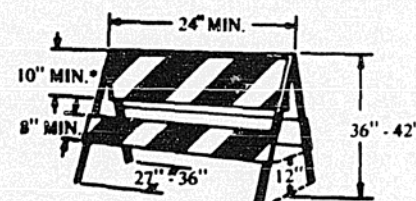


*12" SLOPING


CONES

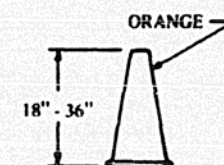

TYPE III BARRICADES

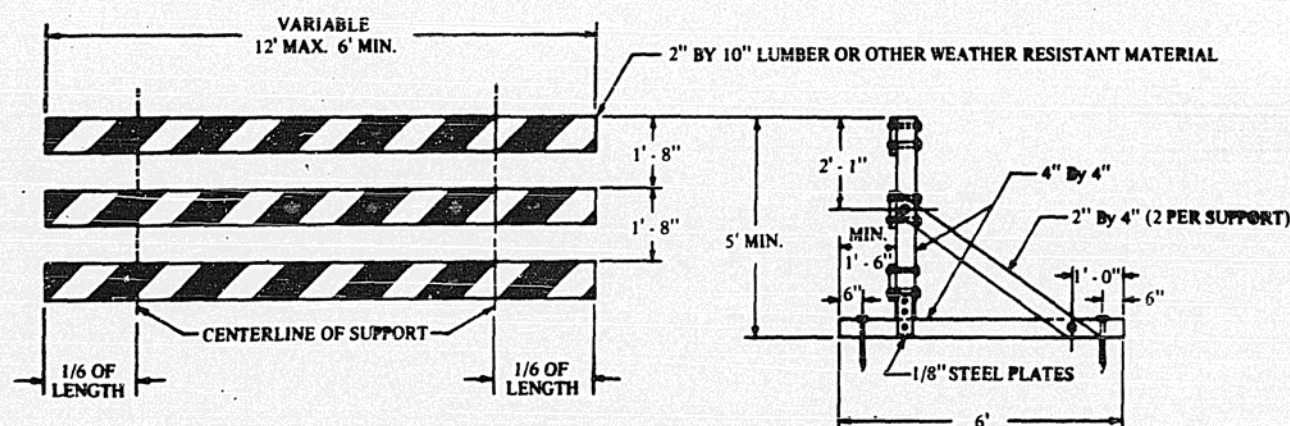


TYPICAL WOOD SUPPORTS

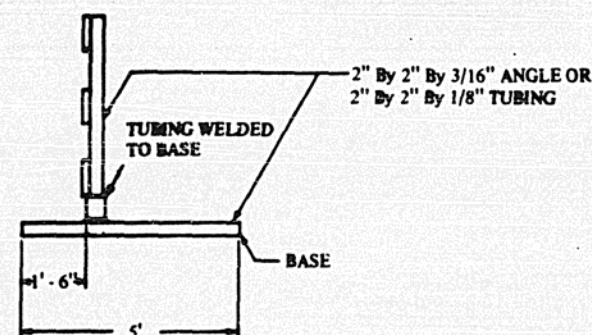


TYPICAL STEEL SUPPORTS

DRUMS

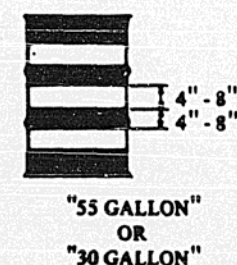

VERTICAL PANELS

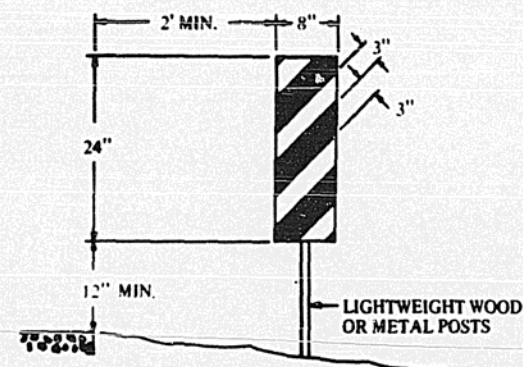


GENERAL NOTES

- Barricade legs or supports shall be orange, white or silver in color.
- All reflectorized material, shall meet the latest reflective sheeting requirements of the Department to be used in construction and maintenance areas.
- All barricades and vertical panels shall have alternating reflectorized white and reflectorized orange stripes at 45° from the vertical. Barricade stripes shall be 6 inches in width on barricades 36 inches or greater in length and 4 inches in width on barricades less than 36 inches in length. Stripes on vertical panels shall be 3 inches in width.
- Type I and Type II Barricades shall be striped on both sides. Type III Barricades shall be striped on both sides where traffic approaches from either direction.
- Diagonal stripes shall slope downward at 45° toward the side on which traffic will pass.
- Vertical panels placed on the outside of curves shall be reflectorized on both sides.
- The top rail on Type I and Type II Barricades may be vertical as shown or sloping at no greater than a 30 degree angle.
- Drums shall have alternating reflectorized orange and reflectorized white horizontal, circumferential stripes. Stripes shall be 4 inches to 8 inches in width. If non reflective spaces are left between the orange and white stripes or at the top and bottom of the drum, they shall be no more than 2 inches in width and shall be painted orange or white. Other than for these 2-inch spaces, the entire drum shall be striped.
- Frames shown are typical. Alternate designs and/or materials may be permitted when authorized by the Engineer. All materials shall be substantial and durable. Nominal lumber sizes are acceptable to satisfy dimensions.
- Barricades may be identified with a legend that does not exceed one inch in height at a location not visible to traffic.
- Weights of concrete, stone, or brick will not be allowed and all weights used to stabilize barricades other than sandbags must be rigidly attached to the barricades as close to the ground as possible. No weights or sandbags will be allowed on the top rail of barricades. Drums may be weighted internally with just enough sand, water, or other material to provide stability.
- When used, warning lights on Type I and Type II Barricades shall be mounted above the top rail to the side on which traffic will pass and shall not obscure any reflectorized portion of the rail.

STATE OF ILLINOIS DEPARTMENT OF TRANSPORTATION	ISSUED 4-5-69 REVISED By DATE
APPROVED <i>12-27-74</i> <i>GE. Mohr</i> Engineer of Traffic	R.V. 6-1-76

STANDARD 2299-7

STANDARD DESIGN FOR FLAGMAN TRAFFIC CONTROL SIGN

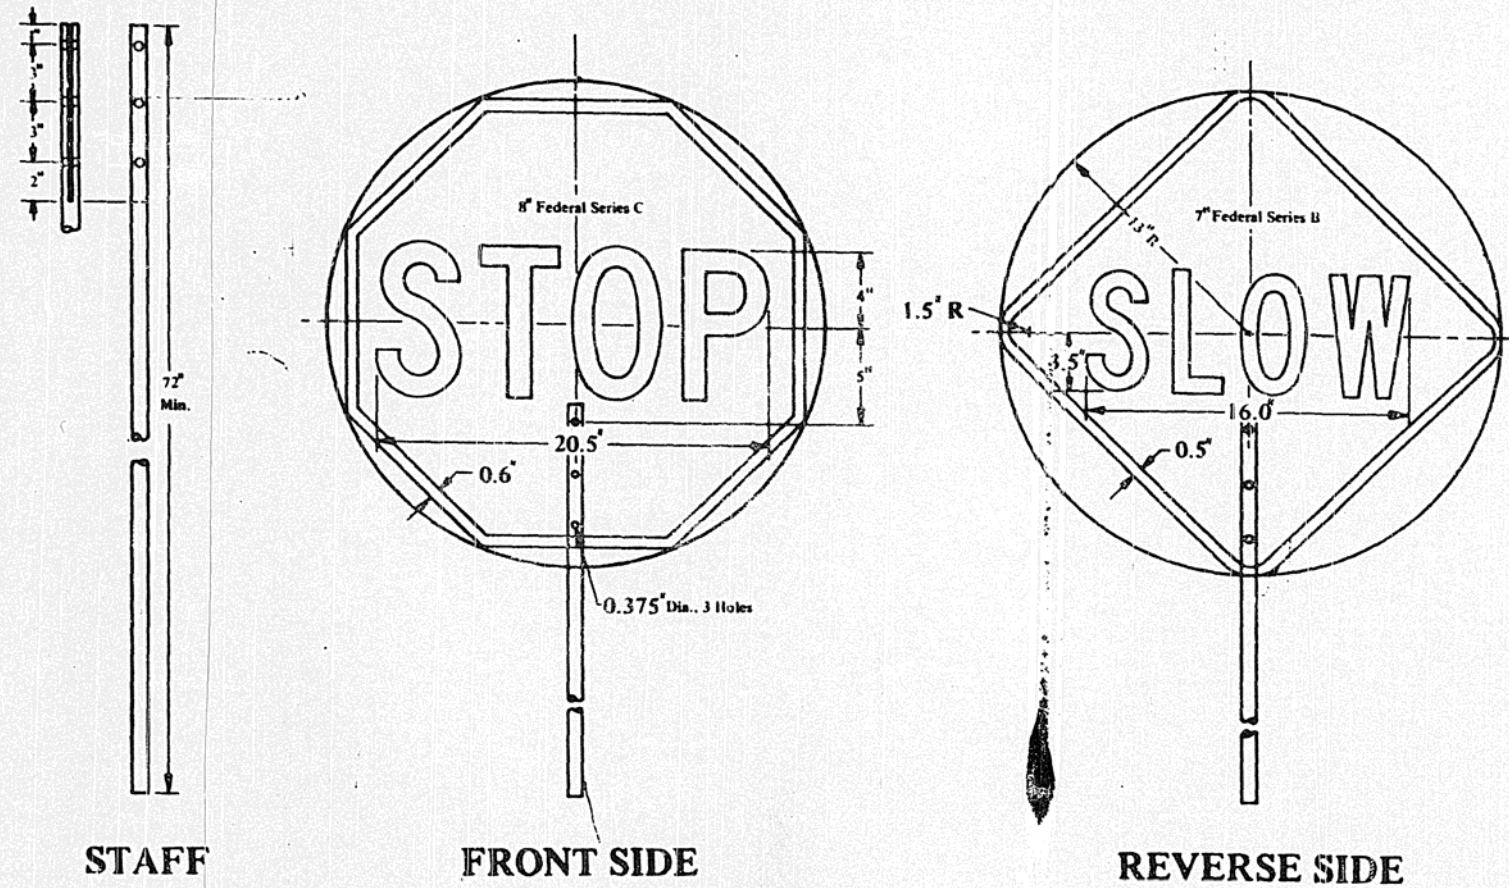

GENERAL NOTES


1. The "STOP" face shall consist of white letters and border on a red reflectorized background.
2. The "SLOW" face shall consist of black letters and border on an orange reflectorized background.
3. Areas outside sign borders shall be light blue.
4. The portion of the staff within the sign face shall match the sign colors.
5. All colors and letters shall meet applicable federal standards.
6. The sign shall be attached to the staff with rust resistant hardware.
7. The staff shall consist of two sections joined by a coupling located 60 in. from the bottom of the staff. Alternate designs may be used when approved by the Engineer. All materials shall be substantial and durable.
8. This sign shall be furnished by the contractor and shall be used by the flagman in lieu of flags or other signaling devices. The cost of furnishing and maintaining the sign shall be considered incidental to the contract and no additional compensation will be allowed.

STATE OF ILLINOIS DEPARTMENT OF TRANSPORTATION		ISSUED 4-3-69	
APPROVED <i>L. E. M. [Signature]</i> 1978		REVISED BY DATE	
Engineer of Traffic			

STANDARD 2300-1

STANDARD DESIGN

TYPICAL APPLICATION OF TRAFFIC CONTROL DEVICES FOR HIGHWAY CONSTRUCTION AND MAINTENANCE

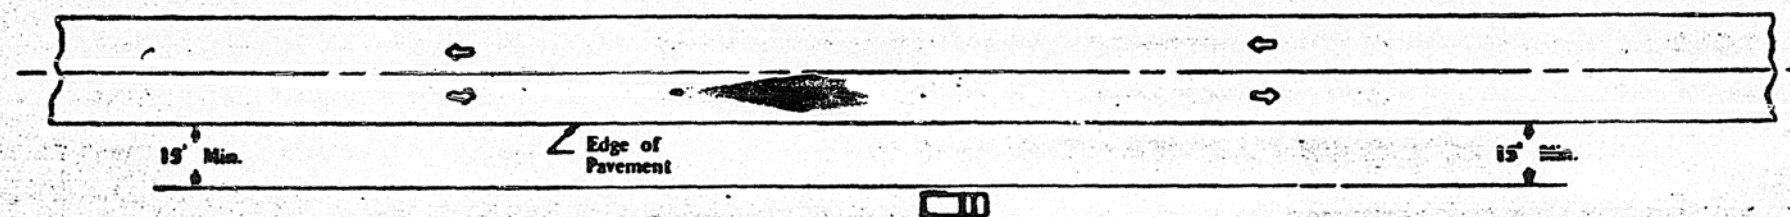

TYPICAL APPLICATIONS

Landscaping Work
Utility Operations
Paving Contracts and Maintenance
Cleaning Culverts

GENERAL NOTES

1. No special signing is required.
2. If the work operation requires that two or more work vehicles cross the 15 ft. clear zone in any one hour, traffic control will be in conformance with Case II.

CASE I

TWO-LANE, TWO WAY TRAFFIC,
RURAL DAY OR NIGHT
OPERATIONS

Where, at all times, all vehicles, equipment, men and their activities are more than 15 ft. from the edge of pavement.


STATE OF ILLINOIS DEPARTMENT OF TRANSPORTATION	ISSUED 4-3-69
APPROVED <i>E. E. Moberly</i> Engineer of Traffic	REVISOR BY DATE
1973	

STANDARD 2301-3

F-606 b

STANDARD DESIGN

TYPICAL APPLICATION OF TRAFFIC CONTROL DEVICES FOR HIGHWAY CONSTRUCTION AND MAINTENANCE

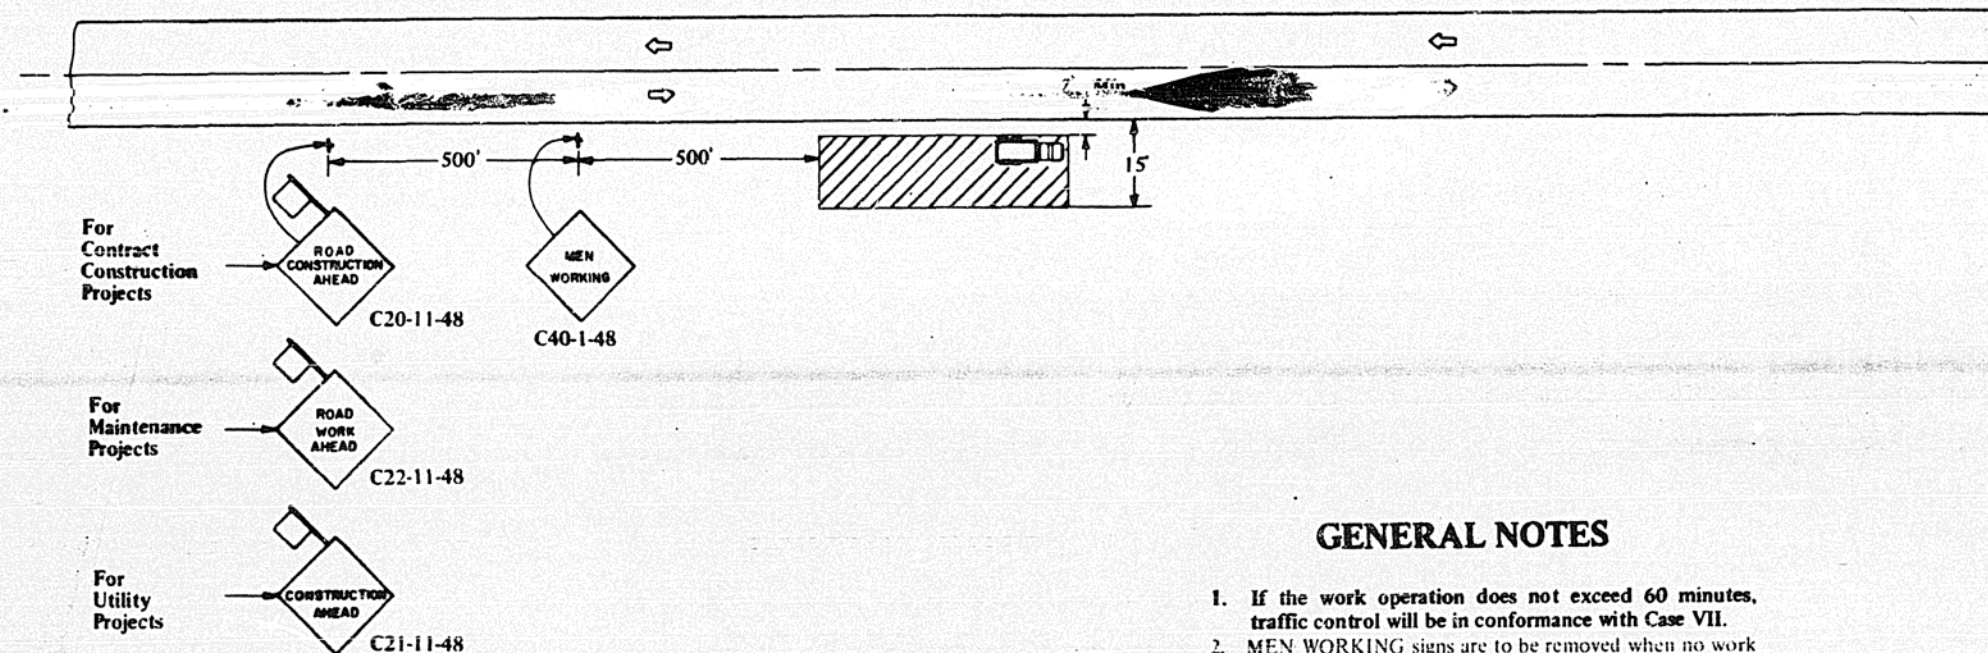

TYPICAL APPLICATIONS

Utility Operations
Culvert Extensions
Side Slope Changes
Guard Rail Installation and Maintenance
Delineator Installation and Maintenance
Landscaping Operations
Cleaning Ditches and Drainage Structures
Sign Installation and Maintenance
Shoulder Repair

SYMBOLS



Work Area.



Sign with 18 in. by 18 in. (minimum) orange flag attached.

Sign on portable or permanent support.

GENERAL NOTES

1. If the work operation does not exceed 60 minutes, traffic control will be in conformance with Case VII.
2. MEN WORKING signs are to be removed when no work is being performed. Any unattended obstacle or excavation in the work area, which in the opinion of the engineer constitutes a hazard, shall be protected by Type I or Type II Barricades at 50-foot centers with flashing lights or torches at night. When used, torches must be placed on the ground. If the hazard exceeds 100 feet in length, steady burning lights shall be substituted for flashing lights or torches. When the distance is greater than 250 feet, barricade spacing may be increased to 100 feet.
3. If the work operation requires that four or more work vehicles enter the through traffic lanes in a one-hour period, a flagman shall be provided and the FLAGMAN 500 FT sign shall be substituted for the MEN WORKING sign.
4. Longitudinal dimensions may be adjusted slightly to fit field conditions.
5. All warning signs shall have minimum dimensions of 48 in. by 48 in. and have black legend and border on an orange reflectorized background.
6. All vehicles, equipment, men and their activities are restricted at all times to one side of the pavement unless otherwise authorized by the Engineer.

CASE II

**TWO-LANE, TWO WAY TRAFFIC,
RURAL DAY OR NIGHT
OPERATIONS**

Where, at any time, any vehicle, equipment, men or their activities will encroach in the area closer than 15 ft. but not closer than 2 ft. to the edge of pavement.


STATE OF ILLINOIS DEPARTMENT OF TRANSPORTATION		ISSUED 4-3-69	
APPROVED <i>L.E. Moberly</i> 6-12-1973 Engineer of Traffic		REVIS BY DATE	

STANDARD 2302-3

F-6.07b

STANDARD DESIGN

TYPICAL APPLICATION OF TRAFFIC CONTROL DEVICES FOR HIGHWAY CONSTRUCTION AND CONTRACT MAINTENANCE

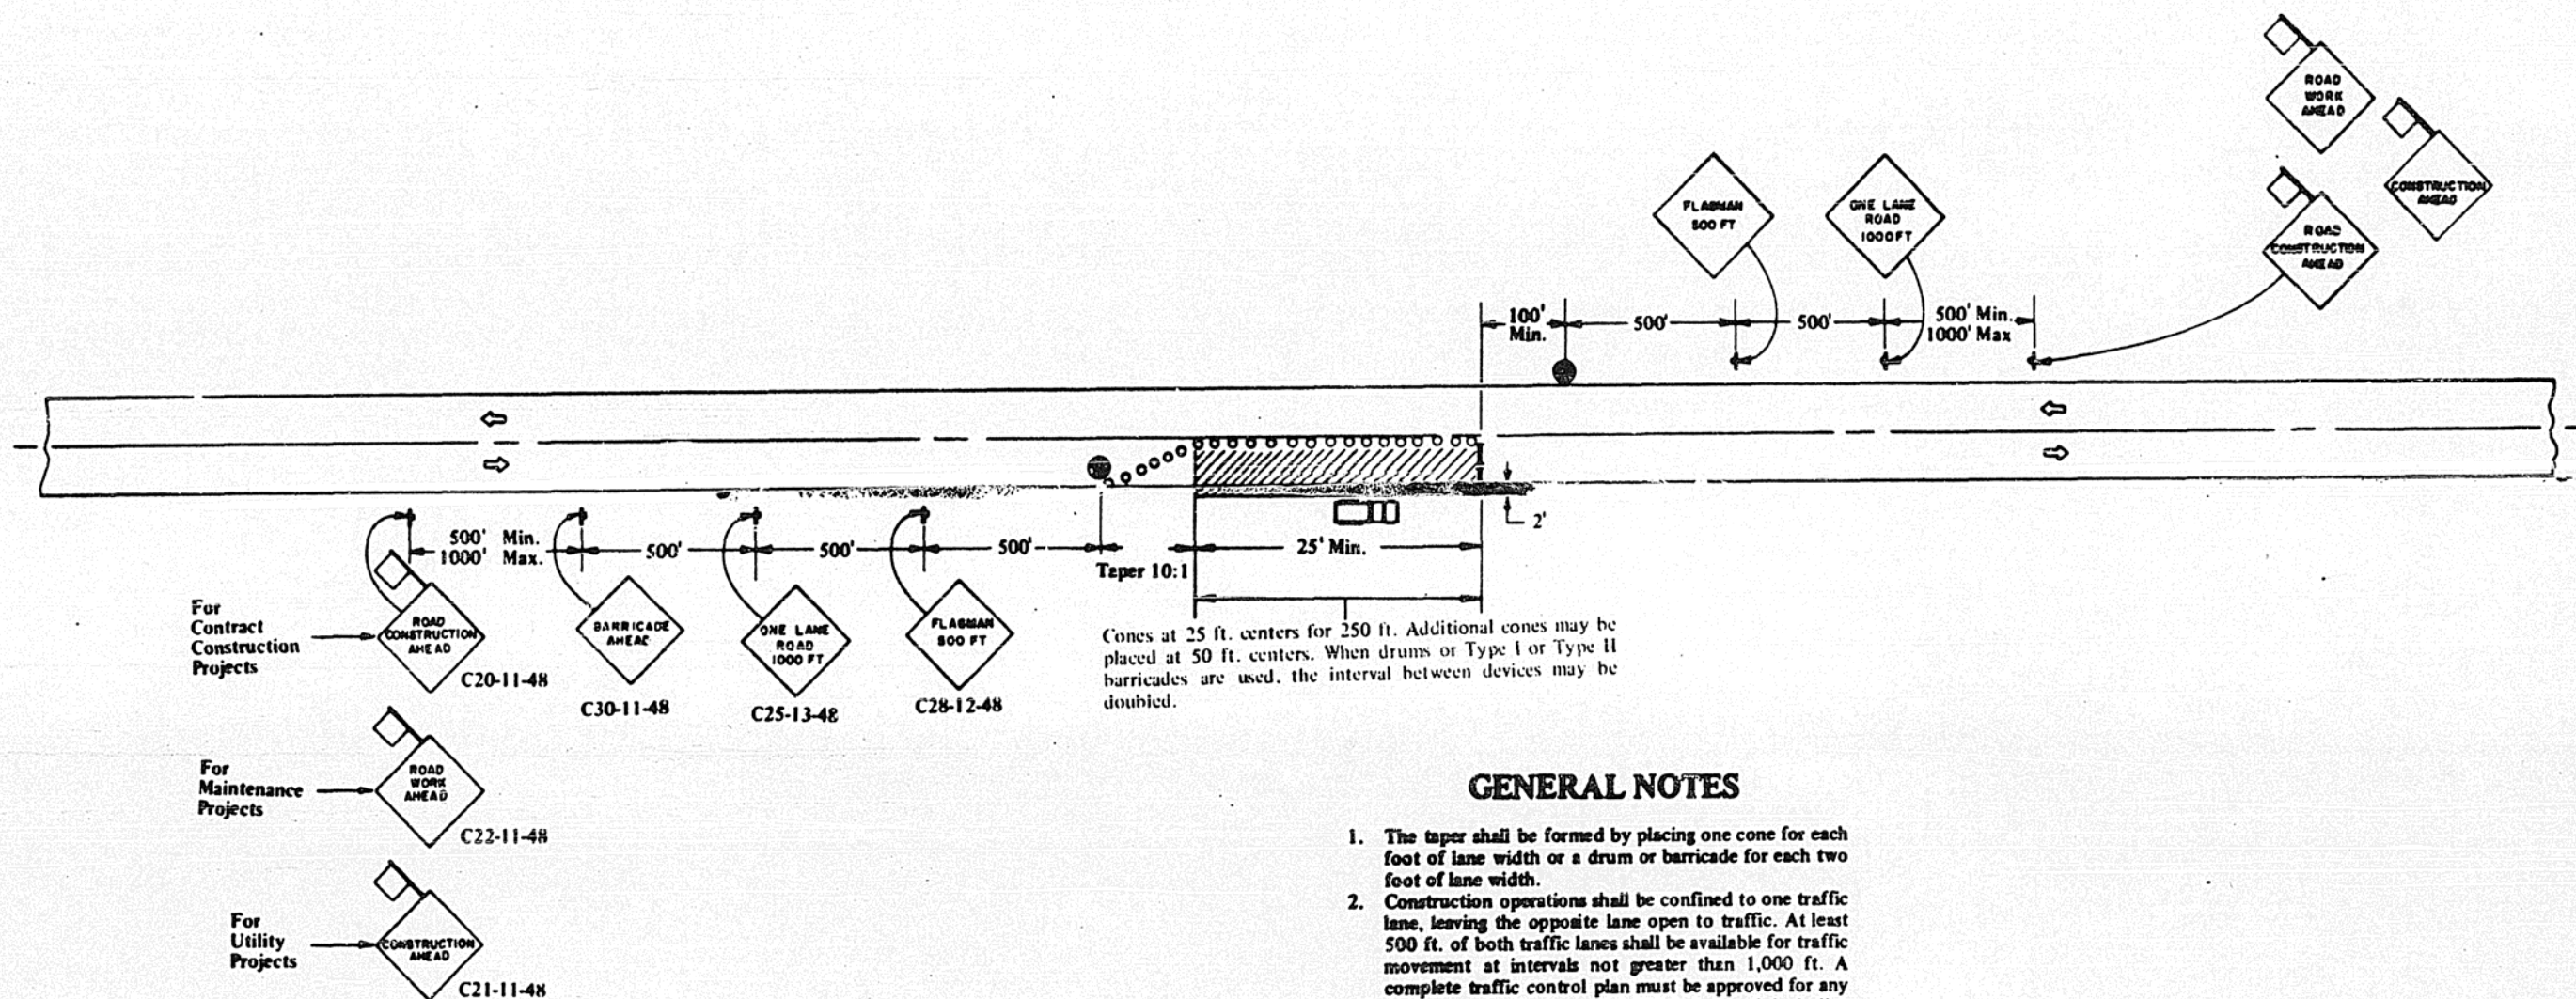

GENERAL NOTES

1. The taper shall be formed by placing one cone for each foot of lane width or a drum or barricade for each two feet of lane width.
2. Construction operations shall be confined to one traffic lane, leaving the opposite lane open to traffic. At least 500 ft. of both traffic lanes shall be available for traffic movement at intervals not greater than 1,000 ft. A complete traffic control plan must be approved for any project expected to exceed 1,000 ft. in length including both taper and work areas.
3. If the work operation does not exceed 60 minutes, traffic control will be in conformance with Case VII.
4. The flagmen shall be in sight of each other or in direct communication at all times.
5. When there is no work being performed, the FLAGMAN 500 FT sign(s) and the flagmen will not be required. A ONE LANE ROAD 500 FT sign(s) shall be installed in place of the FLAGMAN 500 FT sign(s).
6. All signs, cones, barricades and drums are to be removed at completion of the day's operations and the work area opened to traffic.
7. When a side road intersects the highway on which work is being performed, additional traffic control devices shall be erected and flagmen provided as directed by the Engineer.
8. Longitudinal dimensions may be adjusted slightly to fit field conditions. The lateral placement of the flagmen may be varied from that shown.
9. All warning signs shall have minimum dimensions of 48 in. by 48 in. and have black legend and border on an orange reflectorized background.
10. All vehicles, equipment, men (except flagmen) and their activities are restricted at all times to one side of the pavement unless otherwise authorized by the Engineer.

SYMBOLS

- Work Area.
- Sign with 18 in. by 18 in. (minimum) orange flag attached.
- Cone, Drum (55 or 30 gallon), Type I or Type II Barricade.
- Sign on portable or permanent support.
- Flagman with Traffic Control sign.
- Type I or Type II Barricade.

TYPICAL APPLICATIONS

Pavement Patch
Utility Operations

STATE OF ILLINOIS DEPARTMENT OF TRANSPORTATION	ISSUED 4-3-69
APPROVED <i>H. E. Moberly</i> Engineer of Traffic	REVIS BY DATE
1973	

CASE III


TWO-LANE, TWO WAY TRAFFIC,
RURAL DAY OPERATIONS ONLY

Where, at any time, any vehicle, equipment, men or their activities will encroach in the area between the center line and a line 2 ft. outside the edge of pavement.

STANDARD 2303-4

STANDARD DESIGN

TYPICAL APPLICATION OF TRAFFIC CONTROL DEVICES FOR HIGHWAY CONSTRUCTION AND CONTRACT MAINTENANCE

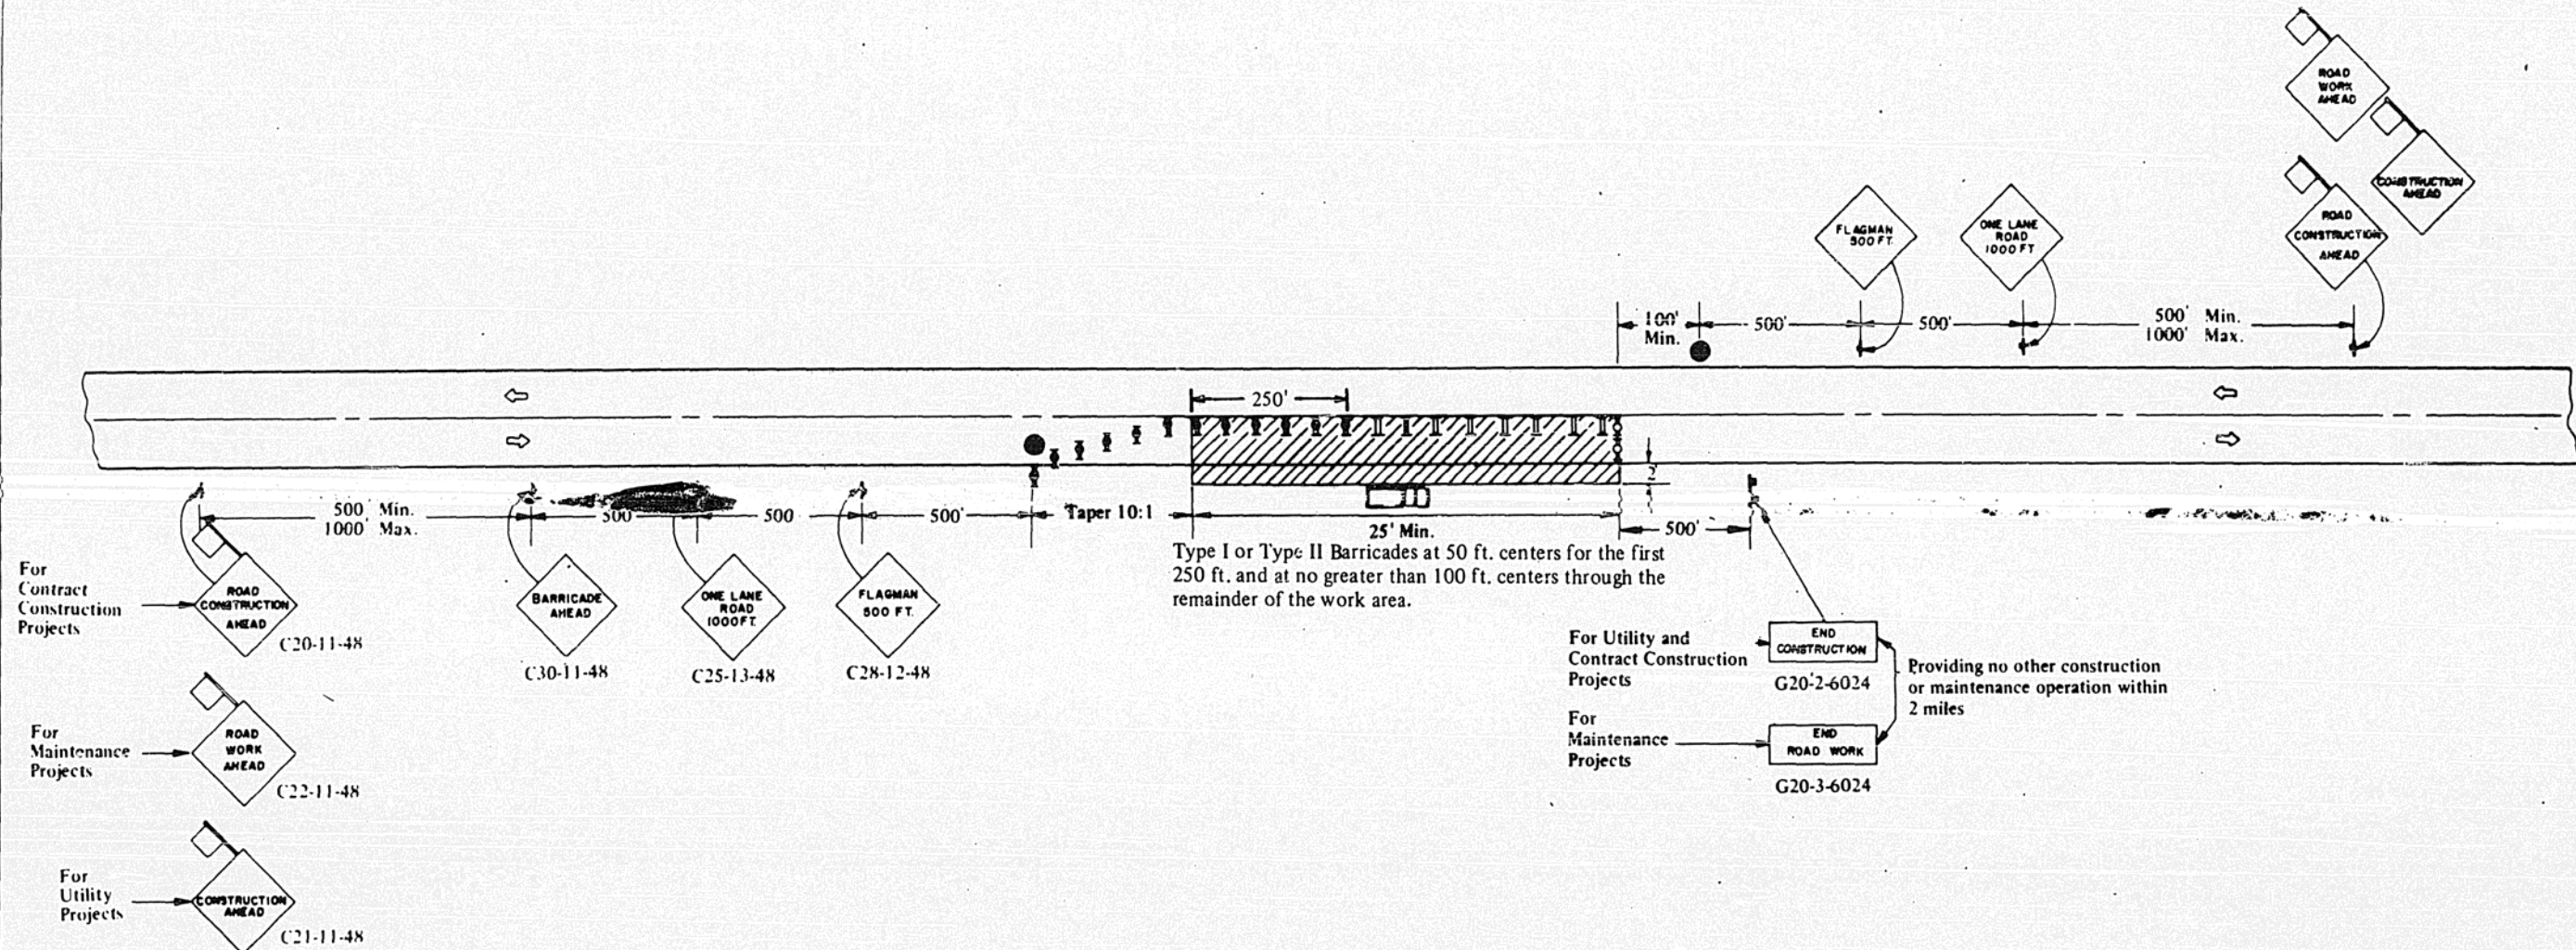

GENERAL NOTES

CASE IV

TWO-LANE, TWO WAY TRAFFIC, RURAL NIGHT OPERATIONS OR OPERATIONS EXCEEDING ONE DAYLIGHT PERIOD

Where, at any time, any vehicle, equipment, men or their activities will encroach in the area between the center line and a line 2 ft. outside the edge of pavement.

STANDARD 2304-4

SYMBOLS

- Work Area.
- Sign with 18 in. by 18 in. (minimum) orange flag attached.
- Sign on portable or permanent support.
- Flagman with Traffic Control sign.
- Type I or Type II Barricade with flashing light.
- Type I or Type II Barricade with steady burning light.
- Type I or Type II Barricade.

TYPICAL APPLICATIONS


Isolated Patch
Installation of Drainage Structure
Utility Operations

STATE OF ILLINOIS DEPARTMENT OF TRANSPORTATION	ISSUED 4-3-69 REVISED BY DATE
APPROVED <i>L.E. Moberly</i> Engineer of Traffic	RTY 4/25/75


F-6090

STANDARD DESIGN


TYPICAL APPLICATION OF TRAFFIC CONTROL DEVICES FOR HIGHWAY CONSTRUCTION AND MAINTENANCE

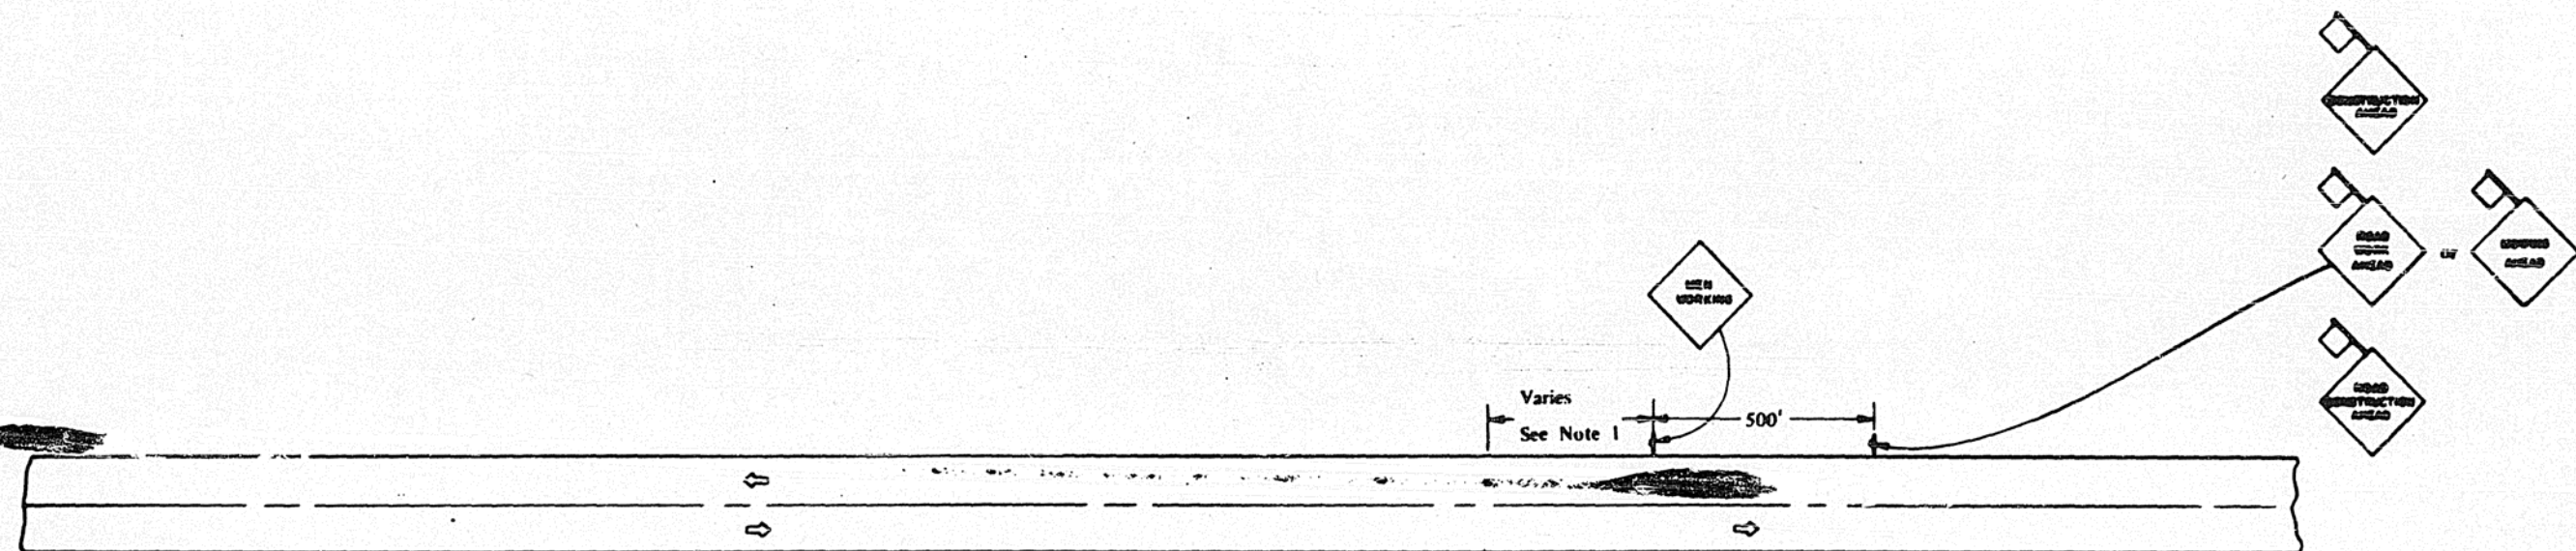


For Contract Construction Projects

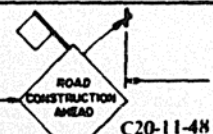

For Maintenance Projects

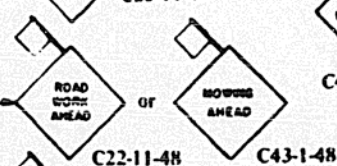

For Utility Projects

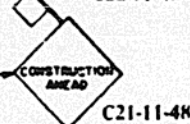

GENERAL NOTES

1. Minimum distance is 200 ft. Maximum distance to be determined by the Engineer but in no case to exceed the length of 1/2 day's operation.
2. If the work operation does not exceed 60 minutes, traffic control will be in conformance with Case VII.
3. All signs are to be removed at completion of the day's operations.
4. For divided roadways the required advance warning signs shall be posted on both the right and left side of the roadway.
5. Signs mounted in the median may be omitted when the median is less than 10 feet wide.
6. For multilane roadways the advance warning signs for traffic approaching from the opposite direction will be omitted.
7. MEN WORKING signs are to be removed when no work is being performed. Any unattended obstacle or excavation in the work area, which in the opinion of the engineer constitutes a hazard, shall be protected by Type I or Type II Barricades at 50-foot centers with flashing lights or torches at night. When used, torches must be placed on the ground. If the hazard exceeds 100 feet in length, steady burning lights shall be substituted for flashing lights or torches. When the distance is greater than 250 feet, barricade spacing may be increased to 100 feet.
8. If the work operation requires that four or more work vehicles enter the through traffic lanes in a one-hour period, a flagman shall be provided and the FLAGMAN AHEAD sign shall be substituted for the MEN WORKING sign.
9. Longitudinal dimensions may be adjusted slightly to fit field conditions.
10. All warning signs shall have minimum dimensions of 48 in. by 48 in. and have black legend and border on an orange reflectorized background.
11. All vehicles, equipment, men and their activities are restricted at all times to one side of the pavement unless otherwise authorized by the Engineer.

CASE V

RURAL MOVING OPERATIONS DAY OPERATIONS ONLY

Where, at any time, any vehicle, equipment, men or their activities require an intermittent or continuous moving operation on the shoulder.

TYPICAL APPLICATIONS

Shoulder Work
Mowing
Utility Operations

SYMBOLS



Work Area.



Sign with 18 in. by 18 in. (minimum) orange flag attached.



Sign on portable or permanent support.


STATE OF ILLINOIS DEPARTMENT OF TRANSPORTATION		ISSUED 4-3-69	
APPROVED <i>L.E. Moberly</i> 1973		REVISOR	
Engineer of Traffic		BY DATE	

STANDARD 2305-3


STANDARD DESIGN

TYPICAL APPLICATION OF TRAFFIC CONTROL DEVICES FOR HIGHWAY CONSTRUCTION AND CONTRACT MAINTENANCE


- A. For any operation that encroaches in the area between the center line and a line 2 ft. outside the edge of the pavement for a period of less than 15 minutes.

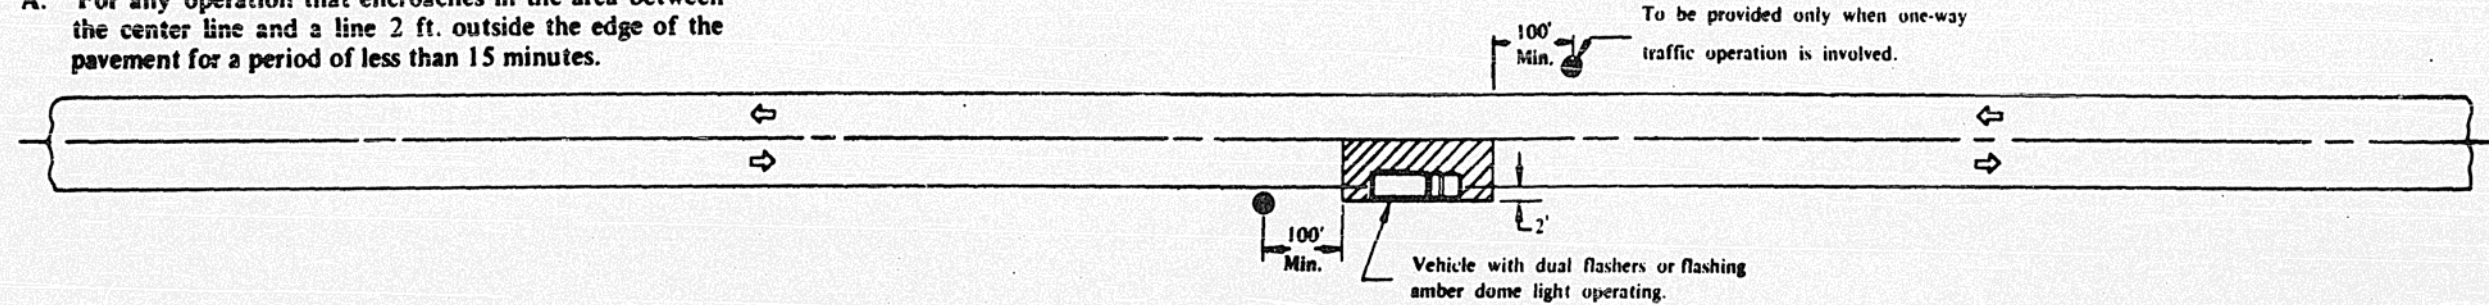

- B. For any operation that encroaches in the area between the center line and a line 2 ft. outside the edge of the pavement for a period of 15 minutes but less than 60 minutes.

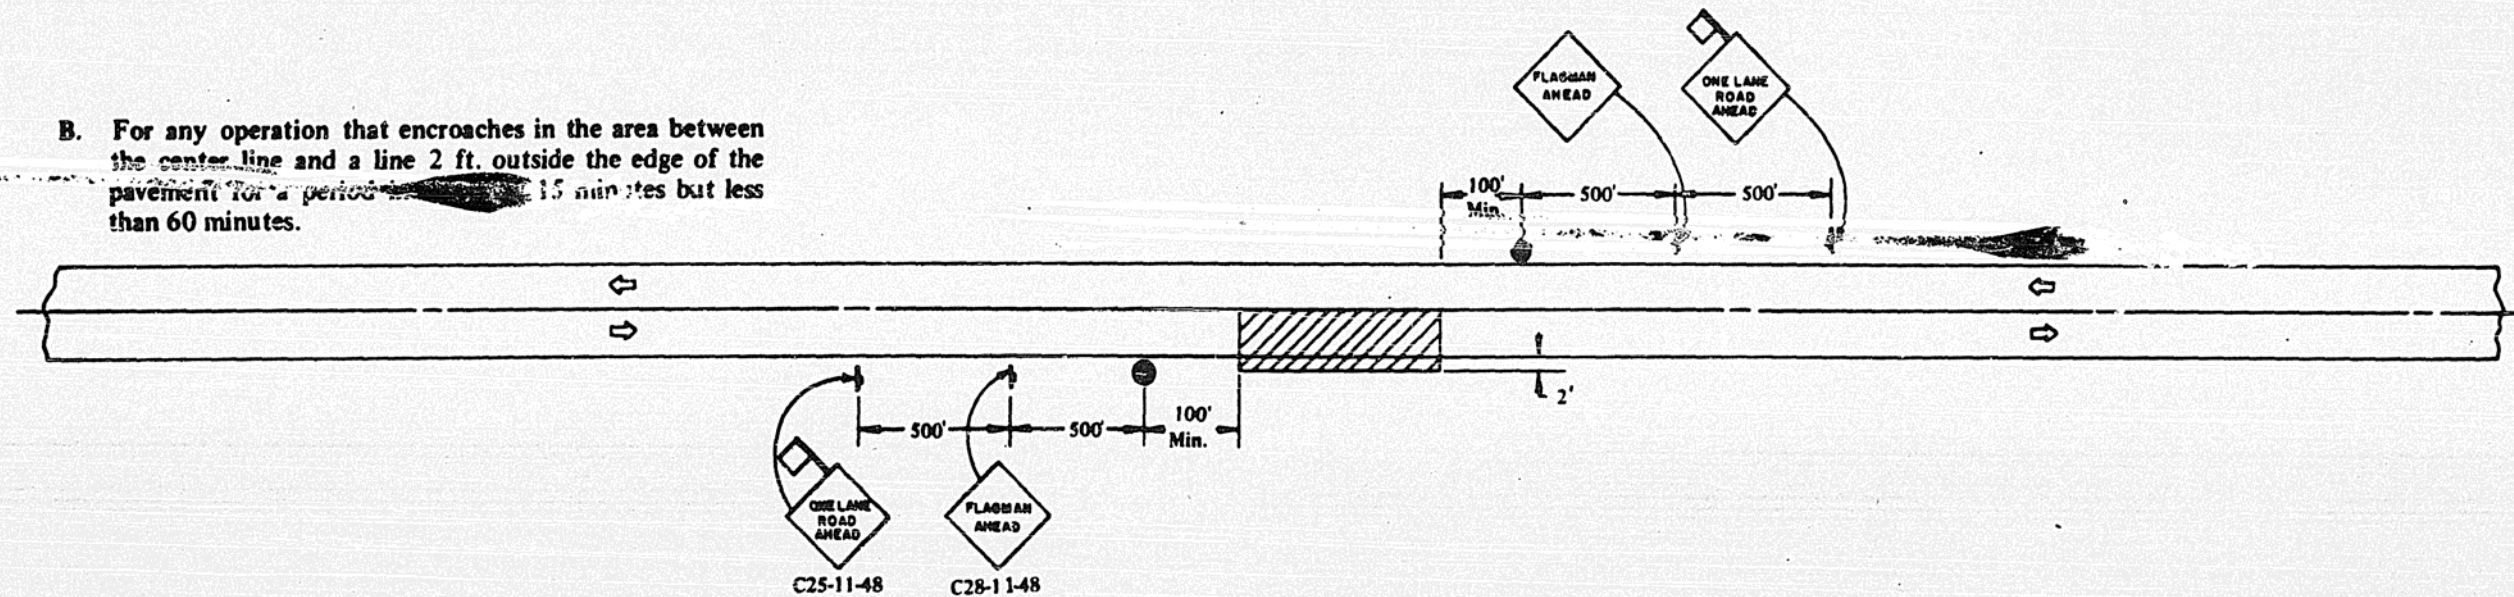

- C. For any operation that is more than 2 ft. outside the edge of the pavement for a period of less than 60 minutes.

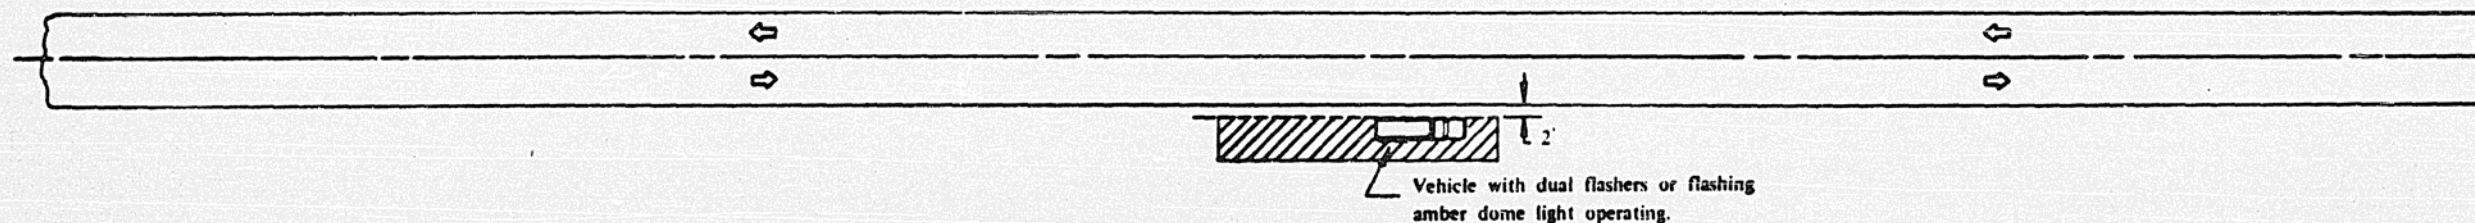

TYPICAL APPLICATIONS

Marking Patches
Field Survey
String Line
Utility Operation
Cleaning Up Debris on Pavement

SYMBOLS

- Work Area.
- Sign with 18 in. by 18 in. (minimum) orange flag attached.
- Sign on portable or permanent support.
- Flagman with Traffic Control sign.

GENERAL NOTES

- Construction operations shall be confined to one traffic lane. On two-lane roads, at least 500 ft. of both traffic lanes shall be available for traffic movement at intervals not greater than 1,000 ft. and a complete traffic control plan must be approved for any project expected to exceed 1,000 ft. in length.
- The flagmen shall be in sight of each other or in direct communication at all times.
- All signs are to be removed at completion of each operation.
- For multilane roadways the flagman shown for traffic approaching from the opposite direction will be positioned as directed by the Engineer and the advance warning signs for traffic approaching from the opposite direction omitted.
- Longitudinal dimensions may be adjusted slightly to fit field conditions. The lateral placement of the flagmen may be varied from that shown.
- All warning signs shall have minimum dimensions of 48 in. by 48 in. and have black legend and border on an orange reflectorized background.
- All vehicles, equipment, men (except flagmen) and their activities are restricted at all times to one side of the pavement unless otherwise authorized by the Engineer.

CASE VII


SHORTTIME OPERATIONS
DAY OR NIGHT OPERATIONS

STATE OF ILLINOIS DEPARTMENT OF TRANSPORTATION	ISSUED 4-3-69 REVISED BY DATE
APPROVED <i>L.E. Murphy</i> Engineer of Traffic	

STANDARD 2307-4

STANDARD DESIGN

TYPICAL APPLICATION OF TRAFFIC CONTROL DEVICES FOR HIGHWAY CONSTRUCTION AND MAINTENANCE

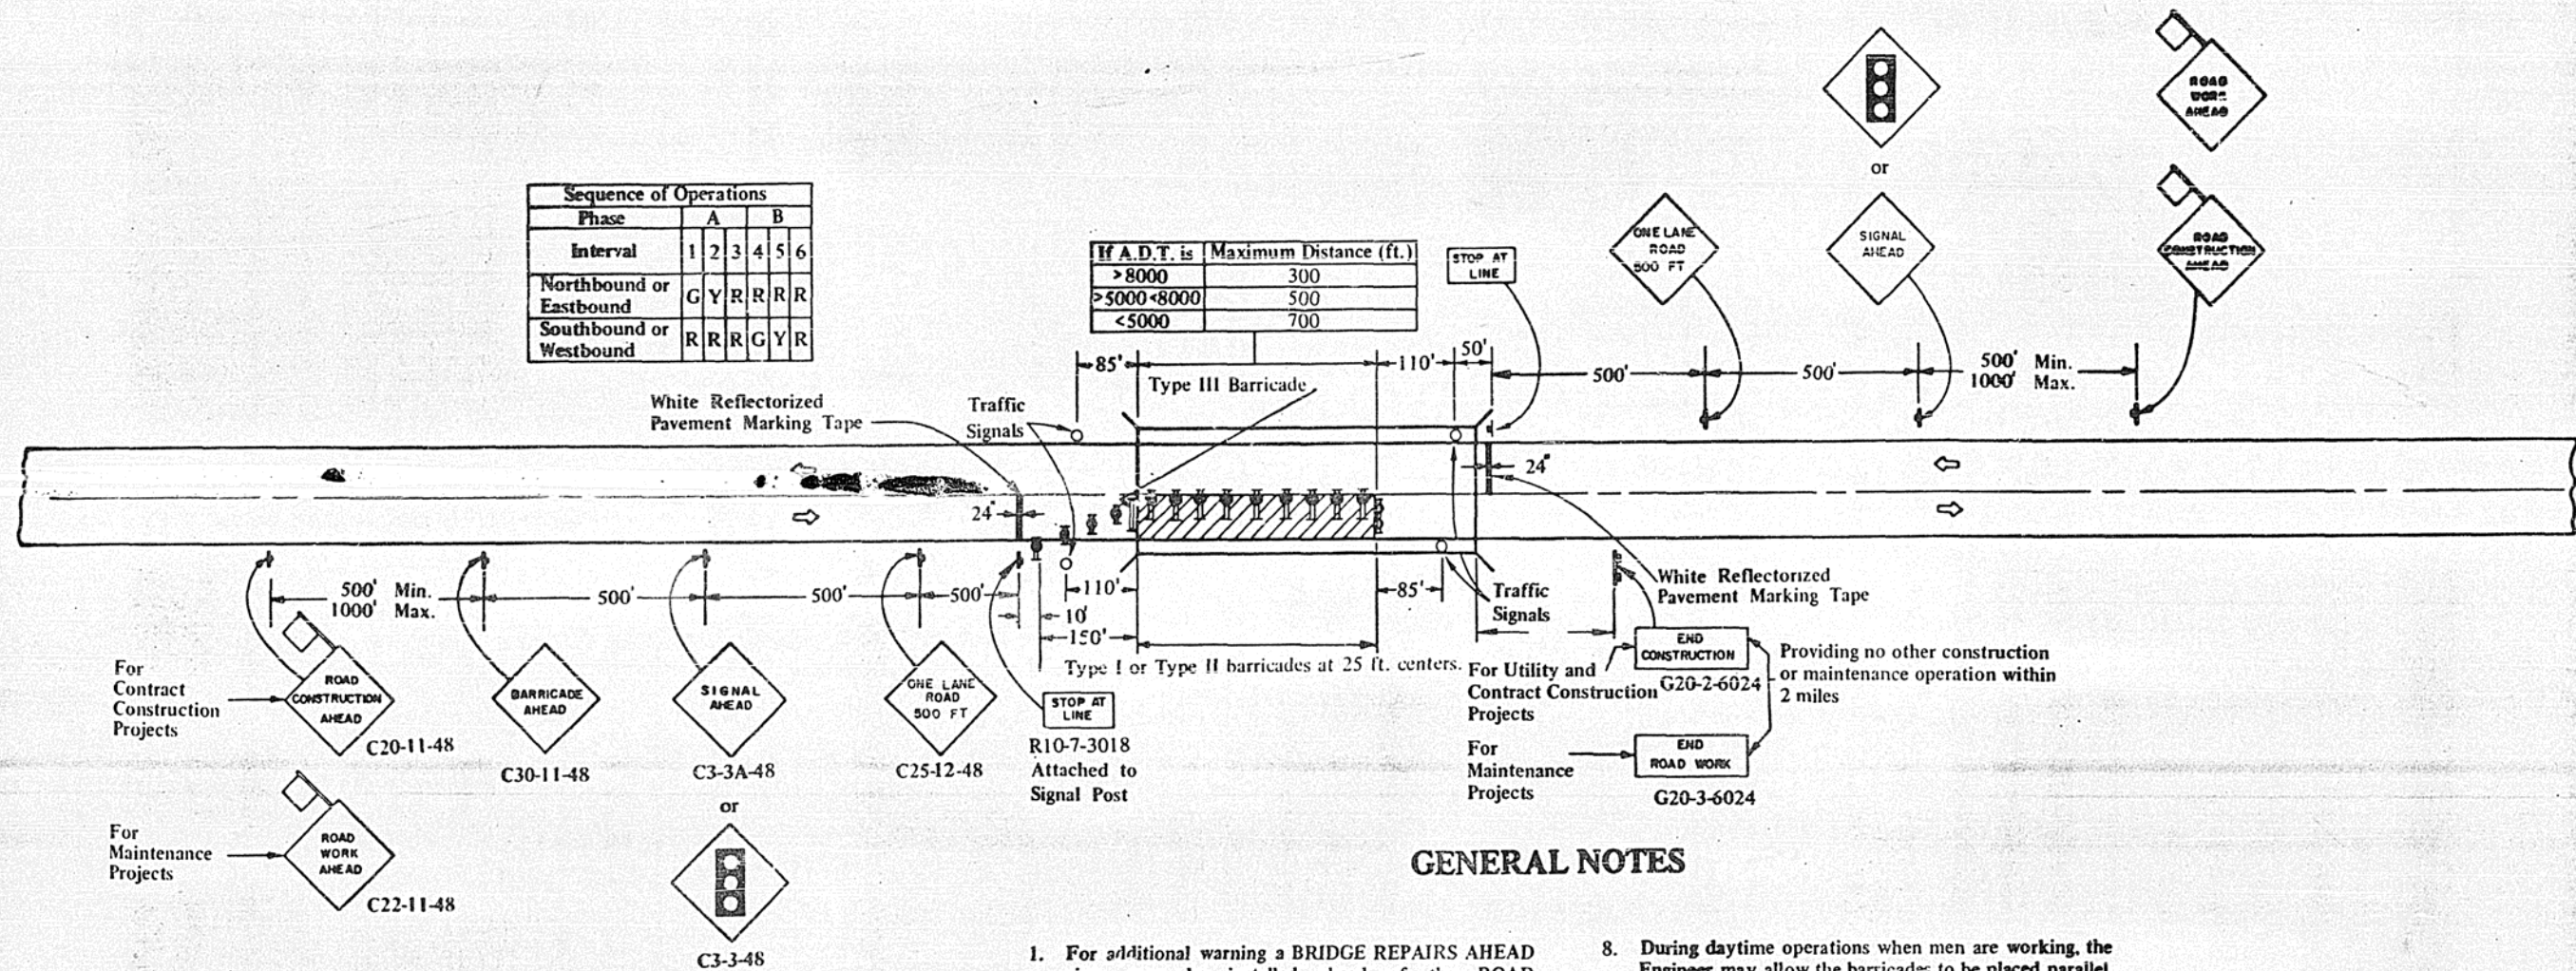

GENERAL NOTES

- For additional warning a BRIDGE REPAIRS AHEAD sign may be installed ahead of the ROAD CONSTRUCTION AHEAD or ROAD WORK AHEAD sign. The distance between successive signs shall be 500 ft.
- The Engineer must be notified at least 72 hours prior to placing the temporary signals in operation so that arrangements can be made to inspect the installation and set the timing of the signals. The Contractor must furnish timing cycle gears of 60, 65, 70, 80, 90, 100, and 110 seconds for the controller.
- At any time that the signals are not operating the signal head shall be hooded and the SIGNAL AHEAD sign covered or removed.
- The left signal head shall normally be mounted at a height of 10 feet above the road surface measured to the bottom of the signal head. The right head shall normally be mounted at a height of 14 feet above the road surface. Baffle plates will be required on all signals.
- All red lenses shall normally be 12-inch nominal diameter. The right signal head shall be aimed so the centers of the light beams of the indications are directed toward a point in the center of the approach lane 500 feet in advance of the signal. The left indication shall be aimed at a point in the center of the approach lane 100 feet in advance of the stop line.
- If flagmen are used instead of traffic signals, the traffic control devices shall conform to Case III or Case IV.
- Cones may be substituted for barricades with steady burning lights at half the spacing during daytime operations.
- During daytime operations when men are working, the Engineer may allow the barricades to be placed parallel to the center line.
- Steady burning lights will not be required for day operations.
- The taper shall be formed by placing one barricade for each two foot of lane width.
- Bidirectional lights shall be used at night along the center line whether the work area is separated from the travelled lane using barricades or by using other devices. Monodirectional lights shall be used at night on all other barricades.
- The Engineer may require drums, either 55 gallon or 30 gallon, to be used to supplement the barricades if the closure time exceeds four days.
- All signs shall be post mounted if the closure time exceeds four days.
- High intensity flashing lights shall be used on each approach in advance of the work area during hours of darkness and installed above the first two signs in each series.
- Longitudinal dimensions may be adjusted slightly to fit field conditions.
- All warning signs shall have minimum dimensions of 48 in. by 48 in. and have black legend and border on an orange reflectorized background. All signs other than warning signs shall have a minimum the dimensions shown and shall have a black legend and border on a white reflectorized background.
- All vehicles, equipment, men and their activities are restricted at all times to one side of the pavement unless otherwise authorized by the Engineer.
- Form BT 725 is required.

SYMBOLS

- Work Area.
- Sign with 18 in. by 18 in. (minimum) orange flag attached.
- Sign on portable or permanent support.
- Type I or Type II Barricade with flashing lights.
- Type I or Type II Barricade with steady burning light.

TYPICAL APPLICATION

Bridge Deck Repair

STATE OF ILLINOIS DEPARTMENT OF TRANSPORTATION	ISSUED 4-3-69 REVISED BY DATE
APPROVED 6-12-1973 E. E. Moberly Engineer of Traffic	

CASE IX

TWO-LANE, TWO WAY TRAFFIC,
RURAL ONE LANE CLOSURE ON
A BRIDGE DECK DAY OR NIGHT
OPERATIONS

Where, at any time, any vehicle,
equipment, men or their activities will
encroach on one lane of a bridge deck
and traffic signals are required.

STANDARD 2309-3

TYPICAL APPLICATION OF TRAFFIC CONTROL DEVICES FOR HIGHWAY CONSTRUCTION AND MAINTENANCE



- ## CASE XII

**TWO-LANE, TWO WAY TRAFFIC
RURAL WORK AREAS IN SERIES
DAY OR NIGHT OPERATIONS**

Where, at any time, any vehicle, equipment, men or their activities will encroach in the area between the center line and a line 2 ft. outside the edge of pavement.

STANDARD 2312-5

Cable Laying
Overhead Stringing of Cable
Patching

 Patch

Sign with 18 in. by 18 in. (minimum) orange flag attached.


Sign on portable or permanent support.

Flagman with Traffic Control sign.


Type I or Type II Barricade with flashing light.

Type I or Type II Barricade with steady burning light.

STATE OF ILLINOIS DEPARTMENT OF TRANSPORTATION		ISSUED 4-3-69 REVISED BY DATE
APPROVED <u>6-12</u> 197 <u>3</u> <i>L. E. McHenry</i> Engineer of Traffic		

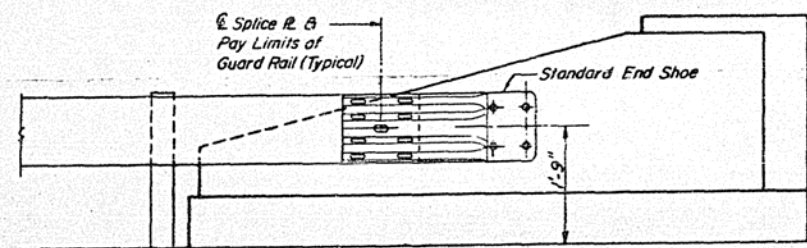


ELEVATION

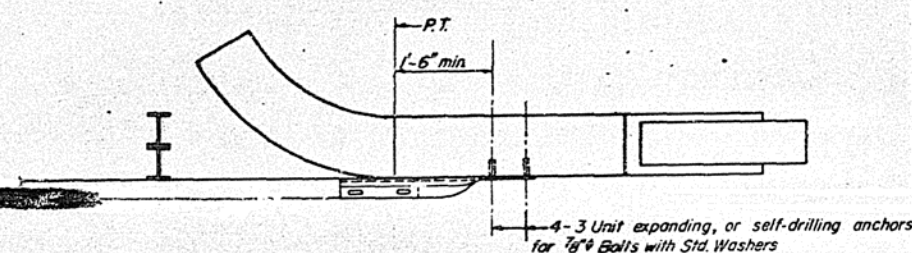


PLAN

CURVED WING

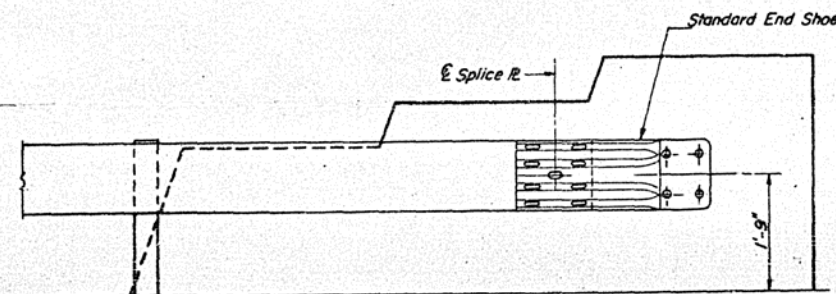


ELEVATION

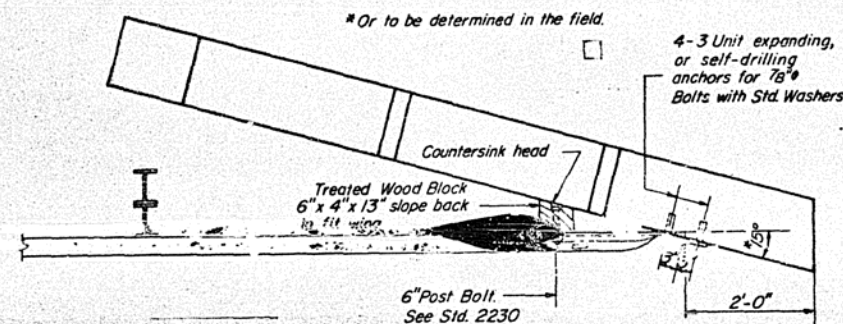


PLAN


FLARED WING

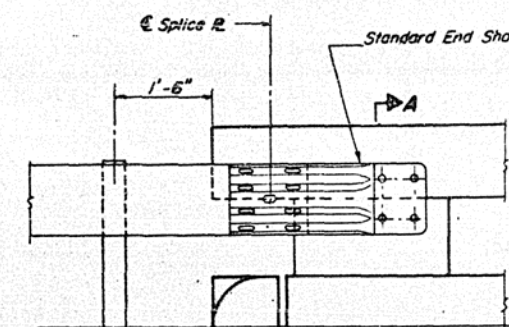


ELEVATION

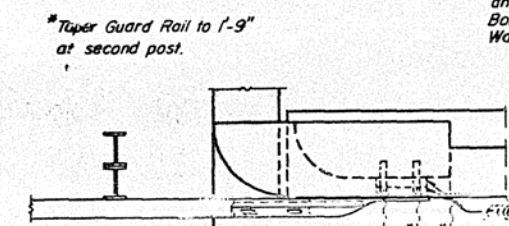

PLAN

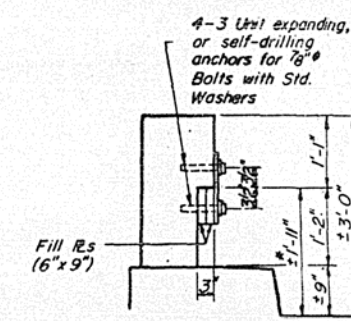


SECTION A-A
(High Rail)

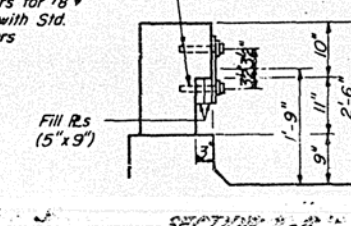


SECTION B-B
(Low Rail)

R.C. HANDRAIL

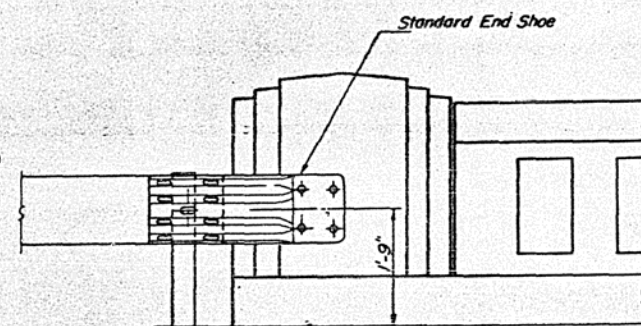

ELEVATION

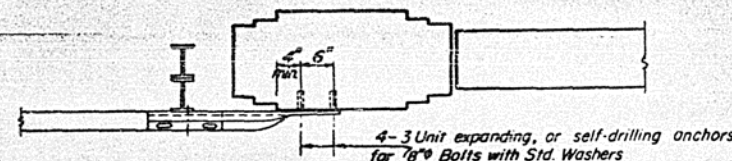

PLAN

CONCRETE HANDRAIL

NOTES

Materials and strength requirements for the Standard End Shoe shall conform to that shown for the "Steel Plate Beam Guard Rail" in the Standard Specifications.

The Contractor shall be required to load test 10% of the expansion anchor bolts in place in the presence of the Engineer. The equipment and method used for load testing shall meet the approval of the Engineer. The minimum test load shall be 8000 pounds in direct pull. For each anchor that fails to pass the minimum test load requirements, two (2) more anchor bolts, picked by the Engineer shall be tested. Each anchor bolt tested that fails to meet the test load requirement shall be reset or removed and the hole drilled deeper. After the anchor bolt is reset, the new setting shall be retested.

The minimum edge distance (distance from any anchor to edge of existing concrete) shall be six (6) inches unless otherwise shown.

If the existing name plate is covered completely or partially by the end shoe, the name plate shall be moved to an adjacent area along the rail or end post.

Pay limits of guard rail shall be at E. of end shoe splice. Cost of Standard End Shoe and attachments shall be included in cost of TRAFFIC BARRIER TERMINAL, TYPE 10 (One Each)

Place end shoe between guard rail and splice plate with the guard rail on the roadway face.

For details of guardrail not shown see Standard 2230

The Standard End Shoe shall be attached to the existing concrete with Pre-drilled or Self-drilling anchor bolts. The anchor cone shall be set flush with the surface of the concrete. Externally threaded studs protruding from the surface of the concrete will not be permitted.

Illinois Department of Transportation

ISSUED 9-25-70

REVISIONS

PASSED Aug 1, 1977
Engineer of Bridge and Traffic Structures
APPROVED Aug 1, 1977
Engineer of Design


D.W.W. 2-1-74
D.W.W. 8-1-77

TRAFFIC BARRIER TERMINAL
TYPE 10

STANDARD 2326-2

Full Size


F-3.210

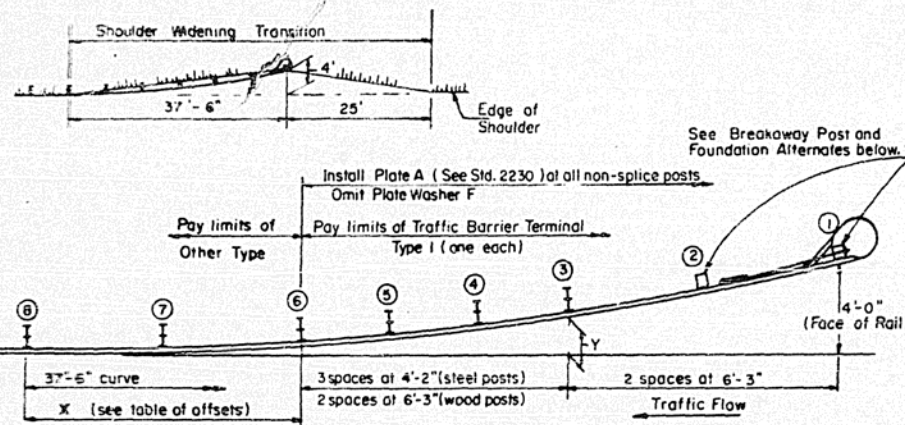



PLAN TYPE I

Post	X	Y
1	37.22	4.00
2	31.09	2.79
3	24.92	1.79
4	20.79	1.25
5	16.64	0.80
6	12.49	0.45
7	6.25	0.11
8	0.00	0.00


NOTE:
The 1'-0" minimum dimension should be increased if the slope adjacent to the barrier is 10:1 or flatter.

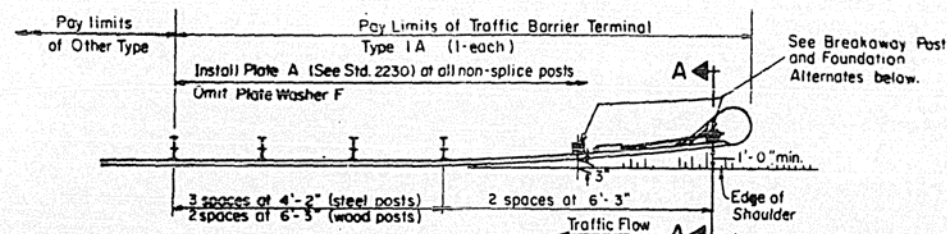



PLAN TYPE 1A

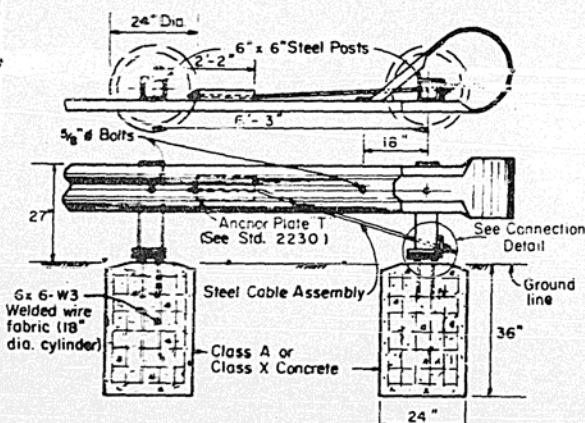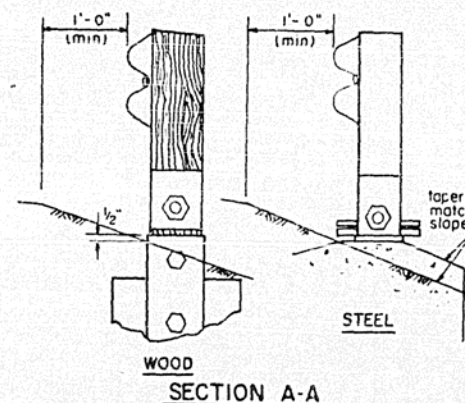


STEEL BREAKAWAY POSTS - CONCRETE FOUNDATIONS

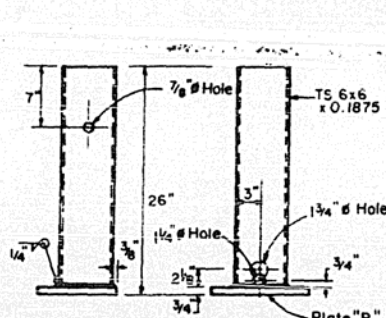


STEEL BREAKAWAY POST (2 ea.)

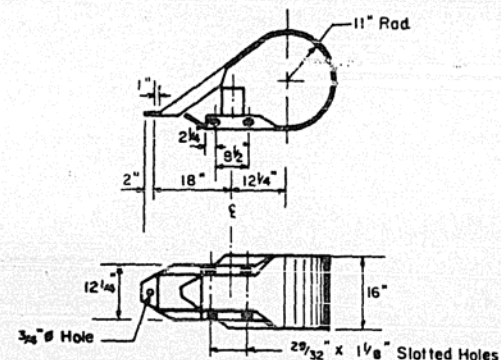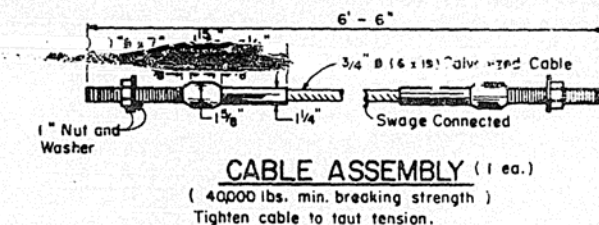




NOSE (1 ea.)

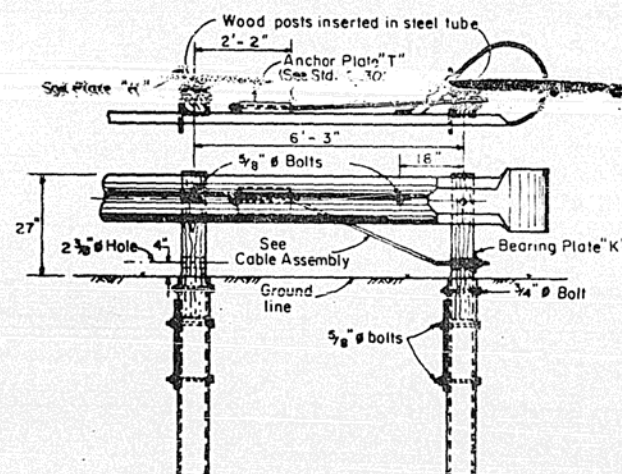

WOOD BREAKAWAY POSTS TUBULAR STEEL FOUNDATIONS

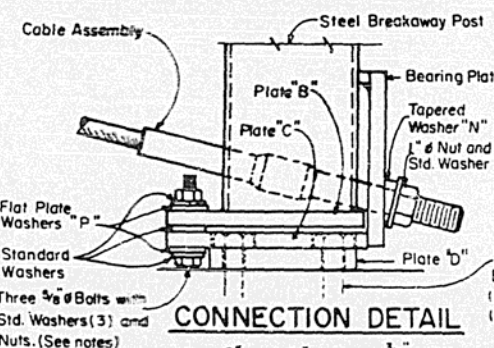

CONNECTION DETAIL

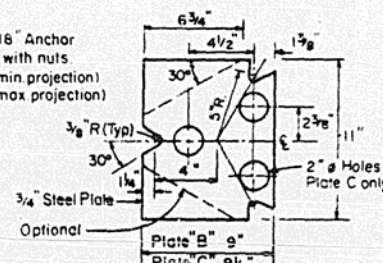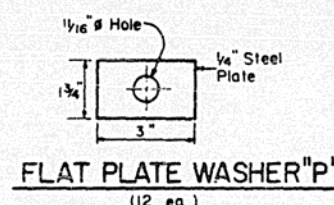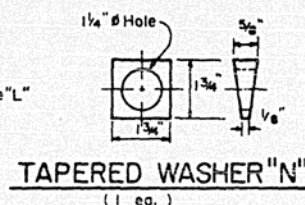

PLATES "B" & "C" (2 ea. "B", 2 ea. "C")




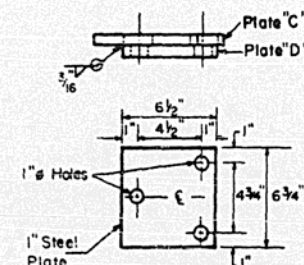


PLATE "D" (2 ea.)

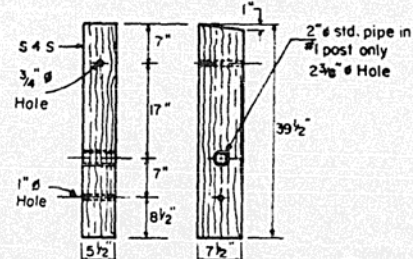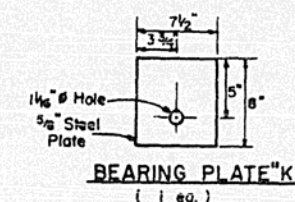

WOOD BREAKAWAY POST (2 ea.)

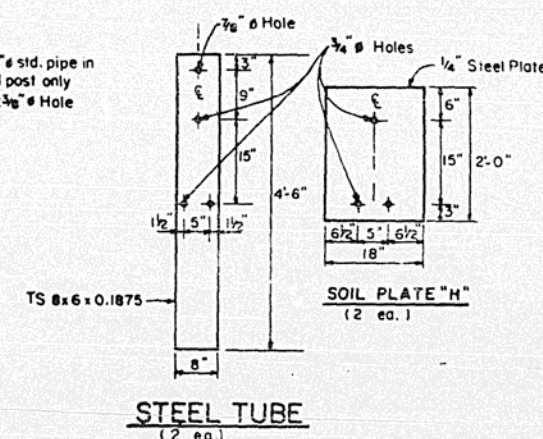

TRAFFIC BARRIER TERMINAL TYPE I & 1A

STANDARD 2336-1

Full Size (DWG. Sr.)

Minnesota Department of Transportation

PASSED Feb. 26, 1979


Engineer of Design Operations

APPROVED Feb. 26, 1979



Engineer of Road

ISSUED 4-5-78


F 3.25 0

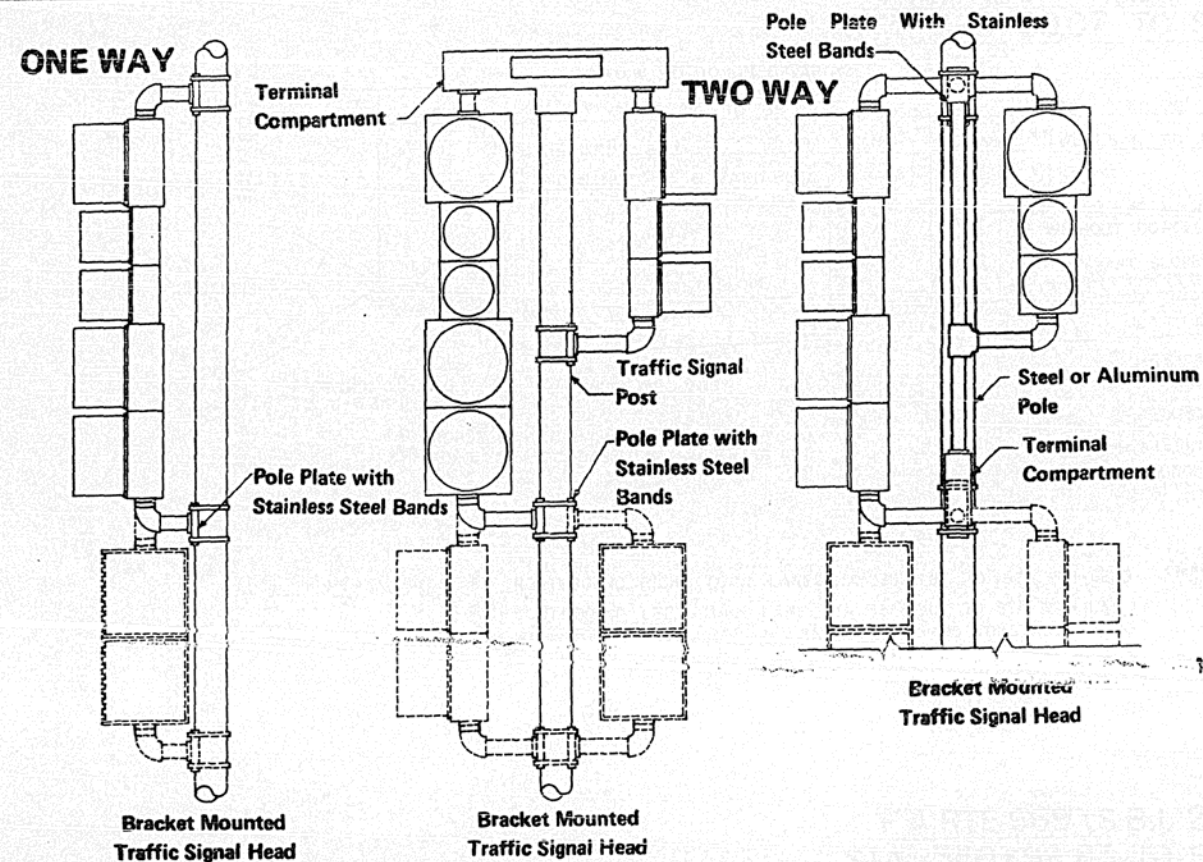

Note: The height of a bracket mounted signal head shall not be less than 8'-0" nor more than 15'-0" above the sidewalk or, if none, above the crown of the pavement.

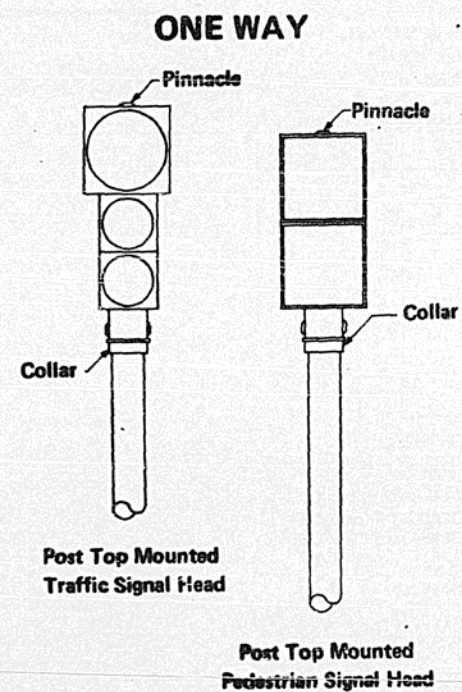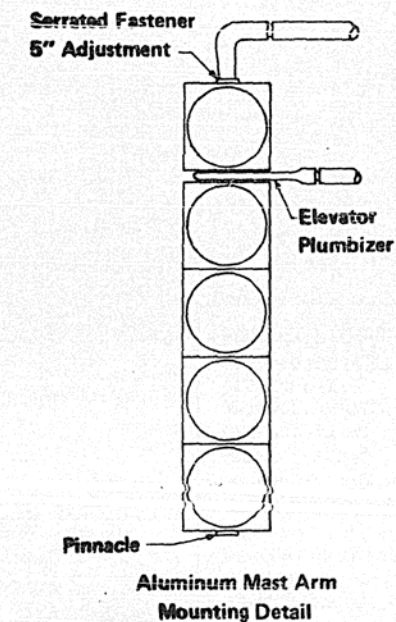

Note: Only traffic signal heads consisting of one face and three sections may be post top mounted.

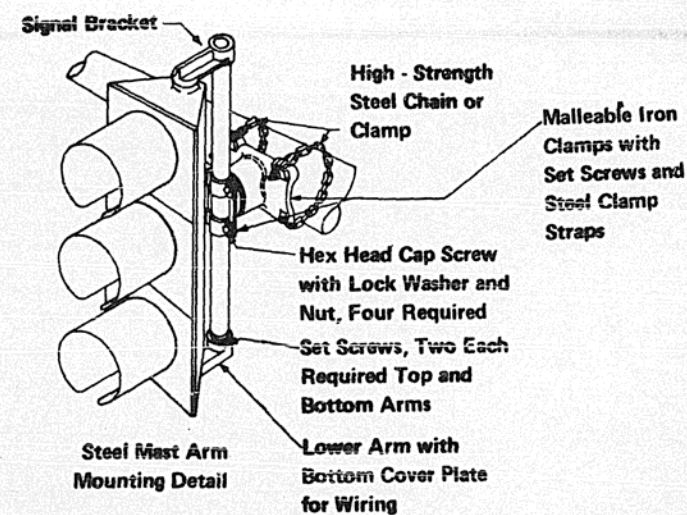

Note: Other Types of Mounting Brackets may be used upon approval by the Engineer

DETAILS FOR MOUNTING TRAFFIC SIGNALS



STANDARD NO. 2371




Illinois Department of Transportation

ISSUED 1-1-77
REVISED
BY DATE

APPROVED
3-18-1977
J. E. Mobley
Engineer of Traffic

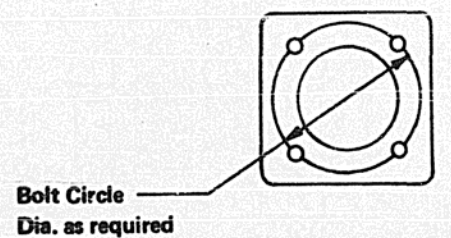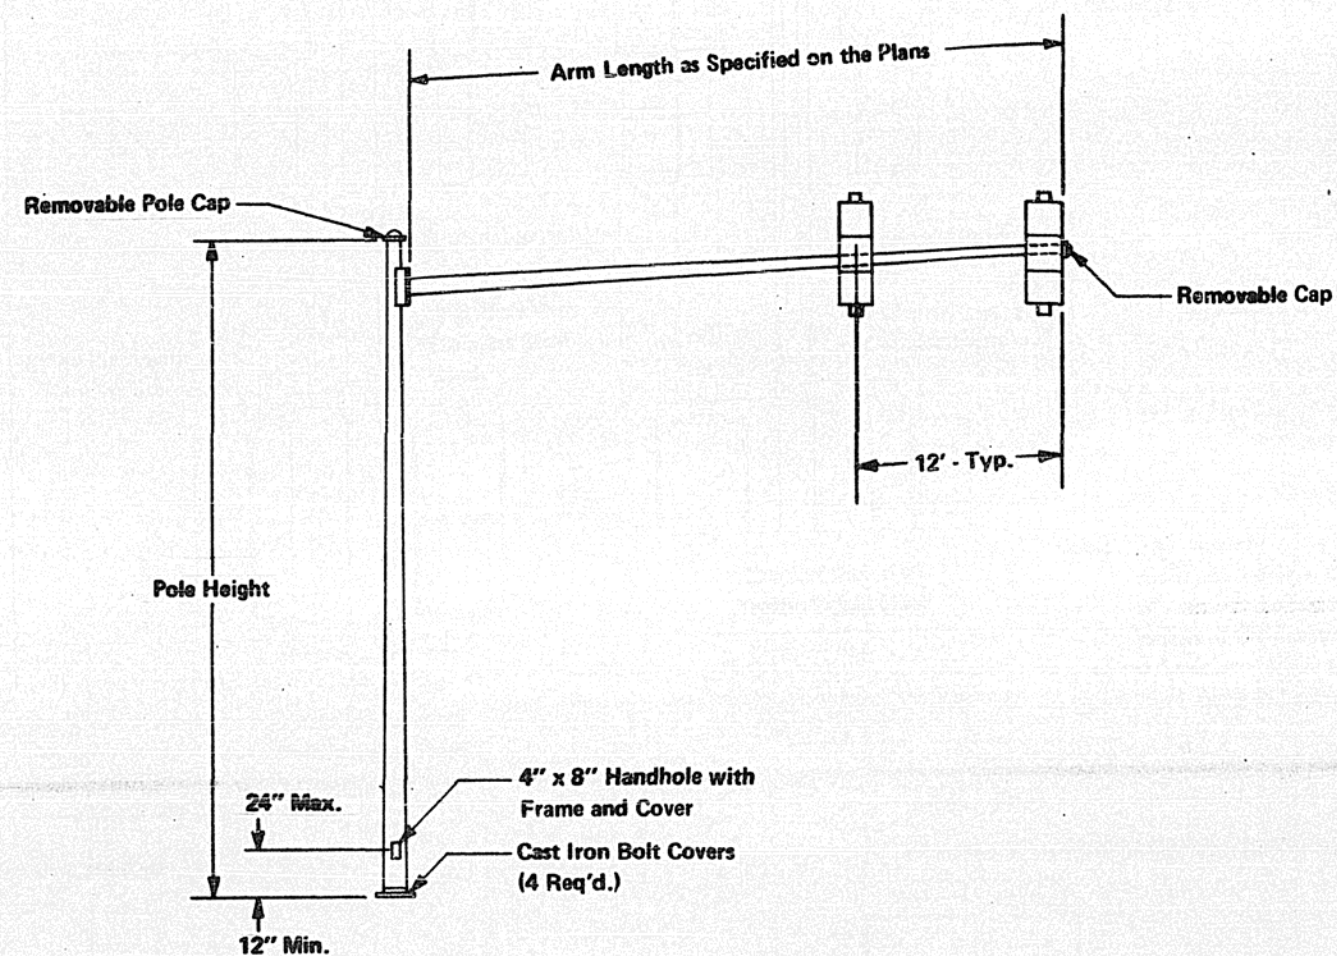

BASE PLATE

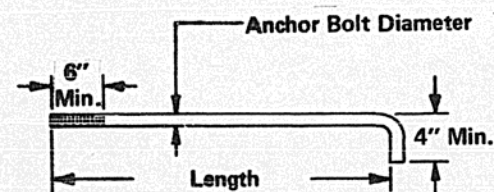

ANCHOR BOLT

The anchor bolts shall conform to the requirements of article 710.12 of the Standard Specifications for Road and Bridge Construction.


NOTES

1. Mast arm assembly and pole shall be constructed with one piece mast arm and pole or other equivalent sectional design.
2. This standard shall be designed to support one 80 pound signal with a projected area of 14.7 square feet at the free end of the mast arm, one 50 pound signal with a projected area of 8.7 square feet, 12 feet inward on the mast arm and one 125 pound signal with a projected area of 7.6 square feet mounted 12 feet high on the shaft or the signal loadings shown on the plans, whichever is greater. The design shall be in accordance with the requirements of the current "Standard Specifications For Structural Supports for Highway Signs, Luminaires, and Traffic Signals" as published by the American Association of State Highway and Transportation Officials for 80 m.p.h. wind velocity.
3. The contractor shall submit detailed drawings showing design materials, thickness of sections, and weld sizes to the Engineer for approval prior to fabrication. These drawings shall be at least 17" x 22" in size and of adequate quality for microfilming.
4. The type of signal mounting bracket to be used shall be approved by the Engineer.
5. The signal head (including, backplate when used) shall be not less than 16'-0" or more than 18'-0" above the roadway.


**DETAILS OF
STEEL MAST ARM ASSEMBLY
AND POLE**

STANDARD NO. 2374


Illinois Department of Transportation APPROVED <i>[Signature]</i> 3-18-1977 Engineer of Bridge and Traffic Structures APPROVED <i>[Signature]</i> 3-18-1977 Engineer of Traffic	ISSUED 1-1-77
	REVISED BY DATE

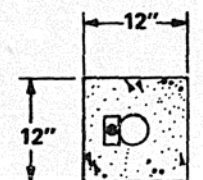


TOP VIEW

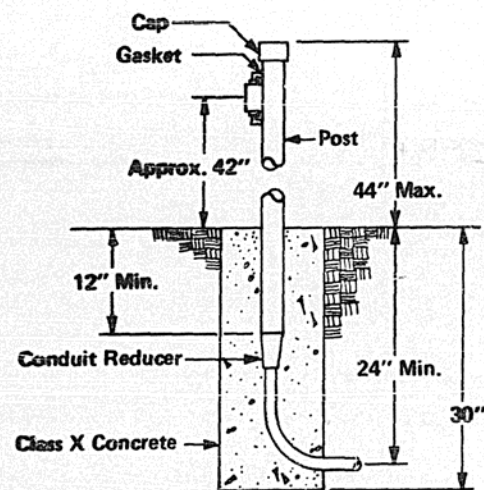

PEDESTRIAN PUSHBUTTON POST
INSTALLATION

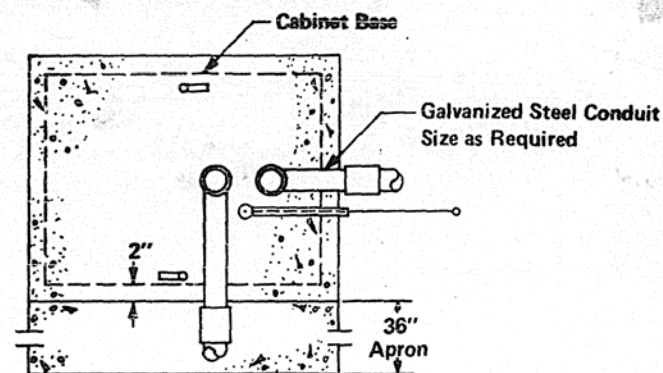


TOP VIEW

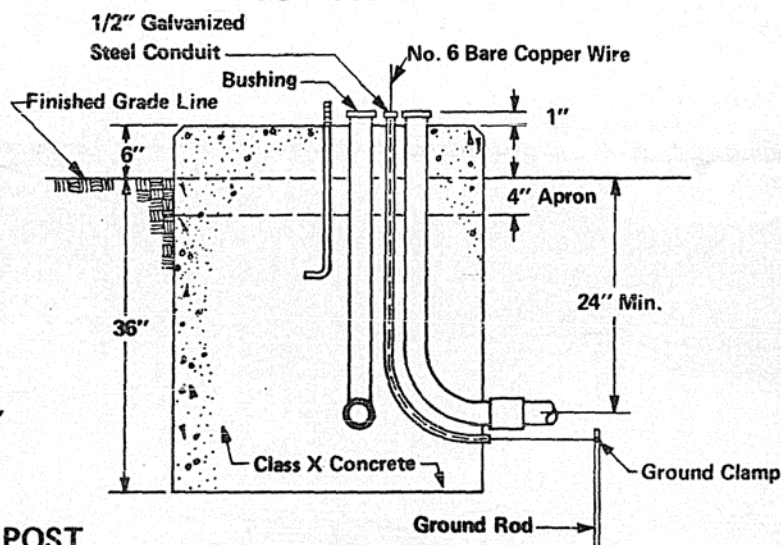


TYPE "D" FOUNDATION
FOR GROUND MOUNTED
CONTROLLER CABINET

Mast Arm Length	Dim. "A"	Dim. "B"	Number of No. 5 Rebars
Less Than 30'	24"	20"	6
30' and Longer	30"	26"	8

TOP VIEW

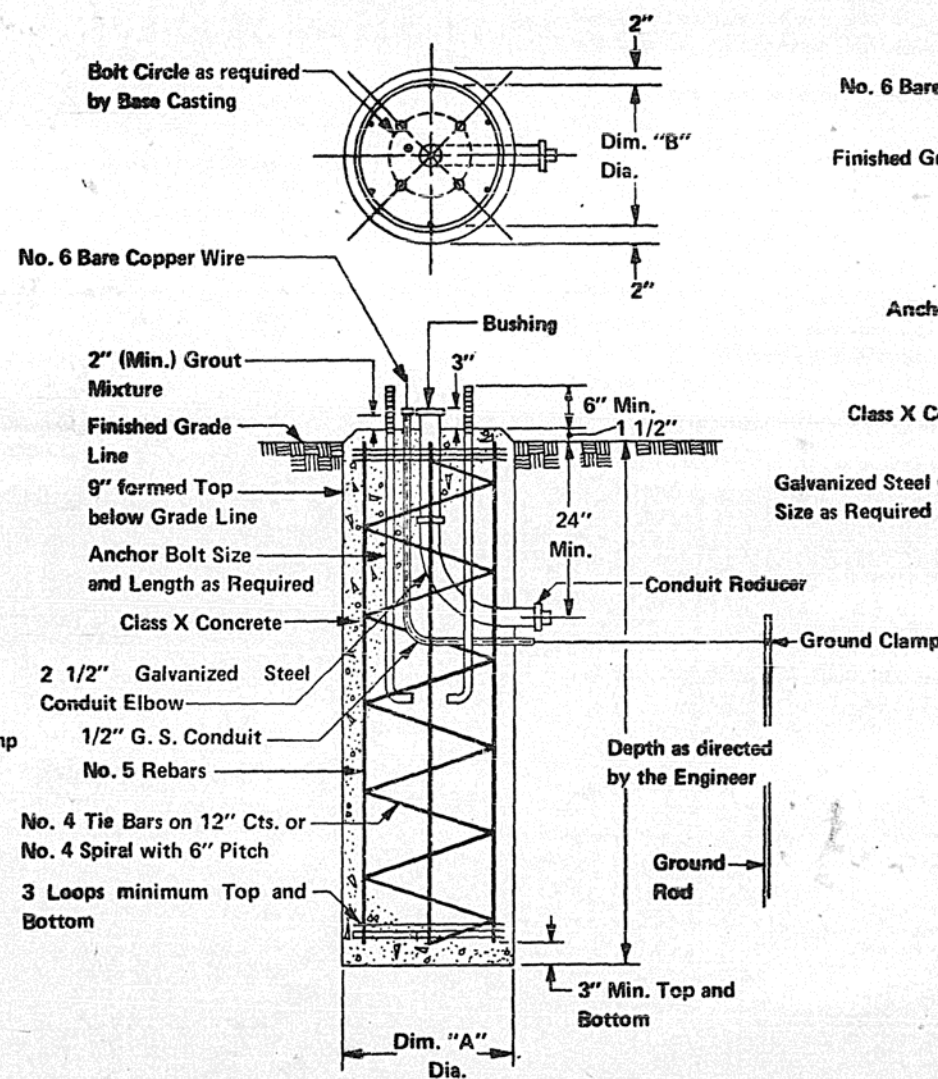

TYPE "E" FOUNDATION

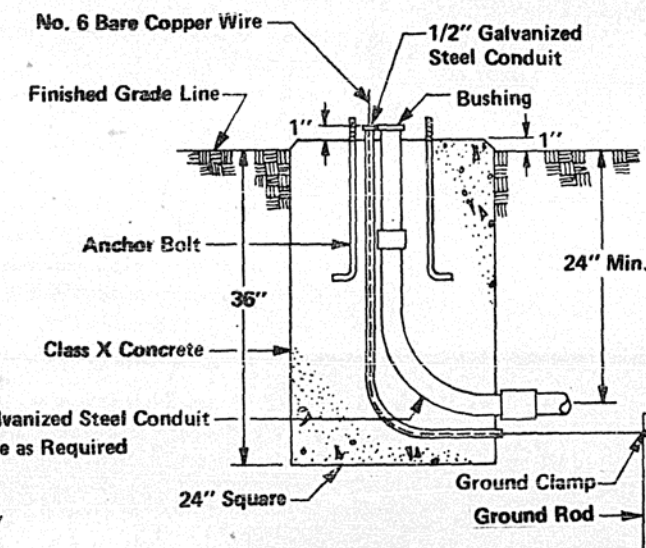

TYPE "A" FOUNDATION

NOTES


1. The dimensions of the type "D" foundation shall be 4" wider and longer than the base dimensions of the controller cabinet.
2. The ground rod shall be installed in the bottom of conduit trench.

DETAILS OF
CONCRETE FOUNDATIONS


STANDARD NO. 2378

ISSUED 1-1-77 REVISED BY DATE	
APPROVED 3-10-1977 [Signature] Engineer of Bridge and Traffic Structures	APPROVED 3-10-1977 [Signature] Engineer of Traffic

SEDIMENT BASIN


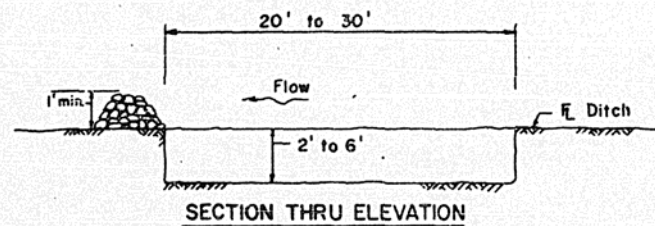


The performance of the basin will improve if put into a series.


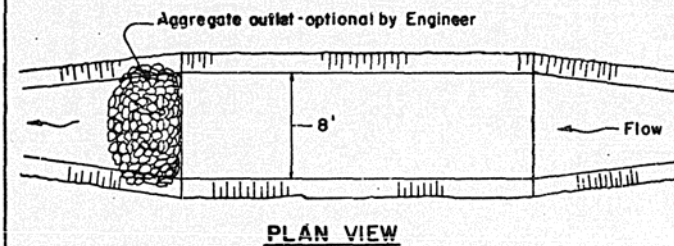


The long dimension should be parallel with the direction of the flow. Accumulated silt shall be removed anytime the basins become 75% filled.


HAY OR STRAW DITCH CHECK

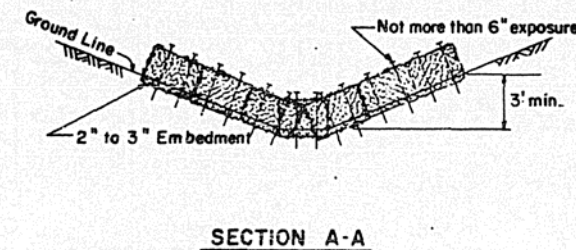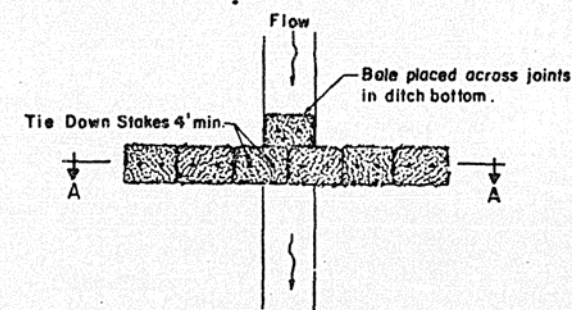


HAY OR STRAW DITCH CHECK - TWO BALES HIGH

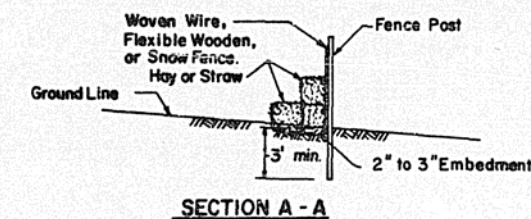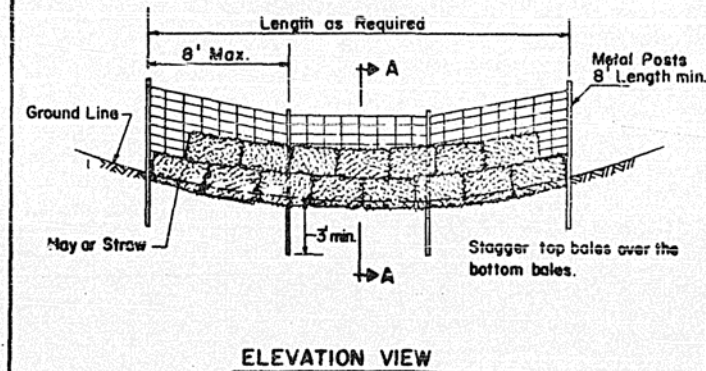



HAY OR STRAW EROSION CHECK STONE OUTLETS

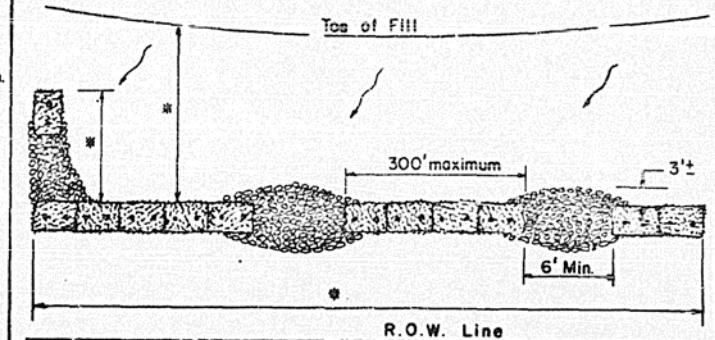

PLAN VIEW

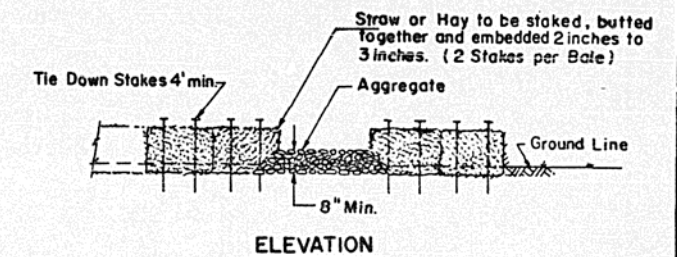


TEMPORARY DITCHES FOR CUT & FILL SECTIONS

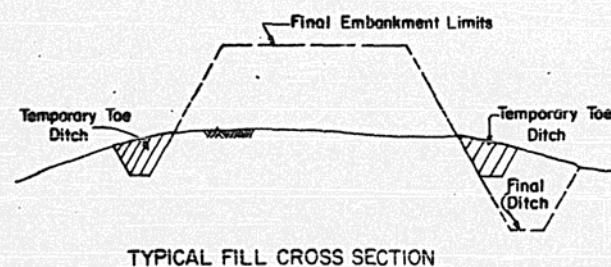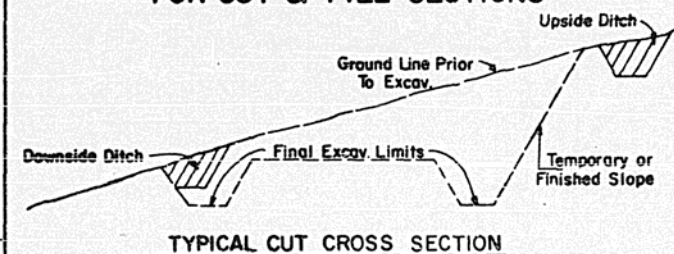



Temporary Ditches or the final ditch grades included in the plans shall be excavated at the earliest opportunity during construction in order to control runoff from the embankment or cut section per Art. 202.06 of the Standard Specifications. Some means of trapping siltation should be provided at the outflow of these ditch systems.

AGGREGATE DITCH CHECK

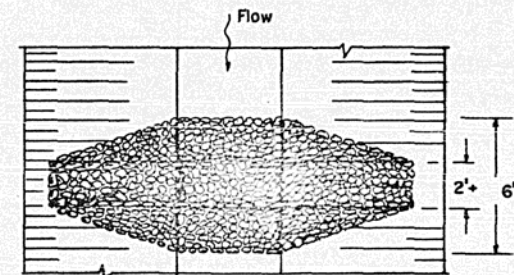

To be constructed by depositing material and shaping in a manner approved by the Engineer. If the ditch check is within the clear zone and the road is open to traffic, the traffic approach slope of the aggregate shall be graded to 4:1.

MULCH BARRIER

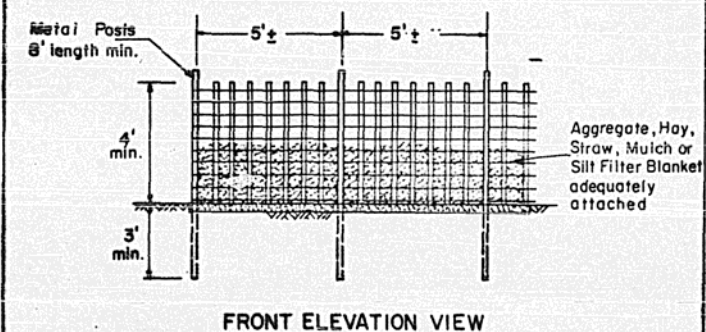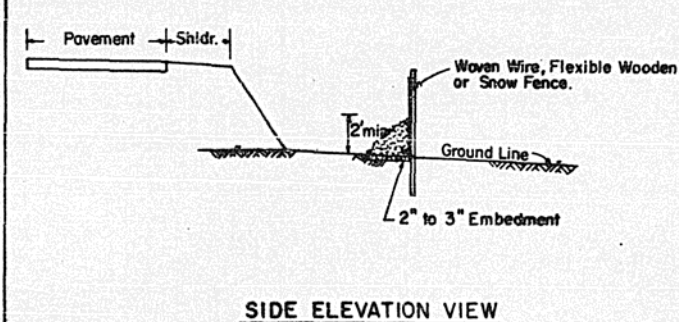

GENERAL NOTES

Actual configuration and location of Temporary Erosion Control Systems shall be as shown on the plans or as directed by the Engineer.

Ditch Checks and Sediment Basins should be constructed at appropriate intervals along the waterway to be effective.

Where more than one row of bales are used, stagger bales to cover joints.

Where bales are shown staked, a minimum of two stakes per bale shall be used.

The Temporary Erosion Control Systems installed by the Contractor shall be properly maintained as directed by the Engineer to control siltation at all times during the life of the contract.

All salvageable temporary erosion control items shall be removed and become the property of the Contractor at the completion of the contract.

Existing R.O.W. fence may be utilized if such location is desired with use of Mulch Barrier or Hay or Straw Ditch Check - Two Bales High.

TEMPORARY EROSION
CONTROL SYSTEMS

STANDARD 2381

Full Size D.W.W. Sr.

A-12.25

State Department of Transportation

PASSED *[Signature]* May 6, 1979
Engineer of Design Operations

APPROVED *[Signature]* May 6, 1979
Engineer of Design

ISSUED 3-6-79