


 PAVEMENT PATCH
 IMPACT ATTENUATORS, TEMPORARY
 (NON-REDIRECTIVE), TEST LEVEL 2

F.A.P. RTE.	SECTION	COUNTY	TOTAL SHEETS	SHEET NO.
328	5R, Y, RS-1	CLAY	242	31
STA. TO STA.				
FED. ROAD DIST. NO. 7		ILLINOIS	FED. AID PROJECT	
CONTRACT NO. 74078				

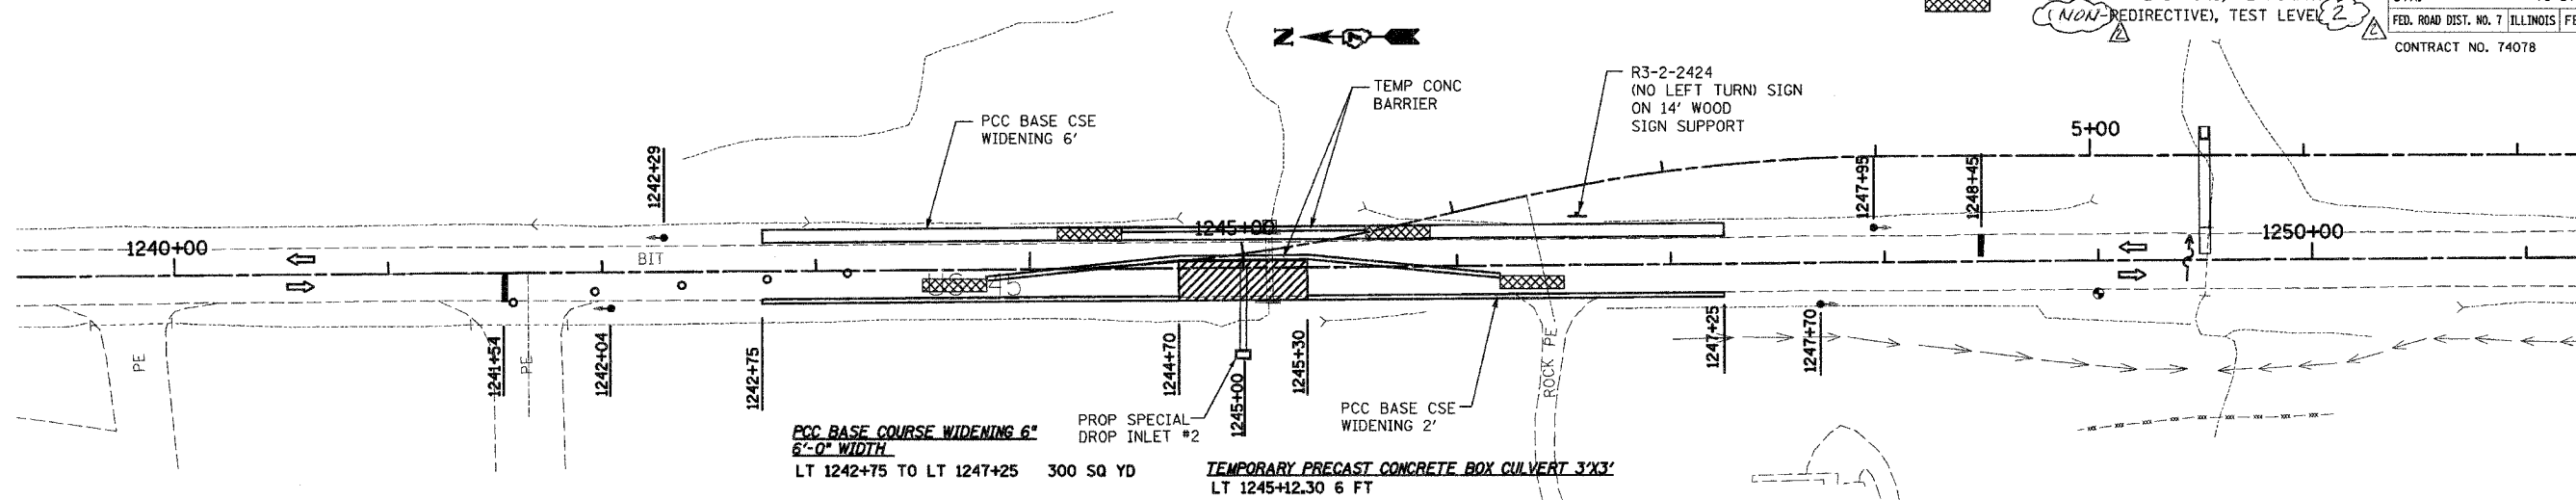

PCC BASE COURSE WIDENING 6" PROP SP
6'-0" WIDTH DROP INI

LT 1242+75 TO LT 1247+25 300 SQ YD

TEMPORARY PRECAST CONCRETE BOX CULVERT 3'X3'
LT 1245+12.30 6 FT

PCC BASE COURSE WIDENING 6"
2'-0" WIDTH

PAVEMENT PATCHING, TYPE IV, 10 INCH
RT 1244+70 TO RT 1245+30 93 SQ YD

TEMPORARY RUMBLE STRIPS

RT 1224+54	1 EACH	LT 1255+45	1 EACH
RT 1229+54	1 EACH	LT 1260+45	1 EACH
RT 1234+54	1 EACH	LT 1265+45	1 EACH

TEMPORARY CONCRETE BARRIER (STATE OWNED)
CL 1243+80 TO 1246+20 240 FT
LT 1244+50 TO 1245+50 100 FT

IMPACT ATTENUATORS, TEMPORARY (REDIRECTIVE), TEST LEVEL 2 ^{7/2/14}

CL 1243+80	1 EACH
CL 1246+20	1 EACH
LT 1244+50	1 EACH
LT 1245+50	1 EACH

WORK ZONE PAVEMENT MARKING REMOVAL
CL 1244+03 TO 1245+98 64 SQ FT
LT 1242+75 TO 1247+25 149 SQ FT



~~TEMPORARY PAVEMENT MARKING - LINE 4~~
~~CL 1244+03 TO 1245+98 195 FT~~
~~LT 1242+75 TO 1247+25 450 FT~~

TEMPORARY BRIDGE TRAFFIC SIGNAL
1 EACH

NOTES:
ALL TRAFFIC CONTROL SHALL BE IN ACCORDANCE
WITH STANDARD 701321.
THE R3-2-2424 SIGN AND WOOD POST
REQUIRED AT THIS LOCATION WILL NOT
BE PAID FOR SEPARATELY BUT WILL BE
CONSIDERED AS INCIDENTAL TO
STANDARD 701321.

SUGGESTED SEQUENCE (MAJOR ITEMS NOTED)

CONSTRUCT BOX CULVERT EXTENSION AND COLLATERAL EARTHWORK FOR SHOULDER WIDENING.
CONSTRUCT PCC BASE CSE WIDENING ALONG WEST EDGE OF SHOULDER AND REMOVE GUARDRAIL.
CONSTRUCT PCC BASE COURSE WIDENING ALONG EAST EDGE OF SHOULDER.
INSTALL TEMPORARY TRAFFIC SIGNALS.
INSTALL SHEET PILING (SEE TEMP SHEET PILING DETAIL SHEET).
SET TEMPORARY CONCRETE BARRIERS (STD 704001) FOR PHASE ONE.
CONSTRUCT NEW BOX CULVERT ON WEST SIDE TO 1'-0" WEST OF CENTERLINE.
CONSTRUCT GEOTEXTILE RETAINING WALL AND PAVEMENT ON WEST SIDE.
SWITCH TRAFFIC TO WEST SIDE.
REMOVE SHEET PILING IN PLACE FOR PHASE 1 (SEE PILING DETAIL SHEET).
CONSTRUCT REMAINDER OF NEW BOX CULVERT AND PAVEMENT ON EAST SIDE.
REMOVE REMAINING STAGING ITEMS.
ANY CHANGES TO STAGING SHALL BE APPROVED BY THE ENGINEER.

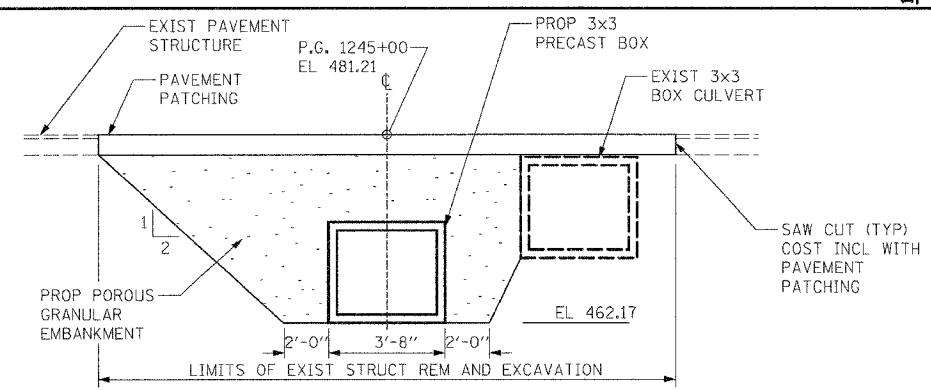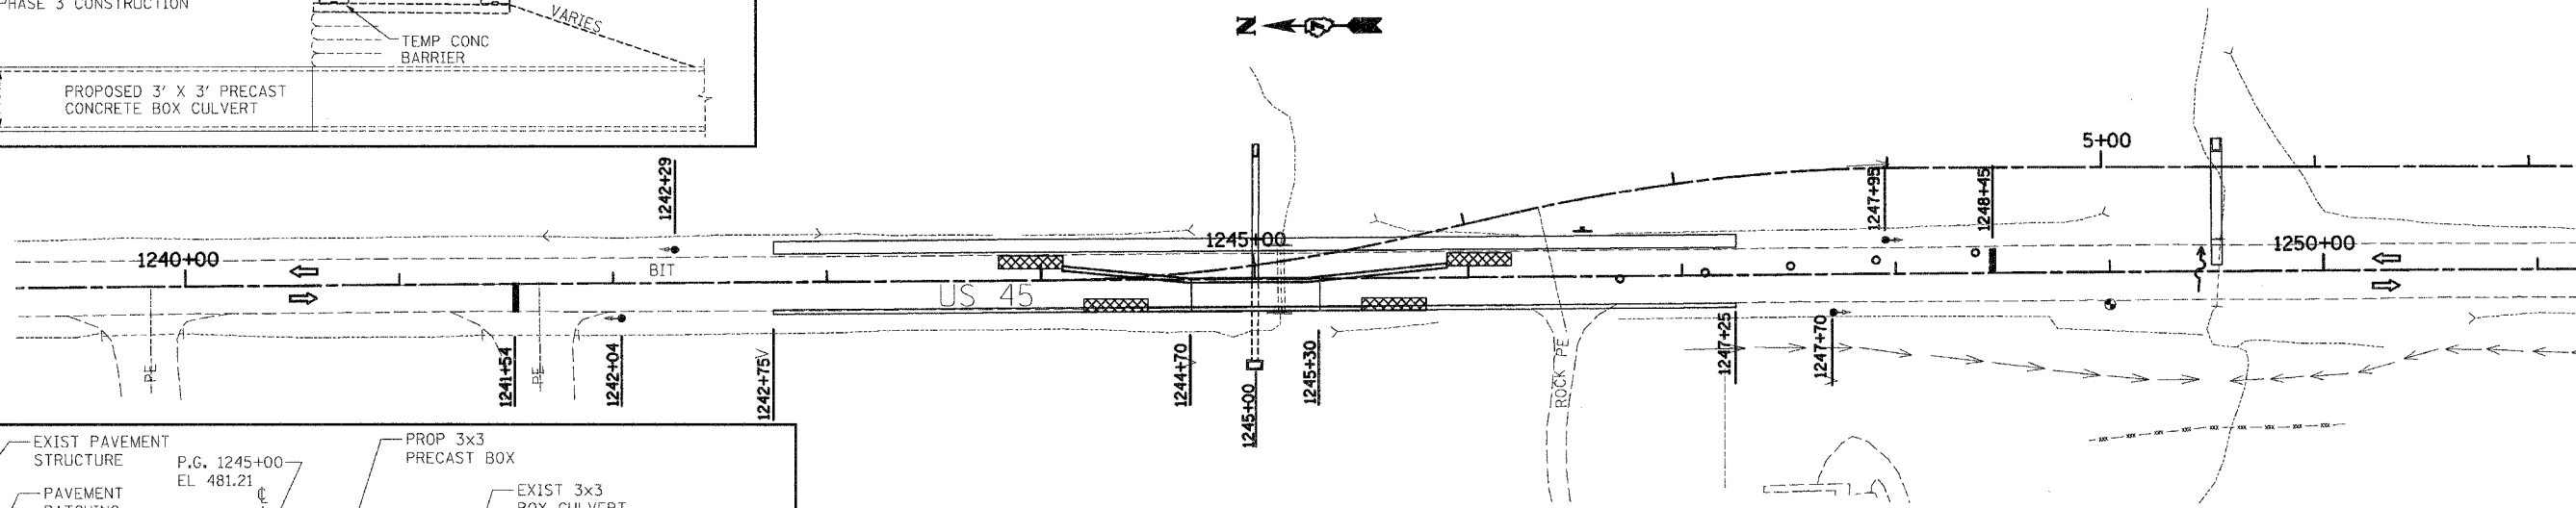

IMPACT ATTENUATORS, RELOCATE (1 REDIRECTIVE), TEST LEVEL 2 

RT 1244+50	1 EACH
RT 1245+50	1 EACH
CL 1244+10	1 EACH
CL 1145+90	1 EACH

TEMPORARY PAVEMENT MARKING - LINE 4"
CL 1244+51 TO 1245+48 97 FT
RT 1242+75 TO 1247+25 450 FT

RELOCATE TEMPORARY CONCRETE BARRIER (STATE OWNED)

CL 1244+10 TO 1245+90	180 FT
RT 1244+50 TO 1245+50	100 FT

[illegible]

ILLINOIS DEPARTMENT OF TRANSPORTATION

**STAGE 1 CONSTRUCTION
BOX CULVERT
STA 1245+00**

SCALE: VERT.
HORIZ.
DATE : 10-21-05

DRAWN BY: UJ
CHECKED BY: MAR

2 Rev. 1-9-06

Rev.