

STATE OF ILLINOIS  
DEPARTMENT OF TRANSPORTATION

FAI RTE	SECTION	COUNTY	TOTAL SHEETS	SHEET NO.
94	FAI 94 22 BP	COOK	116	1
		ILLINOIS	CONTRACT NO. 62U24	
* 116 + 1 = 117 TOTAL SHEETS				


FOR INDEX OF SHEETS, SEE SHEET NO. 2

DESIGN DESIGNATION: INTERSTATE  
FAI ROUTE 94: KENNEDY EXPWY  
2021 ADT: 119,400 VPD  
POSTED SPEED LIMIT: 55 MPH


IMPROVEMENT LOCATED IN:  
CITY OF CHICAGO

PROPOSED  
HIGHWAY PLANS

ROUTE: FAI 94 (I-90/94)  
AT GRAND AVE, HUBBARD ST, GREEN ST,  
AND KINZIE ST TO WAYMAN ST (HUBBARD CAVE) EB  
SECTION FAI 94 22 BP  
FEDERAL AID PROJECT NHPP-5PK1(530)  
BRIDGE PAINTING AND LIGHTING  
COOK COUNTY  
C-91-034-23

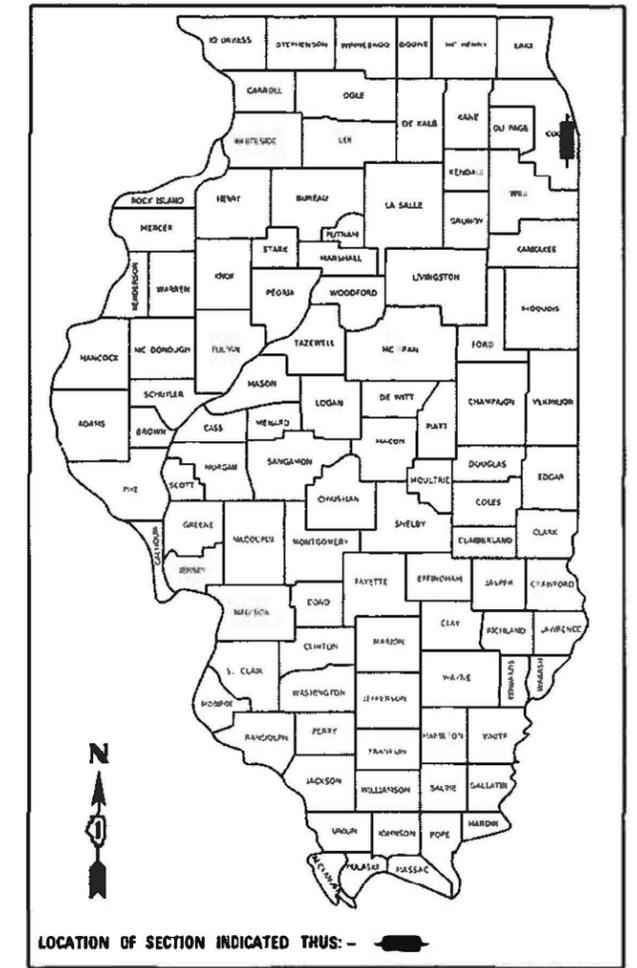


- IMPROVEMENT LOCATION 1:  
I-94 AT GRAND AVE  
SN: 016-2048
- IMPROVEMENT LOCATION 2:  
I-94 AT HUBBARD ST  
SN: 016-2050
- IMPROVEMENT LOCATION 3:  
I-94 AT GREEN ST AND RR  
SN: 016-0136

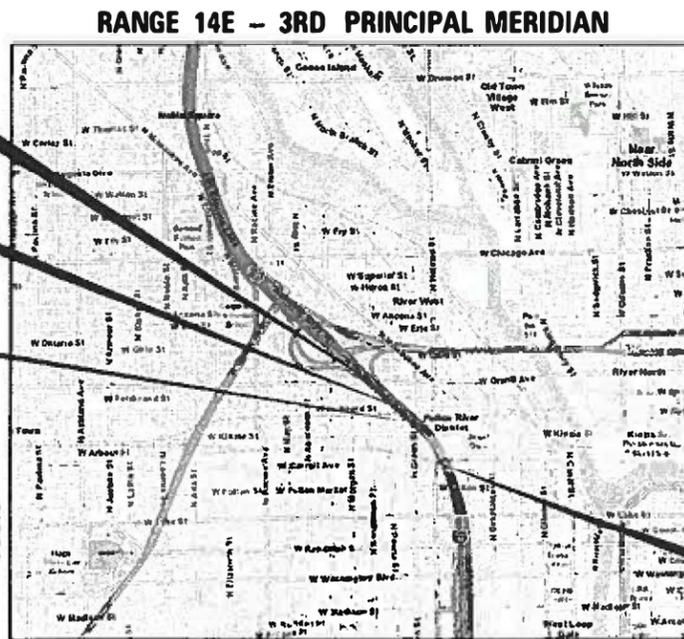

LOCATION MAP (NOT TO SCALE)  
GROSS LENGTH = 2,112 FT. = 0.40 MILE  
NET LENGTH = 2,112 FT. = 0.40 MILE

CHICAGO TOWNSHIP

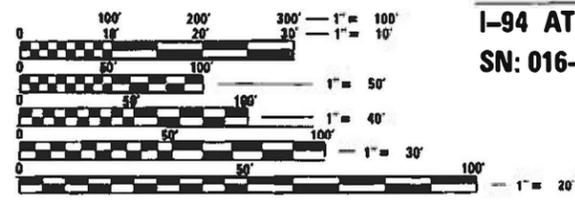

FULL SIZE PLANS HAVE BEEN PREPARED USING STANDARD ENGINEERING SCALES. REDUCED SIZED PLANS WILL NOT CONFORM TO STANDARD SCALES. IN MAKING MEASUREMENTS ON REDUCED PLANS THE ABOVE SCALES MAY BE USED.

C.U.A.N.  
CHICAGO UTILITY ALERT NETWORK  
1-312-744-7000

PROJECT ENGINEER MR. RODRIGO LEDEZMA, P.E. (847) 705-4580  
PROJECT MANAGER MR. J. ALAIN MIDY, P.E., (847) 221-3056

CONTRACT NO. 62U24

**Accurate**  
GROUP, INC.  
WWW.ACCGI.COM  
101 SCHELTER RD., SUITE B-200  
LINCOLNSHIRE, ILLINOIS 60069  
T (847) 613-1100 F (847) 613-1105  
ILLINOIS PROFESSIONAL DESIGN FIRM NO. 184 002053



DATE SIGNED: 10-24-22  
EXP. DATE: 11-30-23

IMPROVEMENT LOCATION 4:  
KINZIE ST TO WAYMAN ST  
(HUBBARD CAVE)  
SN: 016-2020

STATE OF ILLINOIS  
DEPARTMENT OF TRANSPORTATION

SUBMITTED October 25, 2022

Jose Luis Lopez  
REGIONAL ENGINEER

December 9, 2022  
Eric A. Etkin  
ENGINEER OF DESIGN AND ENVIRONMENT

December 9, 2022  
Steph M. Davis  
DIRECTOR OF HIGHWAYS PROJECT IMPLEMENTATION

PRINTED BY THE AUTHORITY  
OF THE STATE OF ILLINOIS

## INDEX OF SHEETS

SHEET NO.	DESCRIPTION
1	COVER SHEET
2-2A	INDEX OF SHEETS, STATE HIGHWAY STANDARDS, LOCATION MAP, AND GENERAL NOTES
3-5	SUMMARY OF QUANTITIES
6	MAINTENANCE OF TRAFFIC GENERAL NOTES
7	DETOUR PLAN - OHIO ST EB I-90 RAMP
8	MAINTENANCE OF TRAFFIC SEQUENCE OF CONSTRUCTION
9-10	MAINTENANCE OF TRAFFIC TYPICAL SECTIONS
11-25	MAINTENANCE OF TRAFFIC PLANS
26-30	EXISTING BRIDGE PLANS (SN 016-2048) (FOR INFORMATION ONLY)
31-33	EXISTING BRIDGE PLANS (SN 016-2050) (FOR INFORMATION ONLY)
34-38	EXISTING BRIDGE PLANS (SN 016-0136) (FOR INFORMATION ONLY)
39-71	EXISTING BRIDGE PLANS (SN 016-2020) (FOR INFORMATION ONLY)
72-107	EXISTING LIGHTING PLANS (FOR INFORMATION ONLY)
108	TC-08 ENTRANCE AND EXIT RAMP CLOSURE DETAILS
109	TC-09 FREEWAY SINGLE AND MULTI-LANE WEAVE
110	TC-17 TRAFFIC CONTROL DETAILS FOR FREEWAY SHOULDER CLOSURES AND PARTIAL RAMP CLOSURES
111	TC-18 SIGNING FOR FLAGGING OPERATIONS AT WORK ZONE OPENINGS
112	TC-21 DETOUR SIGNING FOR CLOSING STATE HIGHWAYS
113	TC-22 ARTERIAL ROAD INFORMATION SIGN
114	TC-25 CENTER LANE CLOSURE, AND SHOULDER LANE
115	TC-33 SMART TRAFFIC MONITORING SYSTEM TYPICAL LAYOUT

## STATE OF ILLINOIS HIGHWAY STANDARDS

STANDARD NO.	DESCRIPTION
000001-08	STANDARD SYMBOLS, ABBREVIATIONS AND PATTERNS
701400-11	APPROACH TO LANE CLOSURE, FREEWAY/EXPRESSWAY
701401-13	LANE CLOSURE, FREEWAY/EXPRESSWAY
701402-12	LANE CLOSURE FREEWAY/EXPRESSWAY, WITH BARRIER
701426-09	LANE CLOSURE, MULTILANE, INTERMITTENT OR MOVING OPER., FOR SPEEDS $\geq$ 45 MPH
701428-01	TRAFFIC CONTROL SETUP AND REMOVAL FREEWAY/EXPRESSWAY
701446-11	TWO LANE CLOSURE, FREEWAY/EXPRESSWAY
701901-08	TRAFFIC CONTROL DEVICES
704001-08	TEMPORARY CONCRETE BARRIER

## COMMITMENTS

NONE.

## GENERAL NOTES

- ALL CONSTRUCTION SHALL BE DONE IN ACCORDANCE WITH THE STANDARD SPECIFICATIONS FOR ROAD AND BRIDGE CONSTRUCTION ADOPTED JANUARY 1, 2022 HEREIN AFTER REFERRED TO AS THE STANDARD SPECIFICATIONS, THE SUPPLEMENTAL SPECIFICATIONS AND RECURRING SPECIAL PROVISIONS ADOPTED JANUARY 1, 2022, THE LATEST EDITION OF THE ILLINOIS MANUAL ON UNIFORM TRAFFIC CONTROL DEVICES FOR STREETS AND HIGHWAYS, THE DETAILS IN THE PLANS, AND THE SPECIAL PROVISIONS INCLUDED IN THE CONTRACT DOCUMENTS.
- BEFORE STARTING ANY EXCAVATION, THE CONTRACTOR MUST CALL "C.U.A.N." (CHICAGO UTILITY ALERT NETWORK) AT (312) 744-7000 FOR FIELD LOCATIONS OF BURIED ELECTRIC, TELEPHONE, AND GAS FACILITIES. NOTICE 48 HOURS IN ADVANCE IS REQUIRED.
- IDOT ELECTRICAL FACILITIES INCLUDING ROADWAY LIGHTING, FIBER OPTIC, ITS EQUIPMENT, TRAFFIC SIGNAL, AND PUMP STATION FACILITIES ARE LOCATED BY THE DEPARTMENT'S ELECTRICAL MAINTENANCE CONTRACTOR. CONTACT MEADE ELECTRIC COMPANY AT 773-287-7672. NOTICE 48 HOURS IN ADVANCE IS REQUIRED.
- THE CONTRACTOR SHALL COORDINATE CONSTRUCTION ACTIVITIES WITH UTILITY COMPANIES AND THE CITY OF CHICAGO.
- THE CONTRACTOR MUST CONTACT THE EXPRESSWAY TRAFFIC CONTROL SUPERVISOR AT (847) 705-4155 A MINIMUM OF 72 HOURS PRIOR TO THE INSTALLATION OF ANY TEMPORARY TRAFFIC CONTROL DEVICES.
- DO NOT SCALE PLANS FOR CONSTRUCTION DIMENSIONS.
- PLAN DIMENSIONS AND DETAILS ARE SUBJECT TO ROUTINE VARIATIONS. THE CONTRACTOR SHALL VERIFY EXISTING DIMENSIONS AND DETAILS AFFECTING NEW CONSTRUCTION AND GAIN APPROVAL FOR NECESSARY ADJUSTMENTS PRIOR TO ORDERING MATERIALS. SUCH VARIATIONS SHALL NOT BE CAUSE FOR ADDITIONAL COMPENSATION IF THEY RESULT IN A CHANGE IN THE SCOPE OF THE WORK. HOWEVER, THE CONTRACTOR WILL BE PAID FOR QUANTITIES ACTUALLY FURNISHED, BASED ON THE BID UNIT PRICE FOR THAT WORK.
- THE CONTRACTOR WILL NOT BE ALLOWED TO SET UP A YARD OR FIELD OFFICE ON STATE PROPERTY WITHOUT WRITTEN PERMISSION FROM THE DEPARTMENT.
- IT SHALL BE THE CONTRACTOR'S RESPONSIBILITY TO PROTECT AND MAINTAIN THE EXISTING BRIDGE LIGHTING AT ANY LOCATIONS THAT LIGHTING IS ENCOUNTERED ADJACENT TO AN AREA TO BE CLEANED AND PAINTED. ONLY THE AFFECTED LIGHTING CIRCUITS BEING WORKED ON SHALL BE TURNED OFF. LIGHTING OVER ACTIVE LANES OF TRAFFIC SHALL REMAIN IN OPERATION.

## GENERAL NOTES CONTINUED

- THE CONTRACTOR SHALL BE REQUIRED TO PROVIDE ACCESS TO ABUTTING PROPERTY AT ALL TIMES DURING THE CONSTRUCTION OF THIS PROJECT.
- WHEN ARTIFICIAL LIGHTING IS UTILIZED IN NIGHTTIME OPERATIONS, THE CONTRACTOR SHALL EXERCISE THE UTMOST PRECAUTIONS PREVENTING ADVERSE VISIBILITY TO THE MOTORING PUBLIC AND ADJACENT RESIDENTIAL AREAS.
- THE EXISTING STRUCTURAL STEEL COATING CONTAINS LEAD. THE CONTRACTOR SHALL TAKE APPROPRIATE PRECAUTIONS TO DEAL WITH THE PRESENCE OF LEAD ON THIS PROJECT.
- PERMANENT PAVEMENT MARKINGS ARE INCLUDED IN CONTRACT NO. 62K74. CONTRACTOR SHALL COORDINATE WITH THE 62K74 CONTRACTOR FOR THE PERMANENT PAVEMENT MARKINGS.
- STATIONS AND OFFSETS ARE APPROXIMATE.

## GENERAL PAINT NOTES

**LOCATION 1: SN 016-2048 (OVER EB I-90/94)**  
CLEANING AND PAINTING OF THE EXISTING STRUCTURAL STEEL SHALL BE AS SPECIFIED IN THE IN THE SPECIAL PROVISIONS FOR "CLEANING AND PAINTING EXISTING STEEL STRUCTURES".

ALL BEAMS, BEARINGS, AND OTHER STRUCTURE STEEL SHALL BE CLEANED PER NEAR WHITE BLAST CLEANING - SSPC-SP 10. THESE AREAS SHALL BE PAINTED ACCORDING TO THE REQUIREMENTS OF PAINT SYSTEM 1 -OZ/E/U. THE COLOR OF THE FINAL FINISH COAT FOR ALL INTERIOR STEEL SURFACES SHALL BE GRAY, MUNSELL NO 5B 7/1. THE COLOR OF THE FINAL FINISH COAT FOR THE FASCIA BEAMS AND BOTTOM FLANGES SHALL BE REDDISH BROWN, MUNSELL NO 2.5YR 3/4.

ALL ITEMS (SUCH AS, BUT NOT LIMITED TO: CONDUITS, BRACKETS AND DECK DRAINS) ATTACHED TO OUTSIDE OF THE FASCIA BEAMS SHOULD BE CLEANED AND PAINTED.

A MINIMUM OF FOUR (4) AIR MONITORS AT EACH LOCATION WILL BE REQUIRED TO MONITOR ABRASIVE BLASTING OPERATIONS. SEE SPECIAL PROVISIONS FOR "CONTAINMENT OF LEAD PAINT CLEANING RESIDUES".

SSPC QP2 CERTIFICATION IS REQUIRED FOR THIS CONTRACT.

**LOCATION 2: SN 016-2050 (OVER EB I-90/94)**  
CLEANING AND PAINTING OF THE EXISTING STRUCTURAL STEEL SHALL BE AS SPECIFIED IN THE IN THE SPECIAL PROVISIONS FOR "CLEANING AND PAINTING EXISTING STEEL STRUCTURES".

ALL BEAMS, BEARINGS, AND OTHER STRUCTURE STEEL SHALL BE CLEANED PER NEAR WHITE BLAST CLEANING - SSPC-SP 10. THESE AREAS SHALL BE PAINTED ACCORDING TO THE REQUIREMENTS OF PAINT SYSTEM 1 -OZ/E/U. THE COLOR OF THE FINAL FINISH COAT FOR ALL INTERIOR STEEL SURFACES SHALL BE GRAY, MUNSELL NO 5B 7/1. THE COLOR OF THE FINAL FINISH COAT FOR THE EXTERIOR FACES AND BOTTOM FLANGES OF THE FASCIA BEAMS SHALL BE REDDISH BROWN, MUNSELL NO 2.5YR 3/4.

ALL ITEMS (SUCH AS, BUT NOT LIMITED TO: CONDUITS, BRACKETS AND DECK DRAINS) ATTACHED TO OUTSIDE OF THE FASCIA BEAMS SHOULD BE CLEANED AND PAINTED.

A MINIMUM OF FOUR (4) AIR MONITORS AT EACH LOCATION WILL BE REQUIRED TO MONITOR ABRASIVE BLASTING OPERATIONS. SEE SPECIAL PROVISIONS FOR "CONTAINMENT OF LEAD PAINT CLEANING RESIDUES".

SSPC QP2 CERTIFICATION IS REQUIRED FOR THIS CONTRACT.

**LOCATION 3: SN 016-0136 (OVER EB I-90/94)**  
CLEANING AND PAINTING OF THE EXISTING STRUCTURAL STEEL SHALL BE AS SPECIFIED IN THE IN THE SPECIAL PROVISIONS FOR "CLEANING AND PAINTING EXISTING STEEL STRUCTURES".

ALL BEAMS, BEARINGS, AND OTHER STRUCTURE STEEL SHALL BE CLEANED PER NEAR WHITE BLAST CLEANING - SSPC-SP 10. THESE AREAS SHALL BE PAINTED ACCORDING TO THE REQUIREMENTS OF PAINT SYSTEM 1 -OZ/E/U. THE COLOR OF THE FINAL FINISH COAT FOR ALL INTERIOR STEEL SURFACES SHALL BE GRAY, MUNSELL NO 5B 7/1. THE COLOR OF THE FINAL FINISH COAT FOR THE EXTERIOR FACES AND BOTTOM FLANGES OF THE FASCIA BEAMS SHALL BE REDDISH BROWN, MUNSELL NO 2.5YR 3/4.

ALL ITEMS (SUCH AS, BUT NOT LIMITED TO: CONDUITS, BRACKETS AND DECK DRAINS) ATTACHED TO OUTSIDE OF THE FASCIA BEAMS SHOULD BE CLEANED AND PAINTED.

A MINIMUM OF FOUR (4) AIR MONITORS AT EACH LOCATION WILL BE REQUIRED TO MONITOR ABRASIVE BLASTING OPERATIONS. SEE SPECIAL PROVISIONS FOR "CONTAINMENT OF LEAD PAINT CLEANING RESIDUES".

SSPC QP2 CERTIFICATION IS REQUIRED FOR THIS CONTRACT.

**LOCATION 4: SN 016-2020 (OVER EB I-90/94)**  
CLEANING AND PAINTING OF THE EXISTING STRUCTURAL STEEL SHALL BE AS SPECIFIED IN THE IN THE SPECIAL PROVISIONS FOR "CLEANING AND PAINTING EXISTING STEEL STRUCTURES".

ALL BEAMS, BEARINGS, AND OTHER STRUCTURE STEEL SHALL BE CLEANED PER NEAR WHITE BLAST CLEANING - SSPC-SP 10. THESE AREAS SHALL BE PAINTED ACCORDING TO THE REQUIREMENTS OF PAINT SYSTEM 1 -OZ/E/U. THE COLOR OF THE FINAL FINISH COAT FOR ALL INTERIOR STEEL SURFACES SHALL BE GRAY, MUNSELL NO 5B 7/1. THE COLOR OF THE FINAL FINISH COAT FOR THE EXTERIOR FACES AND BOTTOM FLANGES OF THE FASCIA BEAMS SHALL BE REDDISH BROWN, MUNSELL NO 2.5YR 3/4.

ALL ITEMS (SUCH AS, BUT NOT LIMITED TO: CONDUITS, BRACKETS AND DECK DRAINS) ATTACHED TO OUTSIDE OF THE FASCIA BEAMS SHOULD BE CLEANED AND PAINTED.

A MINIMUM OF FOUR (4) AIR MONITORS AT EACH LOCATION WILL BE REQUIRED TO MONITOR ABRASIVE BLASTING OPERATIONS. SEE SPECIAL PROVISIONS FOR "CONTAINMENT OF LEAD PAINT CLEANING RESIDUES".

SSPC QP2 CERTIFICATION IS REQUIRED FOR THIS CONTRACT.

MODEL: Default  
FILE NAME: D:\Engineering\Live\Projects\2025\_IDOT\_DURWOW\_35 - Bridge\_Painting\CADD\CADD\_Sheets\Civil\62U24\62U24-shr-generate.dgn





USER NAME = jdvavis	DESIGNED - JMT	REVISED - 01/09/2023 JMT
PLOT SCALE = 2.0000 ' / in.	DRAWN - JMT	REVISED -
PLOT DATE = 1/9/2023	CHECKED - JJD	REVISED -
	DATE - 10/24/2022	REVISED -

STATE OF ILLINOIS  
DEPARTMENT OF TRANSPORTATION

INDEX OF SHEETS, STATE HIGHWAY STANDARDS, AND GENERAL NOTES  
I-90 BRIDGE PAINTING & LIGHTING

SCALE: NONE SHEET 1 OF 1 SHEETS STA. TO STA.

F.A.I. RTE.	SECTION	COUNTY	TOTAL SHEETS	SHEET NO.
94	FAI 94 22 BP	COOK	115	2
CONTRACT NO. 62U24				
ILLINOIS' FED. AID PROJECT NHP-SPK1(530)				

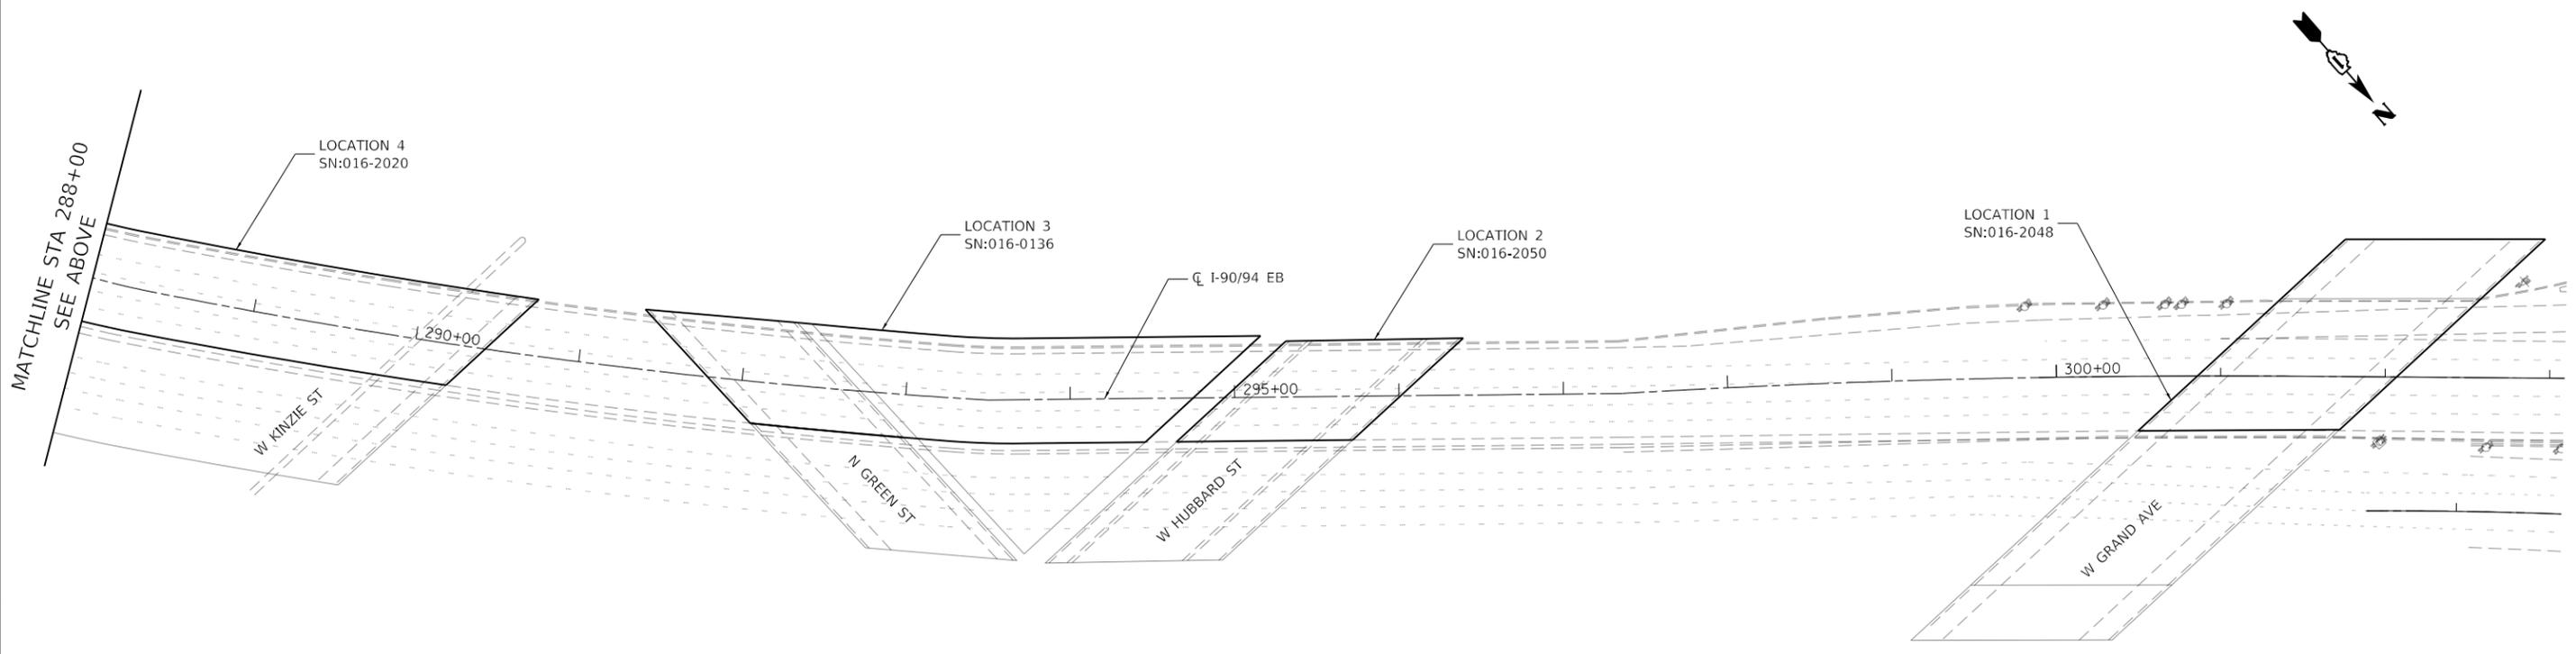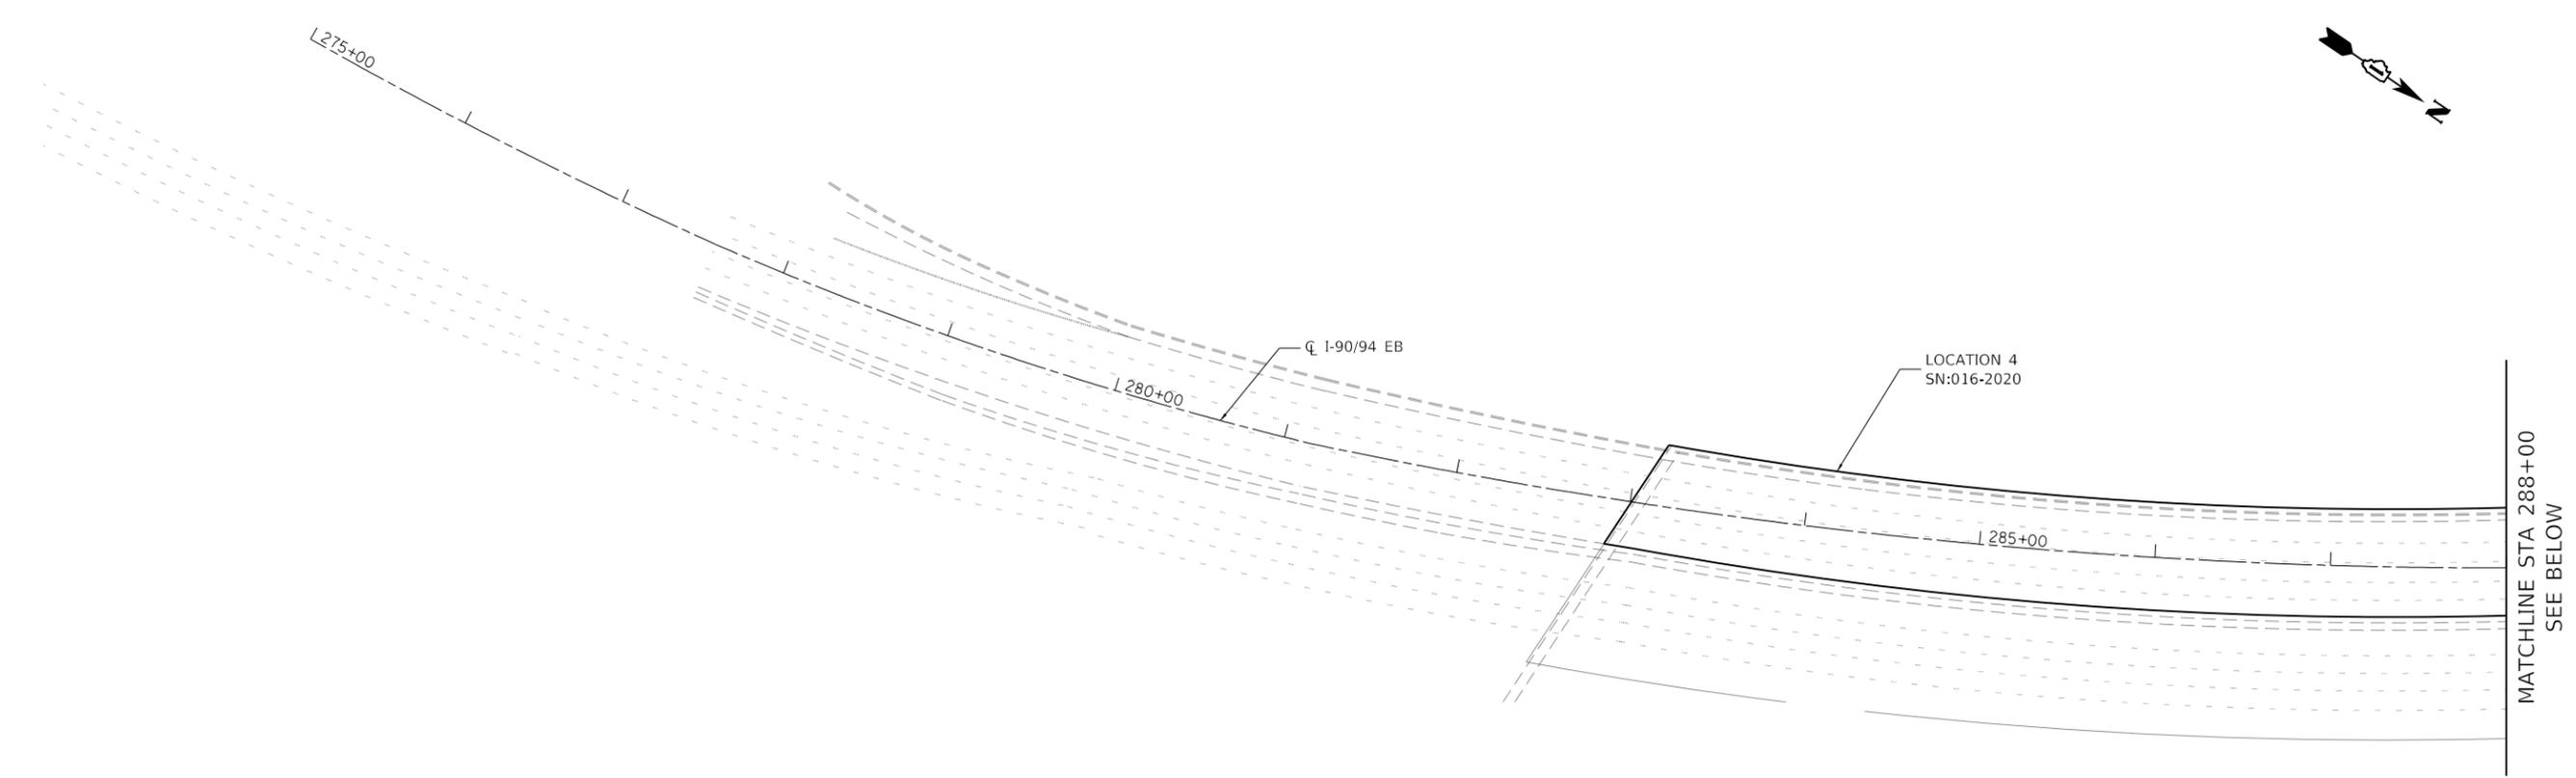

MODEL: Default  
 FILE: I:\mwf\c:\engineering\live\projects\2005\_IDOT\_DWR\W0\_35 - Bridge\_Painting\CADD\CADD\_Sheets\Civil\2024\2024-10-24-14-51-4-1-Location\_Map.dgn



USER NAME = JENT	DESIGNED - JMT	REVISED - 01/09/2023 JMT
DRAWN - JMT	CHECKED - JJD	REVISED -
PLOT SCALE = 100,0000' / in.	DATE - 10/24/2022	REVISED -
PLOT DATE = 1/9/2023		

**STATE OF ILLINOIS**  
**DEPARTMENT OF TRANSPORTATION**

**LOCATION MAP**  
**I-90 BRIDGE PAINTING & LIGHTING**

SCALE: NONE    SHEET 1 OF 1 SHEETS    STA.    TO STA.

F.A.I. RTE. 94	SECTION FAI 94 22 BP	COUNTY COOK	TOTAL SHEETS 115	SHEET NO. 2A
CONTRACT NO. 62U24				
ILLINOIS FED. AID PROJECT NHPP-SPK1(530)				



CONSTRUCTION CODE							
STATE 10%							
FED 90%							

CODE NO.	ITEM	UNIT	TOTAL QUANTITY	ROADWAY	HIGHWAY LIGHTING	BRIDGE	BRIDGE	BRIDGE	BRIDGE
				0047	0021	0047	0047	0047	0047
				URBAN	URBAN	S.N. 016-2048	S.N. 016-2050	S.N. 016-0136	S.N. 016-2020
* 82110008	LUMINAIRE, LED, ROADWAY, OUTPUT DESIGNATION H	EACH	10		10				
* 82110022	LUMINAIRE, LED, UNDERPASS, WALLMOUNT, OUTPUT DESIGNATION E	EACH	52		52				
X2700001	TEMPORARY RUMBLE STRIPS (SPECIAL)	EACH	20	20					
X5060601	<del>CONTAINMENT AND DISPOSAL OF NON LEAD PAINT CLEANING RESIDUES NO. 1</del>	L SUM	1			1			
X5067501	BRIDGE CLEANING AND PAINTING WARRANTY NUMBER 1	L SUM	1			1			
X5067502	BRIDGE CLEANING AND PAINTING WARRANTY NUMBER 2	L SUM	1				1		
X5067503	BRIDGE CLEANING AND PAINTING WARRANTY NUMBER 3	L SUM	1					1	
X5067504	BRIDGE CLEANING AND PAINTING WARRANTY NUMBER 4	L SUM	1						1
X6700407	ENGINEER'S FIELD OFFICE, TYPE A (D1)	CAL MO	15	15					
* X7011015	TRAFFIC CONTROL AND PROTECTION (EXPRESSWAYS)	L SUM	1	1					
X7013820	TRAFFIC CONTROL SURVEILLANCE, EXPRESSWAYS	CAL DA	277	277					
X8570000	SMART TRAFFIC MONITORING SYSTEM	L SUM	1	1					
Z0007101	CONTAINMENT AND DISPOSAL OF LEAD PAINT CLEANING RESIDUES NO. 1	L SUM	1			1			
Z0007102	CONTAINMENT AND DISPOSAL OF LEAD PAINT CLEANING RESIDUES NO. 2	L SUM	1				1		
Z0007103	CONTAINMENT AND DISPOSAL OF LEAD PAINT CLEANING RESIDUES NO. 3	L SUM	1					1	

\* SPECIALTY ITEM

MODEL: SDO\_2  
FILE: MAME\_C:\Engineering\Live\Projects\20005 IDOT DURWO 35 - Bridge Painting\CADD\CADD Sheets\Civil\1612124-rh-SDO.dgn



USER NAME = JENT	DESIGNED - JMT	REVISED -
	DRAWN - JMT	REVISED -
PLOT SCALE = 100.0000' / in.	CHECKED - JJD	REVISED -
PLOT DATE = 10/24/2022	DATE - 10/24/2022	REVISED -

**STATE OF ILLINOIS  
DEPARTMENT OF TRANSPORTATION**

**SUMMARY OF QUANTITIES  
I-90 BRIDGE PAINTING & LIGHTING**

SCALE: NONE SHEET 2 OF 3 SHEETS STA. TO STA.

F.A.I. RTE.	SECTION	COUNTY	TOTAL SHEETS	SHEET NO.
94	FAI 94 22 BP	COOK	115	4
CONTRACT NO. 62U24			ILLINOIS FED. AID PROJECT NHPP-XXX	

CONSTRUCTION CODE  
STATE 10%  
FED 90%

CODE NO.	ITEM	UNIT	TOTAL QUANTITY	ROADWAY	HIGHWAY LIGHTING	BRIDGE	BRIDGE	BRIDGE	BRIDGE
				0047	0021	0047	0047	0047	0047
				URBAN	URBAN	S.N. 016-2048	S.N. 016-2050	S.N. 016-0136	S.N. 016-2020
Z0007104	CONTAINMENT AND DISPOSAL OF LEAD PAINT CLEANING RESIDUES NO. 4	L SUM	1						1
Z0010501	CLEANING AND PAINTING STEEL BRIDGE NO. 1	L SUM	1			1			
Z0010502	CLEANING AND PAINTING STEEL BRIDGE NO. 2	L SUM	1				1		
Z0010503	CLEANING AND PAINTING STEEL BRIDGE NO. 3	L SUM	1					1	
Z0010504	CLEANING AND PAINTING STEEL BRIDGE NO. 4	L SUM	1						1
Z0030850	TEMPORARY INFORMATION SIGNING	SQ FT	221.9	221.9					
Z0033028	MAINTENANCE OF LIGHTING SYSTEM	CAL MO	18		18				
<del>Z0048665</del>	<del>RAILROAD PROTECTIVE LIABILITY INSURANCE</del>	<del>L SUM</del>	<del>1</del>	<del>1</del>					
Z0073510	TEMPORARY TRAFFIC SIGNAL TIMING	EACH	1	1					
* X8211025	LUMINAIRE, LED, TUNNEL, SUSPENDED, OUTPUT DESIGNATION H	EACH	534		534				
* X8420103	REMOVAL OF LUMINAIRE, NO SALVAGE, UNDERPASS	EACH	42		42				
* X8420107	REMOVAL OF LUMINAIRE, NO SALVAGE, TUNNEL	EACH	534		534				
* X8420102	REMOVAL OF LUMINAIRE, SALVAGE, UNDERPASS	EACH	10		10				
* X8420104	REMOVAL OF LUMINAIRE, SALVAGE, ROADWAY	EACH	10		10				
* X7010421	MOVABLE TRAFFIC BARRIER (SPECIAL)	L SUM	1	1					
* X7820008	BARRIER WALL REFLECTORS, SPECIAL	EACH	140	140					
Ø Z0076600	TRAINEES	HOURS	1500	1500					
Ø Z0076604	TRAINEES - TRAINING PROGRAM GRADUATE	HOURS	1500	1500					

\* SPECIALTY ITEM

MODEL: SDO\_3  
FILE: Main\_C:\Engineering\Live\Projects\20005 IDOT DUBUO 35 - Bridge Painting\CADD\CADD Sheets\Civil\1612124-rh-SDO.dgn



USER NAME = JENT	DESIGNED - JMT	REVISED -
	DRAWN - JMT	REVISED -
PLOT SCALE = 100.0000' / in.	CHECKED - JJD	REVISED -
PLOT DATE = 10/24/2022	DATE - 10/24/2022	REVISED -

**STATE OF ILLINOIS  
DEPARTMENT OF TRANSPORTATION**

<b>SUMMARY OF QUANTITIES</b>	
<b>I-90 BRIDGE PAINTING &amp; LIGHTING</b>	
SCALE: NONE	SHEET 3 OF 3 SHEETS STA. TO STA.

F.A.I. RTE. 94	SECTION FAI 94 22 BP	COUNTY COOK	TOTAL SHEETS 115	SHEET NO. 5
CONTRACT NO. 62U24				
ILLINOIS FED. AID PROJECT NHPP-XXX				

Ø 0042