

GENERAL NOTES

Fasteners shall be ASTM F3125 A325 Type 1, mechanically galvanized bolts. Bolts 7/8-in. Ø, holes 1 1/16-in. Ø, unless otherwise noted.

No field welding is permitted except as specified in the contract documents.

The Contractor shall test the existing welds by non-destructive methods within 2 ft. of the end of the existing cover plates for cracks after removal of the existing concrete deck. Dye penetrant (PT), magnetic particle (MT), or other approved testing method shall be performed by qualified personnel approved by the Engineer. If cracks are found, report them to the Bureau of Bridges and Structures for disposition. The cost of testing is included in Removal of Existing Concrete Deck. The cost of crack repair, if necessary, will be paid for according to Article 109.04 of the Standard Specifications.

Reinforcement bars designated (E) shall be epoxy coated.

Prior to pouring the new concrete deck, all heavy or loose rust, loose mill scale, and other loose or potentially detrimental foreign material shall be removed from the surfaces in contact with concrete. Tightly adhered paint may remain unless otherwise noted. Removal shall be accomplished by methods that will not damage the steel and the cost will be included in the pay item covering removal of the existing concrete.

As directed by the Engineer, existing construction accessories welded to the top flange of beams and girders shall be removed. The weld areas shall be ground flush and inspected for cracks using magnetic particle testing (MT) or dye penetrant testing (PT) by qualified personnel approved by the Engineer.

Any cracks that cannot be removed by grinding 1/4 inch deep shall be identified and reported to the Bureau of Bridges and Structures for further disposition. The cost of removing welded accessories, grinding and inspecting weld areas and grinding cracks will be paid for according to Article 109.04 of the Standard Specifications.

If the Contractor elects to use cantilever forming brackets on the exterior beams or girders, the brackets shall be placed at the same locations as required for the hardwood blocks in Article 503.06(b) of the Standard Specifications. If additional cantilever forming brackets are required, hardwood blocking shall be wedged between the exterior and first interior beam at each of these additional bracket locations.

Plan dimensions and details relative to existing plans are subject to nominal construction variations. The Contractor shall field verify existing dimensions and details affecting new construction and make necessary approved adjustments prior to construction or ordering of materials. Such variations shall not be cause for additional compensation for a change in scope of the work, however, the Contractor will be paid for the quantity actually furnished at the unit price bid for the work.

Concrete Sealer shall be applied to the designated areas of the abutment bearing seats and back walls (including abutment hatch block on back walls) and top of pier caps under expansion joints.

All new structural steel shall be shop painted with an inorganic zinc rich primer per AASHTO M300, Type 1.

Cleaning and field painting of structural steel shall be done under a separate painting contract.

Up to 1/4" may be ground off the bridge deck and the bridge approach slabs.

Attention is called to ground wires connecting the existing pier caps to beam webs at Piers 2, 5, and 9. These shall be left undisturbed, and if damaged shall be repaired at the contractor's expense.

All existing drainage system components attached to the structure shall be removed and disposed of in accordance with the applicable portions of Section 501. Existing concrete anchors shall be cut flush with the concrete surface, and attachments to existing girders shall be cut 4 to 6 inches clear of the web. Cost included with Removal of Existing Concrete Deck No. 1.

This project requires a US Army Corps of Engineers (USACE) 404 permit that has been secured by IDOT. As a condition of this permit the contractor will need to submit an in-stream work plan to the Will/South Cook Soil and Water Conservation District (SWCD) for approval. Guidelines on acceptable in-stream work techniques can be found on the USACE website.

Work shall conform to all provisions of the Erosion Control Plan.


Haul Roads, In-Stream Work Pads and Causeways, if needed, shall be constructed in accordance with the Recurring Special Provision Check Sheet #8.

INDEX OF SHEETS


- SA-1. General Plan and Elevation I
- SA-2. General Plan and Elevation II
- SA-3. General Data
- SA-4. Top of Deck Elevations I (Unit 1)
- SA-5. Top of Deck Elevations II (Unit 1)
- SA-6. Top of Deck Elevations III (Unit 1)
- SA-7. Top of Deck Elevations IV (Unit 1)
- SA-8. Top of Deck Elevations I (Unit 2)
- SA-9. Top of Deck Elevations II (Unit 2)
- SA-10. Top of Deck Elevations I (Unit 3)
- SA-11. Top of Deck Elevations II (Unit 3)
- SA-12. Top of Deck Elevations I (Unit 4)
- SA-13. Top of Deck Elevations II (Unit 4)
- SA-14. Top of Deck Elevations III (Unit 4)
- SA-15. Top of Deck Elevations IV (Unit 4)
- SA-16. Top of Deck Elevations V (Unit 4)
- SA-17. Top of South Approach Slab Elevations
- SA-18. Top of North Approach Slab Elevations
- SA-19. Superstructure Plan I (Unit 1)
- SA-20. Superstructure Plan II (Unit 1)
- SA-21. Parapet Elevations (Unit 1)
- SA-22. Superstructure Details (Unit 1)
- SA-23. Superstructure Plan I (Unit 2)
- SA-24. Superstructure Plan II (Unit 2)
- SA-25. Parapet Elevations (Unit 2)
- SA-26. Superstructure Details (Unit 2)
- SA-27. Superstructure Plan I (Unit 3)
- SA-28. Superstructure Plan II (Unit 3)
- SA-29. Parapet Elevations (Unit 3)
- SA-30. Superstructure Details (Unit 3)
- SA-31. Superstructure Plan I (Unit 4)
- SA-32. Superstructure Plan II (Unit 4)
- SA-33. Parapet Elevations (Unit 4)
- SA-34. Superstructure Details (Unit 4)
- SA-35. Bridge Approach Slab Details (1 of 2)
- SA-36. Bridge Approach Slab Details (2 of 2)
- SA-37. Modified Preformed Joint Strip Seal
- SA-38. Modular Expansion Joint (1 of 2)
- SA-39. Modular Expansion Joint (2 of 2)
- SA-40. Unit 1 Framing Plan
- SA-41. Unit 2 Framing Plan
- SA-42. Unit 3 Framing Plan
- SA-43. Unit 4 Framing Plan - I
- SA-44. Unit 4 Framing Plan - II
- SA-45. Cover Plate Retrofit Details
- SA-46. Moment & Reaction Tables
- SA-47. Bearing Details - South Abutment
- SA-48. Bearing Details - Pier 3
- SA-49. Bearing Details - Pier 4 South, Pier 7 South & Pier 7 North
- SA-50. Bearing Details - Pier 4 North & Pier 10 South
- SA-51. Bearing Details - Pier 10 North
- SA-52. Bearing Details - North Abutment
- SA-53. South Abutment Removal Plan
- SA-54. South Abutment Details
- SA-55. North Abutment Removal Plan
- SA-56. North Abutment Details
- SA-57. South Abutment and Slop Wall Repair
- SA-58. Pier 1 Repair
- SA-59. Pier 2 Repair
- SA-60. Pier 3 Repair
- SA-61. Pier 4 Repair and Temporary Support System
- SA-62. Pier 5 Repair
- SA-63. Pier 6 Repair
- SA-64. Pier 7 Repair
- SA-65. Pier 8 Repair
- SA-66. Pier 9 Repair
- SA-67. Pier 10 Repair
- SA-68. Pier 11 Repair
- SA-69. Pier 12 Repair
- SA-70. North Abutment Repair
- SA-71. Drainage Scupper, DS-12M10
- SA-72. Bar Splicer Assembly and Mechanical Splicer Details
- SA-73. Concrete Parapet Slipforming Option

TOTAL BILL OF MATERIAL

ITEM	UNIT	SUPER	SUB	TOTAL
Stone Riprap, Class A4	Ton		1011	1011
Filter Fabric	Sq Yd		254	254
Concrete Removal	Cu Yd		42.5	42.5
Bridge Rail Removal	Foot	2751		2751
Removal of Existing Concrete Deck No. 1	Each	1		1
Protective Shield	Sq Yd	2658		2658
Structure Excavation	Cu Yd		126	126
Cofferdam (Type 2) (Location - 1)	Each		1	1
Cofferdam (Type 2) (Location - 2)	Each		1	1
Floor Drains	Each	16		16
Concrete Structures	Cu yd		58.8	58.8
Concrete Superstructure	Cu Yd	2177.2		2177.2
Protective Coat	Sq Yd	7720		7720
Concrete Superstructure (Approach Slab)	Cu Yd	121.6		121.6
Furnishing and Erecting Structural Steel	Pound	10410		10410
Stud Shear Connectors	Each	13830		13830
Reinforcement Bars, Epoxy Coated	Pound	548,590	10450	559,040
Bar Splicers	Each		88	88
Name Plates	Each	1		1
Preformed Joint Strip Seal	Foot	171		171
Elastomeric Bearing Assembly, Type I	Each	48		48
Elastomeric Bearing Assembly, Type III	Each	6		6
Anchor Bolts, 3/8"	Each		72	72
Anchor Bolts, 1"	Each		36	36
Granular Backfill for Structures	Cu Yd		116	116
Concrete Sealer	Sq Ft		1106	1106
Epoxy Crack Injection	Foot		129	129
Geocomposite Wall Drain	Sq Yd		64	64
Bridge Deck Grooving (Longitudinal)	Sq Yd	5166		5166
Jack and Remove Existing Bearings	Each	54		54
Structural Steel Repair	Pound	73840		73840
Structural Repair of Concrete (Depth Equal to or less than 5 Inches)	Sq Ft		350	350
Structural Repair of Concrete (Depth Greater than 5 Inches)	Sq Ft		220	220
Drainage Scuppers, DS-12M10	Each	16		16
Diamond Grinding (Bridge Section)	Sq Yd	5822		5822
Modular Expansion Joint 6"	Foot	41		41
Pipe Underdrains for Structures 4"	Foot		110	110
Slope Wall Repair	Sq Yd		300	300
Temporary Support System, Location 1	Each		1	1
Cofferdam Excavation (Special)	Cu Yd		688	688

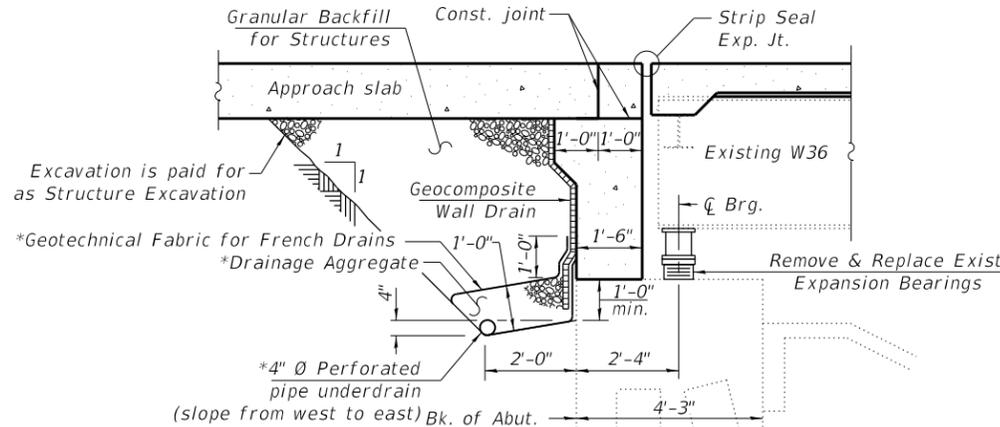

SECTION THRU SOUTH ABUTMENT

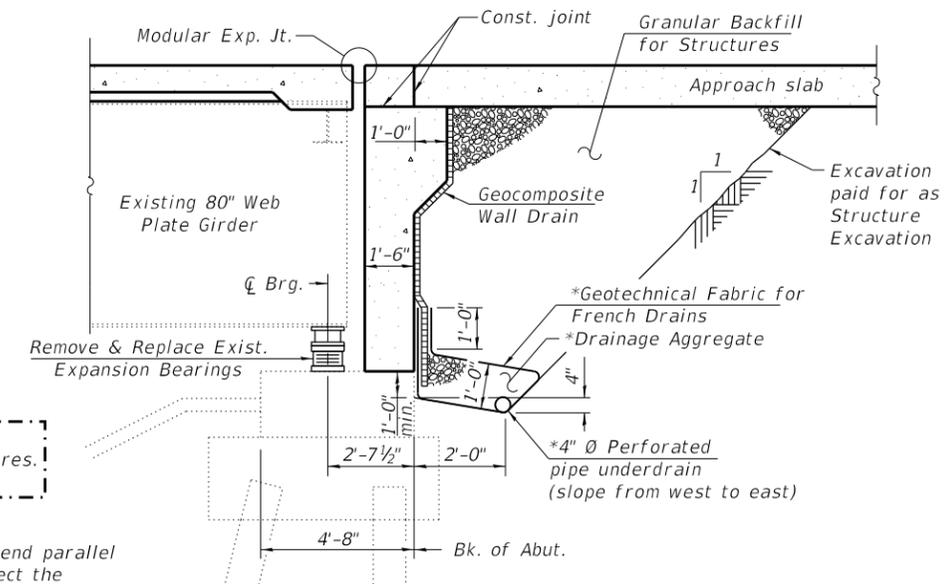

SECTION THRU NORTH ABUTMENT

Note:
All drainage system components shall extend parallel to the abutment back wall until they intersect the wingwalls. The pipe shall extend through the east wingwall, through a newly cored hole if necessary, until intersecting the side slopes. Cost included with Pipe Underdrains for Structures. The pipes shall drain into concrete headwalls. (See Article 601.05 of the Standard Specifications and Highway Standard 601101).

COPY/RIGHT © 2021, BY BAXTER & WOODMAN, INC. STATE OF ILLINOIS - PROFESSIONAL DESIGN FIRM LICENSE NO. - 184-001121 - EXPIRES 4/30/2023
 MODEL: Default
 FILE NAME: pw:\civiltech-pw-bentley.com\civiltech-pw\Documents\Projects\3393\CADD\CADD Sheets\Structures\Structure SN 016-2468\0162468-62H49-003-GENDATA01.dgn



USER NAME = 611blb	DESIGNED - BLB	REVISED - 12/21/21 BLB
PLOT SCALE =	CHECKED - AS	REVISED -
PLOT DATE = 12/21/2021	DRAWN - BLB	REVISED -
	DATE - 10/21/2021	REVISED -

**STATE OF ILLINOIS
DEPARTMENT OF TRANSPORTATION**


**GENERAL DATA
STRUCTURE NO. 016-2468**

F.A.P. RTE. 330	SECTION 2018-133-BR	COUNTY COOK	TOTAL SHEETS 308	SHEET NO. 117
ILLINOIS			CONTRACT NO. 62H49	

SHEET SA-03 OF SA-73 SHEETS

REVISED SHEET 1/3/2022

COPYRIGHT © 2021, BY BAXTER & WOODMAN, INC.
 STATE OF ILLINOIS - PROFESSIONAL DESIGN FIRM
 LICENSE NO. - 184-001121 - EXPIRES 4/30/2023
 MODEL: Sheet
 FILE NAME: pw:\civiltech-pw-bentley.com\civiltech-pw\Documents\Projects\3393\CADD\CADD Sheets\Structures\Structure SA 016-2468-62H49-068-SUBREPAIR12.dgn

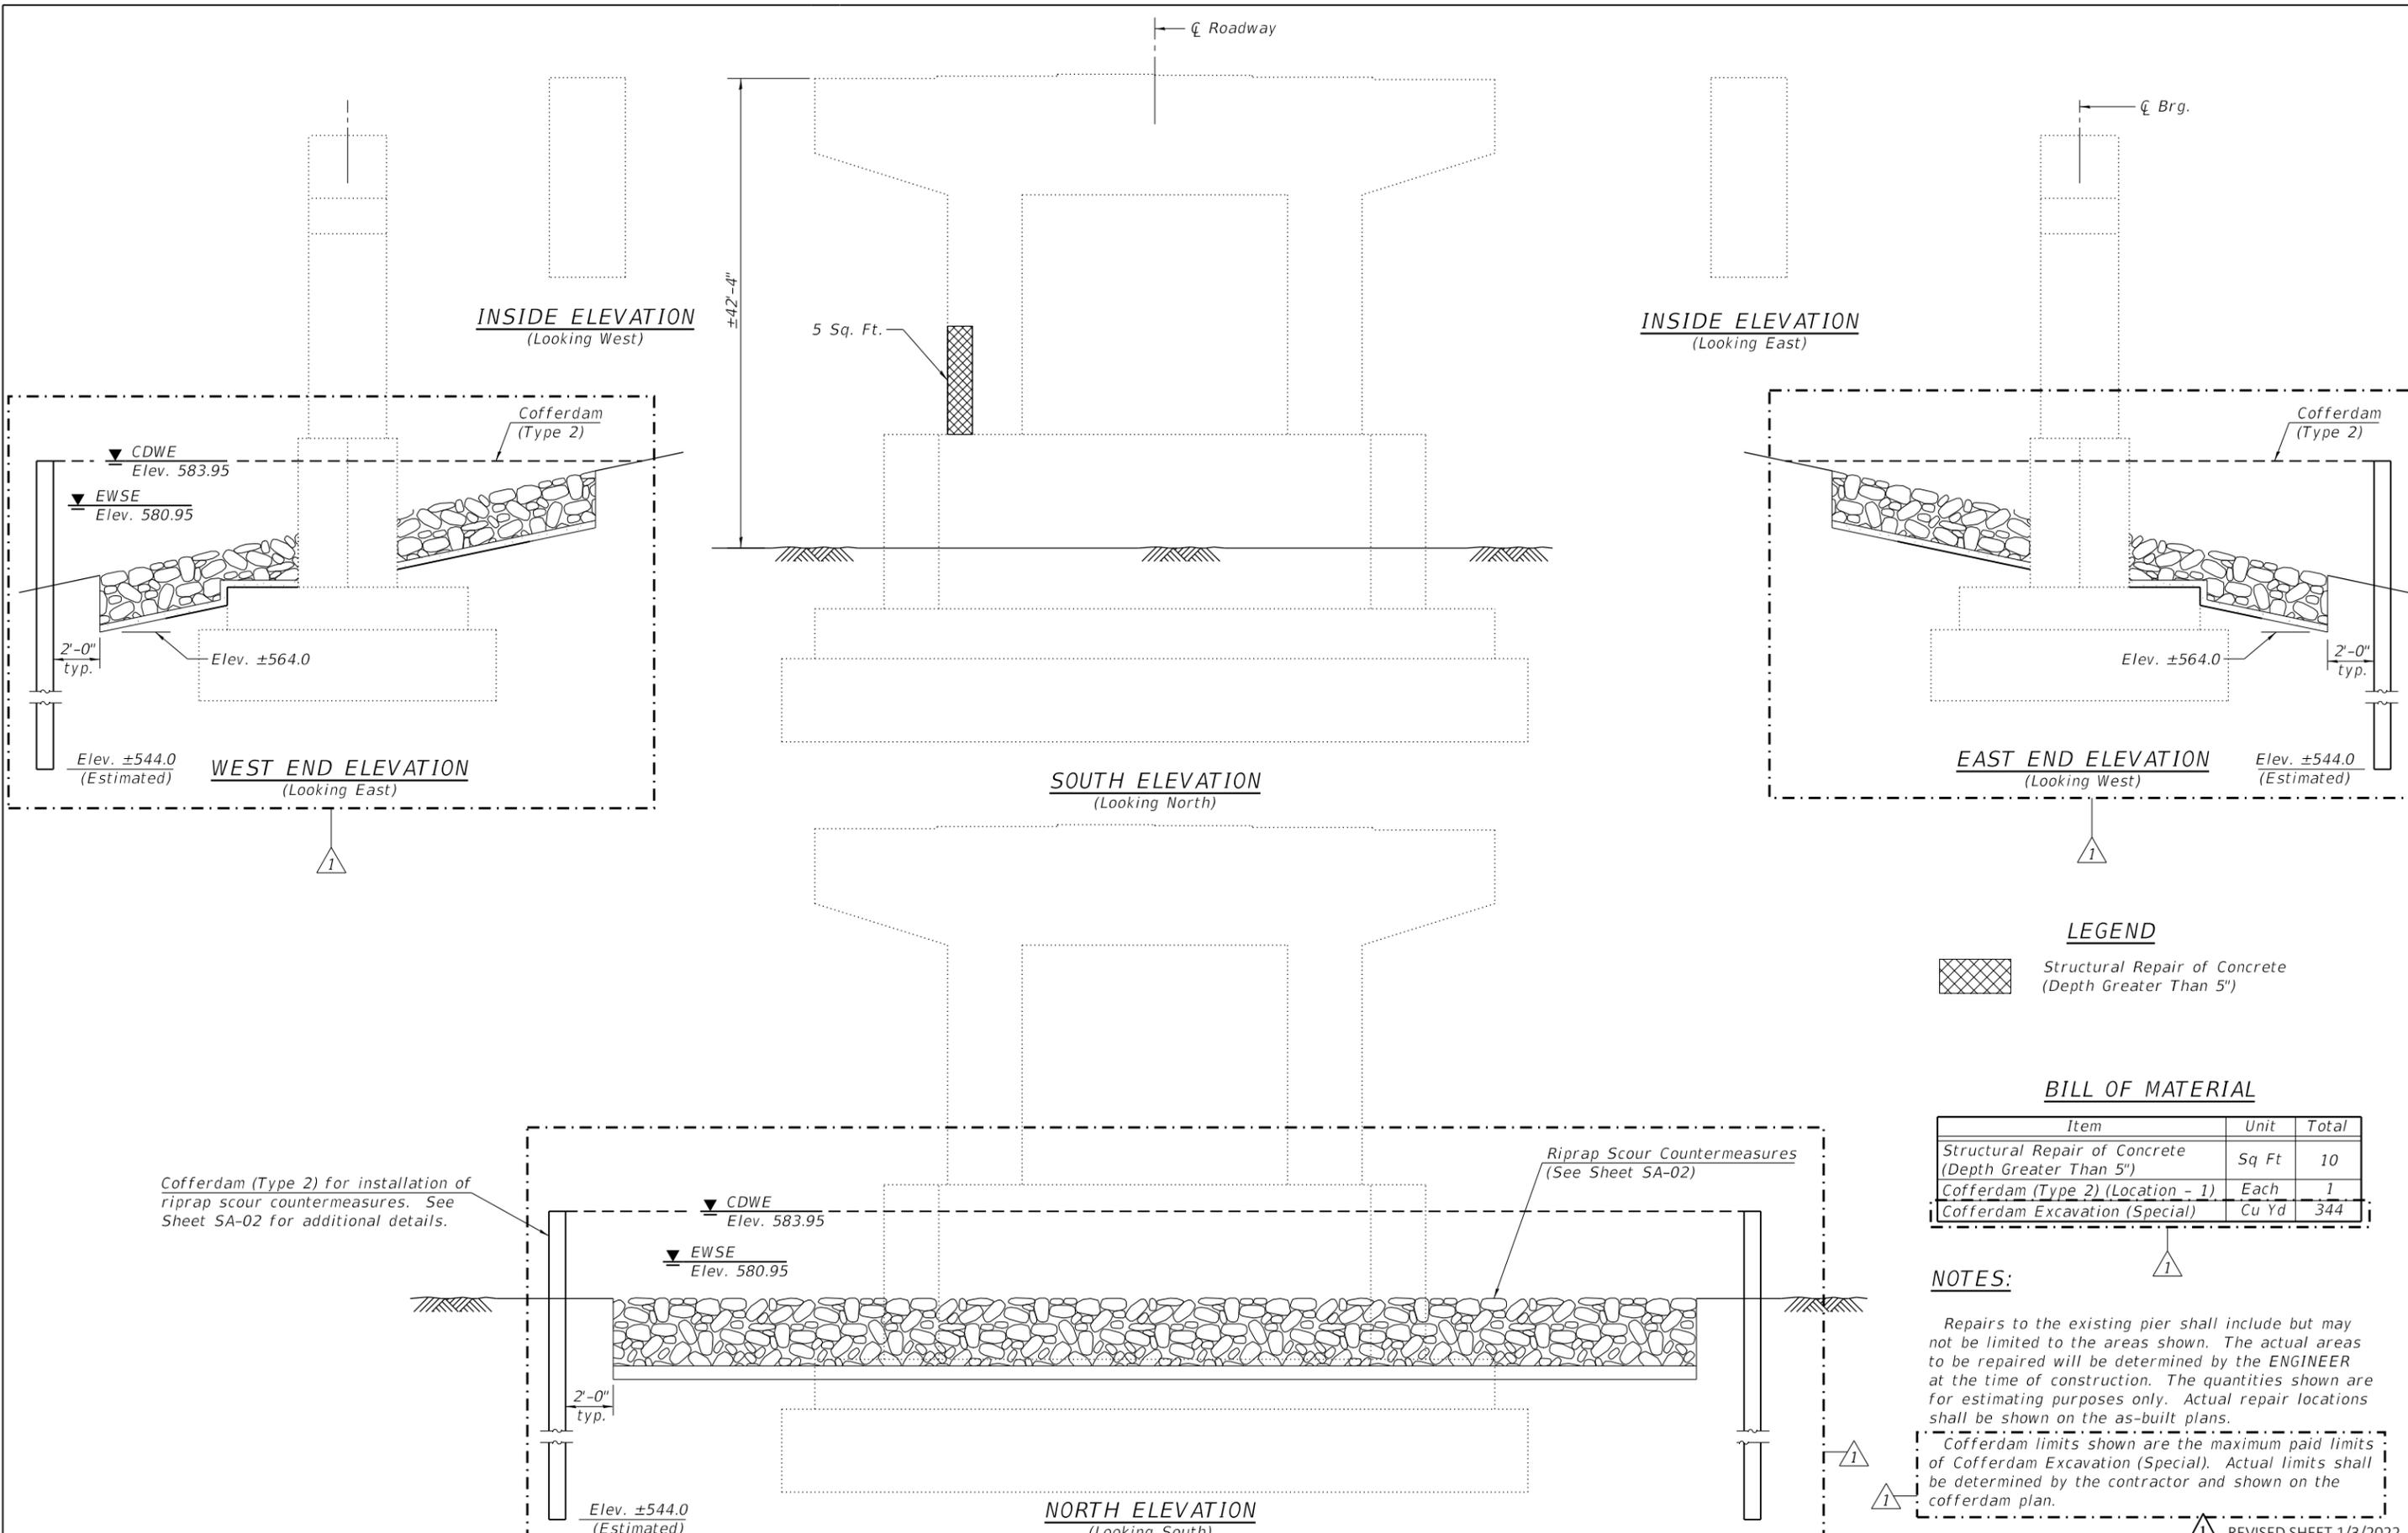

LEGEND

Structural Repair of Concrete (Depth Greater Than 5')

BILL OF MATERIAL

Item	Unit	Total
Structural Repair of Concrete (Depth Greater Than 5')	Sq Ft	10
Cofferdam (Type 2) (Location - 1)	Each	1
Cofferdam Excavation (Special)	Cu Yd	344

NOTES:

Repairs to the existing pier shall include but may not be limited to the areas shown. The actual areas to be repaired will be determined by the ENGINEER at the time of construction. The quantities shown are for estimating purposes only. Actual repair locations shall be shown on the as-built plans.

Cofferdam limits shown are the maximum paid limits of Cofferdam Excavation (Special). Actual limits shall be determined by the contractor and shown on the cofferdam plan.

REVISED SHEET 1/3/2022



USER NAME = 611blb	DESIGNED - BAB	REVISION 12/21/21 BLB
	CHECKED - BLB	REVISION
PLOT SCALE =	DRAWN - LJK	REVISION
PLOT DATE = 12/21/2021	DATE - 10/21/2021	REVISION

STATE OF ILLINOIS
DEPARTMENT OF TRANSPORTATION

PIER 11 REPAIR
STRUCTURE NO. 016-2468

SHEET SA-68 OF SA-73 SHEETS

F.A.P. RTE. 330	SECTION 2018-133-BR	COUNTY COOK	TOTAL SHEETS 308	SHEET NO. 182
			CONTRACT NO. 62H49	
ILLINOIS				

NOTES:

Repairs to the existing pier shall include but may not be limited to the areas shown. The actual areas to be repaired will be determined by the ENGINEER at the time of construction. The quantities shown are for estimating purposes only. Actual repair locations shall be shown on the as-built plans.





Cofferdam limits shown are the maximum paid limits of Cofferdam Excavation (Special). Actual limits shall be determined by the contractor and shown on the cofferdam plan.

LEGEND

 Structural Repair of Concrete (Depth Equal To Or Less Than 5")

BILL OF MATERIAL

Item	Unit	Total
Structural Repair of Concrete (Depth Equal To Or Less Than 5")	Sq Ft	75
Cofferdam (Type 2) (Location - 2)	Each	1
Cofferdam Excavation (Special)	Cu Yd	344

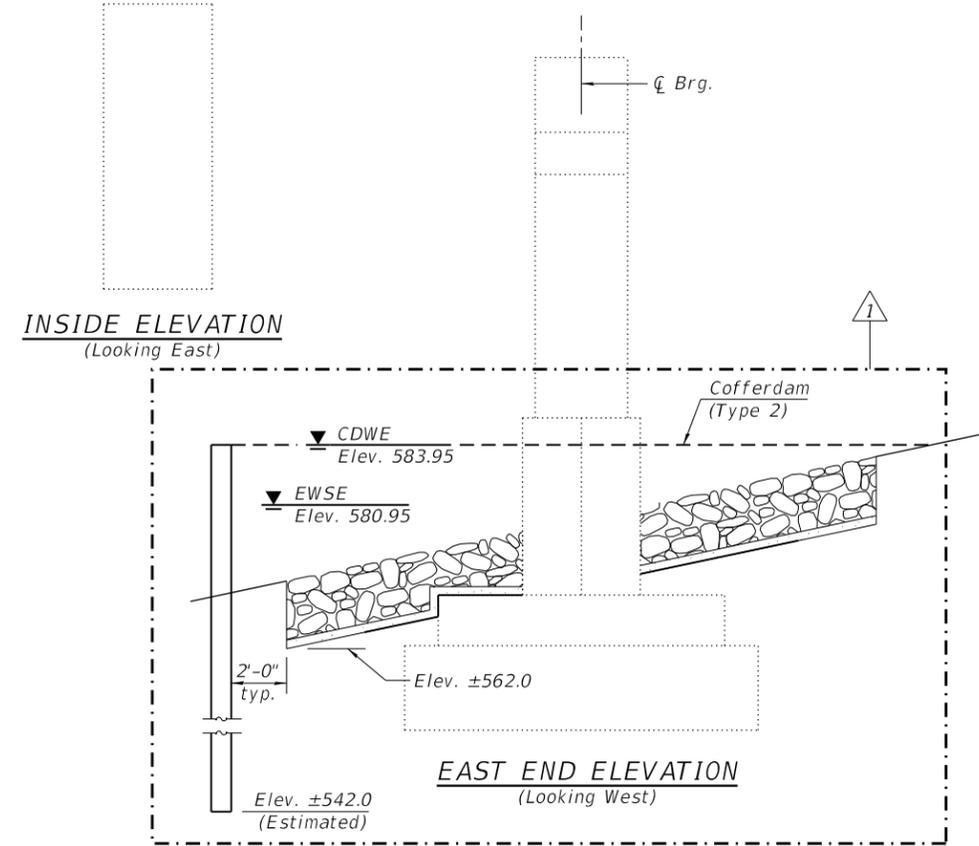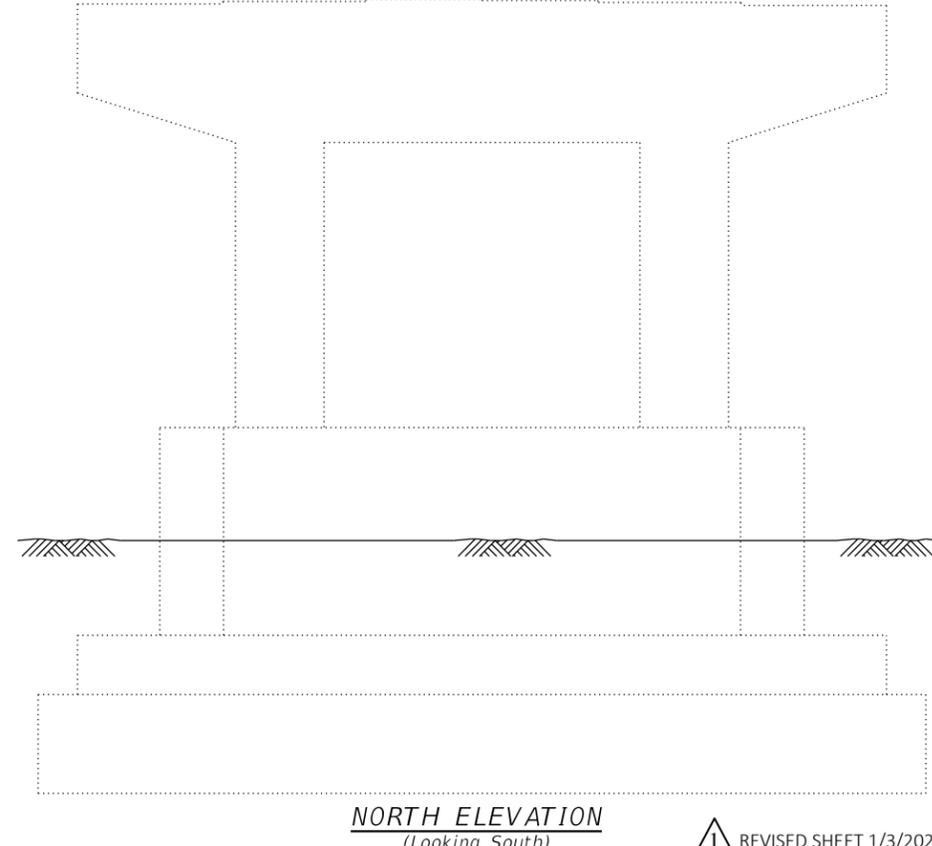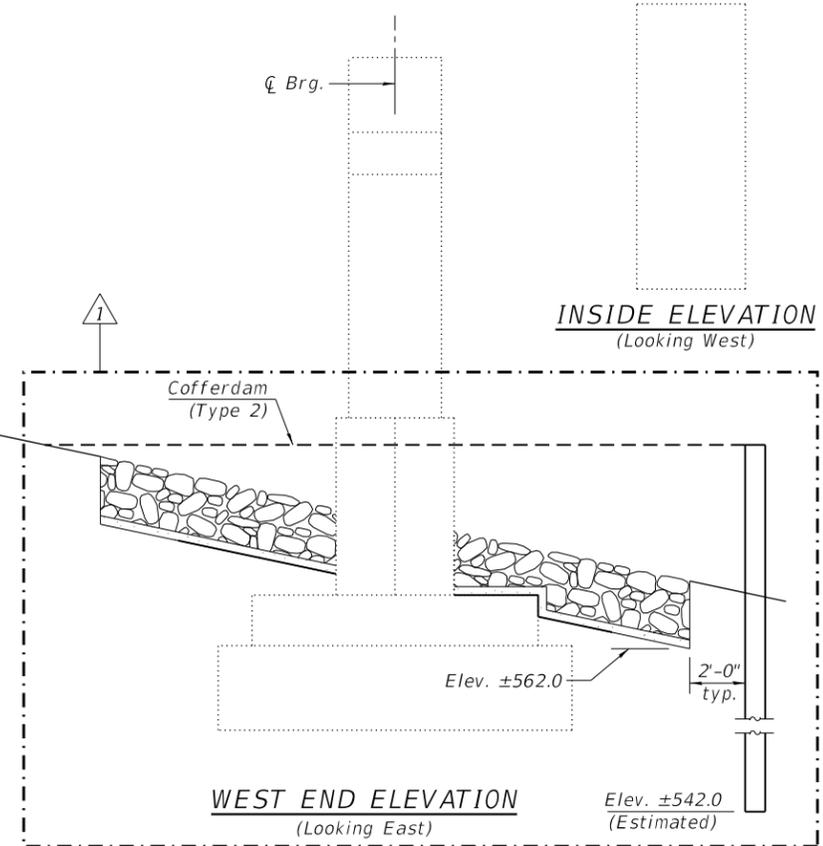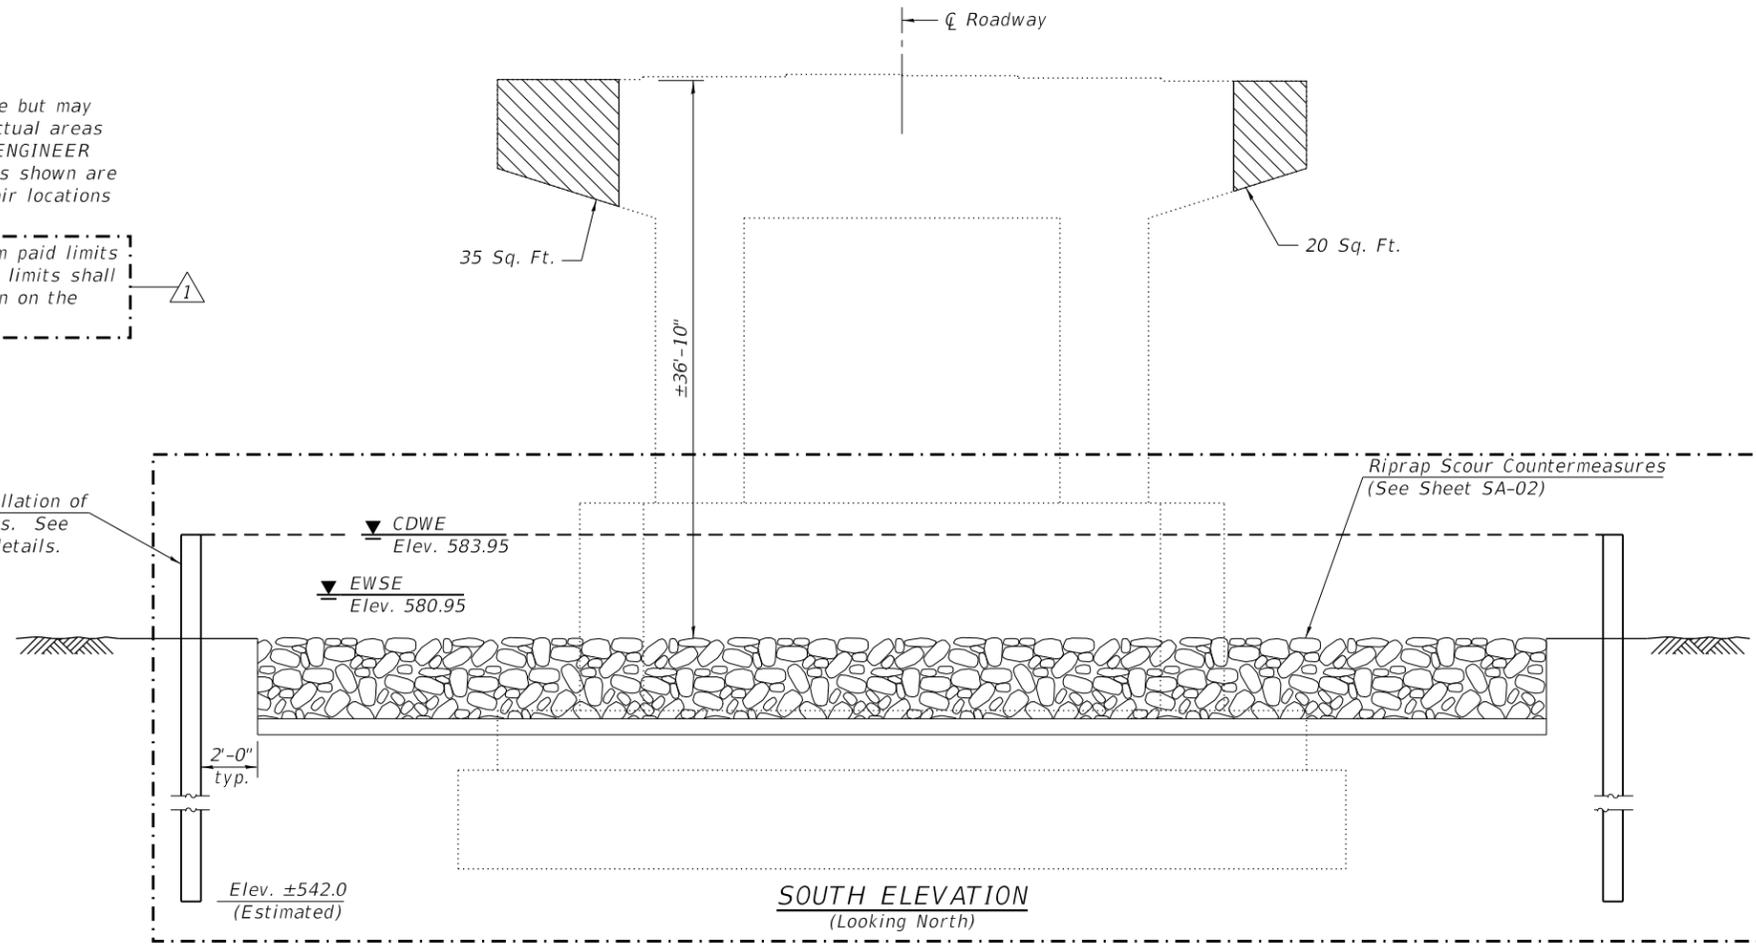

COPYRIGHT © 2021, BY BAXTER & WOODMAN, INC., STATE OF ILLINOIS - PROFESSIONAL DESIGN FIRM LICENSE NO. - 184-001121 - EXPIRES 4/30/2023
 MODEL: Sheet
 FILE NAME: pw:\civiltch-pw-bentley.com\civiltch-pw\Documents\Projects\3393\CADD\CADD Sheets\Structures\Structure SN 016-2468\0162468-62H49-069-SUBREPAIR13.dgn

BAXTER & WOODMAN Consulting Engineers	USER NAME = 611blb	DESIGNED - BAB	REVISED -  12/21/21 BLB
	PLOT SCALE =	CHECKED - BLB	REVISED -
	PLOT DATE = 12/21/2021	DRAWN - LJK	REVISED -
		DATE - 10/21/2021	REVISED -

**STATE OF ILLINOIS
DEPARTMENT OF TRANSPORTATION**

 REVISED SHEET 1/3/2022

**PIER 12 REPAIR
STRUCTURE NO. 016-2468**

SHEET SA-69 OF SA-73 SHEETS

F.A.P. RTE.	SECTION	COUNTY	TOTAL SHEETS	SHEET NO.
330	2018-133-BR	COOK	308	183
CONTRACT NO. 62H49			ILLINOIS	

GENERAL NOTES

- Fasteners shall be ASTM F 3125 Grade A325 Type 1, mechanically galvanized bolts. Bolts 7/8 in. Dia., holes 1 1/16 in. Dia., unless otherwise noted.
- All structural steel shall be AASHTO M 270 Grade 36.
- No field welding is permitted except as specified in the contract documents.
- The Contractor shall test the existing welds by non-destructive methods within 2 ft. of the end of the existing cover plates for cracks after removal of the existing concrete deck. Dye penetrant (PT), magnetic particle (MT), or other approved testing method shall be performed by qualified personnel approved by the Engineer. If cracks are found, report them to the Bureau of Bridges and Structures for disposition. The cost of testing is included in Removal of Existing Concrete Deck. The cost of crack repair, if necessary, will be paid for according to Article 109.04 of the Standard Specifications.
- Reinforcement bars designated (E) shall be epoxy coated.
- Prior to pouring the new concrete deck, all heavy or loose rust, loose mill scale, and other loose or potentially detrimental foreign material shall be removed from the surfaces in contact with concrete. Tightly adhered paint may remain unless otherwise noted. Removal shall be accomplished by methods that will not damage the steel and the cost will be included in the pay item covering removal of the existing concrete.




As directed by the Engineer, existing construction accessories welded to the top flange of beams and girders shall be removed. The weld areas shall be ground flush and inspected for cracks using magnetic particle testing (MT) or dye penetrant testing (PT) by qualified personnel approved by the Engineer. Any cracks that cannot be removed by grinding 1/4 in. deep shall be identified and reported to the Bureau of Bridges and Structures for further disposition. The cost of removing welded accessories, grinding and inspecting weld areas and grinding cracks will be paid for according to Article 109.04 of the Standard Specifications.
- If the Contractor elects to use cantilever forming brackets on the exterior beams or girders, the brackets shall be placed at the same locations as required for the hardwood blocks in Article 503.06(b) of the Standard Specifications. If additional cantilever forming brackets are required, hardwood blocking shall be wedged between the exterior and first interior beam at each of these additional bracket locations.
- Plan dimensions and details relative to existing plans are subject to nominal construction variations. The Contractor Widening, repair or rehabilitation of existing structures. Bridge Manual Section 3 - Design Page 3-5 Jan 2012 shall field verify existing dimensions and details affecting new construction and make necessary approved adjustments prior to construction or ordering of materials. Such variations shall not be cause for additional compensation for a change in scope of the work, however, the Contractor will be paid for the quantity actually furnished at the unit price bid for the work.
- Bearing seat surfaces shall be constructed or adjusted to the designated elevations within a tolerance of 1/16 in. (0.01 ft.). Adjustment shall be made either by grinding the surface or by shimming the bearings.
- Concrete Sealer shall be applied to the reconstructed abutment backwalls and all areas at top of the reconstructed pier caps at Piers 4, 9, 15, 21, 25 & 29.
- Cleaning and field painting of structural steel shall be done under a separate painting contract.
- The existing structural steel coating contains lead. The Contractor shall take appropriate precautions to deal with the presence of lead on this project.
- All new structural steel shall be shop painted with an inorganic zinc rich primer per AASHTO M300, Type 1.

INDEX OF SHEETS

SB-1	General Plan & Elevation I	SB-58	Modular Expansion Joint Details
SB-2	General Plan & Elevation II	SB-59	South Bridge Approach Slab
SB-3	General Plan & Elevation III	SB-60	South Bridge Approach Slab Details
SB-4	General Plan & Elevation IV	SB-61	North Bridge Approach Slab
SB-5	General Data	SB-62	North Bridge Approach Slab Details
SB-6 to 8	Top of Deck Elevations (Unit 1)	SB-63	Cross Girder Cover Plate Retrofit Details
SB-9 to 10	Top of Deck Elevations (Unit 2)	SB-64	Moment & Reaction Tables - Units 1 to 5
SB-11 to 12	Top of Deck Elevations (Unit 3)	SB-65	Moment & Reaction Tables - Units 6 & 7
SB-13 to 14	Top of Deck Elevations (Unit 4)	SB-66	Moment & Reaction Tables - Unit 8
SB-15 to 16	Top of Deck Elevations (Unit 5)	SB-67	Moment & Reaction Tables - Unit 9
SB-17 to 18	Top of Deck Elevations (Unit 6)	SB-68	Moment & Reaction Tables - Unit 10
SB-19 to 20	Top of Deck Elevations (Unit 7)	SB-69	Girder Details - Units 1 to 3
SB-21 to 24	Top of Deck Elevations (Unit 8)	SB-70	Girder Details - Units 4 & 5
SB-25 to 28	Top of Deck Elevations (Unit 9)	SB-71	Girder Details - Unit 6
SB-29 to 30	Top of Deck Elevations (Unit 10)	SB-72	Girder Details - Units 7 & 8
SB-31	Top of South Approach Slab Elevations	SB-73	Girder Details - Units 9 & 10
SB-32	Top of North Approach Slab Elevations	SB-74	Abutment Bearing Details
SB-33	Superstructure Plan Unit 1	SB-75	HLMR Bearing Details 1 - Fixed
SB-34	Superstructure Unit 1 Details 1	SB-76	HLMR Bearing Details 2 - Fixed
SB-35	Superstructure Unit 1 Details 2	SB-77	HLMR Bearing Details 3 - Guided Expansion
SB-36	Superstructure Plan & Cross Section Unit 2	SB-78	HLMR Bearing Details 4 - Guided Expansion
SB-37	Superstructure Unit 2 Details 1	SB-79	HLMR Bearing Details 5 - Guided Expansion
SB-38	Superstructure Plan Unit 3	SB-80	Abutment Removal & Repair Details
SB-39	Superstructure Unit 3 Details 1	SB-81	South Abutment
SB-40	Superstructure Unit 3 Details 2	SB-82	South Abutment Details
SB-41	Superstructure Plan Unit 4	SB-83	North Abutment
SB-42	Superstructure Unit 4 Details 1	SB-84	North Abutment Details 1
SB-43	Superstructure Plan Unit 5	SB-85	North Abutment Details 2
SB-44	Superstructure Unit 5 Details 1	SB-86	Pier Removal Details
SB-45	Superstructure Plan Unit 6	SB-87	Pier Repair Details 1 - Piers 2, 4 & 6
SB-46	Superstructure Unit 6 Details 1	SB-88	Pier Repair Details 2 - Piers 12 & 18
SB-47	Superstructure Plan Unit 7	SB-89	Pier Repair Details 3 - Piers 19 & 23
SB-48	Superstructure Unit 7 Details 1	SB-90	Pier Repair Details 4 - Pier 29
SB-49	Superstructure Plan Unit 8	SB-91	Pier 4
SB-50	Superstructure Unit 8 Details 1	SB-92	Pier 9
SB-51	Superstructure Unit 8 Details 2	SB-93	Pier 15
SB-52	Superstructure Plan Unit 9	SB-94	Pier 21
SB-53	Superstructure Unit 9 Details 1	SB-95	Pier 25
SB-54	Superstructure Unit 9 Details 2	SB-96	Pier 29
SB-55	Superstructure Plan & Cross Section Unit 10	SB-97	Pier Bar Bending Diagrams
SB-56	Superstructure Unit 10 Details 1	SB-98	Slope Wall Repair
SB-57	Preformed Joint Strip Seal	SB-99	Drainage Scupper, DS-12
		SB-100	Drainage System Details 1
		SB-101	Drainage System Details 2
		SB-102	Drainage System Details 3
		SB-103	Bar Splicer Assembly
		SB-104	Concrete Parapet Slipforming Option

TOTAL BILL OF MATERIAL

Description	Unit	Sub	Super	Total
Stone Riprap, Class A4	Ton	201		201
Filter Fabric	Sq. Yd.	53		53
Concrete Removal	Cu. Yd.	221.6		221.6
Bridge Rail Removal	Foot		5,535	5,535
Removal of Existing Concrete Deck No. 2	Each		1	1
Protective Shield	Sq. Yd.		12,891	12,891
Structure Excavation	Cu. Yd.	150		150
Cofferdam (Type 2) (Location - 3)	Each	1		1
Concrete Structures	Cu. Yd.	222.0	30.2	252.2
Concrete Superstructure	Cu. Yd.		4,462.1	4,462.1
Protective Coat	Sq. Yd.		15,346	15,346
Concrete Superstructure (Approach Slab)	Cu. Yd.		123.3	123.3
Furnishing and Erecting Structural Steel	Pound		2,585	2,585
Stud Shear Connectors	Each		24,832	24,832
Reinforcement Bars, Epoxy Coated	Pound	58,800	1,013,100	1,071,900
Bar Splicer	Each	98		98
Name Plates	Each		1	1
Preformed Joint Strip Seal	Foot		442	442
Elastomeric Bearing Assembly, Type II	Each		6	6
Anchor Bolts, 1"	Each		24	24
Anchor Bolts, 1 1/4"	Each		376	376
Granular Backfill for Structures	Cu. Yd.	119		119
Concrete Sealer	Sq. Ft.	1,043		1,043
Epoxy Crack Injection	Foot	26		26
Geocomposite Wall Drain	Sq. Yd.	79		79
Cofferdam Excavation (Special)	Cu. Yd.	152		152
Bridge Deck Grooving (Longitudinal)	Sq. Yd.		10,260	10,260
High Load Multi-Rotational Bearings, Guided Expansion, 350k	Each		36	36
High Load Multi-Rotational Bearings, Guided Expansion, 750k	Each		18	18
High Load Multi-Rotational Bearings, Guided Expansion, 900k	Each		4	4
High Load Multi-Rotational Bearings, Fixed - 750k	Each		18	18
Jack and Remove Existing Bearings	Each		64	64
Structural Steel Repair	Pound		25,073	25,073
Structural Repair of Concrete (depth equal to or less than 5 inches)	Sq. Ft.	2,010		2,010
Drainage Scuppers, DS-12	Each		61	61
Drainage System for Structures	L. Sum		1	1
Diamond Grinding (Bridge Section)	Sq. Yd.		11,409	11,409
Modular Expansion Joint 6"	Foot		41	41
Removal of Existing Bearings	Each		24	24
Pipe Underdrains for Structures 4"	Foot	167		167
Slope Wall Repair	Sq. Yd.	200		200
Temporary Shoring and Cribbing	Each	72		72

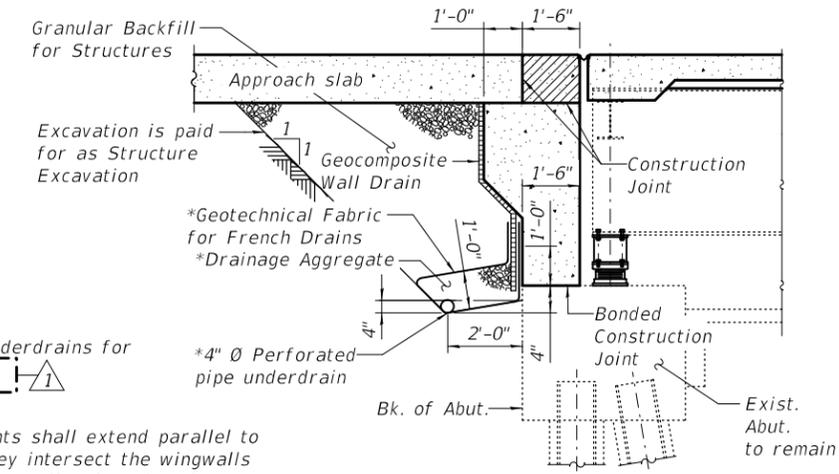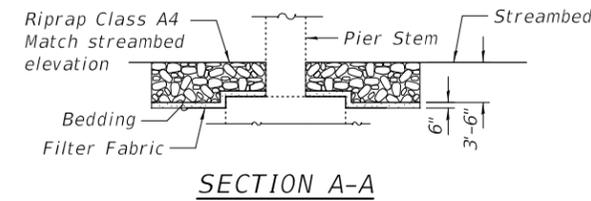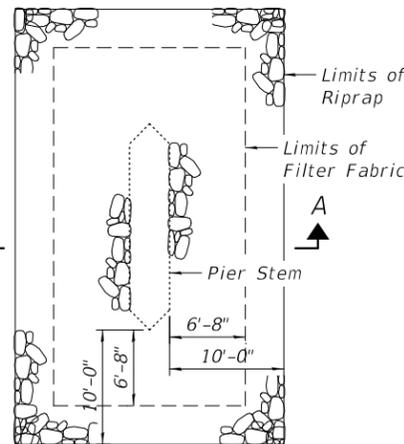

- This project requires a US Army Corp of Engineers (USACE) 404 permit that has been scured by IDOT. As a condition of the permit the Contractor will need to submit a in-stream work plan to the Will/South Cook Soil and Water Conservation District (SWCD) for approval. Guidelines on acceptable in-stream work techniques can be found on the USACE website.
- Work shall conform to all provisions of the Erosion Control Plan.
- Haul Roads, In-Stream Work Pads and Causeways, if needed, shall be constructed in accordance with the Recurring Special Provision Check Sheet #8.

*Included in the cost of Pipe Underdrains for Structures.

Note:
All drainage system components shall extend parallel to the abutment back wall until they intersect the wingwalls or 2'-0" from the end of the wingwalls when the wings are parallel to the abutment. The pipe shall extend under the wingwall, if necessary, until intersecting the side slopes. The pipes shall drain into concrete headwalls. (See Article 601.05 of the Standard Specifications and Highway Standard 601101).

SECTION THRU ABUTMENT
(Horiz. dim. @ Rt. L's)
South Abutment shown, North Abutment similar

REVISED SHEET 1/3/2022

MODEL: Default
FILE NAME: pw:\civiltch-pw-bentley.com\civiltch-pw\Documents\Projects\3393\CAD\CADD Sheets\Structures\Structure SN 016-2467\0162467-62H49-005-GeneralData_rev_1.dgn




USER NAME = JAL	DESIGNED - E. VAYSMAN	REVISED - 12/21/2021 J.A.L.
	CHECKED - G. HATLESTAD	REVISED -
PLOT SCALE = N/A	DRAWN - E. VAYSMAN	REVISED -
PLOT DATE = 12/22/2021	DATE - 10/21/2021	REVISED -

STATE OF ILLINOIS
DEPARTMENT OF TRANSPORTATION

GENERAL DATA
STRUCTURE NO. 016-2467

SHEET SB-5 OF SB-104 SHEETS


F.A.I. RTE. 330	SECTION 2018-133-BR	COUNTY COOK	TOTAL SHEETS 308	SHEET NO. 192
ILLINOIS			CONTRACT NO. 62H49	

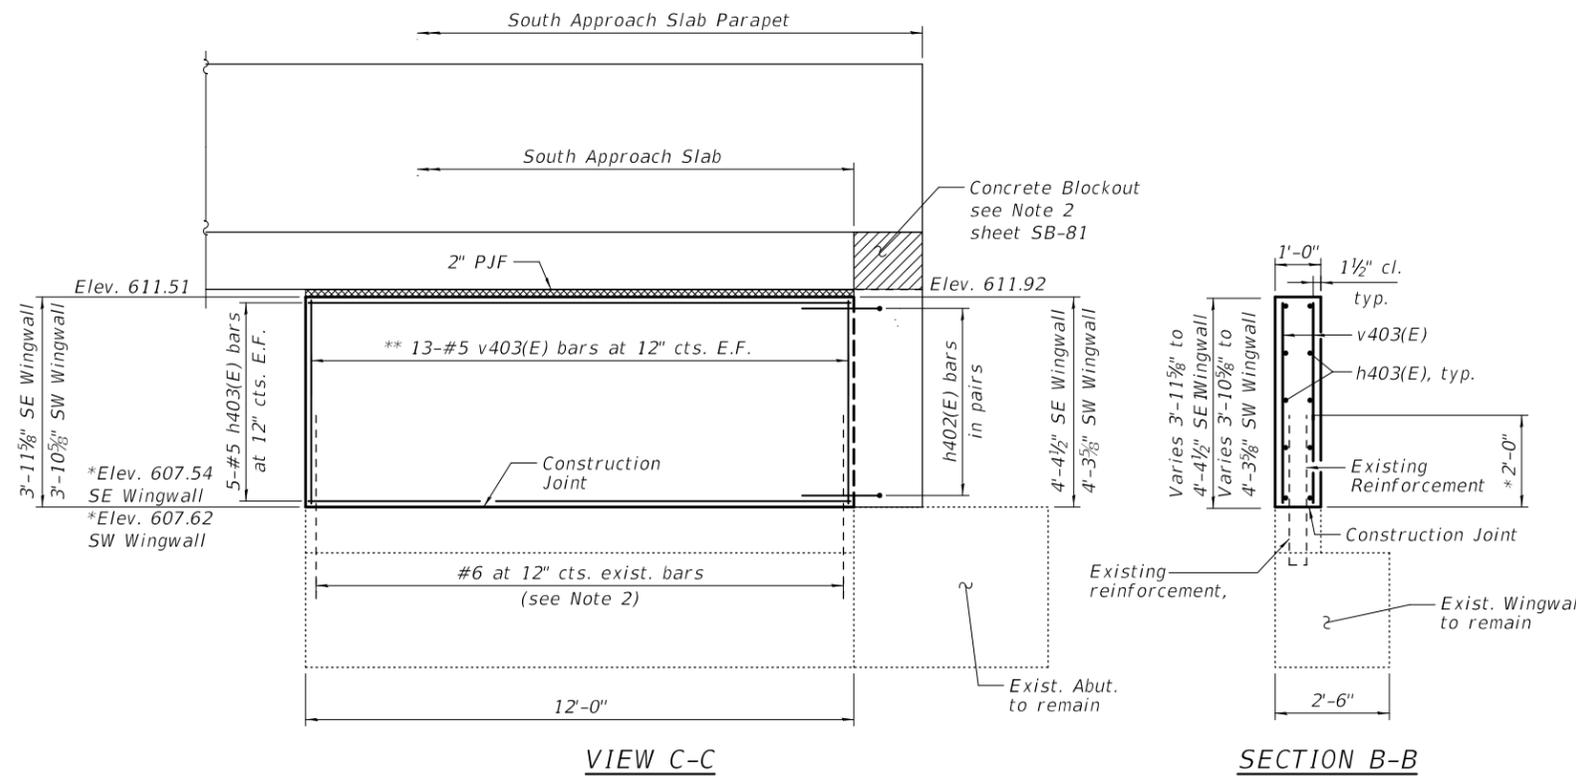

VIEW C-C


SECTION B-B

* Verify in field
 ** See Field Cutting Diagram. Cut bars as needed in field

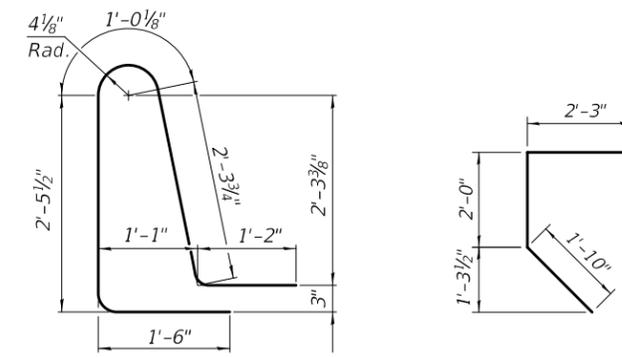


BAR d301(E)

BAR u400E

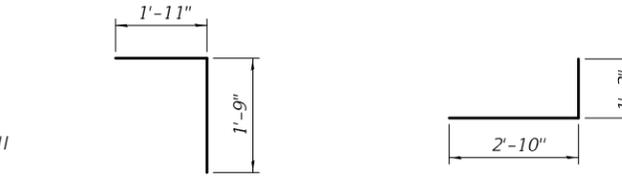

BAR v400(E)

BAR h402(E)

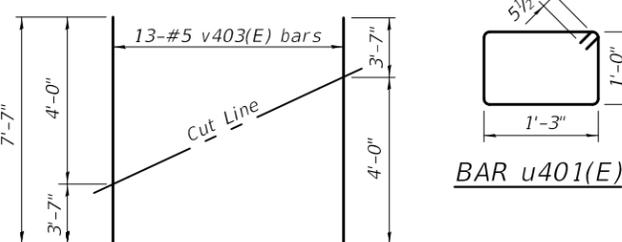


FIELD CUTTING DIAGRAM

Order v403(E) bar full length.
 Cut as shown and use remainder of bars in opposite face

BAR u401(E)

**SOUTH ABUTMENT
 BILL OF MATERIAL**

Bar	No.	Size	Length	Shape
d301(E)	6	#5	8'-6"	
h400(E)	10	#6	23'-11"	
h401(E)	24	#5	22'-9"	
h402(E)	20	#5	4'-1"	
h403(E)	20	#5	11'-9"	
v400(E)	41	#5	3'-8"	
v401(E)	86	#5	5'-4"	
v403(E)	26	#5	7'-7"	
u400(E)	41	#5	6'-1"	
u401(E)	4	#5	5'-5"	
Structure Excavation		Cu. Yd.	65	
Concrete Structures		Cu. Yd.	18.1	
Reinforcement Bars, Epoxy Coated		Pound	2,440	
Granular Backfill for Structures		Cu. Yd.	52	
Concrete Sealer		Sq. Ft.	186	
Geocomposite Wall Drain		Sq. Yd.	34	
Pipe Underdrains for Structures 4"		Feet	89	

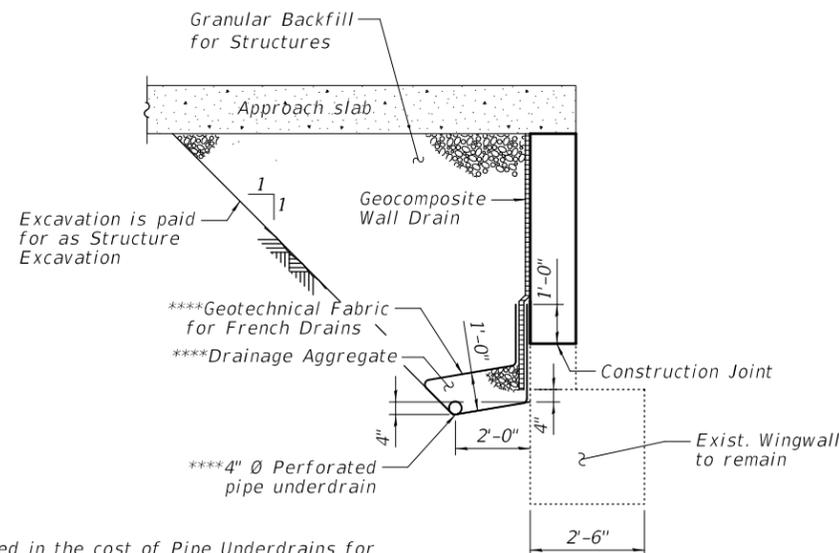

SECTION THRU WINGWALL

(Horiz. dim. @ Rt. L's)

***Included in the cost of Pipe Underdrains for Structures.

Notes:

1. See sheet SB-81 for location of Section B-B and view C-C.
2. Existing reinforcement shall be cleaned, straightened, and incorporated into the new construction. Cost included with "Concrete Removal".

MODEL: Default
 FILE NAME: pw:\civiltch-pw-bentley.com\civiltch-pw\Documents\Projects\3393\CADD\CADD Sheets\Structures\Structure SN 016-2467\0162467-62H49-082-SouthAbutDetails_rev.1.dgn



USER NAME = JAL	DESIGNED - E. VAYSMAN	REVISED - 12/21/2021 J.A.L.
PLOT SCALE = N/A	CHECKED - G. HATLESTAD	REVISED -
PLOT DATE = 12/22/2021	DRAWN - E. VAYSMAN	REVISED -
	DATE - 10/21/2021	REVISED -


STATE OF ILLINOIS
 DEPARTMENT OF TRANSPORTATION

SOUTH ABUTMENT DETAILS
 STRUCTURE NO. 016-2467


SHEET SB-82 OF SB-104 SHEETS

F.A.I. RTE.	SECTION	COUNTY	TOTAL SHEETS	SHEET NO.
330	2018-133-BR	COOK	308	269
ILLINOIS			CONTRACT NO. 62H49	


REVISED SHEET 1/3/2022

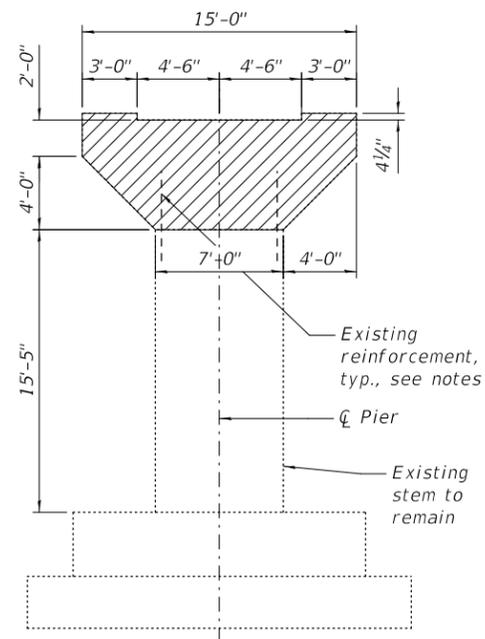


ELEVATION - PIER 4

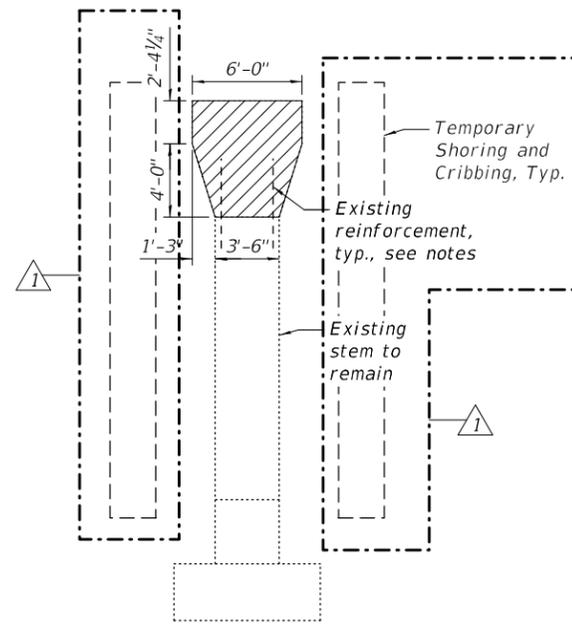

END VIEW - PIER 4

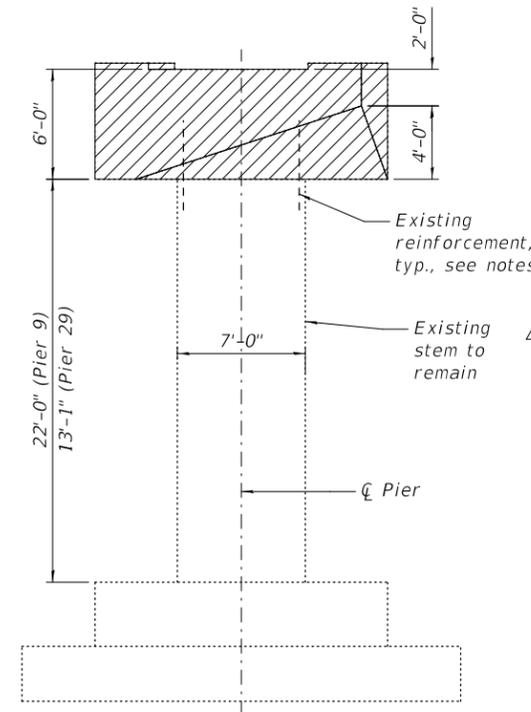


ELEVATION - PIER 9 & 29

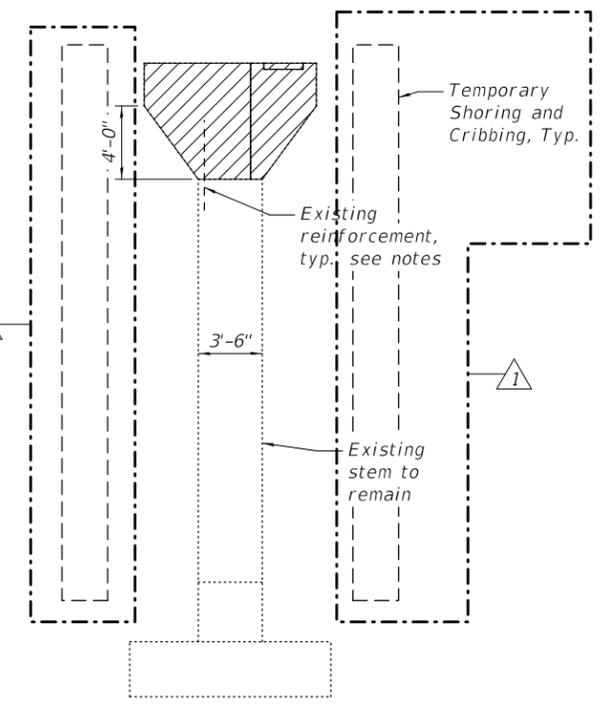


END VIEW - PIER 9 & 29

See Pier Cap Isometric for balance of information

Concrete Removal

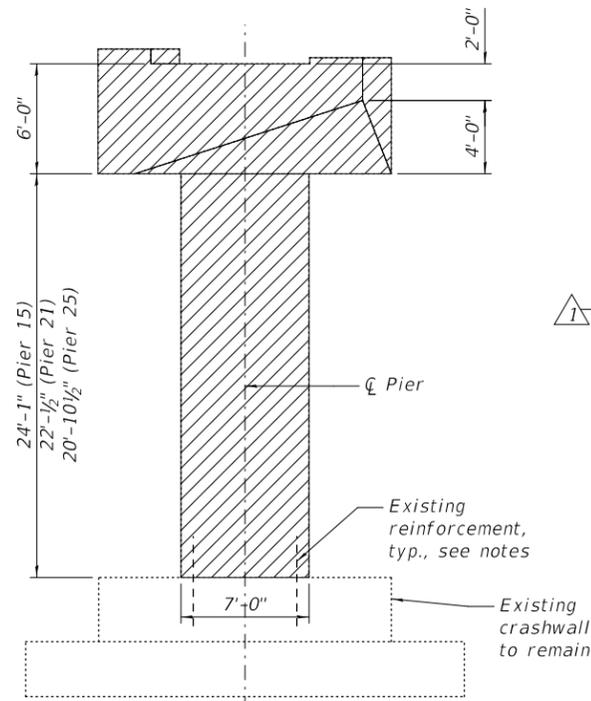


ELEVATION - 15, 21 & 25

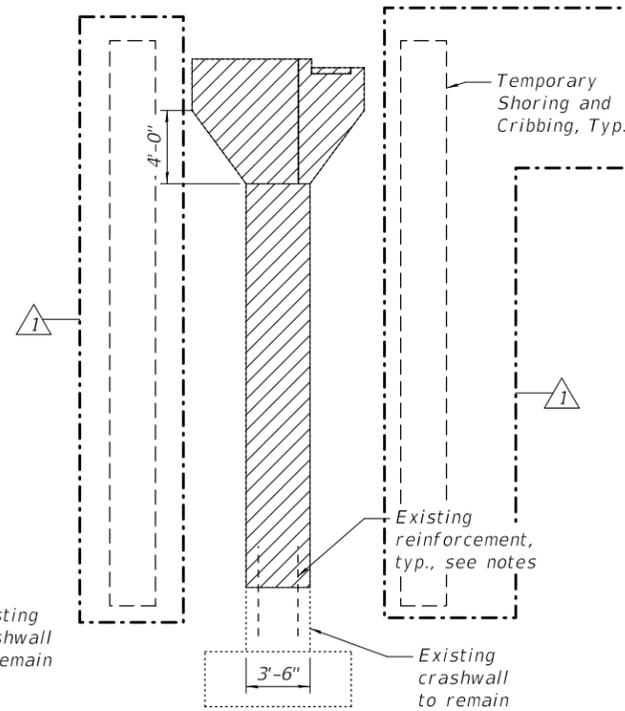

END VIEW - PIER 15, 21 & 25

See Pier Cap Isometric for balance of information

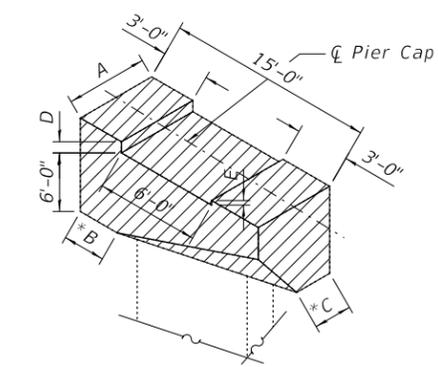

PIER CAP ISOMETRIC

*One corner shown, opposite corner similar (Pier 9, 15, 21, 25, & 29)

Pier No.	A	B	C	D	E
Pier 9	6'-0"	2'-7 3/4"	2'-11 1/2"	4"	4"
Pier 15	6'-0"	2'-7 3/4"	2'-11 1/2"	4 1/8"	4 1/8"
Pier 21	6'-0"	3'-1 1/4"	2'-9 1/2"	9 5/8"	9 5/8"
Pier 25	7'-0"	4'-3 1/4"	1'-10"	9 3/4"	3 3/4"
Pier 29	7'-0"	5'-9 1/2"	0'-0"	8"	2"

Notes:

Existing vertical reinforcement bars projecting from the pier stem into the pier cap or projecting from the crashwall into the pier stem are to remain in place. The existing reinforcement shall be sandblasted clean, straightened, and incorporated into the new construction. Cost included with Concrete Removal.

Temporary Shoring and Cribbing shall be placed after removal of deck and prior to removal of any pier concrete. The Temporary Shoring and Cribbing shall be removed after the pier has been reconstructed and the new bearings are in place and prior to new deck pour. See Special Provision. See "Beam Reactions for Temporary Shoring and Cribbing" table on Sheet SB-4.

BILL OF MATERIAL

Item	Unit	Total
Concrete Removal	Cu. Yd.	180.2
Temporary Shoring and Cribbing	Each	72

REVISED SHEET 1/3/2022




USER NAME = JAL	DESIGNED - E. VAYSMAN	REVISED - 12/21/2021 J.A.L.
PLOT SCALE = N/A	CHECKED - G. HATLESTAD	REVISED -
PLOT DATE = 12/22/2021	DRAWN - E. VAYSMAN	REVISED -
	DATE - 10/21/2021	REVISED -

STATE OF ILLINOIS
DEPARTMENT OF TRANSPORTATION


PIER REMOVAL DETAILS
STRUCTURE NO. 016-2467

SHEET SB-86 OF SB-104 SHEETS


F.A.I. RTE.	SECTION	COUNTY	TOTAL SHEETS	SHEET NO.
330	2018-133-BR	COOK	308	273
			CONTRACT NO. 62H49	
ILLINOIS				

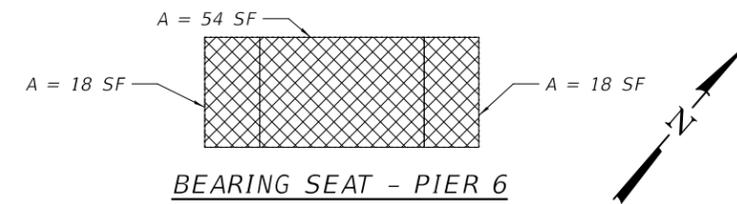


BEARING SEAT - PIER 6

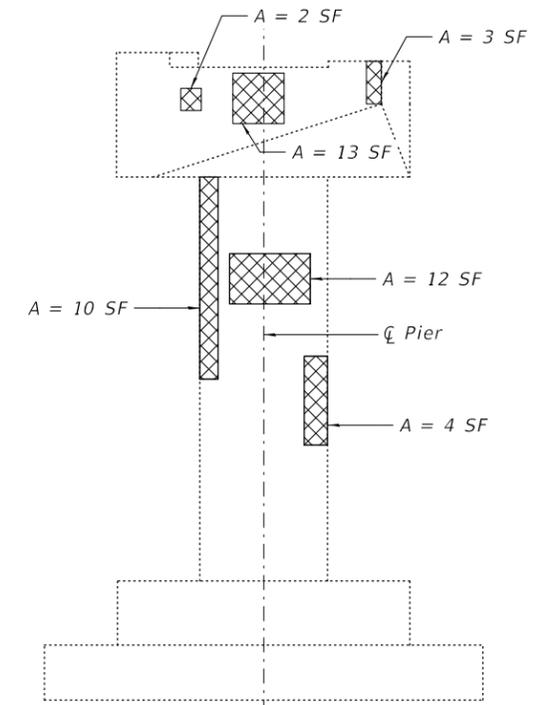

ELEVATION - PIER 6
(Looking North)

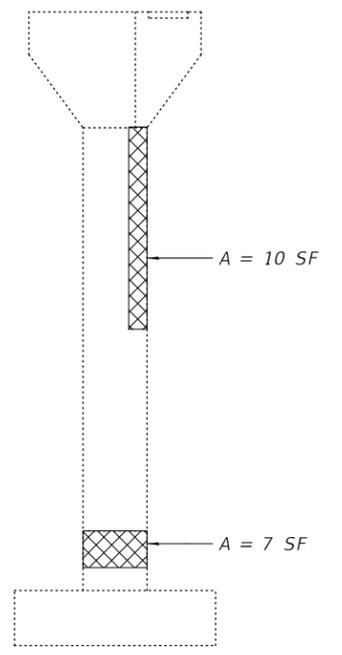

END VIEW - PIER 6
(Looking East)

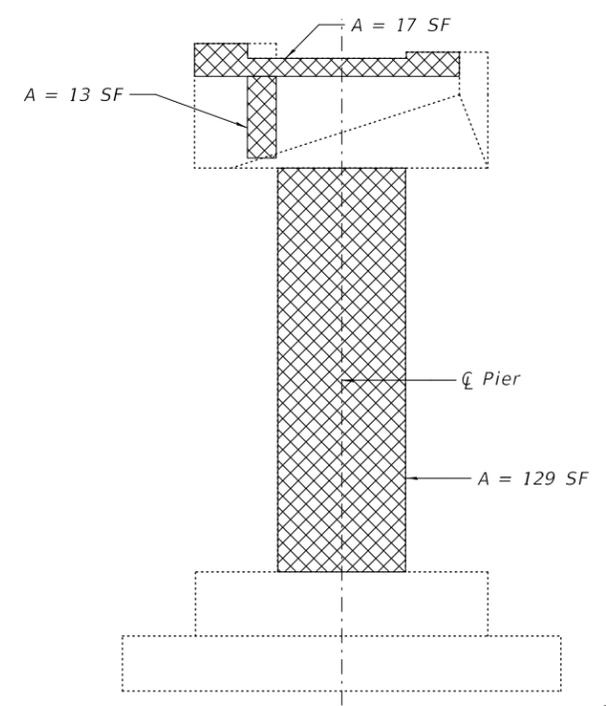


ELEVATION - PIER 6
(Looking South)

Note:
Repairs to the existing pier shall include but may not be limited to the areas shown. The actual areas to be repaired will be determined by the ENGINEER at the time of construction. The quantities shown are for estimating purposes only. Actual repair locations shall be shown on the as-built plans.
Additional repair quantity has been included to account for any repair areas not shown.
Cofferdam limits shown are the maximum pay limits for Cofferdam Excavation (Special). Actual limits shall be determined by the Contractor and shown on the cofferdam plan.

BILL OF MATERIAL


Item	Unit	Total
Structural Repair of Concrete (Depth Equal to or Less Than 5 Inches)	Sq. Ft.	680
Cofferdam (Type 2) (Location -3)	Each	1
Cofferdam Excavation (Special)	Cu. Yd.	152

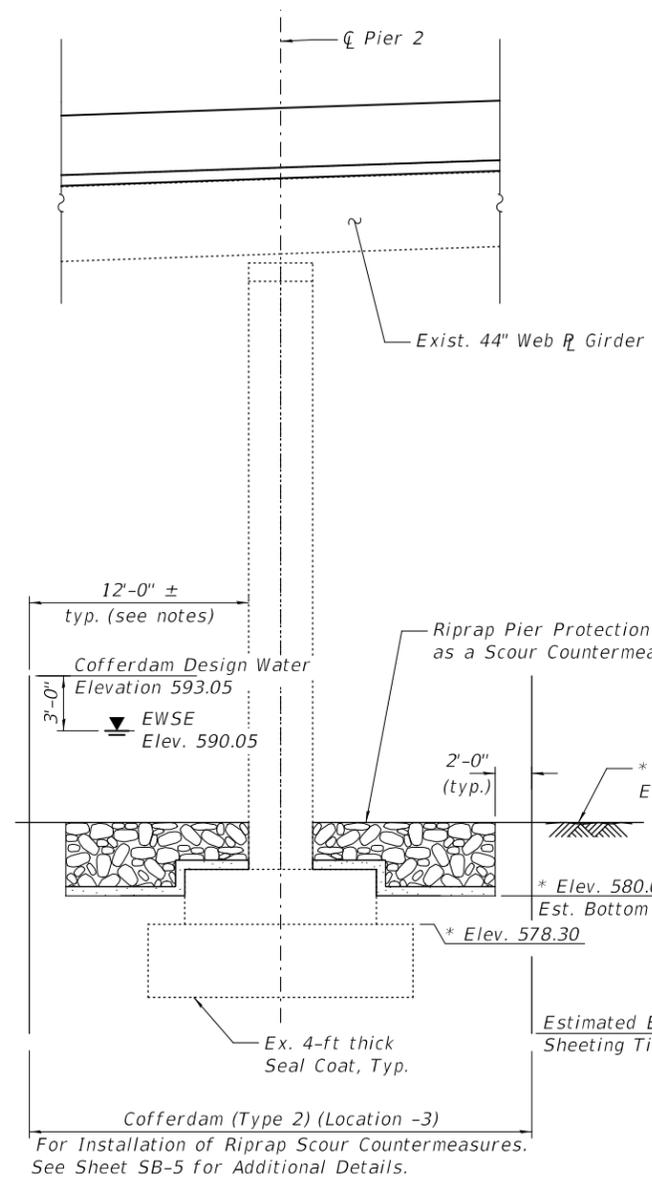


COFFERDAM DETAIL
(at Pier 2)

LEGEND


- Structural Repair of Concrete (Depth Equal to or Less Than 5 Inches)
- SF Square Feet

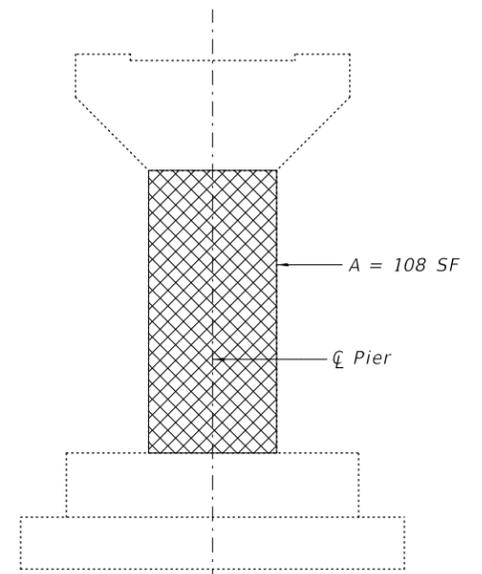


ELEVATION - PIER 4
(Looking North)

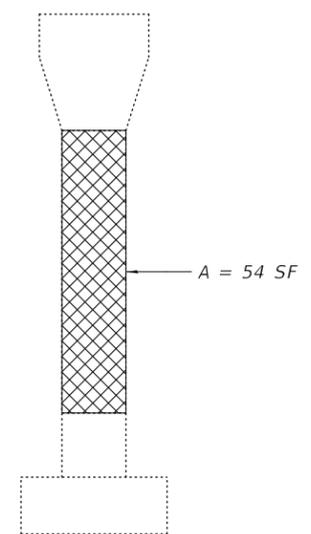

END VIEW - PIER 4
(Looking East)

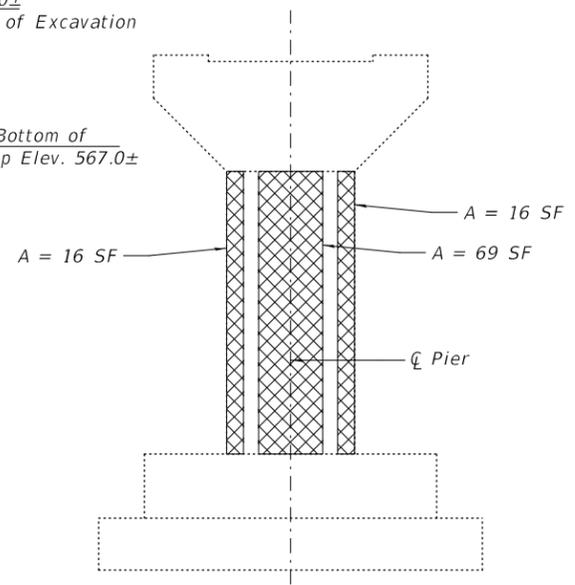

ELEVATION - PIER 4
(Looking South)

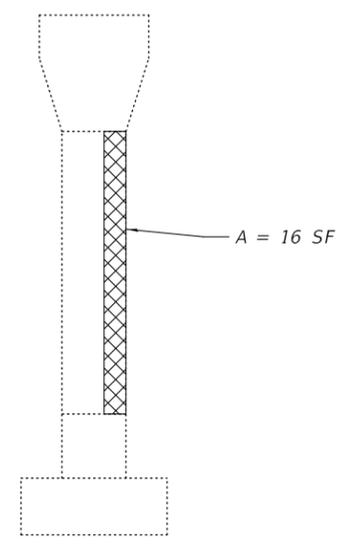

END VIEW - PIER 4
(Looking West)

REVISED SHEET 1/3/2022


STATE OF ILLINOIS
DEPARTMENT OF TRANSPORTATION

PIER REPAIRS DETAILS 1 - PIERS 2, 4 & 6
STRUCTURE NO. 016-2467


SHEET SB-87 OF SB-104 SHEETS

F.A.I. RTE.	SECTION	COUNTY	TOTAL SHEETS	SHEET NO.
330	2018-133-BR	COOK	308	274
ILLINOIS			CONTRACT NO. 62H49	


USER NAME = JAL	DESIGNED - E. VAYSMAN	REVISED - 12/21/2021 J.A.L.
PLOT SCALE = N/A	CHECKED - G. HATLESTAD	REVISED -
PLOT DATE = 12/22/2021	DRAWN - E. VAYSMAN	REVISED -
	DATE - 10/21/2021	REVISED -

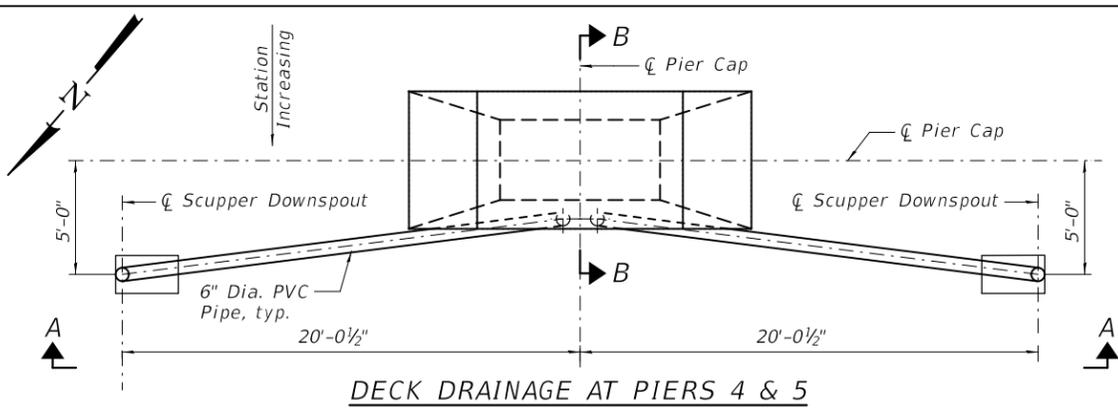


DECK DRAINAGE AT PIERS 4 & 5

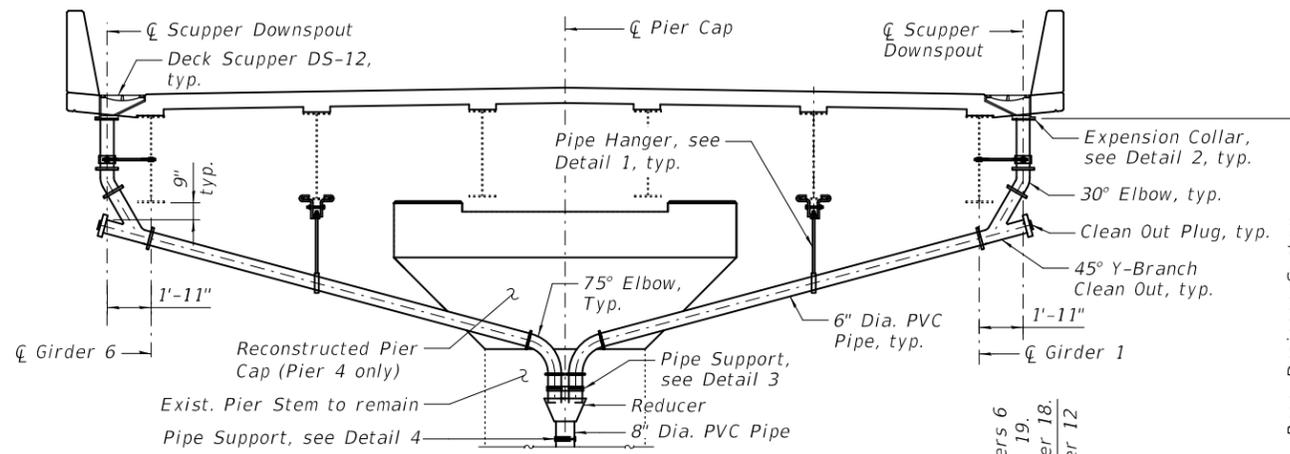


ELEVATION A-A

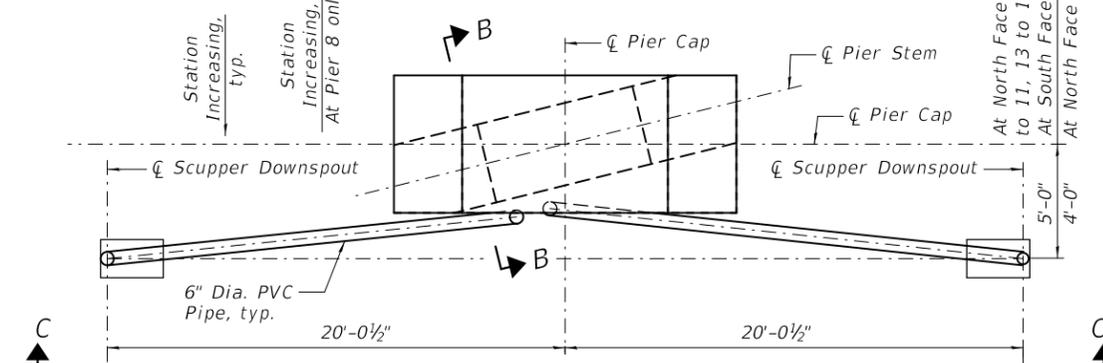


DECK DRAINAGE AT PIERS 6 THRU 19

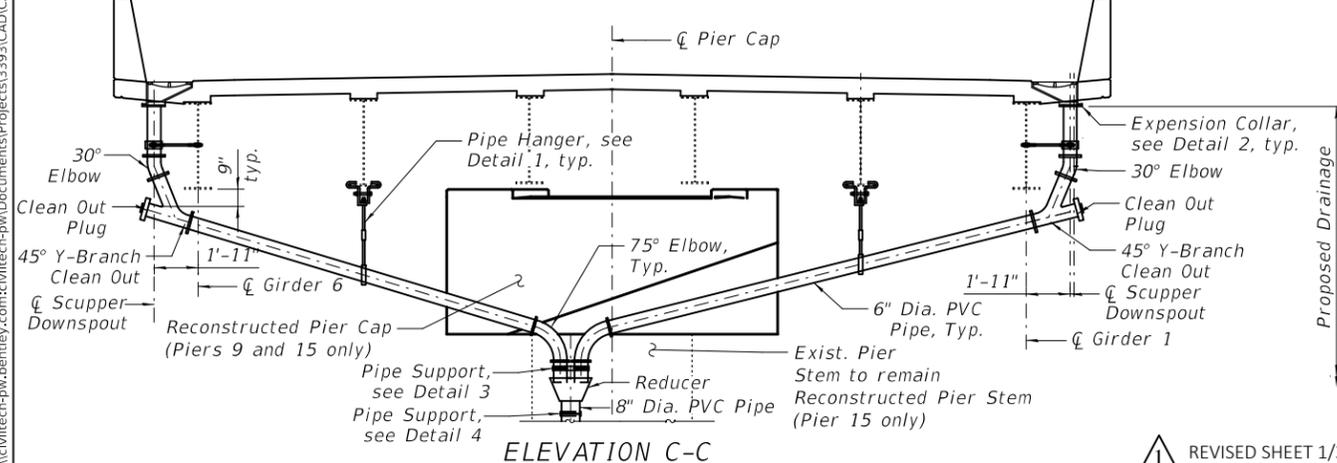


ELEVATION C-C

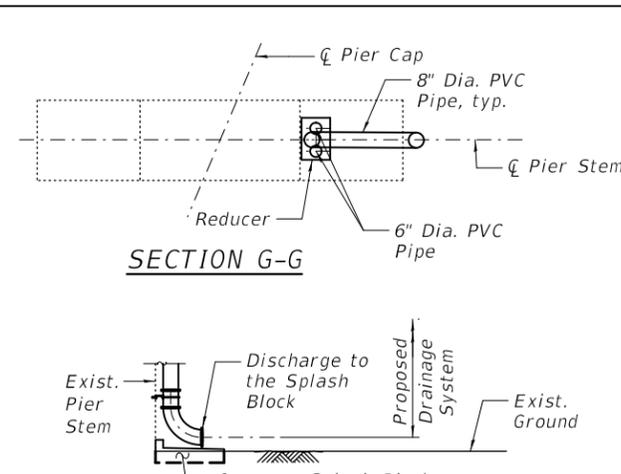


SECTION G-G

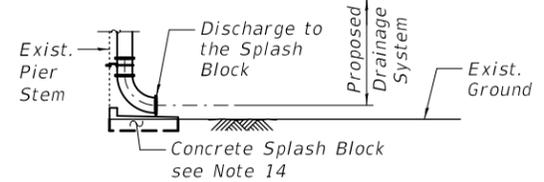

SECTION B-B
(Alternative Section for Piers 5 and 16)

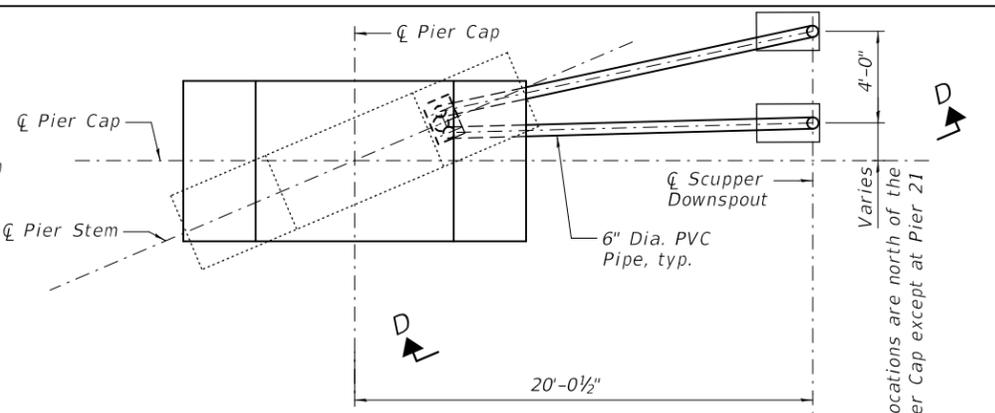

DECK DRAINAGE AT PIERS 20 THRU 29

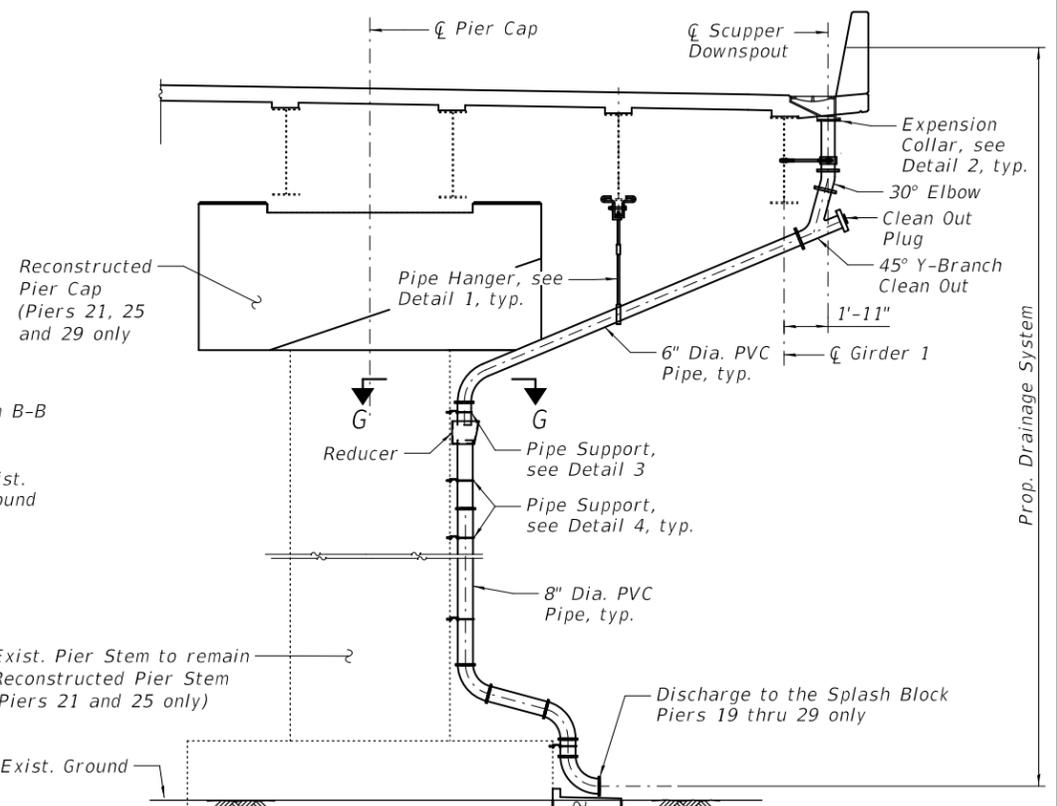

ELEVATION D-D

BILL OF MATERIAL

Item	Unit	Total
Drainage System for Structures 1	L. Sum	1

Notes:

- See Superstructure Units plans sheets SB-33 thru SB-55 for drainage scupper location and spacing.
- See sheet SB-99 for Drainage Scupper details.
- See sheet SB-101 for Details 1 and 2.
- See sheet SB-102 for Details 3 and 4.
- Bolt pattern and size in drain pipe flange to match scupper flange.
- Pipe hangers and supports shall be provided at each tee, elbow or change of direction per manufacturer recommendation. Cost included with Drainage System for Structures.
- All pipe hangers, supports and hardware shall be hot-dipped galvanized after fabrication in accordance with AASHTO M232 (ASTM A153). All bolts nuts and washers shall be stainless steel according to Std. Spec. Art. 1006.29(d).
- All steel straps, bars and plates of pipe support hanger shall meet the requirements of AASHTO M270, Gr. 36 or 50.
- Structural steel shapes used in support of vertical drain pipes shall meet the requirements of AASHTO M270, Gr. 36.
- All pipes, pipe fittings and brackets needed shall be included with cost of Drainage System.
- Connect prop. 8" Dia. drainage pipe to existing underground drainage system. Piers 4 thru Piers 18 only.
- Reducer should be sized to accommodate a longitudinal movement of the superstructure between the abutment or pier and the scupper.
- The PVC pipe and fittings located outside of the fascia beam shall be colored to match the beam, the remainder shall be grey.
- For Splash Block details see Sheet SB-102. Cost of Splash Block included with the cost for Drainage System for Structures.
- Removal of existing drainage system items and connection of proposed drainage element to existing drainage elements included with the cost for Drainage System for Structures.

MODEL: Default
FILE NAME: pw:\civiltech-pw-bentley.com\civiltech-pw\Documents\Projects\3393\CADD\CADD Sheets\Structures\Structure SN 016-2467\0162467-62H49-100-Drainage System Details 1_rev 1.dgn
12/22/2021 2:13:45 PM



USER NAME = JAL	DESIGNED - E. VAYSMAN	REVISED - 12/21/2021 J.A.L.
PLOT SCALE = N/A	CHECKED - G. HATLESTAD	REVISED -
PLOT DATE = 12/22/2021	DRAWN - E. VAYSMAN	REVISED -
	DATE - 10/21/2021	REVISED -

STATE OF ILLINOIS
DEPARTMENT OF TRANSPORTATION

DRAINAGE SYSTEM DETAILS 1
STRUCTURE NO. 016-2467

SHEET SB-100 OF SB-104 SHEETS

F.A.I. RTE. 330	SECTION 2018-133-BR	COUNTY COOK	TOTAL SHEETS 308	SHEET NO. 287
ILLINOIS			CONTRACT NO. 62H49	