

STATE OF ILLINOIS
DEPARTMENT OF TRANSPORTATION

FAI RTE.	SECTION	COUNTY	TOTAL SHEETS	SHEET NO.
74-39		MCLEAN	50	1
ILLINOIS		CONTRACT NO. 70E74		

D5 BRIDGE PAINTING 2022-1

D-95-023-20

FOR INDEX OF SHEETS, SEE SHEET NO. 2
FOR SUMMARY OF QUANTITIES, SEE SHEET NO. 4 - 7

PROPOSED
HIGHWAY PLANS

ROUTES FAI-74 & FAI-39 /(I-74 & I-39)
SECTION D5 BRIDGE PAINTING 2022-1
PROJECT NHPP - ZWCU(271)
BRIDGE PAINTING
MCLEAN COUNTY


C-95-082-20

CURRENT TRAFFIC DATA

LOC. #1	LOC. #2	LOC. #3	LOC. #4	LOC. #5
23,900	23,900	23,900	23,900	23,900
(2019) I-74	(2019) I-74	(2019) I-74	(2019) I-74	(2019) I-74
LOC. #6	LOC. #7	LOC. #8	LOC. #9	LOC. #10
24,200	1,750	1,750	11,950	11,950
(2019) I-74	(2020) Co Hwy 12	(2020) Co Hwy 12	(2019) I-74 (WB)	(2019) I-74 (EB)

TRAFFIC DATA LOCATIONS

- LOC. #1: S.N. 057-0113 - T.R. 76 OVER FAI 74 @ M.P. 118.9
LOC. #2: S.N. 057-0102 - CARLOCK ROAD OVER FAI 74 @ M.P. 120.0
LOC. #3: S.N. 057-0112 - T.R. 90 OVER FAI 74 @ M.P. 120.5
LOC. #4: S.N. 057-0114 - T.R. 104 OVER FAI 74 @ M.P. 121.6
LOC. #5: S.N. 057-0115 - T.R. 201 OVER FAI 74 @ M.P. 123.8
LOC. #6: S.N. 057-0105 - FAS 1473 OVER FAI 74 @ M.P. 126.3
LOC. #7: S.N. 057-0205 - FAI 39 (SB) OVER FAS 472 / CH 12 @ M.P. 4.7
LOC. #8: S.N. 057-0206 - FAI 39 (NB) OVER FAS 472 / CH 12 @ M.P. 4.7
LOC. #9: S.N. 057-0045 - FAI 74 (WB) OVER N.S.R.R. @ M.P. 124.6
LOC. #10: S.N. 057-0046 - FAI 74 (EB) OVER N.S.R.R. @ M.P. 124.6

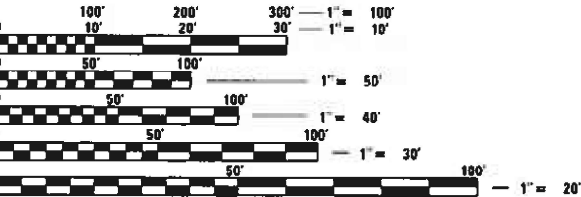

FULL SIZE PLANS HAVE BEEN PREPARED USING STANDARD
ENGINEERING SCALES. REDUCED SIZED PLANS WILL NOT
CONFORM TO STANDARD SCALES. IN MAKING MEASUREMENTS
ON REDUCED PLANS, THE ABOVE SCALES MAY BE USED.

J.U.L.I.E.
JOINT UTILITY LOCATION INFORMATION FOR EXCAVATORS
1-800-892-0123
OR 811

PROJECT ENGINEER: JASON STULTS
SQUAD LEADER: JASON LEE
DESIGNER: MARK HARDEN
PHONE NUMBER: (217)465-4181

CONTRACT NO. 70E74



LOCATION OF SECTION INDICATED THUS: - [hatched pattern] -

STATE OF ILLINOIS
DEPARTMENT OF TRANSPORTATION

SUBMITTED 10/6/21
Kensilla. Barnett sun
REGIONAL ENGINEER
December 10, 2021
Stephen M. Lewis
DIRECTOR OF HIGHWAYS PROJECT IMPLEMENTATION

PRINTED BY THE AUTHORITY
OF THE STATE OF ILLINOIS

INDEX OF SHEETS

<u>SHEET NO.</u>	<u>DESCRIPTION</u>
1	COVER SHEET
2	INDEX OF SHEETS, HIGHWAY STANDARDS, & GENERAL NOTES
3	STRUCTURE LOCATION MAP
4-7	SUMMARY OF QUANTITIES
8	TRAFFIC CONTROL SUMMARY
9-13	DESCRIPTIONS OF WORK FOR LOCATIONS 1-10
14-16	LOCATION #1 STRUCTURE DETAILS
17-19	LOCATION #2 STRUCTURE DETAILS
20-22	LOCATION #3 STRUCTURE DETAILS
23-25	LOCATION #4 STRUCTURE DETAILS
26-28	LOCATION #5 STRUCTURE DETAILS
29-32	LOCATION #6 STRUCTURE DETAILS
33-36	LOCATION #7 & #8 STRUCTURE DETAILS
37-44	LOCATION #9 & #10 STRUCTURE DETAILS
45	DETAIL FOR TEMPORARY RUMBLE STRIPS (SPECIAL)
46-50	WIDTH RESTRICTION SIGNING DETAIL

HIGHWAY STANDARDS

<u>STANDARD NO.</u>	<u>DESCRIPTION</u>
000001-08	STANDARD SYMBOLS, ABBREVIATIONS AND PATTERNS
701001-02	OFF-ROAD OPERATIONS, 2L, 2W, MORE THAN 15' (4.5 m) AWAY
701006-05	OFF-ROAD OPERATIONS, 2L, 2W, 15' (4.5 m) TO 24" (600 mm) FROM PAVEMENT EDGE
701101-05	OFF-ROAD OPERATIONS, MULTILANE, 15' (4.5 m) TO 24" (600 mm) FROM PAVEMENT EDGE
701106-02	OFF-ROAD OPERATIONS, MULTILANE, MORE THAN 15' (4.5 m) AWAY
701201-05	LANE CLOSURE, 2L, 2W, DAY ONLY, FOR SPEEDS $\geq$ 45 MPH
701400-11	APPROACH TO LANE CLOSURE, FREEWAY / EXPRESSWAY
701402-12	LANE CLOSURE, FREEWAY/EXPRESSWAY, WITH BARRIER
701411-09	LANE CLOSURE, MULTILANE, AT ENTRANCE OR EXIT RAMP, FOR SPEEDS $\geq$ 45 MPH
701428-01	TRAFFIC CONTROL SETUP AND REMOVAL FREEWAY / EXPRESSWAY
701901-08	TRAFFIC CONTROL DEVICES
704001-08	TEMPORARY CONCRETE BARRIER
782006-01	GUARDRAIL AND BARRIER WALL REFLECTOR MOUNTING DETAILS

GENERAL NOTES

G.N.-100A
ELECTRONIC FILES AND/OR ELECTRONIC SURVEY INFORMATION
INCLUDING CADD FILES WILL NOT BE AVAILABLE TO THE CONTRACTOR.

G.N.-107.12
THE NAME, ADDRESS AND TELEPHONE NUMBER OF THE LOCAL RAILROAD
CONTACT IS:

Mr. Brian Taylor
Engineer Public Improvements
Norfolk Southern Corporation
650 West Peachtree Street, NW., Box 45
Atlanta, GA 30309
(678) 333-4274
george.taylor3@nscorp.com

ALL EMAIL CORRESPONDENCE WITH NS SHOULD USE THE SUBJECT LINE:
 "SUBJECT" - BLOOMINGTON, IL - NS FILE BR0020925 - I-74 OHB
 PAINTING - MIDWEST DIV. MP SP-381.46
 ALSO CARBON COPY THE FOLLOWING INDIVIDUALS:
 Ronald.Finley@jacobs.com, Ronald.Finley@nscorp.com and
 kauri.benner@jacobs.com.

SPECIAL ATTENTION IS CALLED TO ARTICLE 107.12 REGARDING RAILROAD
FLAGGERS. THE NAME, ADDRESS AND TELEPHONE NUMBER OF THE
RAILROAD CONTACT PERSON FOR FLAGGERS IS: (SEE NOTE BELOW)

FLAGGING WILL BE ASSIGNED BY NORFOLK SOUTHERN ONCE THEIR RIGHT OF ENTRY AND INSURANCE REQUIREMENTS HAVE BEEN MET.

SOME RAILROADS REQUIRE CONTRACTORS TO OBTAIN A RIGHT OF ENTRY PERMIT BEFORE ENTERING UPON RAILROAD RIGHT OF WAY. IT IS THE RESPONSIBILITY OF THE CONTRACTOR TO OBTAIN A RAILROAD RIGHT OF ENTRY PERMIT FROM THE RAILROAD IF REQUIRED BY THE RAILROAD.

G.N.-107.12A (SPECIAL)
ALL WORK TO BE PREFORMED ON, OVER, UNDER, OR ADJACENT TO THE RAILROAD RIGHT OF WAY SHALL COMPLY WITH THE NORFOLK SOUTHERN RAILWAY COMPANY ("RAILROAD", "NSR" OR "NS") PUBLIC PROJECTS MANUAL (APPENDIX E, SPECIAL PROVISIONS FOR THE PROTECTION OF RAILWAY INTERESTS, AND APPENDIX H1, OVERHEAD GRADE SEPARATION DESIGN CRITERIA). WHEN IN CONFLICT WITH OTHER SPECIFICATIONS, THE MOST STRINGENT ONE SHALL APPLY.

ADDITIONALLY, THE MINIMUM TEMPORARY CLEARANCES OF 22'-0" VERTICALLY ABOVE TOP OF HIGHEST RAIL AND 13'-0" HORIZONTALLY FROM CENTERLINE OF ABOVE TRACK (OR 14'-0" HORIZONTALLY FROM CENTERLINE OF CURVED TRACK) SHALL BE MAINTAINED AT ALL TIMES. MINIMUM CLEARANCES FOR CONTAINMENT SYSTEM, OPERATIONS AND REMOVAL SHALL NOT BE LESS THAN 22'-0" ABOVE TOP OF RAIL OF NORFOLK SOUTHERN TRACKS AND 13'-0" FROM CENTERLINE OF TRACK MEASURED AT A RIGHT ANGLE.

ALL PROPOSED TEMPORARY CLEARANCES WHICH ARE LESS THAN THOSE LISTED ABOVE MUST BE SUBMITTED TO RAILROAD ENGINEER FOR APPROVAL PRIOR TO CONSTRUCTION AND MUST ALSO BE AUTHORIZED BY THE REGULATORY BODY OF THE STATE IF LESS THAN THE LEGALLY PRESCRIBED CLEARANCES AS STATED IN ARTICLE 107.12 OF THE STANDARD SPECIFICATIONS.

G.N.-107.12B (SPECIAL)
IT HAS BEEN ADVISED BY THE RAILROAD THAT TRACK AND GROUND PROTECTION SHALL BE PROVIDED TO PROTECT THE BALLAST FROM CONTAMINATION AND THAT IT WOULD BE THE RESPONSIBILITY OF THE CONTRACTOR FOR ANY RESTORATION IF DEEMED NECESSARY BY THE RAILROAD. ALSO, THE CONTRACTOR SHALL PROVIDED THEIR INTENT FOR PROTECTION TO THE RAILROAD AND MAY DISCUSS ANY QUESTIONS AT THE CONTACT INFORMATION SHOWN.

G.N.-107.12C (SPECIAL)
FOR PROJECTS REQUIRING MORE THAN 30 CONSECUTIVE DAYS OF FLAGGING, THE CONTRACTOR SHALL PROVIDE THE FLAGMAN A SMALL WORK AREA WITH A DESK/ COUNTER AND CHAIR WITHIN THE FIELD/SITE TRAILER, INCLUDING THE USE OF BATHROOM FACILITIES, WHERE THE FLAGMAN CAN CHECK IN/OUT WITH THE PROJECT, AS WELL AS TO THE FLAGMAN'S HOME TERMINAL. THE WORK AREA SHOULD PROVIDE ACCESS TO TWO (2) ELECTRICAL OUTLETS FOR RECHARGING RADIO(S). AND A LAPTOP COMPUTER; AND HAVE THE ABILITY TO PRINT OFF NEEDED DOCUMENTATION AND ORDERS AS NEEDED AT THE FIELD/SITE TRAILER. THIS SHOULD AID IN MAXIMIZING THE FLAGMAN'S TIME AND EFFICIENCY ON THE PROJECT.

THE COST OF CONFORMING TO THE ADDITIONAL RAILROAD REQUIREMENTS AS STATED IN G.N.-107.12A (SPECIAL), G.N.-107.12B (SPECIAL) AND G.N.-107.12C (SPECIAL) SHALL BE CONSIDERED AS INCLUDED IN THE CONTRACT UNIT PRICES BID FOR THE VARIOUS ITEMS OF WORK INVOLVED, AND NO ADDITIONAL COMPENSATIOIN WILL BE ALLOWED.

G.N.-501A
THE EXISTING STRUCTURAL STEEL COATING CONTAINS LEAD. THE CONTRACTOR SHALL FOLLOW THE GUIDE BRIDGE SPECIAL PROVISIONS FOR "CONTAINMENT AND DISPOSAL OF LEAD PAINT CLEANING RESIDUES" TO DEAL WITH THE PRESENCE OF LEAD ON THIS PROJECT.

G.N.-506 (SPL.)
ALL FINAL SURFACES OF THE BEAMS SHALL BE PAINTED GRAY (MUNSELL COLOR STANDARD - 5B 7/1) EXCEPT THE EXTERIOR SURFACES OF THE EXTERIOR BEAMS WHICH SHALL BE PAINTED WITH EITHER INTERSTATE GREEN (MUNSELL COLOR STANDARD 7.5G 4/8) OR REDDISH BROWN (MUNSELL COLOR STANDARD 2.5YR 3/4) AS SPECIFIED UNDER THE DESCRIPTION FOR EACH STRUCTURE.

ONLY STRUCTURAL STEEL AND OTHER DESIGNATED SURFACES SHALL BE PAINTED. ALL OTHER SURFACES SHALL BE PROTECTED FROM CONTRACTORS BLASTING AND PAINTING OPERATIONS. ANY AREAS DAMAGED BY BLASTING OR OVERSPRAY WILL BE REMOVED OR REPAIRED AT THE CONTRACTOR'S EXPENSE AND NO ADDITIONAL COMPENSATION WILL BE ALLOWED.

CARE SHALL BE TAKEN NOT TO DAMAGE RUBBER BEARING OR JOINT COMPONENTS DURING BLASTING AND CLEANING OPERATIONS. ANY DAMAGE TO THESE COMPONENTS SHALL BE REPAIRED AT CONTRACTORS EXPENSE.

THE SSPC-QP1 AND QP2 PAINTING CONTRACTOR CERTIFICATIONS WILL BE REQUIRED FOR THIS CONTRACT.


ALL TRASH AND PAINTING DEBRIS, EXCLUDING WASTE BARRELS OR ROLL-OFF DUMPSTERS, SHALL BE REMOVED BEFORE BEGINNING WORK AT ANOTHER LOCATION.

2 YEAR PAINT WARRANTY REQUIRED FOR ALL STRUCTURES


COMMITMENTS
THERE ARE NO COMMITMENTS ON THIS PROJECT.

	USER NAME = eaglinga	DESIGNED -	REVISED -	STATE OF ILLINOIS DEPARTMENT OF TRANSPORTATION	INDEX OF SHEETS, HIGHWAY STANDARDS & GENERAL NOTES	F.A.I. RTE.	SECTION	COUNTY	TOTAL SHEETS	SHEET NO.	
		DRAWN -	REVISED -			74/39	*	MCLEAN	50	2	
	PLOT SCALE = 40,0000 ' / in.	CHECKED -	REVISED -			D5 BRIDGE PAINTING 2022-1					
	PLOT DATE = 10/18/2021	DATE -	REVISED -			SCALE: NONE	SHEET 1	OF 1	SHEETS	STA.	TO STA.
				ILLINOIS FED. AID PROJECT							

STRUCTURE LOCATION MAP

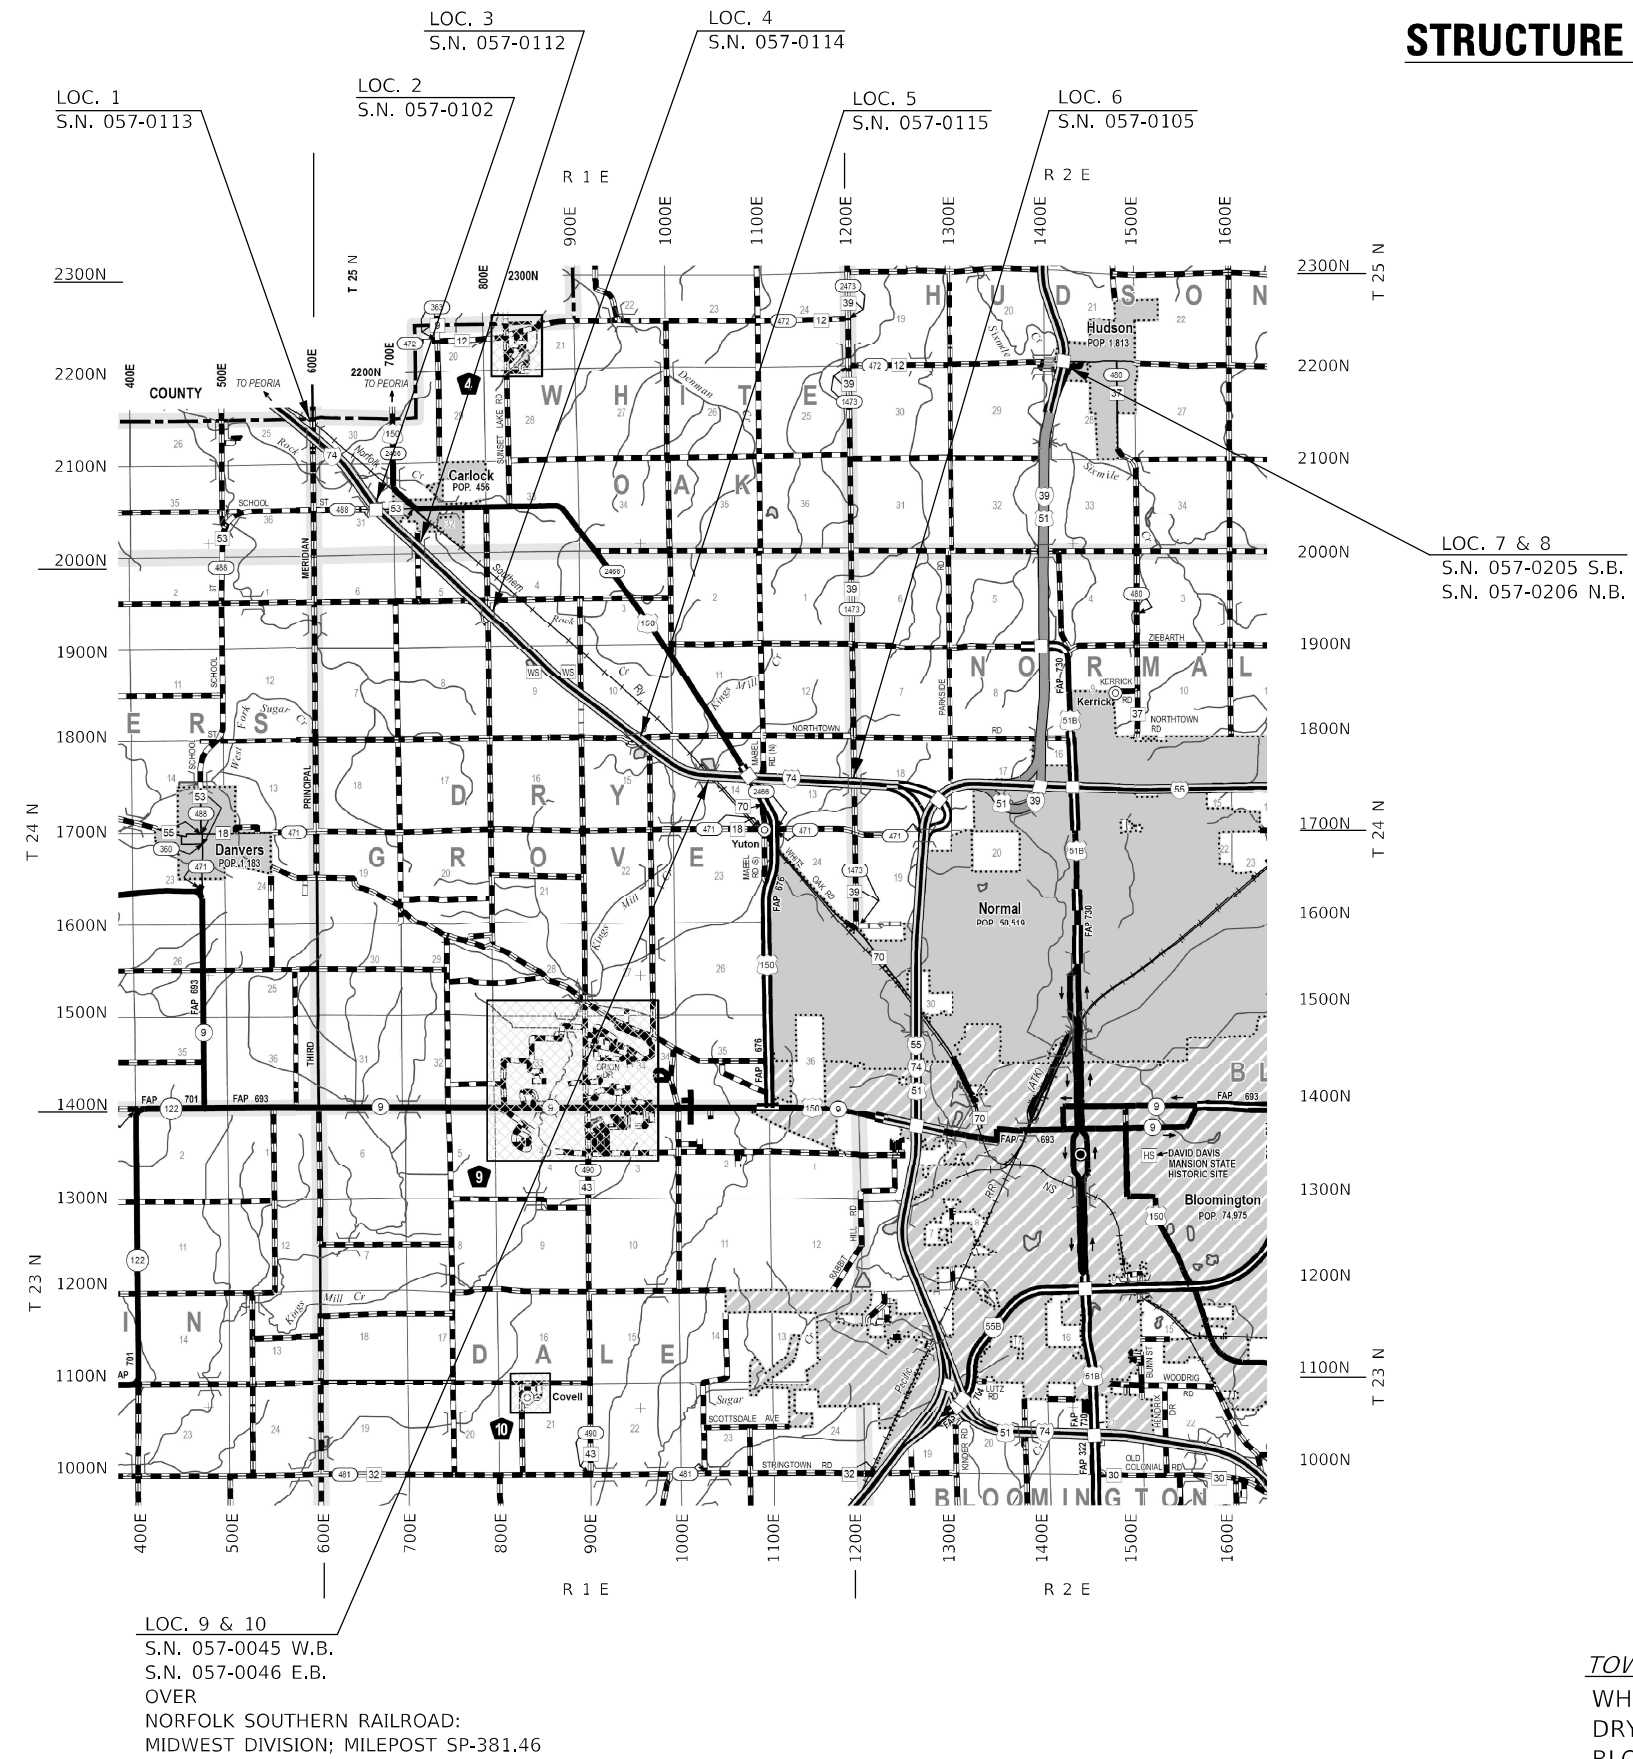

TOWNSHIPS
WHITE OAK
DRY GROVE
BLOOMINGTON

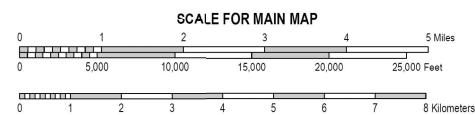

USER NAME = eaglinga	DESIGNED -	REVISED -
	DRAWN -	REVISED -
PLOT SCALE = 40,0000 * / in.	CHECKED -	REVISED -
PLOT DATE = 9/29/2021	DATE -	REVISED -

STATE OF ILLINOIS
DEPARTMENT OF TRANSPORTATION

STRUCTURE LOCATION MAP – MCLEAN COUNTY

SCALE:	SHEET 1 OF 1 SHEETS	STA.	TO STA.
--------	---------------------	------	---------

F.A.I. RTE.	SECTION	COUNTY	TOTAL SHEETS	SHEET NO.
74/39	*	MCLEAN	50	3
*D5 BRIDGE PAINTING 2022-1		CONTRACT NO. 70E74		
ILLINOIS		FED. AID PROJECT		

```
MODEL: $MODEL NAMES
FILE NAME: pwr\ltd-cw-bentley.com\PWIDocuments\IDOT_Offices\District_5\Projects\D570E74\CADData\CAD Sheets\D570E74-s\F-Loc_Map.dgn
```

SUMMARY OF QUANTITIES

[illegible][illegible]

	USER NAME = eaglinga	DESIGNED -	REVISED -	STATE OF ILLINOIS DEPARTMENT OF TRANSPORTATION	SUMMARY OF QUANTITIES			F.A.I. RTE.	SECTION	COUNTY	TOTAL SHEETS	SHEET NO.
		DRAWN -	REVISED -					74/39	*	MCLEAN	50	4
	PLOT SCALE = 40,0000' / in.	CHECKED -	REVISED -		74/39			CONTRACT NO. 70E74				
	PLOT DATE = 9/29/2021	DATE -	REVISED -		SCALE: NONE	SHEET 1 OF 4 SHEETS	STA. TO STA.	ILLINOIS FED. AID PROJECT				

SUMMARY OF QUANTITIES

LOCATION OF WORK:	LOC. #1	LOC. #2	LOC. #3	LOC. #4	LOC. #5	LOC. #6	LOC. #7	LOC. #8	LOC. #9	LOC. #10
	FAI 74	FAI 74	FAI 74	FAI 74	FAI 74	FAI 74	FAI 39 SR	FAI 39 NB	FAI 74 WB	FAI 74 EB
	S.N.057-0113	S.N. 057-0102	S.N. 057-0112	S.N. 057-0114	S.N. 057-0115	S.N. 057-0105	S.N. 057-0205	S.N. 057-0206	S.N. 057-0045	S.N. 057-0046
COUNTY:	MCLEAN	MCLEAN	MCLEAN	MCLEAN	MCLEAN	MCLEAN	MCLEAN	MCLEAN	MCLEAN	MCLEAN
	RURAL	RURAL	RURAL	RURAL	RURAL	URBAN	RURAL	RURAL	RURAL	RURAL
FUNDING BREAKOUT:	90% FEDERAL	90% FEDERAL	90% FEDERAL	90% FEDERAL	90% FEDERAL	90% FEDERAL	90% FEDERAL	90% FEDERAL	90% FEDERAL	90% FEDERAL
	10% STATE	10% STATE	10% STATE	10% STATE	10% STATE	10% STATE	10% STATE	10% STATE	10% STATE	10% STATE
CONSTRUCTION TYPE CODE:	0047	0047	0047	0047	0047	0047	0047	0047	0047	0047

	CODE NO.	ITEM	UNIT	TOTAL QUANTITY	QUANTITY	QUANTITY	QUANTITY	QUANTITY	QUANTITY	QUANTITY	QUANTITY	QUANTITY	QUANTITY
	X5060607	CONTAINMENT AND DISPOSAL OF NON-LEAD PAINT CLEANING RESIDUES NO. 7	L SUM	1.0						1.0			
	X5060608	CONTAINMENT AND DISPOSAL OF NON-LEAD PAINT CLEANING RESIDUES NO. 8	L SUM	1.0							1.0		
	X5067501	BRIDGE CLEANING AND PAINTING WARRANTY NUMBER 1	L SUM	1.0	1.0								
	X5067502	BRIDGE CLEANING AND PAINTING WARRANTY NUMBER 2	L SUM	1.0		1.0							
	X5067503	BRIDGE CLEANING AND PAINTING WARRANTY NUMBER 3	L SUM	1.0			1.0						
	X5067504	BRIDGE CLEANING AND PAINTING WARRANTY NUMBER 4	L SUM	1.0				1.0					
	X5067505	BRIDGE CLEANING AND PAINTING WARRANTY NUMBER 5	L SUM	1.0					1.0				
	X5067506	BRIDGE CLEANING AND PAINTING WARRANTY NUMBER 6	L SUM	1.0						1.0			
	X5067507	BRIDGE CLEANING AND PAINTING WARRANTY NUMBER 7	L SUM	1.0							1.0		
	X5067508	BRIDGE CLEANING AND PAINTING WARRANTY NUMBER 8	L SUM	1.0								1.0	
* DENOTES SPECIALTY ITEM													

MODEL: \\MODEL NAMES
FILE NAME: \\paul@cdawebdev.com\\PI\\DOT Documents\\DOT Office\\District 5\\Projects\\D570E74\\CADD\\sheet570E74-01-SQO.dgn

SUMMARY OF QUANTITIES

[illegible][illegible]

SUMMARY OF QUANTITIES

LOCATION OF WORK:	LOC. #1	LOC. #2	LOC. #3	LOC. #4	LOC. #5	LOC. #6	LOC. #7	LOC. #8	LOC. #9	LOC. #10
	FAI 74	FAI 74	FAI 74	FAI 74	FAI 74	FAI 74	FAI 39 SR	FAI 39 NB	FAI 74 WB	FAI 74 EB
	S.N. 057-0113	S.N. 057-0102	S.N. 057-0112	S.N. 057-0114	S.N. 057-0115	S.N. 057-0105	S.N. 057-0205	S.N. 057-0206	S.N. 057-0045	S.N. 057-0046
COUNTY:	MCLEAN	MCLEAN	MCLEAN	MCLEAN	MCLEAN	MCLEAN	MCLEAN	MCLEAN	MCLEAN	MCLEAN
	RURAL	RURAL	RURAL	RURAL	RURAL	URBAN	RURAL	RURAL	RURAL	RURAL
FUNDING BREAKOUT:	90% FEDERAL	90% FEDERAL	90% FEDERAL	90% FEDERAL	90% FEDERAL	90% FEDERAL	90% FEDERAL	90% FEDERAL	90% FEDERAL	90% FEDERAL
	10% STATE	10% STATE	10% STATE	10% STATE	10% STATE	10% STATE	10% STATE	10% STATE	10% STATE	10% STATE
CONSTRUCTION TYPE CODE:	0047	0047	0047	0047	0047	0047	0047	0047	0047	0047

	CODE NO.	ITEM	UNIT	TOTAL QUANTITY	QUANTITY	QUANTITY	QUANTITY	QUANTITY	QUANTITY	QUANTITY	QUANTITY	QUANTITY	QUANTITY
	Z0010501	CLEANING AND PAINTING STEEL BRIDGE NO. 1	L SUM	1.0	1.0								
	Z0010502	CLEANING AND PAINTING STEEL BRIDGE NO. 2	L SUM	1.0		1.0							
	Z0010503	CLEANING AND PAINTING STEEL BRIDGE NO. 3	L SUM	1.0			1.0						
	Z0010504	CLEANING AND PAINTING STEEL BRIDGE NO. 4	L SUM	1.0				1.0					
	Z0010505	CLEANING AND PAINTING STEEL BRIDGE NO. 5	L SUM	1.0					1.0				
	Z0010506	CLEANING AND PAINTING STEEL BRIDGE NO. 6	L SUM	1.0						1.0			
	Z0010507	CLEANING AND PAINTING STEEL BRIDGE NO. 7	L SUM	1.0							1.0		
	Z0010508	CLEANING AND PAINTING STEEL BRIDGE NO. 8	L SUM	1.0								1.0	
	Z0010509	CLEANING AND PAINTING STEEL BRIDGE NO. 9	L SUM	1.0									1.0
	Z0010510	CLEANING AND PAINTING STEEL BRIDGE NO. 10	L SUM	1.0									1.0
	Z0048665	RAILROAD PROTECTIVE LIABILITY INSURANCE	L SUM	1.0								0.5	0.5
* DENOTES SPECIALTY ITEM													

MODEL: \\MODEL NAMES
FILE: \\models\public\caw\hondley.com\FW\DOT Documents\DOT Office\Director\Projects\0570E74\CAD\data\CAD\sheet\0570E74-sh-500.dgn

TRAFFIC CONTROL SUMMARY

				70100450 TC&P Std. 701201 L Sum	70100207 TC&P Std. 701402 Each	no pay item TC&P Std. 701400 not measured for payment included with 701402	70100420 TC&P Std. 701411 Each	70400100 Temp Conc Barrier Foot	70400200 Relocate Temp Conc Barrier Foot	70600250 Impact Atten Test Level 3 Each	70600350 Relocate Imp Att, TL 3 Each	70107025 Changeable Message Sign Cal Day	X2700001 Temp Rumble Strip Each	
Location	Structure	Direction	Stage											
# 1	057-0113	EB	I	-	1.0	on I-74 EB	-	325	-	1.0	-	7 day advance notice	8.0	
		EB	II	-	1.0		-	-	325	-	1.0			
	057-0113	WB	I	-	1.0	on I-74 WB	-	325	-	1.0	-	7 day advance notice	4.0	
		WB	II	-	1.0		-	-	325	-	1.0			
# 2	057-0102	EB	I	-	1.0	on I-74 EB	1.0	325	-	1.0	-	0 - covered by 057-0113	4.0	
		EB	II	-	1.0		-	-	325	-	1.0			
	057-0102	WB	I	-	1.0	on I-74 WB	1.0	325	-	1.0	-	0 - covered by 057-0113	4.0	
		WB	II	-	1.0		-	-	325	-	1.0			
# 3	057-0112	EB	I	-	1.0	on I-74 EB	1.0	325	-	1.0	-	0 - covered by 057-0113	4.0	
		EB	II	-	1.0		-	-	325	-	1.0			
	057-0112	WB	I	-	1.0	on I-74 WB	-	325	-	1.0	-	0 - covered by 057-0113	4.0	
		WB	II	-	1.0		-	-	325	-	1.0			
# 4	057-0114	EB	I	-	1.0	on I-74 EB	-	325	-	1.0	-	0 - covered by 057-0113	4.0	
		EB	II	-	1.0		-	-	325	-	1.0			
	057-0114	WB	I	-	1.0	on I-74 WB	-	325	-	1.0	-	0 - covered by 057-0113	4.0	
		WB	II	-	1.0		-	-	325	-	1.0			
# 5	057-0115	EB	I	-	1.0	on I-74 EB	-	325	-	1.0	-	0 - covered by 057-0105	4.0	
		EB	II	-	1.0		-	-	325	-	1.0			
	057-0115	WB	I	-	1.0	on I-74 WB	-	325	-	1.0	-	0 - covered by 057-0105	4.0	
		WB	II	-	1.0		-	-	325	-	1.0			
# 6	057-0105	EB	I	-	1.0	on I-74 EB	-	325	-	1.0	-	7 day advance notice	4.0	
		EB	II	-	1.0		-	-	325	-	1.0			
	057-0105	WB	I	-	1.0	will need 3 sets of 3 mile RCA & CMS on I-55 NB & I-55 SB & I-39 SB	-	325	-	1.0	-	7 day advance notice on I-55 NB before merger & 7 day advance notice on I-55 SB before merger 7 day advance notice on I-39 SB before merger	4.0	
		WB	II	-	1.0		-	-	325	-	1.0			
# 7	057-0205	SB	-	0.50	-	-	-	-	-	-	-	7 day advance notice	-	
# 8	057-0206	NB	-	0.50	-	-	-	-	-	-	-	7 day advance notice	-	
# 9	057-0045	WB	-	-	1.0	will need 3 sets of 3 mile RCA & CMS on I-55 NB & I-55 SB & I-39 SB	No 701411 - closure of passing lane anticipated	500	-	1.0	-	0 - covered by 057-0105	4.0	
								-	-	-	-			
# 10	057-0046	EB	-	-	1.0	on I-74 EB		500	-	1.0	-	0 - covered by 057-0105	4.0	
								-	-	-	-			
			TOTALS		1.0	26.0		3.0	4900	3900	14.0	12.0	56.0	60.0

"3 mile RCA & CMS" - refers to the first 2 devices on Traffic Contol & Protection Standard 701400 - Road Construction Ahead / Changeable Message Sign

MODEL: \\MODEL NAMES
FILE: \\models\pww\dot\documents\DOT Offices\District 5\Projects\0570E74\CAD\data\CAD\sheet\0570E74-sh1-TCS.dgn

USER NAME = eaglinga	DESIGNED -	REVISED -
	DRAWN -	REVISED -
PLOT SCALE = 40,0000 * / in.	CHECKED -	REVISED -
PLOT DATE = 9/29/2021	DATE -	REVISED -

STATE OF ILLINOIS
DEPARTMENT OF TRANSPORTATION

TRAFFIC CONTROL SUMMARY			
SCALE: NONE	SHEET 1	OF 1 SHEETS	STA. TO STA.

F.A.I. RTE. 74/39	SECTION *	COUNTY MCLEAN	TOTAL SHEETS 50	SHEET NO. 8
*D5 BRIDGE PAINTING 2022-1		CONTRACT NO. 70E74		
ILLINOIS		FED. AID PROJECT		

MODEL: s:\MODEL NAMES
FILE NAME: s:\models\new\beadby.com\PIV\DOT Documents\DOT Office\District 5\Projects\0570E74\Caddata\Caddsheet\0570E74-Left-Description_Work.dgn

LOCATION #1

DESCRIPTION: T.R. 76 over I-74 @ m.p.118.9 WEST OF CARLOCK
COUNTY: MCLEAN
ROUTE: F.A.I. 74
MARKED ROUTE: I-74
SECTION: 57-17HB-2
STRUCTURE NO.: 057-0113
TYPE OF STRUCTURE: 4 SPAN CONTINUOUS STEEL
5 BEAM LINES - BK-BK ABUTS = 286.75'

CLEANING AND PAINTING OF THE EXISTING STRUCTURAL STEEL SHALL BE AS SPECIFIED IN THE SPECIAL PROVISIONS FOR "CLEANING AND PAINTING EXISTING STEEL STRUCTURES." ALL BEAMS, BEARINGS AND OTHER STRUCTURAL STEEL SHALL BE CLEANED PER NEAR WHITE BLASTNG SSPC-SP10.

THE DESIGNATED AREAS CLEANED PER NEAR WHITE BLAST CLEANING SSPC-SP10 SHALL BE PAINTED ACCORDING TO THE REQUIREMENTS OF PAINT SYSTEM 1 OZ/E/U THE COLOR OF THE FINAL FINISH COAT FOR ALL STEEL SURFACES SHALL BE GREY, MUNSELL NO. 5B 7/1.

A MINIMUM OF TWO (2) HIGH VOLUME AIR MONITORS WILL BE REQUIRED TO MONITOR AIR QUALITY DURING DUST PRODUCING OPERATIONS AT THIS SITE. SEE SPECIAL PROVISIONS FOR "CONTAINMENT AND DISPOSAL OF LEAD PAINT CLEANING RESIDUES".

THE EXISTING STRUCTURAL STEEL COATING CONTAINS LEAD. THE CONTRACTOR SHALL FOLLOW THE GUIDE BRIDGE SPECIAL PROVISIONS FOR "CONTAINMENT AND DISPOSAL OF LEAD PAINT CLEANING RESIDUES" TO DEAL WITH THE PRESENCE OF LEAD ON THIS PROJECT.

NOTE: DECK DRAINS WITHIN THE PAINTING LIMITS DESCRIBED ABOVE ARE TO BE PAINTED AT NO ADDITIONAL COST.

TWO (2) YEAR PAINT WARRANTY REQUIRED FOR THIS STRUCTURE

LOCATION #2

DESCRIPTION: CH 19 (CARLOCK RD.) over I-74 @ m.p.120.0
COUNTY: MCLEAN
ROUTE: F.A.I. 74
MARKED ROUTE: I-74
SECTION: 57-17HB-3
STRUCTURE NO.: 057-0102
TYPE OF STRUCTURE: 4 SPAN CONTINUOUS STEEL
6 BEAM LINES - BK-BK ABUTS = 295.29'

CLEANING AND PAINTING OF THE EXISTING STRUCTURAL STEEL SHALL BE AS SPECIFIED IN THE SPECIAL PROVISIONS FOR "CLEANING AND PAINTING EXISTING STEEL STRUCTURES." ALL BEAMS, BEARINGS AND OTHER STRUCTURAL STEEL SHALL BE CLEANED PER NEAR WHITE BLASTNG SSPC-SP10.

THE DESIGNATED AREAS CLEANED PER NEAR WHITE BLAST CLEANING SSPC-SP10 SHALL BE PAINTED ACCORDING TO THE REQUIREMENTS OF PAINT SYSTEM 1 OZ/E/U. THE COLOR OF THE FINAL FINISH COAT FOR ALL STEEL SURFACES SHALL BE GREY, MUNSELL NO. 5B 7/1.

A MINIMUM OF TWO (2) HIGH VOLUME AIR MONITORS WILL BE REQUIRED TO MONITOR AIR QUALITY DURING DUST PRODUCING OPERATIONS AT THIS SITE. SEE SPECIAL PROVISIONS FOR "CONTAINMENT AND DISPOSAL OF LEAD PAINT CLEANING RESIDUES".

THE EXISTING STRUCTURAL STEEL COATING CONTAINS LEAD. THE CONTRACTOR SHALL FOLLOW THE GUIDE BRIDGE SPECIAL PROVISIONS FOR "CONTAINMENT AND DISPOSAL OF LEAD PAINT CLEANING RESIDUES" TO DEAL WITH THE PRESENCE OF LEAD ON THIS PROJECT.

NOTE: DECK DRAINS WITHIN THE PAINTING LIMITS DESCRIBED ABOVE ARE TO BE PAINTED AT NO ADDITIONAL COST.

NOTE: ELASTOMERIC BEARINGS AT ABUTMENTS

TWO (2) YEAR PAINT WARRANTY REQUIRED FOR THIS STRUCTURE

USER NAME = eagllinga	DESIGNED -	REVISED -
	DRAWN -	REVISED -
PLOT SCALE = 40,0000 * / in.	CHECKED -	REVISED -
PLOT DATE = 9/29/2021	DATE -	REVISED -

STATE OF ILLINOIS
DEPARTMENT OF TRANSPORTATION

DESCRIPTION OF WORK LOCATIONS #1 & #2			
SCALE: NONE	SHEET 1	OF 5 SHEETS	STA. TO STA.

F.A.I. RTE.	SECTION	COUNTY	TOTAL SHEETS	SHEET NO.
74/39	*	MCLEAN	50	9
*D5 BRIDGE PAINTING 2022-1		CONTRACT NO. 70E74		
		ILLINOIS	FED. AID PROJECT	

MODEL: s:\MODEL NAMES
FILE NAME: s:\models\new\hwy.com\PIV\DOT Documents\DOT Office\District 5\Projects\D570E74\Caddata\Caddsheet\D570E74-Left-Description_Work.dgn

LOCATION #3

DESCRIPTION: T.R. 90 over I-74 @ mp 120.5
COUNTY: MCLEAN
ROUTE: F.A.I. 74
MARKED ROUTE: I-74
SECTION: 57-18HB
STRUCTURE NO.: 057-0112
TYPE OF STRUCTURE: 4 SPAN CONTINUOUS STEEL
5 BEAM LINES - BK-BK ABUTS = 304.42'

CLEANING AND PAINTING OF THE EXISTING STRUCTURAL STEEL SHALL BE AS SPECIFIED IN THE SPECIAL PROVISIONS FOR "CLEANING AND PAINTING EXISTING STEEL STRUCTURES." ALL BEAMS, BEARINGS AND OTHER STRUCTURAL STEEL SHALL BE CLEANED PER NEAR WHITE BLASTNG SSPC-SP10.

THE DESIGNATED AREAS CLEANED PER NEAR WHITE BLAST CLEANING SSPC-SP10 SHALL BE PAINTED ACCORDING TO THE REQUIREMENTS OF PAINT SYSTEM 1 OZ/E/U. THE COLOR OF THE FINAL FINISH COAT FOR ALL STEEL SURFACES SHALL BR GREY, MUNSELL NO. 5B 7/1.

A MINIMUM OF ONE (1) HIGH VOLUME AIR MONITOR WILL BE REQUIRED TO MONITOR AIR QUALITY DURING DUST PRODUCING OPERATIONS AT THIS SITE. SEE SPECIAL PROVISIONS FOR "CONTAINMENT AND DISPOSAL OF LEAD PAINT CLEANING RESIDUES".

THE EXISTING STRUCTURAL STEEL COATING CONTAINS LEAD. THE CONTRACTOR SHALL FOLLOW THE GUIDE BRIDGE SPECIAL PROVISIONS FOR "CONTAINMENT AND DISPOSAL OF LEAD PAINT CLEANING RESIDUES" TO DEAL WITH THE PRESENCE OF LEAD ON THIS PROJECT.

NOTE: DECK DRAINS WITHIN THE PAINTING LIMITS DESCRIBED ABOVE ARE TO BE PAINTED AT NO ADDITIONAL COST.

TWO (2) YEAR PAINT WARRANTY REQUIRED FOR THIS STRUCTURE

LOCATION #4

DESCRIPTION: T.R. 104 over I-74 @ mp 121.6
COUNTY: MCLEAN
ROUTE: F.A.I. 74
MARKED ROUTE: I-74
SECTION: 57-18HB-1
STRUCTURE NO.: 057-0114
TYPE OF STRUCTURE: 4 SPAN CONTINUOUS STEEL
5 BEAM LINES - BK-BK ABUTS = 306.0'

CLEANING AND PAINTING OF THE EXISTING STRUCTURAL STEEL SHALL BE AS SPECIFIED IN THE SPECIAL PROVISIONS FOR "CLEANING AND PAINTING EXISTING STEEL STRUCTURES." ALL BEAMS, BEARINGS AND OTHER STRUCTURAL STEEL SHALL BE CLEANED PER NEAR WHITE BLASTNG SSPC-SP10.

THE DESIGNATED AREAS CLEANED PER NEAR WHITE BLAST CLEANING SSPC-SP10 SHALL BE PAINTED ACCORDING TO THE REQUIREMENTS OF PAINT SYSTEM 1 OZ/E/U. THE COLOR OF THE FINAL FINISH COAT FOR ALL STEEL SURFACES SHALL BE GREY, MUNSELL NO. 5B 7/1.

A MINIMUM OF NONE (0) HIGH VOLUME AIR MONITORS WILL BE REQUIRED TO MONITOR AIR QUALITY DURING DUST PRODUCING OPERATIONS AT THIS SITE. SEE SPECIAL PROVISIONS FOR "CONTAINMENT AND DISPOSAL OF LEAD PAINT CLEANING RESIDUES".

THE EXISTING STRUCTURAL STEEL COATING CONTAINS LEAD. THE CONTRACTOR SHALL FOLLOW THE GUIDE BRIDGE SPECIAL PROVISIONS FOR "CONTAINMENT AND DISPOSAL OF LEAD PAINT CLEANING RESIDUES" TO DEAL WITH THE PRESENCE OF LEAD ON THIS PROJECT.

NOTE: DECK DRAINS WITHIN THE PAINTING LIMITS DESCRIBED ABOVE ARE TO BE PAINTED AT NO ADDITIONAL COST.

TWO (2) YEAR PAINT WARRANTY REQUIRED FOR THIS STRUCTURE

USER NAME = eagllnga	DESIGNED -	REVISED -
	DRAWN -	REVISED -
PLOT SCALE = 40,0000 * / in.	CHECKED -	REVISED -
PLOT DATE = 9/29/2021	DATE -	REVISED -

STATE OF ILLINOIS
DEPARTMENT OF TRANSPORTATION

DESCRIPTION OF WORK LOCATION #3 & #4			
SCALE: NONE	SHEET 2	OF 5 SHEETS	STA. TO STA.

F.A.I. RTE.	SECTION	COUNTY	TOTAL SHEETS	SHEET NO.
74/39	*	MCLEAN	50	10
D5 BRIDGE PAINTING 2022-1		CONTRACT NO. 70E74		
		ILLINOIS	FED. AID	PROJECT

MODEL: s:\MODEL NAMES
FILE NAME: s:\models\new\hwy.com\PIV\DOT Documents\DOT Office\District 5\Projects\0570E74\Caddata\Caddsheet\0570E74-sh-Description_Work.dgn

LOCATION #5

DESCRIPTION: T.R. 210 over I-74 @ mp 123.8
COUNTY: MCLEAN
ROUTE: F.A.I. 74
MARKED ROUTE: I-74
SECTION: 57-18HB-2
STRUCTURE NO.: 057-0115
TYPE OF STRUCTURE: 4 SPAN CONTINUOUS STEEL
5 BEAM LINES - BK-BK ABUTS = 275.81'

CLEANING AND PAINTING OF THE EXISTING STRUCTURAL STEEL SHALL BE AS SPECIFIED IN THE SPECIAL PROVISIONS FOR "CLEANING AND PAINTING EXISTING STEEL STRUCTURES." ALL BEAMS, BEARINGS AND OTHER STRUCTURAL STEEL SHALL BE CLEANED PER NEAR WHITE BLASTNG SSPC-SP10.

THE DESIGNATED AREAS CLEANED PER NEAR WHITE BLAST CLEANING SSPC-SP10 SHALL BE PAINTED ACCORDING TO THE REQUIREMENTS OF PAINT SYSTEM 1 OZ/E/U. THE COLOR OF THE FINAL FINISH COAT FOR ALL STEEL SURFACES SHALL BE GREY, MUNSELL NO. 5B 7/1.

A MINIMUM OF TWO (2) HIGH VOLUME AIR MONITORS WILL BE REQUIRED TO MONITOR AIR QUALITY DURING DUST PRODUCING OPERATIONS AT THIS SITE. SEE SPECIAL PROVISIONS FOR "CONTAINMENT AND DISPOSAL OF LEAD PAINT CLEANING RESIDUES".

THE EXISTING STRUCTURAL STEEL COATING CONTAINS LEAD. THE CONTRACTOR SHALL FOLLOW THE GUIDE BRIDGE SPECIAL PROVISIONS FOR "CONTAINMENT AND DISPOSAL OF LEAD PAINT CLEANING RESIDUES" TO DEAL WITH THE PRESENCE OF LEAD ON THIS PROJECT.

NOTE: DECK DRAINS WITHIN THE PAINTING LIMITS DESCRIBED ABOVE ARE TO BE PAINTED AT NO ADDITIONAL COST.

TWO (2) YEAR PAINT WARRANTY REQUIRED FOR THIS STRUCTURE

LOCATION #6

DESCRIPTION: F.A.S. 1473 over I-74 @ mp 126.3
COUNTY: MCLEAN
ROUTE: F.A.I. 74
MARKED ROUTE: I-74
SECTION: 57-19HB
STRUCTURE NO.: 057-0105
TYPE OF STRUCTURE: CONTINUOUS STEEL
5 BEAM LINES - BK-BK ABUTS = 226.43'

CLEANING AND PAINTING OF THE EXISTING STRUCTURAL STEEL SHALL BE AS SPECIFIED IN THE SPECIAL PROVISIONS FOR "CLEANING AND PAINTING EXISTING STEEL STRUCTURES." ALL BEAMS, BEARINGS AND OTHER STRUCTURAL STEEL SHALL BE CLEANED PER NEAR WHITE BLASTNG SSPC-SP10.

THE DESIGNATED AREAS CLEANED PER NEAR WHITE BLAST CLEANING SSPC-SP10 SHALL BE PAINTED ACCORDING TO THE REQUIREMENTS OF PAINT SYSTEM 1 OZ/E/U. THE COLOR OF THE FINAL FINISH COAT FOR ALL STEEL SURFACES SHALL BE GREY, MUNSELL NO. 5B 7/1.

A MINIMUM OF ONE (1) HIGH VOLUME AIR MONITOR WILL BE REQUIRED TO MONITOR AIR QUAITY DURING DUST PRODUCING OPFRATIONS AT THIS SITE. SEE SPECIAL PROVISIONS FOR "CONTAINMENT AND DISPOSAL OF LEAD PAINT CLEANING RESIDUES".

THE EXISTING STRUCTURAL STEEL COATING CONTAINS LEAD. THE CONTRACTOR SHALL FOLLOW THE GUIDE BRIDGE SPECIAL PROVISIONS FOR "CONTAINMENT AND DISPOSAL OF LEAD PAINT CLEANING RESIDUES" TO DEAL WITH THE PRESENCE OF LEAD ON THIS PROJECT.

NOTE: DECK DRAINS WITHIN THE PAINTING LIMITS DESCRIBED ABOVE ARE TO BE PAINTED AT NO ADDITIONAL COST.

TWO (2) YEAR PAINT WARRANTY REQUIRED FOR THIS STRUCTURE

NOTE: EXISTING PROTECTIVE SHIELDING WILL BE REMOVED BY STATE FORCES PRIOR TO PAINTING AND WILL NOT INTERFERE WITH PAINTING OPERATIONS.

USER NAME = eagllnga	DESIGNED -	REVISED -
DRAWN -	REVISED -	
PLOT SCALE = 40,0000 * / in.	CHECKED -	REVISED -
PLOT DATE = 9/29/2021	DATE -	REVISED -

STATE OF ILLINOIS
DEPARTMENT OF TRANSPORTATION

DESCRIPTION OF WORK LOCATIONS #5 & #6			
SCALE: NONE	SHEET 3	OF 5 SHEETS	STA. TO STA.

F.A.I. RTE.	SECTION	COUNTY	TOTAL SHEETS	SHEET NO.
74/39	*	MCLEAN	50	11
'D5 BRIDGE PAINTING 2022-1		CONTRACT NO. 70E74		
		ILLINOIS	FED. AID PROJECT	

MODEL: \$MODELNAMES
FILE NAME: ow:\idot-pw.bentley.com\PW\DOT\Documents\DOT Offices\District 5\Projects\ID570E74\CADDData\CADsheets\ID570E74-sht-Description Work.dgn

CLEANING AND PAINTING OF THE EXISTING STRUCTURAL STEEL SHALL BE AS SPECIFIED IN THE SPECIAL PROVISIONS FOR "CLEANING AND PAINTING EXISTING STEEL STRUCTURES." ALL BEAMS, BEARINGS AND OTHER STRUCTURAL STEEL SHALL BE CLEANED PER NEAR WHITE BLASTING SSPC-SP10.

THE DESIGNATED AREAS CLEANED PER NEAR WHITE BLAST CLEANING SSPC-SP10 SHALL BE PAINTED ACCORDING TO THE REQUIREMENTS OF PAINT SYSTEM 1 OZ/E.U. THE COLOR OF THE FINAL FINISH COAT FOR ALL INTERIOR STEEL SURFACES SHALL BE GRAY, MUNSELL NO. 5B 7/1. THE COLOR OF THE FINAL FINISH COAT FOR ALL EXTERIOR AND BOTTOM FLANGE OF THE FASCIA BEAMS SHALL BE GRAY, MUNSELL NO. 5B 7/1.

THE STRUCTURE HAS AN EXISTING ZINC SILICATE AND VINYL PAINT SYSTEM. CONTAINMENT OF CLEANING RESIDUE IS REQUIRED TO CONTROL NUISANCE DUST. THE CONTRACTOR SHALL FOLLOW THE SPECIFICATIONS FOR CONTAINMENT AND DISPOSAL OF NON-LEAD PAINT CLEANING RESIDUES.

NOTE: ELASTOMERIC BEARINGS AT SOUTH ABUTMENT

STATE OF ILLINOIS
DEPARTMENT OF TRANSPORTATION

CLEANING AND PAINTING OF THE EXISTING STRUCTURAL STEEL SHALL BE AS SPECIFIED IN THE SPECIAL PROVISIONS FOR "CLEANING AND PAINTING EXISTING STEEL STRUCTURES." ALL BEAMS, BEARINGS AND OTHER STRUCTURAL STEEL SHALL BE CLEANED PER NEAR WHITE BLASTING SSPC-SP10.

THE DESIGNATED AREAS CLEANED PER NEAR WHITE BLAST CLEANING SSPC-SP10 SHALL BE PAINTED ACCORDING TO THE REQUIREMENTS OF PAINT SYSTEM 1 OZ/E/U. THE COLOR OF THE FINAL FINISH COAT FOR ALL INTERIOR STEEL SURFACES SHALL BE GRAY, MUNSELL NO. 5B 7/1. THE COLOR OF THE FINAL FINISH COAT FOR ALL EXTERIOR AND BOTTOM FLANGE OF THE FASCIA BEAMS SHALL BE GRAY, MUNSELL NO. 5B 7/1.

THE STRUCTURE HAS AN EXISTING ZINC SILICATE AND VINYL PAINT SYSTEM. CONTAINMENT OF CLEANING RESIDUE IS REQUIRED TO CONTROL NUISANCE DUST. THE CONTRACTOR SHALL FOLLOW THE SPECIFICATIONS FOR CONTAINMENT AND DISPOSAL OF NON-LEAD PAINT CLEANING RESIDUES.

NOTE: ELASTOMERIC BEARINGS AT SOUTH ABUTMENT

DESCRIPTION OF WORK
LOCATIONS #7 & #8

SCALE: NONE	SHEET 4 OF 5 SHEETS	STA. TO STA.
-------------	---------------------	--------------

F.A.I. RTE.	SECTION	COUNTY	TOTAL SHEETS	SHEET NO.
74/39	*	MCLEAN	50	12
*D5 BRIDGE PAINTING 2022-1		CONTRACT NO. 70E74		
	ILLINOIS	FED. AID PROJECT		

MODEL: s:\MODEL NAMES
FILE NAME: s:\models\new\endev.com\PIV\DOT Documents\DOT Office\District 5\Projects\0570E74\CADDdata\Caddsheet\0570E74\Sheet-Description_Work.dgn

LOCATION #9

DESCRIPTION: I-74 WB @ mp 124.6 over NORFOLK SOUTHERN R.R.
COUNTY: MCLEAN
ROUTE: FAI 74
MARKED ROUTE: I-74
SECTION: 57 18VB
STRUCTURE NO.: 057-0045 WB
TYPE OF STRUCTURE: 3 SPAN CONTINUOUS STEEL
7 BEAM LINES - BK-BK ABUTS = 232.94'

CLEANING AND PAINTING OF THE EXISTING STRUCTURAL STEEL SHALL BE AS SPECIFIED IN THE SPECIAL PROVISIONS FOR "CLEANING AND PAINTING EXISTING STEEL STRUCTURES." ALL BEAMS, BEARINGS AND OTHER STRUCTURAL STEEL SHALL BE CLEANED PER NEAR WHITE BLASTNG SSPC-SP10.

THE DESIGNATED AREAS CLEANED PER NEAR WHITE BLAST CLEANING SSPC-SP10 SHALL BE PAINTED ACCORDING TO THE REQUIREMENTS OF PAINT SYSTEM 1 OZ/E/U. THE COLOR OF THE FINAL FINISH COAT FOR ALL STEEL SURFACES SHALL BE GREY, MUNSELL NO. 5B 7/1.

A MINIMUM OF ONE (1) HIGH VOLUME AIR MONITOR WILL BE REQUIRED TO MONITOR AIR QUALITY DURING DUST PRODUCING OPERATIONS AT THIS SITE. SEE SPECIAL PROVISIONS FOR "CONTAINMENT AND DISPOSAL OF LEAD PAINT CLEANING RESIDUES".

THE EXISTING STRUCTURAL STEEL COATING CONTAINS LEAD. THE CONTRACTOR SHALL FOLLOW THE GUIDE BRIDGE SPECIAL PROVISIONS FOR "CONTAINMENT AND DISPOSAL OF LEAD PAINT CLEANING RESIDUES" TO DEAL WITH THE PRESENCE OF LEAD ON THIS PROJECT.

NOTE: DECK DRAINS WITHIN THE PAINTING LIMITS DESCRIBED ABOVE ARE TO BE PAINTED AT NO ADDITIONAL COST.

NOTE: ELASTOMERIC BEARINGS @ ABUTMENTS

TWO (2) YEAR PAINT WARRANTY REQUIRED FOR THIS STRUCTURE

TRAFFIC CONTROL AND PROTECTION

IT IS ANTICIPATED THAT THE CONTRACTOR WILL CLEAN AND PAINT LOCATIONS #9 & #10 FROM THE MEDIAN. UTILIZING TRAFFIC CONTROL AND PROTECTION STANDARD 701402 IS AN OPTION IF WORKING FROM THE MEDIAN IS NOT POSSIBLE. (SEE SPECIAL PROVISIONS)

LOCATION #10

DESCRIPTION: I-74 EB @ mp 124.6 over NORFOLK SOUTHERN R.R.
COUNTY: MCLEAN
ROUTE: FAI 74
MARKED ROUTE: I-74
SECTION: 57-18VB
STRUCTURE NO.: 057-0046 EB
TYPE OF STRUCTURE: 3 SPAN CONTINUOUS STEEL
7 BEAM LINES - BK-BK ABUTS = 232.94'

CLEANING AND PAINTING OF THE EXISTING STRUCTURAL STEEL SHALL BE AS SPECIFIED IN THE SPECIAL PROVISIONS FOR "CLEANING AND PAINTING EXISTING STEEL STRUCTURES." ALL BEAMS, BEARINGS AND OTHER STRUCTURAL STEEL SHALL BE CLEANED PER NEAR WHITE BLASTNG SSPC-SP10.

THE DESIGNATED AREAS CLEANED PER NEAR WHITE BLAST CLEANING SSPC-SP10 SHALL BE PAINTED ACCORDING TO THE REQUIREMENTS OF PAINT SYSTEM 1 OZ/E/U. THE COLOR OF THE FINAL FINISH COAT FOR ALL STEEL SURFACES SHALL BE GREY, MUNSELL NO. 5B 7/1.

A MINIMUM OF ONE (1) HIGH VOLUME AIR MONITOR WILL BE REQUIRED TO MONITOR AIR QUALITY DURING DUST PRODUCING OPERATIONS AT THIS SITE. SEE SPECIAL PROVISIONS FOR "CONTAINMENT AND DISPOSAL OF LEAD PAINT CLEANING RESIDUES".

THE EXISTING STRUCTURAL STEEL COATING CONTAINS LEAD. THE CONTRACTOR SHALL FOLLOW THE GUIDE BRIDGE SPECIAL PROVISIONS FOR "CONTAINMENT AND DISPOSAL OF LEAD PAINT CLEANING RESIDUES" TO DEAL WITH THE PRESENCE OF LEAD ON THIS PROJECT.

NOTE: DECK DRAINS WITHIN THE PAINTING LIMITS DESCRIBED ABOVE ARE TO BE PAINTED AT NO ADDITIONAL COST.

NOTE: ELASTOMERIC BEARINGS @ ABUTMENTS

TWO (2) YEAR PAINT WARRANTY REQUIRED FOR THIS STRUCTURE

TRAFFIC CONTROL AND PROTECTION


IT IS ANTICIPATED THAT THE CONTRACTOR WILL CLEAN AND PAINT LOCATIONS #9 & #10 FROM THE MEDIAN. UTILIZING TRAFFIC CONTROL AND PROTECTION STANDARD 701402 IS AN OPTION IF WORKING FROM THE MEDIAN IS NOT POSSIBLE. (SEE SPECIAL PROVISIONS)

	USER NAME = eagllnga	DESIGNED -	REVISED -	STATE OF ILLINOIS DEPARTMENT OF TRANSPORTATION	DESCRIPTION OF WORK LOCATIONS #9 & #10			F.A.I. RTE. 74/39	SECTION *	COUNTY MCLEAN	TOTAL SHEETS 50	SHEET NO. 13
	PLOT SCALE = 40,0000 ' / in.	CHECKED -	REVISED -					'D5 BRIDGE PAINTING 2022-1		CONTRACT NO. 70E74		
	PLOT DATE = 9/29/2021	DATE -	REVISED -		SCALE: NONE	SHEET 5	OF 5 SHEETS	STA.	TO STA.	ILLINOIS FED. AID PROJECT		


B.M. U.S.C. & G.S. Benchmark M-199
Lt Sta. 54+05 (TR 172) Elev. 767.40

STATE OF ILLINOIS
DEPARTMENT OF PUBLIC WORKS & BUILDINGS
DIVISION OF HIGHWAYS

SHEET NO.	SECTION	COUNTY	TOTAL SHEETS	SHEET NO.
1	57-17HB-2	MCLEAN	27	6
12 SHEETS				

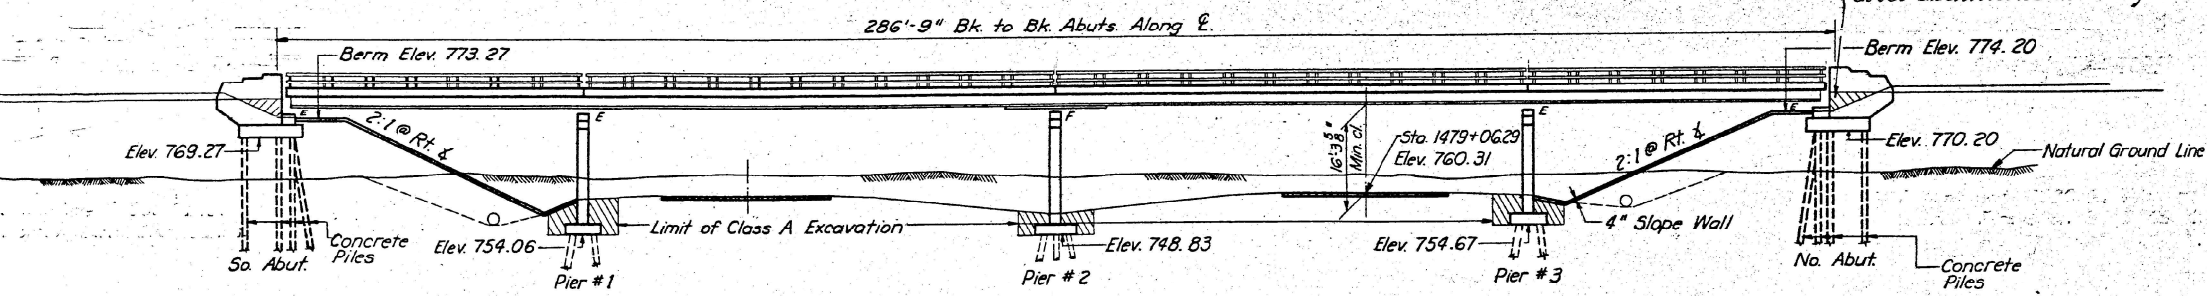


ELEVATION

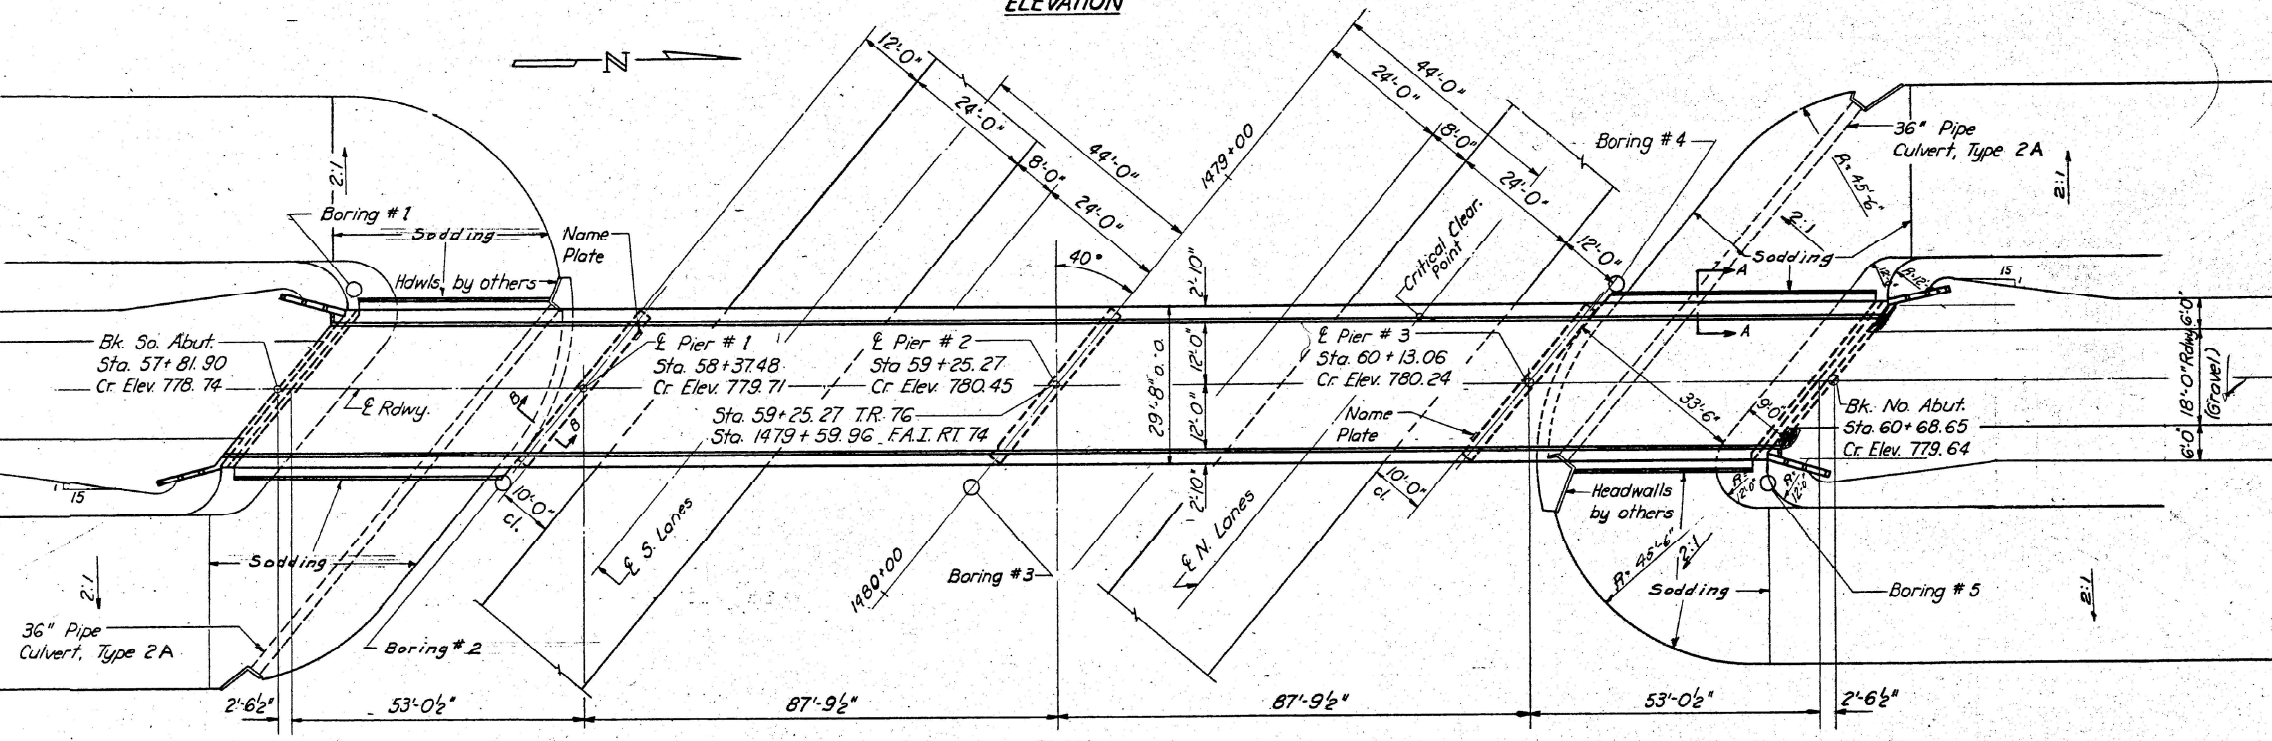


PLAN

STATION 1479+59.96
BUILT 196 BY
STATE OF ILLINOIS
F.A.I. RT. 74 SEC. 57-17HB-2
F.A. PROJECT 1-74-4(91)
LOADING H15-S12


NAME PLATE LETTERING
See Standard 2113

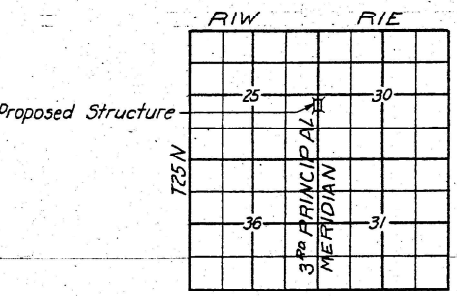


LOCATION PLAN

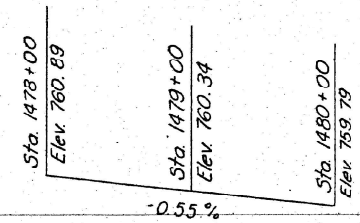


PROFILE F.A.I. RT 74

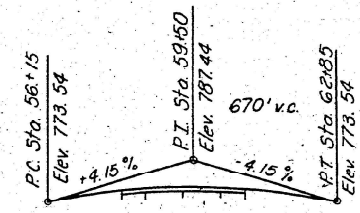

VERTICAL CURVE ON TR 76

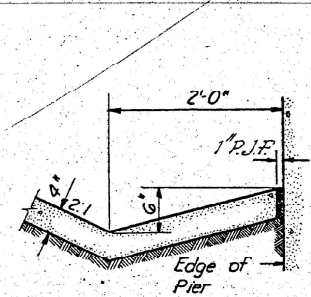

SECTION B-B

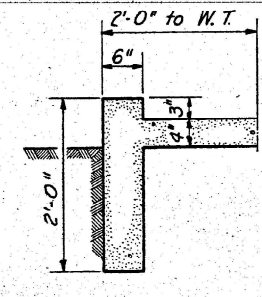

SECTION A-A

GENERAL NOTES

Class X Concrete shall be used throughout. Coarse aggregate which is to be used in end posts, must be free of chert, flint, limonite, and soft sandstone. The concrete floor slab shall be finished in accordance with Article 51.19 of the Standard Specifications. The slope wall shall be reinforced with welded wire fabric 6"x6" mesh, #4 wires, weighing 58#/100 sq. ft. Paved ditch included in quantity of slope wall.

Rivets 3/4", open holes 1 1/8", unless noted. All structural steel shall conform to A.S.T.M. Designation A-36. All rockers, bolsters, bearing plates, lead plates, pintles and anchor bolts shall be fabricated and set in accordance with Article 51.15 of the Standard Specifications and are included in quantity of Structural Steel. Est Weight-7660. Anchor bolts shall be set before riveting diaphragms over supports.

Except as otherwise provided, all Structural Steel shall receive one shop coat of red lead paint and two field coats of aluminum paint. See Articles 56.1 to 56.5 inclusive of the Standard Specifications. All paint shall be furnished and applied by the Contractor.

The piles in each abutment shall be driven in holes precored through the embankment to the natural ground line, in accordance with Article 60.9 (c) of the Standard Specifications. The Contractor shall drive one Conc. test pile @ the North Abut. in a permanent location before ordering or casting the remaining piles. The Contractor shall drive one timber test pile near, or in the vicinity of, Pier #2, (Outside the footing area) before ordering the remaining Piles.

TOTAL BILL OF MATERIAL-SEC.57-17HB-2

Item	Unit	Super	Sub	Total
* Class A Excavation for Strs.	Cu. Yds.			170
Class X Concrete	Cu. Yds.	243.7	240.6	484.3
Structural Steel	Lbs.	270,290		270,290
Metal Handrail	Lin. Ft.			569
Pipe Culvert, Type 2A-36"	Lin. Ft.			172
Reinforcement Bars	Lbs.	50,650	22,160	72,810
Crested Piles 20'-1'-58"	Lin. Ft.			1710
Test Pile Timber	Each			1
Concrete Piles	Lin. Ft.			595
Test Pile Concrete	Each			1
Name Plates	Each	2		2
Slope Wall (4")	Sq. Yds.			446
Protective Coat	Sq. Yds.			1,000

* Includes excavation for Slope Wall

GENERAL PLAN AND ELEVATION
PROJECT 1-74-4 (91) 118
TR 76 OVER F.A.I. RT 74
F.A.I. RT 74 SEC. 57-17HB-2
MCLEAN COUNTY
STA. 1479+59.96

Rev. 2-19-62 WLP Rev. Embankment to 60'-0" Deck - Relocated the Boring on the Plan View. Put "Sodding" on Plan View. Removed Embankment & Borrow Exc. Quans from Sta. 1479+00 to 1479+59.96. Changed Reinf. Bars from #6, #8 to #5, #7 & Revised 12-17-63 by J. Mullenix. Added #30 note to Gen. Notes. Added Protect. Coat & Sealant to quantities. Removed Sec. 57-17HB-2 (Turn. Struct. Steel) from quantities. Rev. the Location Plan. T. Bill at Mat. Change. Pile Culvert from 12' to 17'. Removed (F) from Sec. 57-17HB-2 (B.F.)-2. Removed word "Involved" from Gen. Notes & "Erecting" from Total Bill Mat.

USER NAME = eaglinga	DESIGNED -	REVISED -
	DRAWN -	REVISED -
PLOT SCALE = 40,000" = 1 in.	CHECKED -	REVISED -
PLOT DATE = 9/29/2021	DATE -	REVISED -



STATE OF ILLINOIS
DEPARTMENT OF TRANSPORTATION

AS-BUILT PLANS	SCALE: NONE	SHEET 1 OF 3 SHEETS	STA.	TO STA.
LOCATION #1 S.N. 057-0113				

F.A.I. RTE.	SECTION	COUNTY	TOTAL SHEETS	SHEET NO.
74/39	*	MCLEAN	50	14
CONTRACT NO. 70E74				
ILLINOIS FED. AID PROJECT				

STATE OF ILLINOIS
DEPARTMENT OF PUBLIC WORKS & BUILDINGS
DIVISION OF HIGHWAYS

ROUTE NO.	SECTION	COUNTY	TOTAL SHEETS	SHEET NO.	SHEET NO. 2
57-17H-2	MCLEAN	27	7	12 SHEETS	

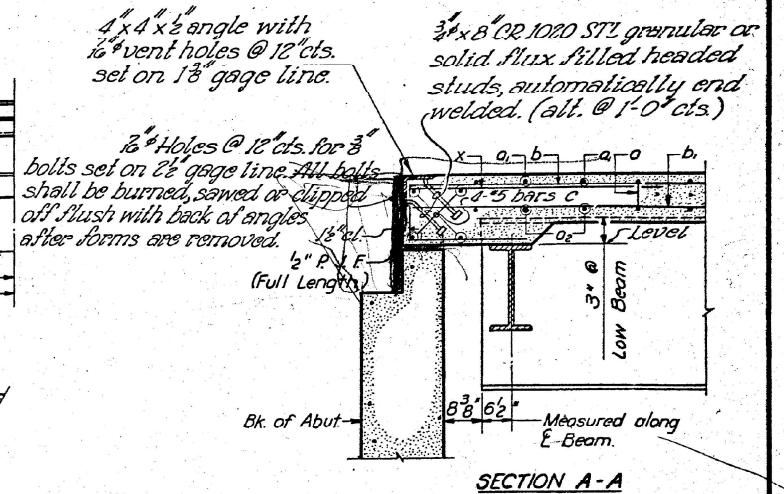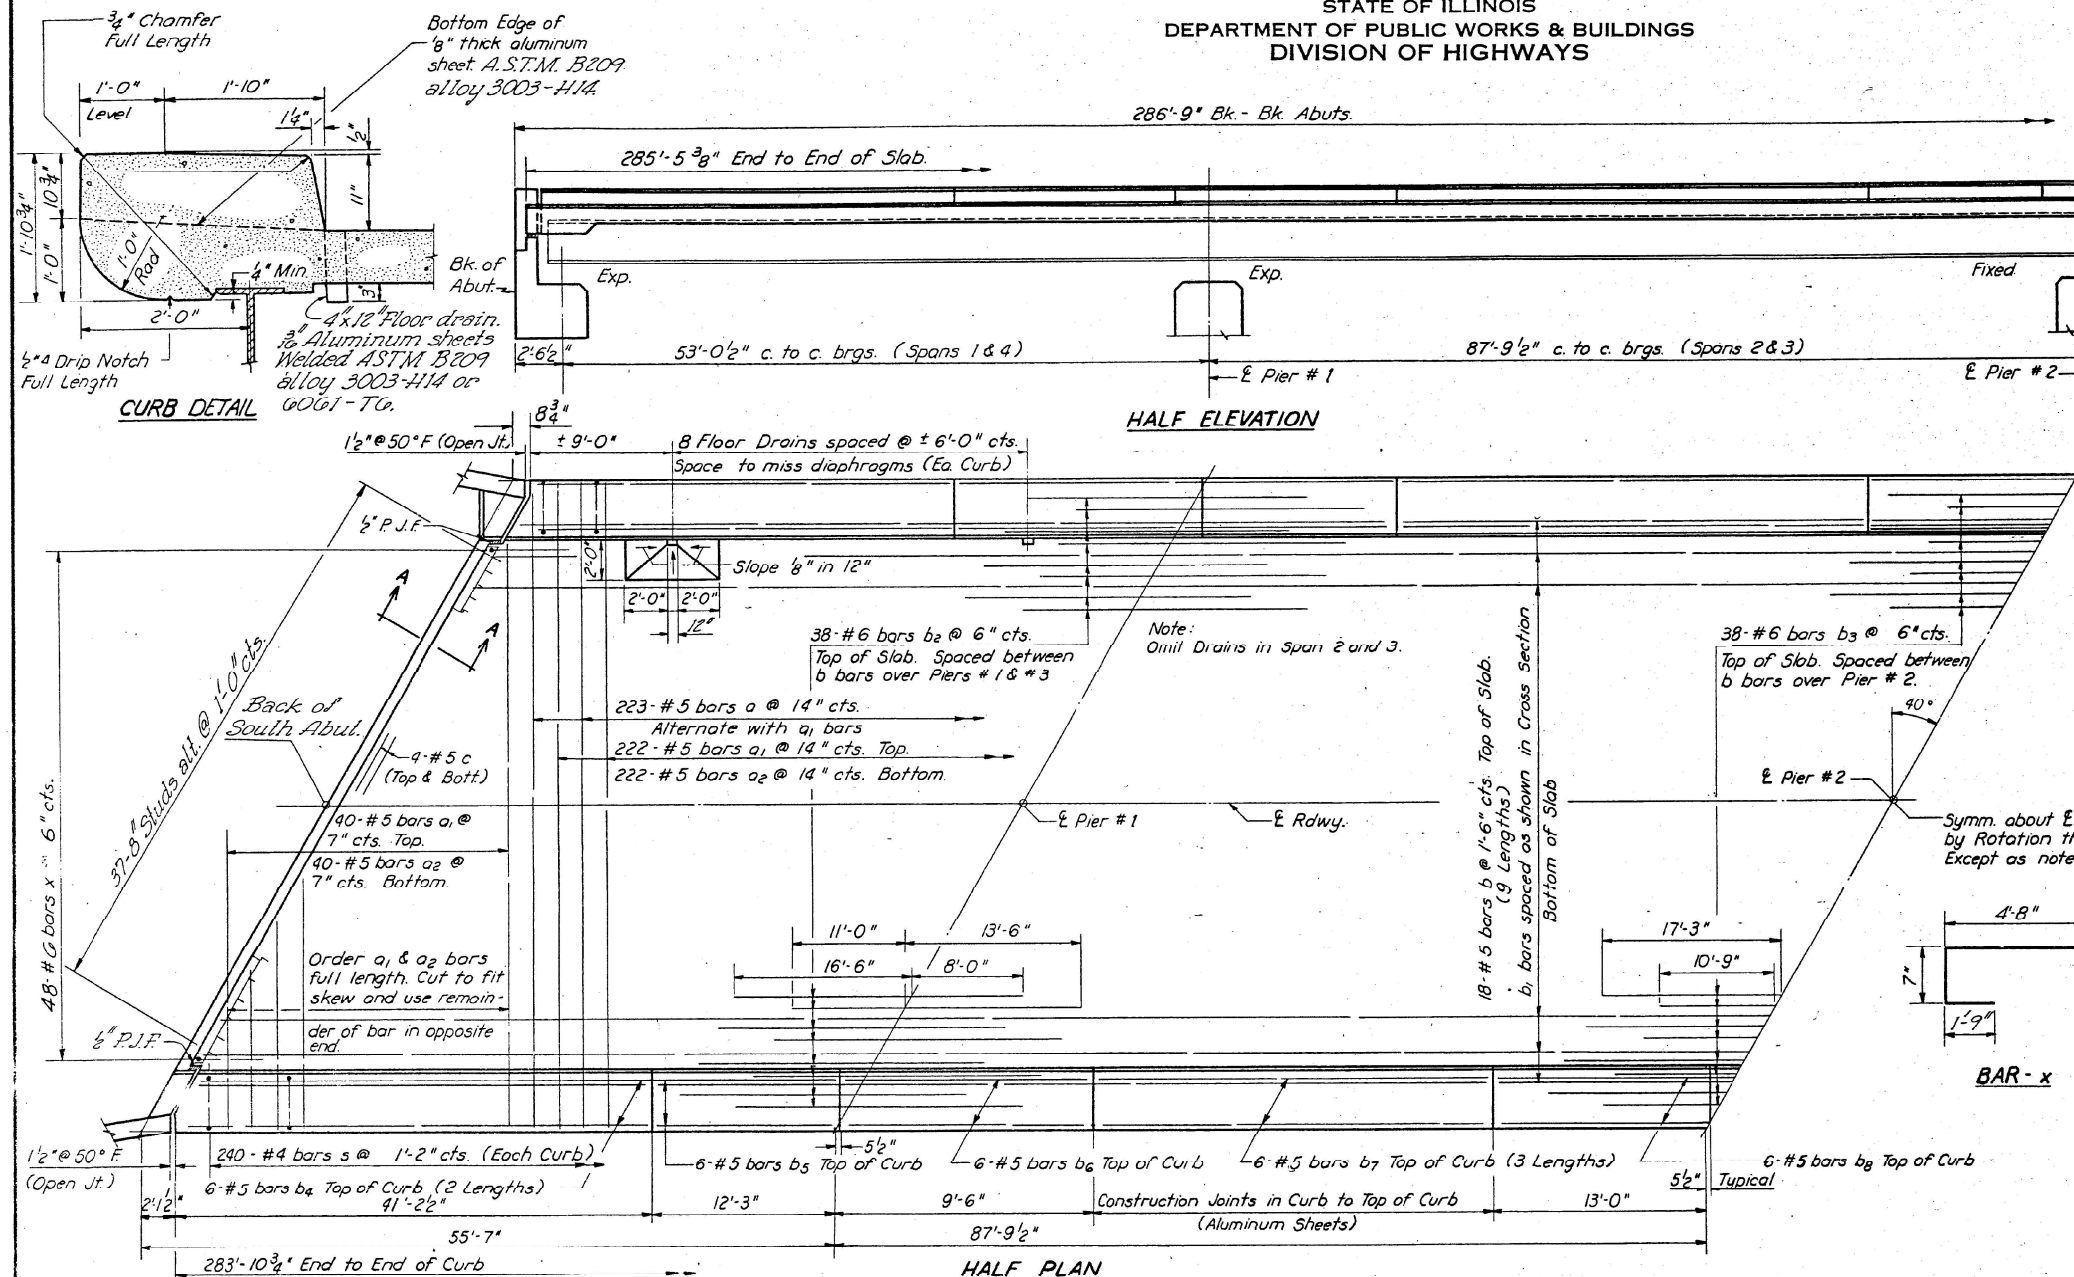


Bar	No.	Size	Length	Shape
a	223	# 5	30'-3"	~
a ₁	262	# 5	29'-3"	~
a ₂	262	# 5	28'-3"	~
b	162	# 5	32'-6"	~
b ₁	360	# 5	29'-6"	~
b ₂	76	# 6	24'-6"	~
b ₃	38	# 6	28'-0"	~
b ₄	48	# 5	22'-3"	~
b ₅	24	# 5	12'-0"	~
b ₆	24	# 5	9'-3"	~
b ₇	72	# 5	22'-9"	~
b ₈	74	# 5	12'-9"	~
c	8	# 5	30'-9"	~
s	480	# 4	6'-3"	~
x	96	# 6	7'-0"	~
Class X Concrete				Cu. Yds. 243.7
Reinforcement Bars				Lbs. 50,630
Structural Steel				Lbs. 870,290

Note:
Cost of Aluminum Sheets and Floor
Drains to be incidental.

SUPERSTRUCTURE
F.A.T. RT. 74 SEC. 57-17H-2
MCLEAN COUNTY
STA. 179+59.96

METHOD OF DETERMINING FILLET HEIGHT "f"
After all structural steel has been erected, elevations of the top flanges of the beams shall be taken @ the Stos. shown on Sheet 10. These Elevs. Subtracted from the Theoretical Grade Elevs. Adjusted for Dead Load Deflection, shown on sheet 10, minus floor thickness equals the fillet heights above top of beams.

DESIGNED	J. F. Otto	EXAMINED	K. E. Baumann
CHECKED	W. Heiny	PASSED	E. H. Baumann
DRAWN	J. Putnam	APPROVED	R. H. Pateman
CHECKED	W. Heiny		

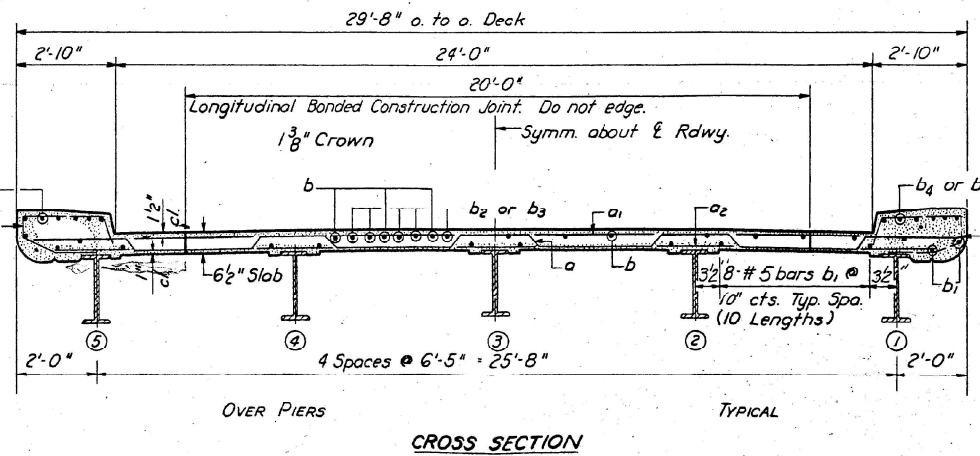

Rev. 2-19-62 WLP Changed b, Bar from #4 @ 9' cts to #6 @ 10' cts. Changed X Bar from #5 @ 12' cts to #5 @ 6' cts. Given Change b, from #6 to #5-X from 4' to 9' cts. Reinf. Bars from 48,860 to 50,040. Revised 12-18-63 by J. Mullerix Increased Struct. Steel quantities from 269,230 to 870,290 lbs. Reinf. bars from 50,040 to 50,630 lbs. Bar x dimen. from 1'-8" to 4'-9" Added 4'-4" x 1/2" to Sec. A-A with Stud & notes. Changed x bars from #5 to #6. Changed floor drains from 6" to 12" Changed Curb Detail notes to conform to Standard. Changed 4' conc. to 3' ea. side in Fillet drawing. Removed "F" from Sec. 57-17H(B,F)-2.





USER NAME	= eaglinga	DESIGNED	-	REVISED	-
PLOT SCALE	= 40,0000 * / in.	DRAWN	-	REVISED	-
PLOT DATE	= 9/29/2021	CHECKED	-	REVISED	-
		DATE	-	REVISED	-

STATE OF ILLINOIS
DEPARTMENT OF TRANSPORTATION

AS-BUILT PLANS
LOCATION #1 S.N. 057-0113

SCALE: NONE	SHEET 2	OF 3	SHEETS	STA.	TO STA.
-------------	---------	------	--------	------	---------

F.A.T. RTE.	SECTION	COUNTY	TOTAL SHEETS	SHEET NO.
74/39	*	MCLEAN	50	15
*DS BRIDGE PAINTING 2022-1		CONTRACT NO. 70E74		
ILLINOIS		FED. AID PROJECT		

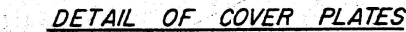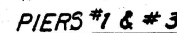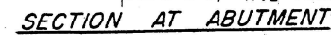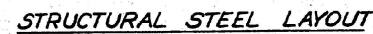

ELEVATION TOP OF BEAMS

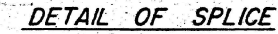
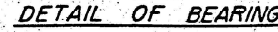


TABLE OF "4" DIMENSIONS

STRUCTURAL STEEL
F.A.I. RT. 74 SEC. 57-17HB-2
MCLEAN COUNTY
STA. 1479 + 59.96

JUNE 15 1961


EXAMINED *H.E. Bannan*
ENGINEER OF BRIDGES AND TRAFFIC STRUCTURES

PASSED *E. J. H. H. H.*
ENGINEER OF DESIGN

APPROVED *R. B. Bantelmeier*
CHIEF HIGHWAY ENGINEER

I-2-L Re-drawn 9-21-59




Revised 12-18-63 by J.Mullenix ~ Changed Diaphragm D note to "high strength bolts." ~ Changed Sec. 57-17H(B,F) & title ~

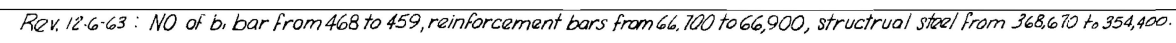

STATE OF ILLINOIS
DEPARTMENT OF PUBLIC WORKS & BUILDINGS
DIVISION OF HIGHWAYS







ROUTE No.	SEC.	COUNTY	TOTAL SHEETS	SHEET
F.A.I. 57-17		MC LEAN	53	16
R.T. 74 HB-3				
FED. ROAD DIST. No.		ILLINOIS		

SH. NO. 5 OF 9

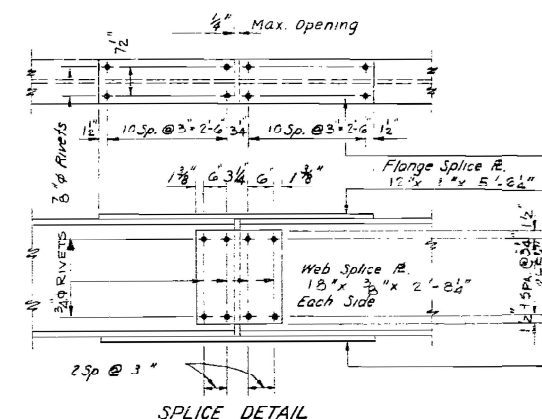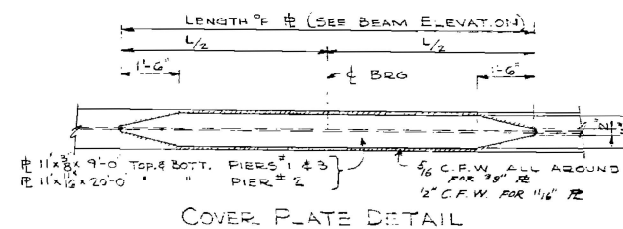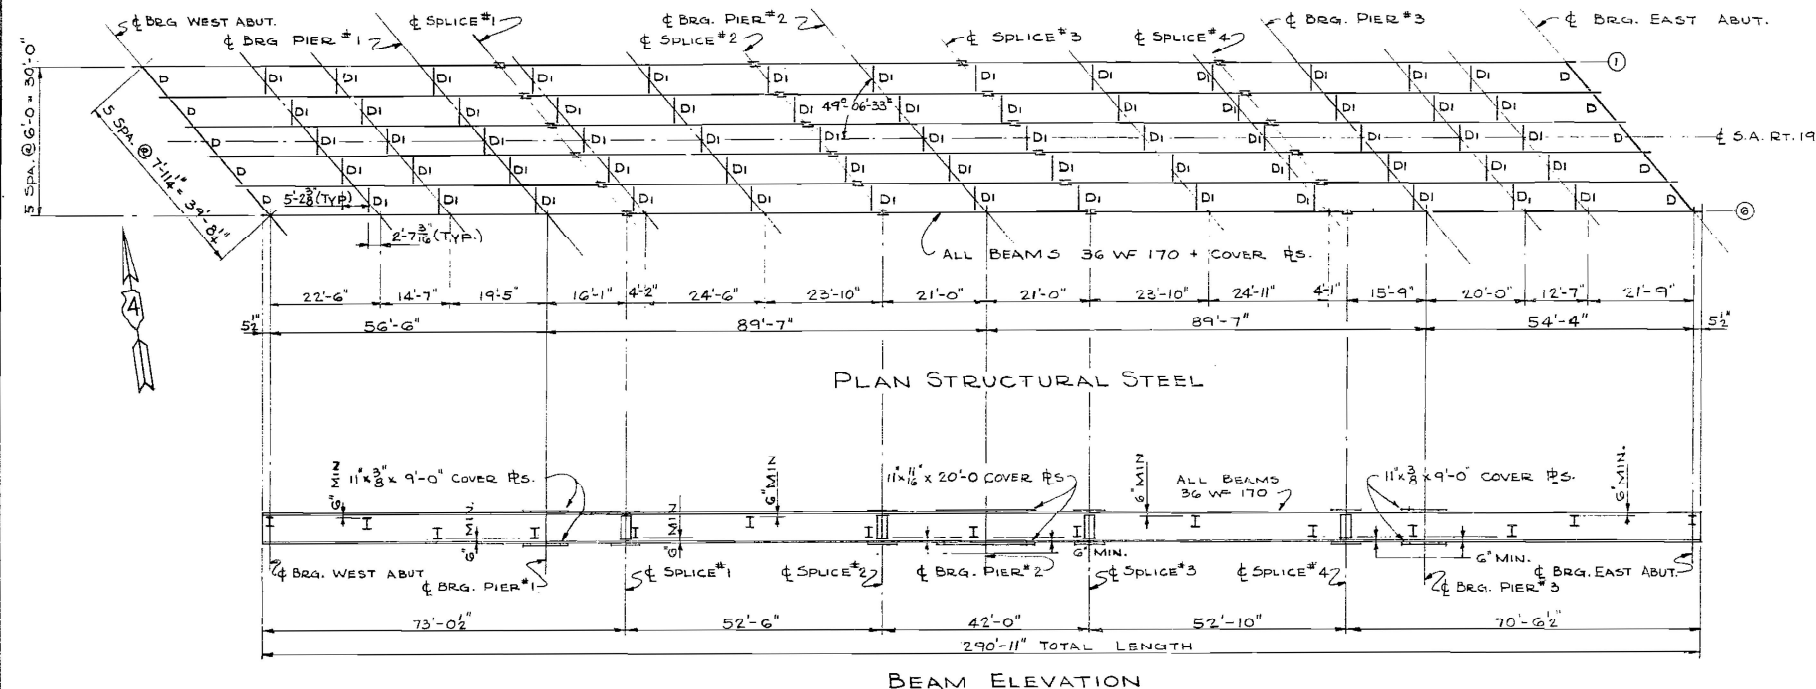

BEAM NUMBER	SHIM PLATE THICKNESS (t)			
	W. ABUT.	PIER #1	PIER #2	E. ABUT.
1				
2				
3	14"	11"	11"	11"
4	11"	11"	11"	14"
5	13"	7"	18"	
6	4"			

SEE DETAIL SH. NO. 6

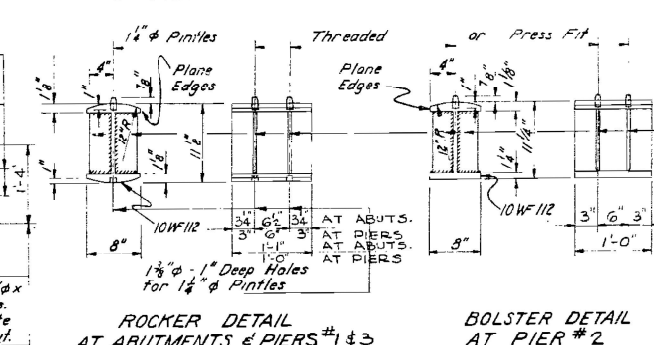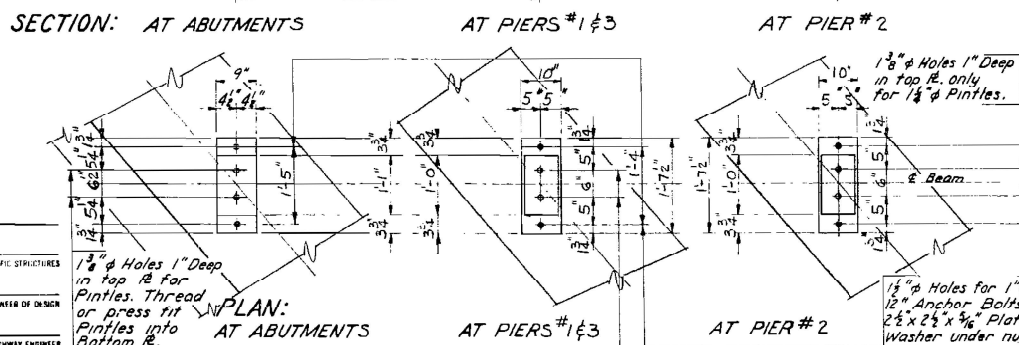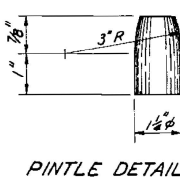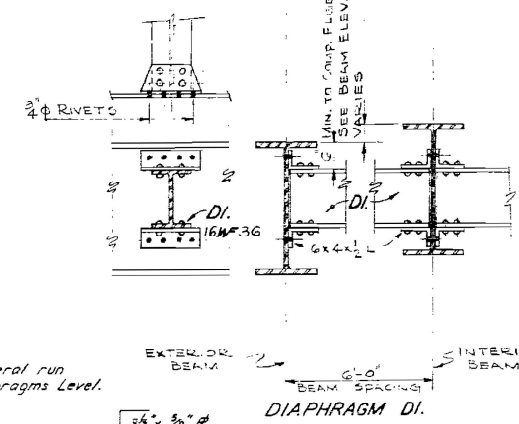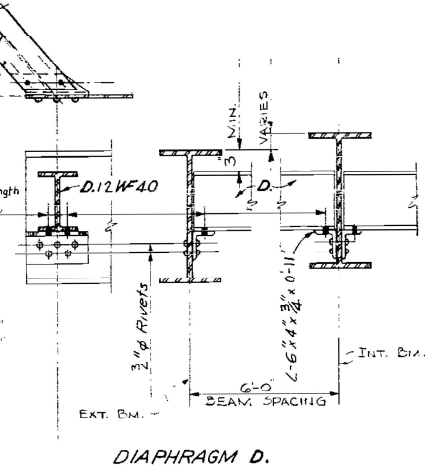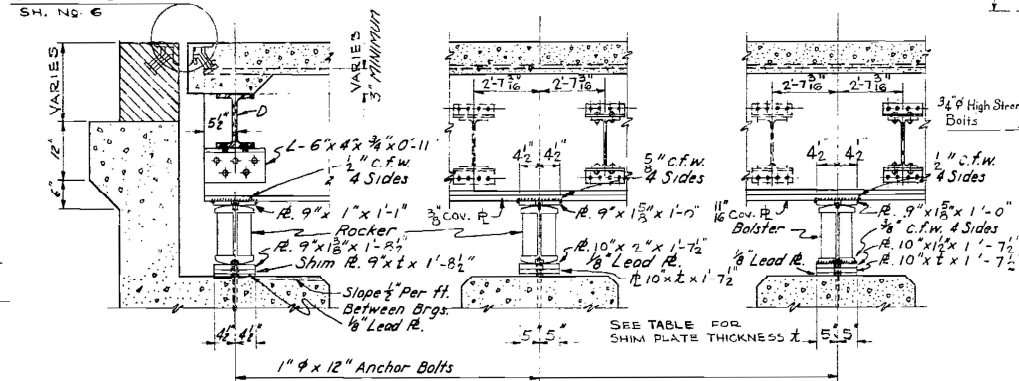

IN GENERAL RUN ALL DIAPHRAGMS LEVEL.

3/8" x 3/8" R. Weld all sides to 10 W F 112 with 3/8" c.f.w.

SUPERSTRUCTURE STRUCTURAL STEEL
F.A.I. ROUTE 74 SECTION 57-17 HB-3
C.H. ROUTE 19 OVER F.A.I. ROUTE 74
STATION 1535+92.53
MC LEAN COUNTY

WARREN AND VAN PRAAG, INC.
CONSULTING ENGINEERS - DECATUR, ILLINOIS

DESIGNED	P. H. M.	EXAMINED	
CHECKED	H. J. K.	ENGINEER OF BRIDGES AND TRAFFIC STRUCTURES	
DRAWN	P. H. M.	PASSET	
CHECKED	H. J. K.	ENGINEER OF DESIGN	
		APPROVED	
		CHIEF HIGHWAY ENGINEER	

SBS-1

STATE OF ILLINOIS
DEPARTMENT OF TRANSPORTATION

AS-BUILT PLANS
LOCATION #2 S.N. 057-0102

SCALE: NONE SHEET 3 OF 3 SHEETS STA. TO STA.

F.A.I. RTE.	SECTION	COUNTY	TOTAL SHEETS	SHEET NO.
74/39	*	MCLEAN	50	19

*DS BRIDGE PAINTING 2022-1 CONTRACT NO. 70E74

ILLINOIS FED. AID PROJECT

B.M. U.S.C. & G.S. N. 199, 1959 - 21.3' R.L.
Sta 229+38.5 Elev. 779.63

STATE OF ILLINOIS
DEPARTMENT OF PUBLIC WORKS & BUILDINGS
DIVISION OF HIGHWAYS

POLY. NO.	SECTION	COUNTY	TOTAL SHEETS	SHEET NO.
57-18HB	MCLEAN	22	6	10
F.A.I. RT. 74	ILLINOIS	74-4(90)119		

SHEET NO. 1
10 SHEETS

GENERAL NOTES

Class X Concrete shall be used throughout.
Coarse aggregate which is to be used in end posts must be absolutely free of chert, flint, limonite, lignite and soft sandstone.
The Concrete floor slab shall be finished in accordance with Article 51.19 of the Standard Specifications.
Slope wall shall be reinforced with welded wire fabric 6"x6" mesh, #4 wires, weighing 58# per 100 sq. ft.

Rivets 3/4", Open holes 3/4", unless noted.
All holes for splices shall be punched 3/4" and reamed to proper size (3/4" in web & 1/2" in flange) with all beams assembled in the shop in proper position. Leave assembled in shop for inspection.
All bolsters, rollers, rockers, bearing plates, shim plates, lead plates, pintles and anchor bolts shall be fabricated and set in accordance with Article 51.15 of the Standard Specifications and are included in quantity of Structural Steel.
Anchor bolts shall be set before riveting diaphragms over supports.
All Structural Steel shall conform to ASTM A-36 Specifications for Structural Steel.

The roadway expansion guards shall be fabricated and erected in accordance with Article 51.13(d) of the Standard Specifications and are included in quantity of Structural Steel Est. Wt. 930 lbs.
Exposed surfaces of expansion guard angles shall be given two shop coats of red lead paint.

Except as otherwise provided, all Structural Steel shall receive one shop coat of red lead paint and two field coats of aluminum paint. See Articles 56.1 to 56.5 inclusive of the Standard Specifications.

All paint shall be furnished & applied by the Contractor.
Holes shall be precored for piles under Abutments in accordance with Article 60.9(c) of the Standard Specifications.
The Contractor shall drive one concrete test pile at South Abutment in a permanent location and one timber test pile in the vicinity of pier 2 as directed by the engineer before ordering remainder of piles.

Wherever in these plans reference is made to the "Standard Specifications", it is understood to include the "Supplemental Specifications" effective March 2, 1964.

TOTAL BILL OF MATERIAL - SEC. 57-18HB

Item	Super	Sub	Total
Class A Excav. for Struct.	Cu. Yds.	190	190
Class X Concrete	Cu. Yds.	277.2	542.3
Structural Steel	Lbs.	294,890	294,890
Furnishing & Erecting Metal Handrail	Lin. Ft.	602	602
Reinforcement Bars	Lbs.	47,670	23,670
Crossed Piles (up to 20')	Lin. Ft.	960	960
Crossed Piles (20'-38')	Lin. Ft.	525	525
Test Piles (Timber)	Ea.	1	1
Concrete Piles	Lin. Ft.	735	735
Test Piles (Concrete)	Ea.	1	1
Name Plates	Ea.	2	2
Slope Wall (4")	Sq. Yds.	500	500
Protective Coat	Sq. Yds.		1,085

STA. 1568+18
BUILT 1966 BY
STATE OF ILLINOIS
F.A.I. RT. 74 SEC. 57-18HB
F.A. PROJ. 74-4(90)
LOADING HIS-S12
NAME PLATE
See Std. 2113-1

PROFILE - F.A.I. RT. 74

Sta.	Elev.	Sta.	Elev.	Sta.	Elev.	Sta.	Elev.	Sta.	Elev.
1566+00	782.64	1567+00	783.08	1568+00	783.32	1569+00	783.56	1570+00	783.80

DESIGN STRESSES

f_c = 1400 p.s.i. Super & Sub
f_s = 25 p.s.i. Footings
f_s = 20,000 p.s.i. Reinf.
f_s = 18,000 p.s.i. Struct.
n = 10

LOADING HIS-S12-44

V.C. DATA - S.A. RT. 18-C

PROJ. 74-4(90)119
GENERAL PLAN & ELEVATION
C.H. RT. 18-C OVER F.A.I. RT. 74
F.A.I. RT. 74 SEC. 57-18 HB
MCLEAN COUNTY
STA. 1568+18

Revised 1-3-64 by J. Mullenix - Added 1" P.J.F. @ bott. of slope on Elev. - Removed word "involved" from GEN. NOTES - Changed A-7 to A-30 Steel in GEN. NOTES - Added 60' berm & embank. backfill note to Elev. - Removed word "Erecting" from Struct. Steel in Quantities - Added Protect. Coat to Quantities

USER NAME	= eaglinga	DESIGNED	-	REVISED	-
PLOT SCALE	= 40,000' / in.	DRAWN	-	REVISED	-
PLOT DATE	= 9/29/2021	CHECKED	-	REVISED	-
		DATE	-	REVISED	-

STATE OF ILLINOIS
DEPARTMENT OF TRANSPORTATION


AS-BUILT PLANS
LOCATION #3 S.N. 057-0112

SCALE: NONE SHEET 1 OF 3 SHEETS STA. TO STA.

F.A.I. RTE.	SECTION	COUNTY	TOTAL SHEETS	SHEET NO.
74/39	*	MCLEAN	50	20
*DS BRIDGE PAINTING 2022-1		CONTRACT NO. 70E74		
ILLINOIS		FED. AID PROJECT		

STATE OF ILLINOIS
DEPARTMENT OF PUBLIC WORKS & BUILDINGS
DIVISION OF HIGHWAYS

ROUTE NO.	MILEAGE	COUNTY	TOTAL SHEETS	SHEET NO.
74	57.18 NB	MCLEAN	22	8
10 SHEETS				

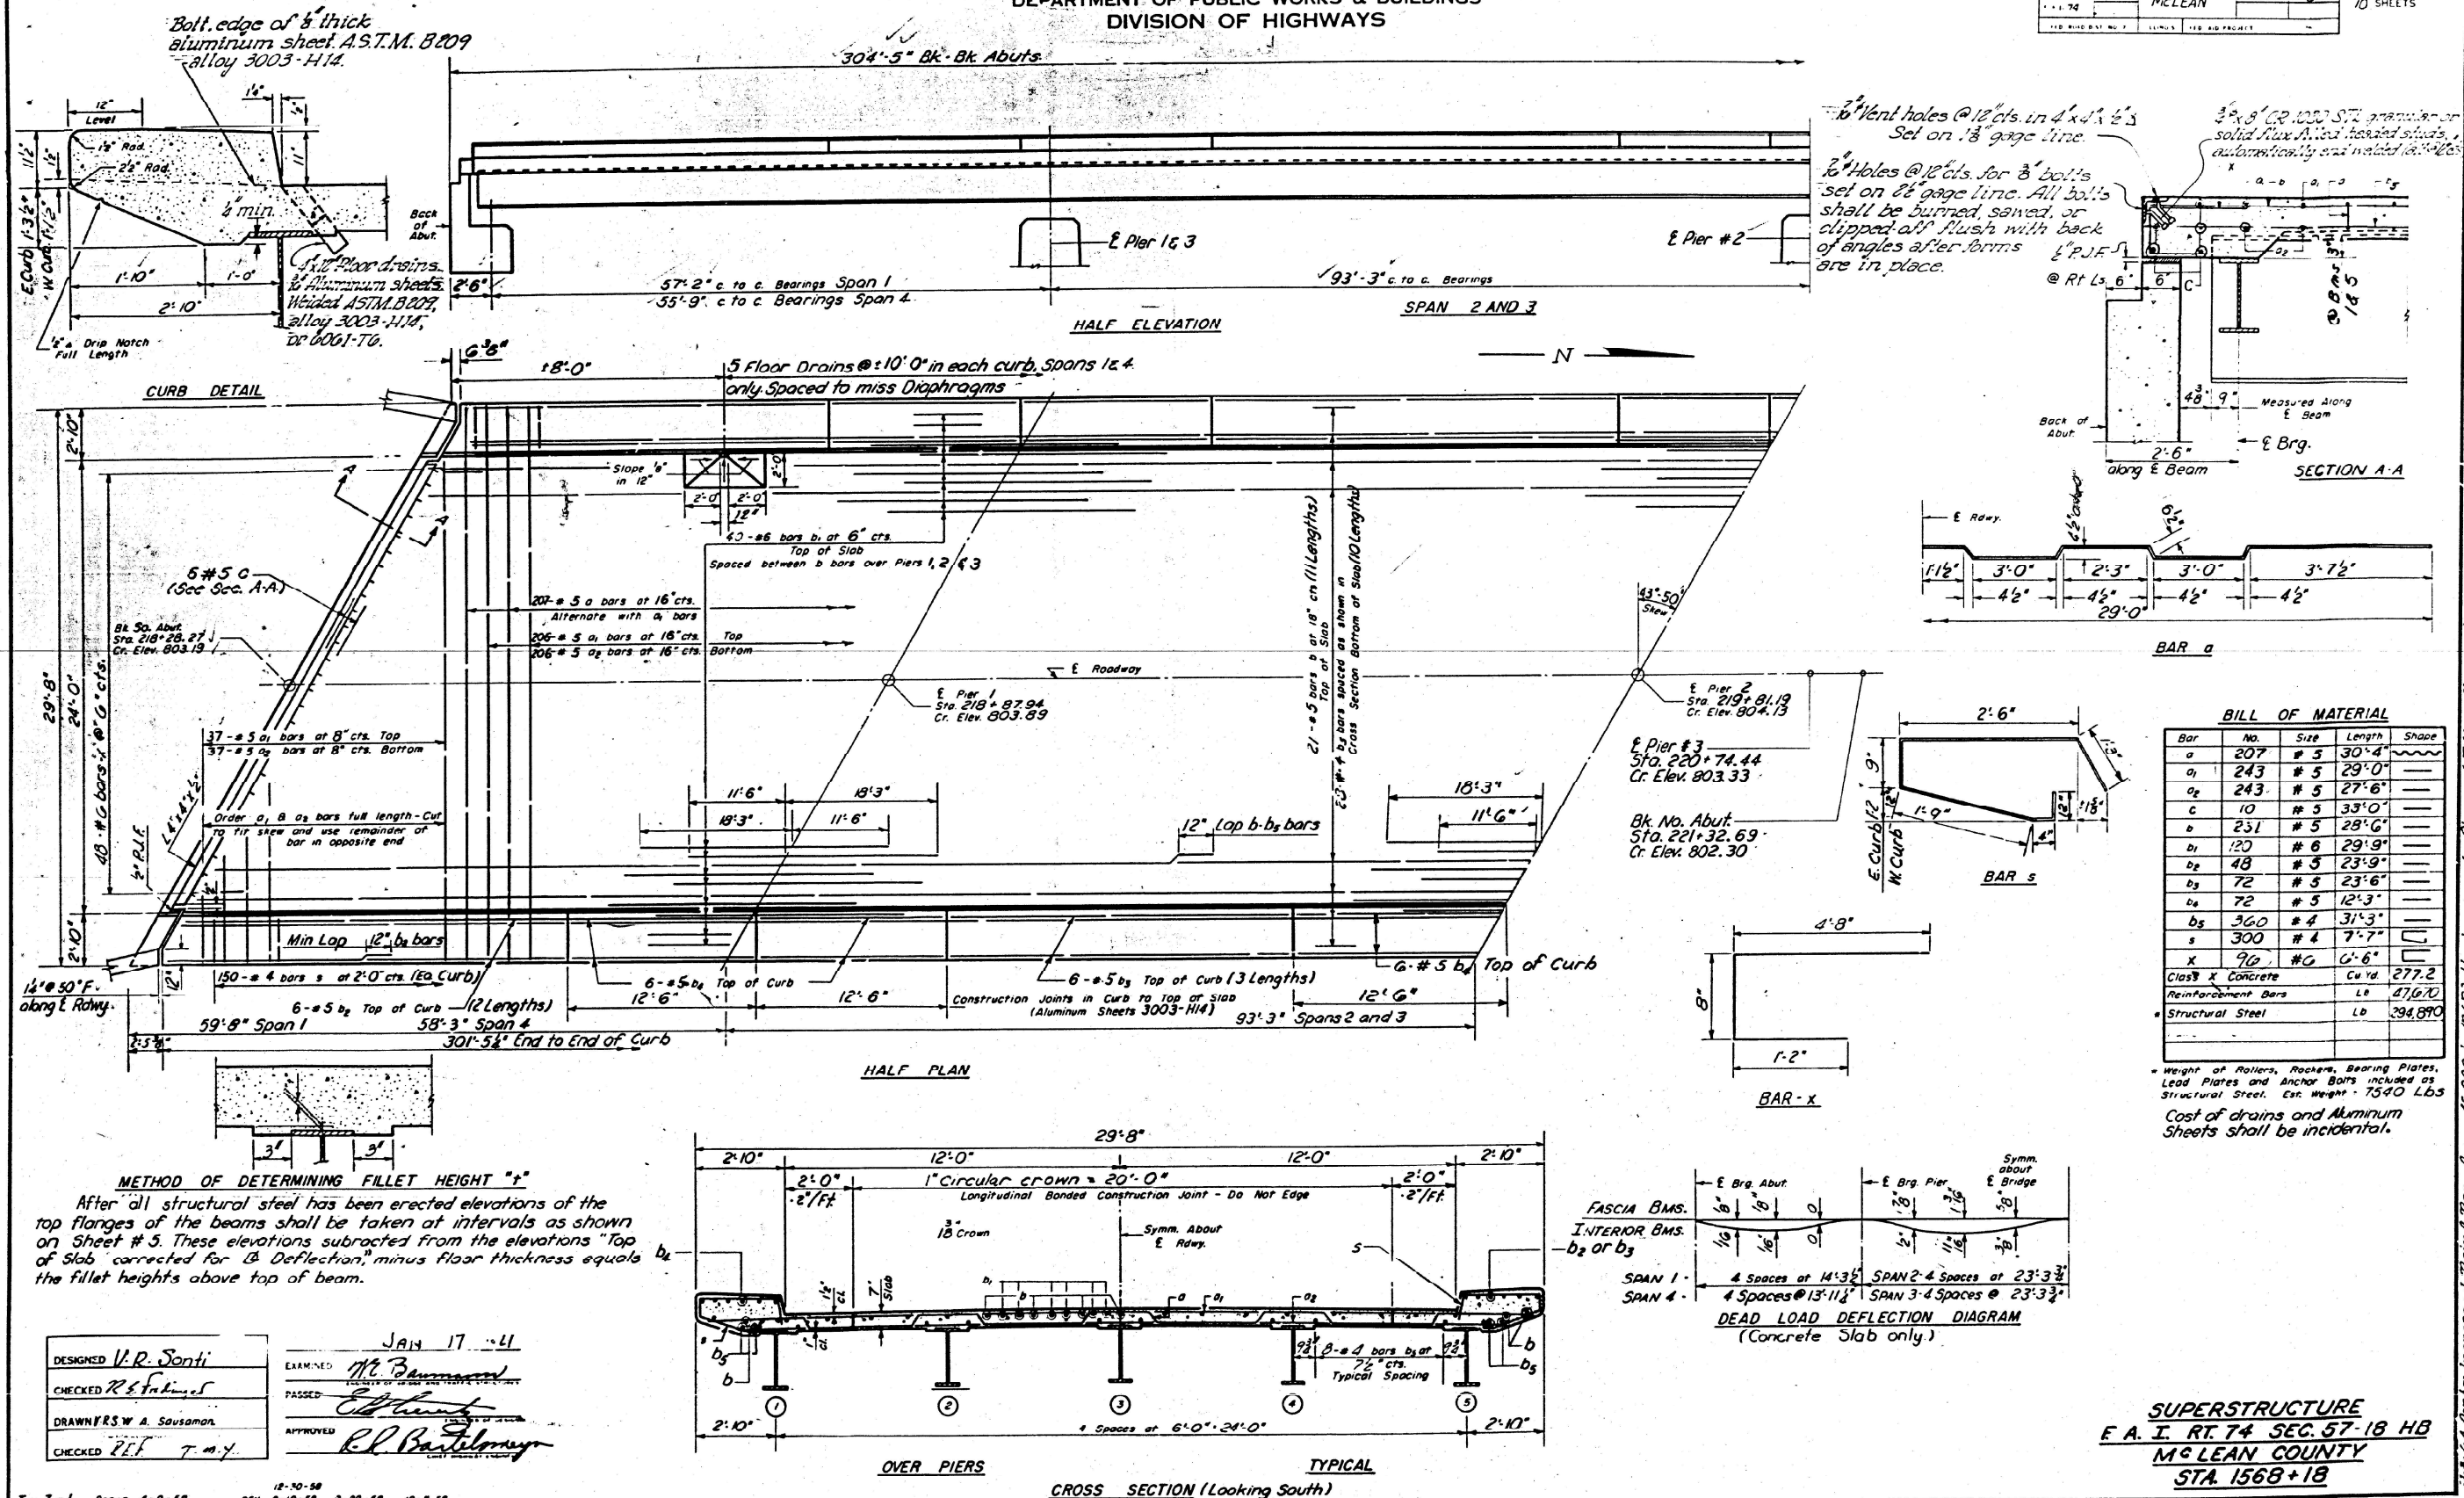



STATE OF ILLINOIS
DEPARTMENT OF TRANSPORTATION

AS-BUILT PLANS
LOCATION #3 S.N. 057-0112

F.A.I. RTE.	SECTION	COUNTY	TOTAL SHEETS	SHEET NO.
74/39	*	MCLEAN	50	21
SCALE: NONE		CONTRACT NO. 70E74		
SHEET 2 OF 3 SHEETS		ILLINOIS FED. AID PROJECT		


ROUTE NO	SECTION	COUNTY	TOTAL SHEETS	SHEET NO
S & L F.A.I. 74	57-18HB	McLEAN	22	9
FEEL ROAD DIST NO 1		BLK/MS	FED AID PROJECT.	

SHEET NO 4
10 SHEETS

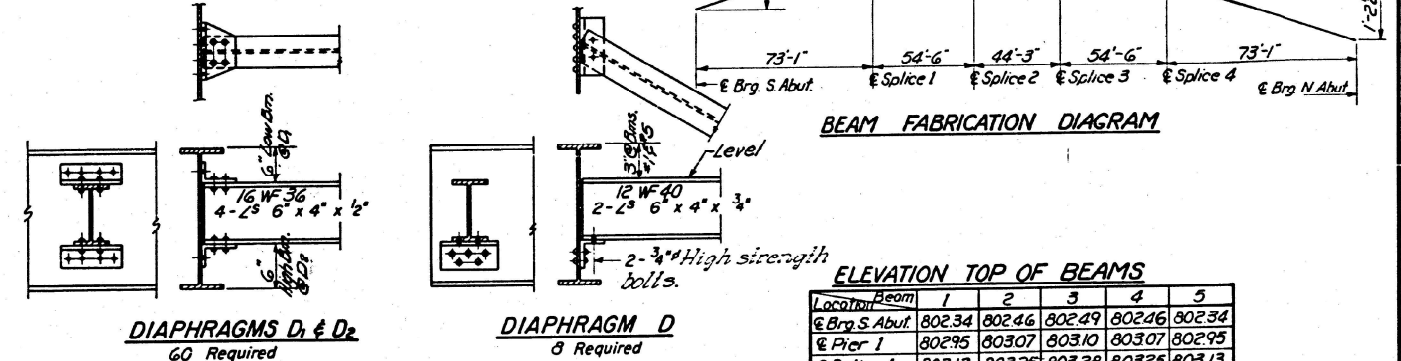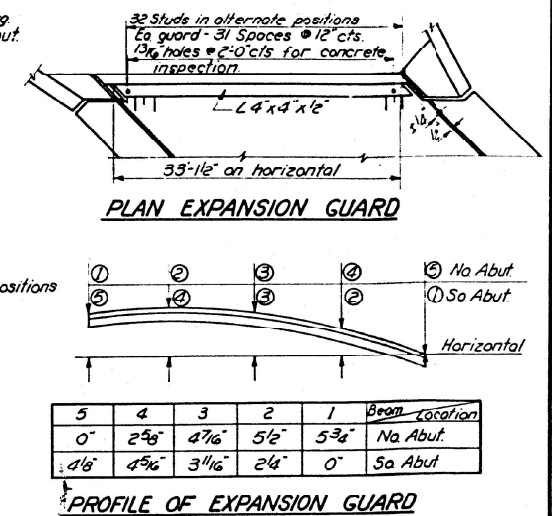

ELEVATION TOP OF BEAMS						
Location	Beam	1	2	3	4	5
€ Pier S Abut		80234	80246	80249	80246	80234
€ Brg 1		80295	80307	80310	80307	80295
€ Splice 1		80313	80325	80328	80325	80313
€ Splice 2		80335	80347	80350	80347	80335
€ Pier 2		80327	80339	80342	80339	80327
€ Splice 3		80319	80331	80334	80331	80319
€ Splice 4		80261	80273	80276	80273	80261
€ Pier 3		80232	80244	80247	80244	80232
€ Brg N Abut		80140	80152	80155	80152	80140


Location	£ Brg. S Abut.	£ Pier 1	£ Pier 2	£ Pier 3	£ Brg. N Abut.
Beams					
Beam 3	36"	3'	3'	3'	36"
Beams 1, 2, 4 & 5	0	0	0	0	0

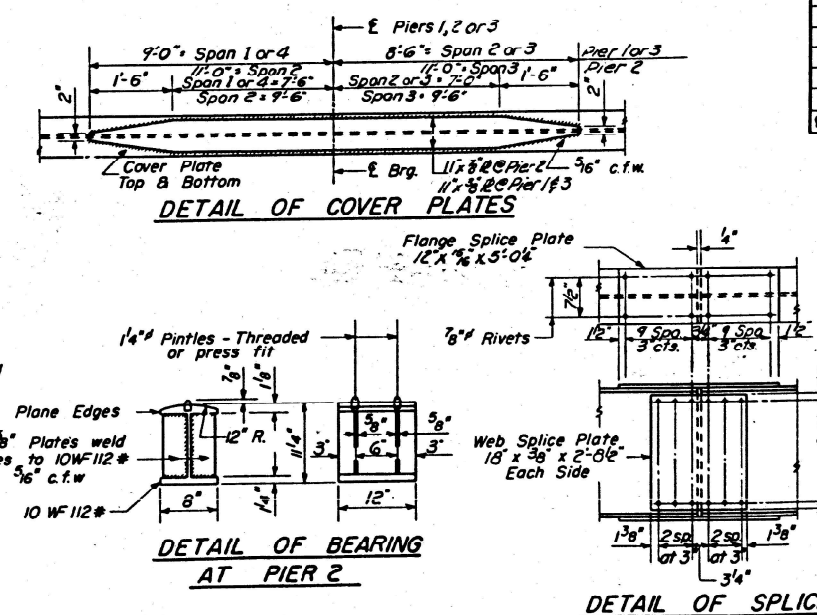

STRUCTURAL STEEL
F.A.I. RT. 74 SEC. 57-18 HB
McLEAN COUNTY
STA. 1568+18

Revised 1-3-64 by J.Mullenix ~ Changed 2-1/2" Bolts to high strength in Diaph. D. ~ Changed Title. ~

*This portion of embankment
backfill by bridge contractor
after abutments are in place*

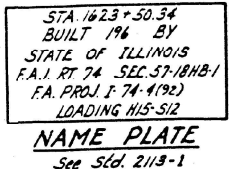

TOTAL BILL OF MATERIAL (SEC. 57-18HB.1)

[illegible]

TOTAL BILL OF MATERIALS			
Item	Super	Sub	Total
Class A Excav. for Structure	Cu Yds	110	110
Class X Concrete	Cu Yds	2570	2860
Structural Steel	Lbs	290,340	290,340
Furnishing Erecting Metal Handrail Lin Pl.		606	606
Reinforcement Bars	Lbs.	44,500	23,980
Crescoided Piles	Lin Ft.	1,365	1,365
Test Piles (Timber)	Eq.	1	1
Concrete Piles	Lin Ft.	848	848
Test Piles (Concrete)	Eq.	1	1
Name Plates	Eq.	2	2
Slope Wall (4')	Sq Yds	490	490
Protective Coat	Sq Yds		1070

PROFILE T.R. 104

GENERAL PLAN & ELEVATION
TR 104 OVER F.A.I.R.T. 74
PROJ. I-74-4(92)120
F.A.I.R.T. 74 SEC. 57-184B-1
MCLEAN COUNTY
STA. 1623+50.34

All holes for splices shall be punched $\frac{1}{8}$ " and reamed to proper size, ($\frac{3}{16}$ " in web and $\frac{1}{4}$ " in flange) with all beams assembled in shop in proper position. Leave assembled in shop for inspection.

Anchor bolts shall be set before riveting diaphragms over supports.

All bolsters, rockers, bearing plates, shim plates, lead plates, pintles and anchor bolts shall be lubricated and set in accordance with Article 5115 of the Standard Specifications and are included in quantity of Structural Steel.

Except as otherwise provided all Structural Steel shall receive one shop coat of red lead paint and two field coats of aluminum paint. See Articles 56.1 to 56.5 inclusive of the Standard Specifications.

All paint shall be furnished and applied by the Contractor.


Concrete piles through embankment shall be driven in precast holes in accordance with Article 60.9(c) of the Standard Specifications.

Revised 1995. In addition removed relations "measured" 12000 Cu Yds, Barrow Exc. 12270 Cu Yds, at Se. of Pt. C. Embankment 12000 Cu Yds, Barrow Exc. 15230 - West of Se. Pt. C.
 Address relation of 12000 Cu Yds to above-4 and abandoned flow of Pt. C. to "Pt. B. flow" appropriate and "Bays 4 and 5".
 In NW relocated Barrow Exc. at Se. Pt. C. and dry-berms of frontage of Se. and Se. North. In SW of Barrow removed then Barrow Exc. 200

Revised 12-27-63 by J.Mullenix ~ Removed P.I.F. @ butts ~ Added Embankment backfill note to GEN. NOTES ~ Added 16-0 to 16-100 ~ Removed "Scale" from PLAN ~ Added Desig. A-36 to GEN. NOTES ~ Changed Super. Limiting ~ From: 250 to 44,500 Lbs
Rev. 1/29/64 Deleted Bridge Footing and Abutment Notes

AS-BUILT PLANS			
LOCATION #4 S.N. 057-0114			
SCALE: NONE	SHEET 1	OF 3	SHEETS STA.

F.A.I. RTE.	SECTION	COUNTY	TOTAL SHEETS	SHEET NO.
74/39	*	MCLEAN	50	23
*D5 BRIDGE PAINTING 2022-1		CONTRACT NO. 70E74		
ILLINOIS FED. AID PROJECT				

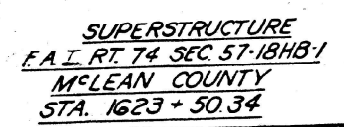


DESIGNED <i>A. K. E. Beck</i>	EXAMINED <i>W. C. Berman</i>
CHECKED <i>W. Hing</i>	PASSED <i>E. H. Hing</i>
DRAWN <i>A. K. E.</i>	APPROVED <i>R. R. B. Berman</i>
CHECKED <i>W. Hing</i>	


Revised 12-27-63 by J. Muller, Inc. - Revised CURB DETAILS notes to conform to Standards - Removed duplicate note & revised exist. notes to conform with Section A-A - Changed floor drains from 3" to 12" - Changed SEC. B-B to DETAIL A. - Changed 4" to 5" in Filler conc. on side brn. - Increased bar x detail from 5'-5" to 5'-5"

STATE OF ILLINOIS
DEPARTMENT OF PUBLIC WORKS & BUILDINGS
DIVISION OF HIGHWAYS

PROJECT NO.	SECTION	COUNTY	TOTAL SHEETS	SHEET NO.
57-15 HB-1	MCLEAN	25	9	10 SHEETS

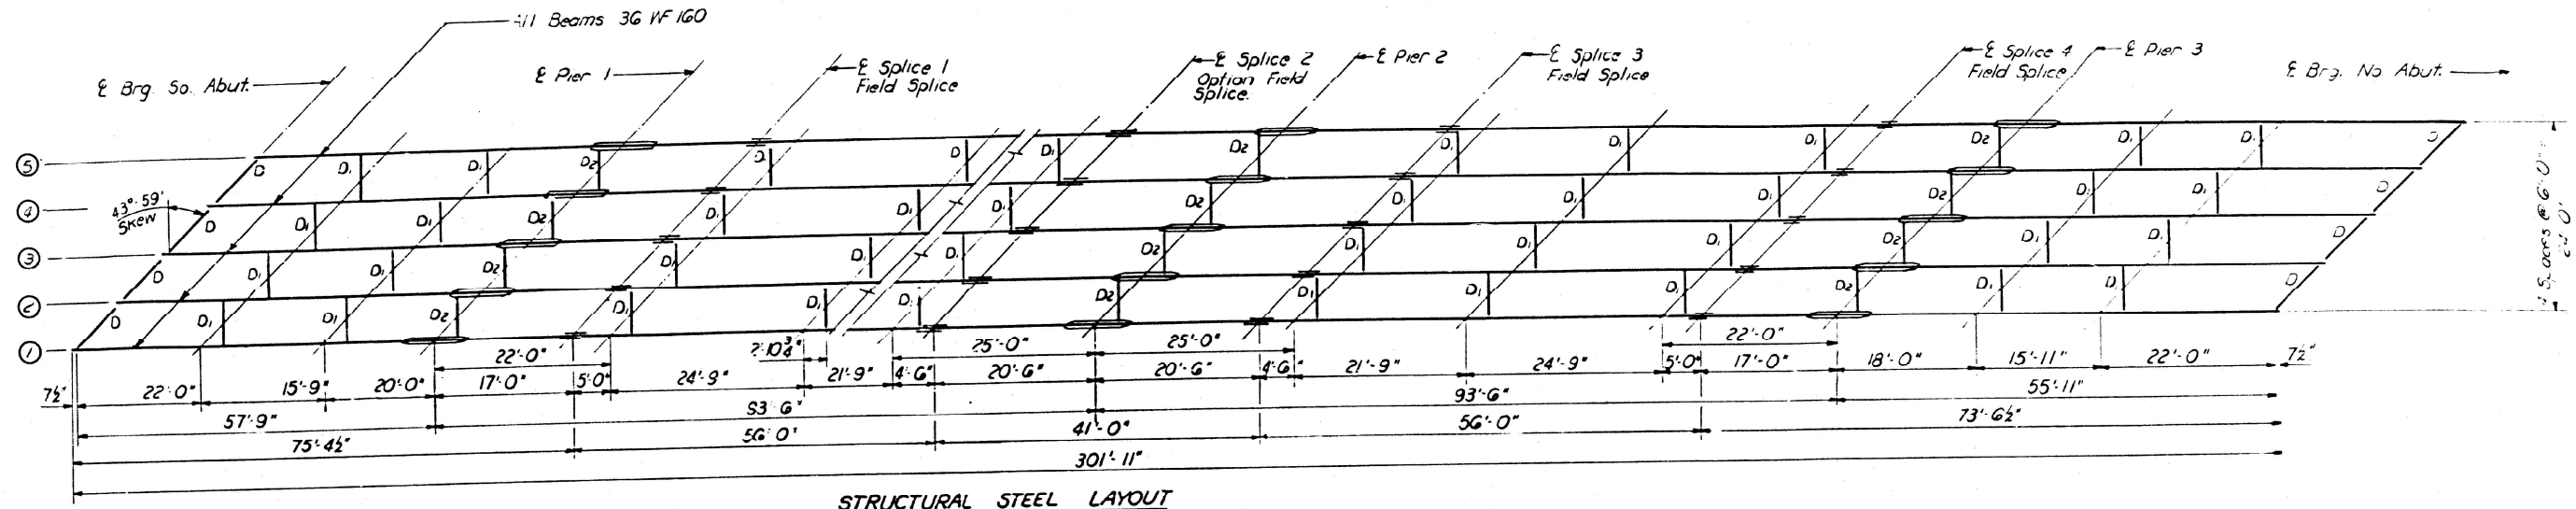


STRUCTURAL STEEL LAYOUT

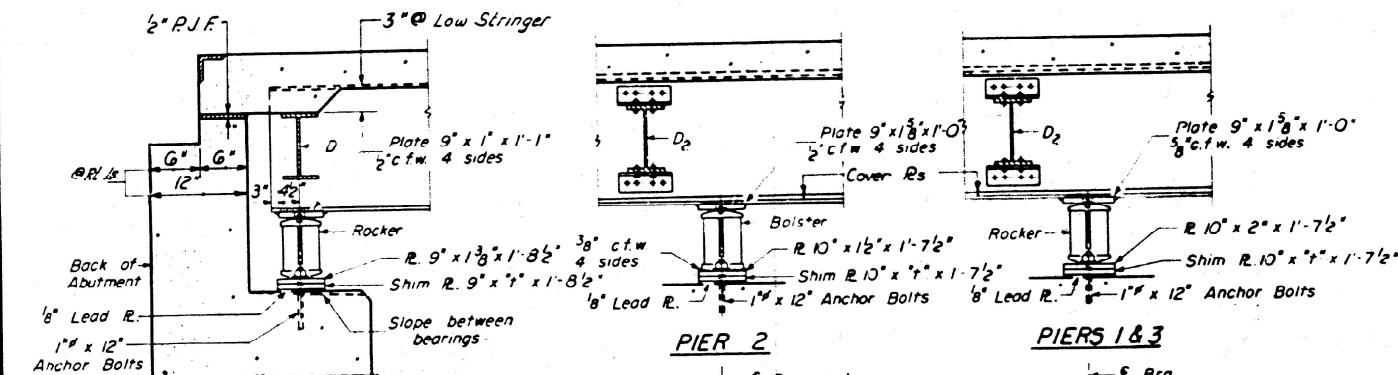

SECTION AT ABUTMENT

PIER 2


PIERS 1 & 3

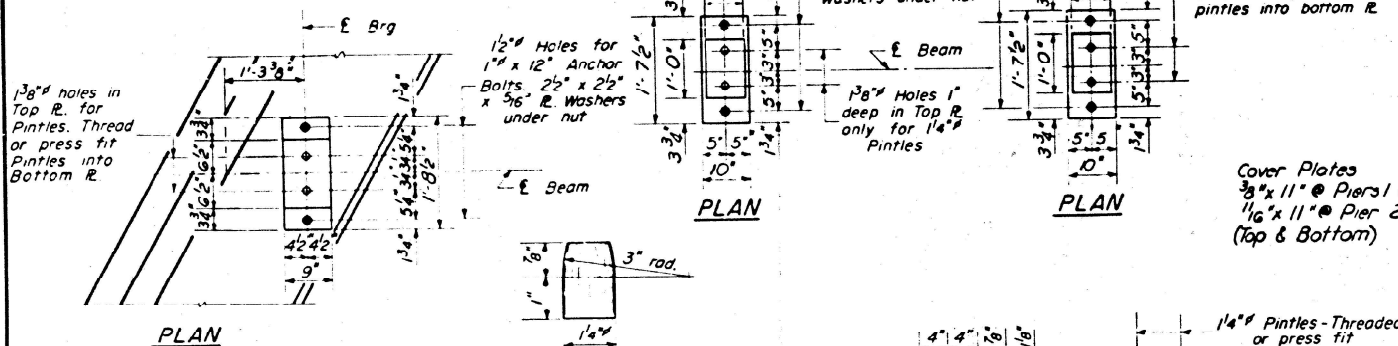

PLAN

DETAIL OF PINTLE


DETAIL OF BEARING
AT PIERS 1 & 3
AND ABUTMENTS

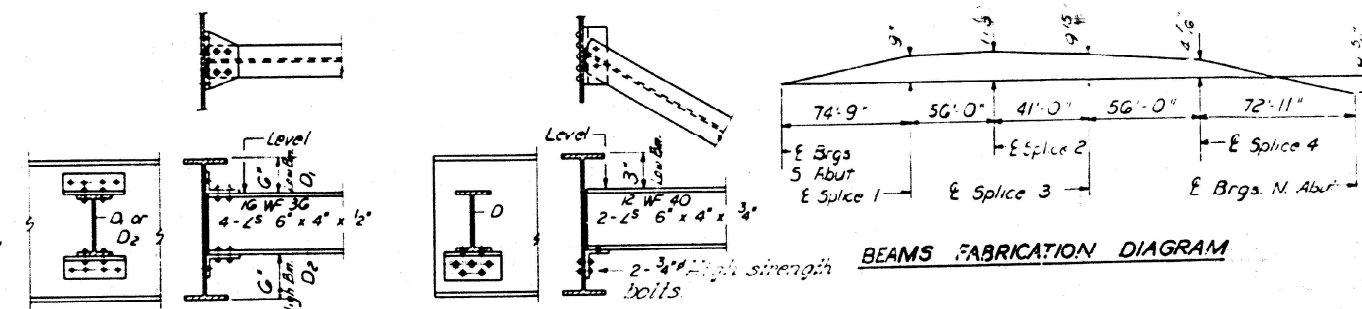

BEAMS FABRICATION DIAGRAM

DIAPHRAGM D₁ & D₂

DIAPHRAGM D

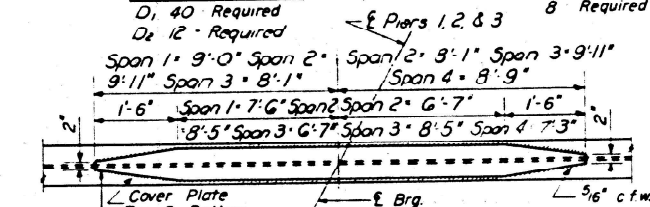

DETAIL OF COVER PLATES



DETAIL OF BEARING
AT PIER 2

DETAIL OF SPLICE

ELEVATION TOP OF BEAMS

	Bm 1	Bm 2	Bm 3	Bm 4	Bm 5
E Brgs. S. Abut.	815.34	815.52	815.62	815.43	815.23
E Pier 1	815.90	816.08	816.18	816.05	815.55
E Splice 1	816.09	816.27	816.37	816.28	816.04
E Splice 2	816.27	816.45	816.55	816.42	816.22
E Pier 2	816.22	816.40	816.50	816.31	816.17
E Splice 3	816.17	816.35	816.45	816.32	816.12
E Splice 4	815.71	815.89	815.99	815.86	815.66
E Pier 3	815.46	815.64	815.74	815.61	815.41
E Brgs. N. Abut.	814.62	814.80	814.90	814.77	814.57

TABLE OF "4" DIMENSIONS

	Bm 1	Bm 2	Bm 3	Bm 4	Bm 5
E Brgs. S. Abut.	3/8"	3/8"	0	0	0
E Pier 1	5/8"	3/8"	0	0	0
E Pier 2	5/8"	3/8"	0	0	0
E Pier 3	5/8"	3/8"	0	0	0
E Brgs. N. Abut.	5/8"	3/8"	0	0	0

STRUCTURAL STEEL DETAILS
F.A.I. RT. 74 SEC 57-18HB-1
MCLEAN COUNTY
STA. 1623 + 50.34

DESIGNED: *Chabon & Beck*
CHECKED: *A. K. E.*
DRAWN: *W. A. Sausman, Jr.*
APPROVED: *R. R. B...*

I-2-L Re-drawn 9-21-59


Revised 12-27-03 by J. Mullerix ~ Added 4" angle picture to SEC. @ ABUT. ~
~ Changed 2-3/4" Bolts to read high strength bolts in DIAPH. D. ~ Changed title ~

STATE OF ILLINOIS
DEPARTMENT OF TRANSPORTATION

AS-BUILT PLANS
LOCATION #4 S.N. 057-0114

SCALE: NONE SHEET 3 OF 3 SHEETS STA. TO STA.

F.A.I. RTE.	SECTION	COUNTY	TOTAL SHEETS	SHEET NO.
74/39	*	MCLEAN	50	25
*DS BRIDGE PAINTING 2022-1		CONTRACT NO. 70E74		
ILLINOIS		FED. AID PROJECT		

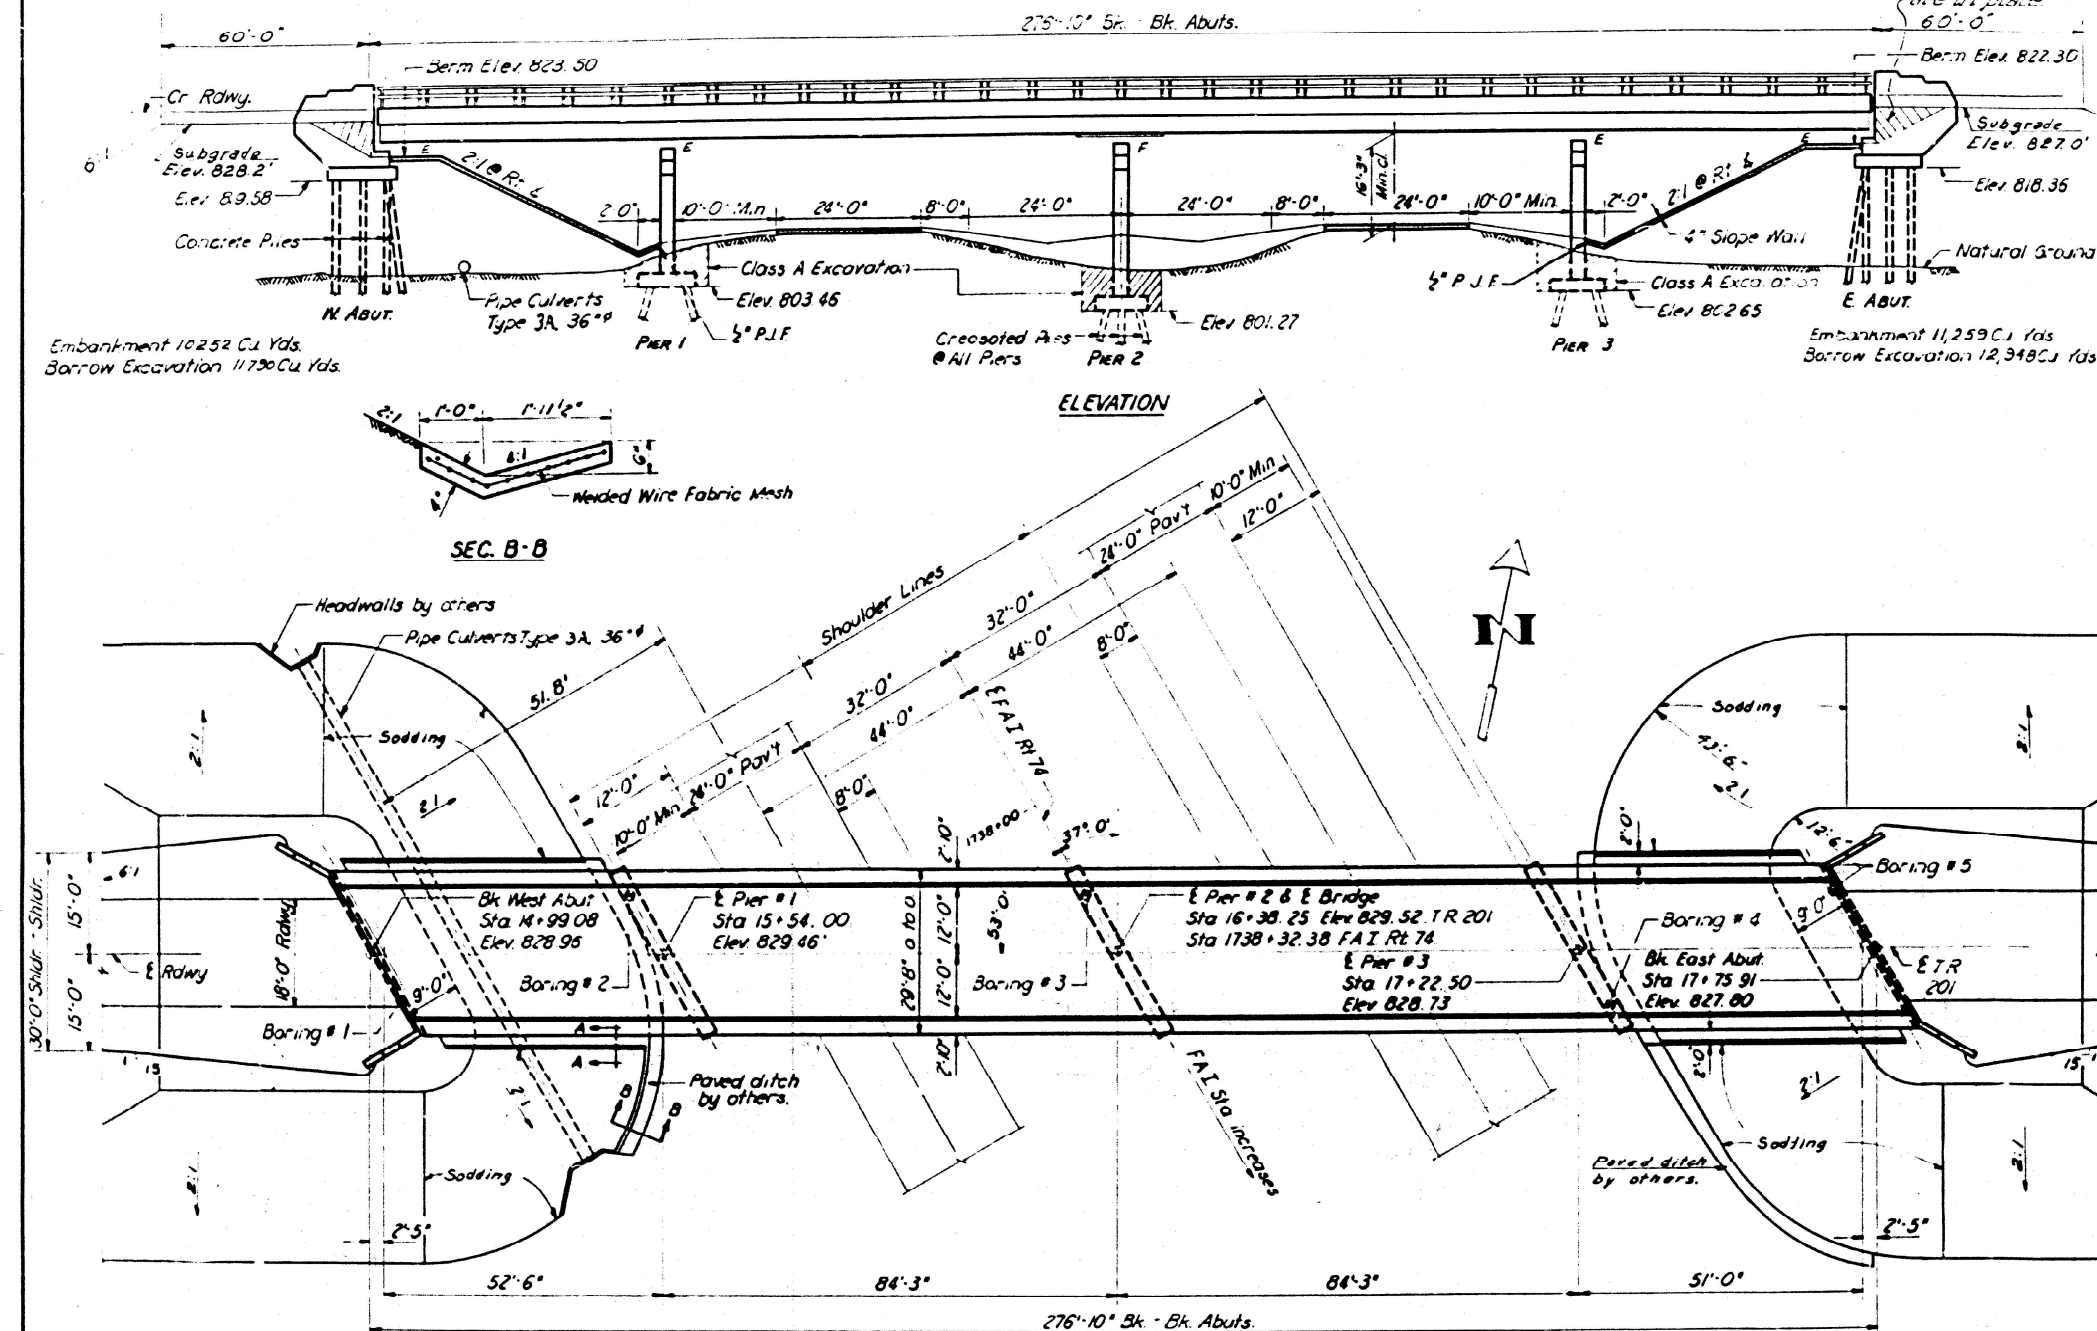

GENERAL NOTES

Class X Concrete shall be used throughout.
Coarse aggregate which is to be used in end posts must be free of chert, flint, ironstone, lignite, and soft sandstone.

The concrete floor slab shall be finished in accordance with Article 5119 of the Standard Specifications.

Slope wall shall be reinforced with welded wire fabric 6"x6" mesh #4 wires, weighing 58# per 100 sq. ft.

Rivers 4"x4" open holes 1/4" x 1/4" unless noted.

All Structural Steel shall conform to A S T M and A Specifications for Structural Steel.

Anchor bolts shall be set before riveting diaphragms over supports.

All bolsters, rockers, bearing plates, shim plates, lead plates, pintles, and anchor bolts shall be fabricated and set in accordance with Article 5115 of the Standard Specifications and are included in quantity of Structural Steel.

Estimated Weight = 7890 lbs

Except as otherwise specified on Structural Steel, shall receive one shop coat and one field coat of aluminum paint. See Articles 5115 and 5116 of the Standard Specifications.

All paint shall be furnished and applied by the Contractor.

Concrete piles through end abutment shall be driven in precored holes in accordance with Article 6031c of the Standard Specifications.

The Contractor shall drive one concrete test pile at West Abutment in a permanent location and one other test pile in the vicinity of Pier #2 as directed by the Engineer before working remainder of piers.

TOTAL BILL OF MATERIAL

Item	Unit	Superstr	Substr	Total
Borrow Excavation	Cu Yds		24,738	24,738
Class A Excavation for Structures	Cu Yds		120	120
Class X Concrete	Cu Yds	231.0	234.1	465.1
Structural Steel	Lbs	245,490		245,490
Furnishing & Erecting Metal Handrail	Lin Ft	568		568
Reinforcement Bars	Lbs	66,140	23,471	89,611
Crested Piles (Up to 20')	Lin Ft		1,120	1,120
Test Piles (Timber)	Each		1	1
Concrete Piles	Lin Ft		920	920
Test Piles (Concrete)	Each		1	1
Name Plates	Each		2	2
Slope Wall (4")	Sq Yds		500	500
Pipe Culverts Type 3A, 36"	Lin Ft		114	114
Protective Coat	Sq Yds			254

STA. 1738+32.38
BUILT 196 BY
STATE OF ILLINOIS
F.A.I. RT. 74 SEC. 57-18HB-6
FA PROJ. I-74-4(93)
LOADING H15-512

NAME PLATE LETTERING
See Standard 2113-1

GENERAL PLAN AND ELEVATION
PROJECT I-74-4.01123
T.R. 201 OVER
F.A.I RT 74 SEC 57-18 HB-2
M^C LEAN COUNTY
STA 1738 + 32.38

DESIGNED	<i>W. N. M.</i>
CHECKED	<i>T. M. Young</i>
DRAWN	<i>J. Putnam</i>
CHECKED	<i>T. M. Young</i>

SEPT 27 1962

EXAMINED *[Signature]*
SUPERVISOR OF BRIDGE AND TRAFFIC STRUCTURES


PASSED *[Signature]*
1. SPECIALTY OF BRIDGE

APPROVED *[Signature]*
R. B. B. B. B.


DESIGN STRESSES

tc = 1400 p.s.i. Super. and Sub.
 vc = 75 p.s.i. F+g.
 fs = 20,000 p.s.i. Reinf.
 fs = 18,000 p.s.i. Struct
 LL Def = $\frac{n \cdot 10}{1000}$
LOADING H15-S12-44

PLAN

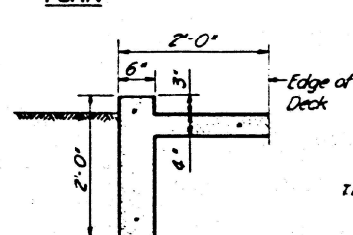


SECTION A-A

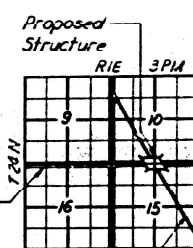

LOCATION PLAN

PROFILE F.A.I RT. 74

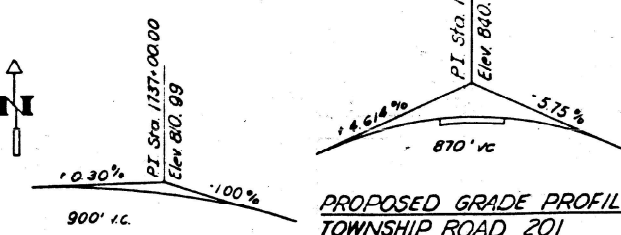


PROPOSED GRADE PROFILE
TOWNSHIP ROAD 201

Revised 1-2-68 by J.Mullenix - Removed 2 #2's @ top of abutts - Removed "Purrrishing & Fret" from Strud Steel quantities - Diamond A-508-A7 floor plate

USER NAME = eaglinga	DESIGNED -	REVISED -	STATE OF ILLINOIS DEPARTMENT OF TRANSPORTATION	AS-BUILT PLANS LOCATION #5 S.N. 057-0115			F.A.I. RTE.	SECTION	COUNTY	TOTAL SHEETS	SHEET NO.
	DRAWN -	REVISED -					74/39	*	MCLEAN	50	26
PLOT SCALE = 40,0000 ' / in.	CHECKED -	REVISED -		SCALE: NONE SHEET 1 OF 3 SHEETS STA. TO STA.			*D5 BRIDGE PAINTING 2022-1		CONTRACT NO. 70E74		
PLOT DATE = 9/29/2021	DATE -	REVISED -					ILLINOIS FED. AID PROJECT				

ROUTE NO.	SECTION	COUNTY	TOTAL SHEETS	SHEET NO.
SR 1 E 14	57-8 40-2	N. C. con	19	7
FED. ROAD DIST. NO. 1		ILLINOIS FED. AID PROJECT		

SHEET NO. 3
11 SHEETS

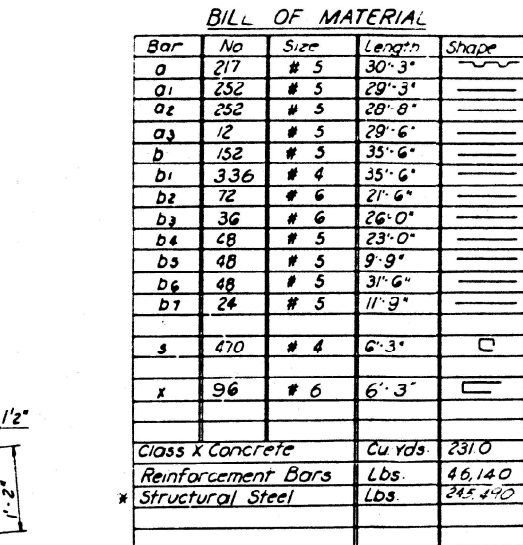

29'-8" a to o. Deck

2'-10" 24'-0" Rdwy. 2'-10"

2'-0" 10'-0" Circular Crown, 1" drop in 10 Ft. Slope 2" / ft.

Longitudinal bonded Construction Jt. Do not Edge.

Sym. about E Rdwy. Crown 1'-8"

b4 or b6 b5 or b7

6" Slab 1 1/2" cl. b a1 a2 b2 or b3 a

1" cl.

Typ. Spacing between beams 10'-0" 9'-4" b1 @ 7" cts. 10'-0"

3'-4" b7

2'-0" 4 Spaces @ 6'-5" = 25'-8" 2'-0"

TYPICAL CROSS SECTION OVER PIERS


1/2" Vent holes @ 12" cts. in 4'x4'x2' d.
Set on 13" gage line.

3/4" x 8" CR 1020 STL granular or
solid flux filled tapered shield,
automatically end welded
(alternate @ 1'-0" cts.)


SUPERSTRUCTURE
F.A.I. RT 74 SEC. 57-18HB-2
MCLEAN COUNTY
STA. 1738 + 32.38

STATE OF ILLINOIS
DEPARTMENT OF PUBLIC WORKS & BUILDINGS
DIVISION OF HIGHWAYS


PROJECT NO.	SECTION	COUNTY	SHEETS	SHEET NO.
1-2-R	57-18	McLean	19	8
DATE	BY	CHKD	APPD	
10/1/20	J. H. H.			

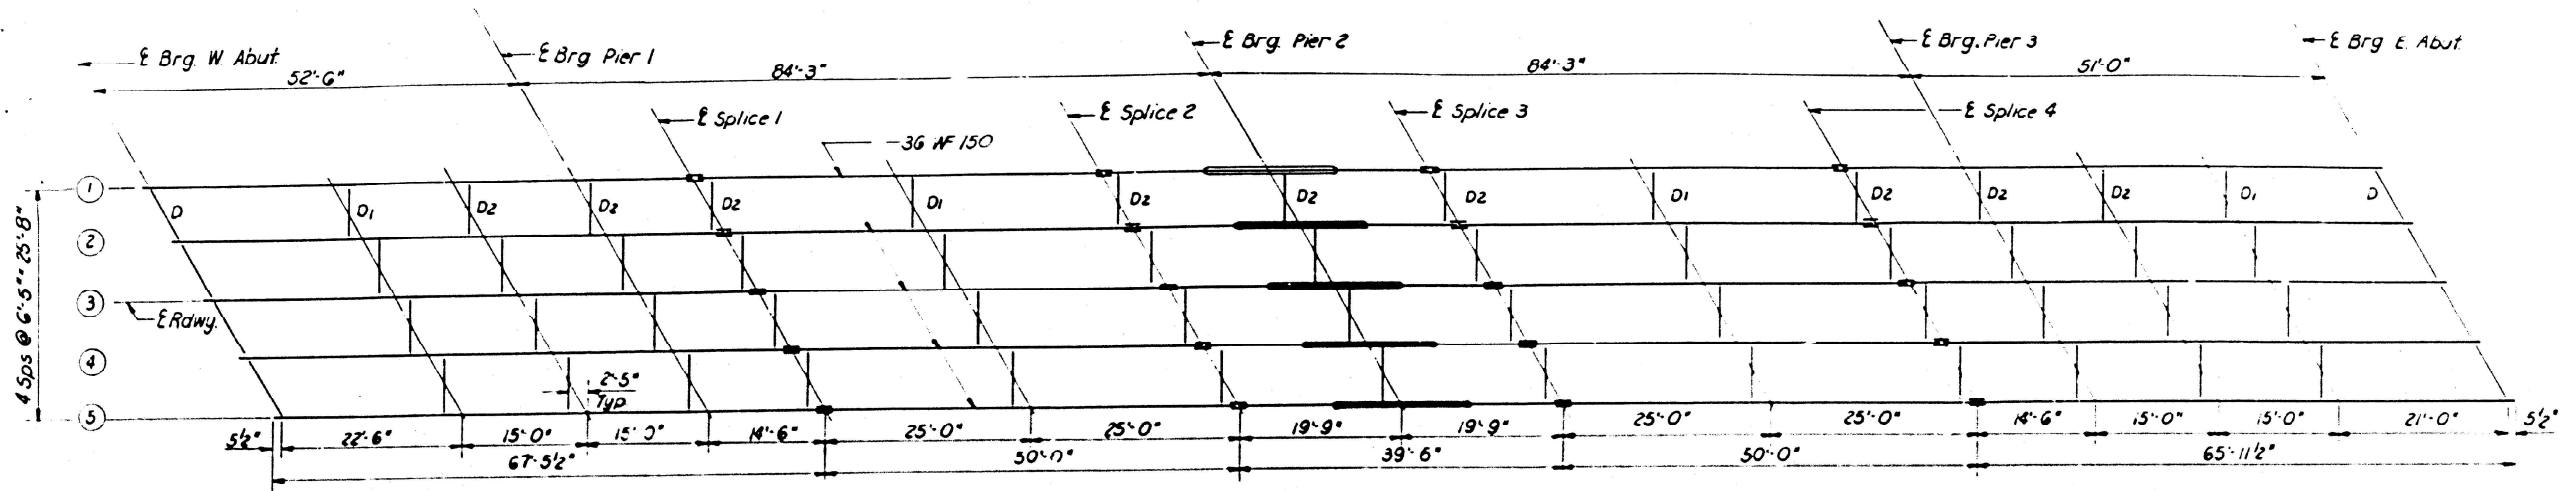

STRUCTURAL STEEL LAYOUT

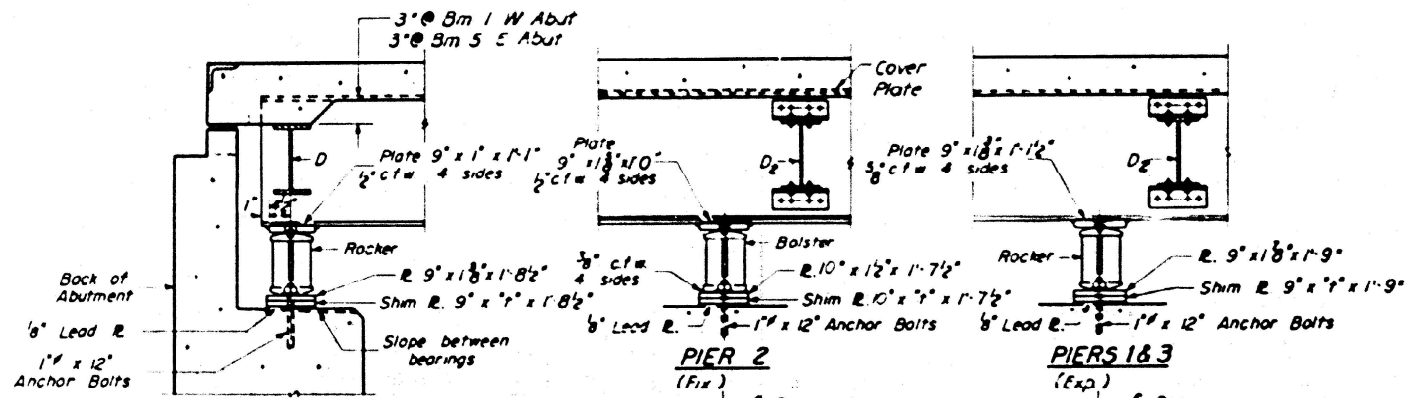


SECTION AT ABUTMENT

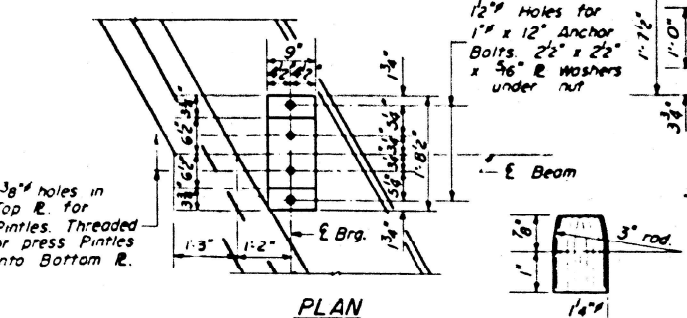

PLAN


DETAIL OF PINTLE

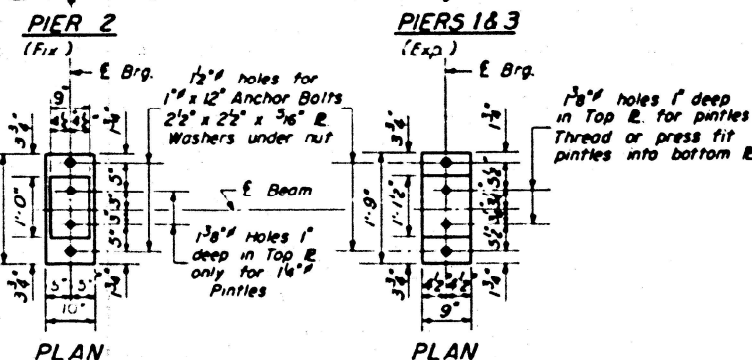


PLAN

PLAN


DETAIL OF BEARING
AT PIERS 1 & 3 & ABUTS.
20 Required

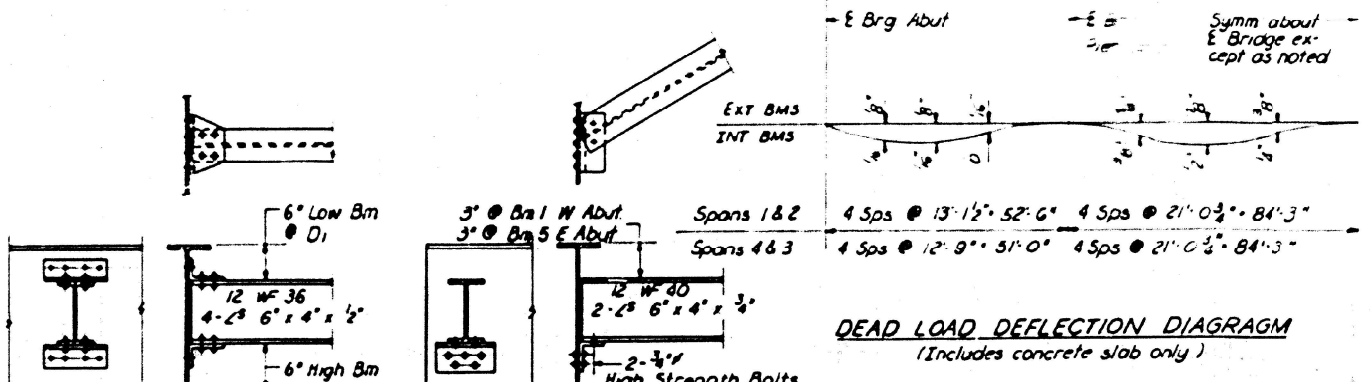


DEAD LOAD DEFLECTION DIAGRAM
(Includes concrete slab only)

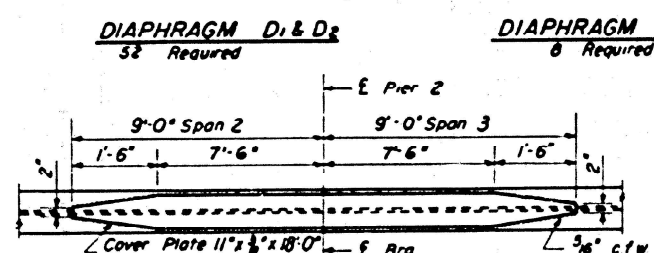

DETAIL OF COVER PLATES

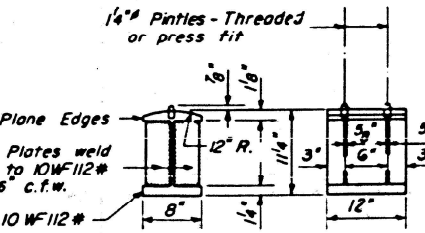

DETAIL OF BEARING
AT PIER 2
5 Required

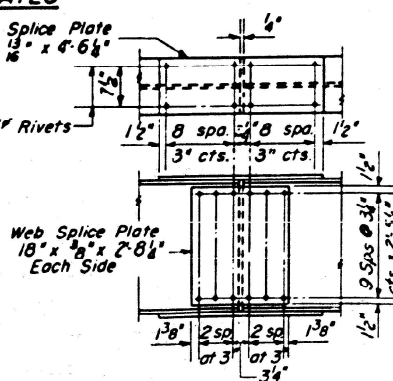

DETAIL OF SPLICE

ELEVATION TOP OF BEAMS									
Beam #	E Brg W Abut	E Pier 1	Splice # 1	Splice # 2	E Pier 2	Splice # 3	Splice # 4	E Pier 3	E Brg E Abut
1	828 21	828 66	828 78	828 89	828 83	828 77	828 34	828 13	827 38
2	828 22	828 67	828 79	828 90	828 84	828 78	828 35	828 14	827 39
3	828 46	828 84	828 95	829 01	828 93	828 84	828 36	828 13	827 32
4	828 49	828 81	828 90	828 90	828 80	828 69	828 15	827 90	827 04
5	828 44	828 76	828 85	828 85	828 75	828 64	828 10	827 85	826 92

TABLE OF "T" DIMENSIONS

Position	Bm 1	Bm 2	Bm 3	Bm 4	Bm 5
E Brg W Abut	0	18"	1"	18"	0
Pier 1	0	18"	18"	18"	0
Pier 2	0	18"	18"	18"	0
Pier 3	0	18"	0	18"	0
E Brg E Abut	34"	18"	0	18"	0

STRUCTURAL STEEL DETAILS
F.A.I. RT. 74 SEC. 57-18HB-2
MCLEAN COUNTY
STA. 1738+32.38

DESIGNED: [Signature]
CHECKED: [Signature]
DRAWN: W.A. Sousamon
CHECKED: [Signature]
EXAMINED: [Signature]
PASSED: [Signature]
APPROVED: [Signature]



I-2-R Re-drawn 9-23-59

USER NAME	DESIGNED	REVIS
REVISION	DRAWN	REVIS
PLOT SCALE	CHECKED	REVIS
PLOT DATE	DATE	REVIS

STATE OF ILLINOIS
DEPARTMENT OF TRANSPORTATION








AS-BUILT PLANS			
LOCATION #5 S.N. 057-0115			
SCALE: NONE	SHEET 3	OF 3	SHEETS
STA.	TO STA.		

F.A.I. RTE.	SECTION	COUNTY	TOTAL SHEETS	SHEET NO.
74/39	*	MCLEAN	50	28
*D5 BRIDGE PAINTING 2022-1		CONTRACT NO. 70E74		
	ILLINOIS	FED. AID PROJECT		

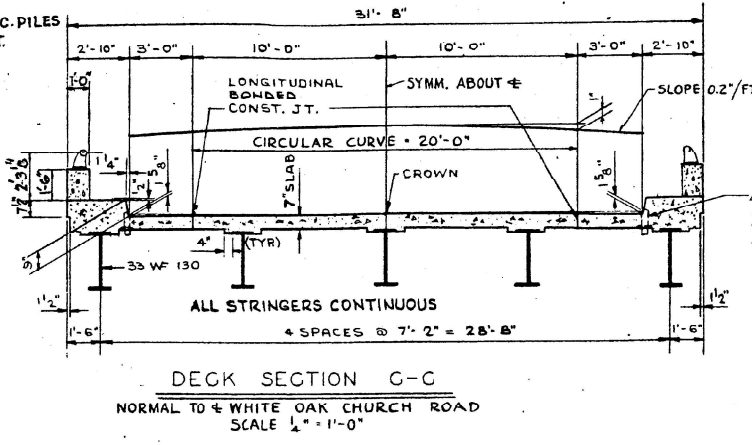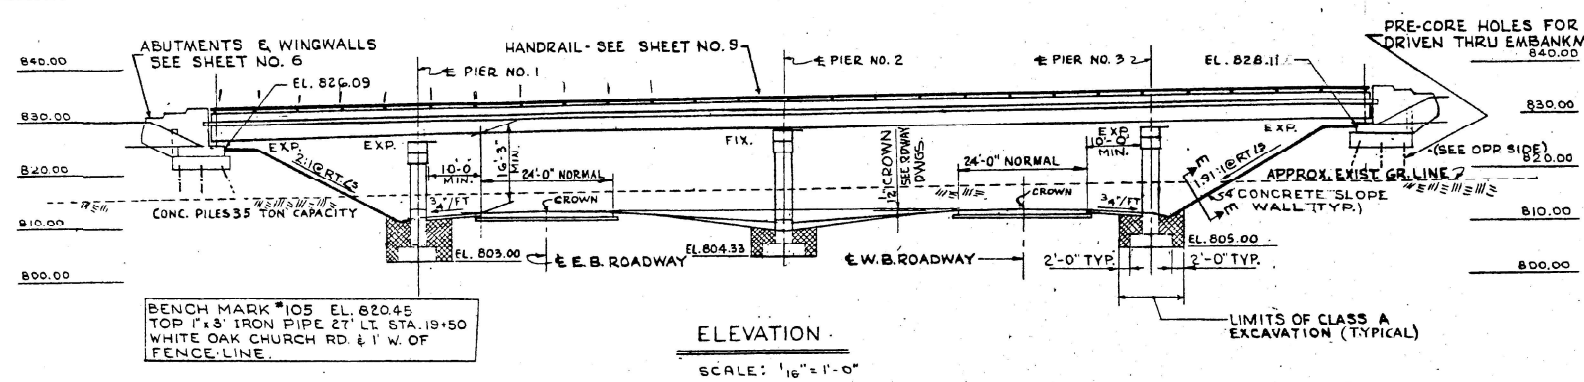


ROUTE NO.	SECTION	COUNTY	TOTAL SHEETS	SHEET NO.
F.A.I. 74	57-1949	MCLEAN	30	7
FED. ROAD DIST. NO.	ILLINOIS	FED. AID PROJECT	1-7A-4 (1702)	

SHEET NO. 1
10 SHEETS

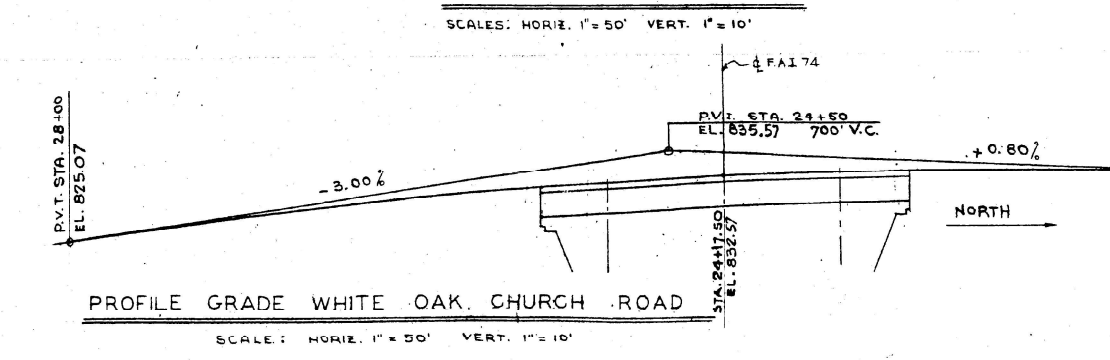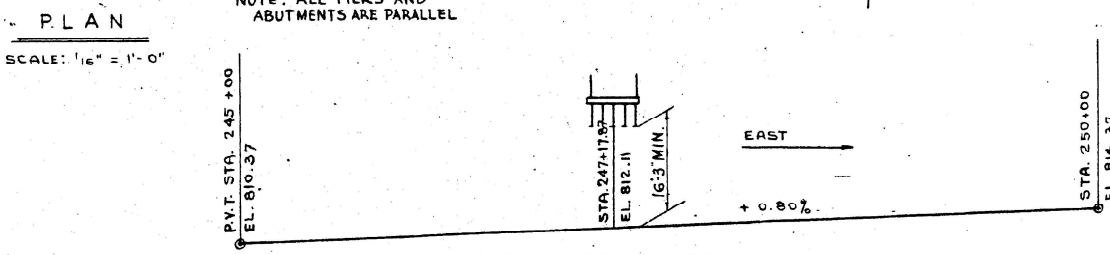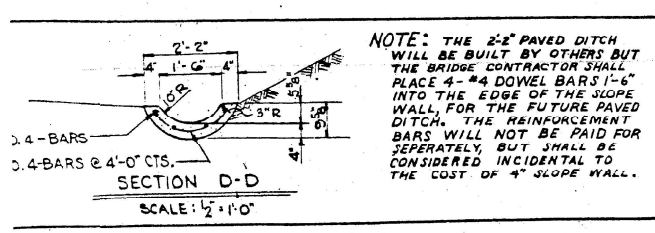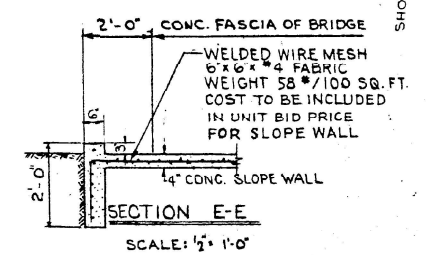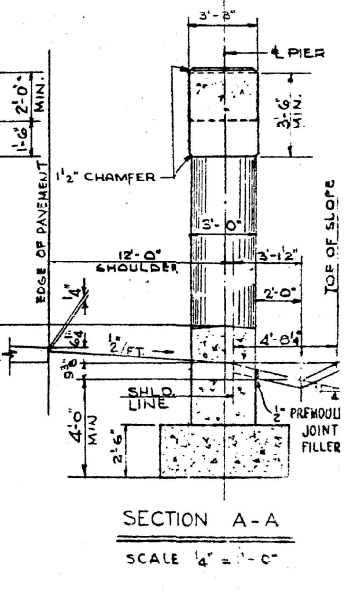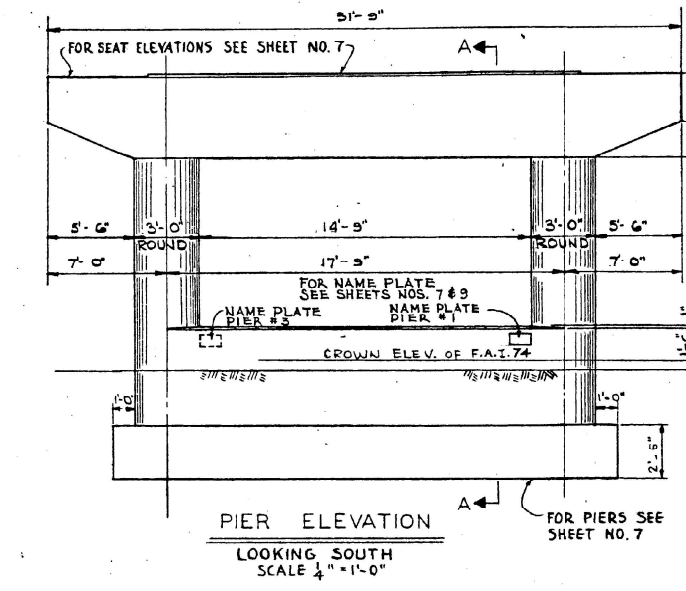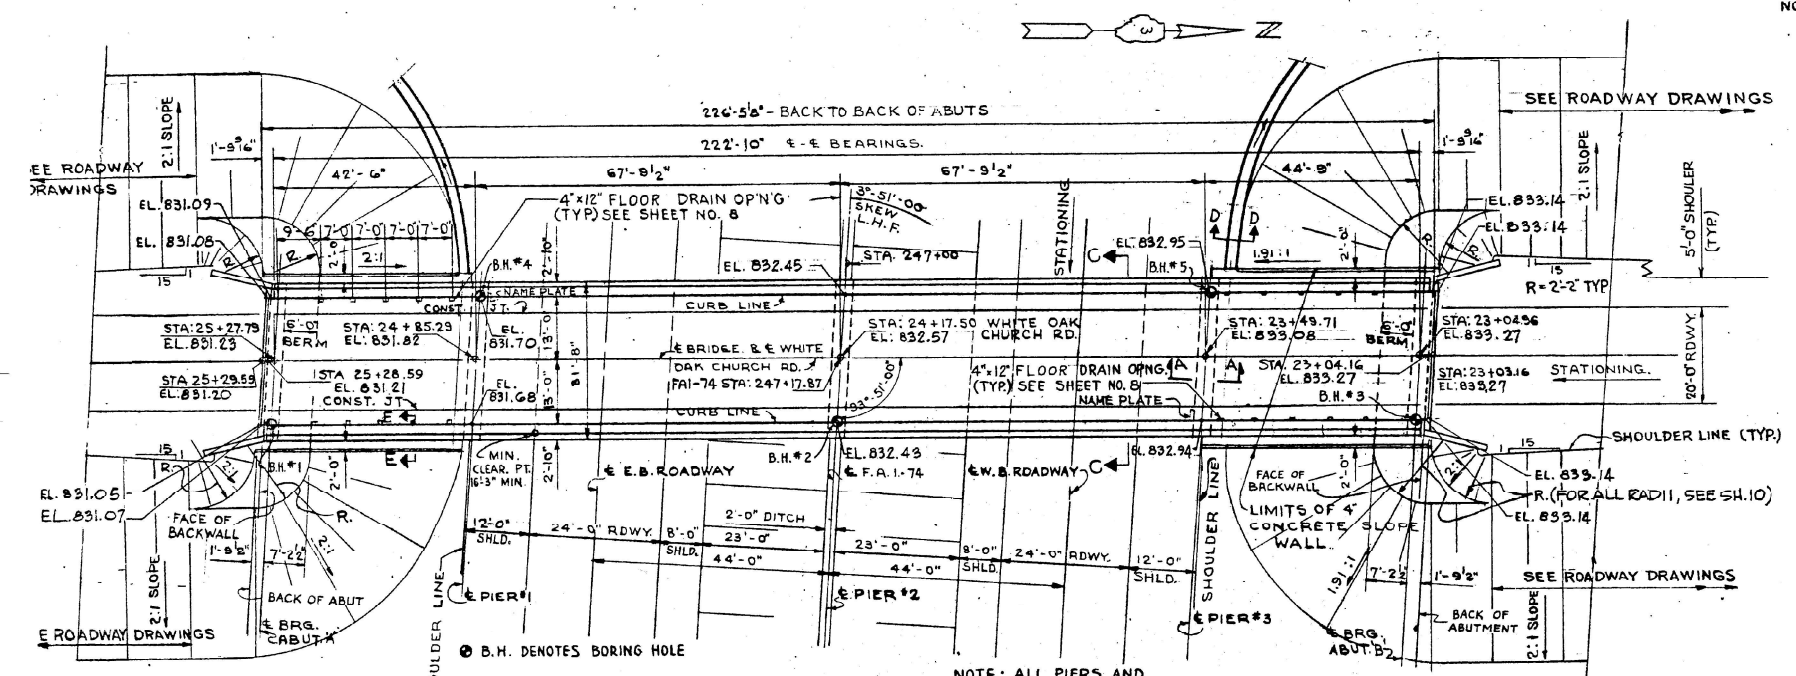

SOIL PRESSURE FOR PIERS ONLY	
EXISTING SOIL PRESSURE	4300 R.S.F.
ALLOWABLE MAX. AVG. SOIL PRESSURE	6000 R.S.F.
EXISTING TOE PRESSURE	6350 R.S.F.
ALLOWABLE TOE PRESSURE	7800 R.S.F.

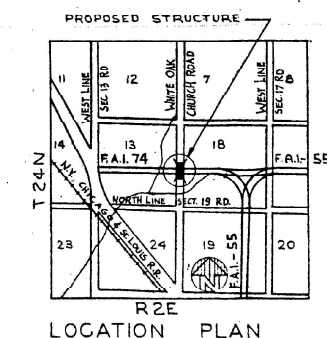

DESIGN LOADING: A.A.S.H.O. H15-S12

GENERAL PLAN & ELEVATION
F.A.I. 74 SECTION 57-1949
F.A.I. 74 UNDER WHITE OAK CHURCH ROAD
MCLEAN COUNTY
STATION 247+17.87

HE LEUW, CATHER & CO., ENGINEERS
DESIGNED BY: R. MEIER & H. HAKIMIAN
DRAWN BY: H. HAKIMIAN, S. LEVY
CHECKED: R. MEIER, J. GANZ
IN CHARGE: L. N. RIAN, A. F. MOREL

STATE OF ILLINOIS
DEPARTMENT OF TRANSPORTATION

AS-BUILT PLANS
LOCATION #6 S.N. 057-0105

F.A.I. RTE.	SECTION	COUNTY	TOTAL SHEETS	SHEET NO.
74/39	*	MCLEAN	50	29
*DS BRIDGE PAINTING 2022-1		CONTRACT NO. 70E74		
ILLINOIS		FED. AID PROJECT		

USER NAME = eaglinga	DESIGNED -	REVISED -
PLOT SCALE = 40,0000 * / in.	DRAWN -	REVISED -
PLOT DATE = 9/29/2021	CHECKED -	REVISED -
	DATE -	REVISED -

SCALE: NONE SHEET 1 OF 4 SHEETS STA. TO STA.

NOTE: ENCIRCLED FIGURES INDICATE DEFLECTION DUE TO WEIGHT OF CONCRETE SLAB, CURB AND PARAPET ONLY.

DEFLECTION IS GIVEN AT MIDSPAN AND QUARTER POINTS FOR END SPANS

MIDPOINT AND SIXTH POINTS FOR CENTER SPANS

SAME DEFLECTION FOR BOTH FASCIA & INTERIOR STRINGERS.


TOTAL ANTICIPATED DEAD LOAD

DEFLECTION



FRAMING PLAN


SCALE $\frac{3}{32}'' = 1'-0''$

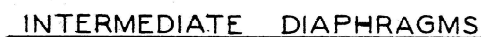


SCALE: $\frac{5}{8}'' = 1'-0''$



SCALE $\frac{3}{8}" = 1'-0"$

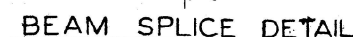


SCALE: $\frac{3}{4}" = 1'-0"$

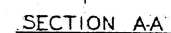

INTERMEDIATE DIAPHRAGM DETAILS

 SCALE: $\frac{3}{4}'' = 1'-0''$



END DIAPHRAGM DETAILS

SCALE: $\frac{3}{4}" = 1'-0"$



SCALE: $\frac{3}{4}" = 1'-0"$



ELEVATIONS AT TOP OF STRINGERS AT:										
STR. NO.	ABUT. A	PIER 1	SPICE 1	SPICE 2	PIER 2	SPICE 3	SPICE 4	PIER 3	ABUT. B	
1	830.503	831.045	831.196	831.649	831.795	831.835	832.292	832.300	832.550	
2	592	134	285	738	884	832.024	321	389	639	
3	634	176	327	780	926	1.066	363	431	681	
4	584	126	277	730	876	1.016	313	381	631	
5	486	28	179	632	778	831.918	215	283	533	

BILL OF MATERIAL

ITEM	UNIT	QUANTITY
FURNISHING AND ERECTING STRUCTURAL STEEL	POUND	174,630

DECK FRAMING PLAN AND DETAIL

E.A. 1. 74 SECTION 57- HB

F.A.I. 74 UNDER WHITE OAK CHURCH RM

MCLEAN COUNTY

STATION 24747.87


SCALE: AS NOTED DATE:

**STATE OF ILLINOIS
DEPARTMENT OF TRANSPORTATION**


AS-BUILT PLANS
LOCATION #6 S.N. 057-0105

SCALE: NONE	SHEET 2 OF 4 SHEETS	STA. TO STA.
-------------	---------------------	--------------


F.A.I. RTE.	SECTION	COUNTY	TOTAL SHEETS	SHEET NO.
74/39	*	MCLEAN	50	30
*D5 BRIDGE PAINTING 2022-1		CONTRACT NO. 70E74		
ILLINOIS FED. AID PROJECT				

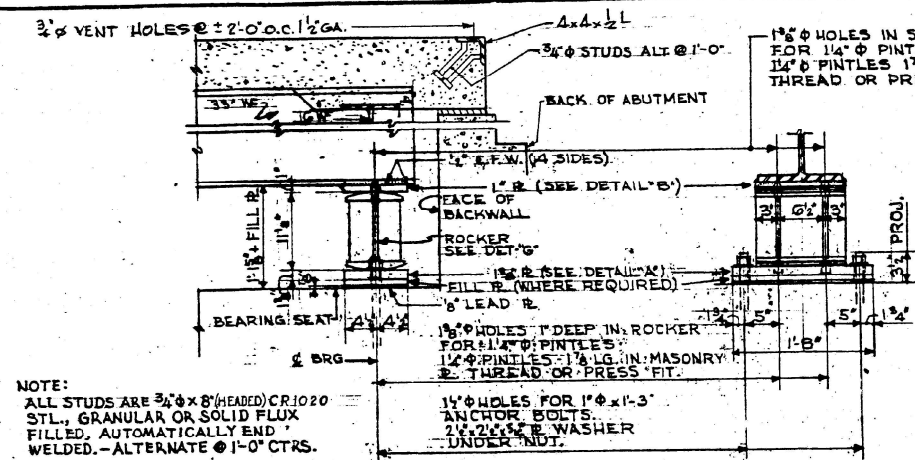


SECTION A-A
EXPANSION BEARING NO. 1
SCALE: 1" = 1'-0"
10 REQ'D @ 260 LBS.

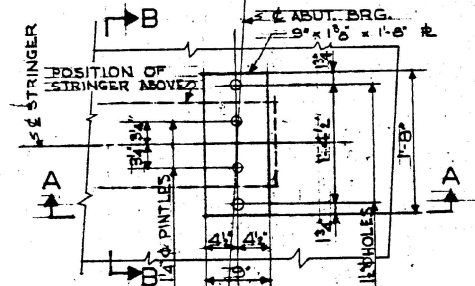


DETAIL A
MASONRY PLATE
SCALE: 1" = 1'-0"

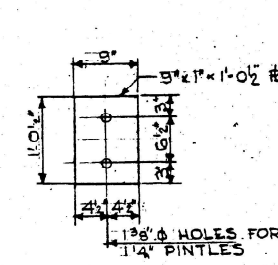


DETAIL B
SOLE PLATE
SCALE: 1" = 1'-0"

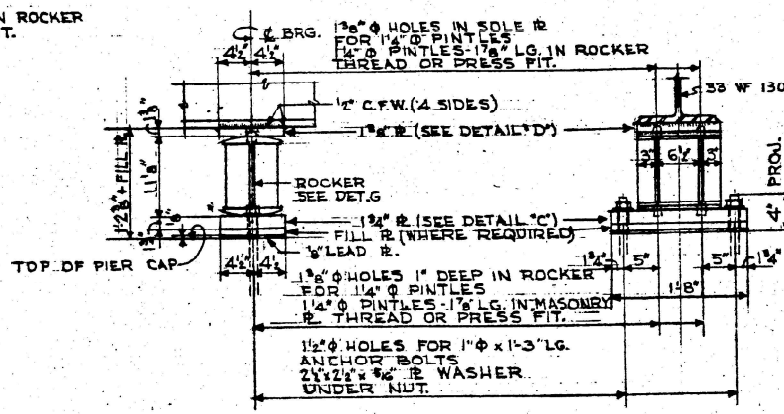


SECTION C-C
EXPANSION BEARING NO. 2
SCALE: 1" = 1'-0"
10 REQ'D @ 299 LBS.

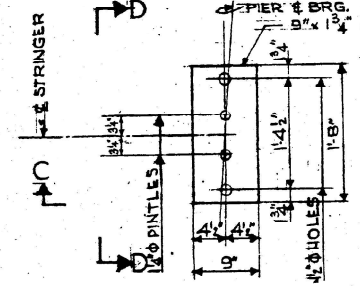


DETAIL C
MASONRY PLATE
SCALE: 1" = 1'-0"

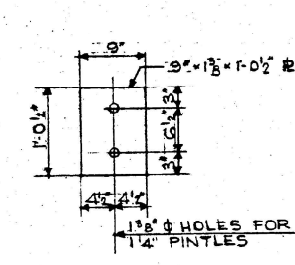


DETAIL D
SOLE PLATE
SCALE: 1" = 1'-0"

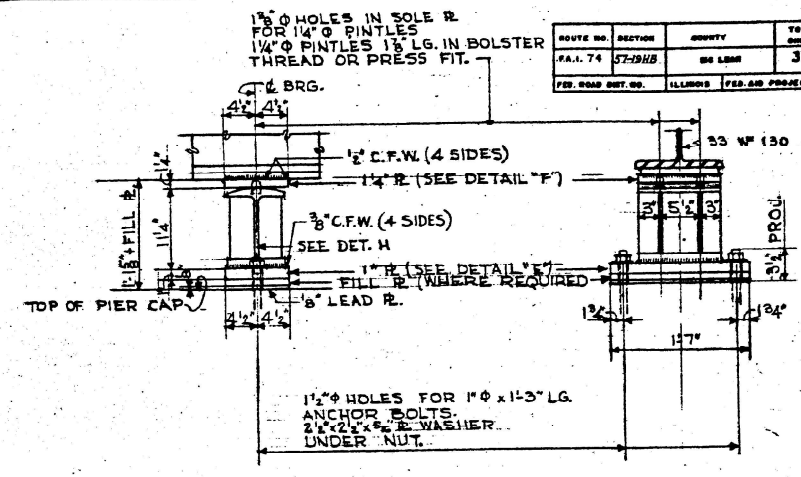


SECTION E-E
FIXED BEARING NO. 3
SCALE: 1" = 1'-0"
5 REQ'D @ 240 LBS.

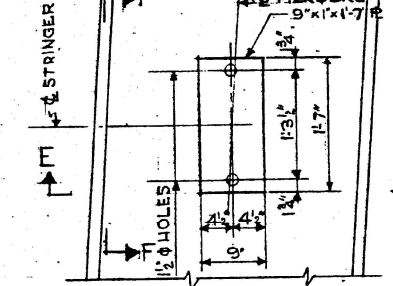


DETAIL E
MASONRY PLATE
SCALE: 1" = 1'-0"

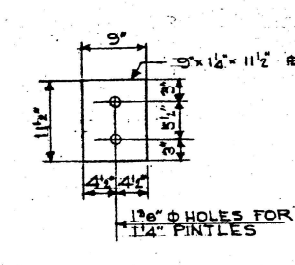


DETAIL F
SOLE PLATE
SCALE: 1" = 1'-0"

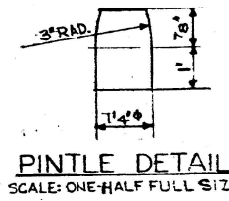

EXPANSION GUARD NOTES:
SEE GENERAL NOTES FOR STRUCTURAL STEEL. SHEET NO. 3
EXPANSION JOINT ASSEMBLIES SHALL BE FABRICATED AND
ERECTED TO CONFORM TO THE ROADWAY CROWN AND SLOPE
OF GRADE AT THE JOINT. THEY SHALL BE ASSEMBLED IN
THE SHOP FOR INSPECTION. ALL PARTS OF JOINT ASSEMBLY
INCLUDING STUD ANCHORS, SHALL BE INCLUDED IN THE
WEIGHT OF STRUCTURAL STEEL.

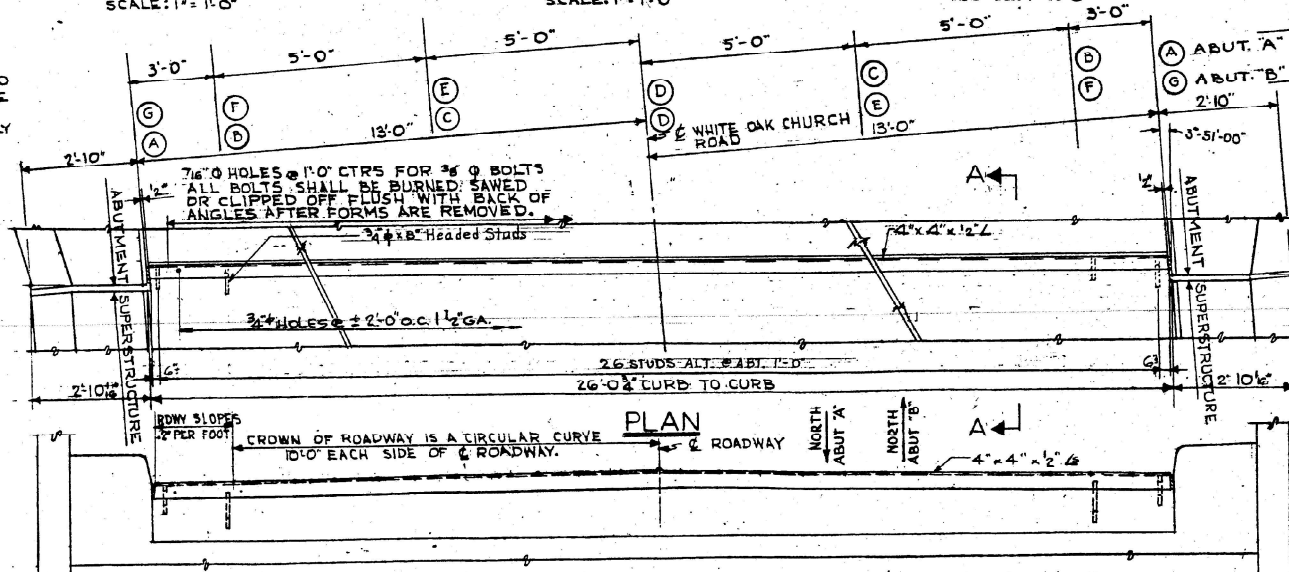

PLAN
DETAIL OF EXPANSION GUARD
SCALE: 1" = 1'-0"

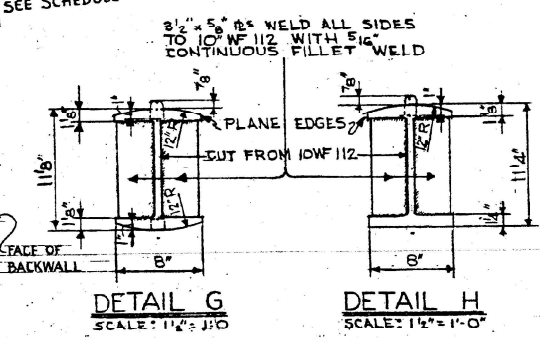

DETAIL G
SCALE: 1/4" = 1'-0"
DETAIL H
SCALE: 1/4" = 1'-0"

BILL OF MATERIAL

ITEM	UNIT	QUANTITY
FURNISHING & ERECTING STRUCTURAL STEEL	POUND	7,850

TABLE OF TOP OF SLAB ELEVATIONS AT ABUTMENTS

FACE OF BACKWALL	A	B	C	D	E	F	G
ABUT. A	831.093	831.140	831.197	831.213	831.187	831.119	831.066
ABUT. B	833.141	833.191	833.252	833.272	833.250	833.186	833.136

NOTE:
WEIGHTS OF BEARINGS SHOWN DO NOT
INCLUDE WEIGHTS OF FILL PLATES

FILL PLATES

STRINGER ROW	1	2	3	4	5
ABUT. A	1/4	1/8	5/8	-	-
PIER NO 1	1/4	1/8	5/8	-	-
PIER NO 2	3/16	-	9/16	-	-
PIER NO 3	1/4	1/8	5/8	-	-
ABUT. B	3/16	-	1/2	-	-

NOTE: CHART ABOVE INDICATES
THICKNESS OF FILL PLATES. LENGTH
AND WIDTH SAME AS MASONRY R.
LOCATION OF 1/2" ANCHOR BOLT HOLE
SAME AS IN MASONRY PLATE. SEE
FRAMING PLAN FOR STRINGER DET.

BEARINGS & JOINTS
F.A.I. 74 SECTION 57-19HB
F.A.I. 74 UNDER WHITE OAK CHURCH ROAD
MCLEAN COUNTY
STATION 247 + 17.87
SCALE: AS NOTED DATE:

DE LEUW, CATHEN & CO., ENGINEERS
DESIGNED BY: J. GANZ
DRAWN BY: J. MUNENO
CHECKED: R. G. MEIER & J. SEIFERT
IN CHARGE: L. M. RIAN & A. F. MOREL

USER NAME	= eaglinga	DESIGNED	-	REVISED	-
PLOT SCALE	= 40,0000 * / in.	DRAWN	-	REVISED	-
PLOT DATE	= 9/29/2021	CHECKED	-	REVISED	-
		DATE	-	REVISED	-

STATE OF ILLINOIS
DEPARTMENT OF TRANSPORTATION

AS-BUILT PLANS
LOCATION #6 S.N. 057-0105

SCALE: NONE SHEET 3 OF 4 SHEETS STA. TO STA.

F.A.I. RTE.	SECTION	COUNTY	TOTAL SHEETS	SHEET NO.
74/39	*	MCLEAN	50	31
*DS BRIDGE PAINTING 2022-1		CONTRACT NO. 70E74		
ILLINOIS		FED. AID PROJECT		




F.A.I. RTE.	SECTION	COUNTY	TOTAL SHEETS	SHEET NO.
74/39	*	MCLEAN	50	32
+D5 BRIDGE PAINTING 2022-1		CONTRACT NO. 70E74		
	ILLINOIS	FED. AID PROJECT		

ROUTE NO.	SECTION	COUNTY	TOTAL SHEETS	SHEET NO.
FAP 412	57-3HB-1	McLEAN	315	144
STA.		TO STA.		
F. HW. A. REG. NO.	ILLINOIS	PROJECT		
SHEET 1 OF 21				


Diagram illustrating the cross-section of a bridge structure, showing various components and dimensions:

- Top Left:** 60' CONSTRUCTION BERM (TYR EA. END), END OF APPR. SLAB.
- Top Right:** END OF APPR. SLAB, $R = 2864.7$, $T = 832.50$, $L = 1620.3'$, $S.E. = TRANS.$, $START STA. = 5$, $END STA. = 3$, $PC STA. = 34$, $PT STA. = 35$.
- Left Side:** TRAFFIC BARRIER TERMINAL TYPE G STD. 2341 (TYR), $EL. 762.09 (MIN.) (ABUT. A)$, $EL. 762.97 (MIN.) (ABUT. C)$.
- Bridge Deck:** 45" HEB I.B GIRDER (COMPOSITE), 36'-1" ± C.R.T. L'S, 14'-0", 18'-0", 14'-0", 32'-0" ± C.R.T. L'S.
- Median:** 18'-0" MEDIAN.
- Right Side:** BOT / CAP, $EL. 759.03 (MIN.) (ABUT. B)$, $EL. 760.21 (MIN.) (ABUT. D)$, CONCRETE PILES (TYR), NATURAL GROUND, BOT. FTG., $EL. 748.50 (ABUT. B)$, $EL. 750.00 (ABUT. D)$.
- Bottom Left:** BOT. / FTG., $EL. 751.00 (ABUT. A)$, $EL. 752.50 (ABUT. C)$.
- Bottom Center:** 2'10" C.R.T. 4 (TYR), P.G., CONCRETE PILES (TYR).
- Bottom Right:** NATURAL GROUND, BOT. FTG., $EL. 748.50 (ABUT. B)$, $EL. 750.00 (ABUT. D)$.


ELEVATION

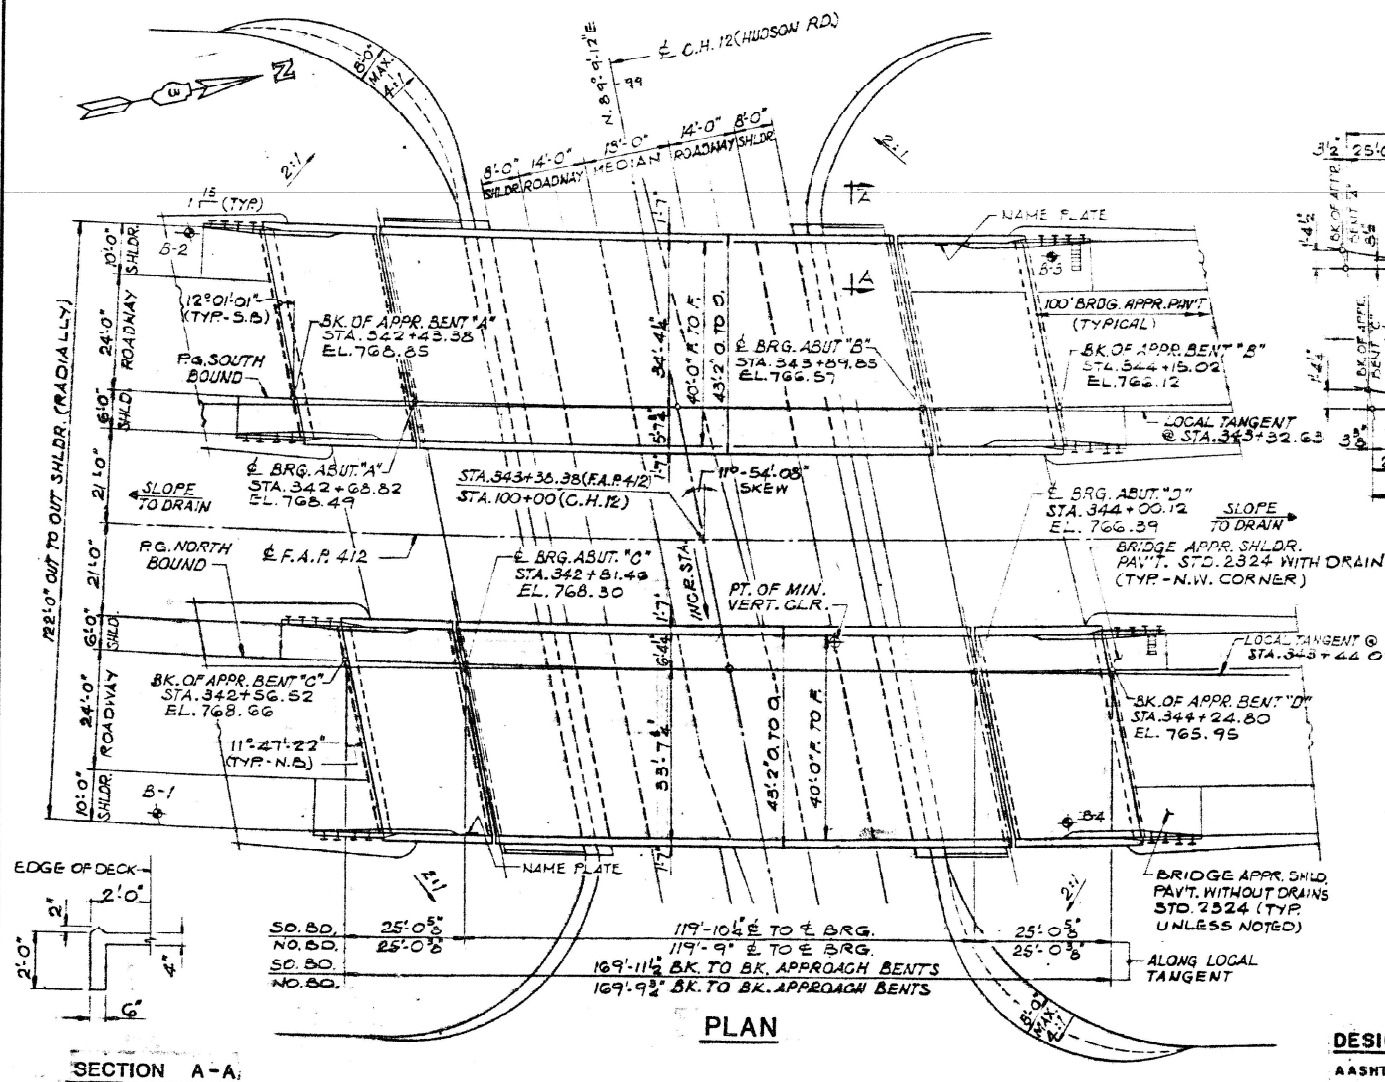


OFFSET SKETCH

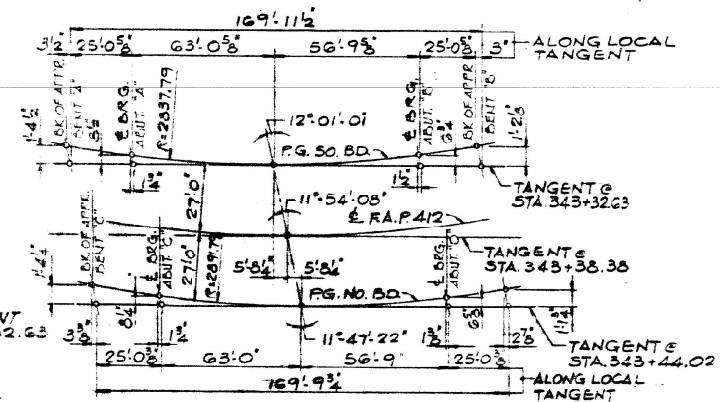


HUDSON RD. PROFILE

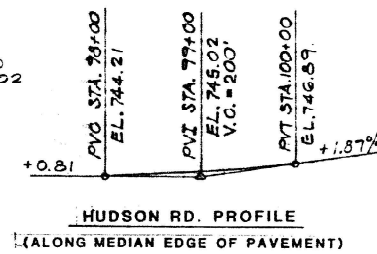

F.A.P. 412 PROFILE

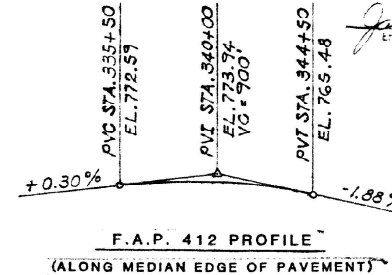

LOCATION PLAN
3RD P.M.

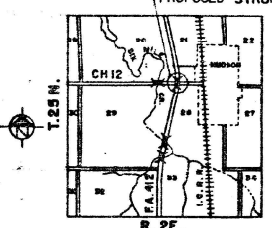

LOADING HS20-44

ALLOW 25 #/SQ. FOR FUTURE WEARING SURFACE.

DESIGN STRESSES

F_c = 3,500 PSI
F_y = 60,000 PSI
F_y = 50,000 (STRUCTURAL STEEL
AASHTO M223 GR.50)
F_y = 36,000 PSI (AASHTO M183)

ab **alfred benesch & company**
CONSULTING ENGINEERS
232 NORTH MICHIGAN AVENUE, CHICAGO, ILLINOIS 60601
JOB NO. 2203

DESIGN SPECIFICATIONS

AASHTO (1983) AND 1964, 1985 INTERIMS

GENERAL PLAN

F.A.P. ROUTE 412 OVER CH.12
F.A.P.ROUTE 412-SEC. 57-3H
McLEAN COUNTY
STATION 343+38.38 (F.A.P.4
STRUCTURE NUMBER 057-0205
057-0204

USER NAME = eaglinga	DESIGNED -	REVISED -
	DRAWN -	REVISED -
PLOT SCALE = 40,0000 ' / in.	CHECKED -	REVISED -
PLOT DATE = 9/29/2021	DATE -	REVISED -



**STATE OF ILLINOIS
DEPARTMENT OF TRANSPORTATION**

AS-BUILT PLANS
LOCATION #7 & #8 S.N. 057-0205 & S.N. 057-0206

SCALE: NONE	SHEET 1 OF 4 SHEETS	STA. TO STA.
-------------	---------------------	--------------

F.A.I. RTE.	SECTION	COUNTY	TOTAL SHEETS	SHEET NO.
74/39	*	MCLEAN	50	33
#D5 BRIDGE PAINTING 2022-1		CONTRACT NO. 70E74		
ILLINOIS		FED. AID PROJECT		

```
MODEL: $MODEL.NAMES
FILE NAME: osw://ilidot-pw.bentley.com:FW/IDOT/Documents/IDOT_Offices/District_5/Projects/D570E74/CADData/CADsheets/D570E74-sht-A4-Bulldgs.dgn
```

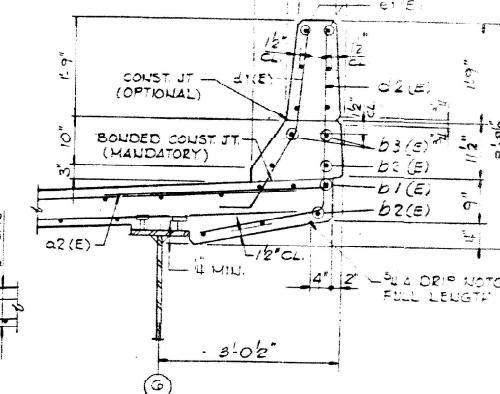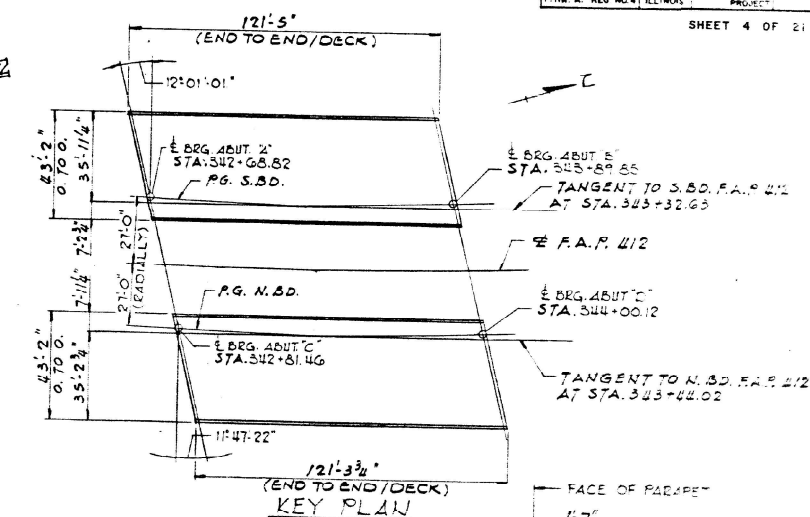SHEET 4 OF 21

MIN. BAR LAPS
#5 BAR = 1'-9"






NOTE:
FOR DETAILS NOT SHOWN OR NOTED
SEE EAST PARAPET DETAIL.

F.A.P. ROUTE 412 OVER CH.12
F.A.P. ROUTE 412-SEC. 57-3HB-1
McLEAN COUNTY
STATION 343+38.38 (F.A.P. 412)
STRUCTURE NUMBER 057-0205 (S.B.)
057-0206 (M.B.)


F.A.I. RTE.	SECTION	COUNTY	TOTAL SHEETS	SHEET NO.
74/39	*	MCLEAN	50	34
D5 BRIDGE PAINTING 2022-1		CONTRACT NO. 70E74		
		ILLINOIS FED. AID PROJECT		

USER NAME = eaglinga	DESIGNED -	REVISED -
	DRAWN -	REVISED -
PLOT SCALE = 40,0000 ' / in.	CHECKED -	REVISED -
PLOT DATE = 9/29/2021	DATE -	REVISED -

ROUTE NO.	SECTION	COUNTY	TOTAL SHEETS	SHEET NO.
7	42-57-3HB-1	MCLEAN	50	35
STA.		TO STA.		
343+38.38		343+38.38		
F 408 A REG NO 4		ILLINOIS		PROJECT
SHEET 9 OF 21				

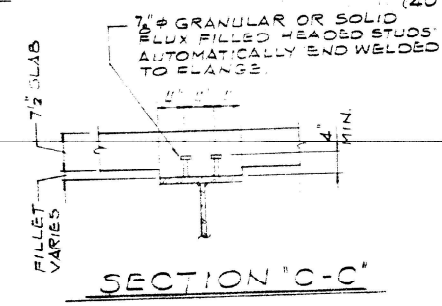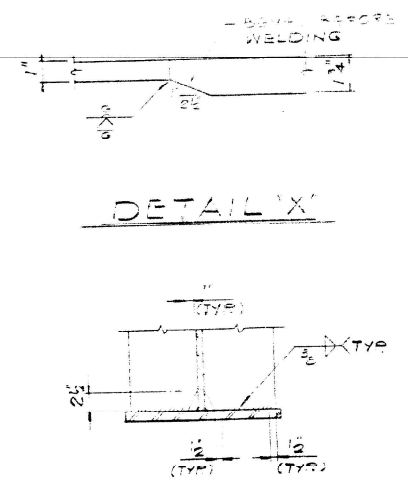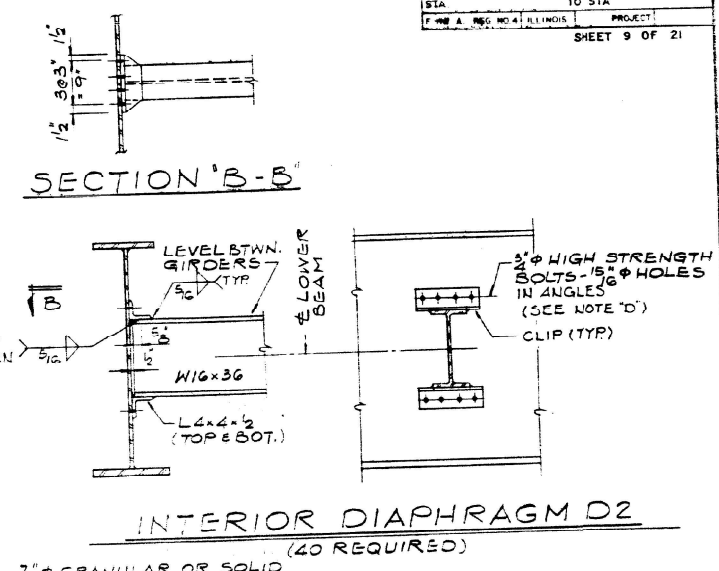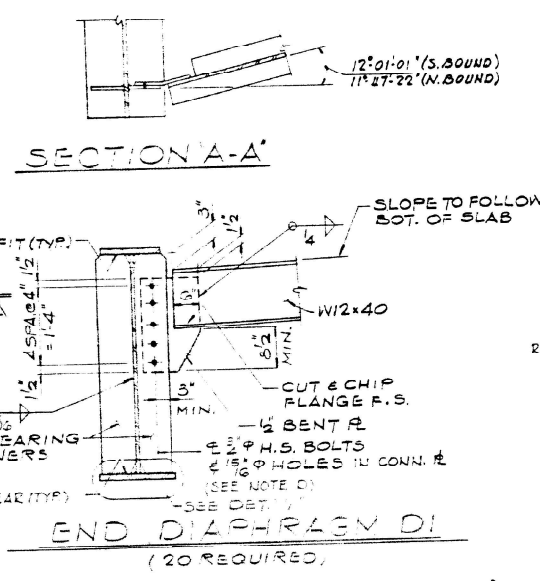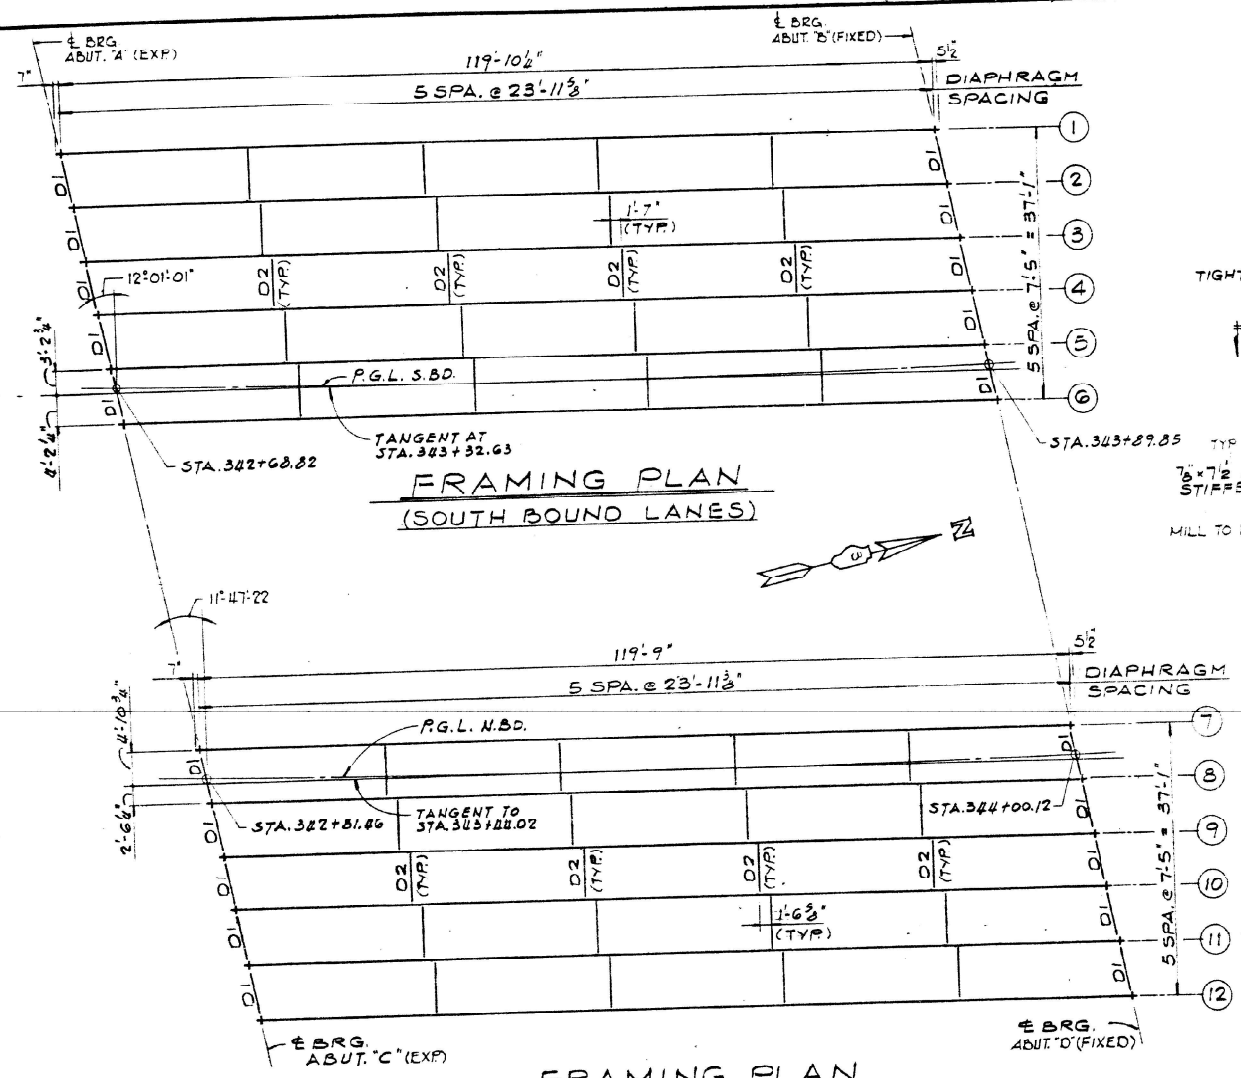

NOTE:
ALL DIAPHRAGMS AND CONNECTION PLATES AND ANGLES SHALL BE AASHTO M183.

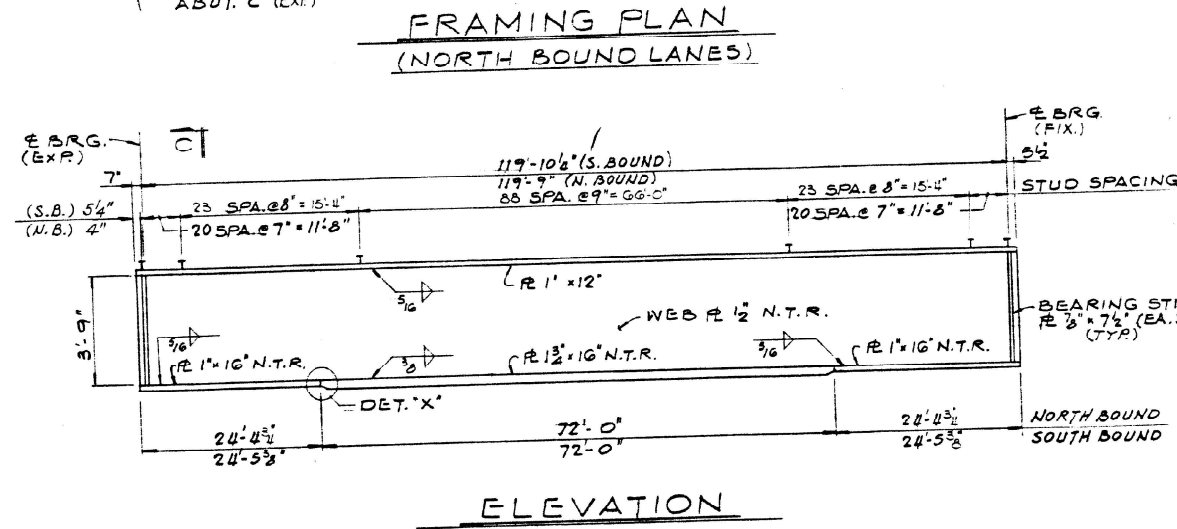

- NOTES:
- A. N.T.R. DENOTES PLATES TO WHICH NOTCH TOUGHNESS REQUIREMENTS ARE APPLICABLE.
 - B. THE FLANGES, WEBS AND ALL BEARING STIFFENERS FOR ALL GIRDERS SHALL BE AASHTO M223, GRADE 50.
 - C. DIAPHRAGM D2 TO BE NORMAL TO GIRDER.
 - D. TWO HARDENED WASHERS SHALL BE USED OVER 1/2\"/>

FRAMING PLAN AND GIRDER ELEVATION
F.A.P. ROUTE 412 OVER CH. 12
F.A.P. ROUTE 412-SEC. 57-3HB-1
MCLEAN COUNTY
STATION 343+38.38 (F.A.P. 412)
STRUCTURE NUMBER 057-0205 (S.B.)
057-0206 (N.B.)

alfred benesch & company
CONSULTING ENGINEERS
800 NORTH MICHIGAN AVENUE, CHICAGO, ILLINOIS 60610
JAN. 1960, 2200


USER NAME = eaglinga	DESIGNED -	REVISED -
DRAWN -	REVISED -	
PLOT SCALE = 40,0000 * / in.	CHECKED -	REVISED -
PLOT DATE = 9/29/2021	DATE -	REVISED -

STATE OF ILLINOIS
DEPARTMENT OF TRANSPORTATION


AS-BUILT PLANS
LOCATION #7 & #8 S.N. 057-0205 & S.N. 057-0206

SCALE: NONE SHEET 3 OF 4 SHEETS STA. TO STA.


F.A.I. RTE.	SECTION	COUNTY	TOTAL SHEETS	SHEET NO.
74/39	*	MCLEAN	50	35
*DS BRIDGE PAINTING 2022-1		CONTRACT NO. 70E74		
ILLINOIS		FED. AID PROJECT		

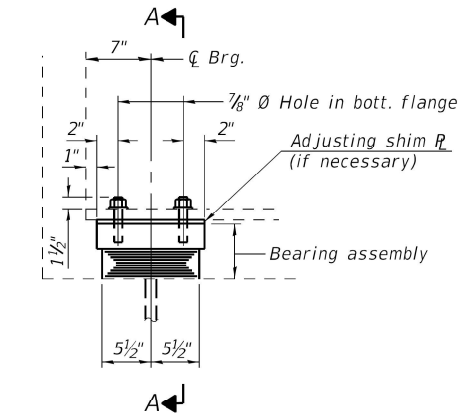


ELEVATION AT S. ABUT.

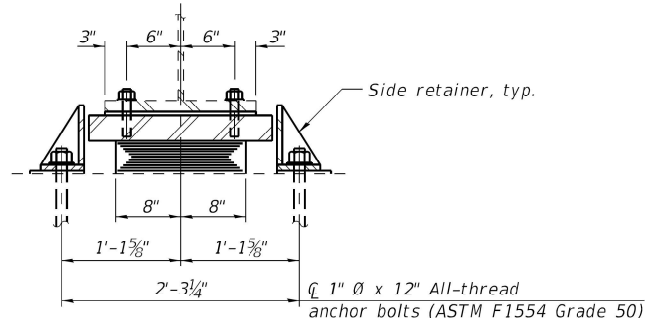

SECTION A-A

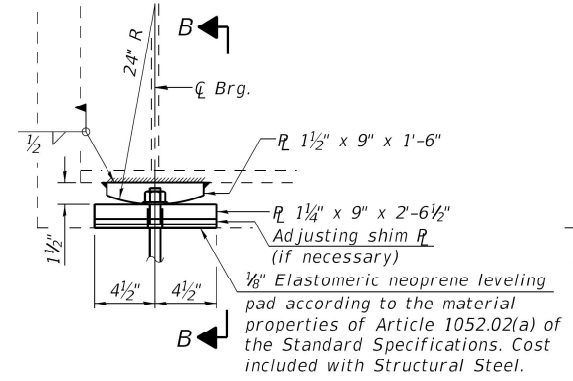


ELEVATION AT N. ABUT.

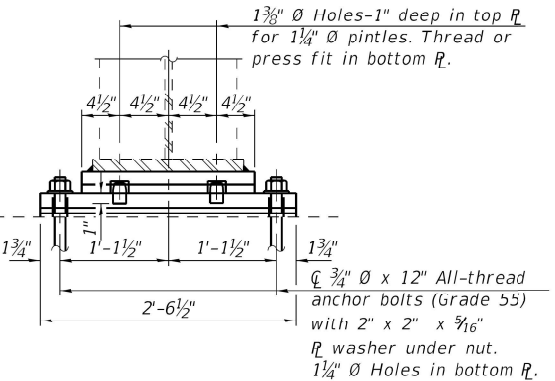

SECTION B-B


FIXED BEARING
AT NORTH ABUTMENTS

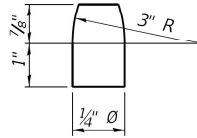

PINTLE

BEAM REACTIONS


R _ℓ	(k)	73.8
R _t	(k)	49.7
Imp.	(k)	10.1
R _{Total}	(k)	133.6

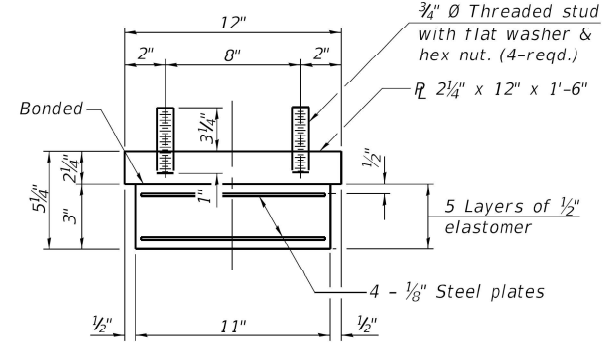

BEARING ASSEMBLY


Note:
Shim plates shall not be placed under bearing assembly.

Notes:
Side retainers and stainless steel plates shall be included in the cost of Elastomeric Bearing Assembly, Type I.
New shim plates and connections bolts are included with Furnishing and Erecting Structural Steel.
Prior to ordering any material the contractor shall verify in the field all bearing height and shim thickness dimensions. Adjustment must account for deck heave due to pack rust (if present).
Min. jack capacity - 67 Tons.
Anchor bolts shall be ASTM F1554 all-thread (or an Engineer-approved alternate material) of the grade(s) and diameter(s) specified. ASTM A307 Grade C anchor bolts maybe used in lieu of ASTM F1554 Grade 50 (Fy=50ksi). The corresponding specified grade of AASHTO M314 anchor bolts may be used in lieu of ASTM F1554.
Drilled and set anchor bolts shall be installed according to Article 521.06 of the Standard Specifications.
All new structural steel shall be hot-dipped galvanized.
See Special Provision for "Hot-Dip Galvanizing for Structural Steel".

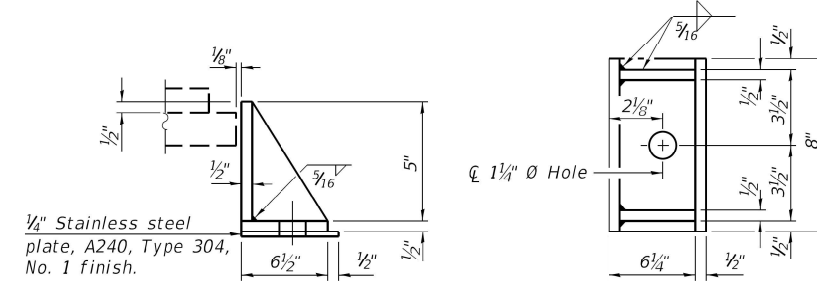

SIDE RETAINER

Equivalent rolled angle with stiffeners will be allowed in lieu of welded plates.

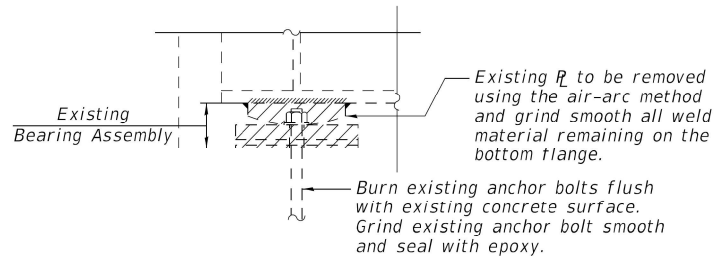

EXISTING BEARING REMOVAL DETAIL

Cost included with Jack and remove Existing Bearings.

BILL OF MATERIAL

Item	Unit	Total
Elastomeric Bearing Assembly, Type I	Each	12
Anchor Bolts 1"	Each	24
Anchor Bolts 3/4"	Each	24
Jack and Remove Existing Bearings	Each	24
Furnishing and Erecting Structural Steel	Pound	2170

MODEL: \$MODELNAMES
FILE NAME: \$FILELS

CEC Cummins Engineering Corporation Civil and Structural Engineering	JOB = 2596.1	DESIGNED - AAN	REVISED -
	FILE NAME = \$FILESS	CHECKED - MDC	REVISED -
	PLOT DATE = \$DATES	DRAWN - SJS	REVISED -
		CHECKED - MDC	REVISED -

STATE OF ILLINOIS
DEPARTMENT OF TRANSPORTATION

BEARING DETAILS
STRUCTURE NO. 057-0205 (S.B.) & 0206 (N.B.)
SHEET 19 OF 23 SHEETS

F.A.I. RTE.	SECTION	COUNTY	TOTAL SHEETS	SHEET NO.
39	(57-3B-1)BDS	McLEAN	97	93
CONTRACT NO. 70D65				
ILLINOIS FED. AID PROJECT				


USER NAME = eaglinga	DESIGNED -	REVISED -
	DRAWN -	REVISED -
PLOT SCALE = 40,0000 * / in.	CHECKED -	REVISED -
PLOT DATE = 9/29/2021	DATE -	REVISED -

STATE OF ILLINOIS
DEPARTMENT OF TRANSPORTATION

AS-BUILT PLANS
LOCATION #7 & #8 S.N. 057-0205 & S.N. 057-0206
SCALE: NONE SHEET 4 OF 4 SHEETS STA. TO STA.

F.A.I. RTE.	SECTION	COUNTY	TOTAL SHEETS	SHEET NO.
74/39	*	McLEAN	50	36
*DS BRIDGE PAINTING 2022-1 CONTRACT NO. 70E74				
ILLINOIS FED. AID PROJECT				

SHEET 7 OF 28

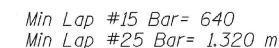


Bar	No.	Size	Length (m)	Shape
$d(E)$	1448	#15	7.000	—
$a_2(E)$	824	#20	1.200	—
$a_3(E)$	1448	#15	5.800	—
$a_5(E)$	8	#15	7.600	—
$a_6(E)$	16	#15	4.950	—
$b(E)$	828	#15	8.350	—
$b_1(E)$	516	#20	5.030	—
$b_2(E)$	800	#15	7.580	—
$d(E)$	1956	#15	0.910	—
$d_1(L)$	1020	#15	0.800	—
$d_2(E)$	468	#15	1.335	—
$d_3(E)$	468	#15	0.970	—
$e(E)$	192	#15	4.425	—
$e_1(E)$	128	#15	3.450	—
$e_2(E)$	96	#15	4.950	—
$e_3(E)$	48	#25	6.880	—
$e_4(E)$	32	#25	3.450	—
$e_5(E)$	24	#25	7.545	—
$e_6(E)$	48	#15	6.425	—
$e_7(E)$	24	#15	7.090	—
$x(E)$	160	#15	1.280	—
Reinforcement Bars, Epoxy Coated			kg	70190
Concrete Superstructures *			m^3	489

SUPERSTRUCTURE DETAILS
FAI ROUTE 74 OVER NORFOLK SOUTHERN R.R. (CONRAIL)
FAI ROUTE 74 SEC. (57-18) VBY
STA. 54+392.074 (FAI 74)
MCLEAN COUNTY
057-0046 (EB.) & 057-0045 (W.B.)


DESIGNED	JKC
CHECKED	LAG
DRAWN	LAG
CHECKED	JKC

F.A.I. RTE.	SECTION	COUNTY	TOTAL SHEETS	SHEET NO.
74	(57-18) VBY	McLEAN	72	5
STA.	TO STA.		ILLINOIS FED. AID PROJECT	


SHEET 9 OF 28

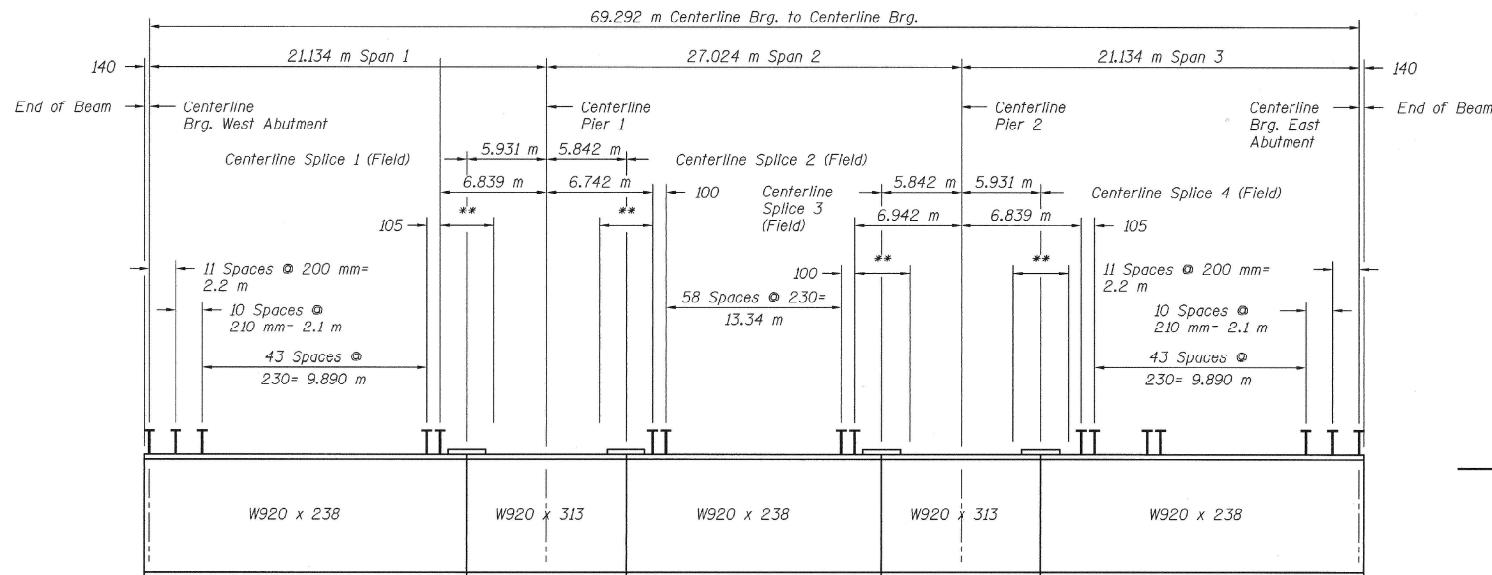

PROPOSED BEAM ELEVATION FOR STUD SHEAR CONNECTORS

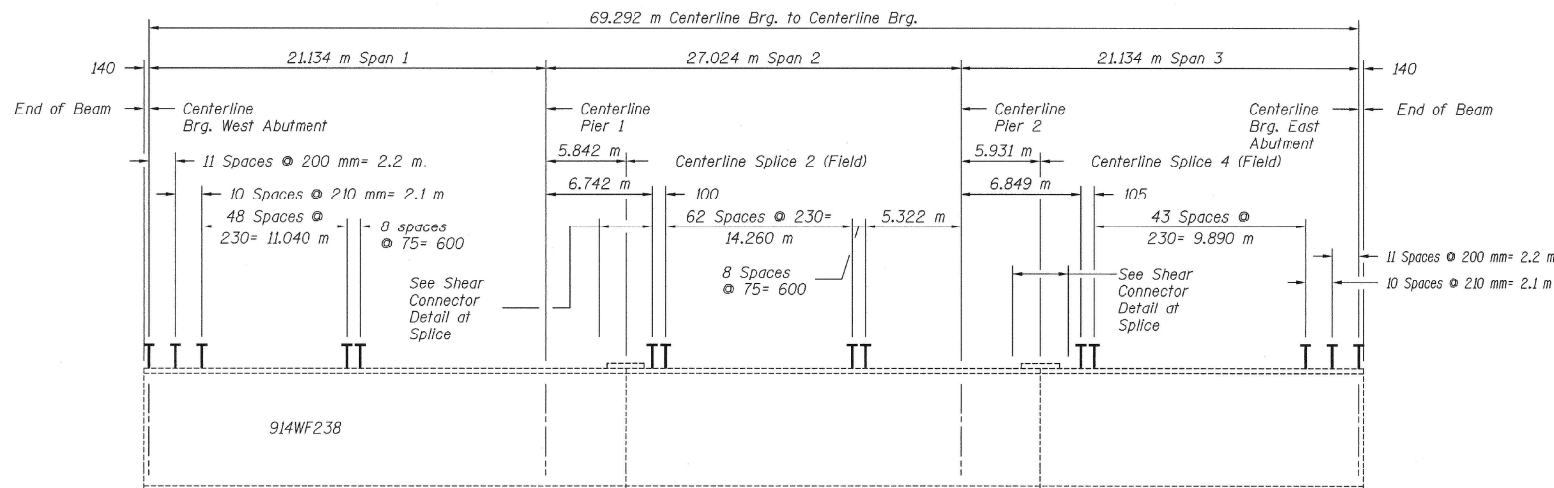


EXISTING BEAM ELEVATION FOR STUD SHEAR CONNECTORS

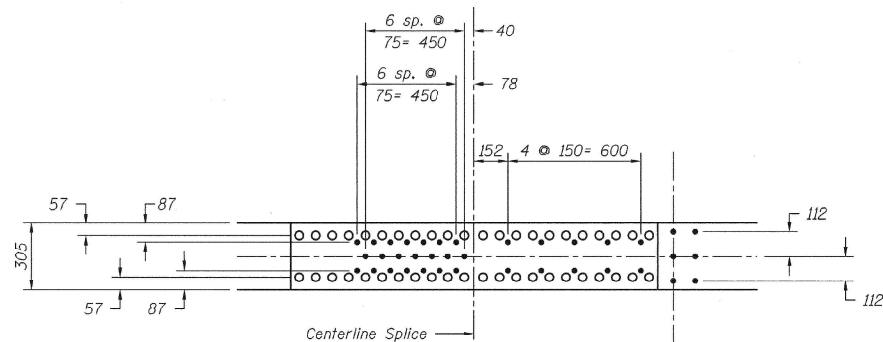


SHEAR CONNECTOR DETAIL AT SPLICE PLATES

(Splice 2 & 4 shown, Splice 1 & 3 Similar by rotation thru 180°)

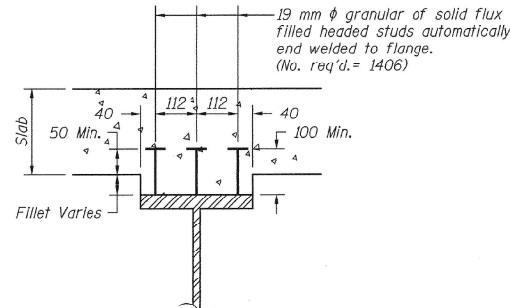

TYPICAL DETAIL OF SHEAR CONNECTORS AT NEW BEAM

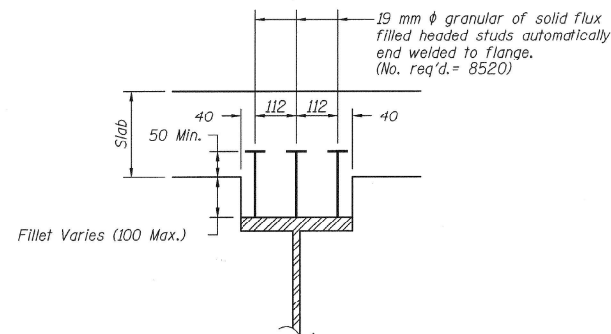

TYPICAL DETAIL OF SHEAR CONNECTORS AT EXISTING BEAM

TOP OF STEEL ELEVATIONS *		
Location	West Bound BMN-1	East Bound BMS-1
Centerline Brg. West Abut.	247.567	247.653
Splice 1 West Side	247.582	247.618
Splice 1 East Side	247.590	247.626
Centerline Pier 1	247.602	247.619
Splice 2 West Side	247.614	247.619
Splice 2 East Side	247.606	247.611
Splice 3 West Side	247.621	247.569
Splice 3 East Side	247.629	247.577
Centerline Pier 2	247.628	247.556
Splice 4 West Side	247.627	247.536
Splice 4 East Side	247.619	247.528
Centerline Brg. East Abut.	247.633	247.492

* ELEVATIONS ARE FOR BEAM FABRICATION ONLY AND ARE AT TOP OF STEEL FLANGE.

BEAM DETAILS
FAI ROUTE 74 OVER NORFOLK SOUTHERN R.R. (CONRAIL)
FAI ROUTE 74 SEC. (57-18) VBY
STA. 54+392.074 (FAI 74)
McLEAN COUNTY
057-0046 (EB.) & 057-0045 (W.B.)

Note: All dimensions are in millimeters (mm) except as noted.

11037.02Y-1

MODEL: 3-MODEL NAMES
FILE: 3-MODEL NAMES
PROJECT: 3-MODEL NAMES
DRAWING: 3-MODEL NAMES
DATE: 3-MODEL NAMES

USER NAME = eaglinga	DESIGNED -	REVISED -
DRAWN -	REVISED -	
PLOT SCALE = 40,0000 * / in.	CHECKED -	REVISED -
PLOT DATE = 9/29/2021	DATE -	REVISED -

STATE OF ILLINOIS
DEPARTMENT OF TRANSPORTATION

AS-BUILT PLANS
LOCATION #9 & #10 S.N. 057-0045 & S.N. 057-0046

SCALE: NONE SHEET 5 OF 8 SHEETS STA. TO STA.

F.A.I. RTE.	SECTION	COUNTY	TOTAL SHEETS	SHEET NO.
74/39	*	McLEAN	50	41
*D5 BRIDGE PAINTING 2022-1		CONTRACT NO. 70E74		
		ILLINOIS FED. AID PROJECT		

F.A.I. RTE.	SECTION	COUNTY	TOTAL SHEETS	SHEET NO.
74	(57-18) VBY	McLEAN	72	5
STA.		TO STA.		
FED. ROAD DIST. NO.		ILLINOIS FED. AID PROJECT		

SHEET 10 OF 28


INTERIOR GIRDER MOMENT TABLE						
		EXISTING BEAM			NEW BEAM	
		0.4 Sp. 1 OR 3	Pier 1 OR 2	0.5 Sp. SPAN 2	0.4 Sp. 1 OR 3	Pier 1 OR 2
I_s	(10^6 mm^4)	4054	5579	4054	4060	5480
I_c	(10^6 mm^4)	11919	---	11919	9305	---
I_{cs}	(10^6 mm^4)	8402	---	8402	6835	---
S_s	(10^3 mm^3)	8865	11872	8865	8870	11800
S_c	(10^3 mm^3)	14059	---	14059	12150	---
S_{cs}	(10^3 mm^3)	12438	---	12438	10990	---
$\bar{Q}$	($\text{kN}\cdot\text{m}$)	12.46	16.27	12.46	11.30	15.10
$M\bar{Q}$	($\text{kN}\cdot\text{m}$)	357.5	923.3	365.3	323.6	949.6
$f_{s\bar{Q}}$ non-comp	(MPa)	40	78	41	36	80
$s\bar{Q}$	(kN/m)	3.81	---	3.81	---	3.81
$M_{s\bar{Q}}$	($\text{kN}\cdot\text{m}$)	131.2	---	164.2	118.5	---
$f_{s\bar{Q}}$ (comp)	(MPa)	10	---	13	11	---
$M_{\bar{Q}}$	($\text{kN}\cdot\text{m}$)	665.1	441.7	722.4	603.6	450.2
M (Imp)	($\text{kN}\cdot\text{m}$)	172.9	110.4	116.2	156.9	112.6
$f_{s(M+M_{\text{Imp}})}$	(MPa)	60	46	60	63	48
f_s (Total)	(MPa)	110	124	114	110	128
VR	(kN)	212	---	212	---	233

INTERIOR GIRDER REACTION TABLE					
		EXISTING BEAM		NEW BEAM	
		Abut.	Pier 1 OR 2	Abut.	Pier 1 OR 2
$R\bar{Q}$	(kN)	126	439	117	416
$R_{\bar{L}}$	(kN)	177	232	164	205
Imp.	(kN)	46	58	43	50
R (Total)	(kN)	349 kN	729 kN	324	671


I_s and S_s are the moment of inertia and section modulus of the steel section used in computing f_s (Total).
 I_{cs} and S_{cs} are the moment of inertia and section modulus of the composite section used in computing stresses due to Live Load.
 I_{csn} and S_{csn} are the moment of inertia and section modulus of the composite section used in computing stresses due to superimposed dead loads.
VR is the maximum Live Load + Impact shear range in span.
 f_s (Total) is the sum of stresses due to $f_{M\bar{Q}} + M_{s\bar{Q}} + M_{\bar{L}} + M_{\text{IMP}}$.

NOTES FOR SETTING OF ANCHOR BOLTS AT EXPANSION BEARINGS

- a.) D^* (Side of brg. away from fixed brg.)
 $D^* = 1 \text{ mm}$ per each 10 m of expansion for every 8 °C fall below the normal temp. of 10 °C.
 D^{**} (Side of brg. toward fixed brg.)
 $D^{**} = 1 \text{ mm}$ per each 10 m of expansion for every 8 °C rise above the normal temp. of 10 °C.
- b.) After beams have been erected and dimensions D^* & D^{**} determined, holes shall be drilled and anchor bolts shall be installed as shown on Sheet #21 of 28. All fixed anchor bolts may be built into the masonry.

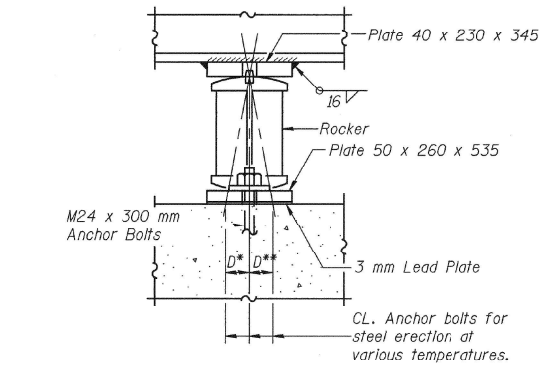

ELEVATION

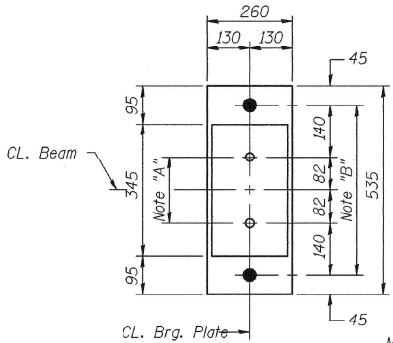


PLAN AT PIER 1


Note "A"
35 mm ϕ Holes-25 mm deep in top Plate for 32 mm ϕ pintles. Thread or press fit pintles in bottom Plate.

Note "B"
40 mm ϕ Holes for M24 Anchor Bolts - 8 x 65 x 65 Plate washer under nut.


BEARING ASSEMBLY DETAILS

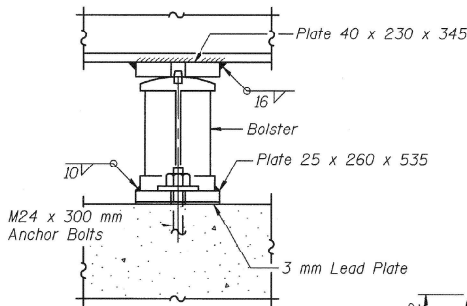


ELEVATION

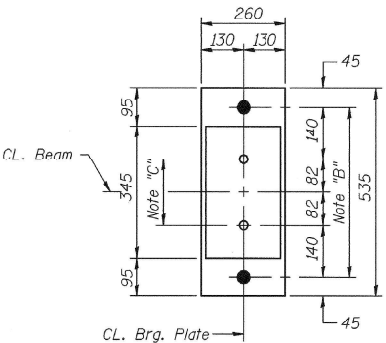


PLAN AT PIER 2

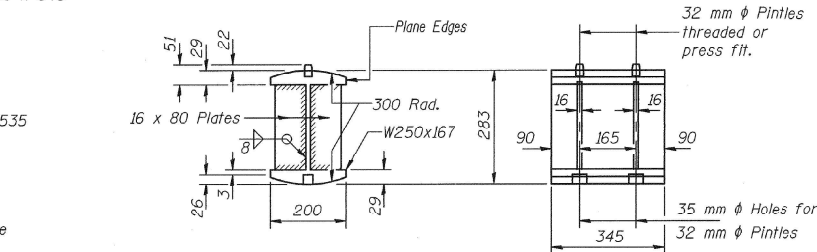

ROCKER DETAIL @ PIER 1

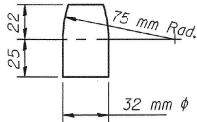

PINLE

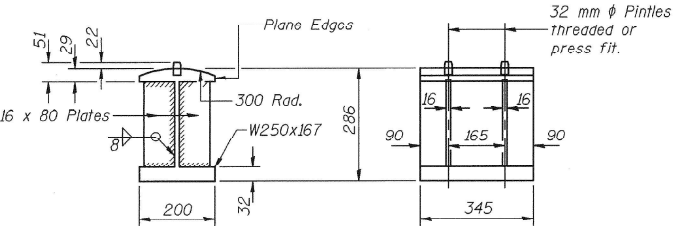

BOLSTER DETAIL @ PIER 2

Note: All dimensions are in millimeters (mm) except as noted.

FRAMING DETAILS
FAI ROUTE 74 OVER NORFOLK SOUTHERN R.R. (CONRAIL)
FAI ROUTE 74 SEC. (57-18) VBY
STA. 54+392.074 (FAI 74)
McLEAN COUNTY
057-0046 (E.B.) & 057-0045 (W.B.)

11037.02Y-1

MODEL: 3-MODEL NAMES
FILE: 11037.02Y-1.dgn
C:\Users\jwheeler\OneDrive\Documents\DOT Office\Drawings\11037.02Y-1.dgn

USER NAME = eaglinga	DESIGNED -	REVISED -
	DRAWN -	REVISED -
PLOT SCALE = 40,0000 * / in.	CHECKED -	REVISED -
PLOT DATE = 9/29/2021	DATE -	REVISED -


STATE OF ILLINOIS
DEPARTMENT OF TRANSPORTATION

AS-BUILT PLANS
LOCATION #9 & #10 S.N. 057-0045 & S.N. 057-0046



SCALE: NONE SHEET 6 OF 8 SHEETS STA. TO STA.

F.A.I. RTE.	SECTION	COUNTY	TOTAL SHEETS	SHEET NO.
74/39	*	McLEAN	50	42
*D5 BRIDGE PAINTING 2022-1		CONTRACT NO. 70E74		
		ILLINOIS FED. AID PROJECT		


SHEET 11 OF 28 SHEETS

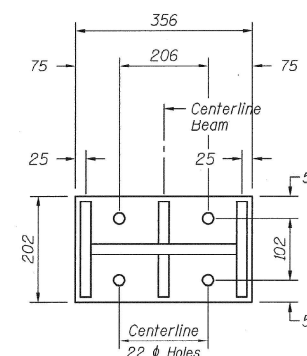

PLAN STEEL EXTENSION

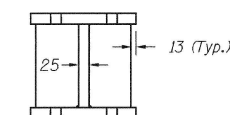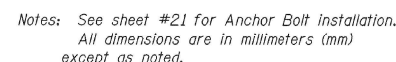

SECTION B-B

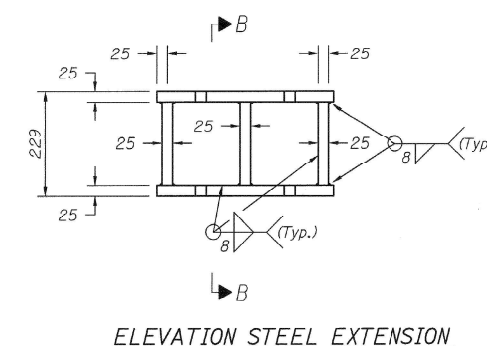

ELEVATION STEEL EXTENSION

STEEL EXTENSION DETAILS

12 REQUIRED - ONE AT EACH
EXISTING BEAM

BILL OF MATERIAL

* Includes steel assembly above elastomeric bearing assembly and side retainers. This quantity included with quantity on sheet 1.

BEARING DETAILS AT EAST ABUTMENT
FAI ROUTE 74 OVER NORFOLK SOUTHERN R.R. (CONRAIL)
FAI ROUTE 74 SEC. (57-18) VBY
STA. 54+392.074 (FAI 74)
McLEAN COUNTY
057-0046 (E.B.) & 057-0045 (W.B.)

11037.02Y-1

**STATE OF ILLINOIS
DEPARTMENT OF TRANSPORTATION**

AS-BUILT PLANS


LOCATION #9 & #10 S.N. 057-0045 & S.N. 057-0046

F.A.I. RTE.	SECTION	COUNTY	TOTAL SHEETS	SHEET NO.
74/39	*	MCLEAN	50	43
*D5 BRIDGE PAINTING 2022-1		CONTRACT NO. 70E74		
ILLINOIS		FED. AID PROJECT		


```
MODEL: $MODEL.NAMES  
FILE NAME: new\litolit-new.html  
PROJECTS(DS70E7A1CADAData\CADReports)\DS70E7A1c01-AeRpt.dgn
```

F.A.I. RTE.	SECTION	COUNTY	TOTAL SHEETS NO.	SHEET NO.
74	(57-18) VBY	McLEAN	72	5
STA.	TO STA.	FED. ROAD DIST. NO. 7	1111015	FED. AID PROJECT

SHEET 12 OF 28 SHEETS

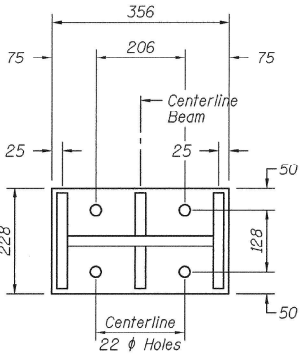

PLAN STEEL EXTENSION

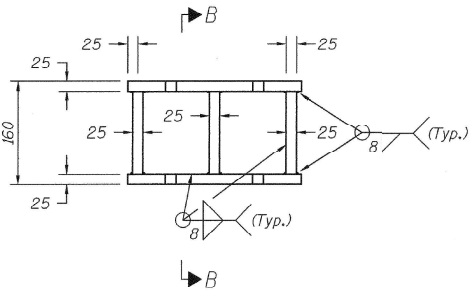

ELEVATION STEEL EXTENSION

STEEL EXTENSION DETAILS


12 REQUIRED - ONE AT EACH EXISTING BEAM

BILL OF MATERIAL


Item	Unit	Total
Elastomeric Bearing Assembly Type II	Each	14
Furnishing and Erecting Structural Steel *	kg	940

* Includes steel assembly above elastomeric bearing assembly and side retainers. This quantity included with quantity on sheet 1.

BEARING DETAILS AT WEST ABUTMENT
FAI ROUTE 74 OVER NORFOLK SOUTHERN R.R. (CONRAIL)
FAI ROUTE 74 SEC. (57-18) VBY
STA. 54+392.074 (FAI 74)
McLEAN COUNTY
057-0046 (E.B.) & 057-0045 (W.B.)

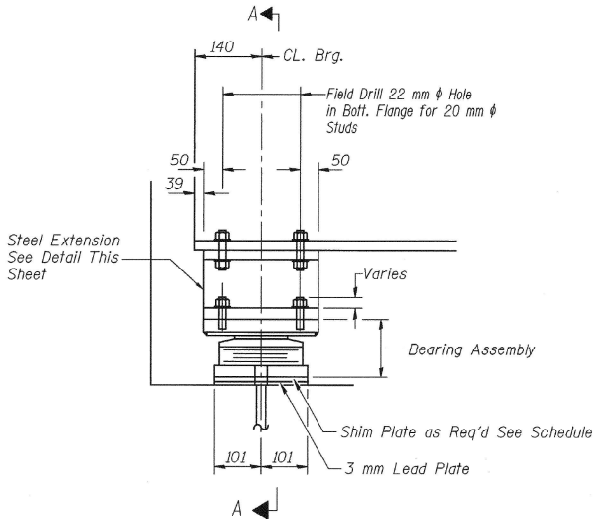


ELEVATION AT ABUT.

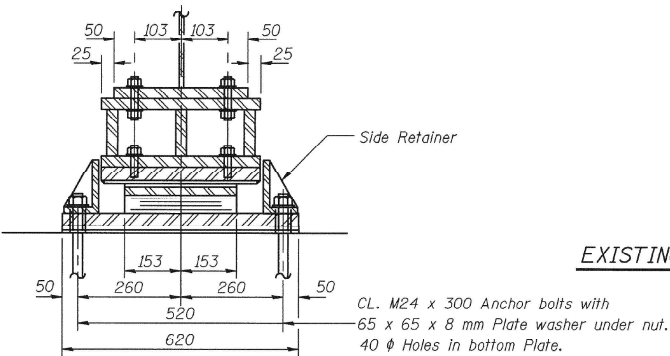


SECTION A-A


TYPE II TFE ELASTOMERIC EXP. BRG.

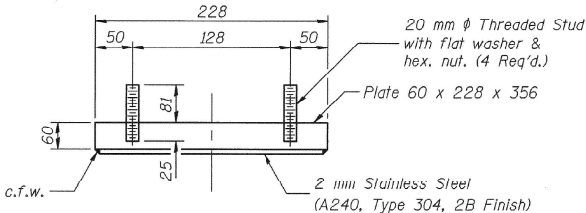


TOP BEARING ASSEMBLY

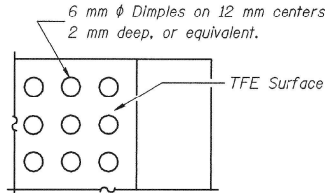


PLAN-TFE SURFACE

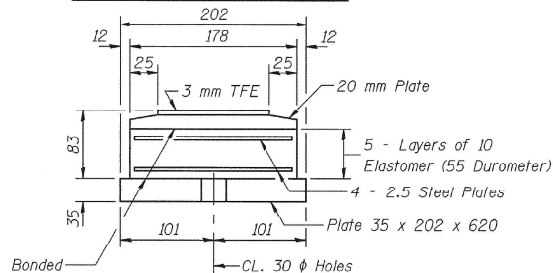

BOTTOM BEARING ASSEMBLY

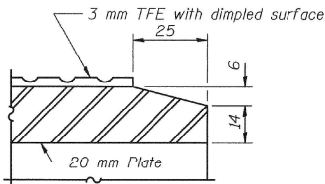


SECTION THRU TFE

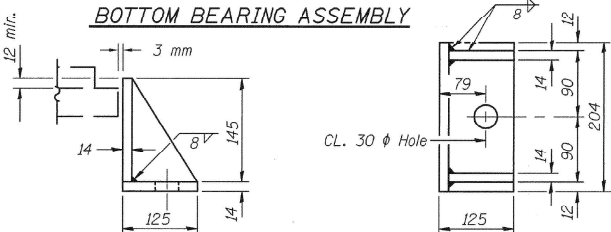


SIDE RETAINER

Equivalent rolled angle with stiffeners will be allowed in lieu of welded plates. Weight included with Structural Steel. (No. Req'd 28)

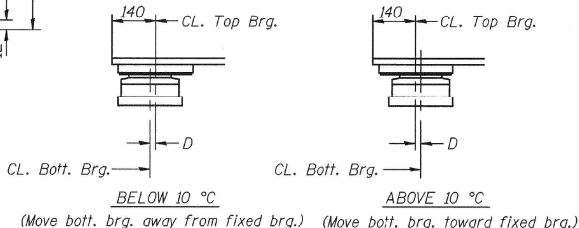


SETTING ANCHOR BOLTS AT EXP. BRG.

U= 1 mm per each 10 m of expansion for every 8 °C temp. change from the normal temp. of 10 °C.

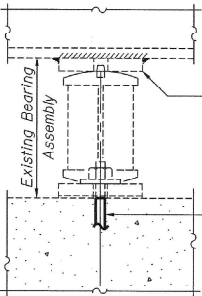

EXISTING BEARING REMOVAL DETAIL

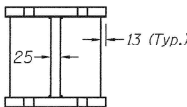

SECTION B-B

202 x 620 SHIM PLATE SCHEDULE			
WESTBOUND		EASTBOUND	
BMN-1	---	BMS-1	---
BMN-2	16	BMS-2	9
BMN-3	16	BMS-3	---
BMN-4	13	BMS-4	19
BMN-5	16	BMS-5	28
BMN-6	31	BMS-6	28
BMN-7	9	BMS-7	16

STATE OF ILLINOIS
DEPARTMENT OF TRANSPORTATION

AS-BUILT PLANS
LOCATION #9 & #10 S.N.057-0045 & S.N.057-0046

SCALE: NONE SHEET 8 OF 8 SHEETS STA. TO STA.



F.A.I. RTE.	SECTION	COUNTY	TOTAL SHEETS	SHEET NO.
74/39	*	McLEAN	50	44
*D5 BRIDGE PAINTING 2022-1		CONTRACT NO. 70E74		
		ILLINOIS FED. AID PROJECT		

MODEL: \\MODEL\NAMES
FILE: \\MODEL\as-built\74\057-0045\057-0045.dgn

USER NAME = eaglinga	DESIGNED -	REVISED -
	DRAWN -	REVISED -
PLOT SCALE = 40,0000 * / in.	CHECKED -	REVISED -
PLOT DATE = 9/29/2021	DATE -	REVISED -

11037.02Y-1

DETAIL FOR TEMPORARY RUMBLE STRIPS (SPECIAL)

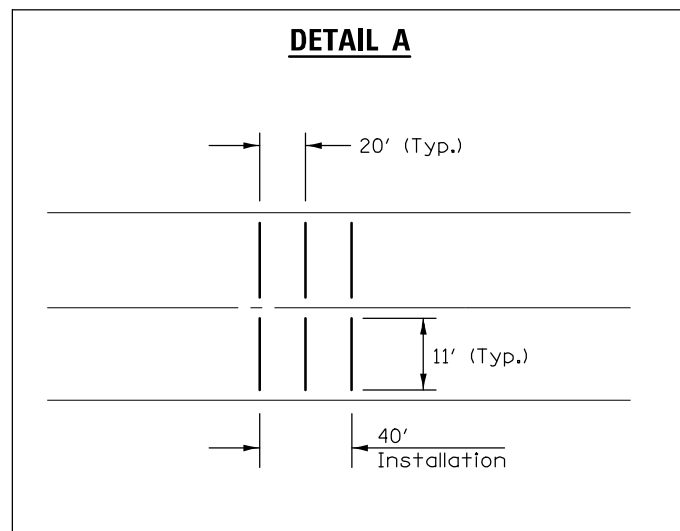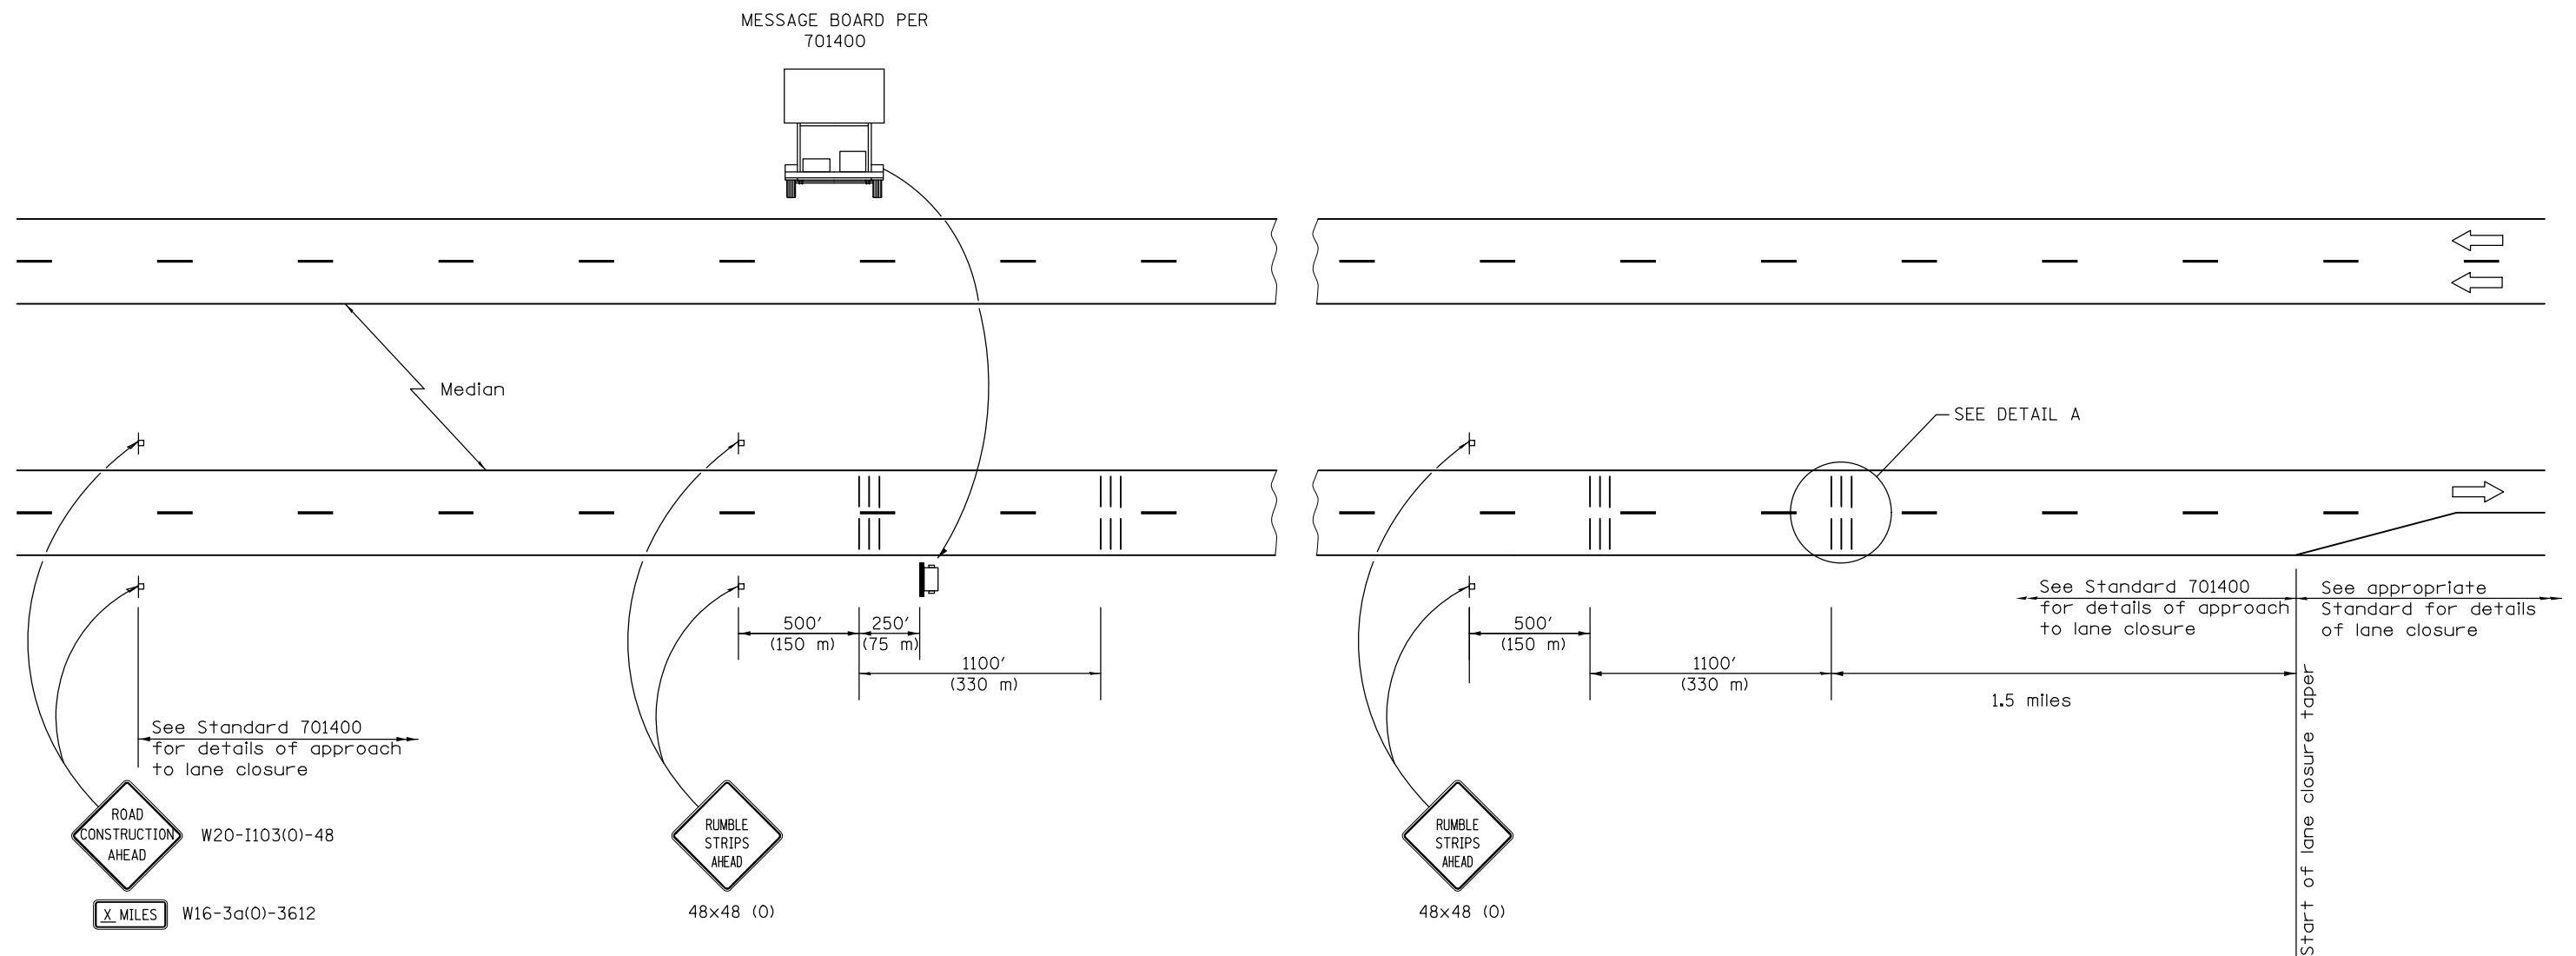

SYMBOLS

- ▮ Sign
- ||| Temporary Rumble Strips (Special)
- 📄 Trailer Mounted Sign

GENERAL NOTES

Remove the Temporary Rumble Strips (Special) prior to the removal of the advanced warning signs.

All dimensions are in inches (millimeters) unless otherwise shown.

The first rumble strip is placed 250' in advance of the message board required by 701400

For consecutive overheads along I-74, the 1.5 mile rumble strips may be used as the advanced rumble strips at the next bridge - to be determined by the engineer.

USER NAME = eaglinga	DESIGNED -	REVISED -
	DRAWN -	REVISED -
PLOT SCALE = 40,0000 ' / in.	CHECKED -	REVISED -
PLOT DATE = 9/29/2021	DATE -	REVISED -

**STATE OF ILLINOIS
DEPARTMENT OF TRANSPORTATION**

DETAIL FOR TEMPORARY RUMBLE STRIPS (SPECIAL)


SCALE: NONE	SHEET 1 OF 1 SHEETS	STA.	TO STA.
-------------	---------------------	------	---------

F.A.I. RTE.	SECTION	COUNTY	TOTAL SHEETS	SHEET NO.
74/39	*	MCLEAN	50	45
*D5 BRIDGE PAINTING 2022-1		CONTRACT NO. 70E74		
	ILLINOIS	FED. AID PROJECT		

MODEL: \$MODEL.NAME\$
FILE NAME: pws:\wlot-pw.bentley.com\pwwid\Documents\DOT_Offices\District_5\Projects\DS570E74\CADDData\CAD\sheet\DS570E74-sht-Details.dgn

WIDTH RESTRICTION SIGNING DETAIL

www.invarion.com

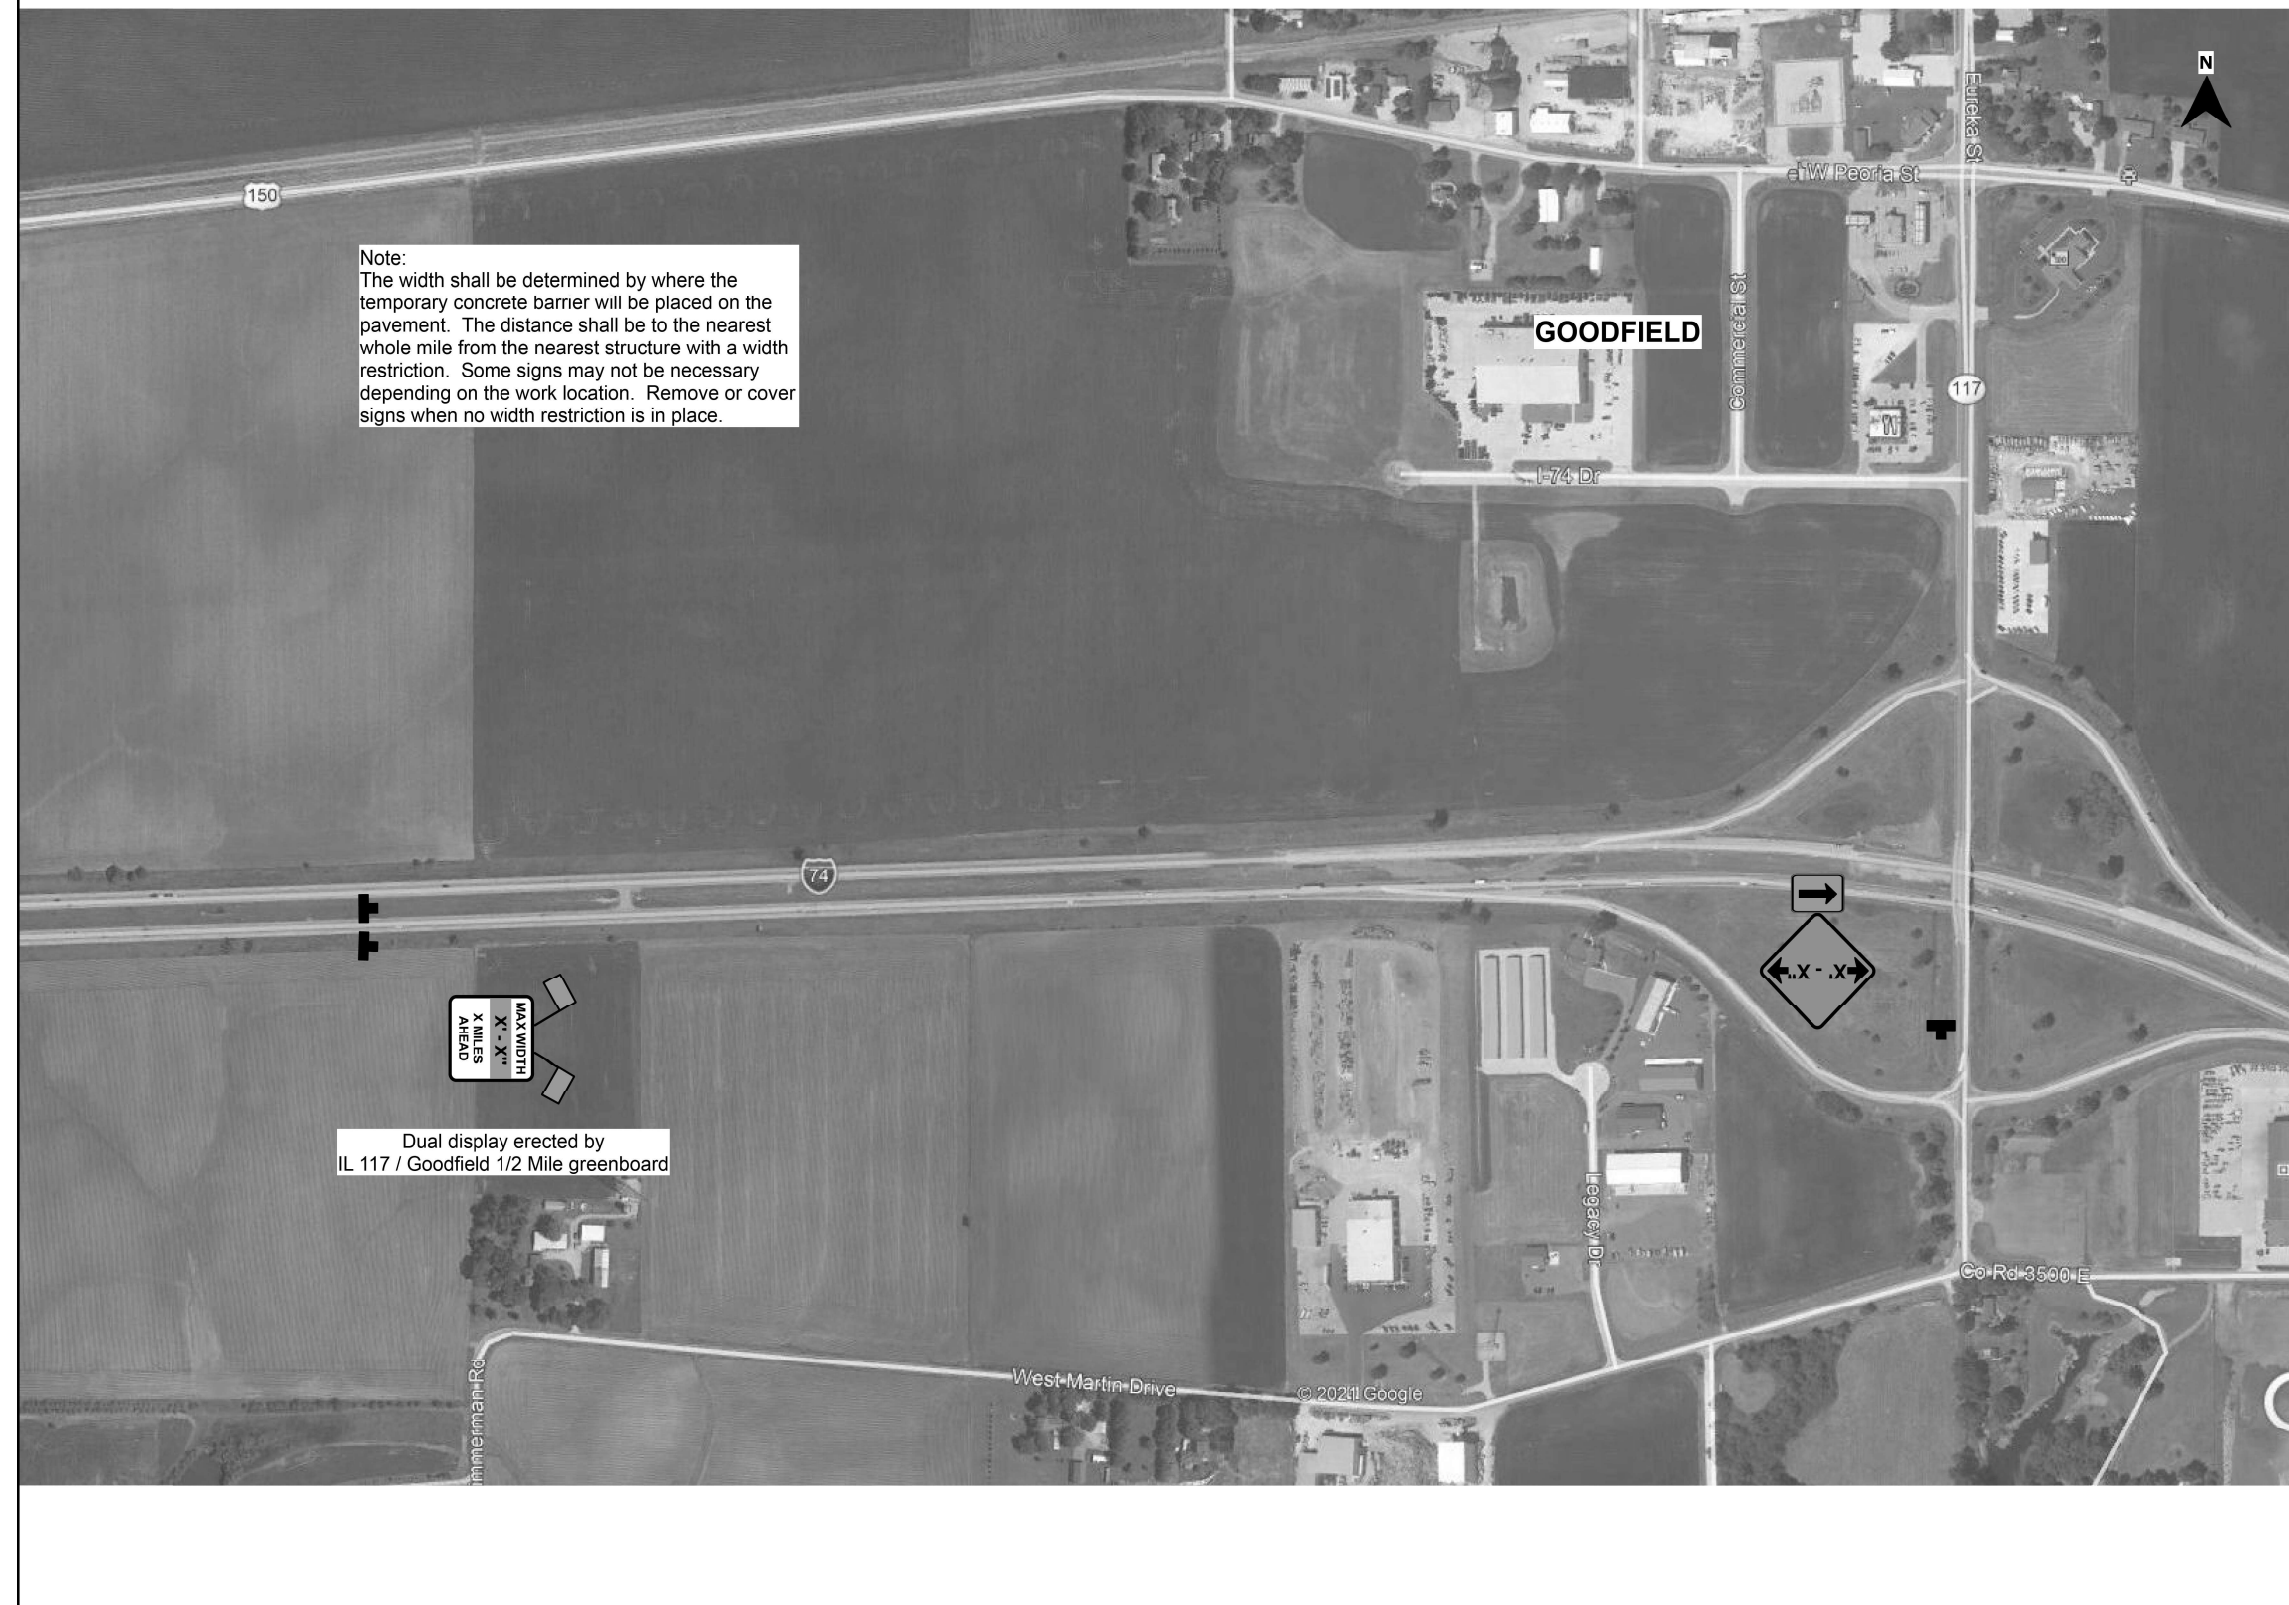

USER NAME = eaglinga	DESIGNED -	REVISED -	STATE OF ILLINOIS DEPARTMENT OF TRANSPORTATION	WIDTH RESTRICTION SIGNING DETAIL				F.A.I. RTE:	SECTION	COUNTY	TOTAL SHEETS	SHEET NO.
	DRAWN -	REVISED -						74/39	*	MCLEAN	50	46
PLOT SCALE = 40,0000 ' / in.	CHECKED -	REVISED -		SCALE: NONE SHEET 1 OF 4 SHEETS STA. TO STA.				*D5 BRIDGE PAINTING 2022-1 CONTRACT NO. 70E74				
PLOT DATE = 9/29/2021	DATE -	REVISED -								ILLINOIS	FED. AID PROJECT	

WIDTH RESTRICTION SIGNING DETAIL

www.invarion.com



USER NAME = eaglinga	DESIGNED -	REVISED -	STATE OF ILLINOIS DEPARTMENT OF TRANSPORTATION	WIDTH RESTRICTION SIGNING DETAIL			F.A.I. RTE.	SECTION	COUNTY	TOTAL SHEETS	SHEET NO.
	DRAWN -	REVISED -					74/39	*	MCLEAN	50	47
PLOT SCALE = 40,000' / in.	CHECKED -	REVISED -		*D5 BRIDGE PAINTING 2022-1							
PLOT DATE = 9/29/2021	DATE -	REVISED -		SCALE: NONE	SHEET 2	OF 4 SHEETS	STA.	TO STA.			
						ILLINOIS FED. AID PROJECT					


www.invarion.com



USER NAME = eaglinga	DESIGNED -	REVISED -	STATE OF ILLINOIS DEPARTMENT OF TRANSPORTATION	WIDTH RESTRICTION SIGNING DETAIL				F.A.I. RTE.	SECTION	COUNTY	TOTAL SHEETS	SHEET NO.	
	DRAWN -	REVISED -							*	MCLEAN	50	48	
PLOT SCALE = 40,0000 ' / in.	CHECKED -	REVISED -		SCALE: NONE	SHEET 3	OF 4	SHEETS	STA.	TO STA.				
PLOT DATE = 9/29/2021	DATE -	REVISED -						*D5 BRIDGE PAINTING 2022-1 CONTRACT NO. 70E74					

WIDTH RESTRICTION SIGNING DETAIL

www.invarion.com

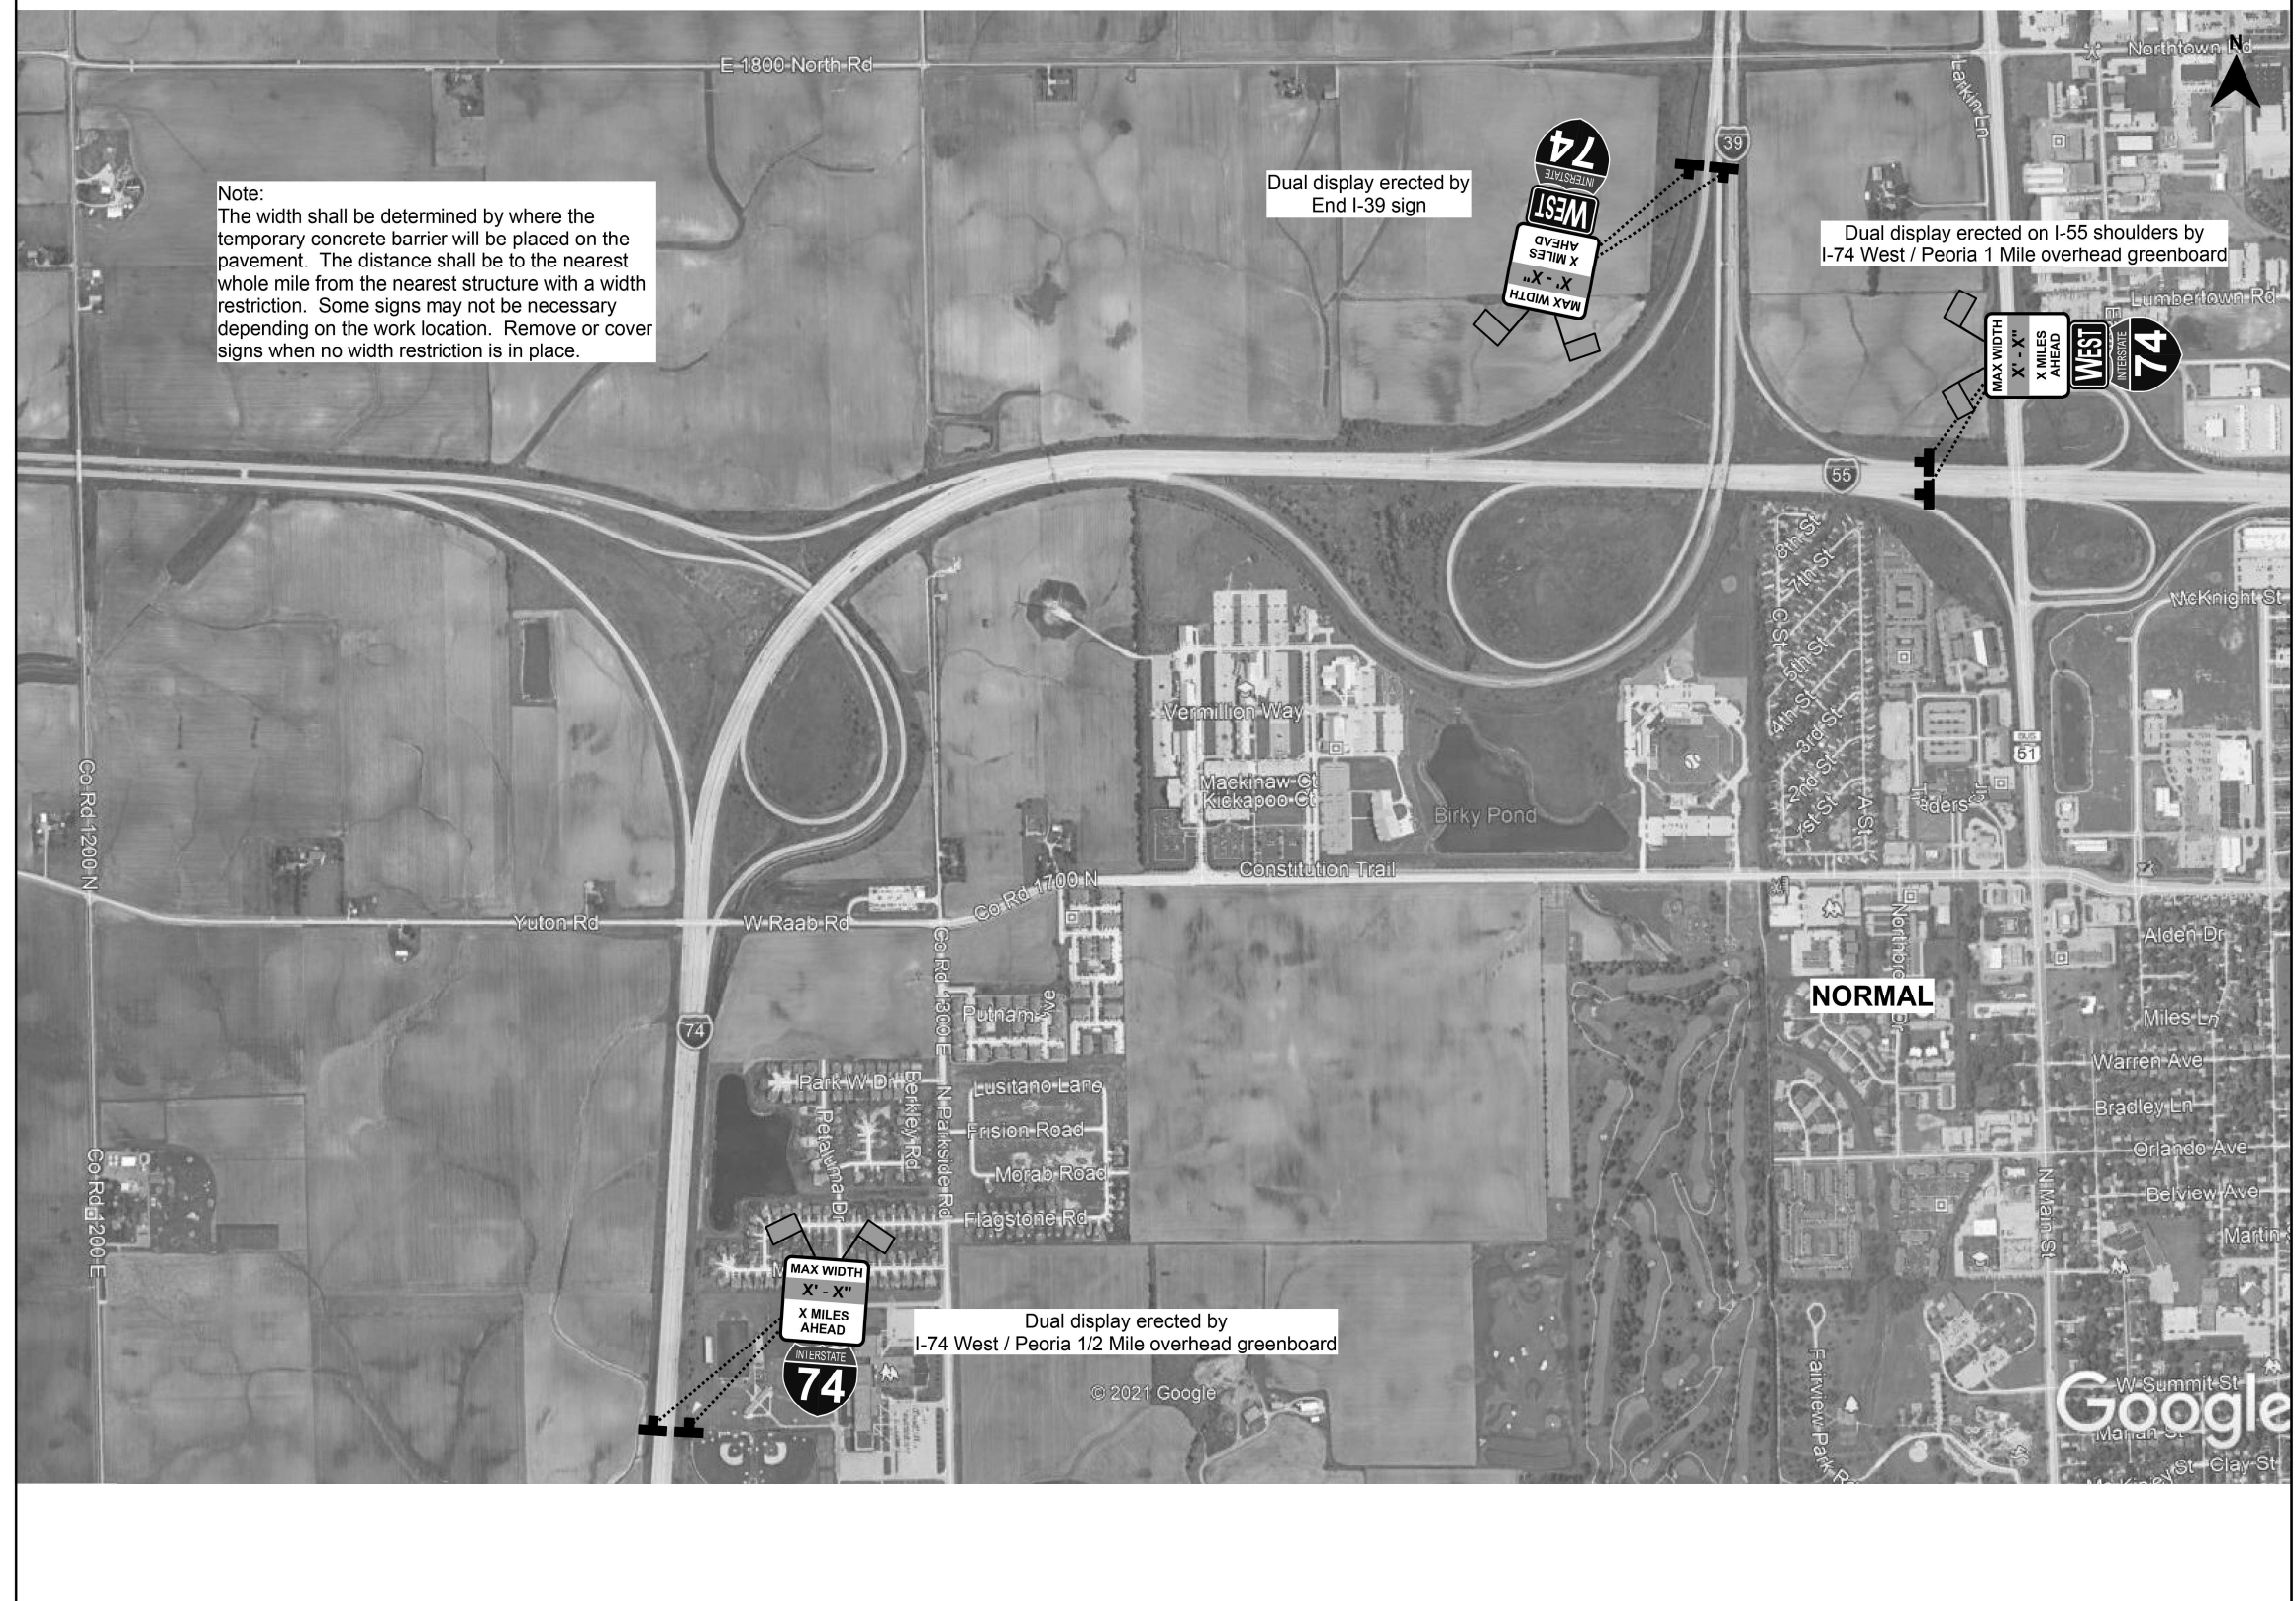

USER NAME = eaglinga	DESIGNED -	REVISED -
	DRAWN -	REVISED -
PLOT SCALE = 40,0000 ' / in.	CHECKED -	REVISED -
PLOT DATE = 9/29/2021	DATE -	REVISED -


STATE OF ILLINOIS
DEPARTMENT OF TRANSPORTATION

WIDTH RESTRICTION SIGNING DETAIL


SCALE: NONE	SHEET 4 OF 4 SHEETS	STA. TO STA.
-------------	---------------------	--------------

F.A.I. RTE.	SECTION	COUNTY	TOTAL SHEETS	SHEET NO.
74/39	*	MCLEAN	50	49
*D5 BRIDGE PAINTING 2022-1		CONTRACT NO. 70E74		
ILLINOIS FED. AID PROJECT				

MODEL: \$MODEL\NAMES
FILE NAME: pws\illdot-pw.bentley.com\pws\illdot Documents\IDOT_Offices\District_5\Projects\DS70E74\CADDData\CADsheets\DS70E74-sht-WRS.dgn

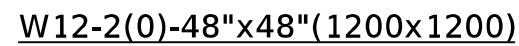

SIGN (B) 2 SIGNS - (SIGN PANEL, TYPE II) AS SHOWN ARE TO BE PLACED AS SHOWN IN THE PLANS OR AS DIRECTED BY THE ENGINEER.

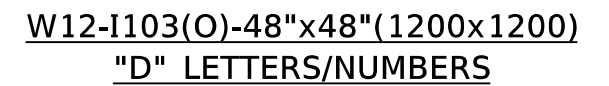

1. ALL TRAFFIC CONTROL DEVICES SHALL BE FURNISHED, ERECTED AND MAINTAINED BY THE CONTRACTOR.
2. ALL (B) SIGNS SHALL HAVE FLAGS INSTALLED UNLESS OTHERWISE DIRECTED.
3. LOCATIONS OF TRAFFIC CONTROL DEVICES MAY BE ADJUSTED BY THE ENGINEER.
4. ALL TRAFFIC CONTROL SHOWN ON THIS SHEET SHALL BE PAID FOR AT THE CONTRACT LUMP SUM PRICE FOR WIDTH RESTRICTION SIGNING.
5. ALL SIGNS SHALL BE POST MOUNTED UNLESS OTHERWISE DIRECTED.
6. ALL SIGNS SHOWN ORANGE (O) SHALL BE FLUORESCENT ORANGE.
7. ALL SIGNS SHOWN SHALL CONSIST OF THE CURRENT RETROREFLECTIVE SHEETING REQUIREMENTS AS OUTLINED IN SECTION 1106.01 OF THE STANDARD SPECIFICATIONS BOOK.

DISTRICT 5 DETAIL NO. X7200201

FILE NAME: 50	USER NAME = eaglinga	DESIGNED -	REVISED - 05/08	STATE OF ILLINOIS DEPARTMENT OF TRANSPORTATION	WIDTH RESTRICTION SIGNING					F.A.I. RTE.	SECTION	COUNTY	TOTAL SHEETS	SHEET NO.
		DRAWN -	REVISED - 10/08 KJT							74/39	*	MCLEAN	50	50
	PLOT SCALE = 40,0000' * / in.	CHECKED -	REVISED - 07/09 KJT							*D5 BRIDGE PAINTING 2022-1				
	PLOT DATE = 9/29/2021	DATE -	REVISED - 03/11 KJT		SCALE: NONE	SHEET 1	OF 1	SHEETS	STA.	TO STA.	CONTRACT NO. 70E74			
												ILLINOIS	FED. AID PROJECT	