


Field Sheet Title
 No. No. Sheet
 062 1950-86 33
 SLIPR 062-34292 RPT

FOR INFORMATION ONLY

PS 4

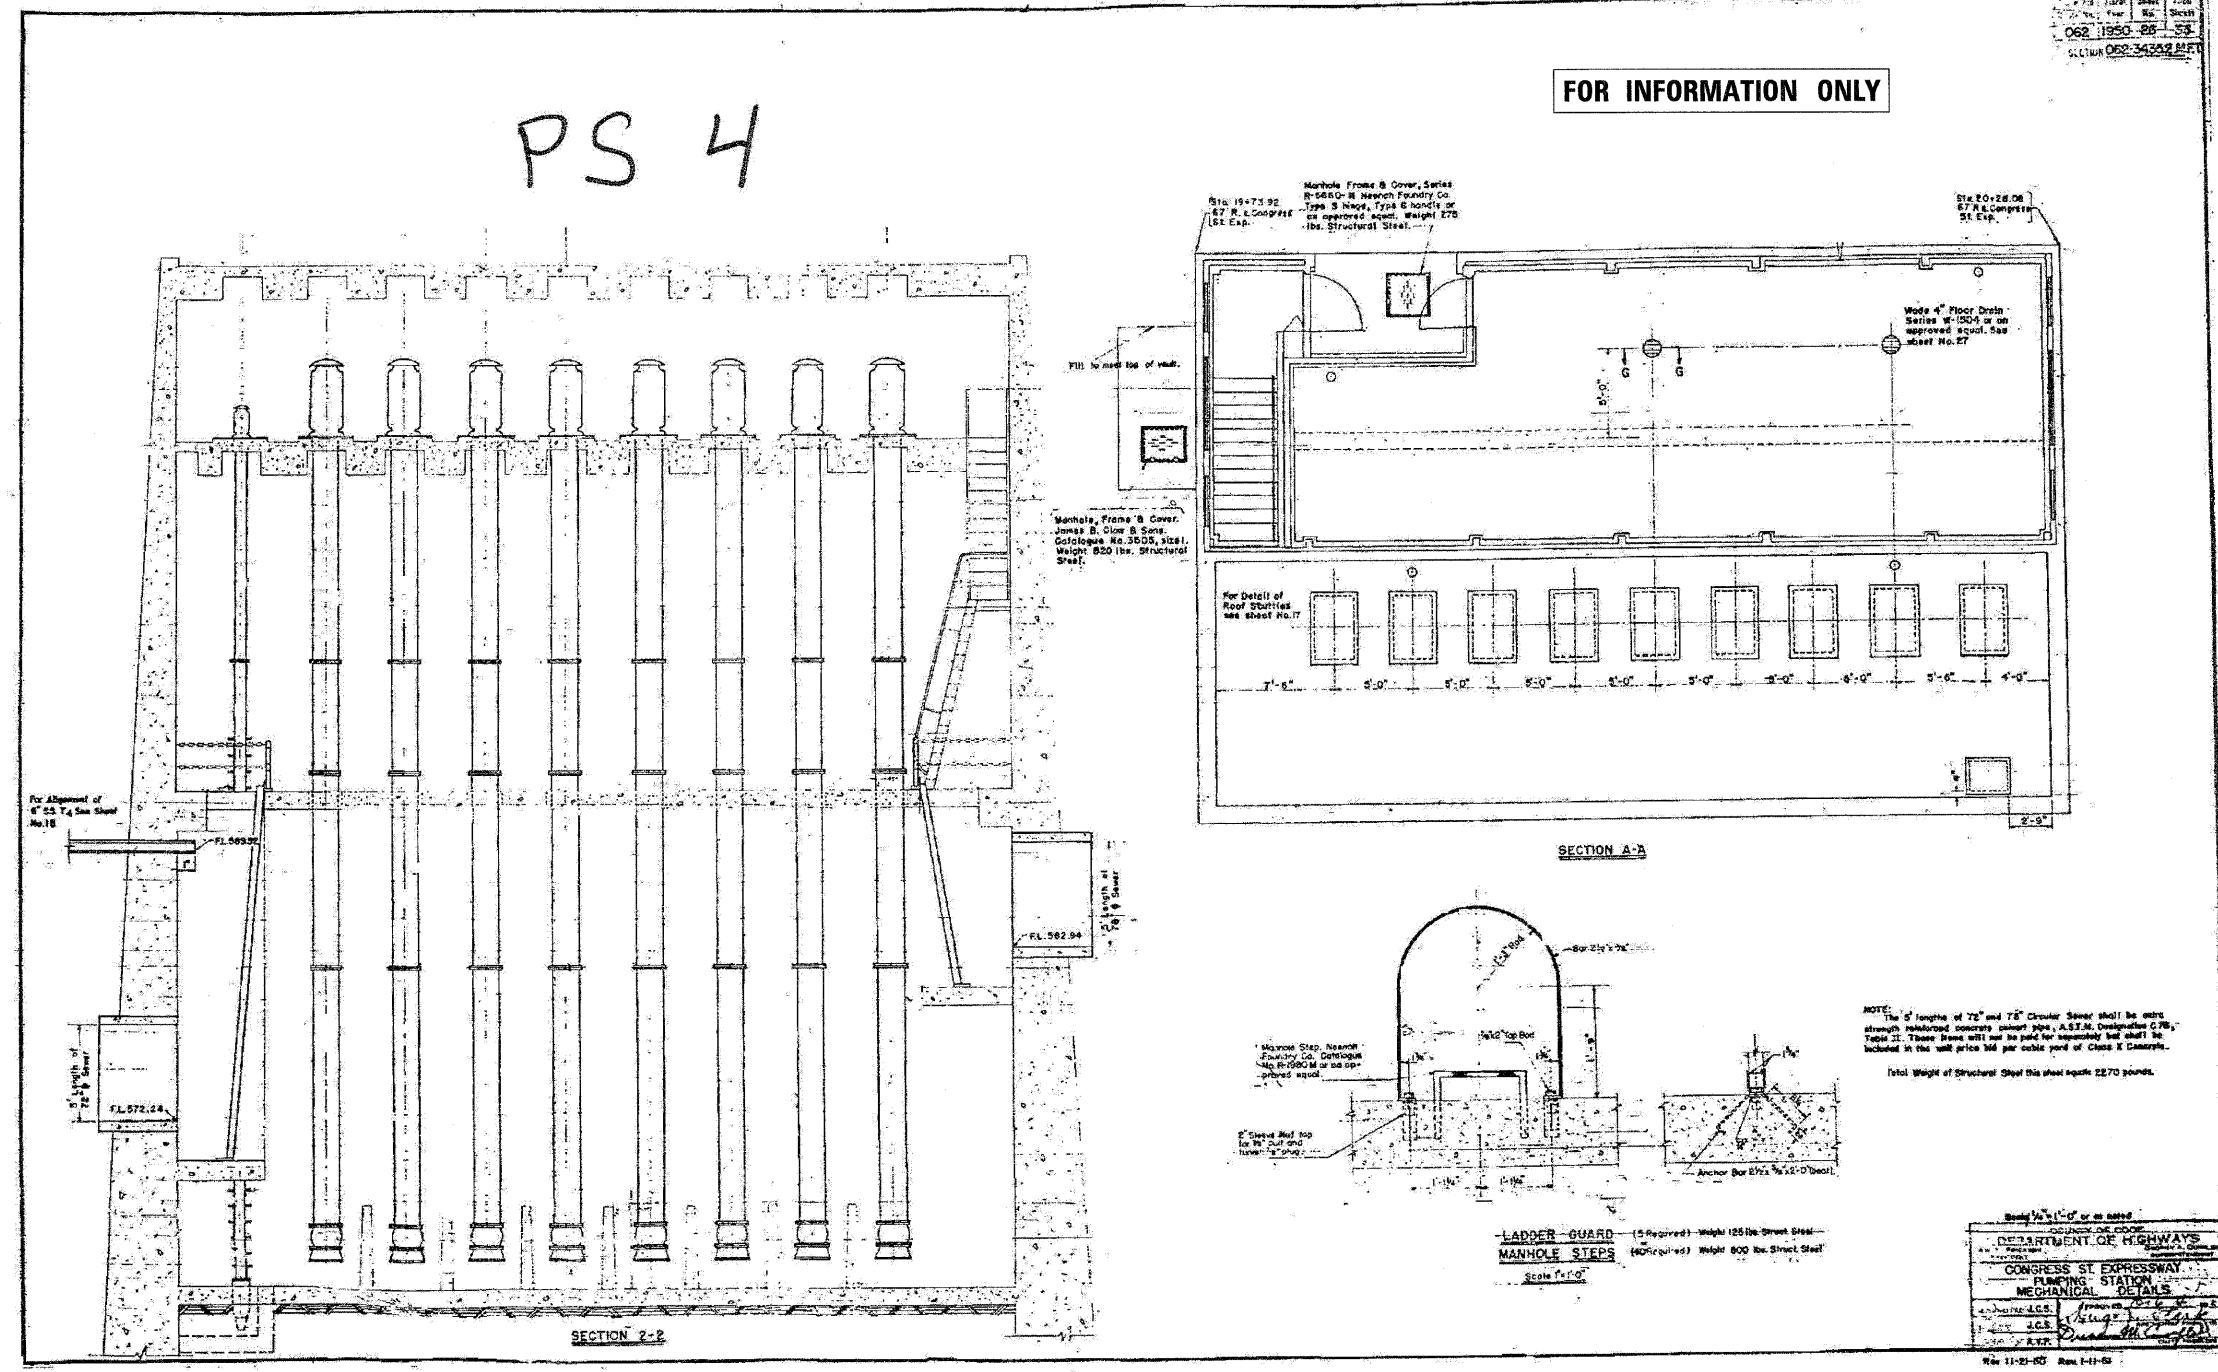

FILE NAME =	DESIGNED - SGL	REVISED -
#FILE#	DRAWN - SGL	REVISED -
USER NAME = #USER#	CHECKED - FML	REVISED -
PLOT DATE = #DATE#	DATE - 1/25/10	REVISED -

LE LIN ENGINEERING, LTD.
 Consulting Engineers
 Chatham, Illinois Westmont, Illinois

STATE OF ILLINOIS
 DEPARTMENT OF TRANSPORTATION

PUMP STATION NO. 4
 RECORD DRAWINGS

SCALE: SHEET NO. 1 OF 2 SHEETS STA. TO STA.

F.A.I. RTE.	SECTION	COUNTY	TOTAL SHEETS	SHEET NO.
290	(3131, ETC., 3435) RS-6	COOK	215	167
			CONTRACT NO. 60K10	
ILLINOIS FED. AID PROJECT				