


DATE: 1/25/10
 DRAWN BY: JMW
 CHECKED BY: MPM
 PLOT DATE: 1/25/2010

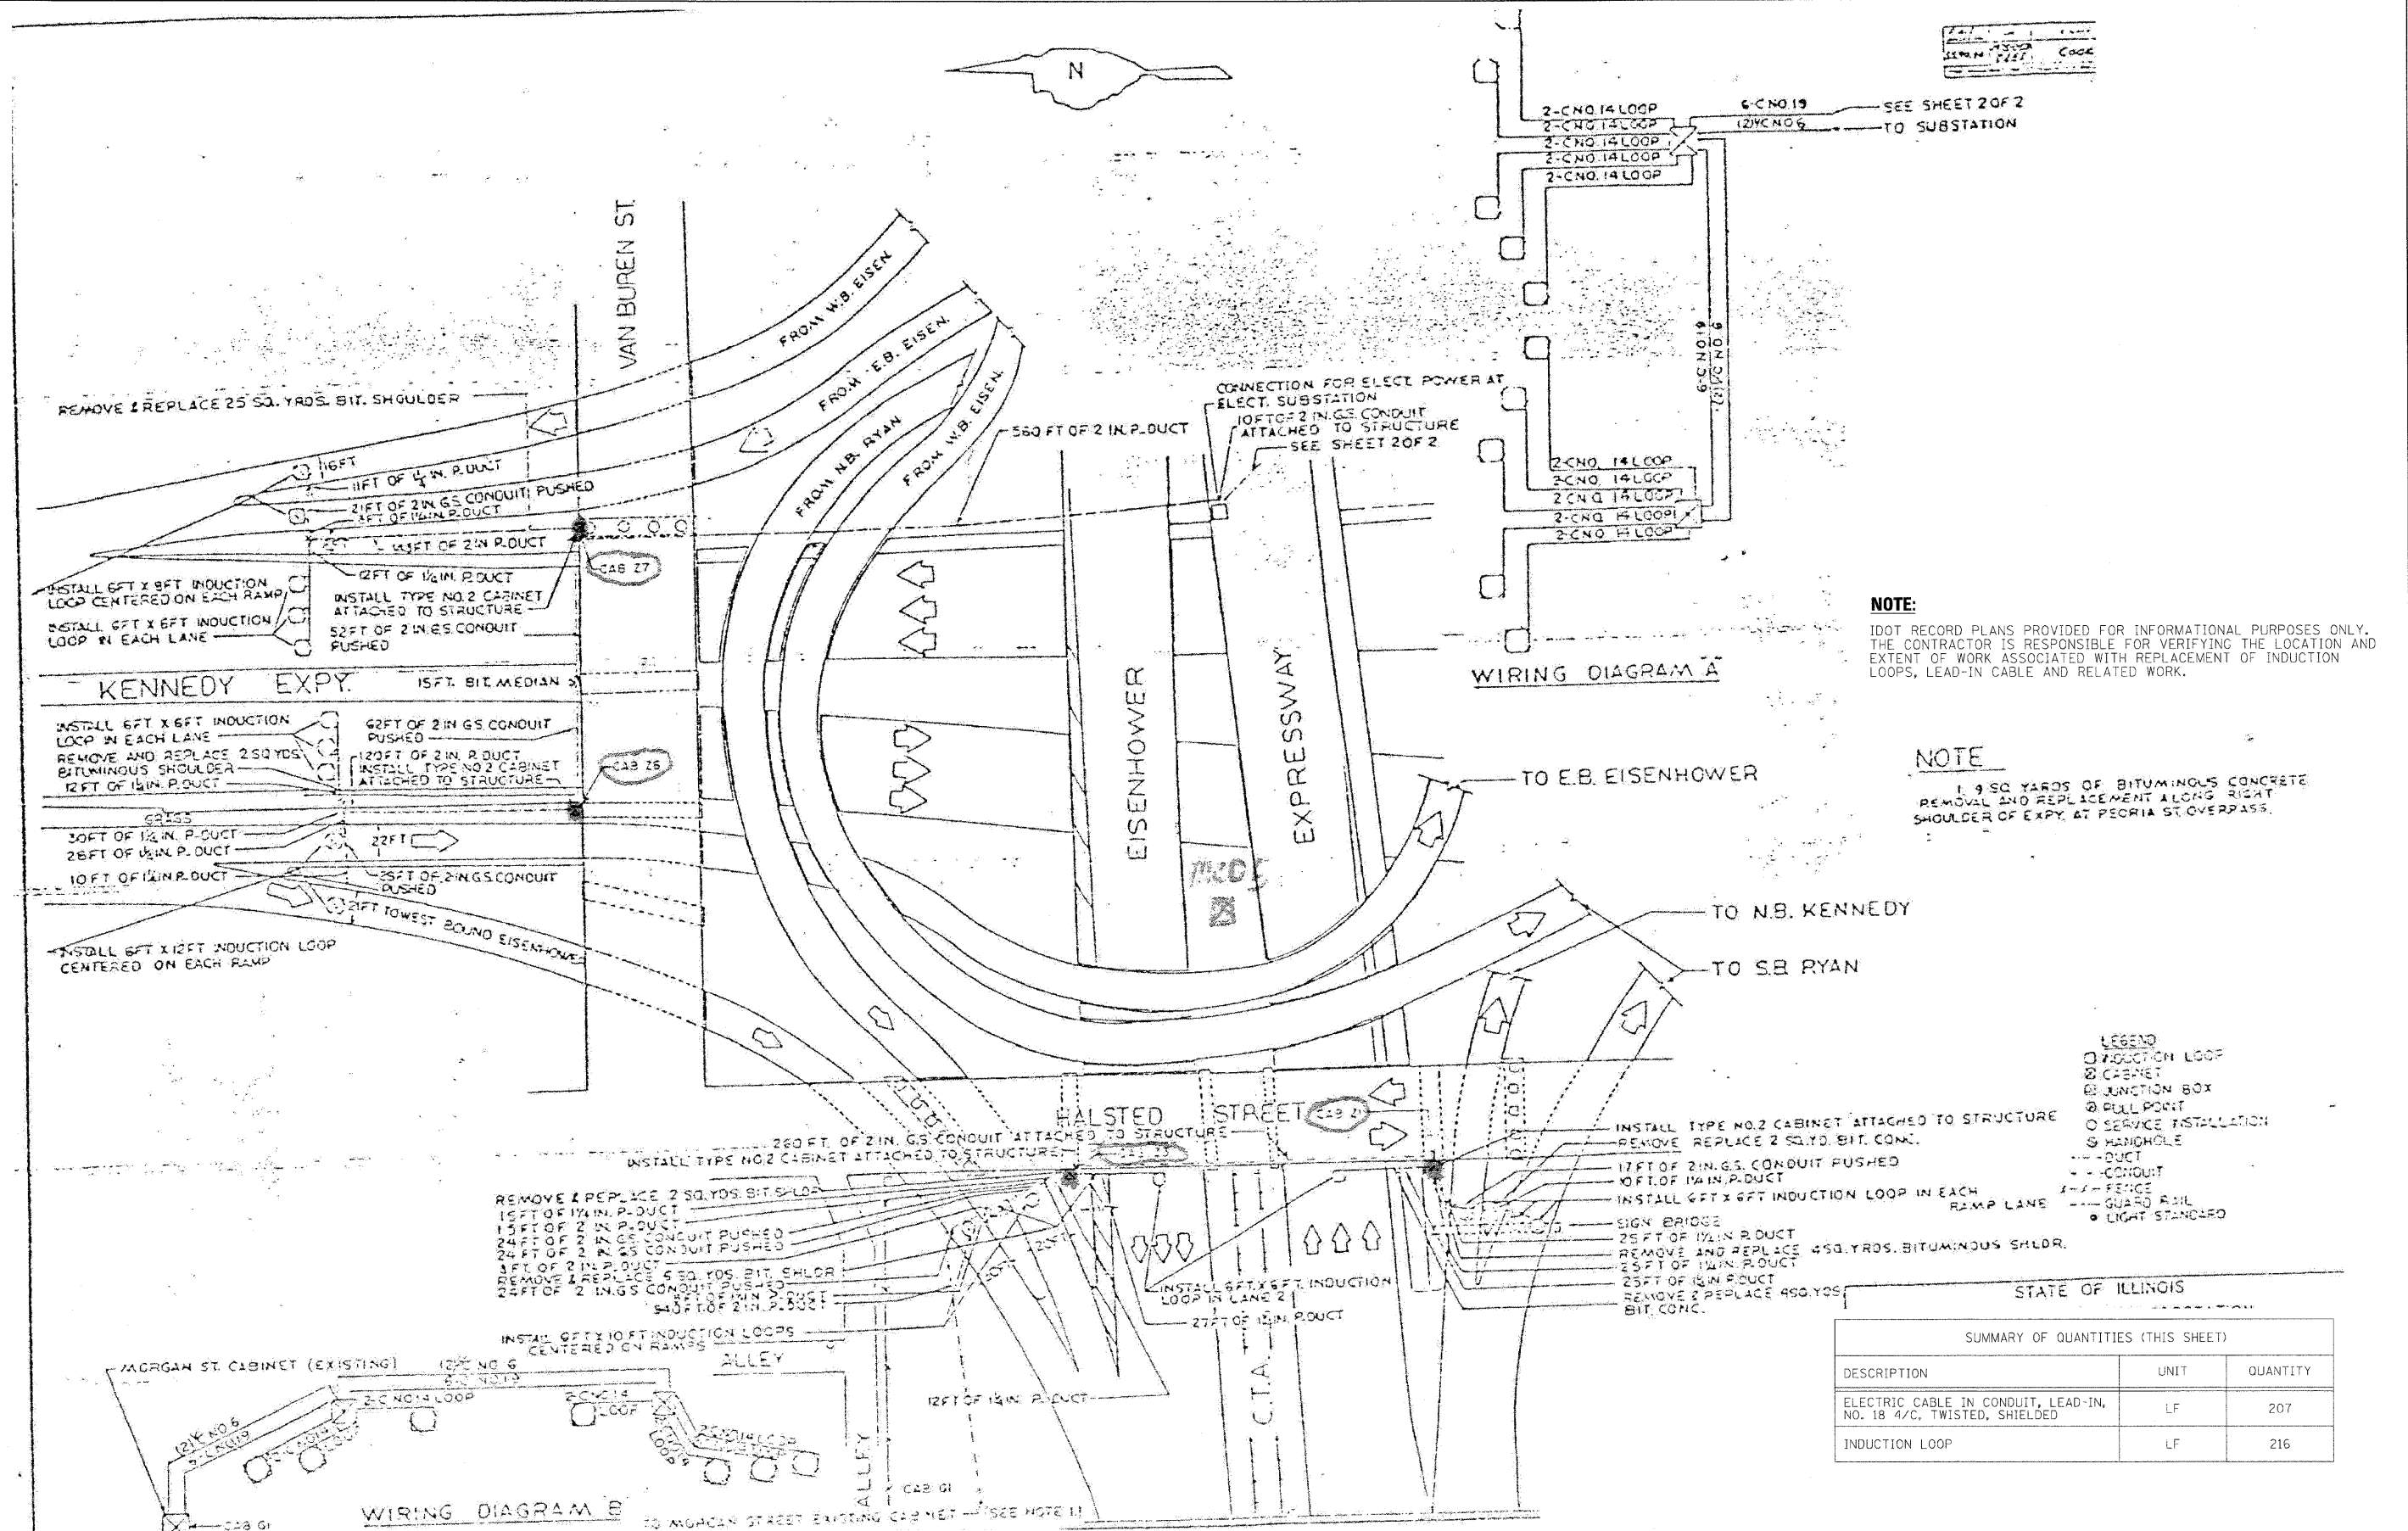

NOTE:
 IDOT RECORD PLANS PROVIDED FOR INFORMATIONAL PURPOSES ONLY. THE CONTRACTOR IS RESPONSIBLE FOR VERIFYING THE LOCATION AND EXTENT OF WORK ASSOCIATED WITH REPLACEMENT OF INDUCTION LOOPS, LEAD-IN CABLE AND RELATED WORK.

NOTE:
 1.9 SQ. YARDS OF BITUMINOUS CONCRETE REMOVAL AND REPLACEMENT ALONG RIGHT SHOULDER OF EXPY. AT PEORIA ST. OVERPASS.

- LEGEND**
- INDUCTION LOOP
 - ⊠ CABINET
 - ⊕ JUNCTION BOX
 - ⊙ PULL POINT
 - SERVICE INSTALLATION
 - HANDHOLE
 - DUCT
 - - - CONDUIT
 - - - FENCE
 - - - GUARD RAIL
 - LIGHT STANDARD

STATE OF ILLINOIS
 DEPARTMENT OF TRANSPORTATION

SUMMARY OF QUANTITIES (THIS SHEET)		
DESCRIPTION	UNIT	QUANTITY
ELECTRIC CABLE IN CONDUIT, LEAD-IN, NO. 18 4/C, TWISTED, SHIELDED	LF	207
INDUCTION LOOP	LF	216

FILE NAME = ...	DESIGNED - GHT	REVISED -
USER NAME = jmw	DRAWN - DMS	REVISED -
PLOT DATE = 1/25/2010	CHECKED - MPM	REVISED -
	DATE - 1/25/10	REVISED -

benesch

**STATE OF ILLINOIS
 DEPARTMENT OF TRANSPORTATION**

**TRAFFIC SURVEILLANCE
 EISENHOWER-KENNEDY-RYAN INSTALLATION (1 OF 2)**

SCALE: N.T.S. SHEET NO. 1 OF 23 SHEETS STA. TO STA.

F.A.I. RTE.	SECTION	COUNTY	TOTAL SHEETS	SHEET NO.
290	(2525, ETC., 2727)RS-8	COOK	201	159
FED. ROAD DIST. NO. ILLINOIS FED. AID PROJECT			CONTRACT NO. 60K11	