

151

03-06-2020 LETTING ITEM 151

STATE OF ILLINOIS  
DEPARTMENT OF TRANSPORTATION

F.A.P. NO.	SECTION	COUNTY	TOTAL SHEETS	SHEET NO.
820	[(1-G),(25)]BDR	DOUGLAS	56	1
CONTRACT NO. 70D77				

D-95-041-19



FOR INDEX OF SHEETS, SEE SHEET NO. 2  
FOR SUMMARY OF QUANTITIES, SEE SHEET NO. 3-5


CURRENT TRAFFIC DATA	
STR. 021-0030	
STR. 021-0031	
2018 ADT	= 1,850
2038 ADT	= 2,050
PU+PC %	= 98.1
SU %	= 3.1
MUX	= 5.0

DESIGN DESIGNATION  
MINOR ARTERIAL

# PROPOSED HIGHWAY PLANS

FAP ROUTE 820 (IL-130)  
SECTION [(1-G),(25)]BDR  
PROJECT  
EMBARRAS RIVER 1.5 MILES SOUTH OF CAMARGO  
SCATTERING FORK 3.0 MILES SOUTH OF CAMARGO  
BRIDGE REPAIRS  
DOUGLAS COUNTY

C-95-046-19

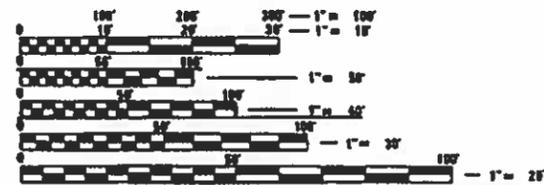

FULL SIZE PLANS HAVE BEEN PREPARED USING STANDARD ENGINEERING SCALES. REDUCED SIZED PLANS WILL NOT CONFORM TO STANDARD SCALES. IN MAKING MEASUREMENTS ON REDUCED PLANS, THE ABOVE SCALES MAY BE USED.


J.U.L.L.E.  
JOINT UTILITY LOCATION INFORMATION FOR EXCAVATORS  
1-800-892-0123  
OR 811

TOWNSHIPS: CAMARGO, BOWDRE

PROJECT ENGINEER: TIM BRANDENBURG  
PROJECT MANAGER: ERIC SHAWLER  
1-217-456-7102

CONTRACT NO. 70D77

EXISTING S.N. 021-0030  
F.A.P. 820 (IL-130)  
EMBARRAS RIVER  
STATION 604+10.10  
BRIDGE REPAIR

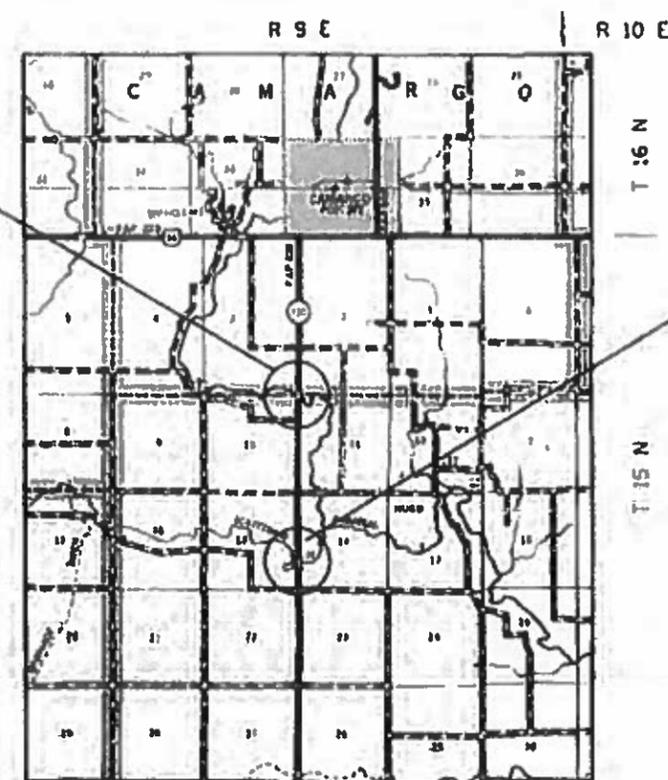

EXISTING S.N. 021-0031  
F.A.P. 820 (IL-130)  
SCATTERING FORK  
STATION 513+66.70  
BRIDGE REPAIR

GROSS LENGTH = 4.22 FT. = 0.008 MILE  
NET LENGTH = 4.22 FT. = 0.008 MILE

STATE OF ILLINOIS  
DEPARTMENT OF TRANSPORTATION

SUBMITTED *[Signature]* 2019  
DEPUTY DIRECTOR OF HIGHWAYS, REGION 3 ENGINEER

*[Signature]*  
ENGINEER OF DESIGN AND ENVIRONMENT

*[Signature]* 13  
DIRECTOR OF HIGHWAYS PROJECT IMPLEMENTATION

PRINTED BY THE AUTHORITY  
OF THE STATE OF ILLINOIS








### STAGE I CONSTRUCTION

S.N. 021-0030

- PRE-STAGE PPC SHOULDER WIDENING 6" (EARTH EXCAVATION & PPC SHOULDERS)
- AGGREGATE SHOULDER, TYPE B (WEDGE)

PORTLAND CEMENT CONCRETE SHOULDERS 6" (Pre-Stage PPC Shoulder 6") Stage I & II						
Structure	Side	Begin Station	End Station	Length (foot)	Shldr Width (foot)	Area (sq yd)
021-0030	Right	600+98	602+93.3	195.3	3.0	65.10
	Right	605+27	607+22	195.0	3.0	65.00
	Left	600+98	602+93.3	195.3	3.0	65.10
	Left	605+27	607+22	195.0	3.0	65.00
					<b>Totals</b>	<b>260.20</b>
					<b>Use</b>	<b>261.00</b>

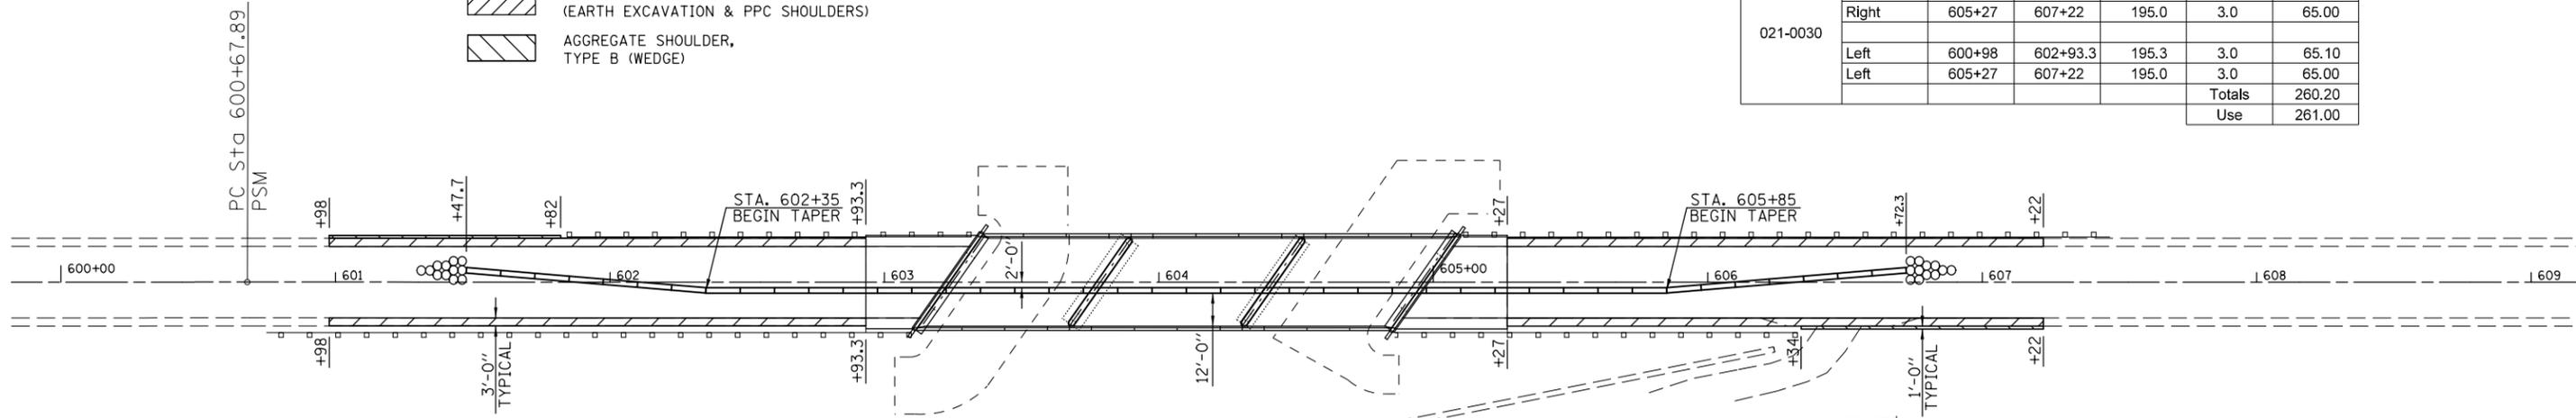

EARTH EXCAVATION Stage I & II							
Structure	Side	Begin Station	End Station	Length (foot)	Shldr Width (foot)	Depth (foot)	Removal (cu yd)
021-0030	Right	600+98	602+93.3	195.3	3.0	0.5	10.85
	Right	605+27	607+22	195.0	3.0	0.5	10.84
	Left	600+98	602+93.3	195.3	3.0	0.5	10.85
	Left	605+27	607+22	195.0	3.0	0.5	10.84
						<b>Totals</b>	<b>43.38</b>
						<b>Use</b>	<b>44.00</b>

AGGREGATE SHOULDER, TYPE B (WEDGE) (Pre-Stage) Stage I & II							
Structure	Side	Begin Station	End Station	Length (foot)	Shldr Width (foot)	Area (cu yd)	AGG. Tons
021-0030	Right	606+34	607+22	88.0	1.0	0.82	1.68
	Left	600+98	601+82	84.0	1.0	0.78	1.60
						<b>Totals</b>	<b>3.28</b>
						<b>Use</b>	<b>4.00</b>

**PLAN NOTES:**

ALL STAGING DETAILS SHALL BE IN ACCORDANCE WITH TRAFFIC CONTROL AND PROTECTION STANDARD 701321 AND PAID FOR AT THE CONTRACT UNIT PRICE PER EACH LOCATION.

ALL WORK WITHOUT TEMPORARY CONCRETE BARRIER IN PLACE SHALL BE IN ACCORDANCE WITH TRAFFIC CONTROL AND PROTECTION STANDARDS 701201 AND 701206.

FOR ADDITIONAL DETAILS ASSOCIATED WITH TEMPORARY CONCRETE BARRIER, SEE HIGHWAY STANDARD 701321.


REFLECTOR SHALL BE ATTACHED TO GUARDRAIL AND BARRIER WALL AT 25 FOOT CENTERS. COST TO BE INCLUDED WITH TRAFFIC CONTROL AND PROTECTION STANDARD 701321.

REFLECTORIZED TEMPORARY MARKING TAPE SHALL BE PLACED THROUGHOUT THE TAPER, AND ALONGSIDE BOTH SIDES OF THE WORK AREA. EXISTING MARKINGS THAT CONFLICT WITH THE STAGED TRAFFIC MARKINGS SHALL BE REMOVED OR COVERED. COST TO REMOVE EXISTING MARKINGS AND FOR THE PLACEMENT AND REMOVAL OF TEMPORARY MARKINGS SHALL BE INCLUDED WITH TRAFFIC CONTROL AND PROTECTION STANDARD 701321.

### STAGE II CONSTRUCTION

S.N. 021-0030

- PRE-STAGE PCC SHOULDER WIDENING 6" (EARTH EXCAVATION & HMA SHOULDERS)
- AGGREGATE SHOULDER, TYPE B (WEDGE)

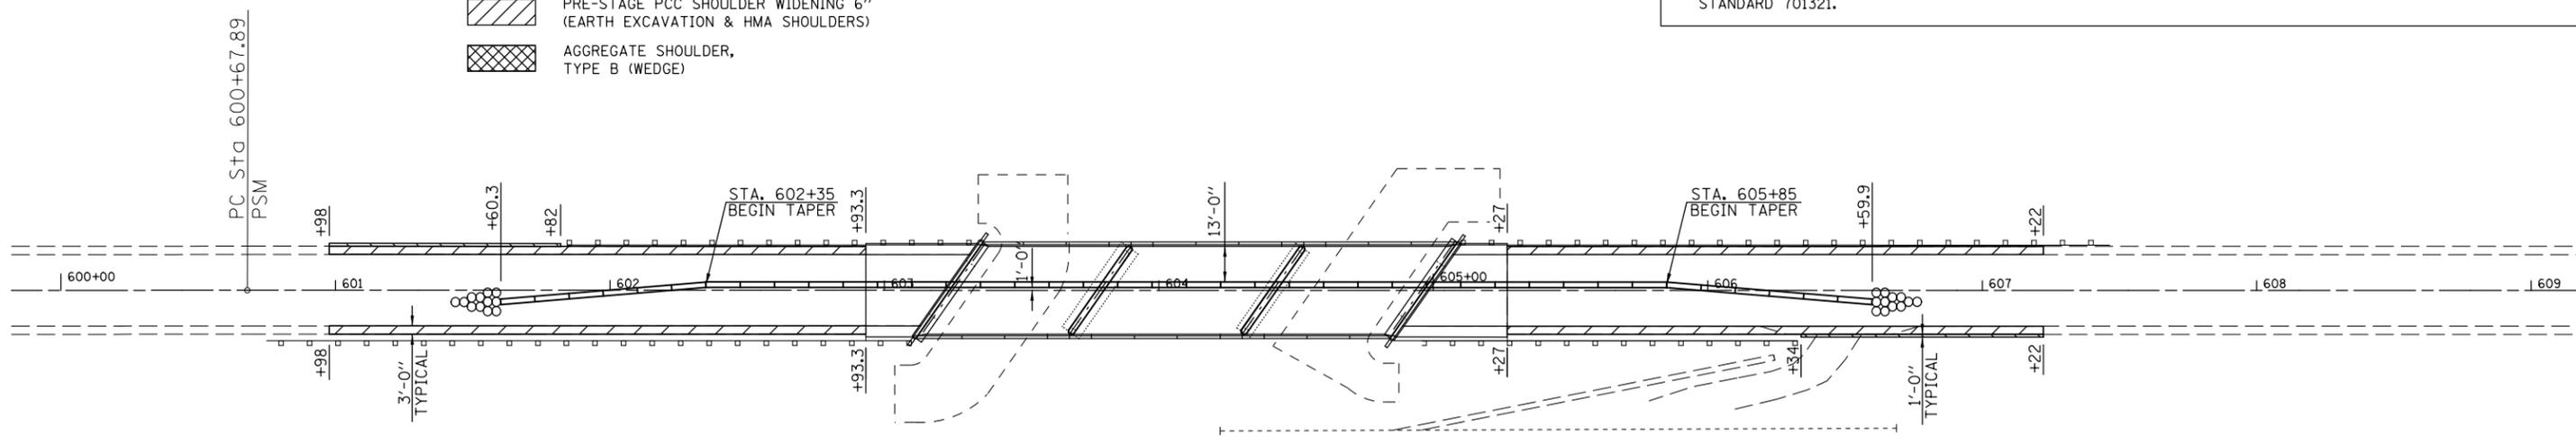

**BILL OF MATERIALS**

ITEM	UNIT	TOTAL
EARTH EXCAVATION	CU YD	44.0
PORTLAND CEMENT CONCRETE SHOULDERS 6"	SQ YD	261.0
AGGREGATE WEDGE SHOULDERS, TYPE B	TONS	4.0
TEMPORARY CONCRETE BARRIER	FOOT	525.0
RELOCATE TEMPORARY CONCRETE BARRIER	FOOT	500.0
IMPACT ATTENUATORS, TEMPORARY (NON-REDIRECTIVE), TEST LEVEL 3	EACH	2.0
IMPACT ATTENUATORS, RELOCATE (NON-REDIRECTIVE), TEST LEVEL 3	EACH	2.0

MODEL: \\MODEL\NAME: FILE: \\MODEL\NAME: PROJECT: \\PROJECT\NAME: DRAWING: \\DRAWING\NAME: DATE: 11/21/2019

USER NAME = shawleres	DESIGNED - ESS	REVISED -
PLOT SCALE = 60.0000' / in.	DRAWN - ESS	REVISED -
PLOT DATE = 11/21/2019	CHECKED - TJB	REVISED -
	DATE -	REVISED -

**STATE OF ILLINOIS  
DEPARTMENT OF TRANSPORTATION**

**TEMPORARY CONCRETE BARRIER DETAILS  
S.N. 021-0030**


SCALE: SHEET OF SHEETS STA. TO STA.

F.A.P. RTE.	SECTION	COUNTY	TOTAL SHEETS	SHEET NO.
820	[(1-G),(25)]BDR	DOUGLAS	56	5
CONTRACT NO. 70D77				
ILLINOIS FED. AID PROJECT				

# STAGE I CONSTRUCTION

## S.N. 021-0031

-  PRE-STAGE PPC SHOULDERS WIDENING 6" (EARTH EXCAVATION & PCC SHOULDERS)
-  AGGREGATE SHOULDER, TYPE B (WEDGE)

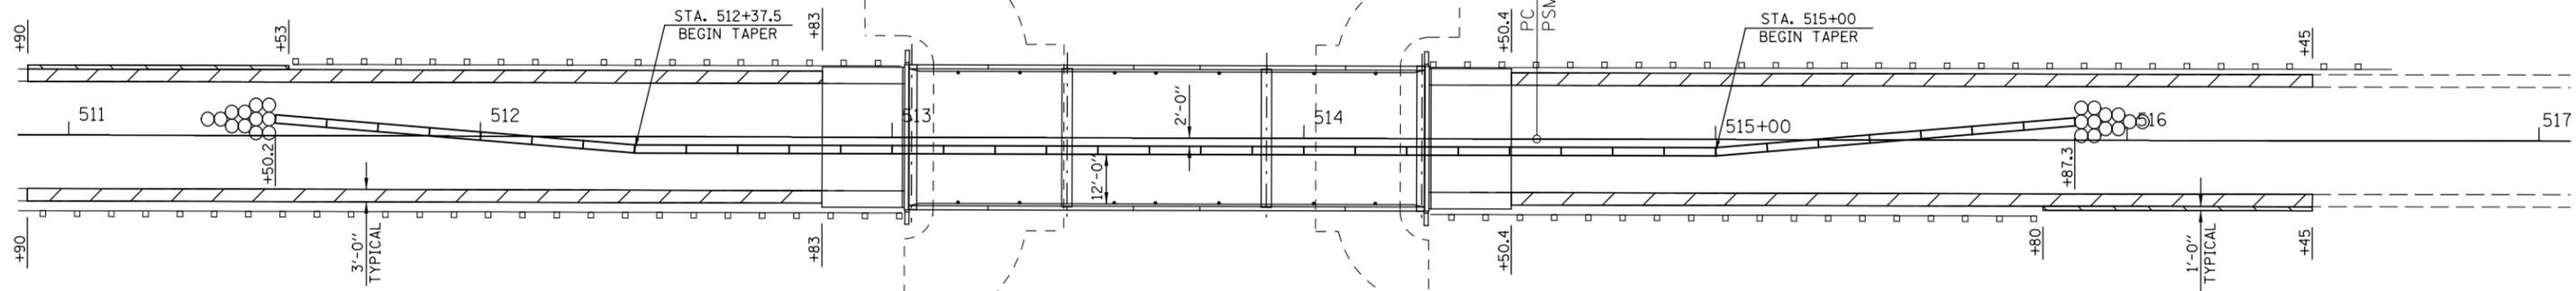

Structure	Side	Begin Station	End Station	Length (foot)	Shldr Width (foot)	Depth (foot)	Removal (cu yd)
021-0031	Right	510+90	512+83	193.0	3.0	0.5	10.72
	Right	514+50.4	516+45	194.6	3.0	0.5	10.81
	Left	510+90	512+83	193.0	3.0	0.5	10.72
	Left	514+50.4	516+45	194.6	3.0	0.5	10.81
Totals							43.06
Use							44.00

Structure	Side	Begin Station	End Station	Length (foot)	Shldr Width (foot)	Area (cu yd)	AGG. Tons
021-0031	Right	515+80	516+45	65.0	2.0	0.61	1.25
	Left	510+90	511+53	63.0	2.0	0.59	1.21
Totals							2.46
Use							3.00

Structure	Side	Begin Station	End Station	Length (foot)	Shldr Width (foot)	Area (sq yd)
021-0031	Right	510+90	512+83	193.0	3.0	64.33
	Right	514+50.4	516+45	194.6	3.0	64.87
	Left	510+90	512+83	193.0	3.0	64.33
	Left	514+50.4	516+45	194.6	3.0	64.87
Totals						258.40
Use						259.00

### PLAN NOTES:

ALL STAGING DETAILS SHALL BE IN ACCORDANCE WITH TRAFFIC CONTROL AND PROTECTION STANDARD 701321 AND PAID FOR AT THE CONTRACT UNIT PRICE PER EACH LOCATION.

ALL WORK WITHOUT TEMPORARY CONCRETE BARRIER IN PLACE SHALL BE IN ACCORDANCE WITH TRAFFIC CONTROL AND PROTECTION STANDARDS 701201 AND 701206.

FOR ADDITIONAL DETAILS ASSOCIATED WITH TEMPORARY CONCRETE BARRIER, SEE HIGHWAY STANDARD 701321.


REFLECTOR SHALL BE ATTACHED TO GUARDRAIL AND BARRIER WALL AT 25 FOOT CENTERS. COST TO BE INCLUDED WITH TRAFFIC CONTROL AND PROTECTION STANDARD 701321.

REFLECTORIZED TEMPORARY MARKING TAPE SHALL BE PLACED THROUGHOUT THE TAPER, AND ALONGSIDE BOTH SIDES OF THE WORK AREA. EXISTING MARKINGS THAT CONFLICT WITH THE STAGED TRAFFIC MARKINGS SHALL BE REMOVED OR COVERED. COST TO REMOVE EXISTING MARKINGS AND FOR THE PLACEMENT AND REMOVAL OF TEMPORARY MARKINGS SHALL BE INCLUDED WITH TRAFFIC CONTROL AND PROTECTION STANDARD 701321.

# STAGE II CONSTRUCTION

## S.N. 021-0031

-  PRE-STAGE PPC SHOULDERS WIDENING 6" (EARTH EXCAVATION & PCC SHOULDERS)
-  AGGREGATE SHOULDER, TYPE B (WEDGE)

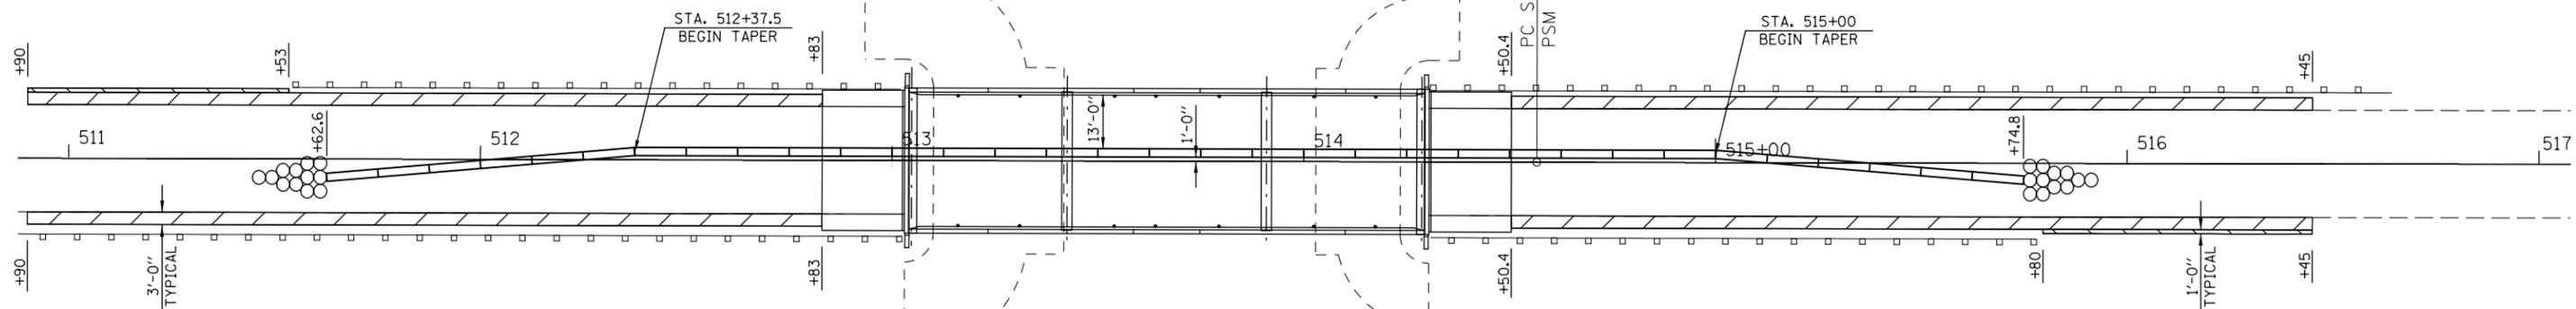

### BILL OF MATERIALS

ITEM	UNIT	TOTAL
EARTH EXCAVATION	CU YD	44.0
PORTLAND CEMENT CONCRETE SHOULDERS 6"	SQ YD	259.0
AGGREGATE WEDGE SHOULDERS, TYPE B	TONS	3.0
TEMPORARY CONCRETE BARRIER	FOOT	437.5
RELOCATE TEMPORARY CONCRETE BARRIER	FOOT	412.5
IMPACT ATTENUATORS, TEMPORARY (NON-REDIRECTIVE), TEST LEVEL 3	EACH	2.0
IMPACT ATTENUATORS, RELOCATE (NON-REDIRECTIVE), TEST LEVEL 3	EACH	2.0

STATE OF ILLINOIS  
DEPARTMENT OF TRANSPORTATION

TEMPORARY CONCRETE BARRIER DETAILS  
S.N. 021-0031

F.A.P. RTE.	SECTION	COUNTY	TOTAL SHEETS	SHEET NO.
820	[(1-G),(25)]BDR	DOUGLAS	56	6
CONTRACT NO. 70D77				
ILLINOIS FED. AID PROJECT				

SCALE: SHEET OF SHEETS STA. TO STA.








# STAGE I CONSTRUCTION DETAIL


S.N. 021-0030

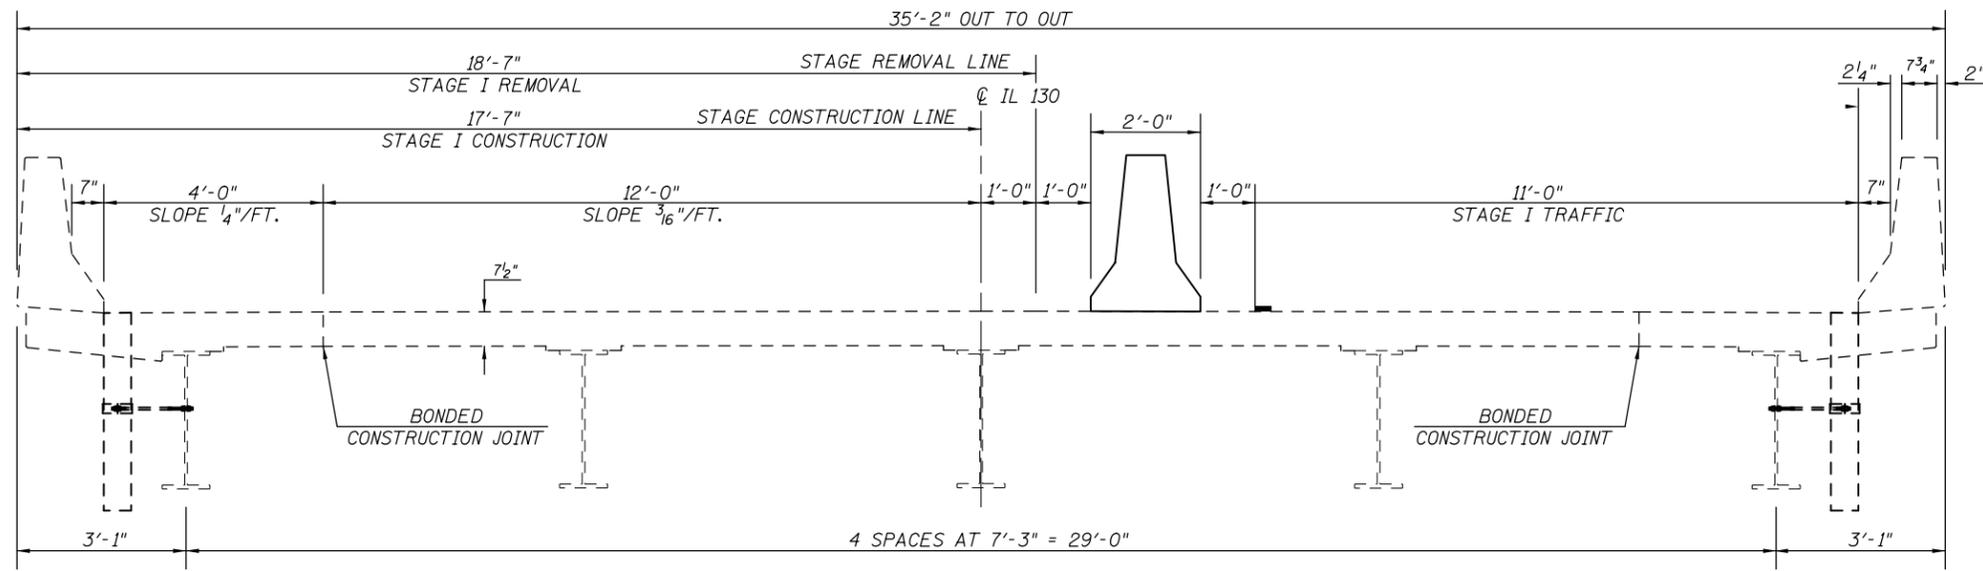

LOOKING NORTH

# STAGE II CONSTRUCTION DETAIL

S.N. 021-0030

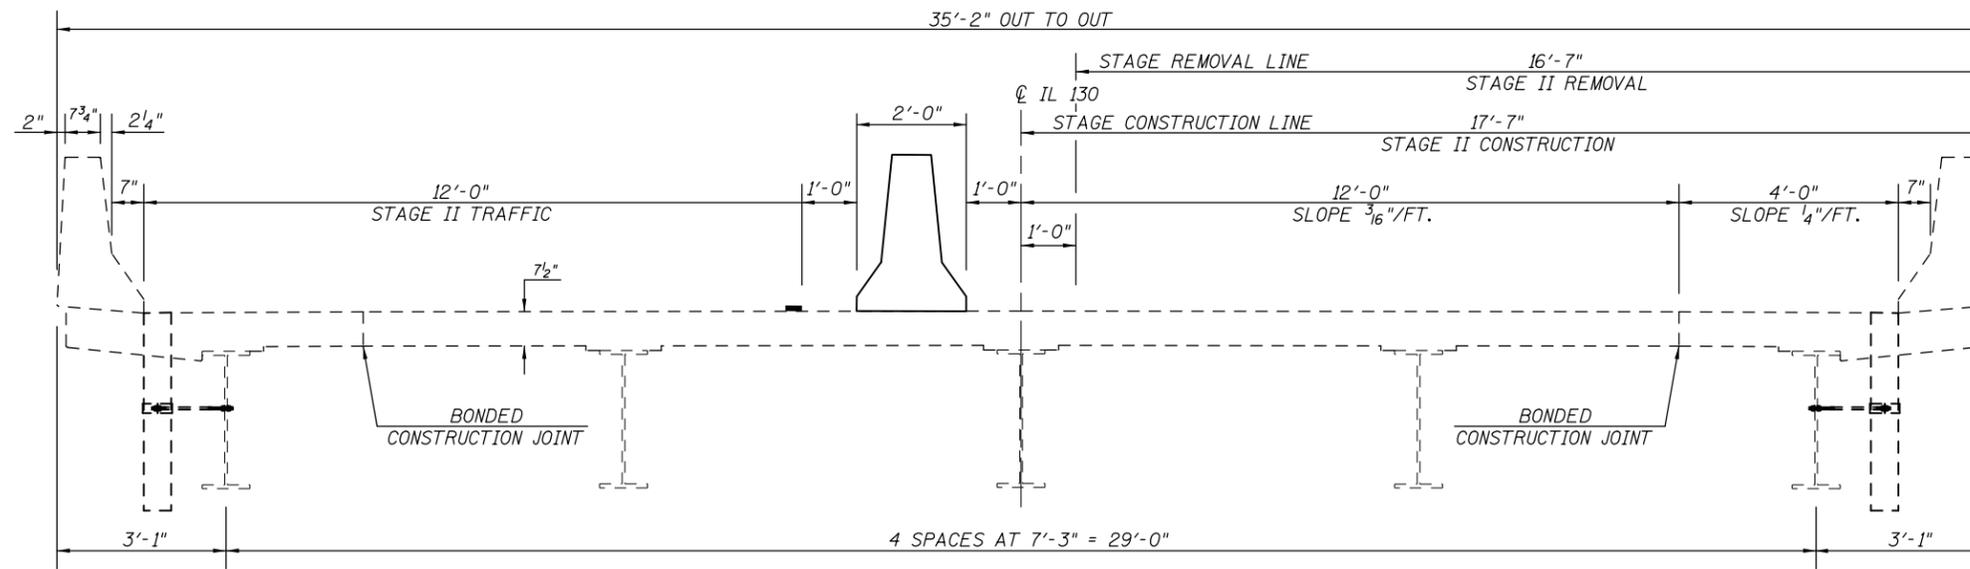

LOOKING NORTH

MODEL: \\MODEL\MHFE  
 FILE: \\MAILS\_P\pub\mcom\m.dwg  
 PROJECT: \\PROJECTS\DOT\_Offices\District\_5\Projects\021-0030\CADD\021-0030\_CAD.dwg  
 DATE: 11/21/2019

USER NAME = shawleres	DESIGNED -	REVISED - ESS
	DRAWN -	REVISED - ESS
PLOT SCALE = 40.0000' / in.	CHECKED -	REVISED - TJB
PLOT DATE = 11/21/2019	DATE -	REVISED -

STATE OF ILLINOIS  
DEPARTMENT OF TRANSPORTATION

STAGE CONSTRUCTION DETAILS  
S.N. 021-0030

SCALE: SHEET 4 OF 25 SHEETS STA. TO STA.

F.A.P. RTE.	SECTION	COUNTY	TOTAL SHEETS	SHEET NO.
820	[(1-G),(25)]BDR	DOUGLAS	56	10
CONTRACT NO. 70D77			ILLINOIS FED. AID PROJECT	










# CONCRETE SUPERSTRUCTURE DETAILS


S.N. 021-0030

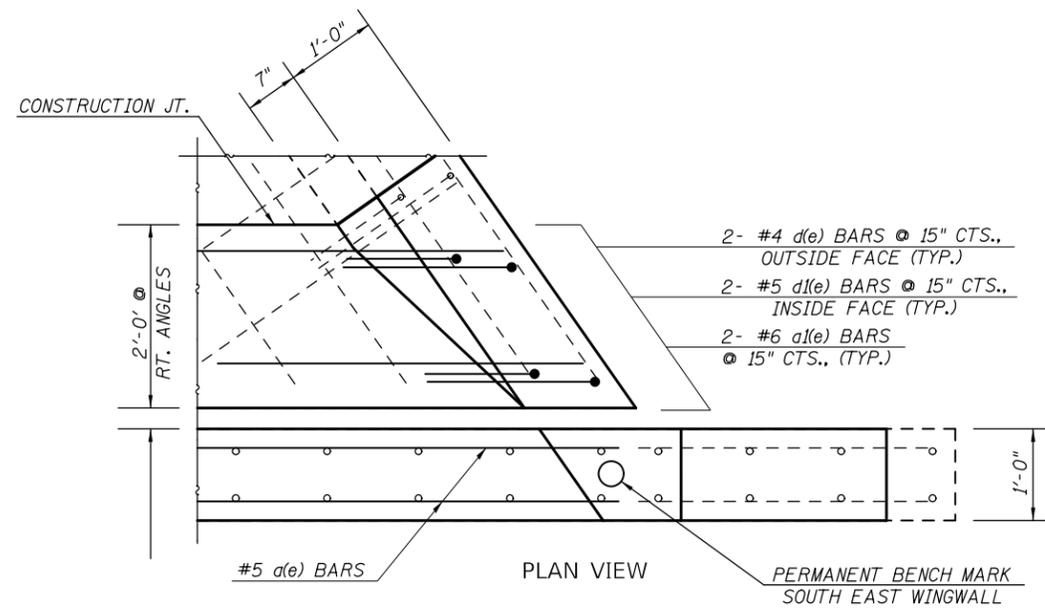


**VIEW E-E**  
**CONCRETE SUPERSTRUCTURE**  
ALL WINGWALLS (SIMILAR)

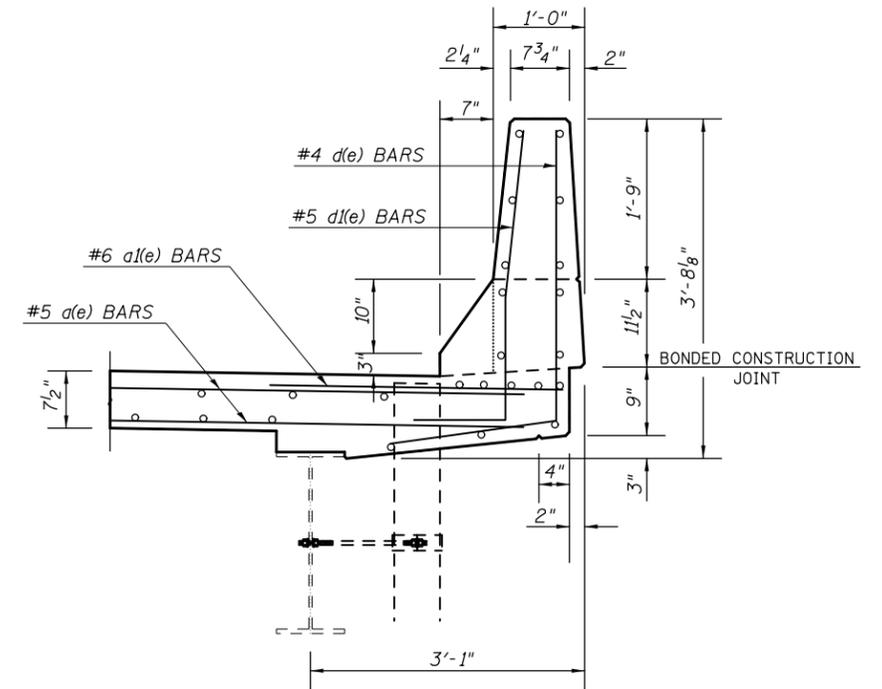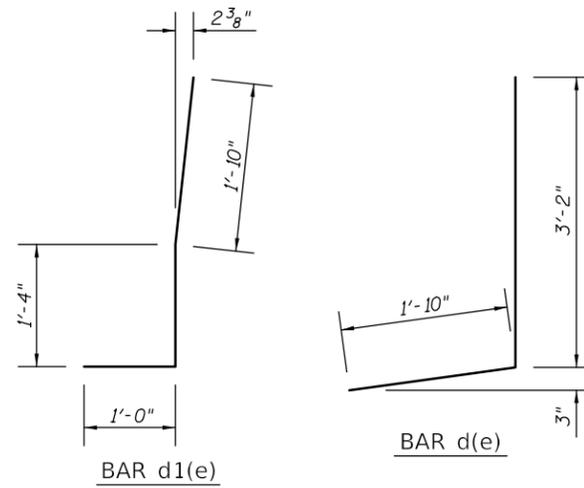

**SECTION B-B**  
**CONCRETE SUPERSTRUCTURE**

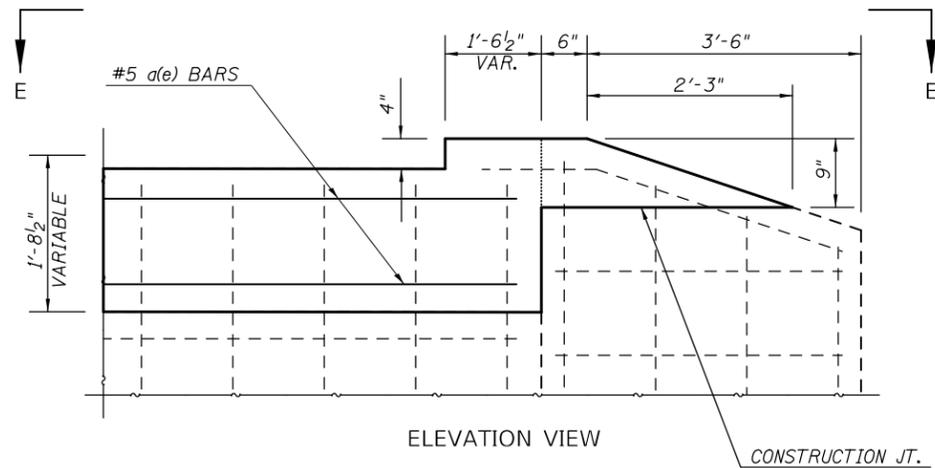

**SECTION D-D**  
**CONCRETE SUPERSTRUCTURE**  
ALL WINGWALLS (SIMILAR)

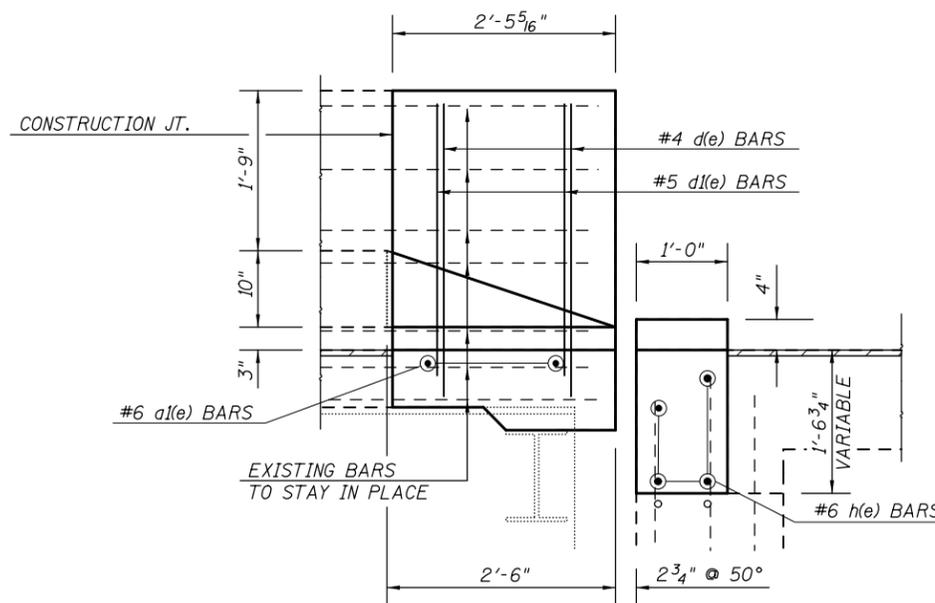

**SECTION C-C**  
**CONCRETE SUPERSTRUCTURE**

NOTE:

PROTECTIVE COAT SHALL BE APPLIED TO THE TOP AND INSIDE FACE OF PARAPETS AND DECK SURFACE OF NEW CONCRETE ADJACENT TO JOINTS.

## BILL OF MATERIALS

BAR	NO.	SIZE	LENGTH	SHAPE
a(e)	32	#5	20'-11"	▬
a1(e)	8	#6	4'-0"	▬
h(e)	16	#6	20'-11"	▬
d(e)	8	#4	5'-0"	▬
d1(e)	8	#5	4'-2"	▬

ITEM	UNIT	TOTAL
REINFORCEMENT BARS (EPOXY)	POUND	1,320.0
CONCRETE SUPERSTRUCTURE	POUND	11.8
BAR SPLICERS	EACH	24.0
PROTECTIVE COAT	SQ YD	33.0
PERMANENT BENCH MARK	EACH	1.0

STATE OF ILLINOIS  
DEPARTMENT OF TRANSPORTATION

CONCRETE SUPERSTRUCTURE - JOINTS  
S.N. 021-0030


SCALE: SHEET 8 OF 25 SHEETS STA. TO STA.

F.A.P. RTE.	SECTION	COUNTY	TOTAL SHEETS	SHEET NO.
820	[(1-G),(25)]BDR	DOUGLAS	56	14
CONTRACT NO. 70D77			ILLINOIS FED. AID PROJECT	


MODEL: \\MODEL\MAR\F... FILE NAME: P:\pub\mcom\da\allink\poc\RWIDOT\Documents\DOT\_Offices\Bldgct\_5\Projects\0570077\CADD\BldgCAD\Inres\0570077\_5ht\_5r02\_1-0030\_Cht.dgn

USER NAME = shawleres	DESIGNED - ESS	REVISED -
PLOT SCALE = 40.0000 ' / in.	DRAWN - ESS	REVISED -
PLOT DATE = 1/24/2020	CHECKED - TJB	REVISED -
	DATE -	REVISED -


MODEL: \$MODELNAME\$  
 FILE NAME: pw:\planroom\dot.illinois.gov\PWIDOT\Documents\DOT Offices\District 5\Projects\570D77\CADData\CADSheets\570D77\_sht\_Str\_021-0030\_Cm.dgn

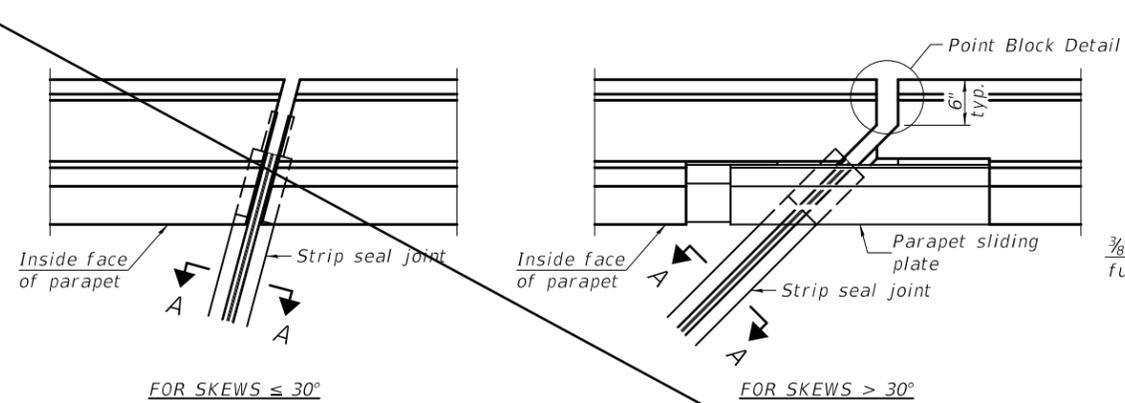

PLAN AT PARAPET

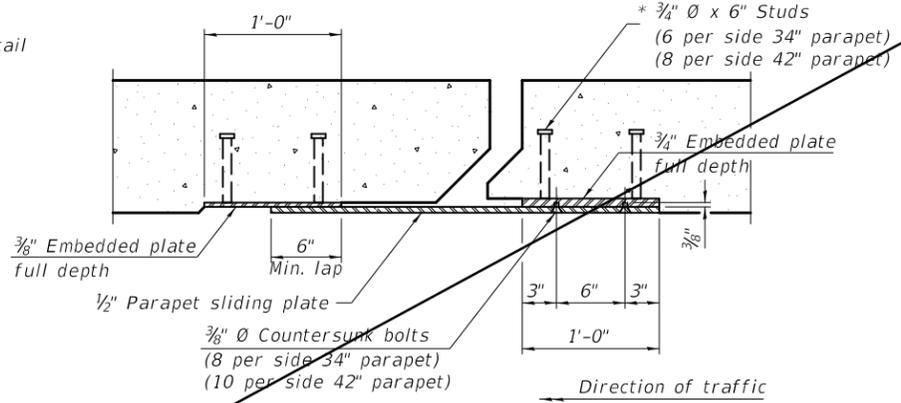


SECTION B-B

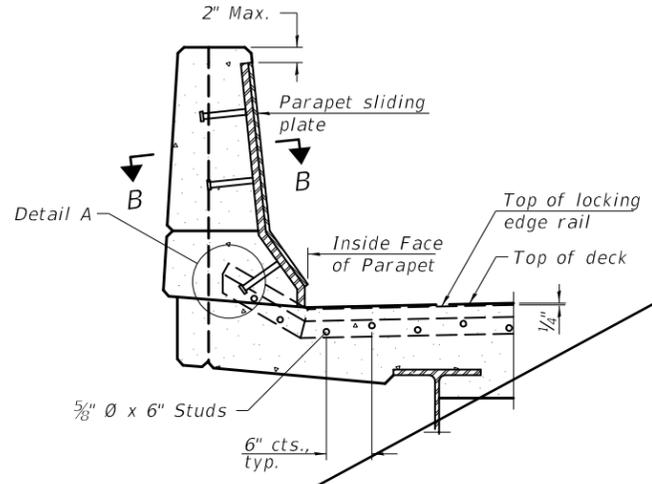


ELEVATION AT PARAPET

(Skews > 30 degrees shown. Skews <= 30 degrees similar except as shown in plan view.)

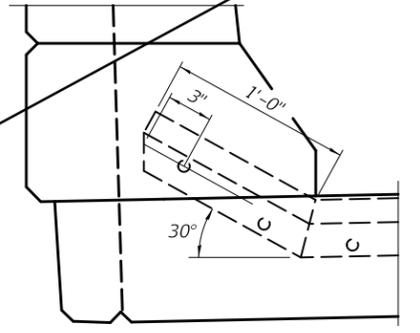


DETAIL A

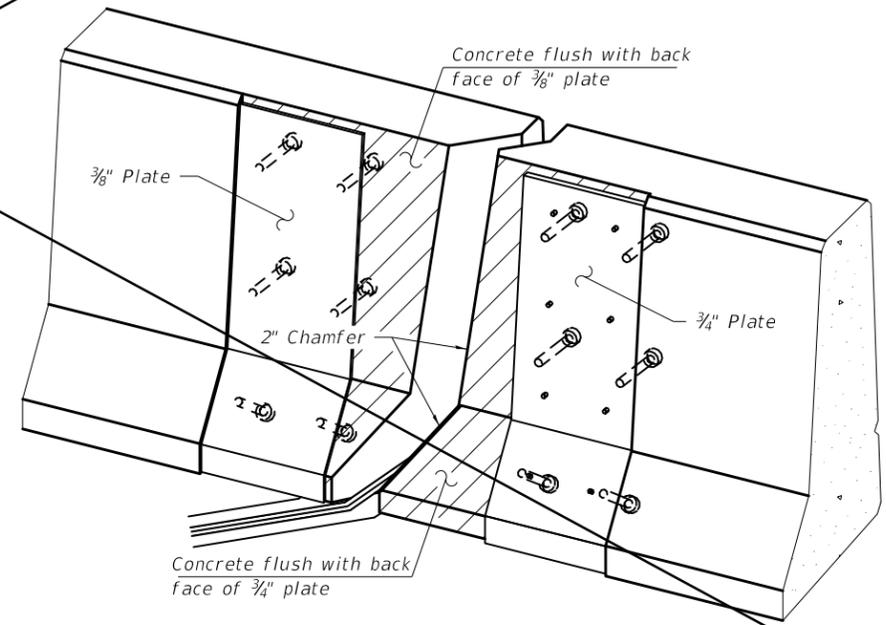


TRIMETRIC VIEW  
(Showing embedded plates only)

Notes:  
 The strip seal shall be made continuous and shall have a minimum thickness of 1/4 inch. The configuration of the strip seal shall match the configuration of the locking edge rails. Open or "webbed" strip seal gland configurations are not permitted. The gland shall be sized for a maximum rated movement of 4 inches.  
 The locking edge rails depicted are configured for typical applications and are conceptual only. The actual configuration of the locking edge rails and matching strip seal may vary from manufacturer to manufacturer provided they fit the application and meet the minimum anchorage shown. Flanged edge rails, however, will not be allowed. Locking edge rails may exceed the 4 1/2 inch maximum depth provided the anchorage system is revised according to the manufacturer's recommendation.  
 The manufacturer's recommended installation methods shall be followed.  
 All steel components shall be galvanized after fabrication according to Article 520.03 of the Standard Specifications.  
 The Maximum space between locking edge rail segments shall be 3/16 inch and sealed with a suitable sealant; however, any rail joint within 10 feet measured perpendicular to the face of the curb or parapet shall be welded as shown in the locking edge rail splice detail.  
 Cost of parapet sliding plates, embedded plates, and anchorage studs included with Preformed Joint Strip Seal.  
 34 inch F-shape barrier shown, 42 inch F-shape similar as noted.  
 The concrete opening below the strip seal will vary based on the locking edge rail chosen by the Contractor. Deck and parapet lengths shown elsewhere in the plans are dimensioned to the concrete opening, not the joint opening, and are based on the rolled locking edge rail. If the Contractor elects to use a different locking edge rail, dimensional adjustments may be required. One exception to this would be the strip seal joint at the end of the precast bridge approach slab. For these cases the pavement connector length shall be adjusted, not the length of the bridge approach slab.

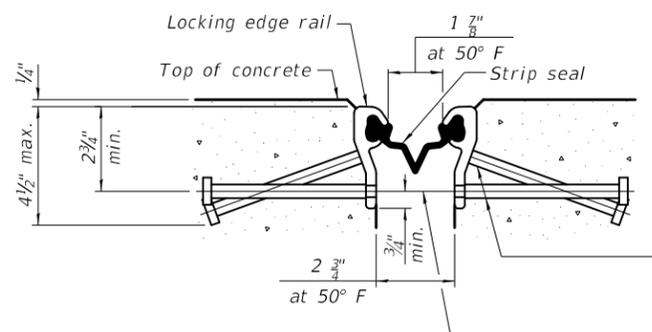


SHOWING ROLLED RAIL JOINT

\* 5/8 inch diameter x 6 inch studs @ 6 inch center to center. (alternate angled/bent studs with horizontal studs)  
 3/8 inch diameter threaded rods in 7/16 inch diameter holes at +/- 4 inch center to center for holding the proper joint opening based on the temperature during the deck pour. Place to miss studs. All rods shall be burned, or sawed off flush with the plates after concrete is set.

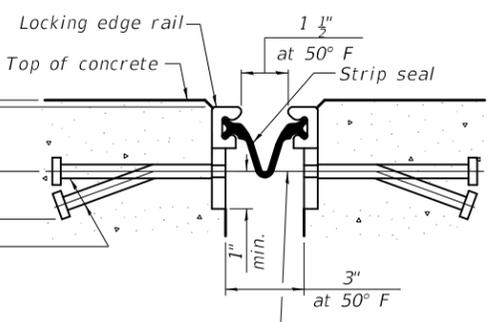


SHOWING WELDED RAIL JOINT

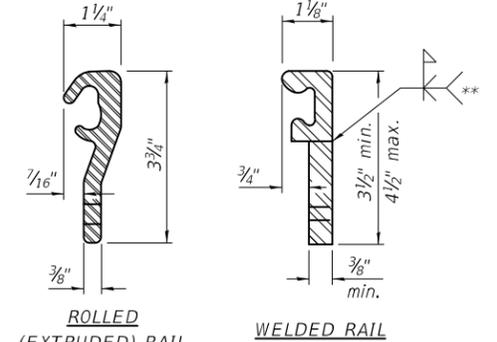

LOCKING EDGE RAILS

\*\* Back gouge not required if complete joint penetration is verified by mock-up.

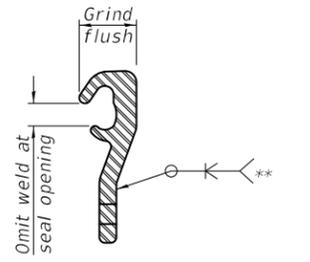

LOCKING EDGE RAIL SPLICE

The inside of the locking edge rail groove shall be free of weld residue. Rolled rail shown, welded rail similar.

BILL OF MATERIAL

Item	Unit	Total
Preformed Joint Strip Seal	Foot	94.0

EJ-SS 1-24-2020


USER NAME =	DESIGNED -	REVISED -
PLOT SCALE =	CHECKED -	REVISED -
PLOT DATE =	DRAWN -	REVISED -
	CHECKED -	REVISED -

STATE OF ILLINOIS  
 DEPARTMENT OF TRANSPORTATION


PREFORMED JOINT STRIP SEAL  
 STRUCTURE NO. 021-0030

SHEET 9 OF 25 SHEETS


F.A. RTE.	SECTION	COUNTY	TOTAL SHEETS	SHEET NO.
			56	15
CONTRACT NO.				
ILLINOIS FED. AID PROJECT				

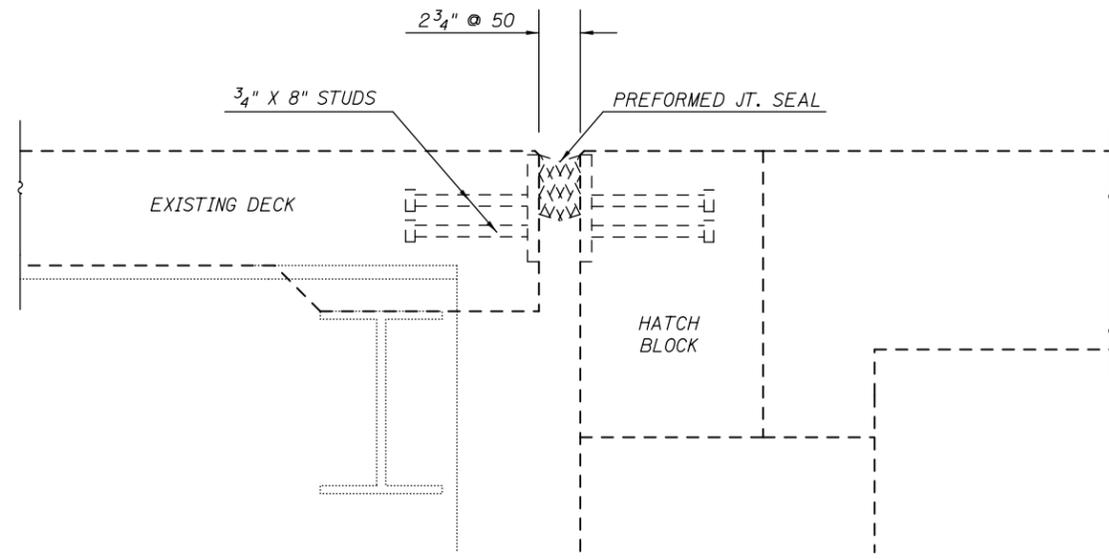


**SECTION AT EXISTING JOINT**

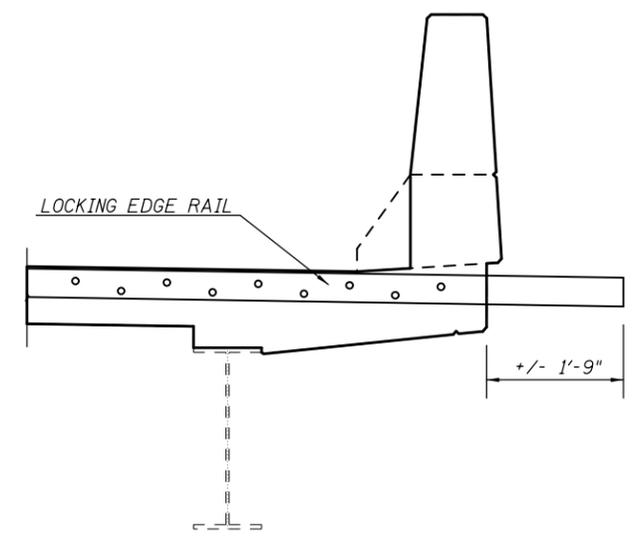

**SECTION AT PROPOSED JOINTS**

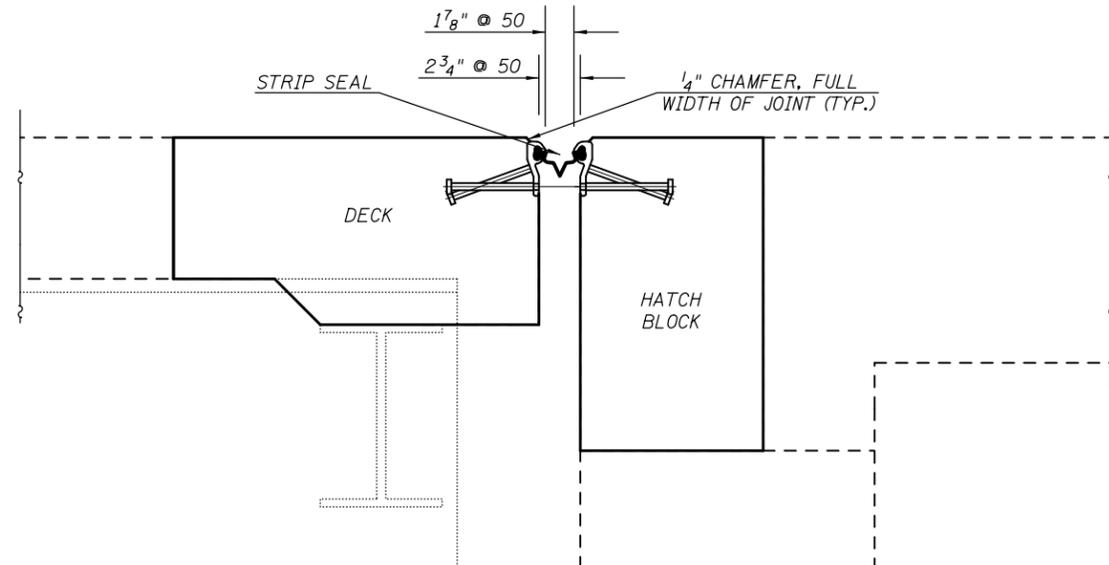

**SECTION AT PROPOSED JOINTS**

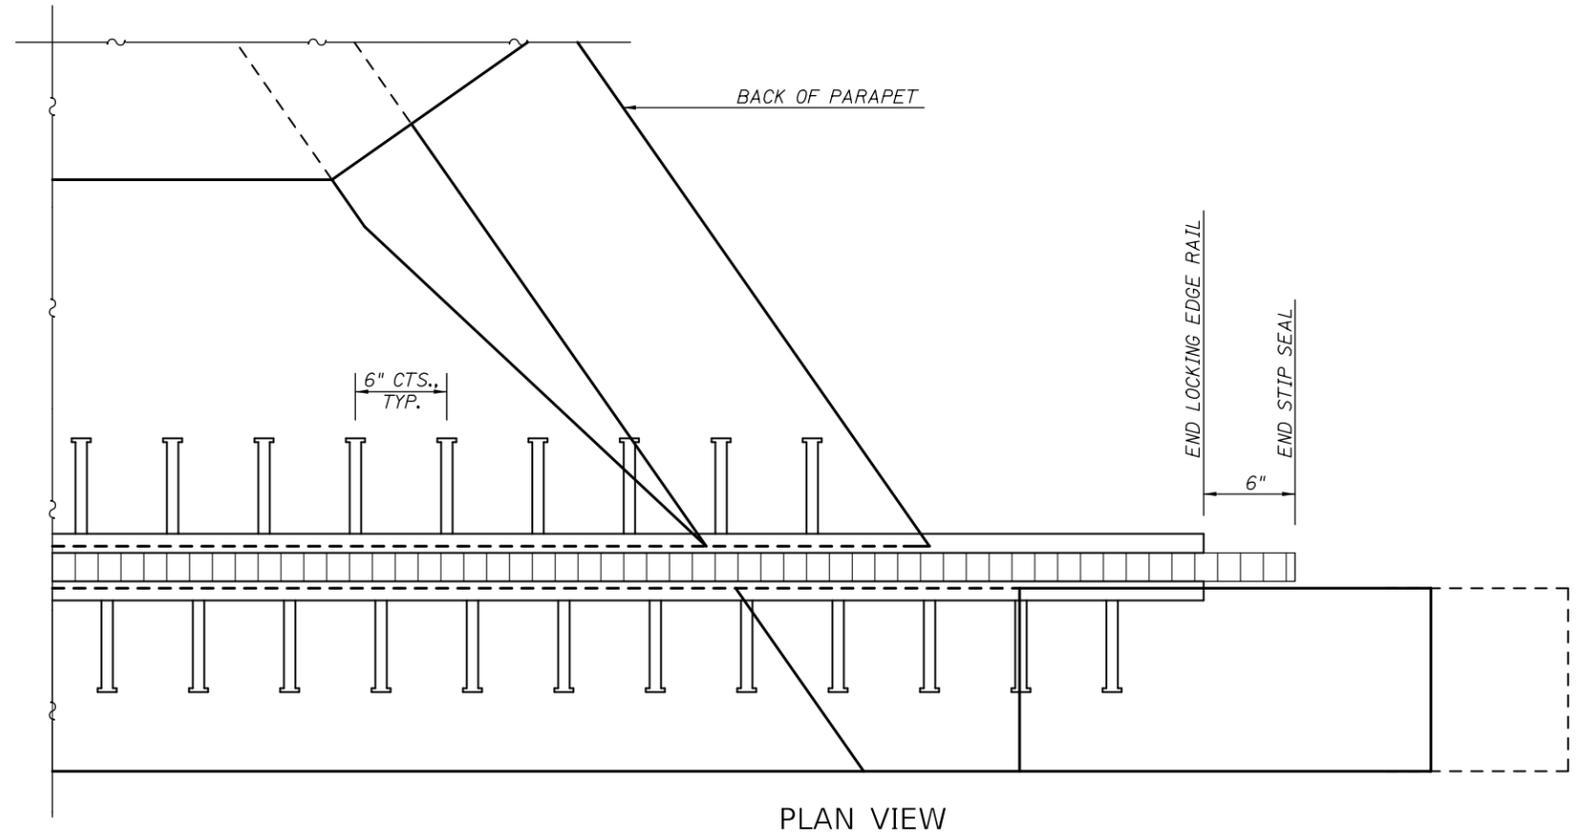

PLAN VIEW



**PROPOSED JOINTS**  
ALL WINGWALLS (SIMILAR)

MODEL: \\MODEL\MARF...  
 FILE NAME: ...  
 PROJECT: ...  
 DATE: 11/21/2019


USER NAME = shawleres	DESIGNED - ESS	REVISED -
PLOT SCALE = 40.0000 ' / in.	DRAWN - ESS	REVISED -
PLOT DATE = 11/21/2019	CHECKED - TJB	REVISED -
	DATE -	REVISED -

**STATE OF ILLINOIS**  
**DEPARTMENT OF TRANSPORTATION**

**JOINT REPLACEMENT DETAIL**  
**S.N. 021-0030**

SCALE: SHEET 10 OF 25 SHEETS STA. TO STA.

F.A.P. RTE.	SECTION	COUNTY	TOTAL SHEETS	SHEET NO.
820	[(1-G),(25)]BDR	DOUGLAS	56	16
CONTRACT NO. 70D77			ILLINOIS FED. AID PROJECT	

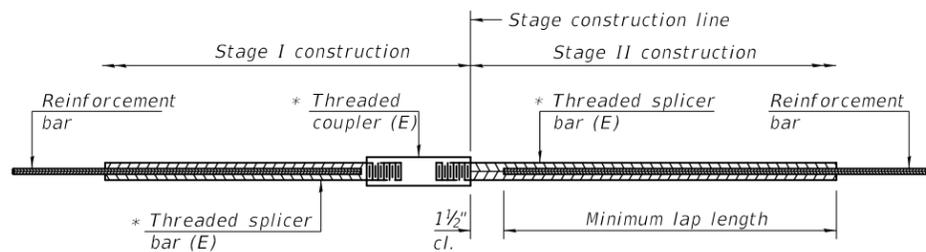


**STANDARD BAR SPLICER ASSEMBLY**

Threaded splicer bar length = min. lap length + 1 1/2" + thread length


\* Epoxy not required on Bar Splicer Assembly components used in conjunction with black bars.

Location	Bar size	No. assemblies required	Minimum lap length
HATCH BLOCKS	#6	8.0	4'-0"
DECK ENDS	#5	16.0	3'-6"

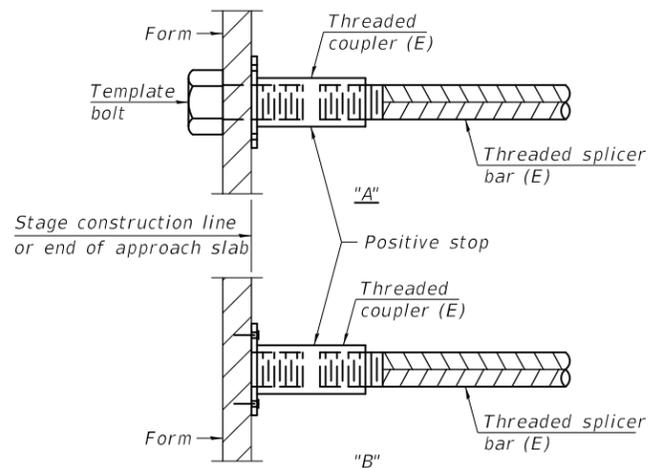


**INSTALLATION AND SETTING METHODS**

"A" : Set bar splicer assembly by means of a template bolt.  
 "B" : Set bar splicer assembly by nailing to wood forms or cementing to steel forms.  
 (E) : Indicates epoxy coating.

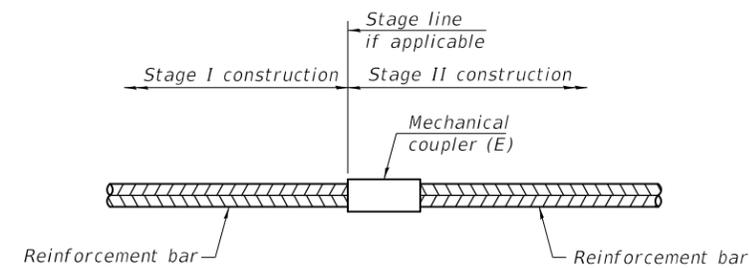

**STANDARD MECHANICAL SPLICER**

Location	Bar size	No. assemblies required

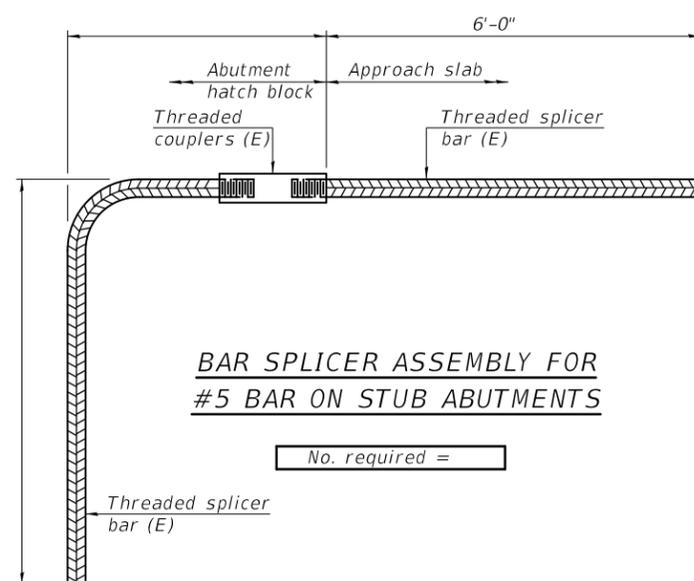

**BAR SPLICER ASSEMBLY FOR #5 BAR ON STUB ABUTMENTS**

No. required =

**NOTES**

Splicer bars shall be deformed with Threaded ends and have a minimum 60 ksi yield strength.  
 All reinforcement shall be lapped and tied to the splicer bars.  
 Bar splicer assemblies shall be epoxy coated according to the requirements for reinforcement bars. See Section 508 of the Standard Specifications.  
 See approved list of bar splicer assemblies and mechanical splicers for alternatives.

MODEL: \\MODEL\MAR\F... FILE NAME: P:\pub\mcom\m... \projects\021-0030\_Cat.dgn

BSD-1

2-17-2017


USER NAME = shawleres	DESIGNED -	REVISED -
PLOT SCALE = 40.0000 ' / in.	DRAWN -	REVISED -
PLOT DATE = 11/21/2019	CHECKED -	REVISED -
	DATE -	REVISED -

**STATE OF ILLINOIS  
DEPARTMENT OF TRANSPORTATION**

**BAR SPLICER ASSEMBLY AND MECHANICAL SPLICER DETAILS  
STRUCTURE NO. 021-0030**

SCALE: SHEET 11 OF 25 SHEETS STA. TO STA.

F.A.P. RTE.	SECTION	COUNTY	TOTAL SHEETS	SHEET NO.
820	[(1-G),(25)]BDR	DOUGLAS	56	17
CONTRACT NO. 70D77			ILLINOIS FED. AID PROJECT	

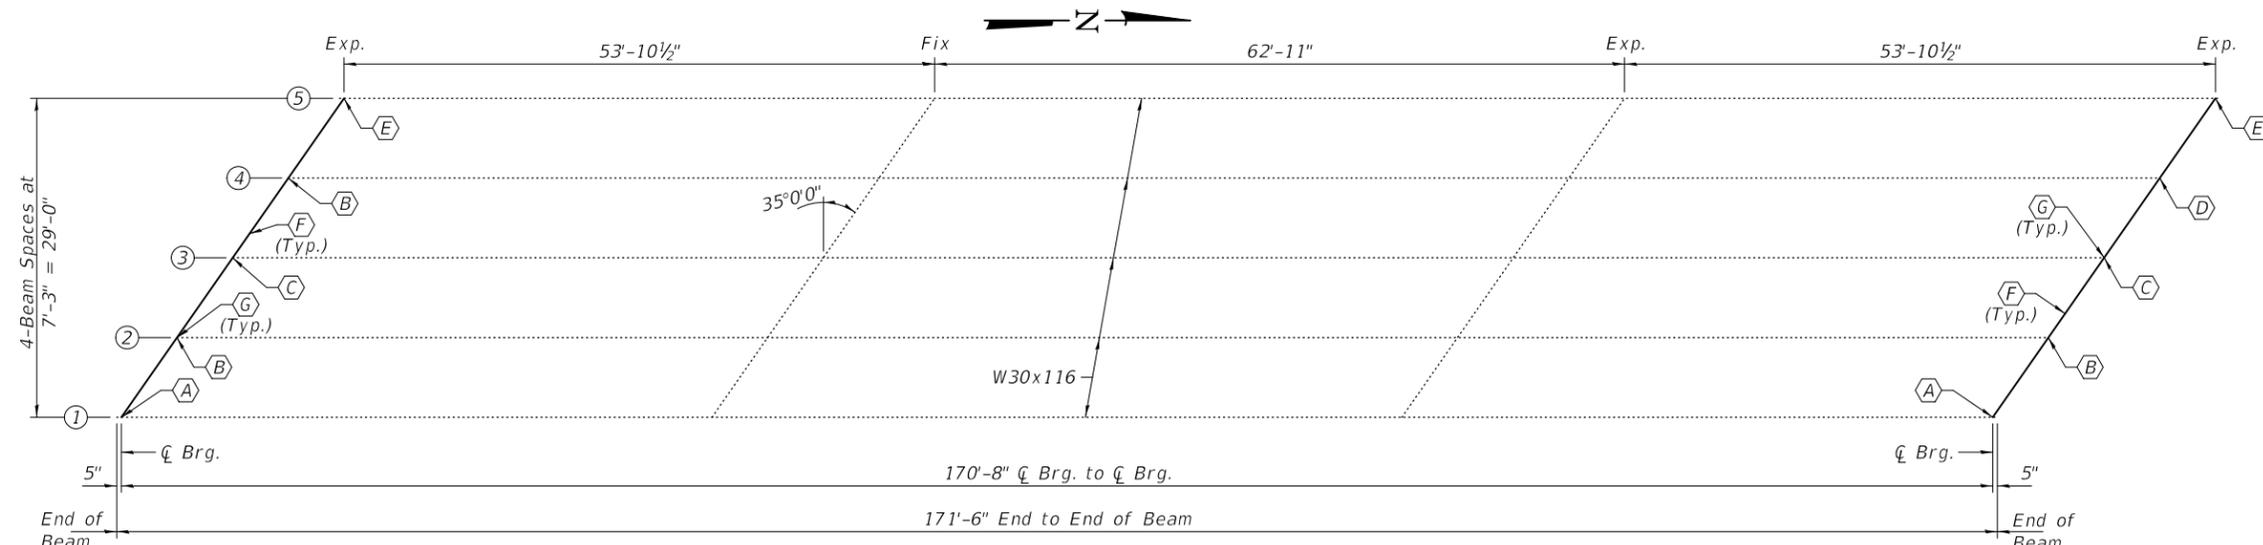

**FRAMING PLAN**


- Ⓐ - Beam End Repair (1N & 1S)
- Ⓑ - Beam End Repair (2N, 2S & 4S)
- Ⓒ - Beam End Repair (3N & 3S)
- Ⓓ - Beam End Repair (4N)
- Ⓔ - Beam End Repair (5N & 5S)
- Ⓕ - Remove & Replace Diaphragms at Both Abutments
- Ⓖ - Remove & Replace Bearings at Both Abutments

**GENERAL NOTES**

All structural steel shall conform to AASHTO Classification M-270 Gr. 50, unless otherwise noted.  
 Plan dimensions and details relative to existing plans are subject to nominal construction variations. The Contractor shall field verify existing dimensions and details affecting new construction and make necessary approved adjustments prior to construction or ordering of materials. Such variations shall not be cause for additional compensation for a change in scope of the work, however, the Contractor will be paid for the quantity actually furnished at the unit price bid for the work.  
 Fasteners shall be high strength bolts. Bolts 3/4"Ø, open holes 13/16"Ø, unless otherwise noted.  
 Existing structural steel that will be in contact with new structural steel shall be cleaned and painted prior to erection as required by the special provision "Cleaning and Painting Contact Surface Areas of Existing Steel Structures".  
 All new structural steel shall be hot-dip galvanized. See Special Provisions for "Hot Dip Galvanizing for Structural Steel."


**BOLT HOLE LEGEND**

- - Field drill using new or existing steel as template.
- - Shop drill holes in new steel.

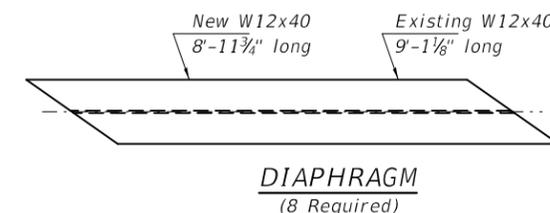


**REPAIR F**


Existing L 6"x4"x3/4" shall be removed by the air-arc method and grind smooth all weld material remaining on the web.

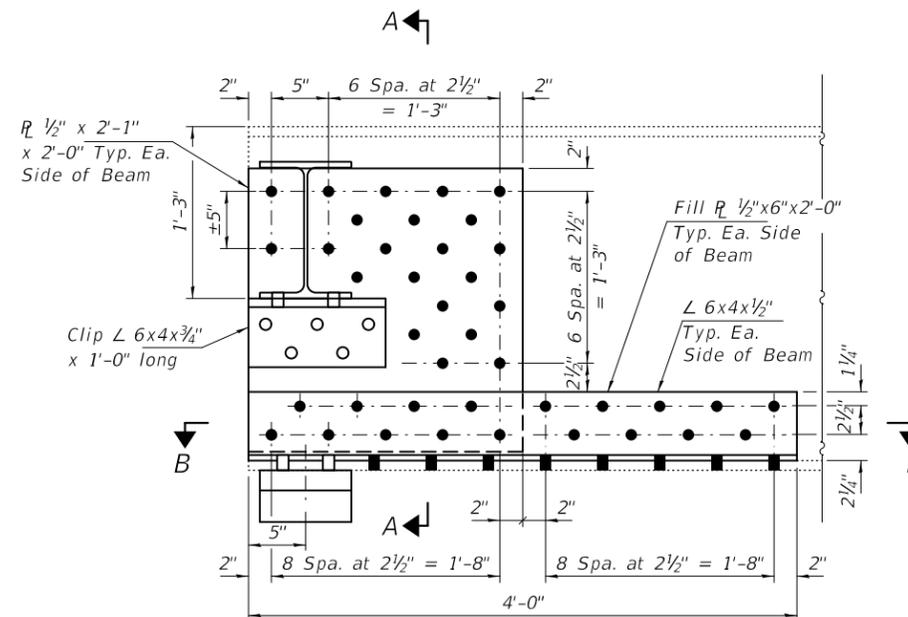


**REPAIR A**  
(2 Locations)

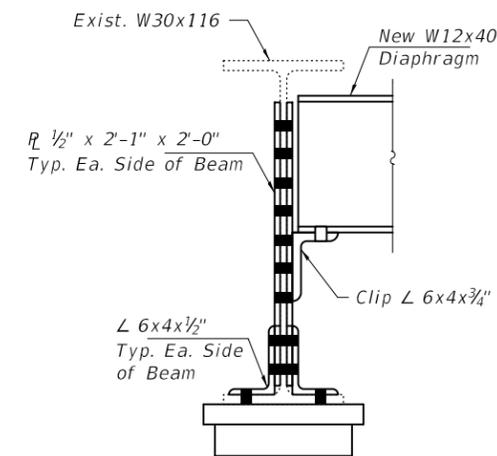

**SECTION A-A**

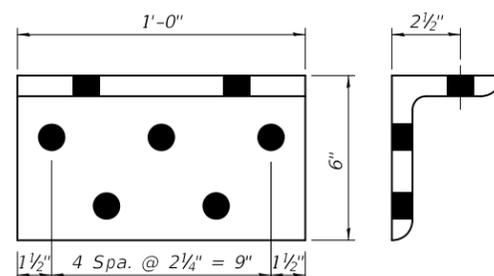

**CLIP ANGLE DETAILS**  
L 6x4x3/4" x 1'-0" long  
(8 Required)

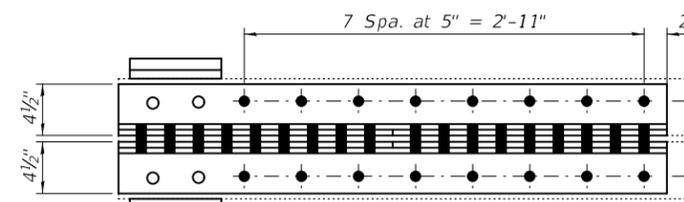

**SECTION B-B**

**BILL OF MATERIAL**

ITEM	UNIT	QUANTITY
Structural Steel Removal	Pound	3320
Structural Steel Repair	Pound	3170
Furnishing and Erecting Structural Steel	Pound	3300

DESIGNED - JSB  
 CHECKED - AJR  
 DRAWN - Venkat Reddy  
 CHECKED - JSB AJR

EXAMINED - *Timothy A. Daulton*  
 ENGINEER OF STRUCTURAL SERVICES  
 PASSED - *Carl R. Meyer*  
 ENGINEER OF BRIDGES AND STRUCTURES


DATE - January 24, 2020  
 REVISED -  
 REVISED -

STATE OF ILLINOIS  
 DEPARTMENT OF TRANSPORTATION


GENERAL PLAN AND ELEVATION  
 FAP 820 OVER EMBARRAS RIVER  
 SN 021-0030

SHEET NO. 1 OF 5 SHEETS


F.A.P. RTE.	SECTION	COUNTY	TOTAL SHEETS	SHEET NO.
820	[(1-G),(25)]BDR	DOUGLAS	56	18
CONTRACT NO. 70D77				
ILLINOIS FED. AID PROJECT				

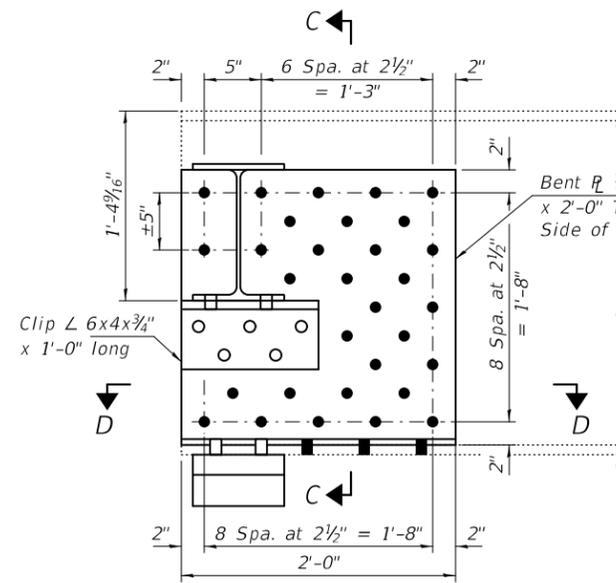


**REPAIR B**  
(3 Locations)

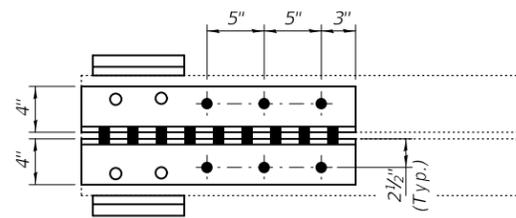


**SECTION D-D**

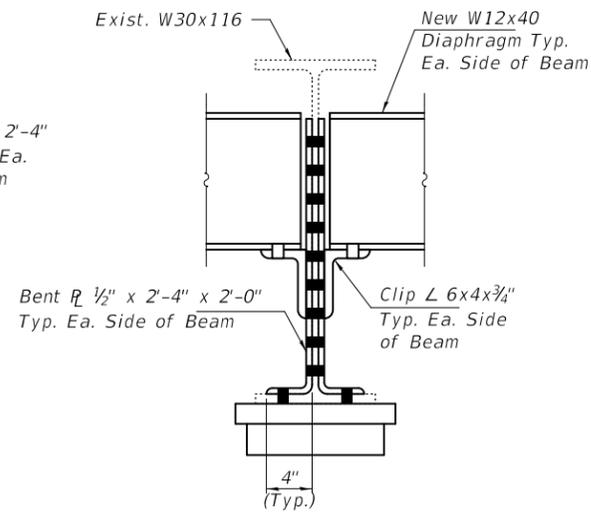


**SECTION C-C**

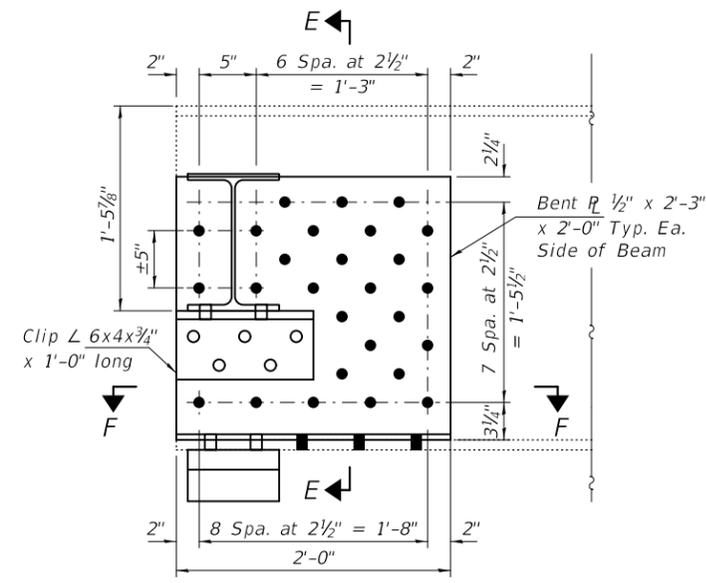

**REPAIR C**  
(2 Locations)

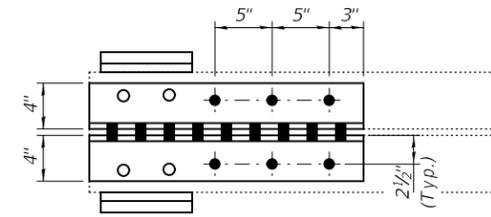

**SECTION F-F**

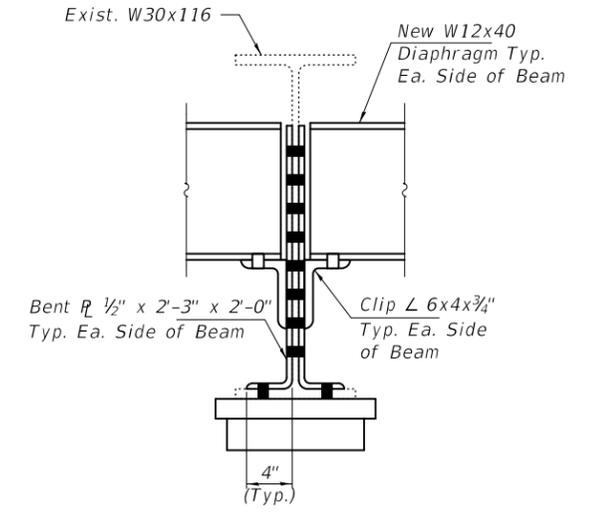

**SECTION E-E**

**BOLT HOLE LEGEND**

- - Field drill using existing steel as template.
- - Shop drill holes in new steel.

DESIGNED - JSB  
 CHECKED - AJR  
 DRAWN - Venkat Reddy  
 CHECKED - JSB AJR

EXAMINED  
 PASSED

Timothy A. ...  
 ENGINEER OF STRUCTURAL SERVICES

Carl ...  
 ENGINEER OF BRIDGES AND STRUCTURES

DATE - January 24, 2020


REVISED -  
 REVISED -

STATE OF ILLINOIS  
 DEPARTMENT OF TRANSPORTATION


BEAM END REPAIR DETAILS - REPAIR B & C  
 SN 021-0030

SHEET NO. 2 OF 5 SHEETS

F.A.P. RTE.	SECTION	COUNTY	TOTAL SHEETS	SHEET NO.
820	[(1-G),(25)]BDR	DOUGLAS	56	19
CONTRACT NO. 70D77				
ILLINOIS		FED. AID PROJECT		

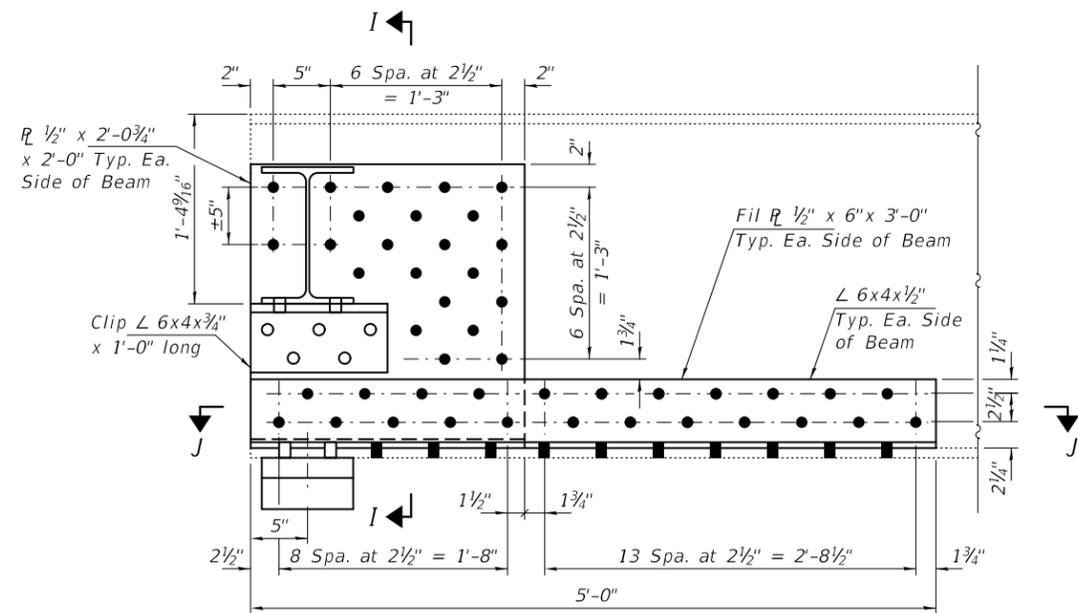


**REPAIR D**  
(1 Locations)

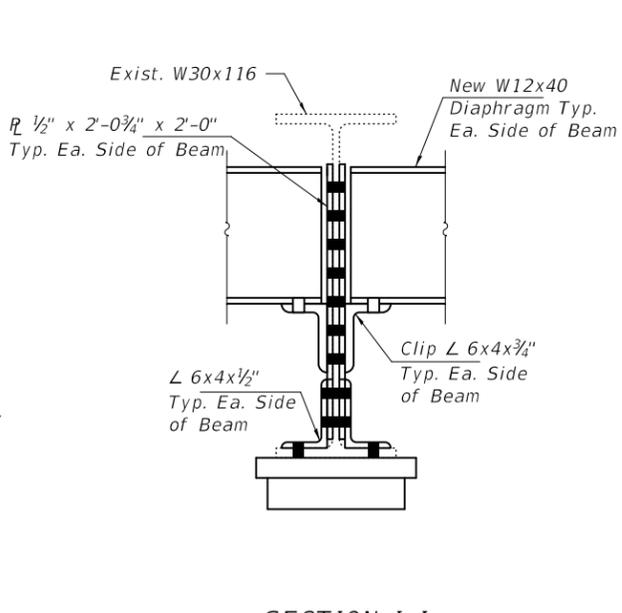


**SECTION I-I**


**BOLT HOLE LEGEND**  
 ○ - Field drill using existing steel as template.  
 ● - Shop drill holes in new steel.

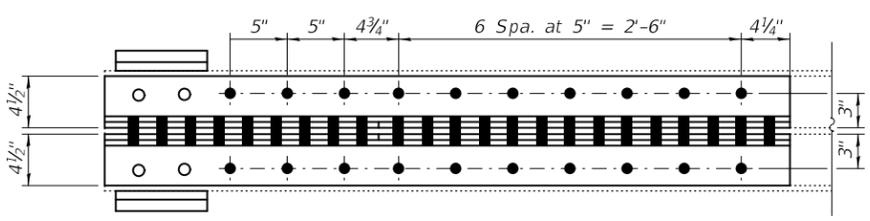


**SECTION J-J**

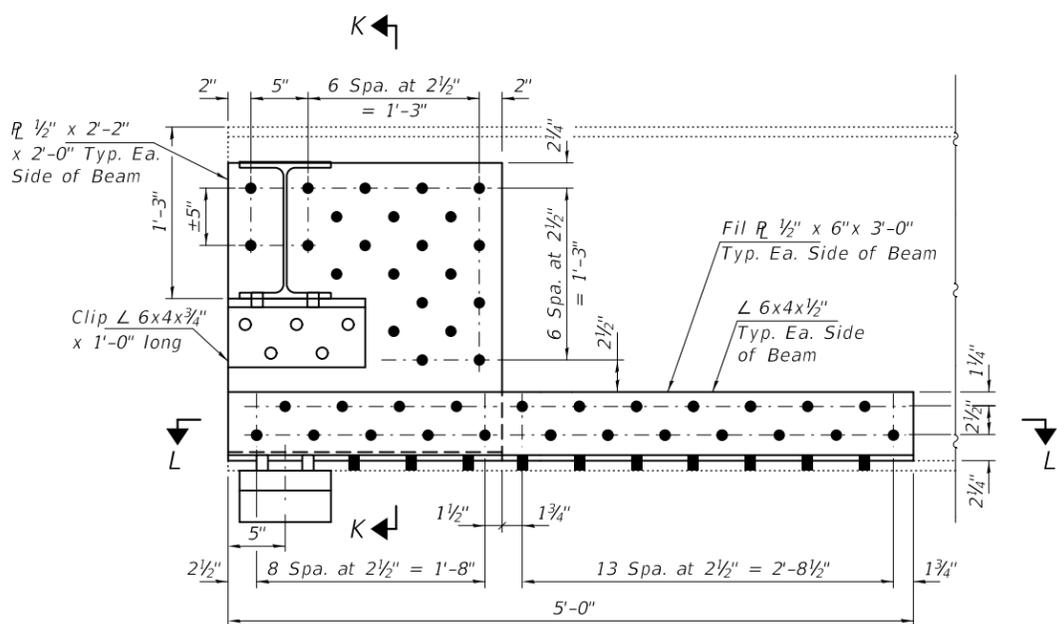

**REPAIR E**  
(2 Locations)

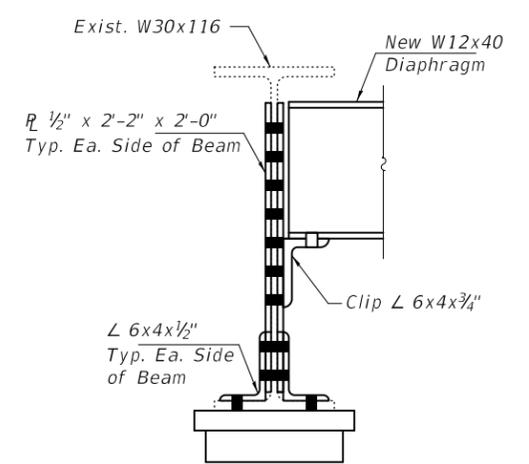

**SECTION K-K**

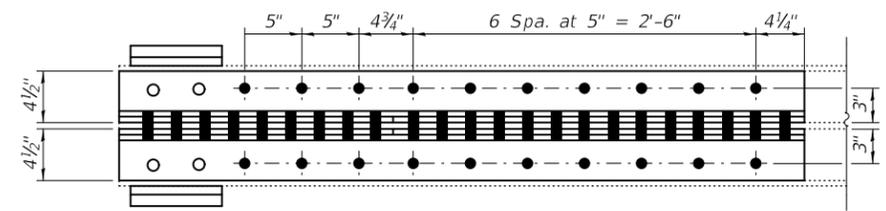

**SECTION L-L**


DESIGNED - JSB	EXAMINED - <i>Timothy A. Daulton</i> ENGINEER OF STRUCTURAL SERVICES	DATE - January 24, 2020
CHECKED - AJR	PASSED - <i>Carl R. Poyner</i> ENGINEER OF BRIDGES AND STRUCTURES	REVISED -
DRAWN - Venkat Reddy		REVISED -
CHECKED - JSB AJR		

**STATE OF ILLINOIS**  
**DEPARTMENT OF TRANSPORTATION**


**BEAM END REPAIR DETAILS - REPAIR D & E**  
**SN 021-0030**

SHEET NO. 3 OF 5 SHEETS

F.A.P. RTE. 820	SECTION [(1-G),(25)]BDR	COUNTY DOUGLAS	TOTAL SHEETS 56	SHEET NO. 20
			CONTRACT NO. 70D77	
ILLINOIS FED. AID PROJECT				

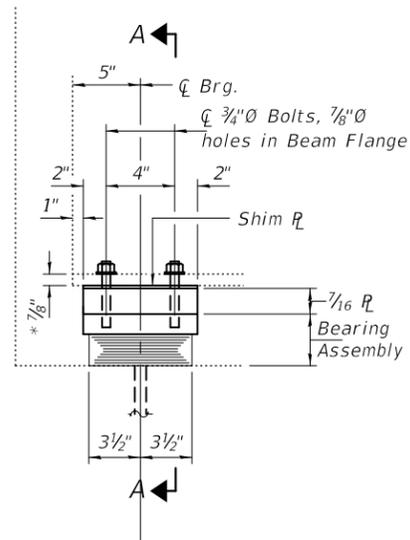


ELEVATION AT ABUTMENT

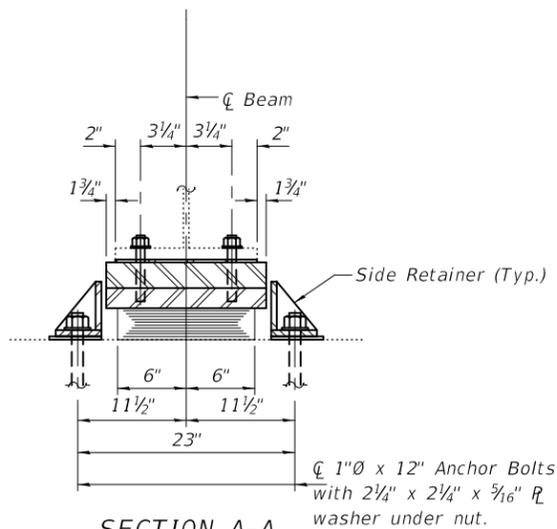

SECTION A-A


TYPE I ELASTOMERIC EXP. BRG.

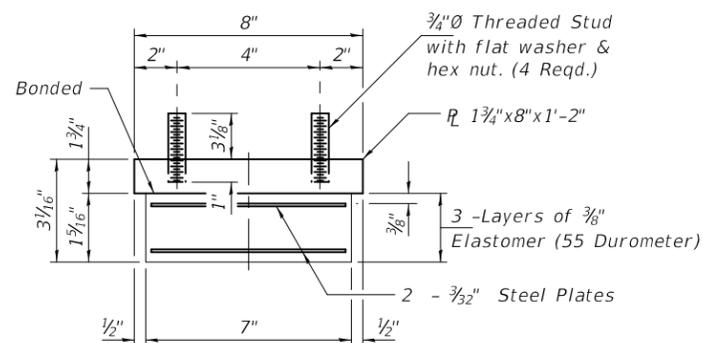

BEARING ASSEMBLY

Note:  
Shim plates shall not be placed under Bearing Assembly.

\* See sheets 1 thru 3 of 5 for additional repair  $R_L$  thickness

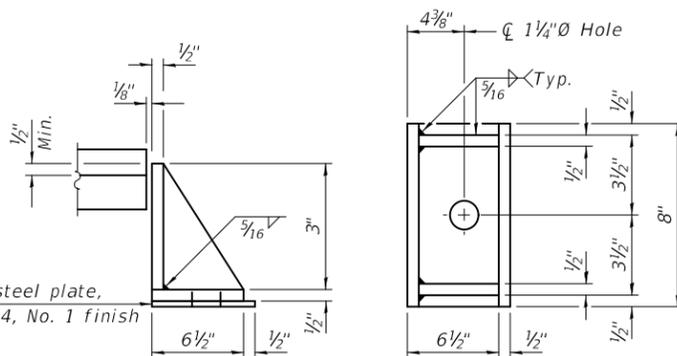

SIDE RETAINER

Equivalent rolled angle with stiffeners will be allowed in lieu of welded plates.

BEAM REACTIONS

R $\phi$	(K)	23.9
R $\downarrow$	(K)	42.3
Imp.	(K)	11.8
R (Total)	(K)	78.0

Notes:

All steel plates and structural steel shapes used in bearing assemblies shall be AASHTO M270 Gr. 36.

Diaphragm removal and reinstallation may be required to facilitate drilling holes. Cost included with Furnishing and Erecting Structural Steel.

New steel extensions, shim plates and connection bolts are included with Furnishing and Erecting Structural Steel.


Prior to ordering any material, the Contractor shall verify in the field all bearing height and shim thickness dimensions. Adjustment must account for deck heave due to pack rust (if present).

Min. jack capacity = 39 Tons.

Anchor bolts shall be ASTM F1554 all-thread (or an Engineer-approved alternate material) of the grade(s) and diameter(s) specified. ASTM A307 Grade C anchor bolts may be used in lieu of ASTM F1554 Grade 36 ( $F_y=36$ ksi). The corresponding specified grade of AASHTO M314 anchor bolts may be used in lieu of ASTM F1554.

Drilled and set anchor bolts shall be installed according to Article 521.06 of the Standard Specifications.

Cost of Side retainers and Stainless Steel plates shall be included in the cost of Elastomeric Bearing Assembly, Type I.

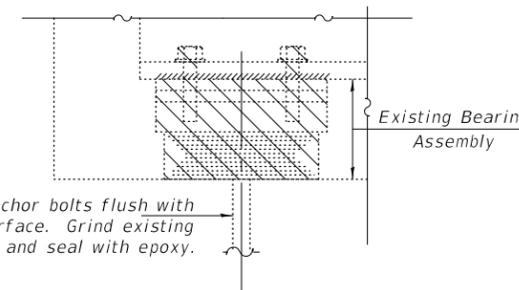

EXISTING BEARING REMOVAL DETAIL

Cost included with Jack and Remove Existing Bearings.

BILL OF MATERIAL

Item	Unit	Total
Elastomeric Bearing Assembly, Type I	Each	5
Jack and Remove Existing Bearings	Each	5
Furnishing and Erecting Structural Steel	Pound	110
Anchor Bolts, 1"Ø	Each	10

TYI/REPS 5-17-2018

DESIGNED - JSB  
CHECKED - AJR  
DRAWN - Venkat Reddy  
CHECKED - JSB AJR

EXAMINED  
PASSED  
Timothy A. [Signature]  
ENGINEER OF STRUCTURAL SERVICES  
[Signature]  
ENGINEER OF BRIDGES AND STRUCTURES


DATE - January 24, 2020  
REVISED -  
REVISED -

STATE OF ILLINOIS  
DEPARTMENT OF TRANSPORTATION


SOUTH ABUT. BEARING REPLACEMENT DETAILS - REPAIR G  
SN 021-0030

SHEET NO. 4 OF 5 SHEETS

F.A.P. RTE.	SECTION	COUNTY	TOTAL SHEETS	SHEET NO.
820	[(1-G),(25)]BDR	DOUGLAS	56	21
CONTRACT NO. 70D77				
ILLINOIS FED. AID PROJECT				

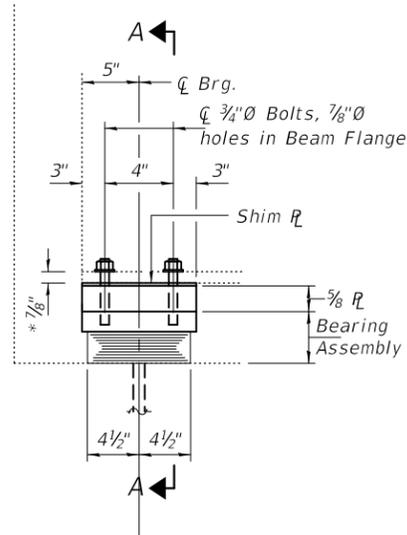

ELEVATION AT ABUTMENT

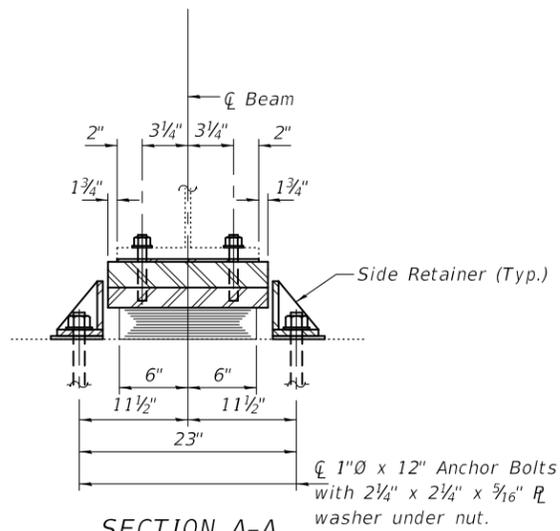

SECTION A-A

BEAM REACTIONS

R <sub>l</sub>	(K)	23.9
R <sub>t</sub>	(K)	42.3
Imp.	(K)	11.8
R (Total)	(K)	78.0

Notes:

All steel plates and structural steel shapes used in bearing assemblies shall be AASHTO M270 Gr. 36.

Diaphragm removal and reinstallation may be required to facilitate drilling holes. Cost included with Furnishing and Erecting Structural Steel.

New steel extensions, shim plates and connection bolts are included with Furnishing and Erecting Structural Steel.

Prior to ordering any material, the Contractor shall verify in the field all bearing height and shim thickness dimensions. Adjustment must account for deck heave due to pack rust (if present).


Min. jack capacity = 39 Tons.

Anchor bolts shall be ASTM F1554 all-thread (or an Engineer-approved alternate material) of the grade(s) and diameter(s) specified. ASTM A307 Grade C anchor bolts may be used in lieu of ASTM F1554 Grade 36 (F<sub>y</sub>=36ksi). The corresponding specified grade of AASHTO M314 anchor bolts may be used in lieu of ASTM F1554.

Drilled and set anchor bolts shall be installed according to Article 521.06 of the Standard Specifications.

Cost of Side retainers and Stainless Steel plates shall be included in the cost of Elastomeric Bearing Assembly, Type I.

TYPE I ELASTOMERIC EXP. BRG.

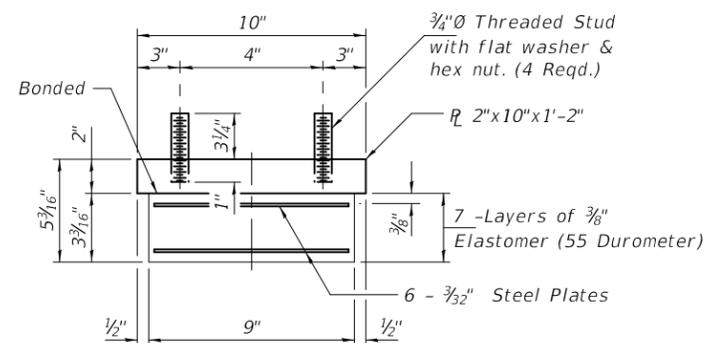


BEARING ASSEMBLY

Note:


Shim plates shall not be placed under Bearing Assembly.

\* See sheets 1 thru 3 of 5 for additional repair R thickness

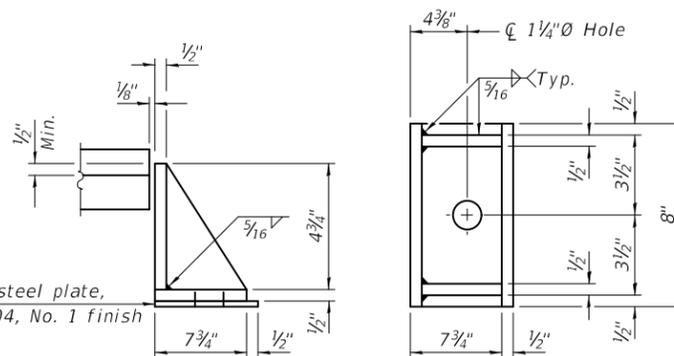

SIDE RETAINER

Equivalent rolled angle with stiffeners will be allowed in lieu of welded plates.

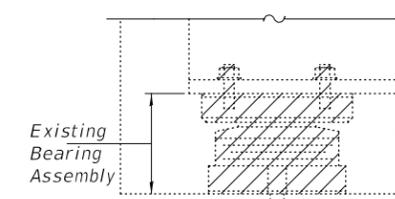

Burn existing anchor bolts flush with existing concrete surface. Grind existing anchor bolt smooth and seal with epoxy.

EXISTING BEARING REMOVAL DETAIL

Cost included with Jack and Remove Existing Bearings.

BILL OF MATERIAL

Item	Unit	Total
Elastomeric Bearing Assembly, Type I	Each	5
Jack and Remove Existing Bearings	Each	5
Furnishing and Erecting Structural Steel	Pound	225
Anchor Bolts, 1"Ø	Each	10

TYI/REPS 5-17-2018

DESIGNED - JSB  
 CHECKED - AJR  
 DRAWN - Venkat Reddy  
 CHECKED - JSB AJR

EXAMINED  
 PASSED  
 ENGINEER OF STRUCTURAL SERVICES  
 ENGINEER OF BRIDGES AND STRUCTURES

DATE - January 24, 2020  
 REVISED -  
 REVISED -

STATE OF ILLINOIS  
 DEPARTMENT OF TRANSPORTATION


NORTH ABUT. BEARING REPLACEMENT DETAILS - REPAIR G  
 SN 021-0030

SHEET NO. 5 OF 5 SHEETS

F.A.P. RTE. SECTION COUNTY TOTAL SHEETS SHEET NO.  
 820 [(1-G),(25)]BDR DOUGLAS 56 22  
 CONTRACT NO. 70D77  
 ILLINOIS FED. AID PROJECT



# AS-BUILT PLANS FOR INFORMATION ONLY

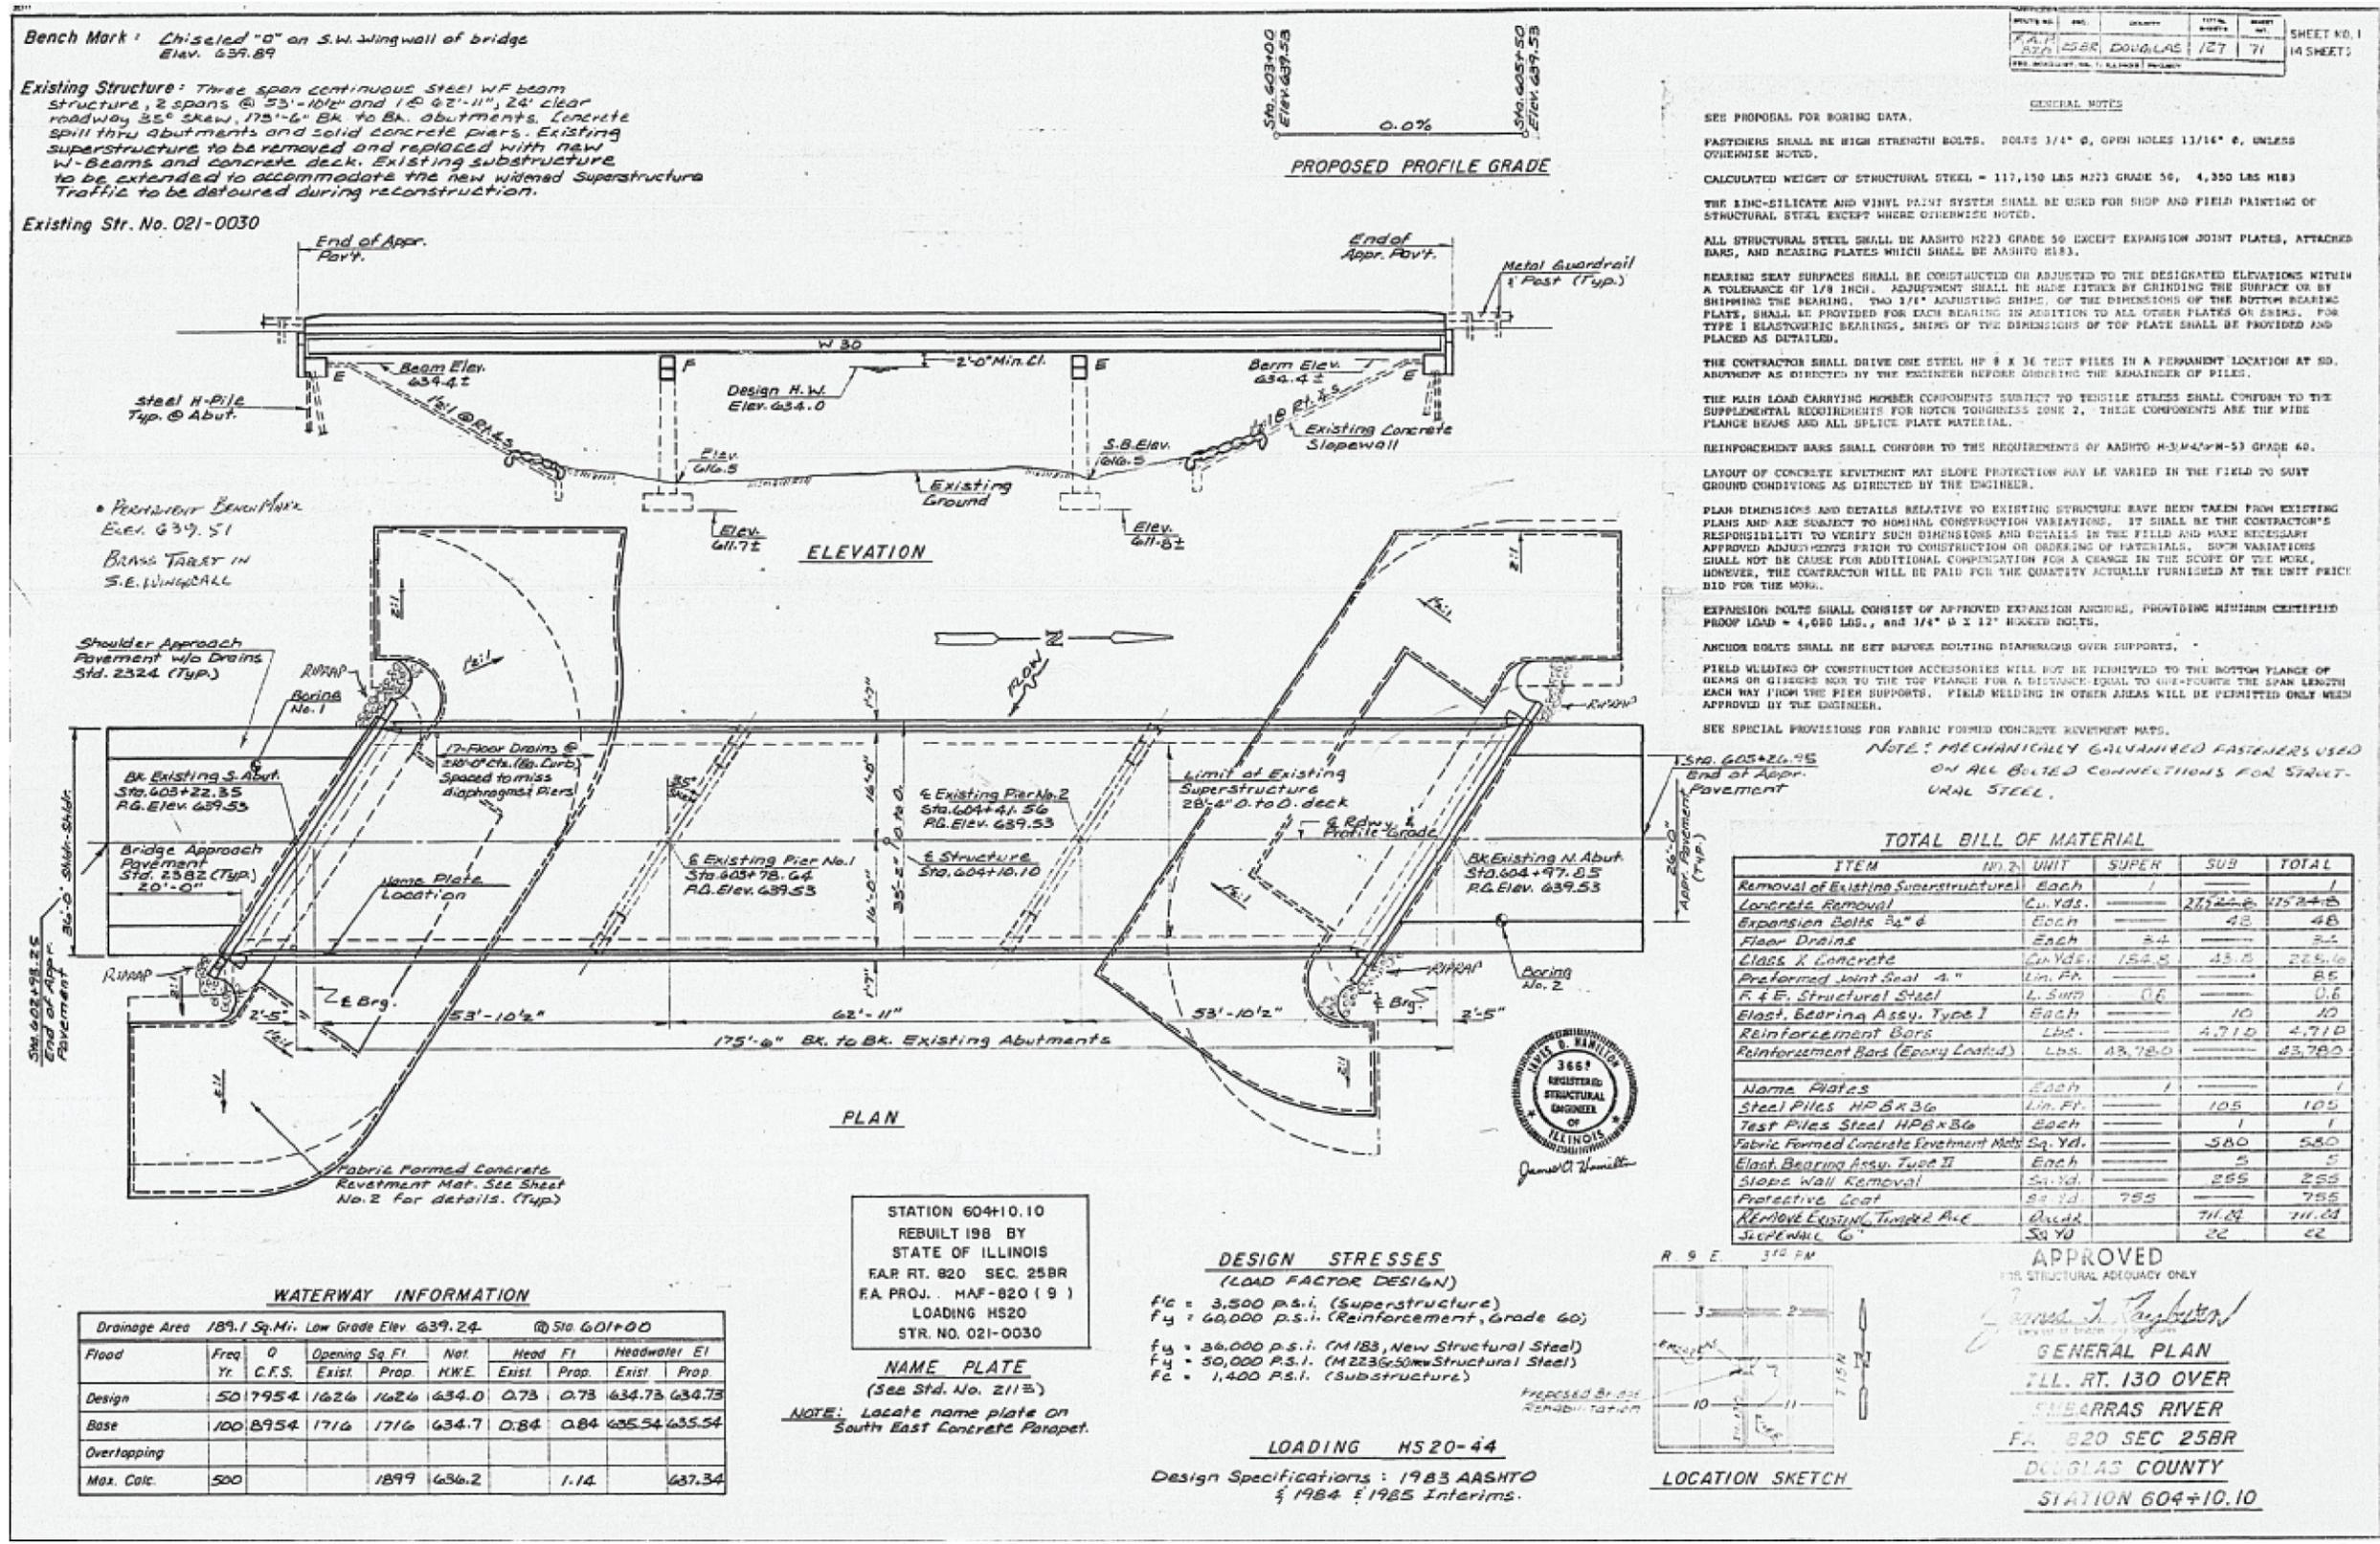

**Bench Mark:** Chiseled "0" on S.W. wingwall of bridge  
Elev. 639.89

**Existing Structure:** Three span continuous steel WF beam structure, 2 spans @ 53'-10 1/2" and 1 @ 62'-11", 24' clear roadway 35° skew, 175'-6" Bk. to Bk. abutments. Concrete spill thru abutments and solid concrete piers. Existing superstructure to be removed and replaced with new W-beams and concrete deck. Existing substructure to be extended to accommodate the new widened Superstructure Traffic to be detoured during reconstruction.

Existing Str. No. 021-0030

• **Permanent Bench Mark**  
Elev. 639.51  
BRASS TARGET IN  
S.E. WINGWALL

**Shoulder Approach Pavement** w/o Drains  
Std. 2324 (Typ.)

**Bk. Existing S. Abut.**  
Sta. 605+22.35  
R.G. Elev. 639.53

**Bridge Approach Pavement**  
Std. 2382 (Typ.)  
20'-0"

**Bk. Existing N. Abut.**  
Sta. 604+97.85  
R.G. Elev. 639.53

**Fabric Formed Concrete Revetment Mat.** See Sheet No. 2 for details. (Typ.)

**WATERWAY INFORMATION**

Drainage Area		189.1 Sq. Mi.		Low Grade Elev. 639.24		@ Sta. 601+00	
Flood	Freq. Yr.	0 C.F.S.	Opening Sq. Ft.	Not. Head	FI	Headwater	EI
Design	50	795.4	1626	1626	634.0	0.73	0.73
Base	100	895.4	1716	1716	634.7	0.84	0.84
Overlapping							
Max. Cole.	500		1899	636.2		1.14	637.34


STATION 604+10.10  
REBUILT 198 BY  
STATE OF ILLINOIS  
F.A.P. RT. 820 SEC. 25BR  
F.A. PROJ. MAF-820 (9)  
LOADING HS20  
STR. NO. 021-0030

**NAME PLATE**  
(See Std. No. 2113)  
NOTE: Locate name plate on  
South East Concrete Parapet.

**DESIGN STRESSES**  
(LOAD FACTOR DESIGN)

$f_c = 3,500$  p.s.i. (Superstructure)  
 $f_y = 60,000$  p.s.i. (Reinforcement, Grade 60)  
 $f_y = 36,000$  p.s.i. (M183, New Structural Steel)  
 $f_y = 50,000$  p.s.i. (M223 & 50ms Structural Steel)  
 $f_c = 1,400$  p.s.i. (Substructure)

**LOADING HS20-44**  
Design Specifications: 1983 AASHTO  
& 1984 & 1985 Interims.

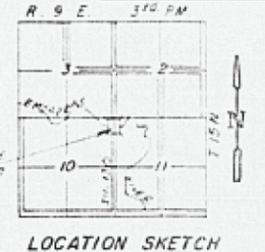

DATE	NO.	REVISION	TOTAL SHEETS	SHEET NO.
12/21/19	1	AS-BUILT	27	71

SHEET NO. 1  
OF 2 SHEETS

**GENERAL NOTES**

SEE PROPOSAL FOR BORING DATA.

FASTENERS SHALL BE HIGH STRENGTH BOLTS. BOLTS 3/4" Ø, OPEN HOLES 13/16" Ø, UNLESS OTHERWISE NOTED.

CALCULATED WEIGHT OF STRUCTURAL STEEL = 117,130 LBS M223 GRADE 50, 4,350 LBS M183

THE EPOXY-SILICATE AND VINYL PAINT SYSTEM SHALL BE USED FOR SHOP AND FIELD PAINTING OF STRUCTURAL STEEL EXCEPT WHERE OTHERWISE NOTED.

ALL STRUCTURAL STEEL SHALL BE AASHTO M223 GRADE 50 EXCEPT EXPANSION JOINT PLATES, ATTACHED BARS, AND BEARING PLATES WHICH SHALL BE AASHTO M183.

BEARING SEAT SURFACES SHALL BE CONSTRUCTED OR ADJUSTED TO THE DESIGNATED ELEVATIONS WITHIN A TOLERANCE OF 1/8 INCH. ADJUSTMENT SHALL BE MADE EITHER BY GRINDING THE SURFACE OR BY SHIMMING THE BEARING. THE 1/16" ADJUSTING SHIMS, OF THE DIMENSIONS OF THE BEARING BEARING PLATE, SHALL BE PROVIDED FOR EACH BEARING IN ADDITION TO ALL OTHER PLATES OR SHIMS. FOR TYPE I ELASTOMERIC BEARINGS, SHIMS OF THE DIMENSIONS OF TOP PLATE SHALL BE PROVIDED AND PLACED AS DETAILED.

THE CONTRACTOR SHALL DRIVE ONE STEEL HP 8 X 36 TEST PILES IN A PERMANENT LOCATION AT SO. APPROXIMATE AS DIRECTED BY THE ENGINEER BEFORE ORDERING THE REMAINDER OF PILES.

THE MAIN LOAD CARRYING MEMBER COMPONENTS SUBJECT TO TENSILE STRESS SHALL CONFORM TO THE SUPPLEMENTAL REQUIREMENTS FOR NOTCH TOUGHNESS ZONE 2. THESE COMPONENTS ARE THE WIRE PLANGE BEAMS AND ALL SPLICE PLATE MATERIAL.

REINFORCEMENT BARS SHALL CONFORM TO THE REQUIREMENTS OF AASHTO M-31.42/M-53 GRADE 60.

LAYOUT OF CONCRETE REVETMENT MAT SLOPE PROTECTION MAY BE VARIED IN THE FIELD TO SUIT GROUND CONDITIONS AS DIRECTED BY THE ENGINEER.

PLAN DIMENSIONS AND DETAILS RELATIVE TO EXISTING STRUCTURE HAVE BEEN TAKEN FROM EXISTING PLANS AND ARE SUBJECT TO NOMINAL CONSTRUCTION VARIATIONS. IT SHALL BE THE CONTRACTOR'S RESPONSIBILITY TO VERIFY SUCH DIMENSIONS AND DETAILS IN THE FIELD AND MAKE NECESSARY APPROVED ADJUSTMENTS PRIOR TO CONSTRUCTION OR ORDERING OF MATERIALS. SUCH VARIATIONS SHALL NOT BE CAUSE FOR ADDITIONAL COMPENSATION FOR A CHANGE IN THE SCOPE OF THE WORK. HOWEVER, THE CONTRACTOR WILL BE PAID FOR THE QUANTITY ACTUALLY FURNISHED AT THE UNIT PRICE BID FOR THE WORK.

EXPANSION BOLTS SHALL CONSIST OF APPROVED EXPANSION ANCHORS, PROVIDING MINIMUM CERTIFIED PROOF LOAD = 4,000 LBS., and 3/4" Ø X 12" HEXED BOLTS.

ANCHOR BOLTS SHALL BE SET BEFORE BOLTING DIAPHRAGMS OVER SUPPORTS.

FIELD WELDING OF CONSTRUCTION ACCESSORIES WILL NOT BE PERMITTED TO THE BOTTOM FLANGE OF BEAMS OR GIRDERS NOR TO THE TOP FLANGE FOR A DISTANCE EQUAL TO ONE-FOURTH THE SPAN LENGTH EACH WAY FROM THE PIER SUPPORTS. FIELD WELDING IN OTHER AREAS WILL BE PERMITTED ONLY WHEN APPROVED BY THE ENGINEER.

SEE SPECIAL PROVISIONS FOR FABRIC FORMED CONCRETE REVETMENT MATS.

NOTE: MECHANICALLY GALVANIZED FASTENERS USED ON ALL BOLTED CONNECTIONS FOR STRUCTURAL STEEL.

**TOTAL BILL OF MATERIAL**

ITEM	NO.	UNIT	SUPER	SUB	TOTAL
Removal of Existing Superstructure	1	Each			1
Concrete Removal		Cu. Yds.	27,226		27,226
Expansion Bolts 3/4" Ø	48	Each			48
Floor Drains	24	Each			24
Class K Concrete	154.8	Cu. Yds.		43.0	225.6
Preformed Joint Seal 4"		Lin. Ft.			85
F. & E. Structural Steel	0.6	L. SHIP			0.6
Elast. Bearing Assy. Type I	10	Each			10
Reinforcement Bars	4,710	Lbs.			4,710
Reinforcement Bars (Epoxy Coated)	43,780	Lbs.			43,780
Name Plates	1	Each			1
Steel Piles HP 8 X 36	105	Lin. Ft.			105
Test Piles Steel HP 8 X 36	1	Each			1
Fabric Formed Concrete Revetment Mat	580	Sq. Yd.			580
Elast. Bearing Assy. Type II	5	Each			5
Slope Wall Removal	255	Sq. Yd.			255
Protective Coat	755	Sq. Yd.			755
Remove Existing Tunnel Pipe	71.82	Each			71.82
Sealant 6"	22	Sq. Yd.			22

**APPROVED**  
FOR STRUCTURAL ADEQUACY ONLY


*James J. Rayburn*  
REGISTERED PROFESSIONAL ENGINEER  
OF ILLINOIS

**GENERAL PLAN**  
ILL. RT. 130 OVER  
SERRAS RIVER  
F.A. PROJ. 820 SEC 25BR  
DOUGLAS COUNTY  
STATION 604+10.10



# AS-BUILT PLANS FOR INFORMATION ONLY

DATE	BY	CHKD	APP'D	SHEET NO. 5
F.A.P. 820	25BR DOUGLAS	127	75	14 SHEETS

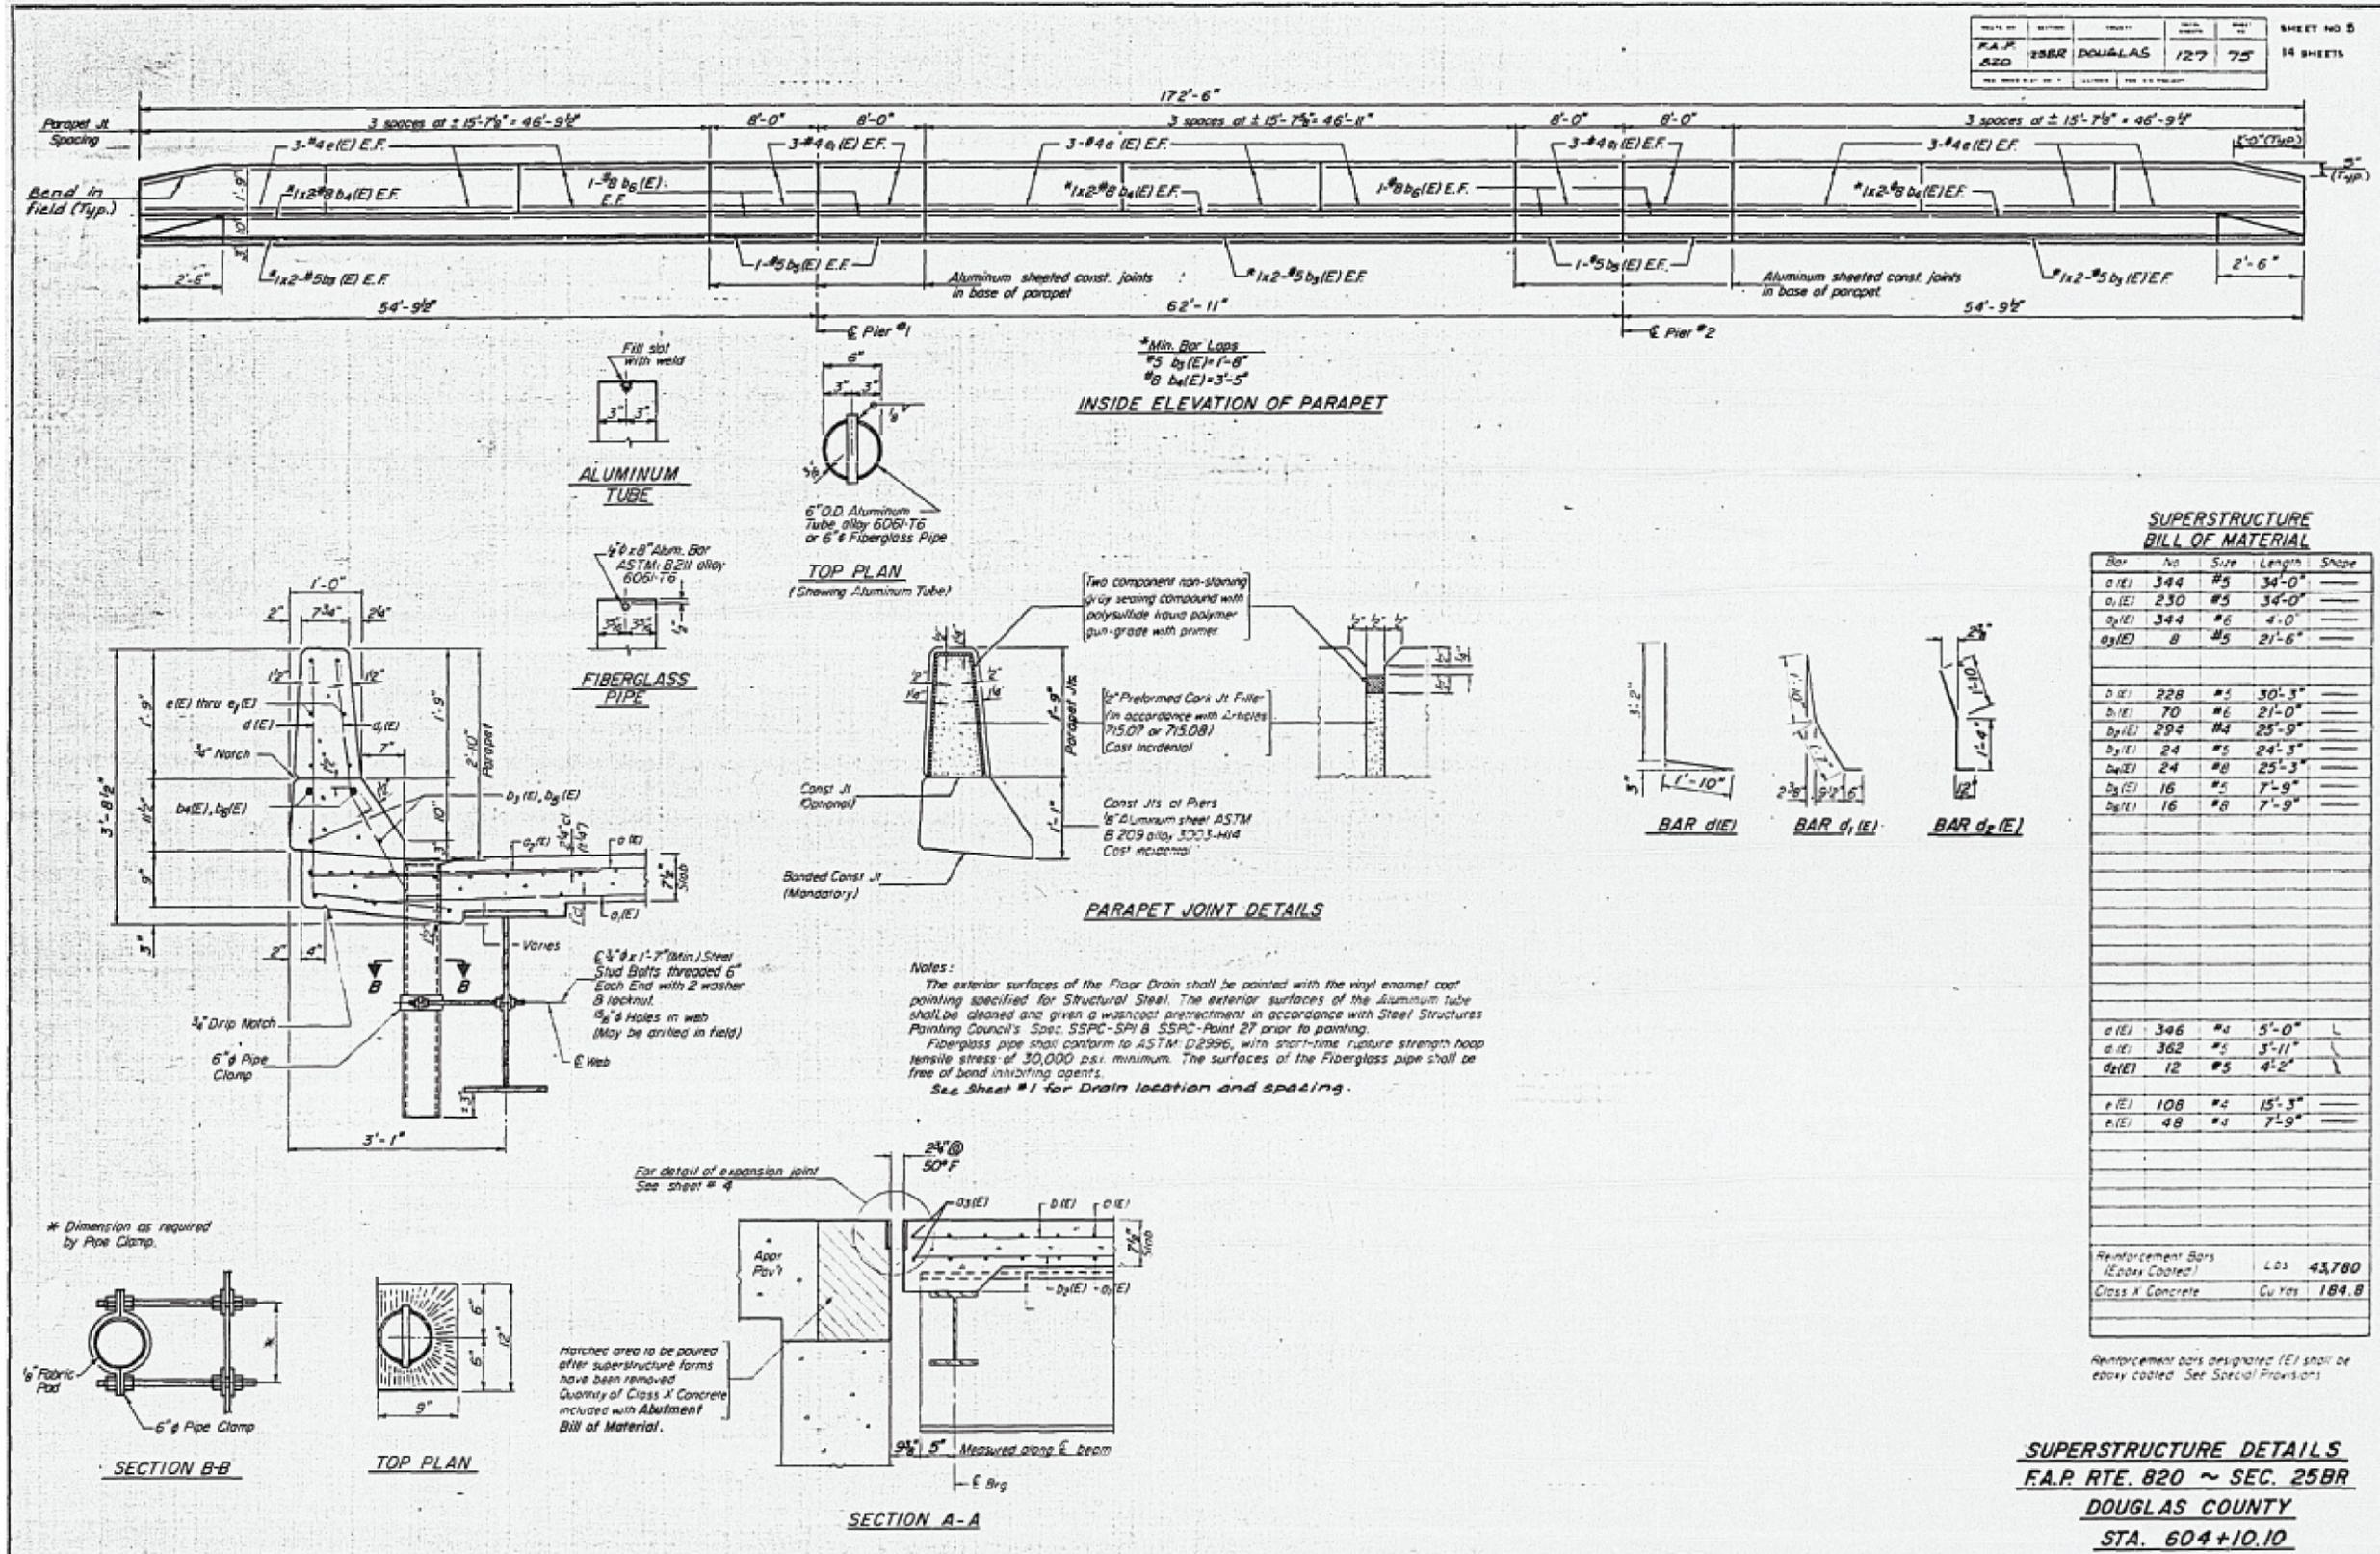

**SUPERSTRUCTURE  
BILL OF MATERIAL**

Bar No	Size	Length	Shape
a1(E)	#5	34'-0"	---
a1(E)	#5	34'-0"	---
a2(E)	#6	4'-0"	---
a3(E)	#5	21'-6"	---
b1(E)	#5	30'-3"	---
b1(E)	#6	21'-0"	---
b2(E)	#4	25'-9"	---
b3(E)	#5	24'-3"	---
b4(E)	#8	25'-3"	---
b5(E)	#5	7'-9"	---
b6(E)	#8	7'-9"	---

c1(E)	#4	5'-0"	---
c1(E)	#5	5'-11"	---
d1(E)	#5	4'-2"	---
e1(E)	#4	15'-3"	---
e1(E)	#4	7'-9"	---

Reinforcement Bars (Epoxy Coated)	Qty	43,780
Class X Concrete	Cu Yds	184.8

Reinforcement bars designated (E) shall be epoxy coated. See Special Provisions.

**SUPERSTRUCTURE DETAILS  
F.A.P. RTE. 820 ~ SEC. 25BR  
DOUGLAS COUNTY  
STA. 604+10.10**

MODEL: S:\MODEL\NAMES FILE NAME: P:\pub\illinois\dot\Documents\DOT Office\Drawings\Projects\0570077\CAD\Drawings\0570077\_S1R\_S1R02\_1-0030\_C04.dwg

USER NAME = shawleres	DESIGNED -	REVISED -
PLOT SCALE = 40.0000' / in.	DRAWN -	REVISED -
PLOT DATE = 11/21/2019	CHECKED -	REVISED -
	DATE -	REVISED -


**STATE OF ILLINOIS  
DEPARTMENT OF TRANSPORTATION**

<b>AS-BUILT PLANS S.N. 021-0030</b>	
SCALE:	SHEET 20 OF 25 SHEETS STA. TO STA.

F.A.P. RTE. 820	SECTION [(1-G).(25)]BDR	COUNTY DOUGLAS	TOTAL SHEETS 56	SHEET NO. 26
			CONTRACT NO. 70D77	
		ILLINOIS	FED. AID PROJECT	

# AS-BUILT PLANS FOR INFORMATION ONLY

PROJECT NO.	SECTION	TOTAL SHEETS	SHEET NO.
F.A.P. RTE. 820	DOUGLAS	127	76
SHEET NO. 6 14 SHEETS			

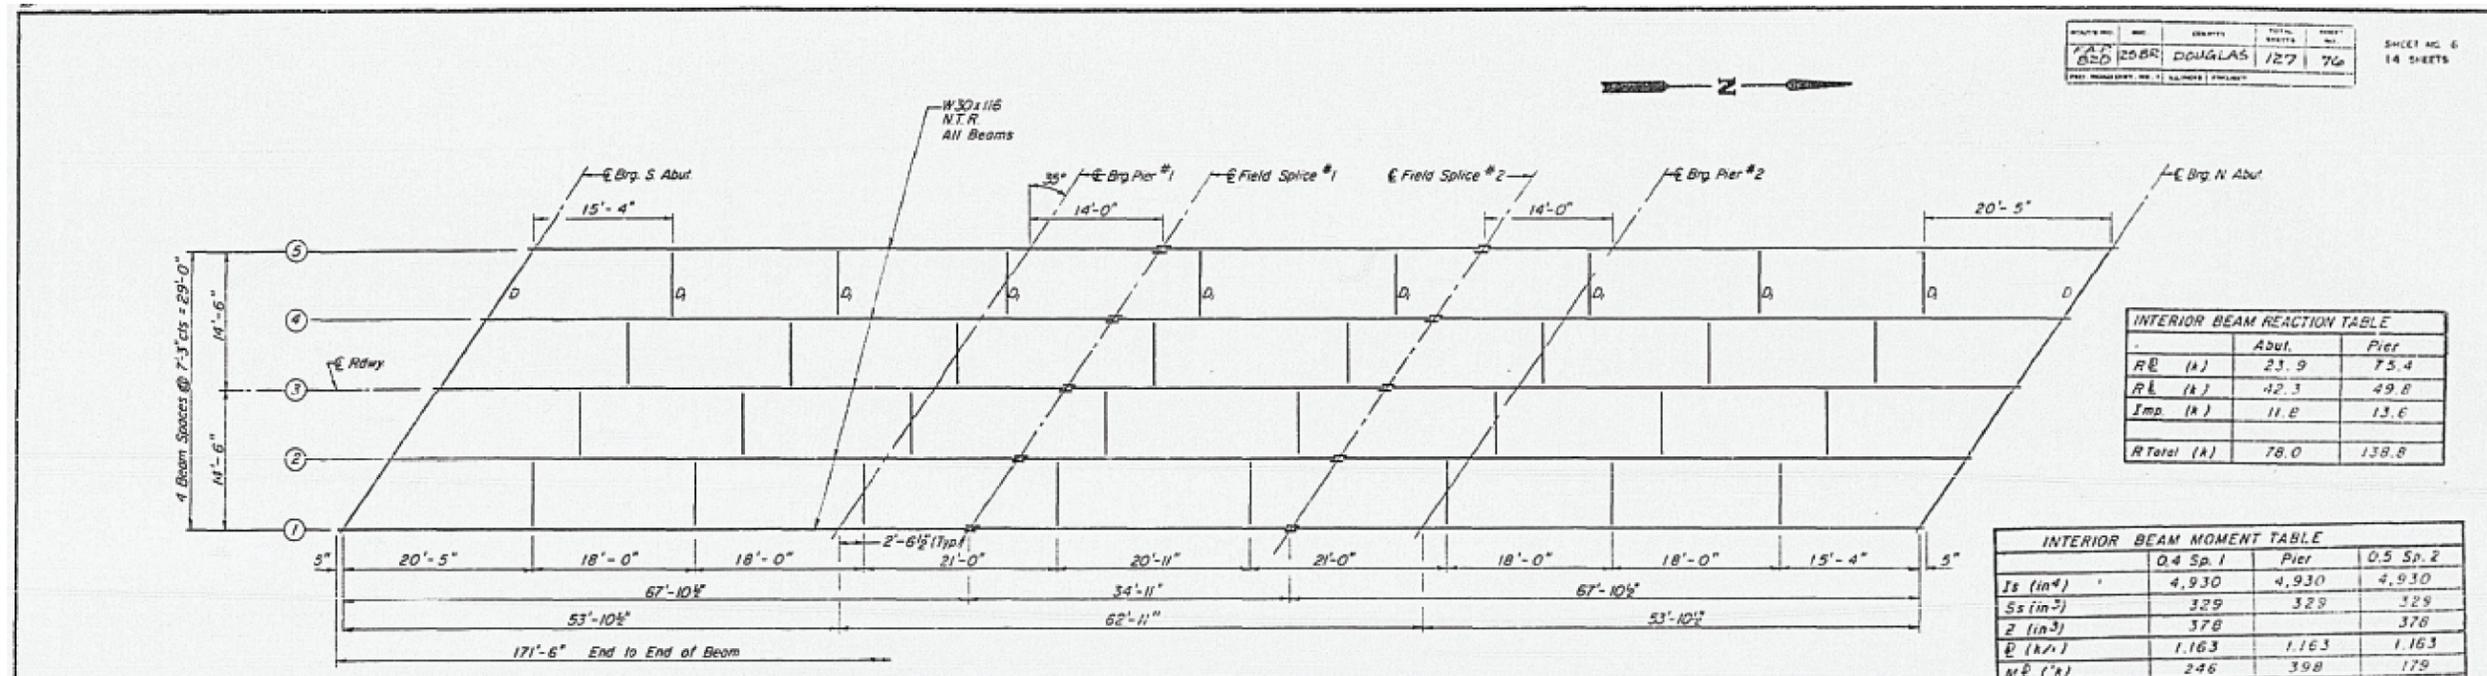


**FRAMING PLAN**  
N.T.R. denotes Notch Toughness Requirements

	Abut.	Pier
$R_E$ (k)	23.9	75.4
$R_L$ (k)	42.3	49.8
Imp (k)	11.8	13.6
$R_{Total}$ (k)	78.0	138.8

	0.4 Sp. 1	Pier	0.5 Sp. 2
$I_s$ (in <sup>4</sup> )	4,930	4,930	4,930
$S_s$ (in <sup>3</sup> )	329	329	329
$Z$ (in <sup>3</sup> )	378	378	378
$P$ (k/ft)	1.163	1.163	1.163
$M_D$ (k)	246	398	179
$M_L$ (k)	368	289	353
$M_{IMP}$ (k)	103	79	94
$S_2(M_L + I)$ (k)	785	613	745
$M_a$ (k)	1340		1427
$M_u$ (k)	1575		1575
$f_s$ non-comp (ksi)	8.97	14.52	6.53
$f_s$ (k.s.i.) (k.s.i.)	28.63	22.36	27.17
$f_s$ (Overload) (k.s.i.)	37.60	36.68	33.70
$f_s$ (Total) (k.s.i.)	47.94		


$I_s$  and  $S_s$  are the moment of inertia and section modulus of the steel section used in computing  $f_s$  (Total and Overload).  
 $Z$  is the plastic section modulus used to determine the Fully Plastic Moment.  
 $M_u$  = Full Plastic Moment Capacity for Compact, Braced section.  
 $M_a$  (Applied Moment) =  $1.3 [M_D + S_2 (M_L + I)]$   
 $f_s$  (Total) is the sum of the stresses due to  $1.3 [M_D + S_2 (M_L + I)]$   
 $f_s$  (Overload) is the sum of the stresses due to  $M_D + S_2 (M_L + I)$   
 $M_D$  - Moment due to dead loads on non-composite section.  
 $M_L$  - Moment due to live load on non composite or composite section.  
 $I$  - Live load impact.

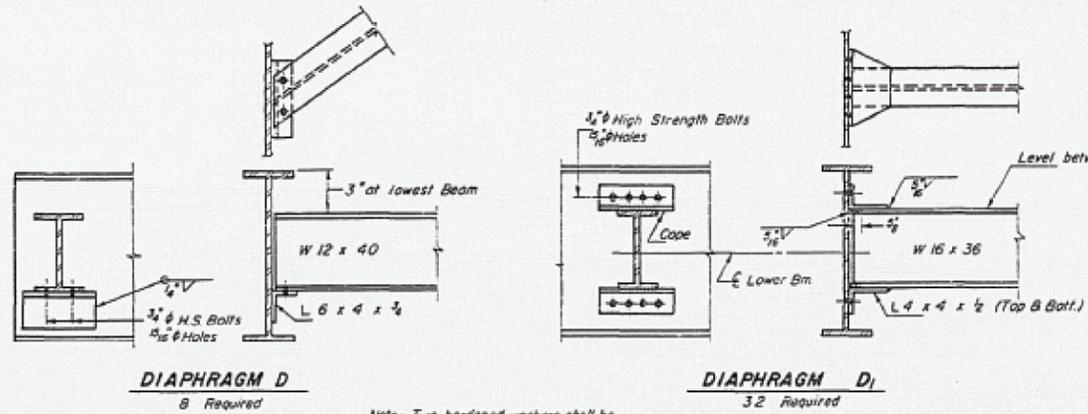

**DIAPHRAGM D**  
8 Required

**DIAPHRAGM D1**  
3/2 Required

Note: Two hardened washers shall be required over all 3/8" holes. All contact surfaces of joints shall be free of paint or lacquer.

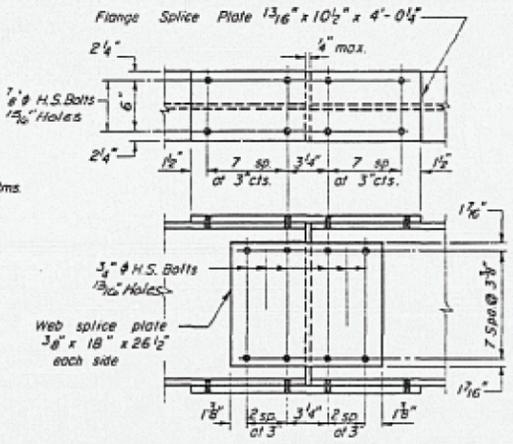

**SPlice**  
Splice Plates - N.T.R.

**TOP OF W-BEAM ELEVATION**

	Beam 1	Beam 2	Beam 3	Beam 4	Beam 5
E Brg. S Abut.	638.62	638.75	638.86	638.75	638.62
E Pier 1	638.57	638.70	638.81	638.70	638.57
E Splice 1	638.56	638.69	638.80	638.69	638.56
E Splice 2	638.56	638.69	638.80	638.69	638.56
E Pier 2	638.57	638.70	638.81	638.70	638.57
E Brg. N Abut.	638.62	638.75	638.86	638.75	638.62

For Fabrication only

**STRUCTURAL STEEL**  
**F.A.P. RTE. 820 ~ SEC. 25BR**  
**DOUGLAS COUNTY**  
**STA. 604+10.10**

USER NAME = shawleres	DESIGNED -	REVISED -
	DRAWN -	REVISED -
PLOT SCALE = 40.0000' / in.	CHECKED -	REVISED -
PLOT DATE = 11/21/2019	DATE -	REVISED -

**STATE OF ILLINOIS  
DEPARTMENT OF TRANSPORTATION**

**AS-BUILT PLANS  
S.N. 021-0030**


SCALE: SHEET 21 OF 25 SHEETS STA. TO STA.

F.A.P. RTE.	SECTION	COUNTY	TOTAL SHEETS	SHEET NO.
820	[(1-G),(25)]BDR	DOUGLAS	56	27
CONTRACT NO. 70D77				
ILLINOIS FED. AID PROJECT				


MODEL: \\MODEL\MARIS... FILE: \\MARIS... PROJECT: 0570077\CAD\BDR\AS-BUILT\0570077\_5R\_5R02\_1-0030\_CAD.dgn

# AS-BUILT PLANS FOR INFORMATION ONLY


F.A.P. RTE.	SECTION	COUNTY	TOTAL SHEETS	SHEET NO.
820	[(1-G),(25)]BDR	DOUGLAS	56	28
CONTRACT NO. 70D77				

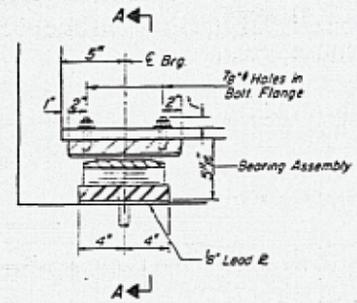


**SECTION AT N. ABUT.**

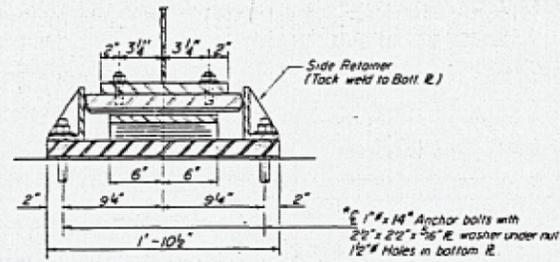

**SECTION A-A**

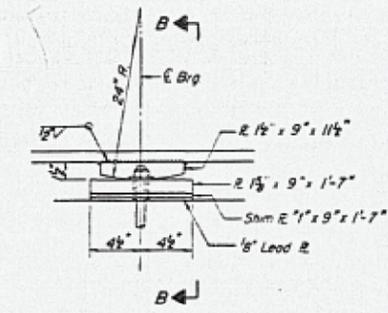


**ELEVATION AT PIER #1**

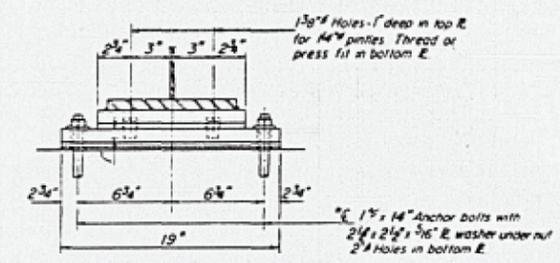


**SECTION B-B**

**FIXED BEARING PIER #1**


**TYPE II TFE ELASTOMERIC EXP BRG.  
N. ABUT.**

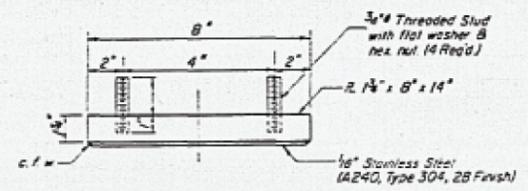


**TOP BEARING ASSEMBLY**

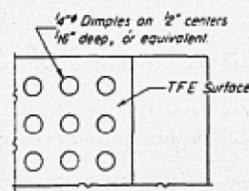

**PLAN-TFE SURFACE**

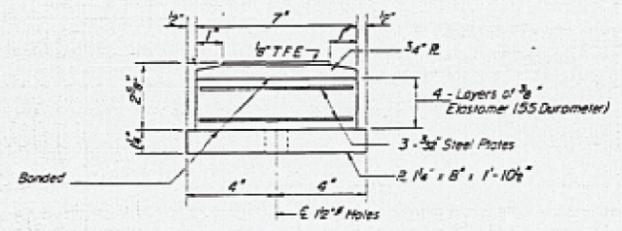

**BOTTOM BEARING ASSEMBLY**

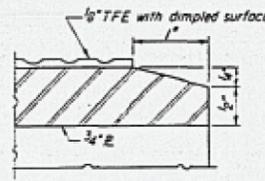


**SECTION THRU TFE**

*Note: The 1/8" TFE sheet shall be bonded directly to the top steel plate with a two-component, medium viscosity epoxy resin, conforming to the requirements of the Federal Specification MMM-A-134, Type I. The bond agent shall be applied on the full area of the contact surfaces.*


*Bonding of 1/8" TFE sheet during vulcanizing process will be permitted provided the process and method of adjusting assembly height is approved by the Engineer.*

*Note: All steel plates and structural steel shapes used in bearing assemblies shall be AASHTO M183.*

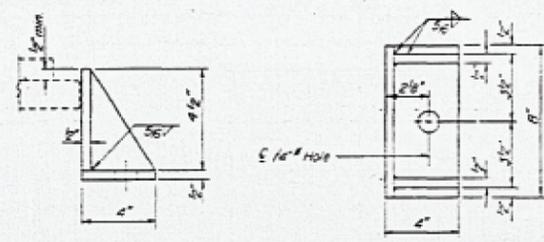


**SIDE RETAINER**

*Equivalent rolled angle with stiffeners will be allowed in lieu of welded plates*

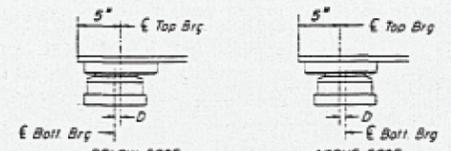

**SETTING ANCHOR BOLTS AT EXP BRG**  
*D = 1/8" per each 100° of expansion for every 15° temp change from the normal temp of 50°F*

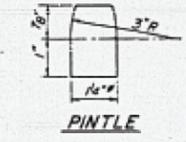

**PINTLE**

**SHIM PLATE THICKNESS AT PIER #1**

LOCATION	BEAM 1 & 5	BEAM 2 & 4	BEAM 3
"1"	0 7/8"	1 1/4"	2 5/8"

**BILL OF MATERIAL**

ITEM	UNIT	TOTAL
Elastomeric Bearing Assembly Type II	Each	5

**BEARING DETAILS  
N. ABUT., PIER #1  
F.A.P. RTE. 820 ~ SEC. 25BR  
DOUGLAS COUNTY  
STA. 604 + 10.10**

MODEL: I:\MODEL\NAME: FILE: NAME: P:\pub\mtdom\da\allink\gov\PIWDOT\Documents\BDR - Office\BDR\det 5\Projects\0570077\CAD\BDR\CAD\BDR\0570077\_5R1\_5R102\_1-0030\_CAD.dwg

USER NAME = shawleres	DESIGNED -	REVISED -
PLOT SCALE = 40.0000 "/in.	DRAWN -	REVISED -
PLOT DATE = 11/21/2019	CHECKED -	REVISED -
	DATE -	REVISED -

**STATE OF ILLINOIS  
DEPARTMENT OF TRANSPORTATION**


**AS-BUILT PLANS  
S.N. 021-0030**

SCALE: SHEET 22 OF 25 SHEETS STA. TO STA.


F.A.P. RTE.	SECTION	COUNTY	TOTAL SHEETS	SHEET NO.
820	[(1-G),(25)]BDR	DOUGLAS	56	28
CONTRACT NO. 70D77				
ILLINOIS FED. AID PROJECT				

# AS-BUILT PLANS FOR INFORMATION ONLY


R.A.P. 820	25BR	DOUGLAS	127	7B
SHEET NO. 8 14 SHEETS				

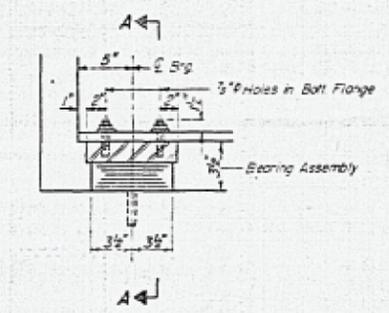


**SECTION AT S. ABUT.**  
**TYPE I ELASTOMERIC EXP. BRG.**  
**S. ABUT.**

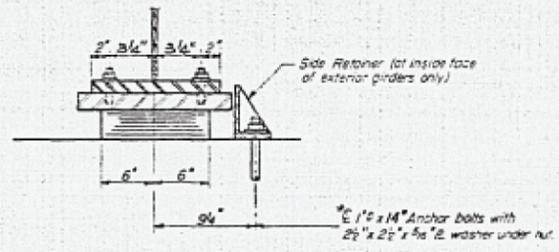

**SECTION A-A**  
\*E 1 1/2 x 14" Anchor bolts with 2 1/2 x 2 1/2 x 1/2" E. washer under nut.

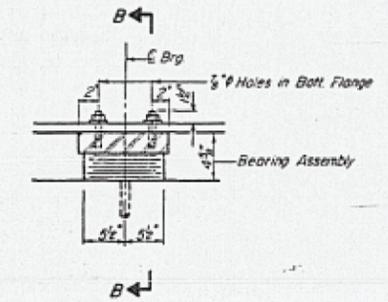


**SECTION AT PIER #2**  
**TYPE I ELASTOMERIC EXP. BRG.**  
**PIER #2**

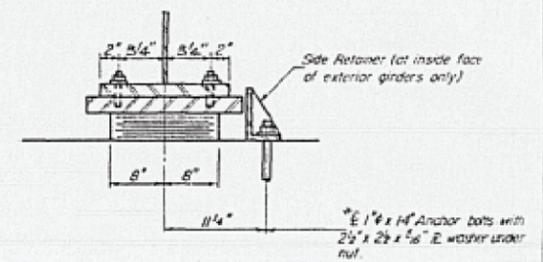


**SECTION B-B**  
\*E 1 1/2 x 14" Anchor bolts with 2 1/2 x 2 1/2 x 1/2" E. washer under nut.


\* See Sheet #9 for Anchor Bolt installation.  
Note: All steel plates and structural steel shapes used in bearing assemblies shall be AASHTO M183.

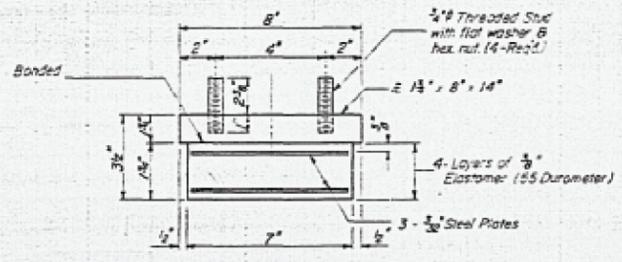

**BEARING ASSEMBLY**  
(At S. Abut.)  
Note: Shim plates shall not be placed under Bearing Assembly.

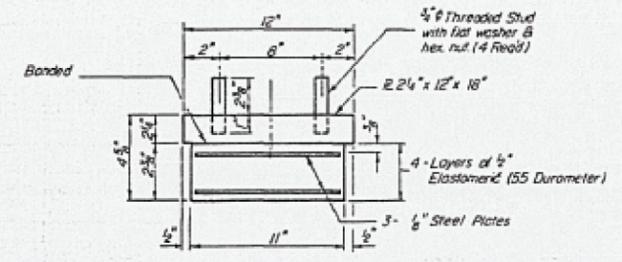

**BEARING ASSEMBLY**  
(At Pier #2)  
Note: Shim plates shall not be placed under Bearing Assembly.

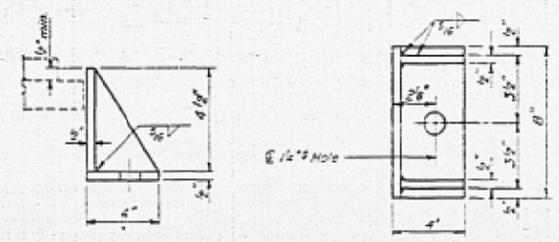

**SIDE RETAINER**  
Equivalent rated angle with stiffeners will be allowed in lieu of welded plates.

**BILL OF MATERIAL**

ITEM	UNIT	TOTAL
Elastomeric Bearing	Each	10

**BEARING DETAILS**  
**S. ABUTMENT, PIER #2**  
**I.P. RTE. 820 ~ SEC. 25BR**  
**DOUGLAS COUNTY**  
**STA. 604+10.10**

MODEL: \\MODEL\MARIS... FILE NAME: ...

USER NAME = shawleres	DESIGNED -	REVISED -
	DRAWN -	REVISED -
PLOT SCALE = 40,0000' / in.	CHECKED -	REVISED -
PLOT DATE = 11/21/2019	DATE -	REVISED -

**STATE OF ILLINOIS**  
**DEPARTMENT OF TRANSPORTATION**

**AS-BUILT PLANS**  
**S.N.. 021-0030**

SCALE: SHEET 23 OF 25 SHEETS STA. TO STA.

F.A.P. RTE.	SECTION	COUNTY	TOTAL SHEETS	SHEET NO.
820	[(1-G),(25)]BDR	DOUGLAS	56	29
CONTRACT NO. 70D77				
ILLINOIS FED. AID PROJECT				






STRUCTURE NO. 021-0031 BUILT AS FAS RTE. 524 SECTION 1-G IN 1948 AT STATION 13+66.50. A THREE SPAN CONTINUOUS STEEL WF BEAM STRUCTURE, 2 SPANS @ 37'-9" AND 1 @ 48'-5" SKEWED 0° SUPPORTED BY SPILL THRU ABUTMENTS AND PILE BENT PIERS. IN 1987 WAS RECONSTRUCTED AS FA RTE. 820, SECTION 1-G-BR AT 513+66.70. THE EXISTING SUBSTRUCTURE WAS WIDENED, THE DECK AND SUPERSTRUCTURE WERE REMOVED AND REPLACED WITH SIX W24X94 CONTINUOUS STEEL BEAMS AND 7½" CONCRETE DECK. THE BACK TO BACK ABUTMENTS LENGTH IS 127'-5". AN OUT TO OUT WIDTH OF 35'-2" AND A CLEAR WIDTH OF 32'-0" FACE TO FACE OF PARAPET.


# GENERAL PLAN & ELEVATION

## S.N. 021-0031


WORK SHALL BE COMPLETED WITH STAGE CONSTRUCTION.

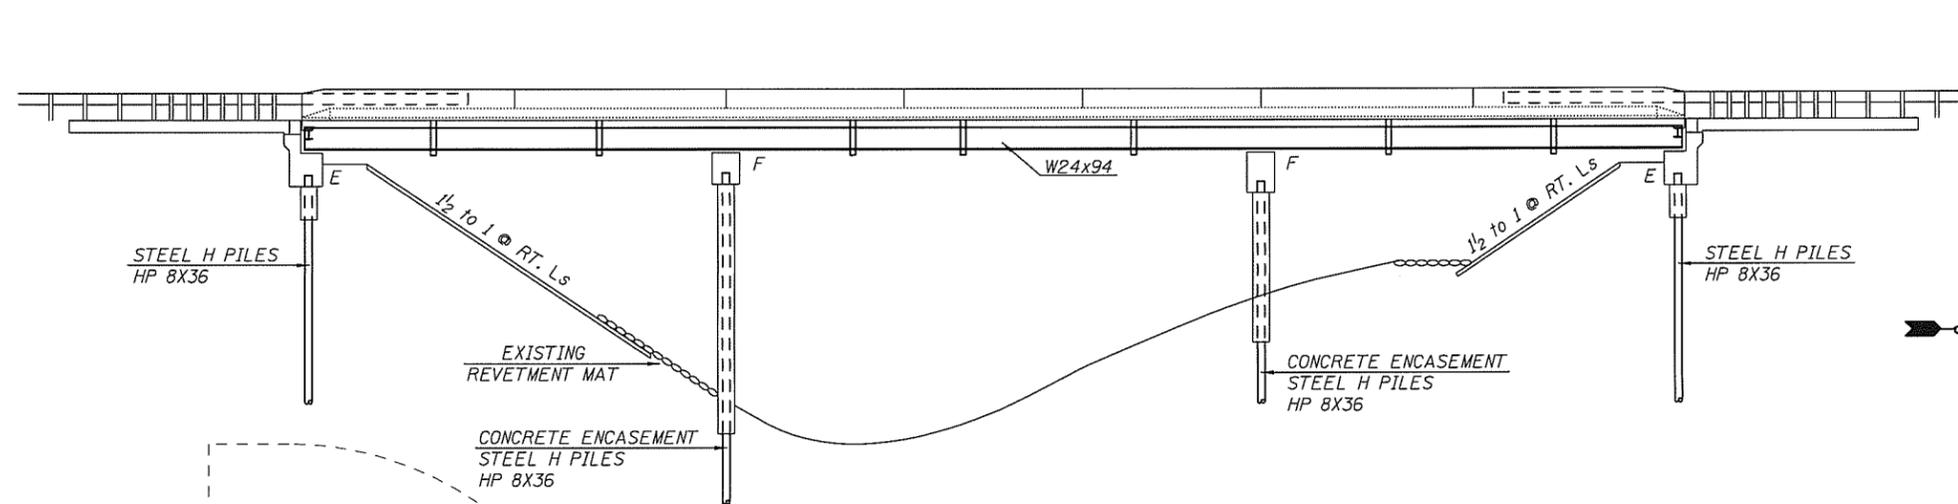

### ELEVATION

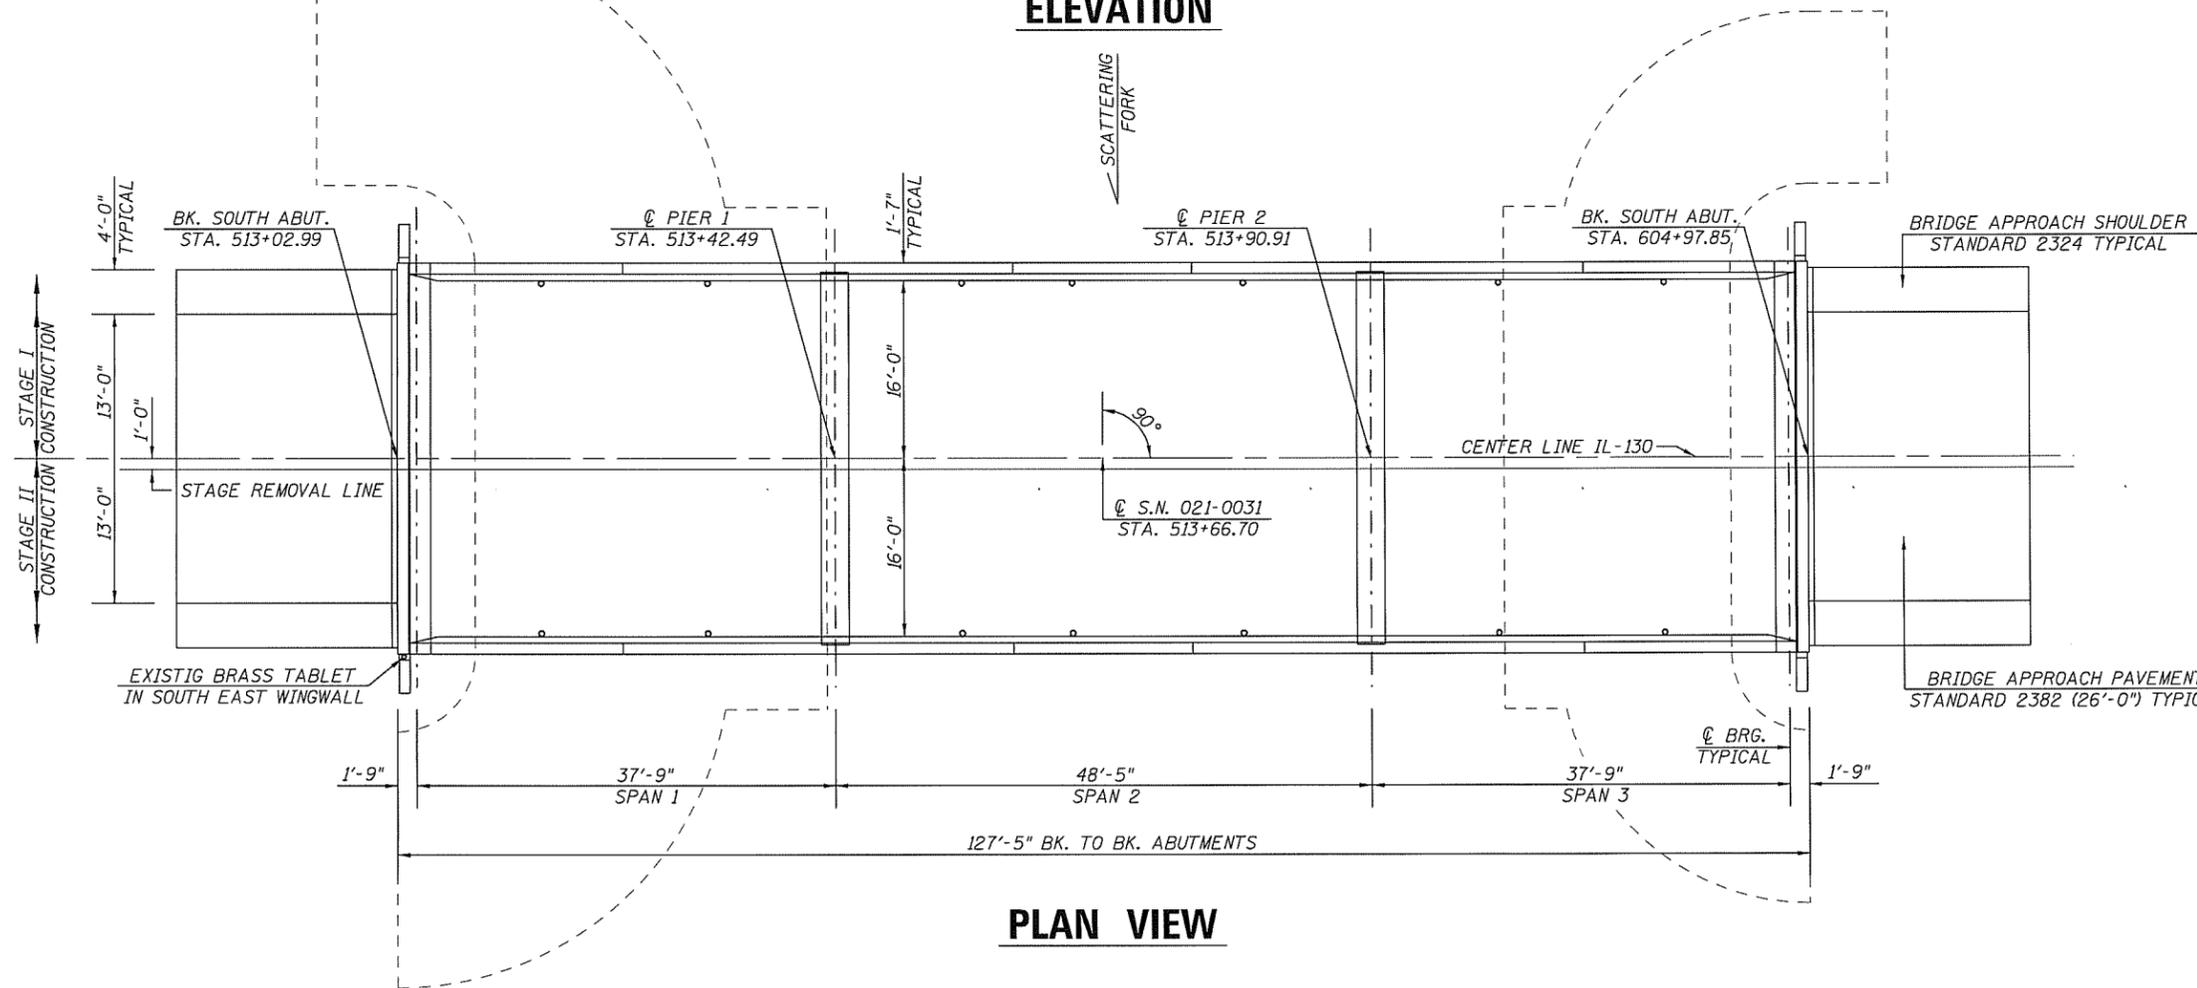

### PLAN VIEW

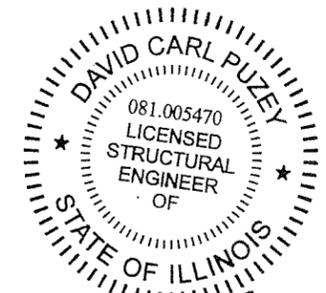

*Dr. Carl Puzey* 1/27/20  
Expires 1/30/20

MODEL: \$MODELNAME\$ FILE: NAME: p:\pub\harrman.doi\illinois.sev\FWIDOT\Documents\DOT\_Offices\Dist1.ctb: 5:\projects\0570D77\CD\Drawings\0570D77\_sht\_021-0031\_CN.dgn

USER NAME = shawleres	DESIGNED - ESS	REVISED -
DRAWN - ESS	REVISIONS -	
PLOT SCALE = 40,0000' / in.	CHECKED - TJB	REVISED -
PLOT DATE = 11/21/2019	DATE -	REVISED -

STATE OF ILLINOIS  
DEPARTMENT OF TRANSPORTATION

GENERAL PLAN & ELEVATION  
S.N. 021-0031


SCALE: SHEET 1 OF 22 SHEETS STA. TO STA.

F.A.P. RTE.	SECTION	COUNTY	TOTAL SHEETS	SHEET NO.
820	[(1-G),(25)]BDR	DOUGLAS	56	32
CONTRACT NO. 70D77				
ILLINOIS   FED. AID PROJECT				



## EXISTING DECK CROSS SECTION


**S.N. 021-0031**

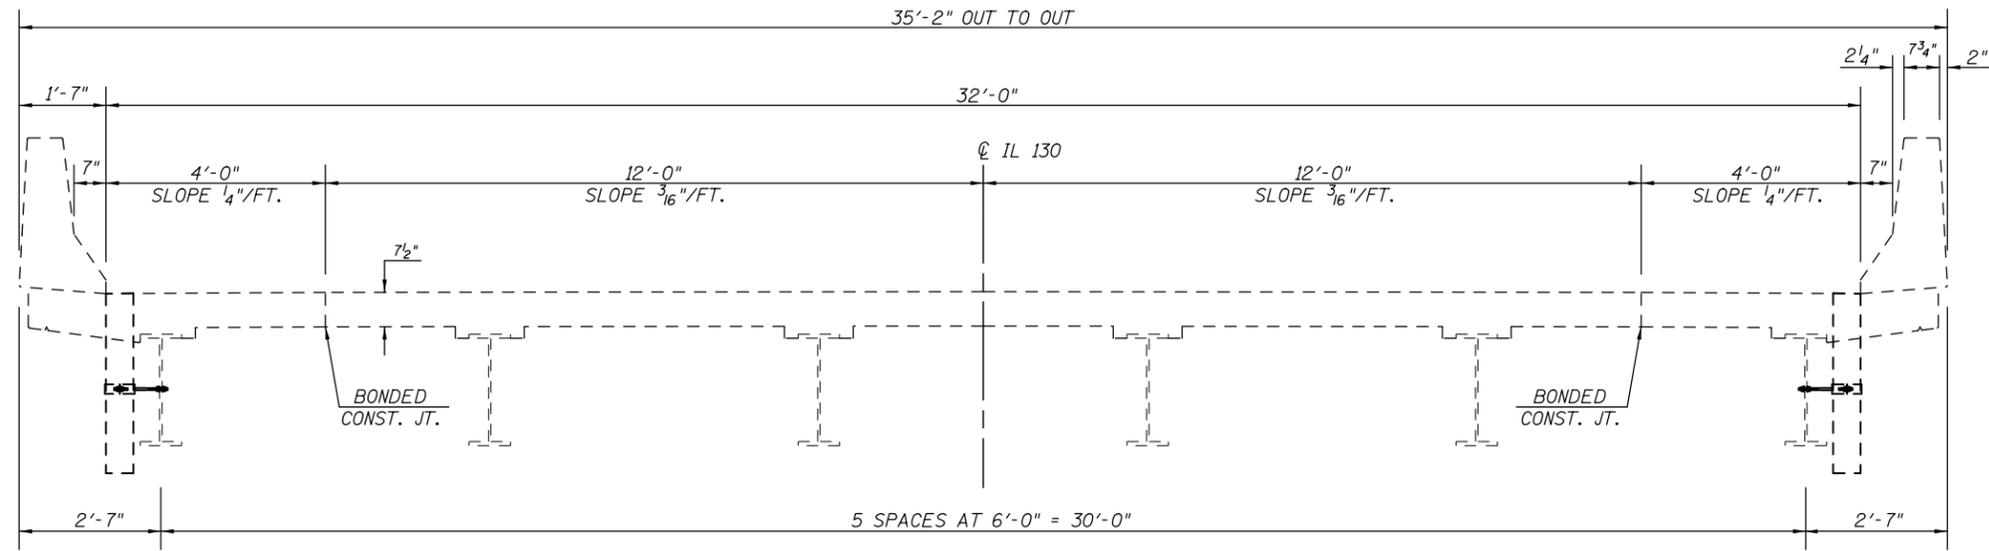

**LOOKING NORTH**

## PROPOSED DECK CROSS SECTION

**S.N. 021-0031**

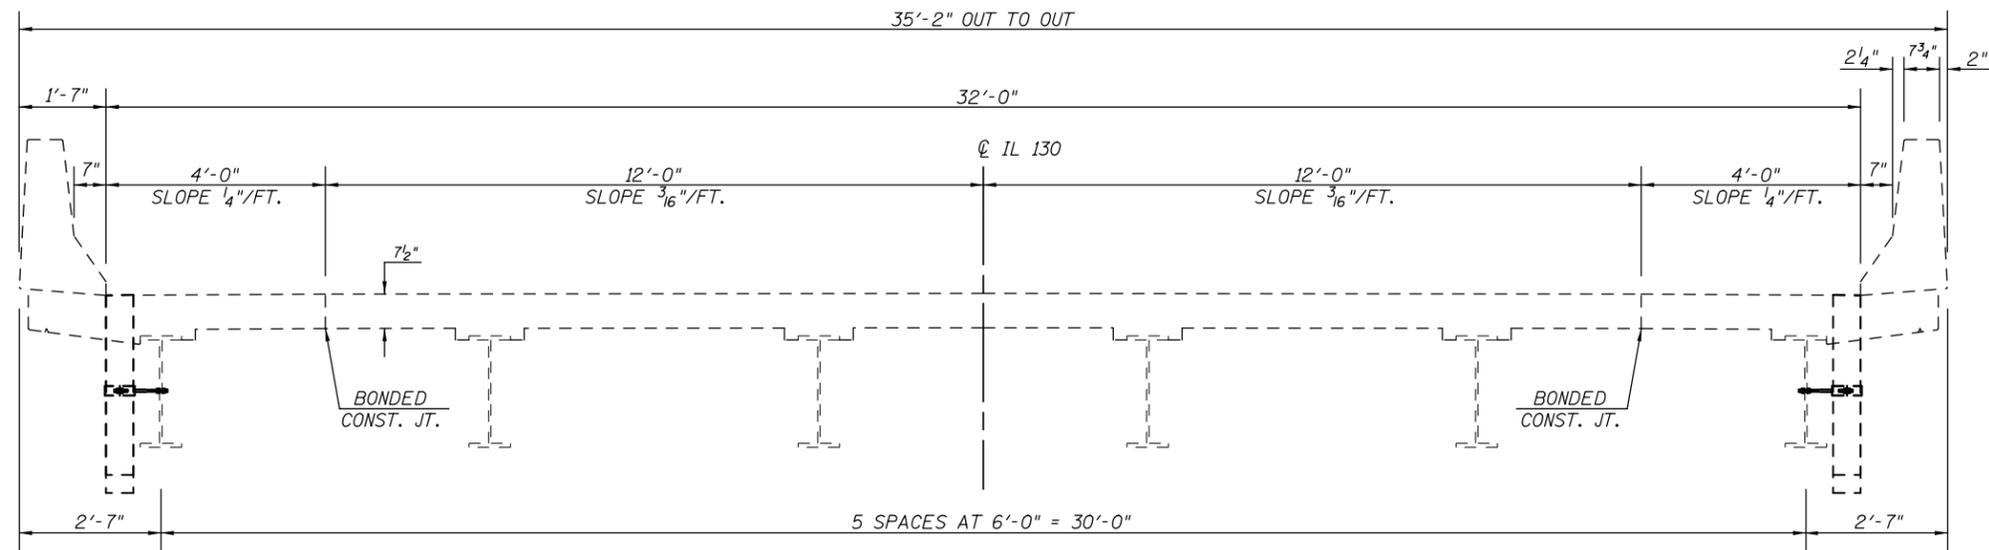

**LOOKING NORTH**

MODEL: \\MODEL\MAME\...  
 FILE: \\MAME\...

USER NAME = shawleres	DESIGNED - ESS	REVISED -
	DRAWN - ESS	REVISED -
PLOT SCALE = 40.0000' / in.	CHECKED - JTB	REVISED -
PLOT DATE = 11/21/2019	DATE -	REVISED -

**STATE OF ILLINOIS  
DEPARTMENT OF TRANSPORTATION**


**DECK CROSS SECTION  
S.N. 021-0031**

SCALE: SHEET 3 OF 22 SHEETS STA. TO STA.

F.A.P. RTE.	SECTION	COUNTY	TOTAL SHEETS	SHEET NO.
820	[(1-G),(25)]BDR	DOUGLAS	56	34
			CONTRACT NO. 70D77	
		ILLINOIS	FED. AID PROJECT	

# STAGE I CONSTRUCTION DETAIL


S.N. 021-0031

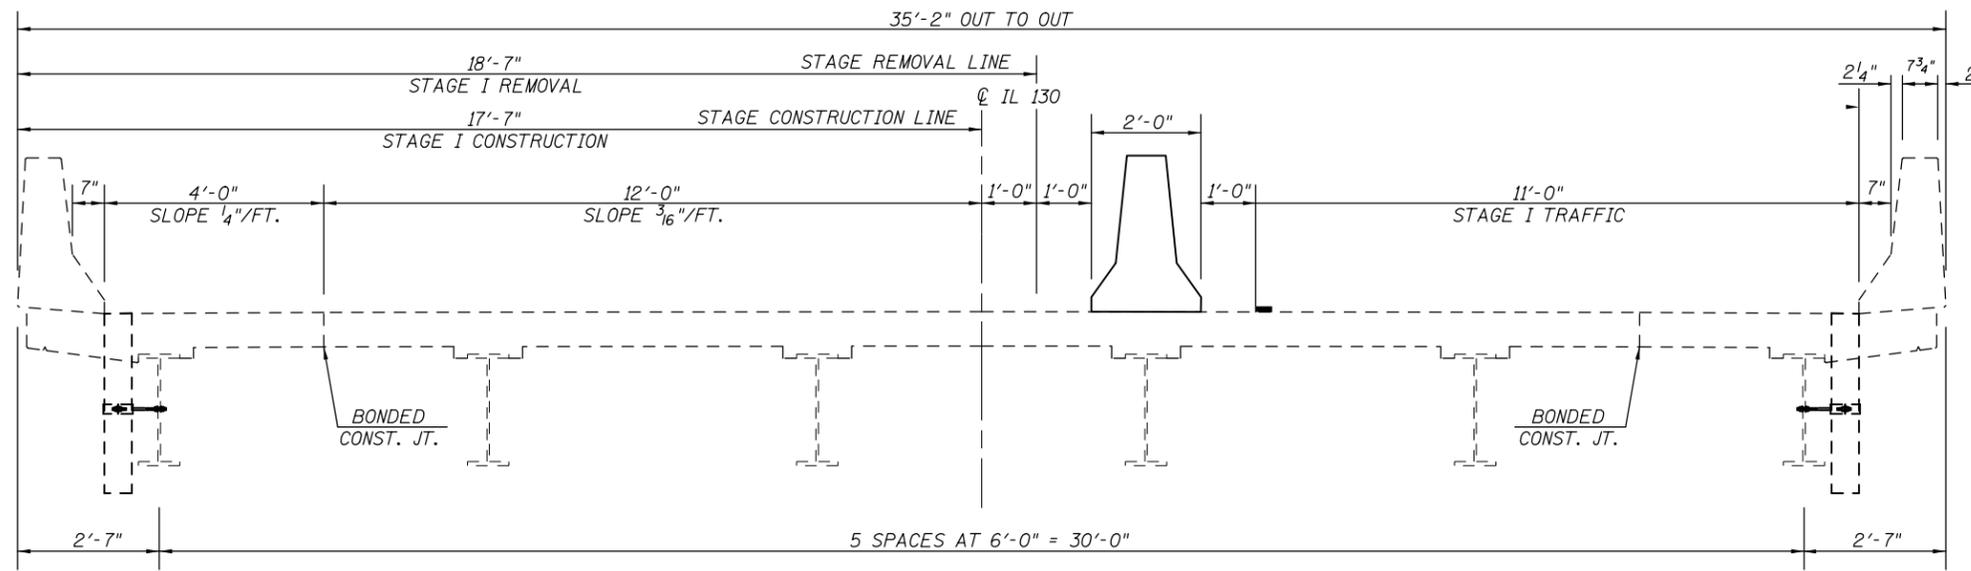

LOOKING NORTH

# STAGE II CONSTRUCTION DETAIL

S.N. 021-0031

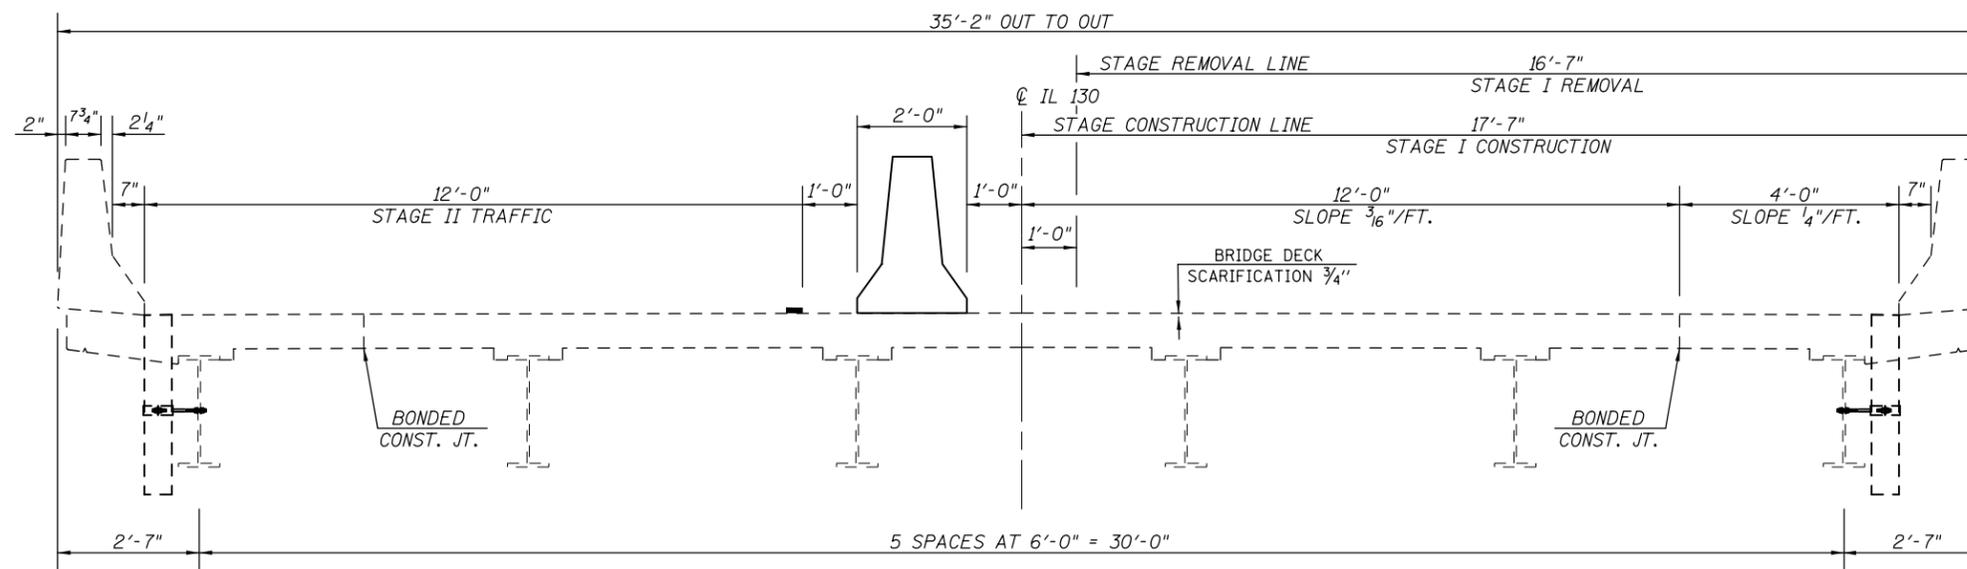

LOOKING NORTH

MODEL: \\MODEL\MAR\F...  
 FILE NAME: P:\pub\mcom\m...  
 PROJECT: 5\Projects\0570077\CADD\0570077\_5H\_5R\021-0031\_C4.dgn

USER NAME = shawleres	DESIGNED - ESS	REVISED -
	DRAWN - ESS	REVISED -
PLOT SCALE = 40.0000' / in.	CHECKED - TJB	REVISED -
PLOT DATE = 11/21/2019	DATE -	REVISED -

STATE OF ILLINOIS  
DEPARTMENT OF TRANSPORTATION


STAGE CONSTRUCTION DETAILS  
S.N. 021-0031

SCALE: SHEET 4 OF 22 SHEETS STA. TO STA.


F.A.P. RTE.	SECTION	COUNTY	TOTAL SHEETS	SHEET NO.
820	[(1-G),(25)]BDR	DOUGLAS	56	35
CONTRACT NO. 70D77				
ILLINOIS FED. AID PROJECT				

# CONCRETE REMOVAL PLAN

S.N. 021-0031

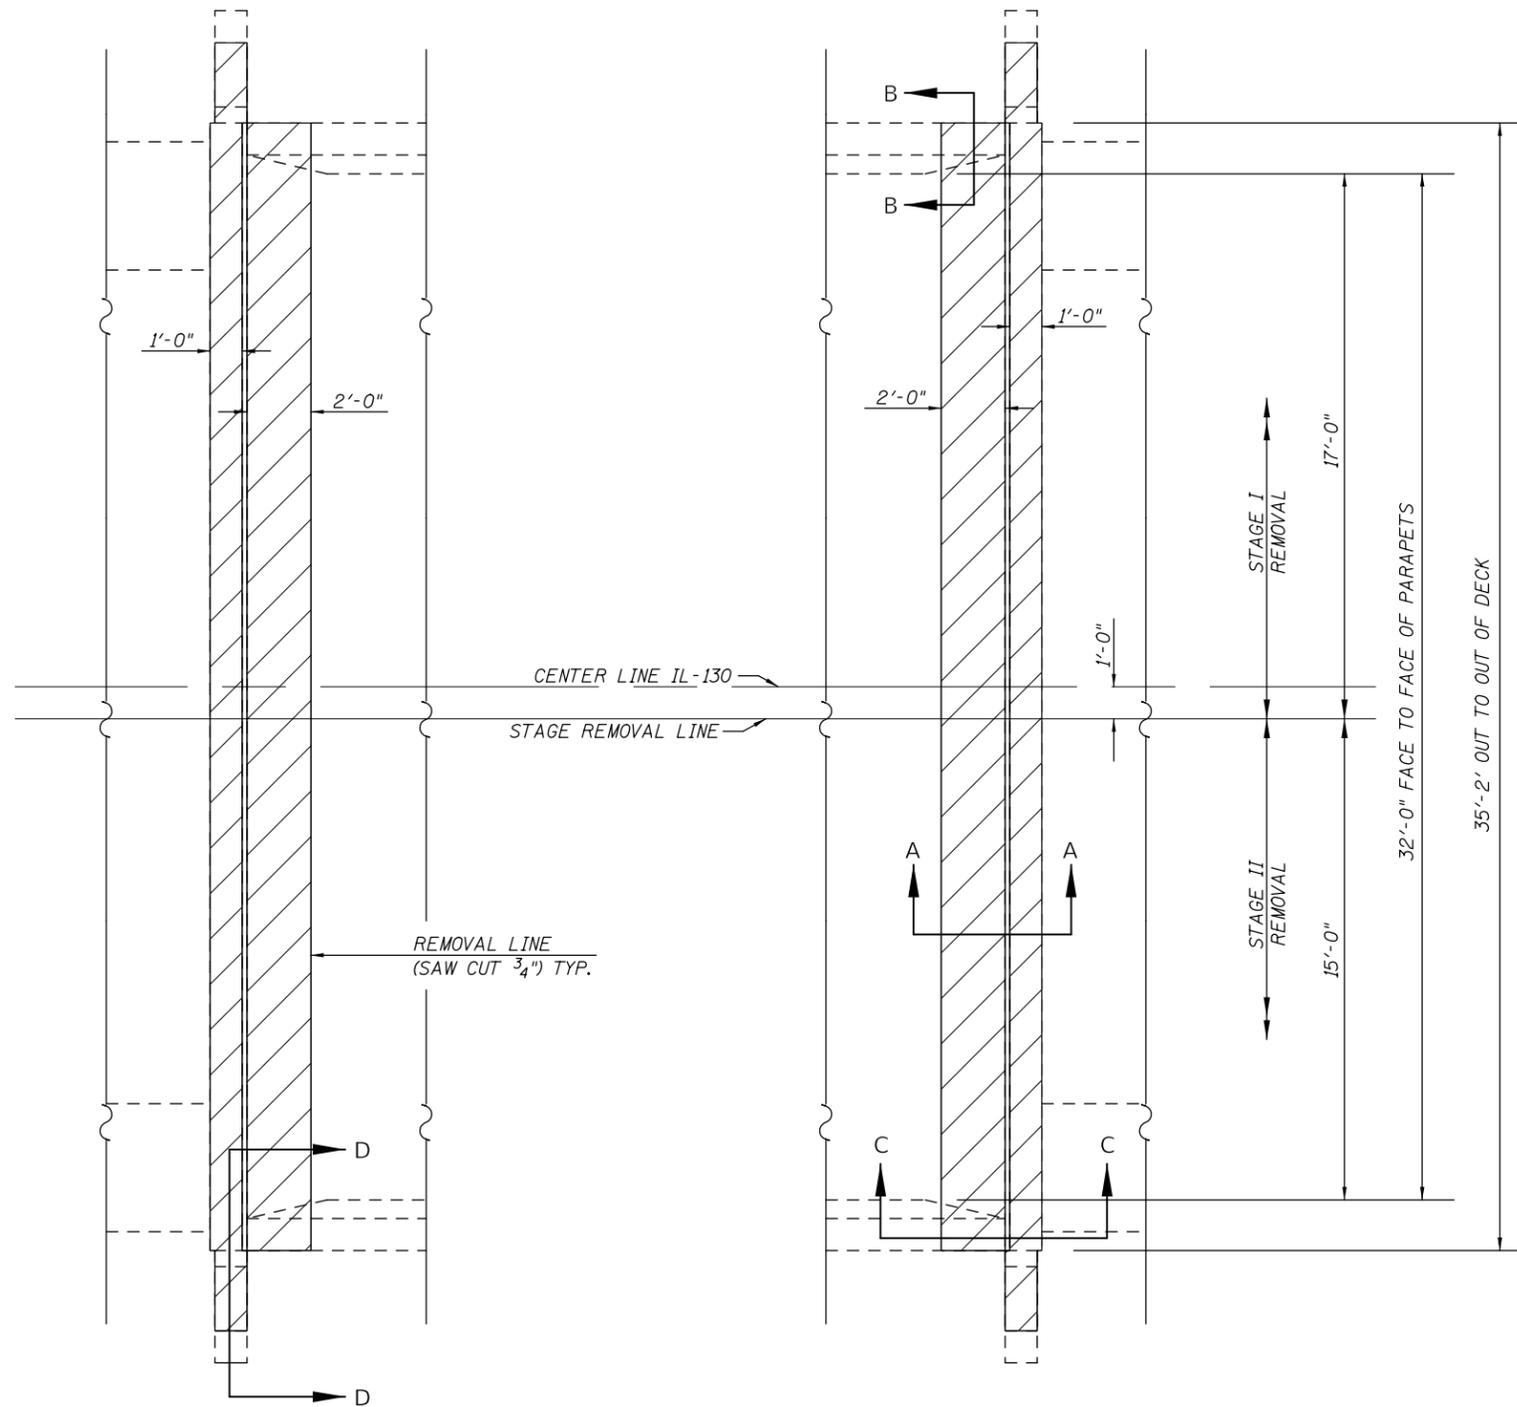

**PLAN VIEW  
CONCRETE REMOVAL**

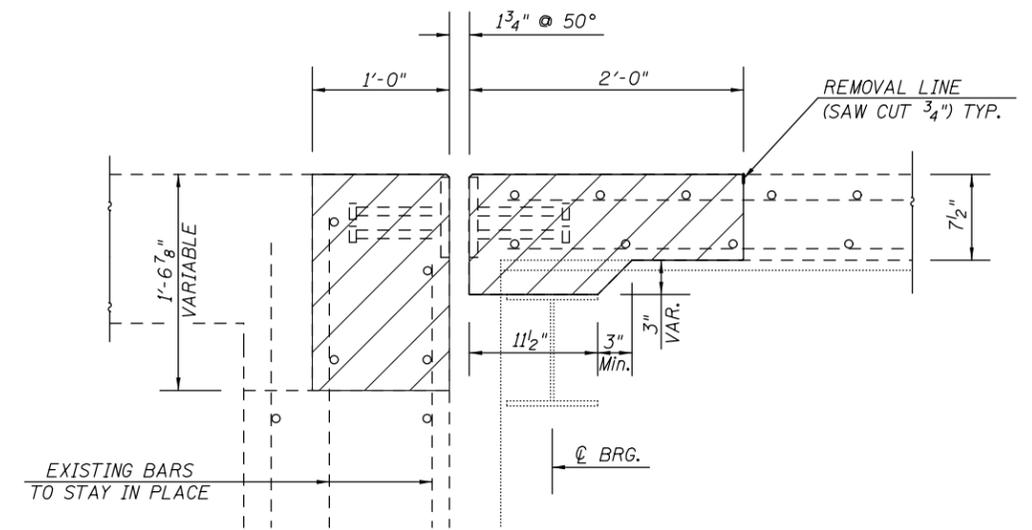

**SECTION A-A  
CONCRETE REMOVAL**



**NOTE:**

THE EXISTING EXPANSION JOINT SYSTEM SHALL BE REMOVED COMPLETELY, AS WELL AS ANY FOREIGN MATERIAL THAT HAS ACCUMULATED OR BEEN PLACED IN THE JOINT OPENINGS. THE COST OF THIS WORK IS INCLUDED IN CONCRETE REMOVAL AND NO ADDITIONAL COMPENSATION WILL BE ALLOWED.

THE GUARDRAIL WITHIN THE PARAPET REMOVAL AND REPLACEMENT LIMITS SHALL BE REMOVED TO ALLOW FOR THE REPAIR WORK TO BE COMPLETED. THE CONTRACTOR IS TO SAFELY STORE REMOVED MATERIAL. FOLLOWING COMPLETION OF REPAIR WORK THE CONTRACTOR TO EITHER SAVE AND RE-USE THE EXISTING CAST-IN-PLACE ANCHOR SYSTEM OR USE EPOXY-GROUTED THREADED RODS TO RE-ATTACH THE EXISTING GUARDRAIL. THE COST OF THIS WORK IS INCLUDED IN CONCRETE REMOVAL AND CONCRETE SUPERSTRUCTURE AND NO ADDITIONAL COMPENSATION WILL BE ALLOWED.

MODEL: \\MODEL\MARIS... FILE: \\MARIS... PROJECTS\0570077\CADD\DATA\CAD\PROJECTS\0570077\_5H\_5R\021-0031\_CRM.dgn


USER NAME = shawleres	DESIGNED - ESS	REVISED -
PLOT SCALE = 40.0000 ' / in.	DRAWN - ESS	REVISED -
PLOT DATE = 1/24/2020	CHECKED - TJB	REVISED -
	DATE -	REVISED -

**STATE OF ILLINOIS  
DEPARTMENT OF TRANSPORTATION**


**CONCRETE REMOVAL - JOINTS  
S.N. 021-0031**

SCALE: SHEET 5 OF 22 SHEETS STA. TO STA.


F.A.P. RTE.	SECTION	COUNTY	TOTAL SHEETS	SHEET NO.
820	[(1-G),(25)]BDR	DOUGLAS	56	36
			CONTRACT NO. 70D77	
ILLINOIS FED. AID PROJECT				

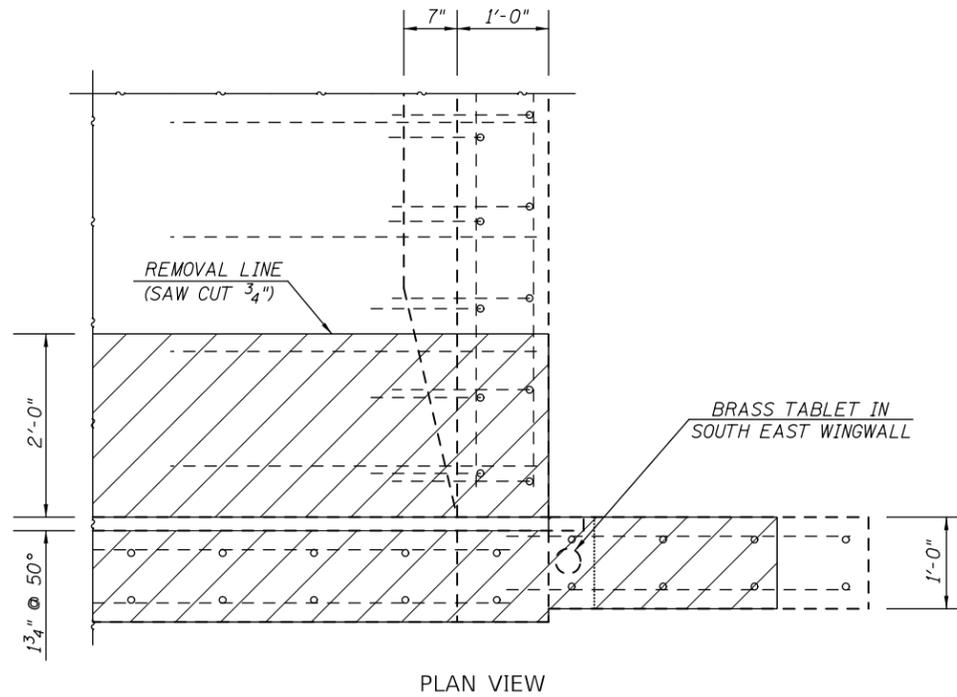


**VIEW E-E**  
**CONCRETE REMOVAL**  
ALL WINGWALLS (SIMILAR)

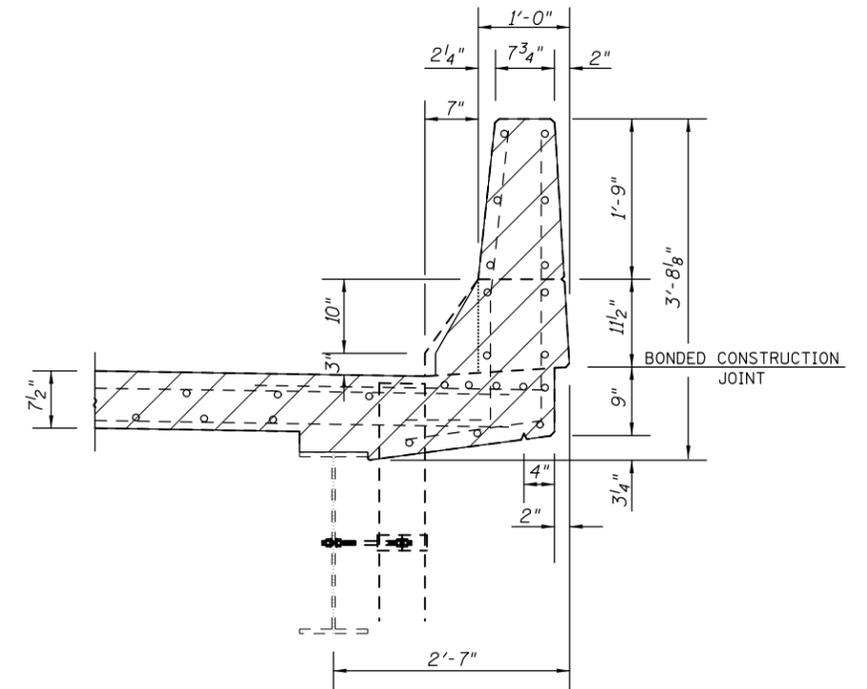

**SECTION B-B**  
**CONCRETE REMOVAL**

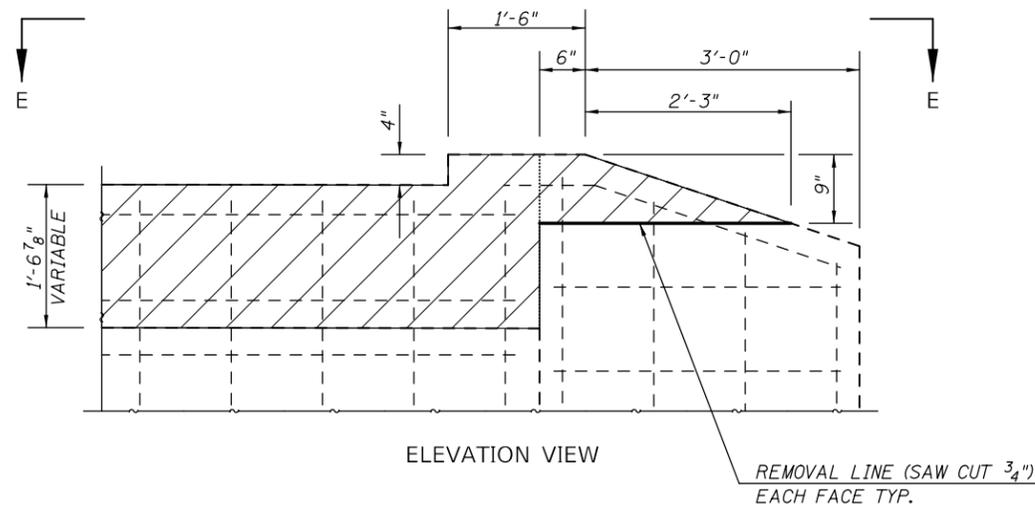

**SECTION D-D**  
**CONCRETE REMOVAL**  
ALL WINGWALLS (SIMILAR)

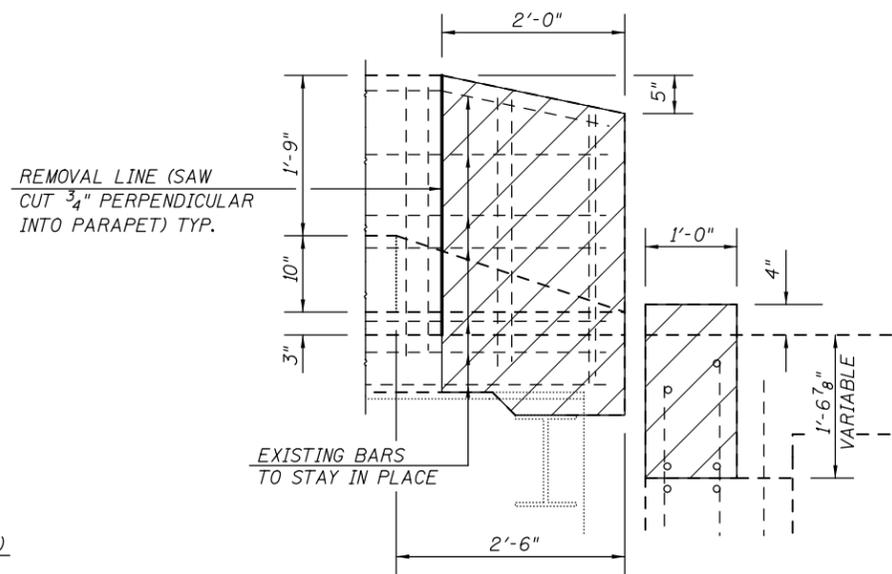

**SECTION C-C**  
**CONCRETE REMOVAL**

CONCRETE REMOVAL

**BILL OF MATERIALS**

ITEM	UNIT	TOTAL
CONCRETE REMOVAL	CU YD	9.5

MODEL: \\MODEL\MARTE  
 FILE: \\MARTE\_Plan\BIM\70D77\CADD\BIM\Documents\BDR\_Offices\BDR\70D77\CADD\BIM\CAD\BIM\70D77\_5H\_Sr\_021-0031\_C4.dgn

USER NAME = shawleres	DESIGNED - ESS	REVISED -
	DRAWN - ESS	REVISED -
PLOT SCALE = 40.0000 ' / in.	CHECKED - TJB	REVISED -
PLOT DATE = 1/24/2020	DATE -	REVISED -

**STATE OF ILLINOIS**  
**DEPARTMENT OF TRANSPORTATION**


**CONCRETE REMOVAL - JOINTS**  
**S.N. 021-0031**

SCALE: SHEET 6 OF 22 SHEETS STA. TO STA.


F.A.P. RTE.	SECTION	COUNTY	TOTAL SHEETS	SHEET NO.
820	[(1-G),(25)]BDR	DOUGLAS	56	37
			CONTRACT NO. 70D77	
		ILLINOIS	FED. AID PROJECT	

# CONCRETE REMOVAL PLAN

S.N. 021-0031

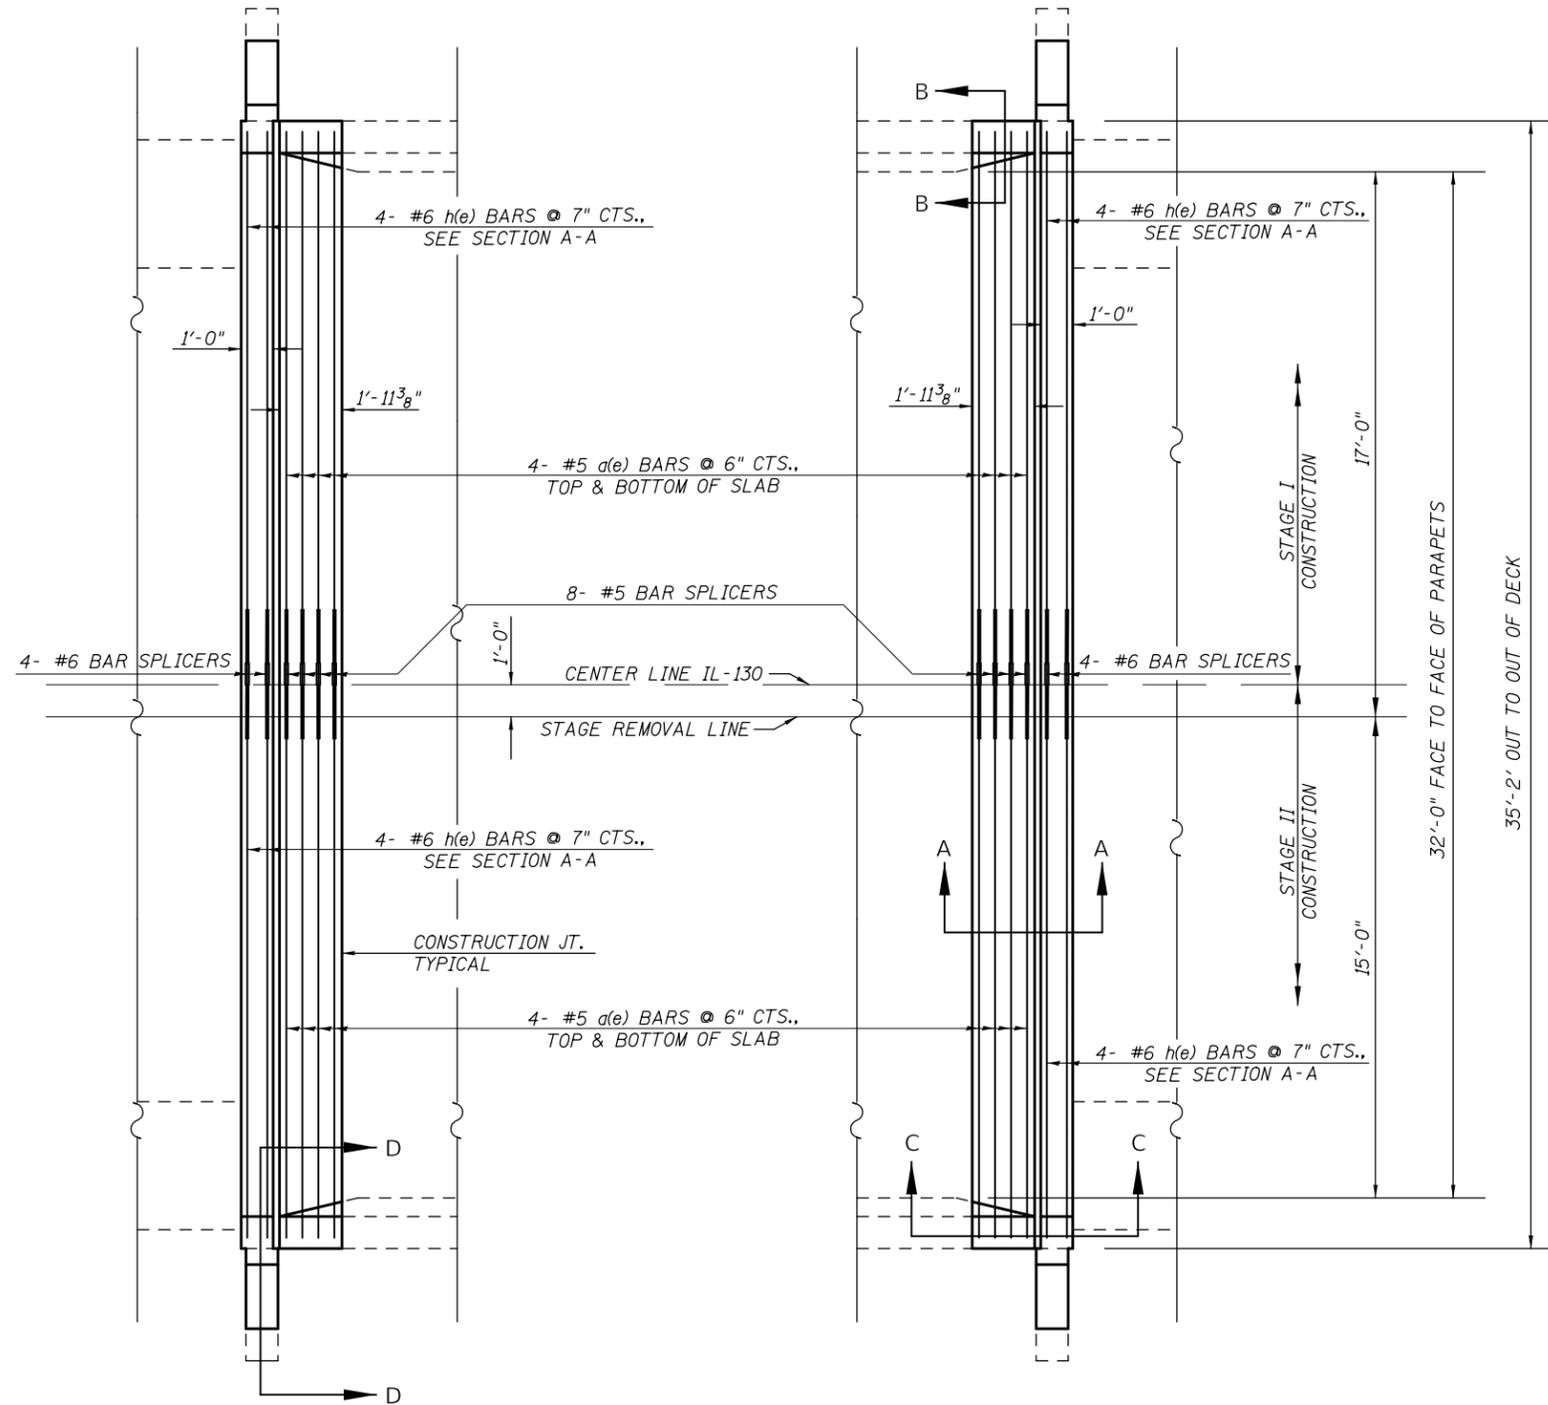

**PLAN VIEW  
CONCRETE REMOVAL**

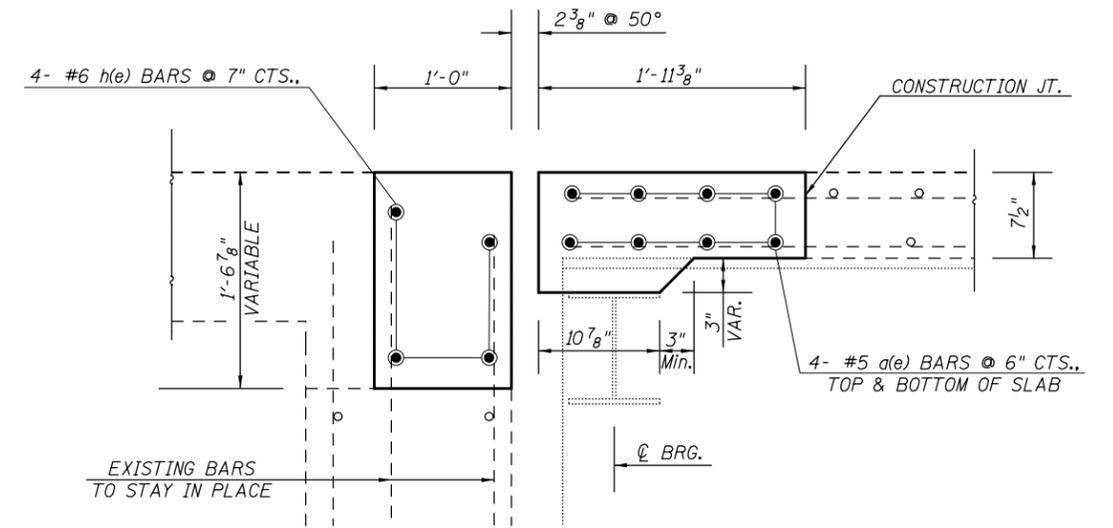

**SECTION A-A  
CONCRETE SUPERSTRUCTURE**

MODEL: \\MODELNAME  
 FILE: \\NAME: \\path\to\file.dwg  
 PROJECT: \\PROJECTNAME  
 OFFICE: \\OFFICE  
 DATE: 1/24/2020

USER NAME = shawleres	DESIGNED - ESS	REVISED -
PLOT SCALE = 40,0000 ' / in.	DRAWN - ESS	REVISED -
PLOT DATE = 1/24/2020	CHECKED - TJB	REVISED -
	DATE -	REVISED -

**STATE OF ILLINOIS  
DEPARTMENT OF TRANSPORTATION**


**CONCRETE SUPERSTRUCTURE - JOINTS  
S.N. 021-0031**

SCALE: SHEET 7 OF 22 SHEETS STA. TO STA.


F.A.P. RTE.	SECTION	COUNTY	TOTAL SHEETS	SHEET NO.
820	[(1-G),(25)]BDR	DOUGLAS	56	38
CONTRACT NO. 70D77			ILLINOIS FED. AID PROJECT	




MODEL: \$MODELNAME\$  
 FILE NAME: pw:\planroom\dot.illinois.gov\PWIDOT\Documents\DOT Offices\District 5\Projects\570D77\CADData\CADSheets\570D77\_sh\_Sir\_021-0031\_Cm.dgn

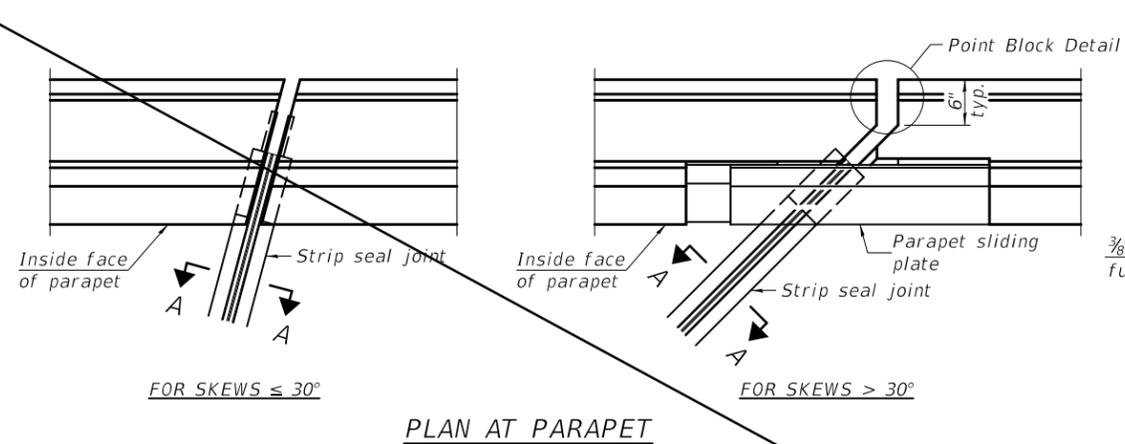

PLAN AT PARAPET

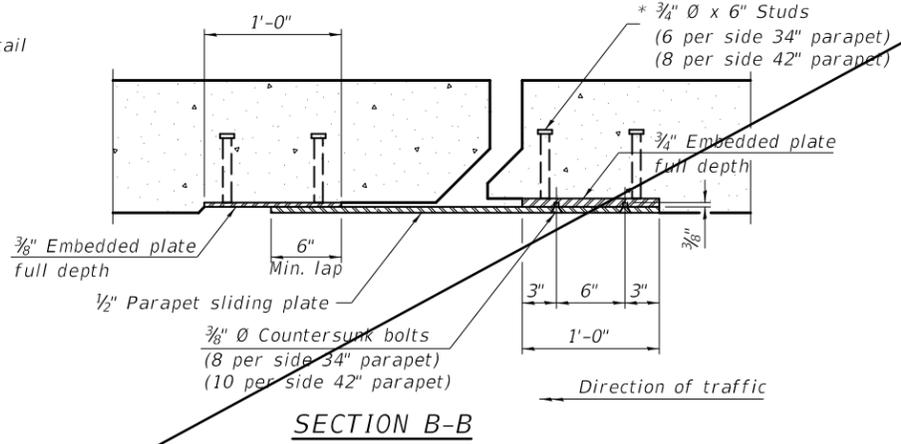


SECTION B-B

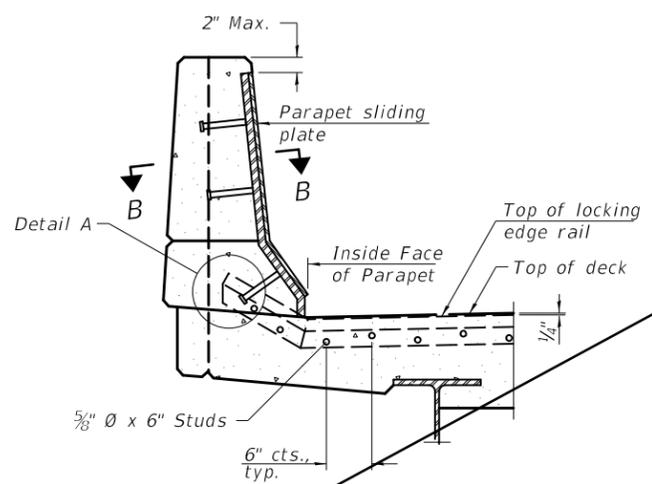


ELEVATION AT PARAPET

(Skews > 30° shown. Skews <= 30° similar except as shown in plan view.)

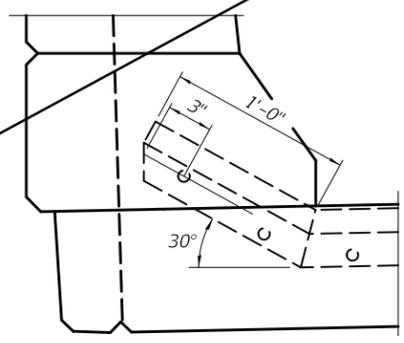


DETAIL A

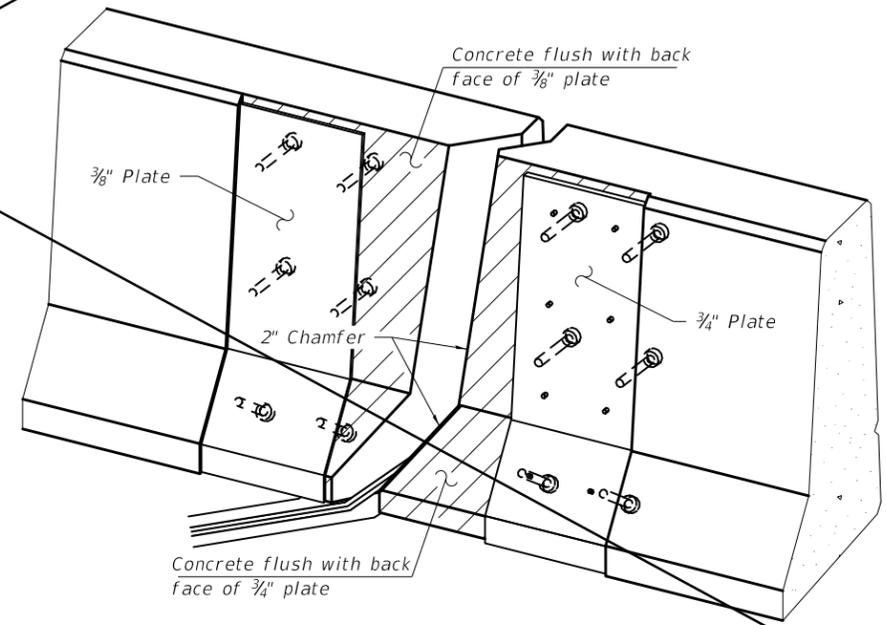


TRIMETRIC VIEW  
(Showing embedded plates only)

Notes:  
 The strip seal shall be made continuous and shall have a minimum thickness of 1/4". The configuration of the strip seal shall match the configuration of the locking edge rails. Open or "webbed" strip seal gland configurations are not permitted. The gland shall be sized for a maximum rated movement of 4 inches.  
 The locking edge rails depicted are configured for typical applications and are conceptual only. The actual configuration of the locking edge rails and matching strip seal may vary from manufacturer to manufacturer provided they fit the application and meet the minimum anchorage shown. Flanged edge rails, however, will not be allowed. Locking edge rails may exceed the 4 1/2" maximum depth provided the anchorage system is revised according to the manufacturer's recommendation.  
 The manufacturer's recommended installation methods shall be followed.  
 All steel components shall be galvanized after fabrication according to Article 520.03 of the Standard Specifications.  
 The Maximum space between locking edge rail segments shall be 3/16" and sealed with a suitable sealant; however, any rail joint within 10' measured perpendicular to the face of the curb or parapet shall be welded as shown in the locking edge rail splice detail.  
 Cost of parapet sliding plates, embedded plates, and anchorage studs included with Preformed Joint Strip Seal.  
 34" F-shape barrier shown, 42" F-shape similar as noted.  
 The concrete opening below the strip seal will vary based on the locking edge rail chosen by the Contractor. Deck and parapet lengths shown elsewhere in the plans are dimensioned to the concrete opening, not the joint opening, and are based on the rolled locking edge rail. If the Contractor elects to use a different locking edge rail, dimensional adjustments may be required. One exception to this would be the strip seal joint at the end of the precast bridge approach slab. For these cases the pavement connector length shall be adjusted, not the length of the bridge approach slab.

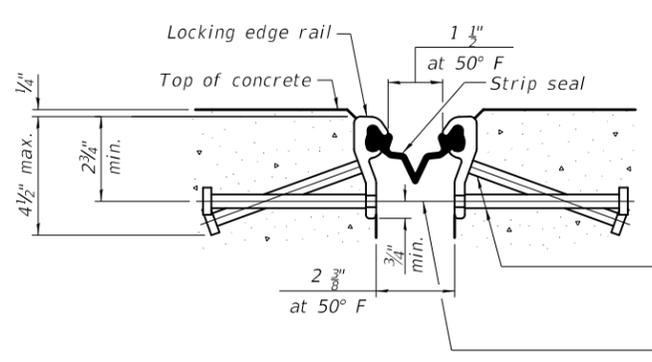


SHOWING ROLLED RAIL JOINT

\* 5/8"  $\phi$  x 6" studs @ 6" cts. (alternate angled/bent studs with horizontal studs)  
 3/8"  $\phi$  threaded rods in 7/16"  $\phi$  holes at  $\pm 4'-0"$  cts. for holding the proper joint opening based on the temperature during the deck pour. Place to miss studs. All rods shall be burned, or sawed off flush with the plates after concrete is set.

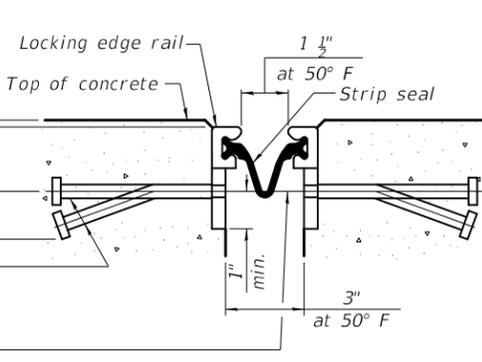


SHOWING WELDED RAIL JOINT

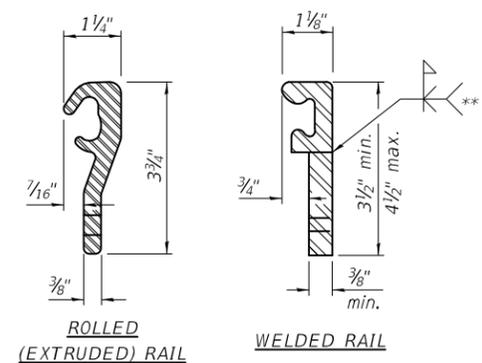

LOCKING EDGE RAILS

\*\* Back gouge not required if complete joint penetration is verified by mock-up.

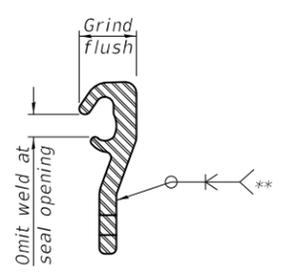

LOCKING EDGE RAIL SPLICE

The inside of the locking edge rail groove shall be free of weld residue. Rolled rail shown, welded rail similar.

BILL OF MATERIAL

Item	Unit	Total
Preformed Joint Strip Seal	Foot	80.0

EJ-SS 1-24-2020

USER NAME =	DESIGNED -	REVISED -
PLOT SCALE =	CHECKED -	REVISED -
PLOT DATE =	DRAWN -	REVISED -
	CHECKED -	REVISED -

STATE OF ILLINOIS  
 DEPARTMENT OF TRANSPORTATION


PREFORMED JOINT STRIP SEAL  
 STRUCTURE NO. 021-0031

SHEET 9 OF 22 SHEETS

F.A. RTE.	SECTION	COUNTY	TOTAL SHEETS	SHEET NO.
			56	40
CONTRACT NO.				
ILLINOIS FED. AID PROJECT				





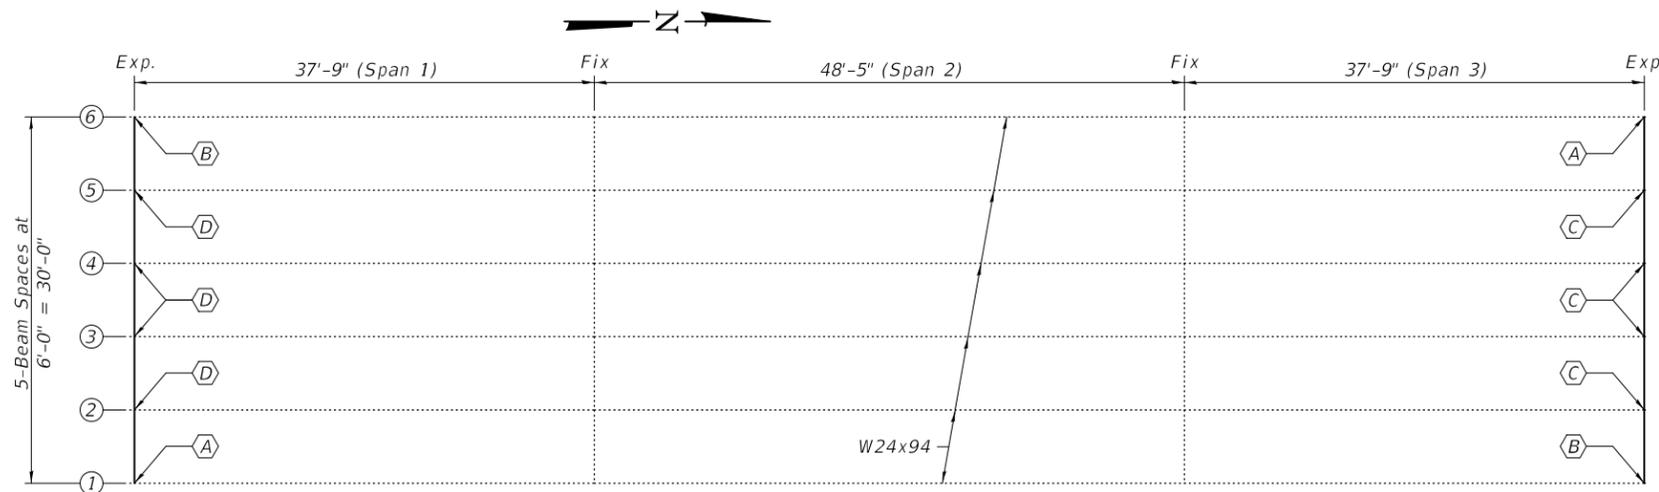


**FRAMING PLAN**

- (A) - Beam End Repair (1S & 6N)
- (B) - Beam End Repair (1N & 6S)
- (C) - Beam End Repair (2N, 3N, 4N & 5N)
- (D) - Beam End Repair (2S, 3S, 4S & 5S)
- (E) - Remove & Replace Bearings at Both Abutments
- (F) - Remove & Replace Diaphragms at Both Abutments

**GENERAL NOTES**

All structural steel shall conform to AASHTO Classification M-270 Gr. 36, unless otherwise noted.  
 Plan dimensions and details relative to existing plans are subject to nominal construction variations. The Contractor shall field verify existing dimensions and details affecting new construction and make necessary approved adjustments prior to construction or ordering of materials. Such variations shall not be cause for additional compensation for a change in scope of the work, however, the Contractor will be paid for the quantity actually furnished at the unit price bid for the work.  
 Fasteners shall be high strength bolts. Bolts  $\frac{3}{4}\phi$ , open holes  $1\frac{1}{16}\phi$ , unless otherwise noted.  
 Existing structural steel that will be in contact with new structural steel shall be cleaned and painted prior to erection as required by the special provision "Cleaning and Painting Contact Surface Areas of Existing Steel Structures".  
 All new structural steel shall be hot-dip galvanized. See Special Provisions for "Hot Dip Galvanizing for Structural Steel".

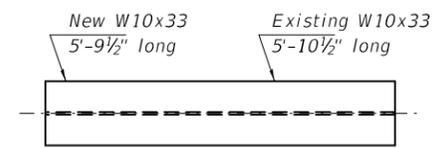


**DIAPHRAGM**  
(10 Required)


**REPAIR F**

Existing  $L 6'' \times 4'' \times \frac{3}{4}''$  shall be removed by the air-arc method and grind smooth all weld material remaining on the web.


- BOLT HOLE LEGEND**
- - Field drill using new or existing steel as template.
  - - Shop drill holes in new steel.

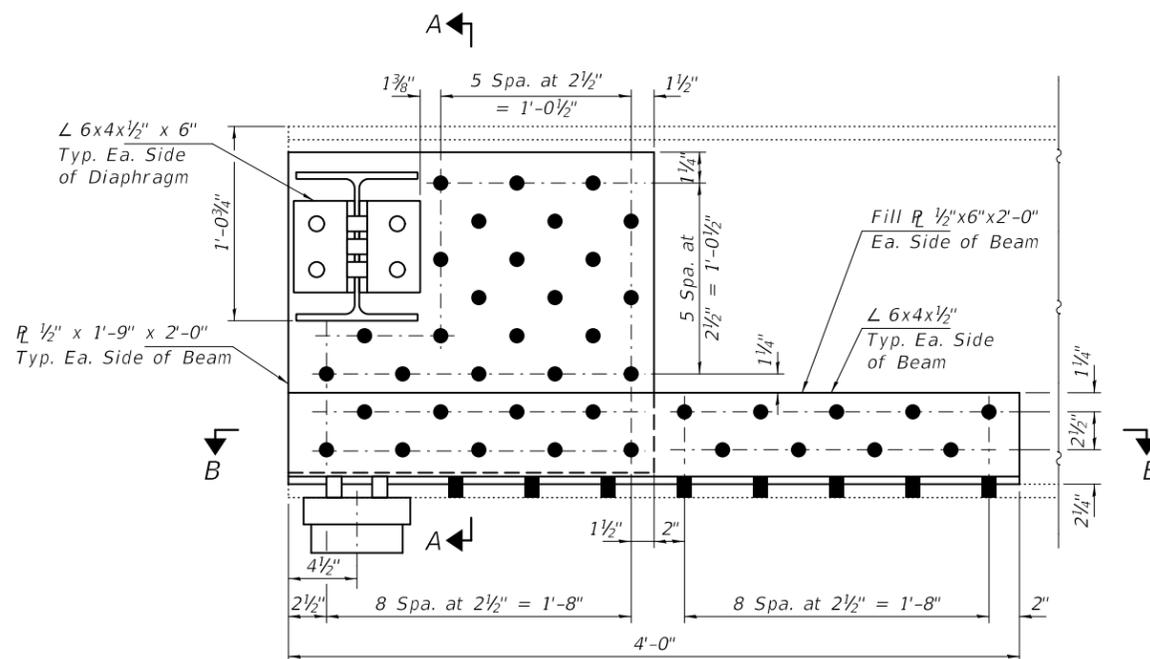


**REPAIR A**  
(2 Locations)

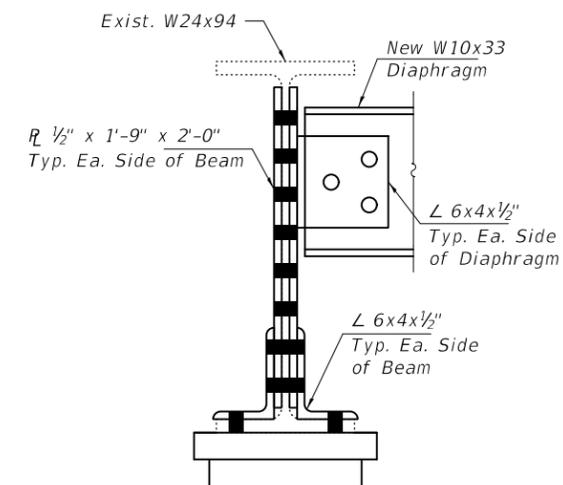

**SECTION A-A**

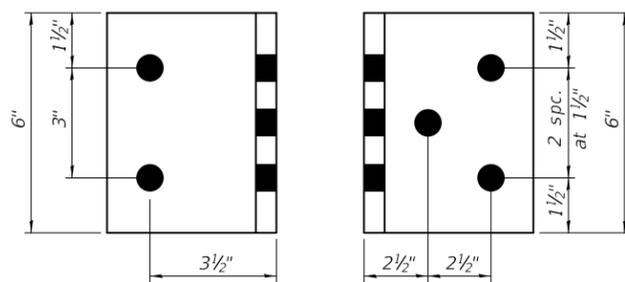

**CLIP ANGLE DETAILS**  
 $L 6 \times 4 \times \frac{1}{2}'' \times 6''$  long  
(8 Required)

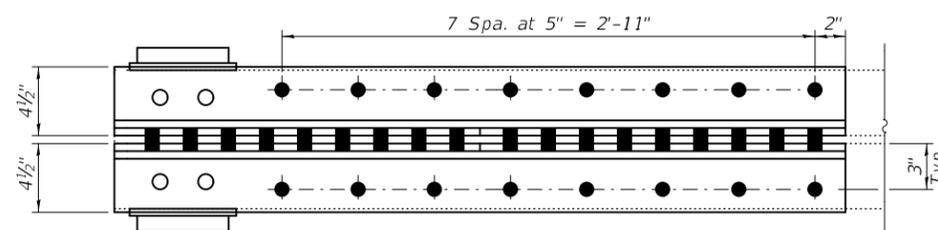

**SECTION B-B**

**BILL OF MATERIAL**

ITEM	UNIT	QUANTITY
Structural Steel Removal	Pound	2440
Structural Steel Repair	Pound	3930
Furnishing and Erecting Structural Steel	Pound	2160

DESIGNED - JSB  
 CHECKED - AJR  
 DRAWN - Venkat Reddy  
 CHECKED - JSB AJR

EXAMINED  
 PASSED  
 ENGINEER OF STRUCTURAL SERVICES  
 ENGINEER OF BRIDGES AND STRUCTURES


DATE - January 24, 2020  
 REVISED -  
 REVISED -

STATE OF ILLINOIS  
 DEPARTMENT OF TRANSPORTATION


GENERAL PLAN AND ELEVATION  
 FAP 820 OVER SCATTERING FORK  
 SN 021-0031

SHEET NO. 1 OF 3 SHEETS


F.A.P. RTE.	SECTION	COUNTY	TOTAL SHEETS	SHEET NO.
820	[(1-G),(25)]BDR	DOUGLAS	56	43
CONTRACT NO. 70D77				
ILLINOIS FED. AID PROJECT				

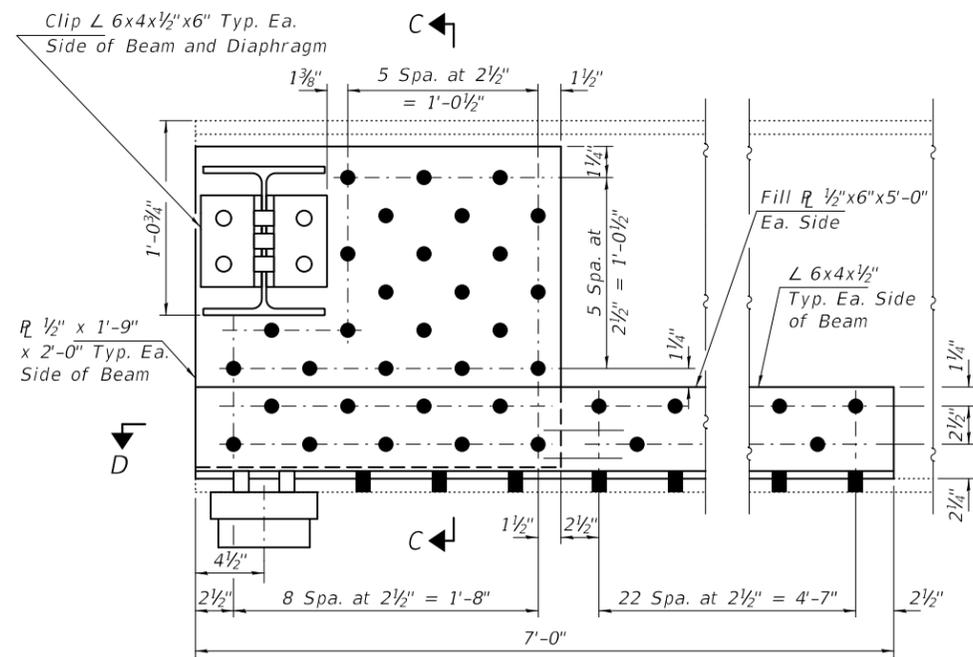


**REPAIR B**  
(2 Locations)

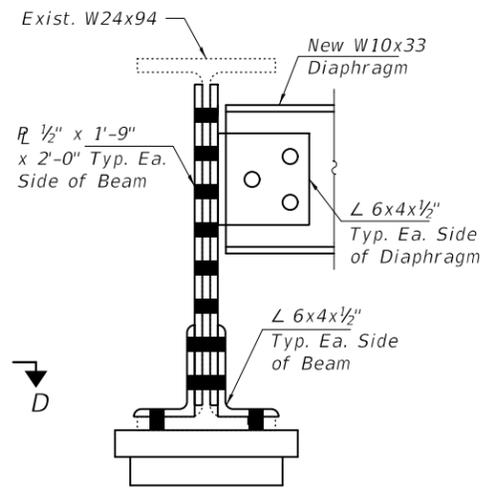


**SECTION C-C**

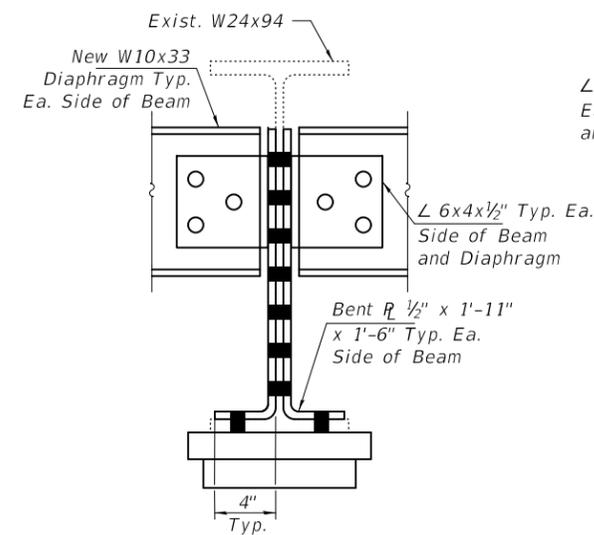


**SECTION E-E**

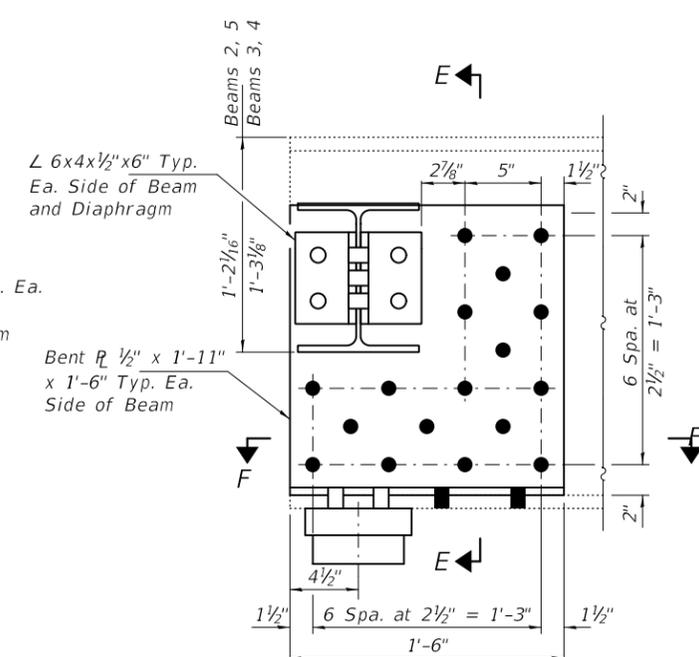


**REPAIR C**  
(4 Locations)

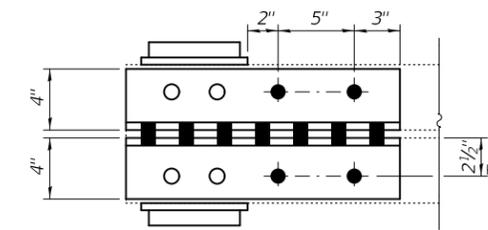

**SECTION F-F**

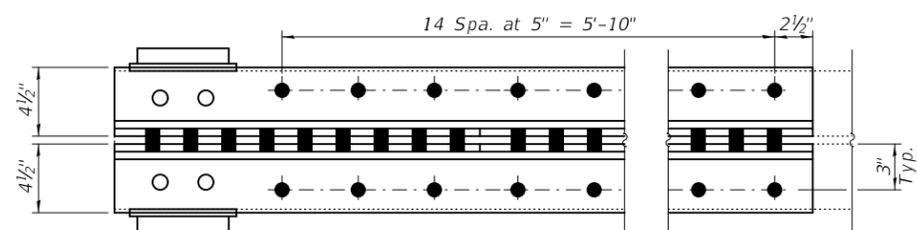


**SECTION D-D**

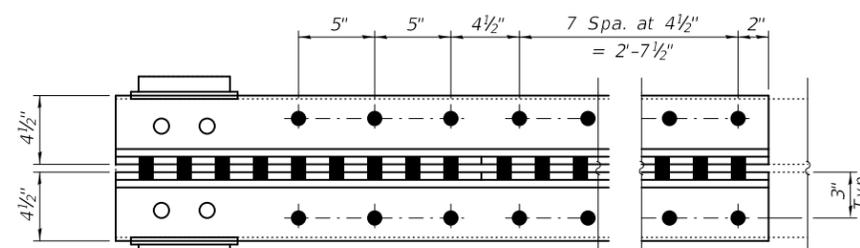


**SECTION J-J**

**BOLT HOLE LEGEND**

- - Field drill using new or existing steel as template.
- - Shop drill holes in new steel.

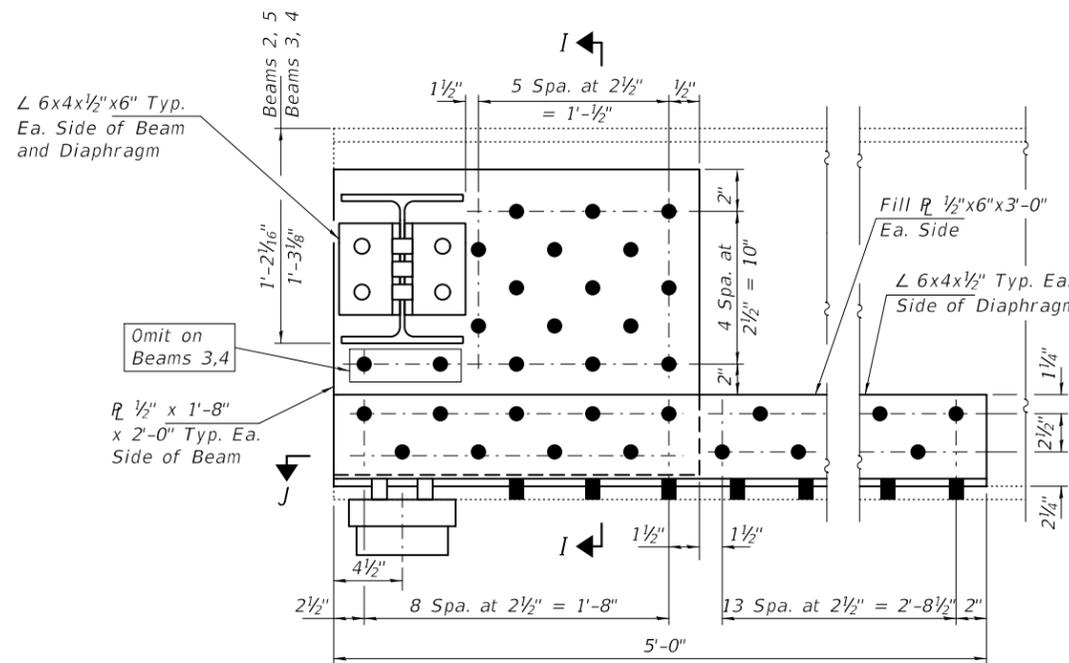

**REPAIR D**  
(4 Locations)

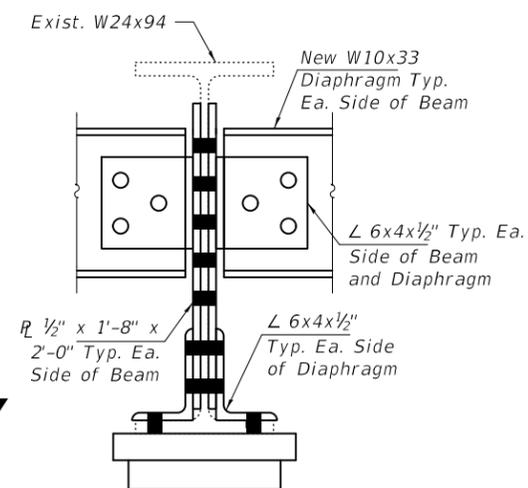

**SECTION I-I**

DESIGNED - JSB  
CHECKED - AJR  
DRAWN - Venkat Reddy  
CHECKED - JSB AJR

EXAMINED  
PASSED  
Timothy A. Daulton  
ENGINEER OF STRUCTURAL SERVICES  
Carl R. Rieger  
ENGINEER OF BRIDGES AND STRUCTURES


DATE - January 24, 2020  
REVISED -  
REVISED -

STATE OF ILLINOIS  
DEPARTMENT OF TRANSPORTATION

BEAM END REPAIR DETAILS - REPAIR B, C & D  
SN 021-0031


SHEET NO. 2 OF 3 SHEETS

F.A.P. RTE. 820	SECTION [(1-G),(25)]BDR	COUNTY DOUGLAS	TOTAL SHEETS 56	SHEET NO. 44
CONTRACT NO. 70D77			ILLINOIS FED. AID PROJECT	

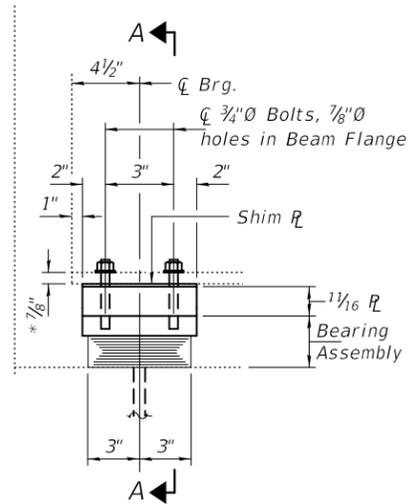

**ELEVATION AT ABUTMENT**

**TYPE I ELASTOMERIC EXP. BRG.**

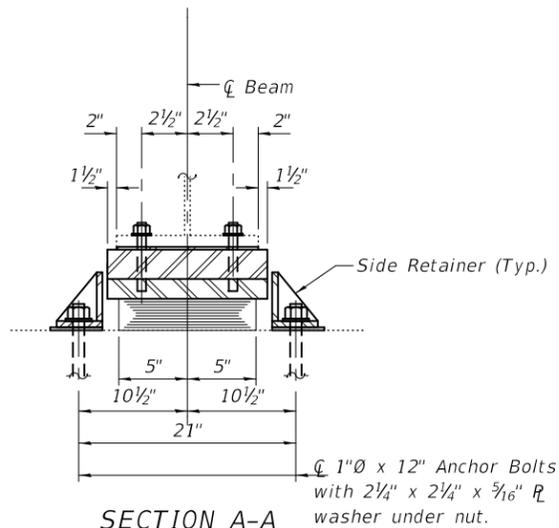

**SECTION A-A**

**BEAM REACTIONS**

R <sub>l</sub>	(K)	13.8
R <sub>t</sub>	(K)	31.8
Imp.	(K)	9.5
R (Total)	(K)	55.1

**Notes:**

Diaphragm removal and reinstallation may be required to facilitate drilling holes. Cost included with Furnishing and Erecting Structural Steel.

New steel extensions, shim plates and connection bolts are included with Furnishing and Erecting Structural Steel.


Prior to ordering any material, the Contractor shall verify in the field all bearing height and shim thickness dimensions. Adjustment must account for deck heave due to pack rust (if present).

Min. jack capacity = 26 Tons.

Anchor bolts shall be ASTM F1554 all-thread (or an Engineer-approved alternate material) of the grade(s) and diameter(s) specified. ASTM A307 Grade C anchor bolts may be used in lieu of ASTM F1554 Grade 36 (F<sub>y</sub>=36ksi). The corresponding specified grade of AASHTO M314 anchor bolts may be used in lieu of ASTM F1554.

Drilled and set anchor bolts shall be installed according to Article 521.06 of the Standard Specifications.

Cost of Side retainers and Stainless Steel plates shall be included in the cost of Elastomeric Bearing Assembly, Type I.

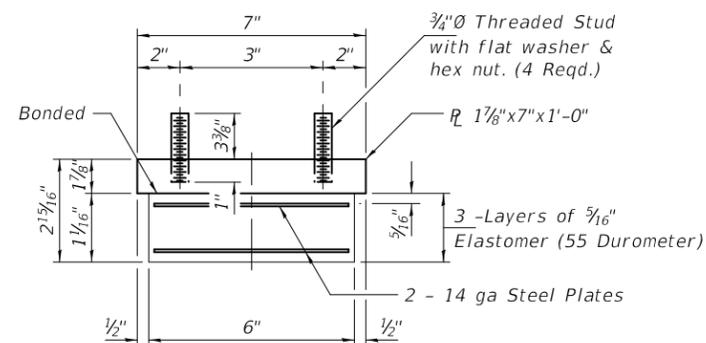


**BEARING ASSEMBLY**

**Note:**


Shim plates shall not be placed under Bearing Assembly.

\* See sheets 1 thru 2 of 3 for additional repair R thickness

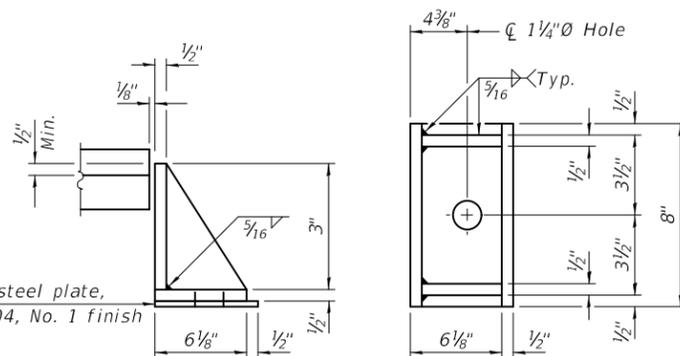

**SIDE RETAINER**

Equivalent rolled angle with stiffeners will be allowed in lieu of welded plates.

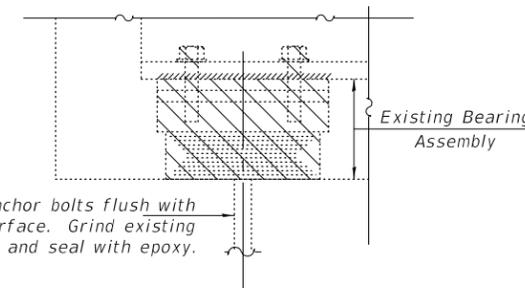

**EXISTING BEARING REMOVAL DETAIL**

Cost included with Jack and Remove Existing Bearings.

**BILL OF MATERIAL**

Item	Unit	Total
Elastomeric Bearing Assembly, Type I	Each	12
Jack and Remove Existing Bearings	Each	12
Furnishing and Erecting Structural Steel	Pound	310
Anchor Bolts, 1"Ø	Each	24

DESIGNED - JSB  
 CHECKED - AJR  
 DRAWN - Venkat Reddy  
 CHECKED - JSB AJR

EXAMINED  
 PASSED  
 ENGINEER OF STRUCTURAL SERVICES  
 ENGINEER OF BRIDGES AND STRUCTURES

DATE - January 24, 2020  
 REVISED -  
 REVISED -

STATE OF ILLINOIS  
 DEPARTMENT OF TRANSPORTATION

BEARING REPLACEMENT DETAILS - REPAIR E  
 SN 021-0031

SHEET NO. 3 OF 3 SHEETS



F.A.P. RTE. SECTION COUNTY TOTAL SHEETS SHEET NO.  
 820 [(1-G),(25)]BDR DOUGLAS 56 45  
 CONTRACT NO. 70D77  
 ILLINOIS FED. AID PROJECT








# AS-BUILT PLANS FOR INFORMATION ONLY


PROJECT NO.	SECTION	COUNTY	TOTAL SHEETS	SHEET NO.
F.A.P. RTE. 820	I-G-BR	DOUGLAS	127	64
SHEET NO. 4 10 SHEETS				

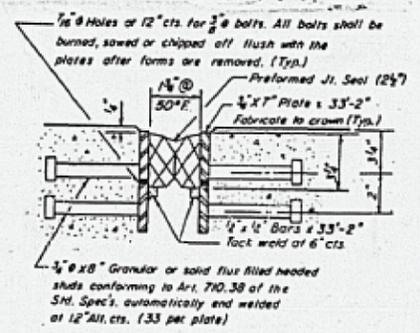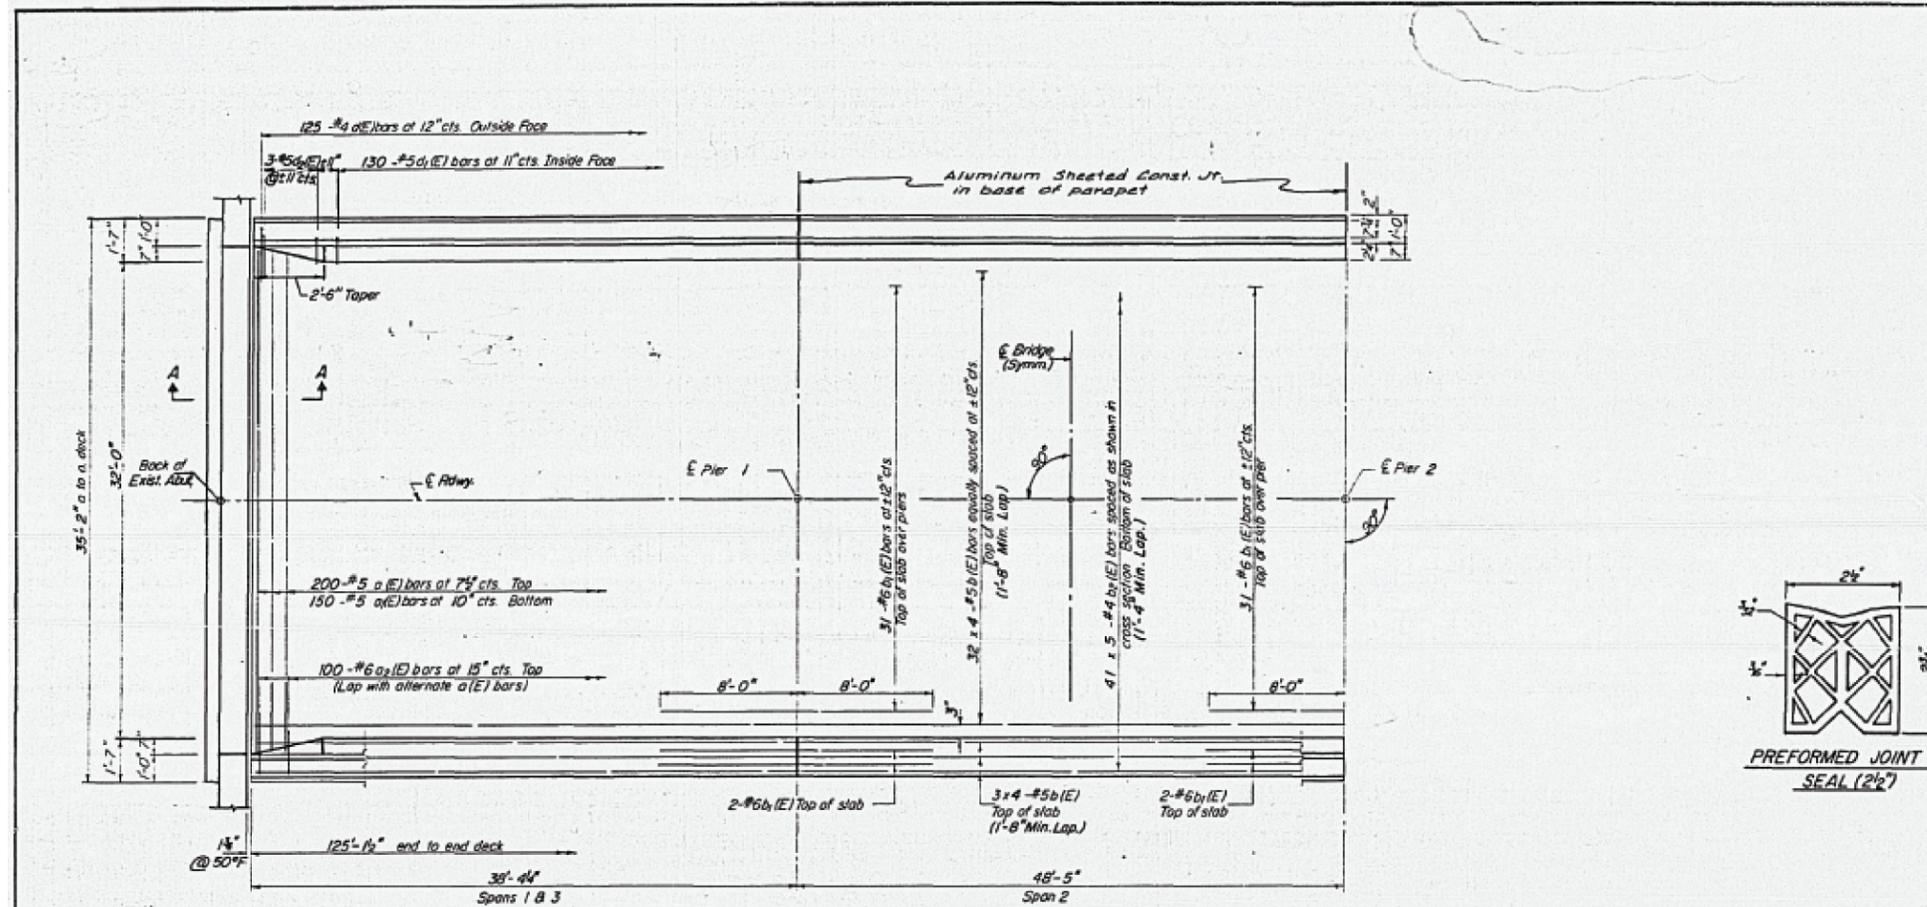

**DETAIL OF EXP. JT.**

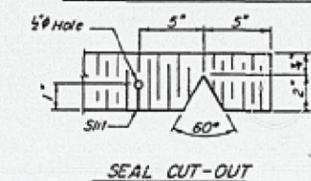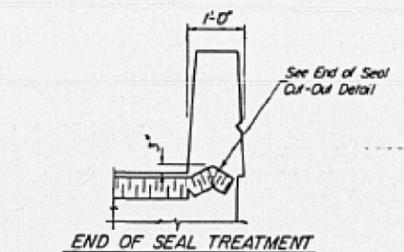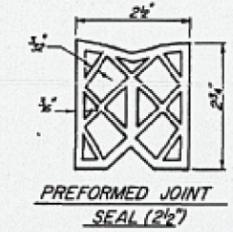

**NOTES:**  
See sheet # 5 for superstructure details and Bill of Material  
Reinforcement bars designated (E) shall be epoxy coated  
Bars indicated thus 20 x 3-#5 etc. indicates 20 lines of bars with 3 lengths per line.  
See Sheet # 5 for Sec. A-A.

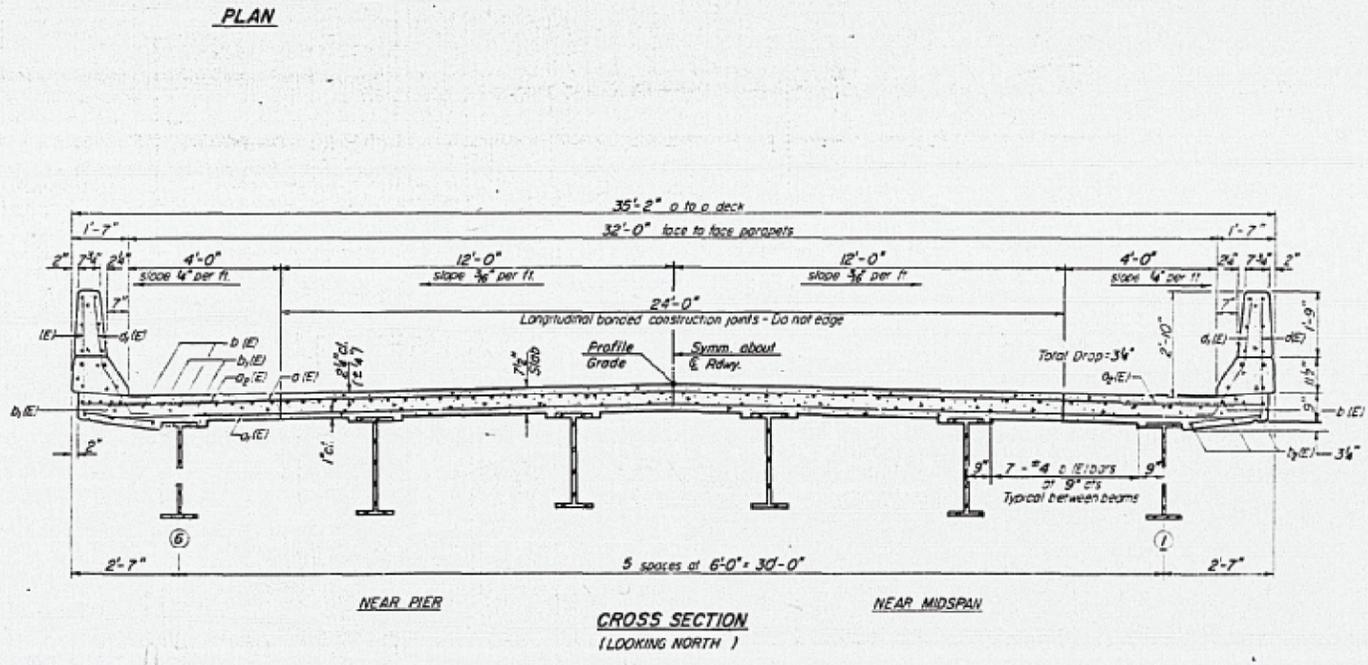

**SUPERSTRUCTURE**  
**F.A.P. RTE. 820 ~ SEC. I-G-BR-**  
**DOUGLAS COUNTY**  
**STA. 513+66.70**

USER NAME = shawleres	DESIGNED -	REVISED -
	DRAWN -	REVISED -
PLOT SCALE = 40.0000 "/td> <td>CHECKED -</td> <td>REVISED -</td>	CHECKED -	REVISED -
PLOT DATE = 11/21/2019	DATE -	REVISED -

**STATE OF ILLINOIS  
DEPARTMENT OF TRANSPORTATION**

**AS-BUILT PLANS  
S.N. 021-0031**


SCALE: SHEET 17 OF 22 SHEETS STA. TO STA.

F.A.P. RTE.	SECTION	COUNTY	TOTAL SHEETS	SHEET NO.
820	[(I-G),(25)]BDR	DOUGLAS	56	48
CONTRACT NO. 70D77				
ILLINOIS FED. AID PROJECT				



MODEL: \\MODEL\MARKS  
FILE: \\MARKS\_Plan\Submittal\0000000000\Documents\BDR - Office\BDR.ctb 5:10:2019 11:21:2019

# AS-BUILT PLANS FOR INFORMATION ONLY


SHEET NO. 5				
10 SHEETS				
F.A.P. 820 I-G-BR DOUGLAS 127 65				

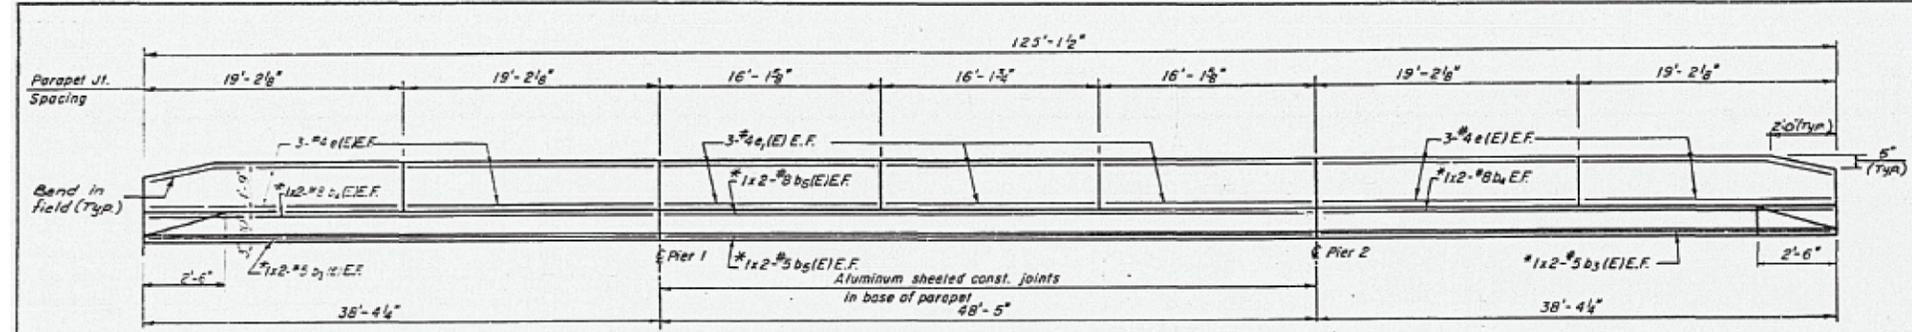


**\* Min. Bar Laps**  
 #5  $d_3(E)$ , #5  $b_5(E)$  = 1'-8"  
 #8  $d_4(E)$ , #8  $b_6(E)$  = 3'-5"  
**INSIDE ELEVATION OF PARAPET**

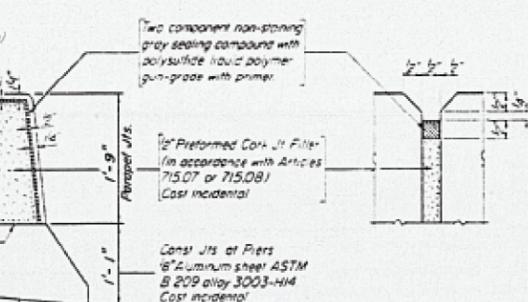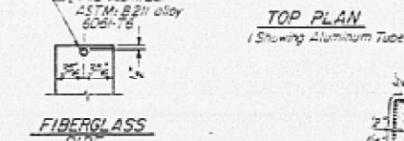


**PARAPET JOINT DETAILS**

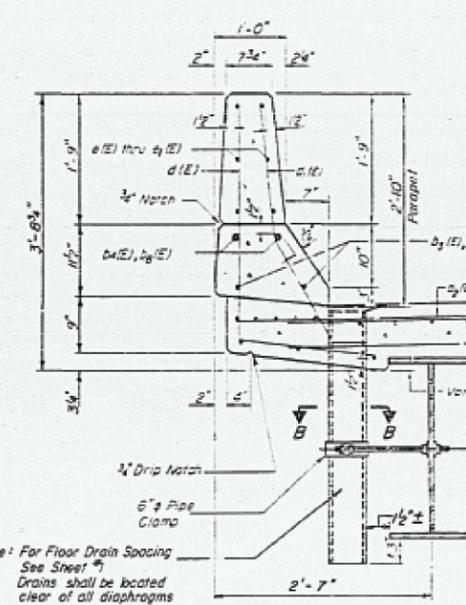


**SECTION THRU PARAPET**

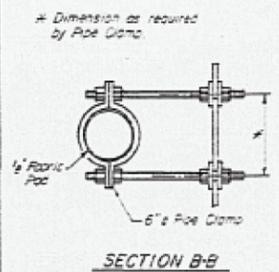

**SECTION B-B**

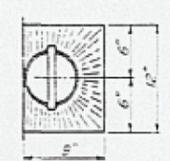

**TOP PLAN**

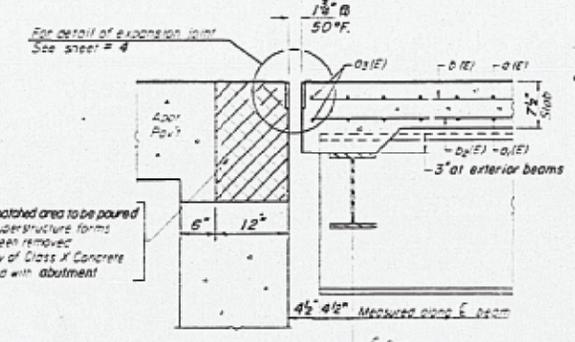

**SECTION A-A**

**SUPERSTRUCTURE  
BILL OF MATERIAL**

Bar	No	Size	Length	Shape
$d_1(E)$	200	#5	34'-0"	
$d_2(E)$	150	#5	34'-0"	
$d_3(E)$	200	#6	4'-0"	
$d_4(E)$	152	#6	32'-6"	
$d_5(E)$	70	#6	16'-0"	
$d_6(E)$	205	#4	26'-3"	
$d_7(E)$	16	#5	20'-0"	
$d_8(E)$	16	#8	21'-0"	
$d_9(E)$	8	#6	25'-0"	
$d_{10}(E)$	8	#8	26'-0"	
$d_{11}(E)$	250	#4	4'-8"	
$d_{12}(E)$	260	#5	3'-11"	
$d_{13}(E)$	12	#5	4'-2"	
$e_1(E)$	48	#4	18'-9"	
$e_2(E)$	36	#4	15'-9"	
Reinforcement Bars (Epoxy Coated)	Lbs	28,910		
Class II Concrete	Cu Yds	135.5		
Floor Drains	Each	14		

Reinforcement bars designated (E) shall be epoxy coated.  
 Bars indicated thus 20x3-5 etc indicate 20 lines of bars with 3 lengths per line.

**SUPERSTRUCTURE DETAILS  
 E. P. RTE. 820 ~ SEC. 1-G-BR  
 DOUGLAS COUNTY  
 STA. 513+66.70**

MODEL: \\MODEL\NAME: FILE: \\MODEL\... PROJECT: 0570077\CAD\BDR\... SHEET: 021-0031\_CAD.dwg

USER NAME = shawleres	DESIGNED -	REVISED -
	DRAWN -	REVISED -
PLOT SCALE = 40.0000' / in.	CHECKED -	REVISED -
PLOT DATE = 11/21/2019	DATE -	REVISED -

**STATE OF ILLINOIS  
DEPARTMENT OF TRANSPORTATION**

**AS-BUILT PLANS  
S.N. 021-0031**


SCALE: SHEET 18 OF 22 SHEETS STA. TO STA.

F.A.P. RTE. 820	SECTION [(1-G),(25)]BDR	COUNTY DOUGLAS	TOTAL SHEETS 56	SHEET NO. 49
			CONTRACT NO. 70D77	
		ILLINOIS FED. AID PROJECT		

# AS-BUILT PLANS FOR INFORMATION ONLY

STATE NO.	SECTION	COUNTY	TOTAL SHEETS	SHEET NO.
F.A.P. 820	1-G-BR	DOUGLAS	127	66


SHEET NO. 6  
OF 10 SHEETS

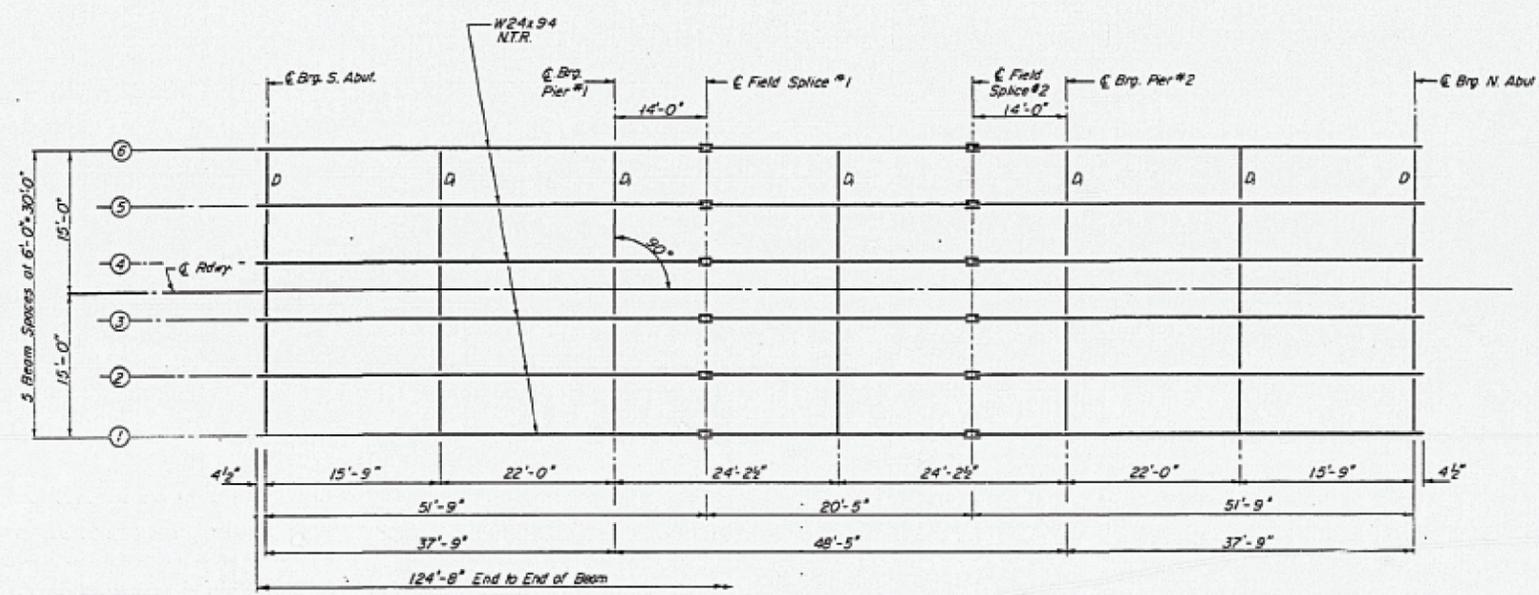



	0.4 Sp. 1	Pier	0.5 Sp. 2
$I_s$ (in <sup>4</sup> )	2700	2700	2700
$S_s$ (in <sup>3</sup> )	222	222	222
$Z$ (in <sup>3</sup> )	254		254
$\bar{P}$ (k/ft)	.966	.966	.966
$M\bar{P}$ (k)	91	181	99
$M\bar{L}$ (k)	180	151	197
$MIMP$ (k)	54	44	57
$S_3(M\bar{L} + I)$ (k)	390	325	423
$M_a$ (k)	625	658	677
$M_u$ (k)	762		762
$f_s \bar{L}$ non-comp (ksi)	4.9	9.8	5.4
$f_s \bar{S}_3(M\bar{L} + I)$ (k.s.i.)	21.1	17.6	22.9
$f_s$ (Overload) (k.s.i.)	26.0	27.4	28.3
$f_s$ (Total) (k.s.i.)		35.6	

	Abut.	Pier
$R\bar{P}$ (k)	13.8	46.4
$R\bar{L}$ (k)	31.8	39.9
$Imp$ (k)	9.5	11.8
$R$ Total (k)	55.1	98.1

$I_s$  and  $S_s$  are the moment of inertia and section modulus of the steel section used in computing  $f_s$  (Total and Overload).  
 $Z$  is the plastic section modulus used to determine the Fully Plastic Moment.  
 $M_u$  - Full Plastic Moment Capacity for Compact, Braced section.  
 $M_a$  (Applied Moment) =  $1.3 [M\bar{P} + S_3 (M\bar{L} + I)]$   
 $f_s$  (Total) is the sum of the stresses due to  $1.3 [M\bar{P} + \frac{2}{3} (M\bar{L} + I)]$   
 $f_s$  (Overload) is the sum of the stresses due to  $M\bar{P} + \frac{2}{3} (M\bar{L} + I)$   
 $M\bar{P}$  - Moment due to dead loads on non-composite section.  
 $M\bar{L}$  - Moment due to live load on non-composite section.  
 $I$  - Live load impact.

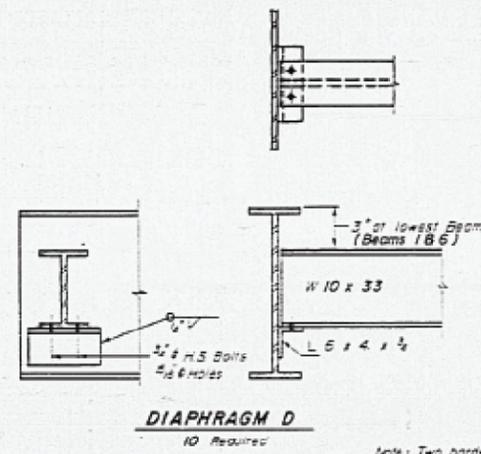

Note: Two hardened washers shall be required over all 3/4" holes.

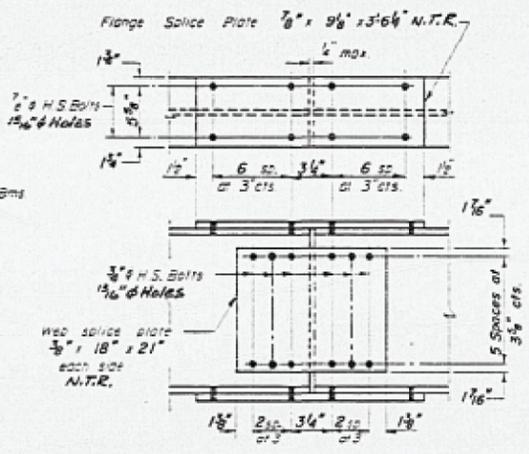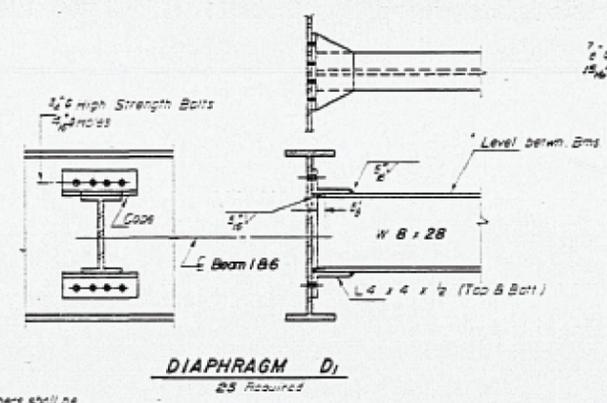

	Beam 16	Beam 2,5	Beam 3,4
$\bar{C}$ Brg. S. Abut.	636.62	636.73	636.82
$\bar{C}$ Pier 1			
$\bar{C}$ Splice 1			
$\bar{C}$ Splice 2			
$\bar{C}$ Pier 2			
$\bar{C}$ Brg. N. Abut.			

For Fabrication only. At field splice locations elevations given are at top of the W-beam.

**STRUCTURAL STEEL**  
**F.A.P. RTE. 820 ~ SEC. 1-G-BR**  
**DOUGLAS COUNTY**  
**STA. 513+66.70**

MODEL NAME: ... PROJECT: ...

USER NAME = shawleres	DESIGNED -	REVISED -
	DRAWN -	REVISED -
PLOT SCALE = 40.0000' / in.	CHECKED -	REVISED -
PLOT DATE = 11/21/2019	DATE -	REVISED -

**STATE OF ILLINOIS  
DEPARTMENT OF TRANSPORTATION**


**AS-BUILT PLANS  
S.N. 021-0031**

SCALE: SHEET 19 OF 22 SHEETS STA. TO STA.


F.A.P. RTE. 820	SECTION [(1-G),(25)]BDR	COUNTY DOUGLAS	TOTAL SHEETS 56	SHEET NO. 50
CONTRACT NO. 70D77			ILLINOIS FED. AID PROJECT	

# AS-BUILT PLANS FOR INFORMATION ONLY


SHEET NO.	SECTION	COUNT	TOTAL SHEETS	SHEET NO.	TOTAL SHEETS
F.A.P. 820	1-G-BR	DOUGLAS	127	67	10 SHEETS
PER SHEET NO. 1					

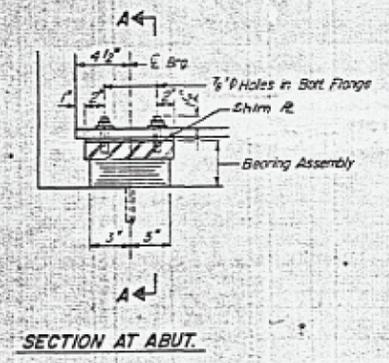


**SECTION AT ABUT.**

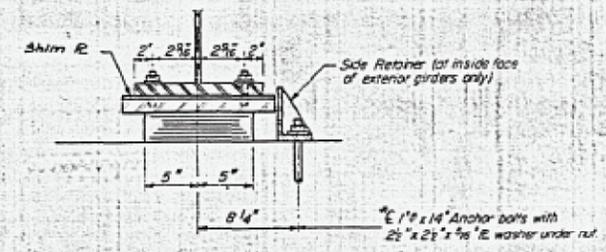

**SECTION A-A**

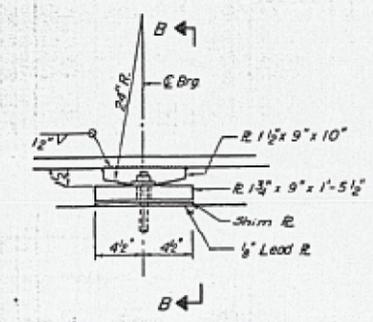


**ELEVATION AT PIERS**

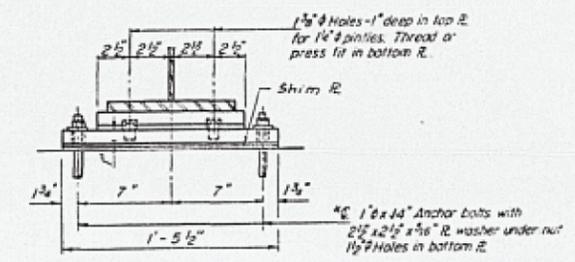


**SECTION B-B**

**FIXED BEARING**

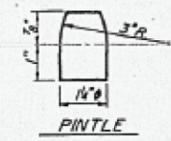


**PINTLE**

*Note: Anchor bolt at fixed bearing may be built into the masonry. See Sheet 68 for Anchor Bolt installation.*

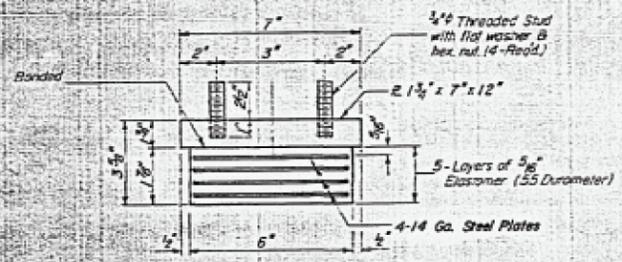

**BEARING ASSEMBLY**

*Note: Shim plates shall not be placed under Bearing Assembly*

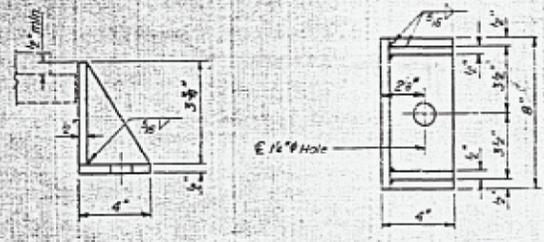

**SIDE RETAINER**

*Equivalent rated angle with stiffeners will be allowed in lieu of welded plates.*

**BILL OF MATERIAL**

ITEM	UNIT	TOTAL
Elastomeric Bearing Assembly Type I	Each	12

**BEARING DETAILS**  
**F.A.P. RTE. 820 ~ SEC. 1-G-BR**  
**DOUGLAS COUNTY**  
**STA 513 + 66.70**

MODEL: I:\MODEL\NAME: FILE: I:\NAME: PROJECT: I:\PROJECT\5\PROJECTS\0570077\CADD\DATA\CAD\DWG\0570077\_513\_513\_021\_0031\_CAD.dwg

USER NAME = shawleres	DESIGNED -	REVISED -
PLOT SCALE = 40.0000 ' / in.	DRAWN -	REVISED -
PLOT DATE = 11/21/2019	CHECKED -	REVISED -
	DATE -	REVISED -

**STATE OF ILLINOIS  
DEPARTMENT OF TRANSPORTATION**

**AS-BUILT PLANS  
S.N. 021-0031**


SCALE: SHEET 20 OF 22 SHEETS STA. TO STA.

F.A.P. RTE.	SECTION	COUNTY	TOTAL SHEETS	SHEET NO.
820	[(1-G),(25)]BDR	DOUGLAS	56	51
			CONTRACT NO. 70D77	
		ILLINOIS	FED. AID PROJECT	



# AS-BUILT PLANS FOR INFORMATION ONLY

PROJECT NO.	820	COUNTY	DOUGLAS	TOTAL SHEETS	127	SHEET NO.	70
SHEET NO. 10 10 SHEETS							

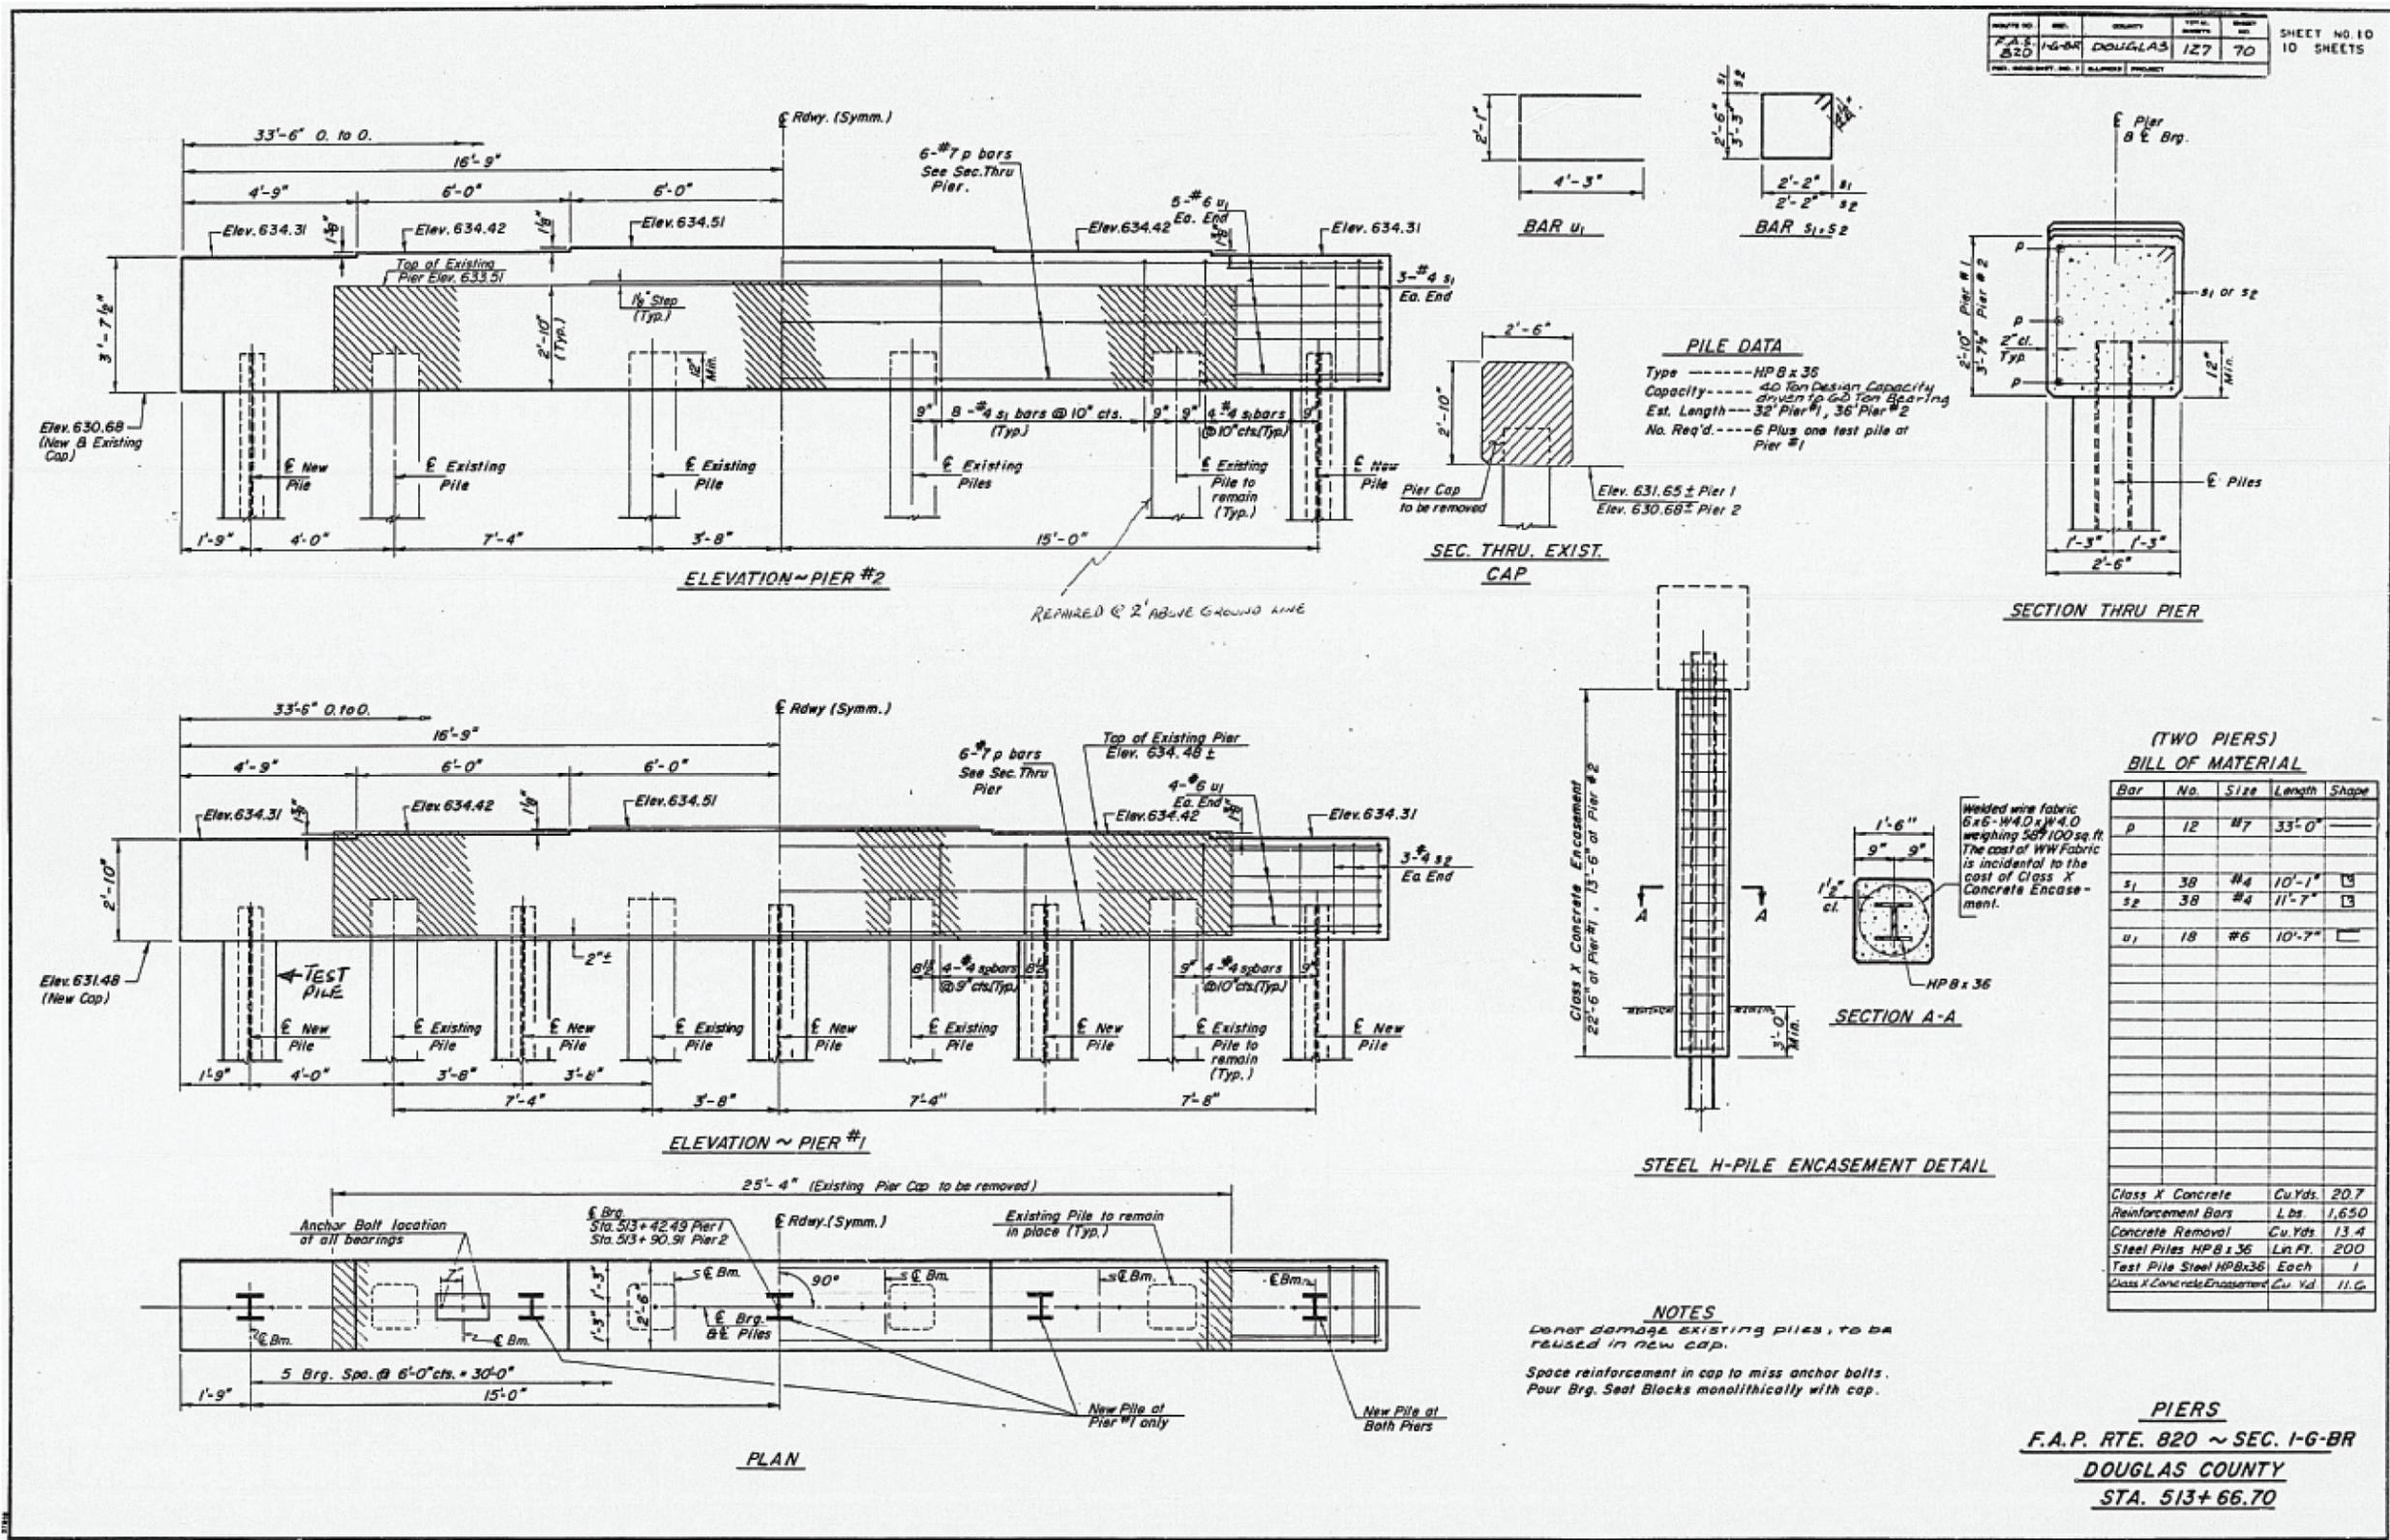

MODEL: \\MODEL\MARKS  
 FILE: MARKS\_Plan\Bridges\gcp\PROJECTS\DOT\Documents\DOT\Office\Bridges\Projects\820\70\AS-BUILT\AS-BUILT-0031\_CAD.dwg  
 PROJECT: 513+66.70  
 DATE: 11/21/2019


USER NAME = shawleres	DESIGNED -	REVISED -
	DRAWN -	REVISED -
PLOT SCALE = 40.0000' / in.	CHECKED -	REVISED -
PLOT DATE = 11/21/2019	DATE -	REVISED -

STATE OF ILLINOIS  
DEPARTMENT OF TRANSPORTATION

AS-BUILT PLANS  
S.N. 021-0031


SCALE: SHEET 22 OF 22 SHEETS STA. TO STA.

F.A.P. RTE.	SECTION	COUNTY	TOTAL SHEETS	SHEET NO.
820	[(1-G),(25)]BDR	DOUGLAS	56	53
CONTRACT NO. 70D77				
ILLINOIS FED. AID PROJECT				

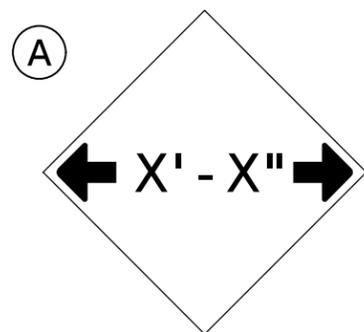


**W12-2(O)-48"x48"(1200x1200)**

SIGN (A) 2 SIGNS - W12-2(O)-48"x48"(1200x1200) ARE TO BE PLACED AS SHOWN IN THE PLANS OR AS DIRECTED BY THE ENGINEER.

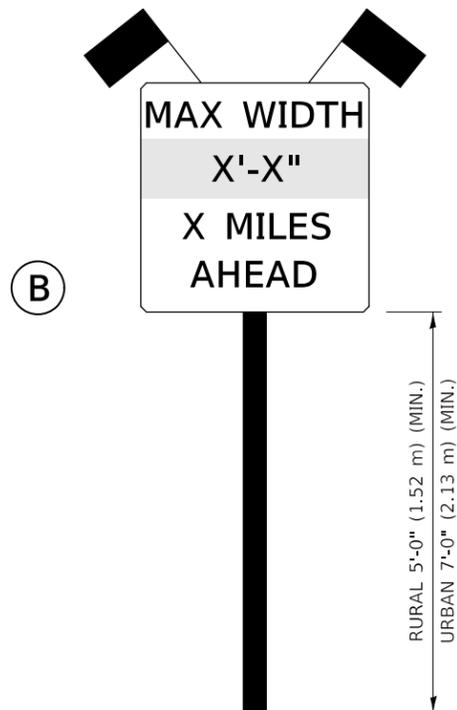

**SIGN PANEL, TYPE II**

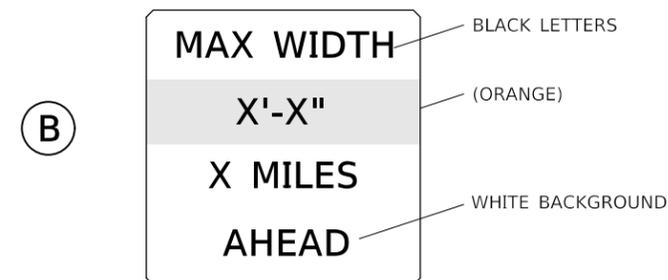

**W12-I103(O)-48"x48"(1200x1200)  
"D" LETTERS/NUMBERS**

SIGN (B) 2 SIGNS - (SIGN PANEL, TYPE II) AS SHOWN ARE TO BE PLACED AS SHOWN IN THE PLANS OR AS DIRECTED BY THE ENGINEER.

**STAGE WIDTHS:**

**STAGE 1 WIDTH = 12'-0" ACTUAL; 10'-6" POSTED; REQUIRED**

**STAGE 2 WIDTH = 13'-0" ACTUAL; 11'-6" POSTED; REQUIRED**

**GENERAL NOTES**

1. ALL TRAFFIC CONTROL DEVICES SHALL BE FURNISHED, ERECTED AND MAINTAINED BY THE CONTRACTOR.
2. ALL (B) SIGNS SHALL HAVE FLAGS INSTALLED UNLESS OTHERWISE DIRECTED.
3. LOCATIONS OF TRAFFIC CONTROL DEVICES MAY BE ADJUSTED BY THE ENGINEER.
4. ALL TRAFFIC CONTROL SHOWN ON THIS SHEET SHALL BE PAID FOR AT THE CONTRACT LUMP SUM PRICE FOR WIDTH RESTRICTION SIGNING.
5. ALL SIGNS SHALL BE POST MOUNTED UNLESS OTHERWISE DIRECTED.
6. ALL SIGNS SHOWN ORANGE (O) SHALL BE FLUORESCENT ORANGE.
7. ALL SIGNS SHOWN SHALL CONSIST OF THE CURRENT RETROREFLECTIVE SHEETING REQUIREMENTS AS OUTLINED IN SECTION 1106.01 OF THE STANDARD SPECIFICATIONS BOOK.

Note: All dimensions are in INCHES (millimeters) unless otherwise shown.

MODEL: \\MODEL\MAR\F... FILE NAME: P:\pub\mcom\m... \projects\0570077\CADD\DATA\CAD\INRES\0570077\_5th\_widtbl\_restrict.bns.dgn

USER NAME = shawleres	DESIGNED -	REVISED - 05/08
	DRAWN -	REVISED - 10/08 KJT
PLOT SCALE = 40.0000 ' / in.	CHECKED -	REVISED - 07/09 KJT
PLOT DATE = 11/21/2019	DATE -	REVISED - 03/11 KJT

**STATE OF ILLINOIS  
DEPARTMENT OF TRANSPORTATION**

**WIDTH RESTRICTION SIGNING**

SCALE: SHEET 1 OF 1 SHEETS STA. TO STA.

**DISTRICT 5 DETAIL NO. X7200201**

F.A.P. RTE.	SECTION	COUNTY	TOTAL SHEETS	SHEET NO.
820	[(1-G),(25)]BDR	DOUGLAS	56	54
			CONTRACT NO. 70D77	
			ILLINOIS FED. AID PROJECT	

**S.N. 021-0030 AND S.N. 021-0031  
WIDTH RESTRICTION SIGNINGS  
FOR IL-130 TRAFFIC**



**A1** US 36 WEST BOUND  
ERECT BY SOUTH IL-130 PRE-TURN SIGN  
INCLUDE DIRECTION ARROW



( 21" X 15" )

**A2** US 36 EAST BOUND  
ERECT BY EAST US 36 SIGN  
AND SOUTH IL-130 SIGN  
INCLUDE DIRECTION ARROW



( 21" X 15" )

**B1** IL-130 SOUTH  
ERECT BY IL-130 SOUTH SIGN  
2 MILES AHEAD

MODEL: s:\MODEL\NAME  
FILE: NAME: s:\pub\m\com\m\da\illinois.gov\PWIDOT\Documents\DOT\_Offices\District 5\Projects\021-0030\021-0031\CADD\DATA\CAD\Inches\021-0031\_5th\_width\_restrictions.dgn

USER NAME = shawleres	DESIGNED -	REVISED -
	DRAWN -	REVISED -
PLOT SCALE = 40.0000 ' / in.	CHECKED -	REVISED -
PLOT DATE = 11/21/2019	DATE -	REVISED -

**STATE OF ILLINOIS  
DEPARTMENT OF TRANSPORTATION**

**WIDTH RESTRICTION SIGNING  
S.N. 021-0030 & S.N. 021-0031**


SCALE: SHEET OF SHEETS STA. TO STA.

F.A.P. RTE.	SECTION	COUNTY	TOTAL SHEETS	SHEET NO.
820	[(1-G),(25)]BDR	DOUGLAS	56	55
			CONTRACT NO. 70D77	
		ILLINOIS	FED. AID PROJECT	

**S.N. 021-0030 AND S.N. 021-0031  
WIDTH RESTRICTION SIGNINGS  
FOR IL-130 TRAFFIC**



**A3** US 130 NORTH BOUND  
ERECT BY NORTH IL-130 SIGN  
5 MILES AHEAD

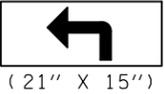

( 21" X 15" )

**B2** IL-130 NORTH  
ERECT BY JUNCTION IL-133 SIGN  
5 MILES AHEAD

MODEL: s:\MODEL\MHFE  
FILE: mhfe\_019\p19\m19\com\m19\dot\Documents\DOT\_Offices\District 5\Projects\021-0030\021-0031\CADD\DATA\CADD\021-0030\021-0031\_5th\_widtbl\_restrict.tbl

USER NAME = shawleres	DESIGNED -	REVISED -
	DRAWN -	REVISED -
PLOT SCALE = 40.0000 ' / in.	CHECKED -	REVISED -
PLOT DATE = 11/21/2019	DATE -	REVISED -

**STATE OF ILLINOIS  
DEPARTMENT OF TRANSPORTATION**

**WIDTH RESTRICTION SIGNING  
S.N. 021-0030 & S.N. 021-0031**

SCALE: SHEET OF SHEETS STA. TO STA.

F.A.P. RTE.	SECTION	COUNTY	TOTAL SHEETS	SHEET NO.
820	[(1-G),(25)]BDR	DOUGLAS	56	56
CONTRACT NO. 70D77			ILLINOIS FED. AID PROJECT	