03-08-2024 LETTING ITEM 104 FOR INDEX OF SHEETS, SEE SHEET NO. 2 **FUNCTIONAL CLASSIFICATION** 

STATE OF ILLINOIS DEPARTMENT OF TRANSPORTATION

# **PROPOSED** HIGHWAY PLANS

**FINAL PLANS** 12 /15 /2023

## TRAFFIC DATA:

**CLASS II TRUCK ROUTE** 

0

0

 $\circ$ 

IL 43 (HARLEM AVE) - 92ND PL TO 95TH ST 2019 ADT - 42,800 2039 ADT - 52,200

IL 43 (HARLEM AVE) OTHER PRINCIPAL ARTERIAL (URBAN)

US 12 & 20 (95TH ST)
OTHER PRINCIPAL ARTERIAL (URBAN)
CLASS II TRUCK ROUTE

IL 43 (HARLEM AVE) - 95TH ST TO 99TH ST 2019 ADT 41.800 2039 ADT 51,000

US 12 & 20 (95TH ST) - F.A.I. 294 TO 69TH AVE 2019 ADT - 46,200 2039 ADT - 56,400

**POSTED SPEED:** IL 43 (HARLEM AVE) - 40 MPH US 12 & 20 (95TH ST) - 45 MPH RAMPS - 25 MPH

PROJECT LOCATED IN:

VILLAGE OF OAK LAWN

**COOK COUNTY** 

**VILLAGE OF BRIDGEVIEW** 

**VILLAGE OF CHICAGO RIDGE** 

FAP 348 IL ROUTE 43 (HARLEM AVENUE) OVER US ROUTE 12/20 (95TH STREET) SECTION 3128-Z-I-R&RS

HARLEM AVE (99TH ST TO 92ND PL/STANFORD DR) FAP 29 95TH ST (F.A.I. 294 (TRI-STATE TOLLWAY)

TO NEW ENGLAND AVE) INTERCHANGE IMPROVEMENT **COOK COUNTY** 


JOB NO. C-91-122-12 PROJECT NHPP-7BJZ(701)

GROSS (NET) LENGTH: = 2,969 (2,969) L.F. = 0.562 (0.562) MI.

GROSS (NET) LENGTH: = 3,357 (2,787) L.F. = 0.636 (0.528) MI.

GROSS (NET) LENGTH: = 8,024 (7,641) L.F. = 1.520 (1.447) MI.

GROSS (NET) LENGTH: = 13,744 (12,791) L.F. = 2.718 (2.537) MI.

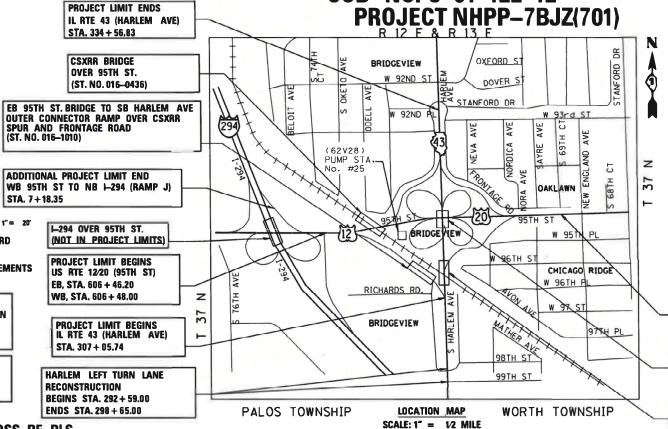

95TH ST

TOTAL

HARLEM AVE (W/LEFT LANE)

RAMPS (A, E/E2, F, G/G2,

H, I, J, & ACCESS ROAD)

D.MBilor STRUCTURAL ENGINEER - ALASKA

PROJECT ENGINEER-LIGHTING PLANS



PROJECT ENGINEER-TRAFFIC SIGNAL PLANS

PROJECT LIMIT ENDS US RTE 12/20 (95TH ST) STA. 636 + 14.88

HARLEM AVE. BRIDGE OVER 95TH ST. (ST NO. 016-0320)


HARLEM AVE. BRIDGE OVER THE CSXRR AND FRONTAGE RD. (ST NO. 016-0321)

THE HOH GROUP, INC. The HOH Group, Inc.

623 Cooper Court Schaumburg, IL 60173 (312) 346-8131 PN: 3730

D-91-122-12 OCLE MERCER MC LEAN COLES LOCATION OF SECTION INDICATED THUS: -

PROJECT LOCATION

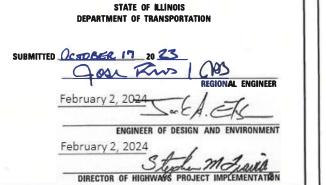

# PRINTED BY THE AUTHORITY OF THE STATE OF ILLINOIS

DISTRICT 1 \*\*685 + 2 = 687 TOTAL SHEETS (\*\*659 + 26 = 685 TOTAL SHEETS \*\* COUNTY TOTAL SHEET NO.

COOK 659 1 SECTION 3128-Z-I-R&RS CONTRACT NO. 60R49

FULL SIZE PLANS HAVE BEEN PREPARED USING STANDARD ENGINEERING SCALES. REDUCED SIZED PLANS WILL NOT CONFORM TO STANDARD SCALES. IN MAKING MEASUREMENTS ON REDUCED PLANS, THE ABOVE SCALES MAY BE USED. JOINT UTILITY LOCATION INFORMATION FOR EXCAVATION

1-800-892-0123 OR 811

MEADE ELECTRIC CO. DISTRICT ONE ELECTRICAL MAINTENANCE CONTRACTOR LOCATES IDOT ELECTRICAL **EQUIPMENT AND UNDERGROUND CABLES (773) 287-7672** 

**IDOT PROJECT MANAGER: MR. JOE CROSS, PE, PLS** (847) 705-4605

IDOT PROJECT ENGINEER: MR. TIMOTHY SCHMIDT, PE, SE

(847) 705-4238

CONTRACT NO. 60R49

				80% FED 20% STATE	80% FED 20% STATE			80% FED 20% STATE	80% FED 20% STATE	80% FED  20% STATE			20% STATE	80% FED 13.3% STATE 6.7% CHICAGO RIDO
CODE NO.	ITEM	UNIT	TOTAL QUANTITY URBAN	ROADWAY	NHS-BRIDGE HARLEM AVE. BRIDGE OVER 95TH ST.	NHPP HARLEM AVE. BRIDGE OVER CSX RR.	RAMP A BRIDGE	NHPP HIGHWAY LIGHTING	NHPP  RAMP E TRAFFIC SIGNALS	NHPP RAMP G TRAFFIC SIGNALS	95TH ST / NB I-294 TRAFFIC SIGNALS	92ND PL / STANFORD DR TRAFFIC SIGNALS	NHPP	NHPP  99TH STREET TRAFFIC SIGNAL AND CHICAGO RIDGE LIGHTING
			ONDAN	0004 URBAN	0013 URBAN	0013 URBAN	0013 URBAN	0021 URBAN	0021 URBAN	0021 URBAN	0021 URBAN	0021 URBAN	0021 URBAN	0021 URBAN
				UNDAIN	UNDAIN	UNDAIN	UNDAIN	UNDAN	UNDAN	UNDAN	UNDAN	URBAN	UNBAN	UNDAIN
40604062	HOT-MIX ASPHALT SURFACE COURSE, IL-9.5, MIX "D", N70	TON	73	73										
40604172	POLYMERIZED HOT-MIX ASPHALT SURFACE COURSE, IL-9.5, MIX "E", N70	TON	1,318	1,318										
40605026	POLYMERIZED HOT-MIX ASPHALT SURFACE COURSE, STONE MATRIX ASPHALT, 9.5, MIX "F", N80	TON	4,346	4,346										
42000070	PAVEMENT CONNECTOR (HMA) FOR BRIDGE APPROACH SLAB	SQ YD	524	524										
42000511	PORTLAND CEMENT CONCRETE PAVEMENT 10 1/2" (JOINTED)	SQ YD	713	713										
42400200	PORTLAND CEMENT CONCRETE SIDEWALK 5 INCH	SQ FT	15,312	15,312										
42400800	DETECTABLE WARNINGS	SQ FT	146	146										
44000100	PAVEMENT REMOVAL	SQ YD	23,471	23,471	$\mathbb{R}$									
44000300	CURB REMOVAL	FOOT	18,482	18,482										
44000500	COMBINATION CURB AND GUTTER REMOVAL	FOOT	6,923	6,923	$\Delta$									
44003100	MEDIAN REMOVAL	SQ FT	28,101	28,101										
44004250	PAVED SHOULDER REMOVAL	SQ YD	4,888	4,888										
44201361	CLASS C PATCHES, TYPE I, 11 INCH	SQ YD	2,204	2,204										
	SPECIALTY ITEM *** 100% VILLAGE OF CHICAGO RIDO  ** 100% VILLAGE OF BRIDGEVIEW COST	GE COST											RE\	/ISED SHEET 2/

SECTION

FILE NAME = ...\D160R49\_sht\_SOQ.dgn
THE HOH GROUP, INC. USER NAME = KSUMRAK DESIGNED - AAF REVISED -DRAWN - AAF REVISED -PLOT SCALE = N/A CHECKED - BAP REVISED -PN: 3730 PLOT DATE = 11/30/2023 DATE -REVISED -

STATE OF ILLINOIS **DEPARTMENT OF TRANSPORTATION** 

SUMMARY OF QUANTITIES SCALE: NTS SHEET NO. 5 OF 36 SHEETS STA. N/A TO STA. N/A

COUNTY TOTAL SHEET NO.

COOK 659 8 3128-Z-I-R&RS CONTRACT NO. 60R49

									CONSTRI	CTION CODE				
				80% FED	80% FED	80% FED	80% FED	80% FED	80% FED	80% FED	80% FED	80% FED 10% BRIDGEVIEW	80% FED	80% FED 13.3% STATE
				20% STATE	20% STATE		20% STATE			20% STATE	20% STATE	10% STATE	20% STATE	6.7% CHICAGO RIDO
				NHPP	NHS-BRIDGE		NHPP	NHPP	NHPP	NHPP	NHPP	NHPP	NHPP	NHPP
CODE NO.	ITEM	UNIT	TOTAL QUANTITY URBAN	ROADWAY	BRIDGE OVER 95TH ST.	HARLEM AVE. BRIDGE OVER CSX RR.	RAMP A BRIDGE	HIGHWAY LIGHTING	RAMP E TRAFFIC SIGNALS	RAMP G TRAFFIC SIGNALS	95TH ST / NB I-294 TRAFFIC SIGNALS	92ND PL / STANFORD DR TRAFFIC SIGNALS	INTERCONNECT	99TH STREET TRAFFIC SIGNALS AND CHICAGO RIDGE LIGHTING
			UNDAN	0004	0013	0013	0013	0021	0021	0021	0021	0021	0021	0021
				URBAN	URBAN	URBAN	URBAN	URBAN	URBAN	URBAN	URBAN	URBAN	URBAN	URBAN
52100400	STEEL BEARING ASSEMBLY	EACH	20				20							
								İ	İ					
									1					
52100520	ANCHOR BOLTS, 1"	EACH	390		160	150	80							
						1		1	1					
52200010	TEMPORARY SHEET PILING	SQ FT	2,750		1,290	1,460								
32200010	TEMPORARI SHEET FILING	3011	2,730		1,290	1,400								
			1		1	1		1	1			1		
52318802	DRAINAGE SYSTEM FOR STRUCTURES	L SUM	1		1									
									İ					
					ļ									
54213657	PRECAST REINFORCED CONCRETE FLARED END SECTIONS 12"	EACH	12	12										
						1		 	1					
				· · · · · · · · · · · · · · · · · · ·										
E4212660	DDECAST DEINICODOED CONCRETE ELADED END CECTIONIC 15"	FACIL	4		K v									
54213660	PRECAST REINFORCED CONCRETE FLARED END SECTIONS 15"	EACH	20	20	<u> </u>									
		· ·			Ĭ									
									1					
54213663	PRECAST REINFORCED CONCRETE FLARED END SECTIONS 18"	EACH	3	3										
			İ		İ				İ					
									1					i
54213666	PRECAST REINFORCED CONCRETE FLARED END SECTIONS 21"	EACH	1	1										
						1								
54213669	PRECAST REINFORCED CONCRETE FLARED END SECTIONS 24"	EACH	3	3				İ	İ					
34213009	FRECAST REINFORCED CONCRETE FEARED END SECTIONS 24	LACIT	, ,	3										1
						1			1					
54213675	PRECAST REINFORCED CONCRETE FLARED END SECTIONS 30"	EACH	4	4										
			-											
54213681	PRECAST REINFORCED CONCRETE FLARED END SECTIONS 36"	EACH	2	2										
											1			
54213687	PRECAST REINFORCED CONCRETE FLARED END SECTIONS 42"	EACH	1	1										
					1	<u> </u>		<u> </u>	1					
F4216100	DEINFORCED CONCRETE DIRE TEE 12" DIRE WITH 12" DIRECT	F. C	1	1										
54216180	REINFORCED CONCRETE PIPE TEE, 12" PIPE WITH 12" RISER	EACH	1	1										
I														

| REVISED SHEET 2/26/2024 | | SUMMARY OF QUANTITIES | | F.A.P. | SECTION | COUNTY | SHEETS | NO. | NO. | SHEET | NO. | SHEET | NO. | STA. N/A | SHEET | NO. | STA. N/A | ST

				80% FED	80% FED	80% FED	80% FED	80% FED	80% FED	CTION CODE 80% FED	80% FED	80% FED 10% BRIDGEVIEW	80% FED	80% FED 13.3% STATE
				20% STATE							20% STATE	10% STATE	20% STATE	6.7% CHICAGO RID
			T	NHPP	NHS-BRIDGE	NHPP	NHPP	NHPP	NHPP	NHPP	NHPP	NHPP	NHPP	NHPP
ODE NO.	ITEM	UNIT	TOTAL QUANTITY URBAN	ROADWAY	HARLEM AVE. BRIDGE OVER 95TH ST.	HARLEM AVE. BRIDGE OVER CSX RR.	RAMP A BRIDGE	HIGHWAY LIGHTING	RAMP E TRAFFIC SIGNALS	RAMP G TRAFFIC SIGNALS	95TH ST / NB I-294 TRAFFIC SIGNALS	92ND PL / STANFORD DR TRAFFIC SIGNALS	INTERCONNECT	99TH STREET TRAFFIC SIGNAL AND CHICAGO RIDGE LIGHTING
			ONDAN	0004	0013	0013	0013	0021	0021	0021	0021	0021	0021	0021
				URBAN	URBAN	URBAN	URBAN	URBAN	URBAN	URBAN	URBAN	URBAN	URBAN	URBAN
54216190	REINFORCED CONCRETE PIPE TEE, 18" PIPE WITH 12" RISER	EACH	1	1										
54216200	REINFORCED CONCRETE PIPE TEE, 24" PIPE WITH 12" RISER	EACH	3	3										
54216231	REINFORCED CONCRETE PIPE TEE, 42" PIPE WITH 12" RISER	EACH	2	2										
57210231	NEW ONCED CONCRETE THE TEE, 42 FIFE WITH 12 NISEN	LACI												
54216264	REINFORCED CONCRETE PIPE TEE, 60" PIPE WITH 12" RISER	EACH	3	3										
54216570	REINFORCED CONCRETE PIPE TEE, 24" PIPE WITH 15" RISER	EACH	1	1										
		27.61.	-	<u> </u>										
54216982	REINFORCED CONCRETE PIPE TEE, 48" PIPE WITH 18" RISER	EACH	1	1										
54217755	REINFORCED CONCRETE PIPE TEE, 66" PIPE WITH 24" RISER	EACH	1	1										
54219202	REINFORCED CONCRETE PIPE TEE, 48" PIPE WITH 48" RISER		1	1	17									
54246005	INLET BOX, STANDARD 542541	EACH	1	1	$\beta \Lambda$									
54261660	CONCRETE END SECTION, STANDARD 542001,60",1:6	EACH	1	1										
550A0050	STORM SEWERS, CLASS A, TYPE 1 12"	FOOT	1,191	1,191										
550A0070	STORM SEWERS, CLASS A, TYPE 1 15"	FOOT	538	538	3 1									
/-	, ,	(	Я		X 44									

STATE OF ILLINOIS DEPARTMENT OF TRANSPORTATION SCALE: NTS SHEET NO. 9 OF 36 SHEETS STA. N/A TO STA. N/A

				80% FED 20% STATE	80% FED 20% STATE	80% FED 20% STATE	80% FED 20% STATE	80% FED 20% STATE	80% FED 20% STATE	80% FED 20% STATE	80% FED 20% STATE	80% FED 10% BRIDGEVIEW 10% STATE	80% FED 20% STATE	80% FED 13.3% STATE 6.7% CHICAGO RIDG
				NHPP	NHS-BRIDGE	NHPP	NHPP	NHPP	NHPP	NHPP	NHPP	NHPP	NHPP	NHPP
CODE NO.	ITEM	UNIT	TOTAL QUANTITY URBAN	ROADWAY	HARLEM AVE. BRIDGE OVER 95TH ST.	HARLEM AVE. BRIDGE OVER CSX RR.	RAMP A BRIDGE	HIGHWAY LIGHTING	RAMP E TRAFFIC SIGNALS	RAMP G TRAFFIC SIGNALS	95TH ST / NB I-294 TRAFFIC SIGNALS	92ND PL / STANFORD DR TRAFFIC SIGNALS	INTERCONNECT	99TH STREET TRAFFIC SIGNALS AND CHICAGO RIDGE LIGHTING
			ONDAN	0004	0013	0013	0013	0021	0021	0021	0021	0021	0021	0021
				URBAN	URBAN	URBAN	URBAN	URBAN	URBAN	URBAN	URBAN	URBAN	URBAN	URBAN
550A0110	STORM SEWERS, CLASS A, TYPE 1 21"	FOOT	5	5										
550A0120	STORM SEWERS, CLASS A, TYPE 1 24"	FOOT	405	405										
550A0140	STORM SEWERS, CLASS A, TYPE 1 30"	FOOT	97	97										
55040460		5007	22	22										
550A0160	STORM SEWERS, CLASS A, TYPE 1 36"	FOOT	23	23										
550A0340	STORM SEWERS, CLASS A, TYPE 2 12"	FOOT	1,298	1,298										
550A0360	CTORM CEWERC CLASS A TYRE 2 15"	FOOT	К	720	K 🔥 📗									
330A0300	STORM SEWERS, CLASS A, TYPE 2 15"	1001	728	728	3 41									
550A0380	STORM SEWERS, CLASS A, TYPE 2 18"	FOOT	330	330										
550A0400	STORM SEWERS, CLASS A, TYPE 2 21"	FOOT	162	162										
550A0410	STORM SEWERS, CLASS A, TYPE 2 24"	FOOT	227	227										
550A0430	STORM SEWERS, CLASS A, TYPE 2 30"	FOOT	191	191										
550A0450	STORM SEWERS, CLASS A, TYPE 2 36"	FOOT	361	361										
550A0470	STORM SEWERS, CLASS A, TYPE 2 42"	FOOT	172	172										
550A0480	STORM SEWERS, CLASS A, TYPE 2 48"	FOOT	186	186	31									
550A0500	STORM SEWERS, CLASS A, TYPE 2 60"	FOOT	375	375	1.7									
•	SPECIALTY ITEM *** 100% VILLAGE OF CHICAGO RIE  ** 100% VILLAGE OF BRIDGEVIEW COST	OGE COST											↑ REV	SED SHEET 2/26

SECTION

FILE NAME = ...\D160R49\_sht\_SOQ.dgn
THE HOH GROUP, INC.
ARCHITECTS | THIGHTERS USER NAME = KSUMRAK DESIGNED - AAF REVISED -DRAWN - AAF REVISED -PLOT SCALE = N/A CHECKED - BAP REVISED -PN: 3730 PLOT DATE = 11/30/2023 DATE -REVISED -

STATE OF ILLINOIS **DEPARTMENT OF TRANSPORTATION** 

**SUMMARY OF QUANTITIES** SCALE: NTS SHEET NO. 10 OF 36 SHEETS STA. N/A TO STA. N/A

COUNTY TOTAL SHEET NO.

COOK 659 13 3128-Z-I-R&RS CONTRACT NO. 60R49 REV-SEP **\$00–10** 

				80% FED	80% FED	80% FED	80% FED	80% FED	CONSTRU 80% FED	CTION CODE 80% FED	80% FED	80% FED	80% FED	80% FED
				20% STATE	20% STATE	20% STATE	20% STATE	20% STATE	20% STATE	20% STATE	20% STATE	10% BRIDGEVIEW 10% STATE	20% STATE	13.3% STATE 6.7% CHICAGO RIDGE
				NHPP	NHS-BRIDGE	NHPP	NHPP	NHPP	NHPP	NHPP	NHPP	NHPP	NHPP	NHPP
CODE NO.	ITEM	UNIT	TOTAL QUANTITY	ROADWAY	HARLEM AVE. BRIDGE OVER 95TH ST.	HARLEM AVE. BRIDGE OVER CSX RR.	RAMP A BRIDGE	HIGHWAY LIGHTING	RAMP E TRAFFIC SIGNALS	RAMP G TRAFFIC SIGNALS	95TH ST / NB I-294 TRAFFIC SIGNALS	92ND PL / STANFORD DR TRAFFIC SIGNALS	INTERCONNECT	99TH STREET TRAFFIC SIGNALS AND CHICAGO RIDGE LIGHTING
			URBAN	0004	0013	0013	0013	0021	0021	0021	0021	0021	0021	0021
				URBAN	URBAN	URBAN	URBAN	URBAN	URBAN	URBAN	URBAN	URBAN	URBAN	URBAN
550A0510	STORM SEWERS, CLASS A, TYPE 2 66"	FOOT	56	56										
550A0800	STORM SEWERS, CLASS A, TYPE 3 60"	FOOT	287	287										
550A5530	STORM SEWERS, CLASS A, TYPE 2 EQUIVALENT ROUND -SIZE 60"	FOOT	660	660										
55100300	STORM SEWER REMOVAL 8"	FOOT	47	47										
55100400	STORM SEWER REMOVAL 10"	FOOT	84	84										
55100500	STORM SEWER REMOVAL 12"	FOOT	1,892	1,892										
55100700	STORM SEWER REMOVAL 15"	FOOT	408	408	$\frac{1}{2}$ $\mathbb{A}$									
			(											
55100900	STORM SEWER REMOVAL 18"	FOOT	567	567										
55101200	STORM SEWER REMOVAL 24"	FOOT	42	42										
55101400	STORM SEWER REMOVAL 30"	FOOT	667	667										
														<u> </u>
55101600	STORM SEWER REMOVAL 36"	FOOT	411	411										
55101900	STORM SEWER REMOVAL 48"	FOOT	152	152										
55102000	STORM SEWER REMOVAL 54"	FOOT	460	460										
58600101	GRANULAR BACKFILL FOR STRUCTURES	CU YD	587		341	246								
;	SPECIALTY ITEM *** 100% VILLAGE OF CHICAGO RID ** 100% VILLAGE OF BRIDGEVIEW COST	GE COST											∧ REVI	SED SHEET 2/26/20

STATE OF ILLINOIS

**DEPARTMENT OF TRANSPORTATION** 

FILE NAME = ...\D160R49\_sht\_SOQ.dgn
THE HOH GROUP, INC.
ARCHITECTS | THIGHTERS

DESIGNED - AAF

DRAWN - AAF

CHECKED - BAP

DATE -

REVISED -

REVISED -

REVISED -

REVISED -

USER NAME = KSUMRAK

PLOT SCALE = N/A

PN: 3730 PLOT DATE = 11/30/2023

SECTION **SUMMARY OF QUANTITIES** 3128-Z-I-R&RS SCALE: NTS SHEET NO. 11 OF 36 SHEETS STA. N/A TO STA. N/A

									CONSTRU	CTION CODE				
				80% FED	80% FED	80% FED	80% FED	80% FED	80% FED	80% FED	80% FED	80% FED 10% BRIDGEVIEW	80% FED	80% FED 13.3% STATE
				20% STATE NHPP	20% STATE NHS-BRIDGE		20% STATE NHPP	20% STATE NHPP	20% STATE NHPP	20% STATE NHPP	20% STATE NHPP		20% STATE NHPP	6.7% CHICAGO RID
CODE NO.	ITEM	UNIT	TOTAL QUANTITY URBAN	ROADWAY		HARLEM AVE. BRIDGE	RAMP A BRIDGE	HIGHWAY LIGHTING	RAMP E TRAFFIC SIGNALS	RAMP G TRAFFIC SIGNALS	95TH ST / NB I-294 TRAFFIC SIGNALS	92ND PL / STANFORD DR TRAFFIC SIGNALS	INTERCONNECT	99TH STREET TRAFFIC SIGNAL AND CHICAGO RIDGE LIGHTING
			UNDAN	0004	0013	0013	0013	0021	0021	0021	0021	0021	0021	0021
				URBAN	URBAN	URBAN	URBAN	URBAN	URBAN	URBAN	URBAN	URBAN	URBAN	URBAN
60500050	REMOVING CATCH BASINS	EACH	42	42										
60500060	REMOVING INLETS	EACH	27	27										
60600605	CONCRETE CURB, TYPE B	FOOT	326	326										
60603000	COMBINATION CONCRETE CURB AND GUTTER, TYPE B-6.12	FOOT	4.057	4.057										
60603800	COMBINATION CONCRETE CORB AND GOTTER, TIPE 8-6.12	FOOT	4,057	4,057										
60604400	COMBINATION CONCRETE CURB AND GUTTER, TYPE B-6.18	FOOT	340	340										
60605000	COMBINATION CONCRETE CURB AND GUTTER, TYPE B-6.24	FOOT	12,610	12,610	<u>}                                    </u>									
60608300	COMBINATION CONCRETE CURB AND GUTTER, TYPE M-2.12	FOOT	410	410										
60608521	COMBINATION CONCRETE CURB AND GUTTER, TYPE M-2.24	FOOT	1,231	1,231										
60618300	CONCRETE MEDIAN SURFACE, 4 INCH	SQ FT	2,371	2,371										
			2,371	2,371										
60619600	CONCRETE MEDIAN, TYPE SB-6.12	SQ FT	4,550	4,550										
60624600	CORRUGATED MEDIAN	SQ FT	819	819										
63000001	STEEL PLATE BEAM GUARDRAIL, TYPE A, 6 FOOT POSTS	FOOT	4,825	4,825.0										
63100045	TRAFFIC BARRIER TERMINAL, TYPE 2	EACH	13	13										
	* SPECIALTY ITEM *** 100% VILLAGE OF CHICAGO  ** 100% VILLAGE OF BRIDGEVIEW COST	RIDGE COST											∕∫\RI	EVISED SHEET

NAME =\D160R49_sht_SOQ.dgn	USER NAME = KSUMRAK	DESIGNED - AAF	REVISED -
HE HOH GROUP, INC.		DRAWN - AAF	REVISED -
ARCHITECTS   ENGINEERS	PLOT SCALE = N/A	CHECKED - BAP	REVISED -
PN: 3730	PLOT DATE = 11/30/2023	DATE -	REVISED -

STATE OF ILLINOIS DEPARTMENT OF TRANSPORTATION

	A			F.A.P. RTE.	SECT	ION	
	SUMMARY OF QUA	NIIIES		29 & 348	3128-Z-	I-R&RS	
SCALE: NTS	SHEET NO. 14 OF 36 SHEETS	STA. N/A	TO STA. N/A		ĺ	ILLINOIS	FED.

COUNTY TOTAL SHEET NO.

COOK 659 17

CONTRACT NO. 60R49

FED. AID PROJECT

									CONSTRU	CTION CODE				
				80% FED	80% FED	80% FED	80% FED	80% FED	80% FED	80% FED	80% FED	80% FED 10% BRIDGEVIEW	80% FED	80% FED 13.3% STATE
				20% STATE NHPP	20% STATE NHS-BRIDGE	20% STATE NHPP	20% STATE NHPP	20% STATE NHPP	20% STATE NHPP	20% STATE NHPP	20% STATE NHPP	10% STATE NHPP	20% STATE NHPP	6.7% CHICAGO RID
CODE NO.	ITEM	UNIT	TOTAL QUANTITY	ROADWAY	HARLEM AVE. BRIDGE OVER 95TH ST.			HIGHWAY LIGHTING	RAMP E TRAFFIC SIGNALS	RAMP G TRAFFIC SIGNALS	95TH ST / NB I-294 TRAFFIC SIGNALS	92ND PL / STANFORD DR TRAFFIC SIGNALS	INTERCONNECT	99TH STREET TRAFFIC SIGNAL AND CHICAGO RIDGE LIGHTING
			URBAN	0004	0013	0013	0013	0021	0021	0021	0021	0021	0021	0021
				URBAN	URBAN	URBAN	URBAN	URBAN	URBAN	URBAN	URBAN	URBAN	URBAN	URBAN
63100070	TRAFFIC BARRIER TERMINAL, TYPE 5	EACH	4	4						ı	1			
63100085	TRAFFIC BARRIER TERMINAL, TYPE 6	EACH	8	8										
03100003	THAT TO BANGLEY FERNINAL, THE O	LACIT												
63100167	TRAFFIC BARRIER TERMINAL, TYPE 1 (SPECIAL) TANGENT	EACH	16	16										
63200310	GUARDRAIL REMOVAL	FOOT	5,575	5,575										
63500105	DELINEATORS	EACH	186	186										
63800920	MODULAR GLARE SCREEN SYSTEM, TEMPORARY	FOOT	900	900	$\mathbb{R}^{2}$									
64300450	IMPACT ATTENUATORS (NON-REDIRECTIVE), TEST LEVEL 3	EACH	4	4										
64301090	ATTENUATOR BASE	SQ YD	76	76										
66400105	CHAIN LINK FENCE, 4'	FOOT	1,986	1,986										
66400505	CHAIN LINK FENCE, 8'	FOOT	430	430										
66405800	CHAIN LINK GATES, 4' X 12" DOUBLE	EACH	1	1										
66700205	PERMANENT SURVEY MARKERS, TYPE I	EACH	6	6										
66900200	NON-SPECIAL WASTE DISPOSAL	CU YD	34,300	34,300										
66900530	SOIL DISPOSAL ANALYSIS	EACH	6	6										
66901001	REGULATED SUBSTANCES PRE-CONSTRUCTION PLAN	L SUM	1	1										
	* SPECIALTY ITEM *** 100% VILLAGE OF CHICAGO RID	GE COST												

FILE NAME = ...\D160R49\_sht\_SOQ.dgn DESIGNED - AAF USER NAME = KSUMRAK REVISED -THE HOH GROUP, INC. DRAWN - AAF REVISED -PLOT SCALE = N/A CHECKED - BAP REVISED -PN: 3730 PLOT DATE = 11/30/2023 DATE -REVISED -

STATE OF ILLINOIS **DEPARTMENT OF TRANSPORTATION** 

**SUMMARY OF QUANTITIES** SCALE: NTS SHEET NO. 15 OF 36 SHEETS STA. N/A TO STA. N/A

REVISED SHEET 2/26/2024 COUNTY TOTAL SHEET NO.
COOK 659 18 SECTION 3128-Z-I-R&RS CONTRACT NO. 60R49

			tuille 1		1.7									
72800100	TELESCOPING STEEL SIGN SUPPORT	FOOT	2,520	2,520	3 1									
72400320	REMOVE SIGN PANEL - TYPE 2	SQ FT	13	13										
72400310	REMOVE SIGN PANEL - TYPE 1	SQ FT	557.5	550										7.5
72000200	SIGN PANEL - TYPE 2	SQ FT	85	13					28		16	28		
72000100	SIGN PANEL - TYPE 1	SQ FT	762	762	$\frac{1}{3}$ $\triangle$					15				15
70600332	IMPACT ATTENUATORS, RELOCATE (FULLY REDIRECTIVE, NARROW), TEST LEVEL 3	EACH	10	10										
70600270	IMPACT ATTENUATORS, TEMPORARY (FULLY REDIRECTIVE, WIDE), TEST LEVEL 3	EACH	4	4										
70600260	IMPACT ATTENUATORS, TEMPORARY (FULLY REDIRECTIVE, NARROW), TEST LEVEL 3	EACH	18	18	$\Lambda$									
					17 . 1									
70400200	RELOCATE TEMPORARY CONCRETE BARRIER	FOOT	3,375	3,375.0										
70400100	TEMPORARY CONCRETE BARRIER  PINNING TEMPORARY CONCRETE BARRIER	EACH	5,518 650	5,518 650	\\\\\\\\\\\\\\\\\\\\\\\\\\\\\\\\\\\\\\									
70400100	TEMPORARY CONCRETE RARRIER	FOOT	5 5 18		K 🔥 I									
70307210	TEMPORARY PAVEMENT MARKING - LINE 24"- TYPE IV TAPE	FOOT	180	180										
70507140	TENT START LAVERENT PIANKING - LINE 0 - TITE IV TAFE	1001	4,000	4,000										
70307140	TEMPORARY PAVEMENT MARKING - LINE 8" - TYPE IV TAPE	FOOT	4,600	4,600										
70307130	TEMPORARY PAVEMENT MARKING - LINE 6" - TYPE IV TAPE	FOOT	1,294	1,294										
				URBAN	URBAN	URBAN	URBAN	URBAN	URBAN	URBAN	URBAN	URBAN	URBAN	URBAN
CODE NO.	ITEM	UNIT	TOTAL QUANTITY URBAN	ROADWAY	BRIDGE OVER 95TH ST.	BRIDGE OVER CSX RR.	RAMP A BRIDGE	HIGHWAY LIGHTING	TRAFFIC SIGNALS 0021	TRAFFIC SIGNALS 0021	NB I-294 TRAFFIC SIGNALS 0021	STANFORD DR TRAFFIC SIGNALS 0021	INTERCONNECT 0021	TRAFFIC SIG AND CHICA RIDGE LIGHT 0021
				NHPP	NHS-BRIDGE HARLEM AVE.	NHPP HARLEM AVE.	NHPP	NHPP	NHPP RAMP E	NHPP RAMP G	NHPP 95TH ST /	NHPP 92ND PL /	NHPP	NHPP 99TH STRE
				20% STATE	20% STATE	20% STATE	20% STATE	20% STATE	20% STATE	20% STATE	20% STATE	10% BRIDGEVIEW 10% STATE	20% STATE	13.3% STA 6.7% CHICAGO

PN: 3730 PLOT DATE = 11/30/2023

DATE -

REVISED -

**SUMMARY OF QUANTITIES** SCALE: NTS SHEET NO. 17 OF 36 SHEETS STA. N/A TO STA. N/A

2024 COUNTY TOTAL SHEET NO.
COOK 659 20 SECTION 3128-Z-I-R&RS

CONTRACT NO. 60R49

										ICTION CODE				
				80% FED	80% FED	80% FED	80% FED	80% FED	80% FED	80% FED	80% FED	80% FED 10% BRIDGEVIEW	80% FED	80% FED 13.3% STATE
				20% STATE		20% STATE	20% STATE	20% STATE		+	20% STATE	10% STATE		6.7% CHICAGO RID
		<u> </u>		NHPP	NHS-BRIDGE		NHPP	NHPP	NHPP	NHPP	NHPP	NHPP	NHPP	NHPP
CODE NO.	ITEM	UNIT	TOTAL QUANTITY URBAN	ROADWAY	HARLEM AVE BRIDGE OVER 95TH ST.	HARLEM AVE. BRIDGE OVER CSX RR.	RAMP A BRIDGE	HIGHWAY LIGHTING	RAMP E TRAFFIC SIGNALS	RAMP G TRAFFIC SIGNALS	95TH ST / NB I-294 TRAFFIC SIGNALS	92ND PL / STANFORD DR TRAFFIC SIGNALS	INTERCONNECT	99TH STREET TRAFFIC SIGNAI AND CHICAGO RIDGE LIGHTING
			UNDAIN	0004	0013	0013	0013	0021	0021	0021	0021	0021	0021	0021
				URBAN	URBAN	URBAN	URBAN	URBAN	URBAN	URBAN	URBAN	URBAN	URBAN	URBAN
* 78000100	THERMOPLASTIC PAVEMENT MARKING - LETTERS AND SYMBOLS	SQ FT	796	796										
* 78000200	THERMOPLASTIC PAVEMENT MARKING - LINE 4"	FOOT	27,244	27,244	$\frac{3}{2}$ $\triangle$									
					Ĭ									
* 78000400	THERMOPLASTIC PAVEMENT MARKING - LINE 6"	FOOT	3,604	3,604										
* 78000500	THERMOPLASTIC PAVEMENT MARKING - LINE 8"	FOOT	4,802	4,802										
78000300	THERMOLEASTIC FAVEMENT MARKING - LINE 0	1001	4,002	4,002										
* 78000600	THERMOPLASTIC PAVEMENT MARKING - LINE 12"	FOOT	1,961	1,961										
78003137	PREFORMED PLASTIC PAVEMENT MARKING, TYPE B - STANDARD - LINE 7"	FOOT	369	369										
* 78000650	THERMOPLASTIC PAVEMENT MARKING - LINE 24"	FOOT	188	188										
* 7000000	MODIFIED URETHANE PAVEMENT MARKING - LETTERS AND SYMBOLS	SQ FT	100	100										
* 78009000	MODITIED ONLINEARE PAVEMENT MARKING - LETTERS AND STMBOLS	3Q F1	109	109										
* 78009004	MODIFIED URETHANE PAVEMENT MARKING - LINE 4"	FOOT	2,993	2,993										
			1											
* 78009006	MODIFIED URETHANE PAVEMENT MARKING - LINE 6"	FOOT	486	486										
* 78009008	MODIFIED URETHANE PAVEMENT MARKING - LINE 8"	FOOT	221	221										
* 78009012	MODIFIED URETHANE PAVEMENT MARKING - LINE 12"	FOOT	12	12										
79000034	MODIFIED LIDETHANE DAVEMENT MARKING LIME 24	FOOT	36	26										
* 78009024 78011040	MODIFIED URETHANE PAVEMENT MARKING - LINE 24"  GROOVING FOR RECESSED PAVEMENT MARKER 8"	FOOT	36	36										
* 78100100		EACH	369	369										
	* SPECIALTY ITEM *** 100% VILLAGE OF CHICAGO RIL  ** 100% VILLAGE OF BRIDGEVIEW COST	DGE COST		1	1	1	1	1	1	1	1		RE'	/ISED SHEET
HOH GROU				A	OF	10			A			F.A.P. RTE.	SECTION	COUNTY
ARCHITECTS   ENGINEERS	P, INC. DRAWN - AAF REVISED -  PLOT SCALE = N/A CHECKED - BAP REVISED -		l Dei		OF ILLINOI OF TRANSP				SUMMAR	Y OF QUANTIT	IE9	29 &   348	3128-Z-I-R&RS	COOK CONTRACT

COUNTY TOTAL SHEET NO.
COOK 659 21 3128-Z-I-R&RS CONTRACT NO. 60R49 REV-SEP **S00–18** 

TO STA. N/A

PN: 3730 PLOT DATE = 11/30/2023

DATE -

REVISED -

				80% FED 20% STATE	80% FED 20% STATE	80% FED 20% STATE	80% FED 20% STATE	80% FED 20% STATE	CONSTRU 80% FED 20% STATE	CTION CODE 80% FED 20% STATE	80% FED	80% FED 10% BRIDGEVIEW 10% STATE	80% FED	80% FED 13.3% STATE 6.7% CHICAGO RE
				NHPP	NHS-BRIDGE	NHPP	NHPP	NHPP	NHPP	NHPP	NHPP	NHPP	NHPP	NHPP
CODE NO.	ITEM	UNIT	TOTAL QUANTITY URBAN	ROADWAY	HARLEM AVE. BRIDGE OVER 95TH ST.	HARLEM AVE. BRIDGE OVER CSX RR.	RAMP A BRIDGE	HIGHWAY LIGHTING	RAMP E TRAFFIC SIGNALS	RAMP G TRAFFIC SIGNALS	95TH ST / NB I-294 TRAFFIC SIGNALS	92ND PL / STANFORD DR TRAFFIC SIGNALS	INTERCONNECT	99TH STREE TRAFFIC SIGNA AND CHICAGO RIDGE LIGHTIN
			UNDAN	0004	0013	0013	0013	0021	0021	0021	0021	0021	0021	0021
				URBAN	URBAN	URBAN	URBAN	URBAN	URBAN	URBAN	URBAN	URBAN	URBAN	URBAN
78200005	GUARDRAIL REFLECTORS, TYPE A	EACH	93	93										
78200010	BARRIER WALL REFLECTORS, TYPE B	EACH	32	32										
78200010	BARRIER WALL REFLECTORS, TYPE B	EACH		12	3 1									
78300201	PAVEMENT MARKING REMOVAL - GRINDING	SQ FT	2,751	2,751	15 1									
			, -											
78300202	PAVEMENT MARKING REMOVAL - WATER BLASTING	SQ FT	2,751	2,751										
		1		1			1		1	1				
80400100	ELECTRIC SERVICE INSTALLATION	EACH	3					2						***1
80400200	ELECTRIC UTILITY SERVICE CONNECTION	L SUM	1					0.66						***0.34
81028200	UNDERGROUND CONDUIT, GALVANIZED STEEL, 2" DIA.	FOOT	7,301						771	692	429	639	4,747	***23
81028220	UNDERGROUND CONDUIT, GALVANIZED STEEL, 3" DIA.	FOOT	338					46	105	19	50	118		
81028240	UNDERGROUND CONDUIT, GALVANIZED STEEL, 4" DIA.	FOOT	4,047					2,164	616	303	484	410		***70
81100320	CONDUIT ATTACHED TO STRUCTURE, 1" DIA., PVC COATED GALVANIZED STEEL	FOOT	1,084					989						***95
81100605	CONDUIT ATTACHED TO STRUCTURE, 2" DIA., PVC COATED GALVANIZED STEEL	FOOT	676					120					556	
81100805	CONDUIT ATTACHED TO STRUCTURE, 3" DIA., PVC COATED GALVANIZED STEEL	FOOT	46					40						***6
	* SPECIALTY ITEM *** 100% VILLAGE OF CHICAGO RID	OGE COST												

 REVISED 

 REVISED 

 REVISED 

 REVISED

FILE NAME = ...\D160R49\_sht\_SOQ.dgn

THE HOH GROUP, INC.

USER NAME = KSUMRAK

PLOT SCALE = N/A

PN: 3730 PLOT DATE = 11/30/2023

DESIGNED - AAF

DRAWN - AAF

CHECKED - BAP

DATE -

STATE OF ILLINOIS
DEPARTMENT OF TRANSPORTATION

SCALE: NTS SHEET NO. 19 OF 36 SHEETS STA. N/A TO STA. N/A

				80% FED  20% STATE  NHPP	80% FED  20% STATE  NHS-BRIDGE	80% FED  20% STATE  NHPP	80% FED 20% STATE NHPP	80% FED 20% STATE NHPP	80% FED  20% STATE  NHPP	80% FED 20% STATE NHPP	80% FED  20% STATE  NHPP	80% FED 10% BRIDGEVIEW 10% STATE NHPP	80% FED  20% STATE  NHPP	80% FED 13.3% STATE 6.7% CHICAGO RI NHPP
CODE NO.	ITEM	UNIT	TOTAL QUANTITY URBAN	ROADWAY	HARLEM AVE. BRIDGE OVER 95TH ST.		•	HIGHWAY LIGHTING	RAMP E TRAFFIC SIGNALS	RAMP G TRAFFIC SIGNALS	95TH ST / NB I-294 TRAFFIC SIGNALS	92ND PL / STANFORD DR TRAFFIC SIGNALS	INTERCONNECT	99TH STREET TRAFFIC SIGNATION AND CHICAGO RIDGE LIGHTIN
			UKDAN	0004	0013	0013	0013	0021	0021	0021	0021	0021	0021	0021
				URBAN	URBAN	URBAN	URBAN	URBAN	URBAN	URBAN	URBAN	URBAN	URBAN	URBAN
88030050	SIGNAL HEAD, LED, 1-FACE, 3-SECTION, BRACKET MOUNTED	EACH	21						7	3	6	4		1
88030100	SIGNAL HEAD, LED, 1-FACE, 5-SECTION, BRACKET MOUNTED	EACH	4									4		
88030110	SIGNAL HEAD, LED, 1-FACE, 5-SECTION, MAST-ARM MOUNTED	EACH	4									4		
88102717	PEDESTRIAN SIGNAL HEAD, LED, 1-FACE, BRACKET MOUNTED WITH COUNTDOWN TIMER	EACH	8						4			4		
88200410	TRAFFIC SIGNAL BACKPLATE, LOUVERED, FORMED PLASTIC	EACH	36						9	5	11	10		1
88500100	INDUCTIVE LOOP DETECTOR	EACH	31						9	5	10	7		
88600100	DETECTOR LOOP, TYPE I	FOOT	1,895						632	235	645	383		
		(	,,,,,,,,,,,,,,,,,,,,,,,,,,,,,,,,,,,,,,,	***************************************	· · ~~~~	· · · · · · · · · · · · · · · · · · ·	~~~~	·····	·	~~~~~
88700200	LIGHT DETECTOR	EACH	10						**3	**2	**2	**2		***1
88700300	LIGHT DETECTOR AMPLIFIER	EACH	5						**1	**1	**1	**1		1
89000100	TEMPORARY TRAFFIC SIGNAL INSTALLATION	EACH	2								1	1		
89500300	RELOCATE EXISTING ILLUMINATED SIGN	EACH	2									**2		
89502200	MODIFY EXISTING CONTROLLER	EACH	1											1
89502300	REMOVE ELECTRIC CABLE FROM CONDUIT	FOOT	27,029					21,160			190		5679	

STATE OF ILLINOIS
DEPARTMENT OF TRANSPORTATION

SCALE: NTS SHEET NO. 25 OF 36 SHEETS STA. N/A TO STA. N/A

					80% FED	80% FED	80% FED	80% FED	80% FED	CONSTRU 80% FED	CTION CODE 80% FED	80% FED	80% FED 10% BRIDGEVIEW	80% FED	80% FED 13.3% STATE
					20% STATE	20% STATE			20% STATE	20% STATE	20% STATE	20% STATE	10% STATE	20% STATE	6.7% CHICAGO RIDGE
COI	DE NO.	ITEM	UNIT	TOTAL	ROADWAY	NHS-BRIDGE HARLEM AVE. BRIDGE OVER 95TH ST.	NHPP HARLEM AVE. BRIDGE OVER CSX RR.	NHPP RAMP A BRIDGE	NHPP HIGHWAY LIGHTING	NHPP  RAMP E TRAFFIC SIGNALS	NHPP  RAMP G TRAFFIC SIGNALS	NHPP 95TH ST / NB I-294 TRAFFIC SIGNALS	NHPP  92ND PL / STANFORD DR TRAFFIC SIGNALS	NHPP INTERCONNECT	NHPP  99TH STREET TRAFFIC SIGNALS AND CHICAGO RIDGE LIGHTING
				URBAN	0004	0013	0013	0013	0021	0021	0021	0021	0021	0021	0021
					URBAN	URBAN	URBAN	URBAN	URBAN	URBAN	URBAN	URBAN	URBAN	URBAN	URBAN
Z00	48665	RAILROAD PROTECTIVE LIABILITY INSURANCE	L SUM	1	1										
				Я		R .			1						
Z00	62456	TEMPORARY PAVEMENT	SQ YD	8,097	8,097										
Z00	64600	SELECTIVE CLEARING	ACRE	1	1										
Z00	73200	TEMPORARY SHORING AND CRIBBING	EACH	2				2							
* Z00	73510	TEMPORARY TRAFFIC SIGNAL TIMING	EACH	12	10							1	1		
* A20	00216	TREE, ACER X FREEMANII MARMO (MARMO FREEMAN MAPLE), 2" CALIPER, BALLED AND BURLAPPED	EACH	21	21										
* A20	01916	TREE, ACER SACCHARUM LEGACY ( LEGACY SUGAR MAPLE), 2" CALIPER, BALLED AND BURLAPPED	EACH	14	14										
* A20	02016	TREE, AESCULUS GLABRA (OHIO BUCKEYE), 2" CALIPER, BALLED AND BURLAPPED	EACH	19	19										
* A20	02316	TREE, BETULA NIGRA (RIVER BIRCH), 2" CALIPER, BALLED AND BURLAPPED	EACH	5	5										
* A20	002470	TREE, BETULA NIGRA HERITAGE (HERITAGE RIVER BIRCH), 8' HEIGHT, CLUMP FORM, BALLED AND BURLAPPED	EACH	19	19										
* A20	02564	TREE, CARPINUS CAROLINIANA (AMERICAN HORNBEAM), 5' HEIGHT, SHRUB FORM, BALLED AND BURLAPPED	EACH	16	16										
* A20	002612	TREE, CARYA CORDIFORMIS (BITTERNUT HICKORY), 1-1/2" CALIPER, BALLED AND BURLAPPED	EACH	5	5										
* A20	02816	TREE, CATALPA SPECIOSA (NORTHERN CATALPA), 2" CALIPER, BALLED AND BURLAPPED	EACH	7	7										
		* SPECIALTY ITEM *** 100% VILLAGE OF CHICAGO RIDG	GE COST												/ISED SHEET 2/26/2

FILE NAME = ....\D160R49\_sht\_SOQ.dgn
THE HOH GROUP, INC. USER NAME = KSUMRAK DESIGNED - AAF REVISED -

PLOT SCALE = N/A

PN: 3730 PLOT DATE = 11/30/2023

DRAWN - AAF

CHECKED - BAP

DATE -

REVISED -

REVISED -

REVISED -

STATE OF ILLINOIS **DEPARTMENT OF TRANSPORTATION** 

**SUMMARY OF QUANTITIES** SCALE: NTS SHEET NO. 28 OF 36 SHEETS STA. N/A TO STA. N/A

COUNTY TOTAL SHEET NO.
COOK 659 31 SECTION 3128-Z-I-R&RS CONTRACT NO. 60R49

								80% FED 20% STATE		80% FED 20% STATE	80% FED 10% BRIDGEVIEW 10% STATE	80% FED 20% STATE	80% FED 13.3% STATE 6.7% CHICAGO RII
ITEM	UNIT	TOTAL OUANTITY	ROADWAY	HARLEM AVE. BRIDGE OVER 95TH	HARLEM AVE. BRIDGE OVER CSX		NHPP HIGHWAY LIGHTING	NHPP  RAMP E  TRAFFIC  SIGNALS	RAMP G TRAFFIC SIGNALS	95TH ST / NB I-294 TRAFFIC	92ND PL / STANFORD DR TRAFFIC SIGNALS	NHPP INTERCONNECT	NHPP  99TH STREET TRAFFIC SIGNA AND CHICAGO RIDGE LIGHTIN
		URBAN	0004	0013	0013	0013	0021	0021	0021	0021	0021	0021	0021
			URBAN	URBAN	URBAN	URBAN	URBAN	URBAN	URBAN	URBAN	URBAN	URBAN	URBAN
WEED CONTROL, PRE-EMERGENT GRANULAR HERBICIDE	POUND	53	53										
PRUNING FOR SAFETY AND EQUIPMENT CLEARANCE	L SUM	1	1										
SELECTIVE MOWING STAKES	EACH	194	14			180							
MAINTENANCE OF EXISTING PUMP STATION DURING CONSTRUCTION	CAL MO	36	36-	12									
				17)									
PROPOSED STORM SEWER CONNECTION TO EXISTING STORM SEWER	EACH	1	1										
COARSE SAND PLACEMENT, 4"	SQ YD	30,471	30,471										
SLOPE WALL CRACK SEALING	FOOT	1,552		531	841	180							
EMERGENCY VEHICLE PRIORITY SYSTEM LINE SENSOR CABLE, NO. 20 3/C	FOOT	1,733						**594	**349	**349	**481		
ROD AND CLEAN EXISTING CONDUIT	FOOT	940										940	
REPLACE EXISTING DECAL WITH NEW LUMINAIRE NUMBERING DECAL	EACH	7					7						
TEMPORARY WOOD POLE, 60 FT., CLASS 4, 15 FT. MAST ARM	EACH	69					69						
WEED CONTROL, NATIVE LANDSCAPE ENHANCEMENT	ACRE	5	5										
TEMPORARY WOOD POLE, 40 FT., CLASS 4	EACH	5					5						
	PRUNING FOR SAFETY AND EQUIPMENT CLEARANCE  SELECTIVE MOWING STAKES  MAINTENANCE OF EXISTING PUMP STATION DURING CONSTRUCTION  PROPOSED STORM SEWER CONNECTION TO EXISTING STORM SEWER  COARSE SAND PLACEMENT, 4"  SLOPE WALL CRACK SEALING  EMERGENCY VEHICLE PRIORITY SYSTEM LINE SENSOR CABLE, NO. 20 3/C  ROD AND CLEAN EXISTING CONDUIT  REPLACE EXISTING DECAL WITH NEW LUMINAIRE NUMBERING DECAL  TEMPORARY WOOD POLE, 60 FT., CLASS 4, 15 FT. MAST ARM	WEED CONTROL, PRE-EMERGENT GRANULAR HERBICIDE  PRUNING FOR SAFETY AND EQUIPMENT CLEARANCE  L SUM  SELECTIVE MOWING STAKES  EACH  MAINTENANCE OF EXISTING PUMP STATION DURING CONSTRUCTION  CAL MO  PROPOSED STORM SEWER CONNECTION TO EXISTING STORM SEWER  EACH  COARSE SAND PLACEMENT, 4"  SQ YD  SLOPE WALL CRACK SEALING  FOOT  EMERGENCY VEHICLE PRIORITY SYSTEM LINE SENSOR CABLE, NO. 20 3/C  FOOT  ROD AND CLEAN EXISTING CONDUIT  FOOT  REPLACE EXISTING DECAL WITH NEW LUMINAIRE NUMBERING DECAL  EACH  TEMPORARY WOOD POLE, 60 FT., CLASS 4, 15 FT. MAST ARM  EACH	WEED CONTROL, PRE-EMERGENT GRANULAR HERBICIDE  PRUNING FOR SAFETY AND EQUIPMENT CLEARANCE  L SUM  1  SELECTIVE MOWING STAKES  EACH  194  MAINTENANCE OF EXISTING PUMP STATION DURING CONSTRUCTION  CAL MO  36  PROPOSED STORM SEWER CONNECTION TO EXISTING STORM SEWER  EACH  1  COARSE SAND PLACEMENT, 4°  SQ YD  30,471  SLOPE WALL CRACK SEALING  FOOT  1,552  EMERGENCY VEHICLE PRIORITY SYSTEM LINE SENSOR CABLE, NO. 20 3/C  FOOT  1,733  ROD AND CLEAN EXISTING CONDUIT  FOOT  940  REPLACE EXISTING DECAL WITH NEW LUMINAIRE NUMBERING DECAL  EACH  69	TITEM  UNIT  TOTAL VURBAN  TOTAL VORD  TOTAL VURBAN  TOTAL VORD	TOTAL   NHPP   NHS RIDGE   NHS RIDGE	TEM	TITEM	No.   1   1   1   1   1   1   1   1   1	1906   1907   1908	PRINCESON PROPERTY FOR STATE	No.   1	1985   1985	Part   Part

FILE NAME = ....\D160R49\_sht\_SOQ.dgn
THE HOH GROUP, INC. USER NAME = KSUMRAK DESIGNED - AAF DRAWN - AAF

PN: 3730 PLOT DATE = 11/30/2023

PLOT SCALE = N/A

STATE OF ILLINOIS

**DEPARTMENT OF TRANSPORTATION** 

REVISED -

REVISED -

REVISED -

REVISED -

CHECKED - BAP

DATE -

**SUMMARY OF QUANTITIES** SCALE: NTS SHEET NO. 32 OF 36 SHEETS STA. N/A TO STA. N/A

COUNTY TOTAL SHEET NO.
COOK 659 35 SECTION 3128-Z-I-R&RS

				80% FED	80% FED	80% FED	80% FED	80% FED	CONSTRU 80% FED	80% FED	80% FED	80% FED	80% FED	80% FED
												10% BRIDGEVIEW		13.3% STATE
				20% STATE	20% STATE			-			20% STATE	10% STATE		6.7% CHICAGO RIDGE
			TOTAL	NHPP ROADWAY	NHS-BRIDGE HARLEM AVE. BRIDGE	BRIDGE	NHPP RAMP A	NHPP	NHPP RAMP E TRAFFIC	NHPP RAMP G TRAFFIC	95TH ST / NB I-294	NHPP 92ND PL / STANFORD DR	NHPP INTERCONNECT	NHPP 99TH STREET TRAFFIC SIGNALS
CODE NO.	ITEM	UNIT	QUANTITY URBAN	0004	OVER 95TH ST.	OVER CSX RR.	BRIDGE 0013	LIGHTING 0021	SIGNALS 0021	SIGNALS 0021	TRAFFIC SIGNALS 0021	TRAFFIC SIGNALS	0021	AND CHICAGO RIDGE LIGHTING 0021
				URBAN	URBAN	URBAN	URBAN	URBAN	URBAN	URBAN	URBAN	URBAN	URBAN	URBAN
X1200043	PRECAST CONCRETE JUNCTION CHAMBER	EACH	6	6										
X1200108	INLET BOX (SPECIAL)	EACH	1	1	BA									
X1400081	FULL-ACTUATED CONTROLLER AND TYPE SUPER P CABINET (SPECIAL)	EACH	1	<del>Juuuu</del>								1		
X1400108	FULL-ACTUATED CONTROLLER AND TYPE SUPER R CABINET (SPECIAL)	EACH	13						11	1	1			
X1400146	HELIX FOUNDATION AND BREAKAWAY DEVICE	EACH	2					2						
X1400150	SERVICE INSTALLATION, GROUND MOUNTED, METERED	EACH	4						1	1	1	1		
X1400216	LAYER II (DATALINK) SWITCH	EACH	13						11	1		1		
X1400217	TERMINATE FIBER IN CABINET	EACH	72						36	12	12	12		
X1400219	SPLICE FIBER IN CABINET	EACH	18						6	6		6		
X1400367	PEDESTRIAN SIGNAL POST, 10 FT.	EACH	5						2			3		
X1400378	PEDESTRIAN SIGNAL POST, 5 FT.	EACH	1						1					
X1400388	VIDEO VEHICLE DETECTION SYSTEM, SINGLE APPROACH	EACH	2									2		
X1400424	ELECTRIC CABLE IN CONDUIT, STREET NAME SIGN, NO. 14 3C, TYPE SOOW	FOOT	343									**343		
X1400460	LAYER III (NETWORK) SWITCH	EACH	1						1					
	* SPECIALTY ITEM *** 100% VILLAGE OF CHICAGO RIE ** 100% VILLAGE OF BRIDGEVIEW COST	DGE COST		I	I			1		I		<u>I</u>	ıl ∕∏ REVI	SED SHEET 2/26/20
OH GROUP,	INC. USER NAME = KSUMRAK DESIGNED - AAF REVISED - INC. DRAWN - AAF REVISED -		<u> </u>	STATE	OF ILLINOI	 S			SIIMMAPI	Y OF QUANTIT	IFS	F.A.P. RTE. 29 & 348	SECTION	COUNTY TOTAL SHEETS COOK 659
ARCHITECTS   ENGINEERS	PLOT SCALE = N/A CHECKED - BAP REVISED -  PART - 1/30/2023 PLOT DATE - 1/30/2023 PROT DATE - 1/30/2022 PROT DATE - 1/30/2022 PROT DATE - 1/30/2022 PROT DA		DEI		OF TRANSP		SCALL			RE CHEETS   STA			3128-Z-I-R&RS	COOK   659

PN: 3730 PLOT DATE = 11/30/2023

DATE -

REVISED -

**SUMMARY OF QUANTITIES** SCALE: NTS SHEET NO. 33 OF 36 SHEETS STA. N/A TO STA. N/A

CONTRACT NO. 60R49

				80% FED 20% STATE NHPP	80% FED  20% STATE  NHS-BRIDGE	80% FED 20% STATE NHPP	80% FED 20% STATE NHPP	80% FED 20% STATE NHPP	80% FED  20% STATE  NHPP	20% STATE  NHPP	80% FED 20% STATE NHPP	80% FED 10% BRIDGEVIEW 10% STATE NHPP	80% FED  20% STATE  NHPP	80% FED 13.3% STATE 6.7% CHICAGO RI NHPP
CODE NO.	ITEM	UNIT	TOTAL QUANTITY URBAN	ROADWAY	HARLEM AVE. BRIDGE OVER 95TH ST.	BRIDGE OVER CSX RR.	RAMP A BRIDGE	HIGHWAY LIGHTING	RAMP E TRAFFIC SIGNALS	RAMP G TRAFFIC SIGNALS	95TH ST / NB I-294 TRAFFIC SIGNALS	92ND PL / STANFORD DR TRAFFIC SIGNALS	INTERCONNECT	99TH STREET TRAFFIC SIGNA AND CHICAGO RIDGE LIGHTIN
				0004 URBAN	0013 URBAN	0013 URBAN	0013 URBAN	URBAN	0021 URBAN	0021 URBAN	0021 URBAN	0021 URBAN	0021 URBAN	0021 URBAN
				ORDAN	ORDAN	ONDAN	ORDAN	ONDAN	ONDAN	ORDAN	ONDAN	ONDAN	ORBAN	ORBAN
X7010238	CHANGEABLE MESSAGE SIGN (SPECIAL)	CAL MO	36	36										
X8211008	TEMPORARY LUMINAIRE, LED, ROADWAY, OUTPUT DESIGNATION H	EACH	69					69						
X8250060	TEMPORARY LIGHTING CONTROLLER	EACH	1					1	<del>-16</del>	6	17	18		13
X8250091	COMBINATION LIGHTING CONTROLLER	EACH	3					3						
X8420111	REMOVAL OF UNDERPASS LIGHTING UNIT, NO SALVAGE	EACH	63					62	1					
X8620200	UNINTERRUPTABLE POWER SUPPLY (SPECIAL)	EACH	4						1	1	1	1		
X8710024	FIBER OPTIC CABLE IN CONDUIT, NO. 62.5/125, MM12F SM24F	FOOT	8,950										8,950	
X8760200	ACCESSIBLE PEDESTRIAN SIGNALS	EACH	9						5			4		
X8780012	CONCRETE FOUNDATION, TYPE A 12-INCH DIAMETER	FOOT	24						12			12		
X8870510	CONFIRMATION BEACON	EACH	1											1
X8809005	LED SIGNAL FACE, LENS COVER	EACH	126						70	8	17	18		13
X1400512	FIBER OPTIC INTERCONNECT CENTER, 24 PORT	EACH	3						1	1		1		
X1400513	FIBER OPTIC INTERCONNECT CENTER, 48 PORT	EACH	1						1					
X0328033	TERMINAL SERVER	EACH	2						1	1				

FILE NAME = ....\D160R49\_sht\_SOQ.dgn

THE HOH GROUP, INC.

ARCHITECTS | :NGNTERS

PLOT SCALE = N/A

USER NAME = KSUMRAK

DESIGNED - AAF

REVISED 
DRAWN - AAF

REVISED 
PLOT SCALE = N/A

CHECKED - BAP

REVISED -

DATE -

REVISED -

PN: 3730 PLOT DATE = 11/30/2023

STATE OF ILLINOIS
DEPARTMENT OF TRANSPORTATION

SCALE: NTS | SHEET NO. 35 OF 36 SHEETS | STA. N/A | TO STA. N/A

					IDOT	_							IDOT			11
	CURB & GUTTER AN	D ISLAND REMOVA	L	CURB REMOVAL	COMBINATION CURB AND GUTTER REMOVAL	ISLAND REMOVAL	REMARKS		CURB & GUTTER AN	D ISLAND REMOVAL		CURB REMOVAL	COMBINATION CURB AND GUTTER REMOVAL	ISLAND REMOVAL	REMARKS	
				44000300	44000500	X4402805						44000300	44000500	X4402805		
ROADWAY	STATION 1	O STATION	OFFSET	FOOT	FOOT	SQ FT		ROADWAY	STATION 1	O STATION	OFFSET	FOOT	FOOT	SQ FT		_  [
95TH ST.	604+25.00	606+48.00	LT EOP		221.8			HARLEM AVE.	322+07.86	326+21.32	RT EOP	569.5			INCLUDES RAMP F & E	IJ L
95TH ST.	606+48.00	613+53.82	LT EOP		698.5			HARLEM AVE.	325+47.30	334+55.62	RT EOP	913.0			INCLUDES RAMP E	┛┕
95TH ST.	613+54.46	617+68.09	LT EOP		415.0											
95TH ST.	617+68.09	618+31.17	LT EOP	125.5				HARLEM AVE.	313+18.13	0+37.24	NB EOP			93.0		1 1
95TH ST.	618+55.40	622+54.24	LT EOP		404.0			HARLEM AVE.	321+89.80	322+05.73	NB EOP			59.0		٦L
95TH ST.	622+56.53	628+00.90	LT EOP		544.5			HARLEM AVE.	316+64.47	316+94.85	SB EOP			158.0		7
95TH ST.	628+00.90	628+80.75	LT EOP	117.5			INCLUDES RAMP E	HARLEM AVE.	326+58.99	326+61.90	SB EOP			167.0		1
95TH ST.	630+43.77	636+13.94	LT EOP		571.0											
95TH ST.	606+48.00	636+13.94	LT MED.	2,967.0				RAMP B	316+67.66 (1)	316+67.66 (1)	LT EOP	47.5			(1) HARLEM AVE. STATIONING	7
95TH ST.	606+42.91	636+13.94	RT MED.	2,966.5				RAMP B	318+07.59 (1)	619+13.84 (2)	RT EOP	959.0			(2) 95TH ST STATIONING	1
95TH ST.	606+95.83	609+64.99	RT EOP	,	272.5				. ,	` '					. 7	1
95TH ST.	609+64.30	619+09.13	RT EOP		962.0			RAMP C	613+49.76 (2)	613+49.76 (2)	LT EOP	32.0			(2) 95TH ST STATIONING	1
95TH ST.	619+13.84	623+54.89	RT EOP		440.0			RAMP C	613+49.76 (2)	614+03.58 (2)	LT EOP	52.0	29.0		(2) 95TH ST STATIONING	1
95TH ST.	623+76.83	630+29.52	RT EOP		670.0			RAMP C	613+53.82	614+16.64	RT EOP	64.0				1
95TH ST.	630+24.74	636+13.94	RT EOP		588.5											1
								RAMP D	617+89.73 (2)	618+29.27 (2)	LT EOP	38.0	8.0		(2) 95TH ST STATIONING	┨
95TH ST.	618+28.59	618+56.32	WB EOP			133.0		RAMP D	618+55.40 (2)	320+63.97 (1)	RT ROP	896.5	16.0		(1) HARLEM AVE. STATIONING	┨
95TH ST.	628+78.19	629+14.62	WB EOP			178.0		RAMP D	321+01.27 (1)	322+09.36 (1)	LT EOP	22.0	88.0		(1) HARLEM AVE. STATIONING	1
95TH ST.	623+49.84	623+79.57	EB EOP			130.0									(-,	1
		020 70107				1 200.0		RAMP E	3+84.69	6+17.82	RT EOP		245.5			┨
HARLEM AVE.	307+71.50	309+91.17	LT EOP	219.5				10.0711 2	3.0 1103	0.17.02			213.3			-
HARLEM AVE.	307+05.74	309+69.66	LT MED.	264.0				RAMP F	18+71.03	28+22.30	RT EOP	865.5				-1
HARLEM AVE.	307+05.74	309+59.64	RT MED.	254.0				RAMP F	27+21.33	28+20.15	LT EOP	110.0				┨
HARLEM AVE.	307+05.74	309+30.35	RT EOP	224.5				IVAIVII 1	2/121.33	20120.13	LI LOI	110.0				
HANLEWI AVE.		OMISSION	INI EOI	224.5				RAMP G2	32+18.11	34+00.00	RT EOP	173.0				┨
HARLEM AVE.	313+03.60	316+67.66	LT EOP	364.0			INCLUDES RAMP B LT EOP	RAMP G2	33+34.56	33+78.49	LT EOP	1/5.0	48.0			
HARLEM AVE.	312+82.60	318+08.50	LT MED.	526.0			INCLODES NAIVIF B EI EOF	RAMP G2	43+32.83	44+09.39	RT EOP	67.0	8.0			1
HARLEM AVE.	312+72.62	318+08.83	RT MED.	536.0				RAMP G2	43+94.49	44+13.25	LT EOP	24.0	8.U			-
HARLEM AVE.	313+37.24	313+82.37	RT EOP	330.0	45.0	1		IVAIVII G2	43134,43	44113.23	LI LOI	24.0				-∥
HARLEM AVE.	313+37.24	313+82.37	RT EOP	304.0	45.0	1		RAMP H	4+28.01	318+10.29 (1)	RT EOP	793.5	<del>                                     </del>	<del> </del>	/1) HADIEM AVE STATIONING	┨
HARLEM AVE.		316+86.37		304.0	92.5	1	DOEC NOT INCLUDE DAME !!		4+28.01 4+45.54			782.5	<del> </del>	<del> </del>	(1) HARLEM AVE. STATIONING	$\dashv$
HAKLEIVI AVE.	316+86.37		RT EOP	+	92.5		DOES NOT INCLUDE RAMP H	RAMP H RAMP H	4+45.54 10+84.78	4+80.78	LT EOP	37.0	107.0	-		$\dashv$
1140151441		RIDGE OMISSION	IT FOR		05.5			KAIVIP H	10+84.78	11+82.77	LIEUP		107.0			
HARLEM AVE.	321+01.99	321+87.50	LT EOP	160.0	85.5	+		DANADI	3,00,00	4,00,00	DT FOR	1	100.5	<del>                                     </del>		$\dashv$
HARLEM AVE.	321+87.50	326+27.58	LT EOP	460.0		1	INCUING DANAD O	RAMP J	3+00.00	4+00.00	RT EOP	1	100.5	<del> </del>		$\dashv$
HARLEM AVE.	325+70.84	325+87.04	LT EOP	20.5		1	INCLUDES RAMP C	RAMP J	4+00.00	5+00.08	RT EOP		97.7			4
HARLEM AVE.	325+87.04	326+45.72	LT EOP	700.5	61.0		INCLUDES RAMP C	LEET TURN LIVE	000.07.61	222.21.52	17.1456	<del> </del>				4
HARLEM AVE.	326+45.72	334+34.39	LT EOP	789.5		1		LEFT TURN LANE	293+87.62	298+94.58	LT MED.	507.0				4
HARLEM AVE.	334+34.39	334+55.62	LT EOP		24.5			LEFT TURN LANE	293+87.62	297+93.03	R MED.	405.5				4
HARLEM AVE.	320+65.56	333+54.78	LT MED.	915.0		1							(	<b>)</b>		4
HARLEM AVE.	333+54.78	334+34.02	LT MED.	+ -	79.0	1		TOTAL				18,481.5	6,923.0	918.0		-
HARLEM AVE.	320+65.56	333+54.78	RT. MED.	915.0									$\sim$			ゴー

1	DEDMANNEN	T CLIDVEY \$44 DVED	T/DE I	IDOT
	PERIVIAINEIN	T SURVEY MARKERS	, ITPE I	66700205
	DOADWAY	STATION	TVDE	UPDATE
	ROADWAY	STATION	TYPE	EACH
	95TH ST.	610+09.14	P.C.	1
	95 TH ST.	611+14.57	P.T.	1
	95 TH ST.	611+82.12	P.C.	1
	95 TH ST.	613+49.59	P.T.	1
	95TH ST.	616+89.37	P.C.	1
	95TH ST.	619+92.41	P.T.	1
	TOTAL		6	

PROJECT GENERAL PAY ITEMS	REMOVAL AND DISPOSAL OF UNSUITABLE MATERIAL	GEOTECHNICAL FABRIC FOR GROUND STABILIZATION	NON-SPECIAL WASTE DISPOSAL	SOIL DISPOSAL ANALYSIS	REGULATED SUBSTANCES PRE- CONSTRUCTION PLAN	REGULATED SUBSTANCES MONITORING	MOBILIZATION	TRAFFIC CONTROL SURVEILLANCE	MAINTENANCE OF EXISTING PUMP STATION DURING CONSTRUCTION	ENGINEER'S FIELD OFFICE, TYPE A (SPECIAL)	TRAFFIC CONTROL AND PROTECTION, (SPECIAL)	CHANGEABLE MESSAGE SIGN, SPECIAL	CONSTRUCTION LAYOUT	RAILROAD PROTECTIVE LIABILITY INSURANCE
ROADWAY	20201200	21001000	66900200	66900530	66901001	66901006	67100100	70103815	X0320033	X6700410	X7010216	X7010238	Z0013798	Z0048665
ROADWAY	CU YD	SQ YD	CU YD	EACH	L SUM	CAL DA	L SUM	CAL DA	CAL MO	CAL MO	L SUM	CAL MO	L SUM	L SUM
ALL	100	500	34300	6	1	200	1	720	36	36	1	36	1	1
TOTAL	100	500	34300	6	1	200	1	720	36	36	1	36	1	1

				IDOT							
ни	HMA CONNECTOR TO APPROACH SLAB  ROADWAY STA, TO STA. OFFSET										
POADWAY	POADWAY STA TO STA DEESET										
KUADWAT	SIA. II	OFFSET	SQ YD								
HARLEM AVE NB	305+21	309+59	RT	95							
HARLEM AVE NB	312+72	312+82	RT	146							
HARLEM AVE NB	317+99	318+09	RT	52							
HARLEM AVE NB	320+66	320+77	RT	46							
HARLEM AVE SB	309+56	309+66	LT	51							
HARLEM AVE SB	312+79	313+08	LT	52							
HARLEM AVE SB	317+98	LT	42								
HARLEM AVE SB	HARLEM AVE SB 320+66 320+76 LT										
TOTAL											

MIXTURE FO	MIXTURE FOR CRACKS, JOINTS, AND FLANGEWAYS SCHEDULE												
DOADWAY	OFFSET OFFSET												
ROADWAY	ROADWAY STATION TO STATION (FT) SIDE												
RAMP A & RAMP G2	VARIES	VARIES	VARIES	VARIES	5								
TOTAL	5												

Λ					
/1\	REVIS	ED SH	HEET	2/27/	2024

FILE NAME =\D160R49_sht_Schedules.dgn	USER NAME = KSUMRAK	DESIGNED - AAF	REVISED - 1 2/23/24 KAS	Т
THE HOH GROUP, INC.		DRAWN - AAF	REVISED -	1
ARCHITECTS   ENGINEERS	PLOT SCALE = N/A	CHECKED - BAP	REVISED -	]
PN: 3730	PLOT DATE = 11/30/2023	DATE -	REVISED -	1

STATE	E 01	F ILLINOIS
DEPARTMENT	0F	TRANSPORTATION

	SCHEDULE	OF QUA	NTITIES		RTE. 29 & 348	
SCALE: NTS	SHEET NO. 5 OF 9	SHEETS	STA. N/ A	TO STA. N/A		

F.A.P. RTE.	SECTION	COUNTY	TOTAL SHEETS	SHEE NO.
29 & 348	3128-Z-I-R&RS	соок	659	96
		CONTRAC	T NO. 60	R49
	ILLINOIS FED. A	ID PROJECT		

								IDOT				
c	URB & GUTTER AND	BARRIER WALLS		CONCRETE CURB, TYPE B	COMB CC&G TB6.12	COMB CC&G TB6.18	COMB CC&G TB6.24	COMB CC&G TM2.12	COMB CC&G TM2.24	GUTTER, TYPE G-3	COMB C&G REM REP<=10F	CONCRETE
				0.500 FT	1.583 FT	2.083 FT	2.583 FT	1.500 FT	2.000 FT	-		
ROADWAY	STATION T	O STATION	OFFSET	50600605	60603800	60604400	60605000	60608300	60608521	TBD BY IDOT	X4400501	50300225
95TH ST.	604+25.00	606+48.00	WB EOP	FOOT	FOOT	FOOT	FOOT	FOOT	FOOT	FOOT	FOOT	CU YD
95TH ST.	606+48.00	610+55.38	WBEOP				223.0					
							405.5					
95TH ST.	610+55.38	612+25.89	WB EOP		167.0				246.0			83.0
95TH ST.	612+25.89	614+74.37	WB EOP						246.0			
95TH ST.	614+74.37	616+10.65	WB EOP				138.0					
95TH ST.	618+23.65	620+52.33	WB EOP		233.5							
95TH ST.	620+52.33	621+39.29	WB EOP		87.0							
95TH ST.	621+39.29	623+14.86	WB EOP					177.5				
95TH ST.	623+93.24	628+61.79	WB EOP				469.0					
95TH ST.	630+09.64	636+13.94	WB EOP				605.5					
95TH ST.	606+95.83	609+64.99	EB EOP				273.0					
95TH ST.	609+61.55	612+09.59	EB EOP						265.5			
95TH ST.	612+09.59	618+21.94	EB EOP				611.5					
95TH ST.	618+21.94	620+55.93	EB EOP						229.0			
95TH ST.	620+55.93	622+50.03	EB EOP				194.0					
95TH ST.	623+89.24	629+14.52	EB EOP				527.0					
95TH ST.	630+54.14	636+13.94	EB EOP	-		<b></b>	560.5		<b></b>			
95TH ST.	606+42.91	611+01.84	EB MEDIAN		460.0							
95TH ST.	611+01.84	612+31.15	EB MEDIAN					130.0				
95TH ST.	612+31.15	612+70.07	EB MEDIAN						39.0			
95TH ST.	612+70.07	619+83.57	EB MEDIAN				711.5					
95TH ST.	619+83.57	621+79.19	EB MEDIAN						195.5			
95TH ST.	621+79.19	636+13.94	EB MEDIAN				1,434.5					
95TH ST.	606+42.91	611+28.71	WB MEDIAN		485.0							
95TH ST.	611+28.71	612+31.15	WB MEDIAN					102.5				
95TH ST.	612+31.15	612+97.07	WB MEDIAN						66.0			
95TH ST.	612+97.07	620+16.18	WB MEDIAN				719.0					
95TH ST.	620+16.18	622+06.19	WB MEDIAN						190.0			
95TH ST.	622+06.19	636+13.94	WB MEDIAN				1,408.0					
HARLEM AVE.	307+05.74	309+30.35	NB EOP				225.5					
HARLEM AVE.	313+59.49	313+96.03	RT		38.0							
HARLEM AVE.	313+96.03	315+00.85	NB EOP				107.0					
HARLEM AVE.	315+51.85	317+42.10	NB EOP				190.0					
HARLEM AVE.	322+47.38	323+42.64	NB EOP				95.5					
HARLEM AVE.	323+84.32	324+33.56	NB EOP				49.5					
HARLEM AVE.	324+71.83	334+56.82	NB EOP				992.0					
HARLEM AVE.	307+71.50	309+84.73	SB EOP				214.0					
HARLEM AVE.	312+99.39	318+07.59	SB EOP				509.5					
HARLEM AVE.	320+64.44	326+28.69	SB EOP				564.5					
HARLEM AVE.	331+04.11	334+55.62	SB EOP				358.0					
HARLEM AVE.	307+05.74	309+40.19	NB MEDIAN		234.5							
HARLEM AVE.	307+05.74	309+40.19	SB MEDIAN		234.5							
HARLEM AVE.	312+96.00	315+31.44	NB MEDIAN		239.0							
HARLEM AVE.	312+96.00	315+28.10	SB MEDIAN		232.0							
HARLEM AVE.	320+83.55	322+75.95	NB MEDIAN		192.5							
HARLEM AVE.	320+83.55	322+75.95	SB MEDIAN		193.0							
HARLEM AVE.	323+65.81	329+68.55	NB MEDIAN		610.0							
HARLEM AVE.	323+65.81	329+68.55	SB MEDIAN		606.5							
RAMP E	4+18.81	14+38.91	WB EOP				1,024.0					
RAMP G	20+34.77	21+75.96	RT EOS			144.0						
RAMP G2	33+19.38	33+33.24	RT	15.0								
RAMP G2	33+54.04	35+29.11	LT EOS			196.0						
RAMP J	3+00.00	4+00.00	RT EOP							100.0		
RAMP J	4+00.00	5+00.07	RT EOP							97.0		
										1		
ACCESS ROAD	10+37.00	10+56.02	LT & RT EOP	1	43.5	1		1				
LEFT TURN LANE	296+88.65	297+87.03	LT	98.5								
LEFT TURN LANE	296+88.65	297+87.03	RT	98.5								
LEFT TURN LANE	297+87.03	298+94.59	LT	107.5								
LEFT TURN LANE	297+87.03	297+93.03	RT	6.0						1		
INCIDENTAL	N/A	N/A	N/A			1					100.0	
	1 "	,	7				$\sim\sim$					

			IC	OT			
	SIDEWALK SO	CHEDULE		PC CONC SIDEWALK 5	DETECTABLE WARNINGS	REMARKS	
ROADWAY	STATION T	O STATION	OFFSET	42400200	42400800		
NOAD WA	SIA II SI	- JIANION	052.	SQ FT	SQ FT		
HARLEM AVE	299+16.30	308+18.88	L	4,588		BEGIN OF SIDEWALK TO RAMP A	
HARLEM AVE	308+13.15	308+18.38	L		10	SOUTH OF RAMP A	
HARLEM AVE	308+16.34	308+21.59	L		10	NORTH OF RAMP A	
HARLEM AVE	308+16.34	309+91.99	L	908		RAMP A TO RR BRIDGE	
HARLEM AVE	313+02.02	316+22.19	L	1,590		RR BRIDGE TO ACCESSS ROAD	
HARLEM AVE	316+15.85	316+22.19	L		14	SOUTH OF ACCESS ROAD	
HARLEM AVE	316+54.32	316+61.45	L		14	NORTH OF ACCESS ROAD	
HARLEM AVE	316+54.32	318+07.55	L	806		ACCESS ROAD TO 95TH BRIDGE	
HARLEM AVE	320+63.89	323+95.80	L	1,823		95TH BRIDGE TO CROSSWALK	
HARLEM AVE	323+90.80	323+95.80	L		10	ACROSS HARLEM AVE, WEST TO MED.	
HARLEM AVE	323+90.80	323+95.80	L/R	75	20	HARLEM MEDIAN	
HARLEM AVE	323+90.80	323+95.80	R		10	ACROSS HARLEM AVE, MED. TO EAST	
HARLEM AVE	323+90.80	324+39.41	R	346		BETWEEN RAMP E & E2	
HARLEM AVE	324+35.65	324+39.41	R		14	SOUTH OF RAMP E	
HARLEM AVE	324+63.88	324+67.64	R		14	NORTH OF RAMP E	
HARLEM AVE	324+61.72	334+41.16	R	5,045		RAMP ETO SE CORNER OF HARLEM & 92 PL	
HARLEM AVE	334+36.16	334+41.16	R		10	SE CORNER OF HARLEM AVE AND 92 PL	
HARLEM AVE	334+36.60	334+52.98	L	131	20	SW CORNER OF HARLEM AVE AND 92 PL	
TOTAL	l			15,312	146		

LONG	LONGITUDINAL JOINT SEALANT SCHEDULE						
				40600370			
ROADWAY	STATION T	O STATION	SIDE	FOOT			
95TH ST. EB	606+46.20	636+13.94	RT	22,258			
95TH ST. WB	606+48.00	636+13.94	LT	25,210			
HARLEM AVE NB	307+05.74	309+45.25	RT	1,437			
HARLEM AVE NB	BRIDGE O	MMISION					
HARLEM AVE NB	312+54.96	318+08.69	RT	3,734			
HARLEM AVE NB	BRIDGE O	MMISION					
HARLEM AVE NB	320+65.56	334+56.82	RT	9,618			
HARLEM AVE SB	307+05.74	309+84.73	LT	2,008			
HARLEM AVE SB	BRIDGE O	MMISION					
HARLEM AVE SB	312+81.25	318+08.69	LT	3,348			
HARLEM AVE SB	BRIDGE O	MMISION					
HARLEM AVE SB	320+65.56	334+56.82	LT	9,707			
RAMP E/G2	20+00.00	25+57.82	RT	1,673			
RAMP G/G2	21+85.21	29+06.54	CL	2,164			
TOTAL				81,159			

FILE NAME =\D160R49_sht_Schedules.dgn	USER NAME = KSUMRAK	DESIGNED - AAF	REVISED - ⚠ 2/23/24 KAS
THE HOH GROUP, INC.		DRAWN - AAF	REVISED -
ARCHITECTS   INGINEERS	PLOT SCALE = N/A	CHECKED - BAP	REVISED -
PN: 3730	PLOT DATE = 11/30/2023	DATE -	REVISED -

STATI	E 01	FILLINOIS
DEPARTMENT	0F	TRANSPORTATION

							SECTION		"
SCHEDULE OF QUANTITIES							3128-Z-I-R&R\$	3	С
									С
SCALE: NTS	SHEET NO.	6 OF	9 SHEETS	STA. N/A	TO STA. N/A		ILLING	NS FED. A	ID PRO

#### MAINTENANCE OF TRAFFIC GENERAL NOTES

- 1. ALL EXISTING RAISED REFLECTIVE PAVEMENT MARKER REFLECTORS LOCATED WITHIN TEMPORARY LANE CLOSURE TAPERS, LANE SHIFT TAPERS OR IN LOCATIONS THAT CONFLICT WITH THE TEMPORARY PAVEMENT MARKING TAPE USED FOR STAGING SHALL BE REMOVED IF THE STAGING WILL REMAIN IN PLACE FOR MORE THAN 14 DAYS. THE EXISTING RAISED REFLECTIVE PAVEMENT MARKER REFLECTORS THAT WERE REMOVED SHALL BE RESTORED AFTER THE COMPLETION OF THE STAGING UNLESS THE RAISED REFLECTIVE PAVEMENT MARKER IS TO BE FULLY REMOVED.
- 2. ALL EXISTING PAVEMENT MARKINGS IN CONFLICT WITH THE PAVEMENT MARKING TAPE, TYPE IV (AND/OR MODIFIED URETHANE) USED FOR STAGING SHALL BE REMOVED. THIS WORK SHALL BE PAID FOR AS "PAVEMENT MARKING REMOVAL-GRINDING"WITHIN THE PROJECT LIMITS.
- 3. PAVEMENT MARKING TAPE, TYPE IV (AND/OR TYPE III) SHOWN ON THE PLANS FOR ANY CONSTRUCTION STAGE THAT THE CONTRACTOR PROPOSES TO EXTEND OVER THE WINTER PERIOD SHALL MEAN MODIFIED URETHANE PAVEMENT MARKING AND WILL BE PAID FOR THEIR RESPECTIVE CONTRACT UNIT PRICE.
- 4. DROP-OFFS ADJACENT TO THE TRAVEL LANE SHALL BE KEPT TO A MINIMUM. PROTECTION OF THE DROP-OFF SHALL BE ACCORDING TO THE IDOT BUREAU OF SAFETY PROGRAMS AND ENGINEERING, SAFETY ENGINEERING POLICY MEMORANDUM 4-21. TEMPORARY CONCRETE BARRIER WALL IS SHOWN ON THE PLANS WHERE THE DROP-OFF REQUIREMENTS FOR USING BARRICADES CANNOT BE MET. THE CONTRACTOR SHALL BE RESPONSIBLE FOR ENSURING THAT THE DROP-OFFS ALONG THE REMAINING AREAS MEET THE OFFSET, HEIGHT, AND DURATION REQUIREMENTS TO USE BARRICADES. THIS MAY REQUIRE THE CONTRACTOR TO REPLACE OR PLACE SUFFICIENT MATERIAL IN THE EXCAVATION TO REDUCE THE DROP-OFF TO BE COMPLIANT WITH THE REQUIREMENTS FOR USE OF BARRICADES. NO ADDITIONAL COMPENSATION SHALL BE ALLOWED TO COMPLY WITH THIS REQUIREMENT.
- 5. WHEN WORKING ADJACENT TO THE ROAD AND UTILIZING DAILY LANE CLOSURES, DROP-OFFS ADJACENT TO THE TRAVEL LANES SHALL BE KEPT TO A MINIMUM. DROP-OFFS REATER THAN (OR GREATER THAN OR EQUAL TO) 12" WILL NOT BE ALLOWED AT LOCATIONS WHERE THE DROP-OFF IS LOCATED WITHIN 8 FT OF THE EDGE OF THE TRAVEL LANE. THE CONTRACTOR WILL BE REQUIRED TO PERFORM THE EXCAVATION REQUIRED FOR THE CONSTRUCTION DURING THE TIME THAT THE ADJACENT LANE IS CLOSED. AS NOTED ABOVE, PRIOR TO REOPENING THE LANE TO TRAFFIC THE CONTRACTOR SHALL PLACE SUFFICIENT MATERIAL TO REDUCE THE DROP-OFF TO LESS THAN 12". THE CONTRACTOR SHALL BE RESPONSIBLE TO DETERMINE THE AMOUNT OF WORK THAT CAN BE COMPLETED WITHIN THE TIME OF THE DAILY LANE CLOSURE. NO ADDITIONAL COMPENSATION SHALL BE ALLOWED TO COMPLY WITH THIS REQUIREMENT.
- 6. THE "ROAD CONSTRUCTION AHEAD" SIGNS SHALL REMAIN INSTALLED UNTIL THE COMPLETION OF THE PROJECT OR WHEN NO ROADWAY HAZARDS REMAIN WITHIN THE WORK ZONE.
- 7. CHANGEABLE MESSAGE SIGNS SHALL BE INSTALLED TWO WEEKS PRIOR TO ALL ROAD CLOSURE, TRAFFIC STAGE CHANGES, AND NEW TRAFFIC SIGNAL TURN-ON EVENTS ON EACH APPROACH OF THE EFFECTED ROADWAY TO WARN MOTORISTS OF THE UPCOMING EVENT. THE SIGNS SHALL BE REMOVED TWO WEEKS THEREAFTER UNLESS THE SIGNS ARE NEEDED AGAIN FOR A SUBSEQUENT FUTURE EVENT THAT WILL OCCUR WITHIN 2 WEEKS ON THE SAME APPROACH OF THE EFFECTED ROADWAY. THE SIGN LOCATIONS SHALL BE (DETERMINED BY THE ENGINEER) PLACED AS DIRECTED BY THE ENGINEER.

8. ALL TEMPORARY BARRIER WALLS ON THE HARLEM OVER 95TH STREET BRIDGE AND HARLEM OVER CSX RAILROAD BRIDGE SHALL BE PINNED TO THE DECK ACCORDING TO STANDARD R-27 AND AS DETAILED ON SHEETS 413 FOR THE CSX BRIDGE AND 475 FOR THE 95TH STREET BRIDGE.

REVISED SHEET 2/27/2024

THE HOH GROUP, INC.

ARCHITECTS | BNGINEERS

PN: 3730

PLOT DATE = 11/30/2023

DESIGNED - AAF

REVISED - ⚠ 02/23/24 BAP

REVISED - ⚠ 02/23/24 BAP

REVISED - ...

REVISED - ...


STATE OF ILLINOIS
DEPARTMENT OF TRANSPORTATION

SCALE: NTS

 
 MAINTENANCE OF TRAFFIC GENERAL NOTES
 F.A.P. RTE. 29 & 348
 SECTION
 COUNTY
 TOTAL SHEETS
 SHEETS NO.

 29 & 348
 3128-Z-I-R&RS
 COOK
 659
 161A

 CONTRACT NO. 60R49

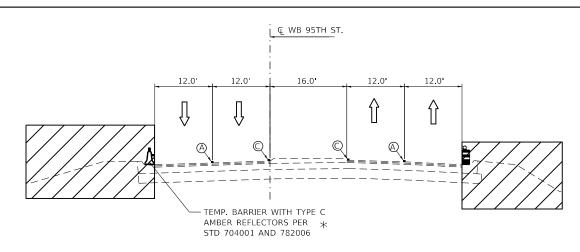

### 95TH STREET - STA. 615+00-STAGE 3


(LOOKING EAST)

#### **PAVEMENT MARKING LEGEND**

- 4" WHITE LINE-(30' SKIP, 10' DASH)
- 4" WHITE LINE-SOLID
- 3 4" YELLOW LINE-SOLID
- 4" YELLOW LINE-DOUBLE SOLID 11" C-C
- 6" WHITE LINE-SOLID
- 4" WHITE LINE-SKIP DASH (6' SKIP, 2' DASH)
- (A) EXIST. 4" WHITE LINE-(30' SKIP, 10' DASH)
  (B) EXIST. 4" WHITE LINE-SOLID
  (C) EXIST. 4" YELLOW LINE-SOLID


#### \* NOTE:

PER STANDARD 704001, TYPE C REFLECTOS ARE TO BE PLACED EVERY 25 FT ON TEMPORARY CONCRETE BARRIER (TCB). THE COST OF TYPE C RELFECTORS ON TCB SHALL BE INCLUDED IN THE COST OF TCB FOR ALL TCB'S.

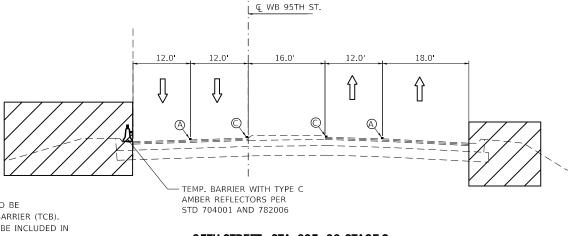


### 95TH STREET - STA. 625+00-STAGE 2

(LOOKING EAST)

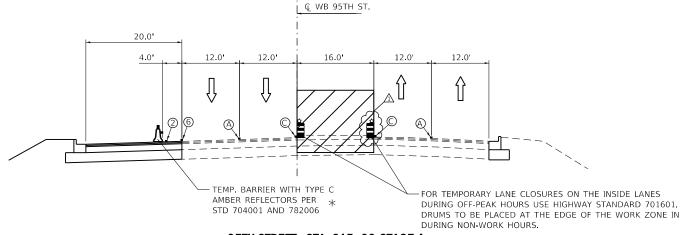


## 95TH STREET - STA. 615+00-STAGE 4

(LOOKING EAST)

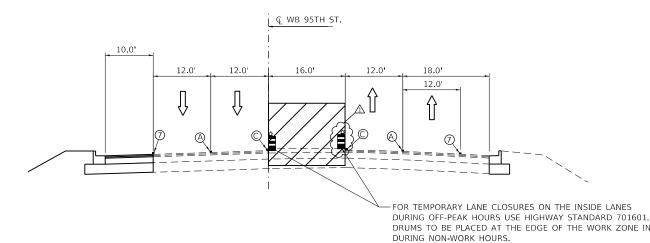


# 95TH STREET - STA. 625+00-STAGE 4

(LOOKING EAST)

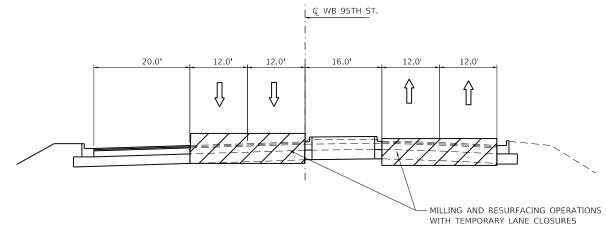

#### 95TH STREET - STA. 615+00-STAGE 5

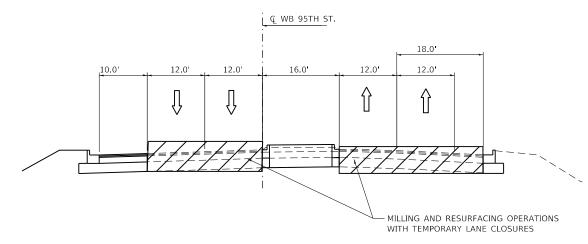

### 95TH STREET - STA. 625+00-STAGE 5


# 1 REVISED SHEET 2/27/2024


FILE NAME =\D160R49_sht_StagIng_Typ.DGN	USER NAME = KSUMRAK	DESIGNED - AAF	REVISED - 1 02/23/24 BAP	Γ
THE <b>HOH</b> GROUP, INC.		DRAWN - AAF	REVISED -	ı
ARCHITECTS   ENGINEERS	PLOT SCALE = N/A	CHECKED - BAP	REVISED -	ı
PN: 3730	PLOT DATE = 11/30/2023	DATE -	REVISED -	

STATI	E OF	- ILLINOIS	
DEPARTMENT	0F	TRANSPORTATION	

SCALE: NTS

MAINTENANCE OF TRAFFICE	F.A.P. RTE	SECTION	COUNTY	TOTAL SHEETS	SHEET NO.
TYPICAL SECTIONS - 95TH ST	29 & 348	3128-Z-I-R&RS	соок	659	162B
TITIOAL DEGITORS - 33111 01			CONTRAC	T NO. 60	0R49
SHEET NO. 3 OF 5 SHEETS STA. N/A TO STA. N/A		ILLINOIS FED. A	ID PROJECT		

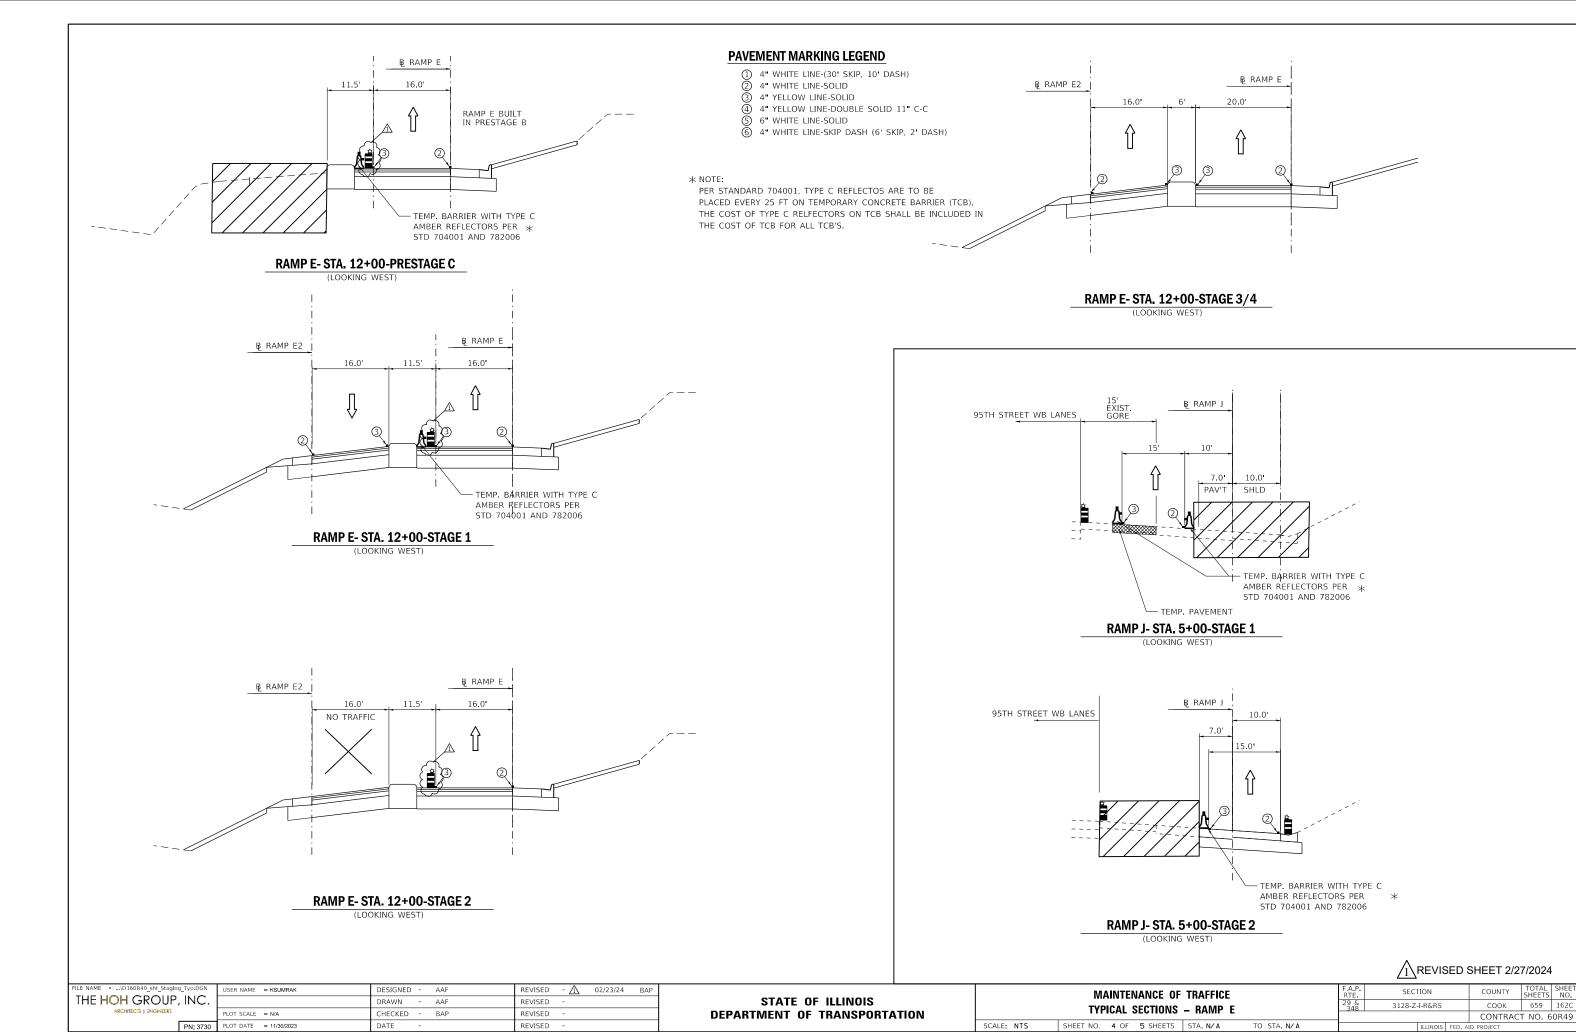


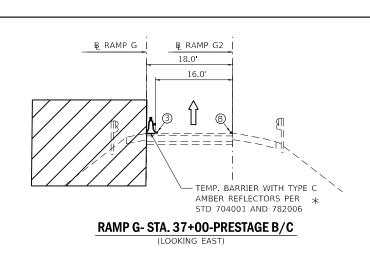

₽ RAMP G ; ₽ RAMP G2 18.0 TEMP. BARRIER WITH TYPE C — \* AMBER REFLECTORS PER STD 704001 AND 782006

MILLING AND RESURFACING OPERATIONS DURING OFF PEAK HOURS ONLY (PERFORM BEFORE STAGE 1)

# RAMP G- STA. 37+00-PRESTAGE B/C (SUBSTAGE)

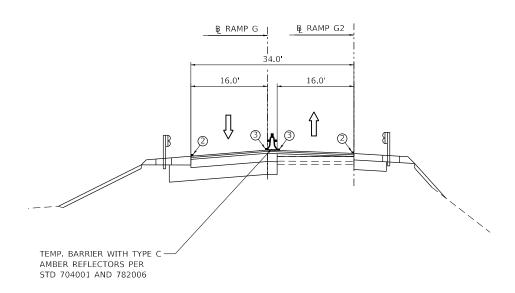

#### **PAVEMENT MARKING LEGEND**

1 4" WHITE LINE-(30' SKIP, 10' DASH)
2 4" WHITE LINE-SOLID
3 4" YELLOW LINE-SOLID
4 4" YELLOW LINE-DOUBLE SOLID 11" C-C
5 6" WHITE LINE-SOLID
6 4" WHITE LINE-SKIP DASH (6' SKIP, 2' DASH)


(7) 8" WHITE LINE-SOLID

(A) EXIST. 4" WHITE LINE-(30' SKIP, 10' DASH)
(B) EXIST. 4" WHITE LINE-SOLID

© EXIST. 4" YELLOW LINE-SOLID

#### \* NOTE:

PER STANDARD 704001, TYPE C REFLECTOS ARE TO BE PLACED EVERY 25 FT ON TEMPORARY CONCRETE BARRIER (TCB). THE COST OF TYPE C RELFECTORS ON TCB SHALL BE INCLUDED IN THE COST OF TCB FOR ALL TCB'S.

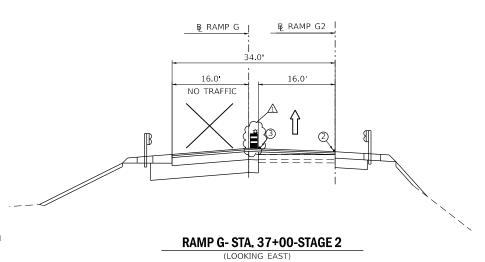

₽ RAMP G | ₽ RAMP G2 18.0

RAMP G- STA. 37+00-STAGE 3

(LOOKING EAST)

RAMP G- STA. 37+00-STAGE 1


REVISED SHEET 2/27/2024


FILE NAME =\D160R49_Sht_Staging_Typ.DGN	USER NAME = KSUMRAK	DESIGNED - AAF	REVISED -1 02/23/24 BAP	l
THE HOH GROUP, INC.		DRAWN - AAF	REVISED -	1
ARCHITECTS   ENGINEERS	PLOT SCALE = N/A	CHECKED - BAP	REVISED -	
PN: 3730	PLOT DATE = 11/30/2023	DATE -	REVISED -	L


STATE OF ILLINOIS	
DEPARTMENT OF TRANSPORTATION	


SCALE: NTS


						7				
MAINTE	NANCE OF	TRAFFICE	F.A.P. RTE	SEC	TION		COUNTY	TOTAL SHEETS	SHEET NO.	
TYPICAL	29 & 348	3128-Z	-I-R&RS		соок	659	162D			
IIIIOAL	SECTIONS	- IIAWII U						CONTRAC	T NO. 6	0R49
SHEET NO. 5 OF	5 SHEETS	STA. N/A	TO STA. N/A			ILLINOIS	FED. A	ID PROJECT		

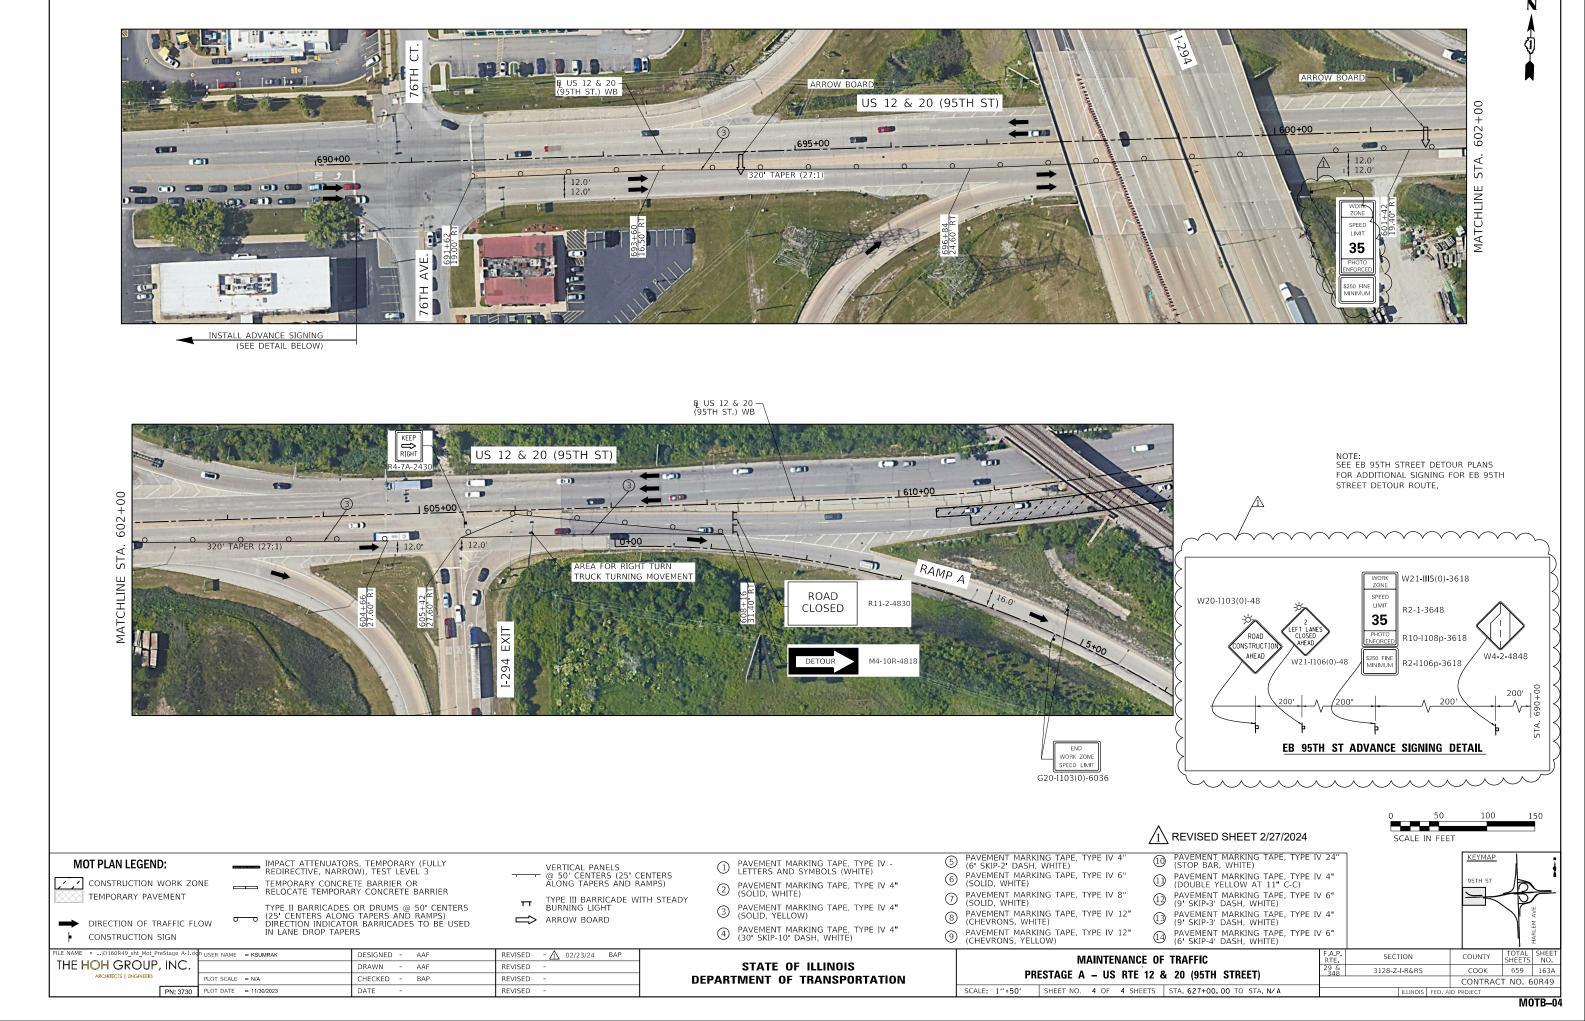


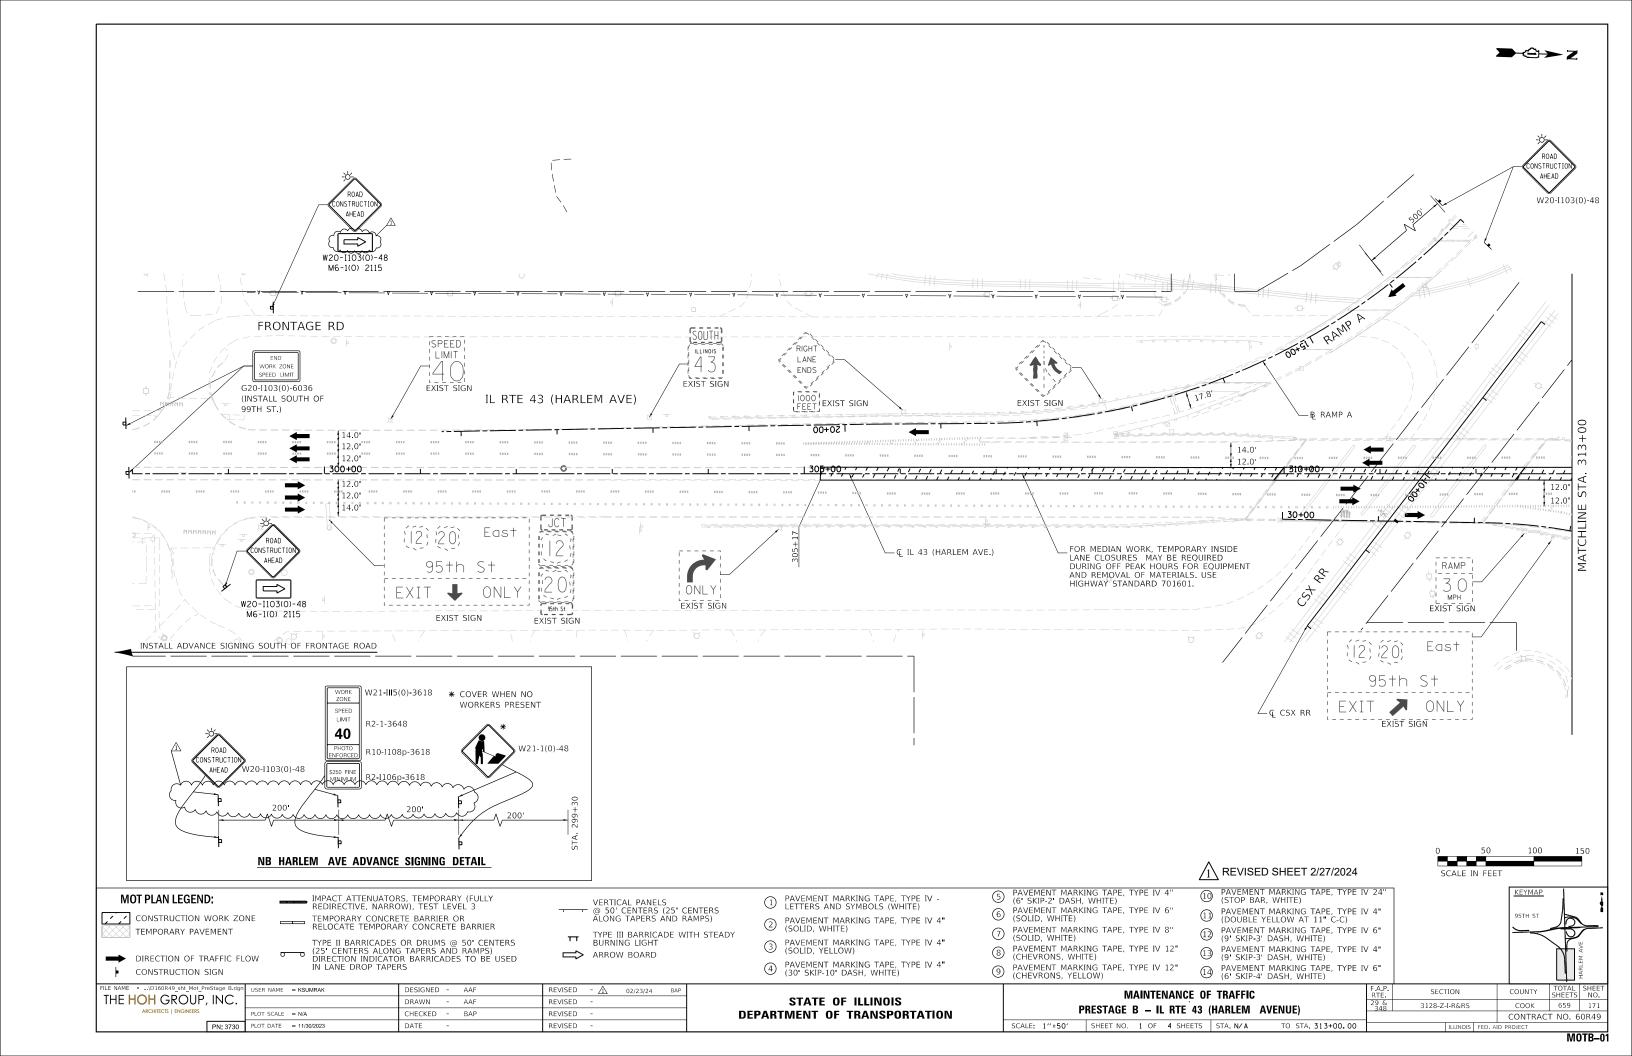


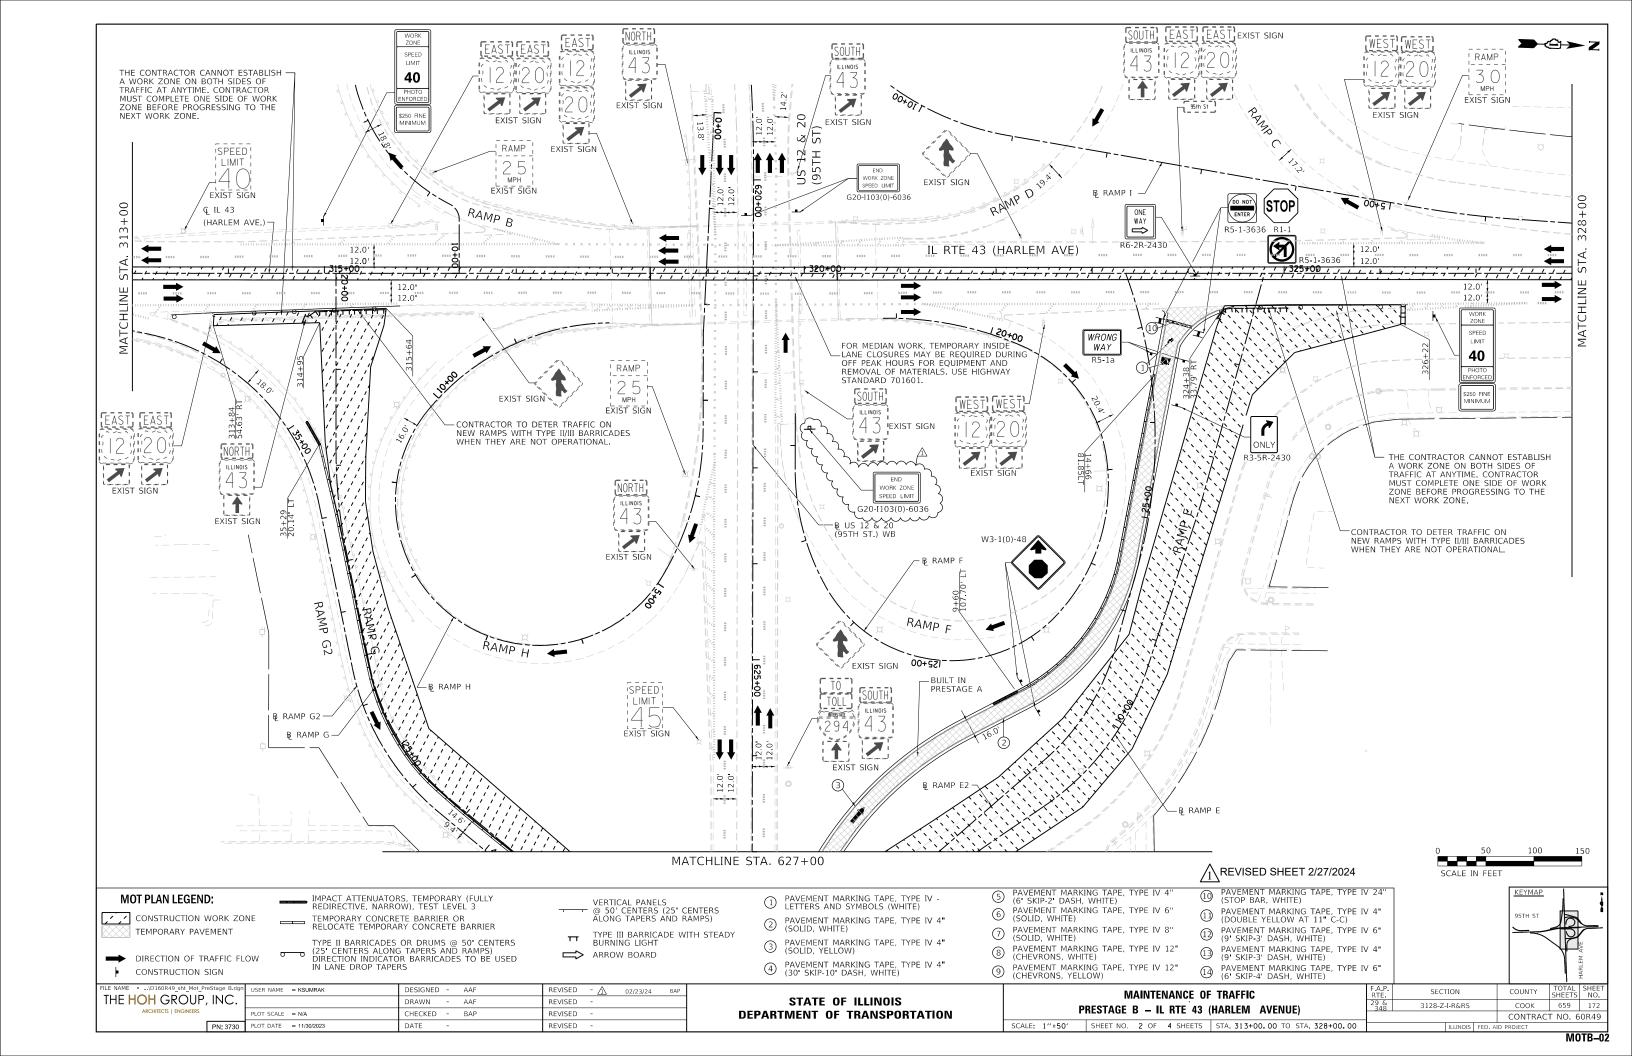


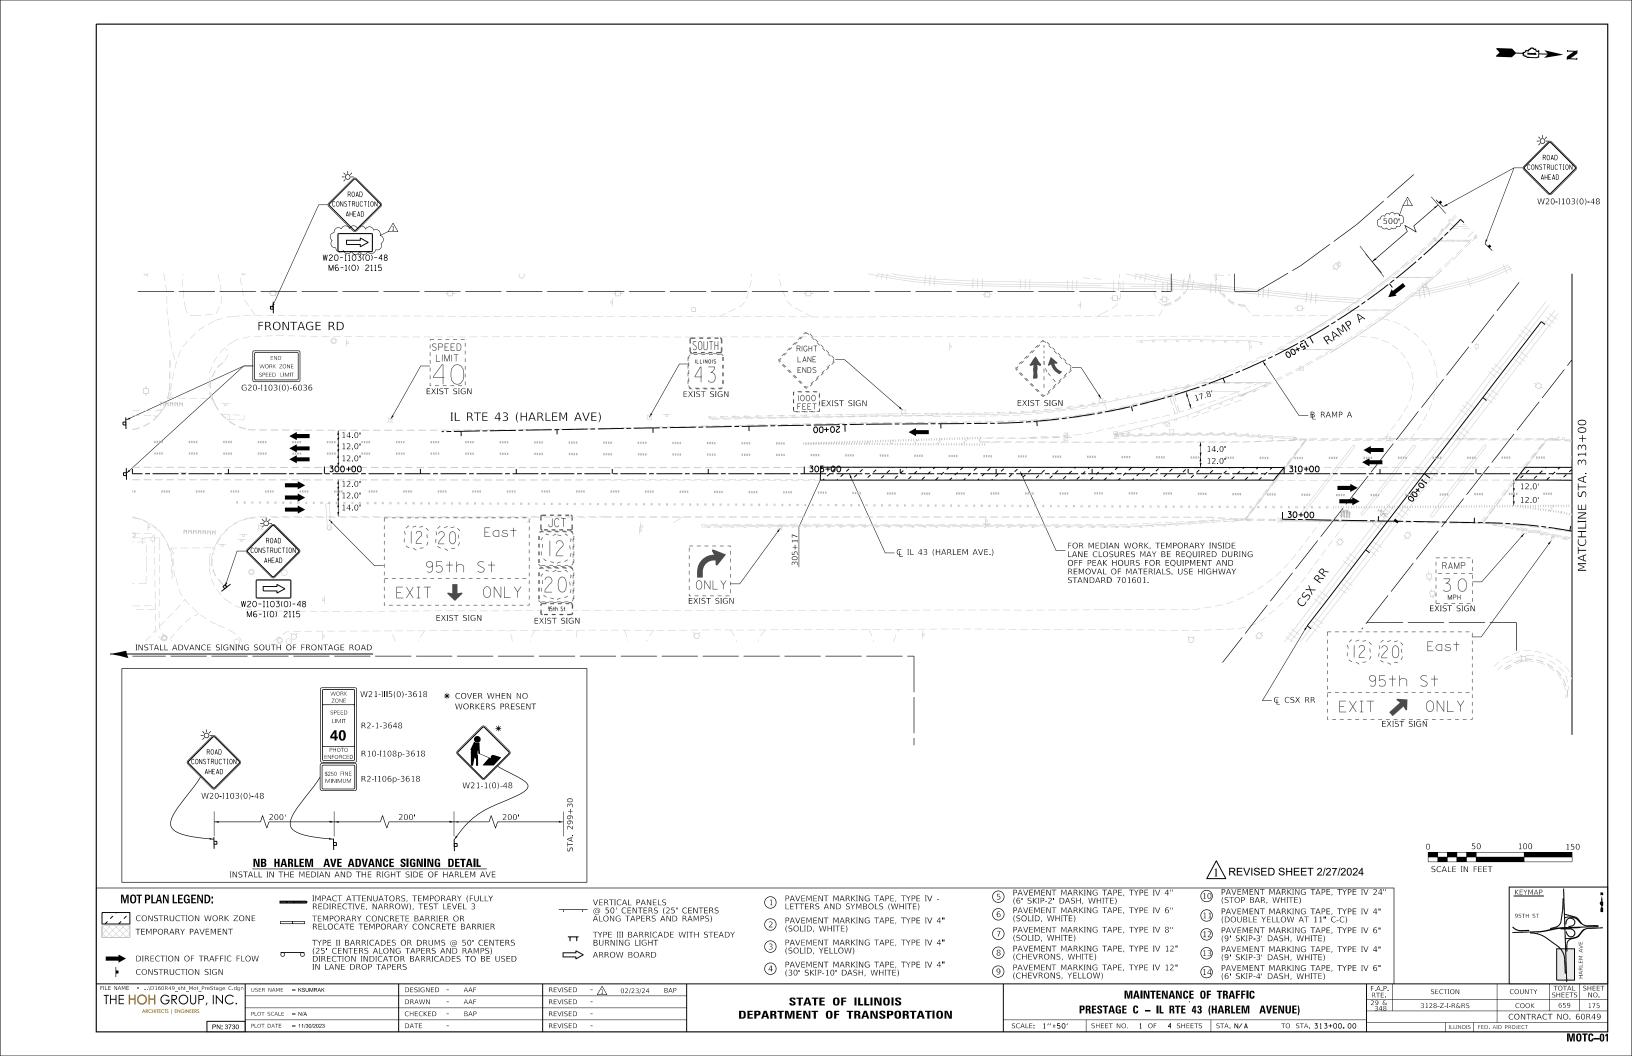


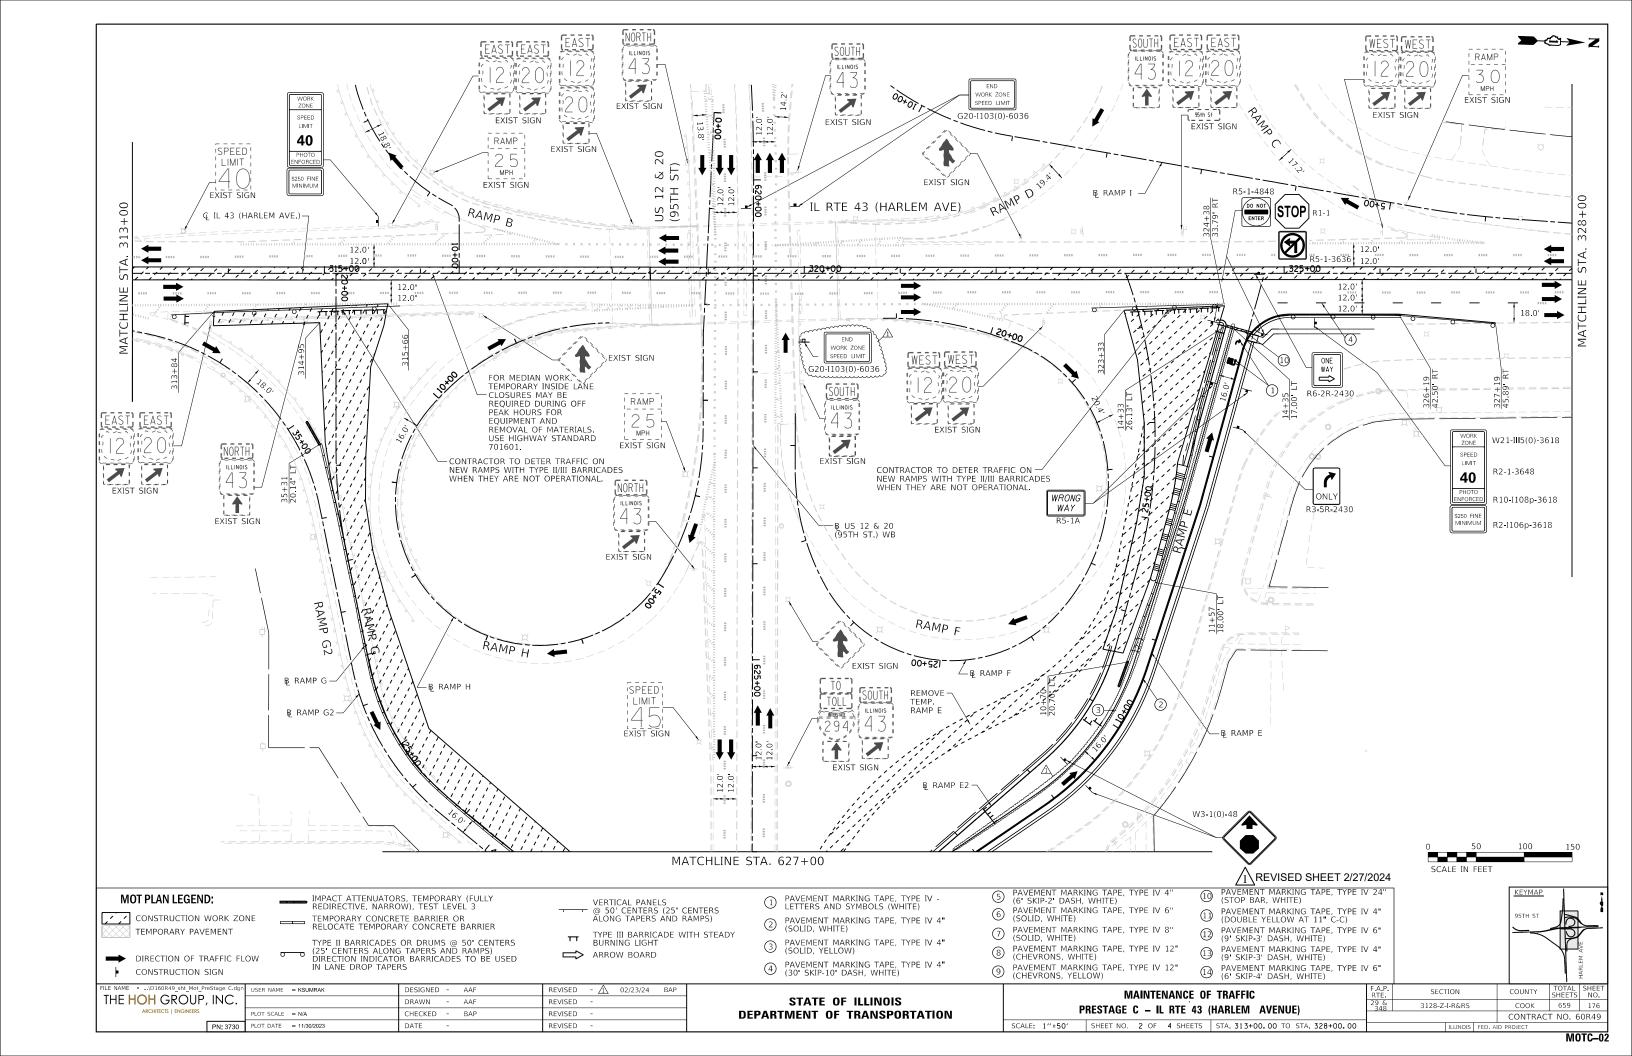

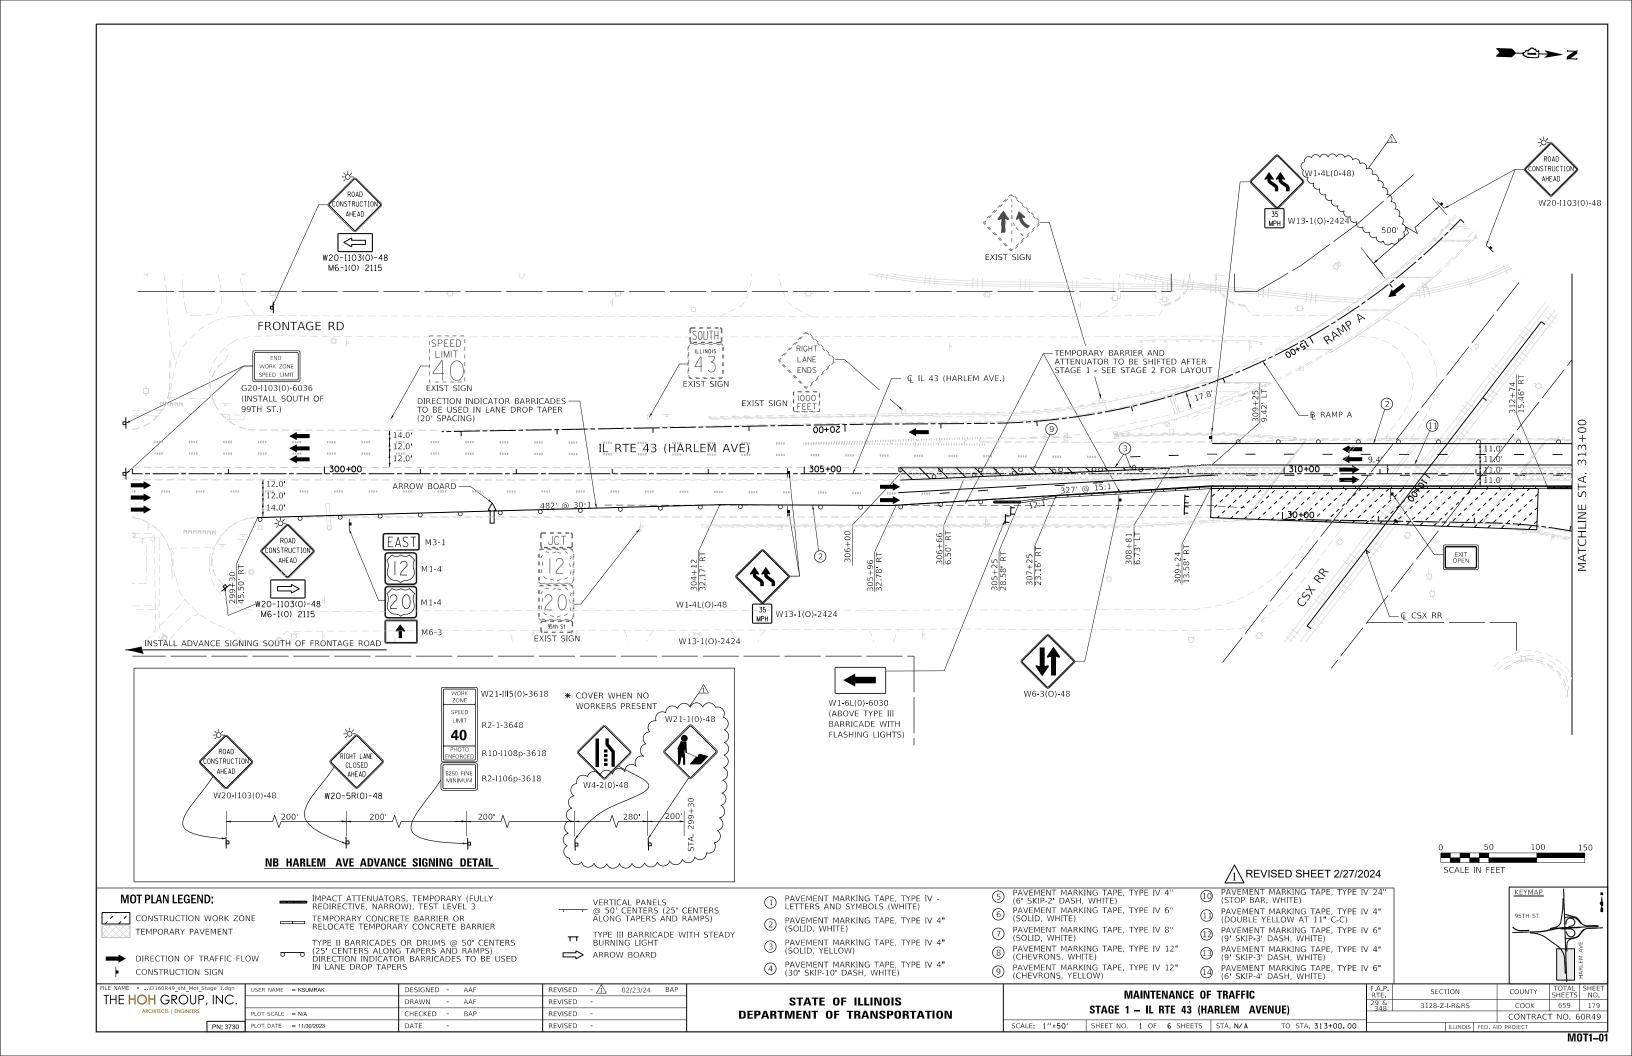

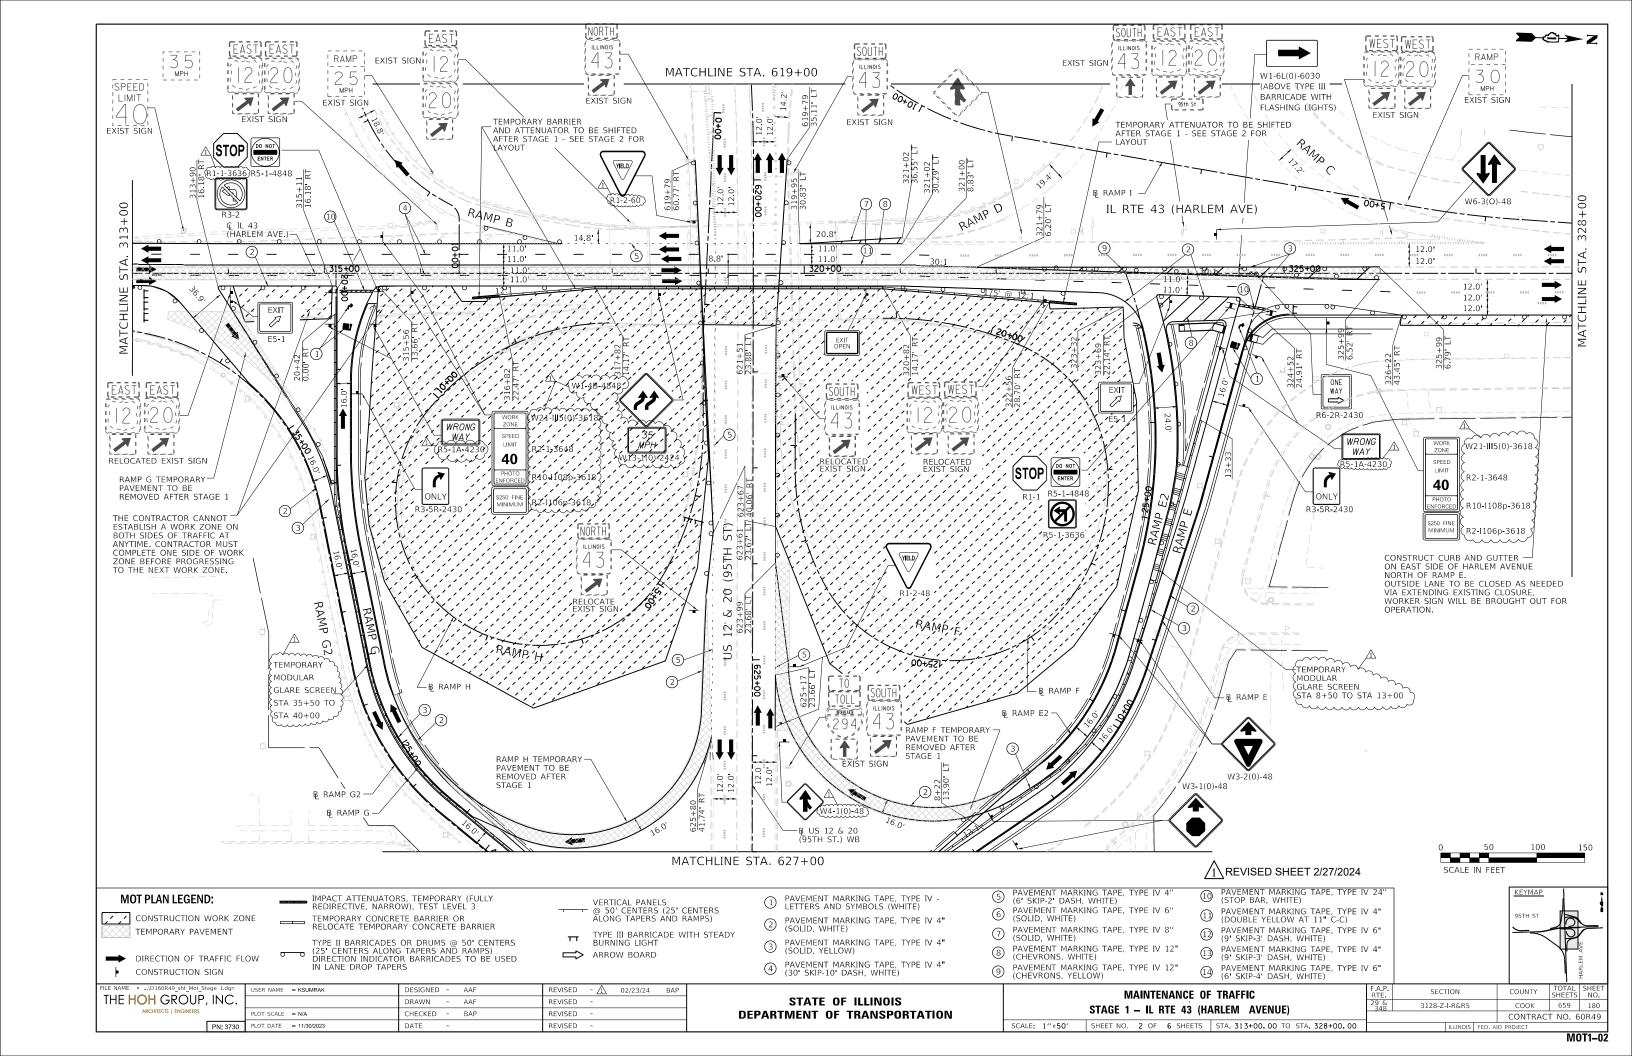

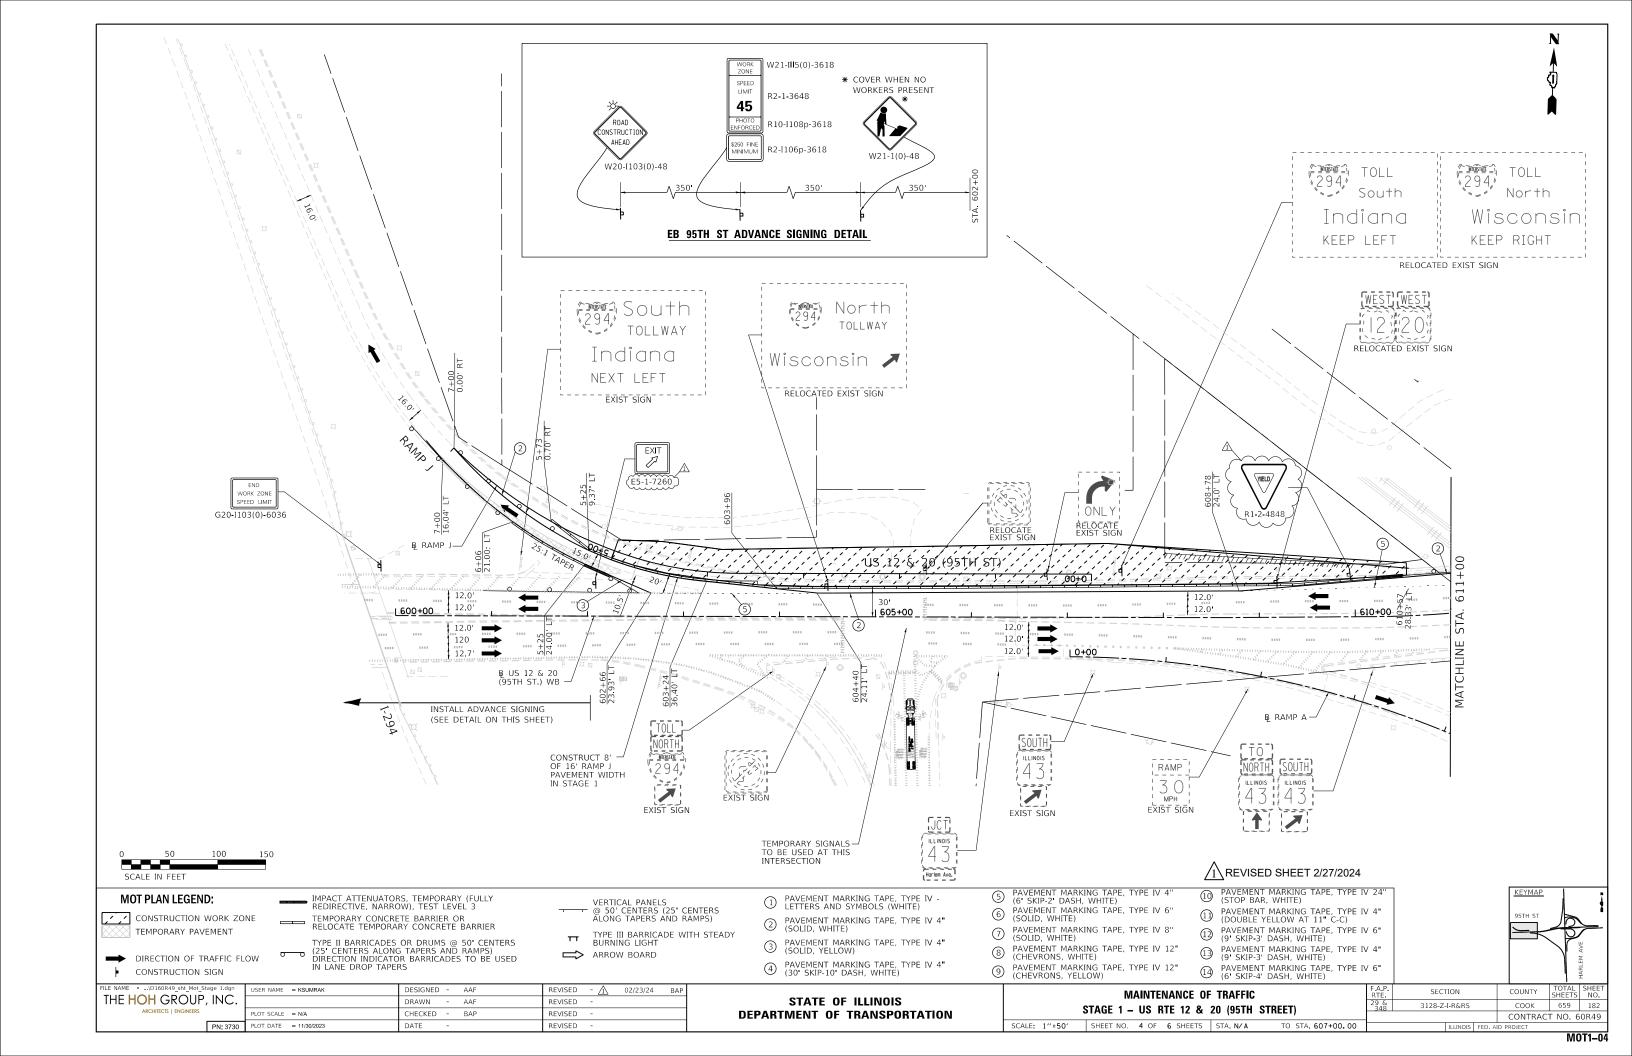

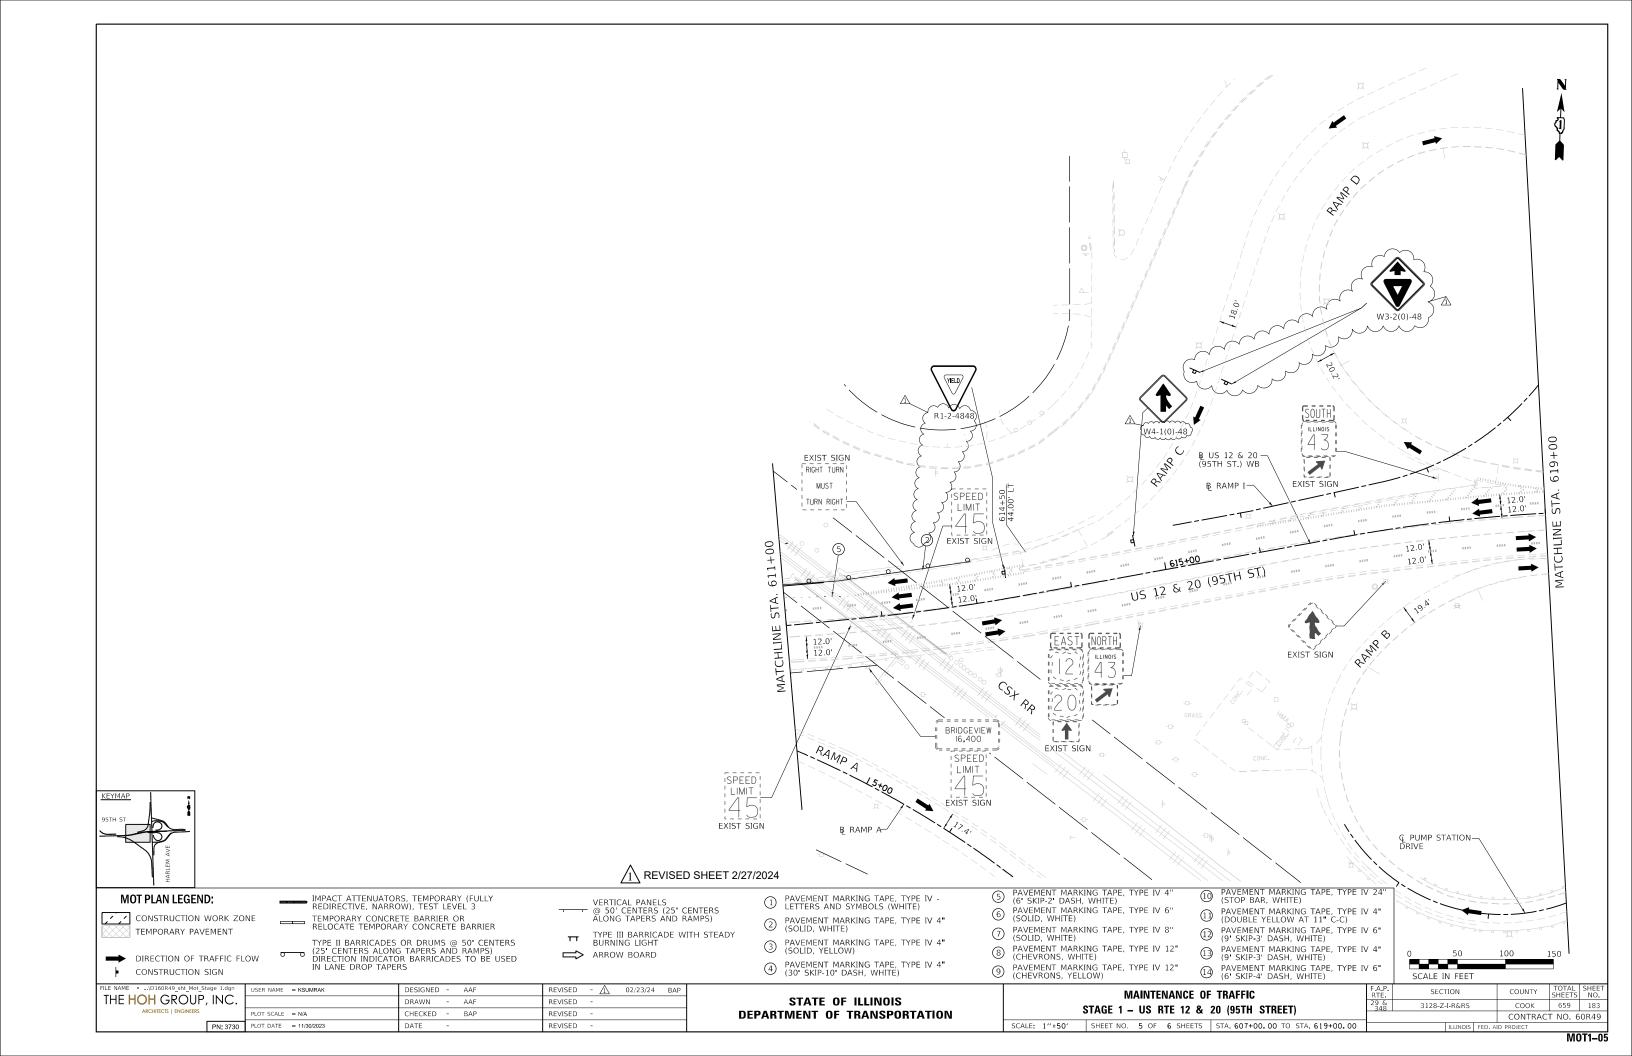


														i			FLARED END SEC		$\sim$	PRC FLAR EVD	
		STO			JRES FLARED	END SECTIONS					PRC FLAR END SEC 12	PRC FLAR END SEC 15	PRC FLAR END SEC 18	PRC FLAR END SEC 21	PRC FLAR END SEC 24	PRC FLAR END SEC 30	SEC 36	PRC FLAR END SEC 42	(SPECIAL)	SEC 48 (SPECIAL)	542001 60
ROADWAY	STRUCT. NO.	STATION	(FT)	SIDE	STRUCTURE	DIA. (IN)	INVER	DIR	INVER FLEV	DIR	54213657	54213660 FACH	54213663	54213666 FACH	54213669 FACH	54213675 FACH	54213681 EACH	54213687 FACH	X1200108	TBD BY IDOT	5426166 EACH
95TH ST.	F200	604+10.0	73.0	L	FES	12	599.00	N N	ELEV.	DIR.	1	EACH	EACH	EACH	- EACH	- EACH	- EACH	- EACH	EACH	- EACH	EACH
95TH ST.	F201	604+68.3	77.5	ī	FES	15	597.60	N			-	1	-	-	-	-	-			-	-
95TH ST.	F203	605+10.0	82.0	L	FES	30			596.90	W		-	-		-	1	-				-
95TH ST.	F204	605+47.0	82.0	L	FES	30	596.30	E			-	-	-	-	-	1	-			-	-
95TH ST.	F202	606+46.4	83.7	L	FES	12	595.50	N			1	-	-		-	-	-	-		-	
95TH ST.	F206	607+70.0	74.9	L	FES	15	594.67	N			-	1	-		-	-	-	-		-	-
95TH ST.	F208A	609+79.5	64.1	L	CES	60			588.65	E	-	-	-	-	-	-	-	-		-	1
95TH ST.	F207	609+22.0	67.6	L	FES	15	589.19	N				1	-		-		-			-	-
95TH ST.	F351	614+87.3	112.8	L	FES	24	586.00	SE				-	-		1	-	-				
95TH ST.	F225	615+98.1	93.1	L	FES	15	585.00	N			-	1	-		-		-			-	-
95TH ST.	F225A	615+98.0	96.3	L	FES	15	500.30	S	584.50	N		1	-	-				-			<u> </u>
95TH ST.	F231B F230	617+69.0 619+57.0	83.1 98.9	R	FES FES	15 15	589.30 589.50	SW	_	_	-		-	-	-	-	-	-		-	_
95TH ST.	F230 F229A	622+47.2	82.3	R	FES	12	596.00	SE			1	1	-	-	- :	- :	- :	- :		<u> </u>	-
95TH ST.	F234	625+06.0	62.2	R	FES	15	596.60	S			1 1	1		<u> </u>	<u> </u>	<u> </u>	<u> </u>			<u> </u>	T.
95TH ST.	F241	625+29.0	45.5	ı.	FES	15	596.70	N				1			-	-		-		-	-
95TH ST.	F300	626+01.0	66.8	L	FES	36	330.73	- "	596.10	N	-	1	-				1				
95TH ST.	F302	626+03.5	141.9	R	FES	36			595.50	SE			-				1				
95TH ST.	F242	626+34.0	46.7	L	FES	12	596.70	N			1	-	-				-	-			-
95TH ST.	F243	627+34.0	55.0	L	FES	15	597.70	N			-	1	-								-
HARLEM AVE	F104	313+25.0	48.9	L	FES	15	626.10	W			-	1	-		-	-	-			-	-
HARLEM AVE	F117	314+87.0	58.1	R	FES	12	622.50	SE			1	-	-		-		-			-	-
HARLEM AVE	F105	314+86.0	55.1	L	FES	15	615.50	SW		_	-	1	-				-			· ·	<u> </u>
HARLEM AVE	F118	316+32.0	65.4	R	FES	15	617.10	SE			-	1	-	- :		- :		- :		-	-
HARLEM AVE	F106 F107	316+68.0 318+00.0	75.3 71.3	R	FES FES	15 15	618.10 613.20	W	_	_	<u> </u>	1	-		-	· ·	-	<u> </u>		<u> </u>	<u> </u>
HARLEM AVE	F107	321+90.0	64.6	L	FES	15	610.00	w			-	1	-	-	-	-	-	-		-	
HARLEM AVE	F110	323+55.0	74.4	i	FES	15	608.00	w				1		- :	- :	- :	-			- :	<del></del>
HARLEM AVE	F120	323+28.0	79.5	R	FES	12	605.00	SW			1	1 :									
HARLEM AVE	F112	324+48.0	64.2	L	FES	15	608.00	w			-	1	-	-	-	-	-			-	-
HARLEM AVE	F122	324+21.0	70.3	R	FES	15	604.90	SW			-	1	-		-	-	-			-	-
HARLEM AVE	F123	325+76.9	75.0	R	FES	12	608.26	E			1			-	-			-		-	-
HARLEM AVE	F124	326+69.8	70.1	R	FES	12	608.58	E			1	-	-	-	-	-	-	-		-	-
HARLEM AVE	F125	327+88.0	70.5	R	FES	12	608.54	E			1	-	-		-	-	-	-		-	-
HARLEM AVE	F126	329+03.5	68.5	R	FES	12	608.50	E			1	-	-	-	-		-			-	-
HARLEM AVE	F127	330+18.7	66.3	R	FES	12	608.76	E			1	-	-		-		-				
HARLEM AVE	F133	333+38.5	68.4	R	FES	12	608.78	E			1	-	-		-		-				-
RAMP E	F404	10+73.0	57.5	L	FES	18	599.60	SW					1								-
RAMPE	F404	10+/3.0	37.3	-	FES	18	599.00	244			<u> </u>	<del>-</del>		-	-	-		<u> </u>		<u> </u>	
RAMP F	F102A	19+72.2	110.6	R	FES	24			594.50	NE			-		1						
		20.722		<u> </u>																	
RAMP H	F157A	4+45.0	76.8	R	FES	18			594.50	NW	-		1					-			-
RAMP H	F157	7+59.7	104.8	R	FES	18			594.50	SW	-	-	1		-	-	-	-			-
RAMP I	F153	6+89.7	53.7	R	FES	21	604.50	SW			-		-	1							-
RAMP I	F156A	11+46.7	27.4	R	FES	30	586.40	NW			-	-	-	-	-	1	-	-			-
RAMP I	F352	12+58.4	155.8	R	FES	24	586.20	SW		-	-	-	-	-	1	-	-	-		-	-
	H		H	-				-		-						<u> </u>					$\leftarrow$
RAMP J	F199	3+25.6	30.0	R	FES	30	599.25	E			-	<u> </u>	-		-	1	-			· ·	-
ACCESS ROAD	F360	13+29.8	101.9	R	FES	42	E70 FC	NE	-		-		-	-		-		<b>—</b> ,			
ACCESS ROAD	F358 (1)	13+29.8 15+55.5	39.1	R	FES (1)	42	579.50	INE.	576.20	w	- :	<u> </u>	- :	- :	-	- :	-	1		1	<del></del>
ACCESS ROAD	F359	14+83.9	113.00	R	FES (1)	15			574.60	E		1							1	<u> </u>	
		14103.3	113.00	<u> </u>	1.23	1.5			374.00	_									<u> </u>		
TOTAL											12	20	3	1	3	4	2	1	1	1	1
														~~~~	~~~	~~~					
NOTES:		DETAIL, PAID FOR ECTION IS A MODI RD 542541.					FES = FLARED CES = CONCR			го ірот:	STANDARD 54200	01	FOR INLET BO	(SPECIAL) SEE DI	ETAIL ON SHEETS	2335,2330					


			ı	DOT			
GENERAL	DRAINAGE PAY I	TEMS	EXPLORATION TRENCH 48" DEPTH	PROPOSED STORM SEWER CONNECTION TO EXISTING STORM SEWER (1)	ELASTOMERIC CHECK VALVE 12" DIAMETER (2)	REMARKS	
ROADWAY	STATION	OFFSET	21301048	X5420112			
RUADWAT	SIATION	OFFSET	FOOT	EACH	EACH		
VARIES	VARIES	VARIES	100				
RAMP G2	33+33.2	85.4' RT		1		JC MH1	
95T-I ST.	622+47.2	82.2' RT			1	END OF PIPE 229A	
RAMP G2	33+46.61	92.2' RT			1	END OF PIPE 703	
TOTAL			100	1	2		
NOTE							
(1) SEE GEI	NERAL NOTE NO. 1	2 (SHEET 2)					
(2) REFER	TO DRAINAGE DETA	AILS					


STATE OF ILLINOIS
DEPARTMENT OF TRANSPORTATION


SCALE: NTS SHEET NO. 4 OF 11 SHEETS STA. N/A TO STAND


$\sqrt{1}$	\ R	EVISED SHEE	T 2/27	/202	4
	F.A.P. RTE.	SECTION	COUNTY	TOTAL SHEETS	SHEET NO.
	29 & 348	3128-Z-I-R&RS	соок	659	214
			CONTRAC	T NO. 6	0R49
		ILLINOIS FED. A	ID PROJECT		

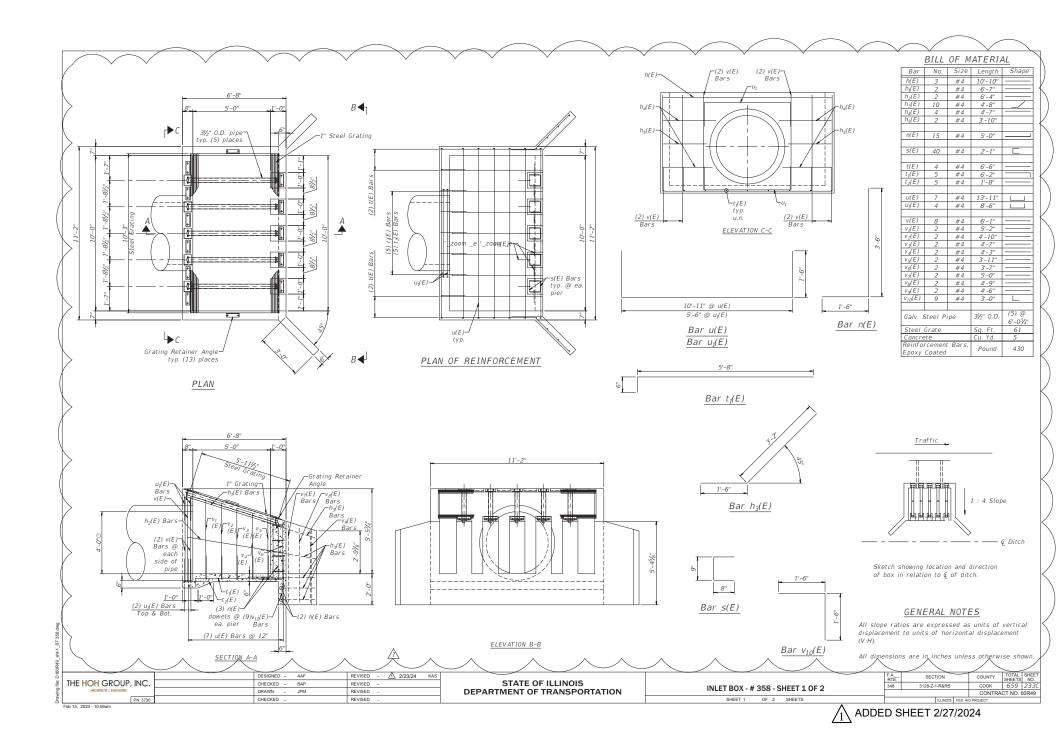


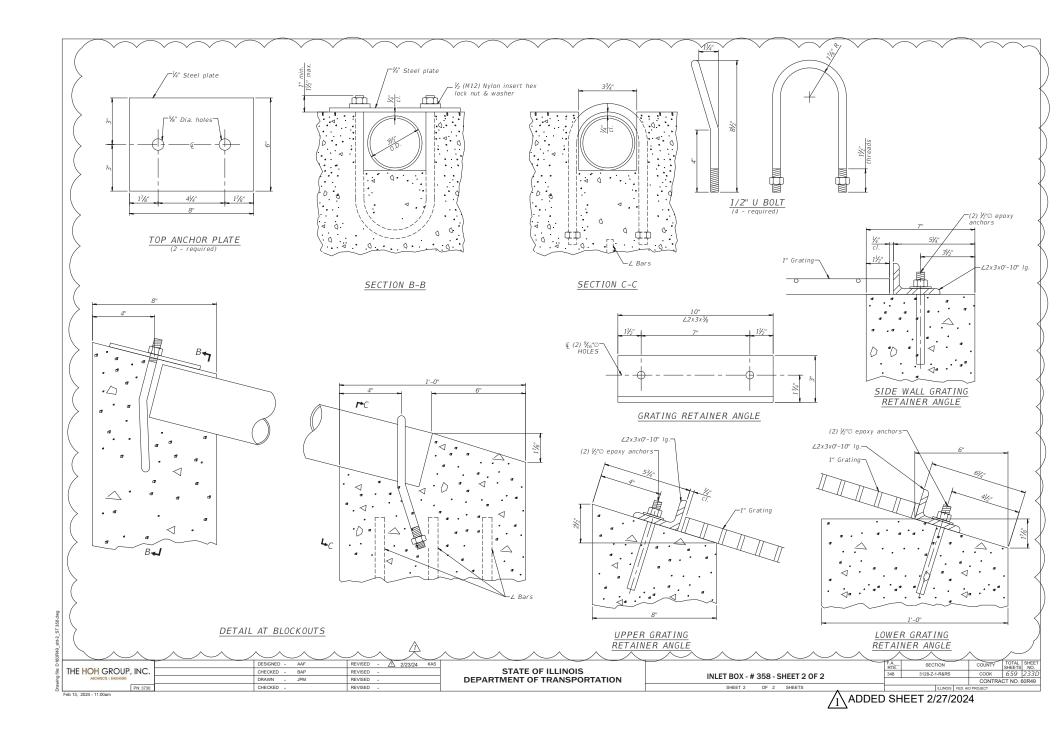

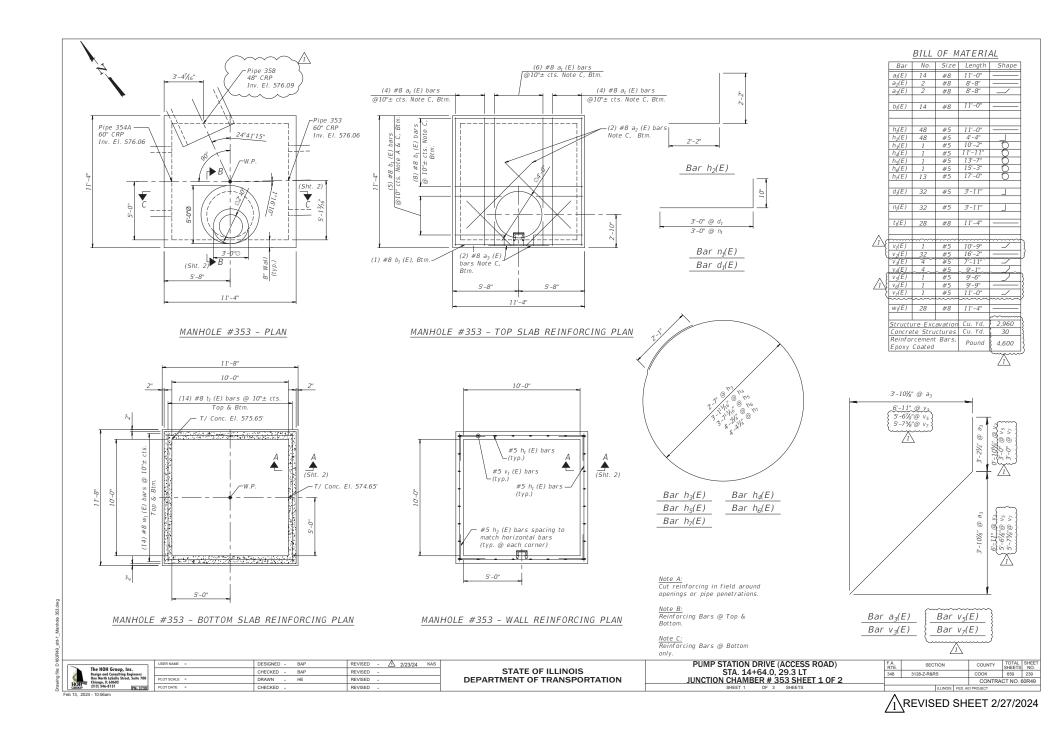


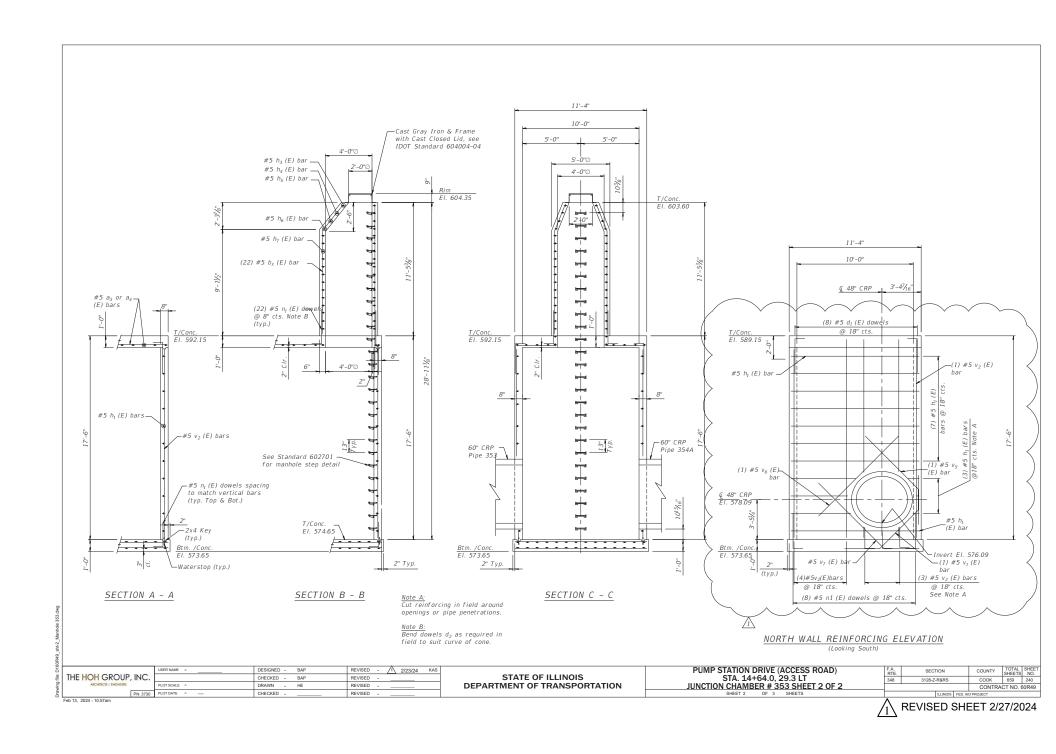

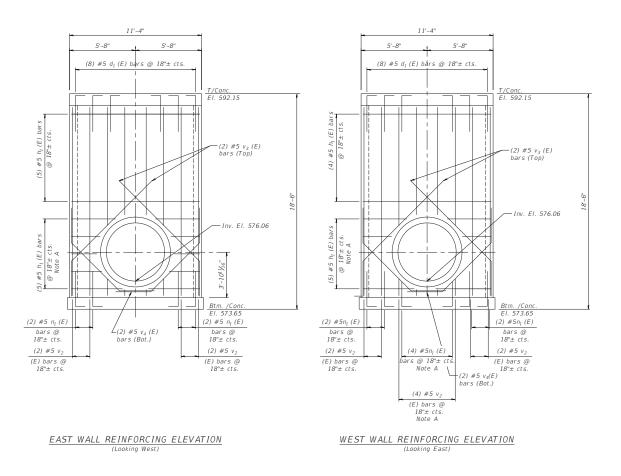

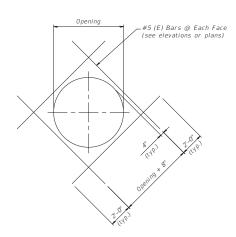

WALL PENETRATION ADDITIONAL REINFORCING DETAIL

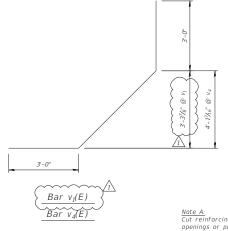

Note A: Cut reinforcing in field around openings or pipe penetrations.  $\frac{\textit{Note B:}}{\textit{Bend dowels } d_2 \textit{ as required in}}$ 

field to suit curve of cone.


REVISED - A 2/23/24 KAS THE HOH GROUP, INC. CHECKED -BAP REVISED DRAWN REVISED CHECKED REVISED


STATE OF ILLINOIS DEPARTMENT OF TRANSPORTATION PUMP STATION DRIVE (ACCESS ROAD) STA. 14+64.0, 29.3 LT JUNCTION CHAMBER # 353

 
 COUNTY
 TOTAL SHEET NO.

 COOK
 659
 241

 CONTRACT NO. 60R49
 SECTION 3128-Z-R&RS REVISED SHEET 2/27/2024

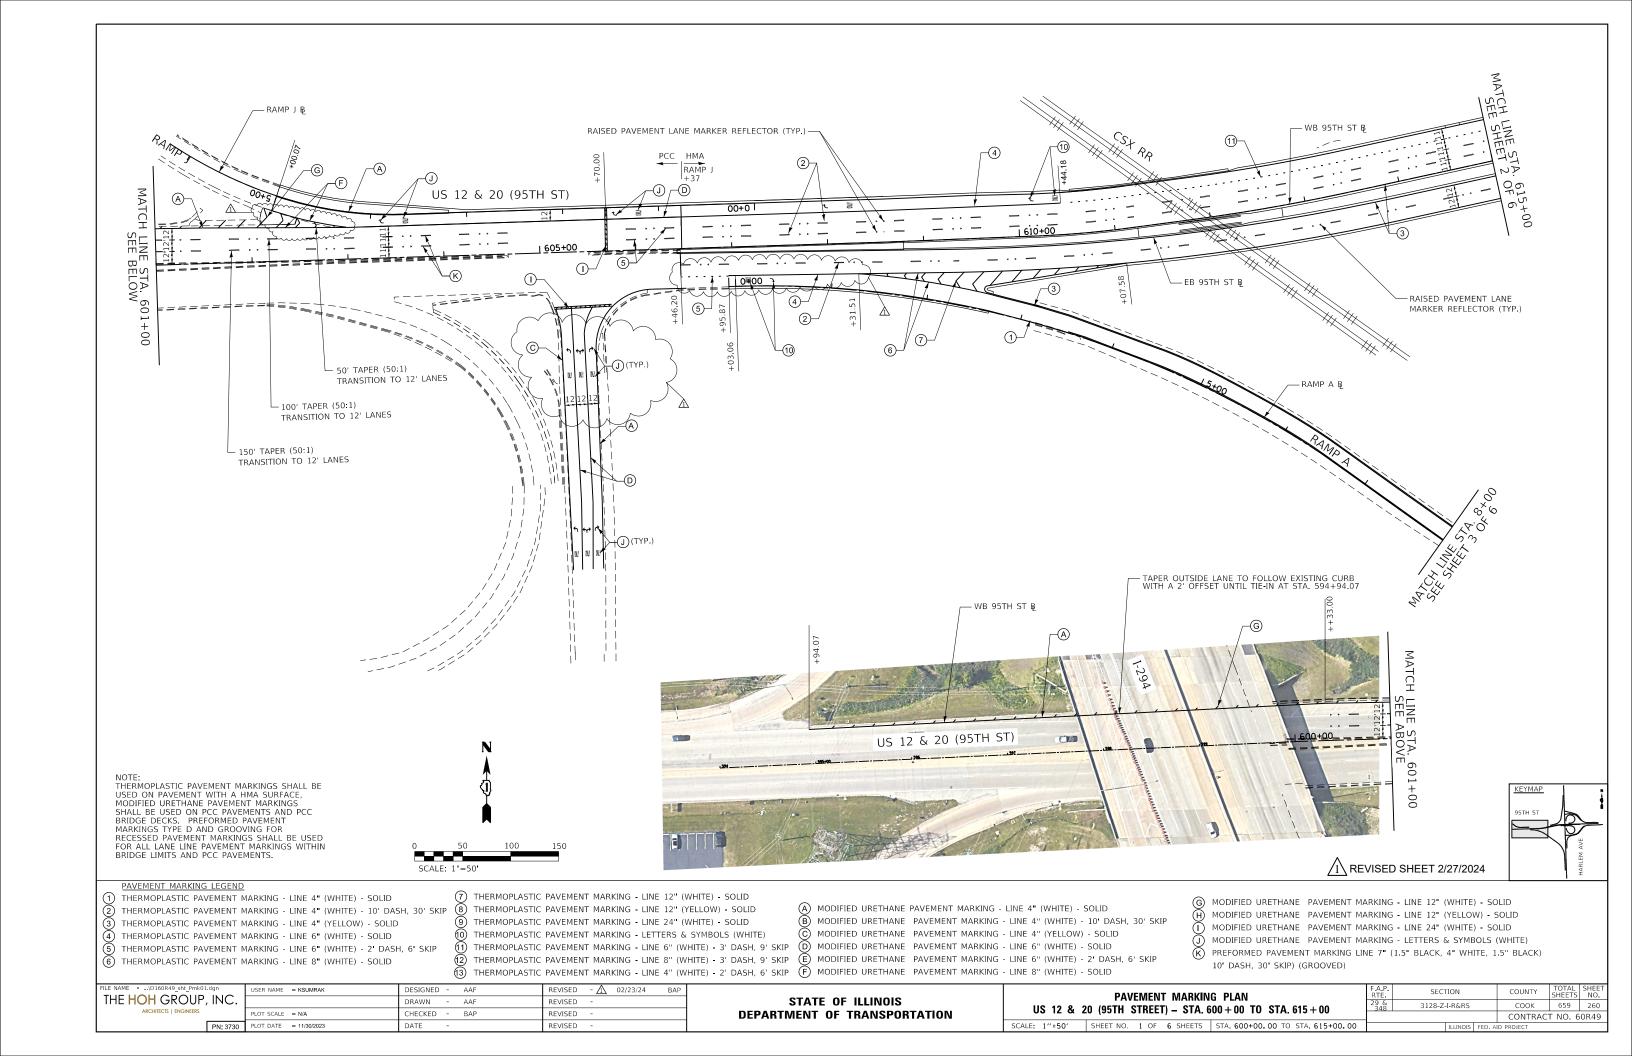

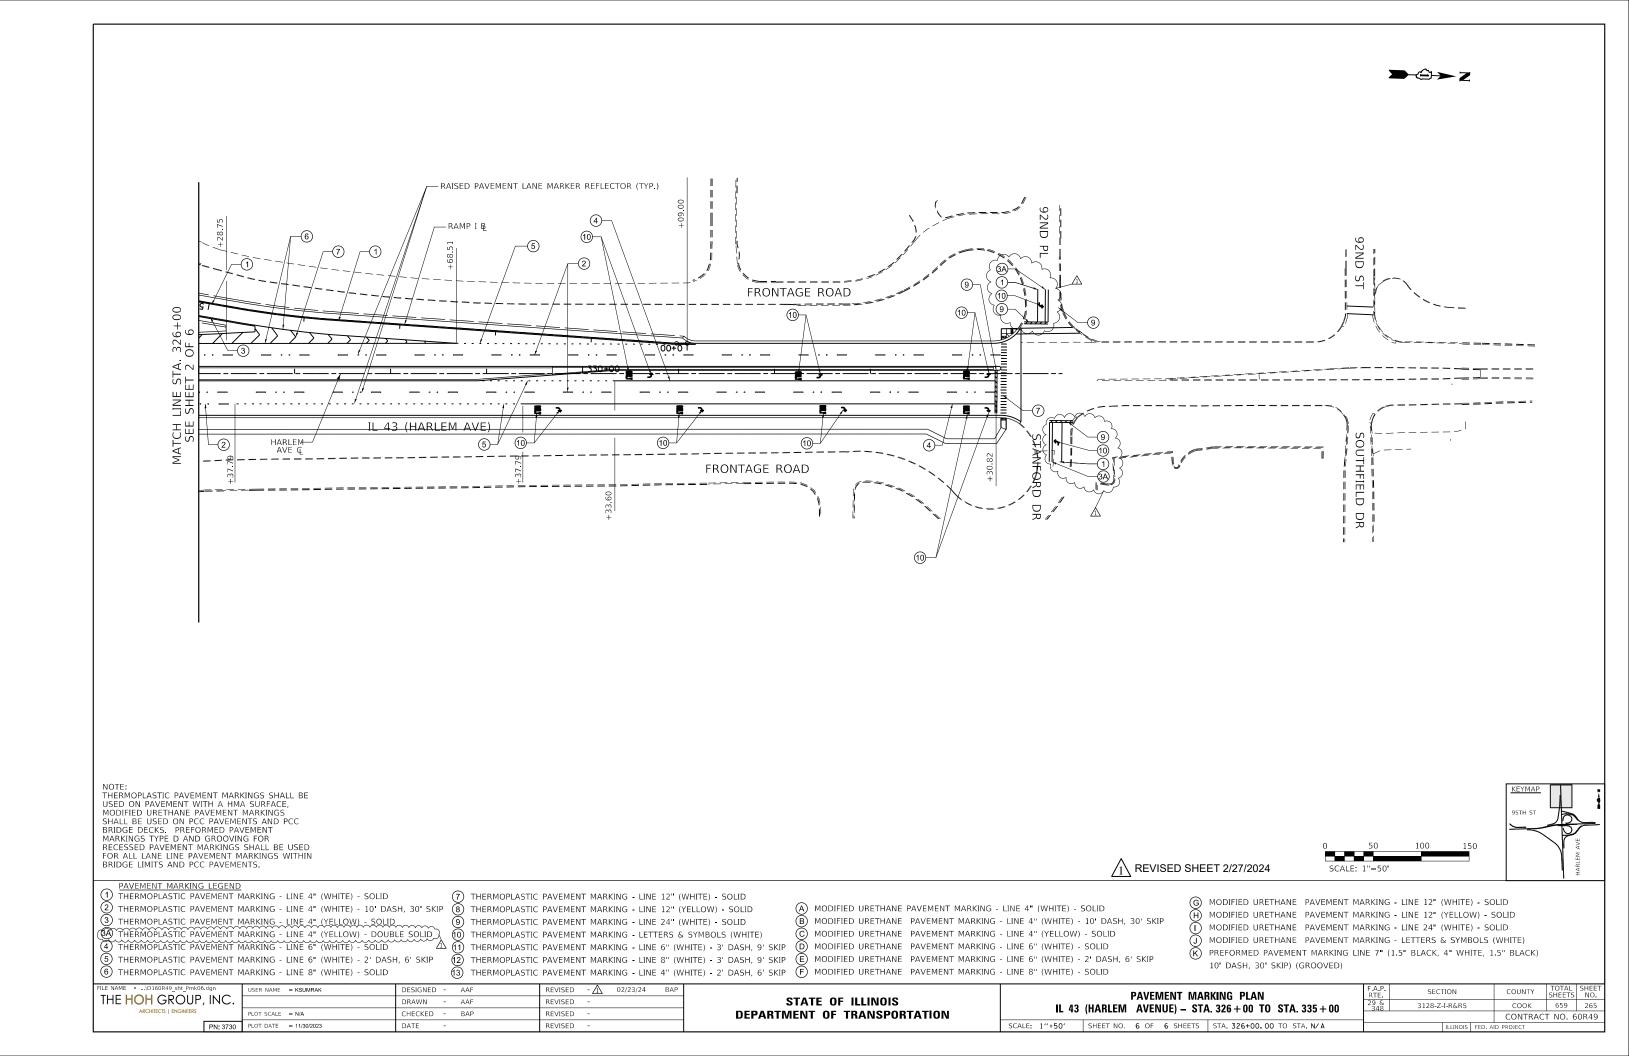

											IDOT						
													Pvn	nt Mt L=Top/sign t	to 3' below gd(+4.5'	more for TS)	Í
		SIGN SCHEDULE				SIGN PANEL -	SIGN PANEL -	REMOVE SIGN	REMOVE SIGN	DIST (H)	DIST (V)	DIST (H)			to 5' below gd (+5' m	nore for TS)	4
						TYPE 1	TYPE 2	PANEL - TYPE 1	PANEL - TYPE 2	EOP-SIGN	EOP-SIGN BOT.	EOP-POST		LESCOPING STL SGI		TELES STL SIN SUPPORT	REMARKS
<del></del>		т т		L MIDTH L	LIFICUT	72000100	72000200	72400210	72400220	6'-C&G	5'-MULTI-SIGN	1		" x 6" OR (2" x 2") :	<del>'                                    </del>		1
ROADWAY	STATION	BEGIN OFFSET	TYPE	WIDTH (FT)	HEIGHT (FT)	72000100 SQ FT	72000200 SQ FT	72400310 SQ FT	72400320 SQ FT	18'-SHLD. A-A	7'-NORM B-B	C-C	P1 FOOT	P2 FOOT	P1+P2 FOOT	72800100 FOOT	1
STH ST.	605+75	MEDIAN	R4-7	2.00	2.50	5 1	30,51	30,F1	30,51	N/A	7.00	C/L	5.00	1		20 🐧	KEEP RIGHT SYMBOL
5TH ST.	610+50	R	R8-3a 🛕	2.00	ζ2.50	5)	<del>                                     </del>		<del>                                     </del>	6.00	7.00	11.00	5.00	9.50	15	20	NO PARKING SYMBOL
5TH ST.	611+00	R	(W12-2)	2.00	2.00	4	<u> </u>			6.00	7.00	8.00	5.00	9.50	14	19	23'-11" CLEARANCE
STH ST.	613+25	MEDIAN	R5-10b	2.50	1.50	3.75	·			N/A	7.00	C/L	5.00	8.50	14	19	PED & BIKE PROHIBITED
35TH ST.	616+50	R	M1-4	2.00	2.00	4	'			6.00	5.00	8.00	5.00	7.00	12	17	ROUTE 12
95TH ST.	616+50	R	M1-4	2.00	2.00	4	[ ]			6.00	5.00	8.00	5.00	7.00	12	17	ROUTE 20
95TH ST.	616+50	R	M3-2	2.00	1.00	2 1				6.00	5.00	7.00	5.00	6.00	11	16 🛆	EAST
STH ST.	620+00	R	W12-2	(3.00	3.00	) j				6.00	7.00	10.50	5.00	(10.00	15	20	14'-11" CLEARANCE
STH ST.	621+75	R	W13-2	2.00	2.50	5	<u> </u>			6.00	7.00	8.50	5.00	9.50	15	20	EXIT 25 MPH
5TH ST.	622+10	R	M6-1	1.75	1.25	2.19	<b></b> '	L		6.00	5.00	7.10	5.00	9.25	14	19	RIGHT TURN ARROW SYMBOL
95TH ST.	622+10	R	M1-5	2.00	2.00	4	<b></b> '									🛕	ILLINOIS 43 - COMB. W/ OTHER SIGN
95TH ST.	622+10	R	M3-1	200~			<b></b> '							7	······		NORTH - COMB. W/ OTHER SIGN
95TH ST.	624+45	R	R8-3a	2.50	2.50	6.25	<b></b> '	<b></b>		6.00	7.00	9.13	4.00	9.50	14	19 }	NO PARKING SYMBOL
95TH ST.	627+00	R	R2-1	2.50	3.00	7.5	<b></b> '	<b></b>		6.00	7.00	9.75	5.00	10.00	15	20 }	SPEED LIMIT 45
STH ST.	629+00	R	W4-3	3.00	3.00		<b></b> '	<b></b>	+	6.00	7.00	10.50	5.00		15	20	MERGE SYMBOL
STH ST.	633+25	R	M1-4	2.00	2.00	4	<b></b> '	<b></b>	+	6.00	5.00	8.00	5.00	7.00	12	17	ROUTE 12
STH ST.	633+25	R	M1-4	2.00	2.00	4	<b></b> '		+	6.00	5.00	8.00	5.00	7.00	12	17	ROUTE 20
95TH ST.	633+25	R	M3-2	2.00	1.00	2	<b></b> '	<del></del>	+	6.00	5.00	7.00	5.00	6.00	11	16	EAST
95TH ST.	601+80	L	W/O 1	3.00	3.00	9	<b>├</b> ──~	<del></del>	+	6.00	7.00	10.50	5.00	10.00	15	20	RIGHT LANE ENDS
95TH ST.	610+10	L	W9-1 M1-1	2.00	2.00	4			+	6.00	5.00	8.00	5.00	10.00 8.25	13	18	INTERSTATE 294 SHIELD
95TH ST.	610+10	L	M2-1				<del></del> '		+	6.00	5.00	8.00	5.00		+	- 18	JCT - COMB. W/ OTHER SIGN
95TH ST.	613+50	L	W12-2	1.75 (3.00	3.00	9 7	<del></del>		<del>                                     </del>	6.00	7.00	10.50	5.00	(10.00	15	· · · · · · · · · · · · · · · · · · ·	23'-11" CLEARANCE
95TH ST.	615+00	L	R2-1	2.00	2.50	5	<u> </u>			6.00	7.00	8.50	5.00	9.50	15	20	SPEED LIMIT 45
95TH ST.	615+70	L	M1-4	2.00	2.00	4				6.00	5.00	8.00	5.00	7.00	12	17	ROUTE 12
95TH ST.	615+70	L	M1-4	2.00	2.00	4			1	6.00	5.00	8.00	5.00	7.00	12	17	ROUTE 20
95TH ST.	615+70	L	M3-4	2.00			· ·			6.00	5.00	7.00	5.00		11	16 🛆	WEST
95TH ST.	618+46	L	R8-3a	(2.50	2.50	6.25				6.00	7.00	9.13	5.00	9.50	15		NO PARKING SYMBOL
95TH ST.	619+00	L	W4-3	3.00	2.50 3.00 3.00	9 1				6.00	7.00	10.50	5.00	10.00	15	20 🛆	MERGE SYMBOL
95TH ST.	621+75	L	W12-2	(3.00	3.00					6.00	7.00	10.50	5.00	(10.00	15	4 4 4 4 4 4 4 4 4 4 4 4 4 4 4 4 4 4 4 4	14'-11" CLEARANCE
95TH ST.	624+85	L	W4-3		3.00	July				6.00	7.00	10.50	5.00	10.00	15	20	MERGE SYMBOL
95TH ST.	626+84	L	R2-1	2.00	2.50	5 <u>A</u>				6.00	7.00	8.50	5.00	9.50	15	20 🛕	SPEED LIMIT 45
95TH ST.	627+93	L	R8-3a	2.00	Ç2.50	5				6.00	7.00	8.50	5.00	9.50	15	20	NO PARKING SYMBOL
95TH ST.	630+50	MEDIAN	R5-10b	2.50	1.50		<b></b> '	<b></b>		N/A	<del>                                     </del>	C/L	5.00	1.50	7	12	PEDESTRIAN & BIKE PROHIBITED
95TH ST.	630+90	L	M6-1	1.75	1.25	2.19	<b></b> '	<b></b>		6.00	5.00	7.10	5.00	6.25	11	16	RIGHT TURN ARROW SYMBOL
95TH ST.	630+90	L	M1-5	2.00	2.00	4	<b></b> '			6.00	5.00	8.00	5.00	7.00	12	17	ILLINOIS 43
95TH ST.	630+90	L	M3-3	2.00	1.00	2	<b></b> '	<b></b>		6.00	5.00	7.00	5.00	6.00	11	16	SOUTH
95TH ST.	630+90	L	M3-1	2.00	1.00	2	<b></b> '	L		6.00	5.00	7.00	5.00	6.00	11	16	NORTH
95TH ST.	631+20	L	WB	N-S Bridgevi			<b></b> '	<b></b>					5.00	0.00	5	10	
95TH ST.	632+30	L	M1-5	2.00	2.00	4	<b></b> '	<b></b>		6.00	5.00	8.00	5.00	8.25	13	18	ILLINOIS 43
95TH ST. 95TH ST.	632+30	L	M2-1	1.75	1.25	2.19	<b></b> '	<b></b>	+		7.00						JCT - COMB. W/ OTHER SIGN
95TH ST.	633+50	L	W13-2	2.00	2.50	5 3.75	<b></b> '	<b></b>	+	6.00	7.00	8.50	5.00	9.50	15	20 19	EXIT 25 MPH
95TH ST.	635+80 636+14	MEDIAN MEDIAN	R5-10b W6-1	2.50 3.00	1.50 3.00	9	<b></b> '		<del>                                     </del>	N/A N/A	7.00 7.00	C/L C/L	5.00	8.50 10.00	15	20	PEDESTRIAN & BIKE PROHIBITED  DIVIDED HIGHWAY SYMBOL
33111 31.	636+14	IVIEDIAN	VV 0-1	3.00	3.00	,	<del></del>		+	IN/A	7.00			10.00	+ 13	20	DIVIDED HIGHWAY SYMBOL
HARLEM AVE.	299+25	MEDIAN	R5-10b	2.50	1.50	3.75	$\vdash$		<del>                                     </del>	N/A	7.00	C/L	5.00	8.50	14	19	PEDESTRIAN & BIKE PROHIBITED
HARLEM AVE.	307+10	MEDIAN	R5-10b	2.50	1.50	3.75				N/A	7.00	C/L	5.00	8.50	14	19	PEDESTRIAN & BIKE PROHIBITED
HARLEM AVE.	307+10	R	M1-4	2.00	2.00	4			1	6.00	5.00	8.00	5.00	7.00	12	17	ROUTE 12
HARLEM AVE.	307+28	R	M1-4	2.00	2.00	4				6.00	5.00	8.00	5.00	7.00	12	17	ROUTE 20
HARLEM AVE.	307+28	R	M2-1	1.75	1.25	2.19				6.00	5.00	7.10	5.00	6.25	11	16	JCT
HARLEM AVE.	309+25	R	D1-2	5.00	2.50		12.5			6.00	5.00	6.00	5.00	7.50	13	18	BRIDGEVIEW / OAK LAWN
HARLEM AVE.	313+08	R	M6-1	1.75	1.25	2.19				6.00	5.00	7.10	5.00	6.25	11	16	RIGHT TURN ARROW SYMBOL
HARLEM AVE.	313+08	R	M1-4	2.00	2.00	4				6.00	5.00	8.00	5.00	7.00	12	17	ROUTE 12
HARLEM AVE.	313+08	R	M1-4	2.00	2.00	4				6.00	5.00	8.00	5.00	7.00	12	17	ROUTE 20
HARLEM AVE.	313+08	R	M3-2	2.00	1.00	2				6.00	5.00	7.00	5.00	6.00	11	16	EAST
HARLEM AVE.	313+08	R	M6-3	1.75	1.25	2.19				6.00	5.00	7.10	5.00	6.25	11	16	STRAIGHT ARROW - SYMBOL
HARLEM AVE.	313+08	R	M1-4	2.00	2.00	4	<u> </u>			6.00	5.00	8.00	5.00	7.00	12	17	ROUTE 12
HARLEM AVE.	313+08	R	M1-4	2.00	2.00	4 \Lambda	<b>└──</b>	<b></b>	ļ	6.00	5.00	8.00	5.00	7.00	12	17	ROUTE 20
HARLEM AVE.	313+08	R	M3-4	2.00	1.00	~~~~~~~~~~~~~~~~~~~~~~~~~~~~~~~~~~~~~~~	<b></b> '	<b></b>	ļ	6.00	5.00	7.00	5.00	6.00	11	16 🗥	WEST
HARLEM AVE.	314+20	R	R8-3a	2.00	Ç2.50	5	<b></b> '	L	<del>                                     </del>	6.00	7.00	8.50	5.00	9.50	15		NO PARKING SYMBOL
HARLEM AVE.	314+95	MEDIAN	R3-2	2.00	2.00	4	<b></b> '	<b></b>	<b></b>	N/A	7.00	CL	5.00	9.00	14	19	NO RIGHT TURN - SYMBOL
HARLEM AVE.	315+85	MEDIAN	R4-7	2.00	2.50	5	<b></b> '	<b></b>	+	N/A	7.00	CL	5.00	9.50	15	20	KEEP RIGHT SYMBOL
HARLEM AVE.	316+90	R	W4-1	3.00	3.00	9	<b></b> '	<b></b>	+	6.00	7.00	10.50	5.00	10.00	15	20	MERGE RIGHT SYMBOL
HARLEM AVE.	320+70	R	M6-1	1.75	1.25	2.19	<b></b> '	<b></b>	+	6.00	5.00	7.10	5.00	6.25	11	16	RIGHT TURN ARROW SYMBOL
HARLEM AVE.	320+70	R	M1-4	2.00	2.00	4	<del>                                     </del>	<del></del>	1	6.00	5.00	8.00	5.00	7.00	12	17	ROUTE 12
HARLEM AVE.	320+70	R	M1-4	2.00	2.00	3 \land	<del>                                     </del>	<del> </del>	1	6.00	5.00	8.00	5.00	7.00	12	17 16 🖄	ROUTE 20
HARLEM AVE. HARLEM AVE.	320+70	R R	M3-4	2.00	1.00 C2.50	~~~~~~~~~~~~~~~~~~~~~~~~~~~~~~~~~~~~~~	<b>├</b> ──	<b></b>	+	6.00 6.00	5.00	7.00	5.00	9.50	11 15	20	WEST NO PARKING SYMBOL
HARLEM AVE.	323+08 323+40	R	R8-3a R5-1	2.50	2.50	6.25		<del></del>	+	6.00	7.00 7.00	8.50 9.13	5.00	9.50	15	20	NO PARKING SYMBOL  DO NOT ENTER
HARLEM AVE.	323+40 323+73	MEDIAN	R5-1 R4-7	2.50	2.50	5	<del></del> '	<del></del>	+	6.00 N/A	7.00	9.13 CL	5.00	9.50	15	20	KEEP RIGHT SYMBOL
HARLEM AVE.	323+73 323+50	R	R6-1L	3.00	1.00	3	<del></del> '		+	6.00	7.00	7.50	5.00	8.00	13	18	ONE WAY ARROW - LEFT
MAKLEIVI AVE.	323130		R6-1R	3.00	1.00	3			<del>                                     </del>	6.00	7.00	7.50	5.00	8.00	13	18	ONE WAY ARROW - LEFT  ONE WAY ARROW - RIGHT
ARLEM AVE.	323+50	l R l															

FILE NAME = ...\D160R49\_sht\_SignSchedule.dgn
THE HOH GROUP, INC.

ARCHITECTS | ENGINEERS
PN: 3730
P

	USER NAME = KSUMRAK	DESIGNED	-	AAF	KEVISED	- 🔼	02/23/24	В
		DRAWN	-	AAF	REVISED	-		
	PLOT SCALE = N/A	CHECKED	-	BAP	REVISED	-		
30	PLOT DATE = 11/30/2023	DATE	-		REVISED	-		

STATE	OF ILLINOIS
DEPARTMENT	OF TRANSPORTATION

		SIGN	SCHEDUI	LES		F.A.P. RTE. 29 & 348	
SCALE: NTS	SHEET NO.	1 OF	3 SHEETS	STA. N/A	TO STA. N/A		

A.P. SECTION COUNTY TOTAL SHEETS NO. 99.6 3128-Z-I-R&RS COOK 659 266 CONTRACT NO. 60R49

											IDOT						
															o 3' below gd(+4.5'		
		SIGN SCHEDULI	<b>.</b>			SIGN PANEL -	SIGN PANEL -	REMOVE SIGN	REMOVE SIGN	DIST (H)	DIST (V)	DIST (H)			5' below gd (+5' n	more for TS)	DEAMA DIVE
						TYPE 1	TYPE 2	PANEL - TYPE 1	PANEL - TYPE 2	EOP-SIGN 6'-C&G	EOP-SIGN BOT. 5'-MULTI-SIGN	EOP-POST		LESCOPING STL SGI ' x 6" OR (2" x 2") (		TELES STL SIN SUPPORT	REMARKS
ROADWAY	STATION	BECIN OFFSET	TVDE	WIDTH	HEIGHT	72000100	72000200	72400310	72400320	18'-SHLD.	7'-NORM		P1	P2	P1+P2	72800100	
		BEGIN OFFSET	TYPE	(FT)	(FT)	SQ FT	SQ FT	SQ FT	SQ FT	A-A	B-B	C-C	FOOT		FOOT	FOOT	
HARLEM AVE.			DC 11	3.00	1.00	2				6.00	7.00	7.50	F 00	8.00	13	18	ONE WAY ADDOM LEFT
HARLEM AVE.	324+28 324+28	R R	R6-1L R6-1R	3.00	1.00					6.00 6.00	7.00 7.00	7.50 7.50	5.00 5.00	8.00 8.00	13	18	ONE WAY ARROW - LEFT ONE WAY ARROW - RIGHT
HARLEM AVE.	325+38	R	W4-3	3.00	3.00	9				6.00	7.00	10.50	5.00	10.00	15	20	ADDED LANE RIGHT SYMBOL
HARLEM AVE.	328+93	R	M1-5	2.00	2.00	4				6.00	5.00	8.00	5.00	8.00	13	18	ILLINOIS 43
HARLEM AVE.	328+93	R	M3-1	2.00	1.00	2				6.00	5.00	7.00					NORTH - COMB. W/ OTHER SIGN
HARLEM AVE.	329+58	R	R2-1	2.00	2.50	5				6.00	7.00	8.50	5.00	9.50	15	20	SPEED LIMIT 45
HARLEM AVE.	208.50	1	W/11 2	2.50	1 2.50	6.25 🛕				6.00	7.00	0.12	F 00	0.50	15	20	DEDECTRIANI CVAMBOL
HARLEM AVE.	308+50 308+50	L	W11-2 (W16-7P)	2.50 (1.75)	2.50 1.50	~~~~				6.00	7.00	9.13	5.00	9.50	13	20	PEDESTRIAN SYMBOL PEDESTRIAN ARROW
HARLEM AVE.	313+07	L	R2-1	2.00	2.50					6.00	7.00	8.50	5.00	9.50	15	20	SPEED LIMIT 45
HARLEM AVE.	314+62	L	M1-5	2.00	2.00	4				6.00	5.00	8.00	5.00	8.00	13	18	ILLINOIS 43
HARLEM AVE.	314+62	L	M3-3	2.00	1.00	2											SOUTH - COMB. W/ OTHER SIGN
HARLEM AVE.	315+00	L	R6-1R	3.00	1.00	3				6.00	7.00	7.50	5.00	8.00	13	18	ONE WAY ARROW - RIGHT
HARLEM AVE.	315+10	MEDIAN	R4-7	2.00	2 50	5 🛕				N/A	7.00	CL	5.00	9.50	15	20 🛆	KEEP RIGHT SYMBOL
HARLEM AVE.	316+05	MEDIAN	M6-1L	3.00	2.50	37				N/A	5.00	CL	5.00	6.00	11	16	RIGHT TURN ARROW - SYMBOL
HARLEM AVE.	316+05	MEDIAN	M1-4	2.00	2.00	4				N/A	5.00	CL	5.00	7.00	12	17	ROUTE 12
HARLEM AVE.	316+05	MEDIAN	M1-4	2.00	2.00	4				N/A	5.00	CL	5.00	7.00	12	17	ROUTE 20
HARLEM AVE.	316+05	MEDIAN	M3-2	2.00	1.00	2				N/A	5.00	CL	5.00	6.00	11	16	EAST
HARLEM AVE.	322+80	MEDIAN	R4-7	2.00	2.50					N/A	7.00	CL	5.00	9.50	15	20	KEEP RIGHT SYMBOL
HARLEM AVE. HARLEM AVE.	322+50 322+75	MEDIAN R	R3-2 R3-2	2.00	2.00					N/A N/A	7.00 7.00	CL CL	5.00	9.00	9 14	14	NO LEFT TURN SYMBOL NO LEFT TURN SYMBOL
HARLEM AVE.	325+59	L	R8-3a	2.00	2.00 G2.50	4 1				6.00	7.00	8.50	5.00	9.00	15	20	NO PARKING SYMBOL
HARLEM AVE.	326+75	MEDIAN	R5-10b	2.50	1.50					N/A	7.00	C/L	5.00	8.50	14	19	PEDESTRIAN & BIKE PROHIBITED
HARLEM AVE.	329+00	MEDIAN	R5-10b	2.50	1.50					N/A	7.00	C/L	5.00	8.50	14	19	PEDESTRIAN & BIKE PROHIBITED
HARLEM AVE.	334+28	MEDIAN	R4-7	2.00	2.50	5				N/A	7.00	CL	5.00	9.50	15	20	KEEP RIGHT SYMBOL
24424															10		
RAMP A	12+20 12+20	L	SB-43-(W11-2) (W16-2P)	3.00 2.00	3.00 1.50					18.00	7.00	22.50	5.00	12.50	18	23	PEDESTRIAN SYMBOL PEDESTRIAN '500 FEET' - COMB. W/ OTHER SIGN
RAMP A	12+20	L	(W16-2F)	2.00	1.00	1											PEDESTRIAN 300 FEET - COMB. W/ OTHER SIGN
RAMP A	12+20	R	SB-43-(W11-2)	3.00	3.00					18.00	7.00	22.50	5.00			A	PEDESTRIAN Symbol
RAMP A	12+20	R	(W16-9P)	2.00	1.00	2 🛕									·····	~~~~~~~~~~~~~~~~~~~~~~~~~~~~~~~~~~~~~~	PEDESTRIAN 'AHEAD' - COMB. W/ OTHER SIGN
RAMP A	16+50	L	SB-43-(W4-1R)	~3.00~						18.00	7.00	22.50	5.00	10.00	15	20 }	MERGE RIGHT SYMBOL
RAMP A	16+86	L R	SB-43-(W11-2)	3.00	3.00	9 }				18.00	7.00	22.50	5.00	10.00	15	20}	PEDESTRIAN SYMBOL
RAMP A	17+00 17+00	R	SB-43-(W11-2) (W16-7P)	(1.75)	3.00 1.50	Annage of the second				18.00	7.00	22.50	5.00	11.50	17	22	PEDESTRIAN SYMBOL PEDESTRIAN ARROW
	17.00		(**10 /1/		1.50												PEDESTITIVITY AND V
RAMP E	5+90	R	E-(W13-3)	2.00	2.50	5 🐧				18.00	7.00	20.50	5.00	9.50~~	15	20 🛆	RAMP 25 MPH
RAMP E	6+50	R	E-(W1-4)	(3.00	3.00	9~				18.00	7.00	22.50	5.00	10.00	15	20	REVERSE CURVE Symbol
RAMP E	11+80	R	E2-(M6-1)	1.75	1.25					18.00	5.00	19.10	5.00	9.25	14	19	RIGHT TURN ARROW SYMBOL
RAMP E RAMP E	11+80	R R	E2-(M1-I100)	2.00	2.00 1.00	2											ILLINOIS 43 - COMB. W/ OTHER SIGN
IMIVIF E	11+80	1 K	E2-(M3-1)	2.00	1.00						-						NORTH - COMB. W/ OTHER SIGN
RAMP E2	25+10	L	E2-(W3-3)	3.00	3.00	9		<u> </u>		18.00	7.00	22.50	5.00	10.00	15	20	STOP LIGHT - SYMBOL
RAMP E2	25+80	L	E2-(R5-1A)	3.00	2.00					18.00	7.00	21.00	5.00	9.00	14	19	WRONG WAY
RAMP E2	25+65	R	E2-(W12-1)	3.00	3.00					18.00	7.00	22.50	5.00	10.00	15	20	DOUBLE ARROWS - SYMBOL
RAMP E2 RAMP E2	26+90 26+90	R R	E2-(M6-1) E2-(M1-5)	1.75 2.00	1.25 2.00					18.00 18.00	5.00 5.00	19.10 20.00	5.00 5.00	6.25 7.00	11	16 17	LEFT TURN ARROW SYMBOL
RAMP E2	26+90	R R	E2-(M1-5)	2.00	1.00					18.00	5.00	19.00	5.00	6.00	11	16	ILLINOIS 43 - COMB. W/ OTHER SIGN  SOUTH - COMB. W/ OTHER SIGN
RAMP E2	25+90	R	E2-(R5-1A)	3.00	2.00	_				18.00	7.00	21.00	5.00	9.00		19 🗥	WRONG WAY
RAMP E2	26+90	R	E2-(R6-3A)	(250	2 00	~~~~				18.00	7.00	20.50	5.00	9.00	14	195	DIVIDED HIGHWAY AHEAD
RAMP E2	26+90	R	E2-(R3-5)	2.50	3.00	7.5				18.00	10.00	21.75	5.00	13.00	18	23	LEFT TURN ONLY
DAMADE	46.77	_	F (1415 2)			<del>  _</del>				40.55	7.00	20.75	F.63	0.77	1.5	20	EVIT OF A 4DU
RAMP F	18+50 20+60	R R	F-(W13-2) F-(W13-3)	2.00	2.50					18.00 18.00	7.00 7.00	20.50	5.00 5.00	9.50 9.50	15 15	20	EXIT 25 MPH RAMP 25 MPH
1231411	20100	, n	1-(4413-3)	2.00	2.30	†				10.00	7.00	20.30	3.00	3.30	15		10-101 E2 101 [1]
RAMP G	22+00	L	G-(W13-3)	2.00	2.50	5				18.00	7.00	20.50	5.00	9.50	15	20	RAMP 25 MPH
RAMP G	25+00	L	G-(W9-1)	3.00	3.00	9 }				18.00	7.00	22.50	5.00	(10.00	15	20 }	LEFT LANE ENDS
RAMP G	27+10	L	G-(W9-2)	3.00	3.00					18.00	7.00	22.50	5.00	10.00	15	20 }	LANE ENDS MERGE RIGHT
PANAD C3	24:00	1 5	63 (14/4 2 2)							40.00	7.00	20.50	5.00	+	15	20	EVIT OF MOU
RAMP G2 RAMP G2	31+90 34+00	R R	G2-(W13-2) G2-(W13-3)	2.00	2.50					18.00 18.00	7.00 7.00	20.50	5.00 5.00	9.50 9.50	15 15	20	EXIT 25 MPH RAMP 25 MPH
RAMP G2	34+00	R	G2-(W13-3) G2-(W1-4)	(3.00	2.50 3.00	~~~~~~~~~~~~~~~~~~~~~~~~~~~~~~~~~~~~~~				18.00	7.00	20.50	5.00	(10.00)	15	Jun 384	REVERSE CURVE Symbol
	35.30		(**1-4)		3.00					10.00	7.00	22.55	3.00		<del>                                     </del>		
RAMP H	5+00	R	H-(W13-3)	2.00	2.50	5				18.00	7.00	20.50	5.00	9.50	15	20	RAMP 25 MPH
CONTINUE ONTO NEX	(T SHEET																

The Name - Into took to _ and and a second and		DESIGNED - AAF	REVISED - ZIZ 02/23/24 BAP
THE HOH GROUP, INC		DRAWN - AAF	REVISED -
ARCHITECTS   ENGINEERS	PLOT SCALE = N/A	CHECKED - BAP	REVISED -
PN: 373	0 PLOT DATE = 11/30/2023	DATE -	REVISED -

STATE OF	ILLINOIS
DEPARTMENT OF 1	<b>TRANSPORTATION</b>

SCALE: NTS

						<u>/1</u>	\\RE\	/ISE[	SHEET 2	/27/20	24	
						F.A.P. RTE. 29 & 348	SEC <sup>-</sup>	TION		COUNTY	TOTAL SHEETS	SHEET NO.
SIGN SCHEDULES							3128-Z-I-R&RS			соок	659	267
							CONTRACT NO. 6					
	SHEET NO.	2 OF	3 SHEETS	STA. N/A	TO STA. N/A	ILLINOIS FED. AID PROJECT						

IDOT													REMARKS				
													Pvn	nt Mt L=Top/sign t	o 3' below gd(+4 5	' more for TS)	
SIGN SCHEDULE						SIGN PANEL -	SIGN PANEL -	REMOVE SIGN	REMOVE SIGN	DIST (H)	DIST (V)	DIST (H)	Pvmt Mt L=Top/sign to 3' below gd(+4.5' more for TS)			1	
						TYPE 1	TYPE 2	PANEL - TYPE 1	PANEL - TYPE 2	EOP-SIGN 6'-C&G	EOP-SIGN BOT. 5'-MULTI-SIGN	EOP-POST		LESCOPING STL SGI ' x 6" OR (2" x 2")		TELES STL SIN SUPPORT	
ROADWAY	STATION		TYPE	WIDTH	HEIGHT	72000100	72000200	72400310	72400320	18'-SHLD.	7'-NORM		P1	P2	P1+P2	72800100	
		BEGIN OFFSET		(FT)	(FT)	SQ FT	SQ FT	SQ FT	SQ FT	A-A	B-B	C-C	FOOT		FOOT	FOOT	
CONTINUE ON PREVIO	US SHEET																
RAMP I	4+25	R	I-(M4-5)	2.00	1.00	2				18.00	7.38	19.00	5.00	8.38	13	18	ТО
RAMP I	4+25	R	I-(M1-1)	2.50	2.00	5				18.00	6.88	20.50	5.00	8.88	14	19	INTERSTATE 294 SHIELD
RAMP I	4+25	R	I-(M6-1)	1.75	1.25	2.19				18.00	5.00	19.10	5.00	6.25	11	16	RIGHT ARROW SYMBOL
RAMP I	4+25	R	I-(M3-4)	2.00	1.00	2				18.00	9.88	19.00	5.00	10.88	16	21	WEST
RAMP I	4+25	R	I-(M1-4)	2.00	2.00	4				18.00	8.88	20.00	5.00	10.88	16	21	ROUTE 12
RAMP I	4+25	R	I-(M1-4)	2.00	2.00	4				18.00	6.88	20.00	5.00	8.88	14	19	ROUTE 20
RAMP I	4+25	R	I-(M6-1)	1.75	1.25	2.19				18.00	5.00	19.10	5.00	6.25	11	16	RIGHT ARROW SYMBOL
RAMP I	2+50	R	I-(W13-2)	2.00	2.50	5				18.00	7.00	20.50	5.00	9.50	15	20	EXIT 25 MPH
RAMP I	3+00	R	I-(R3-2)	2.00	2.00	4				18.00	7.00	20.00	5.00	9.00	14	19	NO LEFT TURN SYMBOL
RAMP I	5+20	R	I-(W11-2)	2.50	2.50	6.25				18.00	7.00	21.13	5.00	9.50	15	20	PEDESTRIAN SYMBOL
RAMP I	6+95	R	I-(W13-3)	2.00	2.50	5 🗥				18.00	7.00	20.50	5.00	9.50	15	20 🛆	RAMP 25 MPH
RAMP I	9+75	L	I-(W1-8)	(2.50	3.00	7.5				18.00	7.00	21.75	5.00	(10.00	15	20.)	CHEVRON ALIGN SYMBOL
RAMP I	10+25	L	I-(W1-8)	1.00	1.50	1.5				18.00	7.00	18.75	5.00	8.50	14	19	CHEVRON ALIGN SYMBOL
RAMP I	10+75	L	I-(W1-8)	1.00	1.50	1.5				18.00	7.00	18.75	5.00	8.50	14	19	CHEVRON ALIGN SYMBOL
RAMP I	11+25	L	I-(W1-8)	1.00	1.50	1.5				18.00	7.00	18.75	5.00	8.50	14	19	CHEVRON ALIGN SYMBOL
			,														
RAMP J	0+40	R	J-(R3-5)	2.50	3.00	7.5				18.00	7.00	21.75	5.00	10.00	15	20	RT ARROW ONLY
RAMP J	1+39	R	J-(W13-2)	2.00	2.50	5				18.00	7.00	20.50	5.00	9.50	15	20	EXIT 35 MPH
RAMP J	3+60	R	J-(M6-1)	1.75	1.25	2.19				18.00	5.00	19.10	5.00	9.25	14	19	RIGHT ARROW SYMBOL
RAMP J	3+60	R	J-(M1-1)	2.50	2.00	5											INTERSTATE 294 SHIELD - COMB. W/ OTHER SIGN
RAMP J	3+60	R	J-(M3-1)	2.00	1.00	2											NORTH - COMB. W/ OTHER SIGN
RAMP J	6+89	R	J-(W13-3)	2.00	2.50	5				18.00	7.00	20.50	5.00	9.50	15	20	RAMP 35 MPH
			, , , , , , , , , , , , , , , , , , , ,														
PUMP ACCESS RD.	9+50	R	PAR-(R1-1)	2.50	2.50	6.25 🖍				18.00	5.00	21.13	5.00	7.50	13000	18/1	STOP
PUMP ACCESS RD.	9+50	R	PAR-(R6-3A)	2.50	2.00	~~~£~ <del>(</del> )				18.00	5.00	20.50	5.00	7.00	12	17	DIVIDED HIGHWAY AHEAD
PUMP ACCESS RD.	9+50	R	PAR-(R6-1R)	3.00	1.00	3 }				18.00	5.00	19.50	5.00	6.00	11	16 }	ONE WAY ARROW - RIGHT
PUMP ACCESS RD.	9+60	L	PAR-(R3-5)							18.00	7.00	21.75	5.00		111115		RIGHT ARROW ONLY
PUMP ACCESS RD.	11+00	R	PAR-(R1-1)	2.50	2.50	6.25				18.00	5.00	21.13	5.00	7.50	13	18	STOP
PUMP ACCESS RD.	11+00	R	N/A	1.00	0.67	0.67		1			5.00			7.50			AUTHORIZED PERSONNEL ONLY
	11.00	13	11/75	1.50	0.07			1						_	1	Δ	AS THE METERS OF ENGLISHMEN ONE!
FRONTAGE ROAD	314+00	R	W14-2P	3.00	3.00	9.5				6.00	7.00	10.50	5.00	(10.00	15	20,	NO OUTLET
ONTAGE NOAD	314+00	IV.	VV 14-2 F	1 2:00				1		0.00	7.00	10.50	3.00		<del>fuituu</del>	<del></del>	NO OUTLET
ESTIMATE								550	12.5								
						Λ		1	† †						1		
TOTAL						C702	13	550	13		†				<del>                                     </del>	(2,520)	

/1\	REVISED SHEET 2/27/2024

COUNTY TOTAL SHEET NO.

COOK 659 268

	USER NAME = KSUMRAK	DESIGNED - AAF	REVISED - ⚠ 02/23/24 BAP
THE HOH GROUP, INC.		DRAWN - AAF	REVISED -
ARCHITECTS   ENGINEERS	PLOT SCALE = N/A	CHECKED - BAP	REVISED -
PN: 3730	PLOT DATE = 11/30/2023	DATE -	REVISED -

STATE OF ILL	.INOIS
DEPARTMENT OF TRA	NSPORTATION

					F.A.P. RTE	SEC <sup>-</sup>	ΓΙΟΝ		COUNTY	SHEETS	
	SIG	N SCHEDU	LES		29 & 348	3128-Z	-I-R&RS		соок	659	268
									CONTRAC	T NO. 6	50R49
SCALE: NTS	SHEET NO. 3 OF	3 SHEETS	STA. N/A	TO STA. N/A	ILLINOIS FED. AID PROJECT						

