#### GENERAL NOTES

ANY REFERENCE TO STANDARDS THROUGHOUT THE PLANS SHALL BE INTERPRETED TO BE THE LATEST STANDARDS OF THE ILLINOIS DEPARTMENT OF

WHEREVER IN THESE PLANS REFERENCE IS MADE TO THE "STANDARD SPECIFICATIONS", IT IS UNDERSTOOD TO INCLUDE THE "SUPPLEMENTAL SPECIFICATIONS" INCLUDED IN THE PROPOSAL.

PLAN QUANTITIES FOR TREE REMOVAL HAVE BEEN BASED ON ALL TREES WITHIN THE EXISTING RIGHT-OF-WAY AND TEMPORARY EASEMENT. THIS QUANTITY MAY BE REVISED DURING CONSTRUCTION, AT THE DIRECTION OF THE ENGINEER, BY DELETING FROM THE REMOVAL QUANTITIES. SUCH TREES THAT DO NOT INTERFERE WITH THE PROPOSED CONSTRUCTION.

ALL WASTE OR UNDESTRABLE MATERIAL AS IDENTIFIED BY THE ENGINEER SHALL BE DISPOSED OF OUTSIDE THE LIMITS OF THE RIGHT OF WAY AT THE CONTRACTOR'S EXPENSE.

FRAMES AND GRATES ON EXISTING DRAINAGE OR SANITARY STRUCTURES, WHICH ARE TO BE REMOVED, ABANDONED, OR WHICH OTHERWISE ARE NOT INCORPORATED INTO THE IMPROVEMENT SHALL BECOME THE PROPERTY OF THE CITY OF DANVILLE. THE CONTRACTOR SHALL STORE THE FRAMES AND GRATES WITHIN THE RIGHT OF WAY AT LOCATIONS DESIGNATED BY THE ENGINEER.

THE PROFILE GRADE ELEVATIONS SHOWN ON THE PLAN AND PROFILE SHEETS AND IN THE STATION CROSS SECTIONS ARE TO THE TOP OF THE FINISHED

WHERE SECTION OR SUBSECTION MONUMENTS ARE ENCOUNTERED, THE ENCINEER SHALL BE NOTIFIED BEFORE SUCH MONUMENTS ARE REMOVED. THE CONTRACTOR SHALL PROTECT AND PRESERVE PROPERTY MARKERS UNTIL THE OWNER, AN AUTHORIZED SURVEYOR, OR AGENT, HAS WITNESSED OR OTHERWISE REFERENCED THEIR LOCATION.

ALL ELEVATIONS SHOWN REFER TO U.S.G.S. MEAN SEA LEVEL DATUM.

THE CONTRACTOR WILL BE REQUIRED TO COMPLY WITH ALL STATE REGULATIONS REGARDING AIR, WATER AND NOISE POLLUTION, THE CONTRACTOR WILL NOT BE ALLOWED TO BUILD FIRES ON THE SITE.

IS THE CONTRACTOR'S RESPONSIBILITY TO ASCERTAIN EXISTING FIELD CONDITIONS BEFORE BIDDING ON THIS PROJECT, SPECIFICALLY AS THEY RELATE TO THE LUMP SUM PAY ITEMS.

VERIFICATION OF DIMENSIONS: IT IS THE CONTRACTOR'S RESPONSIBILITY TO VERIFY ALL DIMENSIONS AND CONDITIONS EXISTING IN THE FIELD PRIOR TO CONSTRUCTION AND ORDERING MATERIALS.

THE CONTRACTOR SHALL BE REQUIRED TO PROVIDE ACCESS TO ABUTTING PROPERTY OWNERS AT ALL TIMES DURING CONSTRUCTION OF THE PROJECT.

THE CONTRACTOR SHALL COOPERATE WITH THE CITY OF DANVILLE ON ANY UNDERGROUND CONSTRUCTION WHICH THE CITY MAY WISH TO PLACE BEFORE THE PROJECT IS COMPLETED

EXISTING PAVEMENT, SIDEWALK, DRIVEWAY PAVEMENT, CURB AND GUTTER AND EXISTING DRAINAGE STRUCTURES NOT INCLUDED IN THE PLANS FOR REMOVAL, BUT DAMAGED DUE TO THE CONTRACTOR'S NEGLIGENCE SHALL BE REPLACED AT THE EXPENSE OF THE CONTRACTOR.

THE CONTRACTOR MAY BE REQUIRED TO CONDUCT SOME OF HIS GRADING AND TRENCHING OPERATIONS AROUND TRANSMISSION POLES AND UNDER TRANSMISSION LINES. THE ADDED COST OF SO DOING SHALL BE INCLUDED IN THE COST OF EARTH EXCAVATION.

EXISTING CONCRETE SIGN BASES AND DITHER MISCELLANEOUS CONCRETE NOT SPECIFICALLY SHOWN ON THE PLANS, BUT INTERFERING WITH PROPOSED CONSTRUCTION, SHALL BE REMOVED, COST OF THIS WORK SHALL BE INCLUDED IN THE COST OF THE EARTH EXCAVATION.

THE REMOVAL OF HOT-MIX ASPHALT SURFACING NOT ON A RIGID TYPE BASE REMOVED IN CONJUNCTION WITH THE BASE SHALL BE REMOVED AS EARTH

WHENEVER IT IS NECESSARY TO REMOVE BITUMINOUS AGGREGATE MIXTURE, OIL AND CHIP SURFACE, EXISTING GRAVEL OR CRUSHED STONE BASE COURSE. IT SHALL BE REMOVED AT THE CONTRACT UNIT PRICE PER CUBIC YARD FOR FARTH EXCAVATION, NO ADDITIONAL COMPENSATION WILL BE ALLOWED FOR ADDITIONAL LABOR OR EDUTEMENT REQUIRED.

ALL EXISTING PRIVATELY OWNED UTILITIES REQUIRING ADJUSTMENT WILL BE MADE BY THE UTILITY COMPANY INVOLVED. WHERE NO PROVISIONS HAVE BEEN MADE FOR ADJUSTMENTS ON THE PLANS, NO ADDITIONAL COMPENSATION WILL BE ALLOWED DUE TO DELAYS OR INCONVENIENCES CAUSED BY THE SAID UTILITY ADJUSTMENTS.

THE LOCATION OF UNDERGROUND UTILITIES SHOWN ON THE PLANS REPRESENTS THE BEST KNOWLEDGE OF THE CITY. IT SHALL BE THE CONTRACTOR'S RESPONSIBILITY TO VERIFY LOCATIONS OF UNDERGROUND INSTALLATIONS BEFORE STARTING CONSTRUCTION OPERATIONS. THE CONTRACTOR SHALL INDEMNIFY THE CITY, ITS OFFICERS AND EMPLOYEES AGAINST ALL CLAIMS DUE TO DAMAGE TO CORPORATE OR PRIVATE PROPERTY RESULTING FROM HIS CONSTRUCTION OPERATIONS AS DESCRIBED IN ARTICLES 107.20 AND 107.26 OF THE STANDARD SPECIFICATIONS.

THE CONTRACTOR SHALL NOTIFY THE AGENCIES AND UTILITIES AT LEAST 10 (TEN) DAYS PRIOR TO ANY CONSTRUCTION IN THE AREA AND SHALL COMPLY WITH ALL RESTRICTIONS FOR EQUIPMENT MOVEMENTS AND CLEARANCES AS REGARDS TO THEIR FACILITIES.

REFORE STARTING ANY EXCAVATION. THE CONTRACTOR MUST CALL JULIAE, AT 1-800-892-0123 OR 811 FOR FIELD LOCATIONS OF BURIED ELECTRICAL. TELEPHONE, GAS FACILITIES, AND ALL PUBLIC UTILITIES. A 48 HOUR NOTIFICATION IS REQUIRED.

THE CONTRACTOR SHALL USE ALL NECESSARY PRECAUTIONS AND PROTECTIVE MEASURES REQUIRED TO MAINTAIN EXISTING UTILITIES, SEWER AND APPURTENANCES THAT MUST BE KEPT IN OPERATION. IN PARTICULAR, THE CONTRACTOR WILL TAKE ADEQUATE MEASURES TO PREVENT THE UNDERMINING OF UTILITIES AND SEWERS WHICH ARE STILL IN SERVICE.

THE CONTRACTOR SHALL COMPLY WITH THE ENVIRONMENTAL PROTECTION AGENCY (E.P.A.) REGULATIONS WHICH APPLY TO STORM SEWER CONSTRUCTION REGARDING THE HORIZONTAL AND VERTICAL SEPARATION OF A STORM SEWER LINE FROM ANY EXISTING OR PROPOSED WATERMAIN. AT LOCATIONS WHERE THE SEPARATION IS INADEQUATE, THE CONTRACTOR SHALL ADJUST THE WATERMAIN TO PROVIDE THE REQUIRED SEPARATION OR CONSTRUCT THE STORM SEWER OF THE MATERIAL SPECIFIED IN THE E.P.A. REGULATIONS.

THE ELEVATIONS AND EXACT SIZE OF ALL EXISTING WATERMAINS AND SANITARY SEWERS SHALL BE DETERMINED BY THE CONTRACTOR PRIOR TO BEGINNING CONSTRUCTION OF EACH RUN OF STORM SEWER TRUNK LINE OR LATERAL LINE WITHIN WHICH A CROSSING OF EITHER OR BOTH TYPES OF THESE EXISTING UTILITIES IS TO BE ENCOUNTERED. THE CONTRACTOR SHALL THEN DETERMINE WHICH OF THE ABOVE OPTIONS HE WILL USE TO RESOLVE THE CONFLICT BETWEEN THE PROPOSED STORM SEWER AND THE EXISTING UTILITY. THE APPROVAL OF THE RESIDENT ENGINEER AND THE SUPERINTENDENT OF THE UTILITY SHALL BE OBTAINED BY THE CONTRACTOR PRIOR TO STARTING CONSTRUCTION OF THIS SEGMENT OF STORM SEWER.

DURING CONSTRUCTION OPERATIONS, IF ANY LOOSE MATERIAL IS DEPOSITED IN THE FLOW LINE OF DITCHES, GUTTERS OF DRAINAGE STRUCTURES SO THAT THE NATURAL FLOW OF WATER IS OBSTRUCTED, IT SHALL BE REMOVED AT THE CLOSE OF EACH WORKING DAY, AT THE CONCLUSION OF CONSTRUCTION OPERATIONS, ALL DRAINAGE STRUCTURES SO AFFECTED SHALL BE FREE FROM ALL DEBRIS. THIS WORK SHALL BE INCLUDED WITH THE COST OF THE STORM SEWER.

THE COST OF ADDITIONAL LABOR AND MATERIALS NOT ACCOUNTED FOR ON THE PLANS, WHICH MIGHT BE INVOLVED IN CONNECTING EXISTING DRAIN TILE OR STORM SEWERS TO PROPOSED DRAINAGE STRUCTURES, SHALL BE INCLUDED WITH THE COST OF THE STORM SEWER.

THE ENDS OF EXISTING DRAINAGE LINES WHICH ARE NOT TO BE INCORPORATED INTO THE PROPOSED IMPROVEMENT ARE TO BE SEALED (PLUGGED) TO THE SATISFACTION OF THE ENGINEER, COST OF SUCH WORK SHALL BE INCLUDED WITH THE COST OF THE STORM SEWER.

#### GENERAL NOTES (CONTINUED)

FOR INLETS AND MANHOLES CONSTRUCTED IN CONJUNCTION WITH THE CURB/GUTTER, THE OFFSET DISTANCE SHOWN ON THE PLANS IS FROM THE CENTERLINE OF CONSTRUCTION TO THE FLOWLINE OF GUTTER. IT SHALL BE THE RESPONSIBILITY OF THE CONTRACTOR TO CONSTRUCT EACH INLET OR MANHOLE, AT THE PROPOSED LOCATION SO THAT THE FRAME MATCHES THE CURB LINE.

ALL AREAS DISTURBED BY CONSTRUCTION ACTIVITIES OUTSIDE THE PROPOSED PAVEMENT SHALL BE SEEDED IN ACCORDANCE WITH THE APPLICABLE SECTION 250 OF THE STANDARD SPECIFICATIONS.

TRAFFIC SIGNS REMOVED MUST BE RESET AT THEIR PERMANENT LOCATIONS IN A WORKMANLIKE MANNER AND VISIBLE TO TRAFFIC ON THE ROADWAY AS DIRECTED BY THE ENGINEER. THESE SIGNS SHALL BE RESET BEFORE THE ROADWAY IS OPEN TO TRAFFIC. COST OF SUCH WORK SHALL BE INCLUDED WITH THE COST OF THE PAVING.

THE CONTRACTOR SHALL BE PERMITTED TO STOCKPILE EXCESS EARTH FROM THE MAY AND ROGERS PORTION OF THE PROJECT FOR USE ON VOORHEES STREET. THE STOCKPILE WILL BE LOCATED ON CITY OWNED PROPERTY AT THE SOUTH END OF COLLETT STREET NEAR THE EAST FAIRCHILD STREET OVERPASS. EXACT LOCATION WILL BE AS DIRECTED BY THE CITY AT THE TIME OF CONSTRUCTION.

#### REQUIRED HIGHWAY STANDARDS LEGEND 000001-06 STANDARD SYMBOLS, ABBREVIATIONS, AND PATTERNS PROPOSED MANHOLE 280001-07 PROPOSED INLET TEMPORARY EROSION CONTROL SYSTEMS 420401-12 PERPENDICULAR CURB RAMPS TRENCH BACKFILL - CU YD INLET AND PIPE PROTECTION (BEFORE PAVING INLET FILTER (AFTER PAVING) 424001-10 DEPRESSED CORNER FOR SIDEWALKS 424021-04 PAVEMENT CONNECTOR (PPC) FOR BRIDGE APPROACH SLAB STRUCTURE OR FIRE HYDRANT TO BE REMOVED 515001-03 NAME PLATE FOR BRIDGES WATER VALVE OR METER TO BE ADJUSTED (A) 602301-04 INLET. TYPE A (A) FRAME AND LID TO BE ADJUSTED 602306-03 INLET, TYPE B $\langle A \rangle$ FIRE HYDRANT TO BE ADJUSTED 602401-04 MANHOLE, TYPE A М FIRE HYDRANT TO BE MOVED 602601-05 PRECAST REINFORCED CONCRETE FLAT SLAB TOP SSWMR STORM SEWER (WATER MAIN REQUIREMENT) 602701-02 MANHOLE STEPS L = 610.95LID ELEVATION 604001-04 FRAME AND LIDS, TYPE 1 INVERT ELEVATION INV = 608.30604036-03 GRATE, TYPE 8 EL = 610.52 FLOWLINE FLEVATION 604041-03 FRAME AND GRATE, TYPE 9 TO BE REMOVED CONCRETE CURB TYPE B AND COMBINATION CONCRETE CURB AND GUTTER PROPOSED STORM SEWER 606001-07 OFF-ROAD OPERATIONS, 2L, 2W, 15' TO 24" FROM PAVEMENT EDGE جديميميميمي STORM SEWER REMOVAL 701006-05 PERIMETER EROSION BARRIER 701326-04 LANE CLOSURE, 2L, 2W, PAVEMENT WIDENING, FOR SPEEDS > 45MPH STDEWALK REMOVAL 701801-06 SIDEWALK, CORNER OR CROSSWALK CLOSURE PORTLAND CEMENT CONCRETE DRIVEWAY REMOVAL 701901-07 TRAFFIC CONTROL DEVICES 000000 PROPOSED RIPRAP

#### HOT-MIX ASPHALT MIXTURE REQUIREMENTS

LOCATION	VOORHEES	MAY &	ROGERS
MIXTURE USES	HMA SURF CRSE	HMA SURF CRSE	HMA BINDER COURSE
PG .	PG 64-22	PG 64-22	PG 64-22
DESIGN AIR VOIDS	. 4% @ N50	4% @ N50	4% @ N50
MIX COMPOSITION: GRADATION MIXTURE).	IL-9.5	IL-9.5	IL-19.0
RICTION AGGREGATE	MIX "D"	MIX "D"	N/A
DUALITY MANAGEMENT	QC/QA	QC/QA	QC/QA
SUBLOT SIZE	N/A	N/A	N/A

DETECTABLE WARNING

HMA QUANTITIES CALCULATED USING 112 1 BZSYZĪN

	· · · · · · · · · · · · · · · · · · ·			^
FILE NAME =	USER NAME = JDaen	DESIGNED - AWM/BAN	RÉVISED -	2/6/18 /1
3999sht-GenNotes.dgn		DRAWN - TJD/CET	REVISED -	
	PLOT SCALE = 2.00000 '/ in.	CHECKED - AWM/BAN	REVISED -	
\$MODELNAME\$	PLOT DATE = 2/7/2018	DATE -	REVISED -	

CITY	OF	DANVII	LLE

780001-05

782006

BLR 21-9

BLR 22-7

TYPICAL PAVEMENT MARKINGS

(ROAD CLOSED TO THRU TRAFFIC)

GUARDRAIL AND BARRIER WALL REFLECTOR MOUNTING DETAILS

TYPICAL APPLICATION OF TRAFFIC CONTROL DEVICES FOR CONSTRUCTION

TYPICAL APPLICATION OF TRAFFIC CONTROL DEVICES FOR CONSTRUCTION

ON RURAL LOCAL HIGHWAYS (TWO-LANE TWO WAY RURAL TRAFFIC)

VOORHEES ST BRIDGE AND MAY ST & ROGERS ST RECONSTRUCTION	F.A.U RTE.	SECTION	COUNTY	TOTAL	SHEET NO.
GENERAL NOTES, STANDARDS AND LEGEND	6999	08-00330-02-PV	VERMILION	79	2
GENERAL NOTES, STANDARDS AND LEGEND			CONTRACT	NO. S	91567
SCALE: NONE SHEET 1 OF 1 SHEETS STA. N/A TO STA. N/A	J	ILLINOIS FED. AI	D PROJECT SHAB	7421	

			• •		CTION CODE.
				100%	80% FEDERA
				LOCAL	20% STATE
				ROADWAY	BRIDGE
CODE		1	TOTAL .	- 0004	· 001 <b>D</b>
NO.	ITEM	UNIT	QUANTITY	URBAN	092-7211
△ 20100110	TREE REMOVAL (6 TO 15 UNITS DIAMETER)	UNIT	131		131
△ 20100210	TREE REMOVAL (OVER 15 UNITS DIAMETER)	UNIT	· 18		18
`					
20200100	EARTH EXCAVATION	CU YD	1546	1426	120
~~~~		<u> </u>	June	<u>·                                     </u>	poisson
26400800	FURNISHED EXCAVATION	си ур	415		415
		n	m		<del></del>
20800150	TRENCH BACKFILL	CU YD	415	415	<u> </u>
					<u> </u>
25000200	SEEDING, CLASS 2	ACRE	0.75	0.5	0.25
3 25000400	NITROGEN FERTILIZER NUTRIENT	POUND	51	33	18
A 25222522	NACOLONIS SECTIONALIZADA	50.00	-		
Δ 25000500	PHOSPHORUS FERTILIZER NUTRIENT	POUND	51	33	18
Ž 25000600	POTASSIUM FERTILIZER NUTRIENT	POUND	51	33	18
1		1.547.5	-		+
∆ 25100125	MULCH, METHOD 3	ACRE	0.75	0.5	0.25
28000250	TEMPORARY EROSION CONTROL SEEDING	POUND	237	37	200
28000400	PERIMETER EROSION BARRIER	FOOT	545	- 80	465
	THE ET AND DIDE DRATECTION				
28000500	INLET AND PIPE PROTECTION	EACH	12	12	
28000510	INLET FILTERS	EACH	12	12	
20000010	THE TAIL LAND	CACH	14	14	

SEE SPECIAL PROVISIONS

A SPECIALTY ITEMS

FILE NAME = USER NAME = JDean DESIGNED - AWM REVISED - 2/6/18 J
3999-she-SOOLdgn

DRAWN - TJD REVISED - CITY OF DANVILLE

FULL NAME = DESIGNED - AWM REVISED - 2/6/18 J
CITY OF DANVILLE

VOORHEES ST BRIDGE AND MAY ST & ROGERS ST RECONSTRUCTION RTE
SHEETS NO.

SUMMARY OF QUANTITIES

FULL NAME = JDean DESIGNED - AWM REVISED - CONTROL SHEETS NO.

SUMMARY OF QUANTITIES

FULL NAME = JDean DESIGNED - AWM REVISED - CONTROL SHEETS NO.

SUMMARY OF QUANTITIES

FULL NAME = JDean DESIGNED - AWM REVISED - CONTROL SHEETS NO.

SUMMARY OF QUANTITIES

FULL NAME = JDean DESIGNED - AWM REVISED - CONTROL SHEETS NO.

SCALE: NONE SHEET I OF 7 SHEETS STA. N/A TO STA. N/A TO STA. N/A FULL NOIS | FRO. ECT SHEER NO.

SCALE: NONE SHEET I OF 7 SHEETS STA. N/A TO STA. N/A FULL NOIS | FRO. ECT SHEER NO.

FULL NAME = JDEAN DESIGNED - AWM REVISED - CONTROL SHEET NO.

SCALE: NONE SHEET I OF 7 SHEETS STA. N/A TO STA. N/A TO STA. N/A FULL NOIS | FRO. ECT SHEER NO.

FULL NOIS | FRO. ECT SHEER NO.

SCALE: NONE SHEET I OF 7 SHEETS STA. N/A TO STA. N/A TO STA. N/A FULL NOIS | FRO. ECT SHEER NO.

FULL NOIS | FRO. ECT SHEET NO.

SCALE: NONE SHEET I OF 7 SHEETS STA. N/A TO STA. N/A TO STA. N/A FULL NOIS | FRO. ECT SHEER NO.

FULL NOIS | FRO. ECT SHEET NO.

SCALE: NO. ECT SHEET STA. N/A TO STA. N/A TO STA. N/A FULL NOIS | FRO. ECT SHEET NO.

FULL NO. ECT SHEET NO.

FULL N

LOCATION	20200100 EARTH EXCAVATION	EXCAVATION TO BE USED IN EMBANKMENT ADJUSTED FOR SHRINKAGE *	EMBANKMENT	BALANCE WASTE (+) OR SHORTAGE (-)			
		.cu yd					
MAY ST	1,210.8	968.6	12.0	956.6			
ROGERS ST	215.2	172.2.	0.0	172.2			
FROM VOORHEES ST SCHEDULE			<u>.</u>	(104.0)			
TOTAL	1.426.0	1,140.8	12.0	1,024.8			
USE	1,426	1,141	12	1,025			

\+	⊢	: 1	4	N	١.

			-	SEEDI	[NG			
		X2110104	25000200	25000400	25000500	25000600	25100125	28000250
		TOPSOIL		. FEF	RTILIZER NUTRI	ENT		TEMPORARY
STATION TO STATION		FURNISH AND PLACE, 4" (SPECIAL)	SEEDING, CLASS 2	NITROGEN	PHOSPHORUS	POTASSIUM	MULCH, METHOD 3	EROSION CONTROL SEEDING
		SQ YD.	ACRE		POUND		ACRE	POUND
ROGERS ST	·							
602+72.83	604+45.06	222.30	0.06	. 5.4	5.4	5.4	0.06	6,0
MAÝ ST			-					
13+18.66	16+75.60	609.40	0.15	13.2	13.2	13.2	0.15	. 14.7
16+96.40	19+84.99	506.00	0.12	10.6	10.6	10.6	0.12	11.8
COLLETT	TRT		0.04	3.7	3.7	3,7	0.04	4.1
VOORHEES	ST .	·						
18+83.17	21+12.17		0.25	18.0	18.0	18.0	0.25	200.0
TOTAL		1337.7	0.62	50.9	50.9	50.9	0.62	236.5
USE	:	1338	0.75	51	51	51	0.75	237

## PERIMETER EROSION BARRIER

		28000400				
STATION .	PERIMETER EROSION BARRIER					
	FOOT					
MAY ST	MAY ST					
13+24.05	13+47.09	26.6				
13+24.43	13+34.55	27.1				
19+48.08	19+69.09	25.5				
TOTAL		79.2				
USE		80				

INLET AND PIPE PROTECTION									
			28000500	28000510					
STATION	OFFSET	SIDE	INLET AND PIPE PROTECTION	INLET FILTERS					
	FOOT		EAG	CH					
ROGERS ST									
603+90.00	12.00	RŦ	1	1					
603+90.00	12.00	Lī	1	1					
MAY ST	-								
13+66.21	12.00	LT	i	1					
14+05.00	19,65	RT	1	1					
16+69.94	45.00	RT	1	1 .					
16+70.27	47.01	<u>L</u> T	1	1					
16+99.29	46.97	į, jos	1	1					
16+97.94	47.00	RT	1	1					
16+99.77	18.66	Rī	1	1					
17+08.84	13.27	LĪ	1	1 -					
19+75.00	32.00	ĹĪ	1	1					
19+76.96	31.01	RT	. 1	1					
TOTAL			12	12					
USE			12	12					

			T		28100107	28200200
STATION	TO STATION	SIDE	HTGIW	LENGTH	STONE RIPRAP, CLASS A4	FILTER FABRIC
		· FT		T	SQ YD	
MAY ST						
13+36.2	13+46.2	· LT	10	17.4	19.3	19.3
VOORHEES	ST					
SEE STRUCTURE PLANS					95.0	95.0
TOTAL					114.3	114.3
USE		. 115	115			

FILE NAME =	USER NAME = JDeen	DESIGNED - AWM	REVISED - 2/6/18 /1
3999-sht-ScheduleØl.dgn		DRAWN - TJD	REVISED -
	PLOT SCALE = 2,0000 '/ in.	CHECKED - AWM	REVISED -
\$MODELNAME\$	PLOT DATE = 2/7/2018	DATE -	REVISED -

#### PAVEMENT SCHEDULE

STATION TO STATION		35100700	40600275	40600290	40603080	40603335	
			BITUMINOUS	MATERIALS	HOT-MIX ASPHALT	HOT-MIX ASPHALT	
		AGGREGATE BASE COURSE, TYPE A, 8"	PRIME TACK COAT COAT		BINDER COURSE, IL-19.0, N50	SURFACE COURSE, MIX "D", N50	
		SO YD	POUND		TON		
ROGERS ST							
602+80.33	604+18.71	430.6	761.1	76.1	42.6	33.1	
MAY ST							
13+46.16	14+28.20	410,1	779.2	77.9	43.6	33,9	
14+28.20	16+52.16	696.8	1231.8	123.2	69.0	53.7	
16+52.16	17+15.62	446.9	860.1	86.0	48.2	37.5	
17+15.62	19+46.75	719.0	1271.2	127.1	71.2	. 55.4	
19+46.75	20+11,54	391.4	756.2	75.6	42.3	32.9	
TOTAL		3094.9	5659.5	565.9	316.9	246.5	
USE		3095	5660	566	317	247	

#### ENTRANÇE SCHEDULE

		MINOR OCHEROLE	
	42001300	40200500	42300200
LOCATION	PROTECTIVE COAT	AGGREGATE SURFACE COURSE, TYPE A 6"	PORTLAND CEMENT CONCRETE DRIVEWAY PAVEMENT 6"
		SQ YD	
ROCERS ST			
603+00.76 RT	10.1		10.1
603+05.76 LT	6.9		6.9
603+30.61 LT	5.7		5.7
603+44.83 RT	18.2	-	18.2
603+89.98 RT	16.9		16.9
MAY ST -			
13+36.12		38.0	
15+08.33 RT	16.9		16.9
15+28.97 RT	18.2		18.2
16+14.39 LT	7.9		7.9
17+63.71 RT	14.3		14.3
17+68.97 LT	8.4		8.4
18+56.67 RT	23.3		23.3
18+21.7 LT	8.2		8.2
18+36.18 RT	18.0		18.0
18+37.32 LT	9.7		9.7
TOTAL	182.6	38.0	182.6
USE	183	38	183

	PORTLAND	CEMENT	CONCRE	TE SIDEWAL	K 5 INCH
				42001300	42400200
STATION T	O STATION	SIDE	MIDIH	PROTECTIVE COAT	PORTLAND CEMENT CONCRETE SIDEWALK 5 INCH
				SO YD	SQ FT
ROGERS ST			: '		<u>:</u>
600+30.28	604+55.64	LT	6′	288.2	2593.8
MAY ST		,		•	
13+54.09	13+65.53	.LT	6′	11.1	100.0
13+65.58	15+06.00	LT	5′	77.9	701.1
16+25.00	16+55.51	LT	5'	16.9	151.9
16+55.51	16+70.41	LT	6′	13.7	123.7
16+58.88	16+64.89	RT	5′-6′	8.4	76.0
16+99.02	17+13.35	LT	6′	16.4	147.3
17+01.39	17+07.4	RT	5′-6′	8.5	76.8
17+13.35	17+50.00	ŁΤ	5′	20.3	183.0
18+26,51	19+56.56	LT	5′	72.2	649.8
19+56.56	19+73.74	LT	6′	8.9	80.0
TOTAL				542.6	4883.4
USE				543	4884

#### HINFAR DETECTABLE WARNING

					42400800	
STATION T	O STATION	OFFSI OFF	ET TO . SET	SIDE	DETECTABLE WARNINGS	
					SQ FT	
MAY ST						
13+54.59	13+59.59	13,08	15.08	LT	10.0	
16+59,38	16+64.38.	17.80	19.80	RT	10.0	
17+01.91	17+06.91	17.83	19.83	RT	10.0	
TOTAL			<u></u>		30.0	
JSE					30	

	RADIAl	_ DETECT	ABLE WAR	NING				
			OUTER	INNER	42400800			
LOCATION	OUTER RADIUS	INNER RADIUS	ARC LENGTH	ARC LENGTH	DETECTABLE WARNINGS			
		. F00T						
ROGERS ST & MA	AY ST							
SW CORNER	17.92	15.92	7.52	6.68	14.20			
BALDWIN ST & N	AY ST							
NW CORNER	17.92	15.92	12.66	9.36	22.03			
NE CORNER	17.92	15.92	11.95	8.65	20.61			
COLLETT ST & #	MAY ST							
NW CORNER	32.92	35.92	9.11	8.16	17,19			
TOTAL	.!				74.03			
USE					. 75			

#### ENTRANCE AND SIDEWALK REMOVAL

FINI	ENTRANCE AND SIDEMALK KEMOVAL							
			44000200	44000600				
STATION T	O STATION	SIDE	DRIVEWAY PAVEMENT REMOVAL	SIDEWALK REMOVAL				
			ŞQ YD	SQ FT				
ROGERS ST								
600+30.28	600+35.07	LΤ		3.5				
603+25.18	603+34.44	LΤ	5.2					
MAY ST								
14+18.91	14+36.33	LT	4.6					
14+29.99	14+32.60	RT		19.9				
14+37.75	15+06.00	LT		225.3				
15+13.93	15+21.82	RT		64.6				
16+25.00	16+66.54	ŁT	·	231.0				
16+61.12	16+65.88	RT		24.6				
17+02.5	17+07.48	RT		31.2				
17+02.37	17+50.00	LT		289.0				
17+74.59	17+84.67	LŦ		23.2				
TOTAL			9.8	912.4				
USE			10	913				

#### PIPE CULVERT REMOVAL

			50105220		
STATION T	O STATION	SIDE	PIPE CULVERT REMOVAL		
1			FOOT		
MAY ST					
16+04.29	16+42.30	LT	38.1		
TOTAL	38.1				
USE			39		

CITY OF DANVILLE

•						
MAY ST & ROGERS ST RECONSTRUCTION	F.A.U RTE.		SECTION	COUNTY	TOTAL SHEETS	SHE
	6999		08-00330-02-PV	VERMILION	-79	12
SCHEDULES OF QUANTITIES				CONTRACT	UNITY SHEETS NO. MILION 79 12 TRACT NO. 9156	
CONTEST 1 OF 7 SUPERTY STA NAME TO STA NAME			THE INDISPED A	IN PROJECT SHEE	3(742)	

#### TREE REMOVAL

-	-			
			20100110	20100210
STATION	0FFSET	SIDE	6 TO 15 UNITS	OVER 15 UNITS
18+96	80'	RIGHT	8	
19+00	66′	RIGHT	8	
19+00	76′	RIGHT.	6	
19+06	22'	RIGHT	10	
· 19+06	23'	RIGHT	10	
19+09	22'	RIGHT	. 6	
19+11	52'	RIGHT	6	
19+16	36′	RIGHT	6	
19+17	23′	RIGHT	9	
19+23	55′	RIGHT	8	
19+27	25′	RIGHT	14	
19+28	23'	RIGHT		18
19+44	73′	RIGHT	8	
19+46	46′	RIGHT	12	
<i>19+51</i>	39′	RIGHT	12	
19+71	27′	RIGHT	8	
-		TOTAL	131	18

#### EARTHWORK SUMMARY

	20200100	50200100	]	
STATION TO STATION	EARTH EXCAVATION	STRUCTURE EXCAVATION	FILL	WASTE (SHORTAGE)
	CU YD .	CU YD	CU YD	CU YD ·
RDWY 18+83.17 - 19+49.17	57		501	(458)
RDWY 20+52.17 - 21+12.17	63		4	43
CHANNEL				
STRUCTURE	·	415		311
COFFERDAM	1			
TOTAL	120	415.	505	(104)
USE	120	415	-	(104)
• •			(a) 25°	( CHDINKACE)

\* SEE EARTHWORK ON SHEET 12 AND GENERAL NOTE REGARDING STOCKPILING EARTH.

### PERIMETER EROSION BARRIER

		28000400
STATION TO STATION	SIDE	F00T
18+83 - 19+49	RIGHT	<i>1</i> 95
19+00 - 19+49	LEFT	55
20+52 - 21+12	LEFT	65
20+52 - 21+92	RIGHT	150
	TOTAL	465

#### AGGREGATE BASE COURSE, TYPE A

				-	35100100
STATION TO STATION	SIDE	THICKNESS	WIDTH	LENGTH	TON
18+95.00 - 19+13.17	RIGHT	0.33′	3.44' AVG.	18.17'	1
19+00.00 - 19+13.17	LEFT	0.33'	2.88' AVG.	13.17′	$I_{\cdot}$
20+82.17 - 21+12.17	LEFT.	0.331	3.18' AVG.	30.00'	2
20+82.17 - 21+12.17	RIGHT	0,33′	3.57' AVG.	30.00′	3
				TOTAL	7

#### HOT-MIX ASPHALT SURFACE REMOVAL, 2 1/4"

·		-	44000158
STATION TO STATION	WIDTH	LENGTH	SQ YD
18+83.17 - 19+03.17	24.81' AVG.	20.00'	55
20+92.17 - 21+12.17	24.15' AVG.	20.00'	54
٠.	-	TOTAL	109

#### MANHOLES TO BE ADJUSTED

			60255500
STATION	OFFSET	SIDE	EACH
18+89	<i>16'</i> ·	RIGHT	1
		TOTAL	1
		STATION OFFSET 18+89 16'	STATION OFFSET SIDE 18+89 16' RIGHT

#### PORTLAND CEMENT BASE COURSE WIDENING 9 3/4"

				35400475
STATION TO STATION	SIDE	WIDTH	LENGTH	SQ YD
18+95.00 - 19+03.17	RIGHT	0.37' AVG.	8.17′	1
19+00.00 - 19+03.17	LEFT	0.09' AVG.	3.17′	1
20+92.17 - 21+12.17	LEFT	0.62' AVG.	20.00'	i
20+92.17 - 21+12.17'	RIGHT	0.73' AVG.	20.001	2
		-	TOTAL	5

#### PAVEMENT SCHEDULE

				<del></del>	
· · · · · · · · · · · · · · · · · · ·		-	40600290	40603335	42000080
STATION TO STATION	WIDTH	LENGTH	TACK COAT POUND 0.05 LBS/SO FT	HOT-MIX ASPHALT SURF CSE TON 112#/SQ YD/IN	PAVEMENT CONNECTOR (PCC) FOR BRIDGE APPROACH SLAB SQ YD
18+83.17 - 19+03.17	24.82' AVG.	20.00'	25	7	
19÷03.17 - 19÷13.17	26.84' AVG.	10.00'		·	30
20+82.17 - 20+92.17	27.12' AVG.	10.00'		1. 1	30
20+92.17 - 21+12.17	24.12' AVG.	20.00′	25	7	
		TOTAL	50	14	60

### PORTLAND CEMENT CONCRETE SIDEWALK 5 INCH

				42400200
STATION TO STATION	SIDE	WIDTH	LENGTH	SQ FT
18+83.17 - 19+13.17	RIGHT	VARIES	30.00'	238
20+82.17 - 21+91.89	RIGHT	9' & VAR.	139.72	940
			TOTAL	1,178

#### PAVEMENT REMOVAL

	•			44000100
	STATION TO STATION	WIDTH	LENGTH	SQ YD
-	19+03.17 - 19+60.42	VARIES	57.25'	173
	20+40.92 - 20+92.17	VARIES	51.25'	156
			TOTAL	329

### COMBINATION CONCRETE CURB AND GUTTER REMOVAL

•		44000500
TATION TO STATION	SIDE	F00T
18+95 - 19+40	RIGHT	45
19+00 - 19+37	LEFT	37
20+68 - 21+12	LEFT	44
20+61 - 21+12	RIGHT	51
	TOTAL	177

### SIDEWALK REMOVAL

					44000600
-	STATION TO STATION	SIDE	WIDTH	LENGTH	SQ FT
	18+83.17 - 19+60.43	RIGHT	VARIES '	77.26′	300
	19+36.91 - 19+60.43	LEFT	2.16' AVG.	23.52'	51
	20+40.84 - 20+67.24	LEFT	2.09' AVG.	26.40'	55
	20+40.84 - 21+91.77	RIGHT	VARIES	150.93'	<i>850</i> .
		1.		TOTAL	1,256

### COMBINATION CONCRETE CURB AND GUTTER, TYPE B-6.18

		60604400
STATION TO STATION	SIDE	FOOT
18+87 - 18+89	RIGHT.	2
19+00 - 19+13	LEFT	13
21+06 - 21+12	LEFT	. 6
20+82 - 21+12	RIGHT	30
	TOTAL	51

#### PAINT PAVEMENT MARKING - LINE 4"

	÷	• •	78001110
STATION TO STATION	SIDE	DESCRIPTION	F007
18+83.17 - 21+12.17	£	YELLOW SKIP DASH	57
		TOTAL	57

### CHAIN LINK FENCE TO BE REMOVED AND RE-ERECTED

•		X6640304
STATION TO STATION	SIDE	FOOT
18+83 - 19+31	RIGHT	50
	TOTAL	50

# EVERGREEN, THUJA ACCIDENTALIS (AMERICAN ABBORVITAE), 6' HEIGHT, BALLED AND BURLAPPED

		D2003772
STATION TO STATION	SIDE	EACH
19+13	LEFT	1
19+13	RIGHT	1
20+75	LEFT	. 1
20+75	RIGHT	1
20+80 - 21+75	LEFT	17
	TOTAL	21


#### LANDSCAPING GRAVEL

•				XU323111
STATION TO STATION	SIDE	WIDTH	LENGTH-	SQ YD
20+74 - 21+79	LEFT	6′	1051	70
:			TOTAL	70

			, Α
FILE NAME =	USER NAME = JDaen	DESIGNED - BAN	REVISED - 2/5/18 /1
3999-sht-Voorhees@01.dgn		DRAWN - CET	REVISED -
	PLOT SCALE = 2.00000'/ im.	CHECKED - BAN/CTM	REVISED -
\$MODELNAME\$	PLOT DATE = 2/7/2018	DATE -	REVISED -

CITY OF DANVILLE

ORHEES ST OVER STONEY CREEK		F.A.U RTE.	SECTION	COUNTY	ŀ
SCHEDULES OF QUANTITIES		6999	08~00330-02-PV	VERMILION	ĺ
SOULD SEE OF WORKHING				CONTRACT	Ī
3 OF 3 SHEETS STA. N/A	TO: STA. N/A		TIL MOTS EED	ATD RED IECT SHEEK	ā

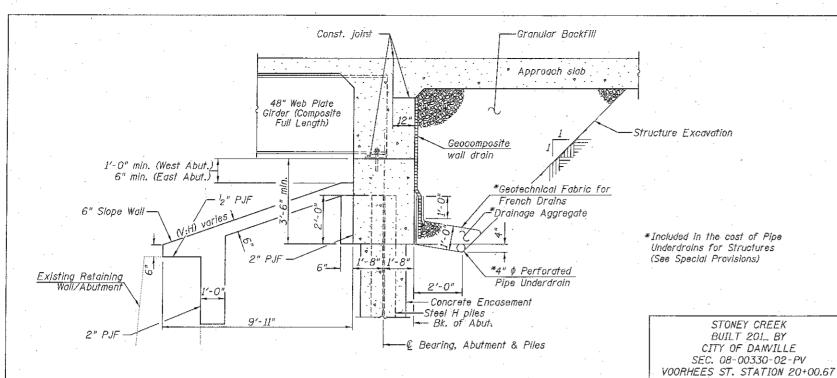

All drainage system components shall extend to inside face of each existing wingwall except the \*pipe underdrain shall extend to the outside face of existing wingwalls. A \*hole shall be drilled into the existing wingwalls for the pipe underdrain to exit through.

#### GENERAL NOTES

SECTION THRU INTEGRAL ABUTMENT

Fasteners shall be ASTM A325 type 3. Bolts  $^34$   $^{\circ}$   $^{\circ}$ , holes  $^{15}_{16}$   $^{\circ}$   $^{\circ}$ , unless otherwise noted.

Calculated weight of Structural Steel = 124,310 lb (AASHTO M270 Gr. 50W) All structural steel shall be AASHTO M270 Gr. 50W.

No field welding is permitted except as specified in the contract documents. Reinforcement bars designated (E) shall be epoxy coated.

The existing structural steel coating contains lead. The Contractor shall take appropriate precautions to deal with the presence of lead on this project.

Structural steel shall only be painted for a distance equal to the depth of embedment into the concrete cap plus 18 inches. Painted areas shall be primed in the shop with a Department approved zinc rich primer. Field painting will not be required.

Layout of slope protection system may be varied to suit ground conditions in the field as directed by the Engineer.

See Special Provisions for soil boring logs.

Plan dimensions and details relative to existing plans are subject to nominal construction variations. The Contractor shall field verify existing dimensions and details affecting new construction and make necessary approved adjustments prior to construction or ordering of materials. Such variations shall be not cause for additional compensation for a change in scope of the work, however, the Contractor will be paid for the quantity actually furnished at the unit price bid for the work.

The Contractor shall make allowance for the deflection of forms, shrinkage and settlement of falsework, in addition to allowance for dead load deflection for the approach slabs.

#### INDEX OF SHEETS

		THE EN OF OFFICE TO
	SH. #'s	DESCRIPTION
	1	General Plan and Elevation
	2	Bill of Material, Details and General Notes
	3	Slope Wall Details
	4-5	Top of Slab Elevations
	6-7	Top of Approach Slab Elevations
	8	Superstructure
	. 9	Superstructure Details
	10-11	DESCRIPTION  General Plan and Elevation Bill of Material, Details and General Notes Slope Wall Details Top of Slab Elevations Top of Approach Slab Elevations
	12-15	Approach Slab Details
16 Drainage Scupper, DS-11		
	. 17	Rail Post Spacing Details
٠	18-18A	Bridge Fence Railing Details
	19	Framing Plan
j	- 20	Structural Steel Details
	21.	
	22-23	Concrete Removal & Repair
	. 24	1 General Plan and Elevation 2 Bill of Material, Details and General Notes 3 Slope Wall Details 4-5 Top of Slab Elevations 6-7 Top of Approach Slab Elevations 8 Superstructure 9 Superstructure Details 10-11 Diaphragm Details 2-15 Approach Slab Details 16 Drainage Scupper, DS-11 17 Rail Post Spacing Details 18-18A Bridge Fence Railing Details 19 Framing Plan 20 Structural Steel Details 21 Bearing Details 22-23 Concrete Removal & Repair 24 West Abutment 25 East Abutment 26 HP Pile Details 27 Concrete Parapet Slipforming Option
		East Abutment
		HP Pile Details
		Concrete Parapet Slipforming Option
ļ	28-30	Existing Plans
	- "	

#### TOTAL BILL OF MATERIAL

ITEM	UNIT	SUPER	SUB ·	TOTAL
Stone Riprap, Class A4	SQ YD		95	95
Filter Fabric	SQ YD		95	95
Granular Backfill for Structures	CU YD		120	120
Removal of Existing Superstructure	EACH			1
Structure Excavation	CU YD		415	415
Concrete Structures	CU-YD		68.2	68.2
Concrete Superstructure	CU YD	194.8		194.8
Concrete Superstructure (Approach Slab)	CU YD	148.6		148.6
Bridge Deck Grooving	SQ YD	525		525
Protective Coat	SQ YD	970	<del> </del>	970
Furnishing and Erecting Structural Steel	L SUM	1		1
Reinforcement Bars, Epoxy Coated	POUND	96,140	7,300.	103,440
Stud Shear Connectors	EACH	2,466		2,466
Anchor Bolts, 1"	EACH		24	24
Structural Repair of Concrete (Depth equal to or less than 5")	SQ FT		36	36
Structural Repair of Concrete (Depth more than 5")	SQ FT	·	47	47
Slope Wall 6 Inch	SQ YD		85	85
Furnishing Steel Piles HP14x89	FOOT		595	595
Setting Piles in Rock	EACH		14	14
Name Plates	EACH	1		1
Concrete Encasement	CU YD	. —	59.8	59.8
Bridge Fence Railing (Sidewalk)	FOOT	168		168
Bridge Fence Railing	FOOT	168		168
Conorete Removal	CU YD		41.7	41.7
Geocomposite Wall Drain	SQ YD	<del></del>	56	56
Pipe Underdrains For Structures 4"	FOOT		76	76
Drainage Scuppers, DS-11	EACH	2		2
) See Special Provisions				

(1) See Special Provisions

	^	
REVISED	2/6/18 //	Т
REVISED		٦
REVISED		٦.
REVISED		٦

SHEET NO. 2 OF 30 SHEETS

 <u></u>							
F.A.U. RTE.	SECTION	COUNTY	TOTAL SHEETS	SHEET NO.			
6999	08-00330-02-PV	VERMILION	79	35			
	. 5N 092-7211	CONTRACT	NO. 9	1567			
FED. RO	DAD DIST. NO. 7 ILLINOIS	. FED. AID PROJE	CT SH88(7-	12)			

F.A. PROJ. SH8B(742) STR. NO. 092-7211 LOADING HL-93

NAME PLATE

Locate Name Plate on Parapet S.W. Corner of Bridge (See Std. 515001)

DESIGNED - CTM

DRAWN - CET/CTM