


BRIDGE DECK SLAB REPAIR

S.N. 092-0048

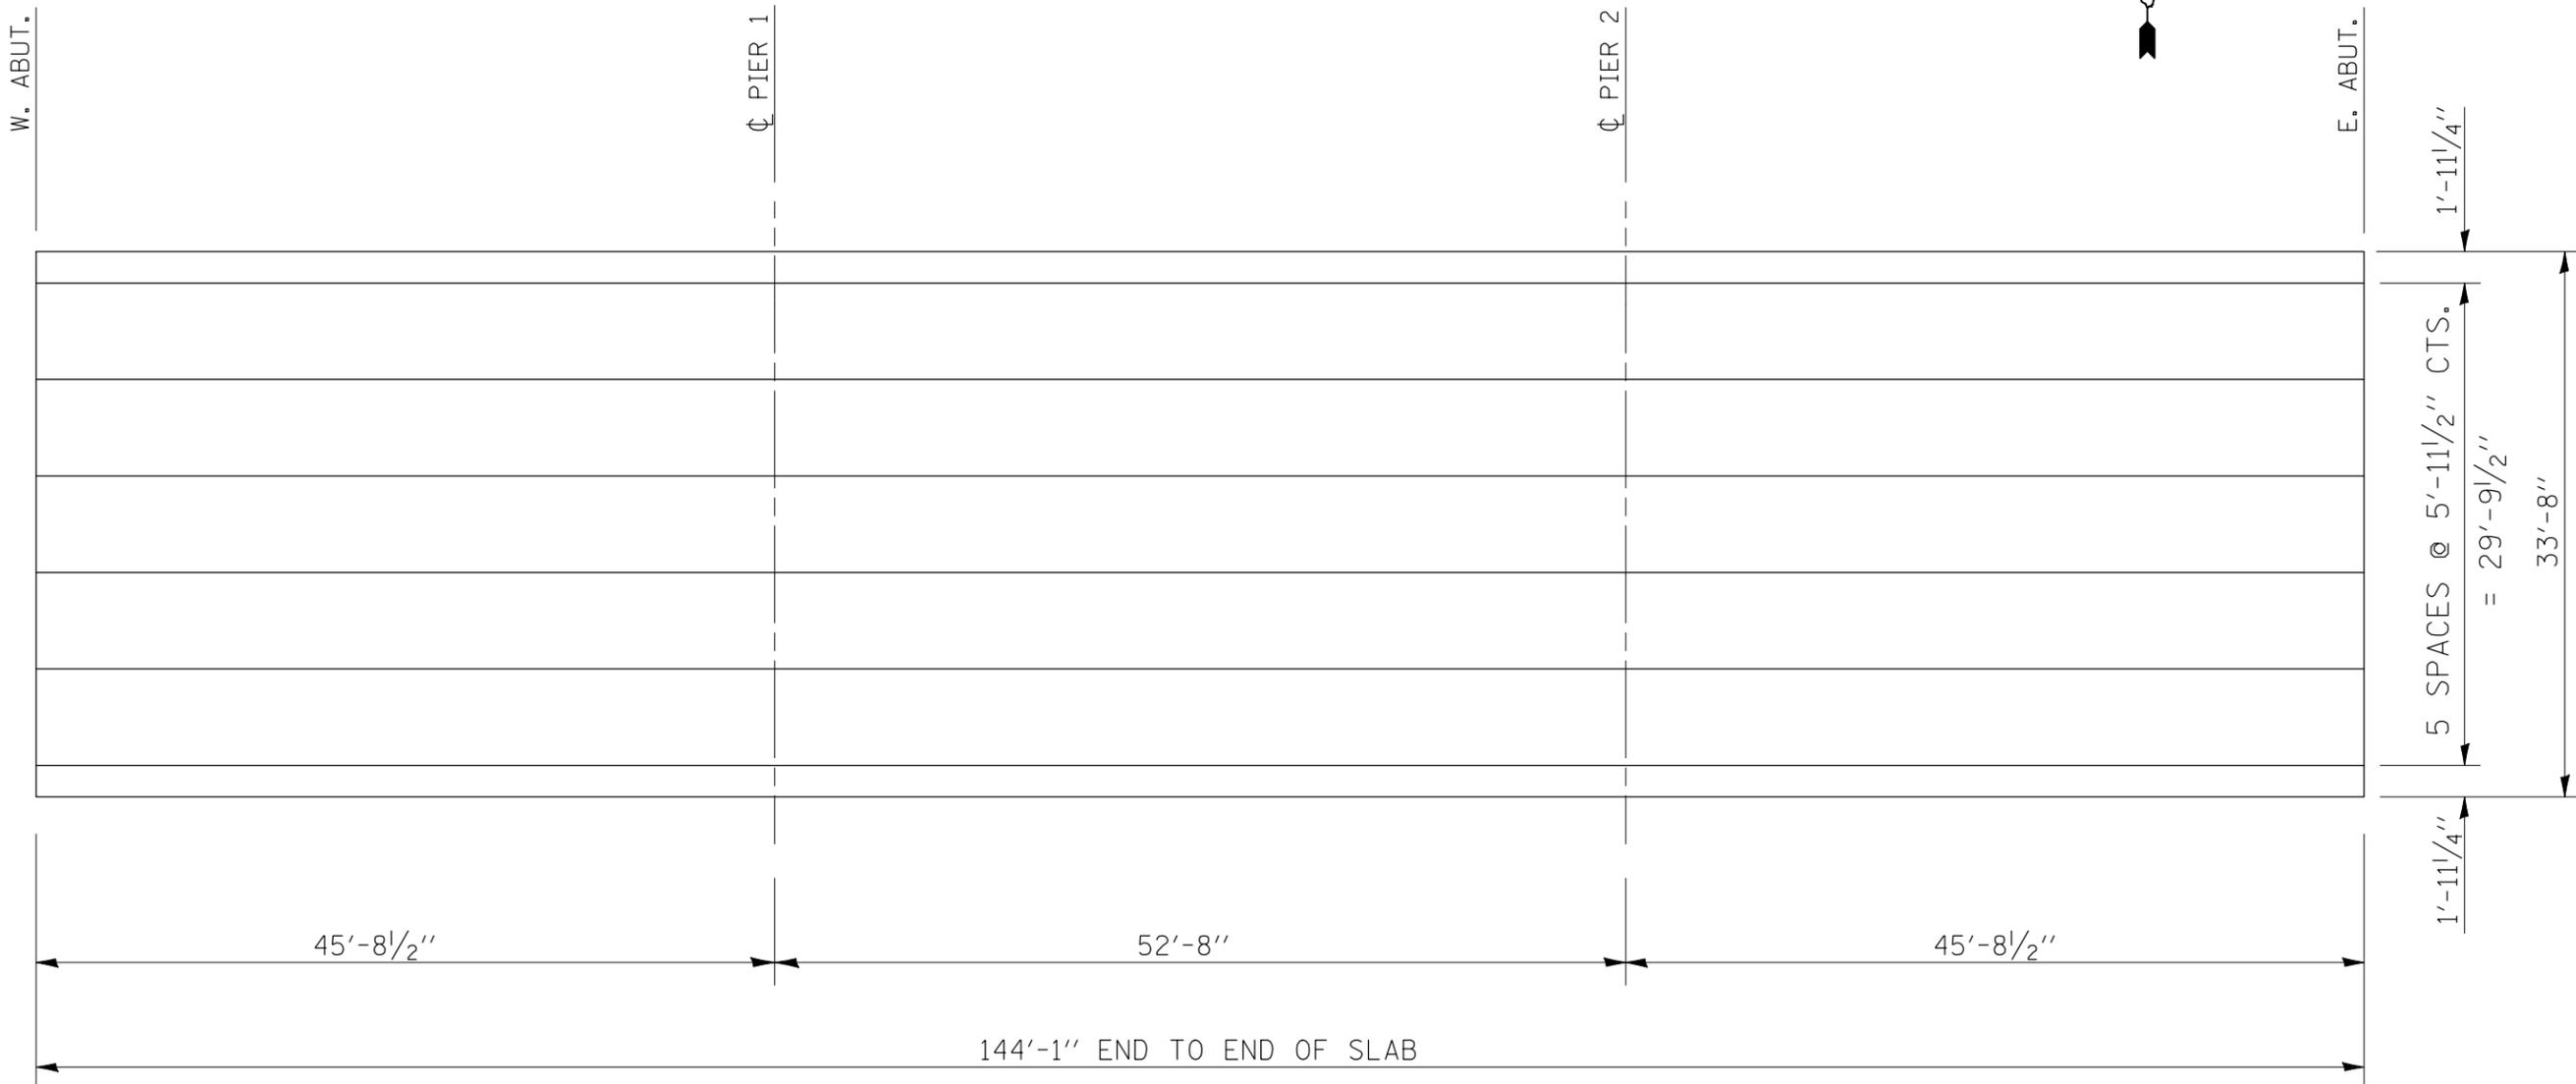

PLAN VIEW OF AS-BUILT PATCHES

= FULL DEPTH PATCHES

= PARTIAL DEPTH PATCHES

FILE NAME =	USER NAME = ceorlockjd	DESIGNED - SC	REVISED -	STATE OF ILLINOIS DEPARTMENT OF TRANSPORTATION	BRIDGE DECK SLAB REPAIR S.N. 092-0048 (AS-BUILT)	F.A.P. RTE.	SECTION	COUNTY	TOTAL SHEETS	SHEET NO.	
ct:\pw\work\PWIDOT\CEARLOCKJD\dms87656\0590866-Hyd.dgn		DRAWN - JP	REVISED -			697	46RS-8&1RS-2&46BDR	VERMILION	75	47	
		CHECKED -	REVISED -			CONTRACT NO. 90866					
		DATE - 12-16-08	REVISED -			FED. ROAD DIST. NO. ILLINOIS FED. AID PROJECT					
				SCALE: NA		SHEET NO. 8 OF 17 SHEETS		STA.		TO STA.	