## INDEX OF SHEETS

SHE	ET NO.	DESCRIPTION
	1	COVER SHEET
	2	INDEX OF SHEETS, STATE STANDARDS, GENERAL NOTES
	3	SUMMARY OF QUANTITIES
	4	TYPICAL SECTIONS
	5	ROADWAY PLAN
	6-7	PAVEMENT MARKING PLAN
	8-16	MAINTENANCE OF TRAFFIC AND STAGING PLANS
	17 .	GENERAL PLAN AND ELEVATION
	1 8	STAGE CONSTRUCTION DETAILS
	19	CONCRETE REMOVAL DETAILS
	20	DECK SLAB REPAIRS
	21-22	SUPERSTRUCTURE DETAILS
	23	DRAIN DETAILS
	24	PREFORMED JOINT STRIP SEAL
	25	BAR SPLICER ASSEMBLY AND MECHANICAL SPLICER DETAILS
	26	DETAILS FOR CONCRETE MEDIAN TYPE SB (DOWELLED) CORRUGATED MEDIAN (MODIFIED)
	27	BUTT JOINTS AND HMA TAPER
	28	TRAFFIC CONTROL AND PROTECTION FOR SIDE ROADS, INTERSECTIONS AND DRIVEWAYS
	29	RAISED REFLECTIVE PAVEMENT MARKERS (SNOW PLOW RESISTANT)
	3.0	DISTRICT ONE TYPICAL PAVEMENT MARKINGS
	31	TRAFFIC CONTROL AND PROTECTION AT TURN BAYS TO REMAIN OPEN TO TRAFFIC
	32	ARTERIAL ROAD INFORMATION SIGN
	33	DRIVEWAY ENTRANCE SIGNING

### STATE STANDARDS

STANDARD NO.	DESCRIPTION
△ 000001-05 420401-08 515001-03	STANDARD SYMBOLS, ABBREVIATIONS AND PATTERNS  BRIDGE APPROACH PAVEMENT CONNECTOR  NAME PLATE FOR BRIDGES
606001 - 04	CONCRETE CURB TYPE B AND COMBINATION CONCRETE CURB AND GUTTER
606301-04	PC CONCRETE ISLANDS AND MEDIANS
701 422-02	LANE CLOSURE, MULTILANE, FOR SPEEDS GREATER THAN OR EQUAL TO 45 MPH TO 55 MPH
701 426-03	LANE CLOSURE, MULTILANE, INTERMITTENT OR MOVING OPERATIONS FOR SPEEDS GREATER THAN OR EQUAL TO 45 MPH
701 431 - 05	LANE CLOSURE, MULTILANE, UNDIVIDED WITH CROSSOVER FOR SPEEDS GREATER THAN OR EQUAL TO 45 MPH TO 55 MPH
701801-04	LANE CLOSURE MULTILANE 1W OR 2W CROSSWALK OR SIDEWALK CLOSURE
701 901 - 01	TRAFFIC CONTROL DEVICES
720001 - 01	SIGN PANEL MOUNTING DETAILS
720006-02	SIGN PANEL ERECTION DETAILS
728001-01	TELESCOPING STEEL SIGN SUPPORT
780001 - 02	TYPICAL PAVEMENT MARKINGS
781 001 - 03	TYPICAL APPLICATIONS RAISED REFLECTIVE PAVEMENT MARKERS

## GENERAL NOTES - ROADWAY

- BEFORE STARTING ANY EXCAVATION, THE CONTRACTOR SHALL CALL "J.U.L.I.E." AT (800)892-0123 FOR FIELD LOCATIONS OF BURIED ELECTRIC, TELEPHONE AND GAS UTILITIES. (48 HOUR NOTIFICATION IS REQUIRED.)
- THE CONTRACTOR SHALL COORDINATE CONSTRUCTION ACTIVITIES WITH UTILITY COMPANIES.
- THE CONTRACTOR WILL NOT BE ALLOWED TO SET UP A YARD OR FIELD OFFICE ON STATE PROPERTY WITHOUT WRITTEN PERMISSION FROM THE DEPARTMENT.
- ALL DAMAGE TO EXISTING PAVEMENT MARKING OR RAISED REFLECTIVE PAVEMENT MARKERS OUTSIDE THE REMOVAL LINE SHOWN ON THE PLANS SHALL BE REPLACED AT THE CONTRACTORS EXPENSE.
- WHEN MILLED PAVEMENT IS OPEN TO TRAFFIC THE MAXIMUM GRADE DIFFERENTIAL BETWEEN PASSES OF THE MILLING MACHINE SHALL NOT EXCEED 1 1/2 INCHES WHERE THE SPEED LIMIT IS 45 MPH OR LESS INCH WHERE THE SPEED LIMIT IS GREATER THAN 45 MPH. WITH WRITTEN APPROVAL FROM THE ENGINEER, A MAXIMIM GRADE DIFFERENTIAL OF 3 INCHES MAY BE ALLOWED IF THE EDGE OF THE MILLING IS SLOPED
- BUTT JOINTS WILL BE INSTALLED AT THE ENDS OF ALL RESURFACING (WHERE RESURFACING MEETS EXISTING PAVEMENT). IN ACCORDANCE WITH "BUTT JOINT AND HOT-MIX ASPHALT TAPER DETAILS" SHEET INCLUDED IN THE PLANS, UNLESS OTHERWISE SPECIFIED.
- THE RESIDENT ENGINEER SHALL CONTACT THE DISTRICT ONE TRAFFIC CONTROL SUPERVISOR AT (847) 705-4470 A MINIMUM OF 72 HOURS PRIOR TO THE PLACEMENT OF ANY TEMPORARY TRAFFIC CONTROL DEVICES.
- WHEN ARTIFICIAL LIGHTING IS UTILIZED IN NIGHT OPERATIONS, THE CONTRACTOR SHALL EXERCISE THE UTMOST PRECAUTIONS IN PREVENTING ADVERSE VISIBILITY TO THE MOTORING PUBLIC AND ADJOINING RESIDENTIAL
- BEFORE BEGINNING ANY WORK, THE CONTRACTOR SHALL RETAIN AND RECORD (FOR FUTURE REFERENCES), ALL EXISTING PAVEMENT MARKING LINES AND RAISED REFLECTIVE PAVEMENT MARKERS IN ORDER THAT THESE LOCATIONS CAN BE RE-ESTABLISHED FOR STRIPING. EXACT LOCATIONS OF
- 10. THE ENGINEER SHALL CONTACT MR. WALLY TRAFFIC FIELD ENGINEER (OR TECHNICIAN), A MINIMUM OF TWO WEEKS PRIOR TO THE START OF THIS PROJECT SO THAT EXACT STATIONING OF NO PASSING ZONES AND OTHER PERMANENT PAVEMENT MARKINGS MAY BE ESTABLISHED.
- 11. DO NOT SCALE PLANS FOR CONSTRUCTION DIMENSIONS.
- THESE PLANS HAVE BEEN PREPARED FROM NOTES RECEIVED FROM BRIDGE
- PAVEMENT MARKING TAPE, TYPE III SHALL BE USED FOR SHORT TERM PAVEMENT MARKINGS ON ALL FINAL SURFACES. THE COST OF THE PAVEMENT MARKING TAPE, TYPE III AND ITS REMOVAL SHALL BE INCLUDED IN THE COST OF SHORT TERM
- 14. SAW CUTTING OF PAVEMENTS, SHOULDERS, ETC., SHALL BE TO FULL DEPTH AND SHALL RESULT IN A CLEAN, STRAIGHT EDGE ON THE PORTION REMAINING. THE COST OF SAW CUTTING REMOVAL ITEMS SHALL BE INCLUDED IN THE UNIT PRICES OF THESE ITEMS.
- THE CONTRACTOR SHALL BE REQUIRED TO PROVIDE ACCESS TO ABUTTING PROPERTY AT ALL TIMES DURING THE CONSTRUCTION OF THIS
- IT SHALL BE THE CONTRACTOR'S RESPONSIBILITY TO VERIFY ALL DIMENSIONS AND CONDITIONS EXISTING IN THE FIELD PRIOR TO CONSTRUCTION AND ORDERING OF MATERIALS.

## GENERAL NOTES - TRAFFIC CONTROL & PROTECTION

- THE MAINTENANCE OF TRAFFIC CONTROL (MOT) PLANS SHALL SERVE AS A GUIDE FOR SAFE DIVERSION OF TRAFFIC DURING EXECUTION OF THIS CONTRACT. HOWEVER, THE CONTRACTOR MAY IMPROVE OR MODIFY THE MOT PLANS TO MEET CONSTRUCTION NEEDS BUT NOT AT THE EXPENSE OF PUBLIC SAFETY OR CONVENIENCE. ANY CHANGES TO THE MOT PLANS SHALL BE SUBMITTED TO THE
- THE ENGINEER SHALL BE INFORMED 48 HOURS IN ADVANCE OF ANY CHANGE TO
- ALL EXISTING PAVEMENT MARKINGS AND RAISED PAVEMENT MARKERS IN CONFLICT WITH THE MAINTENANCE OF TRAFIC STRIPING SHALL BE REMOVED. THIS WORK WILL BE PAID FOR AT THE CONTRACT UNIT PRICE PER SQUARE FOOT, "PAVEMENT
- THE CONTRACTOR SHALL REMOVE ALL TEMPORARY PAVEMENT MARKING TAPE WHICH CONFLICTS WITH THE NEXT STAGE OR FINAL STRIPING. REMOVAL OF TEMPORARY PAVEMENT MARKING TAPE WILL BE PAID FOR AT THE CONTRACT UNIT PRICE PER FOOT, "WORK ZONE PAVEMENT MARKING REMOVAL".
- ALL TRAFFIC CONTROL DEVICES USED FOR THE MAINTENANCE OF TRAFFIC, AS DETAILED ON THE PLANS, OR HIGHWAY STANDARDS SHALL BE REFLECTORIZED PRIOR TO INSTALLATION AND CLEANED AS SPECIFIED IN MAINTENANCE OF TRAFFIC SPECIAL PROVISIONS OR AS DIRECTED BY THE ENGINEER.
- ALL DRUMS, VERTICAL PANELS AND BARRICADES ADJACENT TO THE EDGE OF TRAVELED WAY SHALL BE EQUIPPED WITH STEADY-BURNING LIGHTS.
- ALL EXISTING SIGNS WITHIN THE LIMITS OF MAINTENANCE OF TRAFFIC WHICH ARE OBSCURED BY OR OTHERWISE INTERFERED WITH BY THE CONSTRUCTION OPERATIONS AND MAINTENANCE OF TRAFFIC SHALL BE COVERED OR REMOVED BY THE CONTRACTOR UNLESS SPECIFIED IN THE PLANS OR WHEN DIRECTED BY THE ENGINEER. THIS WORK SHALL BE IN ACCORDANCE WITH ARTICLE 107.25 OF THE IDOT STANDARD SPECIFICATIONS.
- TEMPORARY, OFF-PEAK HOUR LANE CLOSURES MUST BE REQUESTED THROUGH THE ENGINEER AND AS SPECIFIED IN THE SPECIAL PROVISIONS. WHEN OFF-PEAK HOUR OR WEEKEND LANE CLOSURES ARE REQUIRED, A PORTABLE CHANGEABLE MESSAGE SIGN SHALL BE INSTALLED ONE WEEK PROR TO THE CLOSURE. THE MESSAGE SIGN WORDING AND LOCATION WILL BE DETERMINED BY THE ENGINEER.
- ALL TEMPORARY INFORMATION SIGNS SHALL BE PAID FOR SEPARATELY AT THE CONTRACT UNIT PRICE PER SQUARE FEET FOR "TEMPORARY INFORMATION
- TRAFFIC CONDITIONS, ACCIDENTS AND OTHER UNFORESEEN EMERGENCY CONDITIONS MAY REQUIRE THE ENGINEER TO RESTRICT, MODIFY OR REMOVE LANE CLOSURES OF CHANNELIZATION SHOWN IN THE PLANS. THE CONTRACTOR SHALL MAKE THE NECESSARY ADJUSTMENTS AS DIRECTED BY THE ENGINEER WITHOUT DELAY. THE CONTRACTOR SHALL RESPOND TO ANY REQUEST MADE BY THE ENGINEER FOR CORRECTION WITHIN TWO HOURS FROM THE TIME OF
- 11. ALL TEMPORARY PAVEMENT MARKINGS PROPOSED WITHIN THE WORK AREA SHALL BE COMPLETED PRIOR TO THE CONSTRUCTION PHASE CHANGE.
- FOR ADDITIONAL BRIDGE CONSTRUCTION STAGING INFORMATION, SEE STRUCTURAL
- BARRICADES: THE CONTRACTOR SHALL PROVIDE AND I STALL TWO (2) WEIGHTED SAND BAGS ON EACH TYPE I OR TYPE II BARRICADE USED - ONE (1) WEIGHTED SAND BAG ACROSS EACH BOTTOM RAIL.

ringroup

200 West Front Street Wheaton, II 60187

DESIGNED -MTH REVISED DRAWN REVISED DJW CHECKED REVISED DATE 1/28/2010 6:25:37 PM REVISED

STATE OF ILLINOIS

IL-72 OVER DESPLAINES RIVER SN 016-0665

SHEET NO. 2 OF 33 SHEETS STA.

SCALE: N/A

INDEX OF SHEETS, STATE STANDARDS, GENERAL NOTES

TO STA.

SECTION COUNTY SHEETS 1350 CONTRACT NO. 60J57

DATE VAME SCALE

DEPARTMENT OF TRANSPORTATION

				URBAN 801. FED. 201. STATE
				CONSTRUCTION TYPE CODE BRIDGE SN 016-0322
CODE NO.	SUMMARY OF QUANTITIES  ITEM DESCRIPTION	UNIT	TOTAL	SFTY-2A QUANTITY
	SUB-BASE GRANULAR MATERIAL, TYPE A	CU YD	208	208
	BITUMINOUS MATERIALS (PRIME COAT)	TON	0.8	0.8
	AGGREGATE (PRIME COAT)	TON	2	
40600300	· .			
~	CONSTRUCTING TEST STRIP	EACH		
	POLYMERIZED HOT-MIX ASPHALT SURFACE COURSE, MIX "F", N90	TON	96	96
	HOT-MIX ASPHALT SURFACE REMOVAL, 1 3/4" ]	SQ YD	974	974
12001420	COMBINATION CURB AND GUTTER REMOVAL  BRIDGE APPROACH PAVEMENT CONNECTOR (PCG)	F00] 50 YD	619 <b>68</b>	619 <b>68</b>
14001700	HOT-MIX ASPHALT SURFACE REMOVAL (DECK) COMBINATION CONCRETE CURB AND GUTTER REMOVAL	50 YD F007 S0 FT	1, 134	1,134
	MEDIAN REMOVAL (SPECIAL)  PAVEMENT REMOVAL (SPECIAL)	SQ FT	5,077 <b>25</b>	5.077
	MEDIAN REMOVAL (SPECIAL)	SQ FT	2,706	2,706
50102400	CONCRETE REMOVAL	CU YD	75.4	75. 4
50300100	FLOOR DRAINS	EACH	29	29
50300255	CONCRETE SUPERSTRUCTURE	CU YD	78	78
50300260	BRIDGE DECK GROOVING	SQ YD	1,064	1,064
50300300	PROTECTIVE COAT	SQ YD	1, 193	1, 193
50800205	REINFORCEMENT BARS, EPOXY COATED	POUND	12,480	12,480
50800515	BAR SPLICERS	EACH	22	22
52000110	PREFORMED JOINT STRIP SEAL	FOOT	181	181
58700300 <b>602<i>5</i>0400</b>	CONCRETE SEALER  CATCH BASINS TO BE ADJUSTED WITH NEW TYPE 1 FRAME,  COMBINATION CONCRETE CURB AND GUTTER, TYPE B-9.06  QUEN LID	SQ FT EACH	6, 950 <b>3</b>	6, 950 <b>3</b>
		FOOT	6/9	6/9
	CONCRETE MEDIAN SURFACE , 4 INCH	SQ FT	4,811	4,811
60620 <i>354</i>	CONCRETE MEDIAN, TYPE SB-9 (DOWELLED)	SQ FT	2,706	2, 706
60624600	CORRUGATED MEDIAN	SQ FT	266	266
67000400	ENGINEER'S FIELD OFFICE, TYPE A	CAL MO	6	6
67100100	MOBILIZATION	L SUM	1	1
70101 <b>8</b> 00	TRAFFIC CONTROL AND PROTECTION, (SPECIAL)	L SUM	1	1
70300100	SHORT-TERM PAVEMENT MARKING	FOOT	1,154	1, 154
70301000	WORK ZONE PAVEMENT MARKING REMOVAL	SQ FT	21,608	21,608
72000100	SIGN PANEL - TYPE 1	SQ FT	15	15
72400100	REMOVE SIGN PANEL ASSEMBLY - TYPE A	EACH	.3	3
72800100	TELESCOPING STEEL SIGN SUPPORT	FOOT	41	41
78000100	THERMOPLASTIC PAVEMENT MARKING - LETTERS AND SYMBOLS	SQ FT	110	110
78000200	THERMOPLASTIC PAVEMENT MARKING - LINE 4"	FOOT	5,632	5,632

			SUMMARY OF QUANTITIES		TOTAL	SFTY-2A			
		CODE NO.	ITEM DESCRIPTION	UNIT	QUANTITY	QUANTITY			
	*	78000400	THERMOPLASTIC PAVEMENT MARKING - LINE 6"	FOOT	459	459			
	*	78000650	THERMOPLASTIC PAVEMENT MARKING - LINE 24"	FOOT	38	38			
	*	78008210	POLYUREA PAVEMENT MARKING TYPE I - LINE 4"	FOOT	1,220	1,220			
	*	78100100	RAISED REFLECTIVE PAVEMENT MARKER	EACH	246	246			
	*	78100105	RAISED REFLECTIVE PAVEMENT MARKER (BRIDGE)	EACH	10	10			
		78300100	PAVEMENT MARKING REMOVAL	SQ FT	2, 293	2, 293			
		78300200	RAISED REFLECTIVE PAVEMENT MARKER REMOVAL	EACH	222	222			
	$\Delta$	<del>X0326766</del>	CLEAN & RESEAL RELIEF JOINT	<del>-F00T</del>	150	150			
		X0322185	BRIDGE DECK LATEX CONCRETE OVERLAY, 2 1/4 INCHES	SQ YD	1, 134	1, 134			
		X0322256	TEMPORARY INFORMATION SIGNING	SQ FT	103	103			
		X0325775	WET REFLECTIVE TEMPORARY TAPE, TYPE III, 4 INCH	FOOT	20, 454	20, 454			
		X0712400	TEMPORARY PAVEMENT	SQ YD	569	569			
		X0919000	TEMPORARY PAVEMENT REMOVAL	SQ YD	569	569			
Δ	NP	20018500	DRAINAGE STRUCTURES TO BE CLEANED	EACH	4	47			
		Z0006204	BRIDGE DECK HYDRO-SCARIFICATION 1/2"	SQ YD	1, 134	1, 134			
		Z0016001	DECK SLAB REPAIR (FULL DEPTH, TYPE I)	SQ YD	7.5	7.5			
		Z0016002	DECK SLAB REPAIR (FULL DEPTH, TYPE II)	SQ YD	10	10			
		50157300	PROTECTIVE SHIELD	SQ YD	1745	1745			

\* SPECIALTY ITEM

**rjn**group


DESIGNED REVISED DRAWN DJW REVISED CHECKED MAK REVISED 1/28/2010 6:25:37 PMREVISED


STATE OF ILLINOIS **DEPARTMENT OF TRANSPORTATION**  IL-72 OVER DESPLAINES RIVER SN 016-0665 SHEET NO. 3 OF 33 SHEETS STA.

A Rev. 3-31-10 SUMMARY OF QUANTITIES

TO STA.

F.A.U. RTE. 1350

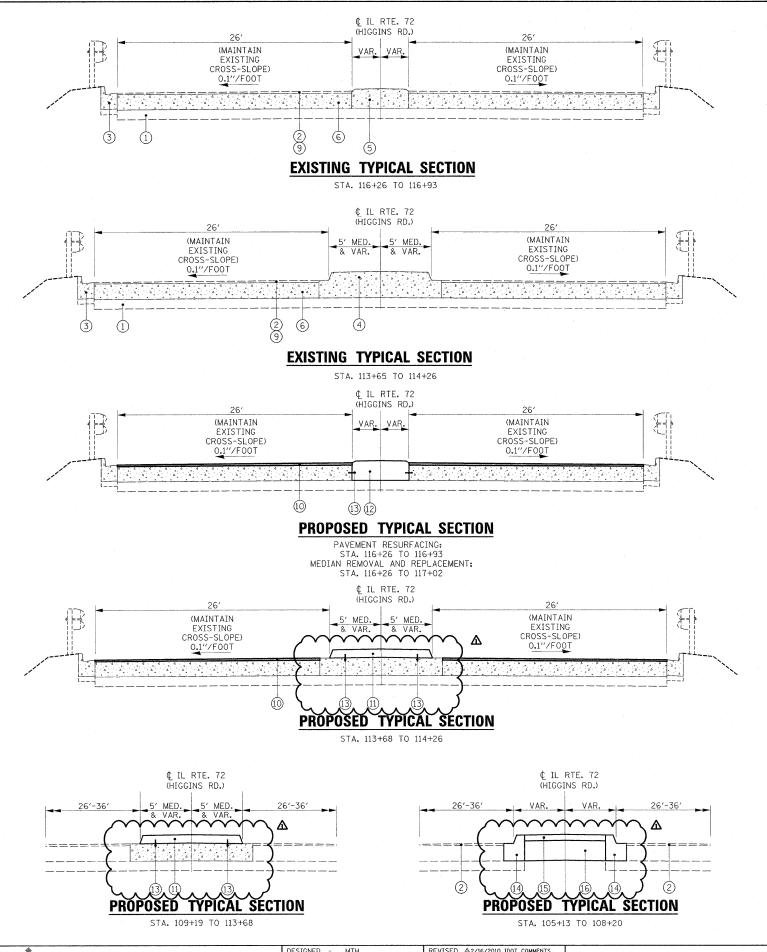

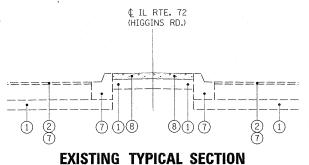

STA. 105+13 TO 108+20

26'-36' 26'-36' VAR. VAR. 2 2

¢ IL RTE, 72

(HIGGINS RD.)

# STAGING TYPICAL SECTION

# **LEGEND**

- 1 EXISTING AGGREGATE BASE COURSE
- EXISTING HOT-MIX ASPHALT OVERLAY, 1 1/2"
- (3) EXISTING COMBINATION CURB AND GUTTER, TYPE B-6.24
- (4) EXISTING CONCRETE BARRIER MEDIAN TYPE SB-9.06
- (5) EXISTING CONCRETE CORRUGATED MEDIAN
- 6 EXISTING CONCRETE APPROACH SLAB
- 7 EXISTING COMBINATION CONCRETE CURB AND GUTTER, TYPE B-9.06
- (8) EXISTING CONCRETE MEDIAN SURFACE, 4"
- 9 PROPOSED HOT-MIX ASPHALT SURFACE REMOVAL, 1
- PROPOSED POLYMERIZED HOT-MIX ASPHALT SURFACE COURSE, MIX "F", N90 1 3/4" \( \Delta \)

  PROPOSED CONCRETE BARRIER MEDIAN, TYPE SB-9 (DOWELLED) \( \Delta \)
- PROPOSED CONCRETE CORRUGATED MEDIAN
- (TIE BARS, NO. 5, 12" LONG, EMBEDDED 6" INTO (EXISTING PAVEMENT @ 30" O.C. (SEE SHEET 26)
- PROPOSED COMBINATION CONCRETE CURB AND GUTTER, TYPE B-9.06
- (15) PROPOSED CONCRETE MEDIAN SURFACE, 4"
- 16 PROPOSED SUB-BASE GRANULAR MATERIAL, TYPE A
- TEMPORARY PAVEMENT (HMA BINDER IL-19 mm
- HMA SURFACE COURSE, MIX "D", N50 (IL 9.5 mm), 1 1/2" (PAID FOR AS TEMPORARY PAVEMENT)

HOT-MIX ASPHALT MIXTURE REQUIREMENTS								
	MIXTURE USES	VOIDS						
MAIN ROADWAY RESURFACING	POLYMERIZED HOT-MIX ASPHALT SURFACE COURSE, MIX "F", N90 (IL-9.5mm)	4% @ 90 GYR.						
TEMPORARY PAVEMENT	TEMP PAVEMENT (HMA BINDER IL-19 mm)	4% @ 50 GYR.						
TEMPORARY PAVEMENT	HMA SURFACE COURSE, MIX "D", N50 (IL 9.5 mm)	4% € 50 GYR.						

THE UNIT WEIGHT USED TO CALCULATE ALL HOT-MIX ASPHALT SURFACE MIXTURES IS 112 LBS/SQ YD/IN.


THE "AC TYPE" FOR POLYMERIZED HMA MIXES SHALL BE "SBS/SBR PG 70-22" AND FOR NON-POLYMERIZED HMA THE "AC TYPE" SHALL BE "PG 64-22" UNLESS MODIFIED BY DISTRICT ONE SPECIAL PROVISIONS. FOR "PERCENT OF RAP" SEE DISTRICT ONE SPECIAL PROVISIONS.

rjngroup Excellence through Ownership

DESIGNED MTH REVISED A2/16/2010 IDOT COMMENTS DRAWN DJW REVISED CHECKED MAK REVISED 200 West Front Street Wheaton, II 60187 DATE 3/23/2010 9:51:12 AN REVISED

STATE OF ILLINOIS **DEPARTMENT OF TRANSPORTATION** 

IL-72 OVER D	ESPLAINES	RIVER		TYPICAL	SECTIONS	F.A.U RTE.	SEC	TION	COUNTY	TOTAL SHEETS	SHEET NO.
N2	016-0665					1350	129	92-I	COOK	33	4
	010 0000		L,						CONTRACT	NO. 60J	157
SCALE: NTS	SHEET NO. 4	OF 33 SH	EETS	STA.	TO STA.	FED.	ROAD DIST. NO. 1	ILLINOIS FED. A	ID PROJECT		

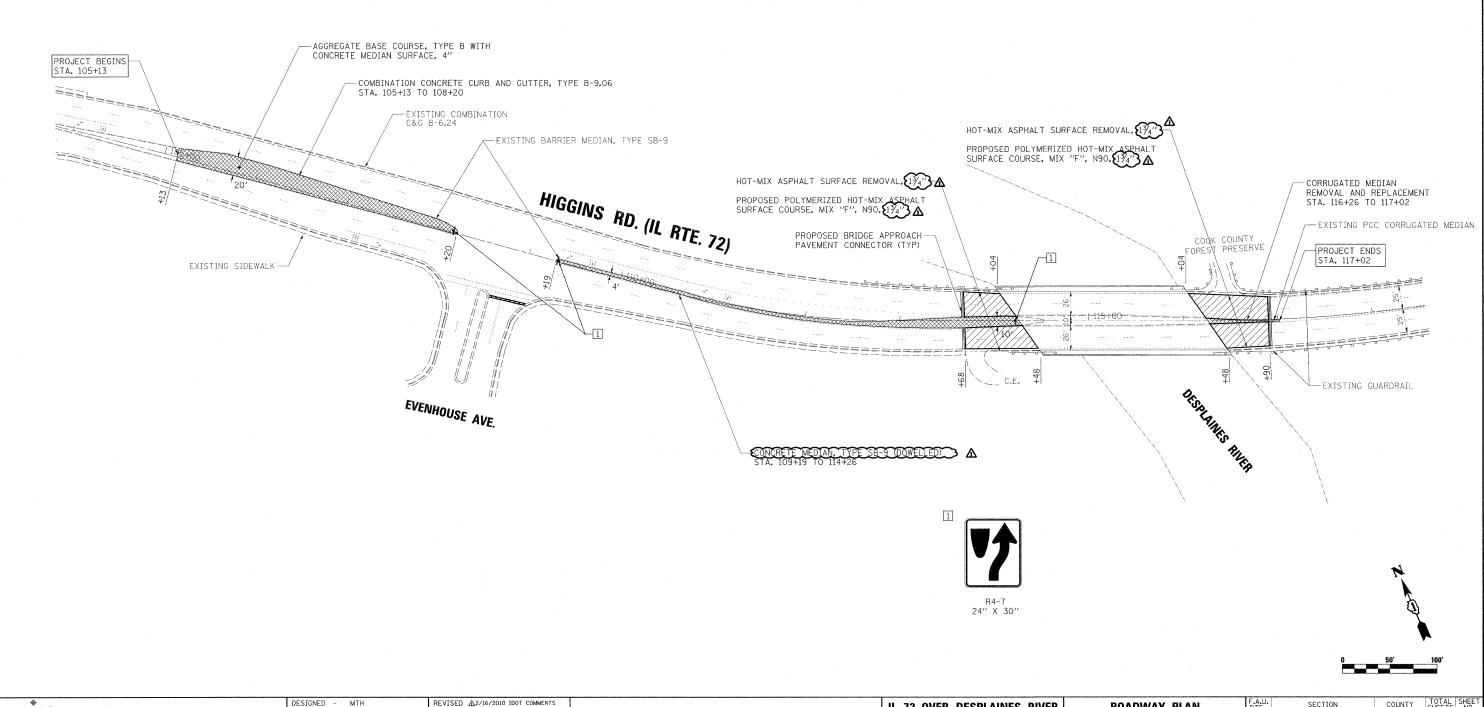

rjngroup Excellence through Ownership


DESIGNED - MTH DRAWN DJW REVISED MAK REVISED CHECKED 200 West Front Street Wheaton, II 60187 3/23/2010 9:51:12 AN REVISED

STATE OF ILLINOIS **DEPARTMENT OF TRANSPORTATION**  IL-72 OVER DESPLAINES RIVER **ROADWAY PLAN** 1350 SN 016-0665 SCALE: 1"=50' SHEET NO. 5 OF 33 SHEETS STA. 104+00 TO STA. 117+00

COUNTY TOTAL SHEET NO. SECTION COOK 33 5 1292-I CONTRACT NO. 60J57


# IL RTE. 72 - PRE-STAGE

(LOOKING EAST)

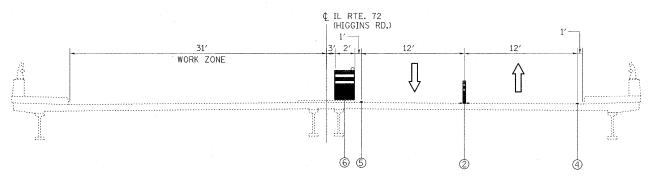


# IL RTE. 72 - STAGE I

(LOOKING EAST)

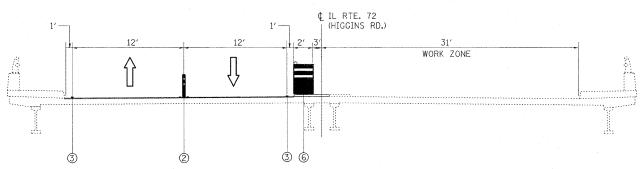

# IL RTE. 72 - STAGE II

(LOOKING EAST)

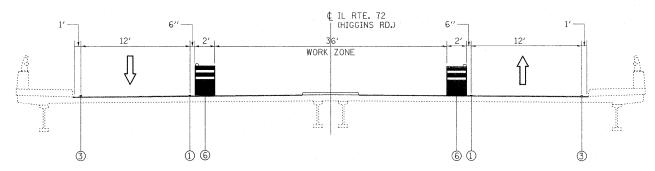

# IL RTE. 72 - STAGE III

### PRE-STAGE

### CONSTRUCTION:

- REMOVE CONCRETE MEDIAN SURFACE AND CONCRETE CURB AND GUTTER STA. 105+13 TO 108+20 AND REPLACE WITH TEMPORARY PAVEMENT TO BE FLUSH WITH ADJACENT PAVEMENT WITHIN THE LIMITS SHOWN
- \* REMOVE CONCRETE MEDIAN STA. 109+19 TO STA. 114+26 TO BE FLUSH WITH ADJACENT
- PAVEMENT WITHIN THE LIMITS SHOWN. \* REMOVE CONFLICTING MARKINGS AND IMPLEMENT STAGE I MOT PAVEMENT MARKINGS WITHIN THE WORK ZONE.

### MAINTENANCE OF TRAFFIC:

- \* CLOSE INSIDE LANE IN BOTH DIRECTIONS PER THE MOT PLANS.
- \* CLOSURES ARE ANTICIPATED TO BE LIMITED TO OFF-PEAK HOURS, UNLESS OTHERWISE APPROVED BY THE ENGINEER.

### STAGE I

- CONSTRUCTION:

  \* PERFORM STRUCTURAL WORK ON NORTH HALF OF DECK AND ABUTMENTS.

  \* PARTIAL REMOVAL AND RESURFACING OF ROADWAY (TO PERMIT TRAFFIC FOR
- REMOVE CONFLICTING MARKINGS AND IMPLEMENT STAGE II MOT PAVEMENT MARKINGS WITHIN THE WORK ZONE.

MAINTENANCE OF TRAFFIC:

\* TRAFFIC REDUCED TO ONE LANE IN EACH DIRECTION, AND SHIFTED TO THE SOUTH SIDE OF THE EXISTING BRIDGE DECK.

## STAGE II

- CONSTRUCTION:

  \* PERFORM STRUCTURAL WORK ON SOUTH HALF OF DECK AND ABUTMENTS.

  \* PARTIAL REMOVAL AND RESURFACING OF ROADWAY (TO PERMIT TRAFFIC FOR
- \* REMOVE CONFLICTING MARKINGS AND IMPLEMENT SHORT-TERM PAVEMENT

MAINTENANCE OF TRAFFIC:

\* TRAFFIC REDUCED TO ONE LANE IN EACH DIRECTION, AND SHIFTED TO THE NORTH SIDE OF THE REHABILITATED BRIDGE DECK.

### STAGE III

- \* REMOVE TEMPORARY PAVEMENT STA. 105+13 TO STA. 108+20 AND REPLACE CONCRETE
- CURB AND GUTTER AND CONCRETE MEDIAN SURFACE.

  \*RECONSTRUCT CONCRETE MEDIAN STA. 109+19 TO 114+26. \* REFLECTIVE PAVEMENT MARKERS.

# MAINTENANCE OF TRAFFIC:

\*\*CLOSE INSIDE LANE IN BOTH DIRECTIONS PER THE MOT PLANS.

ONCE MEDIAN HAS BEEN RECONSTRUCTED AND THERE ARE NO DROP-OFFS TO THE
PAVEMENT, DAILY LANE CLOSURES PER STD. 701422 MAY BE USED.

SEE SHEET 2 FOR TRAFFIC CONTROL AND PROTECTION NOTES.

- ① TYPE III TEMPORARY PAVEMENT MARKING TAPE, FOR WET CONDITIONS, 4" SOLID YELLOW LINE (TYP)
- 2) TYPE III TEMPORARY PAVEMENT MARKING TAPE, FOR WET CONDITIONS, 4" DOUBLE YELLOW LINE @ 11" O.C. (TYP) STA. 112+80 TO STA. 122+00 FLEXIBLE DELINEATORS
- ③ TYPE III TEMPORARY PAVEMENT MARKING TAPE, FOR WET CONDITIONS, 4" SOLID WHITE LINE (TYP)
- (4) EXISTING PAVEMENT MARKING, 4" SOLID WHITE LINE (TYP)
- (5) EXISTING PAVEMENT MARKING, 4" SOLID YELLOW LINE (TYP)
- (6) DRUM WITH STEADY BURN MONODIRECTIONAL LIGHT

ringroup

200 West Front Street Wheaton, Il 60187

DESIGNED MTH REVISED A2/16/2010 IDOT COMMENTS REVISED DRAWN DJW CHECKED MAK REVISED

STATE OF ILLINOIS **DEPARTMENT OF TRANSPORTATION**  IL-72 OVER DESPLAINES RIVER SN 016-0665

SECTION **MAINTENANCE OF TRAFFIC** TYPICAL SECTIONS 350 1292-I

COUNTY

TOTAL SHEE SHEETS NO.

33 8

COOK CONTRACT NO. 60J57 SHEET NO. 8 OF 33 SHEETS STA.