


F.A.I. RTE.	SECTION	COUNTY	TOTAL SHEETS	SHEET NO.
74	(72-74R-3)	PEORIA	1360	10
STA.		TO STA.		
FED. ROAD DIST. NO.		ILLINOIS	FED. AID PROJECT	

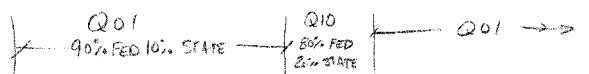

SUMMARY OF QUANTITIES

CODE NO.	PAY ITEM	UNIT	TOTAL QUANTITY	CONSTRUCTION TYPE CODE														
				ROADWAY 1000-2A	ROADWAY J000-2A	BRIDGE (1) X271-2A	BRIDGE (2) X281-2A	BRIDGE (3) X781-2A	BRIDGE (4) X028-2A	MINOR STRUCTURES (5) Y007	OVERHEAD SIGNS Y002-1C	LIGHTING Y030-1E	ITS Y035	TRAFFIC SIGNAL INTERCONNECT Y031-1F	TRAFFIC SIGNALS (6) Y031-1F	TRAFFIC SIGNALS (7) Y031-1F	TRAFFIC SIGNALS (8) Y031-1F	
M5010240	CONCRETE REMOVAL	CU M	698.9						698.6	0.3								
M5010430	CONCRETE HEADWALL REMOVAL	CU M	154.8	44.2	15.6				29.0	<del>95.0</del> 66.0								
M5010521	REMOVE EXISTING CULVERTS	METER	47	23					24	<del>24</del>								
M5010522	PIPE CULVERT REMOVAL	METER	87						87	<del>87</del>								
M5020100	STRUCTURE EXCAVATION	CU M	14,757				1,283	2,782		10,692								
M5030105	NEOPRENE EXPANSION JOINT 50 MM	METER	74.6			24.4	25.5	24.7										
M5030125	NEOPRENE EXPANSION JOINT 100 MM	METER	51.9				25.5	26.4										
M5030350	CONCRETE STRUCTURES	CU M	3,194.3			77.2	962.4	1,215.0		939.7								
M5030360	CONCRETE SUPERSTRUCTURE	CU M	1,573.5			89.4	483.0	729.8		271.3								
M5030390	BRIDGE DECK GROOVING	SO M	3,842			269	1,422	2,151										
M5030450	PROTECTIVE COAT	SO M	4,916			338	1,856	2,722										
M5040914	FURNISHING AND ERECTING PRECAST PRESTRESSED CONCRETE I-BEAMS 914 MM	METER	123.4				123.4											
M5041067	FURNISHING AND ERECTING PRECAST PRESTRESSED CONCRETE I-BEAMS 1067 MM	METER	161.5					161.5										
M5050105	FURNISHING AND ERECTING STRUCTURAL STEEL	L SUM	1			1												
M5050405	FURNISHING AND ERECTING STRUCTURAL STEEL	KG	4,190				1,370	2,820										
M5070209	UNTREATED TIMBER LAGGING	SO M	170							170								
M5070211	FURNISHING SOLDIER PILES (HP SECTION)	METER	360							360								
M5080105	REINFORCEMENT BARS	KG	<del>326,760</del> 174,010	<del>520</del>	<del>170</del>				156,930	<del>17,080</del> 17,080								
M5080205	REINFORCEMENT BARS, EPOXY COATED	KG	444,590	30	15,580	116,920	178,860	790	132,410									
M5110100	SLOPE WALL 100MM	SO M	1,425	450	111	399	465											
M5120100	FURNISHING METAL PILE SHELLS 305 MM	METER	716.0			150.0	566.0											
M5120115	FURNISHING METAL PILE SHELLS 356 MM	METER	1,703.0			437.0	1,266.0											
M5120160	FURNISHING STEEL PILES HP 310 X 79	METER	1,491.0				828.0	663.0										
M5120315	DRIVING STEEL PILES	METER	1,491.0				828.0	663.0										
M5120340	DRIVING AND FILLING SHELLS	METER	2,419.0			437.0	150.0	1,832.0										
M5120460	TEST PILE STEEL HP 310 X 79	EACH	2			1	1											
M5401225	PRECAST CONCRETE BOX CULVERT 3.6 M X 3.0 M	METER	55.0						55.0	<del>55.0</del>								
M5403000	CONCRETE BOX CULVERTS	CU M	<del>1,460.1</del> 5,001.8						1,281.1	<del>179</del> 4,601.1								
M5403220	EXPANSION BOLTS M20	EACH	208						208									
M5429910	CONCRETE COLLAR	CU M	1.0	1.0														
M542E112	PRECAST REINFORCED CONCRETE FLARED END SECTIONS 300MM	EACH	16	4	12													
M542E116	PRECAST REINFORCED CONCRETE FLARED END SECTIONS 375MM	EACH	4	2	2													
M542E124	PRECAST REINFORCED CONCRETE FLARED END SECTIONS 525MM	EACH	3	1	2													
M542E128	PRECAST REINFORCED CONCRETE FLARED END SECTIONS 600MM	EACH	5	1	4													
M542E136	PRECAST REINFORCED CONCRETE FLARED END SECTIONS 750MM	EACH	2	1	1													
M542E144	PRECAST REINFORCED CONCRETE FLARED END SECTIONS 900MM	EACH	2	2														

- \* SPECIALTY ITEMS
- + FUND CODE SFTY-3N
- ++ FUND CODE Y080
- +++ FUND CODE SFTY-3C
- Δ NON PARTICIPATING

- (1) RAMP A-3 OVER RAMP B-5, SN 072-0172
- (2) RAMPS B-3 & B-5 OVER US 150 & RAMP B-6, SN 072-0190 PROPOSED (EXISTING 072-0026)
- (3) RAMPS B-1 & B-4 OVER RAMPS A-3, B-3 & I-74, SN 072-0183 PROPOSED (EXISTING 072-0027)
- (4) NORTH AND SOUTH CULVERT EXTENSION, SN 072-2005 (072-2005), SN 072-2030, SN 072-2032
- (5) WALL 8, SN 072-8556, WALL 8A, SN 072-8557, WALL 9, SN 072-8558, WALL 10, SN 072-8559, WALL 11, SN 072-8560, WALL 12, SN 072-8561, SN 072-2504, WALL 12B, DIFFERENTIAL HEIGHT BARRIER, BOX CULVERT, WALL 18B, SN 072-8618 (072-2005); WALL 18C, SN 072-8619 (072-2005)
- (6) WAR MEMORIAL DRIVE / STERLING / GLEN
- (7) WAR MEMORIAL DRIVE / SCENIC DRIVE
- (8) SCENIC DRIVE / MALL ENTRANCE

REVISIONS	
NAME	DATE



ILLINOIS DEPARTMENT OF TRANSPORTATION

**SUMMARY OF QUANTITIES**

FAI ROUTE 74 (I-74)

DATE 11/23/04

DRAWN BY RDY  
CHECKED BY LSA