
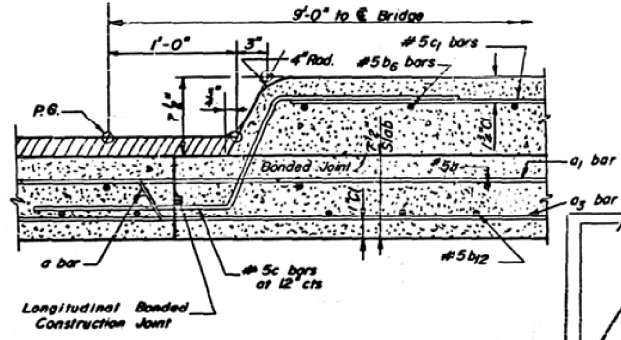



AS-BUILT PLANS - S.N. 074-0055 FOR INFORMATION ONLY

ROUTE NO.	SECTION	COUNTY	TOTAL SHEETS	SHEET NO.
F.A.I. 72	58-66 HB-1	MACONT PIATT	77	22
FED. ROAD DIST. NO. 7		ILLINOIS	FED. AID PROJECT	

SHEET NO. 7
SHEETS 15

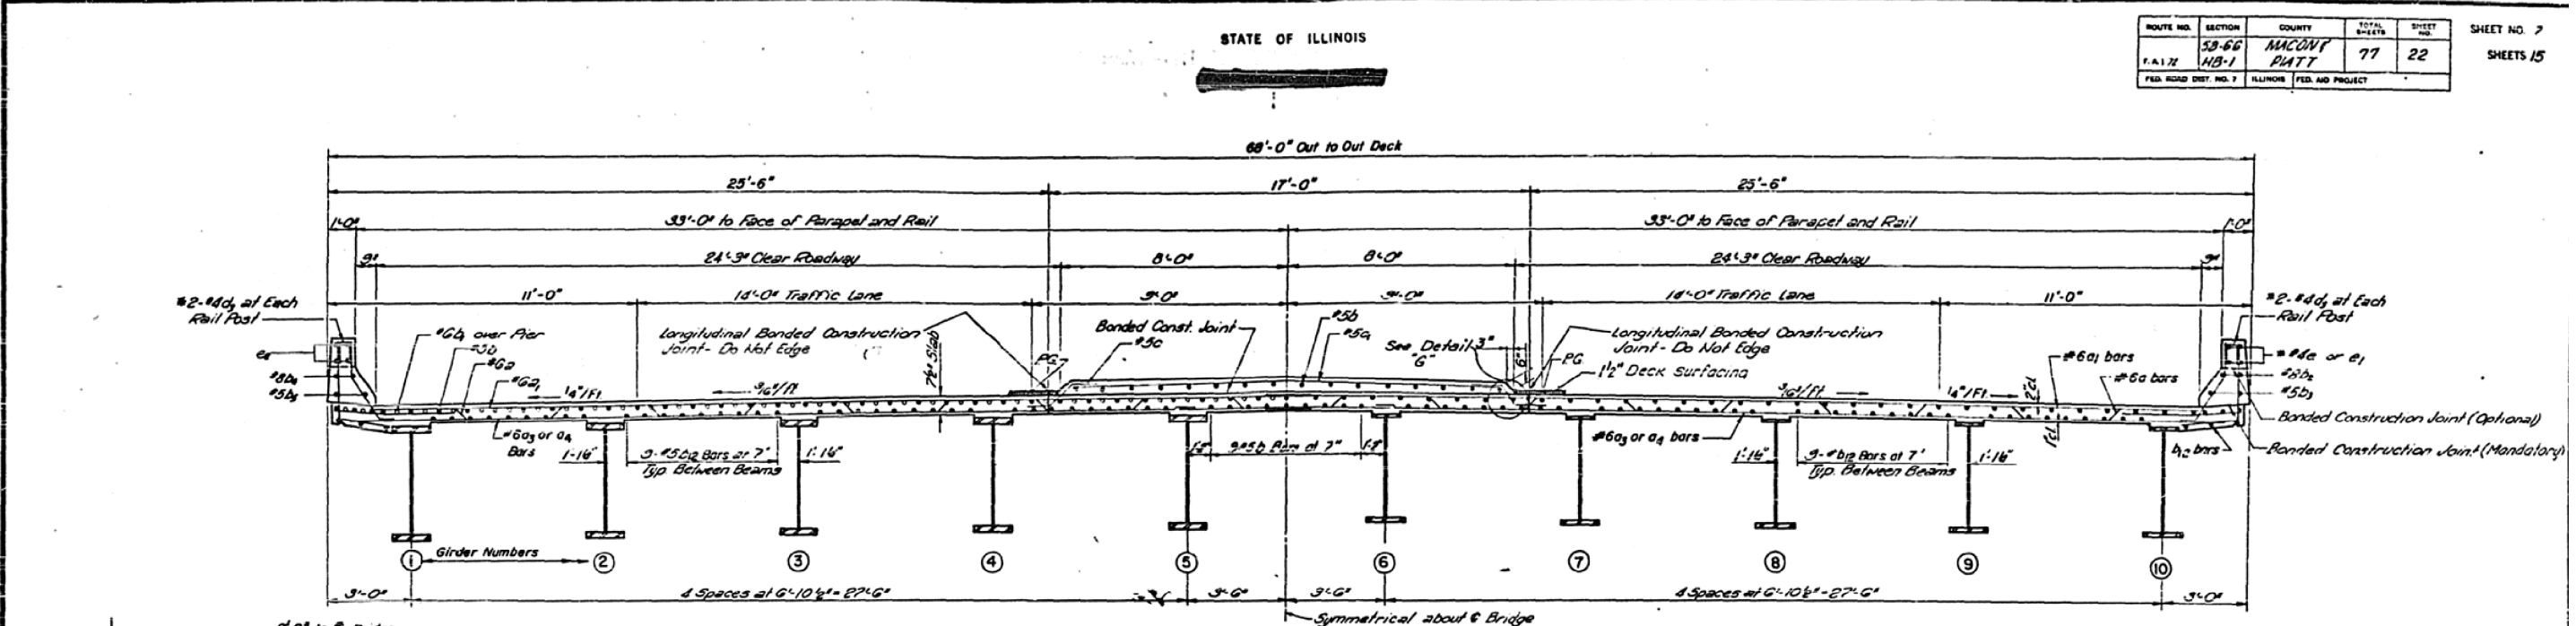


DETAIL "G"

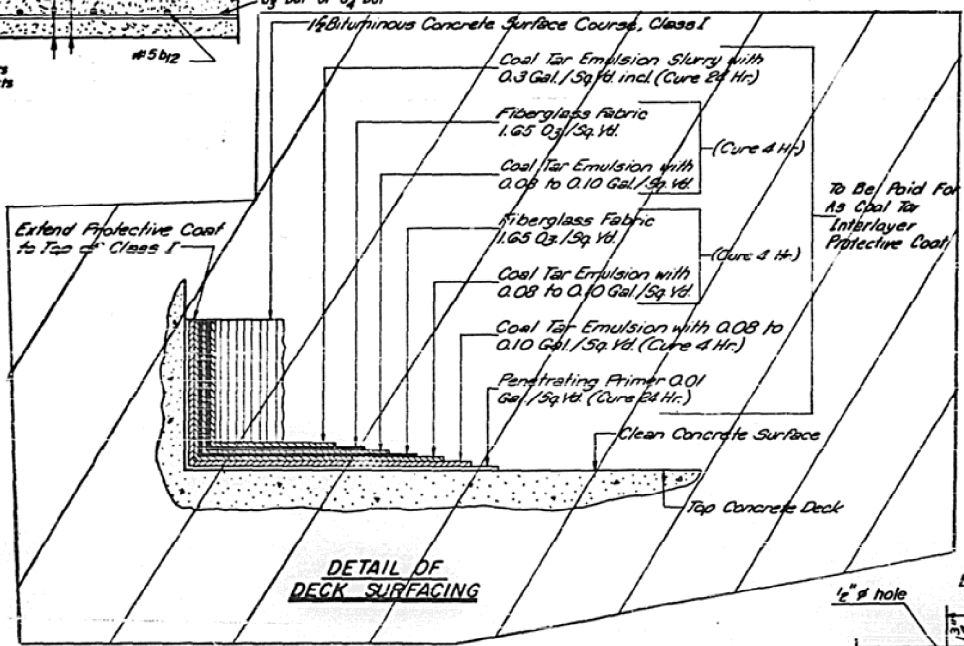


DETAIL OF DECK SURFACING


CROSS SECTION (Looking North)

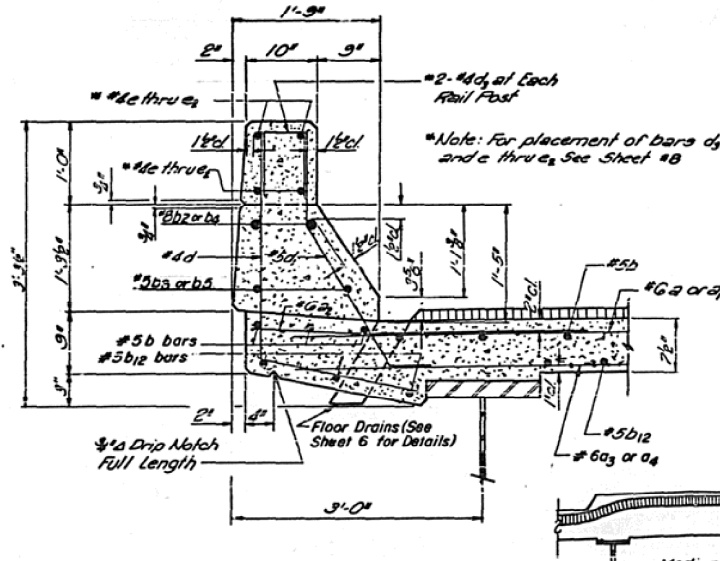

CURB SECTION

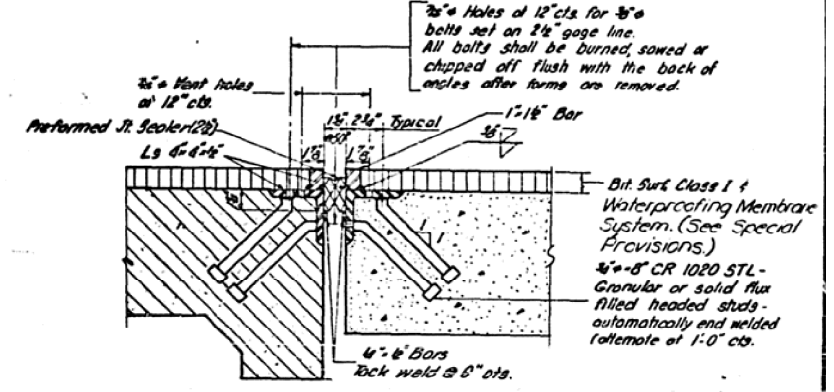

EXPANSION DEVICE AND JOINT SEALER DETAILS

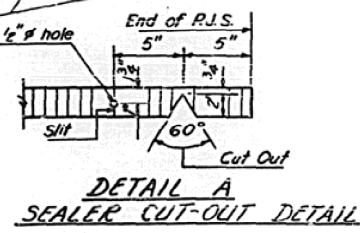

DETAIL A SEALER CUT-OUT DETAIL

SLAB DETAILS
F.A.I.-72 SECTION 58-66-HB-2
MACONT & PIATT COUNTIES
STA. 932+59.22 (F.A.I.-72)

DESIGNED K.S.Y.
CHECKED J.T.
DRAWN C.S.
CHECKED K.S.Y.