


AS-BUILT PLANS - S.N. 074-0062 FOR INFORMATION ONLY

B.M. 35, 3" Concrete filled Iron Pipe on the East side of TR 40A, 1100'S. of Sta. 1256+72

STATE OF ILLINOIS
DEPARTMENT OF TRANSPORTATION


SHEET NO.	SECTION	COUNT	TOTAL SHEETS	SHEET NO.
72	HB	Platt	34	11
14 SHEETS				

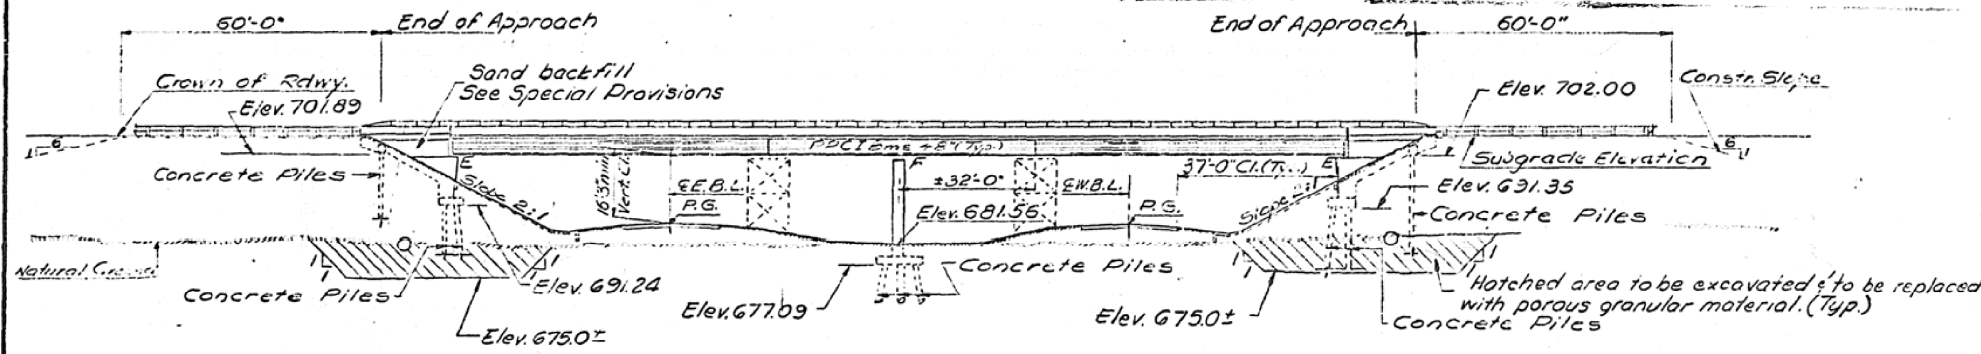

ELEVATION

STATION 1256+11.76
BUILT 197 BY
STATE OF ILLINOIS
F.A.I. RT 72 SEC. 74-68 HB
F.A. PROJ. I-72-2(50)
LOADING HS 15

NAME PLATE
See Standard 2113

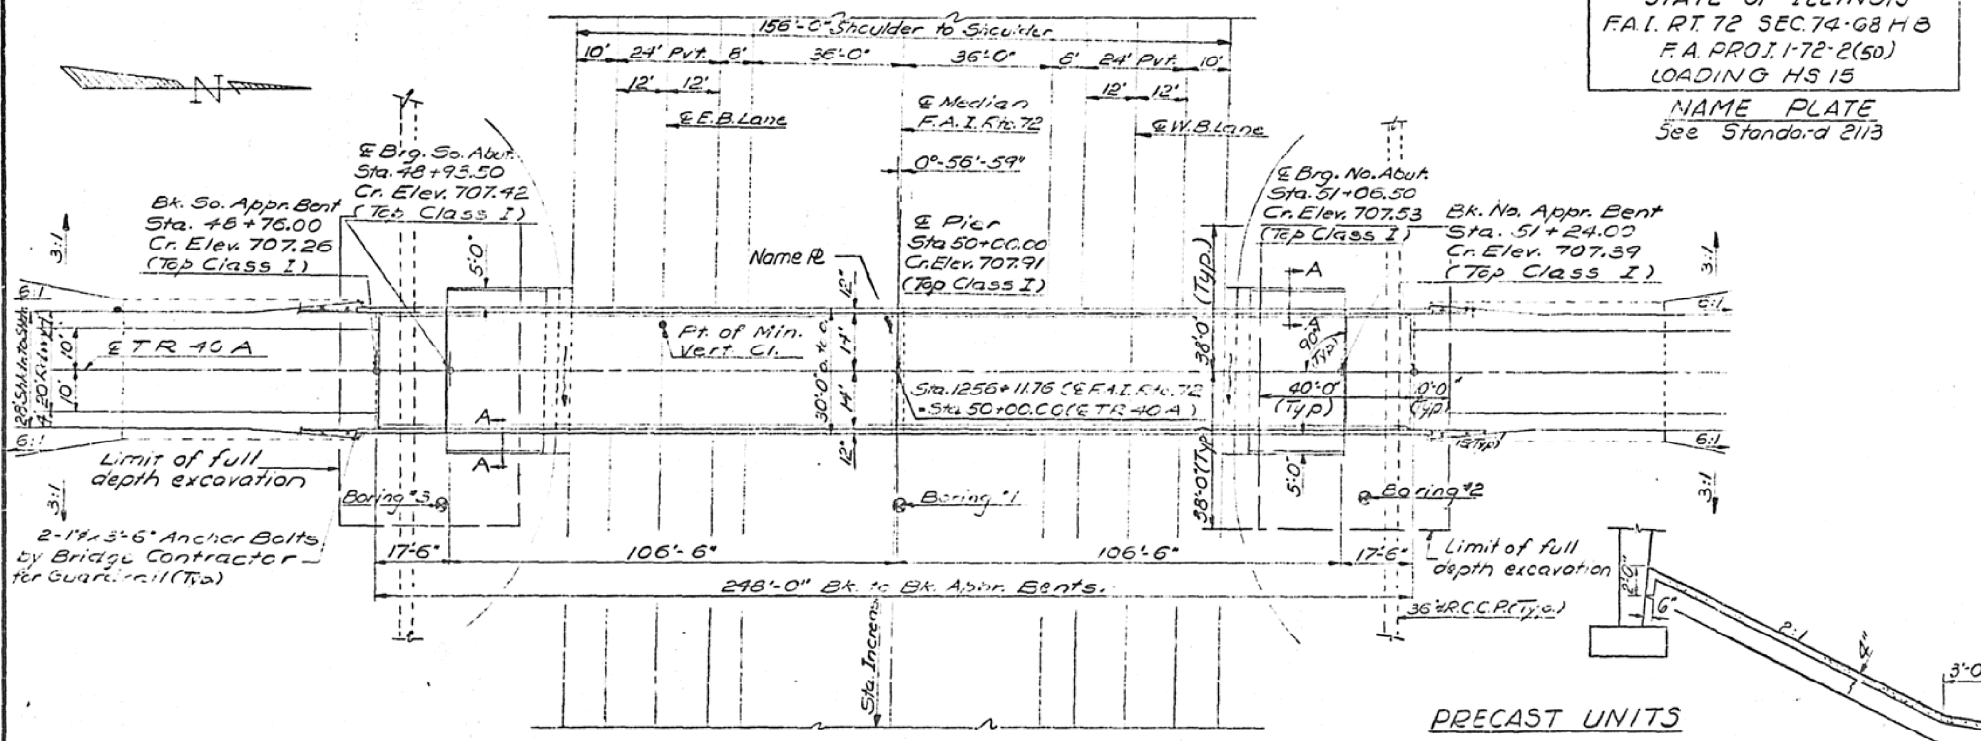

PLAN


PRECAST UNITS

$f_c = 6,000$ psi
 $f_{ci} = 5,000$ psi
 $f'_s = 270,000$ psi
 $f_s = 183,000$ psi
 Beams to be post tensioned after erection
 $f'_s = 202,500$ psi (acc. to int.)
 Anchor see - 93' (Min)


DESIGN STRESSES

$f_c = 1200$ psi (Deck slabs - main span)
 $f_c = 1400$ psi (Curb, Parapet, Subs & apron slabs)
 $f'_s = 20,000$ psi (Reinf.)
 $f'_s = 20,000$ psi (Struct.)
 $f_c = 75$ psi (Ft'gs)
 $n = 10$

SECTION THRU SLOPE WALL

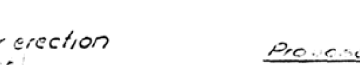

SEC A-A

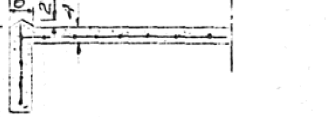


DESIGNED	W. H. H.
CHECKED	T. C. C.
DRAWN	M. W. H.
CHECKED	T. C. C.



PROFILE GR TR 40A
PROFILE GR F.A.I. RT 72
(@ E of Lanes)

Proposed Structure

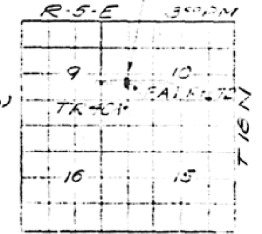

LOCATION SKETCH

All reinforcement bars shall be lapped. See diameters unless otherwise shown.

Slope wall shall be reinforced with welded wire fabric 6" x 6" mesh, weighing 58# per 100 sq. ft.

The embankment configuration shown shall be the minimum embankment that must be constructed prior to construction of the abutments.

The concrete rail section above the mandatory construction joint at the top of the slab shall be constructed of Class X Concrete, except the aggregates shall conform to the requirements of Hard-rail Concrete.

Protective Coat shall not be applied to surfaces to which Waterproofing Membrane System is applied.

The Contractor shall drive 3 test piles in permanent locations as directed by the Engineer before ordering the remainder of piles (for location see sheets 9 & 10).

Concrete Piles at approach bent shall be driven in holes precored through the embankment in accordance with Art. 51309 (c) of the Standard Specifications.

Concrete in beam splices shall be cured to 3,000 psi (Min) before post tension operation starts.

Concrete rail section above the mandatory joint at the top of slab and Class I Surfacing shall not be constructed before post tension operation has been completed. temporary supports have been removed.

See sheet #8 for construction sequence of Superstructure.

BILL OF MATERIAL

Item	Unit	Super	Sub	Total
Bit. Concrete Surf. Cse. Class 2	Tons	59		59
Structure Excavation	Cu Yds		50	50
Protective Coat	Sq Yds	190		190
Class X Concrete	Cu Yds	242.5	167.9	410.4
Post-tensioned Precast Concrete Slabs	Lin. Ft.	1,075		1,075
Neoprene Expansion Dam	Lin. Ft.	58		58
Aluminum Railing	Lin. Ft.	512		512
Reinforcement Bars	Lbs.	17,410	17,680	35,090
Concrete Piles	Lin. Ft.		1,403	1,403
Test Piles (Concrete)	Ea.		3	3
Waterproofing Membrane Sys.	Sq. Yds.	730		730
Slope Walls (2')	Sq. Yds.			330
Name Plates	Ea.		1	1
Sand Backfill	Cu Yds		120	120
Porous Granular Embankment	Cu Yds			2240
Earth Excavation	Cu Yds			2240

GENERAL PLAN & ELEVATION

PROJECT - I-72-2150-58
TR 40A OVER F.A.I. RT 72
F.A.I. RT 72 SEC. 74-68 HB
PLATT COUNTY
STA. 1256+11.76 (F.A.I. RT 72)
STA. 50+00.00 (TR 40A)