

PLOT DATE = 2/8/2010
 FILE NAME = c:\pwworking\PIERSONBR\00189676\289952.dwg
 PLOT SCALE = 1/8" = 1'-0"
 USER NAME = piersonbr

AS BUILT FOR CONCRETE MEDIAN



FOR INFORMATION ONLY

F.A.I. RTE.	SECTION	COUNTY	TOTAL SHEETS	SHEET NO.
72	*	PIATT	251	210


* (58,74-66)&(74-67&68)RS-1

STANDARD DESIGN CONCRETE MEDIANS


TYPE C-4

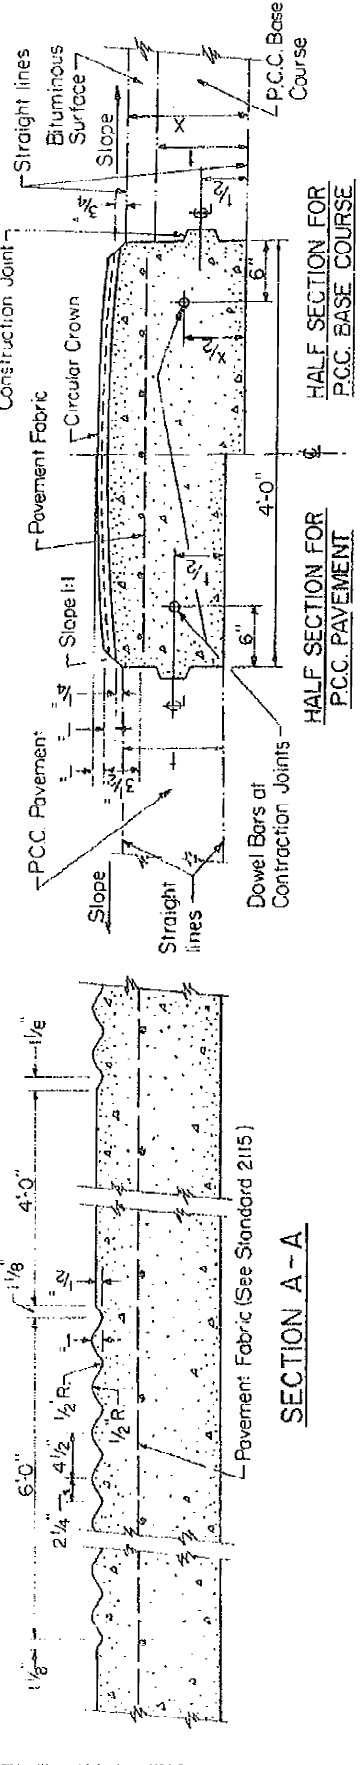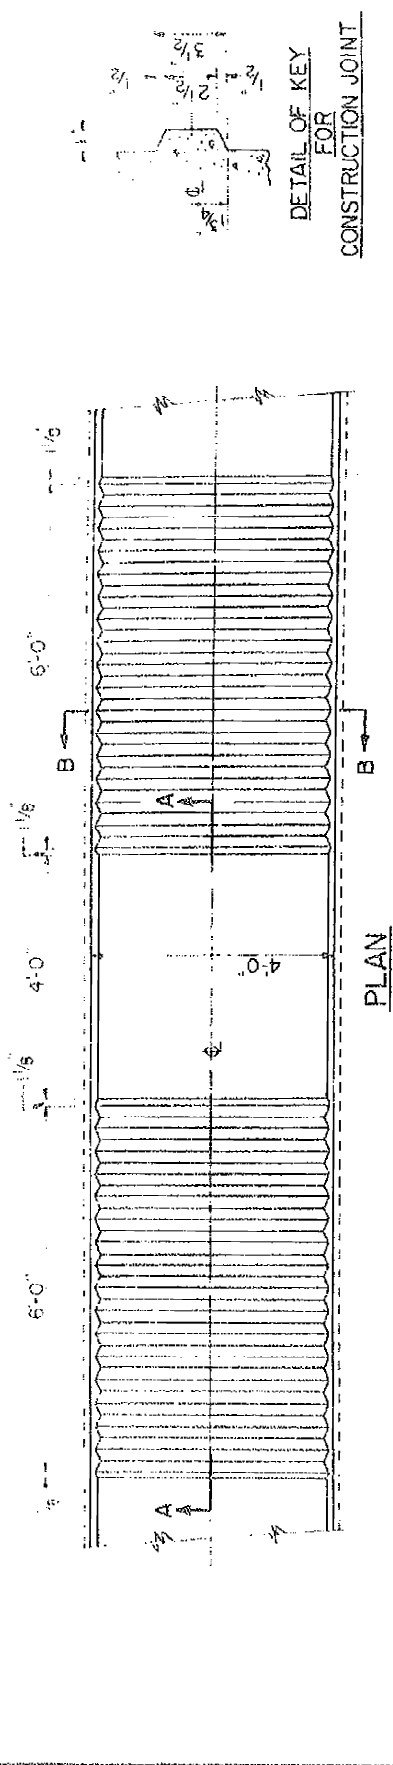

TYPE B-6.06

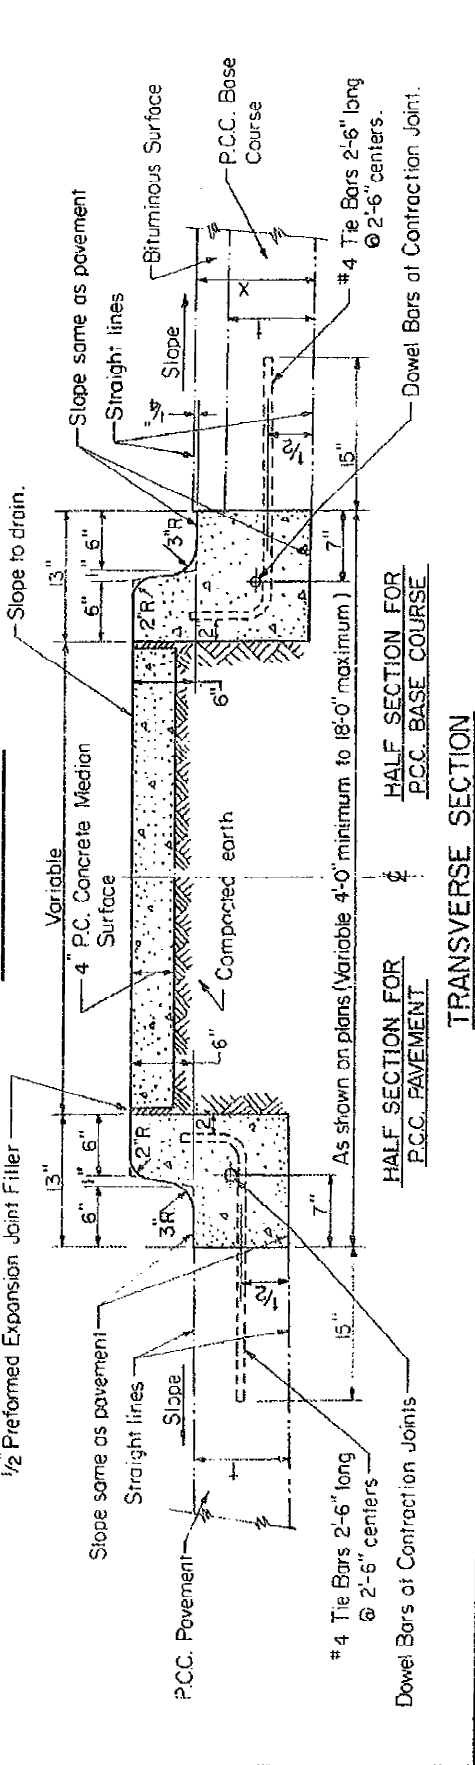

TYPE B-9.06

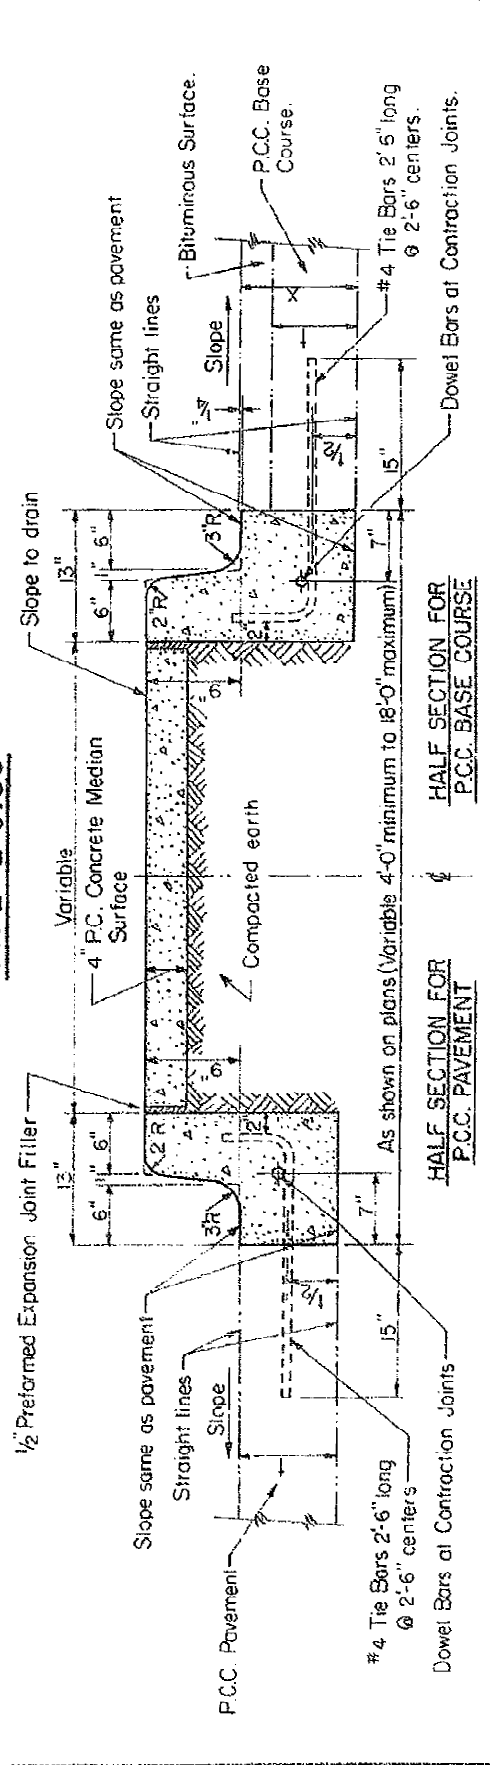

GENERAL NOTES

Dimension "1" is equal to the adjacent pavement edge thickness or base course edge thickness.
 Dimension "x" is equal to the adjacent base course edge thickness plus the bituminous surface edge thickness.
CONTRACTION JOINTS - Contraction joints of a type similar to that used in the adjacent pavement shall be installed in the Concrete Median in prolongation with the joints in the pavement. The details of the transverse joints in the Concrete Median shall be approved by the Engineer. If Contraction Joints are not provided in the pavement, Contraction joints will not be required in the Concrete Median. The cost of Contraction Joints including furnishing and placing dowel bars shall be included in the unit price bid per lineal foot for the particular type of Concrete Median specified.
 The cost of furnishing and placing pavement fabric in the median Type C-4 shall be included in the unit price bid per lineal foot for PORTLAND CEMENT CONCRETE MEDIAN, TYPE C-4.

The concrete median shall be constructed in accordance with the applicable portions of Section 80 of the Standard Specifications. The total perimeter of median curb will be measured for payment, and payment will be made at the contract unit price per lineal foot for the type of median specified.
 The 4" P.C. Concrete Median Surface shall be constructed in accordance with the applicable provisions of Section 89 of the Standard Specifications. This work shall be measured in place and the area computed in square feet; payment will be made at the contract unit price per square foot for PORTLAND CEMENT CONCRETE MEDIAN SURFACE 4 INCHES which price shall include the cost of furnishing and installing the expansion joints.
 The earth work shall be considered as being incidental to Earth Excavation.

STATE OF ILLINOIS DEPARTMENT OF PUBLIC WORKS & BUILDINGS DIVISION OF HIGHWAYS		REVISIONS
PASSED	BY	DATE
December, 12, 1962	WHF	12-12-62
<p style="text-align: right;">APPROVED: <i>[Signature]</i> December, 12, 1962 Engineer of Design</p>		

STANDARD 2122-1
Redrawn W.F. 12-12-62