


F.A. RTE.	SECTION	COUNTY	TOTAL SHEETS	SHEET NO.
338/IL 59	2011-036-1	DUPAGE	0	3
STA. TO STA.		FED. ROAD DIST. NO. ILLINOIS CONTRACT 60R30		

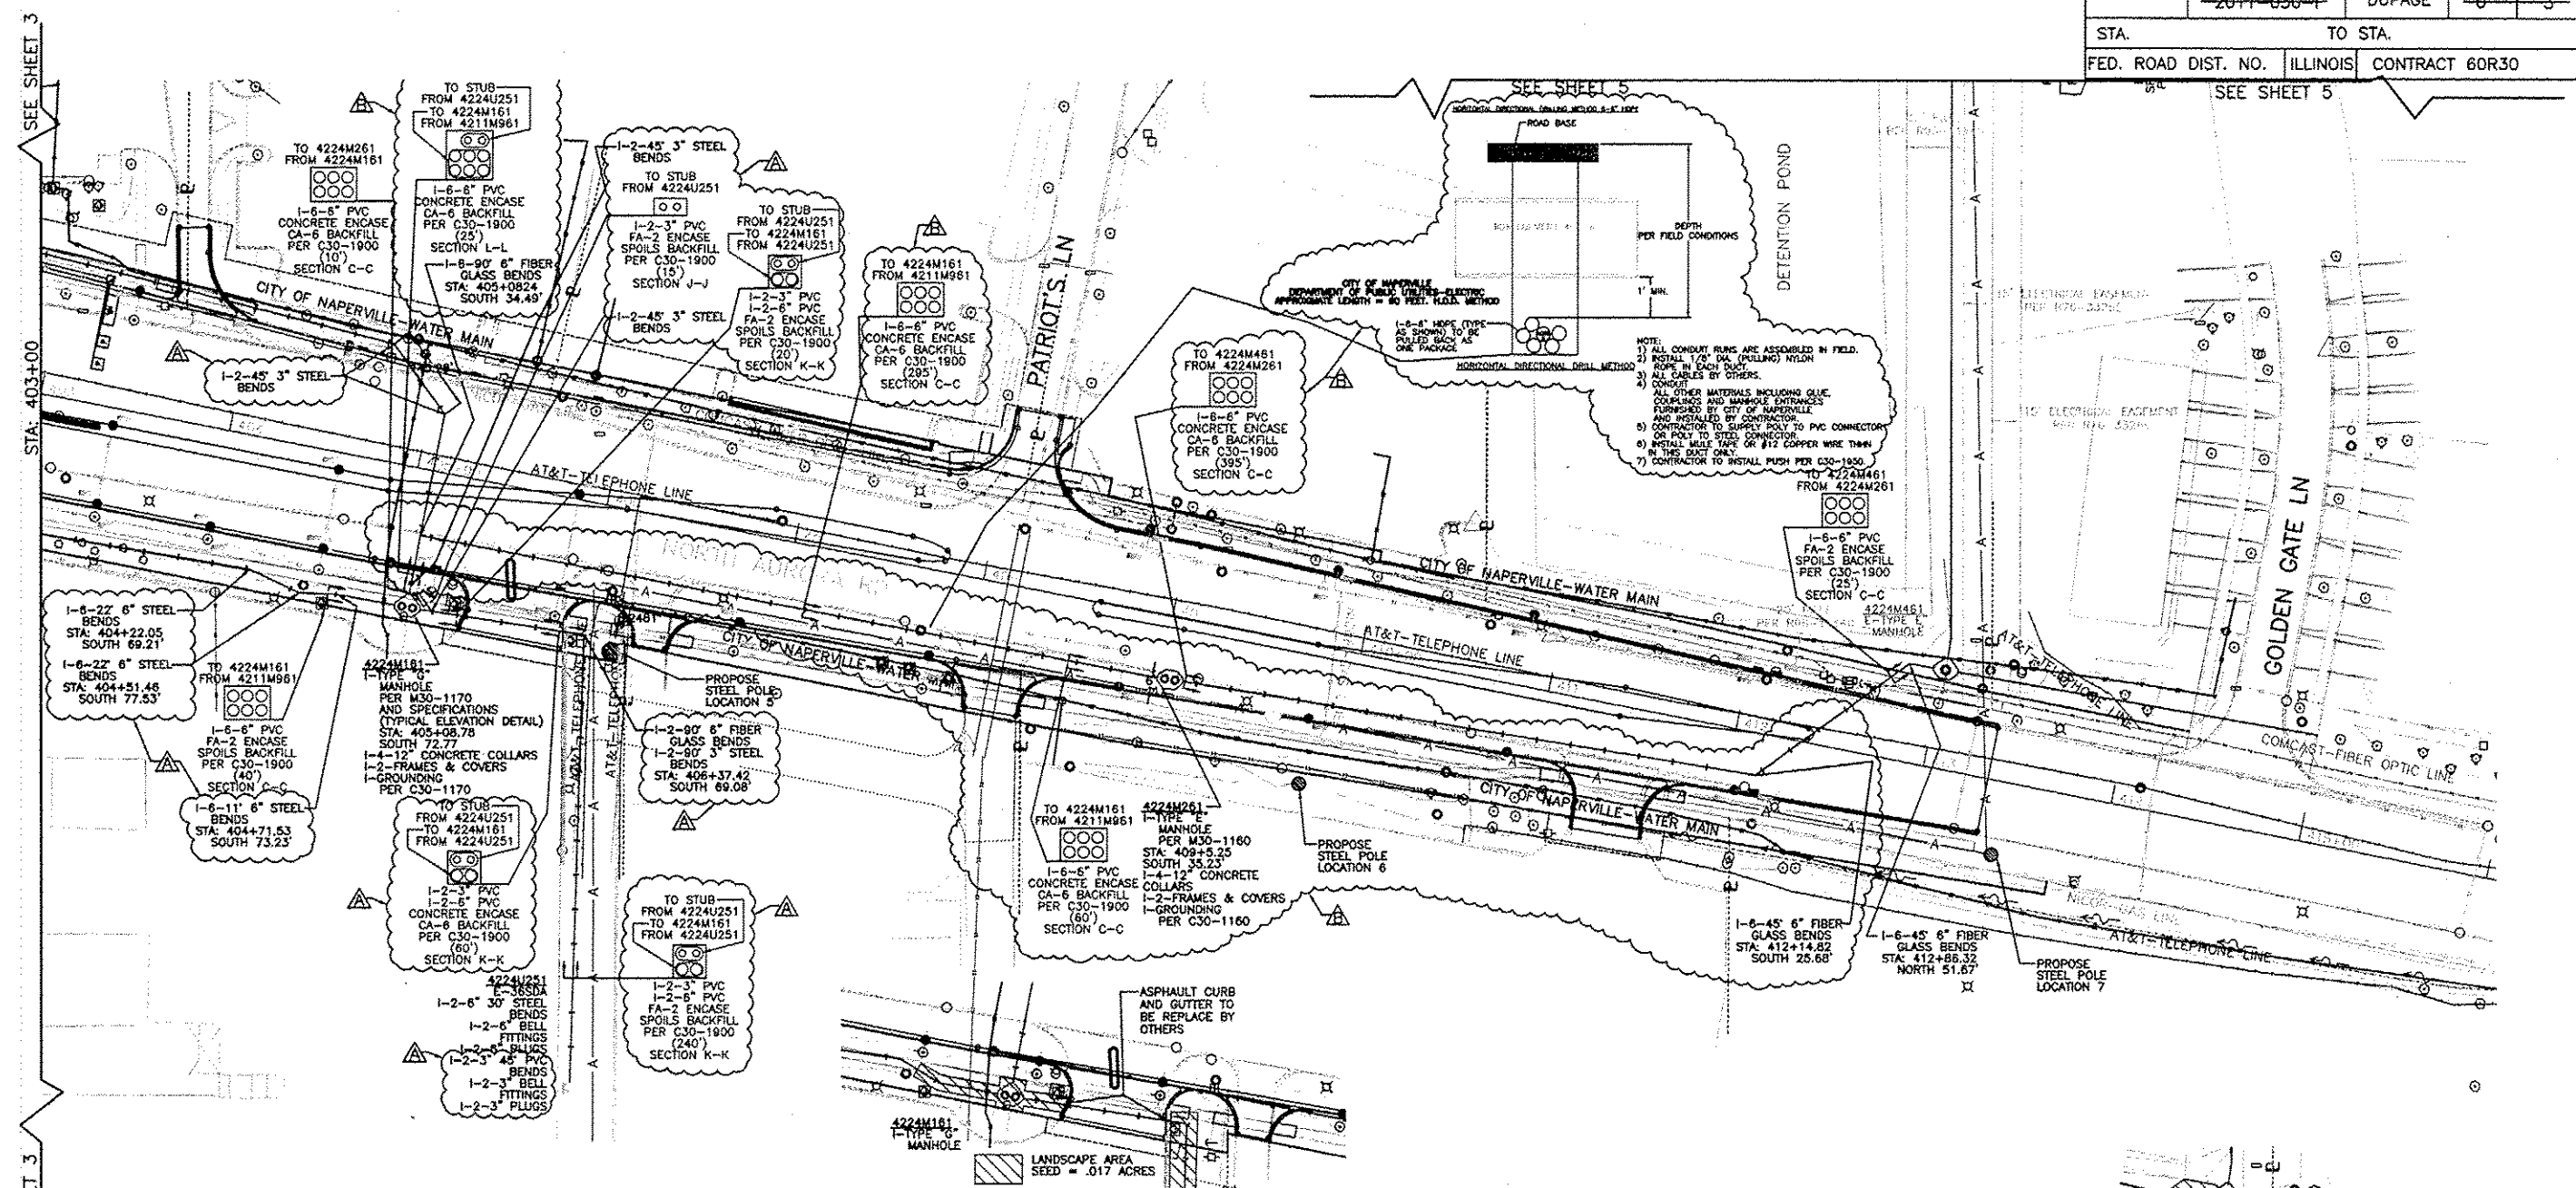

LEGEND

EXISTING	INSTALL
E-SW. MOD.	I-TYPE "G" DOUBLE OPENING MANHOLE
E-TYPE "E" MANHOLE	I-TYPE "E" DOUBLE OPENING MANHOLE
E-CONDUIT	I-CONDUIT
E-TYPE "G" MANHOLE	I-SW. VAULT
E-STEEL TRANSMISSION POLE	I-HANDHOLE PER C30-633
E-O.H. 138KV	

REMOVE AND REPLACE TREES

REMOVE AND REPLACE TREE

LANDSCAPE AREA SEED = .072 ACRES

REMOVE AND REPLACE TREE

CALL JULIE 48 HRS. PRIOR TO CONSTRUCTION
1-800-892-0123 OR CALL 811

NOTES:


- THE PROJECT ENGINEER FOR THIS PROJECT IS BRIAN CHAMBERLAIN PHONE NUMBER (630)420-8653.
- THE PROJECT COORDINATOR FOR THIS PROJECT IS PAUL MICHALOWSKI PHONE NUMBER (630)305-8227.
- CONTRACTOR IS RESPONSIBLE FOR MANHOLE PHOTOS TAKEN OF ALL CLEARLY MARKED CABLE AND ALL WALLS OF MANHOLES. PHOTOS WILL BE GIVEN TO THE GIS GROUP WITH THE AS-BUILTS.

ADDENDUM - 2-18-13

ADDENDUM - 4-30-13

LOCATION MAP

DESIGN REVISION DATES

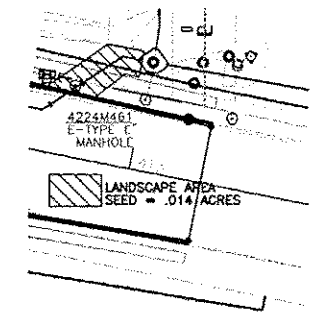

ROUTE 59 ROAD IMPROVEMENTS					
PROJECT DESCRIPTION	TO INSTALL FACILITIES AND RELOCATE OLD FACILITIES ALONG WITH THE ROAD PROJECT	DATE	2-07-13	4211.4224	1 = 40
DESIGNER	BCC	DATE	2-07-13	4211.4224	1 = 40
CHECKED BY	DL	DATE	N/A	EU-12	
DESIGNED BY	PSM	DATE	N/A	EU-12	
APPROVED BY		DATE		4 OF 40	
Naperville				Department of Public Utilities	61123
CONTRACT 60R30				Electric Division	
SHEET 805 OF 1156					