INDEX OF SHEETS

COVER SHEET **GENERAL NOTES** SUMMARY OF QUANTITIES 3.-5. TYPICAL CROSS SECTIONS EXISTING AND PROPOSED PLAN VIEWS 11.-14. DRAINAGE AND UTILITIES PLANS 15.-16 LANDSCAPING PLANS PAVEMENT MARKING PLANS 17,-18 19.-22. STREET LIGHTING PLANS STREET LIGHTING DETAILS 23.-28. CONSTRUCTION AND DISTRICT 3 DETAILS

STATE OF ILLINOIS DEPARTMENT OF TRANSPORTATION

DIVISION OF HIGHWAYS

PLANS FOR PROPOSED FEDERAL AID HIGHWAY

HIGHWAY STANDARDS

29.-30

821101-01

825021-03

STANDARD SYMBOLS, ABBREVIATIONS AND PATTERNS 000001-06 TEMPORARY EROSION CONTROL SYSTEMS 280001-07 PERPENDICULAR CURB RAMPS 424001-08 424011-02 CORNER PARALLEL CURB RAMPS 424016-02 MID BLOCK CURB RAMPS 442201-03 CLASS C AND D PATCHES CATCH BASIN, TYPE A 602001-02 CATCH BASIN, TYPE C 602011-02 INLET, TYPE A 602301-04 MANHOLE, TYPE A 602401-03 MANHOLE STEPS 602701-02 604001-04 FRAME AND LIDS TYPE 1 604086-03 FRAME AND GRATE TYPE 23 CONCRETE CURB TYPE B AND COMBINATION CONCRETE CURB AND GUTTER 606001-06 701427-04 LANE CLOSURE, MULTILANE, INTERMITTENT OR MOVING OPER., FOR SPEEDS ≤ 40 MPH URBAN LANE CLOSURE, MULTILANE INTERSECTION 701701-10 SIDEWALK, CORNER OR CROSSWALK CLOSURE 701801-06 701901-05 TRAFFIC CONTROL DEVICES SIGN PANEL ERECTION DETAILS 720006-04 728001-01 TELESCOPING STEEL SIGN SUPPORT BASE FOR TELESCOPING STEEL SIGN SUPPORT 731001-01 780001-05 TYPICAL PAVEMENT MARKINGS

IL 23/COLUMBUS STREET (FAP 68) FROM LINCOLN PLACE TO LAFAYETTE STREET (FAU 6025) ILLINOIS TRANSPORTATION ENHANCEMENT PROGRAM LIGHTING AND BEAUTIFICATION **PROJECT NO.: TE-00D3(096)**

SECTION NO.: 13-00167-00-LS

JOB NO.: C-93-021-16


CITY of OTTAWA LASALLE COUNTY

A Revised 6-7-16 DESIGN DESIGNATION - COLUMBUS ST ADT = 12300 (2015) EXISTING SPEED LIMIT: 30 MPH PROPOSED SPEED LIMIT: 30 MPH

LUMINARIE WIRING DIAGRAM

FUNCTIONAL CLASSIFICATION - COLLECTOR


LIGHTING CONTROLLER BASEMOUNTED, 240V

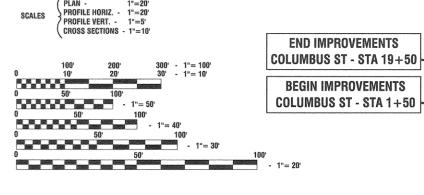


FULL SIZE PLANS HAVE BEEN PREPARED USING STANDARD ENGINEERING SCALES, REDUCED SIZED PLANS WILL NOT CONFORM TO STANDARD SCALES, IN MAKING MEASUREMENTS ON REDUCED PLANS. THE ABOVE SCALES MAY BE USED.


JOINT UTILITY LOCATION INFORMATION FOR EXCAVATION 1 - 800 - 892 - 0123 or 811


CONTRACT NO. 87635

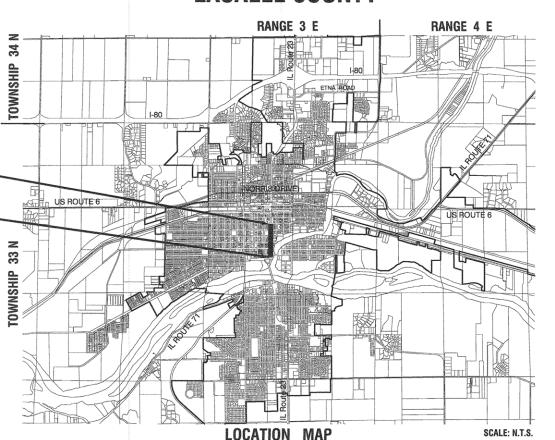

GROSS LENGTH=1,800 FEET=0.341 MILES NET LENGTH=1.800 FEET=0.341 MILES

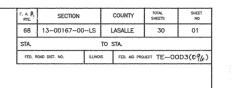

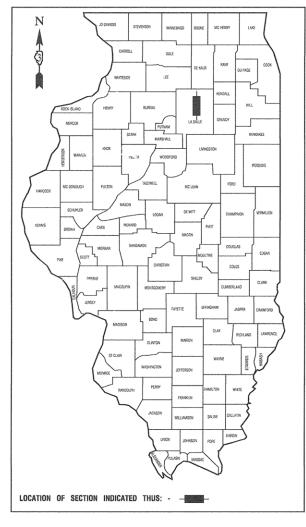

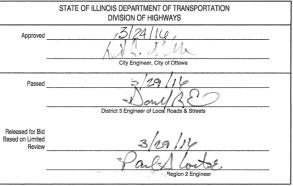

PRINTED BY THE AUTHORITY OF THE STATE OF ILLINOIS

PREPARED BY OR UNDER THE DIRECT SUPERVISION OF:



t	:10	CODE NO.	SUMMARY OF QUANTITIES PAY ITEM	UNIT	QUAN		RUCTION TY	
H	+	81028200	UNDERGROUND CONDUIT, GALVANIZED STEEL, 2" DIA.	FOOT	600	0005	600	003
Ļ	·	•••••	······································		~~~~	~~~	~~~~	\sim
E	*	81028240	UNDERGROUND CONDUIT, GALVANIZED STEEL, 4" DIA.	FOOT	50		50	-}
<u></u>	1	81603090	UNIT DUCT, 600Y, 3-1C NO.4, 1/C NO.6 GROUND, (XLP-TYPE USE), 1 1/4" DIA. POLYETHYLENE	FOOT	3600	~~~~	3600	~
-	-	81702440	ELECTRIC CABLE IN CONDUIT, 600V(XLP-TYPE USE) 3-1/C NO. 1/0	FOOT	285		285	
+	4	~~~	······································		~~~~	~~~	~~~	\sim
t	*	82500350	LIGHTING CONTROLLER, BASE-MOUNTED, 240VOLT, 100AMP	EACH	1			- {
		82500370	LIGHTING CONTROLLER, BASE MOUNTED, 240VOLT, 200AMP	EACH	'1	~~~	1	
	*	83600350	LIGHT POLE FOUNDATION, METAL, 11" BOLT CIRCLE, 8" X 6"	EACH	14		14	
L	*	89502376	REBUILD EXISTING HANDHOLE	EACH	19		19	-
-	_	A2002816	TREE, CATALPA SPECIOSA (NORTHERN CATALPA), 2" CALIPER, BALLED AND BURLAPPED	EACH	5			
-		A2002916	TREE, CELTIS OCCIDENTALIS (COMMON HACKBERRY), 2" CALIPER, BALLED AND BURLAPPED	EACH	4			
		A2004416	TREE, GINKGO BILOBA (GINKGO), 2" CALIPER, BALLED AND BURLAPPED	EACH	4			
		A2004619	TREE, GLEDITSIA TRIACANTHOS VAR. INERMIS IMPERIAL (IMPERIAL THORNLESS HONEYLOCUST), 1-3/4" CALIPER, BALLED AND BURLAPPED	EACH	4			
		A2004716	TREE, GLEDITSIA TRIACANTHOS INERMIS SHADEMASTER (SHADEMASTER THORNLESS COMMON HONEYLOCUST), 2" CALIPER, BALLED AND BURLAPPED	EACH	3			
					-			
		A2005016	TREE, GYMNOCLADUS DIOICUS (KENTUCKY COFFEETREE), 2" CALIPER, BALLED AND BURLAPPED	EACH	3			
		A2007014	TREE, QUERCUS ROBUR FASTIGIATA (FASTIGIATE ENGLISH OAK), 1-3/4" CALIPER, BALLED AND BURLAPPED	EACH .	3	-		
		A2018718	TREE, ULMUS CARPINIFOLIA MORTON, (ACCOLADE ELM), 2" CALIPER, BALLED AND BURLAPPED	EACH	3			
		A2008518	TREE, ULMUS MORTON GLOSSY (TRIUMPH ELM), 2" CALIPER, BALLED AND BURLAPPED	EACH	5	320		
		A2018726	TREE, ULMUS CARPINIFOLIA NEW HORIZON (NEW HORIZON SMOOTHLEAF ELM), 2" CALIPER, BALLED AND BURLAPPED	EACH	3			
	*	X4401198	HOT-MIX ASPHALT SURFACE REMOVAL, VARIABLE DEPTH	SQ YD	4450	4450	-	
	*	X6026050	SANITARY MANHOLES TO BE ADJUSTED	EACH	9	9		
	*	X6026624	VALVE BOXES TO BE ADJUSTED (SPECIAL)	EACH	15	15		
	*	X7010216	TRAFFIC CONTROL AND PROTECTION, (SPECIAL)	LSUM	1		1	
		X7830072	GROOVING FOR RECESSED PAVEMENT MARKING 6"	FOOT	160		160	
	*	XX007295	LIGHTING UNIT A, COMPLETE	EACH	20		20	
T	*	XX007296	LIGHTING UNIT B, COMPLETE	EACH			2	
	*	XX007295	LIGHTS, PEDESTRIAN	EACH	14		14	\prod
	*	XX009104	LIGHT POLE FOUNDATION, METAL, 12" BOLT CIRCLE, 8" X 6"	EACH	20	 	20	7
ſ	T			1	1	مسلم	h	T)

	FILE NAME = 13290-QUAN-01 - IDOT P03	USER NAME =	DESIGNED — JRA/WPD	REVISED - 6-7-16	8
	1		CHECKED JRA/WPD	REVISED —	
١		PLOT SCALE =	DRAWN — KM	REVISED	DEPART
		PLOT DATE = 03-23-16	CHECKED — AG	REVISED —	


STATE OF ILLINOIS
DEPARTMENT OF TRANSPORTATION


1		OFNEDAL NOTES	RTE.	SECTION	COUNTY SHEETS		NO.	
		GENERAL NOTES	68 13-00167-00-LS		LASALLE	30	05	
					CONTRACT	NO. 8763	5	
	SCALE:	SHEET NO. 05 OF 30 SHEETS STA. TO STA.	FED, ROAD DIST. NO. 3 ILLINOIS FED. AID PROJECT TE-00D 3 CO90					


SECTION


COUNTY TOTAL SHEET NO.


LASALLE 30 05

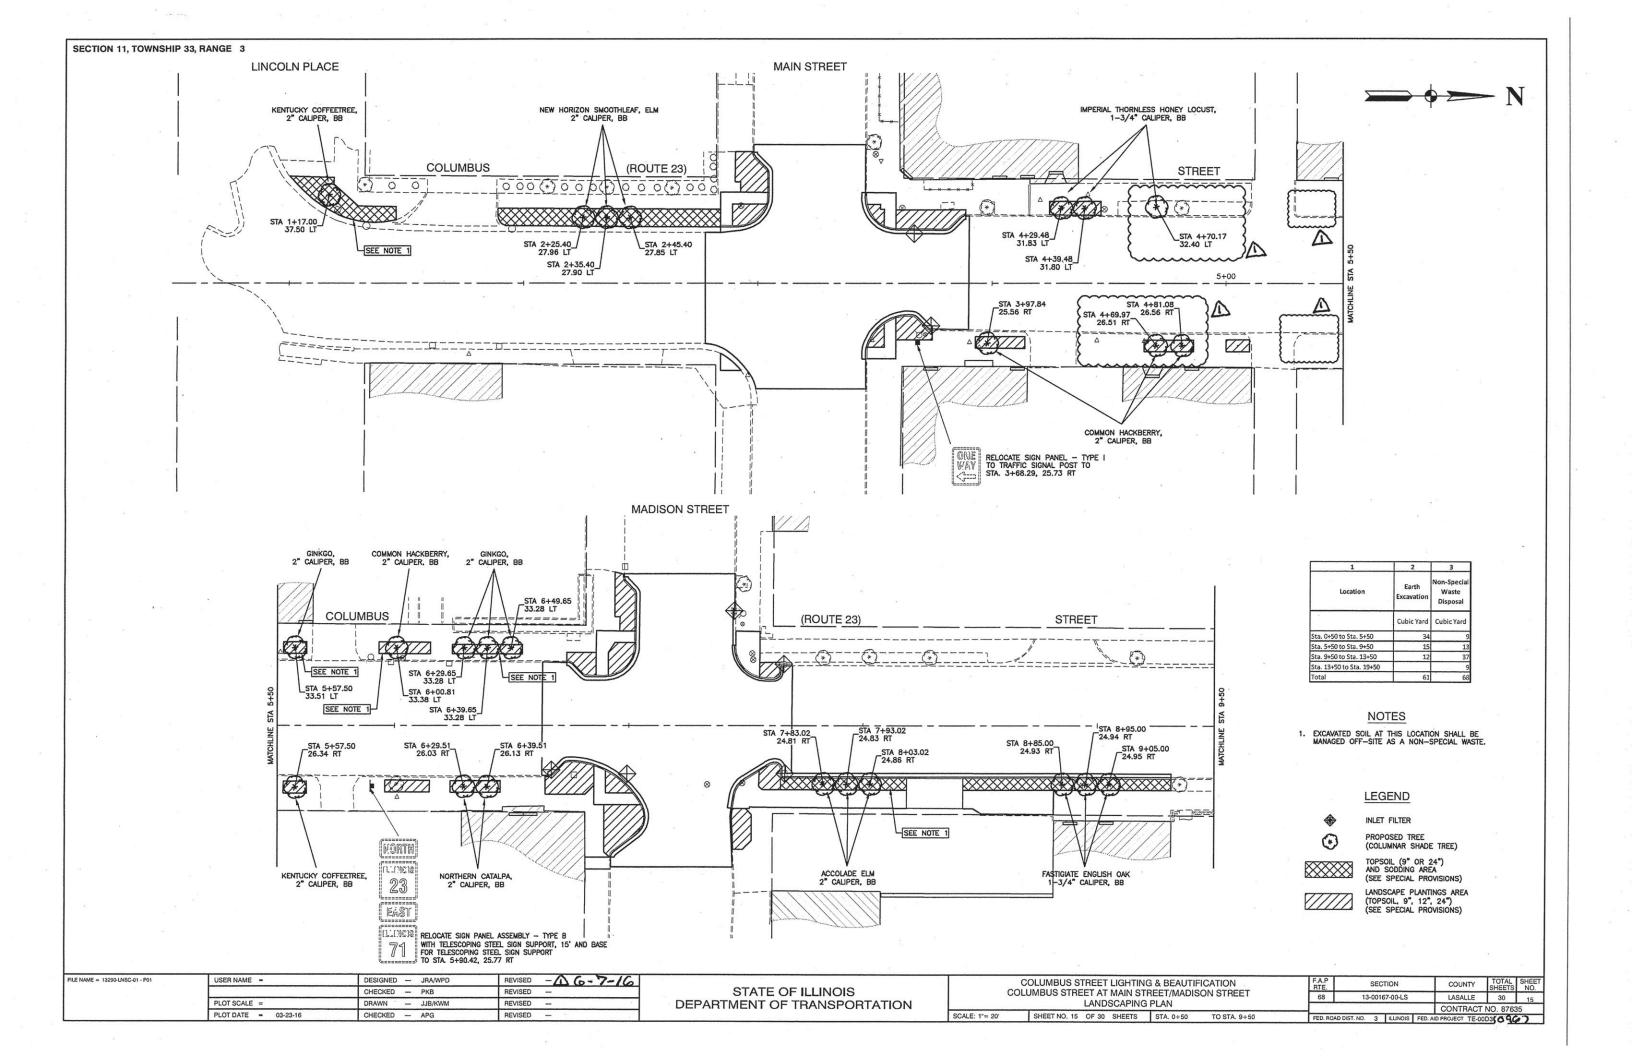


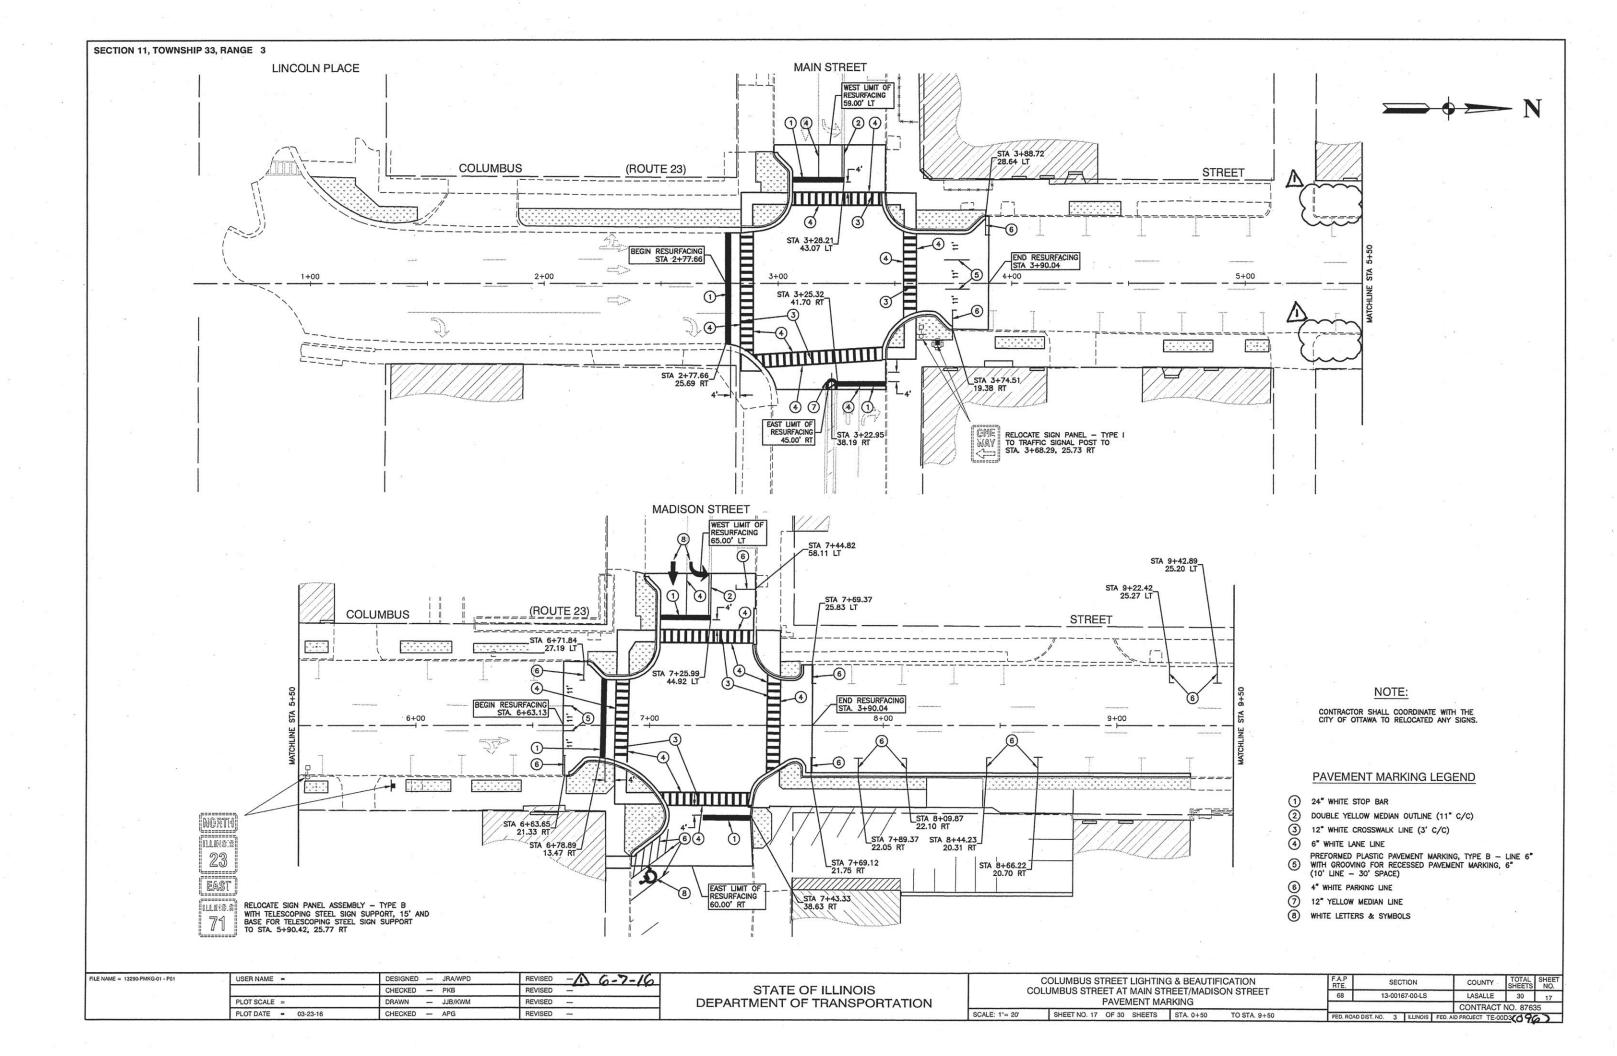


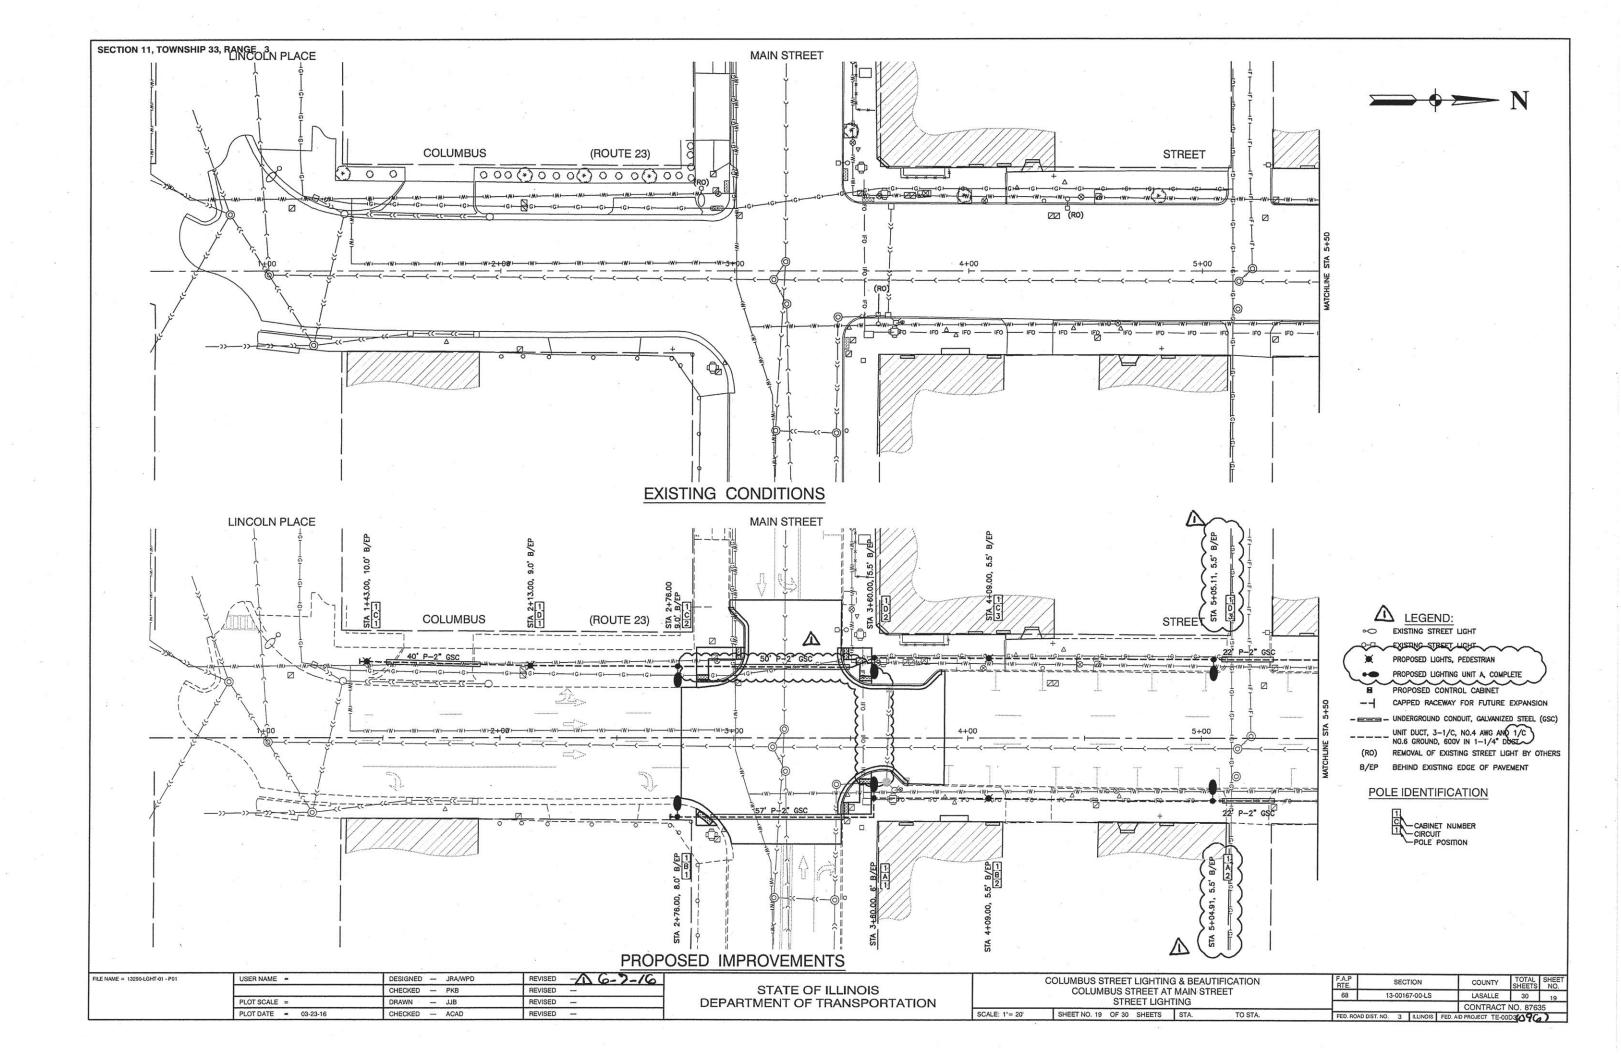

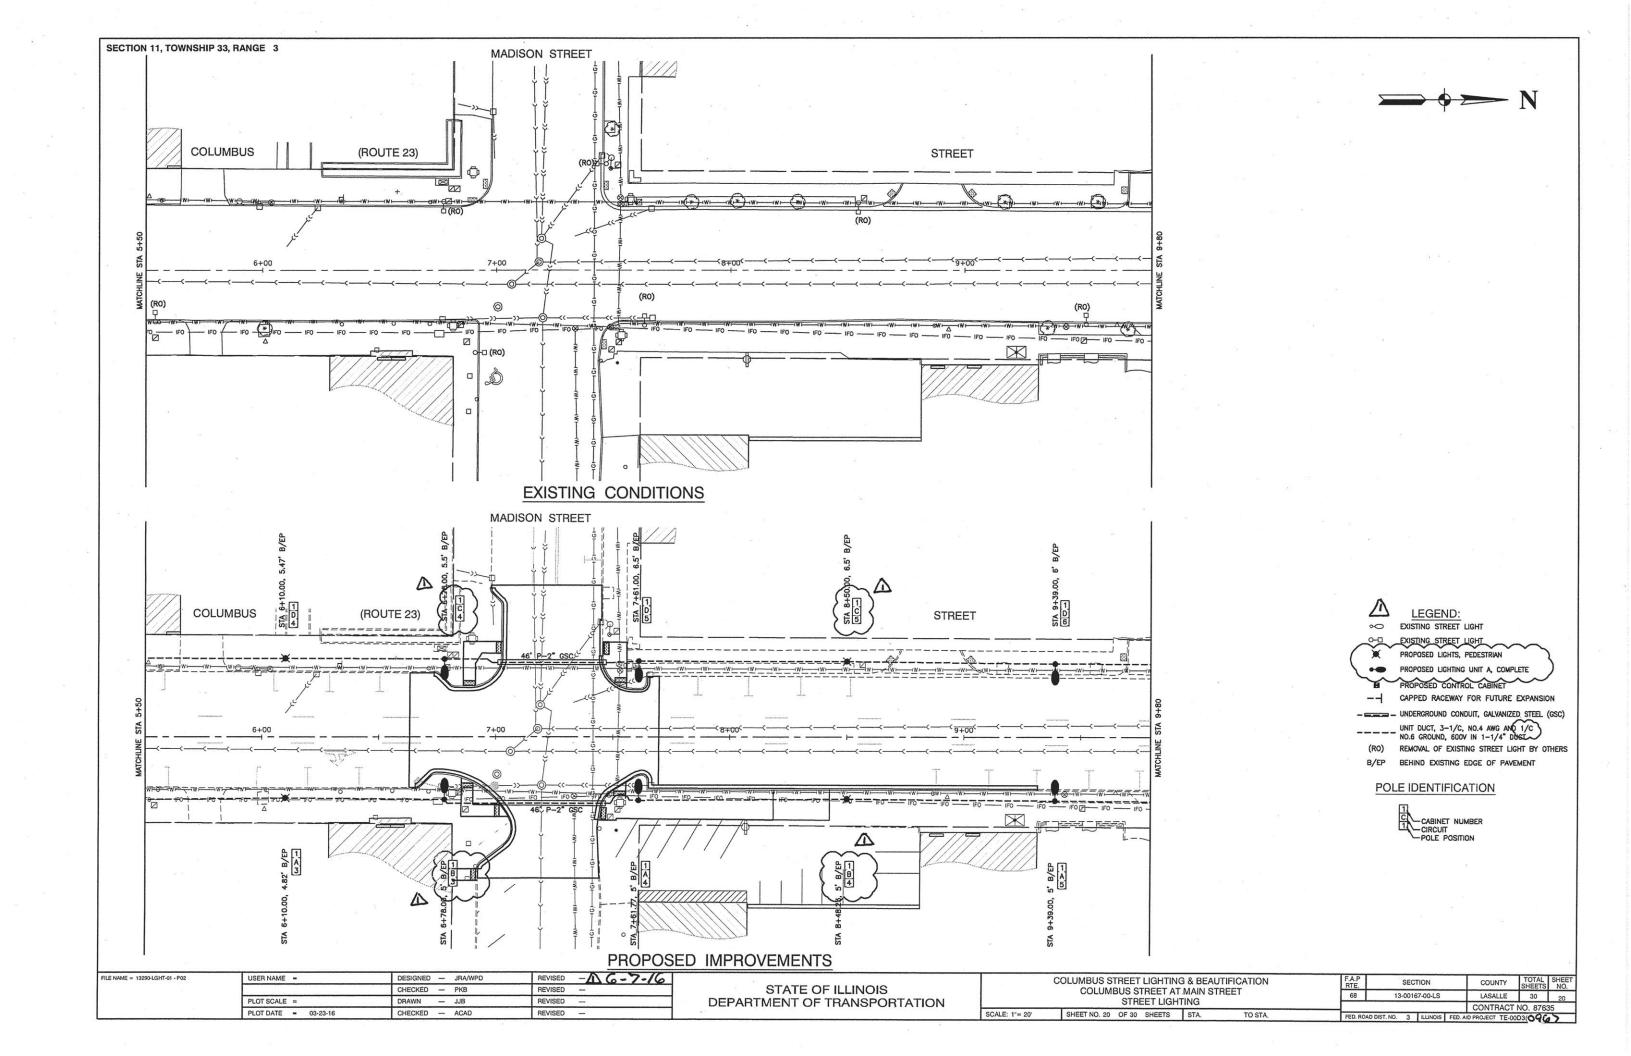

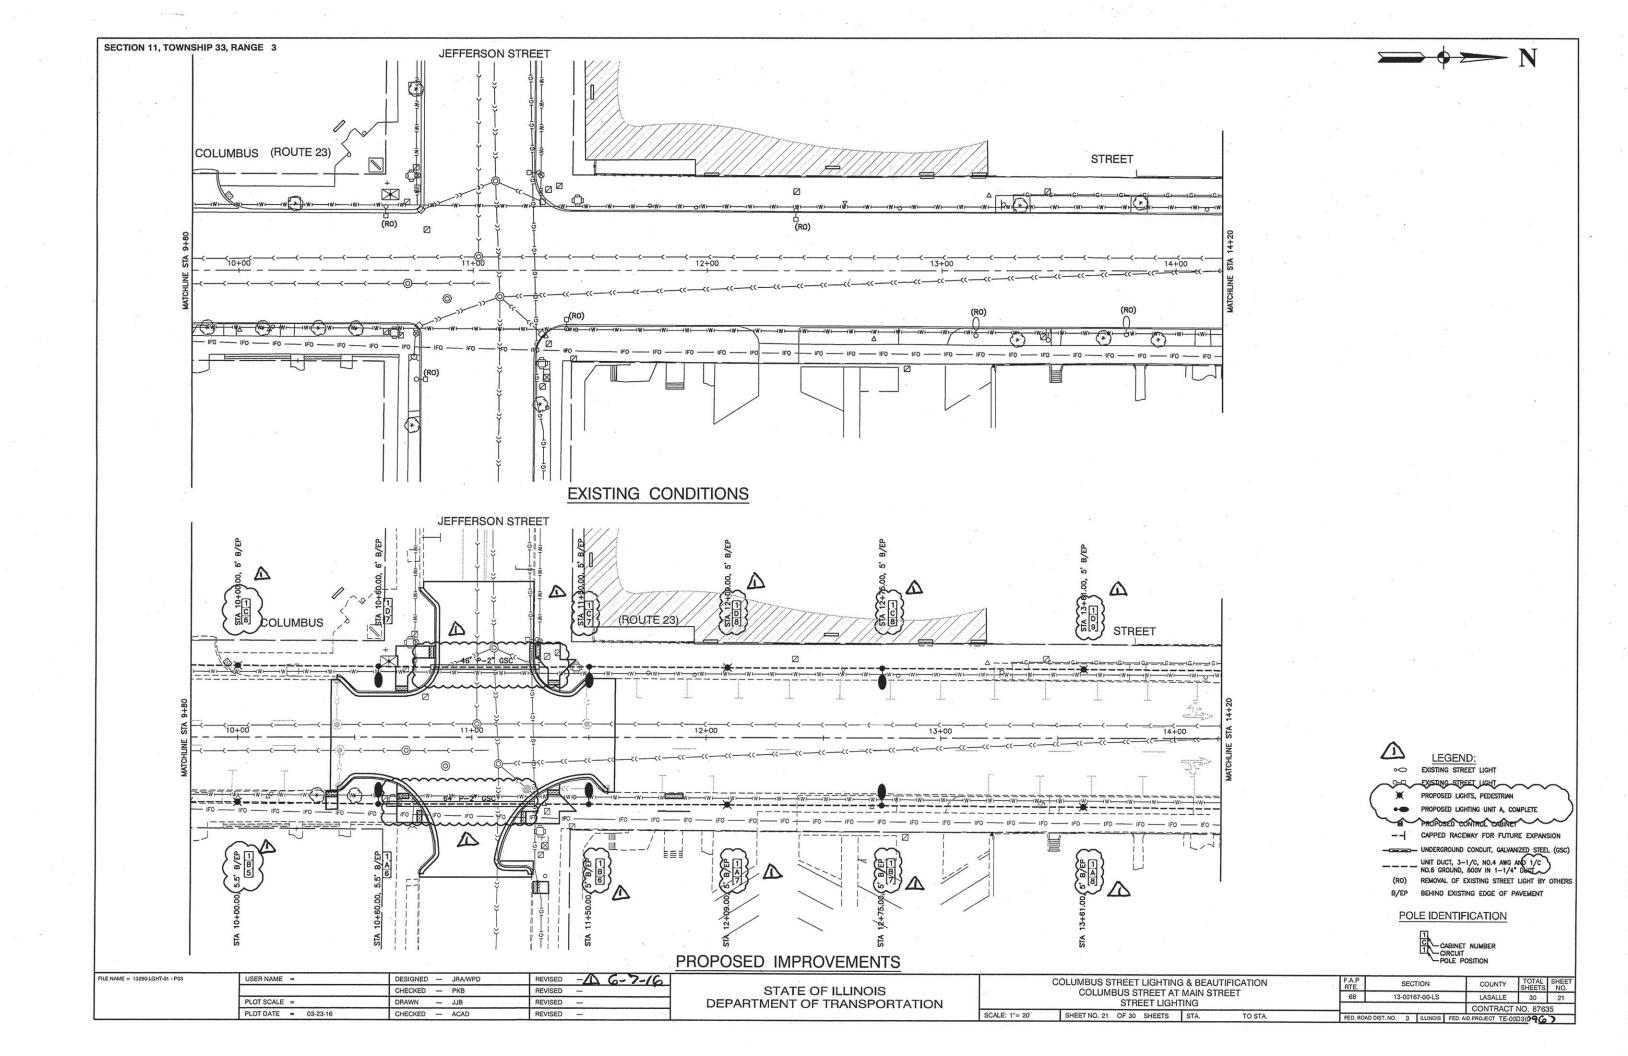

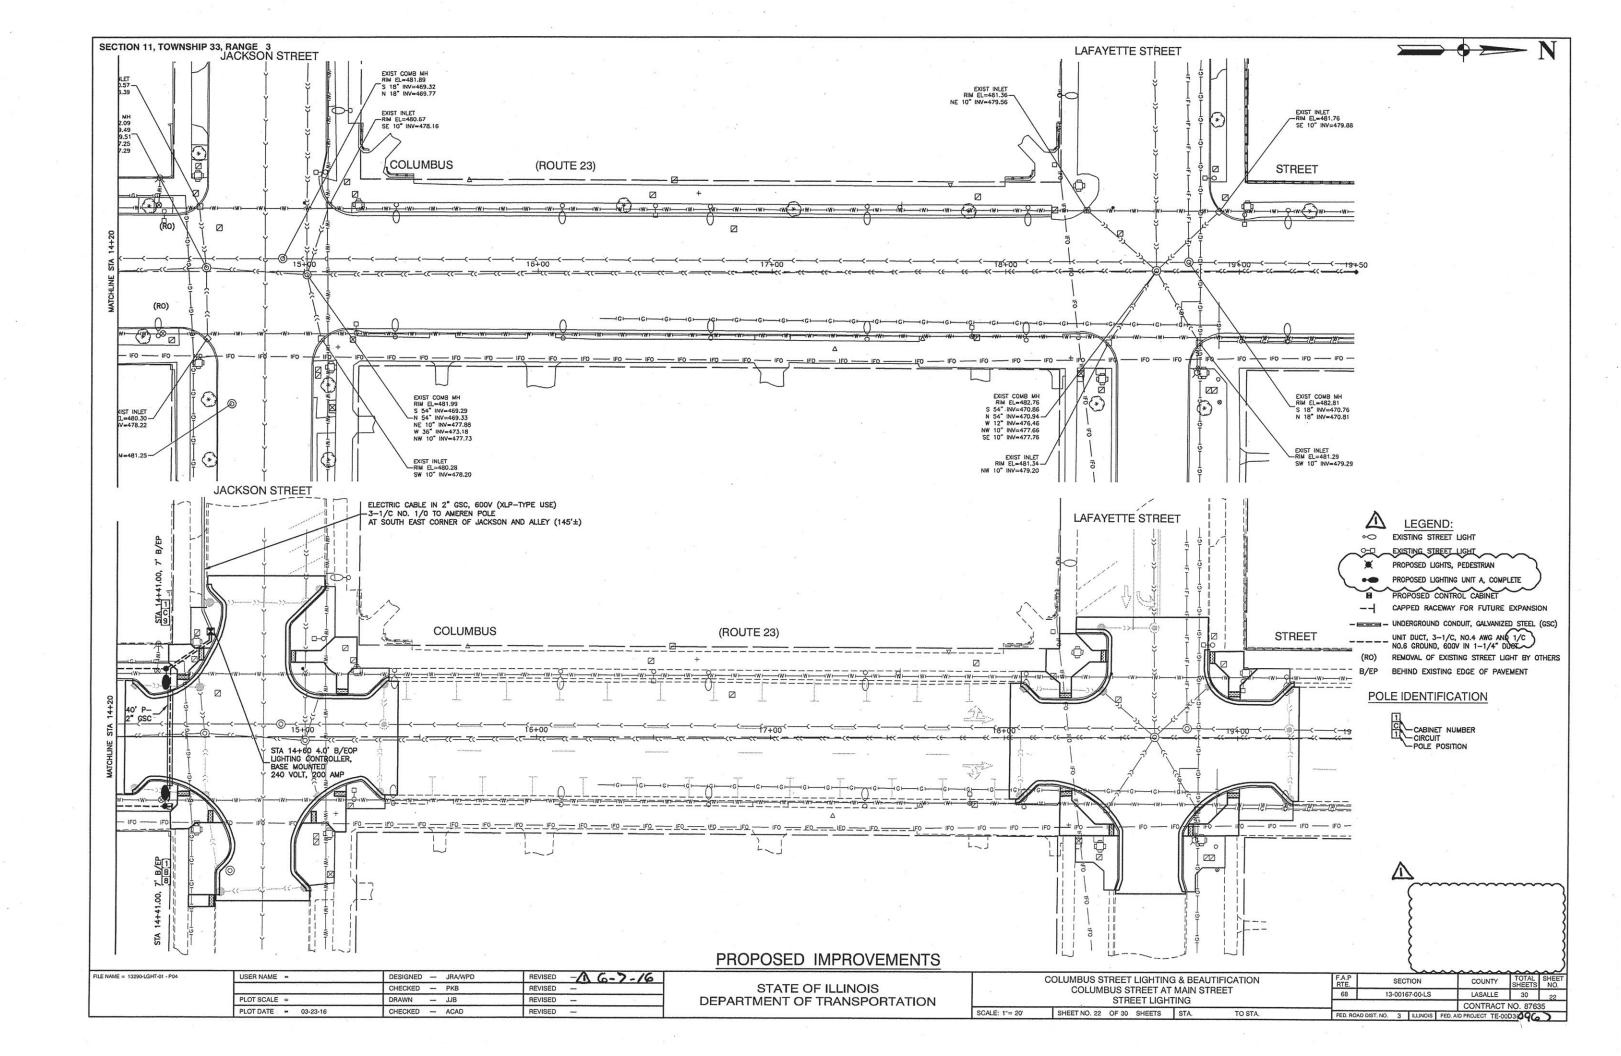

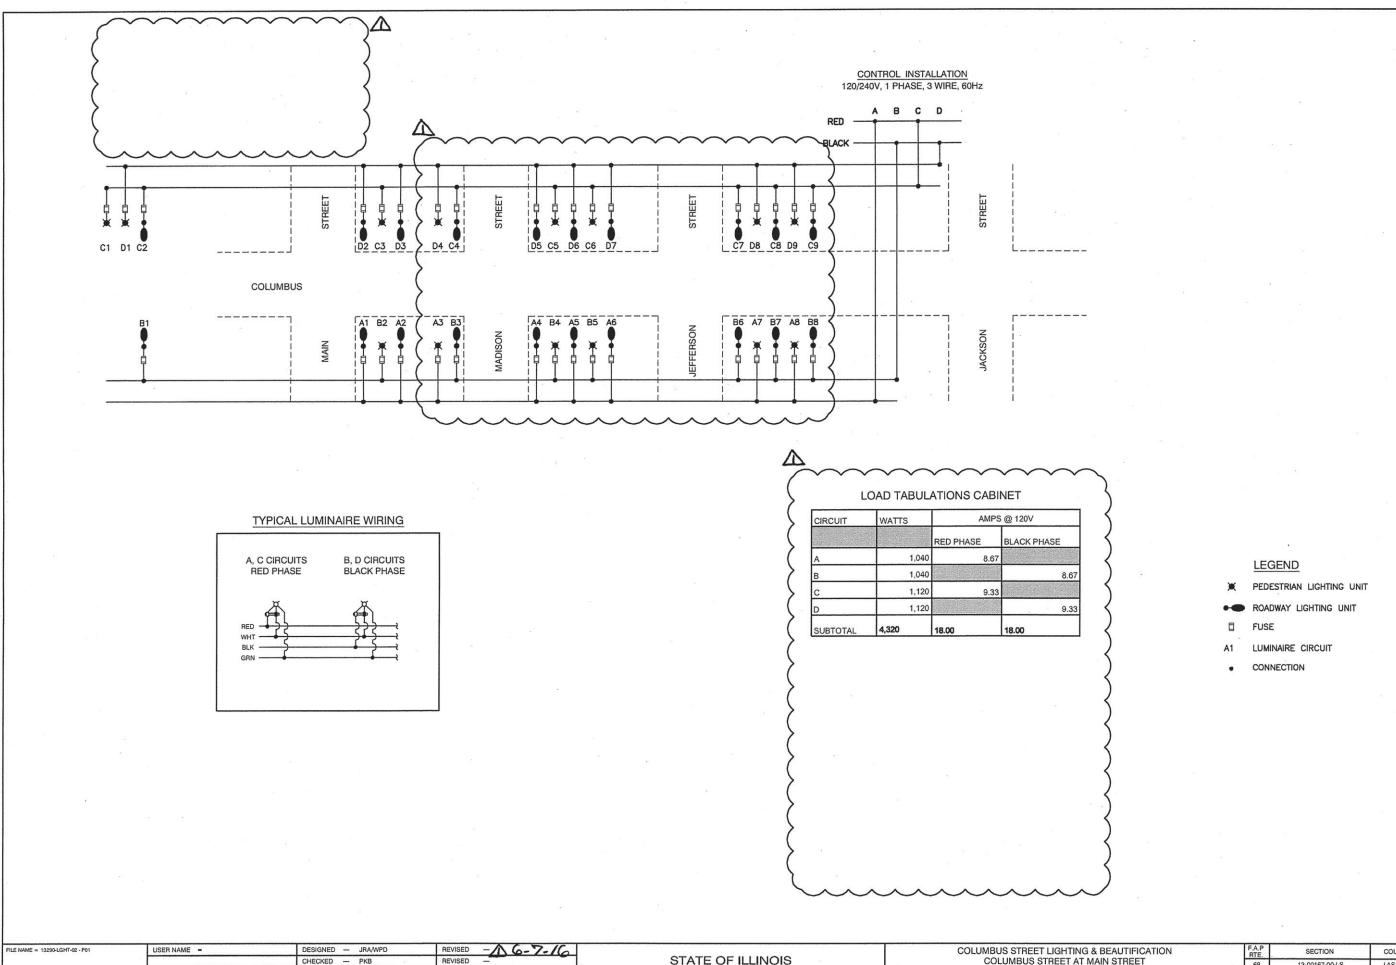



USER NAME =	DESIGNED — JRA/WPD	REVISED - 16-7-16
	CHECKED PKB	REVISED —
PLOT SCALE =	DRAWN — PS	REVISED
PLOT DATE = 03-23-16	CHECKED — AG	REVISED —


STATE OF ILLINOIS
DEPARTMENT OF TRANSPORTATION

COLUMBUS STREET LIGHTING & BEAUTIFICATION COLUMBUS STREET AT MAIN STREET STREET LIGHTING DETAILS						
CALE:	SHEET NO. 23	OF 30	SHEETS	STA.	TO STA	-


RTE.						SHEETS NO		
68	13	-001	67-00-LS		LASALLE	30	23	
					CONTRACT	NO. 8763	35	
FED. ROA	D DIST. NO.	3	ILUNOIS	FED. A	ID PROJECT TE-0	0D3109G	2	

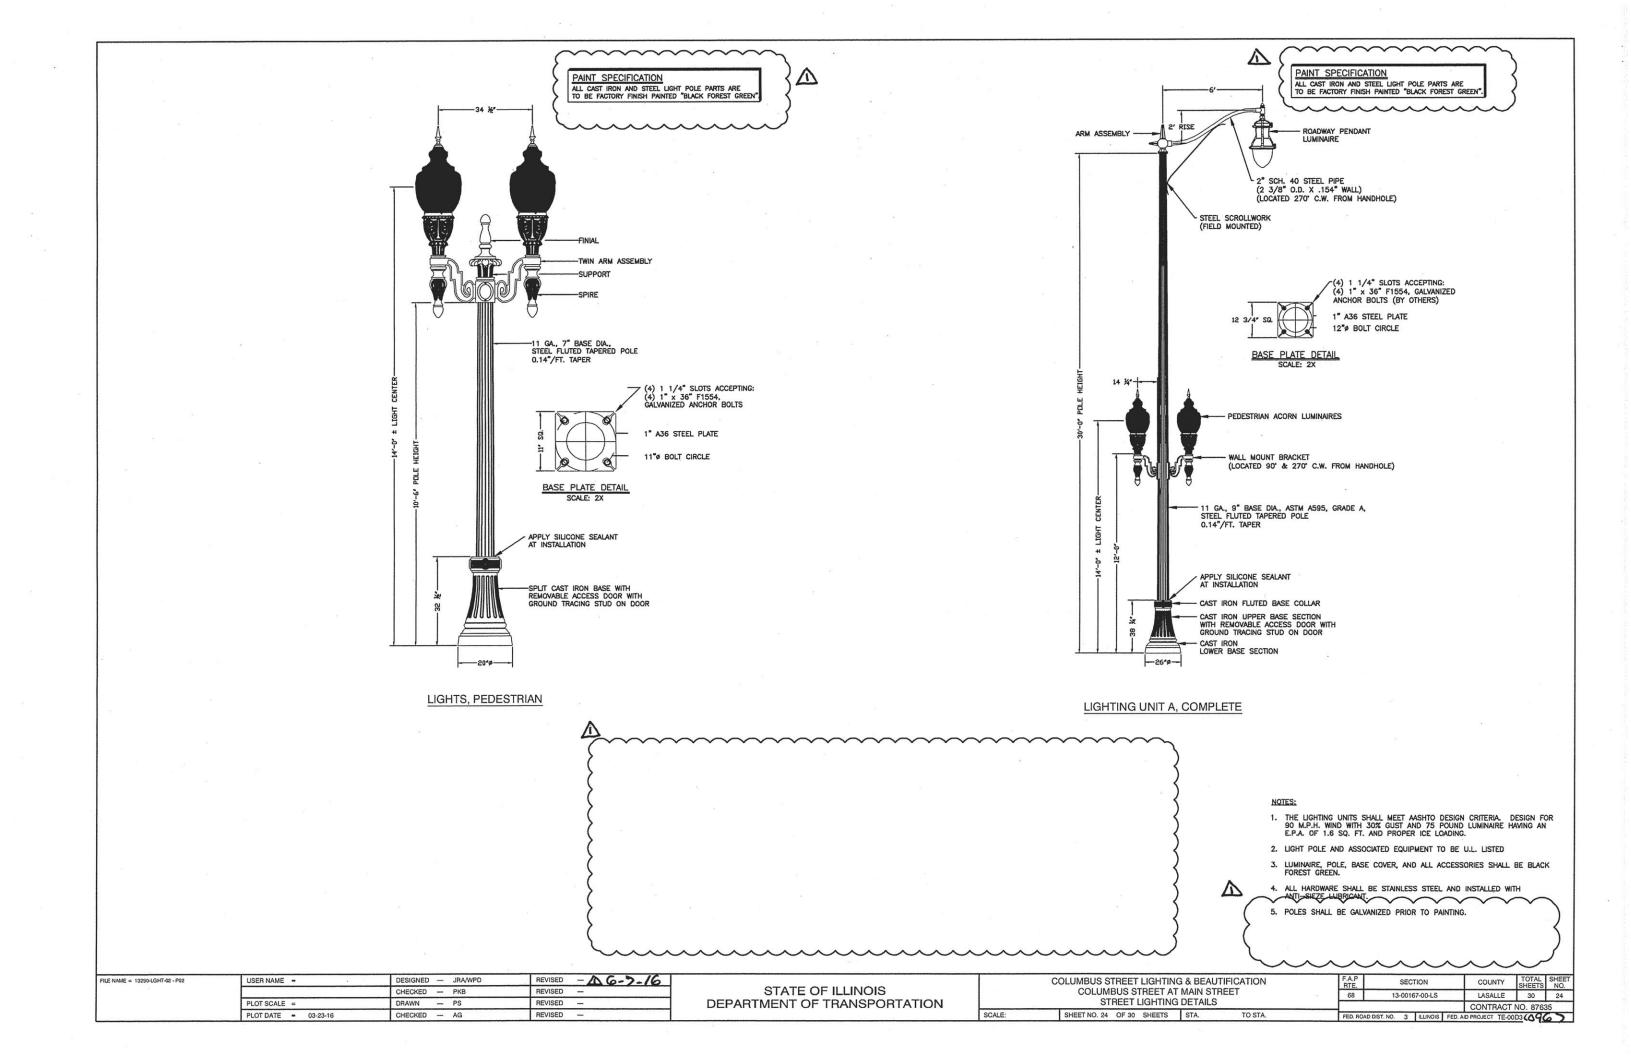


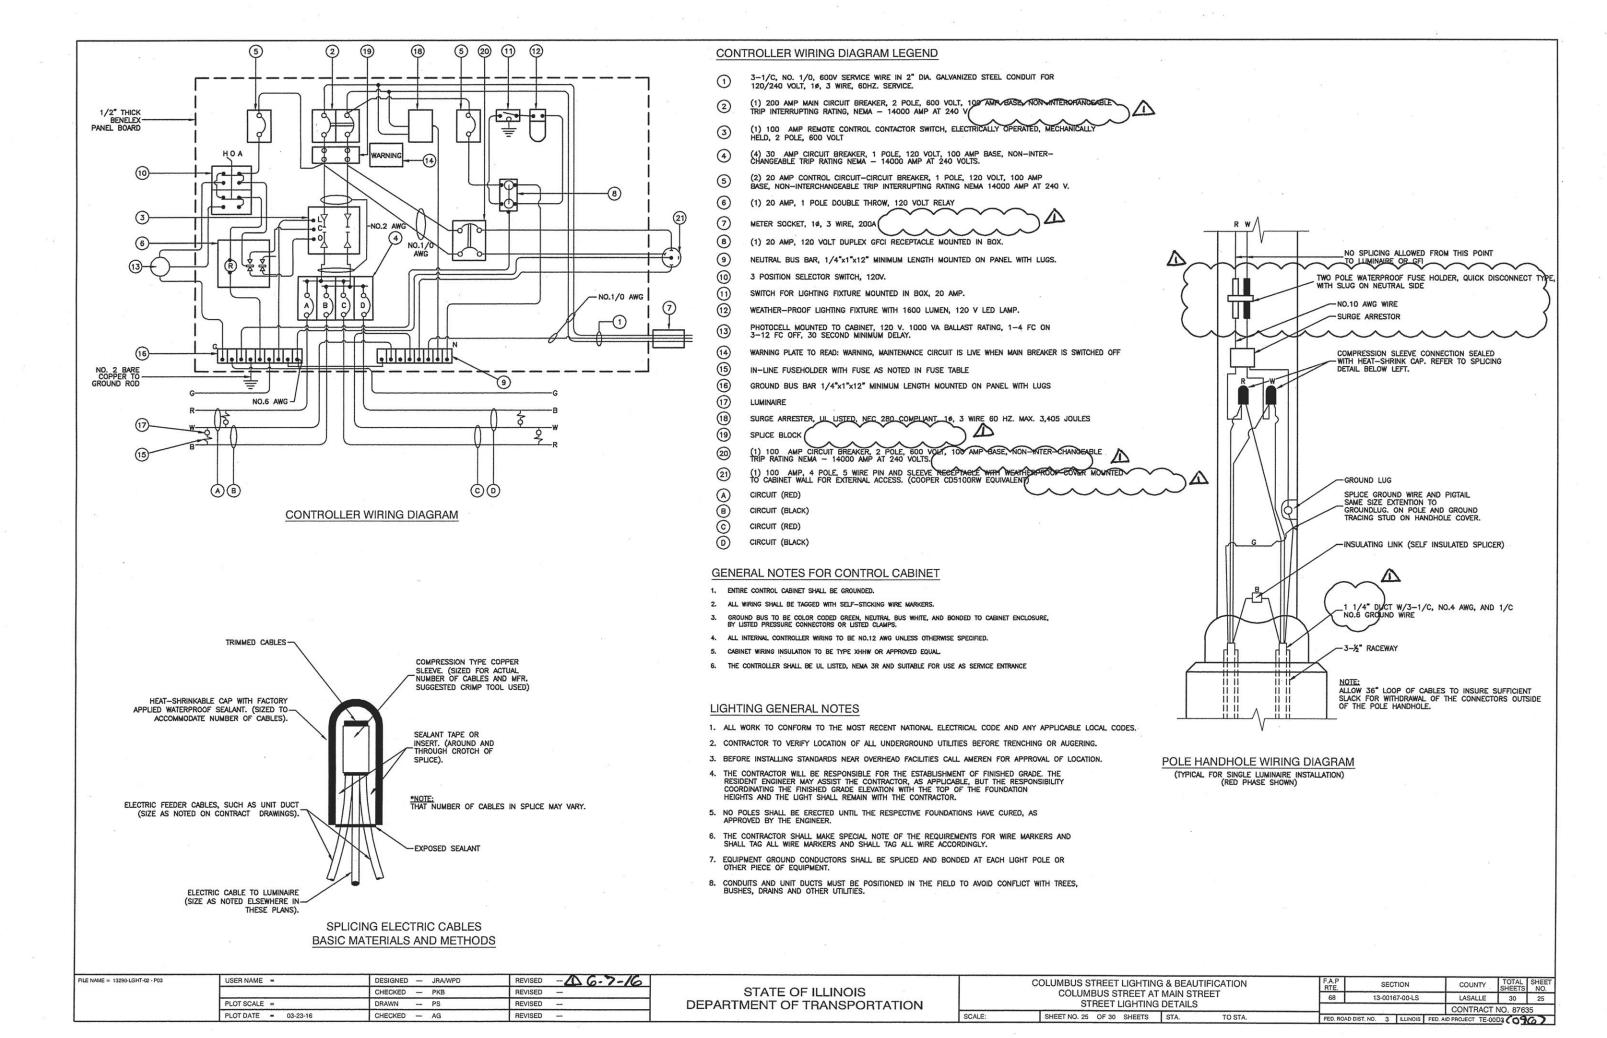

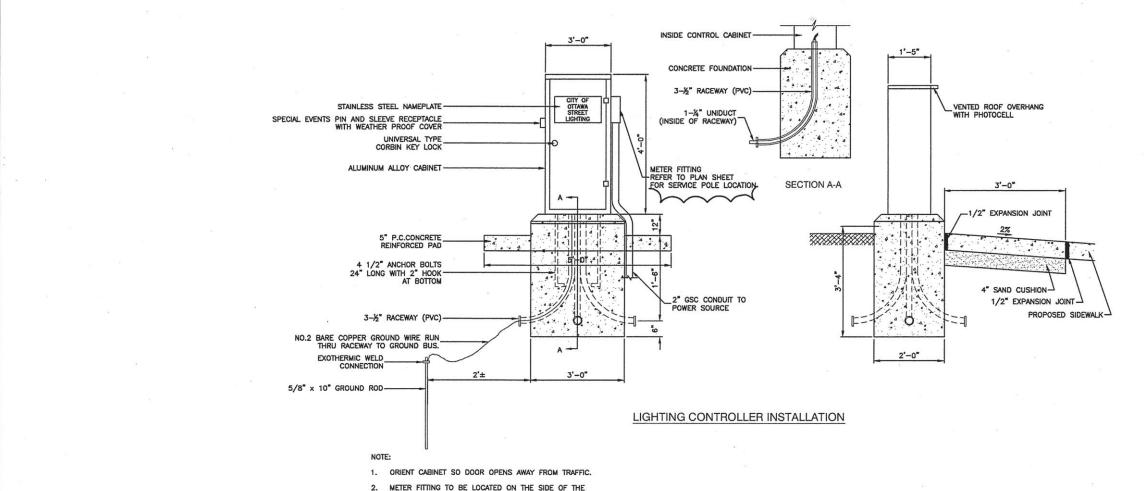

2. METER FITTING TO BE LOCATED ON THE SIDE OF THE CABINET CLOSEST TO SERVICE POLE.

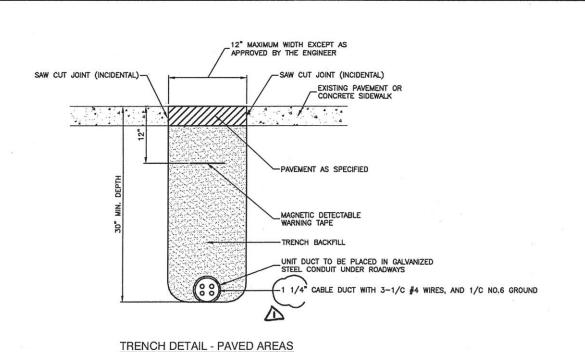

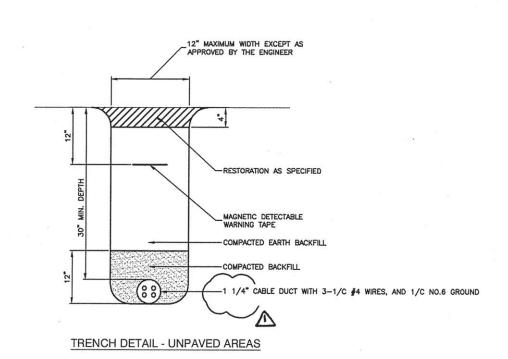

FILE NAME = 13290-LGHT-02 - P04	USER NAME =	DESIGNED — JRAWPD	REVISED -16-2-16
FILE NAME = 13250-LGH1-02 - P04	USER NAME	CHECKED — PKB	REVISED -
	PLOT SCALE =	DRAWN — PS	REVISED
	PLOT DATE - 03-23-16	CHECKED — AG	REVISED —

STATE OF ILLINOIS DEPARTMENT OF TRANSPORTATION

		F.A.P RTE. SECTION			COUNTY	TOTAL	SHEET NO.				
	COLUMBUS STREET AT MAIN STREET STREET LIGHTING DETAILS				68	13-001	67-00-LS		LASALLE	30	26
					W ======		CONTRACT	NO. 8763	35		
_	SCALE:	SHEET NO. 26 OF 30 SHEETS	STA.	TO STA.	FED. ROAD I	DIST. NO. 3	ILLINOIS	FED. A	AID PROJECT TE-00	D3(0) 9 (5

