
F.A.P. RTE.	SECTION		COUNTY		TOTAL SHEETS	SHEET NO.
312	101-2(RS-1,	N-1)	ALEXAN	NDER	189	86
STA.			TO STA.			
FED. RO	AD DIST. NO.	ILLIN	OIS FED.	AID	PROJECT	

## **BILL OF MATERIALS**

	UNIT	QUANTITY
CONDUIT, AUGERED 50MM DIA., PVC	METER	70
UNIT DUCT, 2#8 XLP, 1#8 XLP GROUND 20MM POLYETHYLENE	METER	690
TRENCH AND BACKFILL FOR ELECTRICAL WORK	METER	605
LIGHT POLE, WEATHERING STELL, 15. 2M. M.H., TENON MOUNT	EACH	5
LIGHT POLE, WEATHERING STELL, 15.2M. M.H., TENON MOUNT - TWIN	EACH	2
ELECTRIC SERVICE INSTALLATION	EACH	1
LUMINAIRE, SODIUM VAPOR, MULTI-MOUNT, 400 WATT	EACH	10
LIGHTING CONTROLLER, POLE MOUNTED, 240VOLT, &OAMP	EACH	1
LIGHT POLE FOUNDATION METAL, 15" BOLT CIRCLE, 8" X 8"	EACH	8
BREAKWAY DEVI <b>c</b> e, COUPLING, WITH STAINLESS STEEL SCREEN	EACH	32
REMOVAL OF <del>EXISTING</del> LIGHTING UNIT, NO SALVAGE	EACH	2
REMOVAL OF POLE FOUNDATION		2
REMOVAL OF LIGHTING CONTROLLER	EACH	1
REMOVAL OF ELECTRIC SERVICE INSTALLATION	EACH	1
	UNIT DUCT, 2*8 XLP, 1*8 XLP GROUND 20MM POLYETHYLENE  TRENCH AND BACKFILL FOR ELECTRICAL WORK  LIGHT POLE, WEATHERING STELL, 15. 2M. M. H., TENON MOUNT  LIGHT POLE, WEATHERING STELL, 15. 2M. M. H., TENON MOUNT - TWIN  ELECTRIC SERVICE INSTALLATION  LUMINAIRE, SODIUM VAPOR, MULTI-MOUNT, 400 WATT  LIGHTING CONTROLLER, POLE MOUNTED, 240VOLT, 60AMP  LIGHT POLE FOUNDATION METAL, 15" BOLT CIRCLE, 8" X 8"  BREAKWAY DEVICE, COUPLING, WITH STAINLESS STEEL SCREEN  REMOVAL OF EXISTING-LIGHTING UNIT, NO SALVAGE  REMOVAL OF POLE FOUNDATION REMOVAL OF LIGHTING CONTROLLER	UNIT DUCT, 2*8 XLP, 1*8 XLP GROUND 20MM METER POLYETHYLENE  TRENCH AND BACKFILL FOR ELECTRICAL WORK METER  LIGHT POLE, WEATHERING STELL, 15. 2M. M. H., TENON MOUNT  LIGHT POLE, WEATHERING STELL, 15. 2M. M. H., TENON EACH MOUNT - TWIN  ELECTRIC SERVICE INSTALLATION EACH  LUMINAIRE, SODIUM VAPOR, MULTI-MOUNT, 400 WATT EACH  LIGHTING CONTROLLER, POLE MOUNTED, EACH 240VOLT, 60AMP  LIGHT POLE FOUNDATION METAL, 15" BOLT CIRCLE, EACH 8" X 8"  BREAKWAY DEVICE, COUPLING, WITH STAINLESS EACH STEEL SCREEN  REMOVAL OF EXISTING-LIGHTING UNIT, NO SALVAGE EACH  REMOVAL OF POLE FOUNDATION EACH  REMOVAL OF LIGHTING CONTROLLER  EACH  REMOVAL OF LIGHTING CONTROLLER

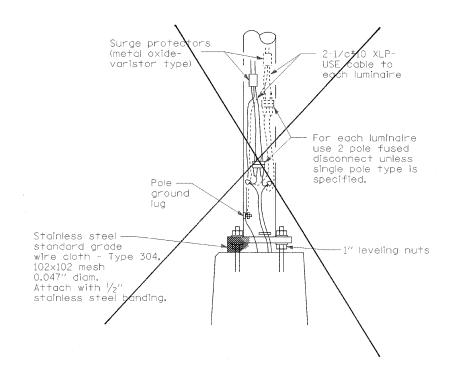

REVISIONS	TILITIOTS DEPARTMEN	IT OF TRANSPORTATION
NAME DATE	ILLINOIS DEI ANTIMEN	II OF TRANSFORTATION
	BILL OF	MATERIALS;
	POLE H	ANDHOLE
	- <del>-</del>	RING
	SCALE: VERT. NONE	DRAWN BY CNH

SCALE: VERT. NONE HORIZ.

DRAWN BY CNH CHECKED BY