# ENGINEER: PHONE: ( © PROJECT

**INDEX OF SHEETS:** 

- 1. COVER SHEET
- 2. COMMITMENTS & GENERAL NOTES
- 3. SUMMARY & SCHEDULE OF QUANTITIES
- 4. GENERAL LAYOUT
- 5. GENERAL PLAN AND ELEVATION

678. PROPOSED TRAFFIC CONTROL

- 8. CROSS SECTIONS
- 9. REMOVAL AND REPLACEMENT


STANDARDS:

420001-07 609001-04 701601-06

> 701001-02 701901-01

606001-04 701006-03

606301-04 701201-03

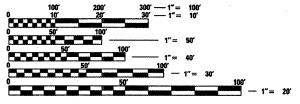

ENGINEERING SCALES, REDUCED SIZED PLANS WILL NOT CONFORM TO STANDARD SCALES. IN MAKING MEASUREMENTS

JOINT UTILITY LOCATION INFORMATION FOR EXCAVATION 1-800-892-0123

PROJECT ENGINEER- JIM MILLER PROJECT MANAGER- MAUREEN ADDIS


CONTRACT NO. 68729 CAT. NO. 033543-00D

REVISED 6-2-09

STATE OF ILLINOIS **DEPARTMENT OF TRANSPORTATION DIVISION OF HIGHWAYS** 


## **PROPOSED** HIGHWAY PLANS

FAI 39 (1-39) SECTION (62-2HB-2)I **BRIDGE DECK WATERPROOFING** MARSHALL COUNTY PROJECT IM-039-1(027) 035

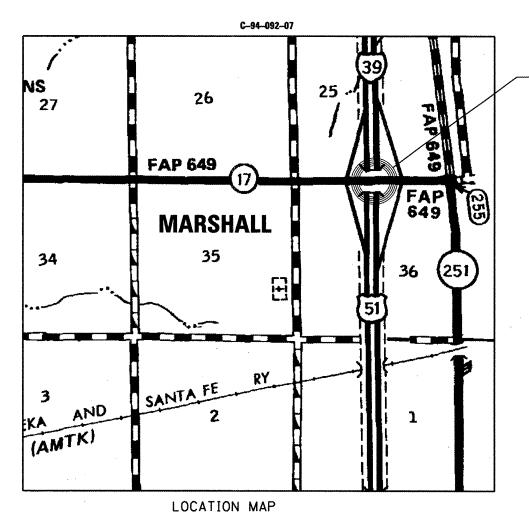

PROJECT CONSISTS OF REMOVAL & REPLACEMENT OF BRIDGE APPROACH SHOULDERS & MEDIAN AND CONCRETE SEALER APPLICATION ON STRUCTURE (SN.062-0050), CARRYING IL.17 OVER I-39

LOCATION OF SECTION INDICATED THUS: -

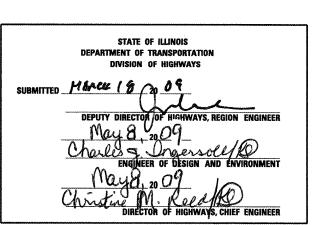

(62-2HB-2)I

D-94-061-07

PRINTED BY THE AUTHORITY OF THE STATE OF ILLINOIS

SN.062-0050

## SCHEDULE OF QUANTITIES

#### MOBILIZATION

LSUM
<u> </u>

#### TRAFFIC CONTROL

LOCATION T,C,&P. SPECIAL (LSUM)		T.C.SURVEILLANCE (CAL DA)		
DECK & APPR.	I	1		

#### CONCRETE MEDIAN REMOVAL

LOCATION	SOFT
MEDIAN	1620

#### BRIDGE APPROACH SHOULDER REMOVAL

LOCATION	SayD
APPR. SHLDRS.	53

#### REINFORCEMENT BARS, EPOXY COATED

LOCATION	LB
APPR. SHLDRS.&MED.	2094
DECK MEDIAN	3840
TOTAL	593 <del>4</del>

#### TIE BARS

LOCATION	EA
LONGI. SHLDR. JTS.	112

#### CONCRETE SUPERSTRUCTURE

LOCATION	CUYD
MEDIAN	30

#### PRISMATIC CURB REFLECTORS

LOCATION	EA
MEDIAN	32

#### PCC BRIDGE APPROACH SHOULDER PAVEMENT

LOCATION	SQYD
APPR. SHLDRS.	53

#### WORKZONE PAVEMENT MARKING REMOVAL

SOFT
537

#### SILANE SURFACE SEALER

LOCATION	SOYD
BRIDGE SURFACES	2200

### CLIN AN ANDY OF OLIANITE TEC 90% FED. SAFETY 2A

SUM	MARY OF QUANTITIES	10% ST MARSI	HALL COU	FETY-2A NTY
CODE NO.	ITEM	UNIT	RURAL	TOTAL
50300255	CONCRETE SUPERSTRUCTURE	CUYD	44.8	44.8
50800205	REINFORCEMENT BARS, EPOXY COATED	POUND	3910	3910
67100100	MOBILIZATION	LSUM	1	1
70101800	TRAFFIC CONTROL AND PROTECTION, (SPECIAL)	LSUM	1	1
70103815	TRAFFIC CONTROL SURVEILLANCE	CAL DA	15	15
70301000	WORKZONE PAVEMENT MARKING REMOVAL	SQFT	537	537
78200300	PRISMATIC CURB REFLECTOR	EACH	32	32
X0300136	BRIDGE APPROACH SHOULDER REMOVAL	SQYD	53_	53
70300520	PAVEMENT MARKING TARE, TYPE III 4"	FOOT	2,000_	2,000
50102400	CONCRETE REMOVAL	cu yd	30	30
Z0075300	TIE BARS	EACH	44	44
X0326443	SILANE SURFACE SEALER	SOYD	2200	2200
			:	
			<del> </del>	

SN.062-0050 IL.17 over I-39 AREVISED 6-2-09

SN.062-0050 IL.17 over I-39

REVISED - \_\_\_ FILE NAME = DESIGNED - CEJ REVISED - \_\_\_ 5-13 TOOR I - 13-0000 - 19-0000 - 19-0000 - 19-0000 DRAWN - CEJ PLOT SCALE = 104.4291 ' / IN. CHECKED REVISED -


STATE OF ILLINOIS **DEPARTMENT OF TRANSPORTATION** 


**SUMMARY OF QUANTITIES** SCALE: \_\_\_\_\_ SHEET NO. \_ OF \_\_ SHEETS STA. \_\_\_\_ TO STA. \_\_\_\_

COUNTY TOTAL SHEETS NO.

MARSHALL 9 3

CONTRACT NO. 68729 (62-2HB-2)[ SILOXANE SEALER APPLICATION

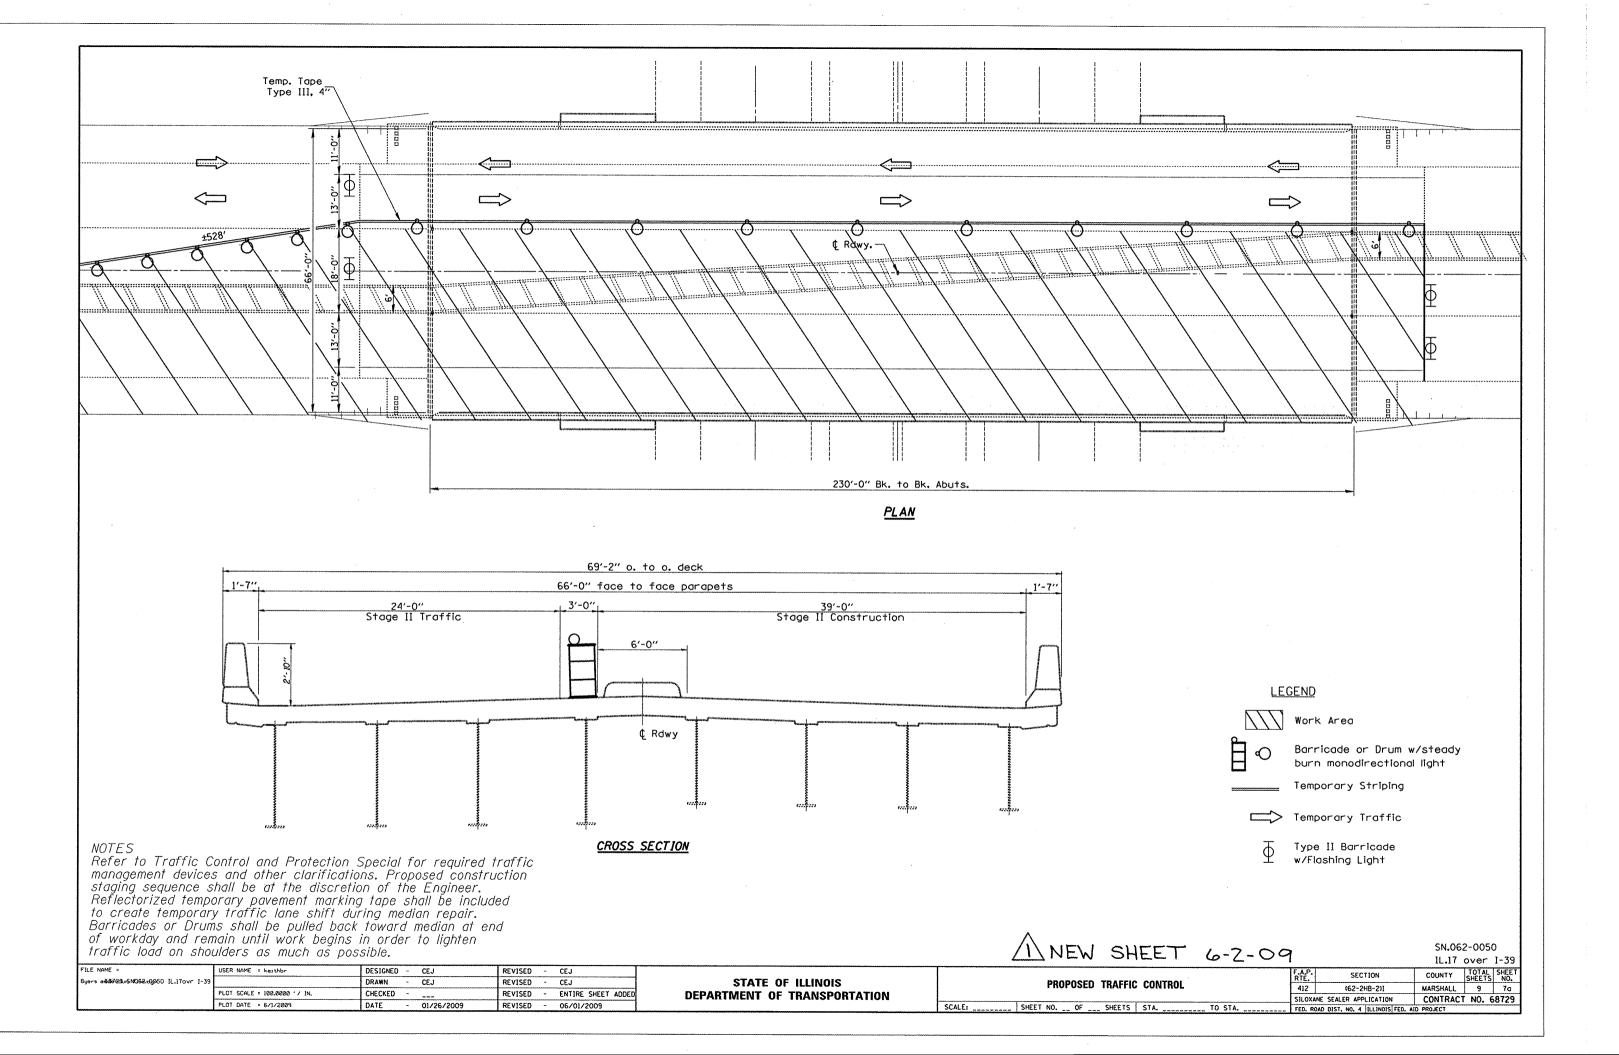

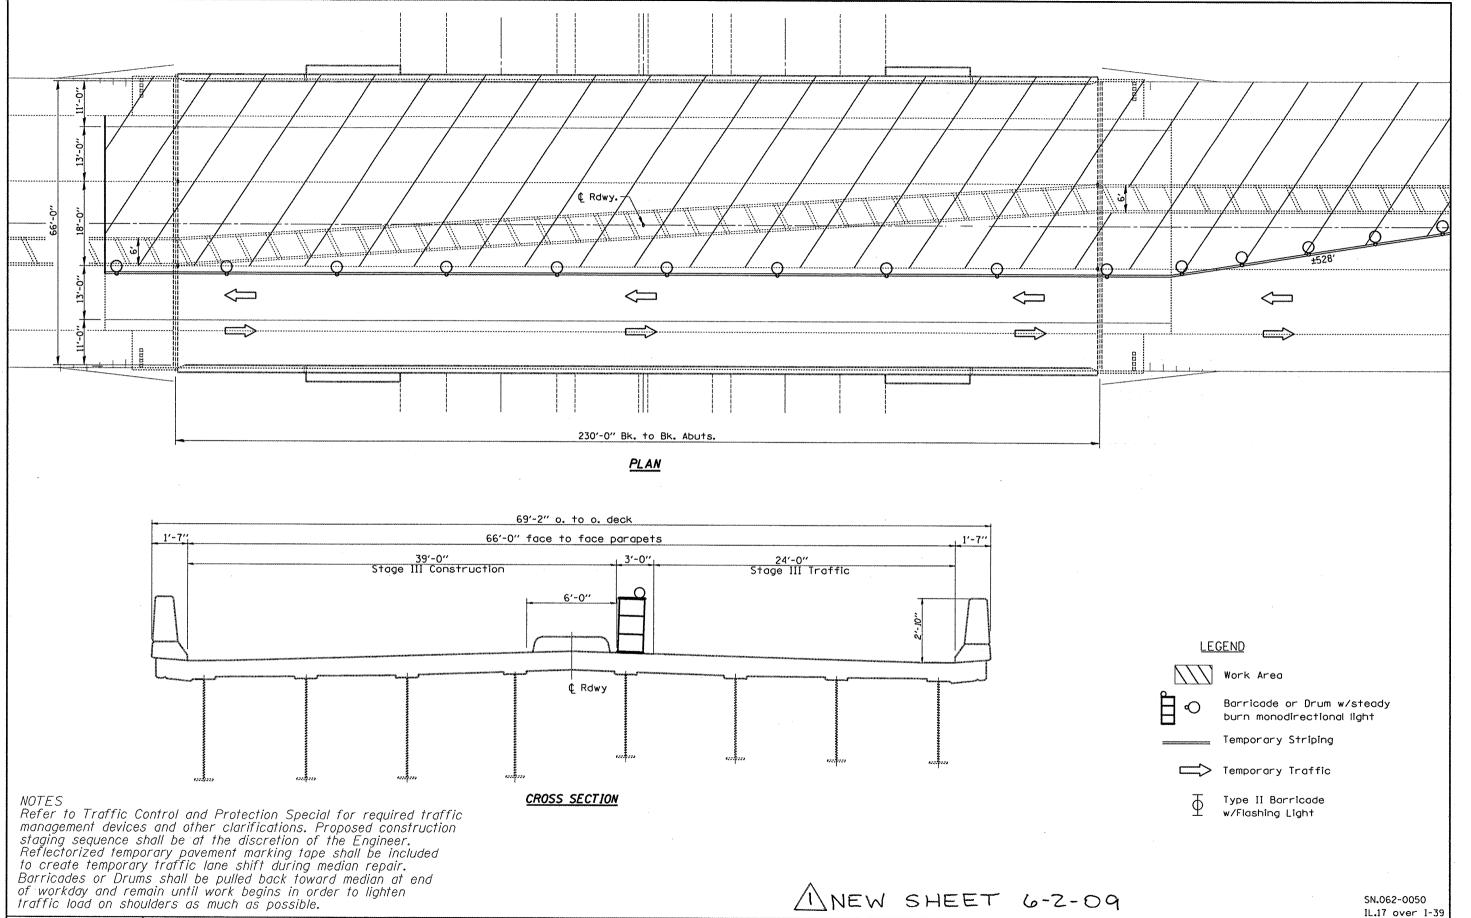

USER NAME = keithbr DESIGNED - CEJ COUNTY TOTAL SHEET NO.

MARSHALL 9 76 REVISED - CEJ SECTION Byers #**666729**0/6**NO62-005**0gn]L.17ovr 1-3 DRAWN - CEJ REVISED - CEJ STATE OF ILLINOIS PROPOSED TRAFFIC CONTROL (62-2HB-2)I PLOT SCALE = 100.0000 '/ IN. CHECKED -REVISED -**DEPARTMENT OF TRANSPORTATION** DATE - 01/26/2009 REVISED - \_\_\_\_ REVISED - 06/01/2009 SILOXANE SEALER APPLICATION CONTRACT NO. 68729 PLOT DATE = 6/1/2009 SHEET NO. \_\_ OF \_\_ SHEETS STA. \_\_\_ FED. ROAD DIST. NO. 4 | ILLINOIS FED. AID PROJECT