
STATE OF ILLINOIS **DEPARTMENT OF TRANSPORTATION DIVISION OF HIGHWAYS** 

# **PROPOSED** HIGHWAY PLANS

FAI 94 I-90/94 (DAN RYAN EXPRESSWAY)

AT 63rd STREET (FAU 1519) SECTION 1920-B PROJECT: ACNHPP-0005 (990) **BRIDGE SUPERSTRUCTURE REPLACEMENT** SN 016-1149 **COOK COUNTY** 

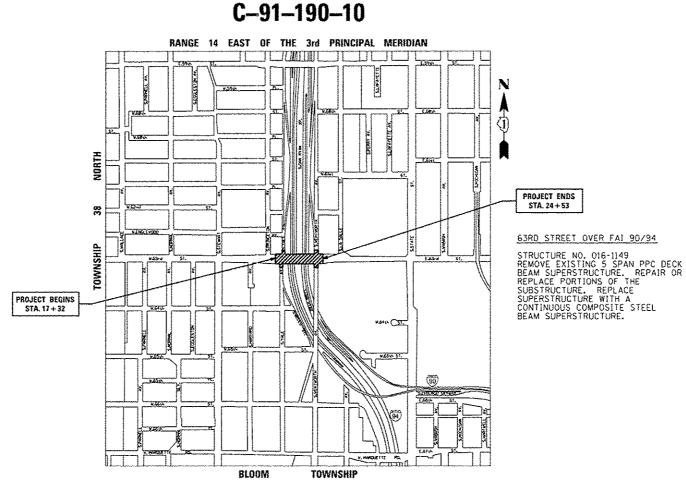

COOK 142 1 094 1920-8 ILLINOIS CONTRACT NO. 60J15 ¥142 41 = 143 143 41= 144 D-91-190-10



PROFESSIONAL ENGINEER 11-30-2015

STATE OF ILLINOIS DEPARTMENT OF TRANSPORTATION SUBMITTED MAT CA 36 DEPUTY DIRECTOR OF HIGHWAYS, REGION ENGINEER

PRINTED BY THE AUTHORITY OF THE STATE OF ILLINOIS

1 Rev. 6-4-14

FOR INDEX OF SHEETS, SEE SHEET NO. 2

TRAFFIC DATA

0

0

63RD STREET: EXISTING ADT =10,600 (2011) SPEED LIMIT = 30 MPH DESIGN SPEED = 30 MPH

THE IMPROVEMENT IS LOCATED WITHIN THE CITY OF CHICAGO

FULL SIZE PLANS HAVE BEEN PREPARED USING STANDARD ENGINEERING SCALES, REDUCED SIZED PLANS WILL NOT CONFORM TO STANDARD SCALES, IN MAKING MEASUREMENTS

C.U.A.N. CHICAGO UTILITY ALERT NETWORK 1-312-744-7000 J.U.L.I.E. JOINT UTILITY LOCATION INFORMATION FOR EXCAVATION 1-800-892-0123 OR 811

PROJECT ENGINEER: CRAIG BAUER 847-705-4265 PROJECT MANAGER: LONG TRAN 847-705-4232

CONTRACT NO. 60J15

ON REDUCED PLANS, THE ABOVE SCALES MAY BE USED.

GROSS LENGTH = 721 FT. = 0.14 MILE NET LENGTH = 721 FT. = 0.14 MILE

8501 W. Higgins Road: Suite 280 Chicago, Illinois 60631

#### INDEX OF SHEETS

	SHEET NO.	DESCRIPTION
	1	COVER SHEET
	2	INDEX OF SHEETS & HIGHWAY STANDARDS
	3-4	GENERAL NOTES
	5-12	SUMMARY OF QUANTITIES
	13-14	TYPICAL SECTIONS
	15	ALIGNMENT, TIES & BENCHMARKS
	16	PLAN & PROFILE
	17-24	SUGGESTED MAINTENANCE OF TRAFFIC AND DETOUR ROUTE
	25-26	DRAINAGE & UTILITIES
	27	DRAINAGE & BARRIER WALL DETAILS
	28-30	SIGNAGE & PAVEMENT MARKING
	31	SIGN DETAIL
	32	TEMPORARY TRAFFIC SIGNAL PLAN 63rd STREET & YALE AVENUE
	33	TEMPORARY CABLE PLAN 63rd STREET & YALE AVENUE
	34	TEMPORARY TRAFFIC SIGNAL PLAN 63rd STREET & WENTWORTH AVENUE
	35	TEMPORARY CABLE PLAN 63rd STREET & WENTWORTH AVENUE
	36-37	TRAFFIC CONTROL SIGNALS
	38	INTERCONNECT
	39	INTERCONNECT CONTROLLER TERMINATION SCHEMATIC
	40-51	TRAFFIC SIGNAL DETAILS
	52	LIGHTING GENERAL NOTES, ABBREVIATIONS, INDEX OF DRAWINGS & SCHEDULE OF QUANTITIES
	53	PROPOSED UNDERPASS LIGHTING
	54	EXISTING UNDERPASS LIGHTING REMOVAL & TEMPORARY LIGHTING PLAN
	55	CONDUIT TRANSITION DETAILS
	56	CONDUIT MOUNTING DETAILS ALONG BRIDGE
	57	IDOT DISTRICT ONE STANDARD LIGHTING DETAIL
	58	ELECTRICAL GENERAL NOTES
	59	COOT STANDARD DETAIL DWG. 826
	60	UNDERGROUND CONDUIT FACILITIES
	61	STREET LIGHTING REMOVAL & INSTALLATION
	62~64	CDOT STANDARO DETAILS
	65-122	STRUCTURAL PLANS
	123	RESTORATION
	124	PAVEMENT ELEVATIONS
	125-128	
	129	DETAIL OF STORM SEWER CONNECTION TO EXISTING SEWER (BD07)
	130	FREEWAY ENTRANCE AND EXIT RAMP CLOSURE DETAILS (TCOB)
	131	TRAFFIC CONTROL DETAILS FOR FREEWAY SINGLE & MULTI-LANE WEAVE (TCO9)
	132	TRAFFIC CONTROL AND PROTECTION FOR SIDE ROADS, INTERSECTIONS, AND DRIVEWAYS (TC10)
	133-134	
	135	DISTRICT ONE TYPICAL PAVEMENT MARKINGS (TC13)
	136	TRAFFIC CONTROL AND PROTECTION AT TURN BAYS (TO REMAIN OPEN TO TRAFFIC) (TC14)
	137	PAVEMENT MARKING LETTERS AND SYMBOLS FOR TRAFFIC STAGING (TC16) TRAFFIC CONTROL DETAILS FOR HIGHWAY SHOULDER CLOSURES AND PARTIAL RAMP CLOSURES (TC17)
	138	
Ĺ	138A 138B	DETOUR SIGNING FOR CLOSING STATE HIGHWAYS (TC21)  FREEWAY/EXPRESSWAY SIGNING FOR FLAGGING OPERATIONS AT WORK ZONE OPENINGS FOR FREEWAYS/EXPRESSWAYS (TC18)
	139	ARTERIAL ROAD INFORMATION SIGN (TC22)

## **HIGHWAY STANDARDS**

STD.	NO.	TITLE

000001-06 STANDARD SYMBOLS, ABBREVIATIONS AND PATTERNS

280001-07 TEMPORARY EROSION CONTROL SYSYTEMS

420001-07 PAVEMENT JOINTS

420111-03 PCC PAVEMENT ROUNDOUTS

420401-09 BRIDGE APPORACH PAVEMENT CONNECTOR

420701-02 PAVEMENT FABRIC

515001-03 NAME PLATE FOR BRIDGES

642001-02 SHOULDER RUMBLE STRIPS, 16 IN.

701400-05 APPROACH TO LANE CLOSURE, FREEWAY/EXPRESSWAY

701401-07 LANE CLOSURE, FREEWAY/EXPRESSWAY

701411-08 LANE CLOSURE, MULTILANE, AT ENTRANCE OR EXIT RAMP, FOR SPEEDS >= 45 MPH

701427-01 URBAN LANE CLOSURE, MULTILANE, INTERMITTENT OR MOVING OPER., FOR SPEEDS <= 40 MPH

701428 TRAFFIC CONTROL SETUP AND REMOVAL FREEWAY/EXPRESSWAY 701446-04 TWO LANE CLOSURE, FREEWAY/EXPRESSWAY

701601-07 URBAN LANE CLOSURE, MULTILANE, 1W OR 2W WITH NONTRAVERSABLE MEDIAN

701602-05 URBAN LANE CLOSURE, MULTILANE, 2W WITH BIDIRECTIONAL LEFT TURN LANE

701606-08 URBAN LANE CLOSURE, MULTILANE, 2W WITH MOUNTABLE MEDIAN

701701-08 URBAN LANE CLOSURE, MULTILANE INTERSECTION

701801-05 SIDEWALK, CORNER OR CROSSWALK CLOSURE

701901-02 TRAFFIC CONTROL DEVICES

704001-07 TEMPORARY CONCRETE BARRIER

720001-01 SIGN PANEL MOUNTING DETAILS

720006-03 SIGN PANEL ERECTION DETAILS

728001-01 TELESCOPING STEEL SIGN SUPPORT

729001-01 APPLICATIONS OF TYPES A & B METAL POSTS (FOR SIGNS & MARKERS)

857001-01 STANDARD PHASE DESIGNATION DIAGRAMS AND PHASE SEQUENCES

REVISED -1 5/23/2014 GRAEF DESIGNED - JSO USER NAME : 0766 REVISED -DRAWN - HJM REVISED -CHECKED - TNS PLOT SCALE = 100.0000 1/ 10-DATE - 03-15-2013 REVISED -PLOT DATE + 5/23/2014

140-142 CITY OF CHICAGO TYPICAL PAVEMENT MARKINGS (TC24)

STATE OF ILLINOIS DEPARTMENT OF TRANSPORTATION

SECTION 63rd STREET BRIDGE REPLACEMENT - COOK COUNTY COOK 142 2 CONTRACT NO. 60J15 1920-8 INDEX OF SHEETS AND HIGHWAY STANDARDS SCALE: 1":50" SHEET I OF I SHEETS STA.

TOTAL SHEE SHEETS NO.

COUNTY

GRØEF CHCODO, MINOSE 60531

#### GENERAL NOTES

- 1. BEFORE STARTING ANY EXCAVATION, THE CONTRACTOR AND ALL OTHER PARTIES INVOLVED IN THE CONSTRUCTION OPERATIONS WITHIN THE PROJECT LIMITS SHALL CALL CUAN (CHICAGO UTILITY ALERT NETWORK) AT (312) 744-7000 FOR FIELD LOCATIONS OF BURIED ELECTRIC, TELEPHONE, GAS AND OTHER EXISTING FACILITIES. (72 HOUR NOTIFICATION IS REQUIRED). THE CONTRACTOR SHALL COOPERATE WITH ALL UTILITY OWNERS AS PROVIDED FOR IN THE STANDARD SPECIFICATIONS.
- 2. 10 FOOT TRANSITIONS SHALL BE USED TO MATCH THE PROPOSED CURB & GUTTER TO THE EXISTING, UNLESS OTHERWISE SHOWN, THE TRANSITIONS SHALL BE PAID FOR AT THE CONTRACT UNIT PRICE FOR THE PROPOSED ITEMS OF WORK SPECIFIED.
- 3. THE CONTRACTOR SHALL COORDINATE CONSTRUCTION ACTIVITIES WITH UTILITY COMPANIES AND THE CITY OF CHICAGO.
- 4. ALL ELEVATIONS REFER TO THE NORTH AMERICAN VERTICAL OF DATUM OF 1988 (NAVD 88).
- 5. THE CONTRACTOR WILL NOT BE ALLOWED TO SET UP A YARD OR FIELD OFFICE ON STATE PROPOERTY WITHOUT WRITTEN PERMISSION FROM THE DEPARTMENT.
- 6. THE CONTRACTOR SHALL CONTACT THE TRAFFIC CONTROL SUPERVISOR AT (847) 705-4470 A MINIMUM OF 72 HOURS PRIOR TO BEGINNING WORK.
- 7. THE RESIDENT ENGINEER SHALL CONTACT THE AREA TRAFFIC FIELD ENGINEER AT (847) 705-4153 AT LEAST TWO (2) WEEKS PRIOR TO THE PLACEMENT OF PERMANENT PAVEMENT MARKINGS, AND SHALL CONTACT THE IDOT EXPRESSWAY TRAFFIC CONTROL SUPERVISOR AT (847) 705-4155 72 HOURS PRIOR TO THE PLACEMENT OF ANY TEMPORARY TRAFFIC CONTROL DEVICES WITH 100T JURISDICTION.
- 8. ALL 63RD ST., WELLS ST., YALE AV. AND WENTWORTH AV. PAVEMENT MARKINGS SHALL BE PLACED THROUGHOUT THE PROJECT ACCORDING TO CITY OF CHICAGO TYPICAL PAVEMENT MARKINGS AND SHALL MATCH EXISTING PAVEMENT MARKINGS AT PROJECT LIMITS. 190/194 PAVEMENT MARKINGS SHALL CONFORM TO 100T DISTRICT ONE STANDARDS AND SHALL MATCH THE EXISTING MARKINGS AND LOCATIONS DISTURBED DURING CONSTRUCTION.
- 9. WHEN ARTIFICIAL LIGHTING IS USED IN NIGHT OPERATIONS THE CONTRACTOR SHALL EXERCISE THE UTMOST PRECAUTIONS IN PREVENTING ADVERSE VISIBILITY TO THE MOTORING PUBLIC AND ADJOINING RESIDENTIAL AREAS.
- 10, DURING CONSTRUCTION, AGGREGATE FOR TEMPORARY ACCESS WILL ALSO BE USED TO PROVIDE TEMPORARY RAMPS AT INTERSECTIONS, BUILDING ENTRANCES, AND AS DETERMINED BY THE ENGINEER FOR PEDESTRIAN MOVEMENT.
- 11. TEMPORARY PAVEMENT MARKING (PAINT) SHALL BE REQUIRED ON ALL TEMPORARY PAYEMENT SURFACES OVER THE WINTER MONTHS EXCEPT ON THE DAN RYAN EXPRESSWAY. PAINT USED OVER THE WINTER MONTHS IN THE TRANSITION AREAS ON EXISTING SURFACES SHALL BE REMOVED BY GRINDING WHEN THE FINAL PAVEMENT MARKINGS ARE INSTALLED. ON EXPRESSWAYS, EPOXY MARKINGS SHALL BE REQUIRED ON ALL TEMPORARY PAVEMENT SURFACES OVER THE WINTER MONTHS. EPOXY USED OVER THE WINTER IN TRANSITION AREAS AT THE LIMITS OF CONSTRUCTION ON EXISTING SURFACES SHALL BE REMOVED BY GRINDING WHEN FINAL PAVEMENT MARKINGS ARE INSTALLED.
- 12. ABANDONED UNDERGROUND UTILITIES THAT CONFLICT WITH CONSTRUCTION SHALL BE DISPOSED OF OUTSIDE OF THE LIMITS OF THE RIGHT OF WAY ACCORDING TO ARTICLE 202.03 OF THE STANDARD SPECIFICATIONS AND AS DIRECTED BY THE ENGINEER. THIS WORK WILL NOT BE PAID FOR SEPARATELY, BUT SHALL BE INCLUDED IN THE COST OF EARTH EXCAVATION.
- 13. ANY REFERENCE TO A STANDARD IN THESE PLANS SHALL BE INTERPRETED TO MEAN THE EDITION AS INDICATED BY THE SUBNUMBER AS SHOWN ON THE LIST OF STANDARDS OR THE COPY INCLUDED IN THESE PLANS.
- 14. ALL DAMAGE TO DEPARTMENT OWNED UNDERGROUND FACILITIES CAUSED BY THE CONTRACTOR SHALL BE REPAIRED TO THE SATISFACTION OF THE DEPARTMENT AT THE CONTRACTOR'S EXPENSE, THIS SHALL INCLUDE ALL TEMPORARY REPAIRS REQUIRED TO KEEP THE FACILITY OPERATIONAL WHILE MATERIAL IS BEING OBTAINED TO MAKE PERMANENT REPAIRS. SPLICING OF ELECTRICAL CALBE SHALL NOT BE ALLOWED. ELECTRICAL CALBE SHALL BE REPLACED FROM POLE TO POLE OR CONTROLLER.
- 15. THE WORK REQUIRED TO CONNECT ANY SEWER TO AN EXISTING DRAINAGE STRUCTURE OR PIPE WILL NOT BE PAID FOR SEPARATELY, BUT SHALL BE CONSIDERED AS INCLUDED IN THE CONTRACT UNIT PRICE BID FOR THE SEWER ITEMS.
- 16, THE CONTRACTOR SHALL BE REQUIRED TO PROVIDE ACCESS TO ABUTTING PROPERTY AT ALL TIMES DURING THE CONSTRUCTION OF THIS PROJECT.
- 17. FOR WORK OUTSIDE THE LIMITS OF THE BRIDGE APPROACH SLAB, ALL REFERENCES IN THE HIGHWAY STANDARDS AND STANDARD SPECIFICATIONS FOR REINFORCEMENT. DOWEL BARS AND TIE BARS IN PAVEMENT, SHOULDERS, CURB, GUTTER, COMBINATION CURB AND GUTTER, MEDIAN AND CHAIR SUPPORTS FOR CRC PAVEMENT SHALL BE EPOXY COATED, UNLESS NOTED ON THE PLANS.

18, WHEN TEMPORARY CONCRETE BARRIER WALL IS USED ON THE CONTRACT, A 3.5 FOOT CLEAR DEFLECTION ZONE SHALL BE PROVIDED FOR FROM THE BACK OF THE BARRIER WALL TO ANY OBSTRUCTION OR DROP OFF. IF THIS 3.5 FOOT CLEAR ZONE CANNOT BE MAINTAINED, THE TEMPORARY CONCRETE BARRIER WALL SHALL BE ANCHORED TO THE PAVEMENT THRU THE 3 ANCHORING HOLES ON THE TRAFFIC SIDE OF THE WALL. PAYMENT FOR THE ANCHORING SHALL NOT BE PAID FOR SEPARATELY, BUT SHALL BE INCLUDED IN THE COST OF THE TEMPORARY CONCRETE BARRIER WALL PAY ITEMS.

#### GENERAL NOTES - CITY OF CHICAGO

- 1. ANY REFERENCE TO "STANDARD SPECIFICATIONS" THROUGHOUT THE PLANS OR SPECIAL PROVISIONS SHALL BE INTERPRETED TO BE THE ILLINOIS DEPARTMENT OF TRANSPORTATION (100T) STANDARD SPECIFICATIONS FOR ROAD AND BRIDGE CONSTRUCTION (SSRBC) AND THE IDOT SUPPLEMENTAL SPECIFICATIONS, ADOPTED JANUARY 1, 2012 (OR LATEST EDITION).
- 2. ALL ADA RAMP CONSTRUCTION SHALL BE IN ACCORDANCE WITH THE LATEST VERSION OF THE "CHICAGO DEPARTMENT OF TRANSPORTATION ADA CONSTRUCTION STANDARDS" AVAILABLE ON THE CITY'S INTERNET WEBSITE.
- 3. ALL DIMENSIONS SHOWN ON THE PLANS ARE TO THE EDGE OF PAVEMENT, UNLESS OTHERWISE NOTED.
- 4. THE INFORMATION SHOWN ON THIS PLAN SET CONCERNING THE TYPE AND LOCATION OF PRIVATE AND PUBLIC UNDERGROUND UTILITIES IS NOT GUARANTEED TO BE ACCURATE OR ALL-INCLUSIVE. THE CONTRACTOR IS RESPONSIBLE FOR MAKING HIS OWN INVESTIGATION TO DETERMINE THE EXISTENCE, NATURE AND EXACT LOCATION OF ALL UNDERGROUND UTILITIES AND APPURTENANCES WITHIN THE LIMITS OF THE IMPROVEMENT, THE COST OF THIS WORK SHALL BE CONSIDERED INCIDENTAL TO THE CONTRACT.
- THE CONTRACTOR MUST PROTECT EXISTING AND NEW UTILITIES WHEN CONSIDERED NECESSARY BY THE COMMISSIONER, BY METHODS APPROVED BY THE COMMISSIONER, AND HE MUST BRACE AND SUPPORT THE UTILITIES PROPERLY TO PREVENT SETTLEMENT, DISPLACEMENT OR CHANGE TO THE UTILITIES. THE PROTECTION OF THE UTILITIES AS SPECIFIED HEREIN WILL NOT BE PAID FOR SEPARATELY, BUT THE COST THEREOF SHALL BE CONSIDERED INCIDENTAL TO THE CONTRACT.
- 6. THE CONTRACTOR SHALL BE RESPONSIBLE FOR THE PROTECTION OF ALL UNDERGROUND UTILITIES AND THEIR APPURTENANCES EVEN THOUGH THEY MAY NOT BE SHOWN ON THE PLANS, ANY UTILITY THAT IS DAMAGED DURING THE CONSTRUCTION SHALL BE REPAIRED OR REPLACED AT THE CONTRACTOR'S EXPENSE. ONLY PERSONNEL AUTHORIZED BY THE COMMISSIONER SHALL PERFORM THIS WORK.
- 7. THE CONTRACTOR SHALL MAINTAIN THE SURFACE DRAINAGE OF THE ROAD DURING CONSTRUCTION OF THIS PROJECT.
- 8. AGGREGATE FURNISHED AND PLACED UNDER THE ITEM AGGREGATE FOR TEMPORARY ACCESS SHALL, AS FAR AS POSSIBLE, BE RE-USED AT LOCATIONS AS DIRECTED BY
- 9. UTILITY ADJUSTMENT AND RELOCATION SHALL BE THE RESPONSIBILITY OF THE OWNERS EXCEPT AS NOTED ON THE PLANS, GENERAL NOTES OR SPECIFICATIONS.
- 10. SAWING OF EXISTING CONCRETE DRIVEWAY, ALLEY PAVEMENT, CURB. CURB & GUTTER OR SIDEWALKS WHEN REQUIRED FOR REMOVAL OR CONSTRUCTION WILL NOT BE PAID FOR SEPARATELY, BUT SHALL BE CONSIDERED INCIDENTAL TO THE VARIOUS PAY ITEMS FOR THE REMOVAL OF SUCH CONSTRUCTION.
- 1. ANY DEWATERING AND/OR SHEETING AND SHORING AND/OR OTHER APPROVED CONSTRUCTION METHODS REQUIRED TO INSTALL SEWER BID ITEMS AS PLANNED AND UNDER THE CONDITIONS NECESSARY TO DO THIS WORK AS SPECIFIED, WILL NOT BE PAID FOR SEPARATELY BUT SHALL BE CONSIDERED INCIDENTAL TO THE UNIT PRICE OF THE ITEM TO BE CONSTRUCTED.
- 12. WHEN SAND IS THE EXCESS MATERIAL EXCAVATED WITHIN THE LIMITS OF THIS IMPROVEMENT, IT SHALL BE USED FOR TRENCH BACKFILL WHEN SO DIRECTED BY THE COMMISSIONER. THE COST OF MOVING AND PLACING IT SHALL BE INCIDENTAL TO THE CONTRACT UNIT PRICE FOR THE VARIOUS SEWER ITEMS OF THE CONTRACT. THE CONTRACTOR SHALL IMMEDIATELY REMOVE MATERIAL REJECTED WHEN SO ORDERED BY THE COMMISSIONER.
- 13. THE CITY OF CHICAGO IS TO MAKE ADJUSTMENTS TO ITS OFFICE OF EMERGENCY MANAGEMENT & COMMUNICATION FACILITIES. THE CONTRACTOR SHALL COORDINATE HIS WORK AND COOPERATE WITH THE CITY OF CHICAGO IN THESE ADJUSTMENTS. THIS COORDINATION AND COOPERATION BY THE CONTRACTOR WILL NOT BE PAID FOR SEPERATELY BUT SHALL BE CONSIDERED INCLUDED IN THE COSTS OF THE CONTRACT.

- 14. ALL DRAINAGE STRUCTURES MUST BE KEPT OPERATIONAL FOR THE DURATION OF THE PROJECT. PROPOSED STRUCTURES WILL NOT BE APPROVED UNLESS THEY ARE CLEAN. PRIOR TO START OF CONSTRUCTION, AN INSPECTION OF EXISITNG MANHOLES. CATCH BASINS AND INLETS THAT ARE TO REMAIN WILL BE PERFORMED BY THE CITY AND CONTRACTOR, AT THAT TIME, THE CITY WILL DETERMINE WHICH STRUCTURES MUST BE CLEANED AS PER CONTRACT PAY ITEM(S). ANY AND ALL STRUCTURES REQUIRING CLEANING AT ANY OTHER TIME DUE TO CONSTRUCTION DEBRIS MUST BE CLEANED BY THE CONTRACTOR AND WILL BE CONSIDERED INCIDENTAL TO THE CONTRACT.
- 15. IF IT IS DETERMINED IN THE FIELD THAT ANY EXISTING CATCH BASIN OR MANHOLE TO BE ADJUSTED, AS SPECIFIED IN THE PLANS, IS IN POOR CONDITIONS AND REQUIRES RECONSTRUCTION, THE CONTRACTOR MUST THEN PERFORM THE RECONSTRUCTION IN ACCORDANCE WITH SECTION 602 OF THE STANDARD SPECIFICATIONS.
- 16. WITHIN THE LIMITS OF THE PROJECT, THERE MAY BE MANHOLES AND CATCH BASINS SHOWN ON THE DEPARTMENT OF WATER MANAGEMENT SEWER ATLASES THAT HAVE NOT BEEN LOCATED IN THE FIELD DUE TO THEIR BEING REMOVED, BURIED, ETC. IF DURING THE COURSE OF THE PROJECT, ANY SUCH STRUCTURE IS ENCOUNTERED DURING EXCAVATION, MANHOLES SHALL BE ADJUSTED, CATCH BASINS SHALL BE FILLED. AND THE OUTLET PIPE(S) SHALL BE PLUGGED. AN ESTIMATED QUANTITY HAS BEEN INCLUDED IN THE SUMMARY OF QUANTITIES.
- 17. PROPOSED P.C. CONCRETE BASE COURSE OR P.C. CONCRETE PAVEMENT SHALL NOT BE OPENED TO VEHICULAR OR CONSTRUCTION TRAFFIC UNTIL AFTER THE SPECIFIED CURING PERIOD AS DEFINED IN SECTION 1020.13 OF THE SSRBC AND UNTIL THE JOINTS HAVE BEEN SEALED.
- 18. THE TRENCH BACKFILL QUANTITY SHOWN IN THE PLANS HAS BEEN CALCULATED ACCORDING TO THE STATE OF ILLINOIS TRENCH BACKFILL TABLE AND ALSO AS SPECIFIED IN ARTICLES 208.03 AND 550.07 OF THE SSRBC. AS STATED IN ARTICLE 550.07 OF THE STANDARD SPECIFICATIONS, NO ALLOWANCE HAS BEEN MADE IN THIS VOLUME FOR SLOPED OR BENCHED WALLS. THE VOLUME OF TRENCH BACKFILL SHOWN IN THE PLANS WILL BE THE BASIS OF THE MAXIMUM PAYMENT TO THE CONTRACTOR, WHERE SAND EXCAVATED FROM THE SITE IS USED AS SPECIFIED HEREIN. THESE VOLUMES WILL BE REDUCED AS DETERMINED BY THE FIELD MEASUREMENTS AND VOLUME CALCULATIONS OF THE COMMISSIONER.
- 19. THE CONTRACTOR SHALL MAINTAIN ACCESS TO PRIVATE PROPERTIES DURING THE CONSTRUCTION OPERATIONS. ADJACENT BUSINESS PROPERTY OWNERS SHALL BE NOTIFIED 72 HOURS IN ADVANCE OF CONSTRUCTION OPERATIONS WHICH MAY AFFECT THEIR DAILY SCHEDULE. THE CONTRACTOR SHALL COORDINATE WORK THROUGH THE RESIDENT ENGINEER TO AVOID ANY UNDUE INCONVENIENCE TO LOCAL BUSINESSES.
- 20. THE CONTRACTOR MUST TAKE ALL NECESSARY SAFETY PRECAUTIONS TO PROTECT ABUTTING PROPERTY, UTILITIES, PARKING FACILITIES, BUS SHELTERS, PEDESTRIANS AND VEHICULAR TRAFFIC
- 21. ALL CATCH BASINS IN THE CITY OF CHICAGO MUST MEET THE DEPARTMENT OF WATER MANAGEMENT STANDARDS.
- 22. PERMITS FROM THE DEPARTMENT OF WATER MANAGEMENT ARE REQUIRED FOR ALL UNDERGROUND STORM OF SEWER STRUCTURES, THE D.W.M. PERMIT MUST BE OBTAINED BY A LICENSED SEWER DRAIN LAYER PRIOR TO THE START OF CONSTRUCTION. THE LICENSED SEWER CONTRACTOR SUBCONTRACTOR MUST SUBMIT TWO SETS OF PLANS APPROVED BY THE DEPARTMENT FOR THE ISSUE OF THE SEWER PERMIT TO SUITE 410, 333 SOUTH STATE STREET, CHICAGO, ILLINOIS 60604-3971. INSPECTION WILL BE PROVIDED BY THE DEPARTMENT, IN CASE OF DAMAGE TO THE CITY OF CHICAGO SEWERS, PRIVATE AND PUBLIC DRAINS, SEWER STRUCTURES AND/OR BENCH MONUMENTS, THE CONTRACTOR SHALL IMMEDIATELY CONTACT THE DEPARTMENT AT (312) 747-7852 OR (312) 747-7893.
- 23. BENCH MARK LOCATIONS SHALL BE THE RESPONSIBILITY OF THE CONTRACTOR WITHIN THE LIMITS OF THE IMPROVEMENT CAN BE OBTAINED FROM THE DEPARTMENT OF WATER MANAGEMENT AT SUITE 410, 333 SOUTH STATE STREET, CHICAGO, ILLINOIS 60604-3971. THE CONTRACTOR IS RESPONSIBLE FOR THE COST OF REPLACING ANY BENCH MONUMENT DAMAGED OR DESTROYED DURING CONSTRUCTION.
- 24. SIDEWALK ACCESSIBILITY RAMPS SHALL NOT BE CONSTRUCTED DIRECTLY OVER EXISTING OR PROPOSED DRAINAGE STRUCTURES.
- 25. ALL BROKEN, CRACKED, WORN OR OTHERWISE DAMAGED OR BICYCLE UNSAFE FRAMES AND GRATES OR LIDS ON SEWER STRUCTURES SHALL BE REPLACED WITH NEW DEPARTMENT OF WATER MANAGEMENT STANDARD FRAMES AND GRATES OR LIDS, OLD FRAMES AND GRATES OR LIDS SHALL BE DELIVERED TO THE DEPARTMENT OF WATER MANAGEMENT AT 39TH ST. AND ASHLAND AVENUE.
- 26. CITY OF CHICAGO WATER VALVE VAULTS AND SEWER STRUCTURES SHALL NOT BE CLOSED. COVERED OR OTHERWISE OBSTRUCTED DURING CONSTRUCTION WITHOUT WRITTEN PERMISSION FROM THE CITY OF CHICAGO DEPARTMENT OF WATER MANAGEMENT.
- 27. CURB AND GUTTER CONSTRUCTION SHALL PROVIDE A MINIMUM CURB HEIGHT OF 3 INCHES.
- 28, PAVEMENT REPLACEMENT AROUND FRAMES AND GRATES OR LIDS WHERE DRAINAGE, WATER MAIN OR ELECTRIC STRUCTURES ARE ADJUSTED OR RECONSTRUCTED. SHALL BE WITH CLASS SI CONCRETE.

GRØEF CHECOL 18 1991 1991 1991 1991 1991

USER NAME # 0766 DESIGNED - JSQ REVISED -1 5/23/2014 GRAEF DRAWN - HJM REVISED CHECKED - TNS REVISED . PLDT SCALE \* 100,0000 1/ 1/ PLOT DATE = 5/22/2014 DATE - 03-15-2013 REVISED

STATE OF ILLINOIS DEPARTMENT OF TRANSPORTATION

TOTAL SHEE SHEETS NO. SECTION COUNTY 63rd STREET BRIDGE REPLACEMENT - COOK COUNTY 142 3 94 1920-B COOK **GENERAL NOTES** CONTRACT NO. 60J15 SCALE: 1"=50" SHEET 1 OF 2 SHEETS STA.

- 31. THE EXPOSED SUBGRADE AND THE BOTTOM OF EXCAVATION SHOULD BE OBSERVED BY AN EXPERIENCED SOIL ENGINEER TO AID IN LOCATING ANY UNSUITABLE AREAS THAT MAY NEED IMPROVEMENT. MATERIALS IDENTIFIED AS UNSUITABLE BY THE COMMISSIONER SHALL BE REMOVED TO THE DEPTH SPECIFIED BY THE COMMISSIONER AND REPLACED.
- 32. THE CONTRACTOR SHALL CHECK THE ELEVATIONS AT THE PROPERTY LINE BEFORE SETTING THE TOP OF CURB ELEVATIONS AND IF NECESSARY, SHALL ADJUST THE TOP OF CURB AND/OR GUTTER ELEVATION TO MEET ADJACENT PROPERTY LINE ELEVATIONS TO THE SATISFACTION OF THE COMMISSIONER, AT NO COST TO THE CITY.
- 33. EXISTING PARKWAYS ABUTTING CURB ARE TO BE EXCAVATED ONE FOOT (1') BACK OF THE CURB AND MUST BE TOPSOILED AND/OR RE-SODDED TO MEET THE PROPOSED TOP OF CURB GRADE. TOPSOIL AND SODDING WILL BE PLACED IN PARKWAYS BEHIND THE CURB AND GUTTER AS DIRECTED BY THE COMMISSIONER.
- 34. THE CONTRACTOR SHALL TAKE ALL NECESSARY PRECAUTIONS TO PROTECT THE EXISTING FENCES AND GUARDRAILS DURING EXCAVATION AND ANY DAMAGE TO THE FENCES OR GUARDRAILS WILL BE THE RESPONSIBILITY OF THE CONTRACTOR. THE CONTRACTOR MUST REPLACE THE DAMAGED FENCE OR GUARDRAIL AT HIS EXPENSE AND NO ADDITIONAL COMPENSATION WILL BE ALLOWED.
- 35. NO EXCAVATION WILL BE PERMITTED MORE THAN ONE FOOT (1) FROM THE BACK OF PROPOSED CURB AND GUTTER WHERE TREES ARE TO REMAIN. HAND EXCAVATION MUST BE PERFORMED IF ROOTS ARE PRESENT, ALL WORK REQUIRED TO PRESERVE TREE ROOTS WILL BE CONSIDERED INCIDENTAL TO ALL REMOVAL ITEMS.
- 36. ALL TEMPORARY, REGULATORY, WARNING AND GUIDE SIGNS WITHIN THE PROPOSED IMPROVEMENT MUST BE RELOCATED BY THE CONTRACTOR AS DIRECTED BY THE COMMISSIONER, AT NO COST TO THE CITY.
- 37. THE CONTRACTOR IS ADVISED THAT CERTAIN CONSTRUCTION OPERATIONS WILL REQUIRE COORDINATION WITH AGENCIES OF THE CITY OF CHICAGO SCHEDULED TO PERFORM WORK WITHIN THE CITY LIMITS OF THE PROJECT CONCURRENTLY WITH THE CONTRACTOR. THE CONTRACTOR SHALL COOPERATE TO THE FULLEST EXTENT WITH THESE AGENCIES WITH COMPLIANCE APPLICABLE TO PORTIONS OF ARTICLE 105.01 OF THE SSRBC.
- 38. IT IS CALLED TO THE CONTRACTOR'S ATTENTION THAT HE MAY BE REQUIRED TO PAY INSPECTION FEES TO THE VARIOUS DEPARTMENTS OF THE CITY OF CHICAGO.
- 39. THE CONTRACTOR MUST OBTAIN NECESSARY PERMITS FROM THE CITY OF CHICAGO PRIOR TO COMMENCING CONSTRUCTION.
- 40. AS-BUILT PLANS MUST BE SUBMITTED SOON AFTER WORK COMPLETION. FINAL PAYMENT SHALL NOT BE MADE TO THE CONTRACTOR UNTIL THE COMMISSIONERS OF THE DEPARTMENT OF TRANSPORTATION AND DEPARTMENT OF WATER MANAGEMENT ACKNOWLEDGE RECEIPT OF AS-BUILTS.
- 41. THE CONTRACTOR SHALL USE EXTREME CARE IN PROSECUTING WORK OUTSIDE THE LIMIT OF RECONSTRUCTION AS SHOWN ON THE PLANS. SO AS NOT TO DAMAGE, DEFACE OR OTHERWISE DISTURB ADJACENT IMPROVED AREAS. ANY CORRECTIVE WORK DONE OUTSIDE THE LIMITS OF WORK THAT IS NECESSARY TO RESTORE ADJACENT AREAS TO EXISTING CONDITIONS WILL BE MADE AT THE EXPENSE OF THE CONTRACTOR.
- 42. ALL WORK IN THE PUBLIC WAY REQUIRES A PERMIT FROM THE CITY OF CHICAGO DEPARTMENT OF TRANSPORTATION, DIVISION OF INFRASTRUCTURE MANAGEMENT.
- 43. ONE HALF INCH (1/2") THICK EXPANSION JOINTS SHALL BE PLACED BETWEEN THE SIDEWALK AND ALL STRUCTURES SUCH AS LIGHT STANDARDS, TRAFFIC SIGNAL FOUNDATIONS AND MANHOLES WHICH EXTEND THROUGH THE SIDEWALK.

- 44. WHEN EXISTING DRAINAGE FACILITIES ARE DISTURBED, THE CONTRACTOR SHALL PROVIDE AND MAINTAIN TEMPORARY OUTLETS AND CONNECTIONS FOR ALL PRIVATE AND PUBLIC DRAINS, SEWERS OR CATCH BASINS, HE SHALL PROVIDE THE FACILITIES TO TAKE IN ALL STORM WATER WHICH SHALL BE RECEIVED BY THESE DRAINS AND SEWERS AND DISCHARGE THE SAME. HE SHALL PROVIDE AND MAINTAIN EFFICIENT PUMPING PLANT, IF NECESSARY, AND A TEMPORARY OUTLET AND BE PREPARED AT ALL TIMES TO DISPOSE OF THE WATER FROM TEMPORARY CONNECTIONS UNTIL SUCH TIME AS THE PERMANENT CONNECTIONS WITH THE SEWERS ARE BUILT AND IN SERVICE, ALL PUMPING SHALL ENTER A SETTLING BASIN SYSTEM, APPROVED BY THE COMMISSIONER, BEFORE PASSING INTO THE EXISTING DRAINAGE SYSTEM. THIS WORK SHALL NOT BE PAID FOR DIRECTLY BUT SHALL BE CONSIDERED INCIDENTAL TO THE CONTRACT.
- 45. FOR ANY EXCAVATION DEEPER THAN 12 FEET BELOW EXISTING GRADE, THE CONTRACTOR IS REQUIRED TO SUBMIT THE FOLLOWING FOR PRIOR REVIEW BY THE CITY OF CHICAGO DEPARTMENT OF TRANSPORTATION: (A) EARTH RETENTION SYSTEM DRAWING AND (B) CALCULATIONS SUPPORTING EARTH RETENTION SYSTEM DESIGN. THIS WORK AS SPECIFIED HEREIN WILL NOT BE PAID FOR SEPARATELY BUT MUST BE CONSIDERED INCIDENTAL TO THE CONTRACT UNIT PRICE FOR THE ITEMS TO BE CONSTRUCTED IN THE EXCAVATION.
- 46. THE CONTRACTOR MUST MAINTAIN THE NUMBER OF TRAFFIC LANES IN THE AREAS SHOWN AS OPEN ON THE SUGGESTED MAINTENANCE OF TRAFFIC PLANS PER TRAFFIC STAGE AT ALL TIMES, WITH MINIMUM LANE WIDTHS AS SHOWN IN THE SUGGESTED MAINTENANCE OF TRAFFIC PLANS.
  - 47 TRAFFIC MUST BE MAINTAINED AS SHOWN ON ALL STREETS AND PARKING MUST BE PROHIBITED WITHIN 50 FEET OF THE CONSTRUCTION AREA AT ALL TIMES. THE CONTRACTOR MUST NOTIFY THE OFFICE OF EMERGENCY MANAGEMENT AND COMMUNICATIONS (OEMC), TRAFFIC MANAGEMENT AUTHORITY 48 HOURS BEFORE COMMENCING CONSTRUCTION.
  - 48. THE CONTRACTOR'S VEHICLES MUST ALWAYS MOVE WITH AND NOT AGAINST OR ACROSS THE FLOW OF TRAFFIC. THESE VEHICLES MUST ENTER OR LEAVE WORK AREAS IN A MANNER WHICH WILL NOT BE HAZARDOUS TO OR INTERFERE WITH NORMAL TRAFFIC, AND MUST NOT PARK OR STOP EXCEPT WITHIN DESIGNATED WORK AREAS. PERSONAL VEHICLES WILL NOT BE PERMITTED TO PARK WITHIN THE RIGHT-OF-WAY EXCEPT IN SPECIFIC AREAS DESIGNATED BY THE COMMISSIONER.
  - 49. WHERE SECTION OR SUBSECTION MONUMENTS OR BENCH MARKS ARE ENCOUNTERED. THE COMMISSIONER MUST BE NOTIFIED BEFORE SUCH MONUMENTS OR BENCH MARKS ARE REMOVED. THE CONTRACTOR MUST PROTECT AND CAREFULLY PRESERVE PROPERTY MARKERS AND MONUMENTS UNTIL THE COMMISSIONER HAS WITNESSED OR OTHERWISE REFERENCED THEIR LOCATION.
  - 50. THE RESIDENT ENGINEER IN THE CITY OF CHICAGO IS ALSO KNOWN AS THE COMMISSIONER, WITH ALL COMMISSIONER NOTATIONS IN THE PLANS AND SPECIFICATIONS INDICATING THE RESIDENT ENGINEER.
  - 51. DISTRICT ONE STANDARD TC-24 CITY OF CHICAGO TYPICAL PAVEMENT MARKINGS SHALL BE USED FOR PERMANENT PAVEMENT MARKINGS ON 63RD STREET, WENTWORTH AVENUE, AND YALE AVENUE. IDOT STANDARD 780001 TYPICAL PAVEMENT MARKINGS IS USED ONLY FOR THE DAN RYAN'S LANE DROP ARROWS.
  - 52. THE CONTRACTOR MUST COORDINATE ALL CONSTRUCTION AND INSTALLATION ACTIVITIES WITH THE CTA. CONTACT MR. ABDIN CARRILLO, PROJECT MANAGER, CONSTRUCTION OVERSIGHT, CHICAGO TRANSIT AUTHORITY AT (312) 681-3913 OR (312) 515-0840. MR. CARRILLO WILL COORDINATE CONSTRUCTION ACTIVITIES AFFECTING THE CTA R.OW., CTA RAIL SAFETY TRAINING, INSURANCE REQUIREMENTS, SECURITY, AND CTA FLAGGING SERVICES.
  - 53. THE CONTRACTOR SHALL COORDINATE THE RELOCATION OF CTA BUS STOP SIGNAGE WITH MR. CARRILLO AND THE CTA BUS OPERATIONS DEPARTMENT.
  - 54. ALL WORK TO BE DONE ON OR ADJACENT TO THE CTA'S R.O.W. WILL REQUIRE A WORK PLAN SUBMITTED BY THE GENERAL CONTRACTOR TO CTA FOR REVIEW AND APPROVAL PRIOR TO THE START OF WORK. THE CONTRACTOR MUST PROVIDE A FIVE (5) WEEK LOOK AHEAD SCHEDULE TO THE CTA RAIL OPERATIONS DEPARTMENT.
  - 55. CTA FLAGGING AND COORDINATION: FLAGGING, SINGLE TRACKS OR LINE CUTS ARE NOT REQUIRED IF ALL CONSTRUCTION ACTIVITIES, EQUIPMENT, PERSONNEL, CONSTRUCTION FENCES, ETC. ARE LOCATED AT LEAST 6'1" AWAY FROM THE CENTERLINE OF THE NEAREST TRACK. WHEN WORKING ADJACENT TO THE CTA TRACKS WITHOUT FLAGGING OR A SINGLE TRACK, THE CONTRACTOR SHALL CONSTRUCT A SOLID BARRIER AT LEAST 6' HIGH AND AT LEAST 6'1" FROM THE CENTERLINE OF NEAREST TRACK TO SEPARATE CONSTRUCTION ACTIVITIES FROM RAIL OPERATIONS. THE BARRIER SHALL BE DESIGNED BY A STRUCTURAL ENGINEER LICENSED IN ILLINOIS AND SUBMITTED TO THE CTA FOR REVIEW PRIOR TO START OF WORK. IF ANY CONSTRUCTION ACTIVITIES, EQUIPMENT, PERSONNEL, CONSTRUCTION FENCES, ETC. ARE CLOSER THAN 6'1" FROM THE CENTERLINE OF THE NEAREST TRACK, FLAGGING AND/OR A SINGLE TRACK OR A LINE CUT IS REDUIRED.
  - 56. THE METRA CREATE ROCK ISLAND FLYOVER PROJECT WILL BE ONGOING THROUGH 2014 AND INTO 2015. THE CONTRACTOR SHALL COORDINATE WITH JOE OTT OF METRA AT (312) 322-6726.

#### GENERAL NOTES - CITY OF CHICAGO DEPARTMENT OF WATER MANAGEMENT

- PRIOR TO THE START OF CONSTRUCTION, A PERMIT IS REQUIRED FROM THE SEWER SECTION
  OF THE DEPARTMENT OF WATER MANAGEMENT FOR ANY UNDERGROUND SEWER WORK INCLUDING
  ADJUSTMENTS OF SEWER STRUCTURES AND REMOVAL/REPLACEMENT OF FRAMES AND LIDS.
  THE PERMIT MUST BE OBTAINED BY A DRAIN LAYER CURRENTLY LICENSED BY THE SEWER UNIT
  OF THE DEPARTMENT OF WATER MANAGEMENT.
- THE CONTRACTOR IS RESPONSIBLE FOR THE ADEQUATE PROTECTION OF THE EXISTING SEWERS, DRAIN CONNECTIONS AND SEWER STRUCTURES DURING CONSTRUCTION OPERATIONS AND USE OF HEAVY EQUIPMENT IN THE LIMITS OF THE PROJECT.
- THE CONTRACTOR MUST LOCATE AND PROPERLY CONNECT TO THE NEW SEWERS ALL LIVE HOUSE DRAINS, CATCH BASIN DRAINS, AND OTHER EXISTING LATERALS, DRAINS AND SEWERS OF WHATEVER NATURES, WHICH ARE CONNECTED TO THE EXISTING SEWERS BEING REPAIRED OR REPLACED.
- 4. EXISTING CATCH BASIN LATERALS TO BE REUSED MUST BE RODDED AND FLUSHED IN THE PRESENCE OF THE SEWER UNIT OF THE DEPARTMENT OF WATER MANAGEMENT INSPECTOR. A NEW CONNECTION TO THE MAIN SEWER IS REQUIRED IF THE EXISTING CATCH BASIN LATERAL IS NOT APPROVED BY THE SEWER INSPECTOR.
- 5. WHEN A SEWER STRUCTURE IS ABANDONED, ALL PIPE OPENINGS MUST BE PLUGGED, STRUCTURES FILLED WITH TRENCH BACKFILL, LIDS AND FRAMES REMOVED AND SURFACE RESTORED AS PER THE SEWER LINIT OF THE DEPARTMENT OF WATER MANAGEMENT'S STANDARDS AND SPECIFICATIONS.
- 6. THE CONTRACTOR IS REQUIRED TO REPLACE ANY BROKEN FRAMES AND LIDS OF SEWER STRUCTURES WITH THE SEWER UNIT OF THE DEPARTMENT OF WATER MANAGEMENT STANDARD FRAMES AND LIDS.
- 7. THE FRAMES AND LIDS OF SEWER STRUCTURES TO BE ABANDONED. REMOVED OR FILLED MUST BE SALVAGED AND THE SEWER UNIT OF THE DEPARTMENT OF WATER MANAGEMENT NOTIFIED FOR PICK UP.
- 8. IN LOCATIONS WHERE THE MAIN SEWER IS NOT BEING REPLACED AND THE EXISTING DRAINAGE FACILITIES ARE DISTURBED OR DAMAGED DURING CONSTRUCTION BY THE CONTRACTOR, IT WILL BE THE CONTRACTOR'S RESPONSIBILITY TO RESTORE AND REPLACE THE DAMAGED FACILITIES AT HIS EXPENSE TO THE SATISFACTION OF THE SEWER UNIT OF THE DEPARTMENT OF WATER MANAGEMENT.
- 9. IN CASE OF ANY DAMAGE TO THE CITY'S SEWER SYSTEM OR PRIVATE AND PUBLIC DRAIN CONNECTIONS, THE CONTRACTOR MUST CONTACT THE SEWER UNIT OF THE DEPARTMENT OF WATER MANAGEMENT IMMEDIATELY AT (312) 747-8117 OR (312) 747-7893, THE CONTRACTOR MUST AT HIS EXPENSE, REPLACE THE AFFECTED SEWERS, DRAIN CONNECTIONS AND/OR SEWER STRUCTURES AS NECESSARY, THE SEWER FLOWS MUST BE MAINTAINED AT ALL TIMES.
- 10. UPON WORK COMPLETION, THE CONTRACTOR MUST PROVIDE THE SEWER UNIT OF THE DEPARTMENT OF WATER MANAGEMENT, FOR REVIEW AND ACCEPTANCE, A POST-CONSTRUCTION VIDEO TAPED INSPECTION OF THE SEWER MAINS.
- 11. AS-BUILT PLANS OF NEW OR REPLACED SEWERS IN THE PUBLIC RIGHT-OF-WAY MUST BE SUBMITTED TO THE DWM SEWER DESIGN SECTION WITHIN 30 DAYS AFTER COMPLETION OF THE PROJECT. THE AS-BUILT PLANS MUST BE SEALED BY A PROFESSIONAL ENGINEER OR REGISTERED LAND SURVEYOR AND BE SUBMITTED WITH THE APPROPRIATE TRANSMITTAL FORM AVAILABLE FROM THE RESIDENT ENGINEER. PLAN AND PROFILE DRAWINGS OF THE SEWERS AND SEWER STRUCTURES MUST BE SUBMITTED ON A COMPACT DISC IN \*TIFF FORMAT, ALL ELECTRONIC FILES MUST BE SUBMITTED IN A FILE FOLDER WITH ONE FILE NAME REFLECTING THE ADDRESS OF THE PROJECT, WITH STREET NAME FIRST (IE. JACKSON ST, 300-500 S.) A HARD COPY OF THE AS-BUILT PLANS MUST ALSO BE SUBMITTED.
- 12. PRE-CONSTRUCTION VIDEO TAPED INSPECTION IS REQUIRED PRIOR TO ISSUANCE OF THE SEWER PERMIT. ALL LIVE LATERALS SHALL BE LOCATED FOR FUTURE CONNECTION TO THE PROPOSED SEWER.
- 13. THE CONTRACTOR SHALL INSTALL RESTRICTORS IN ALL NEW CATCH BASINS INSTALLED OUTSIDE THE CENTRAL BUSINESS DISTRICT, RESTRICTORS MUST NOT BE INSTALLED IN CATCH BASINS IN CLOSE PROXIMITY TO VIADUCT AREAS, BUS STOPS, OR EMERGENCY ENTRANCES. THE DWM MUST APPROVE THE NON-INSTALLATION OR REMOVAL OF ANY RESTRICTOR, REQUIREMENTS FOR RESTRICTOR INSTALLATION ARE AS FOLLOWS:

ARTERIAL STREETS AND BUS ROUTES: 3-INCH ORIFICE RESTRICTORS
RESIDENTIAL STREETS: 3-INCH VORTEX RESTRICTORS (WITH SWIRL CHAMBER)
ALLEYS: 3-INCH ORIFICE RESTRICTOR IN THE LAST CATCH BASIN

THE COST OF THE RESTRICTORS SHALL BE INCLUDED IN THE CONTRACT UNIT PRICE FOR "CATCH BASIN (EXCEPT FRAME AND LID)".

14. THE EXISTING FIRE HYDRANT AT THE SOUTHWEST CORNER OF 63RD STREET AND YALE AVENUE IS TO MOVED TO STATION 19+22, 55° RT. THIS RELOCATION WORK WILL BE DONE BY THE CITY OF CHICAGO DEPARTMENT OF WATER MANAGEMENT. THE CONTRACTOR SHALL COORDINATE THIS RELOCATION WITH THE DEPARTMENT OF WATER MANAGEMENT.

083022\Cab\Site\dgn\CO\060J5-sht 3rdi04 PM

GREEF CHOOMS Road Suffe 2

USER NAME = 0766	DESIGNED - JS	SO	REVISED	-/ 5/23/2014 GRA	EF
		JM.	REVISED	~	
PLOT SCALE : 188,0288 '/ in-	CHECKED - TI	NS	REVISED	-	
PLOT DATE + 5/22/2014	DATE - 0	3-15-2013	REVISED	-	-

90%.FED. 10%.STATE

				,	10%, STATE	Ţ	<del></del>		<del></del>		
T-					URBAN				TRAFFIC SIGNALS OC		51
		CODE NO.	PAY ITEM DESCRIPTION	UNIT	TOTAL	ROADWAY 0004	BRIDGE 0014	LIGHTING 0021	63RD ST/ YALE AVE	63RD ST/ WENTWORTH AVE	INTER- CONNE
-	-	X2011000	TEMPORARY FENCE (SPECIAL)	FOOT	453		453		444		
		X4060110	BITUMINOUS MATERIALS (PRIME COAT)	POUND	97	97					
		X5860110	GRANULAR BACKFILL FOR STRUCTURES	CU YD	92		92				
											ļ
#		X6020083	INLETS, TYPE A, TYPE 1 FRAME, OPEN LID (CITY OF CHICAGO)	EACH		1					<del>                                     </del>
	-	X6022505	CATCH BASINS, TYPE A, 4'-DIAMETER, TYPE I FRAME, OPEN LID (CITY OF CHICAGO)	EACH	4	4		<del> </del>			<u> </u>
		X0022303			· · · · · · · · · · · · · · · · · · ·					TO THE PROPERTY OF THE PROPERT	
_		X7010216	TRAFFIC CONTROL AND PROTECTION (SPECIAL)	L SUM	1	1					
								<u> </u>			
		X7011015	TRAFFIC CONTROL AND PROTECTION (EXPRESSWAYS)	LSUM	1	1				-	<u> </u>
		v 7017070	TRIFFIC CONTON CURVEUS ANCE EVERCECHAVE	CAL DA	235	235				***************************************	
		x7013820	TRAFFIC CONTROL SURVEILLANCE, EXPRESSWAYS	CALUA	2,73	233		<del> </del>	1		<del>                                     </del>
		Z0004552	APPROACH SLAB REMOVAL	SO YO	738	738		<u> </u>		14. P.	
		·-····································									
		Z0012754	STRUCTURAL REPAIR OF CONCRETE (DEPTH EQUAL TO OR LESS THAN 5 INCHES)	SO FT	797		797				
								<u> </u>	<u> </u>	<b></b>	
		20013798	CONSTRUCTION LAYOUT	LSUM	1	1		<del> </del>	<u> </u>		<u> </u>
		Z0018004	DRAINAGE SCUPPERS, DS-12	EACH	4		4	<u> </u>			
		20010004	ordinal see i mid on it	Q-1071	<u> </u>	<del> </del>					<del> </del>
		Z0018800	DRAINAGE SYSTEM	L SUM	1		1				
		Z0026407	TEMPORARY SHEET PILING	SO FT	327		327	<del> </del>			
		70040000	RAILROAD PROTECTIVE LIABILITY INSURANCE	L SUM	1	i					<u> </u>
		20040000	HAILROAD PROTECTIVE CJADICTIT INSURANCE	C JUN	*	<u> </u>		<u> </u>	<u> </u>		
		Z0073100	TEMPORARY SHORING	EACH	4		4	<b>†</b>			
		X0370135	CONCRETE CURB. TYPE B SPECIAL (CDOT)	F007	101	101					
			(2222)	5007	400	420					
*		X0370080	COMBINATION CURB AND GUTTER TYPE B V.12 (CDOT)	FOOT	400	400		<del> </del>	-		
		BUNDIO	SUBBASE GRANULAR MATERIAL, TYPE B 24"	SO YD	43	43		-	<u> </u>		<del> </del>
		SHOLOWO								TO THE PERSON NAMED IN COLUMN	
		X0327617	MODIFY CONCRETE BARRIER AND RETAINING WALL	L SUM	1	1					
								ļ		<u> </u>	-
n		X037008/	SAND CUSHION, 4" (CDOT)	SOFT	2,538	2,538		<u> </u>			-
		VA207: 10	I ANICCADING COCCIAI	L SUM	1	1					
		XU3Z1410	LANDSCAPING, SPECIAL		<u> </u>	*		<del>                                     </del>	<del> </del>		
		V027119	STORM SEWER, TYPE 2, 8 INCH. EXTRA STRENGTH VITRIFIED CLAY PIPE (CDOT)	FOOT	98	98	<del> </del>	<del> </del>		1	
-		A V Z IDOO E									
п		X0370083	STORM SEWER. TYPE 2. 8 INCH, DUCTILE IRON PIPE (CDOT)	FOOT	113	113					
						1					<u> </u>
	*	81100320	CONDUIT ATTACHED TO STRUCTURE, I" DIA., PVC COATED GALVANIZED STEEL	FOOT	518			518	<del> </del>		
	3/		CONDUST ATTACHED TO CERLIPTINGS 2" DEA CALVANIZED CECEL (DEAT)	FOOT	634			634			
**	*	X0370122	CONDUIT ATTACHED TO STRUCTURE, 2" DIA., GALVANIZED STEEL (CDOT)	1.001		<del> </del>	<del> </del>	1 327	<del> </del>	<u> </u>	<del> </del>

\* specialty Items

A Rev. 6-4-14

| Rev. 6-4-14 | F.A.I. | RTE. | 94 |

GRÖEF OVER 1. HERSTER FOR SAITH

	USER NAME = 0766	DESIGNED	-	JS0	REVISED	-
ite 280	_	DRAWN	-	MLH	REVISED	•
N.	PLDT SCALE = 100,0000 '/ In.	CHECKED	-	TNS	REVISED	•
	PLDT DATE + 3/31/2014	DATE	-	03-15-2013	REVISED	-

STATE OF ILLINOIS
DEPARTMENT OF TRANSPORTATION

63rd STREET BRIDGE REPLACEMENT - COOK COUNTY SUMMARY OF QUANTITIES SCALE: N750' SHEET 5 OF 8 SHEETS STA. TO STA.

SECTION 1920-B

101.STATE URBAN TRAFFIC SIGNALS 0021 TOTAL ROADWAY BRIDGE LIGHTING PAY ITEM DESCRIPTION CODE NO. UNIT 63RD ST/ YALE 63RD ST/ QUANTITY 0021 INTER- CONNECT WENTWORTH AVE AVE \* 81100605 CONDUIT ATTACHED TO STRUCTURE, 2" DIA., PVC COATED GALVANIZED STEEL FOOT 140 140 \* Y0370124 CONDUIT ATTACHED TO STRUCTURE, 3" DIA., GALVANIZED STEEL (CDOT) FOOT 3,330 320 \* \* 81100805 CONDUIT ATTACHED TO STRUCTURE, 3" DIA., PVC COATED GALVANIZED STEEL FOOT 952 952 \* 81603081 UNIT DUCT. 600 V, 3-1/C ND. 2, 1/C NO. 4 GROUND, (XLP-TYPE USE), 1 1/4" DIA. POLYETHYLENE) FOOT 102 102 \* XO370263 CONDUIT ATTACHED TO STRUCTURE, 4" DIA., GALVANIZED FOOT 720 720 \* (\* 81702110 ELECTRIC CABLE IN CONDUIT, 600V (XLP-TYPE USE) 1/C NO. 10 FOOT 2.786 2,786 \* 81702140 ELECTRIC CABLE IN CONDUIT, 600V (XLP-TYPE USE) 1/C NO. 4 932 932 FOOT 2790 290 2,500 FOOT 870 870 L SUM 1 FOOT 2320 2320 \* X0323710 REMOVE CONDUIT ATTACHED TO STRUCTURE FOOT 2,403 320 2,083 \* X0370132 MAINTENANCE OF STREET LIGHTING SYSTEM (COOT) L SUM \* YO370003 ELECTRIC TRIPLEX, 2-1/C NO.6 AND 1-1/C NO.8 GROUND (COOT) FOOT 2,692 2,692 \* X0370133 PAINT EXISTING STREET LIGHT/TRAFFIC EQUIPMENT COMPLETE/C DOT ) EACH 1 \* X0370134 JUNCTION BOX, POLE OR POST MOUNTED (CDOT) EACH 2 \* (\* X8/30/25 REMOVE EXISTING JUNCTION BOX EACH 30 30 \* X8210305 PROTECTION AND MAINTENANCE OF EXISTING UNDERPASS LIGHTING L SUM \* X0370/38 ELECTRIC CABLE IN CONDUIT, COAXIAL VIDEO, RG-59/U (CDOT) FOOT 197 149 48 . X Z 0033028 MAINTENANCE OF LIGHTING SYSTEM CAL MO 6 6 \* X0370084 DRILL MANHOLE OR HANDHOLE (CIOOT) 25 EACH 14 @ # X X0370085 CLEAN MANHOLE OR HANDHOLE (CDOT) EACH 4 8 \* X0370076 ROD AND CLEAN DUCT IN EXISTING CONDUIT SYSTEM (C POT) FOOT 456 238 218 \* X0370002 BREAKDOWN STREET LIGHT FOUNDATION (CDOT) EACH 5 3 \* X0370001 TRENCH AND BACKFILL WITH SCREENINGS (CDOT) FOOT 316 39  $\times$  | X0370084 | CONCRETE FOUNDATION, 30" DIAMETER, 1 1/4" ANCHOR RODS, 17 1/4" BOLT CIRCLE, 9 FEET 1 \* specialty Items Rev. @ 100% STATE (NP) 1 Rev. 6-4-14


90%FED.

REVISED -DESIGNED - JSO REVISED -PLOT SCALE + 100.0008 1/ in CHECKED - TNS REVISED -- 03-15-2013 REVISED -

STATE OF ILLINOIS DEPARTMENT OF TRANSPORTATION

63rd STREET BRIDGE REPLACEMENT - COOK COUNTY SUMMARY OF QUANTITIES SCALE: NTSO' SHEET 6 OF 8 SHEETS STA.

SECTION COOK 142 10 1920-8 94 CONTRACT NO. 60JI5 ILLINDIS FEO. AID PROJECT

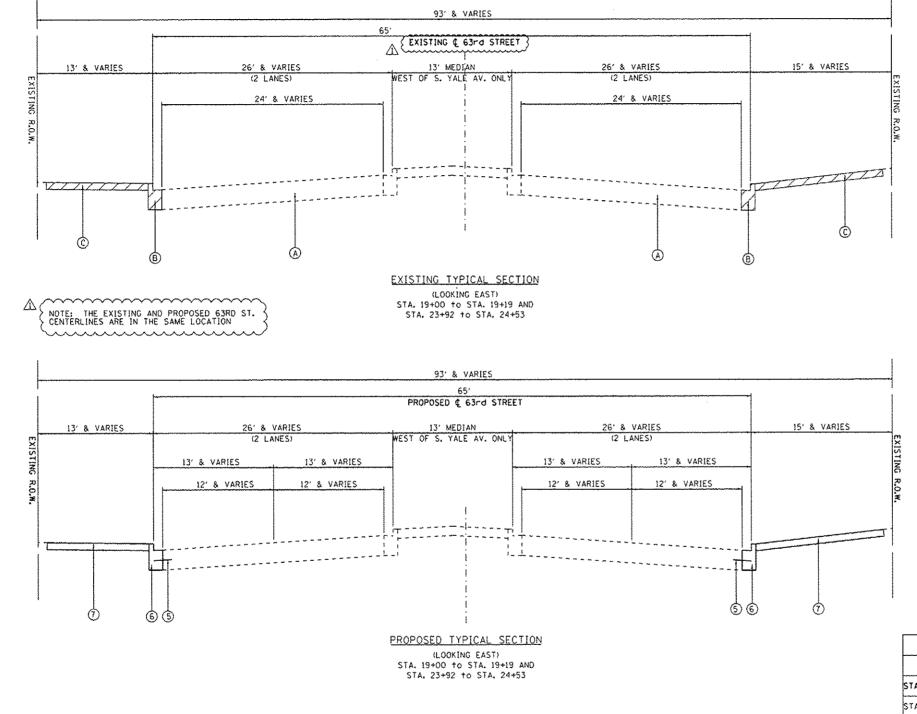

#### **EXISTING CONDITIONS:**

- A P.C.C. PAVEMENT
- (B) COMBINATION CONCRETE CURB AND GUTTER
- C P.C.C. SIDEWALK (5" ) & 8" (AT ADA RAMPS)

ITEM TO BE REMOVED

# **PROPOSED CONDITIONS:**

- 1 P.C.C. PAVEMENT 10" (JOINTED)
- 2 AGGREGATE SUBGRADE IMPROVEMENT 12"
- 3 LONGITUDINAL CONSTRUCTION JOINT WITH NO. 6×24 EPOXY COATED TIE BARS AT 24" CENTERS
- (4) LONGITUDINAL SAWED JOINT WITH NO. 6×30 EPOXY COATED TIE BARS AT 30" CENTERS
- (5) NO. 5×30 EPOXY COATED ROUND TIE BARS AT 30" CENTERS. DRILLED AND GROUTED
- 6 COMBINATION CURB & GUTTER TYPE B-V.12
- 7 P.C.C. SIDEWALK 5"
- 8 PARAPET WALL
- 9 BRIDGE FENCE RAILING

MIXTURE TYPE	AIR VOIDS	OUALITY MANAGEMENT PROGRAM (OMP)
STABILIZED SUBBASE 6"		
STABILIZED SUBBASE HMA (IL-19mm) 6"	4% @ 50 GYR	QC/QA

THE UNIT WEIGHT USED TO CALCULATE ALL HOT-MIX ASPHALT SURFACE MIXTURE IS 112 LBS/SO YD/IN.

THE "AC TYPE" FOR NON-POLYMERIZED HMA MIXES SHALL BE "PG 64-22" UNLESS MODIFIED BY DISTRICT ONE SPECIAL PROVISIONS. FOR USE OF RECYCLED MATERIALS SEE SPECIAL PROVISIONS.

QUALITY MANAGEMENT PROGRAM (OMP) IDENTIFIES THE PARTICULAR QUALITY CONTROL SPECIFICATION THAT APPLIES TO THE HMA MIXTURE.

GRØEF 500 1. Hoodes Roods Suite 280 Okcops, Mirola 6063) (773) 399-012


STATE OF ILLINOIS
DEPARTMENT OF TRANSPORTATION


63rd STREET BRIDGE REPLACEMENT - COOK COUNTY
TYPICAL SECTIONS

SCALE: 1"250" | SHEET 1 | OF 2 | SHEETS | STA. TO STA.

0/60/15-sht-typical01.dg

CADNSITENCE ON CONDISOUS-Sht-ty

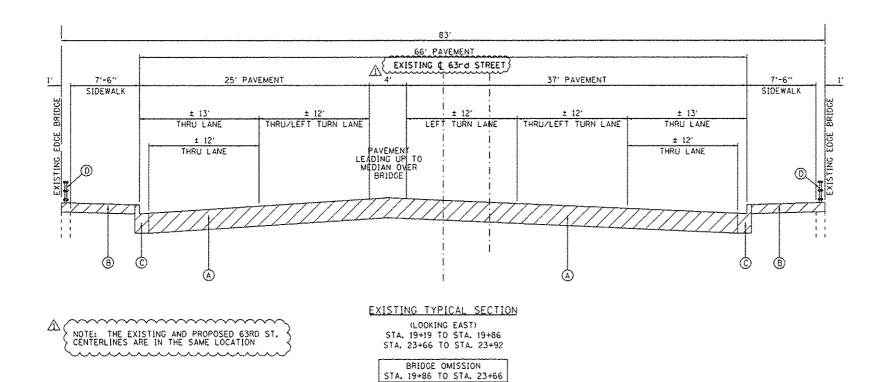

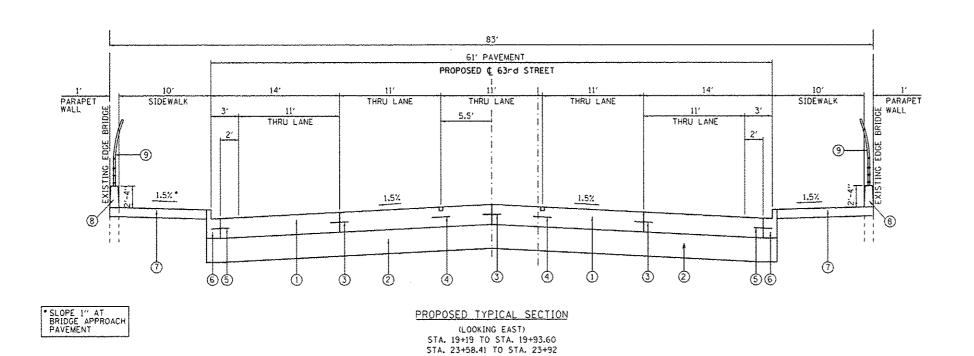

BRIDGE OMISSION STA. 19+93.60 TO STA. 23+58.41

# **EXISTING CONDITIONS:**

- (A) P.C.C. PAVEMENT
- B P.C.C. SIDEWALK
- © P.C.C. CURB & GUTTER
- (TO BE REMOVED)



ITEM TO BE REMOVED

#### **PROPOSED CONDITIONS:**


- 1 P.C.C. PAVEMENT 10" (JOINTED)
- 2 AGGREGATE SUBGRADE IMPROVEMENT 12"
- 3 LONGITUDINAL CONSTRUCTION JOINT WITH NO. 6×24 DEFORMED EPOXY COATED TIE BARS AT 24" CENTERS
- 4 LONGITUDINAL SAWED JOINT WITH NO. 6×30 DEFORMED EPOXY COATED TIE BARS AT 30" CENTERS
- (5) NO. 5x30 EPOXY COATED ROUND TIE BARS AT 30" CENTERS
- 6 COMBINATION CURB & GUTTER TYPE 8-V.12
- 7 P.C.C. SIDEWALK 5"
- 8 PARAPET WALL
- 9 BRIDGE FENCE RAILING


REVISED - 5/23/2014 GRAEF USER NAME : 0766 DESIGNED - JSO REVISED -GROEF CHOOSE HOUSE SOLITE CHECKED - TNS REVISED PLD? SCALE + 180,0000 1/ in DATE - 03-15-2013 REVISED PLOT DATE . 5/22/2014


STATE OF ILLINOIS **DEPARTMENT OF TRANSPORTATION** 

63rd STREET BRIDGE REPLACEMENT - COOK COUNTY TYPICAL SECTIONS SCALE: 1"=50" SHEET 2 OF 2 SHEETS STA. TO STA.

COUNTY TOTAL SHEET NO. COOK 142 14 SECTION 94 1920-B CONTRACT NO. 60J15

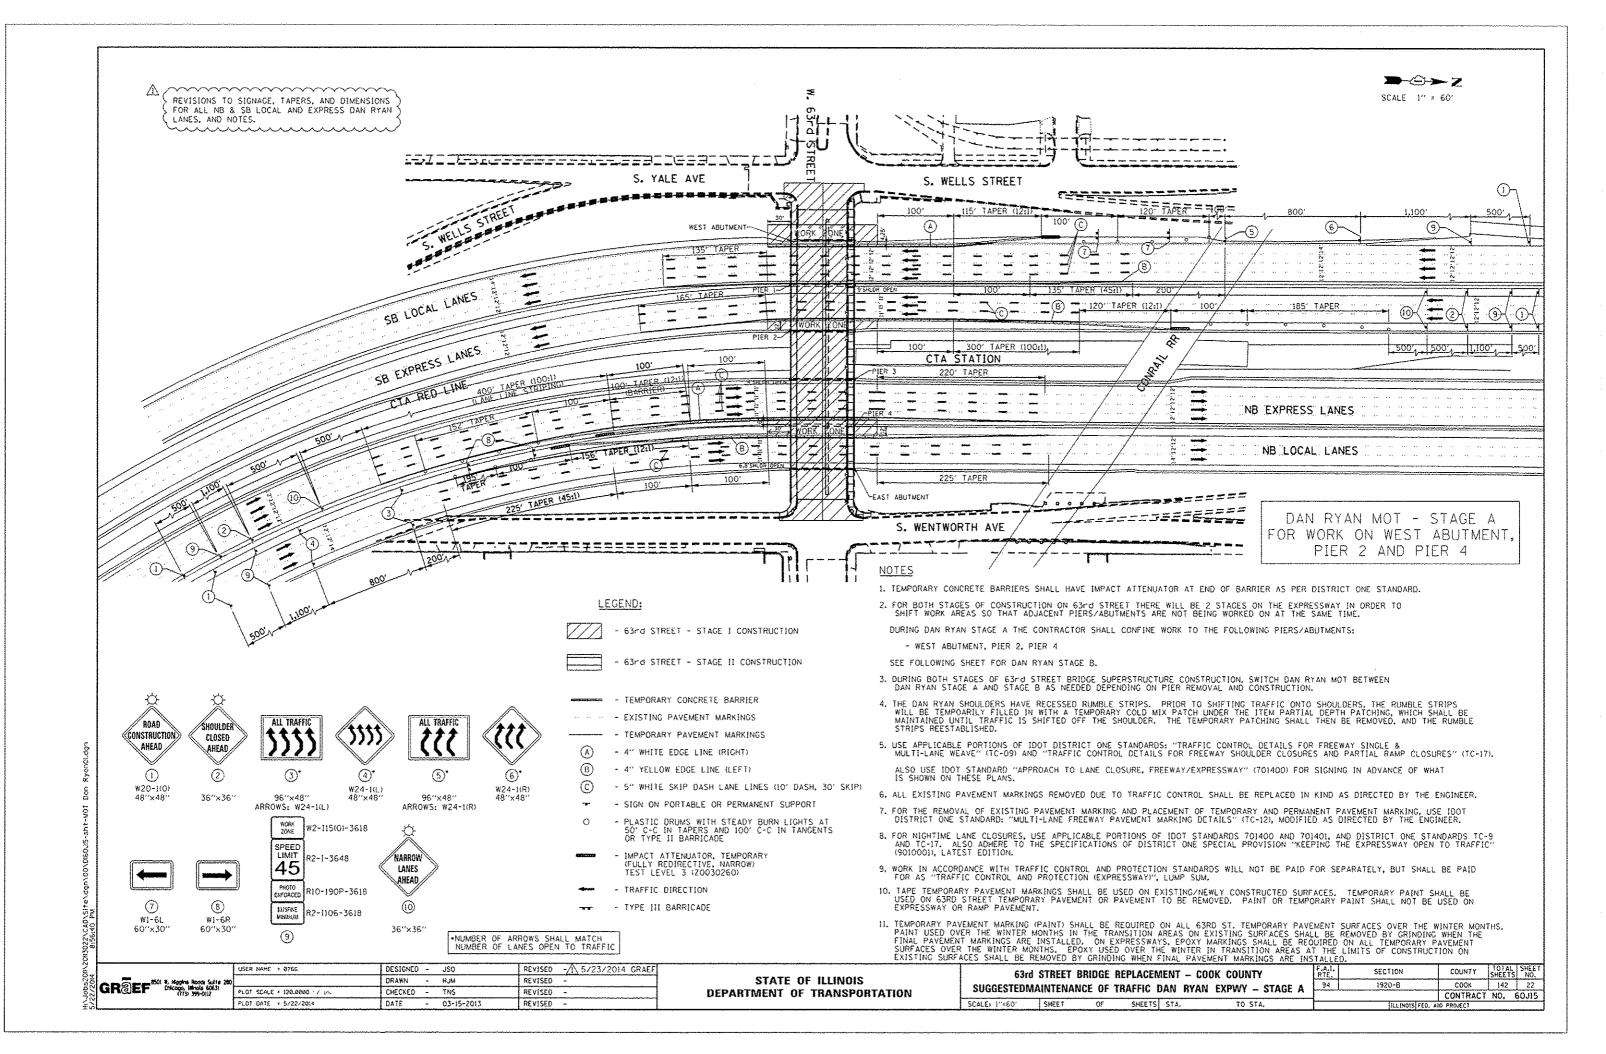

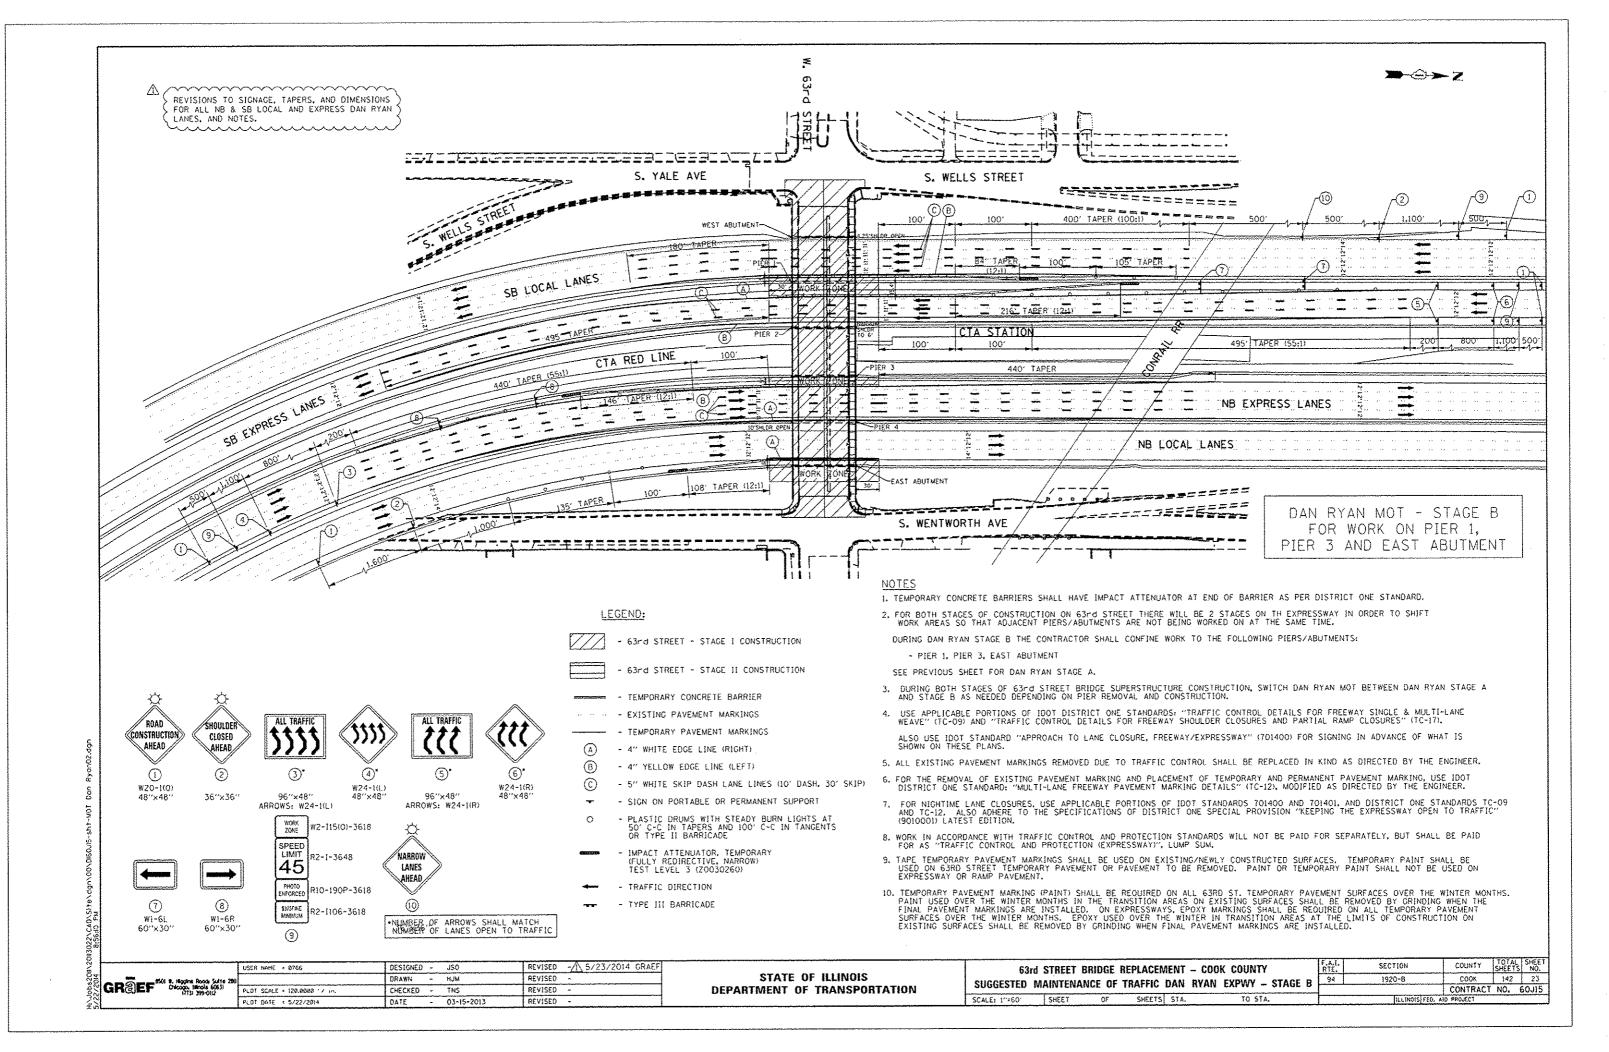

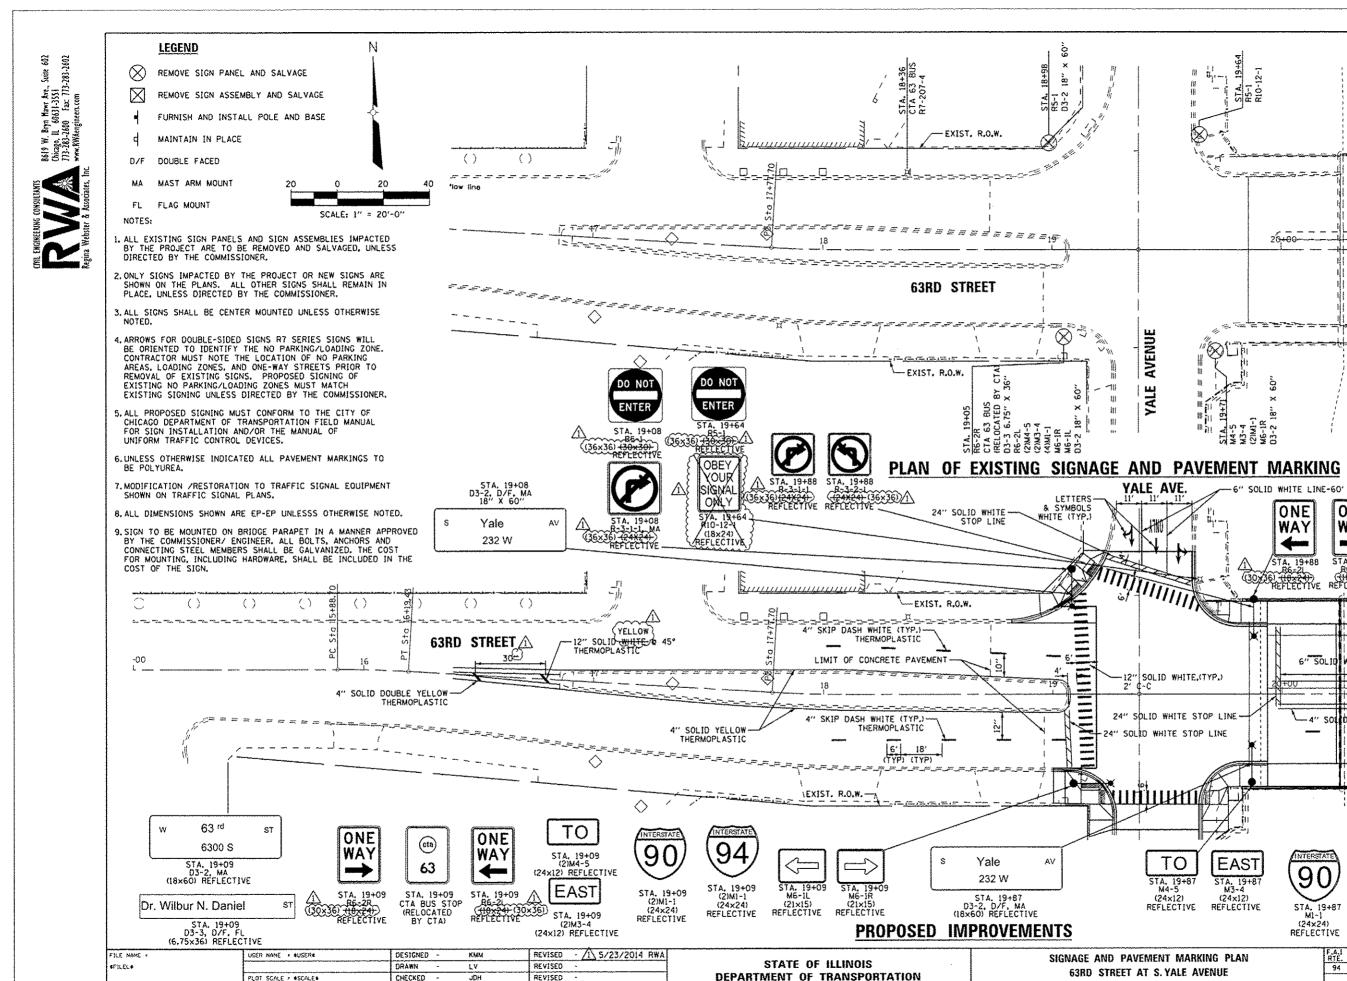

DATE

03-31-2014

REVISED

COUNTY TOTAL SHEE SHEETS NO. SECTION 94 1920-8 COOK 142 28 63RD STREET AT S. YALE AVENUE CONTRACT NO. 60J15 SCALE: 1"=20" SHEET NO. OF SHEETS STA. IO STA.

8

7

STA.

ST.

63RD

MATCHLINE

00

7

STA.

ST.

63RD

MATCHLINE

111

STA. 19+87 STA. 19+87 STA. 19+87 M6-1R R-3-2-1- MA (24x24) REFLECTIVE REFLECTIVE REFLECTIVE

63rd St

STA. 20+91 (ON BRIDGE PARAPET.

SEE NOTE 9)

4" SKIP DASH-WHITE (TYP.)

D DOUBLE YELLOW


REFLECTIVE

D3-1 (18x60)

REFLECTIVE


ONE

WAY

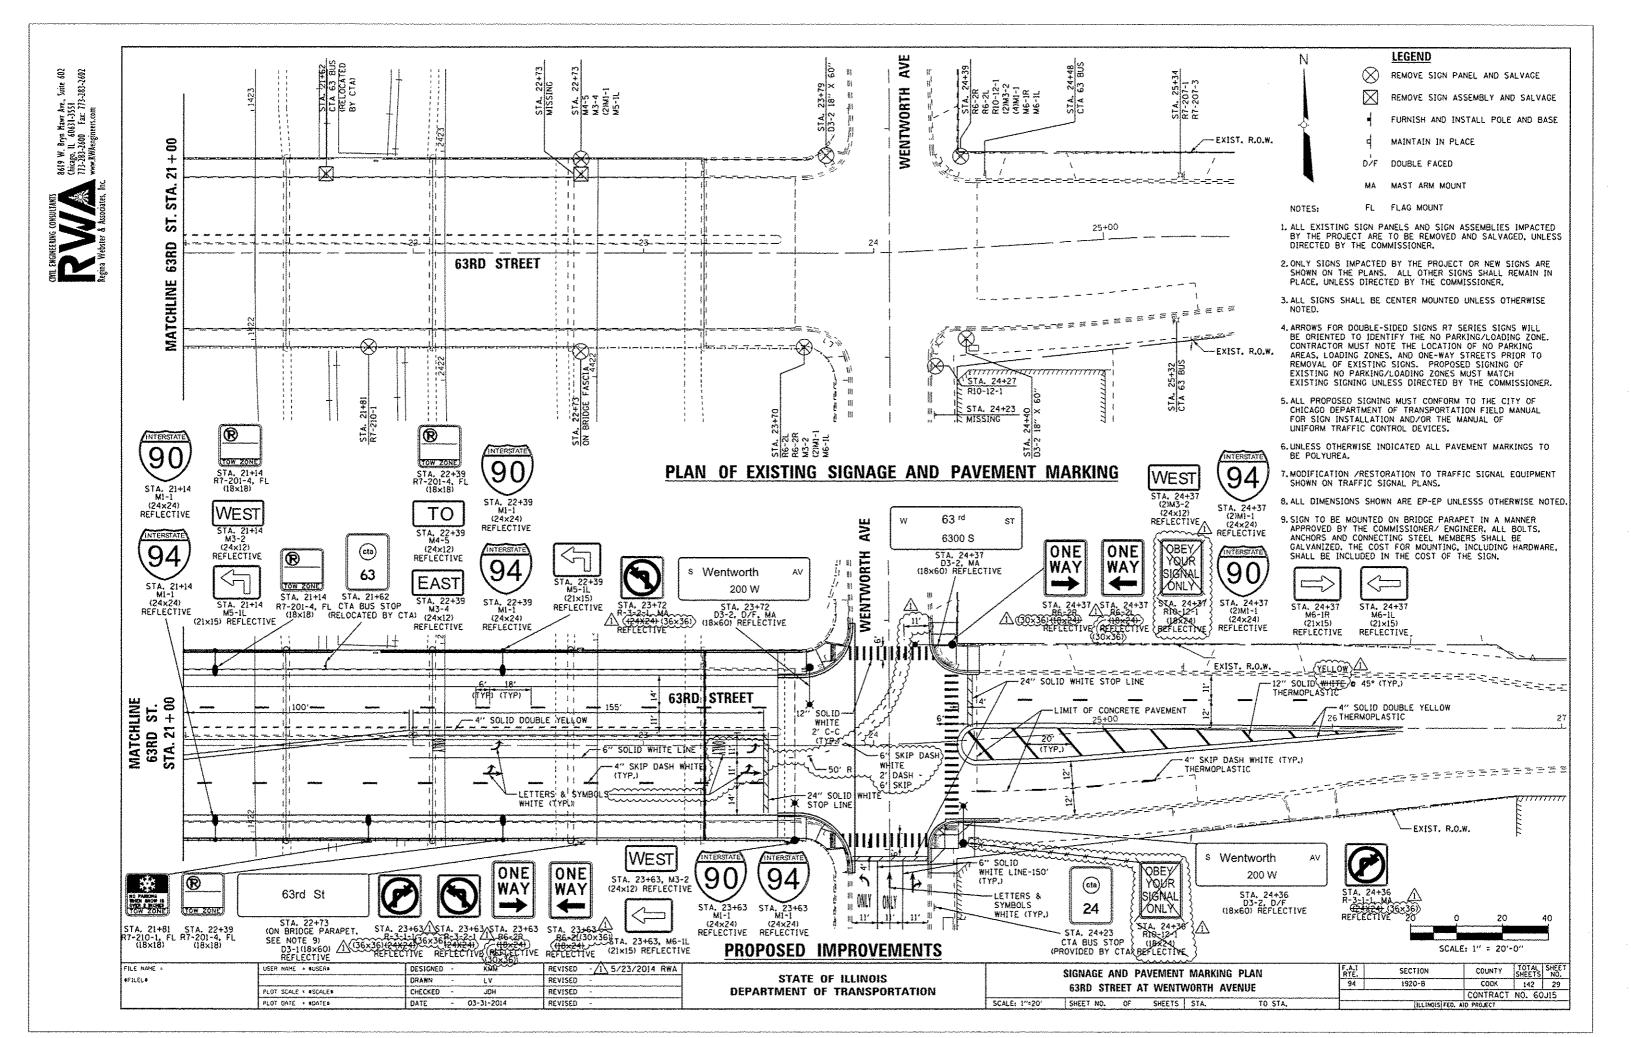



# **REGULATORY SIGN LEGEND**

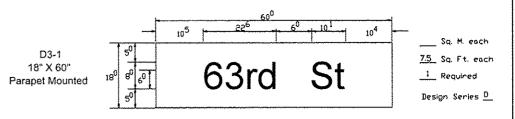

D3-2 18" X 60" 63 rd ST 6300 S

D3-2 D/F 18" X 60"

ΑV Yale 232 W

D3-2 18" X 60" s Wentworth ΑV 200 W

D3-3 D/F 6.75" X 36"

Dr. Wilbur N. Daniel

S

ST











CTA BUS STOP











WEST

INTERSTATE

90

M1-1 (24×24)

SCALE:

WEST M3-2 (24×12)

M1-1 (24×24)

INTERSTATE 94

INTERSTATE 90 M1-1 (24×24)

TO STA.

**EAST** 

M3-4 (24×12)

**EAST** M3-4 (24×12) INTERSTATE

M1-1 (24×24)

M6-1R (21×15)

TO M4-5 (24×12) <u>\_</u>

M5-1L (21×15)

M6-1L
(21×15)

LE NAME «	USER NAME 4 #USER#	DESIGNED	-	KMM	REVISED	ΞZ	5/23/	2014	RWA
ILEC#		DRAWN	-	LY	REVISED	-			
	PLOT SCALE . *SCALE*	CHECKED	-	JDH	REVISED	-			
	PLOT DATE . *DATE*	DATE	~	03-31-2014	REVISED	-			

STATE O	F ILLINOIS
DEPARTMENT OF	TRANSPORTATION

		SIGN	DETAIL	SHEET
SHEET	NO.	OF	SHEETS	STA,

F.A.I RTE.	SECTION	COUNTY	TOTAL SHEETS	SHEET NO.				
94	1920-8	COOK	142	31				
		CONTRACT	NO. 60	J15				
	ILLINOIS FED. AID PROJECT							

#### **BILL OF MATERIALS**

			TOTAL	IDOT UNDERPASS	CDOT OVERPASS
	ITEM	UNIT	QUANTITY		QUANTITY
	IDOT	FOOT	518	518	
	CONDUIT ATTACHED TO STRUCTURE, I" DIA., PVC COATED GALVANIZED STEEL	1001	010	316	
	CONDUIT ATTACHED TO STRUCTURE, 2° DIA., PVC COATED GALVANIZED STEEL	FOOT	140	140	
	CONDUIT ATTACHED TO STRUCTURE, 3" DIA., PVC COATED GALVANIZED STEEL	FQOT	952	952	
	RINCTION BOX, STABILESS STEEL, ATTACHED TO STRUCTURE 6" X 6" X 4"	EACH	12	12	
	JUNCTION BOX, STAINLESS STEEL, ATTACHED TO STRUCTURE, 12" X 10" X 6"	EACH	6	6	
	JUNCTION BOX, STAINLESS STEEL, ATTACHED TO STRUCTURE, 24" X 24" X 10"	EACH	2	2	
(	UNIT DUCT, 660V, 3-IC-NO.2, L'C-NO.4 GROUND, (XLP-TYPEUSE), 1-I/F DIA. POLYET/PYLENE	FOOT	102	102	)
۶	CHI DOC; OVI, O K TOOL LEGIST SIGNED AND TO BE SOON				<b>(</b>
ζ	UNIT DUCT, 600V, 3-1C NO.2, 1/C NO.4 GROUND, (XLP-TYPE USE), 1 1/2" DIA. POLYETHYLENE	FOOT	242	242	)
Λ	ELECTRIC CABLE IN CONDUIT, 600V (XLP-TYPE USE) 1/C NO, 10	FOOT	2786	2786	
	ELECTRIC CABLE IN CONDUIT, 660V (XLP-TYPE USE) 1/C NO. 4	FOOT	932	932	
	ELECTRIC CABLE IN CONDUIT, 600V (XLP-TYPE USE) I/C NO. 2	FOOT	2500	2500	
	REMOVE ELECTRIC CABLE FROM CONDUIT	FOOT	5982	5982	
*	MAINTENANCE OF LIGHTING SYSTEM	CALMO	6	6	
*	REMOVE CONDUIT ATTACHED TO STRUCTURE	FOOT	2083	2083	
*	REMOVE EXISTING JUNCTION BOX	EACH	30	30	
*	PROTECTION AND MAINTENANCE OF EXISTING UNDERPASS LIGHTING	LSUM	1	1	
	CDOT	FOOT	237	1	237
	UNDERGROUND CONDUIT, PVC, 2" DIA.	<u> </u>			
	CONDUIT ATTACHED TO STRUCTURE, 2" DIA., GALVANIZED STEEL.	FOOT	634		634
	CONDUIT EMBEDDED IN STRUCTURE, 2" DIA., PVC	FOOT	221		221
*	REMOVE EXISTING STREET LIGHTING EQUIPMENT	LSUM	1		1
*	MAINTENANCE OF STREET LIGHTING SYSTEM (CITY OF CHICACO)	LSUM	1		1
*	PAINT EXISTING STREET LIGHT/TRAFFIC EQUIPMENT COMPLETE	EACH	1		1
*	CABLE IN CONDUIT, TRIPLEX, 2-I/C NO. 6 AND I-I/C NO. 8 GROUND	FÓOT	2692	<b></b>	2692
*	RACK, SECONDARY-AERIAL, 2-WIRI:	EACH	1		1
*	POLE, STEEL, 326°, ANCHOR BASE, 11 1/2° B.C., 7 GAUGE (INSTALL ONLY)	EACH	4		4
*	MAST ARM, STEEL, STREET LIGHTING, 8 POOF (INSTALL ONLY)	EACH	9		9
*	MAST ARM, STEEL, STREET LIGHTING, 15 FOOT (INSTALL ONLY)	EACH	4		4
*	LUMINAIRE, STREET LIGHT, CERAMIC METAL HALIDE, 210 WATT, 240 VOLT, ARTERIAL SEMI-CUTOFF (INSTALL ONLY)	EACH	15		15
	SURP APPLAZ JONO C	FOOT	260	<b> </b>	260
*	WIRE, AERIAL, I/C NO. 6 INDICATE SPECIAL PROVISION	1:507	J		<u> </u>

	n	73	n	*	##		T	n	RI	•
Δ	ĸ	к	н	•	V١	ш	11	ŧ	IM	

ABBREVIATION	DESCRIPTION
AC	ALTERNATING CURRENT
A/C	AERIAL CABLE
AFG	ABOVE FINISHED GRADE
CB :	CIRCUIT BREAKER
CKT	CIRCUIT
CM	CENTIMETER
CP	CONTROL PANEL
CT	CURRENT TRANSFORMER
DA	DAVIT ARM
DC DC	DIRECT CURRENT
DIA	DIAMETER
DP	DISTRIBUTION PANEL
E	EXISTING UNIT TO REMAIN
ECA	ELECTRIC CABLE ASSEMBLY
FT	FEET OR FOOT
fU	FUSE
GND	GROUND
HID	HIGH INTENSITY DISCHARGE
JB	JUNCTION BOX
KVA	KILOVOLT-AMPERE
K₩	KILOWATTS
M	METER
MA	MAST ARM
MM	MILLIMETER
M.H.	MOUNTING HEIGHT
MW	MESSENGER WIRE
NO. *	NUMBER
P	PROPOSED
PB	PUSH BUTTON
PNL	PANEL
PVC	POLYVINYL CHLORIDE
PVCC RGC	PVC COATED RIGID GALVANIZED CONDUI
PT	POTENTIAL TRANSFORMER
R	EXISTING UNIT TO BE REMOVED
	(OWNER SALVAGED U.N.O.)
RR	EXISTING UNIT TO BE REMOVED AND
	REINSTALLED
RECP	RECEPTACLE
RGC	RIGID GALVANIZED CONDUIT
SEL SW	SELECTOR SWITCH
SPARE	SPARE
SPACE	SPACE STEEL
\$5	STAINLESS STEEL
STA	STATION
UD	UNIT DUCT
U.N.O.	UNLESS NOTED OTHERWISE
WP VC110	WOOD POLE
XFMR	TRANSFORMER
HPS	HIGH PRESSURE SODIUM
LPS	LOW PRESSURE SODIUM
LTFM	LIQUID TIGHT FLEXIBLE METALLIC

#### **GENERAL NOTES**

1. IT IS THE RESPONSIBILITY OF THE CONTRACTOR TO ASCERTAIN EXISTING FIELD CONDITIONS BEFORE BIDDING ON THIS PROJECT, SPECIFICALLY AS THEY RELATE TO LUMP SUM ITEMS AND UNIT PRICE ITEMS.

ALL NEW CONDUITS, JUNCTION BOXES AND APPURTENANCES ARE INDICATED DIAGRAMMATICALLY ON THE DRAWINGS, THE ACTUAL LOCATIONS IN THE FIELD SHALL MEET WITH APPROVAL OF THE ENGINEER. 2.

THE ELECTRICAL WORK SHALL BE PERFORMED IN ACCORDANCE WITH THE LATEST CODES, STANDARDS AND THE IDOT STANDARD SPECIFICATIONS FOR ROAD AND BRIDGE CONSTRUCTION ADOPTED JANUARY 1, 2012, AND SUPPLEMENTAL SPECIFICATIONS AND SPECI

THE SCALE SHOWN ON PLAN DRAWINGS APPLIES ONLY TO THE FULL SIZE PLANS AND NOT TO REDUCED SIZE PLANS.

THE CONTRACTOR SHALL BE RESPONSIBLE FOR THE ESTABLISHMENT OF THE FINISHED GRADE. THE ENGINEER MAY ASSIST THE CONTRACTOR, AS APPLICABLE, BUT THE RESPONSIBILITY FOR COORDINATION OF THE FINISHED GRADE WITH THE TOP OF THE FOUNDATION HEIGHTS AND THE LIKE SHALL REMAIN WITH THE CONTRACTOR.

THE CONTRACTOR SHALL FURNISH AND INSTALL LUMINAIRE LAMPS IN ACCORDANCE WITH THE SUPPLIER'S RECOMMENDATIONS AND IN ACCORDANCE WITH THE SPECIFICATIONS. THE COST OF THIS WORK AND MATERIAL SHALL BE INCLUDED IN THE APPLICABLE LUMINAIRE PAY ITEM. SEPARATE PAYMENT WILL NOT BE MADE.

ALL LUMINAIRES SHALL BE ORIENTED WITH THE OPTICS PERPENDICULAR TO THE ROADWAY UNLESS NOTED OTHERWISE OR DIRECTED BY THE ENGINEER. THE LUMINAIRES MAY REQUIRE NIGHT-TIME OPTICAL ADJUSTMENT UPON INSPECTION BY THE ENGINEER. THIS WORK SHALL BE CONSIDERED INCLUDED IN THE APPLICABLE LUMINAIRE PAY ITEMS. SEPARATE PAYMENT WILL NOT BE MADE.

CONDUITS AND UNIT DUCTS SHALL BE INSTALLED AT A MINIMUM 30 INCH DEPTH BELOW GRADE AND POSITIONED IN THE FIELD TO AVOID CONFLICT WITH ROADWAY UNDERDRAINS AND OTHER EXISTING AND PROPOSED UTILITIES. THE CONTRACTOR SHALL INCREASE DEPTH OF UNIT DUCT AND CONDUIT AS REQUIRED AT NO ADDITIONAL COST OF THE STATE. THE CONTRACTOR SHALL COGRDINATE RACEWAY DEPTH WITH THE ELECTRICAL DETAILS AND THE ENGINEER.

THE CONTRACTOR SHALL MAKE SPECIAL NOTE OF THE SPECIFIED REQUIREMENTS FOR BURIED WARNING TAPE, AS PART OF THE UNDERGROUND CONDUIT OR UNIT DUCT. THE INSTALLATION OF THE TAPE SHALL BE INSPECIED BY THE ENGINEER PRIOR TO BACKFILLING OR DURING PLOWING OPERATIONS, AS APPLICABLE.

10. WHERE THE CONTRACTOR'S EXCAVATION MEETS AN OBSTRUCTION, THE CONTRACTOR SHALL NOTIFY THE ENGINEER FOR DIRECTION IN WRITING PRIOR TO FURTHER EXCAVATION. THE CONTRACTOR SHALL RESTORE ANY DAMAGE TO EXISTING SYSTEMS OR UTILITIES AND REMOVE EXISTING OBSTRUCTIONS AND FOUNDATIONS TO THE SATISFACTION OF THE ENGINEER, THIS WORK SHALL BE CONSIDERED INCIDENTAL TO THE APPROPRIATE PAY ITEM.

# **INDEX OF DRAWINGS:**

DRAWING NO.	STANDARD NO.	TITLE
E-1	-	GENERAL NOTES, ABBREVIATIONS, INDEX OF DRAWINGS AND SCHEDULE OF QUANTITIES
E-2	•	PROPOSED UNDERPASS LIGHTING PLAN
E-3	-	EXISTING UNDERPASS LIGHTING REMOVAL AND TEMPORARY LIGHTING PLAN
E-4	-	CONDUIT TRANSITION DETAILS
E-5	-	CONDUIT MOUNTING DETAILS ALONG BRIDGE
E-6	8E-902	IDOT DISTRICT 1 STANDARD DETAIL
E-7	-	ELECTRICAL GENERAL NOTES
E-8	826	CDOT STANDARD DETAILS
E-9	-	UNDERGROUND CONDUIT FACILITIES
E-10	-	STREET LIGHTING REMOVAL AND INSTALLATION PLAN
£-11	753, 620	CDOT STANDARD DETAILS
E-12	762	COOT STANDARD DETAILS
E-13	840	CDOT STANDARD DETAILS


E-1


REVISED A- ADDENDUM 1 5/23/14 SINGH USER NAME & mgorvido
PLOT SCALE + 2,80888801,802080 DESIGNED - BN ORAWN - AM REVISED CHECKED -KCP REVISED SHICH - ASSOCIATE INC CONSULTING ENGINEESS PLOT DATE = 22-MAY-2014 13:22 REVISED - 4/25/2014 DATE

STATE OF ILLINOIS DEPARTMENT OF TRANSPORTATION

63rd STREET OVER DAN RYAN EXPRESSWAY (1-90 /94) SECTION GENERAL NOTES, ABBREVIATIONS, INDEX OF DRAWINGS AND 94 1920-8 SCHEDULE OF QUANTITIES FED. ROAD DIST. NO. 1 ILLINOIS FED. AID PROJECT SCALE: N.T.S. SHEET NO. 1 OF 13 SHEETS STA.

COUNTY TOTAL SHEET NO. COOK 142 52 CONTRACT NO. 60J15

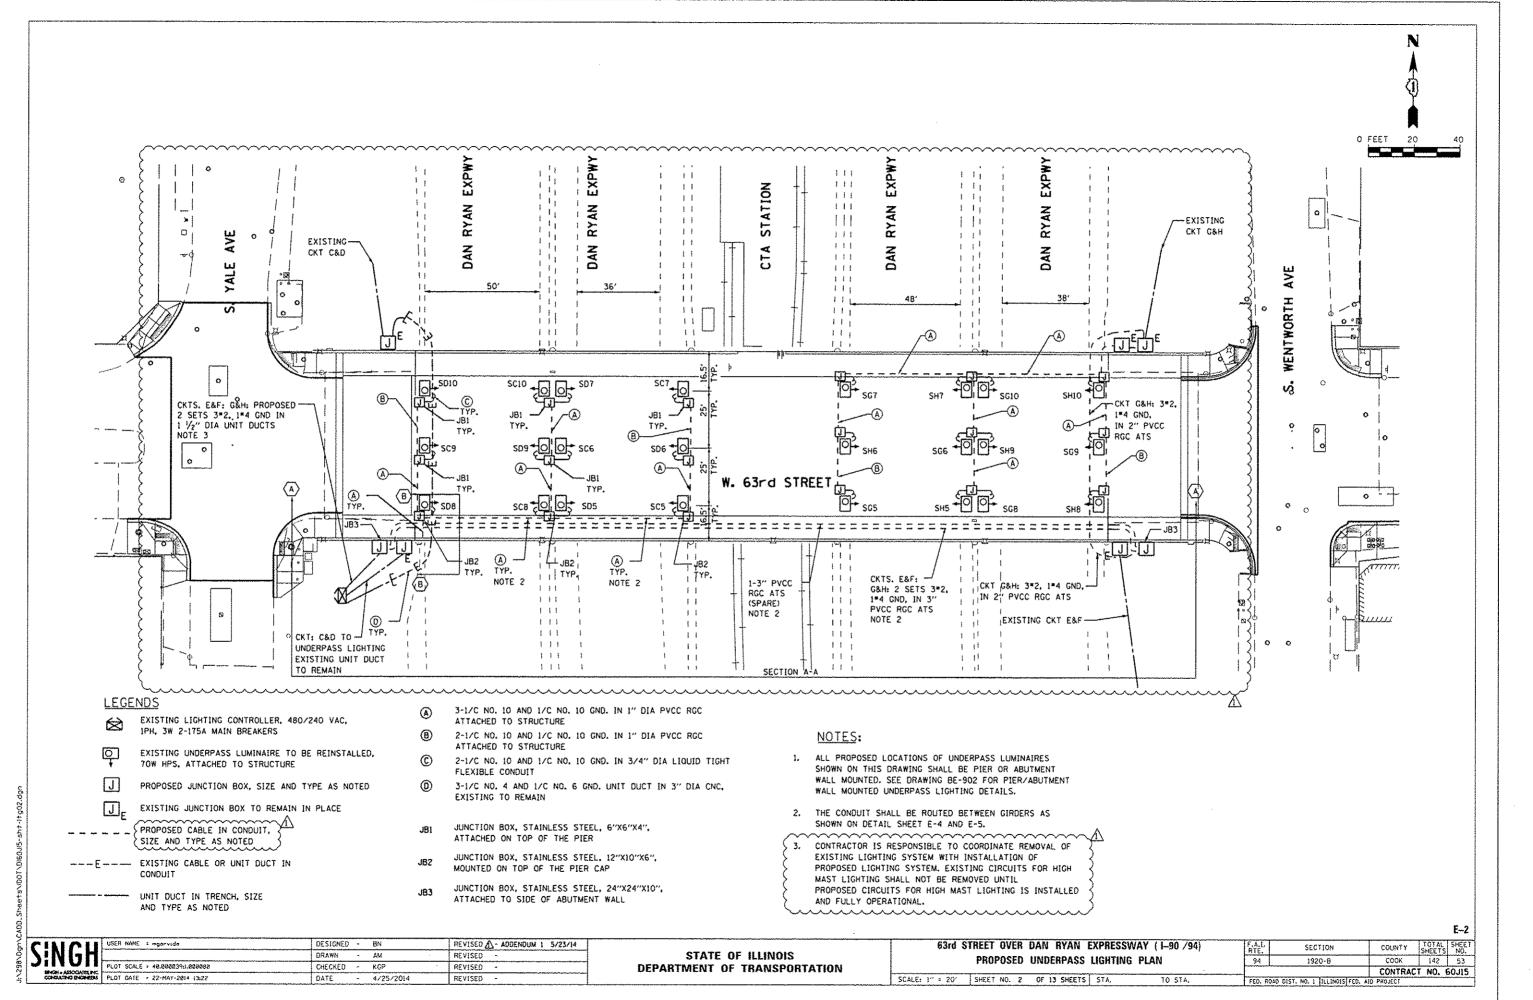

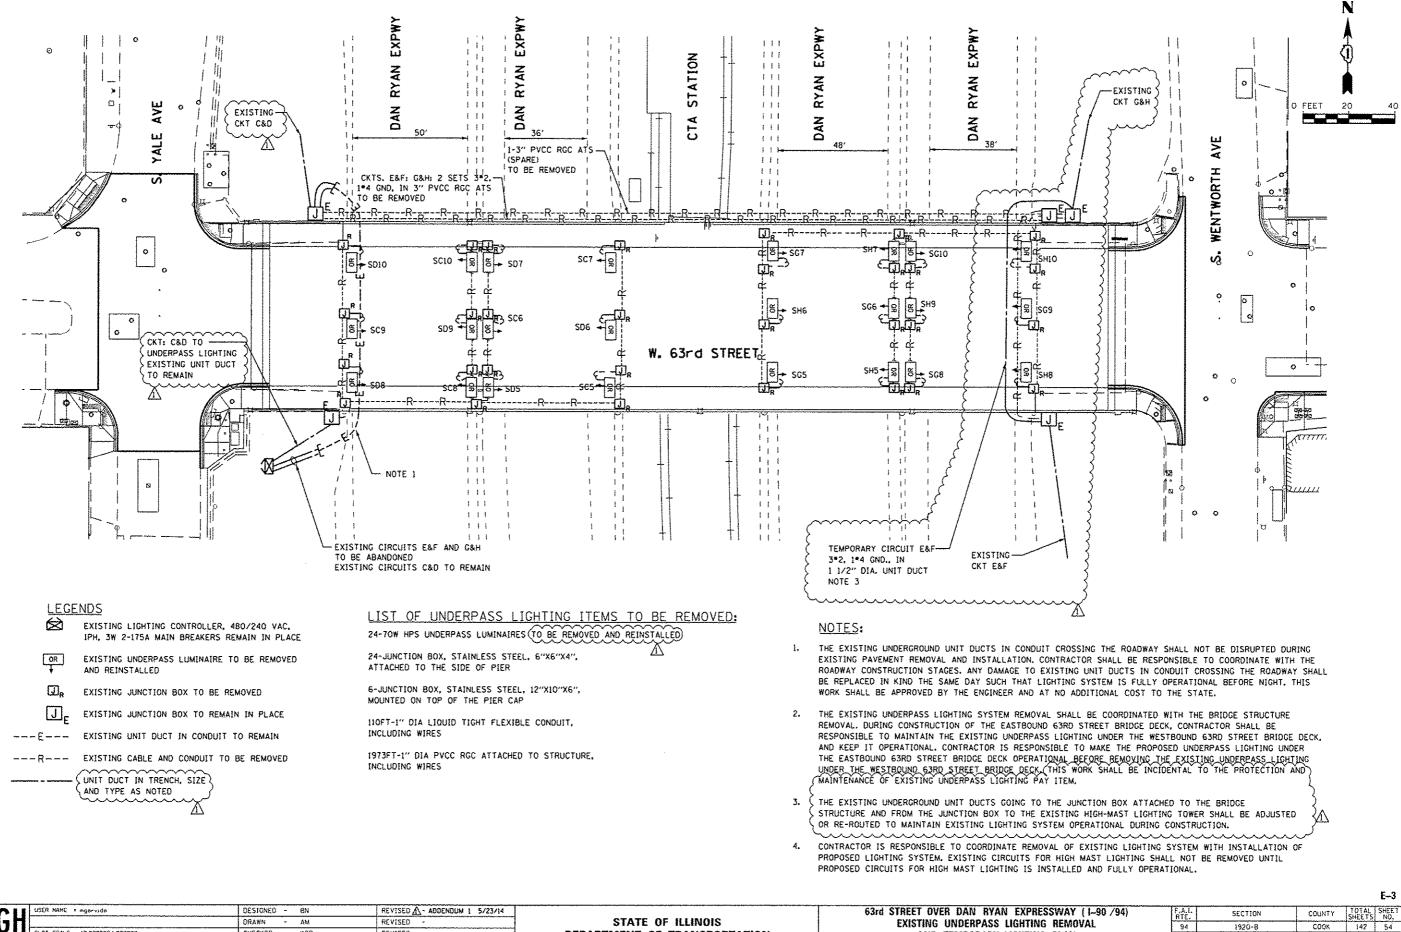

DEPARTMENT OF TRANSPORTATION

PLOT SCALE . 40.88803941.828288

CONSAING BICHESS PLOT DATE = 22-MAY-2814 13/22

CHECKED - KGP

4/25/2014

DATE

REVISED

REVISED


CONTRACT NO. 60J15

94

AND TEMPORARY LIGHTING PLAN
SCALE; 1" = 20' SHEET NO. 3 OF 13 SHEETS STA.

1920-B

FED. ROAD DIST, NO. 1 SELINOIS FED. AND PROJECT

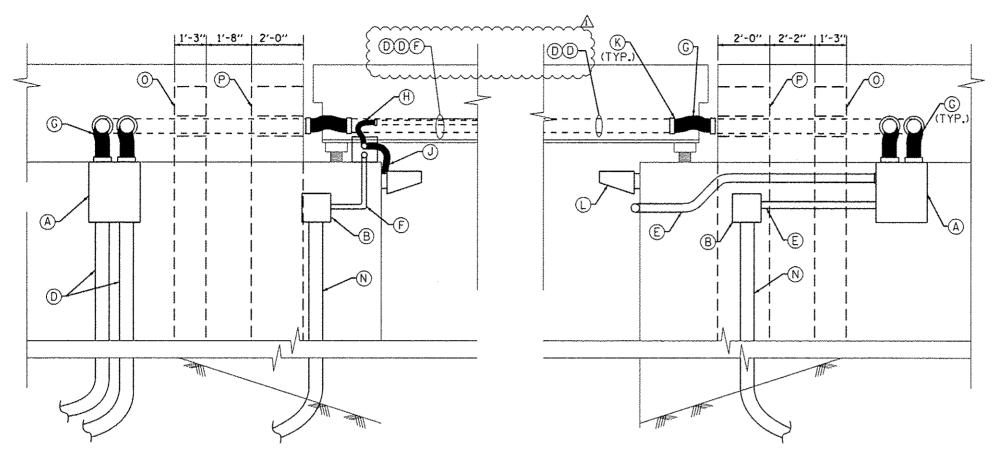


#### LEGEN

- A PROPOSED JUNCTION BOX, STAINLESS STEEL, 24"X24"X10" ATTACHED TO STRUCTURE
- (B) EXISTING JUNCTION BOX ATTACHED TO STRUCTURE
- PROPOSED JUNCTION BOX. STAINLESS STEEL, 12"X10"X6"
  ATTACHED TO TOP OF THE PIER CAP
- D 3" PVCC RGC ATTACHED TO STRUCTURE
- (E) 2" PVCC RGC ATTACHED TO STRUCTURE,
- (F) 1" PVCC RGC ATTACHED TO STRUCTURE.
- (G) 3" LIQUIDTIGHT FLEXIBLE METALLIC CONDUIT, 3FT (NOTE 6)
- (H) 1" LIQUIDTIGHT FLEXIBLE METALLIC CONDUIT. 2FT (NOTE 7)
- (J) 3/4" LIOUIDTIGHT FLEXIBLE CONDUIT, SFT
- PVCC RGS TO LIQUIDTIGHT FLEXIBLE CONDUIT COUPLING SIZE PER CONDUIT
- REINSTALLED EXISTING UNDERPASS LUMINAIRE
- (M) HARDWARE FOR CONDUIT SUPPORT
- (N) EXISTING CONDUIT
- (0) EXISTING COUNTERFORT WALL
- P NEW ABUTMENT BACKWALL

# SECTION A-A ELEVATION VIEW LOOKING NORTH AT SOUTH WING WALLS ATTACHED CONDUIT TRANSITION DETAILS

- ADDENDUM | 5/23/14

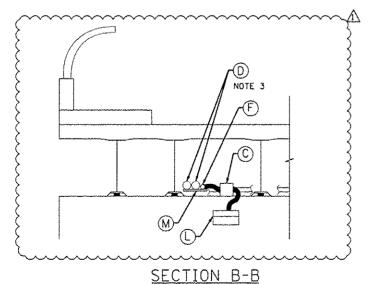

ELEVATION VIEW LOOKING WEST AT WEST ABUTMENT WALL

#### NOTES:

- 1. SEE STANDARD DETAIL DRAWING BE-902 FOR MORE DETAILS.
- 2. SEE PROPOSED UNDERPASS LIGHTING PLANS FOR WIRING.
- 3. SEE CONDUIT MOUNTING DETAILS SHEET E-5 FOR MORE INFORMATION.
- 4. CORE DRILL HOLES THROUGH EXISTING WING WALLS AND EXISTING COUNTERFORT WALL FOR 3" PVCC RGC CONDUIT PENETRATION, CORE DRILLING SHALL BE INCLUDED IN THE COST OF 3" PVCC RGC CONDUIT INSTALLATION.
- 5. PROVIDE GALVANIZED STEEL SLEEVE FOR EACH CONDUIT PENETRATION IN NEW ABUTMENT BACKWALL. SLEEVE DIAMETER SHALL BE 1" LARGER THAN CONDUIT OUTSIDE DIAMETER, GALVANIZED STEEL SLEEVE SHALL BE INCLUDED IN THE COST OF 3" PVCC RGC CONDUIT.

3" LIQUIDTIGHT FLEXIBLE METALLIC CONDUITS NEEDED AT STRUCTURE JOINTS SHALL BE INCLUDED AS PART OF THE PAY ITEM "CONDUIT ATTACHED TO STRUCTURE, 3" DIA., PVC COATED GALVANIZED STEEL".

7. 1" LIQUIDTIGHT FLEXIBLE METALLIC CONDUITS NEEDED AT STRUCTURE JOINTS SHALL BE INCLUDED AS PART OF THE PAY ITEM "CONDUIT ATTACHED TO STRUCTURE, 1" DIA., PVC COATED GALVANIZED STEEL".

MOII	USER NAME = mgorvide	DESIGNED -	BN	REVISED A
NUH		DRAWN -	AM	REVISED
		CHECKED -	KGP	REVISED
OH + ASSOCIATES INC		DATE -	4/25/2014	REVISED

STATE OF ILLINOIS
DEPARTMENT OF TRANSPORTATION


63rd STREET OVER DAN RYAN EXPRESSWAY (1–90 /94)

CONDUIT TRANSITION DETAILS


SCALE: N.T.S. SHEET NO. 4 OF 13 SHEETS STA. TO STA.

5-sht-ltg04.dgr

F--

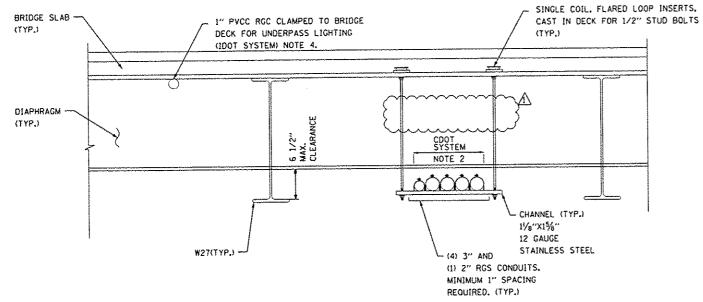

### CONDUIT SUPPORT DETAIL UNDER WB 63RD ST. LANES LOOKING EAST

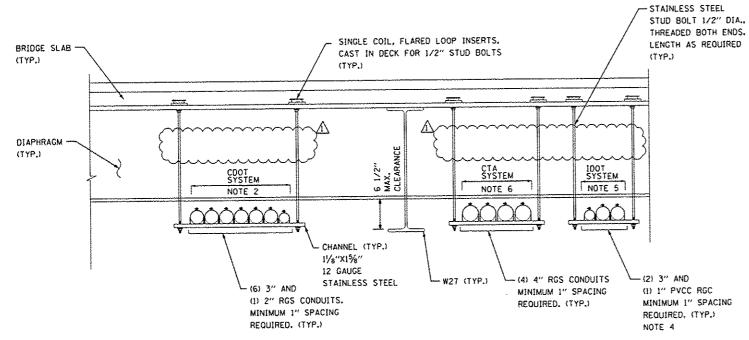


CONDUIT SUPPORT DETAIL UNDER EB 63RD ST. LANES

CONDUIT MOUNTING DETAILS ALONG BRIDGE N.T.S.

NOTES:

- 1. CONDUIT SUPPORT SHALL BE INSTALLED EVERY 10FT. COORDINATE WITH STRUCTURAL ENGINEER FOR SUPPORT INSTALLATION.
- 2. CONDUIT SUPPORT SYSTEM INCLUDING ALL ASSOCIATED HARDWARE SHALL BE INCLUDED IN THE COST OF 3-INCH RGS CONDUIT PAY ITEM INCLUDED IN TRAFFIC SIGNAL PLANS. SEE TRAFFIC SIGNAL PLANS FOR CONDUIT ROUTING.
- 3. SEE STRUCTURE PLANS FOR LOCATION OF CONDUIT MOUNTING ASSEMBLIES.
- 4. SEE PROPOSED UNDERPASS LIGHTING PLANS SHEET E-2 FOR CONDUIT ROUTING.
- 5. CONDUIT SUPPORT SYSTEM INCLUDING ALL HARDWARE SHALL BE INCLUDED IN THE COST OF 3-INCH PVCC RGC FOR HIGHMAST LIGHTING.
- 6. CONDUIT SUPPORT SYSTEM INCLUDING ALL HARDWARE SHALL BE INCLUDED IN THE COST OF 4-INCH RGS CONDUIT SHOWN IN THE DRAINAGE AND UTILITIES PLAN FOR THE CTA STATION.

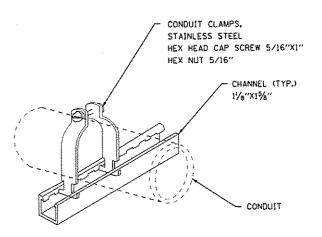

CONDUIT CLAMP DETAIL

REVISED A- ADDENDUM 1 5/23/14 DESIGNED - BN SINGH PLOT SCALE - 88.82620861,888988 DRAWN - AM REVISED . REVISED CHECKED KGP CONSULTING ENGINEERS PLOT DATE = 22-MAY-2014 13:22 REVISED - 4/25/2014 DATE

STATE OF ILLINOIS DEPARTMENT OF TRANSPORTATION


63rd STREET OVER DAN RYAN EXPRESSWAY (1-90 /94) CONDUIT MOUNTING DETAILS ALONG BRIDGE SCALE: N.T.S. SHEET NO. 5 OF 13 SHEETS STA.

COUNTY TOTAL SHEET SHEET NO. SECTION 94 1920-B CONTRACT NO. 60JIS


E--5

#### SIGNING FOR FLAGGING OPERATIONS AT WORK ZONE OPENINGS

#### WORK ZONE EXIT OPENING

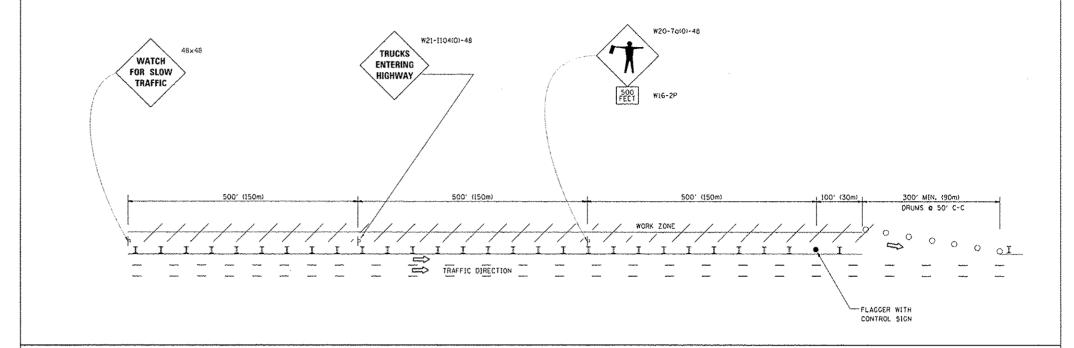

# WORK ZONE ENTRY OPENING

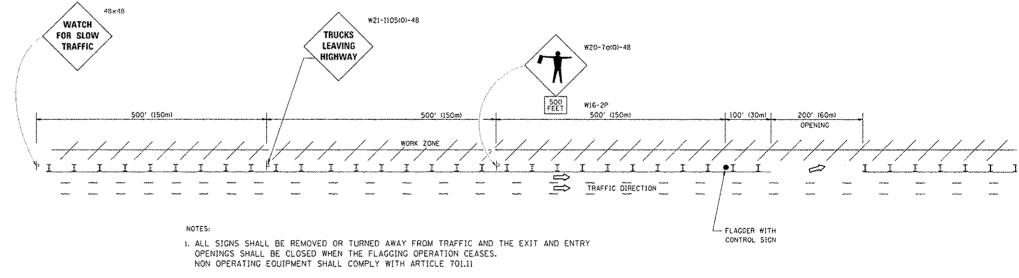

 WORK ZONE OPENINGS SHALL BE A MINIMUM OF ONE HALF MILE APART AND A MINIMUM OF ONE QUARTER MILE FROM ALL ENTRANCE AND EXIT RAMPS.

3. EXITING THE WORK ZONE AT ANY PLACE OTHER THAN AT A WORK ZONE EXIT OPENING WILL BE PROHIBITED.

4. ALL VEHICLES SHALL ENTER THE WORK ZONE AT ENTRY OPENINGS, USING THEIR TURN SIGNALS TO WARN MOTORISTS

5. FLAGGERS SHALL NOT STOP TRAFFIC OR DIRECT TRAFFIC INTO AN ADJACENT LANE.

A NEW PLAN SHEET

↑ 5/23/2014 GRAEF

ALL DIMENSIONS ARE IN INCHES (MILLIMETERS)
UNLESS OTHERWISE SHOWN

- 1	FILE NAME :	USER NAME = footomy	DESIGNED -	REVISED - J.A.F. 02-06		FREEWAYEXPRESSWAY SIGNING FOR FLAGGING OPERATIONS	FA - SECTION COUNTY TOTAL SHEET
j	cr\pw_work\pwidot\footomj\d8188315\tcl8.	gr <sub>1</sub>	DRAWN -	REVISED - S.P.B. 01-07	STATE OF ILLINOIS		1388
- 1	1	PLOT SCALE > 58.888 ' / 10.	CHECKED -	REVISED - S.P.B. 12-09	DEPARTMENT OF TRANSPORTATION	AL HOUR COUR DECINING ON THEINTHOUSERING	TC-18 CONTRACT NO.
Į		PLOT DATE * 7/8/2013	DATE -	REVISEO - M.D. 06-13		SCALE: NONE SHEET NO. 1 OF 1 SHEETS STA. TO STA.	FED. ROAD DIST, NO. 1   ILLINOIS FED. AID PROJECT