
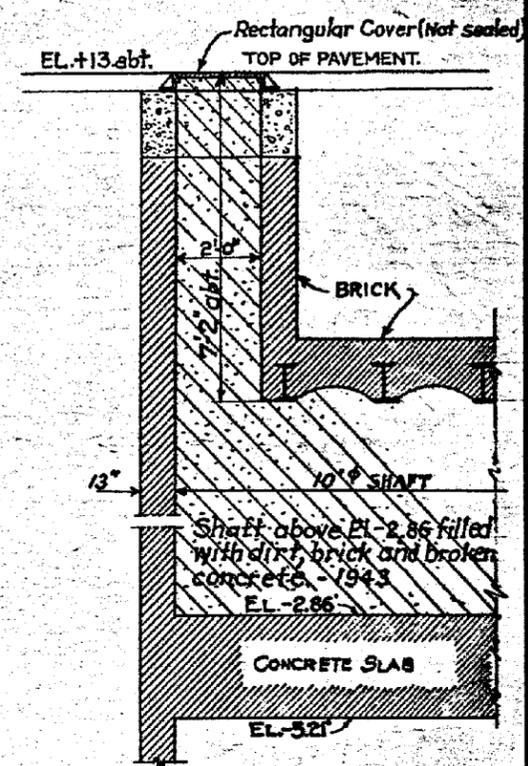


D 5

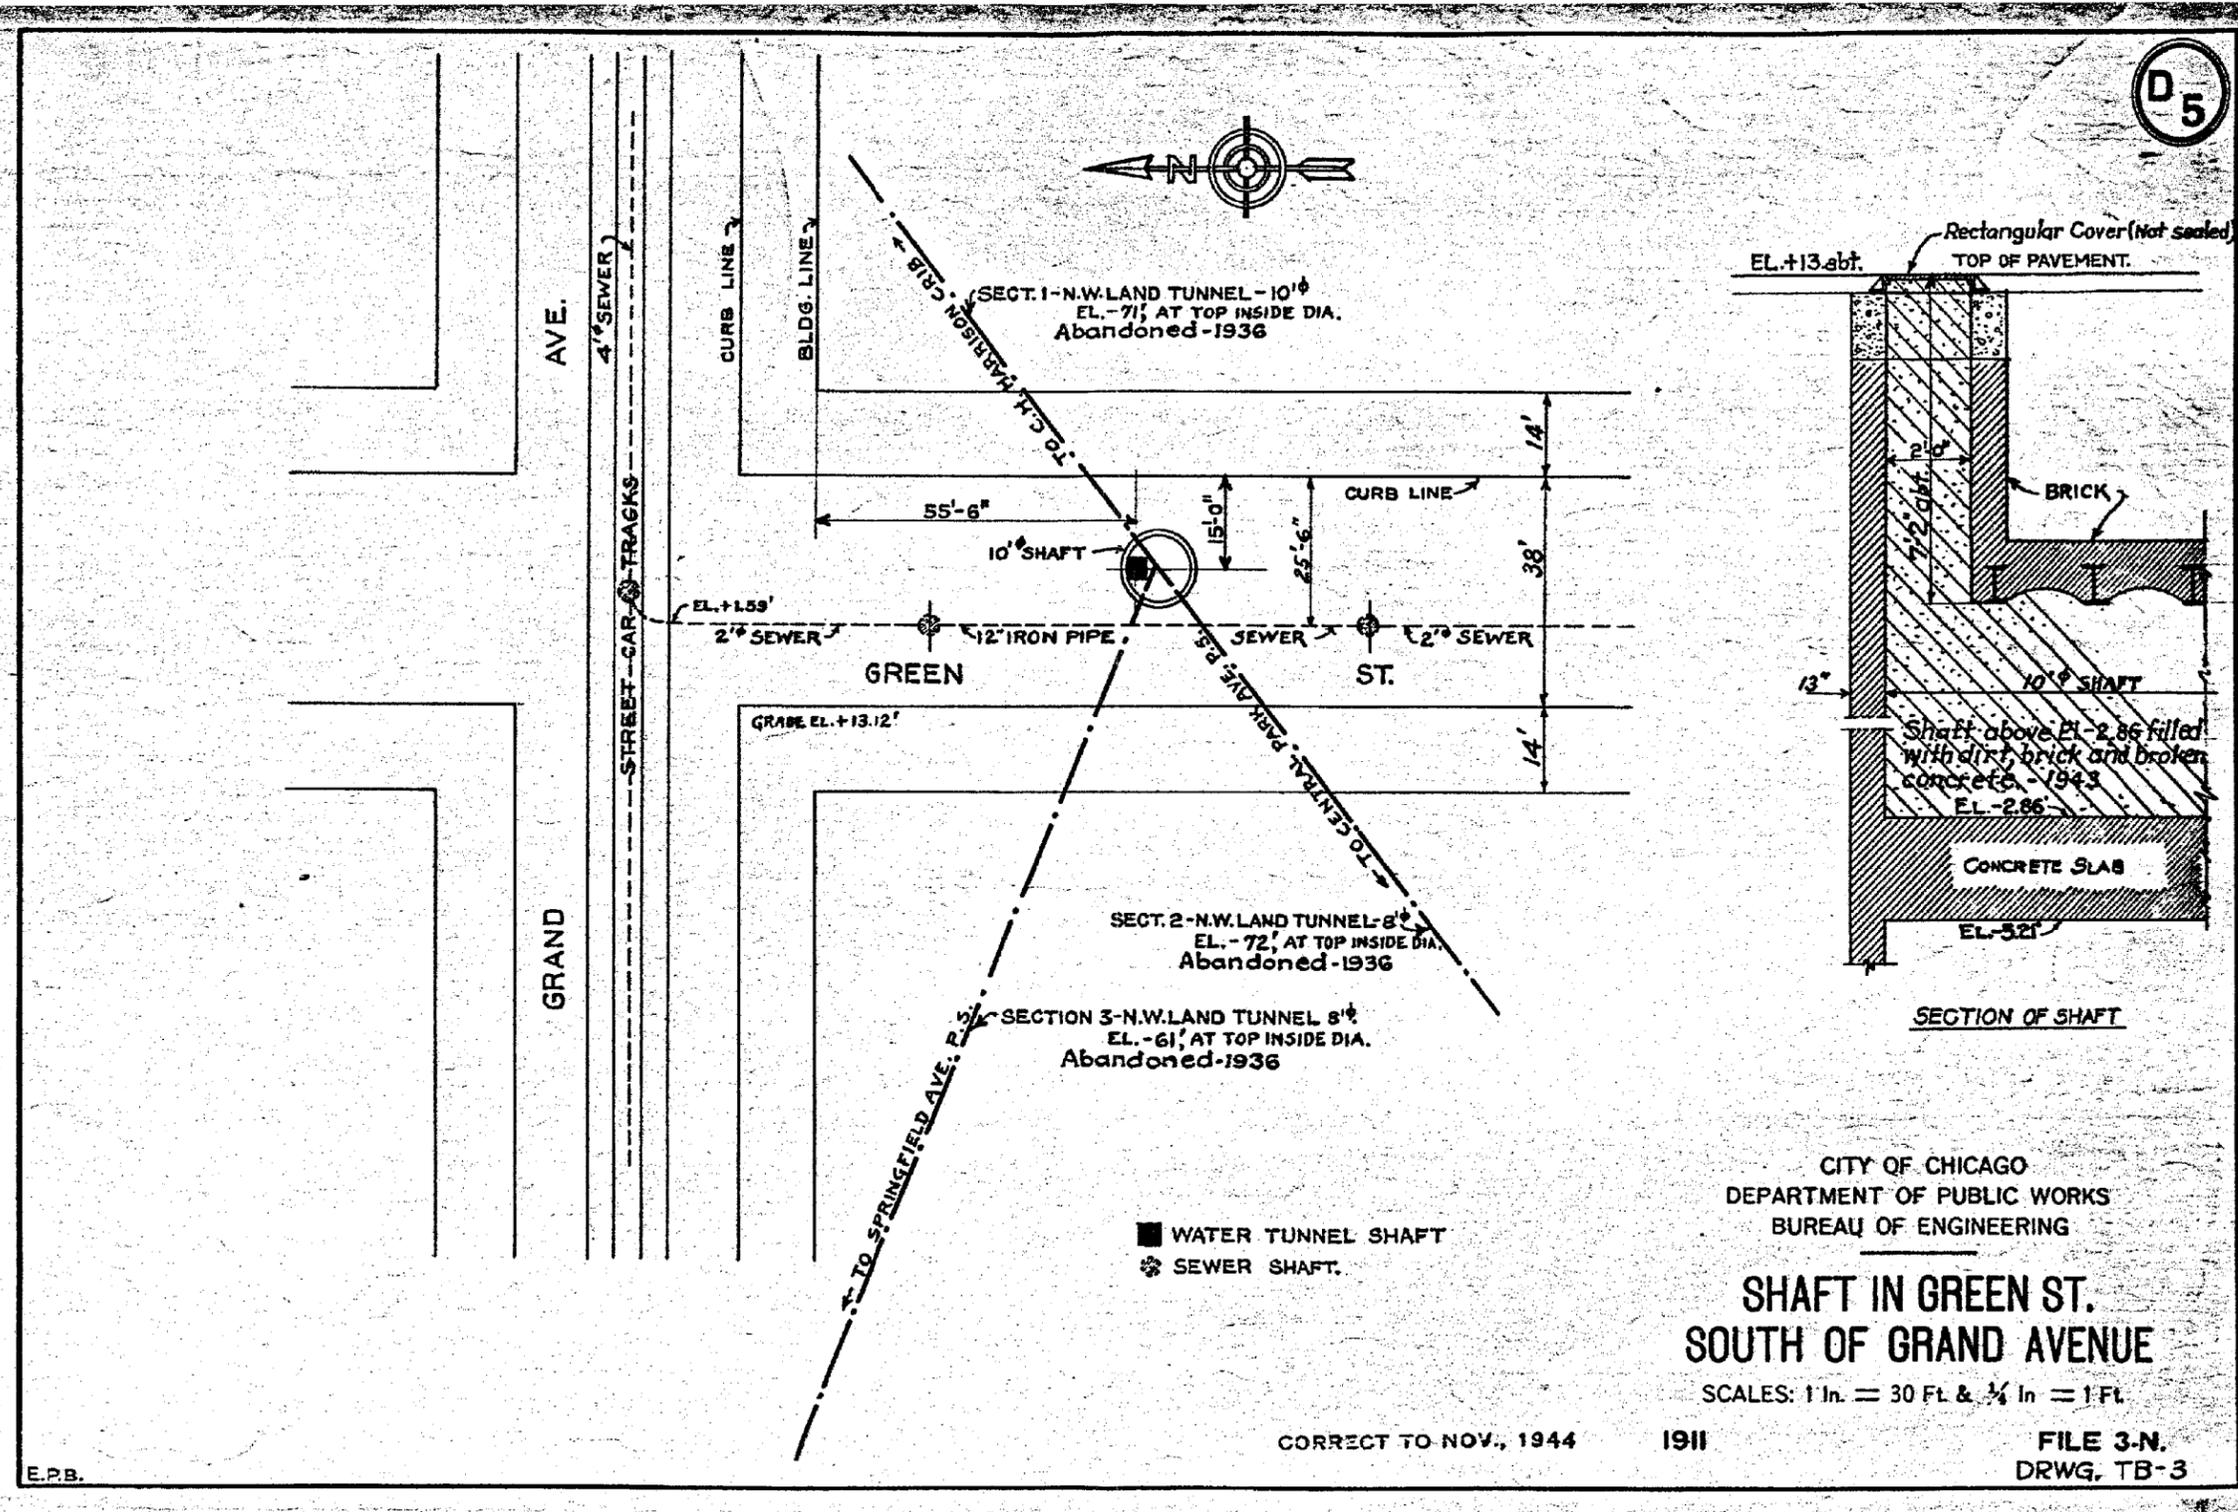

CITY OF CHICAGO
 DEPARTMENT OF PUBLIC WORKS
 BUREAU OF ENGINEERING

**SHAFT IN GREEN ST.
 SOUTH OF GRAND AVENUE**

SCALES: 1 in. = 30 Ft. & 1/4 in. = 1 Ft.

CORRECT TO NOV., 1944 1911

FILE 3-N.
 DRWG. TB-3

- NOTES:
- AS BUILT PLANS OF THE TUNNEL DROPSHAFTS ARE INCLUDED IN THE CONTRACT PLANS FOR CONTRACTOR INFORMATION ONLY. THE CONTRACTOR MAY UTILIZE THIS INFORMATION TO LOCATE THE TUNNEL ENDPOINTS TO ASSIST IN FIELD LOCATING THE EXISTING TUNNEL THROUGH THE PROJECT AREA.
 - THE CONTRACTOR SHOULD BE ADVISED THAT THE TUNNEL DROPSHAFTS ARE PAVED OVER AND MAY NOT BE ABLE TO BE VISUALLY LOCATED.

FOR INFORMATION ONLY

FILE NAME = I:\7000 - 194 at Ohio Street\CADD\CADD SHEETS\SD160663-Bulkhead Detail.dgn

COLLINS ENGINEERS

USER NAME = r9e11	DESIGNED -	REVISED -
PLOT SCALE = 40.000000 ' / in.	DRAWN -	REVISED -
PLOT DATE = 3/25/2013	CHECKED -	REVISED -
	DATE -	REVISED -

STATE OF ILLINOIS
 DEPARTMENT OF TRANSPORTATION

I-90/94 AT OHIO STREET EXISTING WATER TUNNEL BULKHEAD NOTES AND DETAILS			
SCALE:	SHEET NO.	OF SHEETS	STA. TO STA.

F.A.I. RT.E.	SECTION	COUNTY	TOTAL SHEETS	SHEET NO.
90/94	0303-474HB-R	COOK	368	135
CONTRACT NO. 60F63				
FED. ROAD DIST. NO. 1 ILLINOIS FED. AID PROJECT				