




PLAN

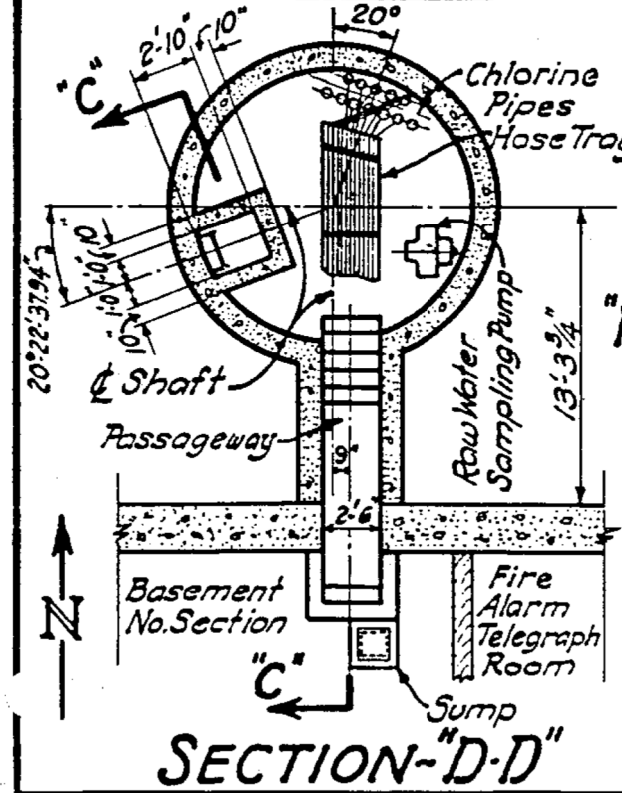


SECTION-D-D

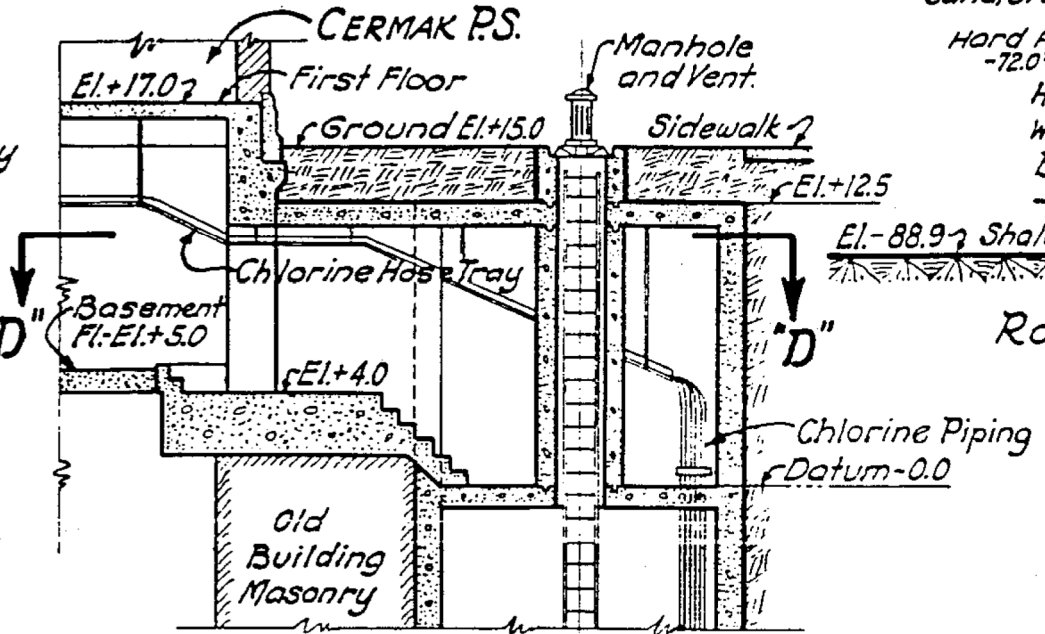

SECTION-C-C
Scale - 1" = 10'-0"

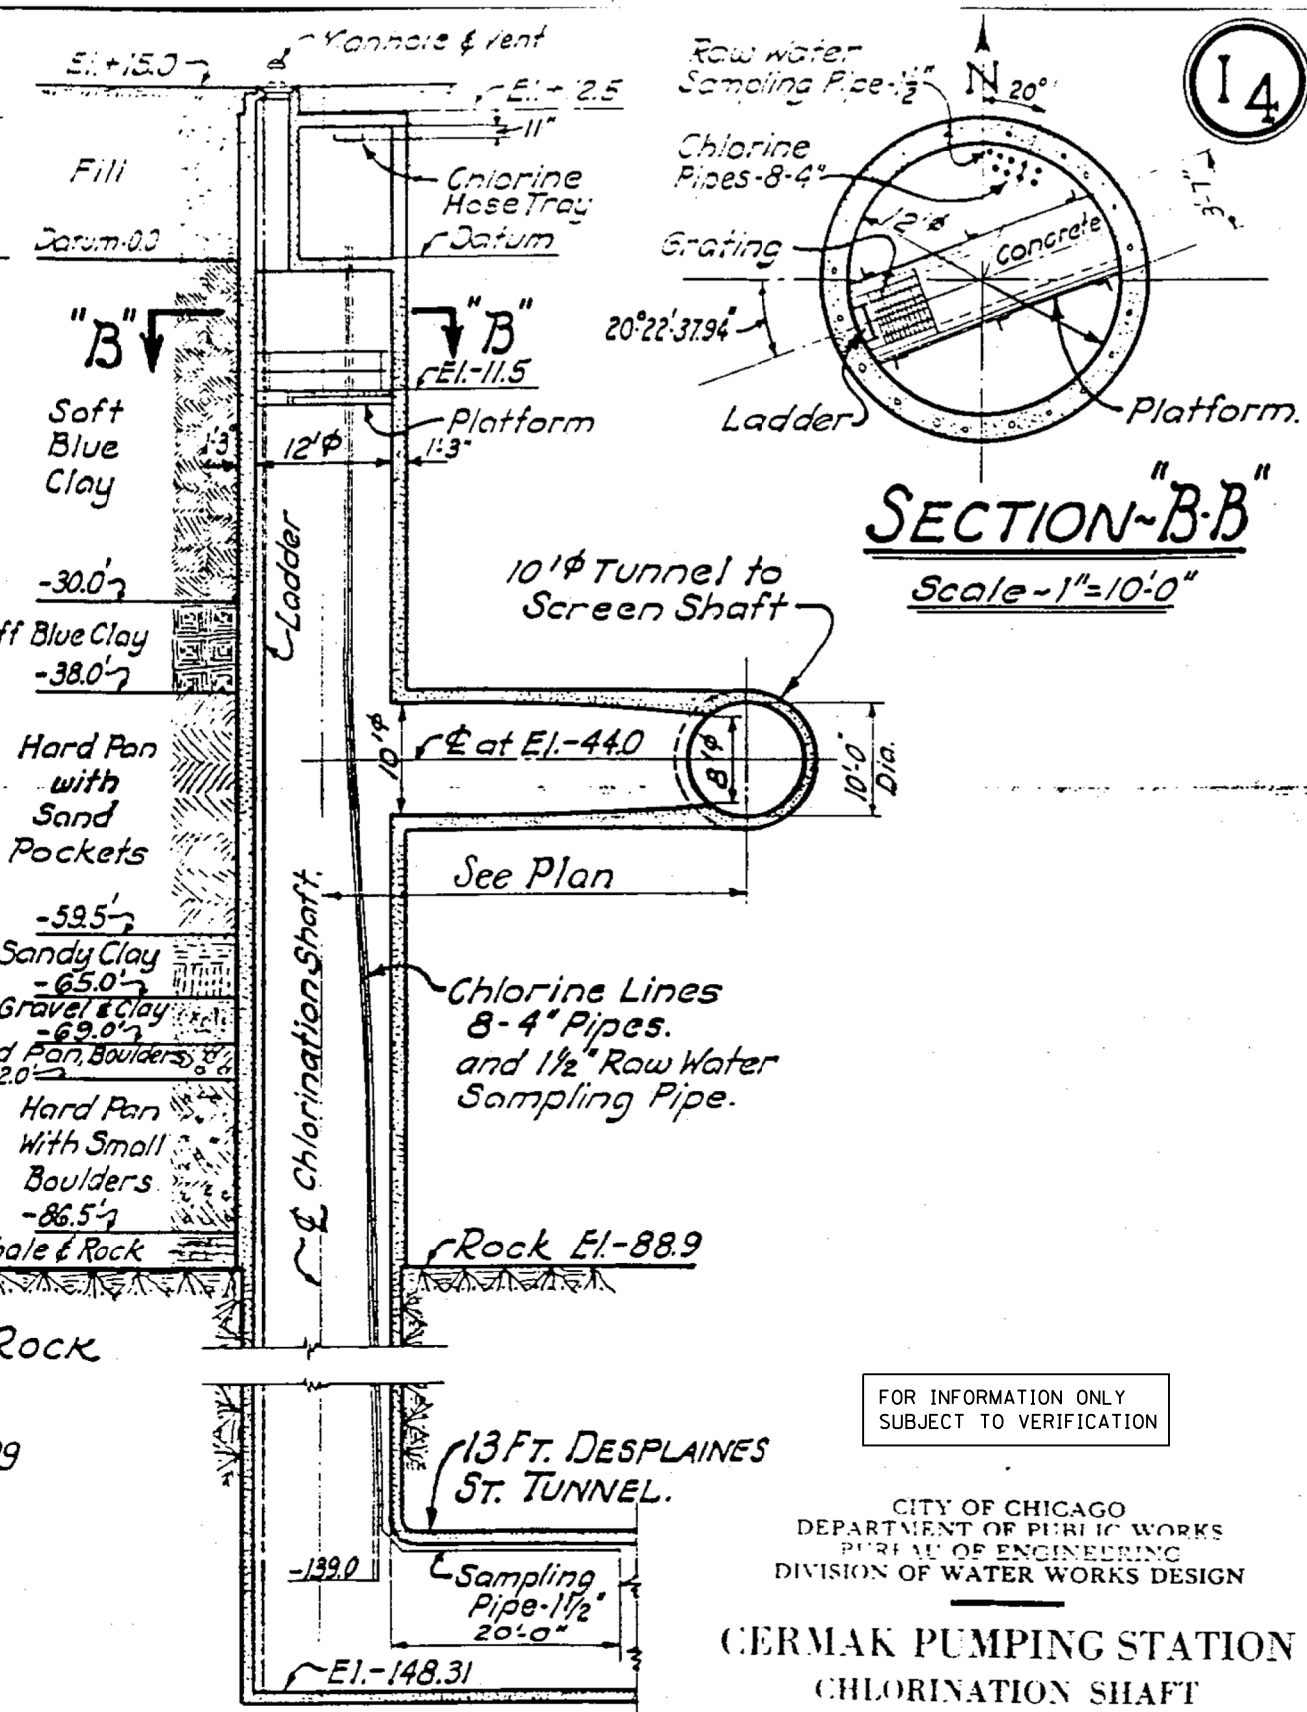

SECTION-A-A

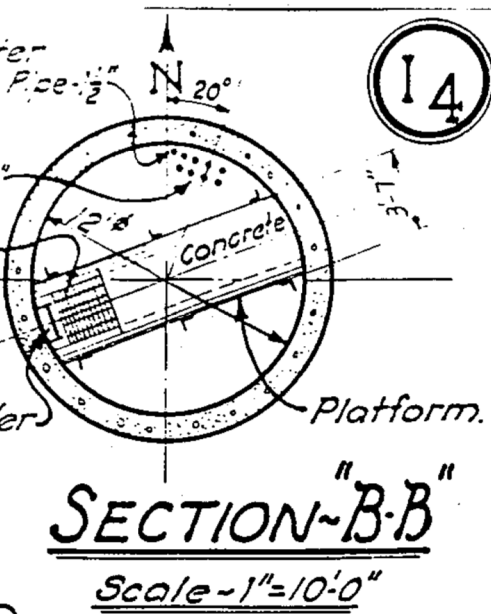

SECTION-B-B
Scale - 1" = 10'-0"

FOR INFORMATION ONLY
SUBJECT TO VERIFICATION

CITY OF CHICAGO
DEPARTMENT OF PUBLIC WORKS
BUREAU OF ENGINEERING
DIVISION OF WATER WORKS DESIGN

**CERMAK PUMPING STATION
CHLORINATION SHAFT**

SCALE: 1 inch = 10 and 20 ft. January 1941
FILE 3-N

FILE NAME = 8FILES

COLLINS ENGINEERS

USER NAME = r9e11
PLOT SCALE = 2.0000 1/ in.
PLOT DATE = 4/12/2013

DESIGNED -
DRAWN -
CHECKED -
DATE -

REVISED -
REVISED -
REVISED -
REVISED -

STATE OF ILLINOIS
DEPARTMENT OF TRANSPORTATION

RECORD DRAWING

SCALE: SHEET NO. OF SHEETS STA. TO STA.

F.A.I. RTE.	SECTION	COUNTY	TOTAL SHEETS	SHEET NO.
90/94	0101.6-2P-1-3 (13)	COOK	37	16
CONTRACT NO. 60W36			FED. ROAD DIST. NO. 1 ILLINOIS FED. AID PROJECT	