
		CONTRACT	NO- 6	0846
F.A RTE.	SECTION	COUNTY	TOTAL SHEETS	SHEET NO.
	99 (182) WRS, 99 (182) WRS-2 82006-031	Will	zze	148
STA.	564+00	TO STA. 5714	00	
FED. RO	DAD DIST. NO.	ILLINOIS FED.	AID PROJ	ECT





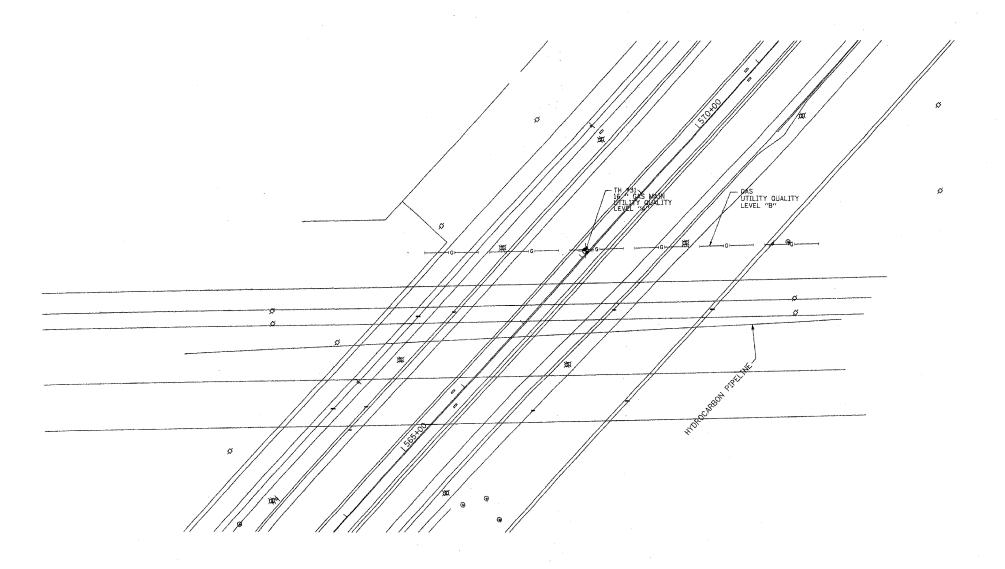

TBE GROUP, INC.

CIVIL ENGINEERING \* TRANSPORTATION \* ENVIRONMENTAL

\* PLANNING \* UTILITY ENGINEERINGLOCATING

GROUP

IL09500132, 142, 158, 229, 245 

->>>>:	FORCE MAIN
	TELEPHONE
	WATER
)	GAS
CTV CTV	CABLE TELEVISION
	FIBER OPTIC
EE	ELECTRIC
-	TEST HOLE

The SBC locations depicted have been obtained through the application of geophysical methods to determine the existence and approximate horizontal position of these facilities. However, SBC will not provide TBE Group, Inc. with utility records nor allow access to their field closures (pedestals/manholes etc.), to help verify the locations of their existing underground facilities. Therefore, TBE is unable to verify the completeness of the SBC locations depicted in accordance with the CI/ASCE Standard 38-02.

Utilities shown on these plans as depicted in the legend have been investigated by TBE Group, Inc in accordance with SUE Industry Standards. All other information shown has been provided to TBE Group, Inc by others. Changes to utilities after dates shown may have been made and therefore may result in variances from this plan. Consideration should be given to updating this plan if deemed advisable prior to final design and construction.


205 W. WACKER DRIVE SUITE 1020 CHICAGO, IL 60606 (312) 704-1970

	S	REVISIO	
ILLINOIS DEPA	DATE	NAME	
SUE Investiga			
I-55/I-80 fr	-		
Section No. 99 (18 Contract No.			

ARTMENT OF TRANSPORTATION

ation of Underground Utilities From US Rt. 30 to Weber Road Will County 1&2) WRS, 99 (1&2) WRS-2 &2006-031 . 62895, 62896, 60846 and 60885

DRAWN BY : KLC