STATE OF ILLINOIS

DEPARTMENT OF TRANSPORTATION

DIVISION OF HIGHWAYS

PROPOSED HIGHWAY PLANS

VARIOUS ROUTES

(1) FAU ROUTE 2786 – LEHIGH AVE. (CENTRAL AVE. TO OAKTON ST.)

(2) FAU ROUTE 1334 – HOWARD ST. (LEHIGH AVE. TO GROSS POINT RD.)


(3) FAU ROUTE 1332 – OAKTON AVE. (CALDWELL ST. TO LONG AVE.)

SECTION: 2000–037RS


RESURFACING (MAINTENANCE)

COOK COUNTY

C-91–144–00

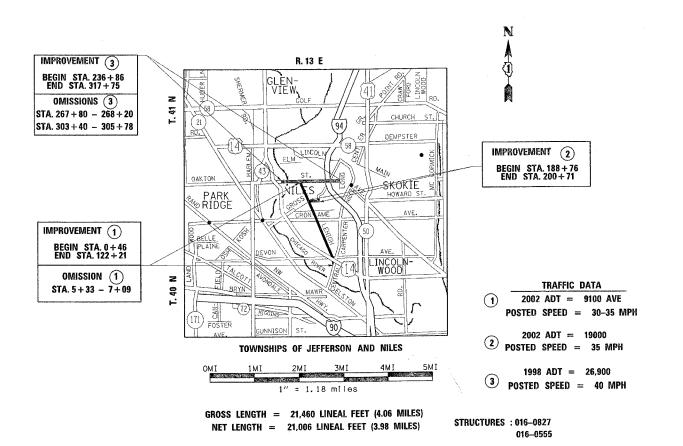



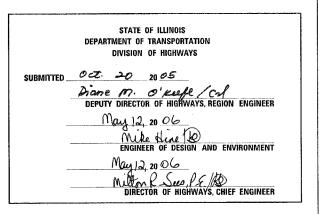

PRINTED BY THE AUTHORITY OF THE STATE OF ILLINOIS

FOR INDEX OF SHEETS, SEE SHEET NO. 2

IMPROVEMENT LOCATED IN THE VILLAGES
OF NILES, MORTON GROVE, SKOKIE
AND THE CITY OF CHICAGO

0 100' 200' 300' -- 1" = 100'
0 10' 20' 30' -- 1" = 10'
0 50' 100' 1" = 50'
0 50' 100' 1" = 40'
0 50' 100' -- 1" = 30' 100' -- 1" = 20'

FULL SIZE PLANS HAVE BEEN PREPARED USING STANDARD

FULL SIZE PLANS HAVE BEEN PREPARED USING STANDARD ENGINEERING SCALES. REDUCED SIZED PLANS WILL NOT CONFORM TO STANDARD SCALES. IN MAKING MEASUREMENTS ON REDUCED PLANS, THE ABOVE SCALES MAY BE USED.

J.U.L.I.E. (JOINT UTILITY LOCATION INFORMATION FOR EXCAVATION 1-800-892-0123 OR CUAN (CHICAGO UTILITY ALERT NETWORK) 1-312-844-7000

CONTRACT NO. 60930

IN PREPARATION ENGINEER: KEN ENG /ISSAM RAYYAN (847) 705-4553

FEO. RO	AD DIST. NO. 1	ILLINOIS	FED.	AID	PROJECT	
STA.		TO	STA.			
*	2000-037	RS	COO	K	58	2
F.A.U.	SECTION	C	TNUO	Y	TOTAL SHEETS	SHEET NO.

***** 2786, 1334, 1332

INDEX OF SHEETS

SI	EET NO.	DESCRIPTION
	1 .	TITLE SHEET
	2	INDEX OF SHEETS, STATE STANDARDS AND GENERAL NOTES
	3-4	SUMMARY OF QUANTITIES
	5-11	TYPICAL SECTIONS
	12	MILLING AT P.C.C. PAVEMENT JOINT AND AT RAILROAD SPUR CROSSINGS
	13-22	PLAN AND PAVEMENT MARKING DETAILS
	23-34	DETECTOR LOOP REPLACEMENT PLANS
	35-39	OAKTON STREET OVER I-94 BRIDGE DETAILS
	40-41	OAKTON STREET OVER N. BRANCH CHICAGO RIVER BRIDGE DETAILS
	42-58	DISTRICT DETAILS

LIST OF STANDARDS

000001-04	STANDARD	SYMBOLS,	ABBREVIATIONS	AND	PATTERNS

420001-06 PAVEMENT JOINTS

420401-05 BRIDGE APPROACH PAVEMENT

442201-01 CLASS C AND D PATCHES

482011-01 BITUMINOUS SHOULDER STRIPS/SHOULDERS WITH RESURFACING

604001-02 FRAME AND LIDS, TYPE 1

604051-02 FRAME AND GRATE, TYPE 11

604056-02 FRAME AND GRATE, TYPE 11V

606001-02 CONCRETE CURB AND COMBINATION CONCRETE CURB AND GUTTER

606206-01 OUTLET AND DOUBLE OUTLET, TYPE 1, FOR TYPE B GUTTER

630001-00 STEEL PLATE BEAM GUARDRAIL

635006-02 REFLECTOR AND TERMINAL MARKER PLACEMENT

701301-02 LANE CLOSURE, 2-L, 2-W, SHORT TIME OPERATIONS

701311-02 LANE CLOSURE, 2-L. 2-W, MOVING DAY ONLY OPERATIONS 701400-02 APPROACH TO LANE CLOSURE FREEWAY/EXPRESSURY

701501-03 URBAN LANE CLOSURE, 2-L, 2-W, UNDIVIDED

701401-03 LANECLOSURE, FREEWAY/EXPRESSWAY

701601-04 URBAN LANE CLOSURE, MULTILANE 1W OR 2W WITH NONTRAVERSABLE MEDIAN

701440 TWO-LANE CLOSURE - FREEWAY / EXPRESSWAY
701606-04 URBAN LANE CLOSURE, MULTILANE, 2W, WITH MOUNTABLE MEDIAN

701701-04 LIRBAN LANE CLOSURE, MULTILANE INTERSECTION

701801-03 LANE CLOSURE, MULTILANE 1W OR 2W CROSSWALK OR SIDEWALK CLOSURE

702001-00 TRAFFIC CONTROL DEVICES

780001-01 TYPICAL PAVEMENT MARKINGS

886001 DETECTOR LOOP INSTALLATIONS

886006 TYPICAL LAYOUT FOR DETECTOR LOOPS

CHICAGO NOTES

PERMITS FROM THE DEPARTMENT OF SEWERS ARE REQUIRED FOR ALL UNDERGROUND STORM, SANITARY OR COMBINED SEWER SYSTEM CONSTRUCTION, AND FOR ALL WORK INVOLVING ADJUSTMENT OF SEWER STRUCTURES. THE DEPARTMENT OF SEWERS' PERMIT MUST BE OBTAINED BY A LICENSED SEWER DRAIN LAYER PRIOR TO START OF CONSTRUCTION. THE LICENSED SEWER CONTRACTOR/SUBCONTRACTOR MUST SUBMIT TWO SETS OF PLANS APPROVED BY THE DEPARTMENT OF SEWERS FOR THE ISSUE OF THE SEWER PERMIT TO SUITE 400, 333 SOUTH STATE STREET, CHICAGO, IL 60604-3971. INSPECTION WILL BE PROVIDED BY THE DEPARTMENT OF SEWERS.

IN CASE OF DAMAGE TO CITY OF CHICAGO SEWERS, PRIVATE AND PUBLIC DRAINS, SEWER STRUCTURES AND/OR BENCH MONUMENTS, THE CONTRACTOR SHALL IMMEDIATELY CONTACT THE DEPARTMENT OF SEWERS AT (312)747-7892 OR (312)747-7893.

PREFORMED LIDS SHALL BE PLACED ON ALL MANHOLES AND CATCH

BENCH MONUMENT LOCATIONS WITHIN THE LIMITS OF THE IMPROVEMENT CAN BE OBTAINED FROM THE DEPARTMENT OF SEWERS AT SUITE 400, 333 SOUTH STATE STREET, CHICAGO, IL 60604-3971. THE CONTRACTOR IS RESPONSIBLE FOR THE COST OF REPLACING ANY BENCH MONUMENT DAMAGED OR DESTROYED DURING CONSTRUCTION.

SIDEWALK ACCESSIBILITY RAMPS SHALL NOT BE CONSTRUCTED DIRECTLY OVER EXISTING OR PROPOSED DRAINAGE STRUCTURES

ALL BROKEN, CRACKED, WORN OR OTHERWISE DAMAGED OR BICYCLE UNSAFE FRAMES AND GRATES OR LIDES ON THE SEWER STRUCTURES SHALL BE REPLACED WITH THE NEW DEPARTMENT OF SEWERS' STANDARD FRAMES AND GRATES OR LIDS. OLD FRAMES AND GRATES OR LIDS SHALL BE DELIVERED TO THE DEPARTMENT OF SEWERS AT 39TH STREET AND

CITY OF CHICAGO WATER VALVE VAULTS AND SEWER STRUCTURES SHALL NOT BE CLOSED, COVERED OR OTHERWISE OBSTRUCTED DURING CONSTRUCTION WITHOUT WRITTEN PERMISSION FROM THE CITY OF CHICAGO DEPARTMENT OF WATER AND/OR DEPARTMENT

CURB AND GUTTER CONSTRUCTION SHALL PROVIDE A MINIMUM CURB HEIGHT OF 75 MM (3").

BACKFILL MATERIAL LINDER SIDEWALKS SHALL BE FA-2.

PAVEMENT REPLACEMENT AROUND FRAMES AND GRATES OR LIDS WHERE DRAINAGE, WATER MAIN OR ELECTRICAL STRUCTURES ARE ADJUSTED OR RECONSTRUCTED, SHALL WITH CLASS SI CONCRETE.

ALL PAVEMENT PATCHING SHALL BE CLASS D

ALL UNBALLASTED TYPE I & TYPE II BARRICADES SHALL HAVE TWO SANDBAGS ON THE BOTTOM RAIL

GENERAL NOTES

BEFORE STARTING ANY EXCAVATION, THE CONTRACTOR SHALL CALL "JULIE" AT 800-892-0123 OR CUAN (CHICAGO UTILITY ALERT NETWORK) 312-744-7000 FOR FIELD LOCATIONS OF BURIED ELECTRIC, TELEPHONE AND GAS FACILITIES. (48 HOUR NOTIFICATION IS REQUIRED)

3 METER (10 FEET) TRANSITIONS SHALL BE USED TO MATCH PROPOSED CURB AND GUTTER AND MEDIAN ITEMS OF WORK TO EXISTING CURBS AND GUTTERS AND MEDIANS IN THE FIELD, UNLESS OTHERWISE SHOWN. THE TRANSITIONS SHALL BE PAID FOR AT THE CONTRACT UNIT PRICE FOR THE PROPOSED ITEMS OF WORK SPECIFIED

THE CONTRACTOR SHALL COORDINATE CONSTRUCTION ACTIVITIES WITH UTILITY COMPANIES, THE VILLAGES OF NILES, MORTON GROVE, SKOKIE, LINCOLNWOOD AND THE CITY OF CHICAGO.

THE CONTRACTOR WILL NOT BE ALLOWED TO SET UP A YARD OR FIELD OFFICE ON STATE PROPERTY WITHOUT WRITTEN PERMISSION FROM

WHEN MILLED PAVEMENT IS OPEN TO TRAFFIC THE MAXIMUM GRADE DIFFERENTIAL BETWEEN PASSES OF THE MILLING MACHINE SHALL NOT EXCEED 40 MM (1/2 INCHES) WHERE THE SPEED LIMIT IS 80 KM/H (45 MPH) OR LESS AND 25 MM (1 INCH) WHERE THE SPEED LIMIT IS GREATER THAN 80 KM/H (45 MPH). WITH WRITTEN APPROVAL FROM THE ENGINEER, A MAXIMUM GRADE DIFFERENTIAL OF 75 MM (3 INCHES) MAY BE ALLOWED IF THE EDGE OF THE MILLING IS SLOPED A MINIMUM.

BUTT JOINTS WILL BE INSTALLED: AT THE ENDS OF ALL RESURFACING WHERE RESURFACING MEETS EXISTING PAVEMENT), IN ACCORDANCE
WITH THE "BUTT JOINT AND BITUMINOUS TAPER DETAILS" SHEET INCLUDED IN THE PLANS, UNLESS OTHERWISE SPECIFIED.

THE RESIDENT ENGINEER SHALL CONTACT WALTER CZARNY AREA TRAFFIC FIELD ENGINEER AT (773) 685-8386 A MINIMUM OF 2 WEEKS PRIOR TO PLACEMENT OF PERMANENT PAVEMENT MARKINGS

THE CONTRACTOR SHALL BE REQUIRED TO COMPLETE ALL PAVEMENT PATCHING AFTER THE BITUMINOUS SURFACE REMOVAL OPERATION

ALL PAVEMENT MARKINGS SHALL BE PLACED THROUGHOUT THE IMPROVEMENT ACCORDING TO DISTRICT 1 TYPICAL PAVEMENT MARKING

RAISED REFLECTIVE PAVEMENT MARKERS SHALL BE PLACED THROUGHOUT THE IMPROVEMENT ACORDING TO THE DISTRICT STANDARDS AS NOTED IN

THE RESIDENT ENGINEER SHALL VERIFY ALL EXISTING PAVEMENT MARKINGS BEFORE MILLING

> ILLINOIS DEPARTMENT OF TRANSPORTATION INDEX OF SHEETS, LIST OF STANDARDS, CHICAGO NOTES AND GENERAL NOTES SCALE: VERT. DRAWN BY RN DATE 3/30/200 CHECKED BY

c:\projects\dll4400\dll4400aa.m32 julllaumef.p

SECTION

2000-037RS

COUNTY

58

	and the state of t					100% ST	ATE									786, 1334, 13 -100% STA		HIGHWA	PRO
	SUMMARY OF QUANTITIES					CONSTRUC	TION TYPE (CODE			SUMMARY OF QUANTITIES				· · · · · · · · · · · · · · · · · · ·		ION TYPE (
	ITEM	UNIT	URBAN TOTAL QUANTITIES	#1 LEHIGH AVE.	#2 HOWARD ST. IOOO	#3 OAKTON AVE. 1000	SN 016-0555 #3 OVER CHC RIVER SFTY-2A	#3 OVER I-94	50 CITY 50% STATE Y025	CODE NO	ITEM	UNIT	URBAN TOTAL QUANTITIES	#1 LEHIGH AVE. IOOO	#2 HOWARD ST. IOOO	#3 OAKTON AVE. IOOO	SN 016-0555 #3 OVER CHC RIVER SFTY-2A	#3 OVER I-94	
GRAD.	NG AND SHAPING SHOULDERS	UNIT	13	13						55039700	STORM SEWERS TO BE CLEANED	F00T	2700	1000		1700			
REMO	AL AND DISPOSAL OF UNSUITABLE MATERIAL	CU YD	. 6			6				58100200	WATERPROOFING MEMBRANE SYSTEM	SQ FT	1294					1294	
GRAD	NG AND SHAPING DITCHES	FOOT	328	328				 		60250200	CATCH BASINS TO BE ADJUSTED	EACH	12	1	9	2		:	
BITU	INOUS MATERIALS (PRIME COAT)	TON	41	16. 65	4	20			0. 35	60251500	CATCH BASINS TO BE ADJUSTED WITH NEW TYPE 11 FRAME AND GRATE	EACH	8			. 8			
AGGRI	GATE (PRIME COAT)	TON	198	78	17	100		}	3	60252800	CATCH BASINS TO BE RECONSTRUCTED	EACH	. 3	1	1	1		:	
MIXT	RE FOR CRACKS, JOINTS, AND FLANGEWAYS	TON	10	4	1	5				60254100	CATCH BASINS TO BE RECONSTRUCTED WITH NEW TYPE 11 FRAME AND GRATE	EACH	4			4		-	
	RUCTING TEST STRIP	EACH	2	1		1				60255500	MANHOLES TO BE ADJUSTED	EACH	1			1			
				555	98	548		1		60260100	INLETS TO BE ADJUSTED	EACH	2			2			
100	INOUS SURFACE REMOVAL - BUTT JOINT	SQ YD	1201							60300105	FRAMES AND GRATES TO BE ADJUSTED	EACH	60			60			
	INOUS REPLACEMENT OVER PATCHES	TON	1892	395	97	1400				60300310	FRAMES AND LIDS TO BE ADJUSTED (SPECIAL)	EACH	131	68	21	42			
PROTI	CTIVE COAT	SQ YD	1297	1037	100	160				60403500	GRATES, TYPE B	EACH	6	6	-				
BITU	INOUS SURFACE REMOVAL 1 1/2"	SQ YD	31165	22184.5	8175				805. 5	60404805	FRAMES AND GRATES, TYPE 11V	EACH	5	5					
BITU	INOUS SURFACE REMOVAL 2 1/2"	SQ. YD	47162			47162	-				FRAMES AND LIDS, TYPE 1, OPEN LID	EACH	62		2	60			
BITU	INOUS SURFACE REMOVAL 3"	SQ YD	507				507			60406000			2		2				
BITU	INOUS SURFACE REMOVAL (VARIABLE DEPTH)	SQ YD	357	357						60406100	FRAMES AND LIDS, TYPE 1, CLOSED LID	EACH CU YD	9.6	9. 6	_				
BITUN	INOUS REMOVAL OVER PATCHES 11/2"	SQ YD	5825	4700	1125					60600095	CLASS SI CONCRETE (OUTLET)	FOOT	2624	2624					
BITUN	INOUS REMOVAL OVER PATCHES 6"	SQ YD	4000			4000				60602800	CONCRETE GUTTER, TYPE B					100		,	
GUTTE	R REMOVAL	FOOT	2624	2624						60605000	COMBINATION CONCRETE CURB AND GUTTER, TYPE B-6.24	FOOT	100	i		100		·	
сомві	NATION CURB AND GUTTER REMOVAL	F00T	200			200		1		63000000	STEEL PLATE BEAM GUARD RAIL, TYPE A	FOOT	25			25			
	NATION CONCRETE CURB AND GUTTER AL AND REPLACEMENT	F00T	1567	487	300	780				63100167	TRAFFIC BARRIER TERMINAL TYPE 1, SPECIAL (TANGENT)	EACH	1			1			
MEDIA	N REMOVAL PARTIAL DEPTH	SQ FT	5378	5378						63200310	GUARDRAIL REMOVAL	FOOT	75			75			
CLASS	D PATCHES, TYPE II, 8 INCH	SQ YD	335		335				ļ., l	67000400	ENGINEER'S FIELD OFFICE, TYPE A	CAL MO	5	2	1	2			
CLASS	D PATCHES, TYPE III, 8 INCH	SQ YD	196		196					67100100	MOBILIZATION	L SUM	1	0.35	0.2	0.45			
CLASS	D PATCHES, TYPE IV, 8 INCH	SQ YD	110		110					70103815	TRAFFIC CONTROL SURVEILLANCE	CAL DA	30	15		15			
	D PATCHES, TYPE I, 10 INCH	SQ YD	8	8	·					70102620	TRAFFIC CONTROL AND PROTECTION, STANDARD 701501	L SUM	1	0.35	0. 20	0.45			
CLASS	D PATCHES, TYPE II, 10 INCH	SQ YD	3879	1791		2088				70102625	TRAFFIC CONTROL AND PROTECTION,	L SUM	1	0. 35	0.20	0.45			
CLASS	D PATCHES, TYPE III, 10 INCH	SQ YD	890	186		704				70102630	TRAFFIC CONTROL AND PROTECTION,	L SUM	1	0.50	0.50				
CLASS	D PATCHES, TYPE IV, 10 INCH	SQ YD	2909	2189		720			.	70102635	STANDARD 701601 TRAFFIC CONTROL AND PROTECTION,	L SUM	1	0. 35	0. 20	0.45			
AGGRE	GATE SHOULDERS, TYPE B	TON	396	396		İ					STANDARD 701701	1 6:11:				•		,	
BITUN	INOUS SHOULDERS 6"	SQ YD	40			40				70102640	TRAFFIC CONTROL AND PROTECTION, STANDARD 701801	L SUM	1		}			,	
BITUN	INOUS SHOULDERS 8"	SQ YD	250	250						70300100	SHORT-TERM PAVEMENT MARKING	FOOT	21989	7950	605	13434			
CONCR	ETE REMOVAL	CU YD	9.6	9.6				54		70300210	TEMPORARY PAVEMENT MARKING	SQ FT	2373	363	370	1640			
	FURAL REPAIR OF CONCRETE (DEPTH EQUAL LESS THAN 5")	SQ FT	246					246		70300220	- LETTERS AND SYMBOLS TEMPORARY PAVEMENT MARKING - LINE 4"	FOOT	67048	28030	3018	36000			

* SPECIALTY ITEM

CODE NO

20201006

20201200 21400100

40600200

40600300 40600400

40600895

40600980

40601000

42001300

44000006

44000008

44000030

44000106

44000124

44000400

44000500

44001700

44003510

44201741

44201745

44201747

44201761

44201765

44201769

44201771

48101200 48200400

48200600

50102400

REVISIONS SUMMARY OF QUANTITIES

SECTION

COUNTY

2000-037RS COOK 58 FED. ROAD DIST. NO. 1 ILLINOIS HIGHWAY PROJECT 2786, 1334, 1332 -100% STATE--100% STATE-CONSTRUCTION TYPE CODE CONSTRUCTION TYPE CODE SUMMARY OF QUANTITIES SUMMARY OF QUANTITIES 50 CITY URBAN SN # 3 TOTAL 016-0555 016-0827 016-0555 016-0827 50% STATE TOTAL LEHIGH HOWARD OAKTON LEHIGH HOWARD OAKTON #3 OVER #3 OVER CODE NO ITEM UNIT QUANTITIES #3 OVER #3 OVER CODE NO ITEM UNIT QUANTITIES AVE. ST. AVE. AVE. ST. AVE. CHC RIVER CHC RIVER 1-94 1000 1000 1.000 0001 1000 1000 SFTY-2A SFTY-2A SFTY-2A SFTY-2A Y025 TEMPORARY PAVEMENT MARKING - LINE 6" X7011015 TRAFFIC CONTROL AND PROTECTION (EXPRESSWAYS) L SUM 70300240 FOOT 7549 2763 746 4040 26 DECK SLAB REPAIR (FULL DEPTH, TYPE I) Z0016001 70300250 TEMPORARY PAVEMENT MARKING - LINE 8" F00T DECK SLAB REPAIR (FULL DEPTH, TYPE II) SQ YD 175 175 Z0016002 70300260 TEMPORARY PAVEMENT MARKING - LINE 12" F00T 1424 224 1200 39 Z0016200 DECK SLAB REPAIR (PARTIAL) SQ YD 70300280 TEMPORARY PAVEMENT MARKING - LINE 24" FOOT 1469 535 183 751 **EACH** 143 DRAINAGE STRUCTURES TO BE CLEANED Z0018500 WORK ZONE PAVEMENT MARKING REMOVAL 21500 70301000 SQ FT 36305 13170 1635 107 Z0037620 PAVEMENT RELIEF JOINT, REMOVE AND REPLACE SQ FT 107 78000100 THERMOPLASTIC PAVEMENT MARKING SQ FT 1553 363 370 820 RAILROAD PROTECTIVE LIABILITY INSURANCE L SUM 0.1 Z0048665 LETTERS AND SYMBOLS POUND 865 50501130 STRUCTURAL STEEL REPAIR 78000200 THERMOPLASTIC PAVEMENT MARKING - LINE 4" FOOT 67048 28030 3018 6000 98 FOOT SILICONE JOINT SEALER, 2' THERMOPLASTIC PAVEMENT MARKING - LINE 6" X0321744 78000400 FOOT 7549 2763 4040 746 130 78000500 THERMOPLASTIC PAVEMENT MARKING - LINE 8" FOOT X0323077 SILICONE JOINT SEALER, 2 3/4" FOOT 130 78000600 THERMOPLASTIC PAVEMENT MARKING - LINE 12" FOOT 1424 224 1200 THERMOPLASTIC PAVEMENT MARKING - LINE 24" 78000650 FOOT 535 183 1469 78100100 RAISED REFLECTIVE PAVEMENT MARKER EACH 1079 229 81 769 TERMINAL MARKER - DIRECT APPLIED 78201000 EACH 78300200 RAISED REFLECTIVE PAVEMENT MARKER REMOVAL EACH 127 90 37 DETECTOR LOOP REPLACEMENT 2246 88600600 FOOT 3345 776 323 87301305 ELECTRIC CABLE IN CONDUIT, LEAD-IN, FOOT 1060 1060 NO. 14 1 PAIR DRILL EXISTING HANDHOLE 87900200 EACH 88600100 DETECTOR LOOP, TYPE I FOOT 174 174 89502300 REMOVE ELECTRIC CABLE FROM CONDUIT FOOT 916 916 X0320887 POLYMER CONCRETE CU FT 9.5 PROTECTIVE SHIELD (PERMANENT) SQ YD - 750- X0322256 TEMPORARY INFORMATION SIGNING SQ FT 155 270.4 51.4 67.5 BITUMINOUS CONCRETE SURFACE COURSE, X4066426 4307 TON 3548.5 691 SUPERPAVE, MIX "D", N70 X4066548 POLYMERIZED BITUMINOUS CONCRETE SURFACE TON 4817 4622 145 COURSE, SUPERPAVE, MIX "F", N90 POLYMERIZED LEVELING BINDER (MACHINE X4067100 TON 3703 1284 350 2034 35 METHOD), SUPERPAVE, IL-4.75, N50 X4400100 PORTLAND CEMENT CONCRETE SURFACE SQ YD 10780 10780 REMOVAL (VARIABLE DEPTH) BITUMINOUS CONCRETE REMOVAL (DECK) 44000910 SO YD 1525 1525 PARTIAL DEPTH PATCHING X4421000 TON 163 PARTIAL DEPTH REMOVAL 2" SQ YD X4422025 1453 1453

. SPECIALTY ITEM


REVISIONS DATE


ILLINOIS DEPARTMENT OF TRANSPORTATION SUMMARY OF QUANTITIES

PLOT DATE: 3/30/2006


F.A.U. RTE.	SECTION	COUNTY	TOTAL	SHEET NO.
*	2000-037RS	COOK	58	5
STA.	0+46	TO STA. 16+4	8	
FED. RC	DAD DIST. NO. 1 ILLIN	OIS FED. AID	PROJECT	

* 2786, 1334, 1332

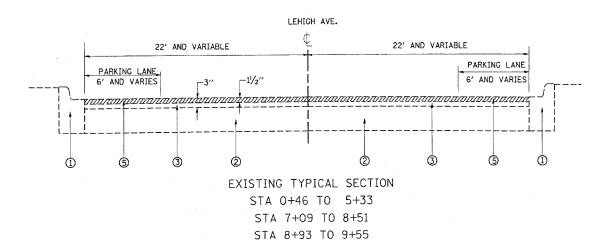

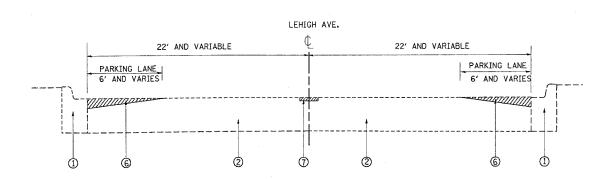

EXISTING TYPICAL SECTION STA 9+55 TO 16+48

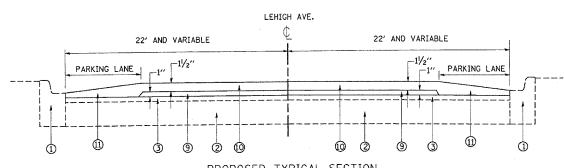

PROPOSED TYPICAL SECTION STA 0+46 TO 5+33 STA 7+09 TO 8+51 STA 8+93 TO 9+55

AIR VOIDS (%)

2.5% @ 50 GYR

4% @ 70 GYR

4% @ 70 GYR

4% @ 70 GYR

4% @ 70 GYR

BITUMINOUS MIXTURE REQUIREMENTS

AC TYPE

SBS/SBR

PG 64-22

PG 64-22

PG 64-22


NOTE: THE UNIT WEIGHT USED TO CALCULATE BITUMINOUS

SURFACE MIXTURE QUANTITIES IS 112 LBS/SQYD/IN

MAX RAP. (%)

15%

15%

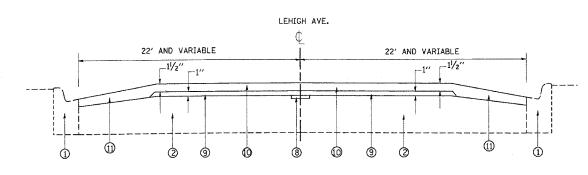

LEGEND

PROPOSED TYPICAL SECTION

STA 9+55 TO 16+48

- (1) EXISTING COMB. CURB AND GUTTER TYPE B-6.12
- (2) EXISTING PCC PAVEMENT (10" AND VARIES)
- 3 EXISTING BIT. AFTER MILLING SURFACE, 11/2"
- (4) EXISTING CONCRETE MEDIAN
- (5) PROP. BIT. SURFACE REMOVAL, 11/2"
- 6 PROP. PCC SURFACE REMOVAL (VAR. DEPTH), SEE DISTRICT DETAIL BD-33
- 7 PROP. PARTIAL DEPTH REMOVAL, 2"
- (8) PROP. POLYMERIZED LEVELING BINDER (MM), SUPERPAVE, IL-4.75, N50, 2"
- 9 PROP. POLYMERIZED LEVELING BINDER (MM), SUPERPAVE, IL-4.75, N50, 1"
- (10) PROP. BIT. CONC. SURFACE COURSE, SUPERPAVE, MIX "D", N70, $1\frac{1}{2}$ "
- (1) PROP. BIT. TAPER AT EDGE OF P.C.C. PAVEMENT (SEE DISTRICT DETAIL BD-33)
- (12) EXISTING AGGREGATE SHOULDER
- 13 PROP. AGGREGATE SHOULDER, TYPE B
- (14) PROP. MEDIAN REMOVAL (PARTIAL DEPTH)
- 15 EXISTING GUTTER, TYPE B
- (6) PROP. BIT SHOULDERS, SUPERPAVE, 8"

ILLINOIS DEPARTMENT OF TRANSPORTATION
TELINOIS DEPARTMENT OF TRANSFORTATION
LEHIGH AVE. (CENTRAL AVE. TO OAKTON AVE.) EXISTING AND PROPOSED

TYPICAL SECTION SCALE: VERT. NONE

DRAWN BY: RK

DATE 10/27/2005

IO/27/2005 c:\projects\dii4400\dii4400aa.m32 gulliaumefp

MIXTURE USE

BIT. CONC. SURFACE COURSE, SUPERPAVE, MIX "D" N70

CLASS D PATCHES

POLYMERIZED LEVELING BINDER(MM), SUPERPAVE, IL-4.75, N50


BIT. REPLACEMENT OVER PATCHES (BINDER IL-19)

BITUMINOUS SHOULDERS, 6" & 8"


*REF-




FED. ROAD DIST. NO. 1 ILLINOIS FED. AID PROJECT

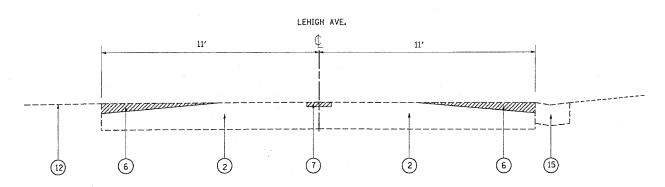


EXISTING TYPICAL SECTION STA 16+48 TO 60+48 STA 77+41 TO 85+16 STA 103+59 TO 116+13

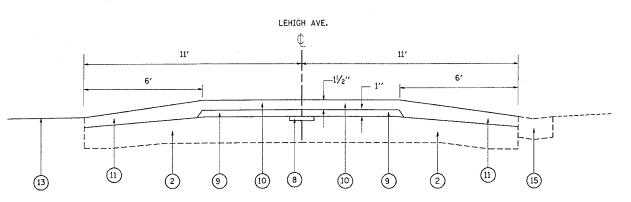


PROPOSED TYPICAL SECTION STA 16+48 TO 60+48 STA 77+41 TO 85+16 STA 103+59 TO 116+13

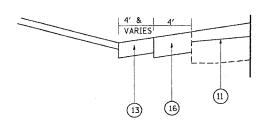

PROPOSED TYPICAL SECTION STA 81+25 TO 87+72 STA 111+16 TO 116+13

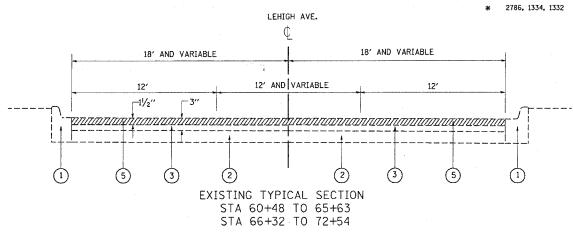

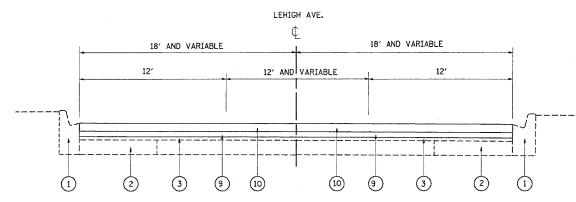

PROPOSED TYPICAL SECTION STA 60+48 TO 65+53 STA 66+32 TO 72+54

LEGEND

- 1 EXISTING COMB. CURB AND GUTTER TYPE B-6.12
- 2 EXISTING PCC PAVEMENT (10" AND VARIES)
- \bigcirc EXISTING BIT. AFTER MILLING SURFACE, $1\frac{1}{2}$ "
- 4 EXISTING CONCRETE MEDIAN
- 5) PROP. BIT. SURFACE REMOVAL, 11/2"
- (6) PROP. PCC SURFACE REMOVAL (VAR. DEPTH), SEE DISTRICT DETAIL BD-33
- 7 PROP. PARTIAL DEPTH REMOVAL, 2"
- (8) PROP. POLYMERIZED LEVELING BINDER (MM), SUPERPAVE, IL-4.75, N50, 2"
- PROP. POLYMERIZED LEVELING BINDER (MM), SUPERPAVE, IL-4.75, N50, 1"
- (10) PROP. BIT. CONC. SURFACE COURSE, SUPERPAVE, MIX "D", N70, $1\frac{1}{2}$ "
- (1) PROP. BIT. TAPER AT EDGE OF P.C.C. PAVEMENT (SEE DISTRICT DETAIL BD-33)
- 12 EXISTING AGGREGATE SHOULDER
- [3] PROP. AGGREGATE SHOULDER, TYPE B
- (4) PROP. MEDIAN REMOVAL (PARTIAL DEPTH)
- (15) EXISTING GUTTER, TYPE B
- (6) PROP. BIT SHOULDERS, SUPERPAVE, 8"


REVISIO	NS	TILINOIS DEPARTMEN	T OF TRANSPORTATION
NAME	DATE	TECTHOTS DELAKTMEN	TOP TRANSPORTATION
			H AVE.
			TO OAKTON AVE.)
			ND PROPOSED
		TYPICA	L SECTION
		SCALE: VERT. NONE	DRAWN BY: RK
		DATE 10/27/2005	CHECKED BY


.u/ z.i / zuub c:\projects\dii4400\dii4400aa.m32 gulllaumef.p




F.A.U. RTE.	SECTION	COUNTY	SHEETS	NO.
*	2000-037RS	COOK	58	7
STA.	85+16	TO STA. 122-	-21.2	
FED. RO	AD DIST. NO. 1 ILLI	NOIS FED. AID	PROJECT	٢




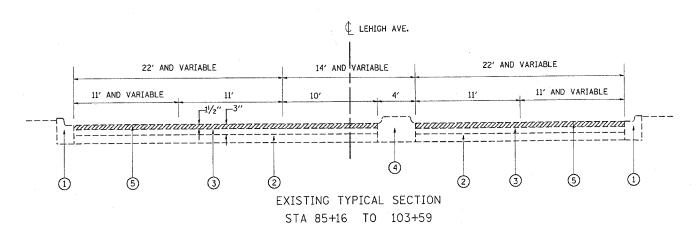

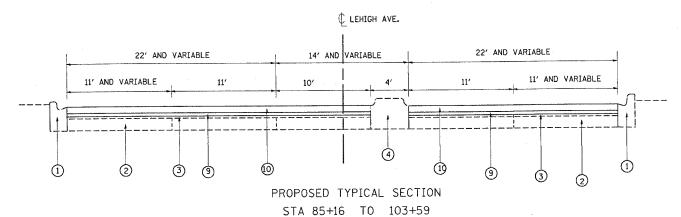


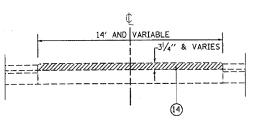


EXISTING TYPICAL SECTION STA 88+75 TO 91+66 STA 96+55 TO 100+44 MEDIAN ONLY

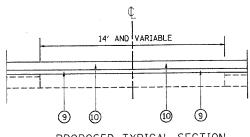

PROPOSED TYPICAL SECTION STA 88+75 TO 91+66 STA 96+55 TO 100+44 MEDIAN ONLY

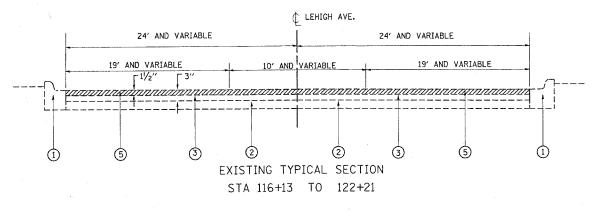

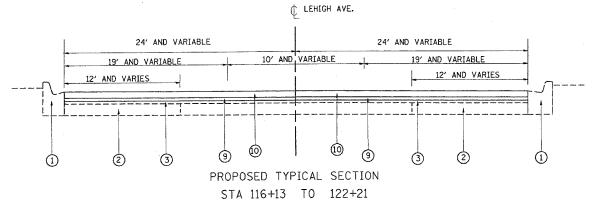

LEGEND


- 1 EXISTING COMB. CURB AND GUTTER TYPE B-6.12
- ② EXISTING PCC PAVEMENT (10" AND VARIES)
- $\begin{tabular}{ll} \hline \end{tabular}$ EXISTING BIT. AFTER MILLING SURFACE, $11/2^{\prime\prime}$
- 4 EXISTING CONCRETE MEDIAN
- \bigcirc PROP. BIT. SURFACE REMOVAL, $1\frac{1}{2}$ "
- 6 PROP. PCC SURFACE REMOVAL (VAR. DEPTH), SEE DISTRICT DETAIL BD-33
- 7 PROP. PARTIAL DEPTH REMOVAL, 2"
- 8 PROP. POLYMERIZED LEVELING BINDER (MM), SUPERPAVE, IL-4.75, N50, 2"
- 9 PROP. POLYMERIZED LEVELING BINDER (MM), SUPERPAVE, IL-4.75, N50, 1"
- (10) PROP. BIT. CONC. SURFACE COURSE, SUPERPAVE, MIX "D", N70, 11/2"
- (1) PROP. BIT. TAPER AT EDGE OF P.C.C. PAVEMENT (SEE DISTRICT DETAIL BD-33)
- 12 EXISTING AGGREGATE SHOULDER
- 13) PROP. AGGREGATE SHOULDER, TYPE B
- (4) PROP. MEDIAN REMOVAL (PARTIAL DEPTH)
- 15 EXISTING GUTTER, TYPE B
- (6) PROP. BIT SHOULDERS, SUPERPAVE, 8"

REVISIO	NS DATE	ILLINOIS DEPARTMEN	IT OF TRANSPORTATION
NAME	DATE		
		1 5411	GH AVE.
	1 1	LENS	JN AVE.
		CENTRAL AVE	TO OALTON AVE \
		(CENTRAL AVE.	TO OAKTON AVE.)
		EXISTING A	ND PROPOSED
		TVDIOAL	OFOTIONIC
	1 1	IYPICAL	. SECTIONS
		VERT.	
			DRAWN BY RN
	1 1	HORIZ.	
		DATE 10/27/2005	CHECKED BY


c:&projects\d114400\d114400aa.m32 culliaumefo

 F.A.U. RTE.	SECTION	-	C	OUNT	′	TOTAL	SHEET NO.
*	2000-037	RS		COOL	<	58	8
STA.	188+50	TO STA.201+00				0	
FED. RO	AD DIST. NO. 1	ILLIN	OIS	FED.	AID	PROJECT	

***** 2786, 1334, 1332

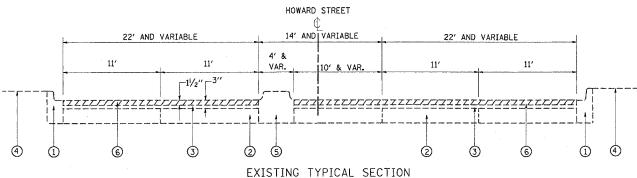

EXISTING TYPICAL SECTION HOWARD STREET STA. 188+50 TO 201+00

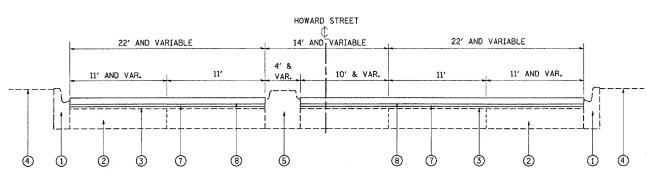

PROPOSED TYPICAL SECTION HOWARD STREET STA. 188+50 TO 201+00


LEGEND

- ① EXISTING COMB. CURB AND GUTTER TYPE 8-6.12
- ② EXISTING PCC PAVEMENT (10" AND VARIES)
- 3 EXISTING BIT. AFTER MILLING SURFACE, 11/2"
- EXISTING GROUND LINE
- (5) EXISTING CONCRETE MEDIAN
- 6 PROP. BIT. SURFACE REMOVAL, 11/2"
- 7 PROP. POLYMERIZED LEV. BINDER (MM), SUPERPAVE, IL-4.75, N50,3/4"
- (8) PROP. BIT. CONC. SURFACE COURSE, SUPERPAVE, MIX "D", N70, 11/2"


REVISIONS
NAME
DATE
LOCATION #2
HOWARD STREET
(LEHIGH AVE. TO GROSS POINT RD.)
EXISTING AND PROPOSED
TYPICAL SECTIONS

SCALE: VERT. NONE DRAWN BY: RK
HORIZ.
DATE 10/27/2005 CHECKED BY:

F.A.U. RTE.	SECTION		COUNT	Y	TOTAL	SHEET NO.
1332	2000-037	₹S	C00	K	58	9
STA.	238+19	-	TO STA.	299	+14	
FED. ROAD	DIST. NO.	ILLIN	OIS FED.	AID	PROJECT	

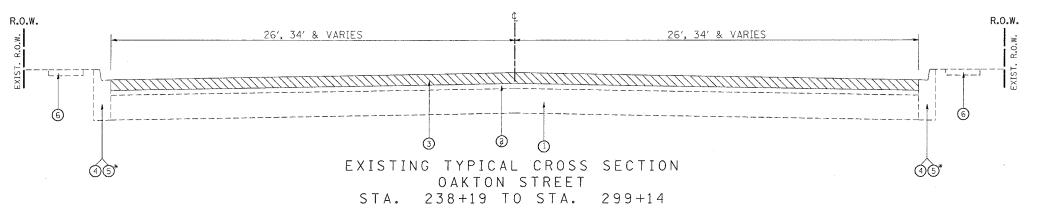

* TYPE B6.24 CURB & GUTTER FROM STATION 295+29 TO STATION 299+14

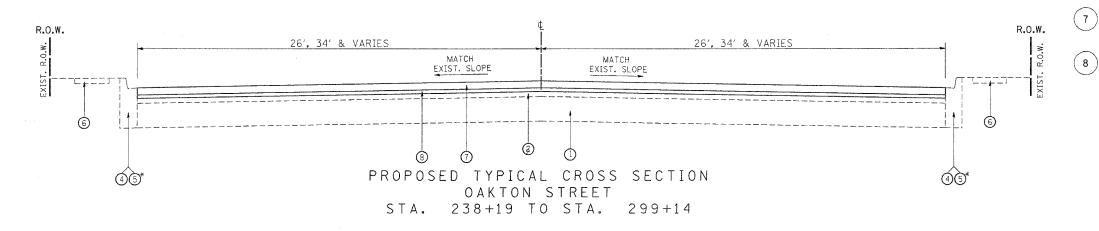

MIXTURE REQUIREMENTS								
MIXTURE USES	AC / PG	RAP % (MAX)	DESIGN AIR VOIDS					
POLYMERIED BITUMINOUS CONCRETE SURFACE COURSE, SUPERPAVE, MIX "F", N90	SBS/SBR PG 70-22	0	4% € 90 GYRATIONS					
POLYMERIZED LEVELING BINDER (MACHINE METHOD), SUPERPAVE, IL-4.5, N50	SBS/SBR PG 76-28	0	2.5% @ 50 GYRATIONS					
BITUMINOUS REPLACEMENT OVER PATCHES BINDER IL-19.0MM	PG 64-22	15	4% @ 70 GYRATIONS					
CLASS D PATCHING, BINDER IL-19.0MM	PG 64-22	15	4% @ 70 GYRATIONS					

NOTE: THE UNIT WEIGHT USED TO CALCULATE BITUMINOUS SURFACE MIXTURE QUANTITIES IS 112 LBS/SQYD/IN

LEGEND

- EXISTING CONCRETE BASE COURSE, 10" (+/-)
- 2) EXISTING BITUMINOUS RESURFACING, 6" (+/-)
- (3) PROPOSED BITUMINOUS SURFACE REMOVAL, 21/2"
- (4) EXISTING B6.12 COMBINATION CONCRETE CURB & GUTTER
- (5) EXISTING B6.24 COMBINATION CONCRETE CURB & GUTTER
- 6 EXISTING P.C.C. SIDEWALK
- PROPOSED POLYMERIZED BITUMINOUS CONCRETE SURFACE COURSE, SUPERPAVE, MIX. "F", N90, 1¾"
- PROPOSED POLYMERIZED LEVELING BINDER (MACHINE METHOD), SUPERPAVE, IL-4.5, N50, $\frac{3}{4}$ "

NAME DATE ILLI

ILLINOIS DEPARTMENT OF TRANSPORTATION


OAKTON ST. (CALDWELL AVE. – LONG AVE.) EXISTING AND PROPOSED TYPICAL SECTIONS


SCALE: VERT. N/A HORIZ.

DRAWN BY J CHECKED BY

10/21/2003 s:fprojec†s@d148000@d148000a

F.A.U. RTE.	SECTION	1	COUNT	Y	TOTAL	SHEET NO.
1332	2000-03	7RS	C00	K	58	10
STA.	301+38	TO	STA.	30	7+59	
FED. ROA	D DIST. NO.	ILLINOIS	FED.	AID	PROJECT	

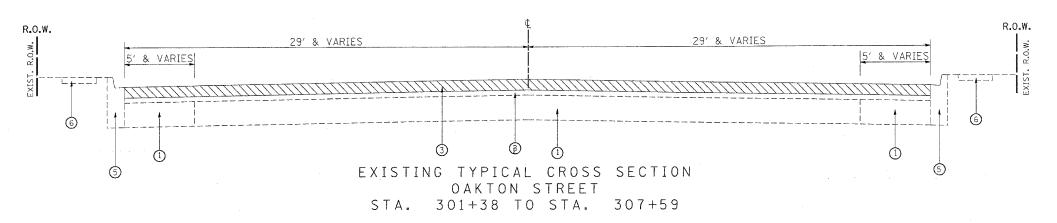

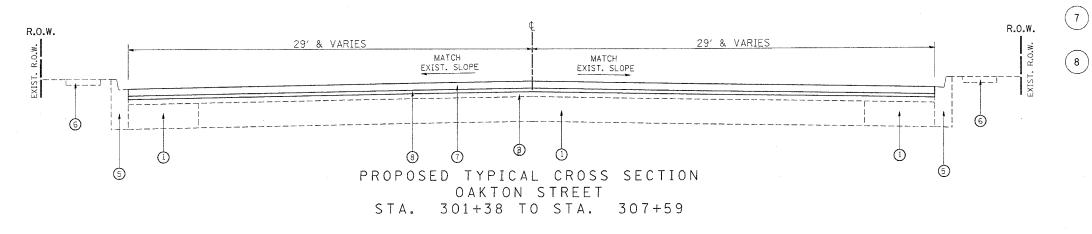

LEGEND

- (1) EXISTING CONCRETE BASE COURSE, 10" (+/-)
- 2) EXISTING BITUMINOUS RESURFACING, 6" (+/-)
- (3) PROPOSED BITUMINOUS SURFACE REMOVAL, $2\frac{1}{2}$ "
- (4) EXISTING B6.12 COMBINATION CONCRETE CURB & GUTTER
- 5 EXISTING B6.24 COMBINATION CONCRETE CURB & GUTTER
- 6 EXISTING P.C.C. SIDEWALK
- 7 PROPOSED POLYMERIZED BITUMINOUS CONCRETE SURFACE COURSE, SUPERPAVE, MIX. "F", N90, 1¾"
 - PROPOSED POLYMERIZED LEVELING BINDER (MACHINE METHOD), SUPERPAVE, IL-4.5, N50, $\frac{3}{4}$ "

REVISIONS ILLINOIS DEPARTMENT OF TRANSPORTATION


OAKTON ST. (CALDWELL AVE. – LONG AVE.) EXISTING AND PROPOSED TYPICAL SECTIONS


SCALE: VERT. N/A HORIZ. DATE 10/27/2005

DRAWN BY JR CHECKED BY

3/21/2005 #010140148000

F.A.U. RTE.	SECTION		COUNT	Y	TOTAL	SHEET NO.
1332	2000-037	RS	C00	K	58	11
STA.	307+59	T	O STA.	317-	+ 75	
FED. RO	AD DIST. NO.	ILLING	IS FED.	AID	PROJECT	

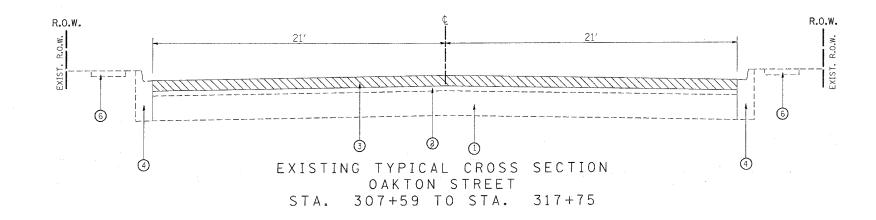

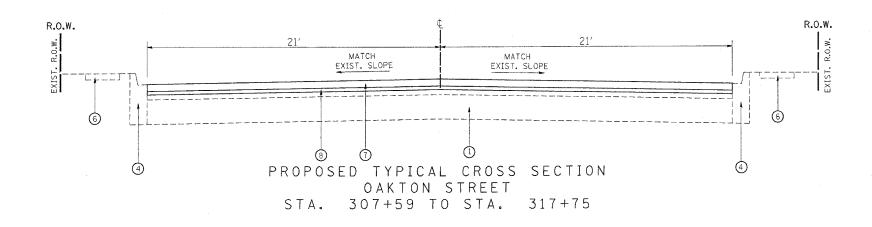

LEGEND

- (1) EXISTING CONCRETE BASE COURSE, 10" (+/-)
- 2 EXISTING BITUMINOUS RESURFACING, 6" (+/-)
- PROPOSED BITUMINOUS SURFACE REMOVAL, 21/2"
- (4) EXISTING B6.12 COMBINATION CONCRETE CURB & GUTTER
- 5 EXISTING B6.24 COMBINATION CONCRETE CURB & GUTTER
- 6 EXISTING P.C.C. SIDEWALK
- 7 PROPOSED POLYMERIZED BITUMINOUS CONCRETE SURFACE COURSE, SUPERPAVE, MIX. "F", N90, 13/4"
- 8 PROPOSED POLYMERIZED LEVELING BINDER (MACHINE METHOD), SUPERPAVE, IL-4.5, N50, 3/4"

REVISIONS
NAME DATE

ILLINOIS DEPARTMENT OF TRANSPORTATION

OAKTON ST. (CALDWELL AVE. – LONG AVE.) EXISTING AND PROPOSED TYPICAL SECTIONS


SCALE: VERT. N/A HORIZ. DATE 10/27/2005

DRAWN BY J


リノと1/2005 :傷projects覆d148000畳d148000ac.mi

F.A.U. RTE.	SECTION	COUNTY	TOTAL	SHEE NO.
*	2000-037RS	соок	58	12
STA.		TO STA.		
FED ROA	IT I ON TOTAL	INTS FED. ATT	PROJECT	7

* 2786, 1334, 1332

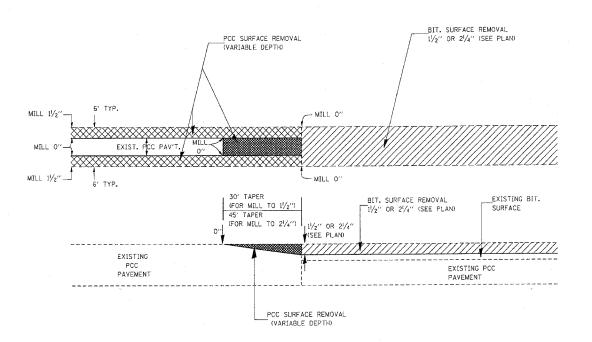

MILLING AND RESURFACING AT THE BITUMINOUS / PCC PAVEMENT JOINT

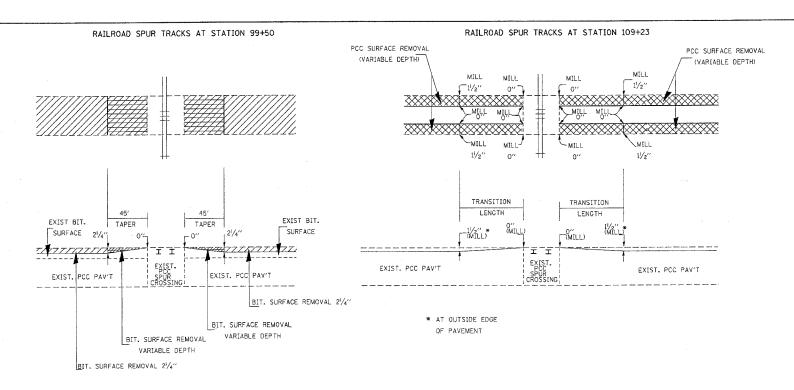

PCC SURFACE REMOVAL (VARIABLE DEPTH)

PCC SURFACE REMOVAL (VARIABLE DEPTH)

(FOR TAPER LENGTH @ BIT./PCC PAV'T JOINT)

1) REMOVE THE EXISTING CURB & GUTTER OR GUTTER AND RECONSTRUCT AT A HIGHER ELEVATION.
2) ADJUST THE BITUMINOUS TAPER LENGTH SO THAT THE CROSS SLOPE ON THE PAVEMENT IS LESS STEEP.

NOTE: ANY OPEN JOINTS AT THE PCC CROSSINGS FOR THE RAILROAD SPUR TRACKS SHOULD BE FILLED WITH THE MIXTURE FOR CRACKS, JOINTS & FLANGEWAYS.

THE MIXTURE SHOULD BE COMPACTED TO THE SATISFACTION OF THE ENGINEER.

AFTER PLACEMENT OF THE MIXTURE FOR CRACKS, JOINTS & FLANGEWAYS, THE LEVELING
BINDER AND SURFACE COURSE SHOULD BE PLACED ACROSS THE SPUR TRACKS.

IT MAY BE NECESSARY FOR THE ENGINEER TO:


- BIT SUBFACE REMOVAL (VARIABLE DEPTH

- BIT. SURFACE REMOVAL 21/4"

— BIT. SURFACE REMOVAL (VARIABLE DEPTH)


_				
	REVISIONS		TILINOIS DEPARTMENT	T OF TRANSPORTATION
ı	NAME	DATE		
Ī			DETAILS FOR MILL	ING RAILROAD SPUR
			CROSSINGS AND BIT.	P.C.C. PAVEMENT JOINT
-			LOCA"	TION #1
t			LEHIC	GH AVE.
-			(CENTRAL AVE.	TO OAKTON AVE.)
ŀ			SCALE: HORIZ.	DRAWN BY RN
İ			DATE 10/27/2005	CHECKED BY


MILLING AT THE RAILROAD SPUR CROSSINGS

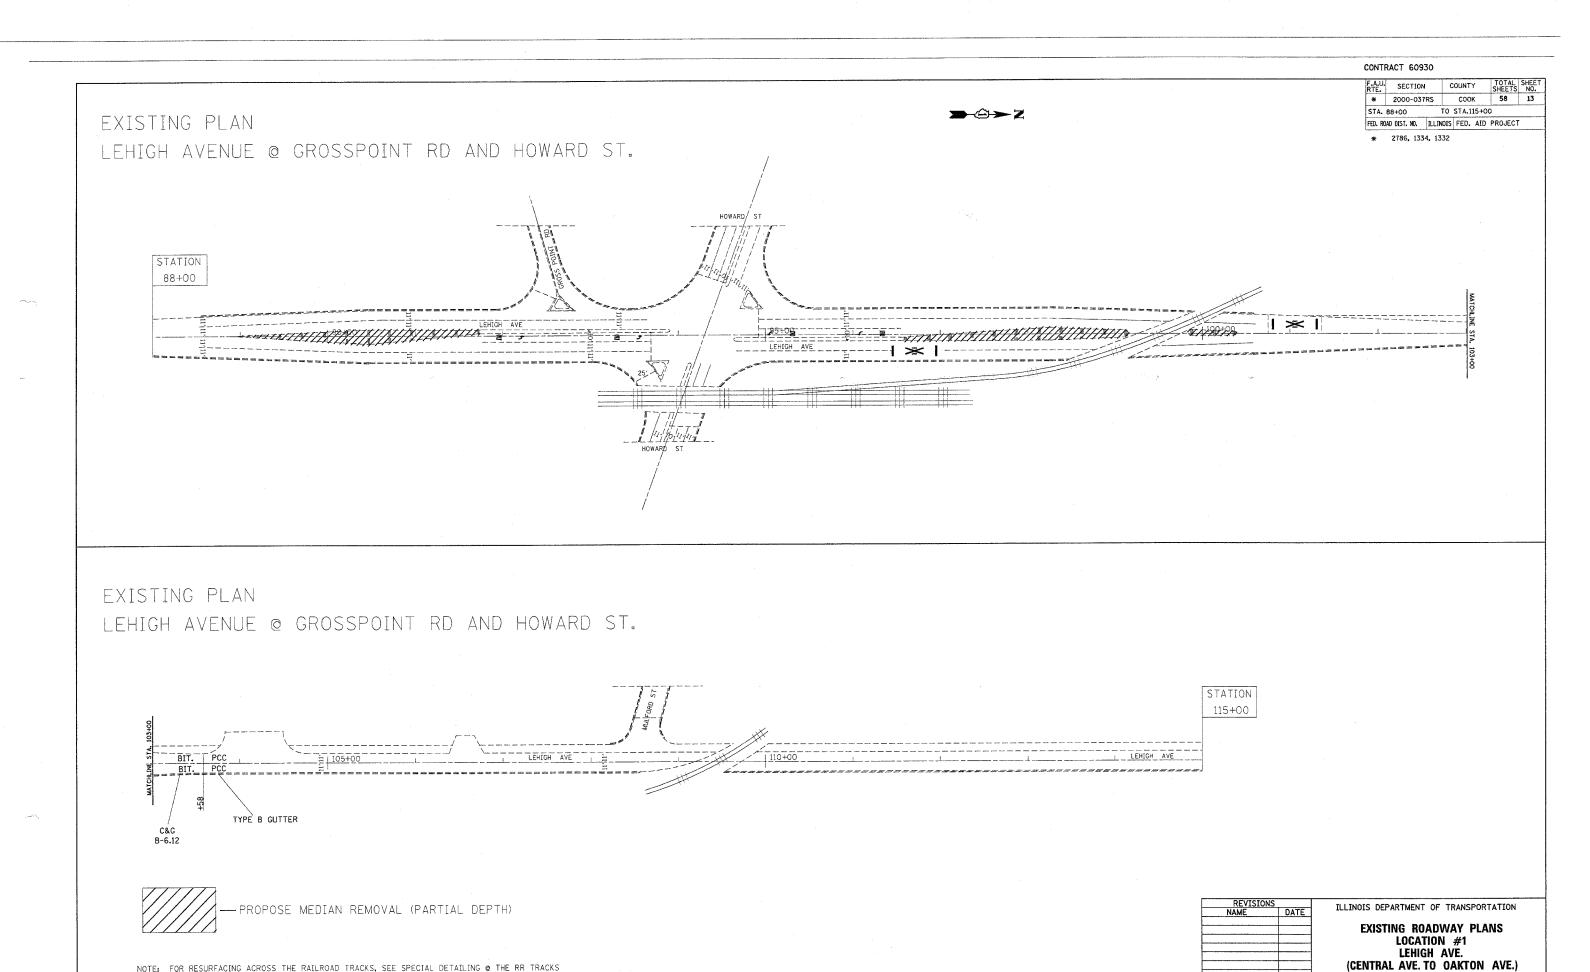


SCALE: VERT.

DRAWN BY RN CHECKED BY

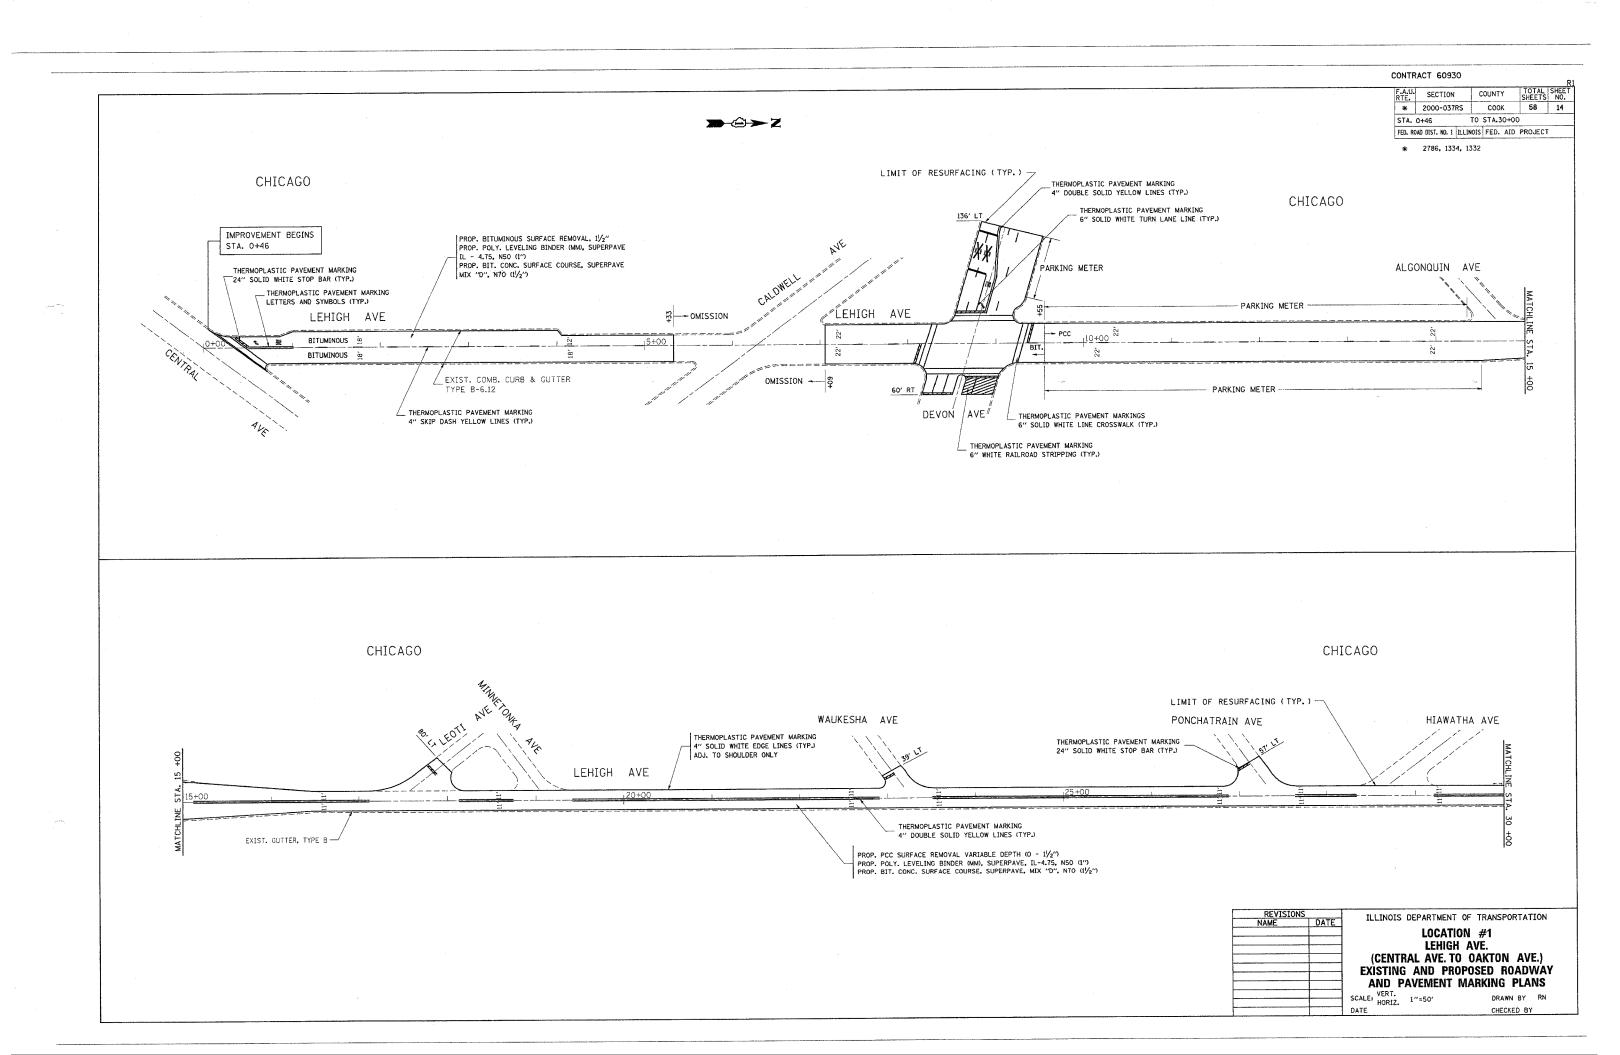

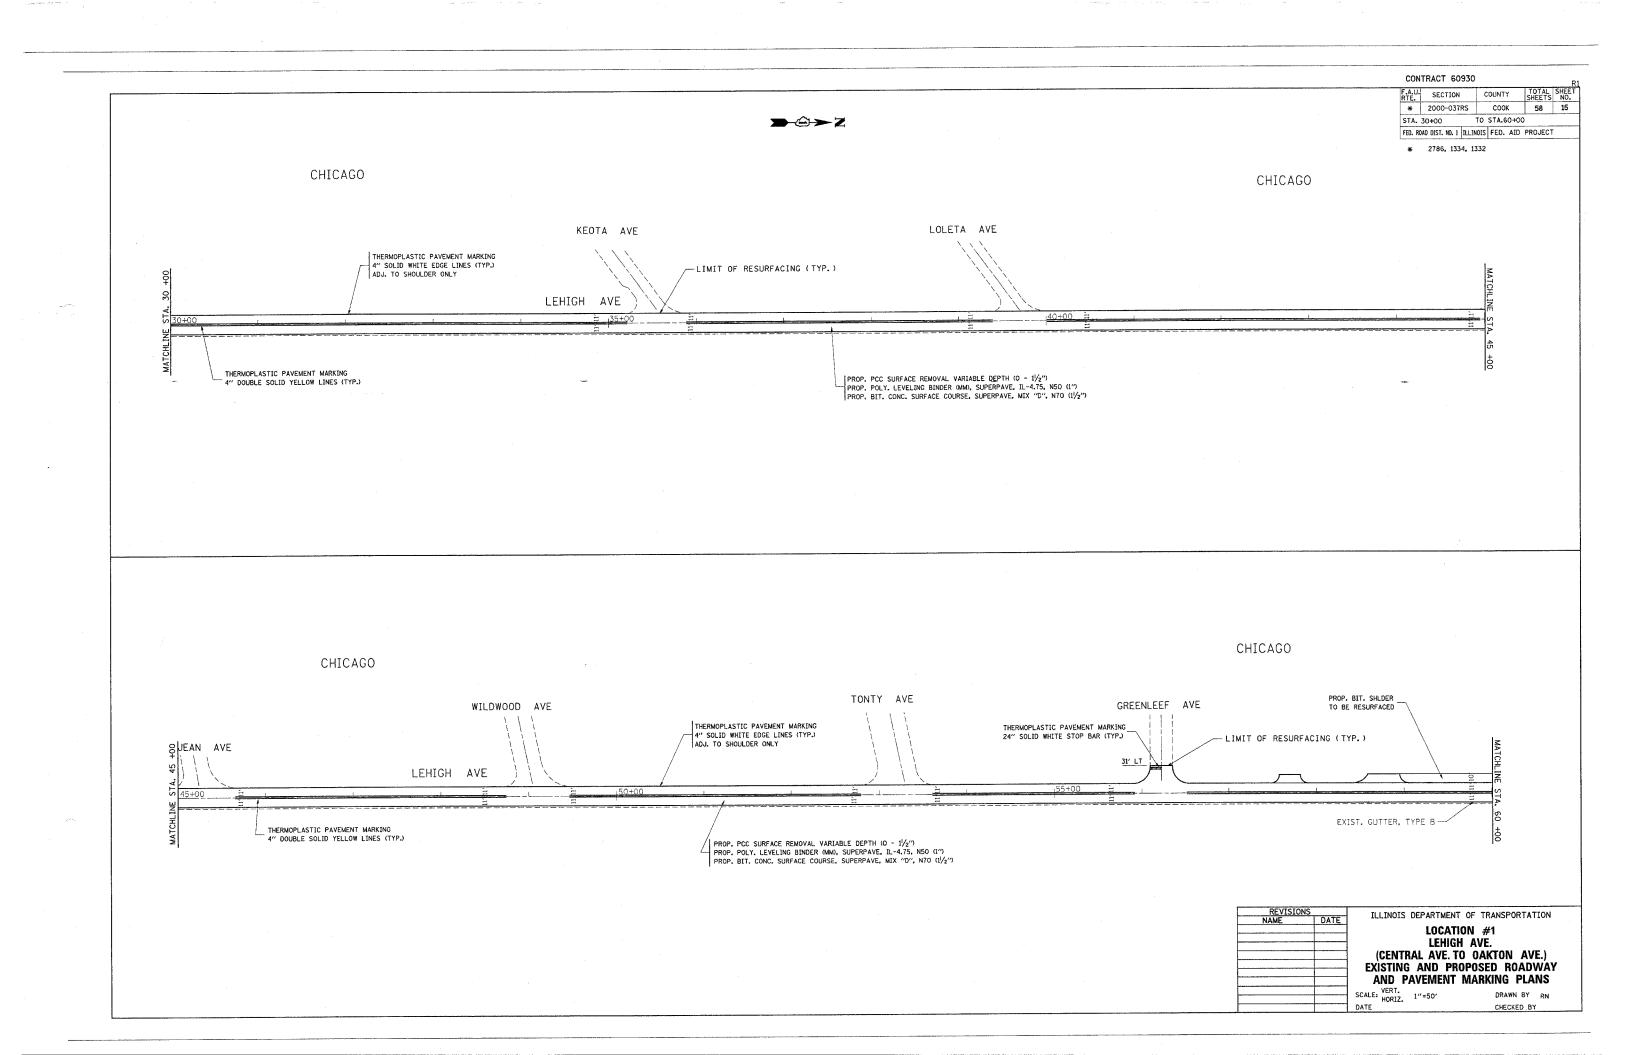


CONTRACT 60930 RTE. SECTION COUNTY TOTAL SHEETS NO. * 2000-037RS COOK 58 **→**⊕→Z TO STA.90+00 STA. 60+00 FED. ROAD DIST. NO. 1 ILLINOIS FED. AID PROJECT ***** 2786, 1334, 1332 CHICAGO (CHICAGO LIMIT AT STA 65+63) PROP. P.C.C. SURFACE REMOVAL (VARIABLE DEPTH) PROP. BIT. CONC. SURFACE COURSE, SUPERPAVE MIX "D", N50 (1/2") THERMOPLASTIC PAVEMENT MARKING
6" SOLID WHITE TURN LANE LINE (TYP.) THERMOPLASTIC PAVEMENT MARKINGS TOUHY AVE 6" SOLID WHITE LINE CROSSWALK (TYP.) THERMOPLASTIC PAVEMENT MARKING EXIST. COMB. CURB & GUTTER 4" SKIP DASH YELLOW LINES (TYP.) TYPE B-6,12 EXIST. COMB. CURB & GUTTER THERMOPLASTIC PAVEMENT MARKING PROP. BIT. SHLDR TO BE RESURFACED THERMOPLASTIC PAVEMENT MARKING 24" SOLID WHITE STOP BAR (TYP.) TYPE B-6.12 THERMOPLASTIC PAVEMENT MARKING LETTERS AND SYMBOLS (TYP.) 12" SOLID YELLOW LINES (TYP.) LEHIGH AVE BIT. PCC = PCC - BIT 32' RT THERMOPLASTIC PAVEMENT MARKING 4" DOUBLE SOLID YELLOW LINES (TYP.) EXIST. GUTTER, TYPE B EXIST. COMB. CURB & GUTTER -EXIST. COMB. CURB & GUTTER TYPE B-6.12 TYPE B-6.12 PROP. DOUBLE OUTLET TYPE 1 PROP. BITUMINOUS SURFACE REMOVAL, 11/2"
PROP. POLY. LEVELING BINDER (MM), SUPERPAVE FOR TYPE B GUTTER THERMOPLASTIC PAVEMENT MARKING (DOUBLE) GRATE TYPE B 12" SOLID YELLOW LINES (TYP.) II - 4.75, N50 (1") PROP. BIT. CONC. SURFACE COURSE, SUPERPAVE LIMIT OF RESURFACING (TYP.) MIX "D", N70 (11/2") PROP. PCC SURFACE REMOVAL VARIABLE DEPTH (0 - 1½")
PROP. POLY. LEVELING BINDER (MM), SUPERPAVE, 1L-4.75, N50 (1")
PROP. BIT. CONC. SURFACE COURSE, SUPERPAVE, MIX "D", N70 (1½") PROP. BITUMINOUS SURFACE REMOVAL, 11/2" PROP. POLY. LEVELING BINDER (MM), SUPERPAVE IL - 4.75. N50 (1') PROP. BIT. CONC. SURFACE COURSE, SUPERPAVE MIX "D", N70 (1/2") THERMOPLASTIC PAVEMENT MARKING 4" SOLID WHITE EDGE LINES (TYP.) PROPOSED GRADING AND ADJ. TO SHOULDER ONLY SHAPING OF DITCHES (TYP.) STA. 81+06 TO STA. 84+35 PROP. AGGREGATE SHLDR PROP. 4' BITUMINOUS SHLDR. -EXIST. AGGREGATE SHLDR PROP. BIT. SHLDR TYPE B (TYP) TO BE RESURFACED PCC | 85+00 BIT 80+00 LEHIGH AVE EXIST. GUTTER, TYPE B-PROP. PCC SURFACE REMOVAL VARIABLE DEPTH (0 - $1\frac{1}{2}$ ")
PROP. POLY. LEVELING BINDER (MM), SUPERPAVE, IL-4.75, N50 (1") THERMOPLASTIC PAVEMENT MARKING 4" DOUBLE SOLID YELLOW LINES (TYP.) PROP. BIT. CONC. SURFACE COURSE, SUPERPAVE, MIX "D", N70 (1/2") EXIST. COMB. CURB & GUTTER -THERMOPLASTIC PAVEMENT MARKING TYPE B-6.12 4" SKIP DASH YELLOW LINES (TYP.) THERMOPLASTIC PAVEMENT MARKING 12" SOLID YELLOW LINES (TYP.) ILLINOIS DEPARTMENT OF TRANSPORTATION LOCATION #1 LEHIGH AVE. (CENTRAL AVE. TO OAKTON AVE.) EXISTING AND PROPOSED ROADWAY AND PAVEMENT MARKING PLANS SCALE: VERT. HORIZ. 1"=50' DRAWN BY RN DATE CHECKED BY

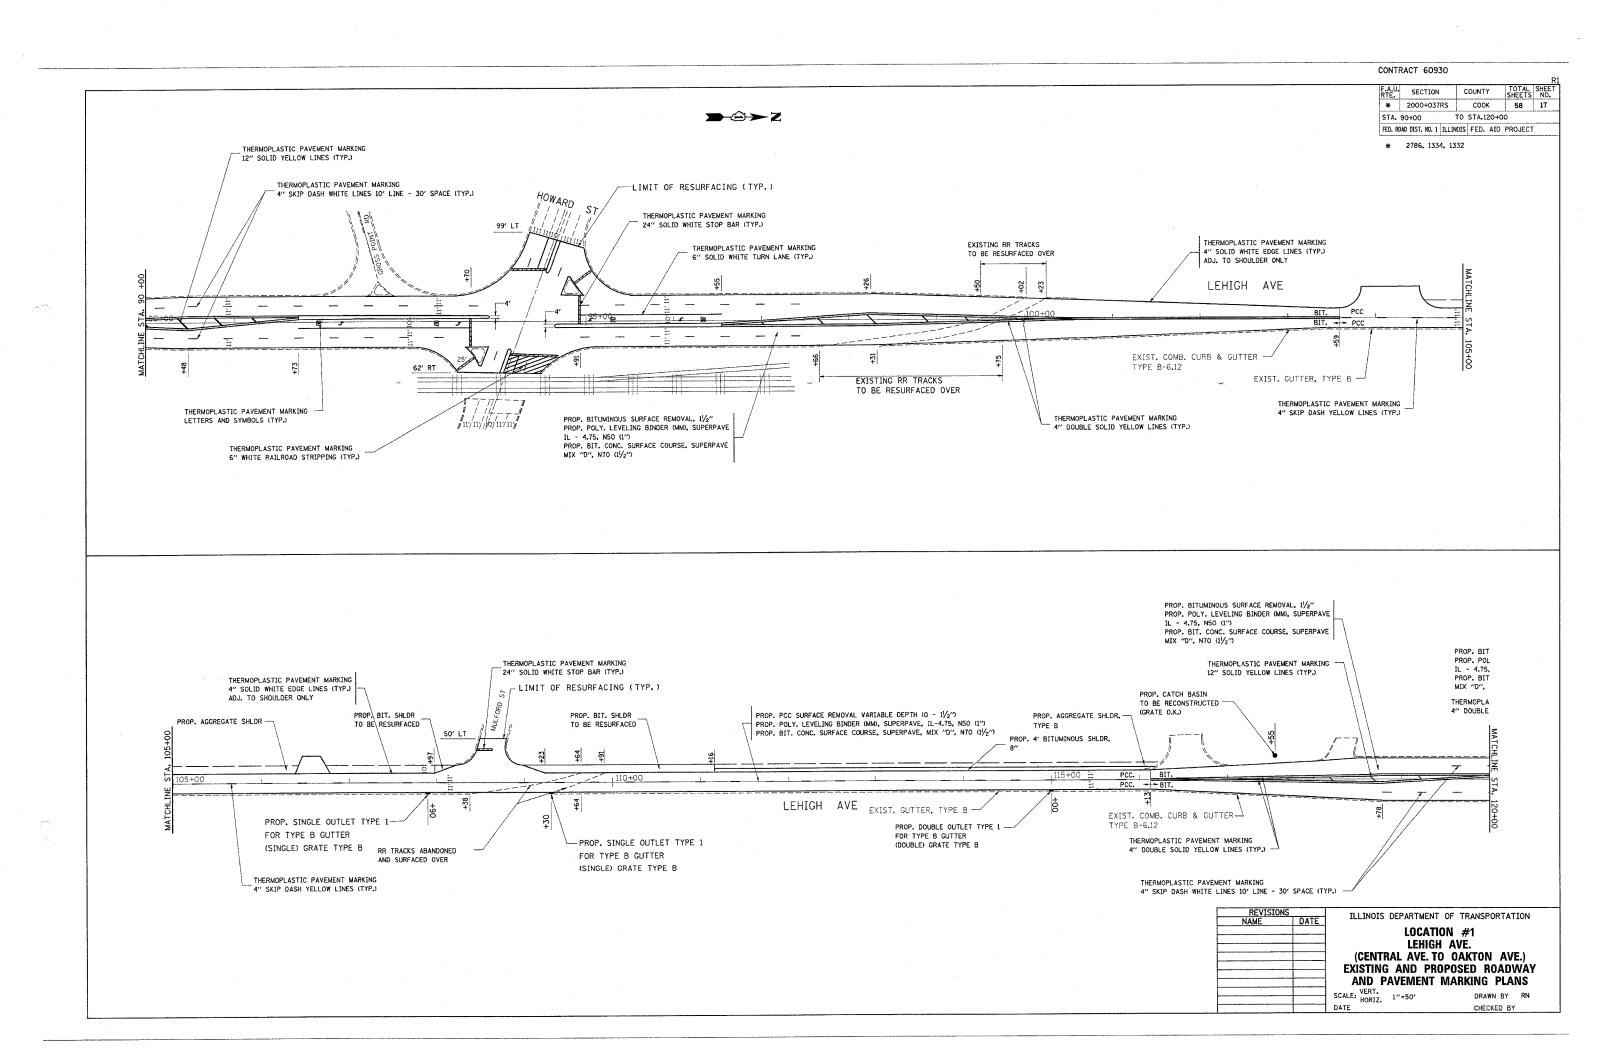


STA. 120+00 TO STA.122+21.2 FED. ROAD DIST. NO. 1 ILLINOIS FED. AID PROJECT


***** 2786, 1334, 1332

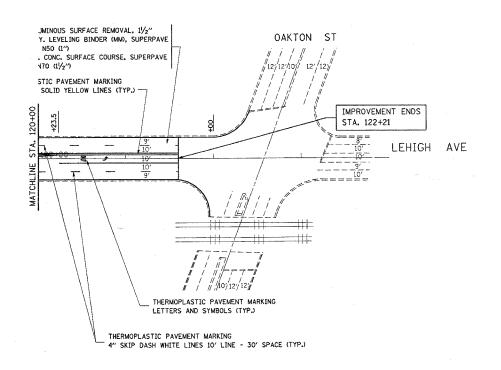



→②→Z


REVISIONS NAME ILLINOIS DEPARTMENT OF TRANSPORTATION LOCATION #1
LEHIGH AVE.
(CENTRAL AVE. TO OAKTON AVE.)
EXISTING AND PROPOSED ROADWAY AND PAVEMENT MARKING PLANS SCALE: VERT. HORIZ. 1"=50" DRAWN BY RN

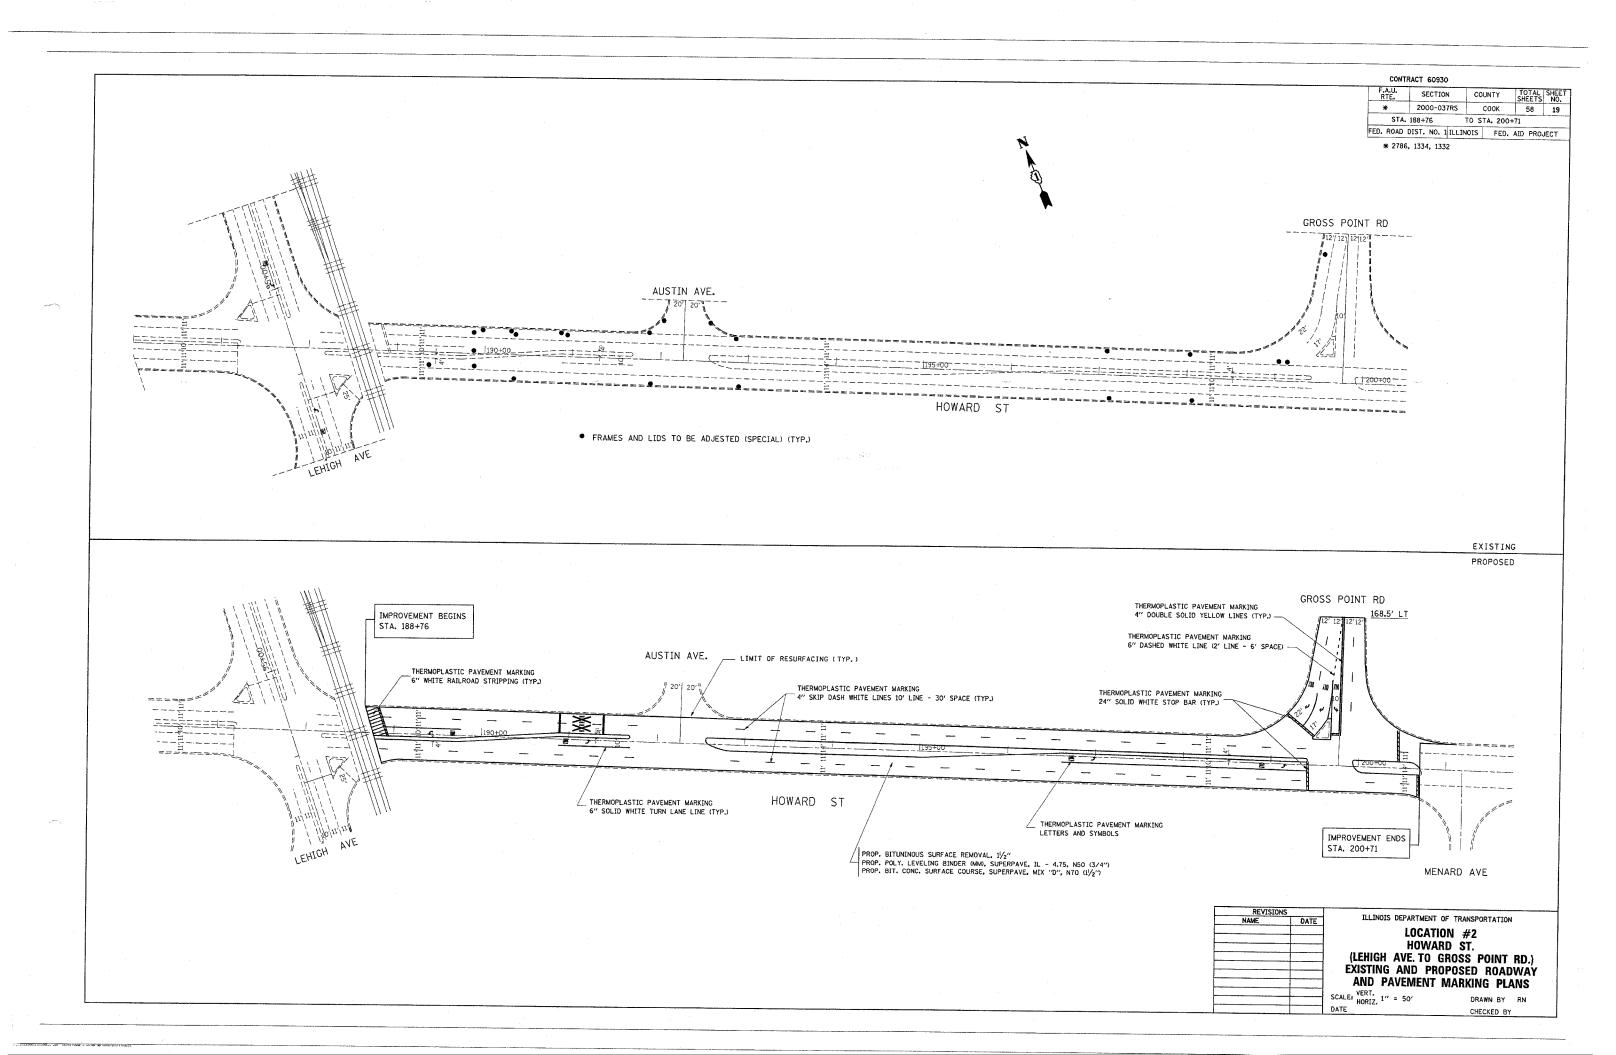

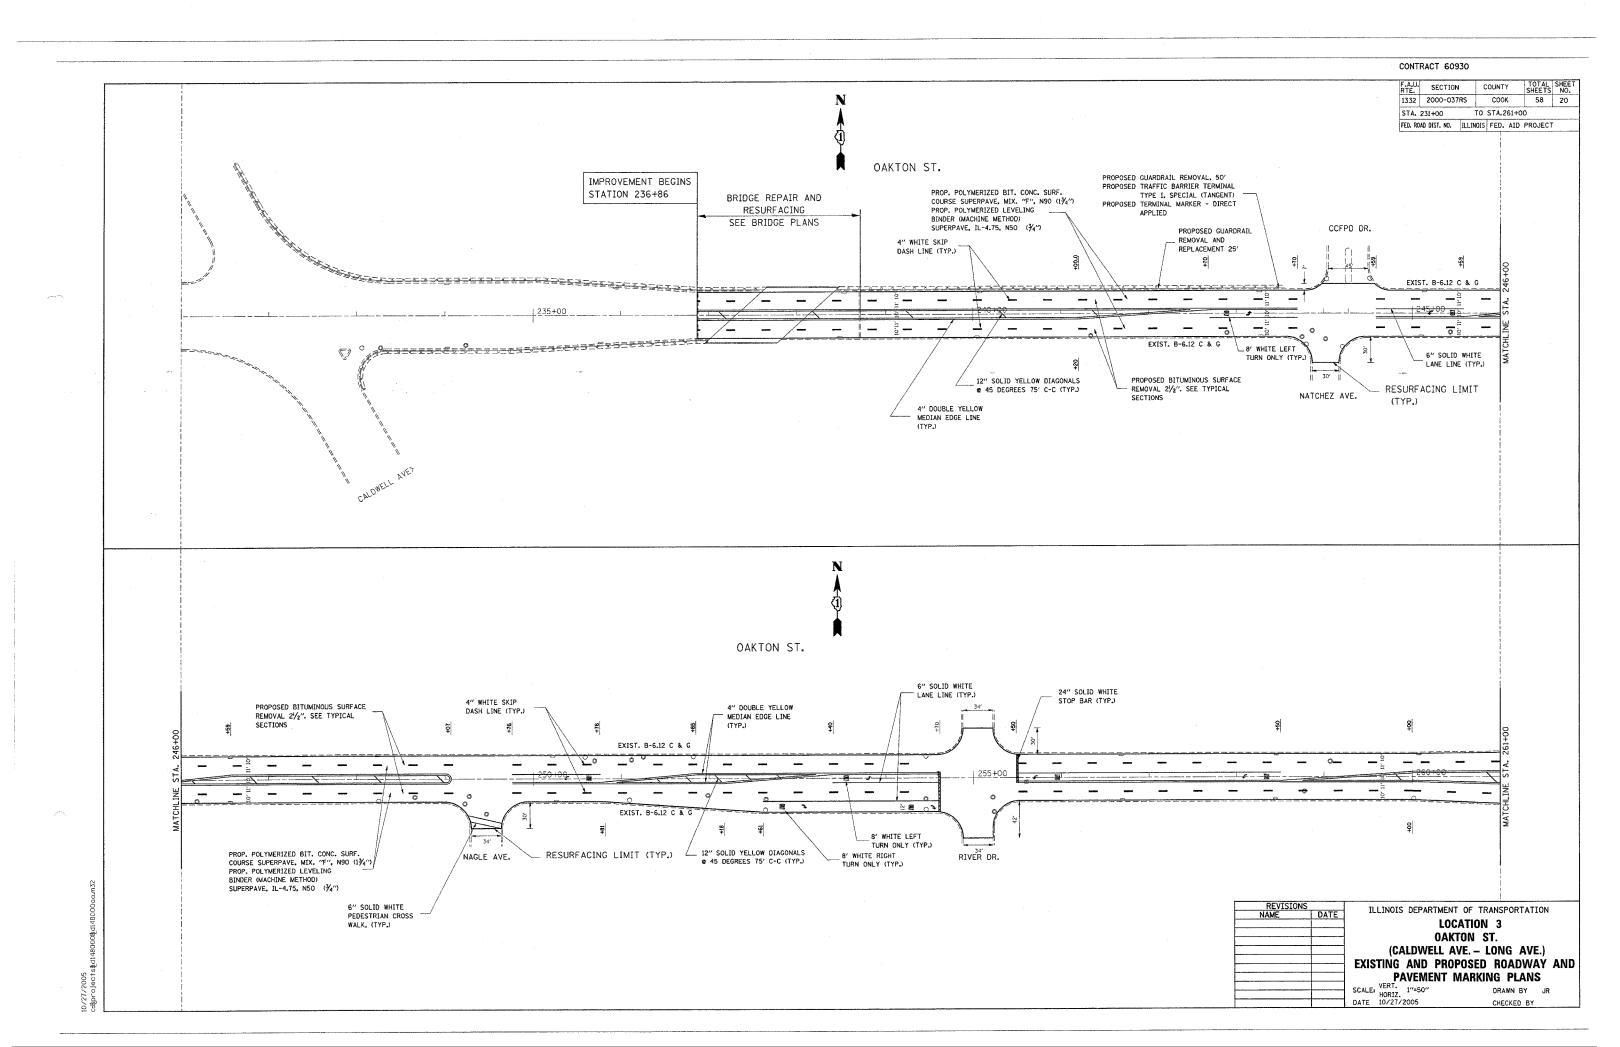


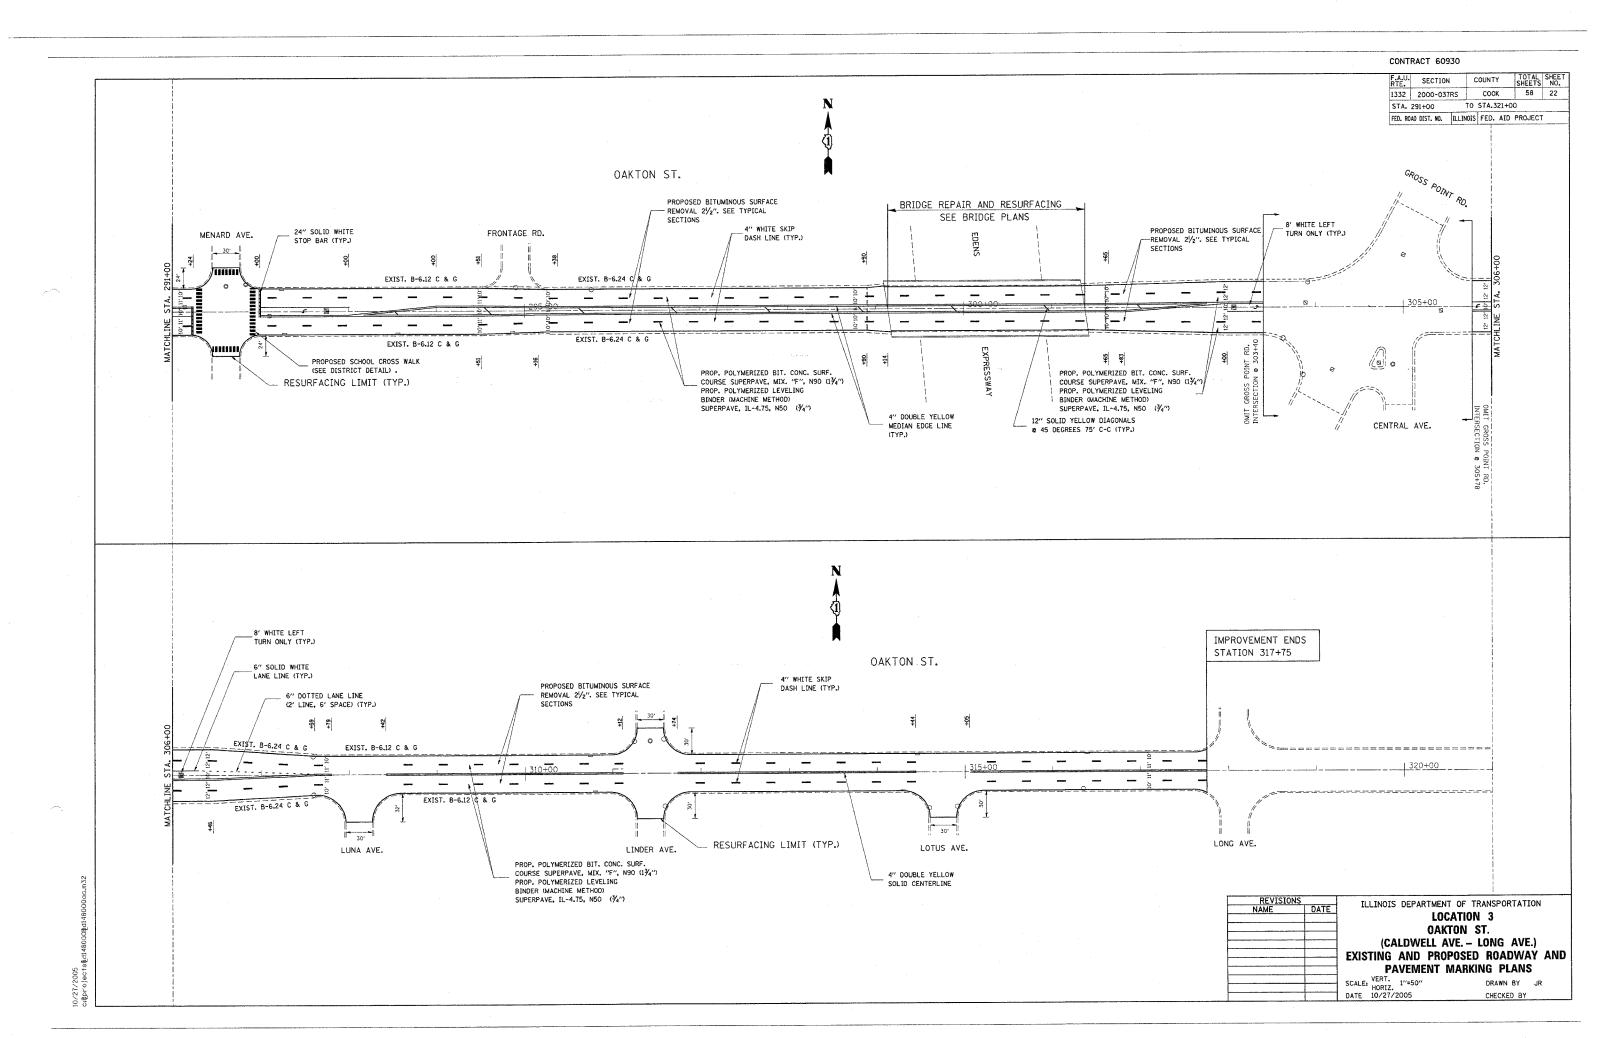


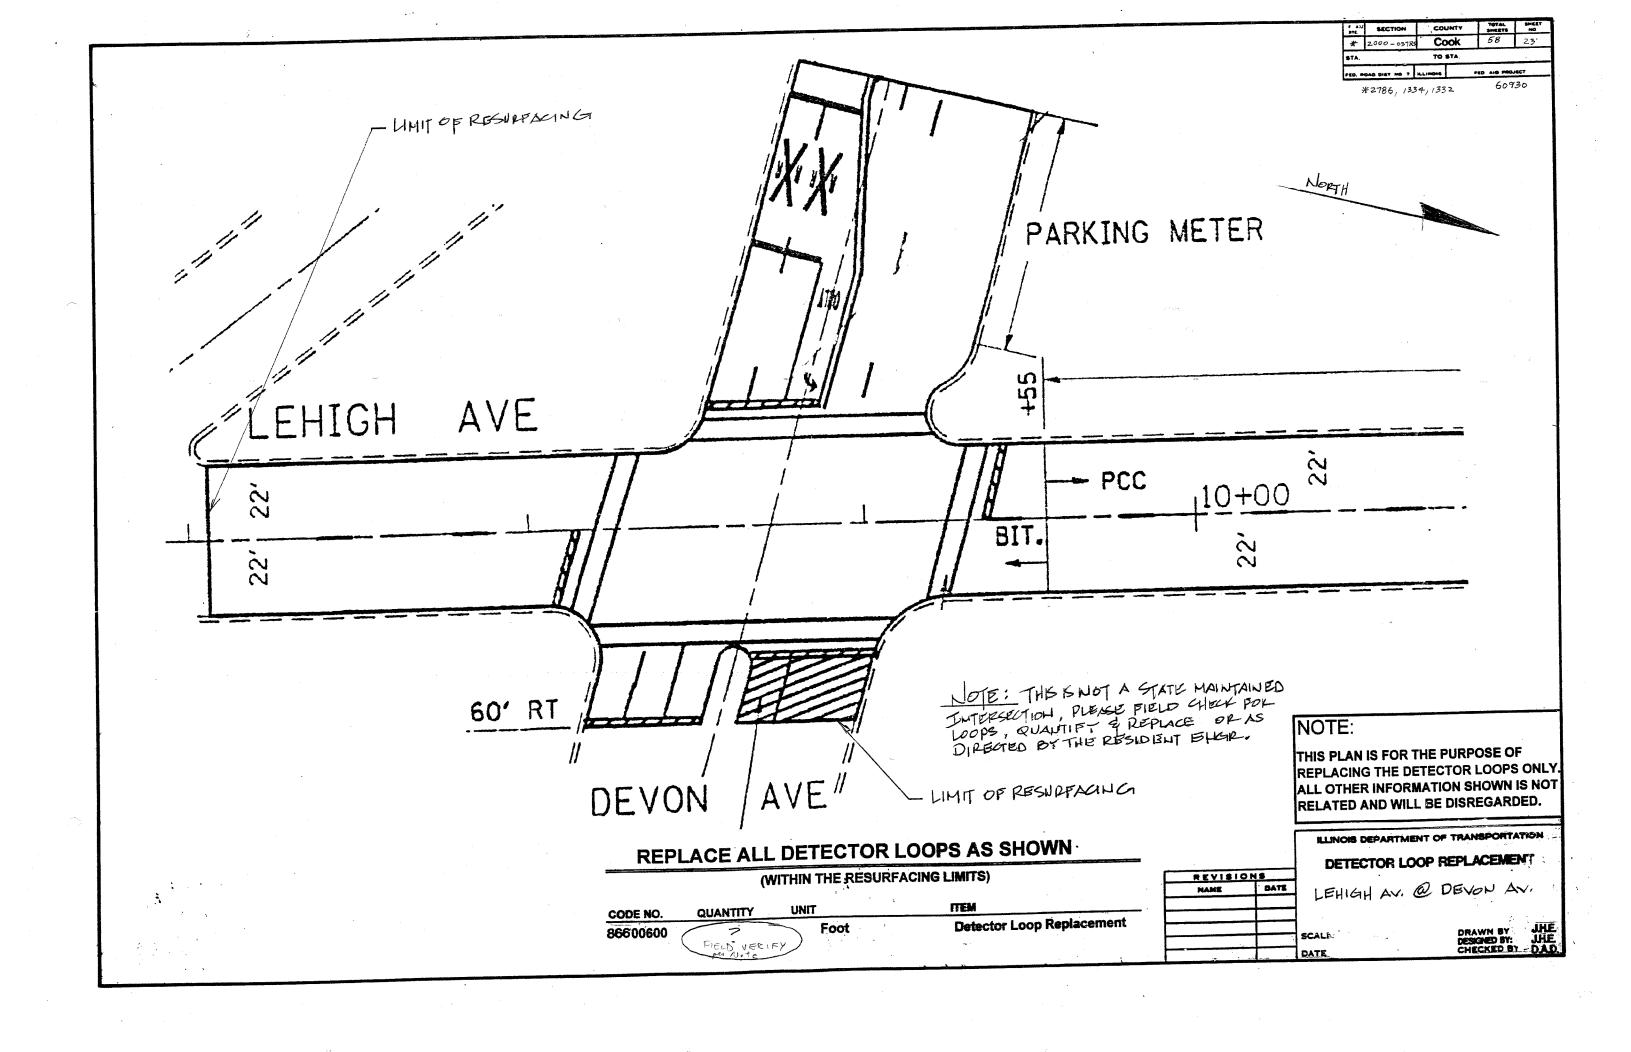


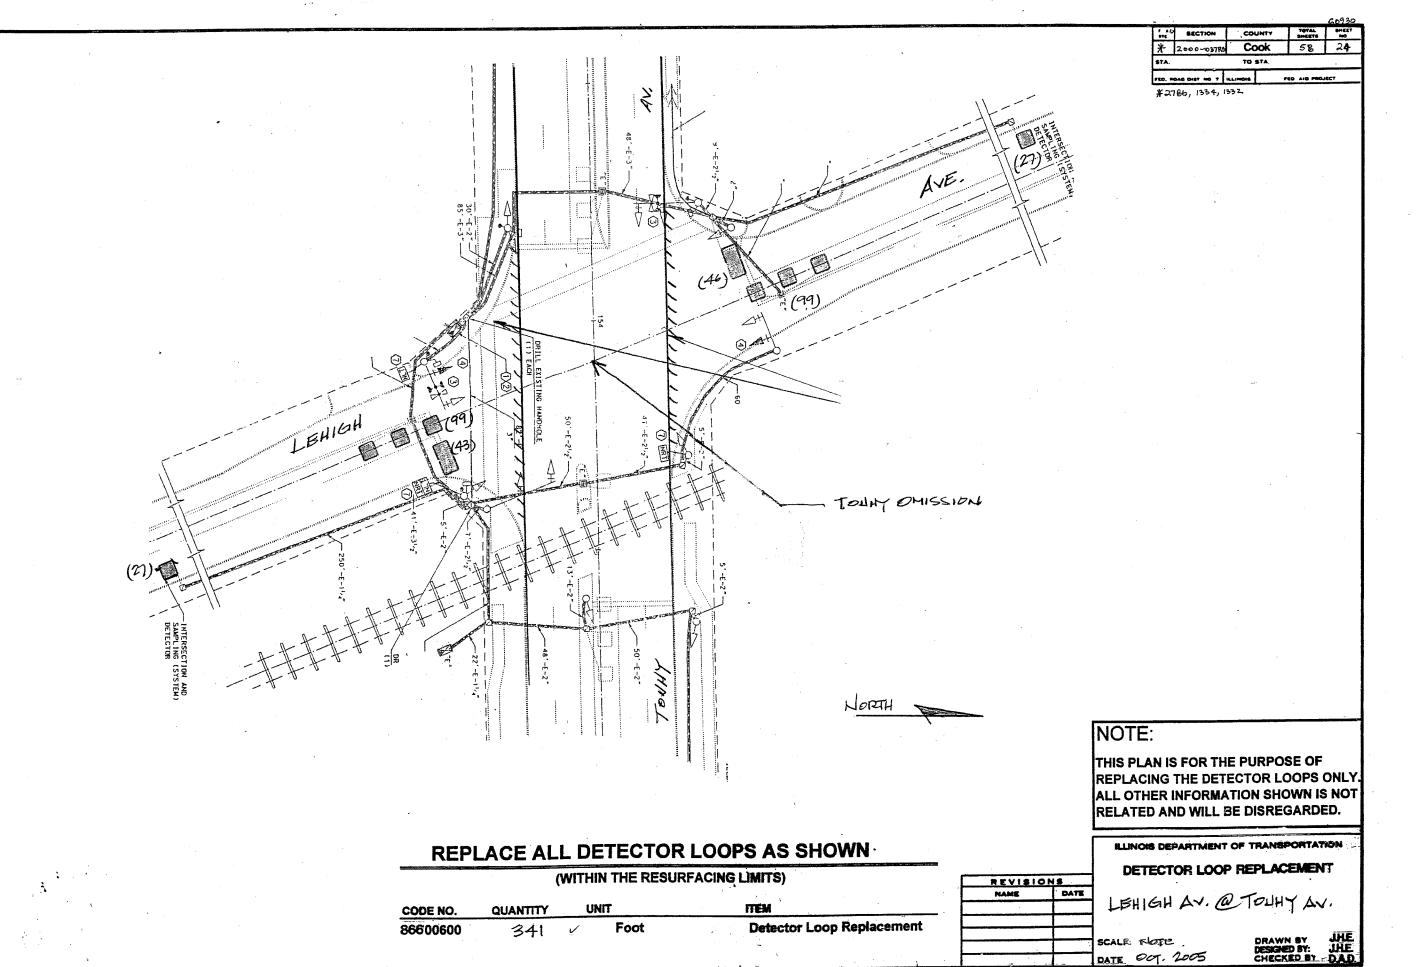



DATE OCT. 2005

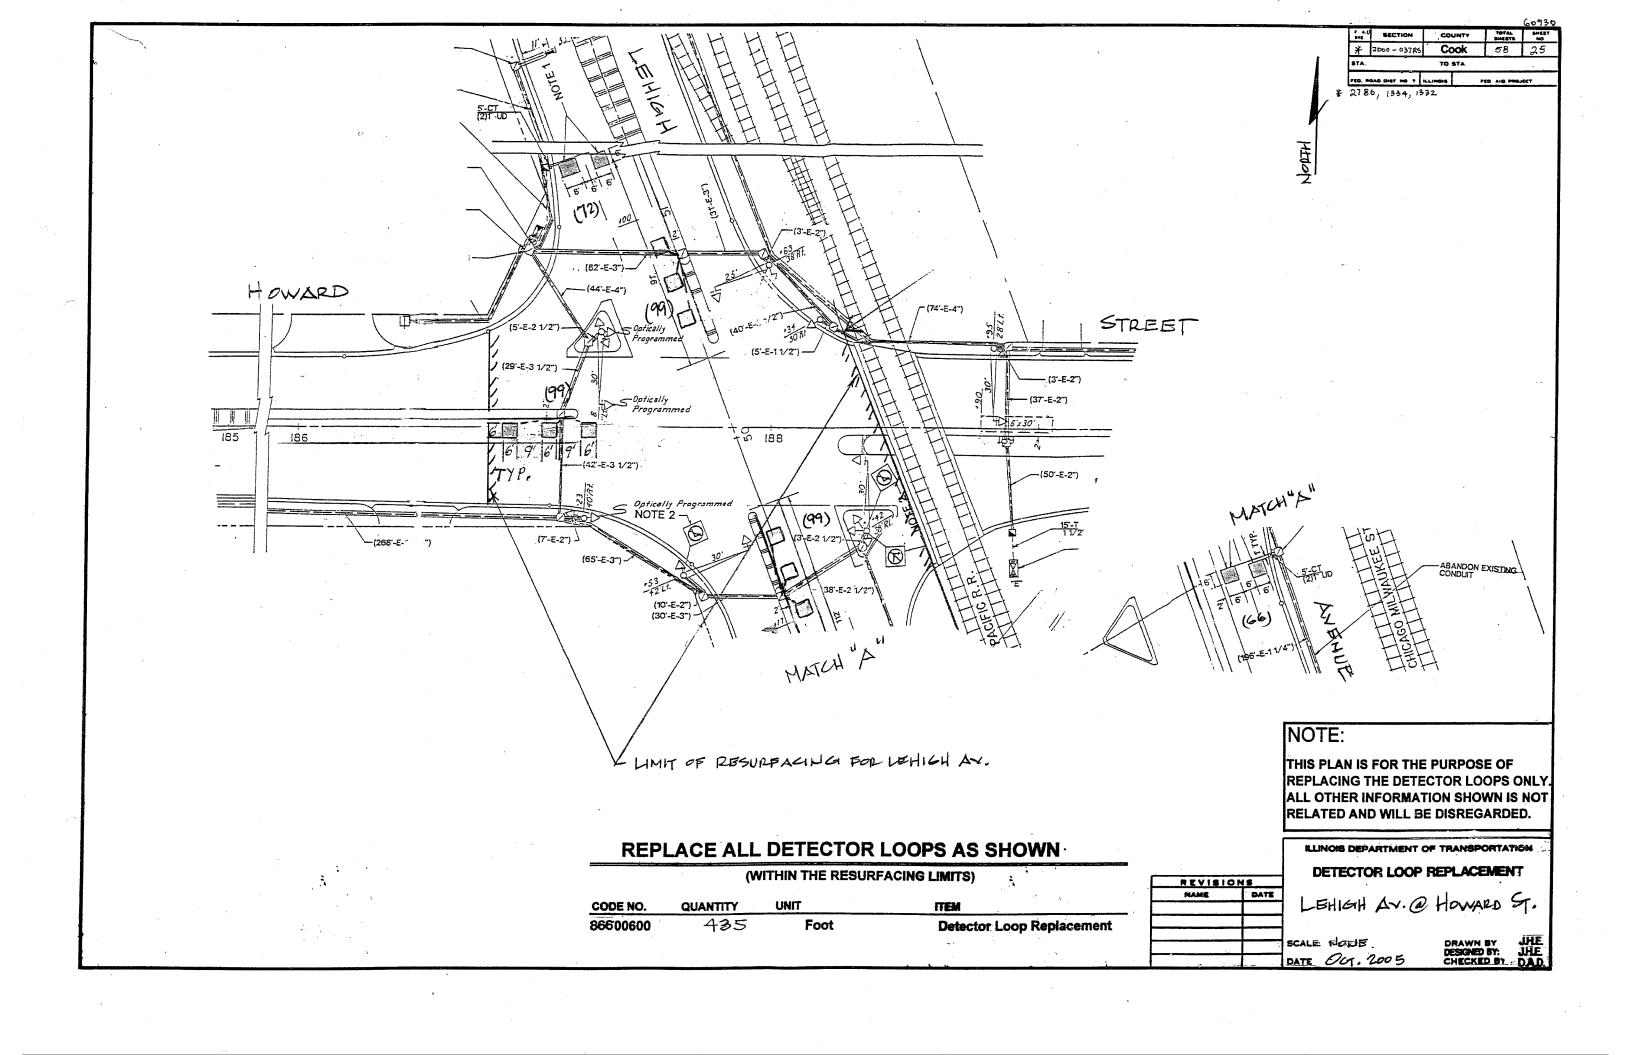


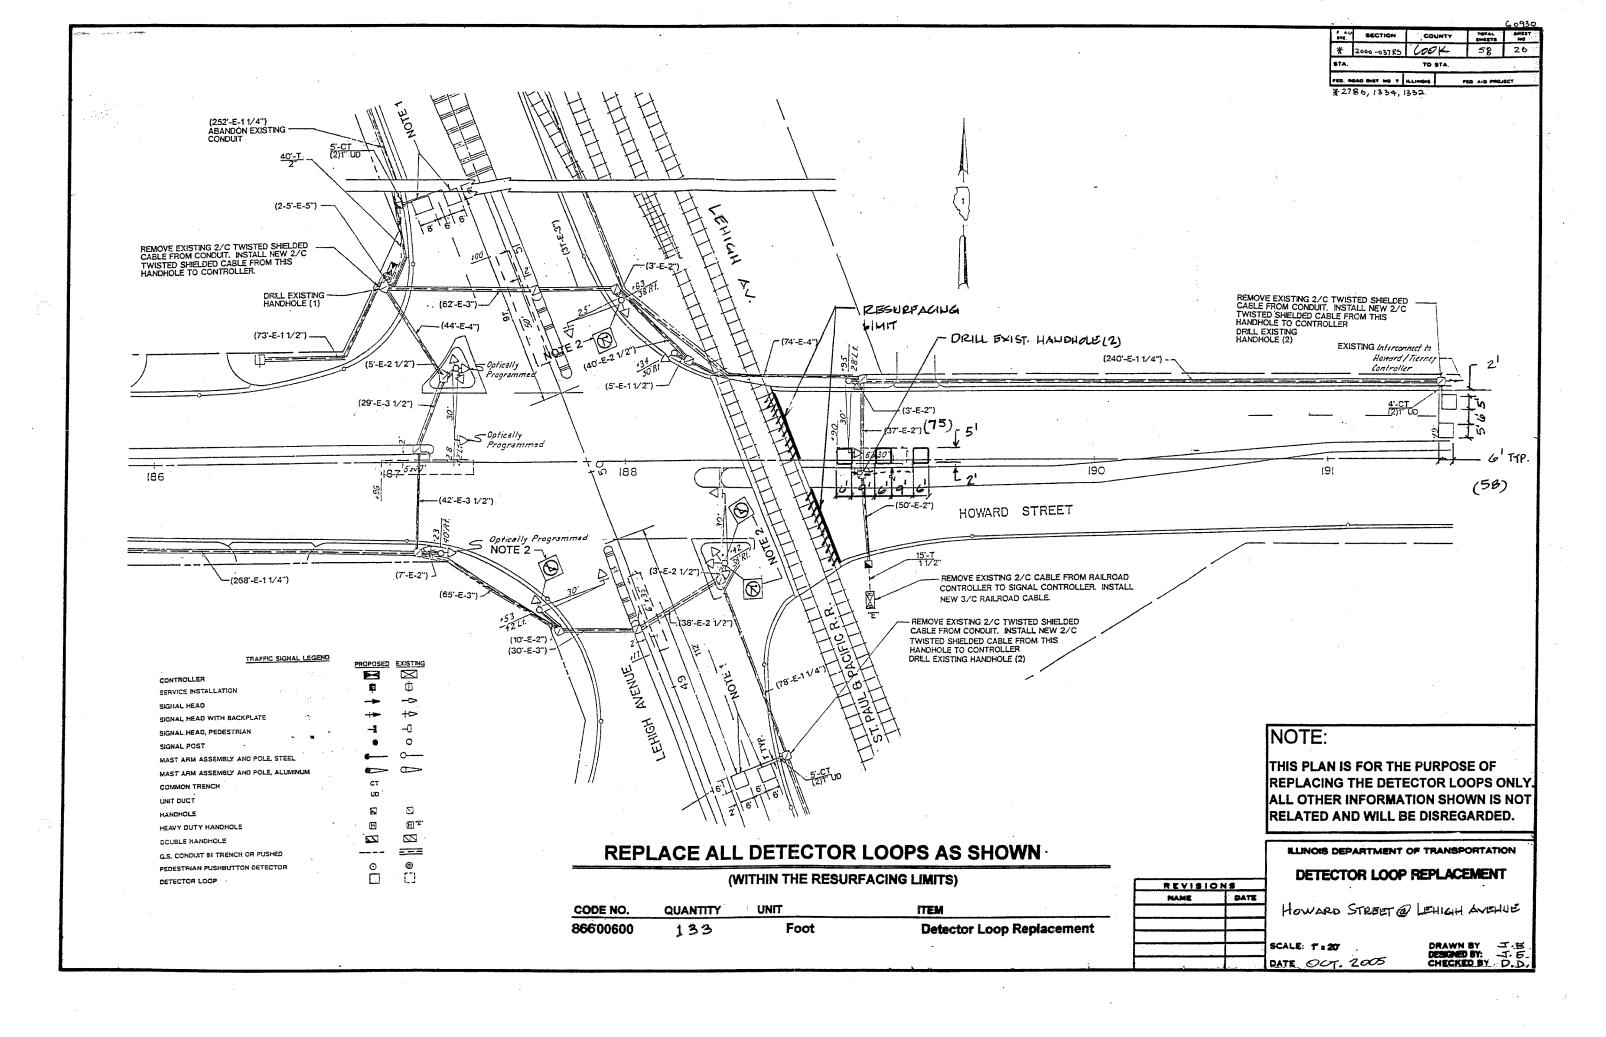


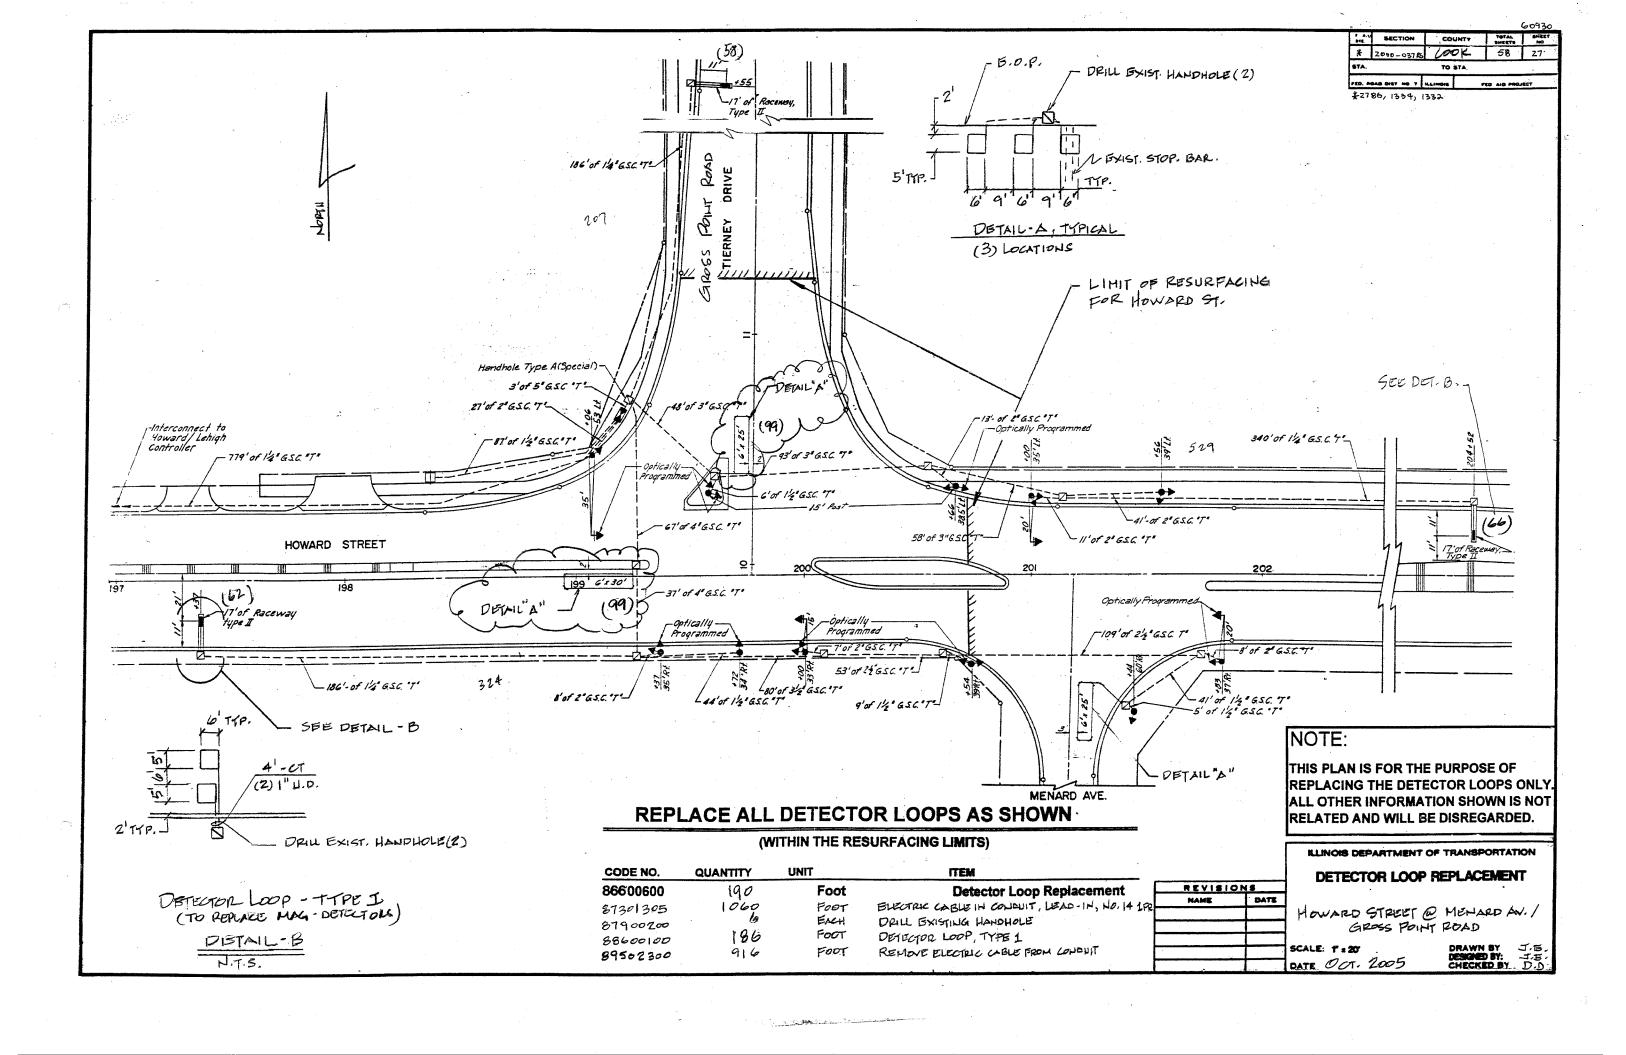


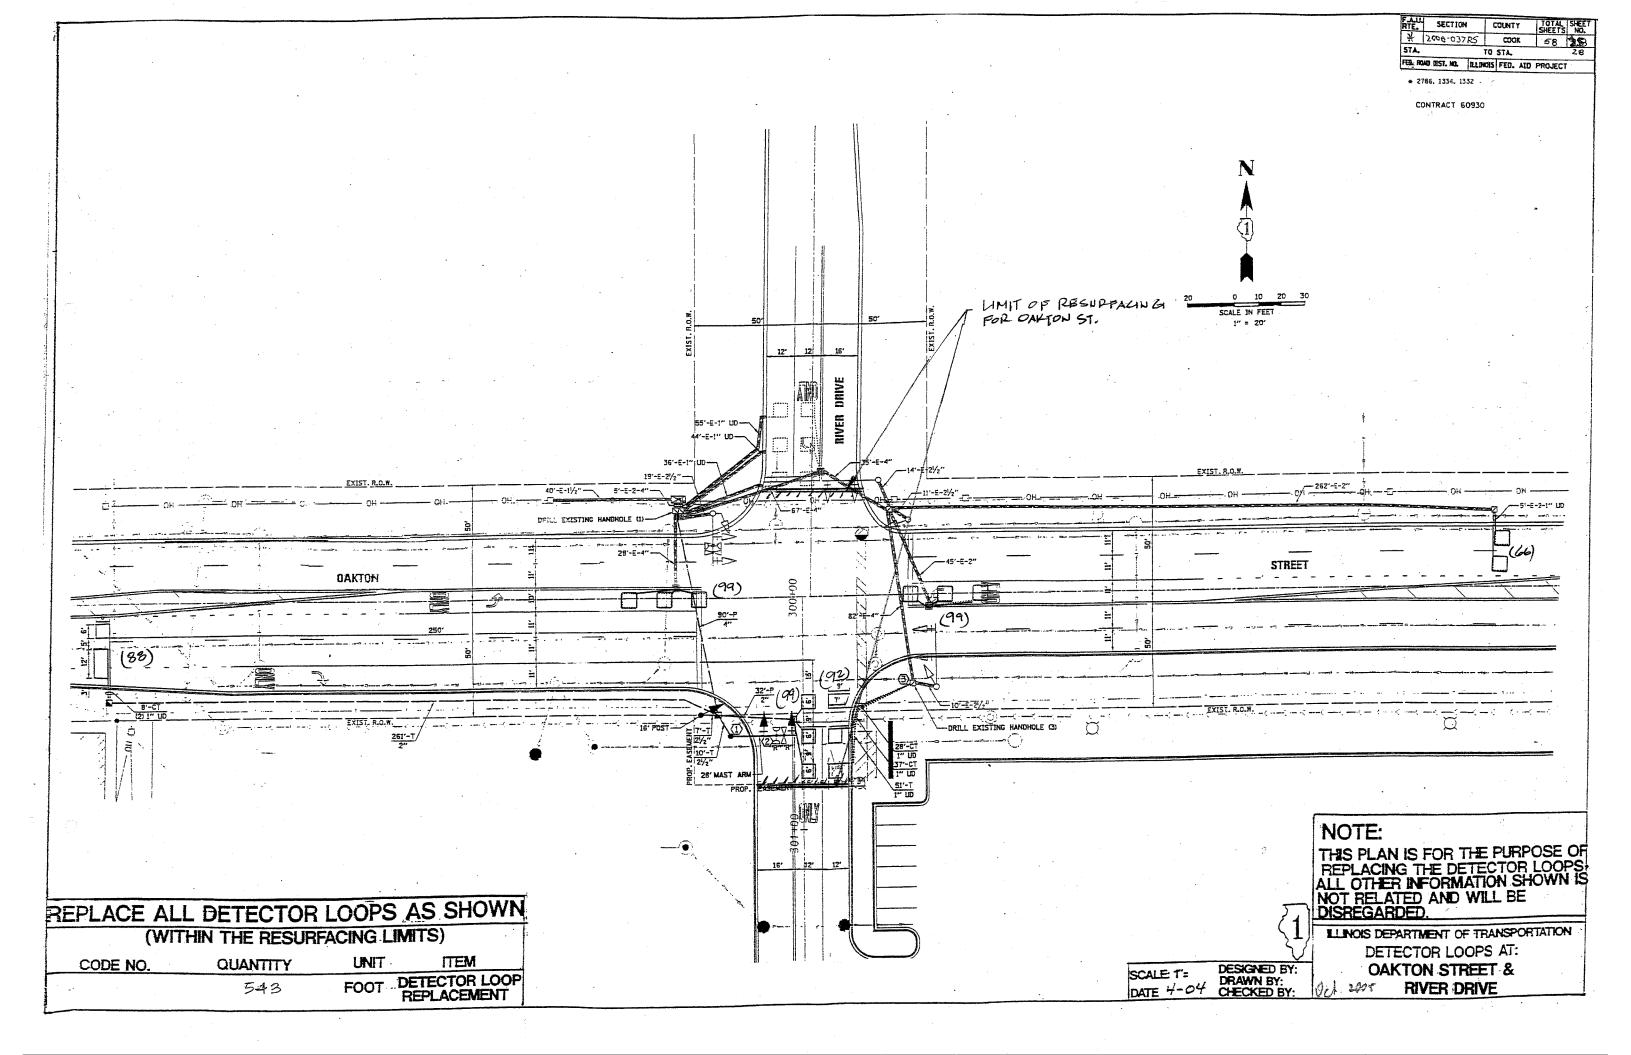

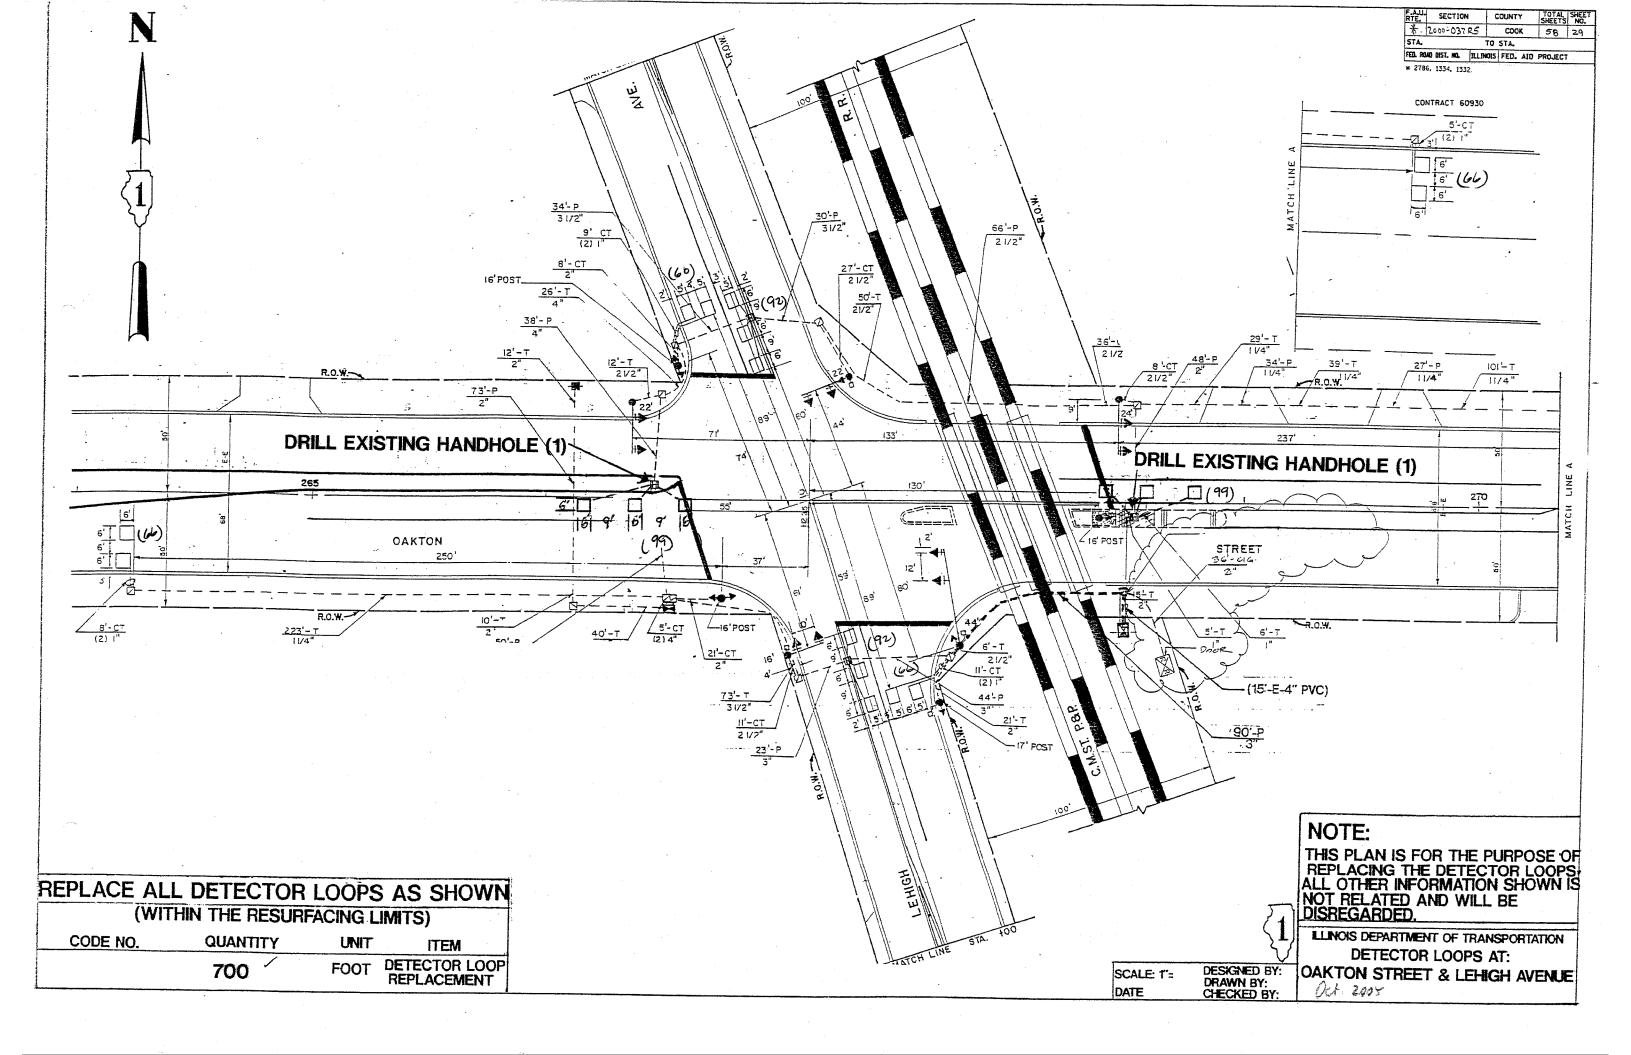

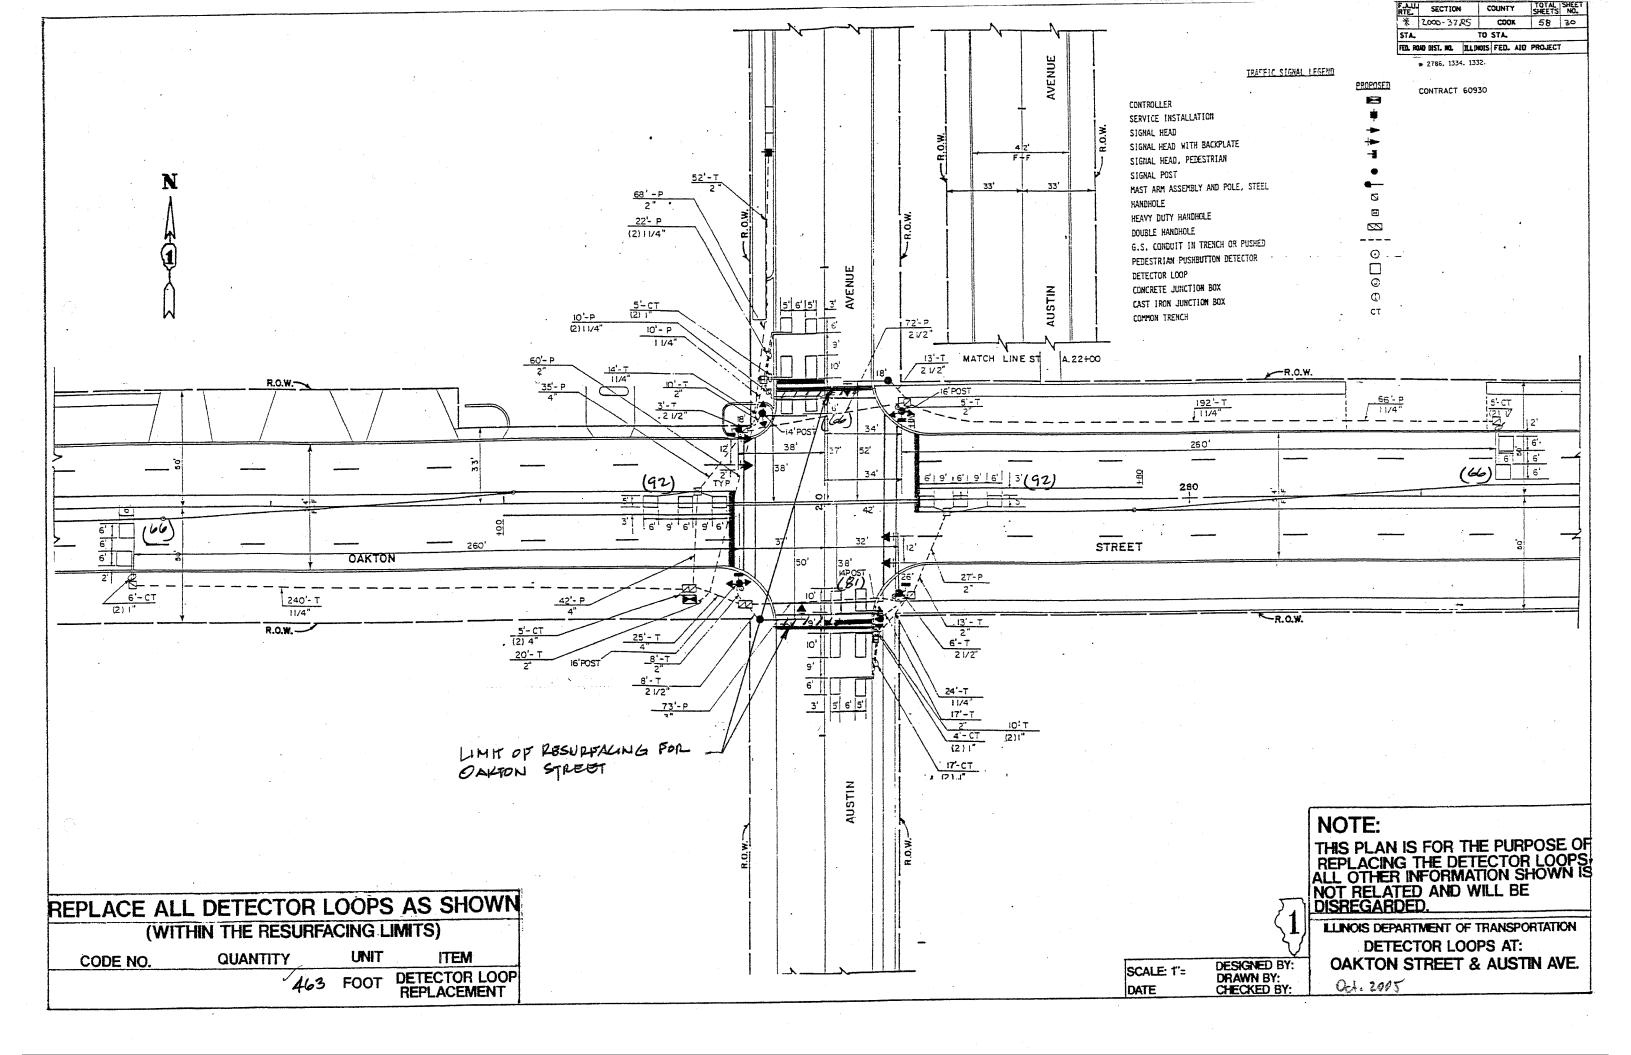

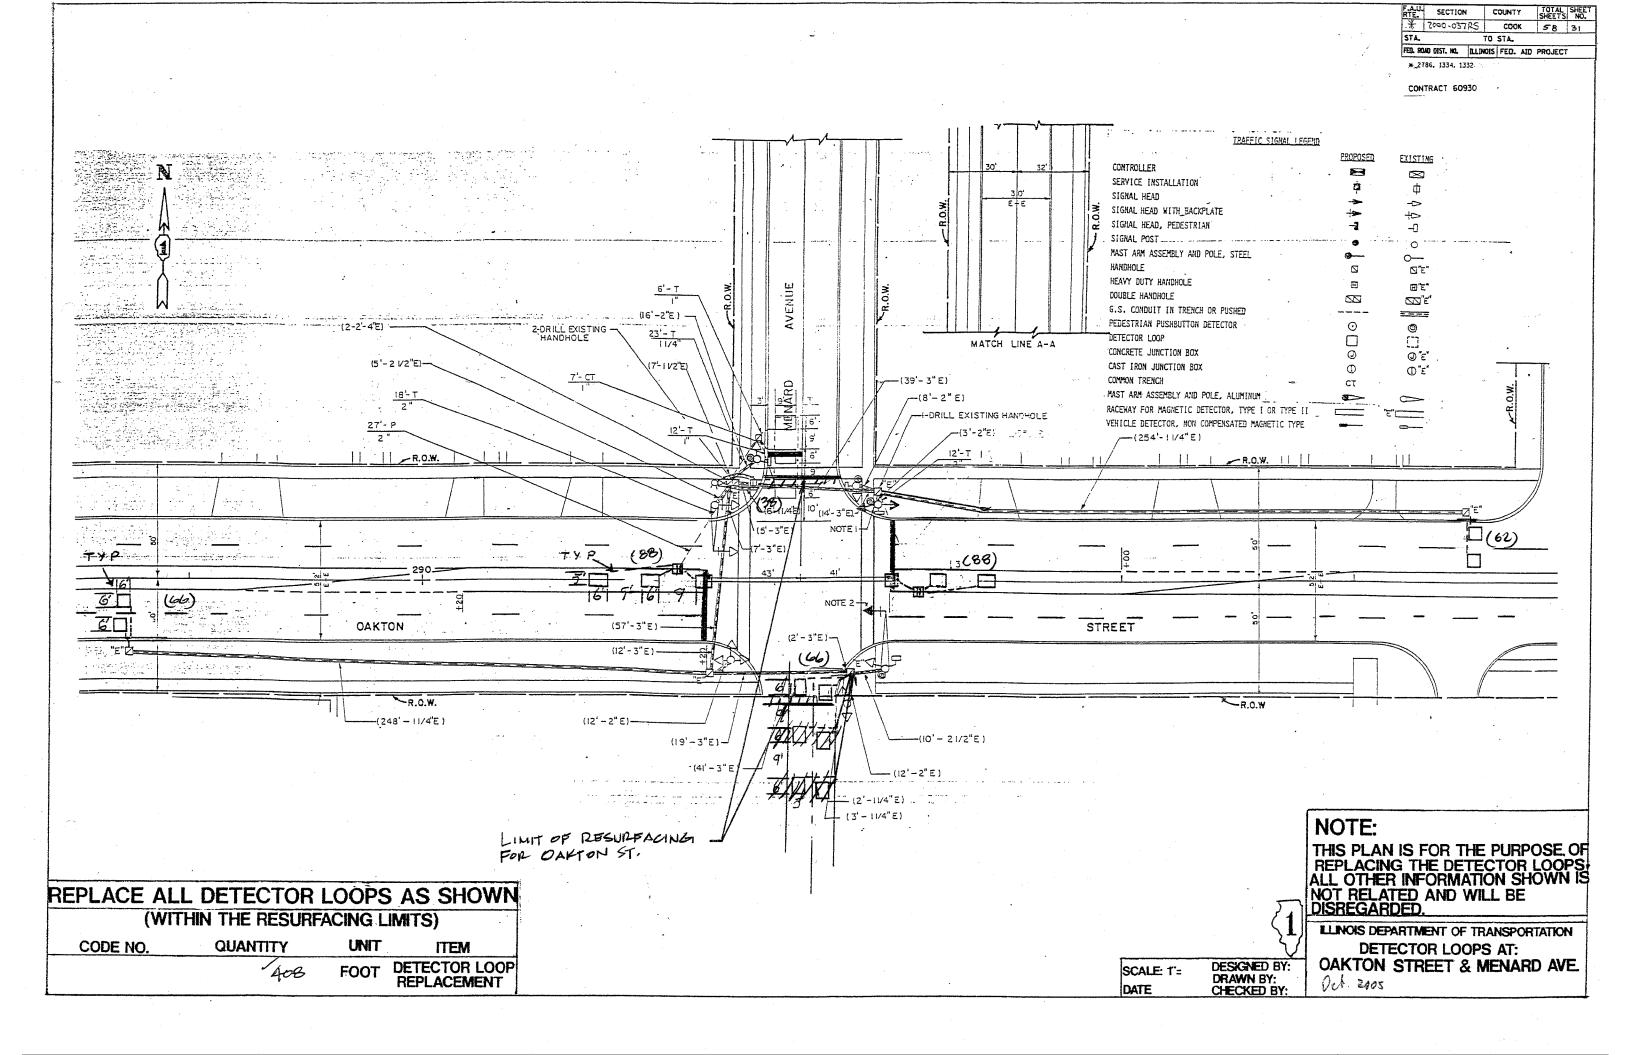


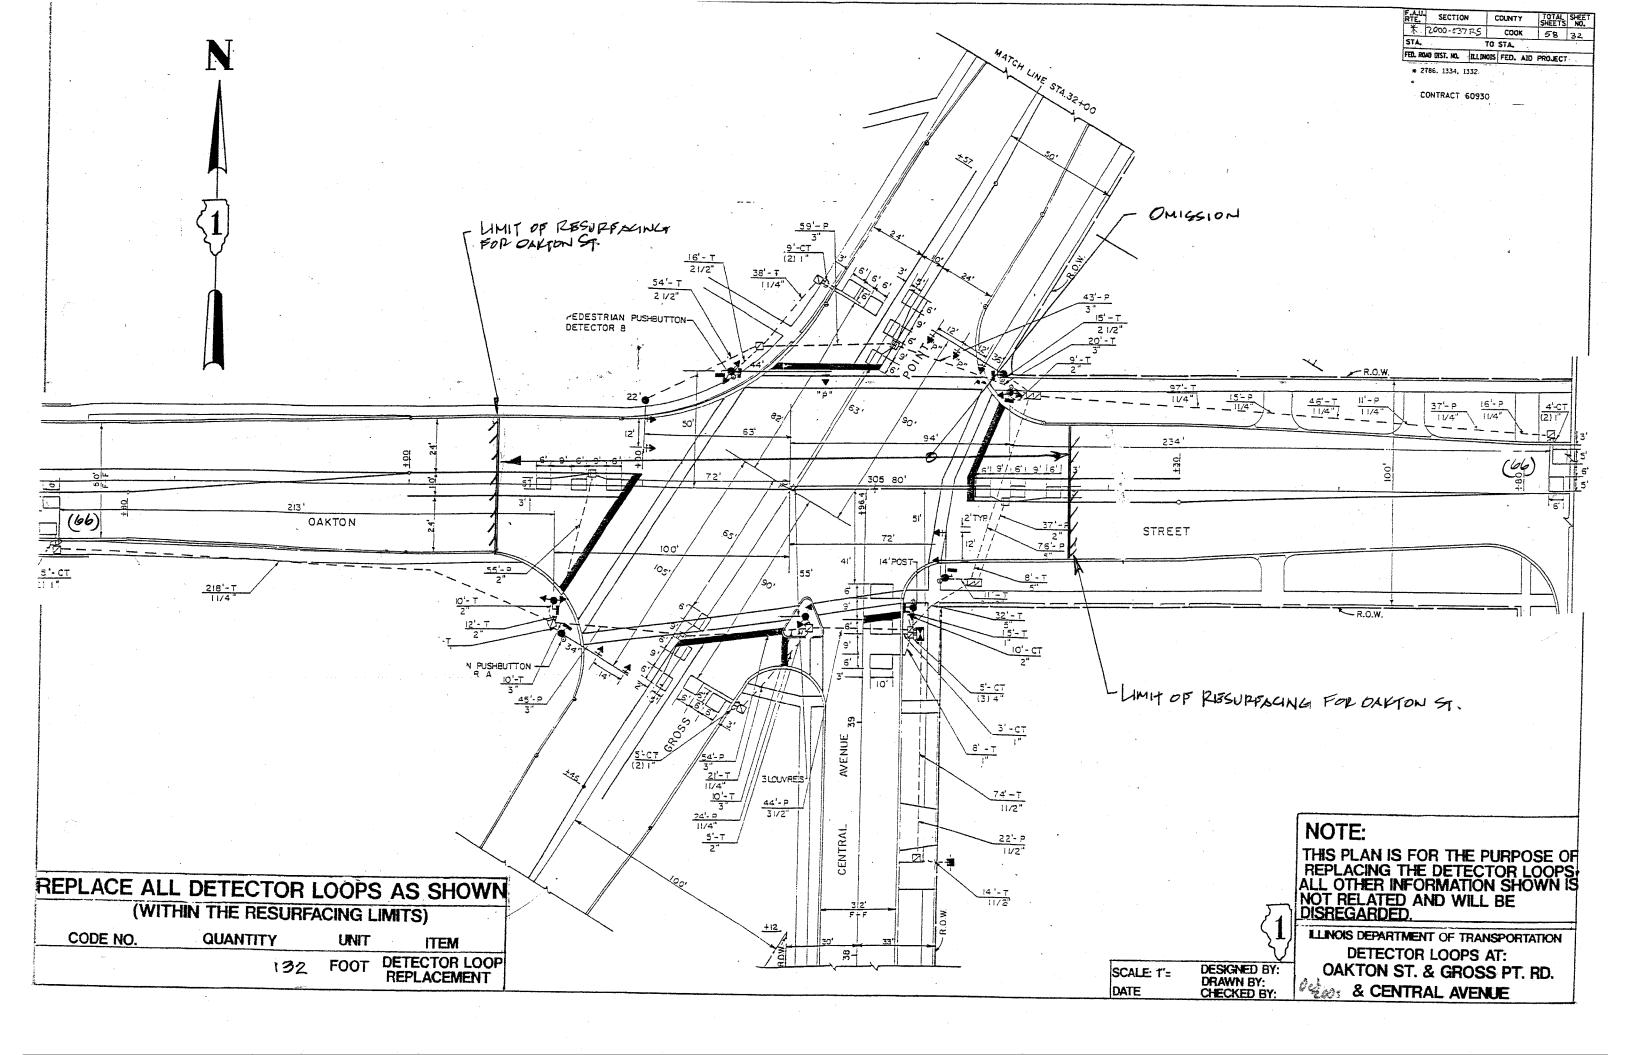


LOOP DETECTOR NOTES

- 1. EACH PAIR OF LOOP WIRES SHALL BE PLACED IN A SEPARATE UNIT DUCT FROM THE EDGE OF PAVEMENT TO THE HANDHOLE. SPACING BETWEEN THE HOLES DRILLED IN THE PAVEMENT SHALL NOT BE LESS THAN 6" (150 mm). UNIT DUCT SHALL BE INCLUDED IN THE COST OF THE LOOP
- 2. THE NUMBER OF LOOP TURNS SHALL BE AS RECOMMENDED BY THE AMPLIFIER MANUFACTURER. ALL ADJACENT SIDES OF THE LOOPS SHALL BE INSTALLED IN SUCH A WAY THAT THE CURRENT FLOW IS IN THE SAME DIRECTION TO REINFORCE ITS MAGNETIC FIELDS FOR SMALL VEHICLE DETECTION.
- 3. EACH LOOP LEAD-IN SHALL BE IDENTIFIED AND PERMANENTLY TAGGED IN THE HANDHOLE. EACH LEAD-IN CABLE TAG SHALL INDICATE THE LOCATION OF THE LOOP, LOOP ROTATION (CLOCKWISE/COUNTERCLOCKWISE), LOOP LEAD-IN DIRECTION (IN OR OUT), LOOP CABLE NUMBER AND LOCATION IN CABINET, AND NUMBER OF TURNS IN THE DETECTOR LOOPS IN WATER PROOF INK AS INDICATED ON THE DISTRICT 1 STANDARD TRAFFIC SIGNAL DESIGN DETAIL. THE CONTRACTOR SHALL MARK LOOP LOCATIONS ON RECORD DRAWINGS AND PRESENT TO THE ENGINEER AFTER FINAL INSPECTION. LOOPS SHALL BE MARKED BY LANE AND LOOP NUMBER. SEE DETAIL BELOW.
- 4. ALL LOOP CABLE SHALL BE FASTENED WITH PLASTIC TIE WRAP TO THE HANDHOLE HOOKS.
- 5. IN ASPHALT PAVEMENT, LOOPS SHOULD BE PLACED IN THE BINDER AND DIVEHOLES MARKED AT THE CURB WITH A SAW-CUT. THE SAW-CUT SHALL BE CUT IN ACCORDANCE WITH LOCAL AND E.P.A. DUST CONTROL REQUIREMENTS. DETECTOR LOOP(S) SHALL NOT BE INSTALLED IN WET CONDITIONS AND THE SAW-CUTS MUST BE FREE OF DEBRIS AND RESIDUE SUCH AS DUST AND WATER WHICH IS TO BE ACHIEVED BY THE USE OF COMPRESSED AIR, WIRE BRUSHING AND HEAT DRYING ACCORDING TO SEALANT MANUFACTURER REQUIREMENTS. THE DETECTOR WIRE SHALL BE HELD IN PLACE BY THE USE OF FORM WEDGES. WEDGES SHALL BE SPACED NO MORE THAN 18" (450 mm) APART.
- 6. LOOP SPLICES SHALL BE SOLDERED USING A SOLDERING IRON. BLOW TORCHES OR OTHER DEVICES WHICH OXIDIZE COPPER CABLE SHALL NOT BE ALLOWED FOR SOLDERING OPERATIONS. SEE DETAIL BELOW RIGHT.
- 7. PREFORMED DETECTOR LOOPS SHALL BE USED, AS SHOWN ON THE PLANS, WHERE NEW CONCRETE PAVEMENT IS PROPOSED. THE INSTALLATION OF PREFORMED LOOPS SHALL BE IN ACCORDANCE WITH THE DISTRICT 1 SPECIFICATIONS OR AS DIRECTED BY THE ENGINEER.

LOOP LEAD-IN CABLE TAG

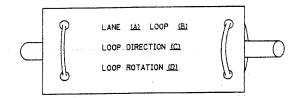



- A. LANE 1 IS THE LANE CLOSEST TO THE CENTERLINE OF THE ROADWAY
- B. LOOP *1 IS THE LOOP IN THE LANE CLOSEST TO THE INTERSECTION.
- C. LABEL LOOP CABLE "IN" OR LOOP CABLE "OUT".
- D. LABEL LOOP CABLE CLOCKWISE OR LOOP CABLE COUNTERCLOCKWISE.

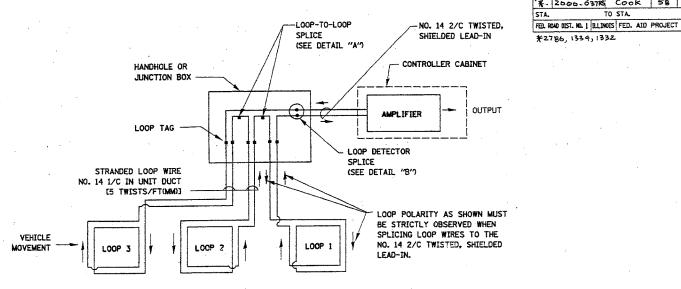


DETECTOR LOOP WIRING SCHEMATIC

- . LOOPS SHALL BE SPLICED IN SERIES.
- * SAW-CUTS SHALL BE A MINIMUM WIDTH OF 5/16" (8 mm).
- * SAW-CUT DEPTHS SHALL BE 3" (75 mm). IF IN CONCRETE, THE SAW-CUT DEPTH SHALL BE TO THE TOP OF THE REINFORCEMENT.
- LOOP CORNERS SHALL BE DRILLED WITH A 2" (50 mm) DIAMETER CORE.

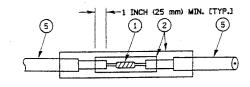

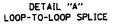

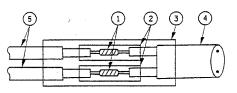

DETAIL "B" LOOP-TO-CONTROLLER SPLICE

LOOP DETECTOR SPLICE


- (1) WESTERN UNION SPLICE SOLDERED WITH ROSIN CORE FLUX. ALL EXPOSED SURFACES OF THE SOLDER SHALL BE SMOOTH.
- (2) WCSMW 30/100 HEAT SHRINK TUBE, MINIMUM LENGTH 3" (75 mm), UNDERWATER GRADE.
- (3) WCS 200/750 HEAT SHRINK TUBE, MINIMUM LENGHT 6" (150 mm), UNDERWATER GRADE.
- (4) NO. 14 2/C TWISTED. SHIELDED CABLE.
- (5) LOOP CONDUCTOR WITH FLEXIBLE PLASTIC TUBE.


REVISIONS		TULINOIS DEPARTMEN	NT OF TRANSPORTATION			
NAME	NAME DATE					
 		DISTRICT ONE				
		STANDARD TRAFFIC SIGNAL				
		DESIGN	DETAILS			
		SCALE: VERT. NONE	DRAWN BY: RWP DESIGNED BY: DAD			
		DATE 1-01-02	CHECKED BY: JAZ SHEET OF .			


F.A.P. SECTION COUNTY

¥2786, 1334, 1332


* 2006-6378 Cook 58 33

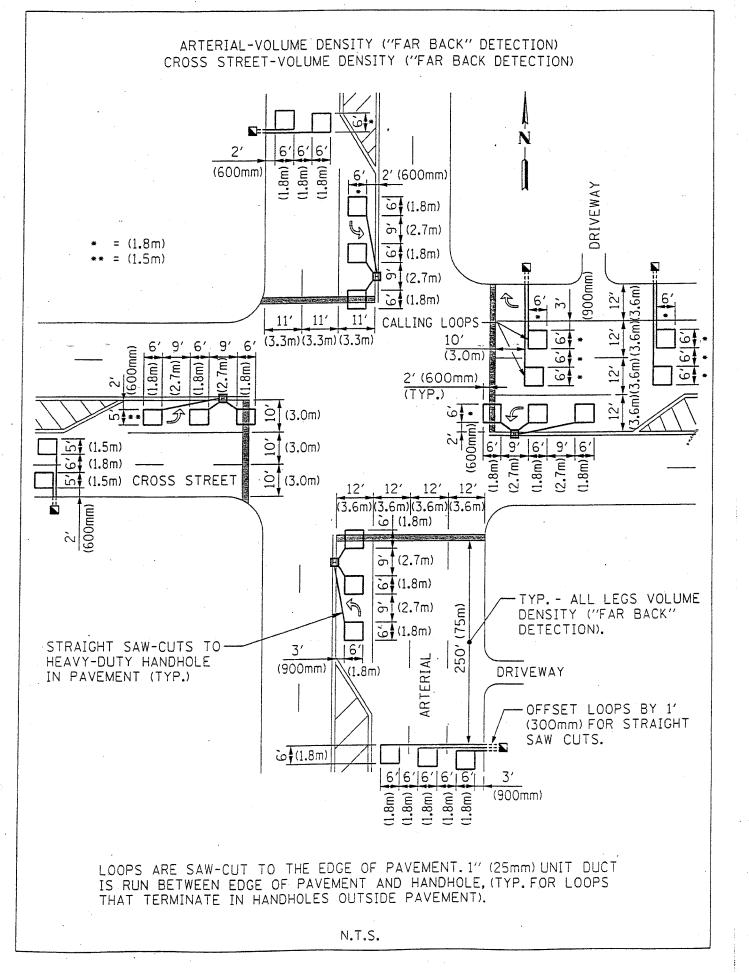

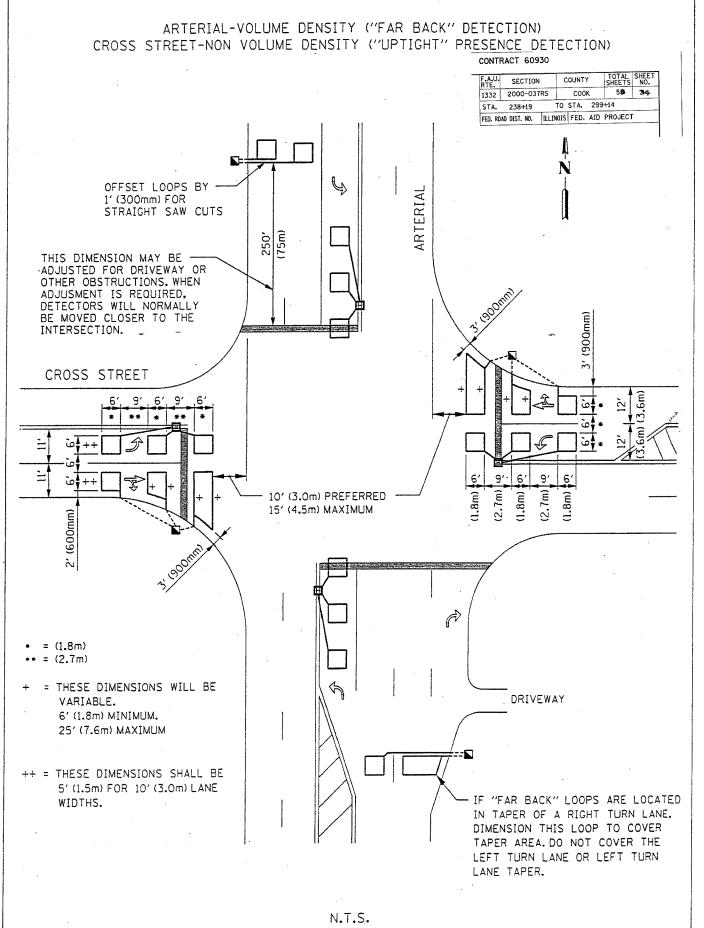

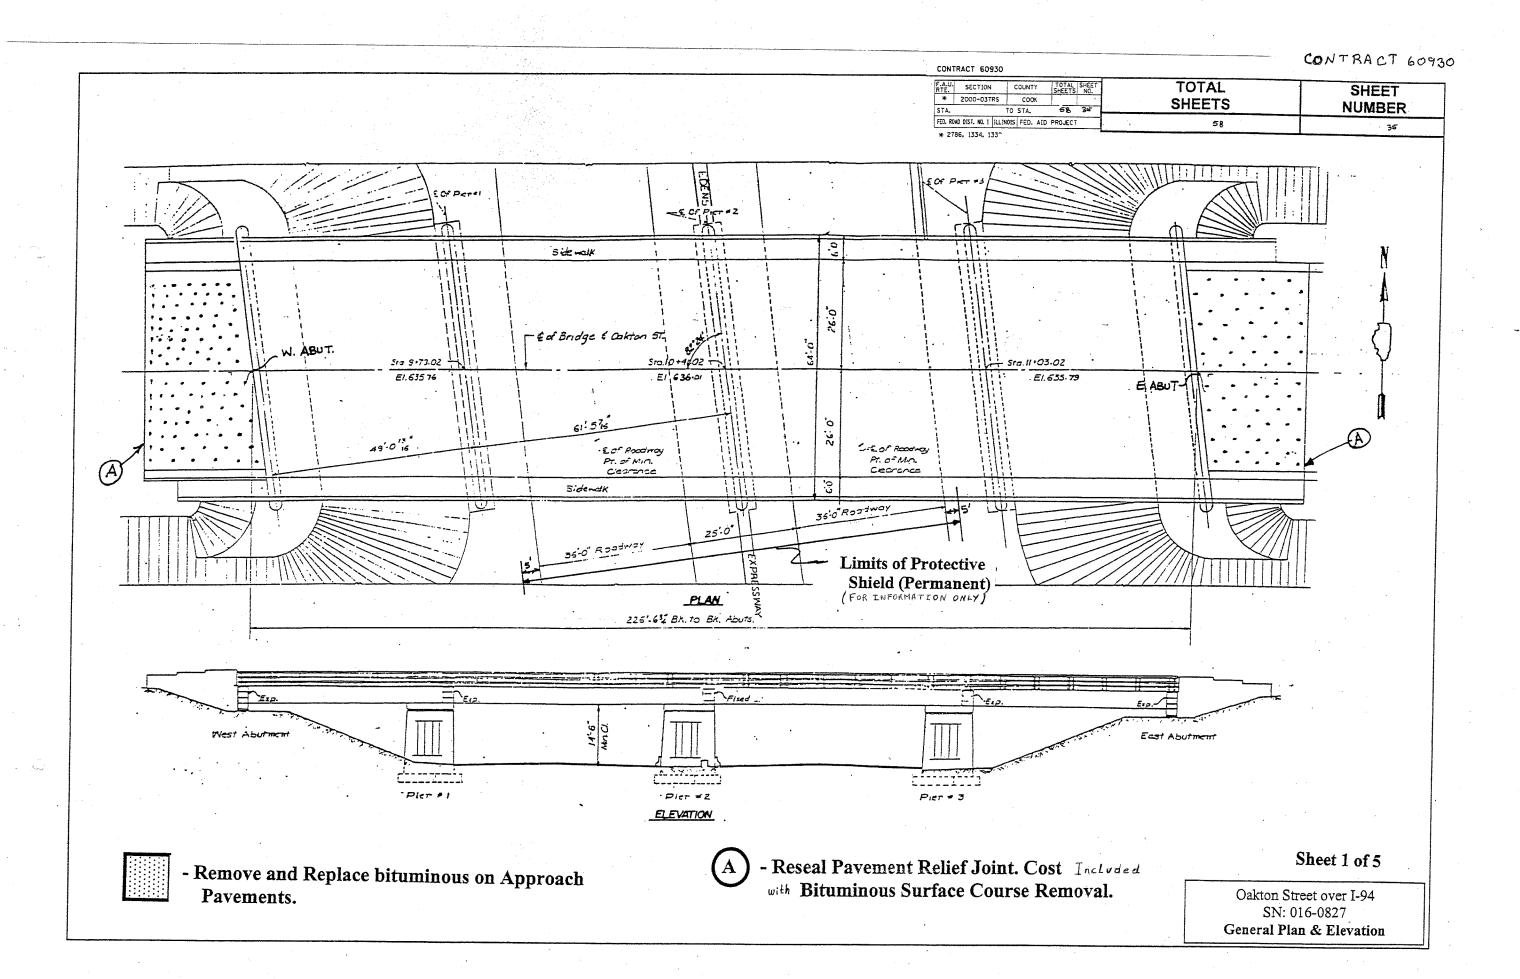

F.A.U. RTE.	SECTION	COUNTY	TOTAL	SHEET NO.	TOTAL	SHEET
STA.	2000-037RS	COOK TO STA.	58	34	SHEETS	NUMBER
	D DIST. NO. 1 ILLIN	OES FED. AIE	PROJEC			36

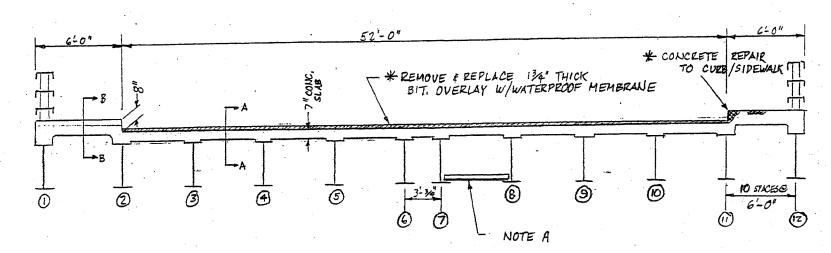

CROSS SECTION

GENERAL NOTES

- 1. DO NOT SCALE PLANS FOR DIMENSIONS.
- 2. PATCHING LOCATIONS ARE ESTIMATED ONLY, FINAL LOCATIONS SHALL BE DETERMINED BY THE ENGINEER IN THE FIELD.
- 3. IT SHALL BE THE CONTRACTOR'S RESPONSIBILITY TO VERIFY ALL DIMENSIONS AND CONDITIONS EXISTING IN THE FIELD PRIOR TO CONSTRUCTION AND ORDERING OF MATERIALS.
- 4. THE CONTRACTOR WILL NOT BE ALLOWED TO SET UP A YARD OR FIELD OFFICE ON STATE PROPERTY WITHOUT WRITTEN PERMISSION FROM THE DEPARTMENT.
- 5. WHEN ARTIFICAL LIGHTING IS UTILIZED IN NIGHT OPERATIONS, THE CONTRACTOR SHALL EXERCISE THE UTMOST PRECAUTIONS IN PREVENTING ADVERSE VISIBILITY TO THE MOTORING PUBLIC AND ADJOINING RESIDENTIAL AREAS.
- 6. THE CONTRACTOR SHALL CONTACT THE DISTRICT ONE TRAFFIC CONTROL SUPERVISOR AT 847/705-4155 A MINIMUM OF 72 HOURS IN ADVANCE OF BEGINNING WORK.

NOTE A:

THERE IS EXISTING PERMANENT PROTECTIVE SHIELDING BETWEEN BEAMS 1-12, WHICH EXTENDS OVER TRAFFIC LANES AND HALF OF THE SHOULDER, THAT SHALL REMAIN IN PLACE. THE CONTRACTOR SHALL PROVIDE ADDITIONAL TEMPORARY PROTECTION, IF NECESSARY, ACCORDING TO ART. 107.09 OF THE STANDARD SPECIFICATIONS. ALL DEBRIS SHALL BE REMOVED FROM THE PERMANENT PROTECTIVE SHIELDING BY THE COMPLETION OF THE CONTRACT.

Bill Of Materials	Unit	Quantity
Deck Slab Repair (Full Depth Type I)	SY	26
Deck Slab Repair (Full Depth Type II)	SY	175
Deck Slab Repair (Partial)	SY	39
STRUCTURAL REPAIR OF CONCRETE DEPTH 4 5"	SF	246
Polymerized Bituminous Concrete Surface Course, Mix F, Super Pave, N90*	Ton	145
Bituminous Concrete Removal (Deck)	SY	1,525
SiliconeJoint Sealer, 2¾"	LF	130
	:	
Waterproofing Membrane System	SY	1,294
STRUCTURAL STEEL REPAIR	LBS	365

^{* -} Includes quantities for the Bridge Approach Pavement.

All new structural steel shall be shop painted with the inorganic zinc rich primer per AASHTO M 300, Type 1. Cost included with Structural Steel Repair.

The existing structural steel coating contains lead. The Contractor should take appropriate precautions to deal with the presence of lead on this project.

Existing structural steel that will be in contact with new structural steel shall be cleaned and painted prior to erection as required by the Special Provision "Cleaning and Painting Contact Surface Areas of Existing Steel Structures"..


Sheet 2 of 5

Oakton Street over I-94 SN: 016-0827 General Notes & Cross Secti

General Notes & Cross Section Bill of Material

			CONTRACT 60930			
		•			OTAL	SHEET
			* 2000-037RS STA. TO S	COOK SH	EETS	NUMBER
			FED. ROAD DIST. NO. 1 ILLINOIS	ED. AID PROJECT	58	. 37
			* 2786, 1334, 1332 ′.			
		•				11.3 11.3
						٠
	•				1	
		224'-1"				
	_	7		•	7.	
	8	8	· · · · · · · · · · · · · · · · · · ·	4	ABUT.	•
	<u> </u>	PIER		<u>m</u>		.0
			™ Rect	~	Ш	
						4
						7
	7777777 12.5E	177777				
	3-10	5'x 6'			•	14
1	2189	303E				
1						10-
Ţ	\\\\\\\\\\\\\\\\\\\\\\\\\\\\\\\\\\\\\\	2' 185F 2' 185F	4'x5'	\\\\\\\\\\\\\\\\\\\\\\\\\\\\\\\\\\\\\\	12'	22
	12554 x 3 3 3 45 45 F 2 x	2' 105F	ZOSE	485F		
*						2)
						
			4	. "		7 27
		4	BIT, WEAR, SURF.			64'.
		- 245E	MAP CRACKED			.0
, A	A A C C C C C C C C	4'x6'				26-0"
4	SEE SHEET 5 TYPICAL BOTH APUT 35 SE	5'x6'	4	×4¹		0,0
	B B TYPICAL BUTH AFT 353F	305F 165F				1 1 1
	1 1	3°\$F			1005F	4 44
e, s				85 40 0	\$4'xZ' 50'x2' 3	<u> </u>
	M. ABUT.	6				= 7
	กลัง					Ī
	72					'
		TOP OF DECK SUE	PVFY			
	***	10. 01 000X 300				
	- Existing Partial Depth Patch		4			
				TIME LIATER	TIPPETT Of he	
	- Deck Slab Repair Partial Depth			FIELD NOTES: J. DRAWN BY: J. TIP	1188ELK 4/14/	P5
				DRAWN BY: J. TIP	PETT 9/14/05	
	- Formed Concrete Repair Sidewalk &	Curb		5 .	*	heet 3 of 5
	Millilly - 1 office Concrete Repair Sidewalk &	Cuib			3	Heer 2 of 2
				· ·	Oakton Stree	
					SN: 016	
					Top Deck	Survey

F.A.U. RTE.	SECTION	COUNTY	TOTAL	SHEET NO.	TOTAL	SHEET
* STA.	2000-037R\$	COOK TO STA	58	38	SHEETS	NUMBER
	AD DIST. NO. 1 111.19	IOIS FED. AIL	PROJECT		28	. эв

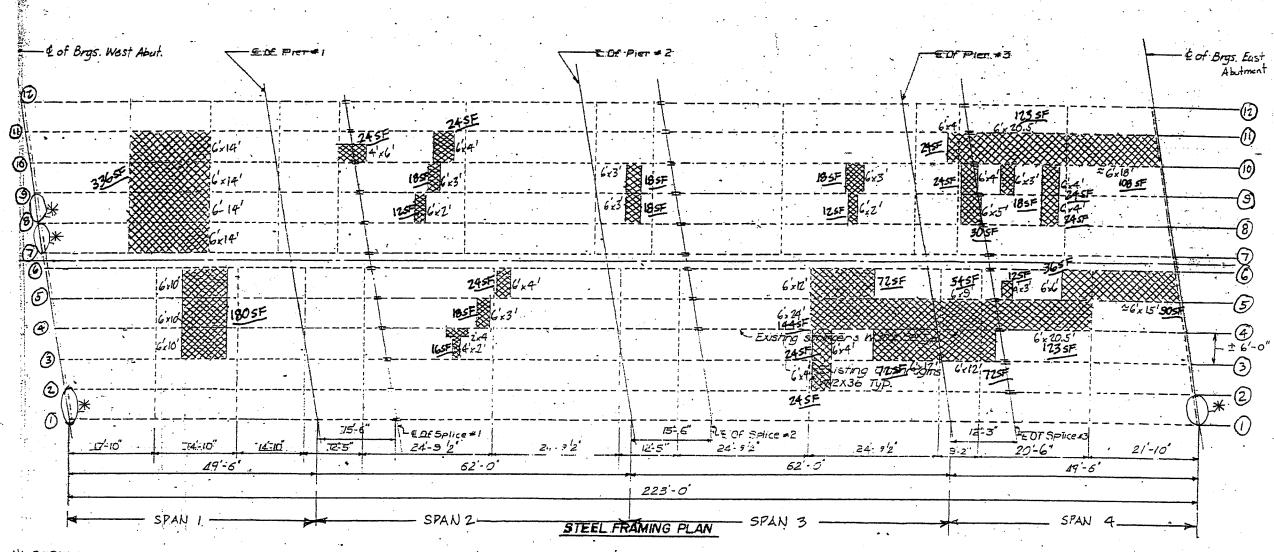


* REPLACE DIAPHRAMS W 12×36 (4) DECK UNDERSIDE
Cost of removal & replacement of clip angles required to replace diaphragms included in cost of "structural Steel Repair."

FIELD NOTÉS: J. TIPPETT 9/14/05 DRAWN BY: J. TIPPETT 9/14/05

- Deck Slab Repair Full Depth Type I & II

Sheet 4 of 5

Oakton Street over I-94 SN: 016-0827 **Bottom Deck Survey**

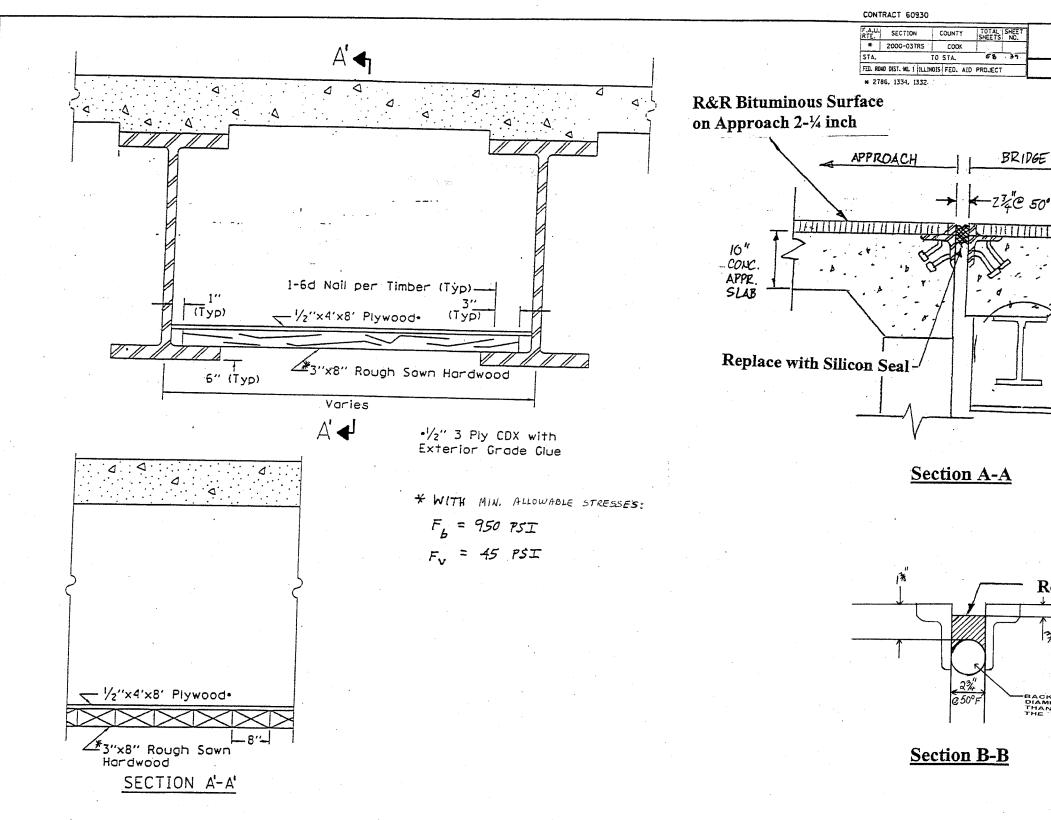



EXISTING PROTECTIVE SHIELD (PERMANENT) DETAILS

FOR INFORMATION ONLY

TOTAL SHEET SHEETS NUMBER · 58


> RR Bituminous Surface on Bridge Deck w/Waterproofing - 1-3/4 inch

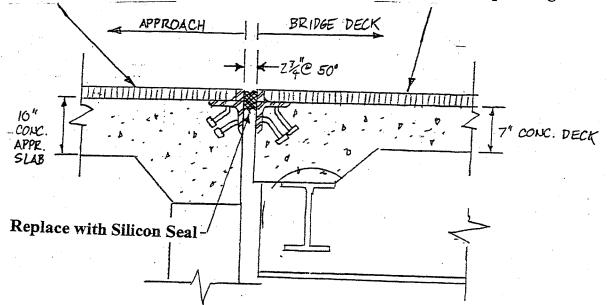


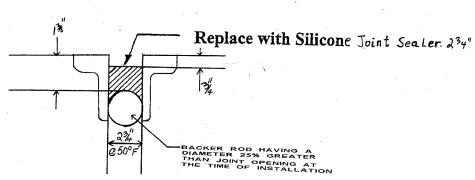



Sheet 5 of 5

Oakton Street over I-94 SN: 016-0827 **Details**

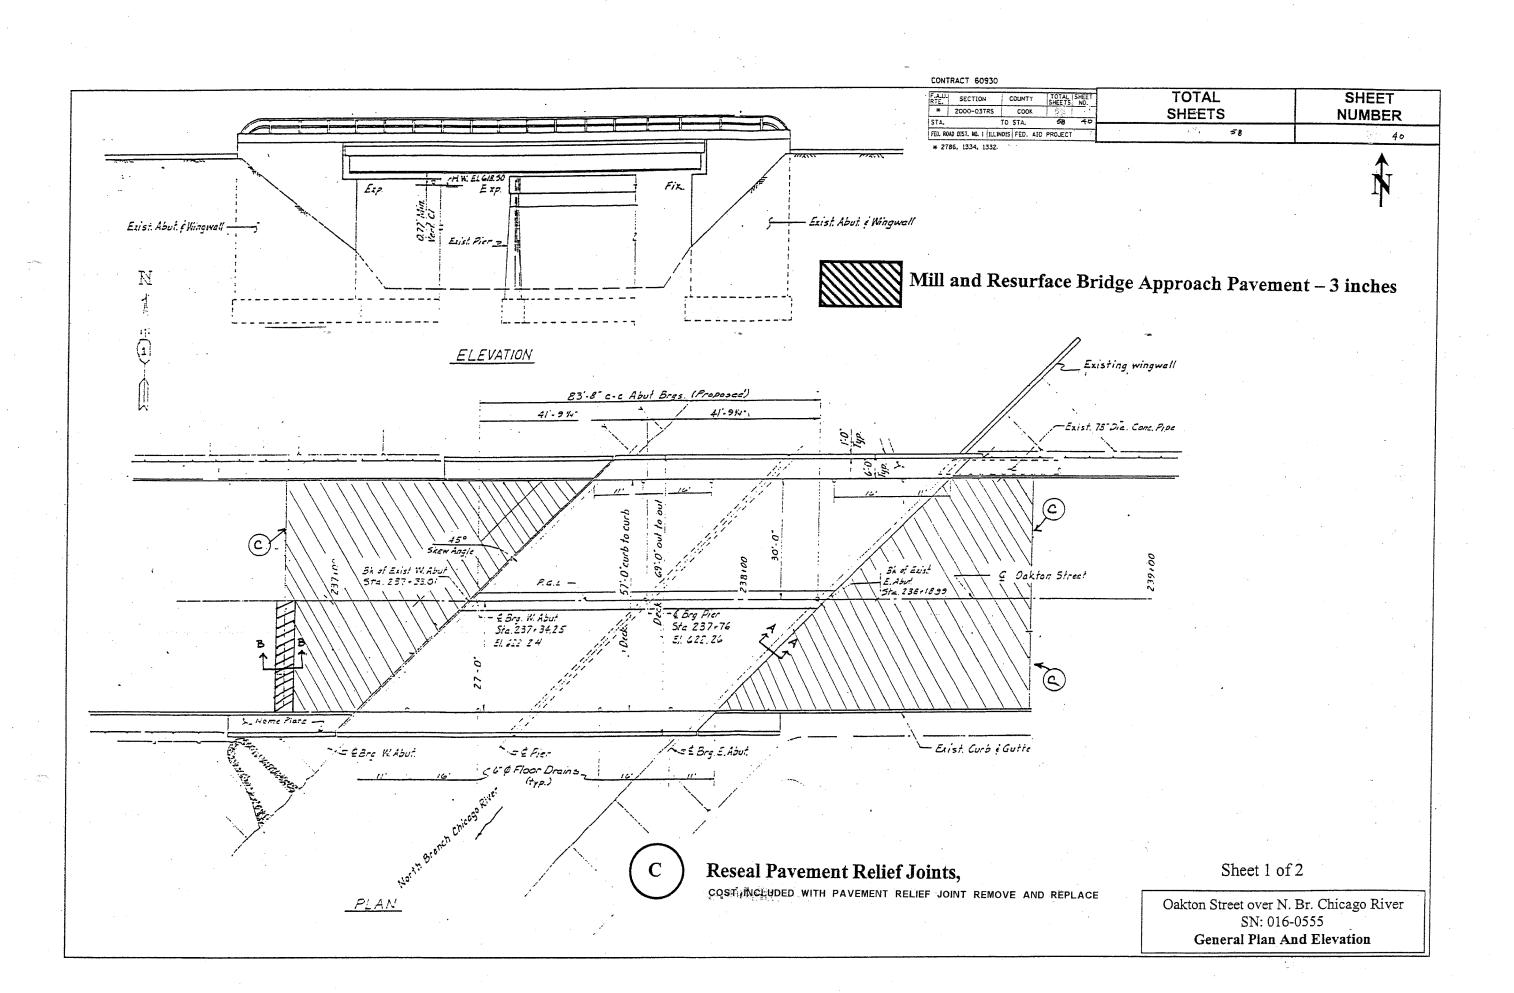


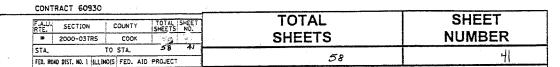

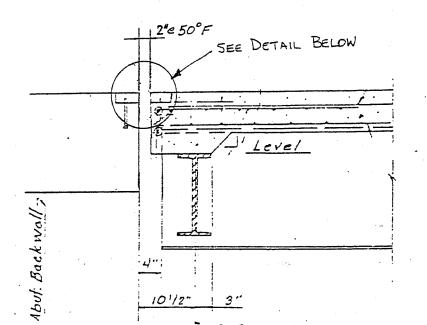

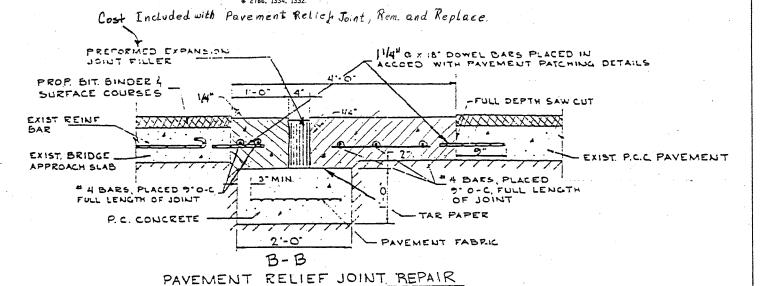

SECTION A-A

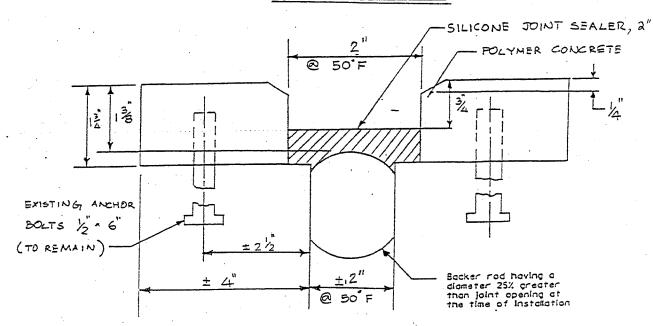

BILL OF MATERIALS

ITEM	UNIT	QUANTITY
Bituminous Surface Removal (3")	SY. YD.	507
Pavement Relief Joint Remove and Replace	SQ. FT.	107
Poly. Bituminous Concrete Surface, Superpave Mix "F", N90 (1 3/4")	TON	50
Poly. Leveling Binder (Machine Method), Superpave, IL-4.75, N50 (1 1/4")	TON	35
SILICONE JOINT SEALER, 2"	L. FOOT	98
Polymer Concrete	CU. FT.	9.5


AT EXISTING NEOPRENE JOINT LOCATION

Sheet 2 of 2

Oakton Street over N. Br. Chicago River SN: 016-0555 **Details**

Removal of Existing Neoprene Blocks and Glands is included with Polymer Concrete.

COUNTY TOTAL SHEET NO F. A.U SECTION * 2000-037 RS COOK 58 42 TO STA. FED. ROAD DIST. NO. _ BLINOIS FED. AID PROJECT *2786, 1334, 1332

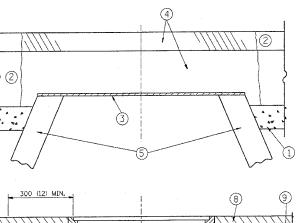

PROPOSED SAND FILL PROPOSED - BRICK, MORTAR, OR CONC. ADJUSTING RINGS PROPOSED

NOTES:

EXISTING BROKEN FRAMES AND LIDS SHALL BE REMOVED AND DISPOSED OF BY THE CONTRACTOR AND SHALL BE REPLACED AS DIRECTED BY THE ENGINEER. REPLACEMENT FRAMES AND LIDS WILL BE PAID FOR IN ACCORDANCE WITH ARTICLE 109.04 OF THE STANDARD SPECIFICATIONS UNLESS A SEPARATE PAY ITEM HAS BEEN PROVIDED.

SAND FILL

IF THE EXISTING LIDS ARE OPEN, THE FRAME WILL BE ADJUSTED TO THE ELEVATION OF THE MILLEN PAVEMENT SURFACE PRIOR TO THE MILLING OPERATION. THE FRAME WILL NOT SE REMOVED AND COVERED BY THE METAL PLATE.

CITY OF CHICAGO CASTINGS ARE THE PROPERTY OF THE CITY AND THE CONTRACTOR SHALL MOTIFY THE CITY FOR REMOVAL AND DISPOSITION OF THE CASTINGS.

THE METAL PLATE USED TO COVER THE STRUCTURE SHALL REMAIN THE PROPERTY OF THE CONTRACTOR.

WHEN STRUCTURES ARE TO BE ADJUSTED OR RECONSTRUCTED, THE LOWERING AND RAISING OF THE FRAMES AND LIDS WILL NOT BE PAID FOR SEPARATELY BUT WILL BE INCLUDED IN THE COST OF THE CORRESPONDING PAY ITEM.

CONSTRUCTION PROCEDURES

STACE 1 (BEFORE PAVEMENT MILLING)

- A) REMOVE A MINIMUM OF 300 (12) OF THE PAVEMENT FROM AROUND THE STRUCTURE.
- B) REMOVE THE EXISTING FRAME AND LID FROM THE STRUCTURE.
- C) COVER THE STRUCTURE OPENING WITH A 900 (36) DIAMETER METAL PLATE.
- D) BACKFILL WITH CRUSHED STONE AND A MINIMUM 40 $(1^1/2)$ THICK BITUMINOUS MATERIAL APPROVED BY THE ENGINEER.

STAGE 2 (AFTER PAVEMENT MILLING)

- A) REMOVE THE BITUMINOUS MATERIAL AND CRUSHED STONE.
- B) INSTALL THE FRAME AND LID; ADJUST THE FRAME TO ITS FINAL SURFACE ELEVATION.
- C) THE SURROUNDING SPACE SHALL BE FILLED WITH CLASS SI CONCRETE, OR BITUMINOUS CONCRETE SURFACE OR BINDER COURSE MATERIAL TO THE ELEVATION OF THE SURFACE OF THE EXISTING BASE COURSE OR THE BINDER COURSE.

THE PROCEDURE EXPLAINED ABOVE SHALL CONFORM TO THE APPLICABLE PORTIONS OF SECTIONS 353, 406, 602, AND 603 OF THE STANDARD SPECIFICATIONS.

LEGEND

- 1 SUB-BASE GRANULAR MATERIAL
- 2 EXISTING PAVEMENT
- 3 900 (36) DIAMETER METAL PLATE
- PROPOSED CRUSHED STONE AND BITUMINOUS MATERIAL
- 5 EXISTING STRUCTURE
- 6 FRAME AND LID (SEE NOTES)
- 7 CLASS SI CONCRETE. BITUMINOUS CONCRETE SURFACE OR BINDER COURSE MATERIAL
- 8 PROPOSED BITUMINOUS CONCRETE SURFACE COURSE
- 9 PROPOSED BITUMINOUS CONCRETE BINDER COURSE

LOCATION OF STRUCTURES:

THE CONTRACTOR WILL BE REQUIRED TO KEEP A RECORD OF THE LOCATIONS OF THE BURIED STRUCTURES ACCORDING TO THE STATION AND DISTANCE LEFT OR RIGHT OF THE CENTERLINE OF PAVEMENT. UPON COMPLETION OF THE WORK, THE CONTRACTOR WILL DELIVER THE RECORD TO THE ENGINEER.

BASIS OF PAYMENT: FRAMES AND LIDS TO BE ADJUSTED, SPECIAL EACH

NEW FRAMES AND LIDS, WHEN SPECIFIED, WILL BE PAID FOR SEPARATELY.

DETAILS FOR FRAMES AND LIDS ADJUSTMENT WITH MILLING

ALL DIMENSIONS ARE IN MILLIMETERS (INCHES) UNLESS OTHERWISE SHOWN

ILLINOIS DEPARTMENT OF TRANSPORTATION

DETAILS FOR FRAMES AND LIDS ADJUSTMENT WITH MILLING

SCALE: NONE


DRAWN BY


CHECKED BY

BD600-03 (BD-8) REVISION DATE: 05/17/04

IO/26/2005 W:\diststd\bd08.dgn VI-BD8

::::std\bb08.dgn 10/26/2006 3:18:43 PM User=gs1:lsu=efp

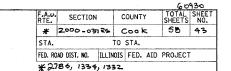

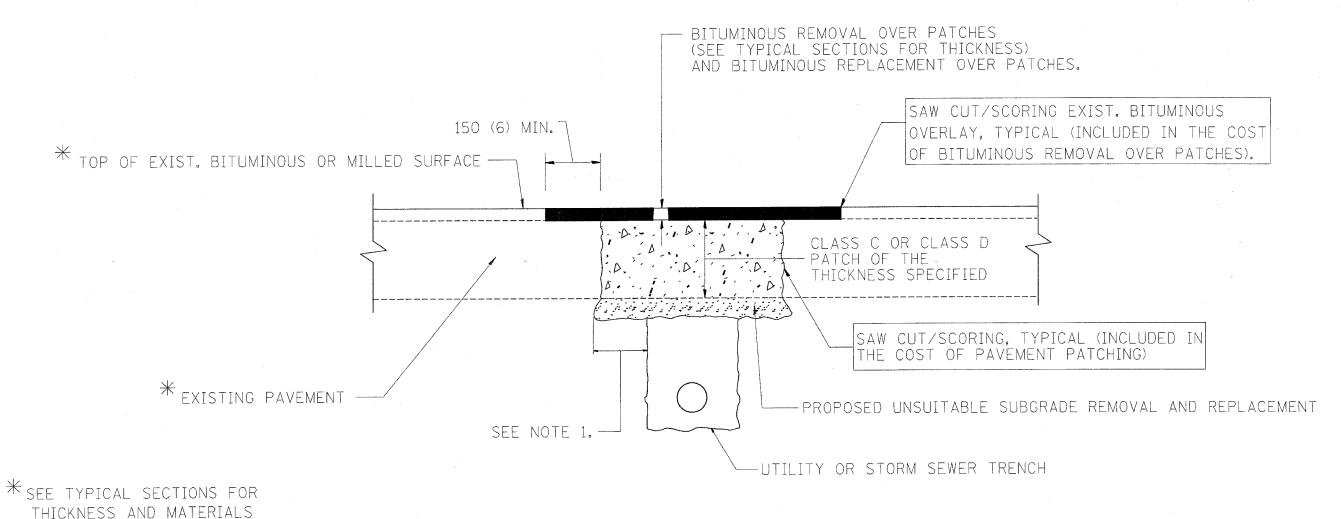

NOTES:

- 1. THE WIDTH OF THE FULL DEPTH PATCH OVER A TRENCH. SHALL BE 300 (12) WIDER ON EACH SIDE OF THE TRENCH.
- 2. FOR METHOD OF MEASUREMENT AND BASIS OF PAYMENT, SEE SPECIAL PROVISION "PATCHING WITH BITUMINOUS OVERLAY REMOVAL".

SEQUENCE OF CONSTRUCTION

- 1. REMOVE THE EXISTING BITUMINOUS MATERIAL OVER THE AREA TO BE PATCHED.
- 2. REMOVE AND REPLACE FULL DEPTH PATCHES
- 3. REPLACE BITUMINOUS MATERIAL OVER THE AREA TO BE PATCHED.

ALL DIMENSIONS ARE IN MILLIMETERS (INCHES) UNLESS OTHERWISE SHOWN.

REVISIO NAME	DATE
R. SHAH	10/25/94
R. SHAH	01/14/95
R. SHAH	03/23/99
R. SHAH	04/24/95
A. HOUSEH	03/15/96
A. ABBAS	03/21/97
A. ABBAS	01/20/98
ART ABBAS	04/27/98

ILLINOIS DEPARTMENT OF TRANSPORTATION

PAVEMENT PATCHING FOR BITUMINOUS SURFACED PAVEMENT

SCALE: VERT. HORIZ. DATE 10/26/2005

DRAWN BY CHECKED BY

RIZ. CHEC

BD400-04 (BD-22) BEVISION DATE: 04/27/98

Wi\diststd\bd22.d 10/26/2005 VI=BD22

TOTAL SHEETS COUNTY SECTION # 2000-037 RG COOK 58 VARIABLE - TO MEET EXISTING FEO. ROAD DIST. NO. _ BLUNOTS DIMENSIONS AND FIELD CONDITIONS *2786, 1334, 1332 (SEE NOTE (2)) PROP. CONC. CURB OR CURB AND GUTTER REPLACEMENT IN ACCORDANCE WITH STATE STANDARD 606001. (SEE NOTE 2) SAW CUT FULL DEPTH - INCLUDED IN THE COST OF SIDEWALK, DRIVEWAY OR MEDIAN SURFACE REMOVAL 450 (18) SEE STATE STANDARD 606001 MAX. EXISTING OR PROPOSED BITUMINOUS SURFACE (IF APPLICABLE) 5 (1/4) ** * EXISTING SIDEWALK, DRIVEWAY, MEDIAN SURFACE OR GROUND. PROPOSED SIDEWALK, DRIVEWAY PAVEMENT, MEDIAN SURFACE OR SALT TOLERANT SOD AND TOP SOIL, 100 (4) SOD RESTORATION (SEE NOTE 1). EXISTING CONCRETE PAVEMENT, CONCRETE BASE COURSE OR FLEXIBLE PAVEMENT. SUITABLE BACKFILL MATERIAL -75 (3) MIN. (INCLUDED IN THE COST OF CURB OR CURB AND GUTTER REMOVAL AND REPLACEMENT) 来 75 (3) MINIMUM FROM TOP AND BOTTOM OF THE CONCRETE PAVEMENT OR BASE COURSE. PROPOSED 20 (3/4) PREFORMED EXPANSION JOINT AT CONCRETE SIDEWALKS, DRIVEWAYS, AND MEDIANS, (INCLUDED IN THE COST 米米 IF THE FINAL SURFACE OF THE PAVEMENT IS CONCRETE, THE GUTTER IS TO BE FLUSH OF CURB OR CURB AND GUTTER REMOVAL AND REPLACEMENT.) WITH THE PAVEMENT. NOTE: 1 SIDEWALK, DRIVEWAY PAVEMENT OR MEDIAN SURFACE SHALL BE SIMILAR TO THE MATERIAL UNSUITABLE SUB-BASE MATERIAL TO BE REMOVED, IF DIRECTED BY BEING REMOVED AND WILL BE PAID FOR SEPARATELY. THE ENGINEER, SHALL BE REPLACED WITH EITHER SUB-BASE GRANULAR MATERIAL, TYPE B OR ADDITIONAL THICKNESS OF CONCRETE. SALT TOLERANT SOD AND TOP SOIL, 100 (4) RESTORATION WILL NOT BE PAID FOR SEPARATELY, BUT SHALL BE INCLUDED IN THE COST OF CURB OR CURB AND GUTTER REMOVAL AND REPLACEMENT. REMOVAL AND REPLACEMENT 100 (4) OR LESS IS INCLUDED IN THE COST OF CURB OR CURB AND GUTTER REMOVAL AND REPLACEMENT. 2 CURB OR CURB AND GUTTER REPLACEMENT SHALL MATCH THE SHAPE OF THE EXISTING CURB OR CURB AND GUTTER UNLESS OTHERWISE SPECIFIED. REMOVAL AND REPLACEMENT IN EXCESS OF 100 (4) WILL BE PAID FOR IN ACCORDANCE WITH ARTICLE 109.04 OF THE STANDARD SPECIFICATIONS. (3) FOR CURB OR CURB AND GUTTER REMOVAL AND REPLACEMENT ADJACENT TO FLEXIBLE PAVEMENT DELETE EPOXY COATED TIE BARS. PROPOSED NO. 20 (NO. 6) EPOXY COATED TIE BARS 600 (24) LONG AT 4 LONGITUDINAL BARS, IF ENCOUNTERED IN THE EXISTING CURB OR CURB AND GUTTER, ARE 600 (24) CENTERS WILL NOT BE PAID FOR SEPARATELY. DELETE EPOXY NOT TO BE REPLACED. CUTTING AND REMOVING LONGITUDINAL BARS SHALL BE INCLUDED COATED TIE BARS IF EXISTING TIE BARS ARE USUABLE AS DETERMINED IN THE COST OF CURB OR CURB AND GUTTER REMOVAL AND REPLACEMENT. BY THE ENGINEER. (SEE NOTE 3). (5) THE COST OF BITUMINOUS SURFACE REMOVAL IN THE EXISTING GUTTER FLAG SHALL BE INCLUDED IN THE COST OF THE CURB AND GUTTER REMOVAL AND REPLACEMENT. BASIS OF PAYMENT: (6) THE REMOVAL AND REPLACEMENT OF THE EXISTING CURB OR CURB AND GUTTER SHALL THIS WORK WILL BE PAID FOR AT THE CONTRACT UNIT PRICE PER BE DONE IN ACCORDANCE WITH THE APPLICABLE PORTIONS OF SECTION 440 AND 606 METER (FOOT) FOR "CURB REMOVAL AND REPLACEMENT" OR "COMBINATION CONCRETE CURB AND GUTTER REMOVAL AND REPLACEMENT". OF THE STANDARD SPECIFICATIONS. 7) THE LOCATIONS OF REMOVAL AND REPLACEMENT OF EXISTING CURB OR CURB AND GUTTER SHALL BE DETERMINED BY THE RESIDENT ENGINEER AT THE TIME OF CONSTRUCTION. ALL DIMENSIONS ARE IN MILLIMETERS (INCHES) UNLESS OTHERWISE SHOWN. ILLINOIS DEPARTMENT OF TRANSPORTATION M. DE YONG 05/28/91 **CURB OR**

CURB OR CURB AND GUTTER REMOVAL AND REPLACEMENT

A. HOUSEH 03/11/94 R. SHAH 02/24/95 R. SHAH 03/02/95 R. SHAH 08/19/96 09/12/96 09/19/96 09/19/96 10/03/96 03/21/97 M. GOMEZ 01/22/01 DATE 10/26/2005


CURB AND GUTTER REMOVAL AND REPLACEMENT

CHECKED BY BD600-06 (BD-24

REVISION DATE: 12/06/88

aulllaumef p

3160010\6624.dgn 10/26/2005 3:21:02 PM User-guillausets

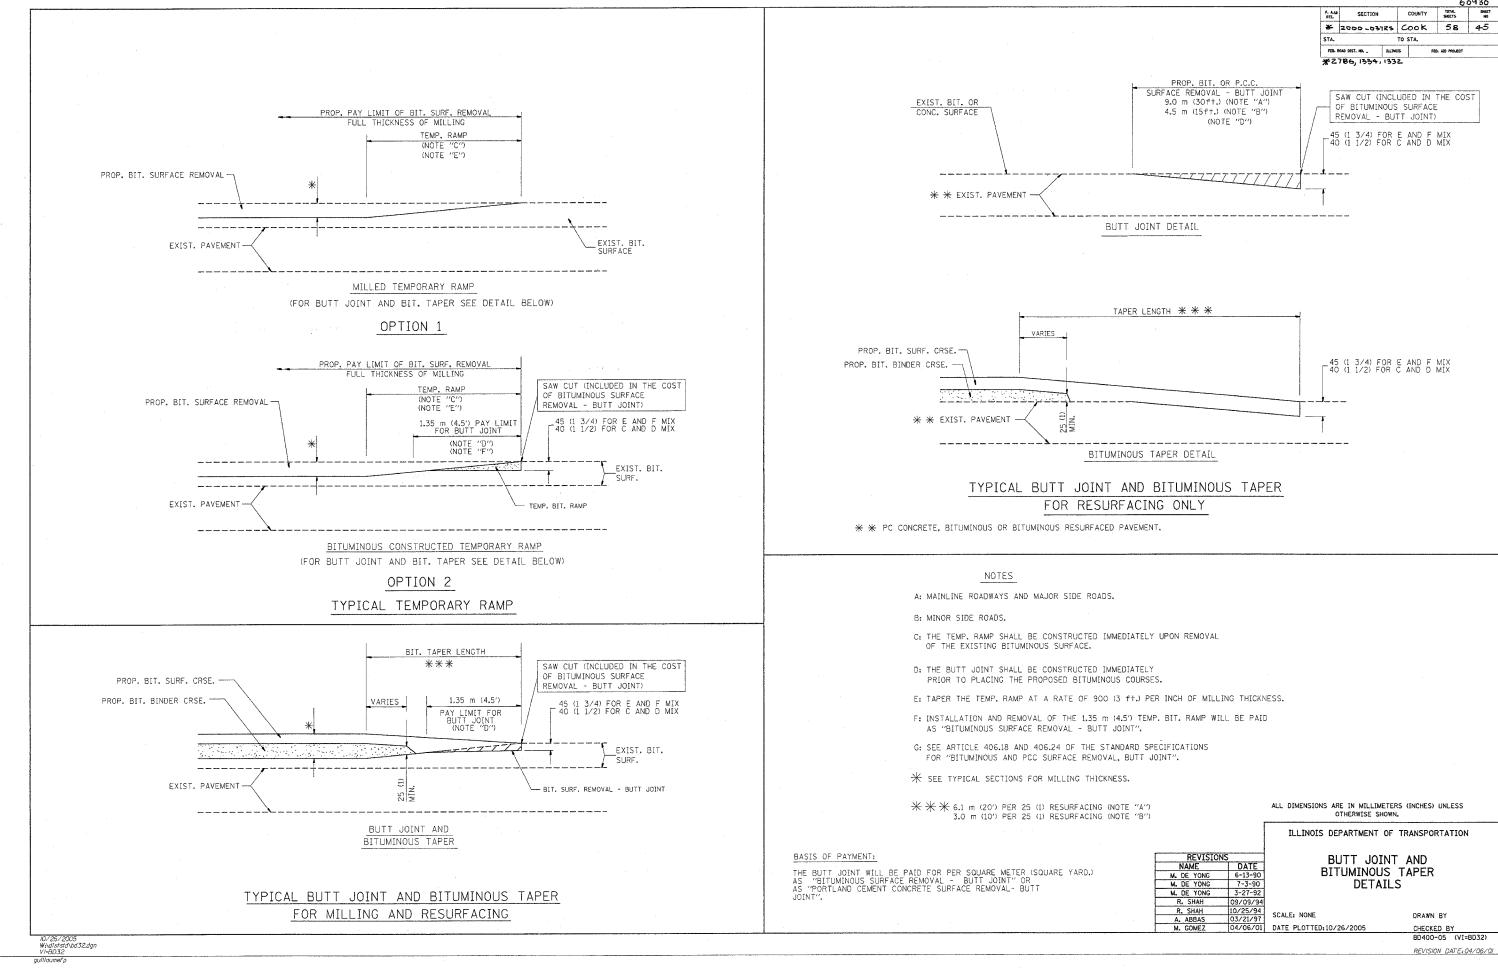

2, 91.514 Up# 10/26/2005 3: 21: 29 PM User*rguillausefp

F. A.U SECTION COUNTY TOTAL SHEETS NO

2000-03185 Cook 58 46 COUNTY TOTAL SHEETS 1.8 m (6') - EXIST. CURB & GUTTER EXIST. P.C. CONCRETE PAVEMENT PROP. PORTLAND CEMENT CONCRETE PROP. LEVELING BINDER (MACHINE METHOD), SUPER PAVE SURFACE REMOVAL (VAR. DEPTH) IN SQ. M. OR SQ. YD. PROP. BITUMINOUS CONCRETE SURFACE COURSE, SUPERPAVE BITUMINOUS TAPER AT EDGE OF P.C.C PAVEMENT LEVELING BINDER SUPERPAVE SUPERPAVE THICKNESS * MILLING AT GUTTER FLAG SURFACE THICKNESS MIX C OR D 33 (1¹/₄) 25 (1) 38 (11/2) 44 (1¾) 19 (¾) 38 (11/2) E OR F ALL DIMENSIONS ARE IN MILLIMETERS (INCHES) UNLESS OTHERWISE SHOWN. ILLINOIS DEPARTMENT OF TRANSPORTATION BITUMINOUS TAPER AT EDGE OF P.C.C. PAVEMENT SCALE: NONE DRAWN BY Jis CHECKED BY A. ABBAS BD400-06 (BD33) DATE 10/26/2005 IO/26/2005 W:\distatd\bd33.dgn VI-BD33 gulliaumef.p REVISON DATE:12/21/00

825 (33) (12) (12) -STEEL PLATE BEAM GUARD RAIL ALEXIVATIVE TO THE PROPERTY OF BITUMINOUS SHOULDER 150 (6) (SEE NOTE 1) — COMB. CONC. CURB & GUTTER L SUB-BASE L PAVEMENT

> NOTES: 1. THE BITUMINOUS SHOULDER SHALL EXTEND UNDER THE TRAFFIC BARRIER TERMINAL

> > 2. GUARD RAIL MAY BE PLACED AT THE BACK OF CURB WHEN DIRECTED BY THE ENGINEER.

BASIS OF PAYMENT: BITUMINOUS SHOULDER 150 (6) WILL BE PAID FOR AT THE CONTRACT UNIT PRICE

PER m² (sq. yd.) AS "BITUMINOUS SHOULDER 150 (6)."

STEEL PLATE BEAM GUARD RAIL AND TRAFFIC BARRIER TERMINAL, OF THE TYPE SPECIFIED

WILL BE PAID FOR SEPARATELY.

DETAILS FOR STEEL PLATE BEAM GUARD RAIL ADJACENT TO CURB AND GUTTER

FOR ROADWAY SPEED 60 kmh (35 MPH) TO 70 kmh (45 MPH)]

¥ 2000-037 RS Cook 58 47 TO STA. FED. ROAD DIST. NO. _ RLINDIS #2786, 1334, 1332 OFFSET BASED ON MANUFACTURERS' SPECIFICATIONS GUARDRAILTBT TAPER OR FLARE
BASED ON MANUFACTURER'S SPECIFICATIONS DISTANCE FROM FACE OF RAIL 0.9 m (3'-0") - EDGE OF PAVEMENT EDGE OF SHOULDER OR BACK OF CURB & GUTTER 1:10 MAX_ CROSS SLOPE VARIES 3.0 m (10'-0")
UNLESS OTHERWISE NOTED 750 mm (2'-6") SHOULDER EDGE OF SHOULDER STABILIZATION

EDGE OF SHOULDER STABILIZATION -

DEPRESSED CURB FOR URBAN CROSS SECTION

BASED ON MANUFACTURER'S SPECIFICATIONS 11.4 m (37.5FT.) MIN. 15.2 m (50'-0') MAX.

STABILIZATION AT TBT TY. 1 SPL.

ALL DIMENSIONS ARE IN MILLIMETERS (INCHES) UNLESS

ILLINOIS DEPARTMENT OF TRANSPORTATION

825 mm (2'-9") CURB & GUTTER

DETAILS FOR STEEL PLATE BEAM GUARD RAIL ADJACENT TO CURB AND GUTTER M. DE YONG R. SHAH R. SHAH

STABILIZATION AT TBT TY 1 SPL.

SCALE: NONE DATE 10/26/2005 DRAWN BY jis CHECKED BY BD600-10 (BD 34)


REVISION DATE: 08/28/00

COUNTY TOTAL SHEET NO

IO/26/2005 W:\dlststd\bd34.dgn VI=B034

9:std/0034.dgn 10/26/2005 3.22.25 PM User*Quillaume*p

REVISION DATE: 01/25/01

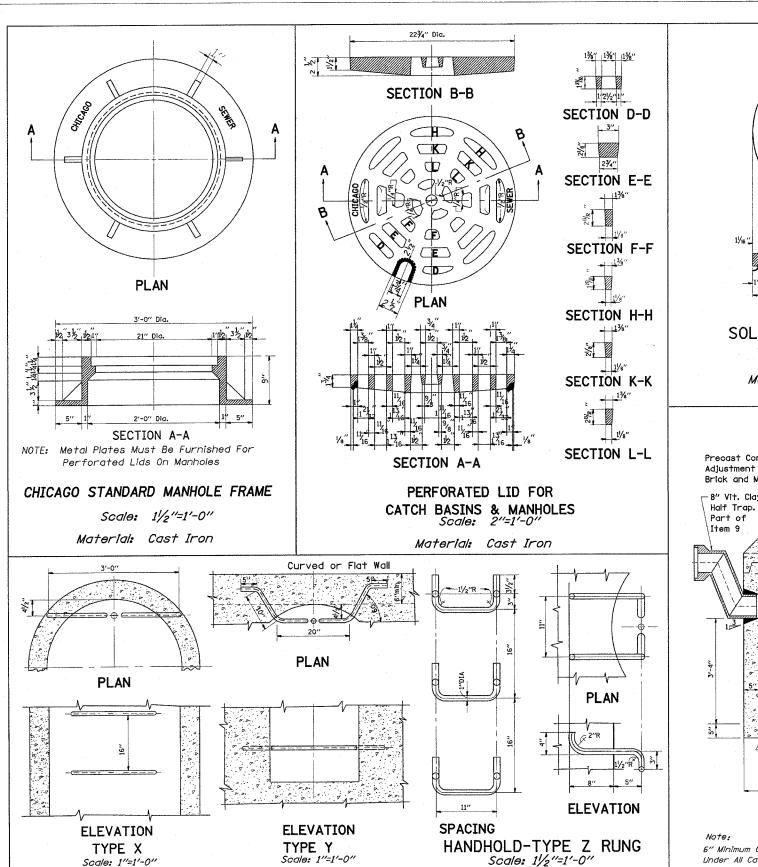

STANDARD LADDER RUNGS


All Ladder Rungs Shall Be Aluminum or

Spefications, Part 2, rticle214.2.

Area


Galvanized Wrought Iron As Specified in

Rungs Shall Be 1" Diameter or of A Shape Having An Equivalent Cross-Sections!

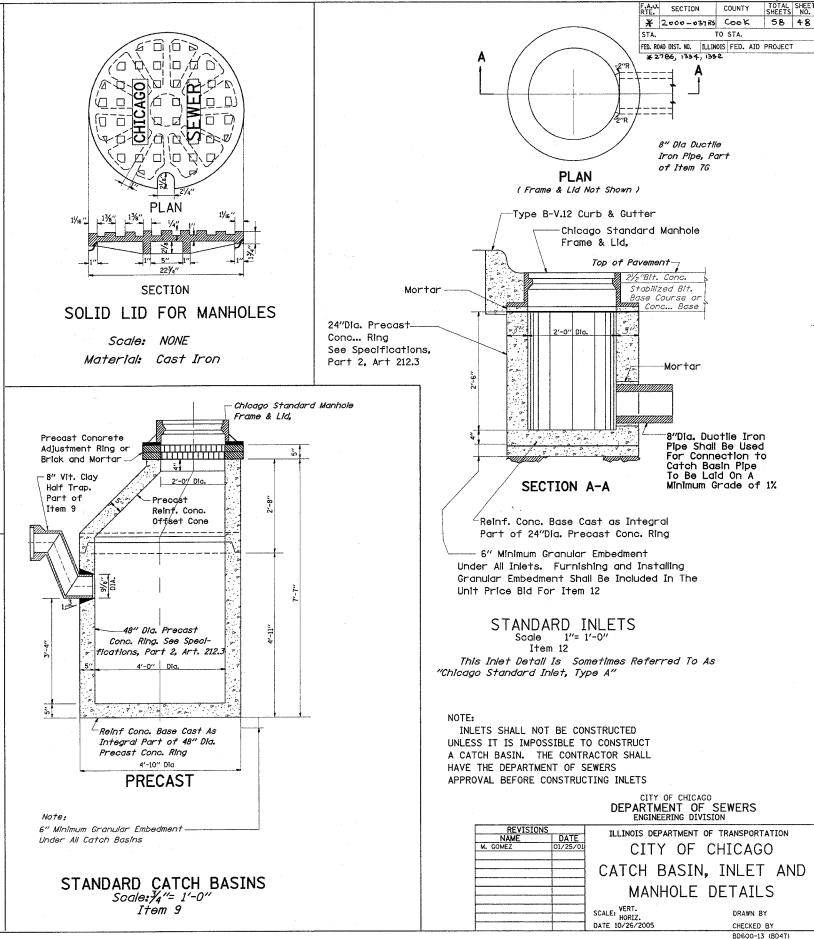

. ats/ad47 day 10/25/2005 3:22 53 PM User=guilloune fo

IO/26/2005 W:\diststd\bd47.dgn VI-BD47 Jillaumero

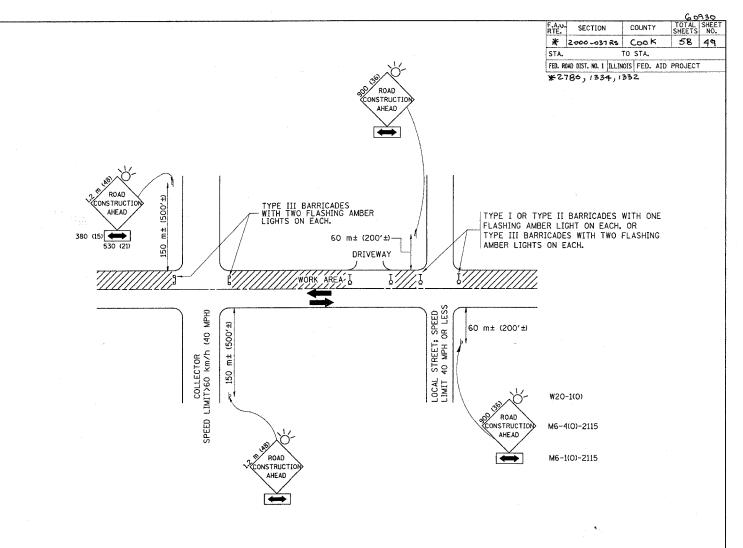

TRAFFIC CONTROL AND PROTECTION FOR SIDE ROADS, INTERSECTIONS, AND DRIVEWAYS

NOTES:

- A. FOR NO LANE RESTRICTION ON THE SIDE ROAD OR DRIVEWAYS
- SIDE ROAD WITH A SPEED LIMIT OF 60 km/h (40 MPH) OR LESS AS SHOWN ON THE DRAWING AND AS DIRECTED BY THE ENGINEER:
- O) DNE ROAD CONSTRUCTION AHEAD SIGN 900×900 (36×36) WITH A FLASHER AND FLAG MOUNTED ON IT APPROXIMATELY 60 m (200*) IN ADVANCE OF THE MAIN ROUTE.
- b) THE CLOSED PORTION OF THE MAIN ROUTE SHALL BE PROTECTED BY BLOCKING WITH TYPE I, TYPE II OR TYPE III BARRICADES, 1/3 OF THE CROSS SECTION OF THE CLOSED PORTION.
- 2. SIDE ROAD WITH A SPEED LIMIT GREATER THAN 60 km/h (40 MPH) AS SHOWN ON THE DRAWING AND AS DIRECTED BY THE ENGINEER:
- d) ONE ROAD CONSTRUCTION AHEAD SIGN 1.2 m \times 1.2 m (48 \times 48) WITH A FLASHER MOUNTED ON IT APPROXIMATELY 150 m (500') IN ADVANCE OF THE MAIN ROUTE.
- b) THE CLOSED PORTION OF THE MAIN ROUTE SHALL BE PROTECTED BY BLOCKING WITH TYPE III BARRICADES, 1/2 OF THE CROSS SECTION OF THE CLOSED PORTION.
- 3. WHEN THE SIDE ROAD LIES BETWEEN THE BEGINNING OF THE MAINLINE SIGNING AND THE WORK ZONE, A SINGLE HEADED ARROW (MG-1) SHALL BE USED IN LIEU OF THE DOUBLE HEADED ARROW (MG-4).

- B. FOR A LANE CLOSURE ON A SIDE ROAD OR DRIVEWAY:
- USE APPLICABLE PORTIONS OF THE TYPICAL APPLICATION OF TRAFFIC CONTROL DEVICES (STD. 701501, STD. 701606 OR THE APPROPRIATE STANDARD). THE SPACING OF SIGNS AND BARRICADES SHALL BE ADJUSTED FOR FIELD CONDITIONS AS DIRECTED BY THE ENGINEER. THE DIRECTIONAL ARROW SHALL BE COVERED OR REMOYED WHEN NO LONGER CONSISTENT WITH THE SIDE ROAD LANE CLOSURE.
- C. ADVANCE WARNING SIGNS ARE TO BE OMITTED ON DRIVEWAY UNLESS OTHERWISE NOTED.
- D. THE TRAFFIC CONTROL AND PROTECTION FOR SIDE ROADS, INTERSECTIONS, AND DRIVEWAYS SHALL BE INCIDENTAL TO THE COST OF SPECIFIED TRAFFIC CONTROL STANDARDS OR ITEMS.

	REVISIONS					
	DATE	NAME				
70	6/89	LHA				
1.5	09/08/94	T. RAMMACHER				
	10/18/95	J. OBERLE				
_	03/06/96	A. HOUSEH				
S	10/15/96	A. HOUSEH				
	01/06/00	T. RAMMACHER				
604						
3CM						

ILLINOIS DEPARTMENT OF TRANSPORTATION

TRAFFIC CONTROL AND PROTECTION

FOR

SIDE ROADS, INTERSECTIONS, AND

DRIVEWAYS


SCALE: VERT. HORIZ. DATE 10/26/2005


DRAWN BY CHECKED BY


TC-10

IO/26/2005 w:\diststd\tcl0.dgn gulllaumef.p


REVISION DATE: 01/06/00

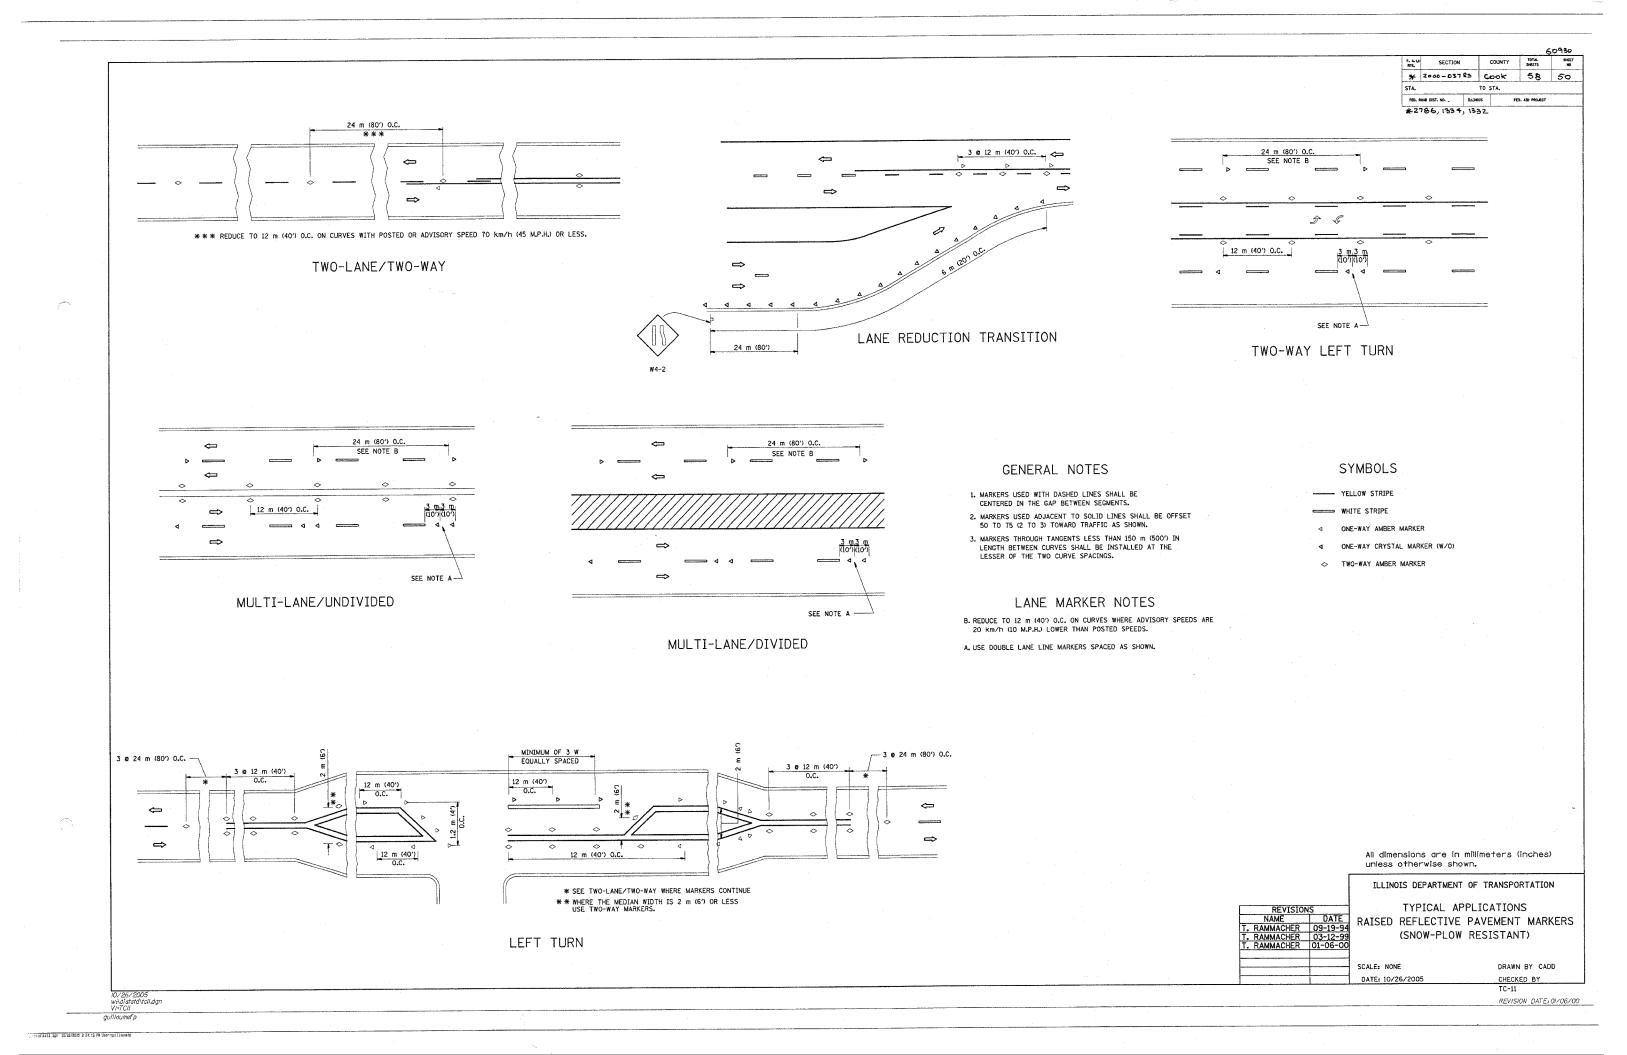

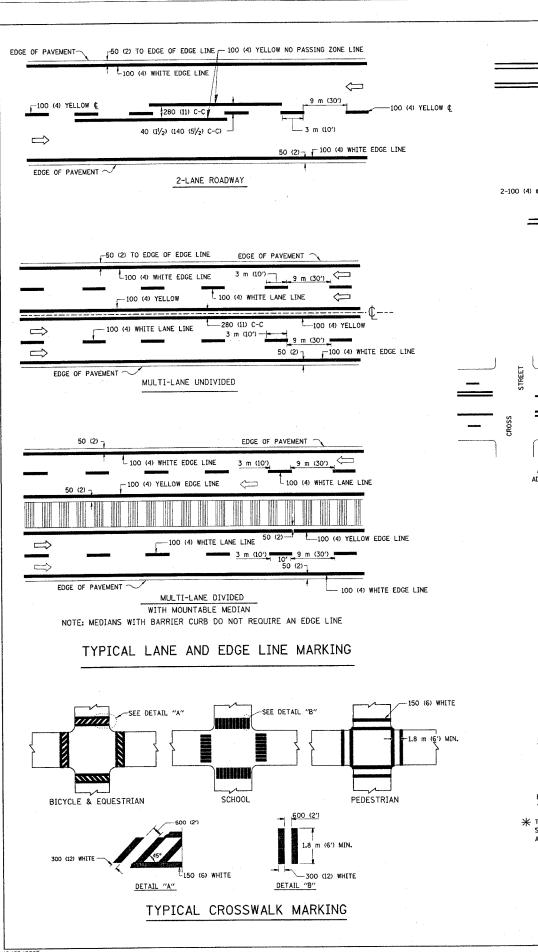

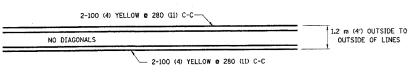


1.2 m (4') WIDE MEDIANS ONLY

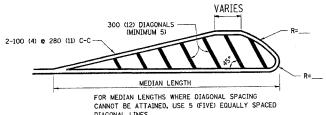


DIAGONAL LINE SPACING: 15 m (50') C-C (LESS THAN 50 km/h (30 MPH))
25 m (75') C-C (50 km/h (30 MPH) TO 70 km/h (45 MPH))
45 m (150') C-C (MORE THAN 70 km/h (45 MPH))

MEDIANS OVER 1.2 m (4') WIDE

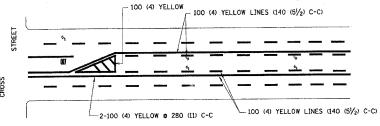


A MINIMUM OF TWO PAIRS OF TURN ARROWS SHALL BE USED, WHITE IN COLOR. ADDITIONAL PAIRS SHALL BE PLACED AT 60 m (200') TO 90 m (300') INTERVALS.

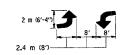

MEDIAN WITH TWO-WAY LEFT TURN LANE

TYPICAL PAINTED MEDIAN MARKING

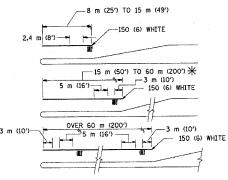


FULL SIZE LETTERS 2.4 m (8') AND ARROWS SHALL BE USED. \spadesuit AREA = 1.5 m² (15.6 SQ. FT.) ONLY AREA = 1.9 m² (20.8 SQ. FT.)

** TURN LANES IN EXCESS OF 120 m (400") IN LENGTH MAY HAVE AN ADDITIONAL SET OF ARROW - "ONLY" INSTALLED MIDWAY BETWEEN THE OTHER TWO SETS OF ARROW - "ONLY".

TYPICAL LEFT (OR RIGHT) TURN LANE

TYPICAL TURN LANE MARKING

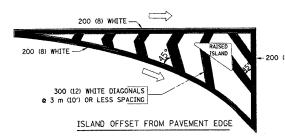

TOTAL SHEETS SECTION ¥ 2000-037 RS Cook 58 51 TO STA. RAZINOIS # 2786, 1334, 1332

- 50 (2) 200 (8) WHITE RAISED ISLAND ISLAND AT PAVEMENT EDGE

TYPICAL ISLAND MARKING

TYPE OF MARKING	WIDTH OF LINE	PATTERN	COLOR	SPACING / REMARKS
CENTERLINE ON 2 LANE PAVEMENT	100 (4)	SKIP-DASH	YELLOW	3 m (10') LINE WITH 9 m (30') SPACE
CENTERLINE ON MULTI-LANE UNDIVEDED PAVEMENT	2 @ 100 (4)	SOLID	YELLOW	280 (II) C-C
NO PASSING ZONE LINES: FOR ONE DIRECTION FOR BOTH DIRECTIONS	100 (4) 2 c 100 (4)	SOLID SOLID	YELLOW YELLOW	140 (5)/ ₂) C-C FROM SKIP-DASH CENTERLINE 280 (11) C-C OMIT SKIP-DASH CENTERLINE BETWEEN
LANE LINES	100 (4) 125 (5) ON FREEWAYS	SKIP-DASH SKIP-DASH	WHITE WHITE	3 m (10') LINE WITH 9 m (30') SPACE
DOTTED LINES (EXTENSIONS OF CENTER, LANE OR TURN LANE MARKINGS)	SAME AS LINE BEING EXTENDED	SKIP-DASH	SAME AS LINE BEING EXTENDED	600 (2') LINE WITH 1.8 m (6') SPACE
EDGE LINES	100 (4)	SOLID	YELLOW-LEFT WHITE-RIGHT	OUTLINE MOUNTABLE MEDIANS IN YELLOW; EDGE LINES ARE NOT USED NEXT TO BARRIER CURB
TURN LANE MARKINGS	150 (6) LINE; FULL SIZE LETTERS & SYMBOLS (2.4 m (8'))	SOLID	WHITE	SEE TYPICAL TURN LANE MARKING DETAIL
TWO WAY LEFT TURN MARKING	2 @ 100 (4) EACH DIRECTION	SKIP-DASH AND SOLID	YELLOW	3 m (10') LINE WITH 9 m (30') SPACE FOR SKIP-DASH; 140 (5½) C-C BETWEEN SOLID LINE AND SKIP-DASH LINE
	2.4 m (8') LEFT ARROW	IN PAIRS	WHITE	SEE TYPICAL TWO-WAY LEFT TURN MARKING DETAIL
CROSSWALK LINES (PEDESTRIAN) A. DIAGONALS (BIKE & EQUESTRIAN) B. LONGITUDINAL BARS (SCHOOL)	2 © 150 (6) 300 (12) © 45° 300 (12) © 90°	SOLID SOLID SOLID	WHITE WHITE WHITE	NOT LESS THAN 1.8 m (6') APART 600 (2') APART 600 (2') APART SEE TYPICAL CROSSWALK MARKING DETAILS.
STOP LINES	600 (24)	SOLID	WHITE	PLACE 1.2 m (47) IN ADVANCE OF AND PARALLEL TO CROSSWALK, IF PRESENT. OTHERWISE, PLACE AT DESIRED STOPPING POINT. PARALLEL TO CROSSROAD CENTERLINE, WHERE POSSIBLE
PAINTED MEDIANS	2 @ 100 (4) WITH 300 (12) DIAGONALS @ 45° NO DIAGONALS USED FOR L2 m (4') WIDE MEDIANS	SOLID	YELLOW: TWO WAY TRAFFIC WHITE: ONE WAY TRAFFIC	280 (11) C-C FOR THE DOUBLE LINE SEE TYPICAL PAINTED MEDIAN MARKING.
GORE MARKING AND CHANNELIZING LINES	200 (8) WITH 300 (12) DIAGONALS @ 45°	SOLID	WHITE	DIACONALS: 4.5 m (15°) C-C (LESS THAN 50 km/h (30 MPH)) 6 m (20°) C-C (50 km/h (30 MPH) TO 70 km/h (45 MPH 9 m (30°) C-C (0VER 70 km/h (45 MPH))
RAILROAD CROSSING	600 (24) TRANSVERSE LINES; "RR" IS 1.8 m (6') LETTERS; 400 (16) LINE FOR "X"	SOLID	WHITE	SEE STATE STANDARD 780001 AREA 0F: "X"-0.33m2 (3.6 SQ. FT.) EACH "X"=5.0 m2 (54.0 SQ. FT.)
SHOULDER DIAGONALS	300 (12) e 45°	SOLID	WHITE - RIGHT	15 m (50') C-C (LESS THAN 50 km/h (30 MPH)) 25 m (75') C-C (50 km/h (30 MPH) TO 70 km/h (45 MPH 45 m (150') C-C (OVER 70 km/h (45 MPH))

FOR FURTHER DETAILS ON PAVEMENT MARKING REFER TO STANDARD SPECIFICATIONS FOR ROAD AND BRIDGE CONSTRUCTION AND STATE STANDARD 780001.

All dimensions are in millimeters (inches) unless otherwise shown.

ILLINOIS DEPARTMENT OF TRANSPORTATION DISTRICT ONE


TYPICAL PAVEMENT MARKINGS

> SCALE: NONE DATE 10/26/2005


DRAWN BY CADD CHECKED BY

TC-13 REVISION DATE: 01/06/00


Fastri3 dm 10/26/2005 3:24:45 2M dser-oull laurers

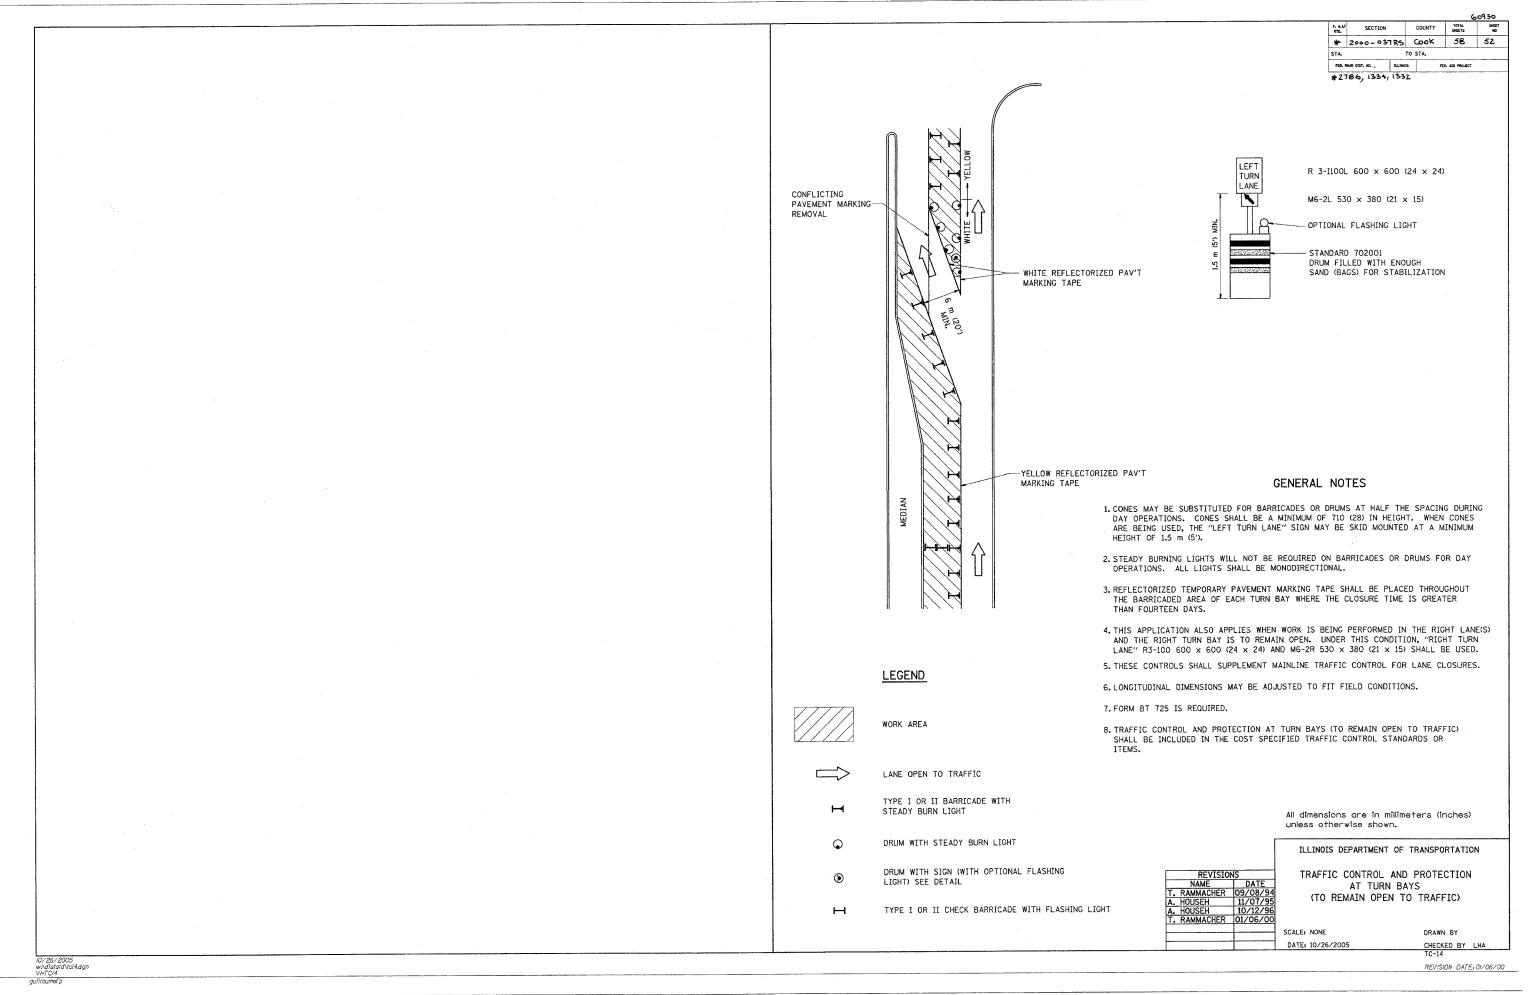


;;:told/tol4.dgo 10/25/2005 1:25:57 2M User-guilloune/p

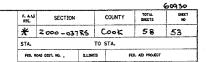


* 2786, 1334, 1332

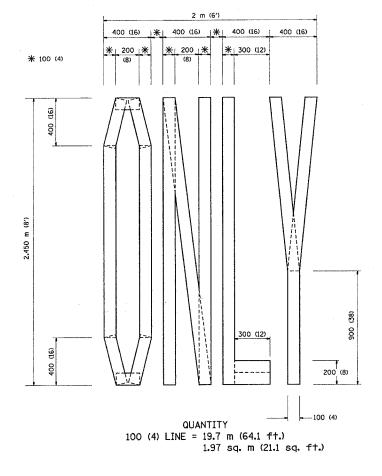

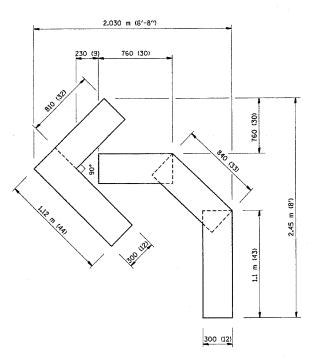

QUANTITY 100 (4) LINE = 13.9 m (45.5 ft.) 1.39 sq. m (15.2 sq. ft.)

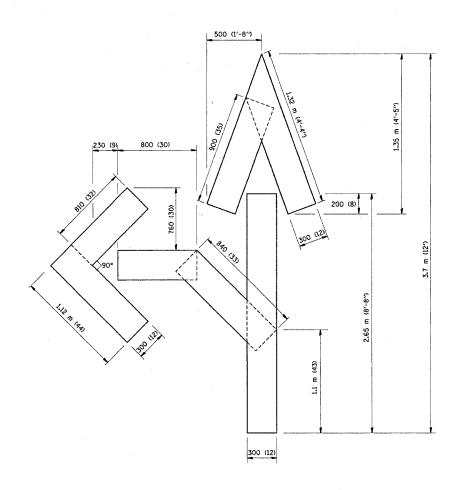

QUANTITY 100 (4) LINE = 25.3 m (82.5 ft.) 2.53 sq. m (27.5 sq. ft.)

All dimensions are in millimeters (inches) unless otherwise shown.

ILLINOIS DEPARTMENT OF TRANSPORTATION

REVISIONS PAVEM LETTERS MACHER 09/18/94 LETTERS MACHER 06/01/96 FOR TR/MACHER 11/04/97


PAVEMENT MARKING LETTERS AND SYMBOLS FOR TRAFFIC STAGING

SCALE: NONE
DATE 10/26/2005

DRAWN BY CADD CHECKED BY TC-16

REVISION DATE: 08/28/00

IO/26/2005 w:\diststd\tcl6.dgn VI=TCl6

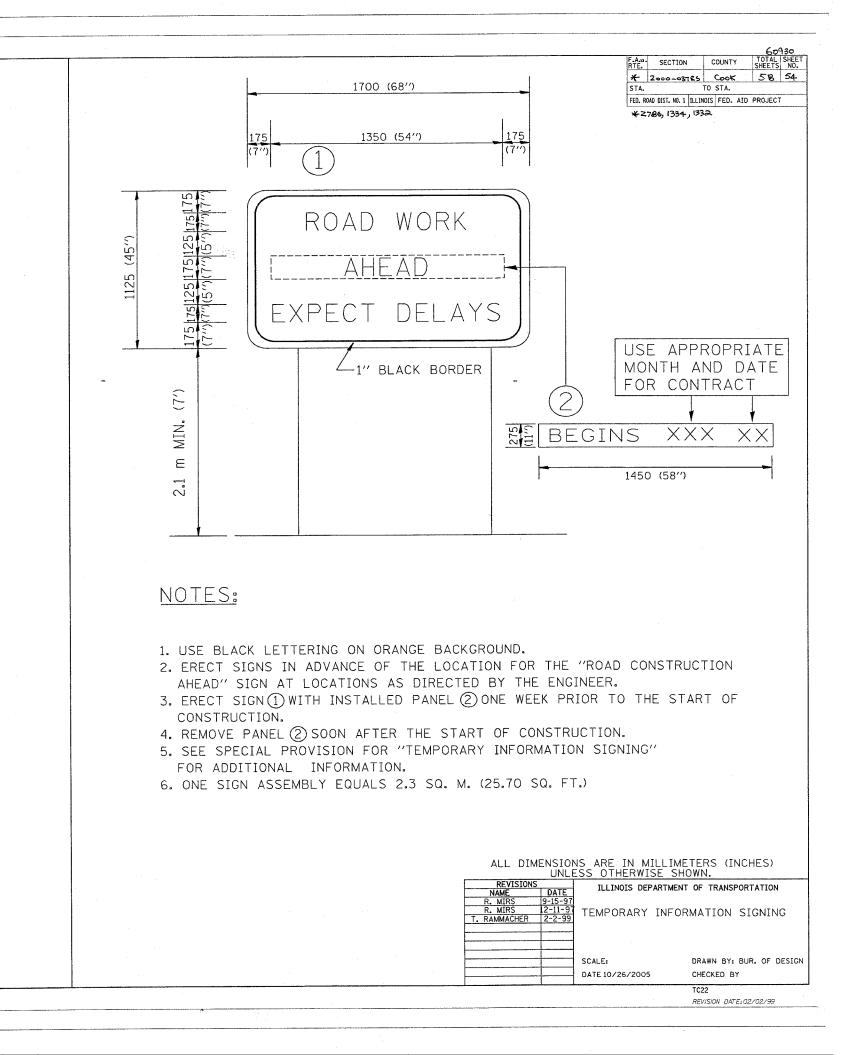


FED. ROAD DIST. NO. 1 ILLINOIS FED. AID PROJECT

*2786, 1334, 133A

WITH INTERSECTION TRAFFIC SIGNALS


WITH NEAR-SIDE TRAFFIC SIGNALS

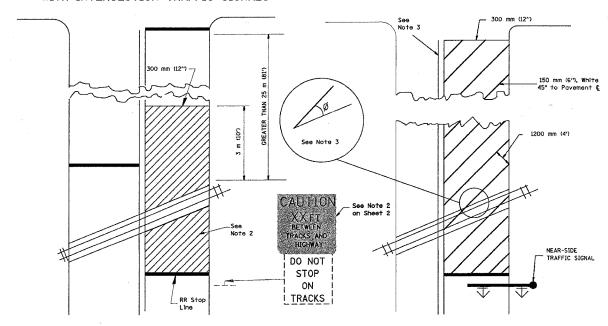

NOTES:

- PAVEMENT MARKINGS TO BE INSTALLED ONLY ON APPROACHES TO INTERSECTIONS CONTROLLED BY TRAFFIC SIGNALS
 WHICH ARE INTERCONNECTED WITH THE RAILROAD WARNING SIGNALS.
- 2. WHERE NEAR-SIDE TRAFFIC SIGNALS ARE USED, THE PAVEMENT MARKINGS EXTENDS TO THE INTERSECTION.
- WHERE THE ANGLE BETWEEN THE DIAGONAL STRIPES AND THE TRACK (Ø) WOULD BE LESS THAN APPROXIMATELY 20°,
 THE STRIPES SHOULD BE SLOPED IN THE OPPOSITE DIRECTION FROM THAT SHOWN.

WITH NONSIGNALIZED INTERSECTION

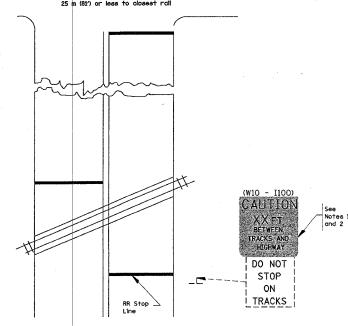

NOTE


- DISTANCE TO BE SHOWN ON SIGN MEASURED FROM A POINT 1.8 m
 (6 FEET) FROM THE RAIL CLOSEST TO THE INTERSECTION TO THE STOP LINE OR CROSSWALK, WHICKEVER IS CLOSEST, ROUNDED DOWN TO THE NEAREST 1.5 m (5 FEET), WHERE THERE IS NO STOP LINE, MEASURE TO POINT WHERE THE BY IN GY FETY.
- 2. THE CLEARANCE SIGN IS ALSO TO BE USED AS AN INTERIM MEASURE AT LOCATIONS WITH INTERCONNECTED INTERSECTION TRAFFIC SIGNALS WHERE IT IS PLANNED TO CHANGE THEM TO NEAR-SIDE SIGNALS AT A FUTURE TIME. IN THIS CASE, THE DISTANCE TO BE SHOWN ON THE SIGN IS MEASURED FROM THE EDGE OF THE STRIPED-OUT AREA INSTEAD OF 6-FEET FROM THE RAIL. THE SIGN IS TO BE REMOVED WHEN THE NEAR-SIDE SIGNALS ARE INSTALLED AND THE PAVEMENT MARKINGS EXTEND TO THE INTERSECTION.


ALL DIMENSIONS ARE IN MILLIMETERS (INCHES)
UNLESS OTHERWISE SHOWN.

	THE TO TO ALCOHOL TATION
ILLINOIS DEPART	MENT OF TRANSPORTATION
SIGNING AND	_ SUPPLEMENTAL) PAVEMENT MARKING R RAILROAD CROSSINGS
	DRAWN BY:
10/26/2005	CHECKED BY
	TYPICAL SIGNING AND TREATMENT FO

TC23

10/26/2005 w:BdiststdBtc23.dgn VI=TC23

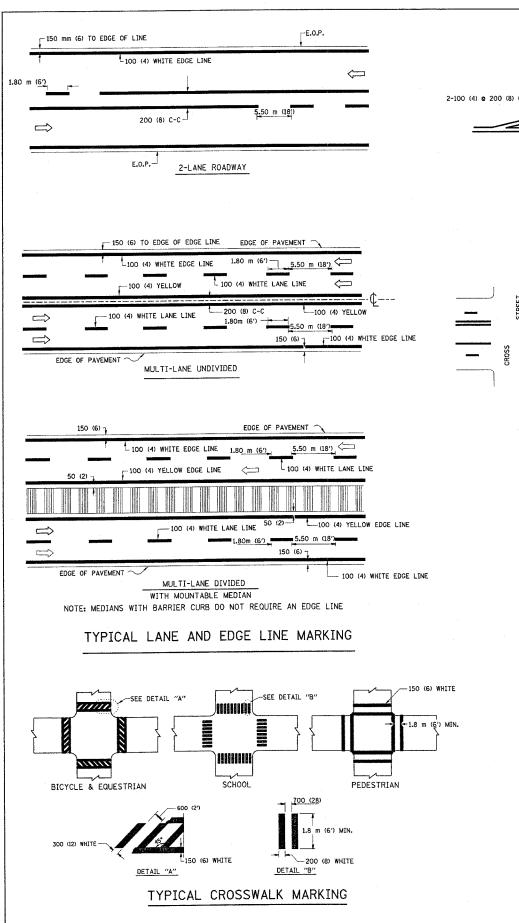


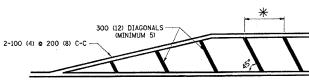


*FOR MEDIAN LENGTHS WHERE DIAGONAL SPACING CANNOT BE ATTAINED, USE 5 (FIVE) EQUALLY SPACED DIAGONAL LINES.

* DIAGONAL LINE SPACING: 6.1 m (20') C-C

PAINTED MEDIANS

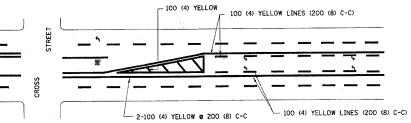


A MINIMUM OF TWO PAIRS OF TURN ARROWS SHALL BE USED, WHITE IN COLOR. ADDITIONAL PAIRS SHALL BE PLACED AT 60 m (200') TO 90 m (300') INTERVALS.

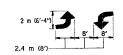

MEDIAN WITH TWO-WAY LEFT TURN LANE

TYPICAL PAINTED MEDIAN MARKING

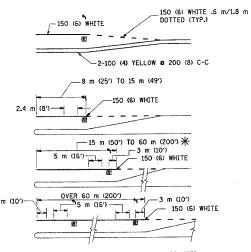


FULL SIZE LETTERS 2.4 m (8') AND ARROWS SHALL BE USED. \uphi AREA = 1.47 m² (15.8 SQ. FT.) \uphi AREA = 2.13 m² (22.9 SQ. FT.)

* TURN LANES IN EXCESS OF 120 m (400") IN LENGTH MAY HAVE AN ADDITIONAL SET OF ARROW - "ONLY" INSTALLED MIDWAY BETWEEN THE OTHER TWO SETS OF ARROW - "ONLY".

TYPICAL LEFT (OR RIGHT) TURN LANE

TYPICAL TURN LANE MARKING

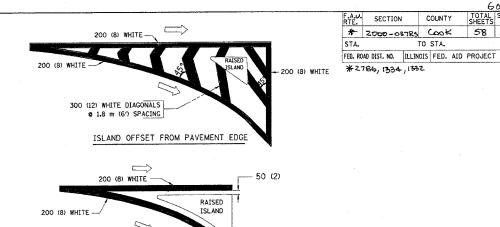

TYPICAL ISLAND MARKING

ISLAND AT PAVEMENT EDGE

-50 (2)

TYPE OF MARKING	WIDTH OF LINE	PATTERN	COLOR	SPACING / REMARKS
CENTERLINE ON 2 LANE PAVEMENT	100 (4)	SKIP-DASH	YELLOW	1.80 m (6') LINE WITH 5.50 m (18') SPACE
CENTERLINE ON MULTI-LANE UNDIVIDED PAVEMENT	2 & 100 (4)	SOLID	YELLOW	200 (8) C-C
NO PASSING ZONE LINES: FOR ONE DIRECTION FOR BOTH DIRECTIONS	100 (4) 2 e 100 (4)	SOLID SOLID	YELLOW YELLOW	200 (8) C-C
LANE LINES	100 (4) 125 (5) ON FREEWAYS	SKIP-DASH SKIP-DASH	WHITE WHITE	1.80 m (6') LINE WITH 5.50 m (18') SPACE
DOTTED LINES (EXTENSIONS OF CENTER, LANE OR TURN LANE MARKINGS)	SAME AS LINE BEING EXTENDED	SKIP-DASH	SAME AS LINE BEING EXTENDED	600 (2') LINE WITH 1.8 (6') SPACE
EDGE LINES	100 (4)	SOLID	YELLOW-LEFT WHITE-RIGHT	OUTLINE MOUNTABLE MEDIANS IN YELLOW; EDGE LINES ARE NOT USED NEXT TO BARRIER CURB
TURN LANE MARKINGS	150 (6) LINE; FULL SIZE LETTERS & SYMBOLS (2.4 m (8'))	SOLID	WHITE	SEE TYPICAL TURN LANE MARKING DETAIL
TWO WAY LEFT TURN MARKING	2 c 100 (4) EACH DIRECTION	SKIP-DASH AND SOLID	YELLOW	1.8 m (6') LINE WITH 5.50 m (18') SPACE FOR SKIP-DASH; 200 (8) C-C BETWEEN SOLID LINE AND SKIP-DASH LINE
	2.4 m (8') LEFT ARROW	IN PAIRS	WHITE	SEE TYPICAL TWO-WAY LEFT TURN MARKING DETAIL
CROSSWALK LINES (PEDESTRIAN) A. DIAGONALS (BIKE & EQUESTRIAN) B. LONGITUDINAL BARS (SCHOOL)	2 & 150 (6) 300 (12) & 45° 200 (8) @ 90°	SOLID SOLID SOLID	WHITE WHITE WHITE	NOT LESS THAN 1.8 m (6') APART 600 (2') APART 700 (2'-4') APART SEE TYPICAL CROSSWALK MARKING DETAILS.
STOP LINES	600 (24)	SOLID	WHITE	PLACE 1.2 m (4) IN ADVANCE OF AND PARALLEL TO CROSSWALK, IF PRESENT. OTHERWISE, PLACE AT DESIRED STOPPING POINT. PARALLEL TO CROSSROAD CENTERLINE, WHERE POSSIBLE
PAINTED MEDIANS	2 @ 100 (4) WITH 300 (12) DIAGONALS @ 45°	SOLID	YELLOW: TWO WAY TRAFFIC WHITE: ONE WAY TRAFFIC	200 (8) C-C FOR THE DOUBLE LINE SEE TYPICAL PAINTED MEDIAN MARKING.
GORE MARKING AND CHANNELIZING LINES	200 (8) WITH 300 (12) DIAGONALS @ 45°	SOLID	WHITE	DIAGONALS: 6.1 m (20') (LESS THAN 50 km/h (30 MPH))
RAILROAD CROSSING	600 (24) TRANSVERSE LINES; "RR" IS 1.8 m (6') LETTERS; 400 (16) LINE FOR "X"	SOLID	WHITE	SEE STATE STANDARD 780001 AREA OF: "R"-0.33m2 (3.6 SQ. FT.) EACH "X"-5.0 m2 (54.0 SQ. FT.)

RAMMACHER

FOR FURTHER DETAILS ON PAVEMENT MARKING REFER TO STREET MARKING STAMDARDS, PRINTED BY CITY OF CHICAGO, DEPARTMENT OF TRANSPORTATION, BUREAU OF TRAFFIC.

All dimensions are in millimeters (inches) unless otherwise shown.

ILLINOIS DEPARTMENT OF TRANSPORTATION

F.A.U. SECTION COUNTY

*2786, 1334, 1332

STA.

2000-03785 COOK 58 56

TO STA.

CITY OF CHICAGO TYPICAL PAVEMENT MARKINGS

SCALE: NONE

DRAWN BY CADO CHECKED BY TC-24

REVISION DATE: 12/07/00

1 OF 2

:stsb4\tc24.egs 10/26/2005 3:27:24 9A User-quillausetp


IO/26/2005 wi\diststd\tc24.dgn VI=TC24


TOTAL SHEET SHEETS NO.

RTE. SECTION COUNTY

DRAWING #32

2000-03785 Cook 58 57
STA. TO STA.
FED. ROAD DIST. NO. IILINOIS FED. AID PROJECT
#2786, 1334, 1332

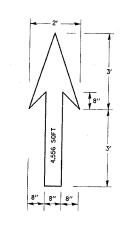


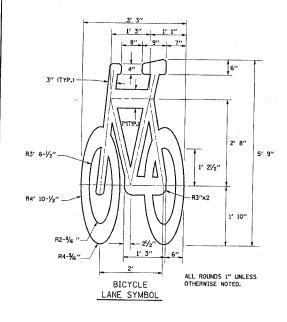

NOTE:
1.) FOR BIKE LANE SYMBOLS ONLY,
USE PRE-FORMED THERMOPLASTIC
WITH A MINIMUM THICKNESS OF 90 MILS,
MINIMUM SKID RESISTANCE VALUE OF 60 BPN,
& A MINIMUM INDEX OF REFRACTION OF 1.50.

2.) THE RESIDENT ENGINEER SHALL CONTACT MR. BEN COMBERG AT 312-744-8093 AT LEAST ONE CALENDAR WEEK PRIOR TO INSTALLING BIKE LANE SYMBOLS.

TYPICAL BIKE LANE SYMBOLS
DRAWING #28

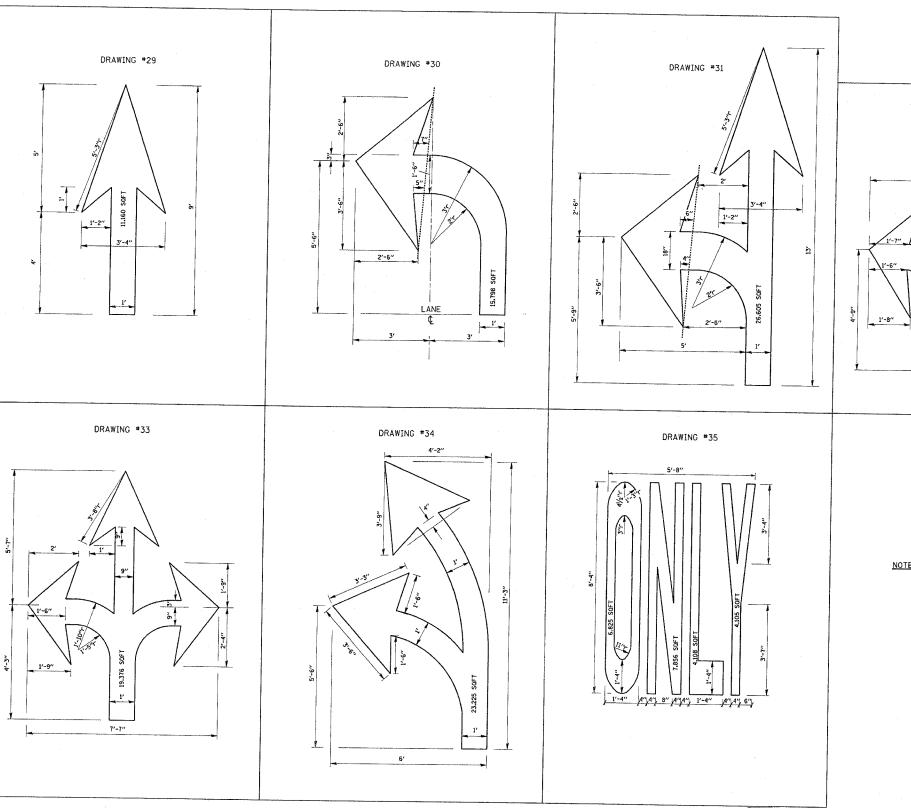

REVISIONS
NAME DATE
MMACHER 12/07/00

2 OF 2

ILLINOIS DEPARTMENT OF TRANSPORTATION

ALL MARKINGS SHALL BE SOLID WHITE UNLESS OTHERWISE NOTED IN THE

PLANS

CITY OF CHICAGO TYPICAL PAVEMENT MARKINGS.

SCALE: NONE DATE 10/26/2005 DRAWN BY CHECKED BY TC-24

REVISION DATE: 02/25/04

IO/26/2005 w:\diststd\tc24.dgn VI=TC24 guillaumefp


008 10/26/2015 3:27 24 58 (Service) | December

PROVIDE A PAVEMENT REPLACEMENT NOTE WHICH SHOULD EQUAL 3' (900 mm) X WIDTH OF PAVED SHOULDER. PAVED OR NON-PAVED SHOULDER. PAVED OR NON-PAVED SHOULDER PAVED OR NON-PAVED SHOULDER 10' (3.0 m) (3.0 m) ** * * UNIT DUCT IS TO BE SHOWN ON PLAN SHEETS BUT SHALL NOT BE INCLUDED IN THE PAY ITEMS.

LEFT TURN LANES WITH MEDIANS VOLUME DENSITY ("FAR OUT" DETECTION) ON SAME APPROACH

(PROTECTED / PERMITTED LEFT TURN PHASING)


HANDHOLE LOCATION MAY VARY DEPENDING ON GEOMETRICS AND DESIGN OF TRAFFIC SIGNALS. HEAVY-DUTY HANDHOLES TO BE USED WHEN THE MEDIAN IS MOUNTABLE. REFER TO STANDARD 814001 TO ENSURE THAT HANDHOLE FITS IN MEDIAN.

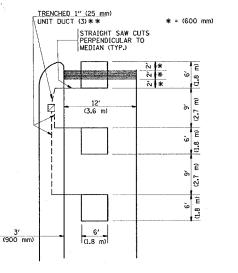

** UNIT DUCT IS TO BE SHOWN ON PLAN SHEETS BUT SHALL NOT BE INCLUDED IN THE PAY ITEMS. NOTE: DUAL LEFT TURNS NOT SHOWN REFER TO VOLUME DENSITY ("FAR OUT" DETECTION)
ON SAME APPROACH


(PROTECTED / PERMITTED LEFT TURN PHASING)

* = (600 mm)

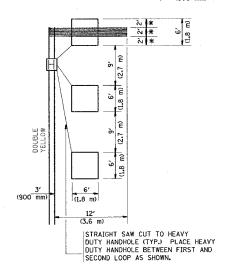


NOTE: DUAL LEFT TURNS NOT SHOWN REFER TO PLAN SHEET FOR DETECTOR LOOP REPLACEMENT

ARTERIAL-VOLUME DENSITY ("FAR OUT" DETECTION) CROSS STREET-VOLUME DENSITY ("FAR OUT" DETECTION)

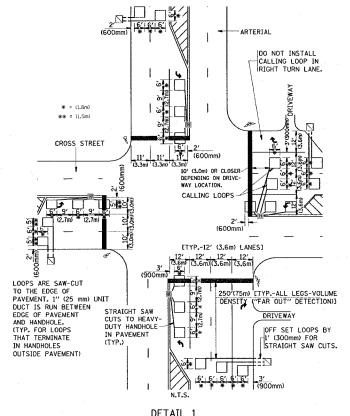

a Additional Colors 10/25/2003 3: 20: At 36 (Second) Dispers

ARTERIAL-VOLUME DENSITY ("FAR OUT" DETECTION)
CROSS STREET-NON VOLUME DENSITY ("UPTIGHT" PRESENCE DETECTION)

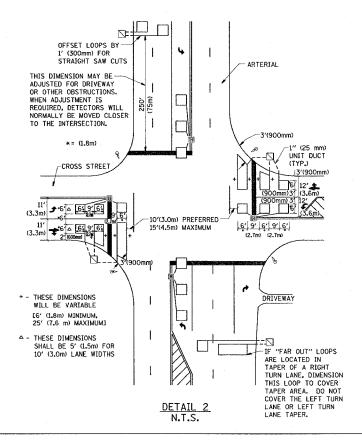

| 1,4,0 | SECTION | COUNTY | TO STA. | FED. 0000 CIST. NO. 1 | BLANDIS | FED. AND PROJECT | SHEET | NO. 1 | BLANDIS | FED. AND PROJECT | STA.

¥ 2786, 1334, 1332

NOTES:

VEHICLES LOOP DETECTORS

- * ALL LEAD IN CABLE SHALL BE TWO CONDUCTOR NO. 14 TWISTED, SHIELDED.
- * EACH DETECTOR LOOP SHALL HAVE ITS OWN SAW CUT FROM THE LOOP TO THE EDGE OF PAVEMENT OR TO A HANDHOLE IN THE PAVEMENT.
- * EACH DETECTOR LOOP SHALL HAVE ITS OWN ONE INCH (25 mm) UNIT DUCT BETWEEN THE EDGE OF PAVEMENT AND THE FIRST HANDHOLE OR JUNCTION BOX, EACH UNIT DUCT RUN SHALL BE SHOWN ON THE PLANS BY THE DESIGNER, BUT SHALL NOT BE PAID FOR SEPARATLY. THIS ITEM IS INCIDENTAL TO THE PAY ITEM FOR DETECTOR LOOPS.
- * ONE DIMENSION OF $\underline{\mbox{ALL}}$ DETECTOR LOOPS SHALL BE SIX FEET (1.8 m)
- * EACH LANE OF NON-LOCKING, PRESENCE DETECTION AND EACH LANE OF A DOUBLE LEFT TURN LANE REQUIRES A SEPARATE INDUCTIVE LOOP DETECTOR AND LEAD IN CABLE.
- * WHEN NON-LOCKING, PRESENCE DETECTION IS USED, MORE THAN ONE LOOP PER LANE IS REQUIRED BEHIND THE STOP BAR (i.e. 1-1/2, 1-3/4, 2).
- * WHEN SYSTEM LOOPS ARE REQUIRED ON AN APPROACH OF AN INTERSECTION, THE LOOPS USED FOR VOLUME DENSITY AND INTERSECTION TIMING SHALL ALSO BE USED AS SYSTEM DETECTORS, EACH ONE OF THESE TYPE OF LOOPS REQUIRES A SEPARATE TWO CONDUCTOR NO. 14 TWISTED SHIELDED CABLE AND A SEPARATE INDUCTIVE LOOP DETECTOR WHEN NEW CONTROLLERS ARE UTILIZED. THE DESIGNER SHALL LABEL THESE TYPES OF LOOPS AS "INTERSECTION AND SAMPLING (SYSTEM) DETECTORS" ON THE SIGNAL LAYOUT, THE INTERCONNECT PLAN AND THE SYSTEM CABLE PLAN. WHEN AN EXISTING CONTROLLER IS UTILIZED FOR THIS TYPE OF DETECTION, THE PAY ITEM "INDUCTIVE LOOP DETECTOR WITH SYSTEM OUTPUT" SHOULD BE USED.

PLACEMENT OF DETECTORS

THE FOLLOWING FIGURES REPRESENT THE MOST COMMON DETECTOR LOOP LOCATIONS AND SIZES, ADJUSTMENTS WILL BE NECESSARY FOR SPECIFIC GEOMETRIC CONSIDERATIONS.

LOCATIONS AND DEMENSIONS OF DETECTOR LOOPS ARE REQUIRED ON $\underline{\mathsf{ALL}}$ SIGNAL LAYOUT PLAN SHEETS.

"FAR OUT" DETECTION REFERS TO LOCKING, PRESENCE TYPE DETECTION LOCATED IN THRU LANES, RIGHT TURN LANES, AND RIGHT TURN LANE TAPER AREAS (IF APPLICABLE), USUALLY 250' (75 m) IN ADVANCE OF STOP BARS. "UPTIGHT" DETECTION REFERS TO NON-LOCKING PRESENCE TYPE DETECTION LOCATED IN ALL LANES AND 10'-15' (3.0 m-4.5 m) BEHIND THE CROSSING STREET'S EDGE OF PAVEMENT EXTENDED.

NOTE:

ALL DETAILS AND NOTES SHOWN ARE FROM THE I.D.O.T. DISTRICT 1
TRAFFIC SIGNAL DESIGN GUIDELINES DATED JANUARY 1995

THIS DRAWING HAS BEEN PREPARED TO ASSIST THE RESIDENT ENGINEER FOR ALL ROADWAY RESURFACING OR S.M.A.R.T. PROJECTS WHERE THE DIMENSIONS ARE NOT SHOWN ON THE PLANS AND THE FINAL LOCATIONS FOR CROSSWALKS OR STOP BARS ARE NOT DETERMINED.

ILLINOIS DEPARTMENT OF TRANSPORTATION

REVISIONS
NAME
DATE
DETECTOR LOOP
INSTALLATION DETAILS
FOR ROADWAY RESURFACING

SCALE: NONE
DRAWN BY CADD
DESIGNED BY
CHECKED BY R.K.F.

1507

REVISION DAI E: