

FOR INFORMATION ONLY


STATE OF ILLINOIS
CITY OF CHICAGO
DEPARTMENT OF PUBLIC WORKS
BUREAU OF ENGINEERING

NORTHWEST ROUTE SUPERHIGHWAY

PLANS FOR
HALSTED STREET INTERCHANGE
SECTION 0101.6-1P

FAI ROUTE NO. 94 PROJECT I-94-3 (1)-51 (NEW NUMBER)
FAI ROUTE NO. 4 PROJECT I-04-8 (89) (OLD NUMBER)

REVISED BY: []
DATE: []
F.A.I. 0101.6-1P COO: 118
728 5000 BY: []

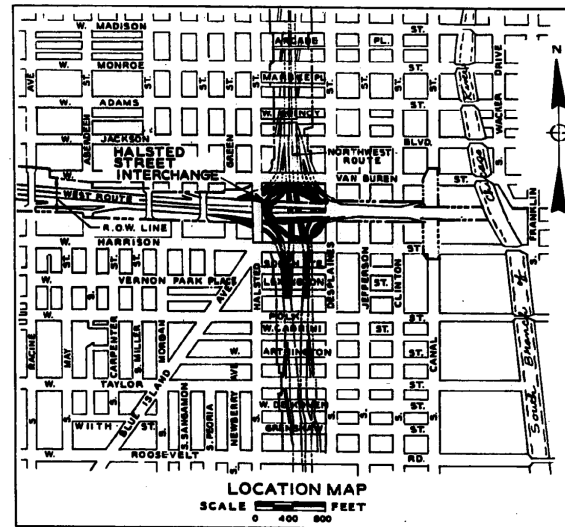

APPROVED AS TO SEWER ALTERATIONS AND ADDITIONS

[Signature]
CHIEF ENGINEER OF SEWERS
DEPUTY FOR SEWER

CITY OF CHICAGO
DEPARTMENT OF PUBLIC WORKS
BUREAU OF ENGINEERING
DATE AUGUST 13, 1959
APPROVED *[Signature]*
CHIEF SURVEY AND SUPERHIGHWAY ENGINEER
APPROVED *[Signature]*
ASSISTANT CHIEF ENGINEER
APPROVED *[Signature]*
CHIEF ENGINEER
APPROVED *[Signature]*
COMMISSIONER

DEPARTMENT OF COMMERCE
BUREAU OF PUBLIC ROADS
APPROVED _____ 19____
DIVISION ENGINEER DATE

THE DEPARTMENT OF
PUBLIC WORKS AND BUILDINGS
DIVISION OF HIGHWAYS
APPROVED _____ 19____
APPROVED _____ 19____
DIRECTOR

SHEET NO. 6-1 OF 118 SHEETS

FILE PATH = C:\Projects\14-0425 - 60W28 StreetBulbs\14-0425-60W28-sht-AS-BUILT-01.dgn



D160W28-sht-AS-BUILT-01.dgn
USER NAME = auyeungh
PLOT SCALE = 1.0000' / in.
PLOT DATE = 4/25/2014

DESIGNED -
DRAWN -
CHECKED -
DATE - 04/28/14

REVISED -
REVISED -
REVISED -
REVISED -

STATE OF ILLINOIS
DEPARTMENT OF TRANSPORTATION

EXISTING AS-BUILTS
SN 016-2449 & SN 016-2451

SCALE: SHEET 1 OF 48 SHEETS STA. TO STA.

F.A.I. RTE.	SECTION	COUNTY	TOTAL SHEETS	SHEET NO.
90/94/290	2013-010R	COOK	747	471
CONTRACT NO. 60W28				
ILLINOIS FED. AID PROJECT				