


FOR INFORMATION ONLY



SECTION	COUNTY	DATE	NO.
P.A.134	COOK	113	4

FILE PATH = C:\Project\14-0425 - 60W28 - 60W28 - sht-AS-BUILT-03.dgn

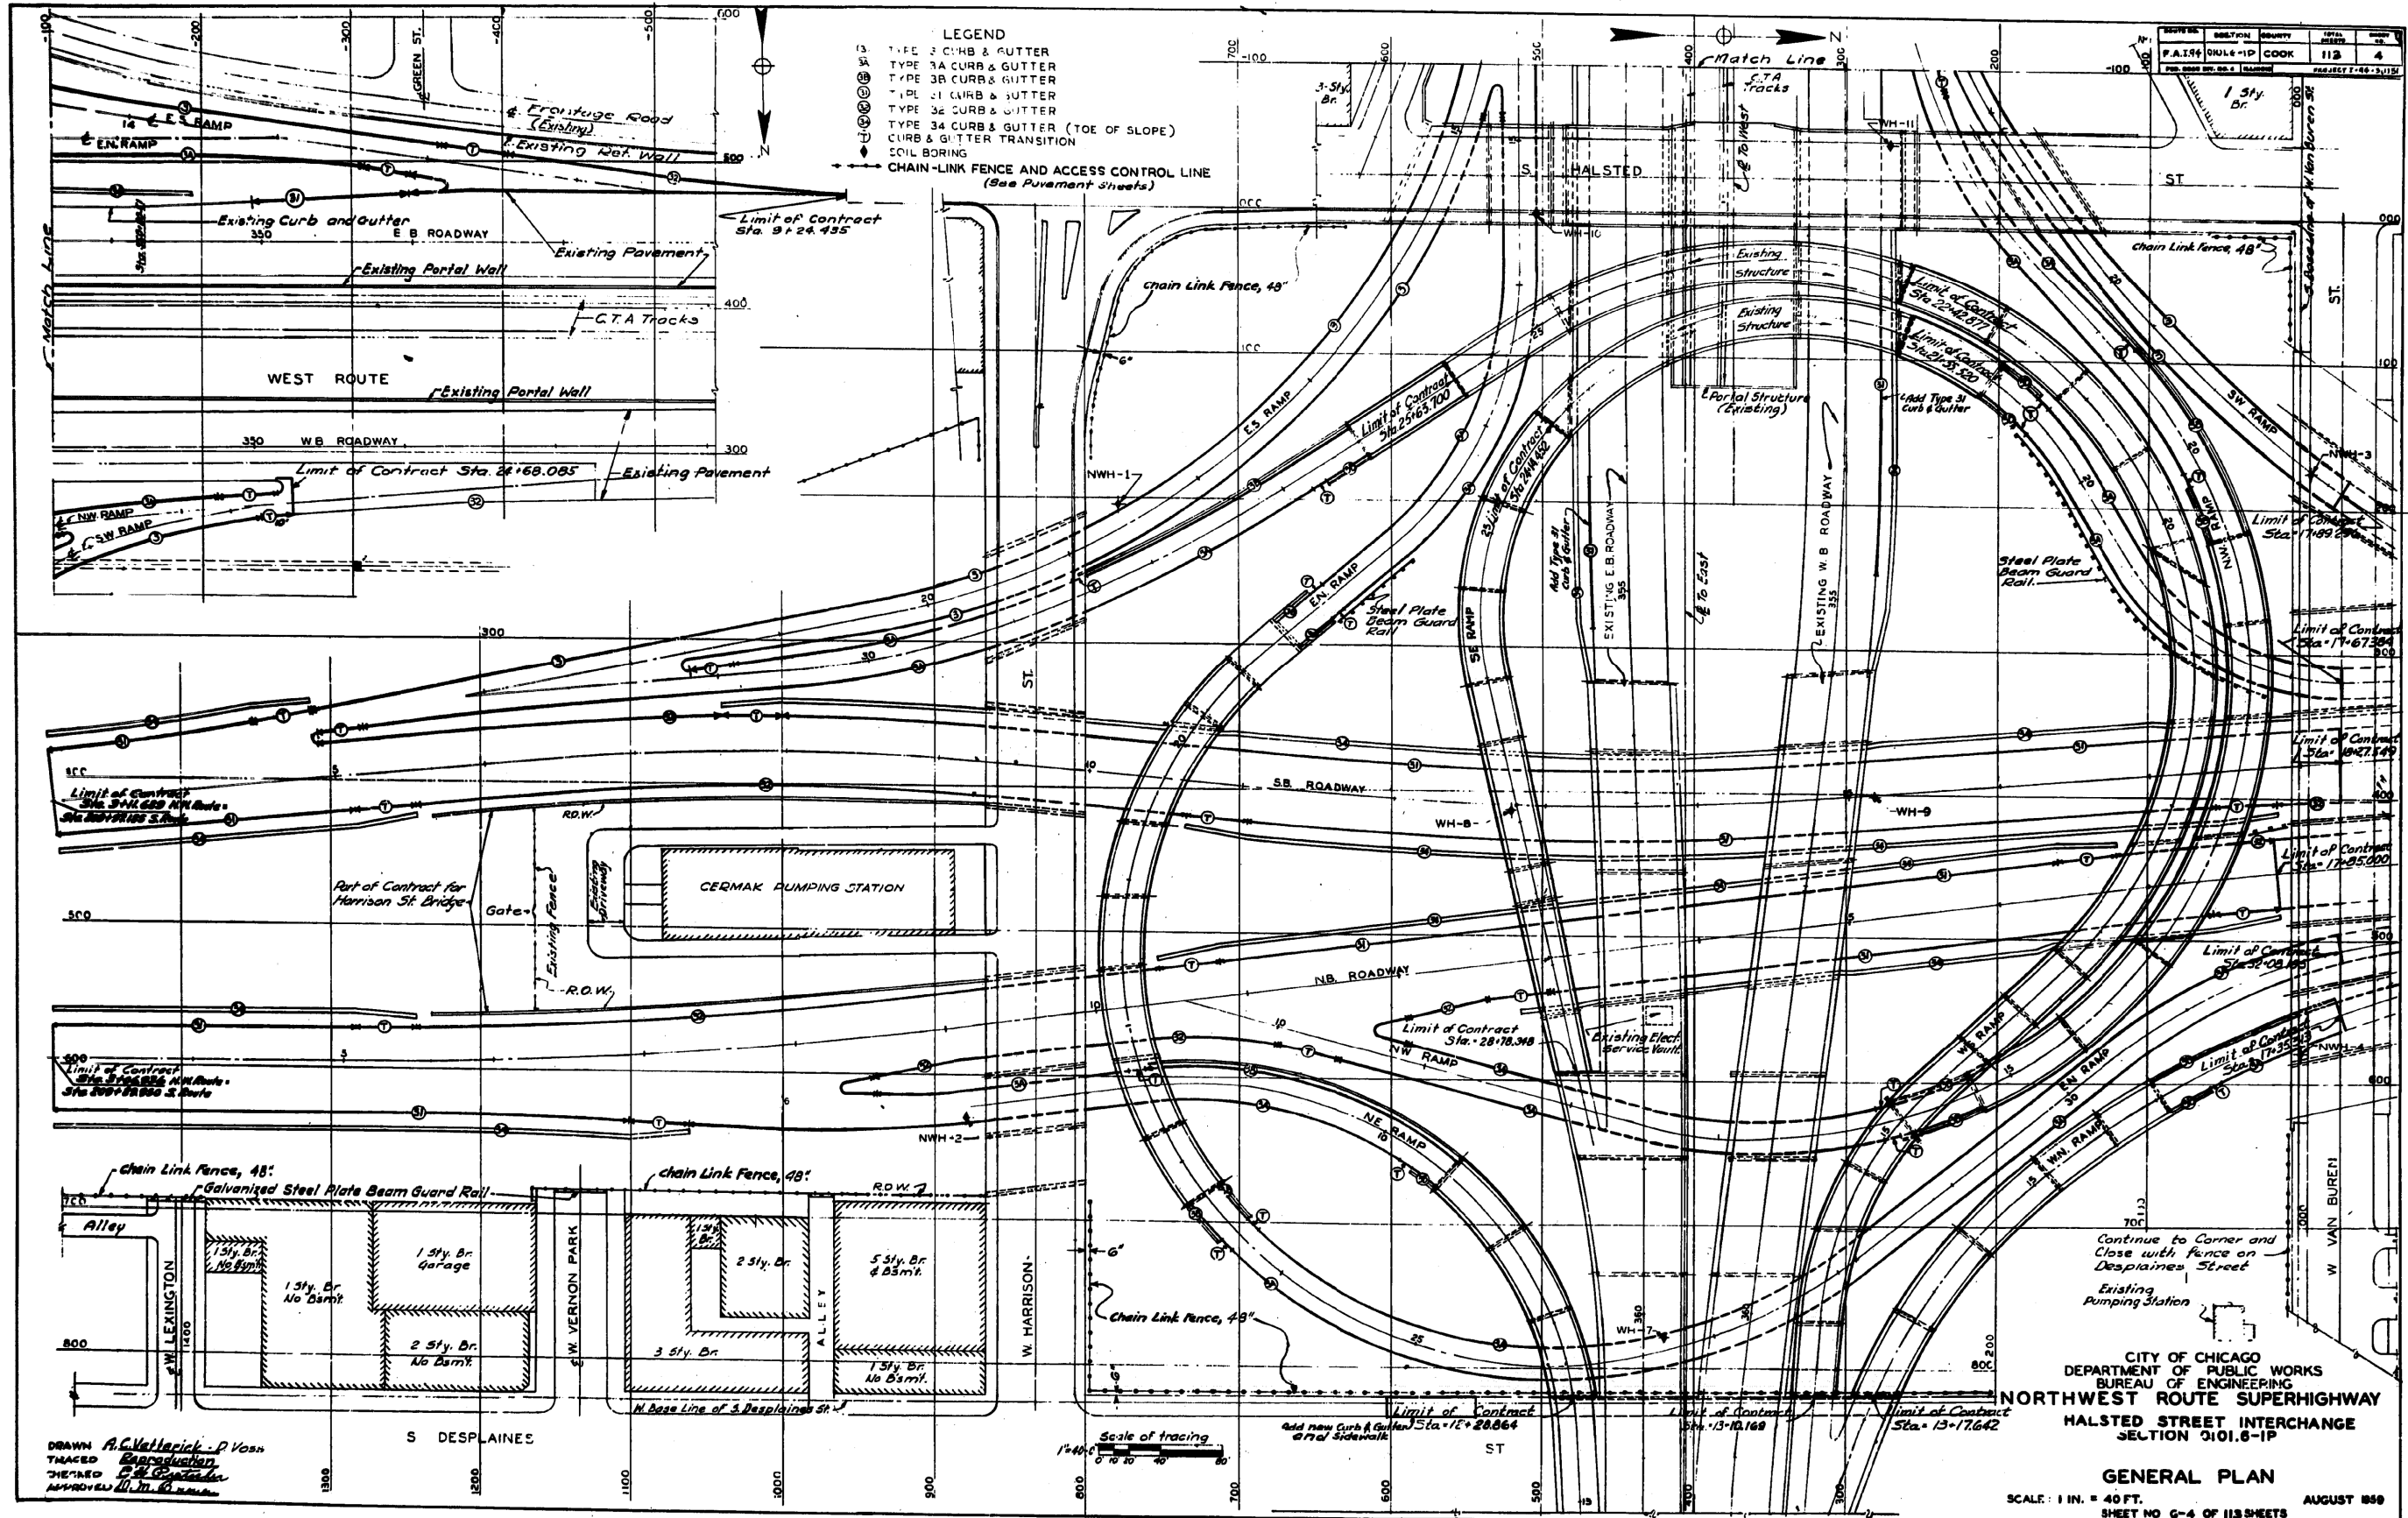

D160W28-sht-AS-BUILT-03.dgn  
 USER NAME = auyehung  
 PLOT SCALE = 1:8000 / 1 in.  
 PLOT DATE = 4/25/2014

DESIGNED -  
 DRAWN -  
 CHECKED -  
 DATE - 04/28/14

REVISED -  
 REVISED -  
 REVISED -  
 REVISED -

STATE OF ILLINOIS  
 DEPARTMENT OF TRANSPORTATION

EXISTING AS-BUILTS  
 SN 016-2449 & SN 016-2451

SCALE: NTS SHEET 3 OF 48 SHEETS STA. TO STA.

F.A.I. RTE.	SECTION	COUNTY	TOTAL SHEETS	SHEET NO.
90/94/290	2013-010R	COOK	747	473
CONTRACT NO. 60W28				

ILLINOIS FED. AID PROJECT