


FOR INFORMATION ONLY

ROUTE NO. 1	SECTION	COUNTY	SHEET
F. A. I. 94	0101.6-1P	COOK	113
FED. ROAD DIV. No. 4	ILLINOIS	PROJECT 1-94-3(1)-51	65

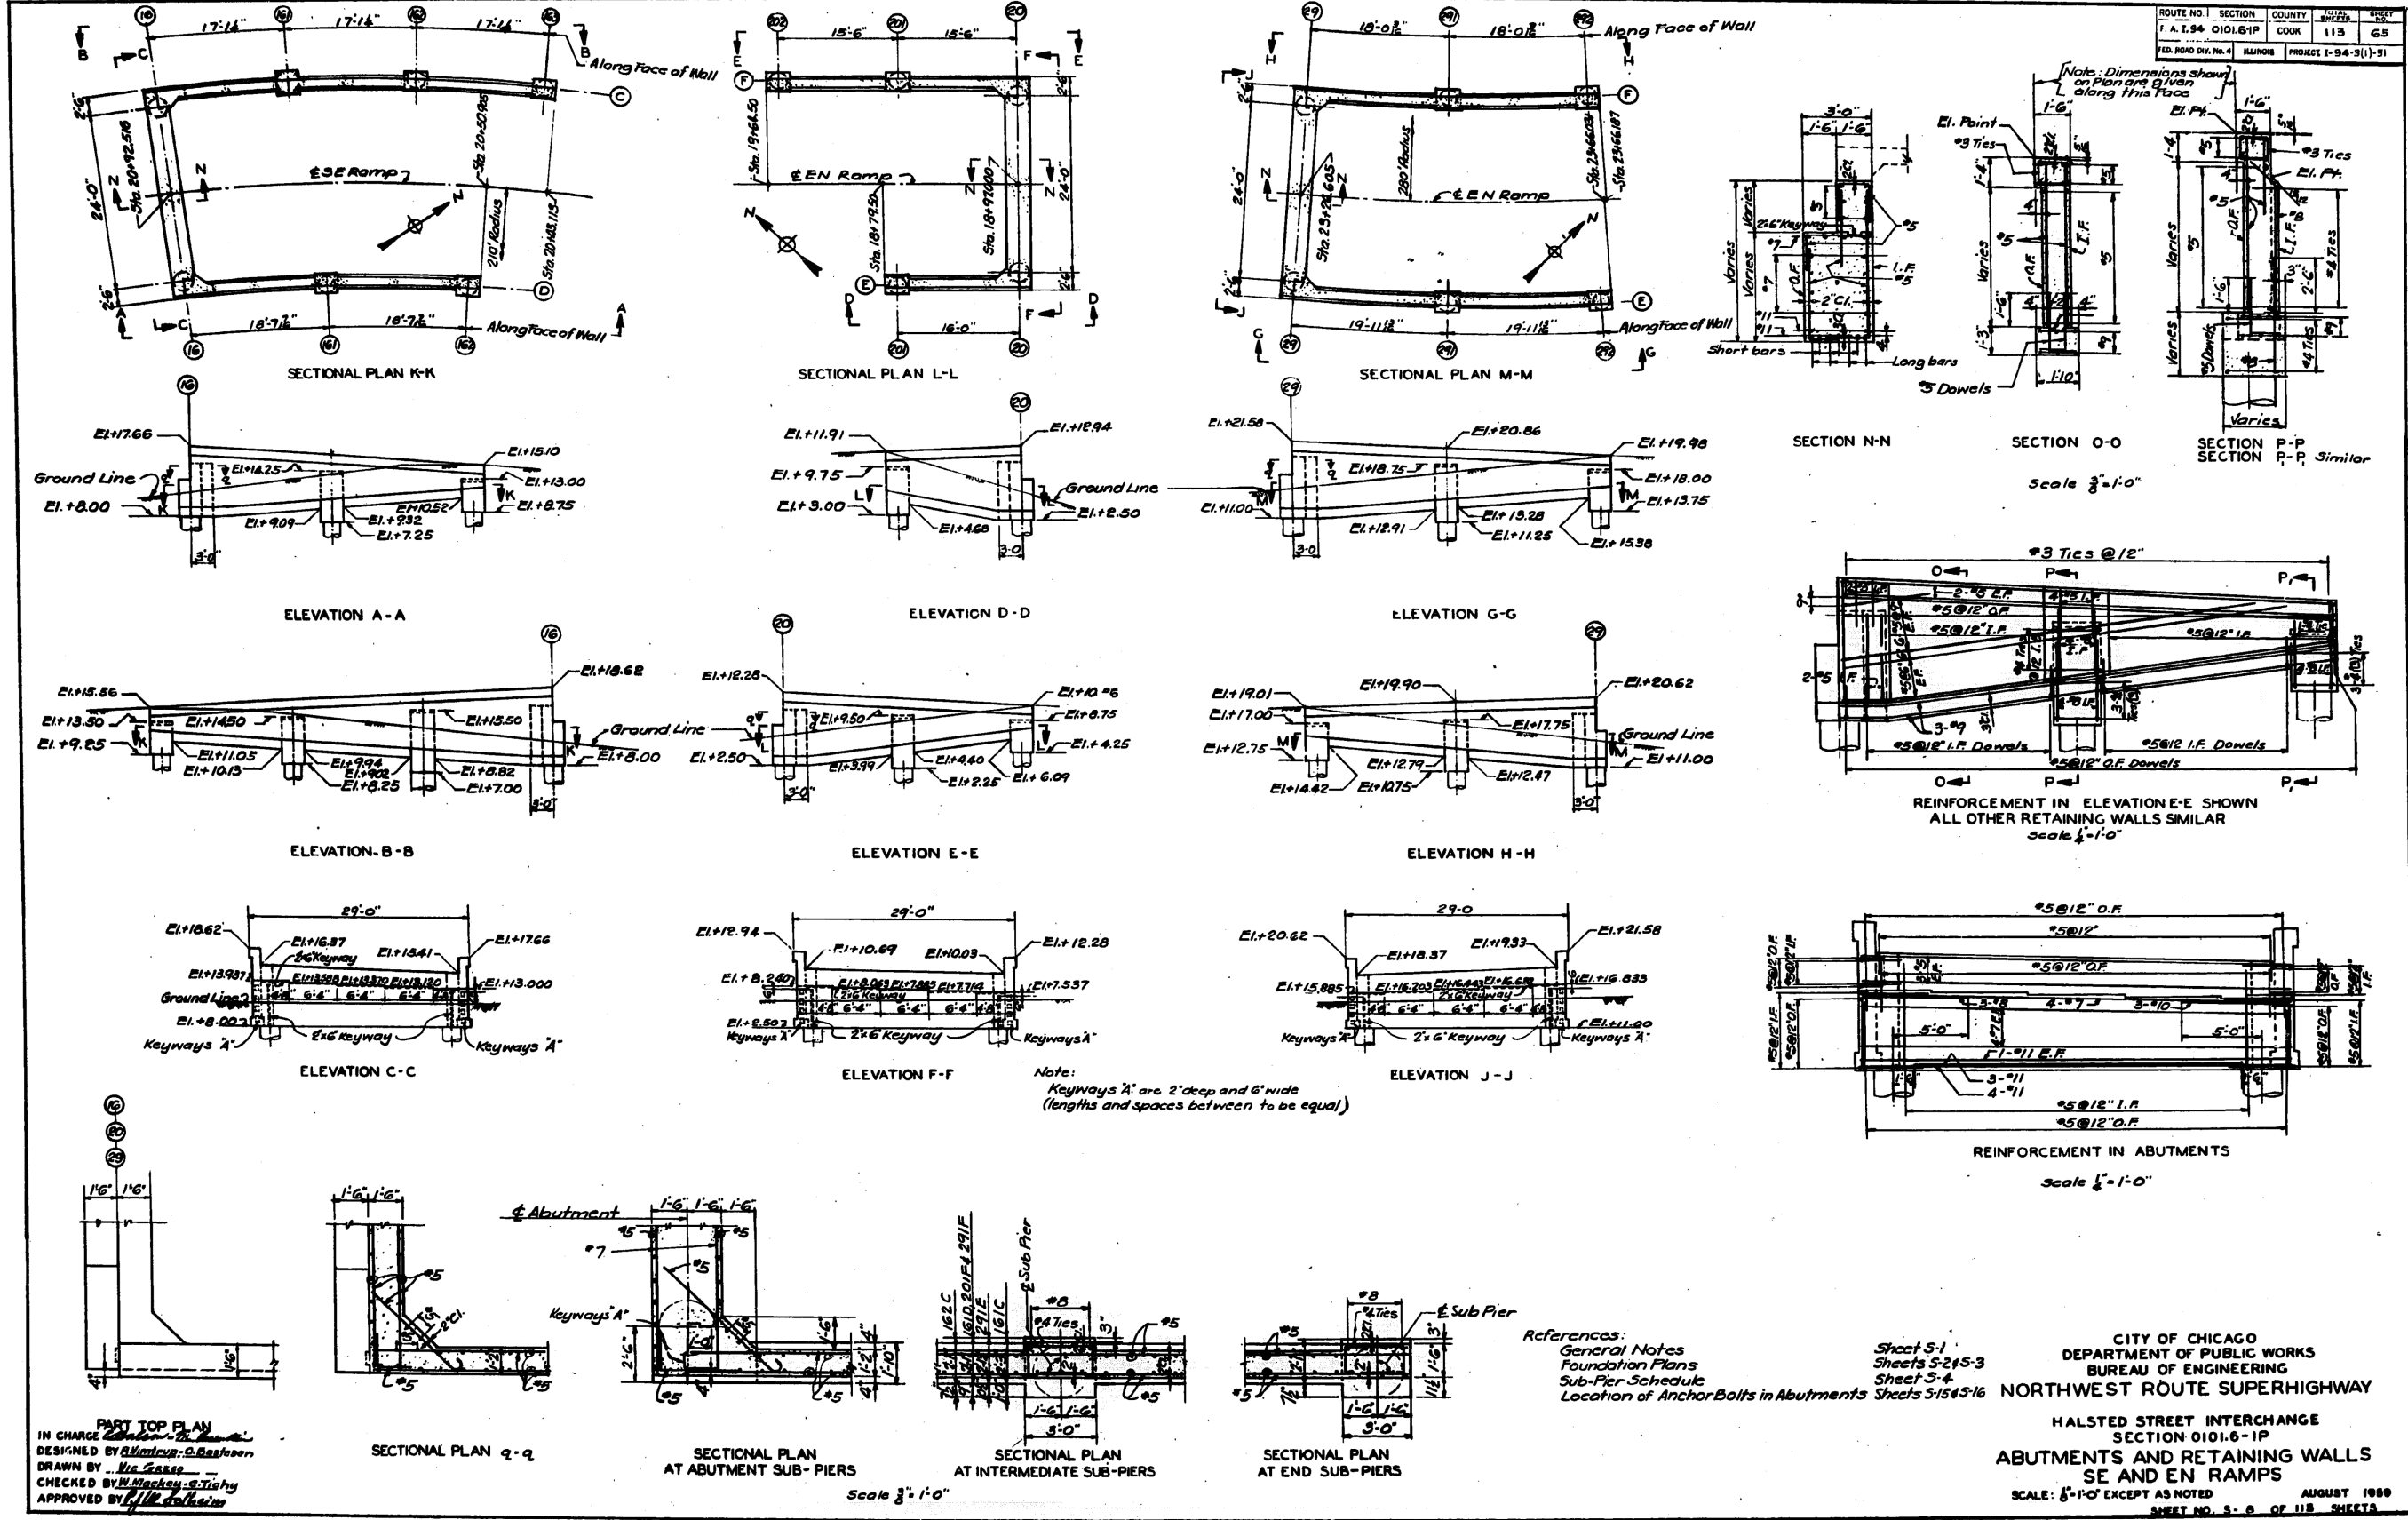

PART TOP PLAN
 IN CHARGE: [Signature]
 DESIGNED BY: [Signature]
 DRAWN BY: [Signature]
 CHECKED BY: [Signature]
 APPROVED BY: [Signature]

Note:
 Keyways 'A' are 2' deep and 6' wide
 (lengths and spaces between to be equal)

References:
 General Notes
 Foundation Plans
 Sub-Pier Schedule
 Location of Anchor Bolts in Abutments

Sheet S-1
 Sheets S-215-3
 Sheet S-4
 Sheets S-1545-16

CITY OF CHICAGO
 DEPARTMENT OF PUBLIC WORKS
 BUREAU OF ENGINEERING
NORTHWEST ROUTE SUPERHIGHWAY
 HALSTED STREET INTERCHANGE
 SECTION 0101.6-1P
**ABUTMENTS AND RETAINING WALLS
 SE AND EN RAMP**
 SCALE: 1/4" = 1'-0" EXCEPT AS NOTED
 AUGUST 1989
 SHEET NO. 3 OF 113 SHEETS

FILE PATH = C:\Projects\14-0425 - 60W28 - Structure\14-0425 - 60W28 - Structure\AS-BUILT-13.dgn



D160W28-sht-AS-BUILT-13.dgn
 USER NAME = auyeyungh
 PLOT SCALE = 1:8000 / in.
 PLOT DATE = 4/25/2014

DESIGNED -	REVISIONS
DRAWN -	REVISIONS
CHECKED -	REVISIONS
DATE - 04/28/14	REVISIONS

STATE OF ILLINOIS
 DEPARTMENT OF TRANSPORTATION

EXISTING AS-BUILTS
 SN 016-2449 & SN 016-2451

SCALE: NTS SHEET 13 OF 48 SHEETS STA. TO STA.

F.A.I. RTE.	SECTION	COUNTY	TOTAL SHEETS	SHEET NO.
90/94/290	2013-010R	COOK	747	483
				CONTRACT NO. 60W28
ILLINOIS FED. AID PROJECT				