


FOR INFORMATION ONLY



FILE PATH = C:\Projects\14-0425 - 60W28 Structure\14-0425 - 60W28-Str-Built-14.dgn

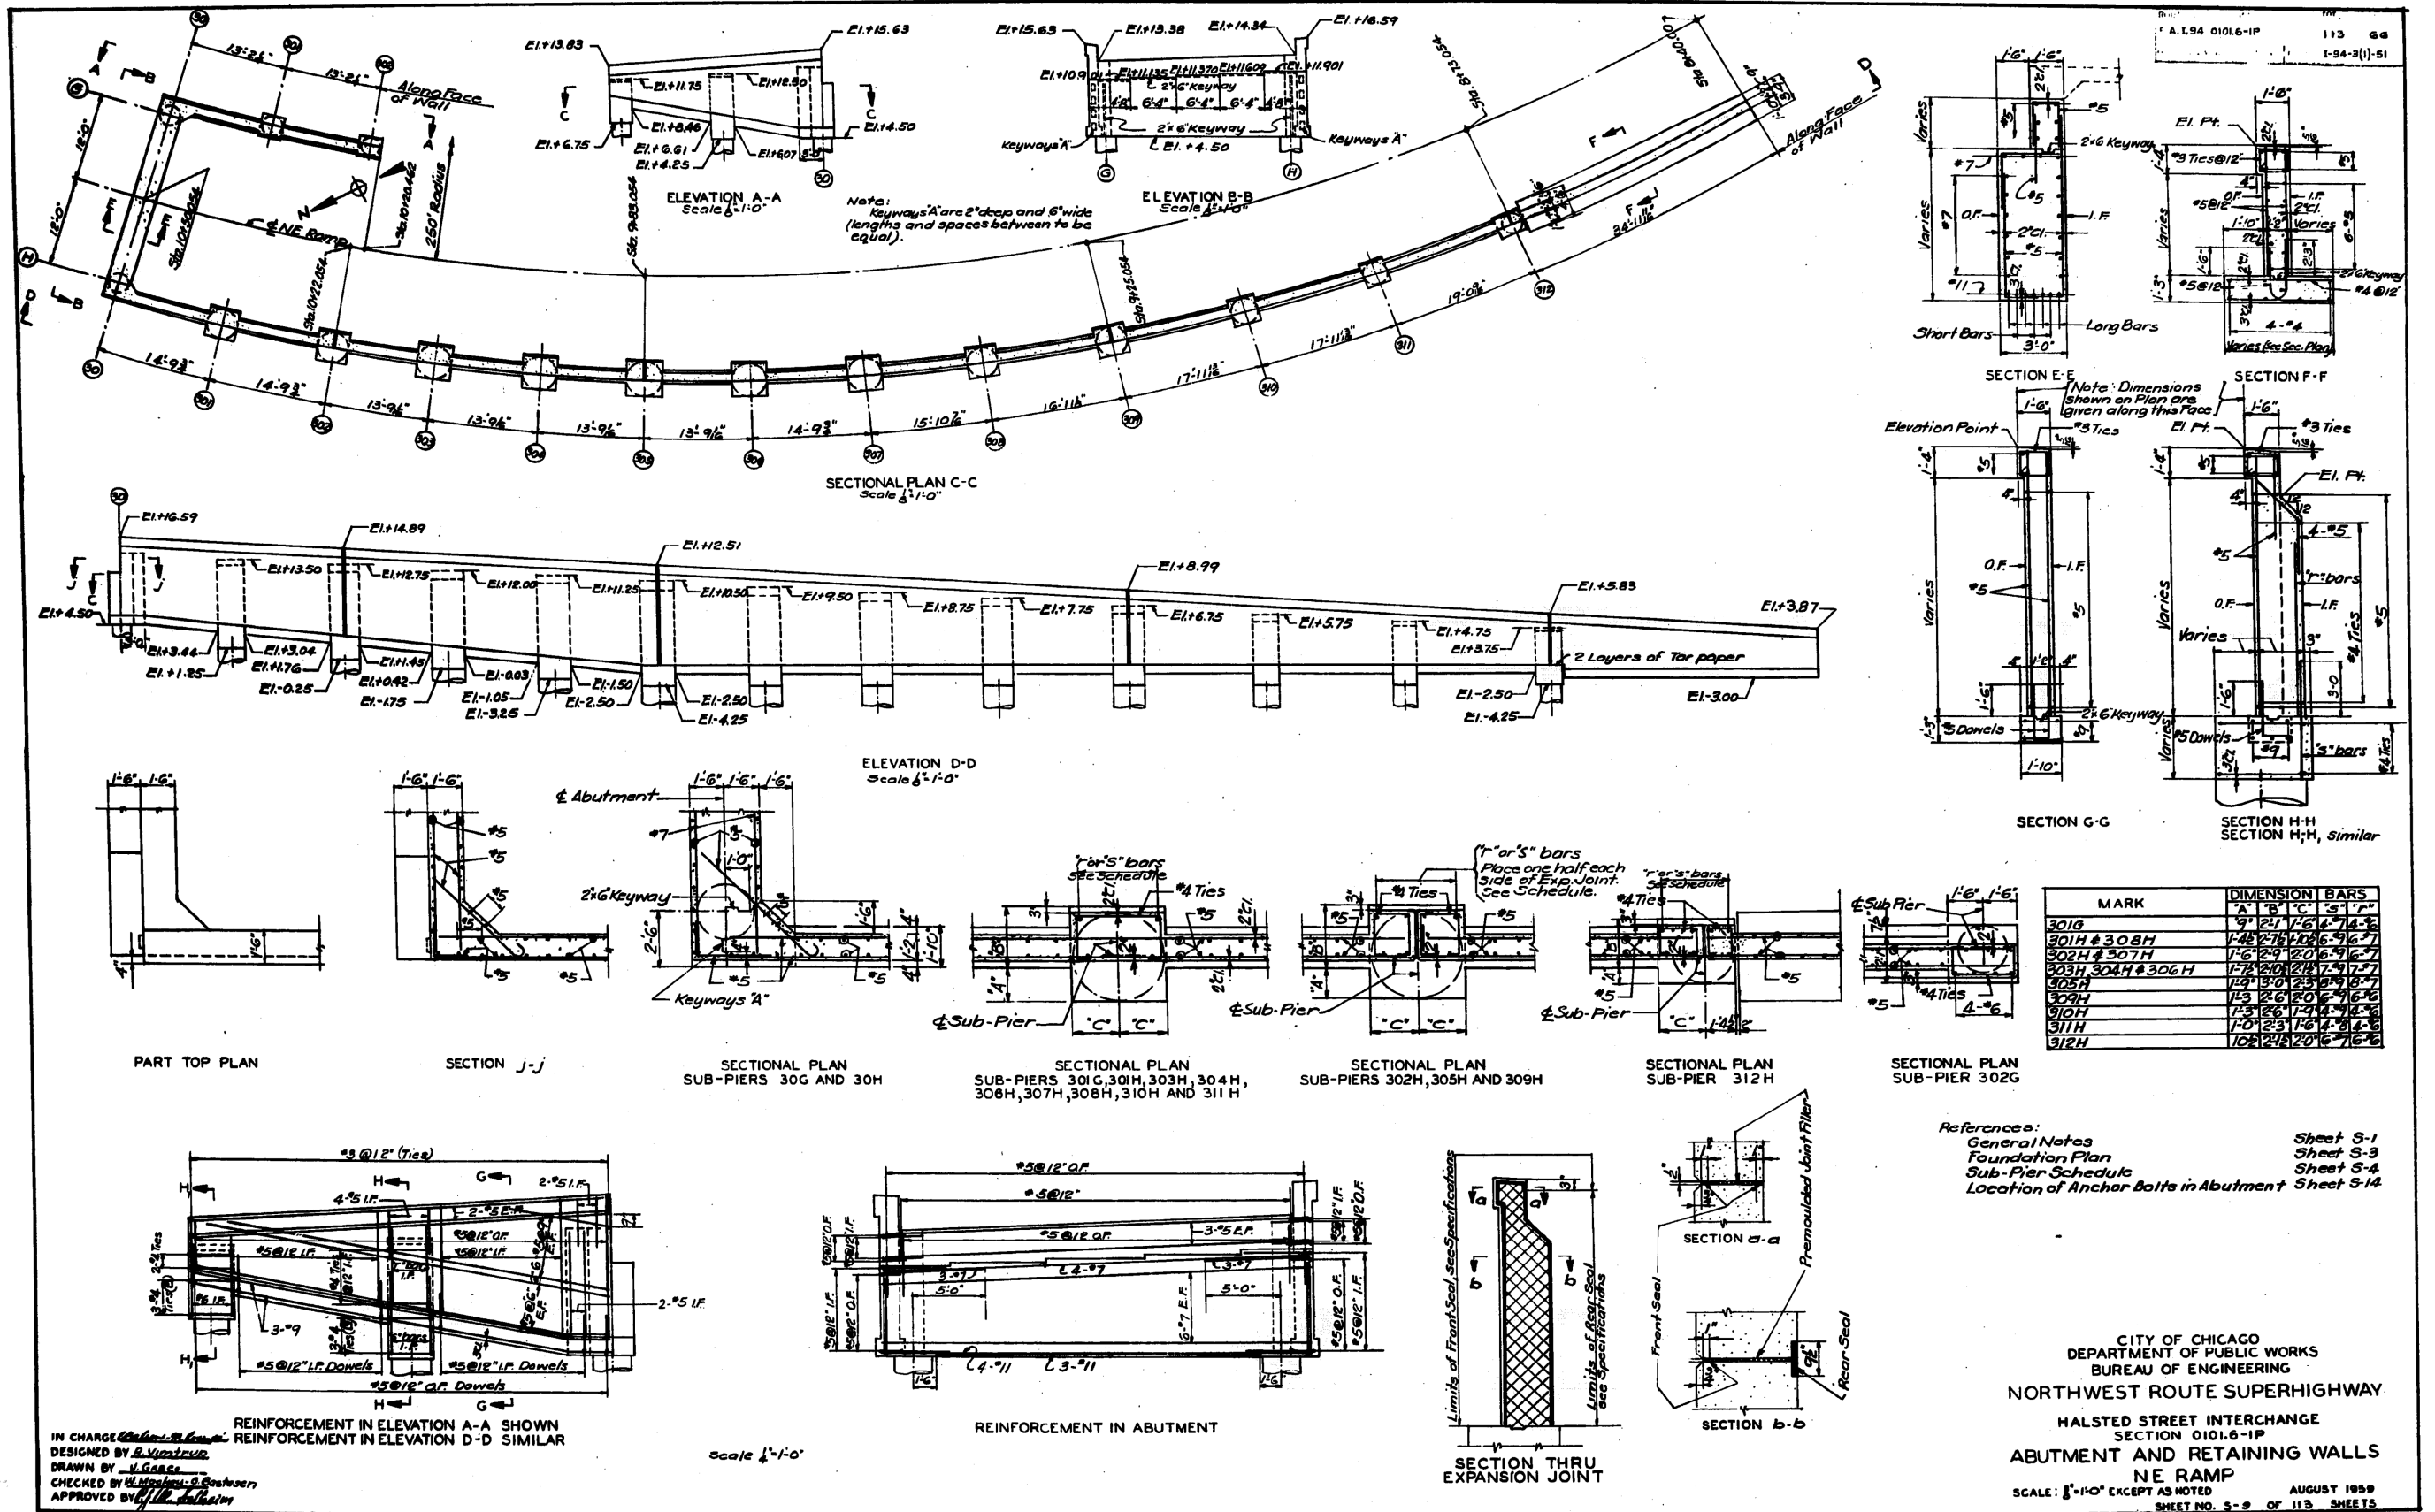

D160W28-sht-AS-BUILT-14.dgn
 USER NAME = ayeung
 PLOT SCALE = 1:8000 / 1/8"=1'-0"
 PLOT DATE = 4/25/2014

DESIGNED -
 DRAWN -
 CHECKED -
 DATE - 04/28/14

REVISED -
 REVISED -
 REVISED -
 REVISED -

STATE OF ILLINOIS
 DEPARTMENT OF TRANSPORTATION

EXISTING AS-BUILTS
 SN 016-2449 & SN 016-2451

CITY OF CHICAGO
 DEPARTMENT OF PUBLIC WORKS
 BUREAU OF ENGINEERING
 NORTHWEST ROUTE SUPERHIGHWAY
 HALSTED STREET INTERCHANGE
 SECTION 0101.6-1P
 ABUTMENT AND RETAINING WALLS
 NE RAMP
 SCALE: 1/4"=1'-0" EXCEPT AS NOTED
 SHEET NO. S-9 OF 113 SHEETS

F.A.I. R.T.E.	SECTION	COUNTY	TOTAL SHEETS	SHEET NO.
90/94/290	2013-010R	COOK	747	484

CONTRACT NO. 60W28
 ILLINOIS FED. AID PROJECT

SCALE: NTS SHEET 14 OF 48 SHEETS STA. TO STA.