


FOR INFORMATION ONLY

ROUTE NO.	SECTION	COUNTY	TOTAL SHEETS	SHEET NO.
F.A. 1-94	0101.6-1P	COOK	115	73
FEED ROAD DIV. NO. 4	ILLINOIS	PROJECT 1-94-3(1)-51		



FILE PATH = C:\Projects\14-0425 - 60W28 - 60W28 - 60W28 - sht-AS-BUILT-21.dgn

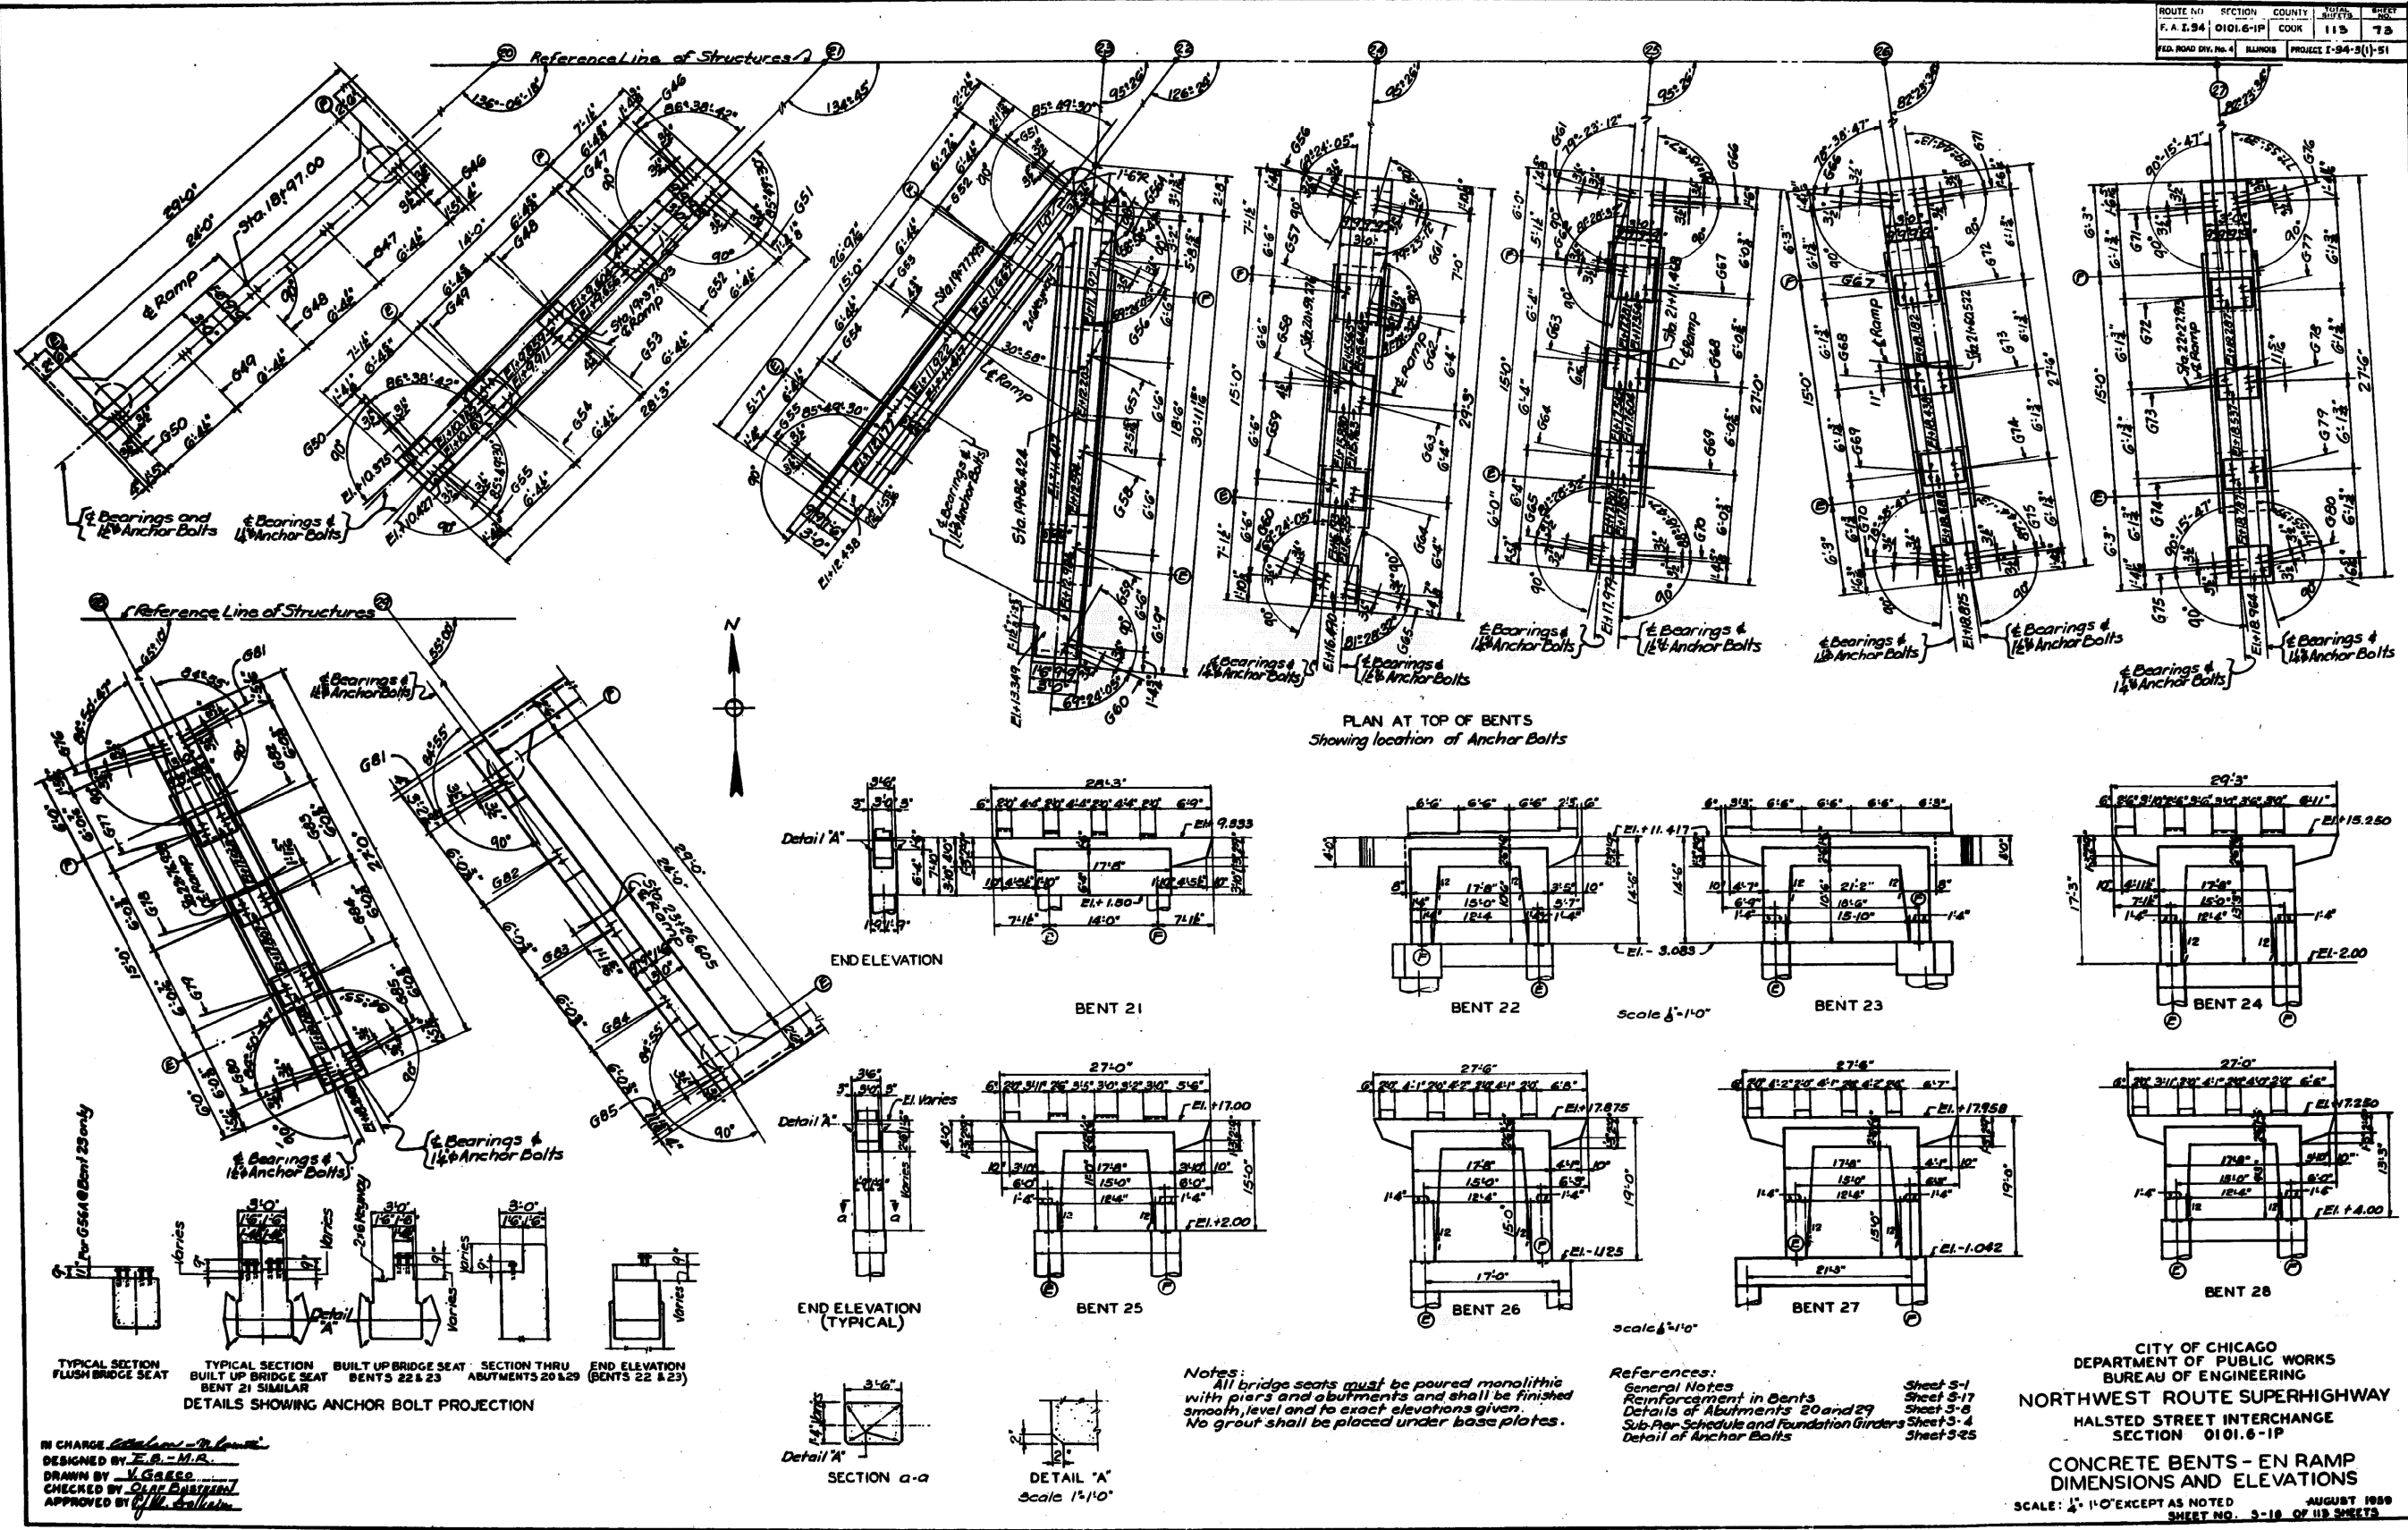

D160W28-sht-AS-BUILT-21.dgn  
USER NAME = ayeungh  
PLOT SCALE = 1.0000 / in.  
PLOT DATE = 4/25/2014

DESIGNED -  
DRAWN -  
CHECKED -  
DATE - 04/28/14

REVISED -  
REVISED -  
REVISED -  
REVISED -

STATE OF ILLINOIS  
DEPARTMENT OF TRANSPORTATION

EXISTING AS-BUILTS  
SN 016-2449 & SN 016-2451  
SCALE: NTS SHEET 21 OF 48 SHEETS STA. TO STA.

F.A.I. RTE.	SECTION	COUNTY	TOTAL SHEETS	SHEET NO.
90/94/290	2013-010R	COOK	747	491
				CONTRACT NO. 60W28
ILLINOIS FED. AID PROJECT				