


FOR INFORMATION ONLY

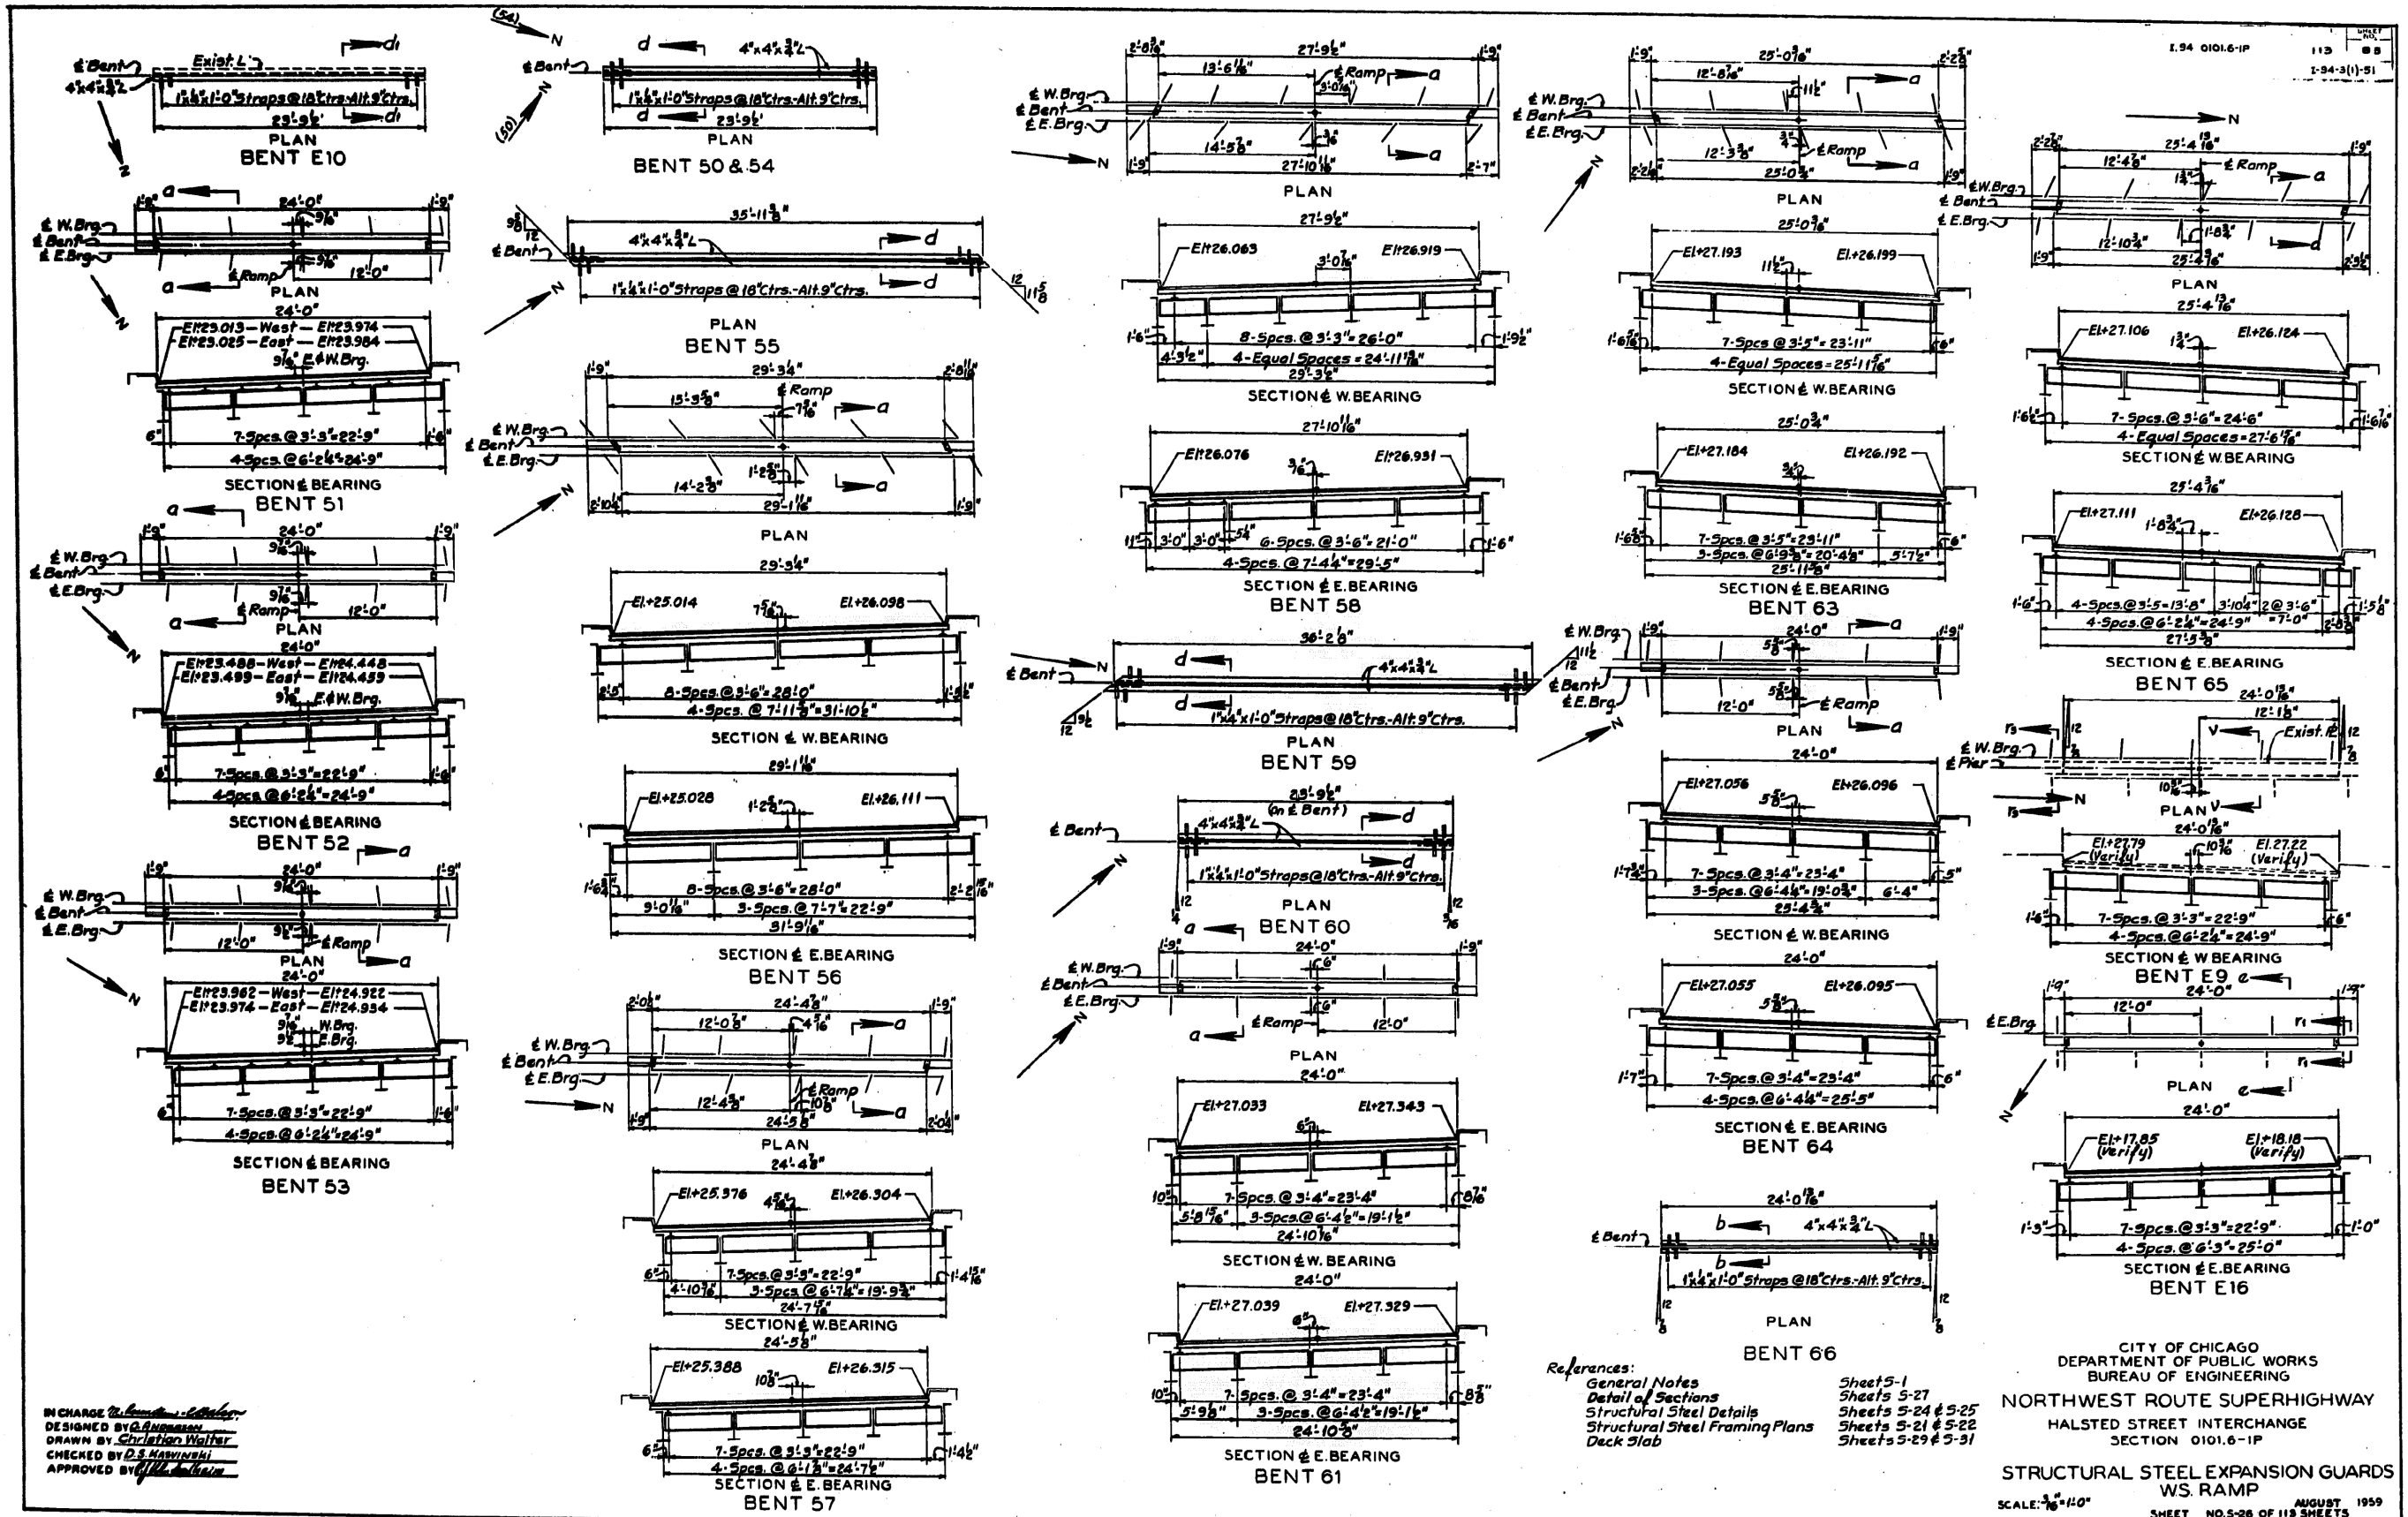

IN CHARGE: *[Signature]*
 DESIGNED BY: *[Signature]*
 DRAWN BY: *[Signature]*
 CHECKED BY: *[Signature]*
 APPROVED BY: *[Signature]*

References:
 General Notes
 Detail of Sections
 Structural Steel Details
 Structural Steel Framing Plans
 Deck Slab

CITY OF CHICAGO
 DEPARTMENT OF PUBLIC WORKS
 BUREAU OF ENGINEERING
 NORTHWEST ROUTE SUPERHIGHWAY
 HALSTED STREET INTERCHANGE
 SECTION 0101.6-1P
 STRUCTURAL STEEL EXPANSION GUARDS
 WS RAMP
 SCALE: 3/8" = 1'-0"
 AUGUST 1959
 SHEET NO. 5-26 OF 113 SHEETS



D:\6028-sht-AS-BUILT-31.dgn
 USER NAME = ayeunguh
 PLOT SCALE = 1:8000 / 1"
 PLOT DATE = 4/25/2014

DESIGNED -	REVISED -
DRAWN -	REVISED -
CHECKED -	REVISED -
DATE - 04/28/14	REVISED -

STATE OF ILLINOIS
 DEPARTMENT OF TRANSPORTATION

EXISTING AS-BUILTS
 SN 016-2449 & SN 016-2451

SCALE: NTS SHEET 31 OF 48 SHEETS STA. TO STA.

F.A.I. RTE.	SECTION	COUNTY	TOTAL SHEETS	SHEET NO.
90/94/290	2013-010R	COOK	747	501
CONTRACT NO. 60W28				
ILLINOIS FED. AID PROJECT				