


FOR INFORMATION ONLY



FILE PATH = C:\Projects\14-0425 - 60W28-Structural\14-0425-60W28-Structural\AS-BUILT.rvt-32.dgn

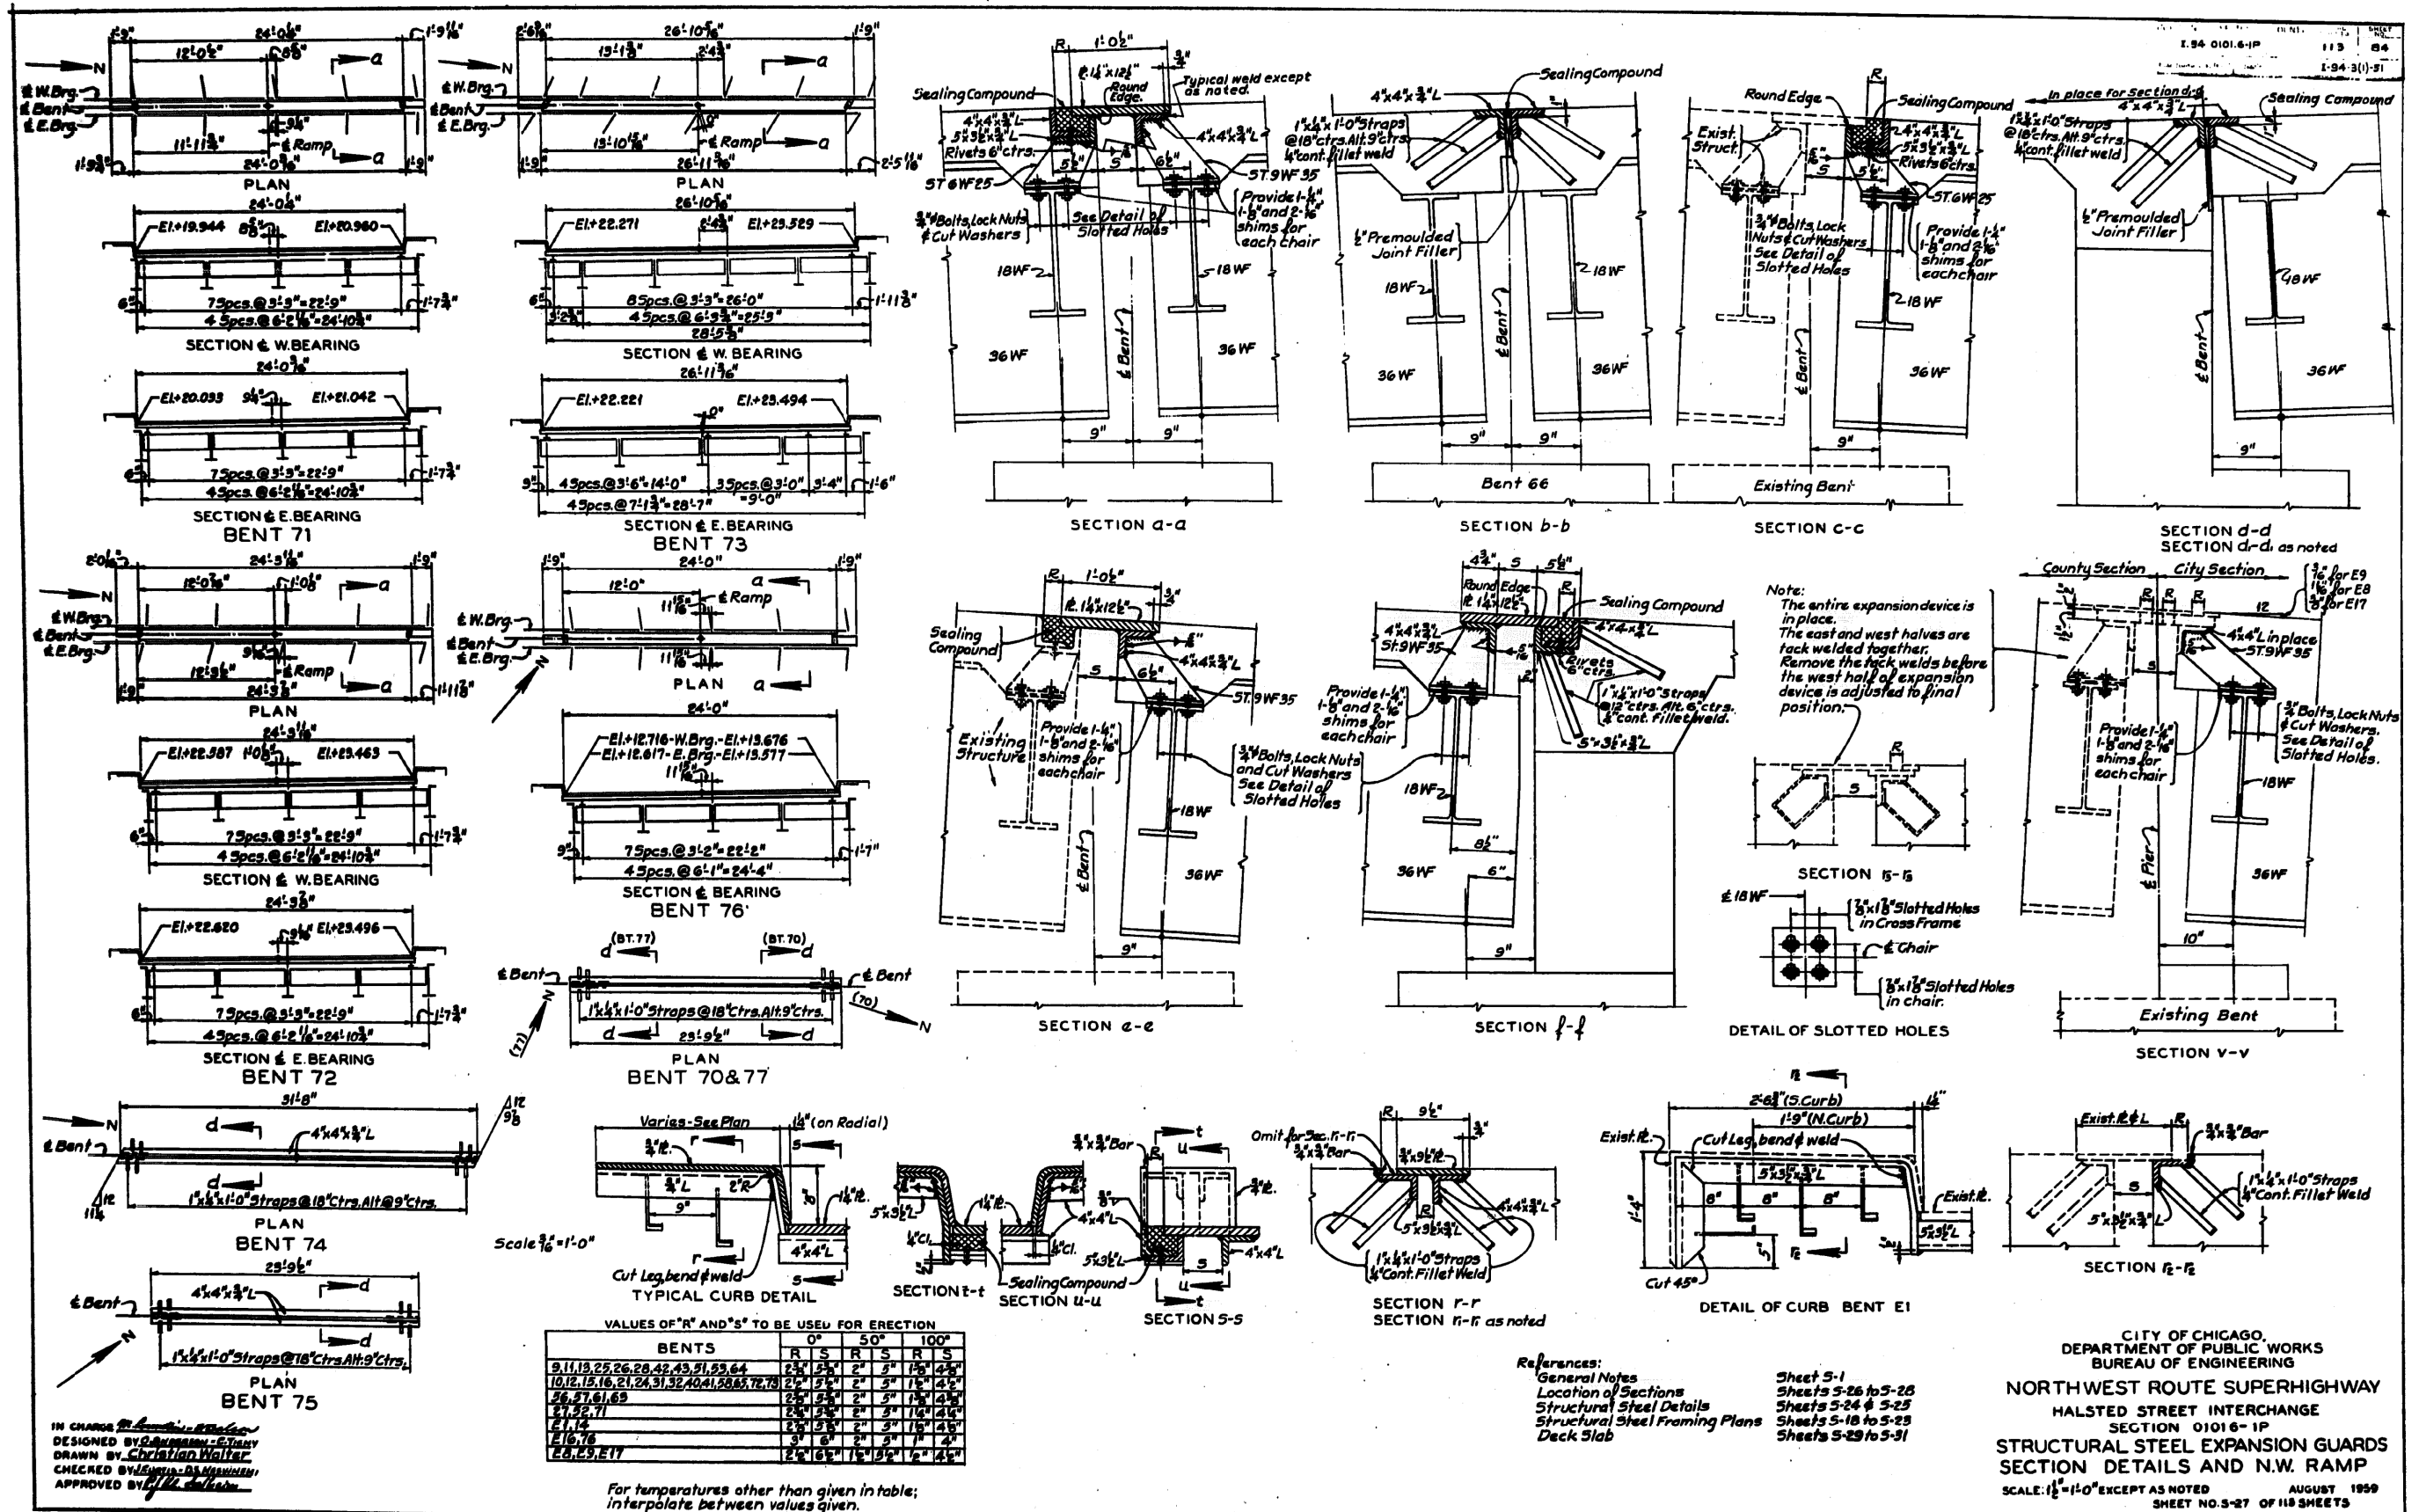

D160W28-sht-AS-BUILT-32.dgn
 USER NAME = auyeuongh
 PLOT SCALE = 1:8000 / in.
 PLOT DATE = 4/25/2014

DESIGNED -
 DRAWN -
 CHECKED -
 DATE - 04/28/14

REVISED -
 REVISED -
 REVISED -
 REVISED -

SCALE: NTS
 SHEET 32 OF 48 SHEETS
 STA. TO STA.

F.A.I. R.E.	SECTION	COUNTY	TOTAL SHEETS	SHEET NO.
90/94/290	2013-010R	COOK	747	502
CONTRACT NO. 60W28			ILLINOIS FED. AID PROJECT	