


FOR INFORMATION ONLY



FILE PATH = C:\Projects\14-0425 - 60W28 StructSteel\14-0425-60W28-StructSteel-Built-33.dgn

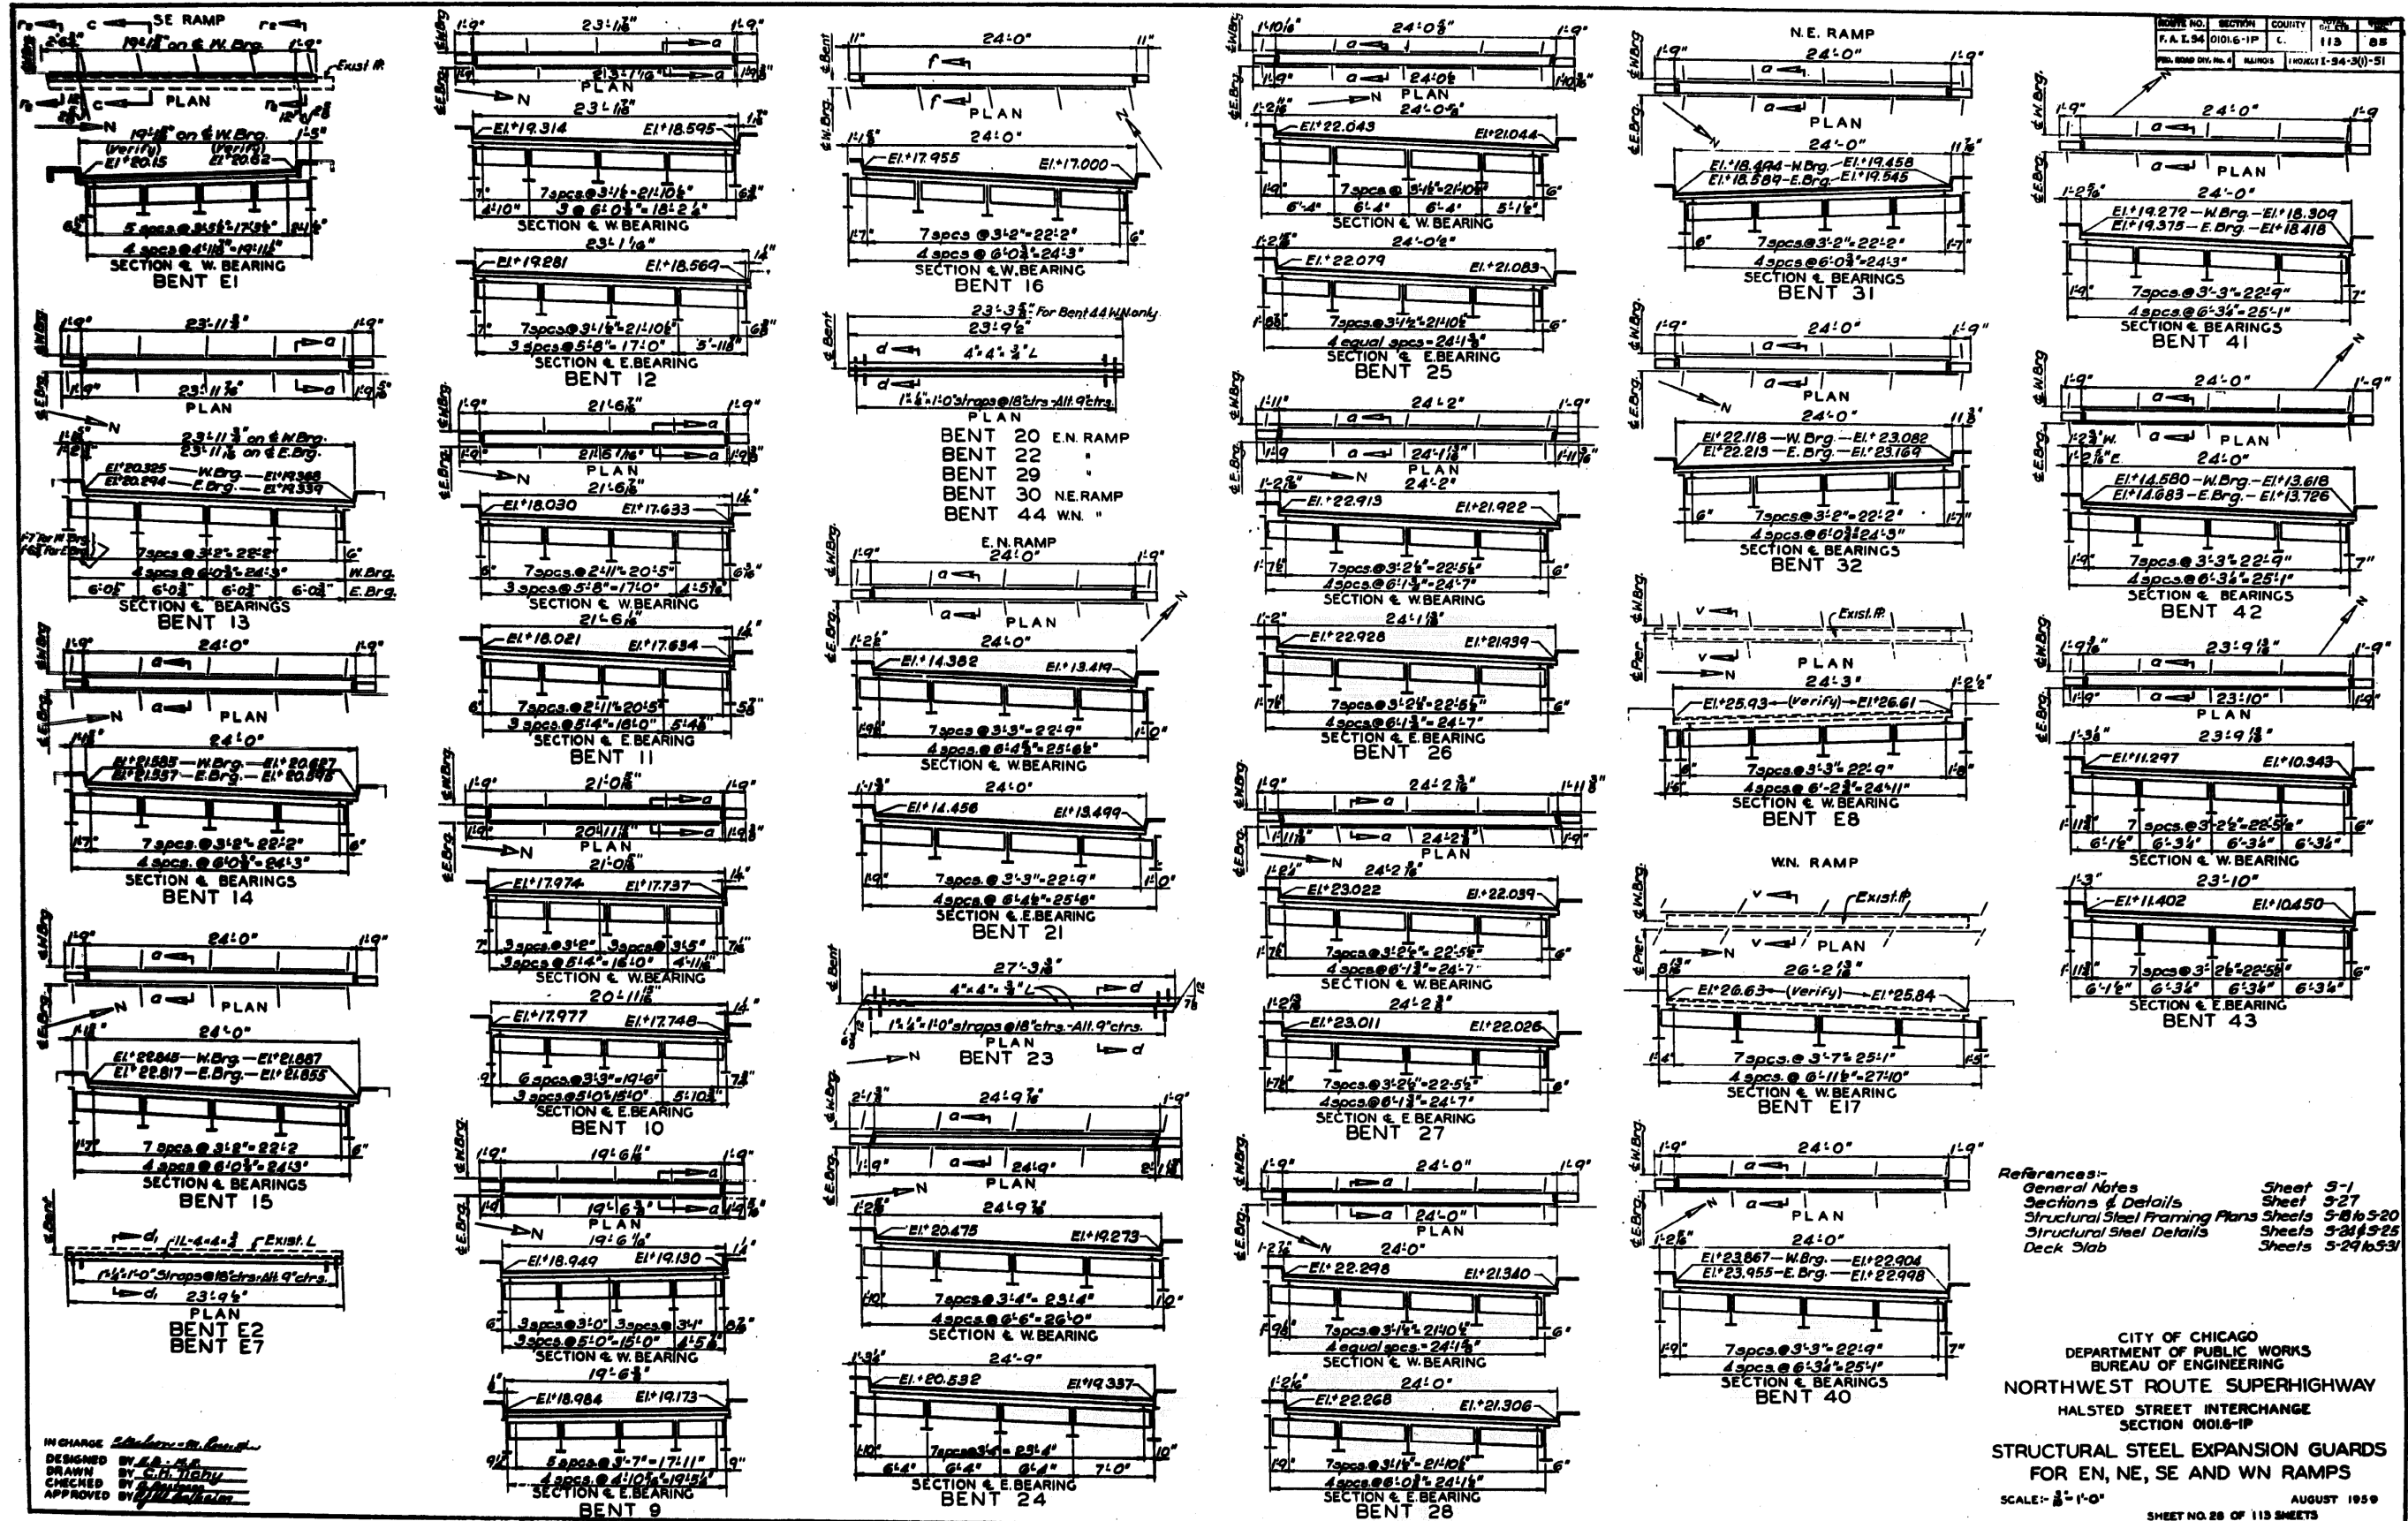

D160W28-sh-t-AS-BUILT-33.dgn
 USER NAME = ayeungh
 PLOT SCALE = 1:8000 / in.
 PLOT DATE = 4/25/2014

DESIGNED -
 DRAWN -
 CHECKED -
 DATE - 04/28/14

REVISED -
 REVISED -
 REVISED -
 REVISED -

STATE OF ILLINOIS
 DEPARTMENT OF TRANSPORTATION

EXISTING AS-BUILTS
 SN 016-2449 & SN 016-2451
 SCALE: NTS SHEET 33 OF 48 SHEETS STA. TO STA.

F.A.I. RTE.	SECTION	COUNTY	TOTAL SHEETS	SHEET NO.
90/94/290	2013-010R	COOK	747	503
CONTRACT NO. 60W28			ILLINOIS FED. AID PROJECT	