


FOR INFORMATION ONLY

.I.94 0101.6-1P 113 86  
 I-94-3(1)-51

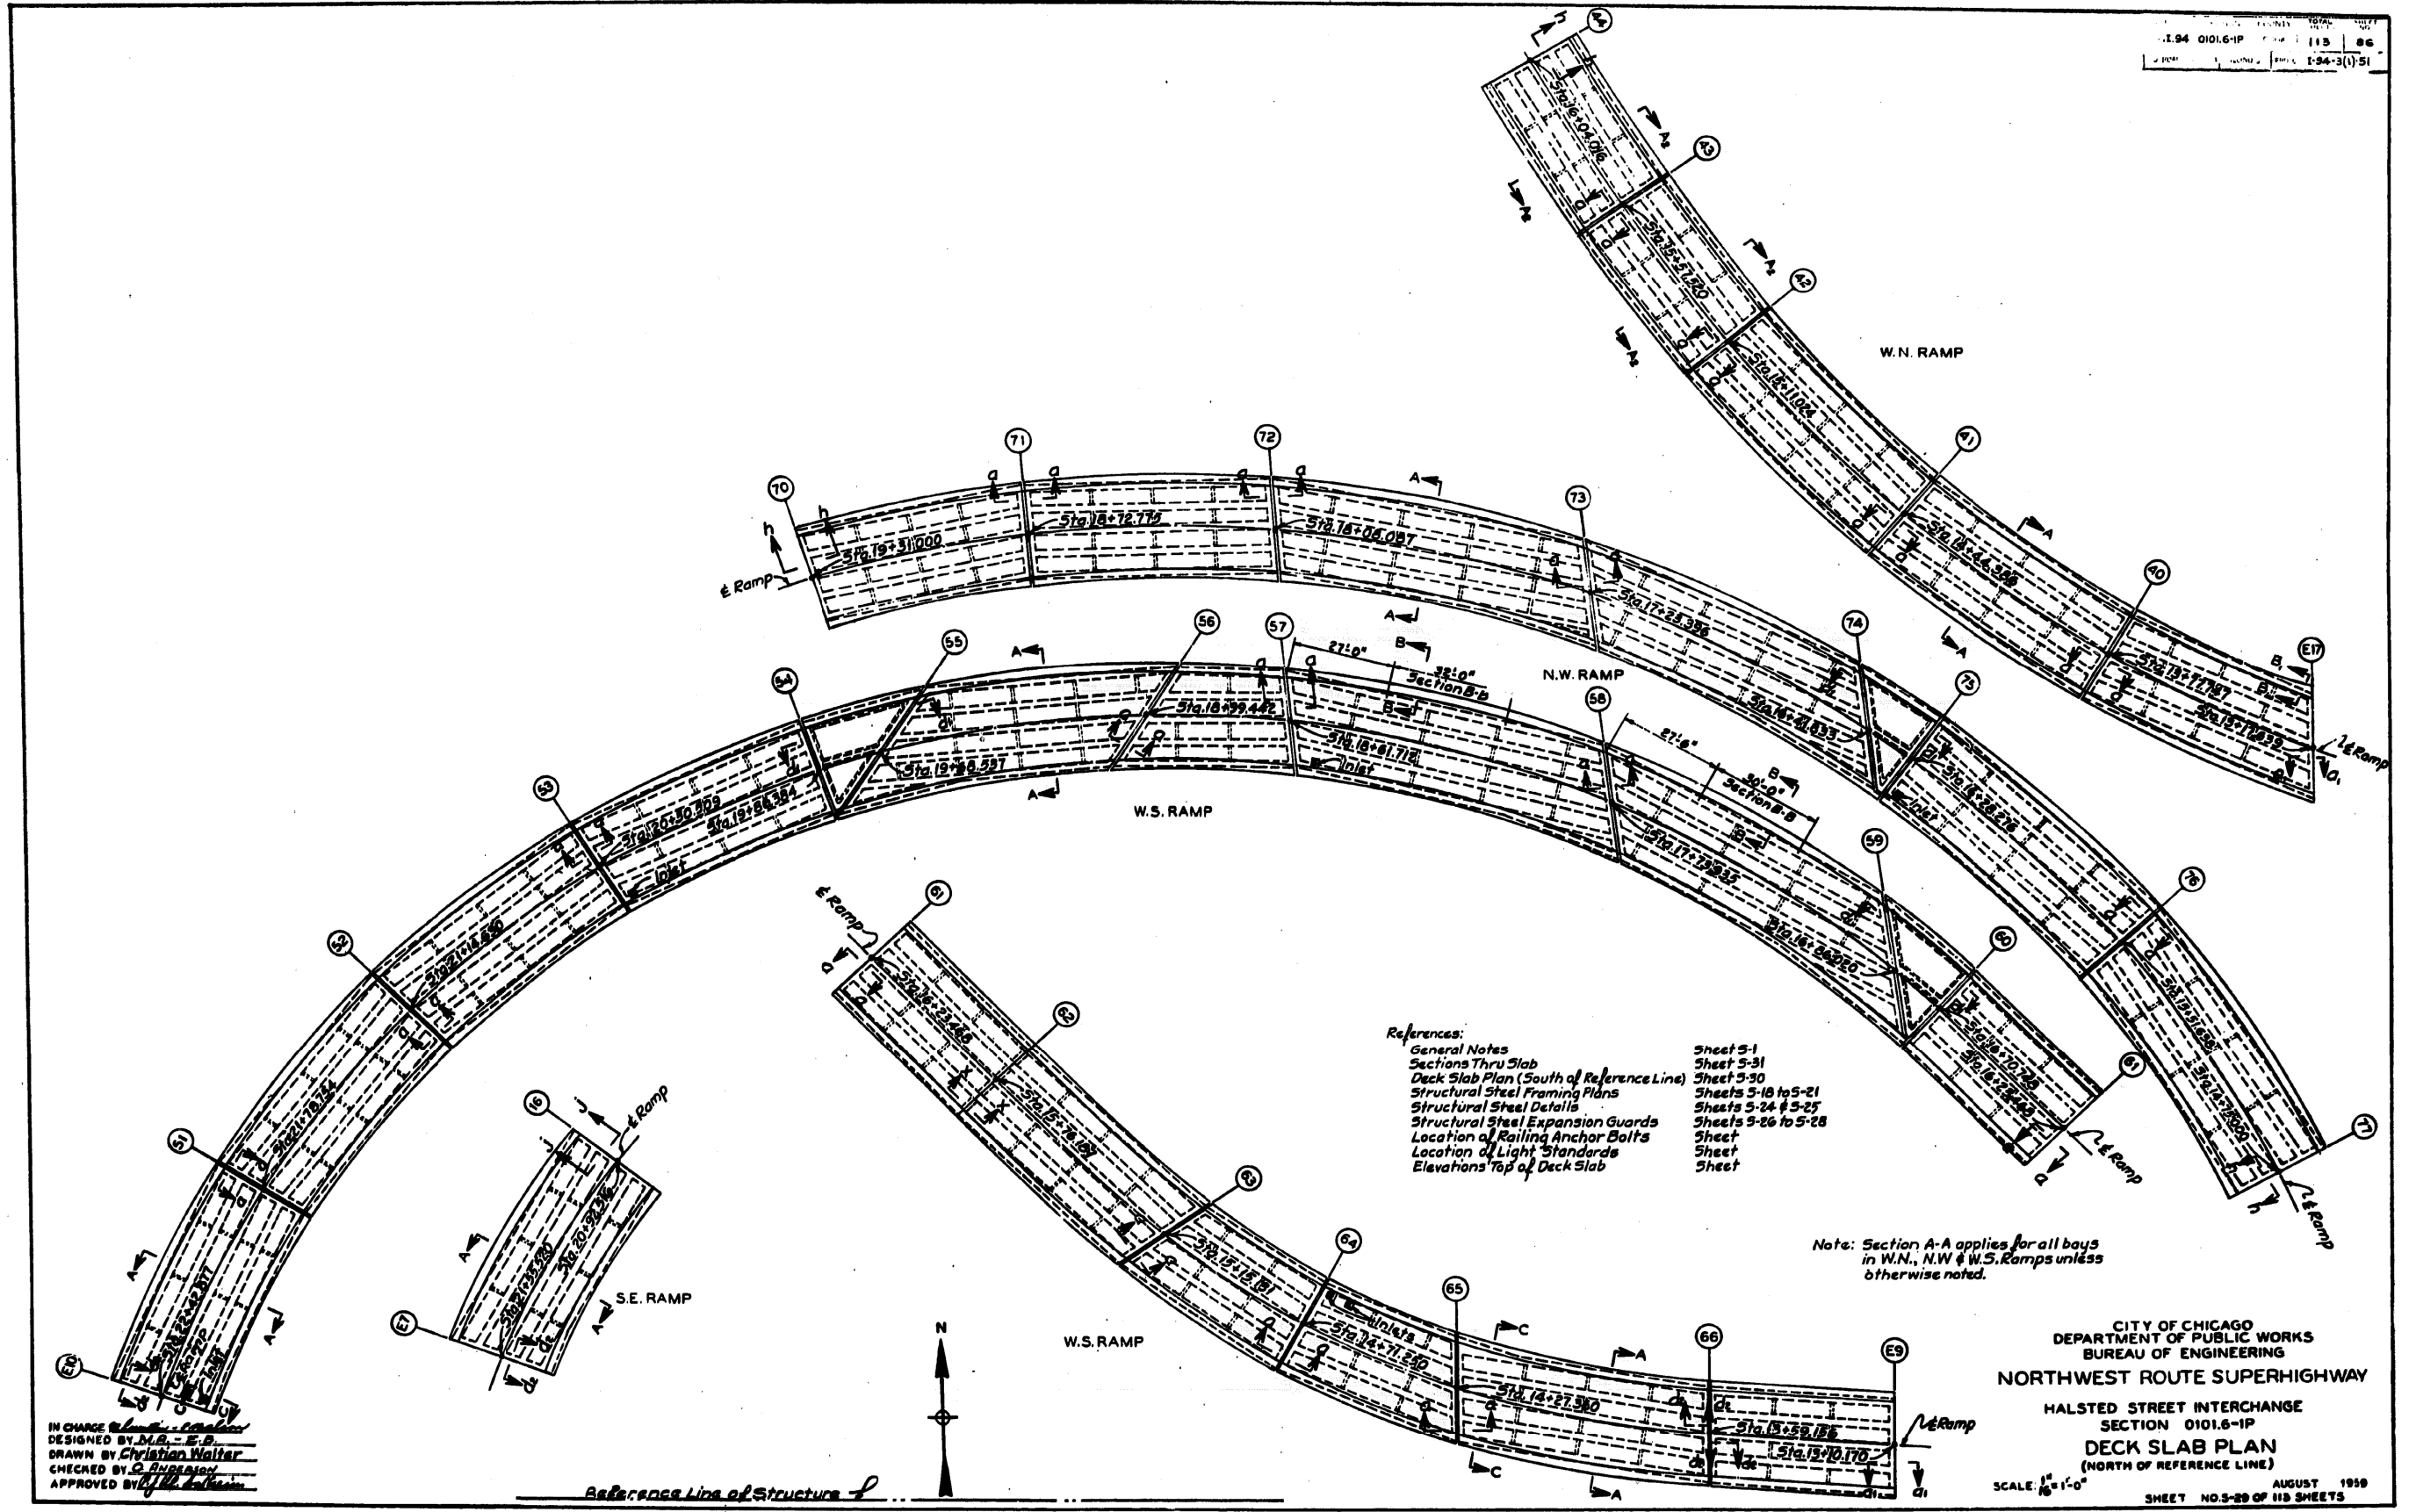

- References:
- General Notes
  - Sections Thru Slab
  - Deck Slab Plan (South of Reference Line)
  - Structural Steel Framing Plans
  - Structural Steel Details
  - Structural Steel Expansion Guards
  - Location of Railing Anchor Bolts
  - Location of Light Standards
  - Elevations Top of Deck Slab
- Sheet 5-1
  - Sheet 5-31
  - Sheet 5-50
  - Sheets 5-18 to 5-21
  - Sheets 5-24 & 5-25
  - Sheets 5-26 to 5-28
  - Sheet
  - Sheet
  - Sheet

Note: Section A-A applies for all bays in W.N., N.W. & W.S. Ramps unless otherwise noted.

IN CHARGE *[Signature]*  
 DESIGNED BY *[Signature]*  
 DRAWN BY Christian Walter  
 CHECKED BY *[Signature]*  
 APPROVED BY *[Signature]*

CITY OF CHICAGO  
 DEPARTMENT OF PUBLIC WORKS  
 BUREAU OF ENGINEERING  
 NORTHWEST ROUTE SUPERHIGHWAY  
 HALSTED STREET INTERCHANGE  
 SECTION 0101.6-1P  
 DECK SLAB PLAN  
 (NORTH OF REFERENCE LINE)  
 SCALE: 1/8" = 1'-0"  
 SHEET NO. 5-29 OF 113 SHEETS  
 AUGUST 1959

FILE PATH = C:\Projects\14-0425 - 60W28 Structure\14-0425 - 60W28-Struct\BUILT-AS-BUILT-34.dgn



D160W28-sht-AS-BUILT-34.dgn  
 USER NAME = auyeungh  
 PLOT SCALE = 1:8000 / in.  
 PLOT DATE = 4/25/2014

DESIGNED -  
 DRAWN -  
 CHECKED -  
 DATE - 04/28/14

REVISED -  
 REVISED -  
 REVISED -  
 REVISED -

STATE OF ILLINOIS  
 DEPARTMENT OF TRANSPORTATION

EXISTING AS-BUILTS  
 SN 016-2449 & SN 016-2451  
 SCALE: NTS SHEET 34 OF 48 SHEETS STA. TO STA.

F.A.I. RTE.	SECTION	COUNTY	TOTAL SHEETS	SHEET NO.
90/94/290	2013-010R	COOK	747	504
CONTRACT NO. 60W28				
ILLINOIS FED. AID PROJECT				