


FOR INFORMATION ONLY

I-94 0101.6-IP 113 07  
I-94 3(1)-51

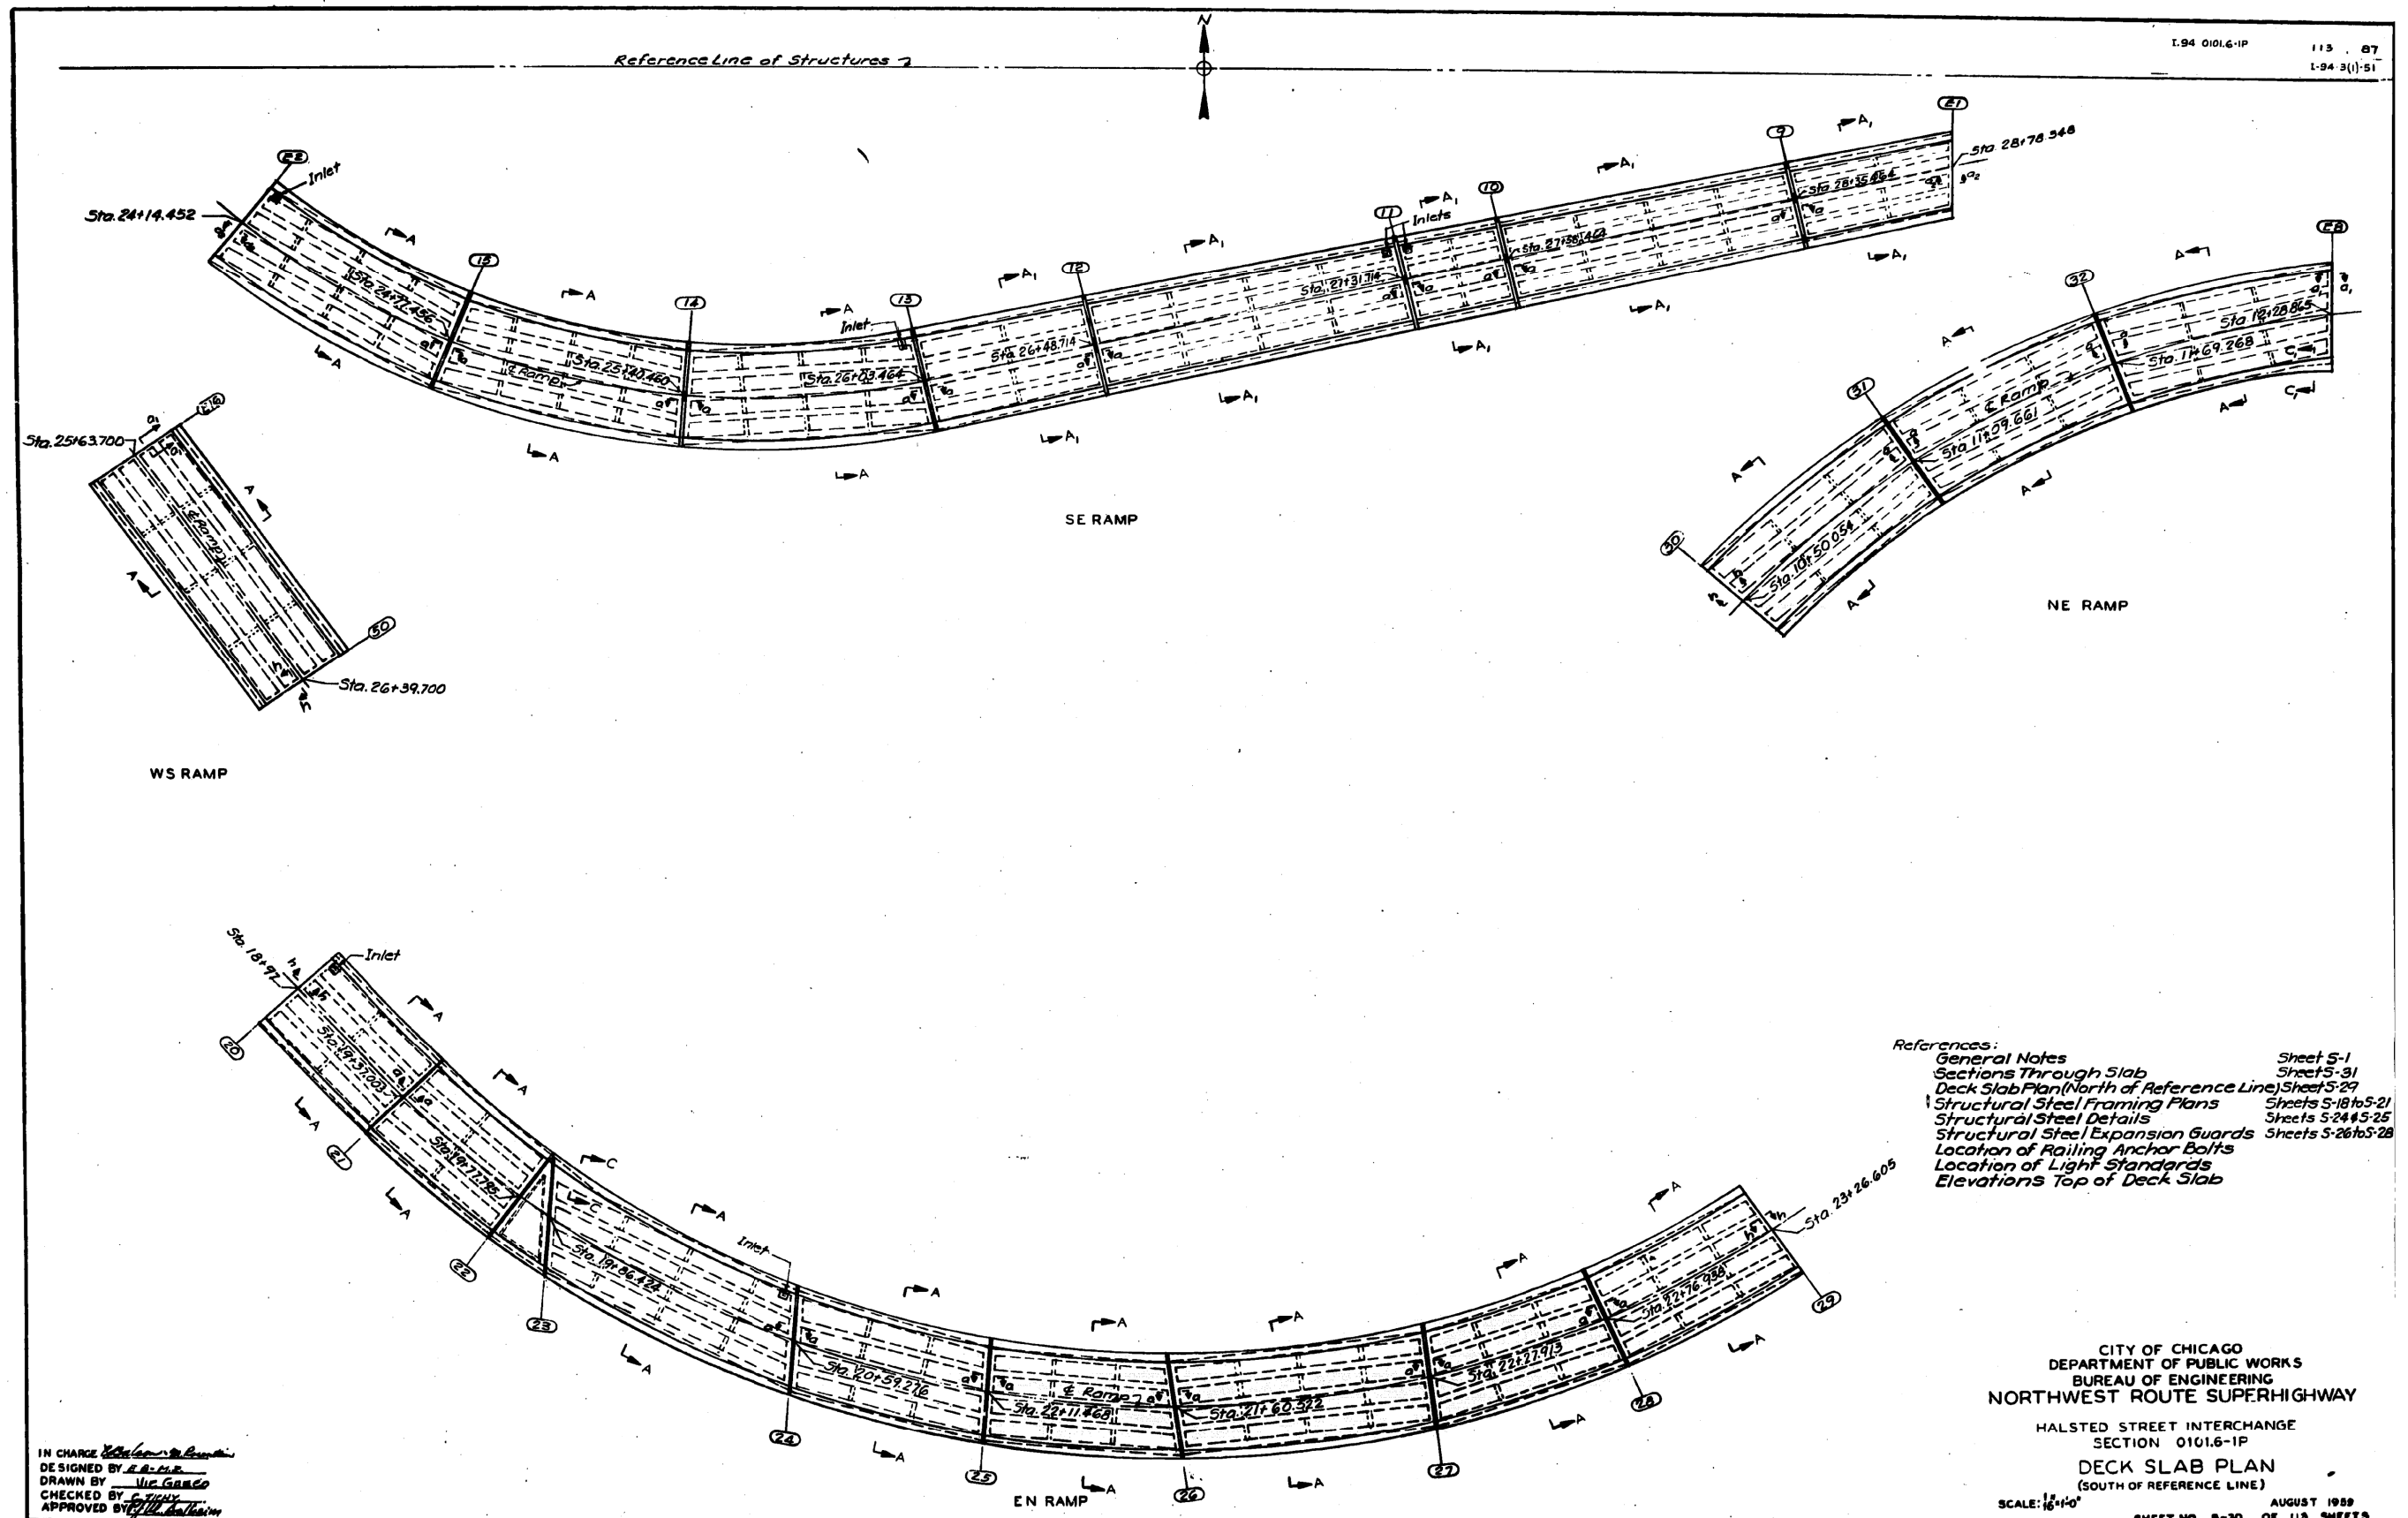

- References:
- General Notes
  - Sections Through Slab
  - Deck Slab Plan (North of Reference Line)
  - Structural Steel Framing Plans
  - Structural Steel Details
  - Structural Steel Expansion Guards
  - Location of Railing Anchor Bolts
  - Location of Light Standards
  - Elevations Top of Deck Slab
- Sheet S-1  
Sheet S-31  
Sheet S-27  
Sheets S-18 to S-21  
Sheets S-24 & S-25  
Sheets S-26 to S-28

IN CHARGE: *[Signature]*  
DESIGNED BY: E.A.M.S.  
DRAWN BY: J.M. GARRO  
CHECKED BY: C. TICHY  
APPROVED BY: *[Signature]*

CITY OF CHICAGO  
DEPARTMENT OF PUBLIC WORKS  
BUREAU OF ENGINEERING  
NORTHWEST ROUTE SUPERHIGHWAY  
HALSTED STREET INTERCHANGE  
SECTION 0101.6-IP  
DECK SLAB PLAN  
(SOUTH OF REFERENCE LINE)  
SCALE: 1/8"=1'-0"  
AUGUST 1989  
SHEET NO. S-30 OF 113 SHEETS

FILE PATH = C:\Projects\14-0425 - 60W28 StructBul\14-0425-60W28-Struct-AS-BUILT-35.dgn



D160W28-sht-AS-BUILT-35.dgn  
USER NAME = auyeungh  
PLOT SCALE = 1:8000 / 1 in.  
PLOT DATE = 4/25/2014

DESIGNED -	REVISED -
DRAWN -	REVISED -
CHECKED -	REVISED -
DATE - 04/28/14	REVISED -

STATE OF ILLINOIS  
DEPARTMENT OF TRANSPORTATION

EXISTING AS-BUILTS  
SN 016-2449 & SN 016-2451  
SCALE: NTS SHEET 35 OF 48 SHEETS STA. TO STA.

F.A.I. RTE.	SECTION	COUNTY	TOTAL SHEETS	SHEET NO.
90/94/290	2013-010R	COOK	747	505
CONTRACT NO. 60W28				
ILLINOIS FED. AID PROJECT				