


FOR INFORMATION ONLY

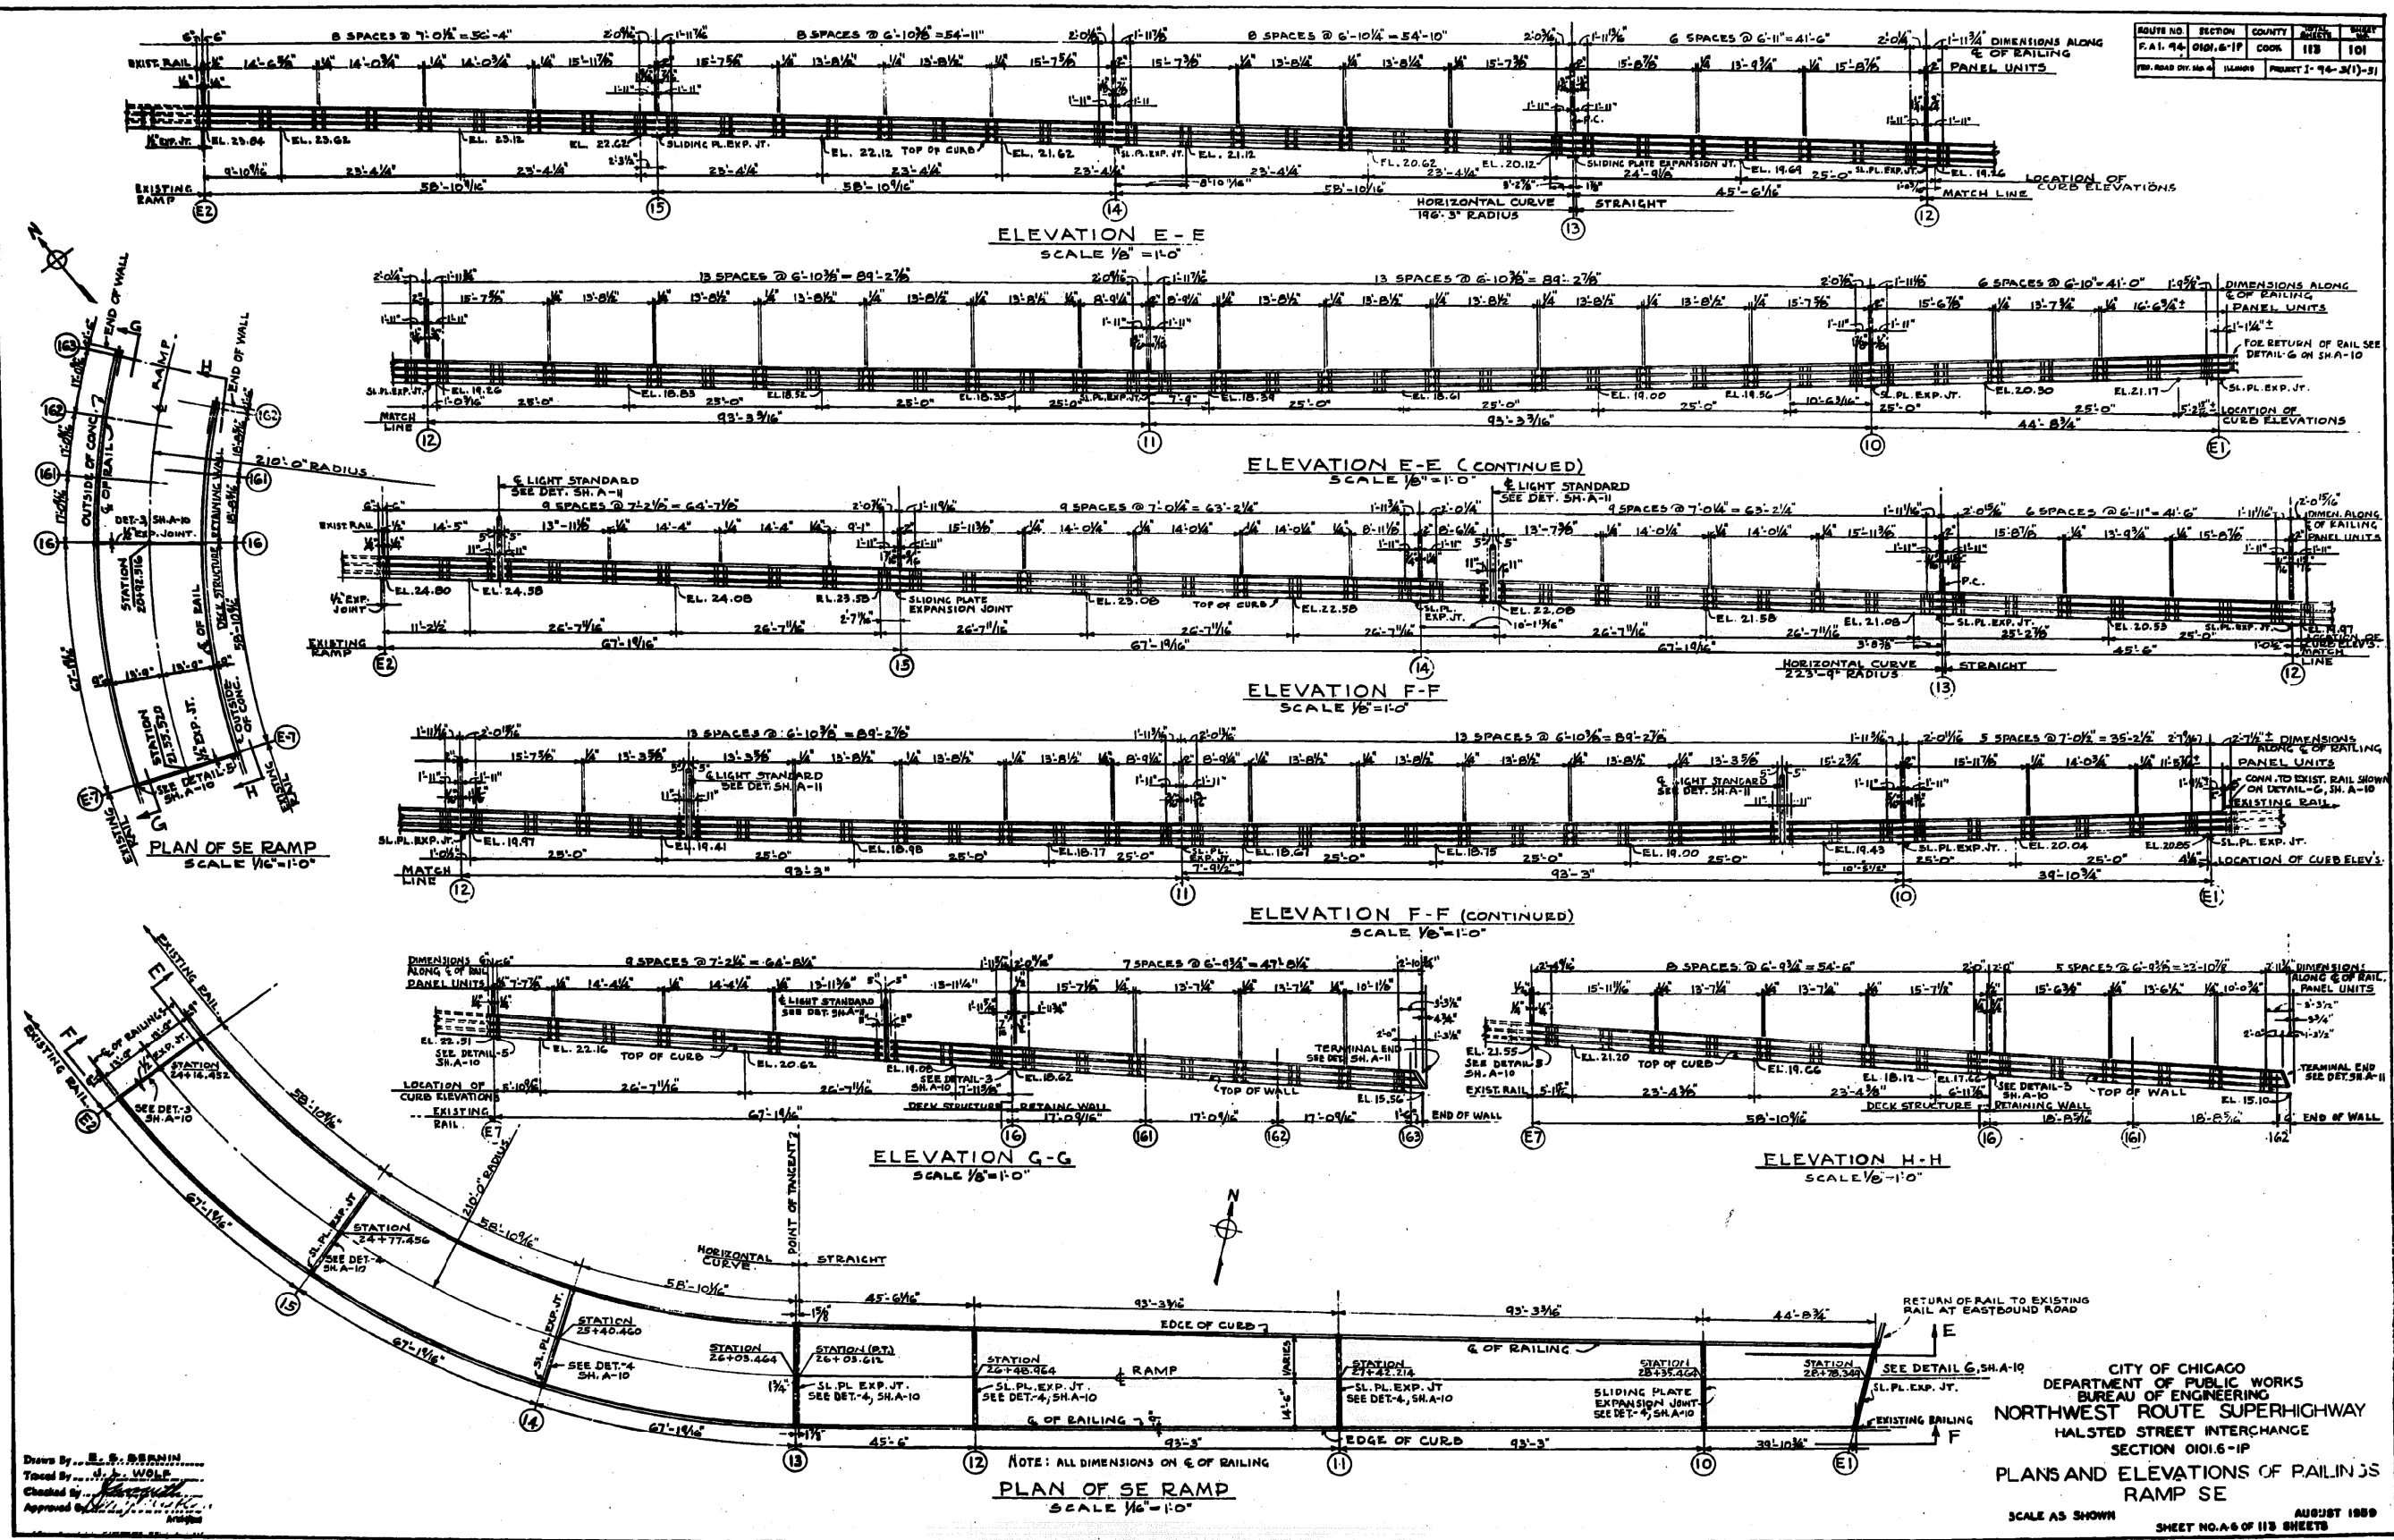

Drawn By: E.S. BERNIN
 Titled By: J. W. W. W.
 Checked By: [Signature]
 Approved By: [Signature]

NOTE: ALL DIMENSIONS ON ϵ OF RAILING
PLAN OF SE RAMP
 SCALE 1/8" = 1'-0"

CITY OF CHICAGO
 DEPARTMENT OF PUBLIC WORKS
 BUREAU OF ENGINEERING
NORTHWEST ROUTE SUPERHIGHWAY
 HALSTED STREET INTERCHANGE
 SECTION 0101.6-1P
PLANS AND ELEVATIONS OF RAILINGS
 RAMP SE
 SCALE AS SHOWN
 AUGUST 1989
 SHEET NO. 46 OF 118 SHEETS

FILE PATH = C:\Project\case14-0425 - 60W28 StructBulins\DI60W28-sht-AS-BUILT-42.dgn



DI60W28-sht-AS-BUILT-42.dgn
 USER NAME = auyeungh
 PLOT SCALE = 1:8000 / 1" = 80'
 PLOT DATE = 4/25/2014

DESIGNED -	REVISED -
DRAWN -	REVISED -
CHECKED -	REVISED -
DATE - 04/28/14	REVISED -

STATE OF ILLINOIS
 DEPARTMENT OF TRANSPORTATION

EXISTING AS-BUILTS
 SN 016-2449 & SN 016-2451

SCALE: NTS SHEET 42 OF 48 SHEETS STA. TO STA.

F.A.I. R.T.E.	SECTION	COUNTY	TOTAL SHEETS	SHEET NO.
90/94/290	2013-010R	COOK	747	512
CONTRACT NO. 60W28			ILLINOIS FED. AID PROJECT	