


FOR INFORMATION ONLY

ROUTE NO.	SECTION	COUNTY	SHEET	TOTAL SHEETS
F.A.I. 90-01016-1P	COOK	113	108	
FED. ROAD DIV. NO. 4	NUMBER	PROJECT	3-94-3(1)-81	



FILE PATH = C:\Projects\14-0425 - 60W28 StructBulbs\14-0425-60W28-StructBulbs\14-0425-60W28-StructBulbs\14-0425-60W28-StructBulbs.dgn

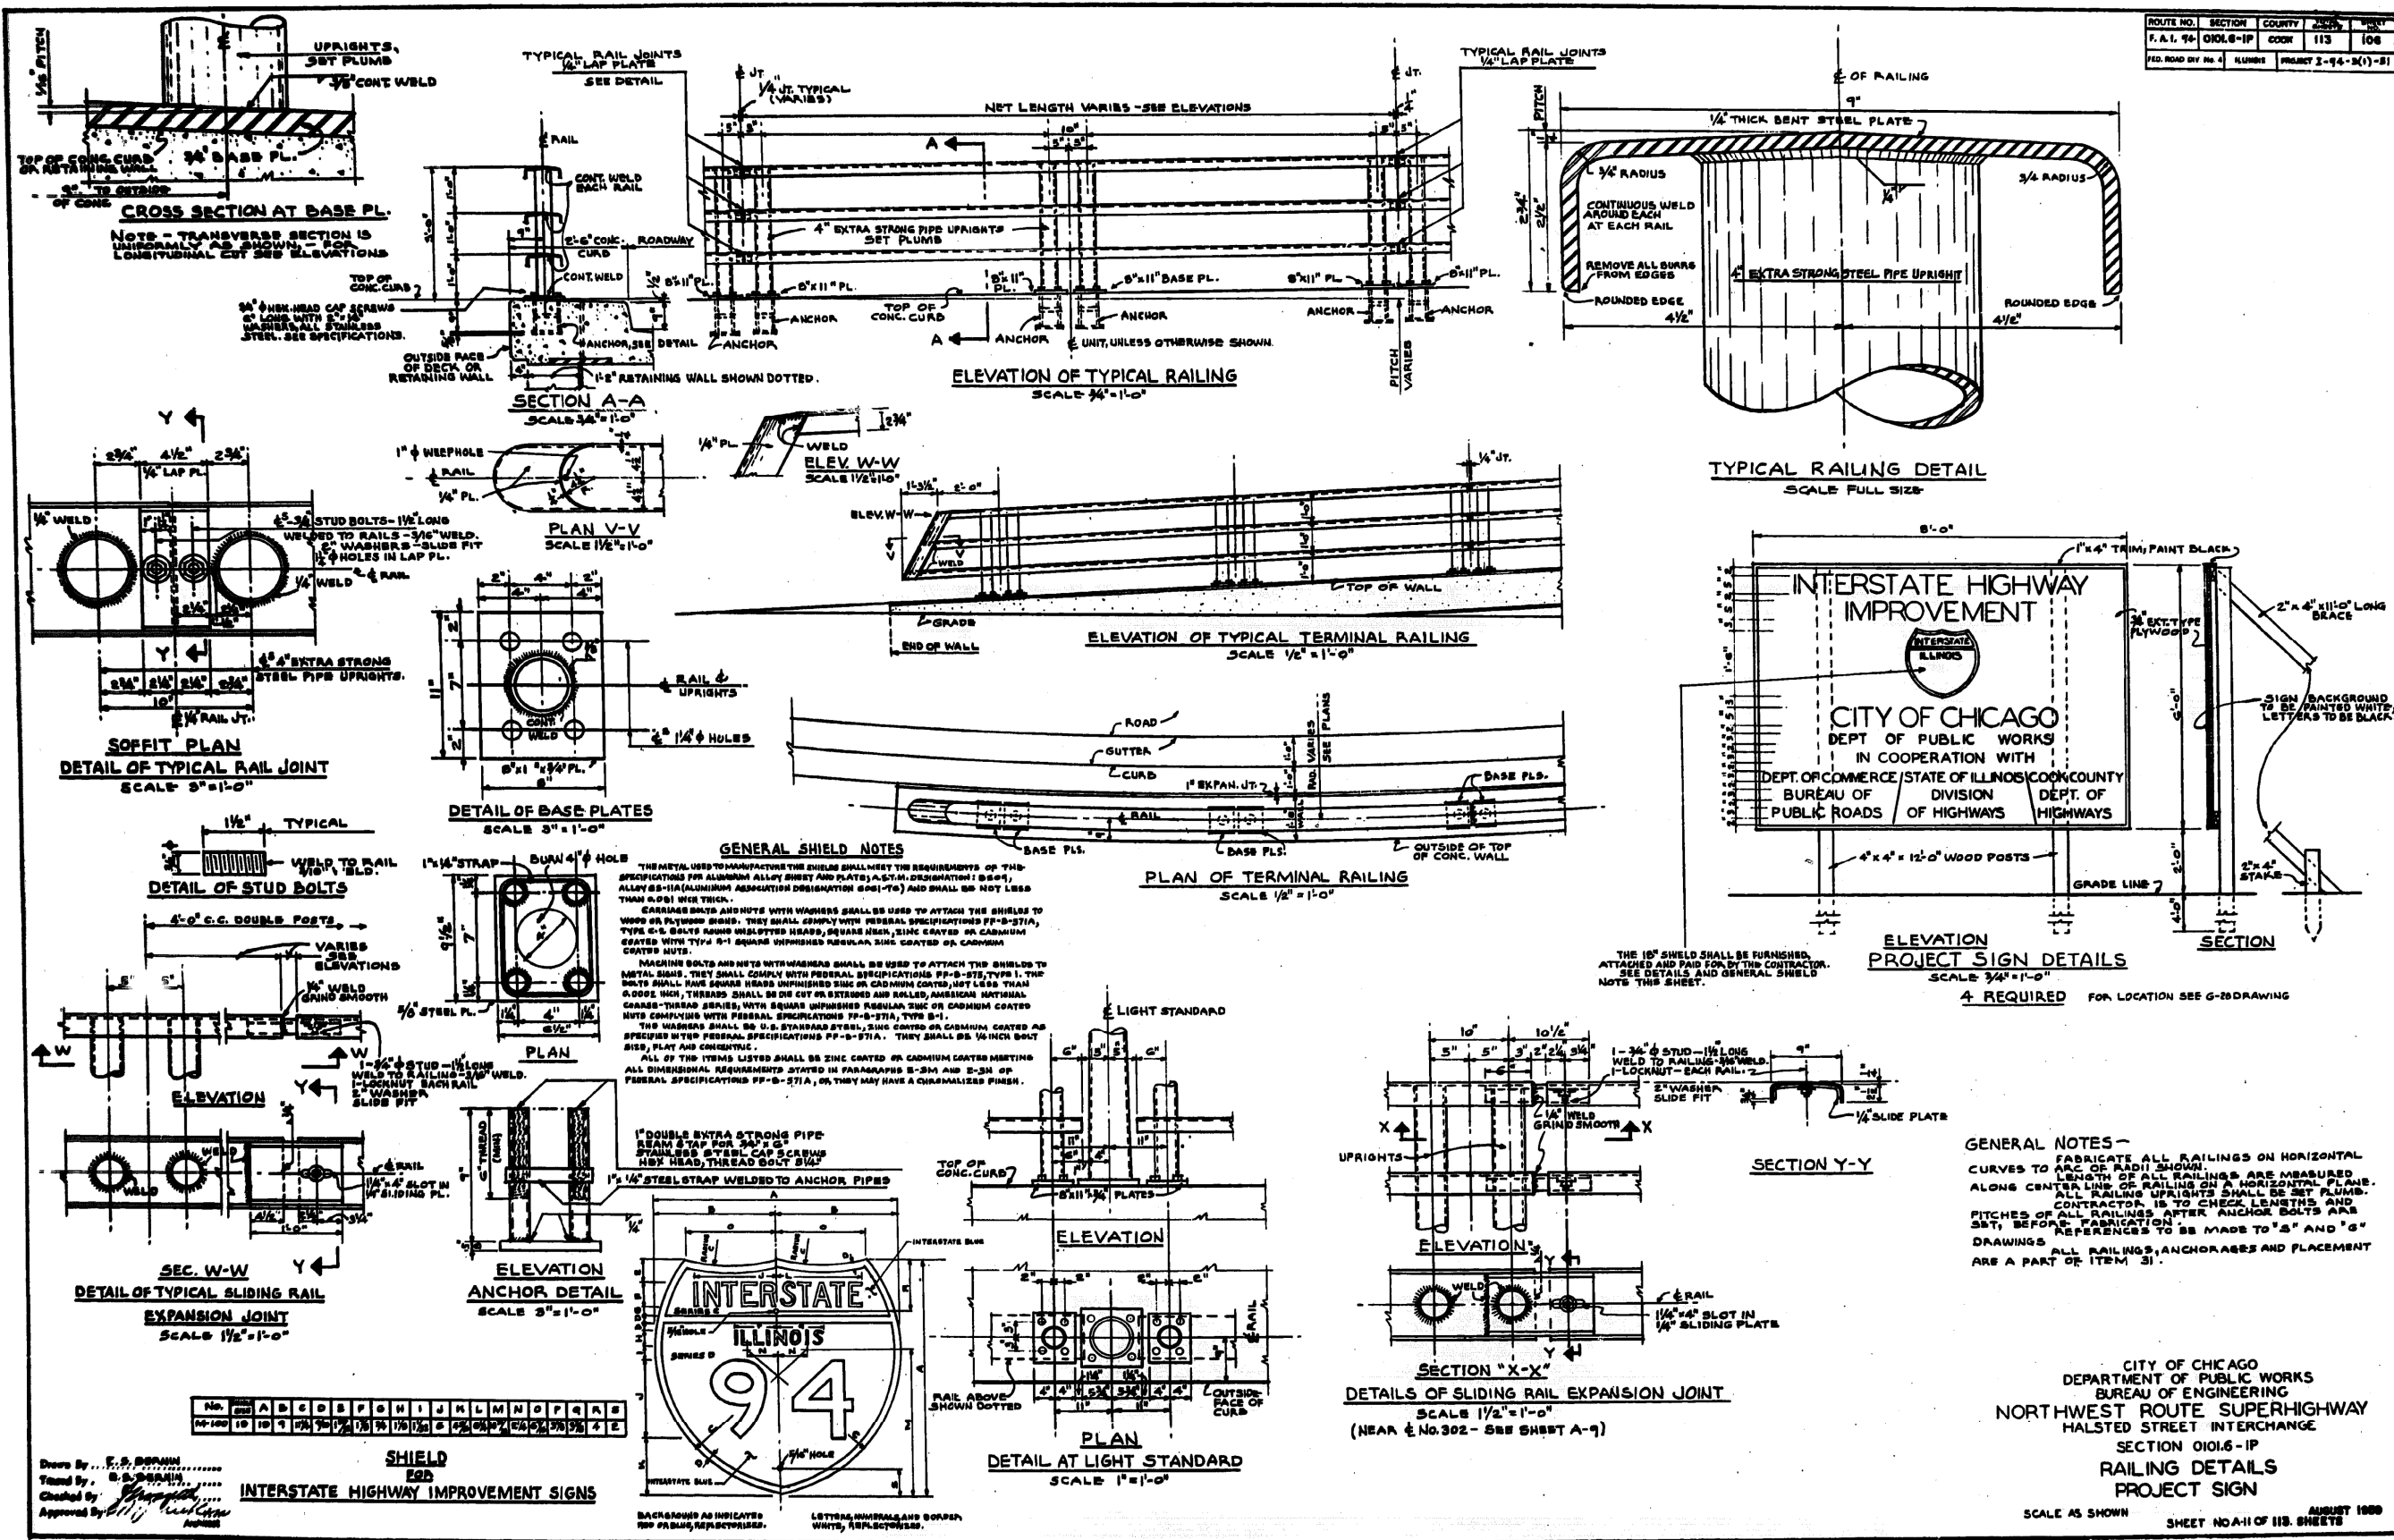

D:\60W28-sht-AS-BUILT-47.dgn
 USER NAME = ayeungh
 PLOT SCALE = 1:8000 / 1"
 PLOT DATE = 4/25/2014

DESIGNED	-	REVISED	-
DRAWN	-	REVISED	-
CHECKED	-	REVISED	-
DATE	04/28/14	REVISED	-

STATE OF ILLINOIS
DEPARTMENT OF TRANSPORTATION

EXISTING AS-BUILTS
SN 016-2449 & SN 016-2451
 SCALE: NTS SHEET 47 OF 48 SHEETS STA. TO STA.

F.A.I. RTE.	SECTION	COUNTY	TOTAL SHEETS	SHEET NO.
90/94/290	2013-010R	COOK	747	517
CONTRACT NO. 60W28				ILLINOIS FED. AID PROJECT

CITY OF CHICAGO
 DEPARTMENT OF PUBLIC WORKS
 BUREAU OF ENGINEERING
 NORTHWEST ROUTE SUPERHIGHWAY
 HALSTED STREET INTERCHANGE
 SECTION 01016-1P
RAILING DETAILS
PROJECT SIGN
 SCALE AS SHOWN SHEET NO.41 OF 118 SHEETS AUGUST 1999