

STATE OF ILLINOIS

DEPARTMENT OF PUBLIC WORKS AND BUILDINGS


DIVISION OF HIGHWAYS

PLANS FOR PROPOSED

FEDERAL AID HIGHWAY


SECTION	SHEET NO.	TOTAL SHEETS	SHEET NO.
74 37-24 HVB	HENRY	37	1

P-94-001-00

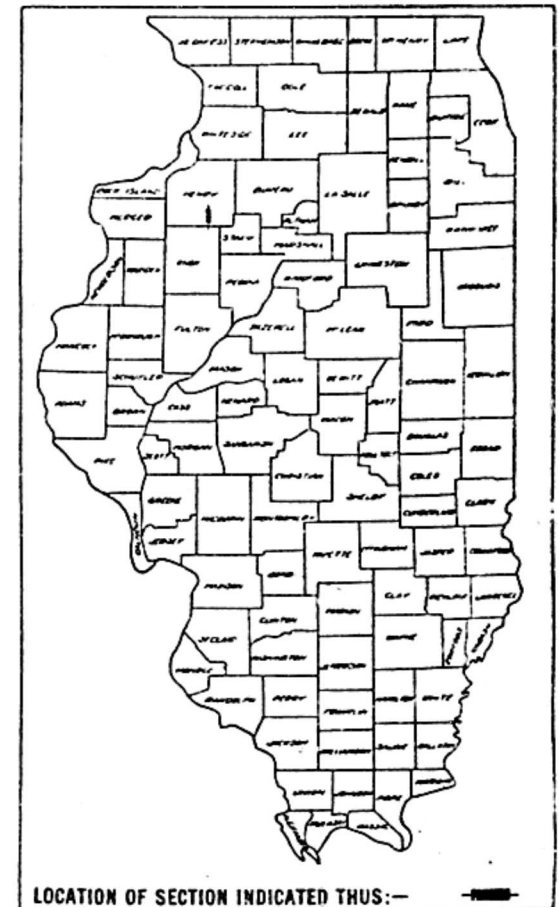

LOCATION OF SECTION INDICATED THUS:—

SEE SHEET NO. 2 FOR
INDEX OF PLAN SHEETS

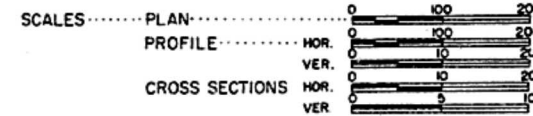


F.A.I. ROUTE 74 SECTION 37-24 HVB

PROJECT I-IG-74-2 (31) 31

HENRY COUNTY

C-94-020-64

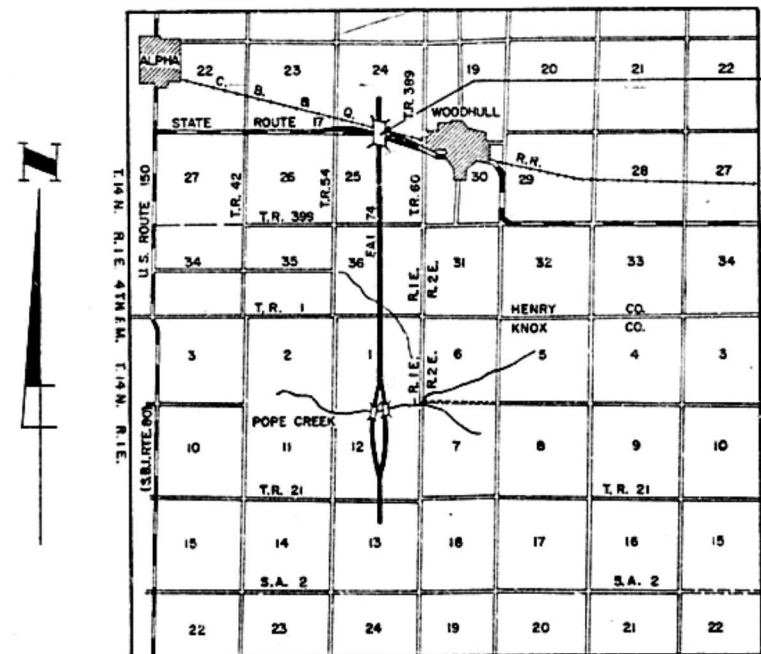

SECTION 37-24 HVB INCLUDES:
TWO (2) PARALLEL, 4 SPAN CONTINUOUS
STEEL W-BEAM RR. GRADE SEPARATION STRUCTURES
(CARRYING F.A.I. RTE. 74 AND RAMPS OVER
S.B.I. RTE. 65 (ILL. RTE. 17) AND C.B. & Q. R.R.)
ON 22 PIERS ON TIMBER PILES AND CONC.
PILE BENT ABUTMENTS (SPANS
51'-6", 67'-8", 67'-8", 54'-6") AT STA. 22+64.70
(F.A.I. 74) AND THE CONSTRUCTION OF EARTH
EMBANKMENT AND DETOUR ROAD.

APPROVED

FOR STRUCTURAL AGENCY ONLY

STATE OF ILLINOIS DEPARTMENT OF PUBLIC WORKS AND BUILDINGS DIVISION OF HIGHWAYS	
SUBMITTED	Nov. 18, 1964
DESIGNED	April 13, 1965
CHECKED	April 13, 1965
APPROVED	April 13, 1965
APPROVED	April 13, 1965

PLANS PREPARED BY
MISSMAN, STANLEY, FARMER & ASSOCIATES
CIVIL ENGINEERS
ROCK ISLAND, ILLINOIS

DEPARTMENT OF COMMERCE BUREAU OF PUBLIC ROADS	
APPROVED	
DIVISION	ENGINEER
DATE	

LAYOUT

1 1/2 0 1

APPROX SCALE IN MILES


NET LENGTH OF PROJECT
= 248.84 FT. = .047 MILES

CONTRACT NO. 24127

TYPICAL SECTION THROUGH S.B.I. ROUTE 83
(ILL. ROUTE 17) RELOCATED
STATION 41+37.79 TO STATION 73+12.21

ROUTE NO.	SHEET NO.	COUNTY	TOTAL SHEETS	SHEET NO.
74	37-24	HENRY	37	2

* GRADE REFERENCE POINT IS AS SHOWN FROM STA. 46+00 TO 65+50 ONLY AND IS ALONG SURVEY LINE THROUGHOUT REMAINDER OF S.B.I. RTE. 83 IMPROVEMENT.

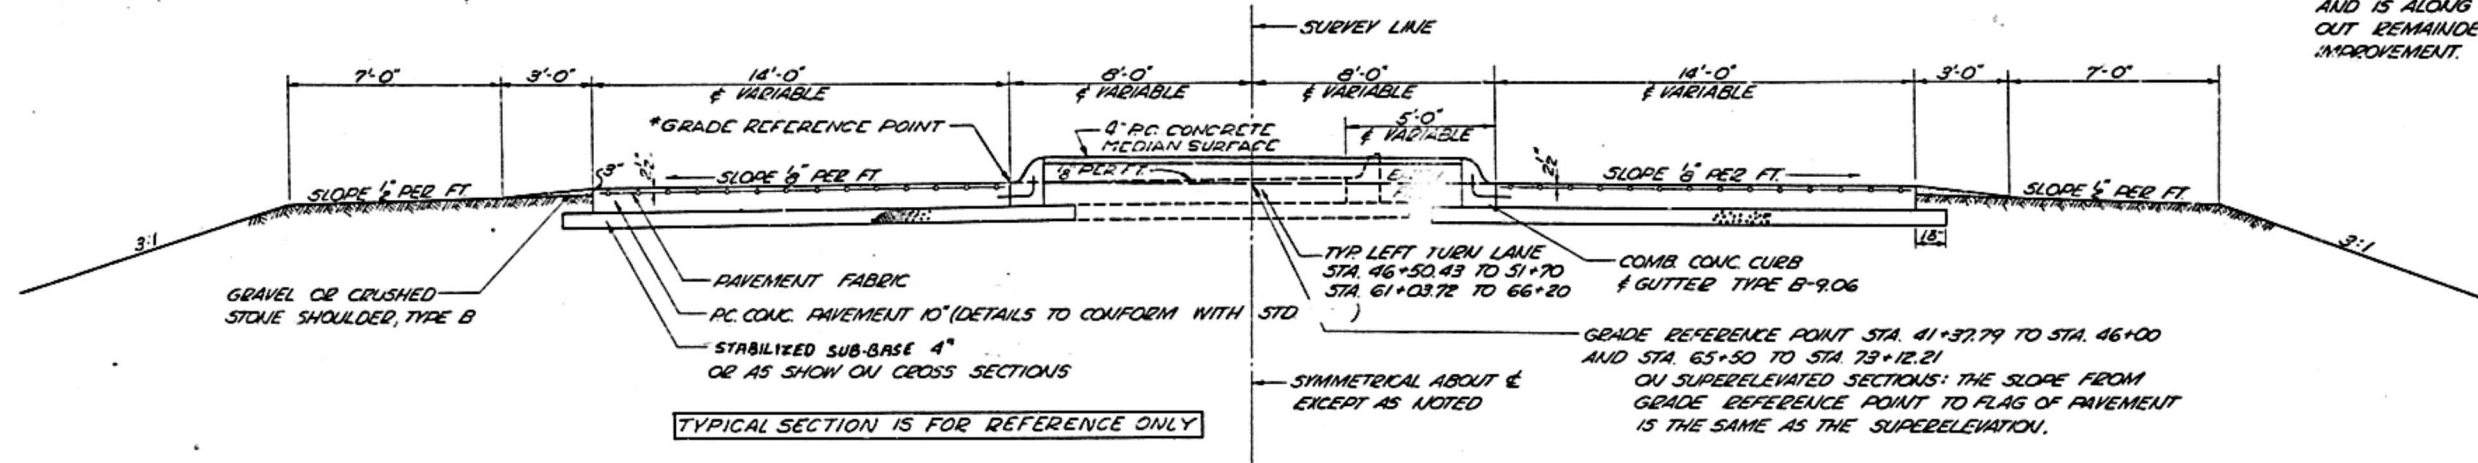

SUMMARY OF QUANTITIES CONSTRUCTION TYPE CODE X531

QUANTITY	UNIT	ITEMS	CODE NO.	47%	53%	STATE
1	UNIT	HEDGE REMOVAL	010006	0.5	0.5	
870	CU YD	EARTH EXCAVATION	011001	409	461	
87746	CU YD	BORROW EXCAVATION	013001	41241	46505	
757	TON	GRAVEL OR CRUSHED STONE BASE COURSE TYPE A	029001	356	401	
666	GALS	BITUMINOUS MATERIALS (PRIME COAT)	044001	313	353	
173	TON	COVER COAT MIXTURE COMPLETE	044002	81	92	
552	CU YD	CLASS A EXCAVATION FOR STRUCTURES	050001	259	293	
13984	CU YD	CLASS X CONCRETE	052003	657.2	741.2	
2710	SQ YD	PROTECTIVE COAT	052021	1274	1436	
608260	POUND	FURNISHING & ERECTING STRUCTURAL STEEL	054001	285882	322378	
50	LIN FT.	PIPE CULVERT, TYPE I, CORRUGATED METAL CULVERT PIPE 15"	058394	24	26	
245	80	POUND REINFORCEMENT BARS	059001	117303	132277	
6980	LIN FT.	FURNISHING CREOSOTED PILES 20.1 TO 38 FEET	060005	3281	3699	
2	EACH	TEST PILE TIMBER	060007	1	1	
7620	LIN FT.	DRIVING TIMBER PILES	060008	3581	4039	
4415	LIN FT.	DRIVING CONCRETE PILES	060043	2075	2340	
4415	LIN FT.	FURNISHING CONCRETE PILES	060044	2075	2340	
2	EACH	TEST PILE CONCRETE	060047	1	1	
2	EACH	NAME PLATES	061001	1	1	
540	SQ YD	PAVEMENT REMOVAL	082001	254	286	
2127	SQ YD	SLOPE WALL 4 INCH	083002	1000	1127	
2	EACH	FURNISHING AND ERECTING RIGHT OF WAY MARKERS	104001	4	4	
1756	SQ YD	SODDING	112001	825	931	
984	LIN FT.	ALUMINUM HANDRAIL	200004	462	522	
2	EACH	PERMANENT BARRICADES	200176	1	1	
* 2745	LIN FT.	WOVEN WIRE FENCE	201022	1070	1205	470
1	L SUM	BRIDGE SEAT SEALANT	201023	1	0	
1	L SUM	RAILROAD PROTECTIVE SERVICES	201065	0	1	
1	EACH	ENGINEERS FIELD OFFICE TYPE A	201398	0.5	0.5	
8	EACH	DELINEATORS	220278	4	4	
640	LIN FT.	TRANSPORTING TIMBER PILES	X02890	300	340	

INDEX OF SHEETS

SHEET NO.	TITLE
1	TITLE SHEET
2	INDEX OF SHEETS, SUMMARY OF QUANTITIES
3	PLAN & PROFILE F.A.I. 74
4	PLAN & PROFILE S.B.I. 83
5	DETOUR ROAD
6	GENERAL PLAN & ELEVATION & GENERAL NOTES
7	BORINGS
8	DECK DETAILS
9	STRUCTURAL STEEL
10	STRUCTURAL STEEL DETAILS
11, 11A	HANDRAIL & PARAPET DETAILS
12	END POST DETAILS
13	NORTH ABUTMENT
14	SOUTH ABUTMENT
15	PIER 1
16	PIER 2
17	PIER 3
18	DECK DETAILS
19	STRUCTURAL STEEL
20	STRUCTURAL STEEL DETAILS
21, 21A	HANDRAIL & PARAPET DETAILS
22	END POST DETAILS
23	NORTH ABUTMENT
24	SOUTH ABUTMENT
25	PIER 4
26	PIER 5
27	PIER 6
28	PILE DETAILS
29-31	CROSS SECTIONS F.A.I. 74
32	CROSS SECTIONS S.B.I. 83 & DETOUR ROAD
33, A	STANDARD 2113-1 & 1686-2
34	STANDARD 2169-2
35, A, B	STANDARD 2114 & 2153-4 & 1744-1
36, A	STANDARD 1971-3 & 2208-2
37	STANDARD 2181-2
37A	CRITICAL PATH SCHEDULE

TYPICAL SECTION THRU PROPOSED IMPROVEMENT

F.A.I. 74

SURVEY LINE STA. 10+00 TO STA. 154+85.28 - TO CONFORM TO STANDARD 2181-2 EXCEPT THE DEPRESSED MEDIAN IS 64'

THE NOMINAL THICKNESS FOR SUB-BASE GRANULAR MATERIAL AND GRAVEL OR CRUSHED STONE SHOULDERS TYPE A; BASE AND SURFACE COURSES ARE SHOWN ON THE TYPICAL SECTION, STANDARDS, SCHEDULES OR SPECIAL DETAILS. THE CONSTRUCTED THICKNESSES OF THE ABOVE ITEMS SHALL NOT BE LESS THAN 90 PER CENT OF NOMINAL THICKNESS AT ANY LOCATION.

THE THICKNESS OF BITUMINOUS MIXTURE SHOWN ON THE PLANS IS THE NOMINAL THICKNESS. DEVIATIONS FROM THE NOMINAL THICKNESS WILL BE PERMITTED WHEN SUCH DEVIATIONS OCCUR DUE TO IRREGULARITIES IN THE EXISTING SURFACE OR BASE ON WHICH THE BITUMINOUS MIXTURE IS PLACED.

HIGHWAY CLASSIFICATION

F.A.I. RTE. 74

965 - T - 70 - 1985

MAXIMUM GRADE 3.0%
LENGTH OF MAX. GRADE 756'
MIN. STOPPING SIGHT DISTANCE 738'
MIN. HORIZONTAL RADIUS TANGENT

S.B.I. RTE. 83
397 - M - 70 - 1986

MAXIMUM GRADE +0.44%
LENGTH OF MAX. GRADE 1500'
MIN. STOPPING SIGHT DISTANCE 1000'
MIN. HORIZONTAL RADIUS 3819.72'



ONE (1) SIGN CONFORMING TO STD. 2153-4 SHALL BE ERECTED AT LOCATIONS SHOWN ON THE PLANS SHEET NO. 4

SUBMITTED 11-5-64
District Design Engineer
EXAMINED
District Construction Engineer
EXAMINED Nov. 2, 1964
District Maintenance Engineer
EXAMINED Nov. 5, 1964
District Traffic Engineer
ENTIRE SECTION INSPECTED AND APPROVED AS TO POLICY
DATE Nov. 18, 1964
District Engineer

T14N, R1E, OF THE 4TH PM.
SECTION 24

SEC. 37-24 HWB
STA. 21+04.45 - STA. 23+52.79
EAST STR. STA. 21+19.74 TO 23+63.08
WEST STR. STA. 20+94.16 TO 23+42.50

T14N, R1E, OF THE 4TH PM.
SECTION 25

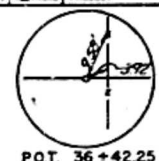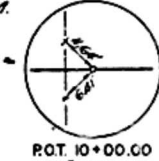

P.O.T. 10+00.00
3/4" PIPE

WILLIAM E. SHETLER


SURVEY LINE & PROPOSED
IMPROVEMENT F.I. 74

P.O.T. 21+27.32
1/2" STEEL ROD

P.O.T. 23+61.06
3/4" PIPE

P.O.T. 36+42.25
1/2" STEEL ROD

FILL EXIST. WELL
BY 5' x 2' x 3'

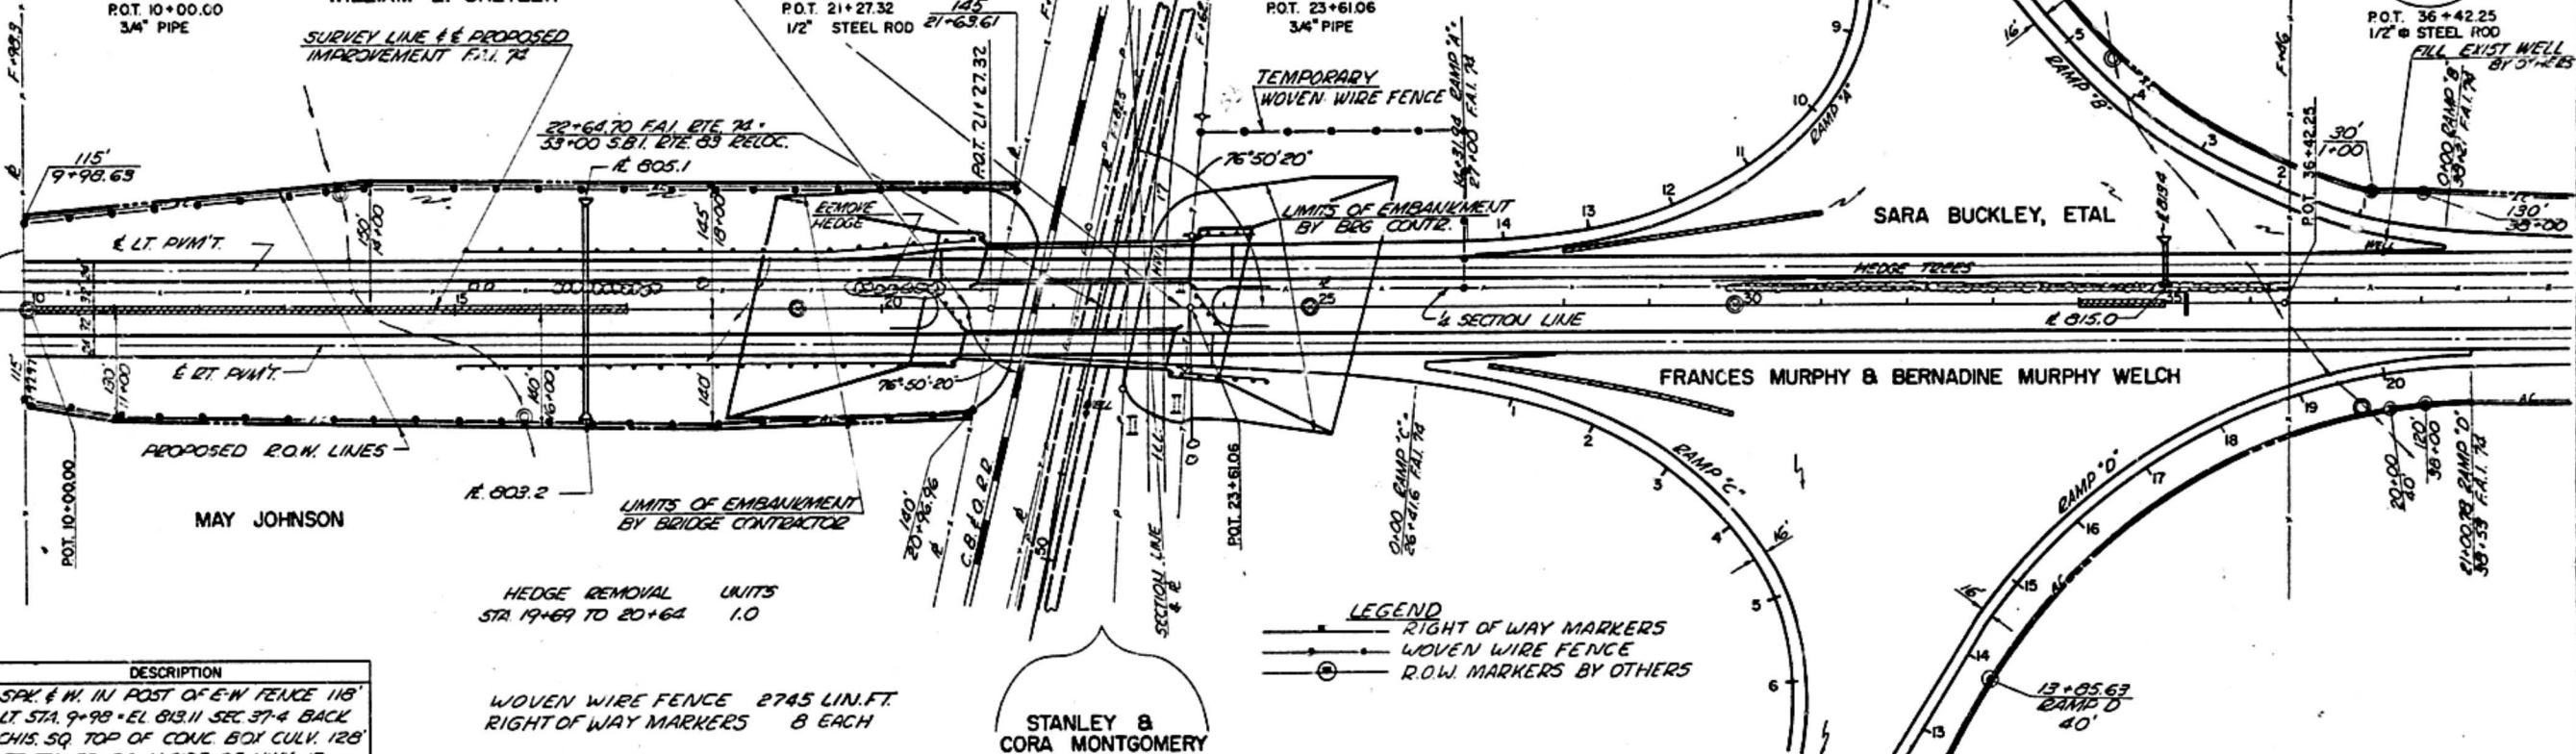


B.M.	ELEV.	DESCRIPTION
B.M. #1	813.194	SPK. & W. IN POST OF E-W FENCE 118'
B.M. #2	809.852	LT. STA. 9+98 = EL. 813.11 SEC. 37-4 BACK CHIS. SQ. TOP OF CONC. BOX CULV. 128' RT. STA. 22+94 N. SIDE OF HWY. 17




HEDGE REMOVAL UNITS
STA. 19+69 TO 20+64 1.0

WOVEN WIRE FENCE 2745 LIN. FT.
RIGHT OF WAY MARKERS 8 EACH



STANLEY &
CORA MONTGOMERY

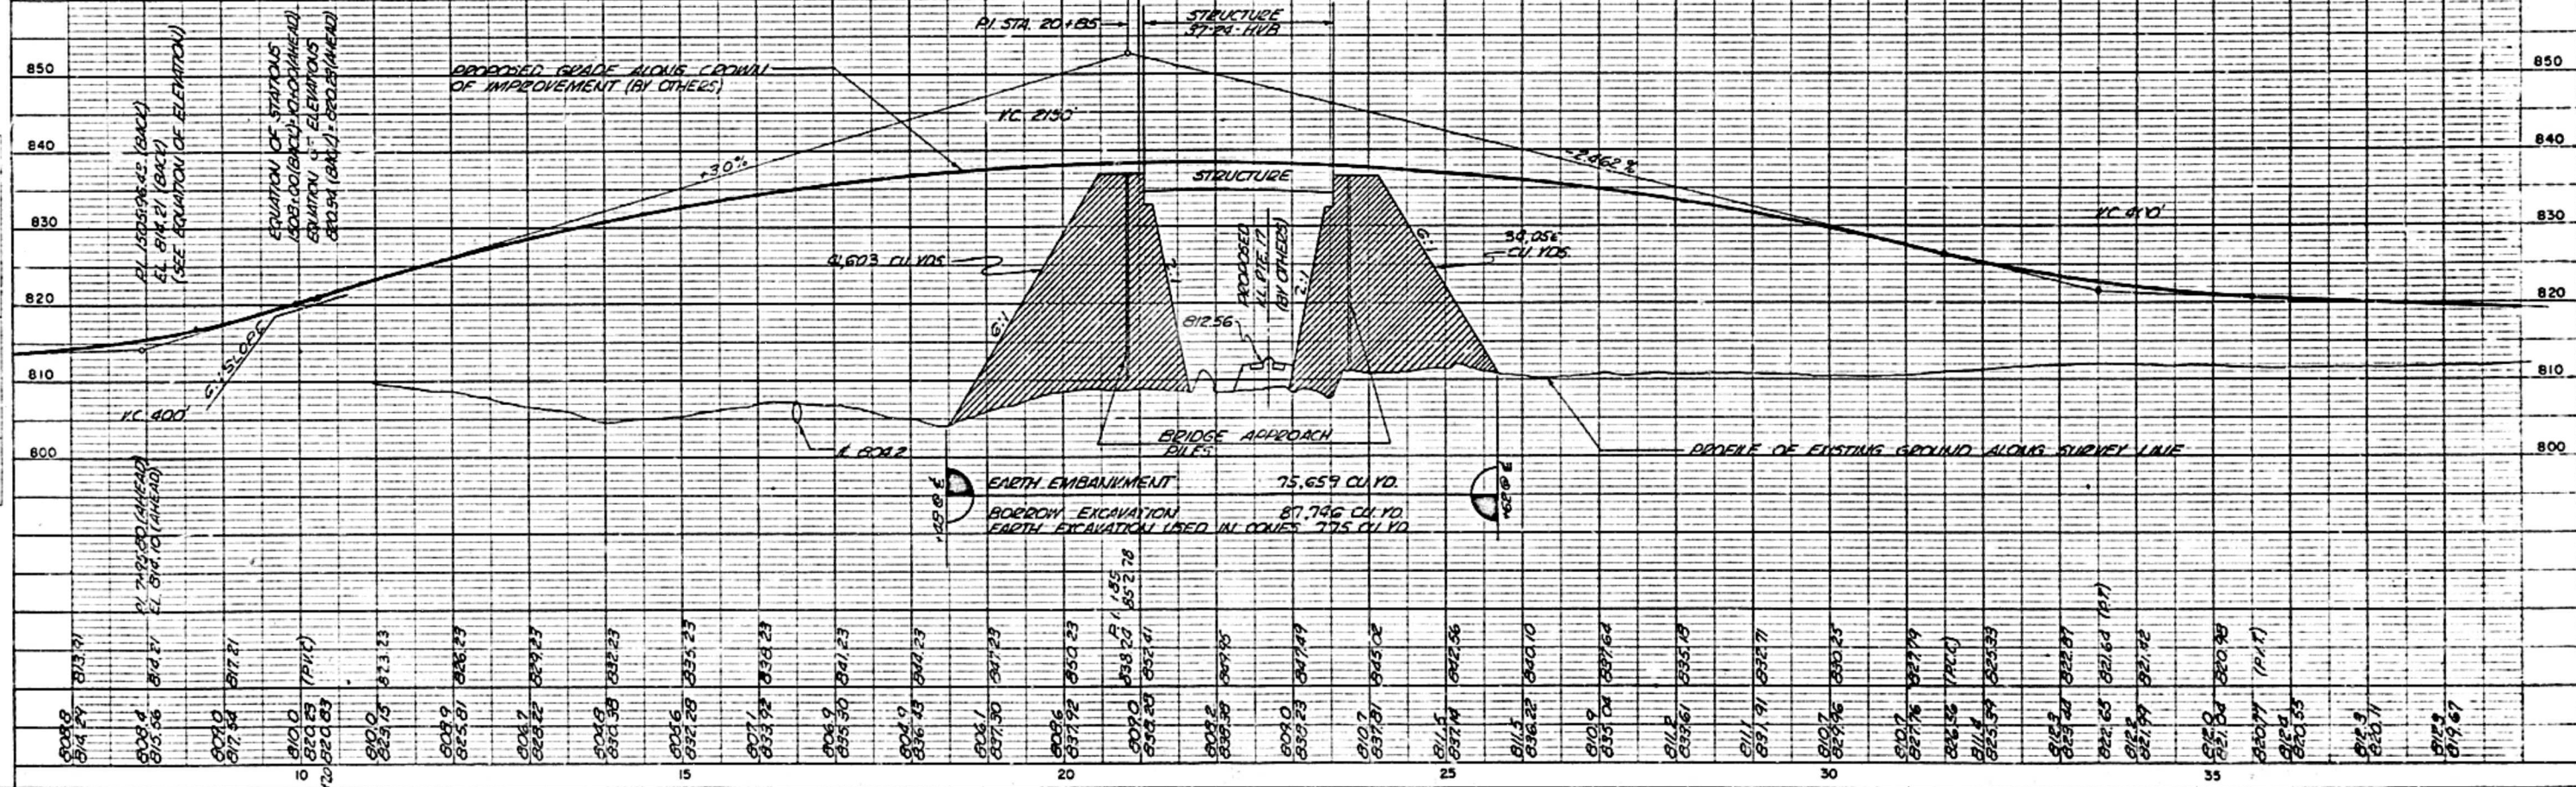

T. 14 N. R. 1 E. OF THE 4TH P.M.
SECTION 2A

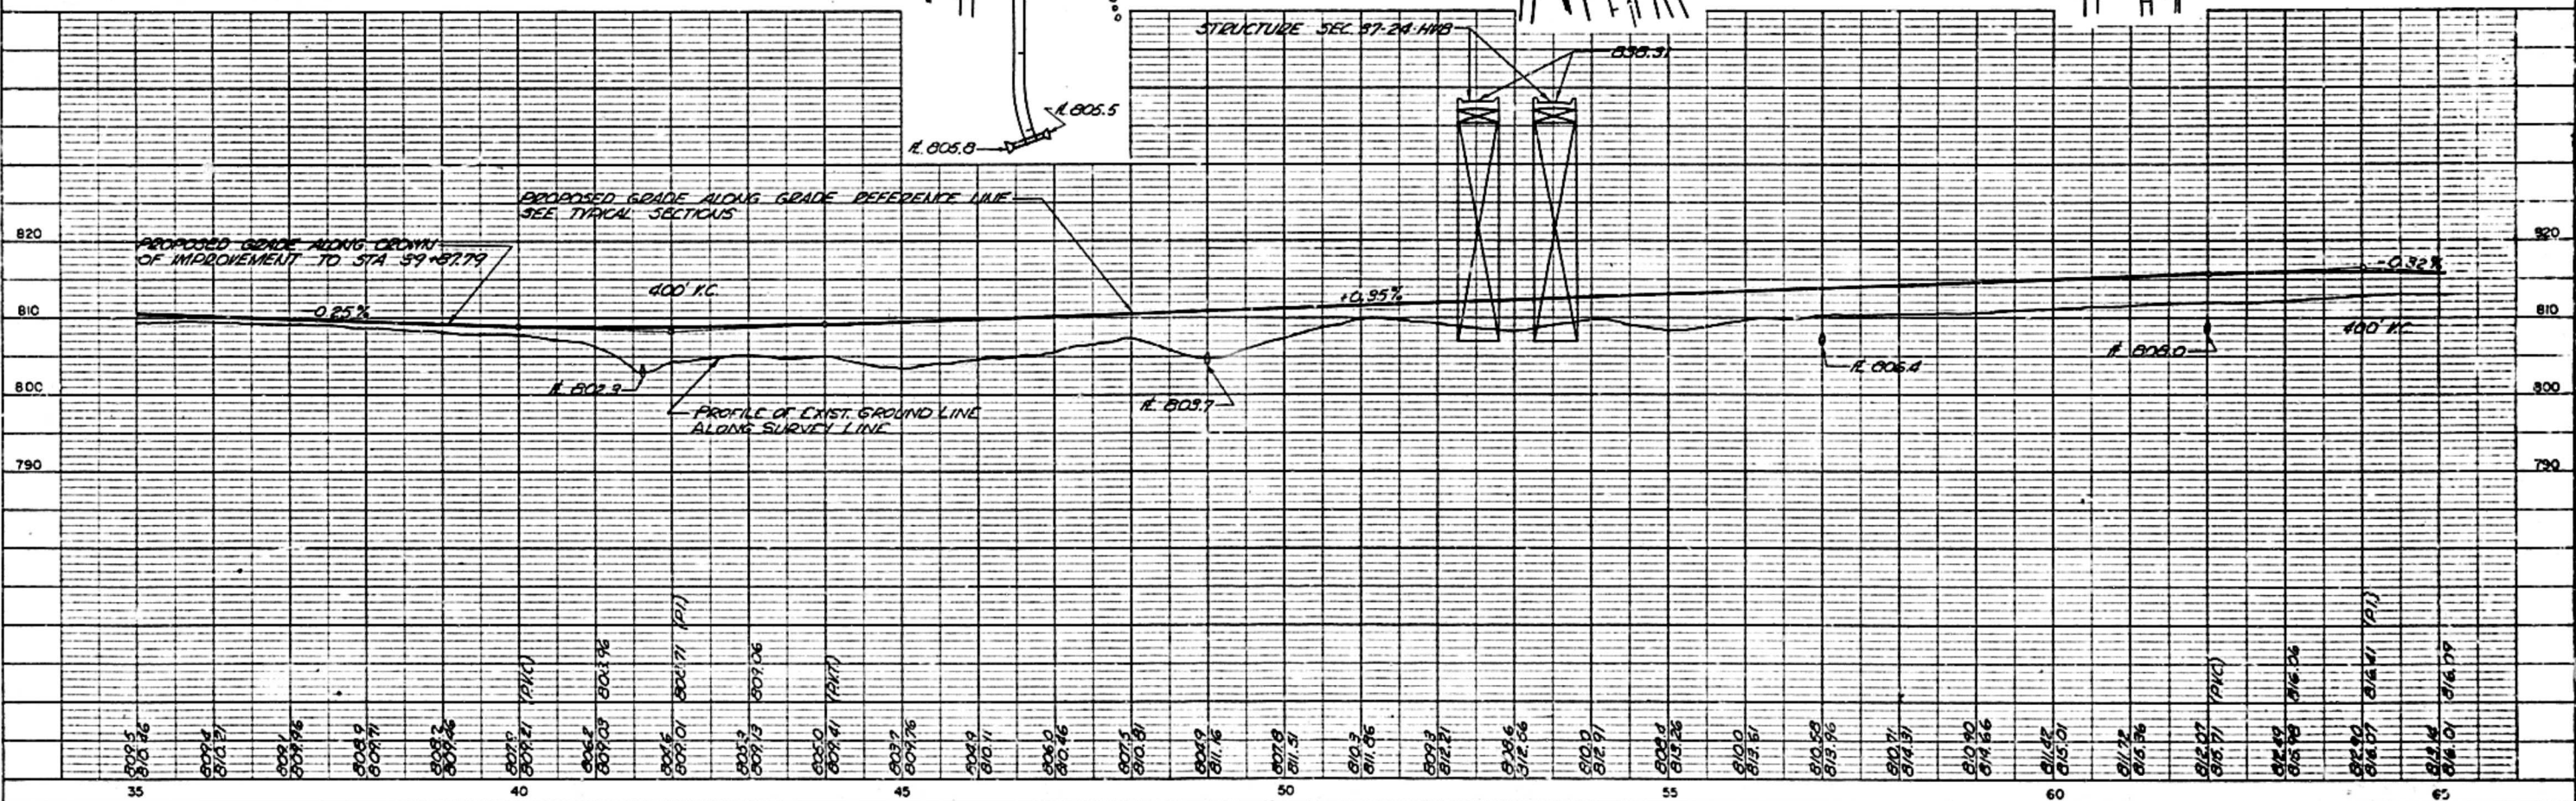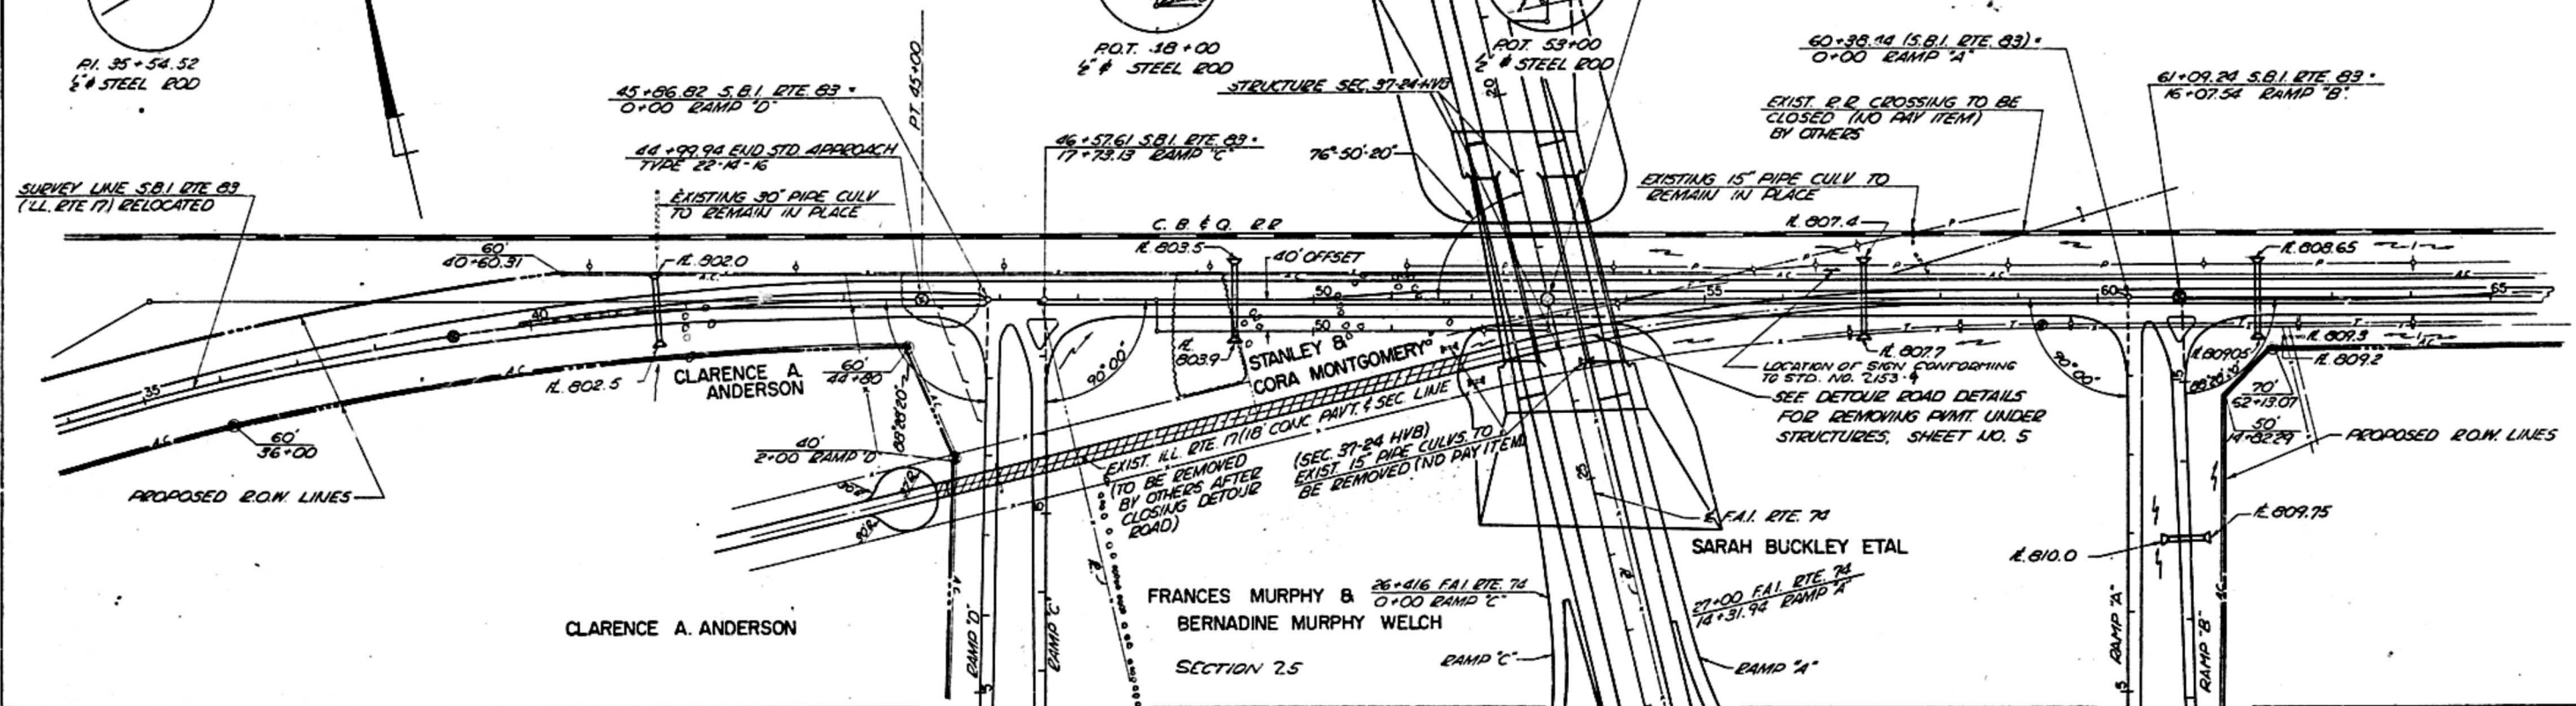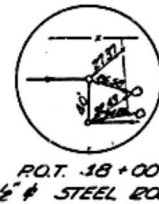

ROUTE NO.	SECTION	SURVEY	DATE	BY
74	37-24	HENRY	3.7	5
STA.	TO	BY	DATE	BY
22+64.70	33+00	37-24	3.7	5

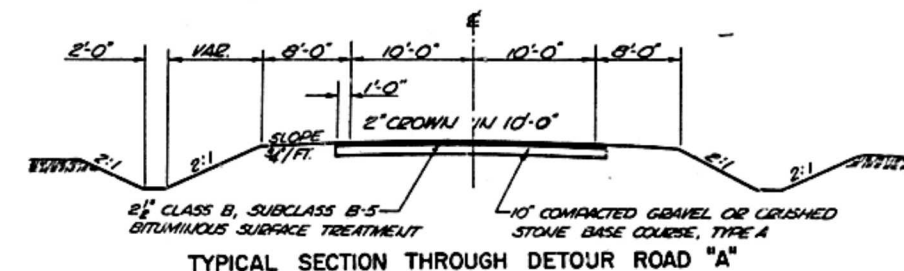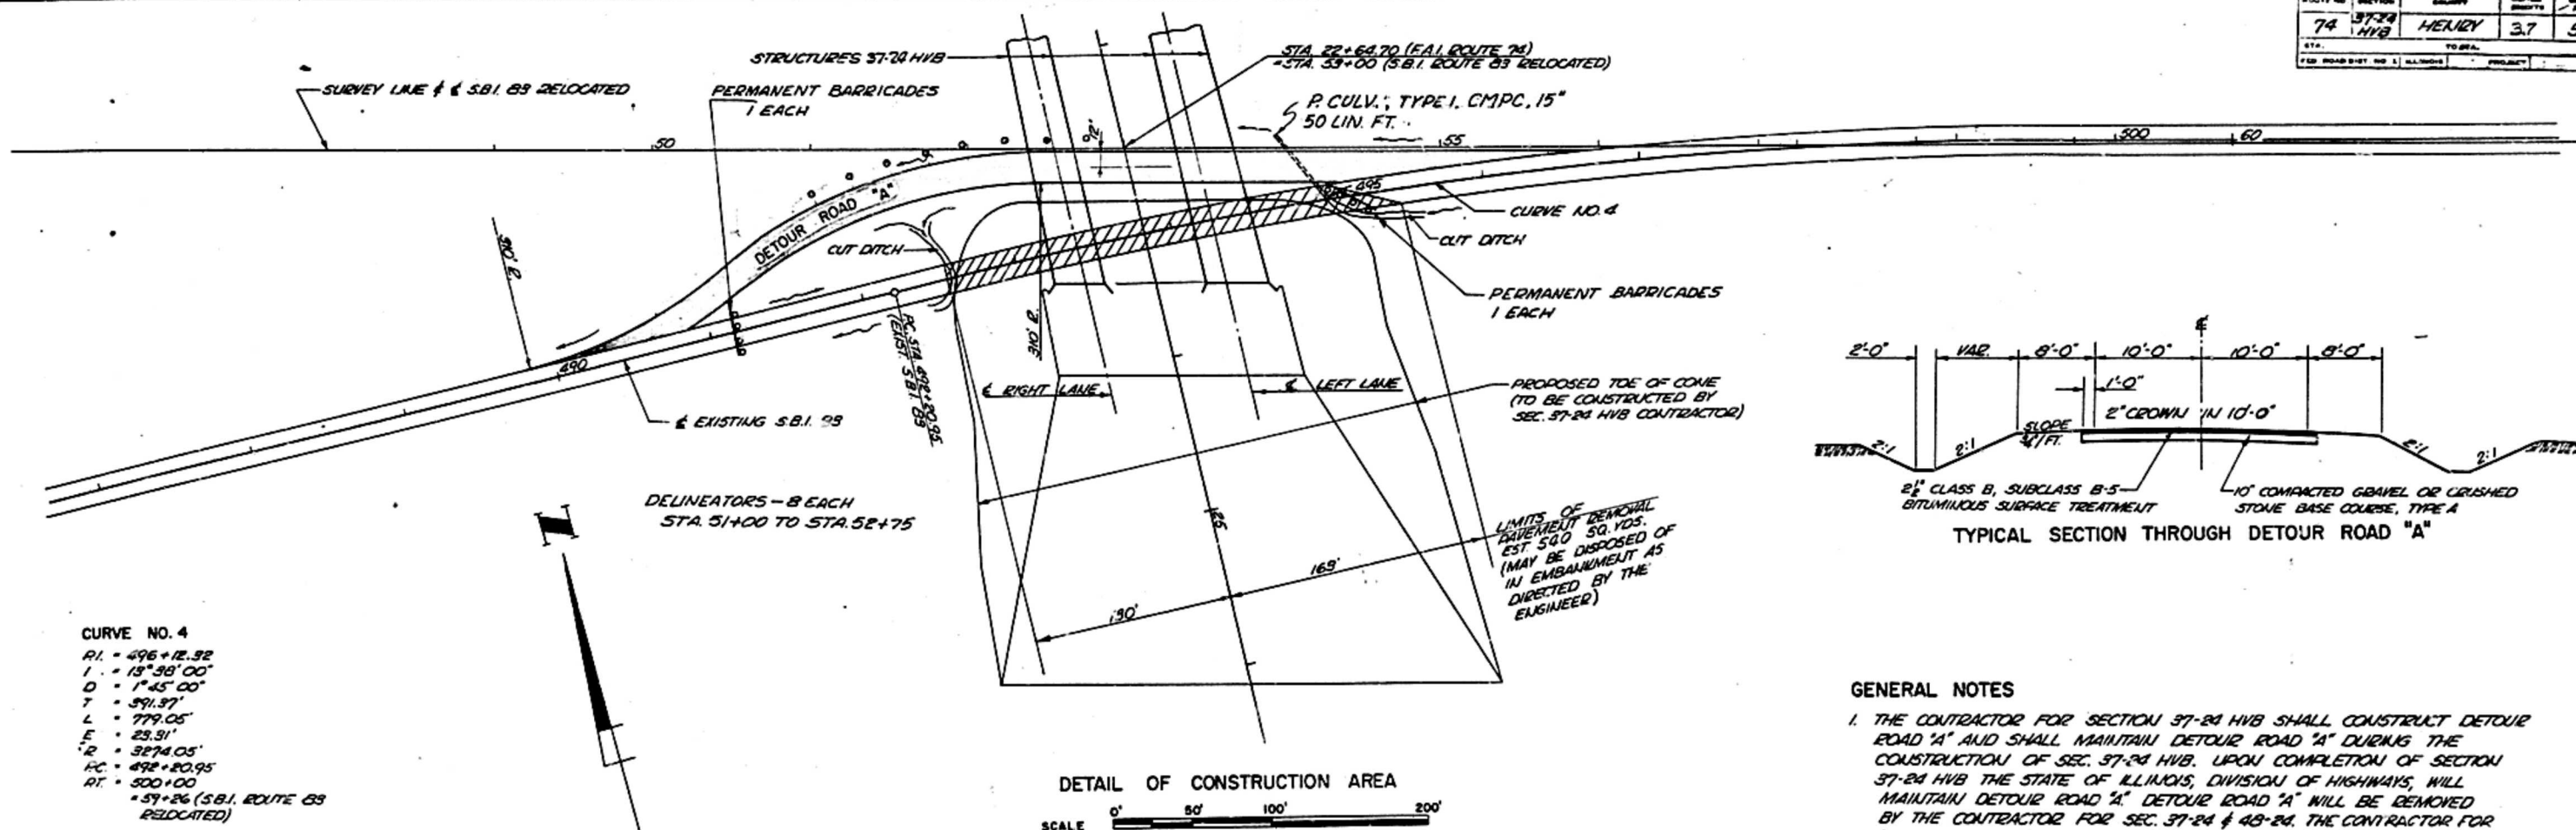


GENERAL NOTES



1. THE CONTRACTOR FOR SECTION 37-24 HVB SHALL CONSTRUCT DETOUR ROAD "A" AND SHALL MAINTAIN DETOUR ROAD "A" DURING THE CONSTRUCTION OF SEC. 37-24 HVB. UPON COMPLETION OF SECTION 37-24 HVB THE STATE OF ILLINOIS, DIVISION OF HIGHWAYS, WILL MAINTAIN DETOUR ROAD "A". DETOUR ROAD "A" WILL BE REMOVED BY THE CONTRACTOR FOR SEC. 37-24 & 48-24. THE CONTRACTOR FOR SEC. 37-24 & 48-24 SHALL MAINTAIN DETOUR ROAD "A" FROM THE AWARDING OF THE CONTRACT FOR SEC. 37-24 & 48-24 UNTIL IT IS REMOVED BY HIM.
2. USE 775 CU. YDS. EXCESS EARTH EXCAVATION FROM DETOUR ROAD TO CONSTRUCT EMBANKMENT CONES.

SUMMARY OF QUANTITIES

ITEM	UNITS	Q'JAN.
EARTH EXCAVATION	CU. YD.	870
GRAVEL OR CRUSHED STONE BASE COURSE TYPE A	TON	757
BITUMINOUS MATERIALS (PRIME COAT)	GAL.	666
COVER COAT MIXTURE COMPLETE	TON	173

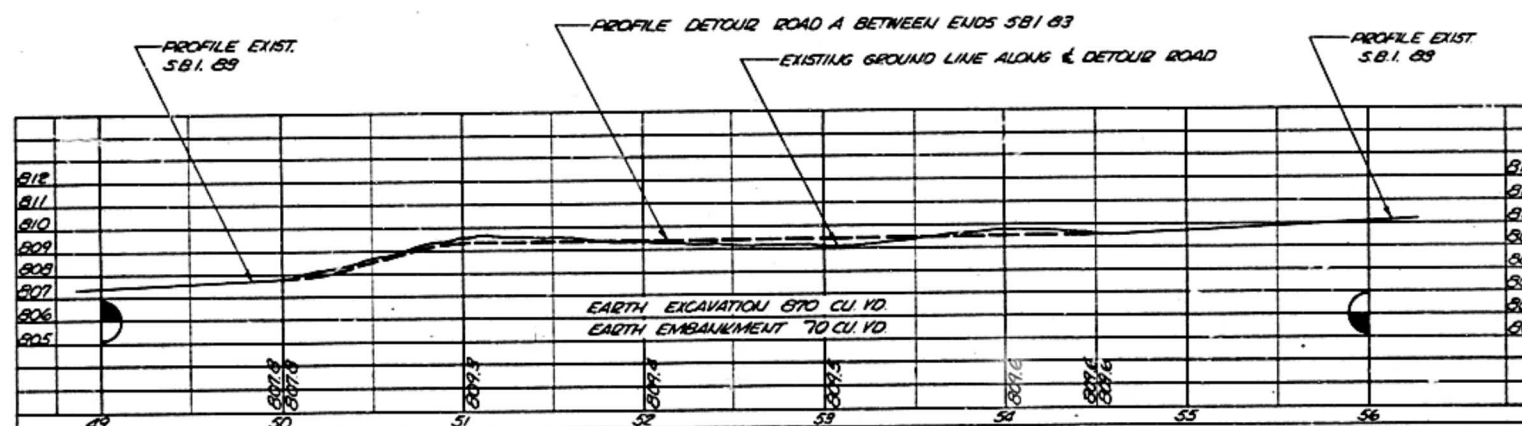

DETOUR ROAD "A"
 F.A.I. RTE. 74 SEC. 37-24 HVB
 F.A.I. 74 OVER C.B. & Q. R.R. & S.B.I. RT. 83
 HENRY CO., ILLINOIS
 STA. 22+64.70

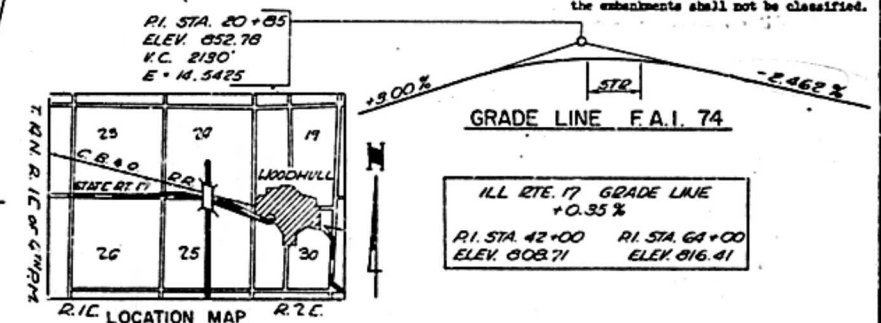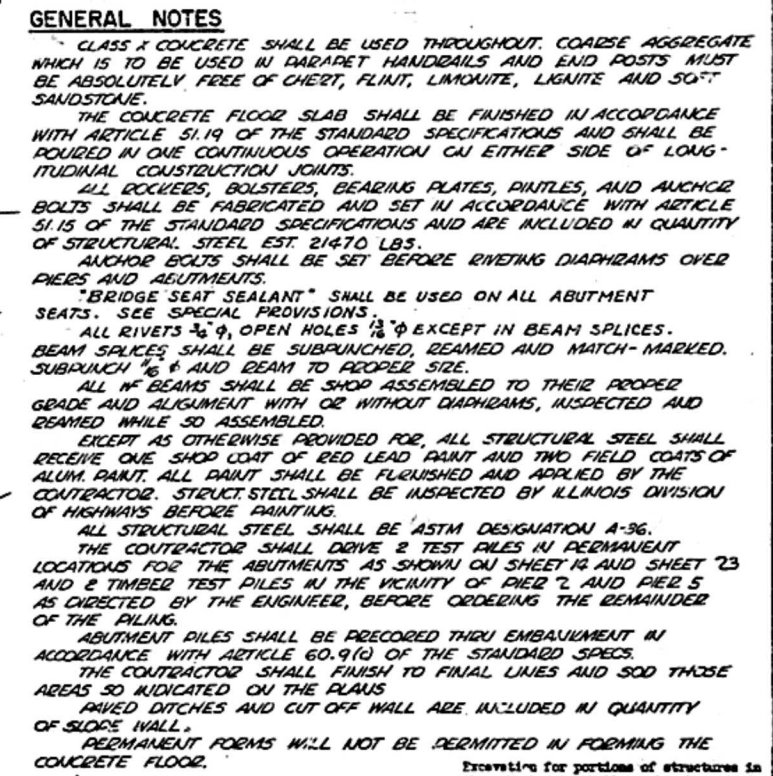

BILL OF MATERIAL (2 STRUCTURES)				
ITEM	UNITS	SUPER	SUB	TOTAL
CLASS A EXCAVATION FOR STRUCTURES	CU. YD.		552	552
CLASS X CONCRETE	CU. YD.	651.9	747.0	1398.9
FURNISHING & ERECTING STRUCTURAL STEEL	LBS	608260		608260
REINFORCEMENT BARS	LBS	150410	99170	249580
FURNISHING CREOSOTED PILES (20.1' TO 38')	LINEAL FT.		6980	6980
TEST PILE (TIMBER)	EA.		2	2
DRIVING TIMBER PILES	LINEAL FT.		7620	7620
DRIVING CONCRETE PILES	LINEAL FT.		9915	9915
FURNISHING CONCRETE PILES	LINEAL FT.		9915	9915
TEST PILE (CONCRETE)	EA.		2	2
NAME PLATE	EA.	2		2
SLOPE WALL (4 INCH)	SQ. YD.		2127	2127
ALUMINUM HANDRAIL	LINEAL FT.	984		984
PROTECTIVE COAT	SQ. YD.	2710		2710
SODDING	SQ. YD.			1756
TRANSPORTING CREOSOTED PILES	LINEAL FT.		649	649
BRIDGE SEAT SEALANT	LUMP SUM	1		1



DESIGN STRESSES

FC = 1400 PSI. SUPER & SUB
FS = 20,000 PSI. STRUCT. (A-36 STEEL)
FS = 20,000 PSI. REINF.
V = 75 PSI. FOOTINGS
n = 10

HS 20-44 LOADING & ALTERNATE LG
DEAD LOAD TO INCLUDE 13' 10" R.W.Y.
FOR FUTURE SURFACING

DESIGNED BY: T.D. GAZDA
CHECKED BY: J. DUHAP & S. SCHOLL
DRAWN BY: T.D.G. & J.T.

GENERAL PLAN AND ELEVATION
F.A.I. RTE. 74 SEC 37-24 HVB
PROJ. 176 -74-2(31)31
F.A.I. 74 OVER C.B.Q. R.R. & S.B.I. RT. 83
HENRY CO., ILLINOIS
STA. 22 +64.70

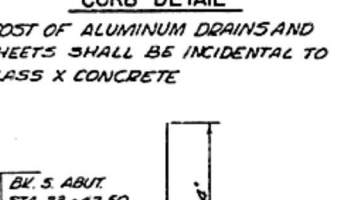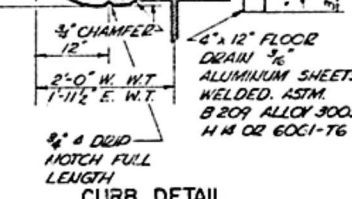

STA. 23 + 62.30
C.R. EL. 636.08

8" 1/2"

3"

BAR d₁

3/8" x 1-1/2" Aluminum Bar ASTM B20 alloy 3003-H14 or 6061-T6


12" 3/8"

TOP VIEW

8" 2"


END VIEW

Fill slot with welds

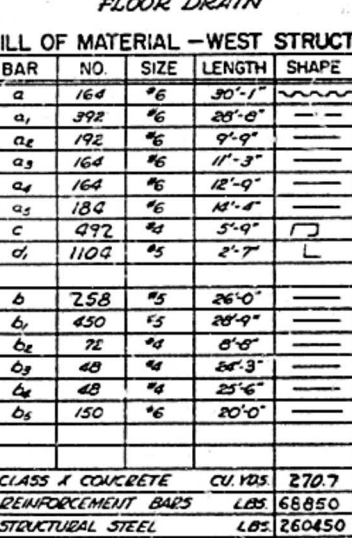


CK DETAILS — WEST STRUCTURE
F.A.I. RTE. 74 SEC. 37-24 HVB
I. 74 OVER C.B.B.Q. R.R. & S.B.I. RT. 83
HENRY CO., ILLINOIS
STA. 23+64.70

STRENGTH

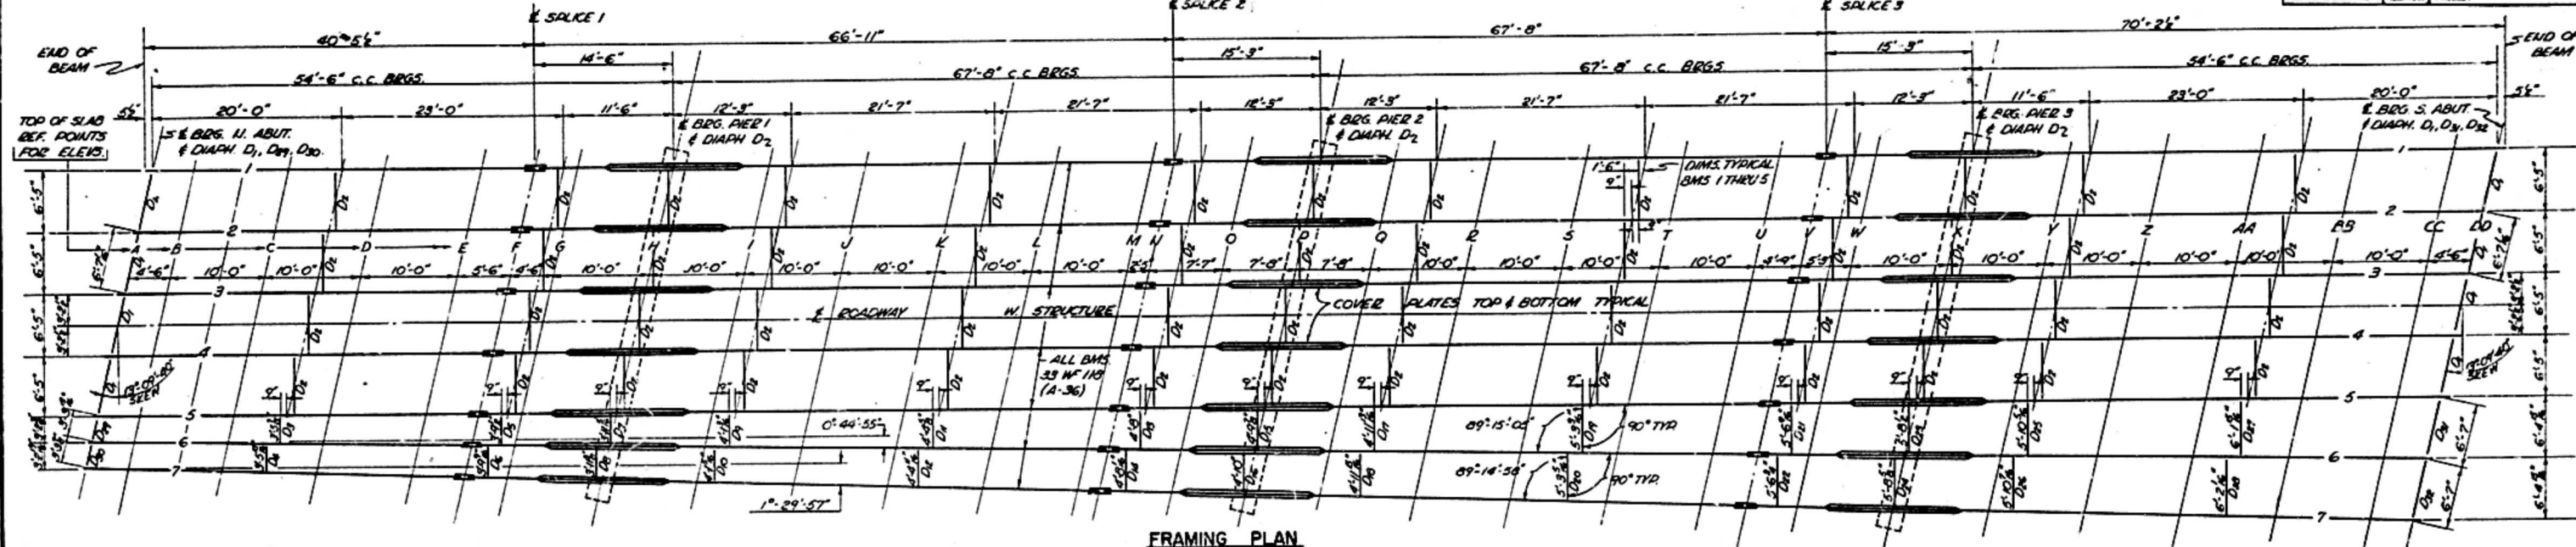

FRAMING PLAN

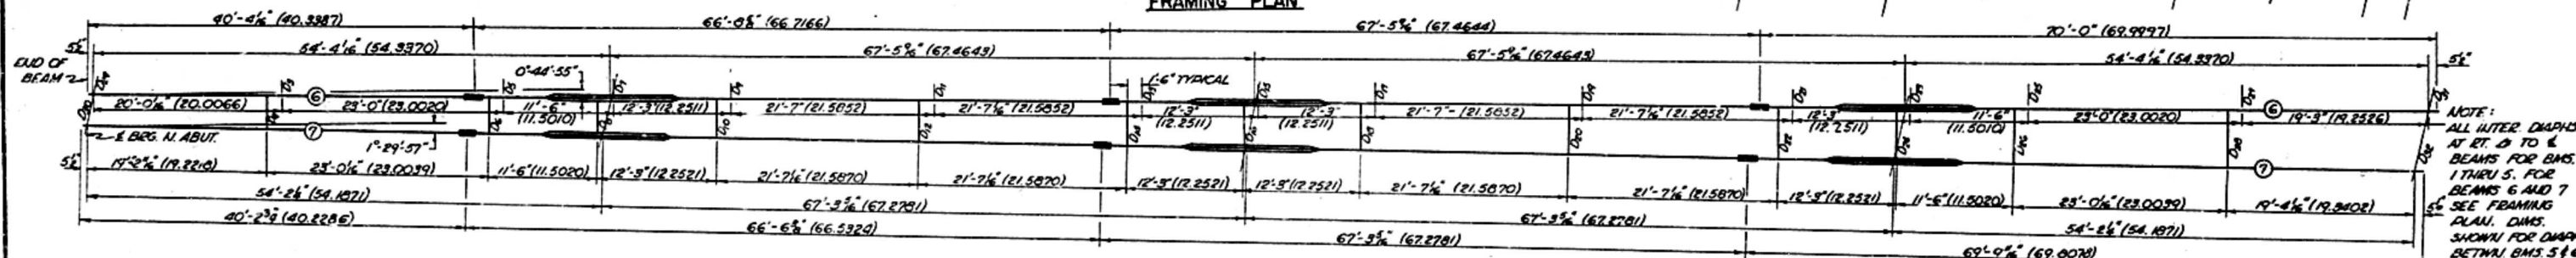

DIMENSIONS FOR FANNED BEAMS ⑥ & ⑦

NOTE:
ALL INTER. DIAPHS.
AT RT. 2 TO 6
BEAMS FOR BMS.
1 THRU 5. FOR
BEAMS 6 AND 7
SEE FRAMING
PLAN, DIMS.
SHOWN FOR DIAPHS.
BETWEEN BMS. 5 & 6
AND 6 & 7. ARE
C.C. BMS MEASURED
ALONG & DIAPHS.

GRADE ELEVATIONS ADJUSTED FOR DEAD LOAD DEFLECTIONS

GRADE	ELEVATIONS ADJUSTED FOR DEAD LOAD DEFLECTION						
LOCATION	BM. 1	BM. 2	BM. 3	BM. 4	BM. 5	BM. 6	BM. 7
A	838.07	838.19	838.26	838.26	838.18	838.12	838.05
B	838.09	838.21	838.28	838.27	838.20	838.13	838.07
C	838.13	838.24	838.31	838.31	838.23	838.16	838.10
D	838.15	838.26	838.33	838.33	838.25	838.18	838.12
E	838.16	838.27	838.34	838.34	838.26	838.19	838.12
F	838.16	838.27	838.34	838.34	838.27	838.19	838.12
G	838.15	838.27	838.34	838.34	838.27	838.19	838.12
H	838.15	838.28	838.35	838.35	838.27	838.20	838.11
I	838.18	838.29	838.37	838.37	838.29	838.21	838.13
J	838.20	838.31	838.39	838.39	838.31	838.22	838.15
K	838.22	838.32	838.40	838.40	838.32	838.23	838.16
L	838.21	838.32	838.40	838.40	838.32	838.23	838.16
M	838.20	838.31	838.39	838.39	838.31	838.22	838.14
N	838.19	838.31	838.38	838.38	838.31	838.22	838.13
O	838.17	838.29	838.37	838.37	838.30	838.20	838.11
P	838.16	838.28	838.36	838.36	838.29	838.20	838.10
Q	838.16	838.28	838.36	838.36	838.29	838.19	838.09
R	838.17	838.28	838.36	838.36	838.29	838.19	838.10
S	838.17	838.28	838.35	838.36	838.29	838.19	838.10
T	838.15	838.27	838.34	838.34	838.27	838.17	838.08
U	838.12	838.24	838.31	838.32	838.25	838.14	838.04
V	838.10	838.22	838.29	838.30	838.23	838.12	838.02
W	838.08	838.20	838.28	838.28	838.21	838.11	838.00
X	838.04	838.17	838.25	838.25	838.18	838.08	837.96
Y	838.03	838.15	838.23	838.23	838.16	838.05	837.94
Z	838.01	838.13	838.21	838.21	838.14	838.03	837.92
AA	837.99	838.11	838.19	838.19	838.12	838.01	837.90
BB	837.95	838.07	838.15	838.15	838.09	837.97	837.86
CC	837.90	838.02	838.10	838.11	838.04	837.92	837.80
DD	837.87	838.00	838.08	838.08	838.01	837.89	837.77


TABLE OF DEAD LOAD DEFLECTIONS

LOCATION	BM. 1	BM. 2	BM. 3	BM. 4	BM. 5	BM. 6	BM. 7
1/4 PT. SPAN 1	3° 2'	6°	6°	6°	3° 2'	3° 2'	3° 2'
1/2 PT. SPAN 1	3° 2'	6°	6°	6°	3° 2'	3° 16'	3° 0'
3/4 PT. SPAN 1	3° 16'	0°	0°	0°	3° 2'	3° 16'	3° 32'
1/4 PT. SPAN 2	3° 32'	3° 2'	3° 2'	3° 2'	3° 16'	3° 32'	3° 16'
1/2 PT. SPAN 2	0° 16'	3° 32'	3° 32'	3° 32'	0° 16'	0°	0°
3/4 PT. SPAN 2	3° 32'	3° 32'	3° 32'	3° 32'	3° 16'	0°	3° 32'
1/4 PT. SPAN 3	3° 32'	3° 32'	3° 32'	3° 32'	3° 16'	3° 16'	3° 16'
1/2 PT. SPAN 3	0° 16'	3° 32'	3° 32'	3° 32'	0° 16'	3° 16'	3° 32'
3/4 PT. SPAN 3	3° 32'	3° 32'	3° 32'	3° 32'	3° 32'	3° 16'	3° 32'
1/4 PT. SPAN 4	3° 16'	0°	0°	0°	3° 32'	3° 32'	3° 16'
1/2 PT. SPAN 4	3° 32'	6°	6°	6°	0°	6°	3° 32'
3/4 PT. SPAN 4	3° 16'	3° 32'	6°	6°	3° 32'	3° 32'	0°

* ELEVATIONS OF TOP OF WF BEAMS


LOCATION	BM. 1	BM. 2	BM. 3	BM. 4	BM. 5	BM. 6	BM. 7
← BORG N. ABUT	837.47	837.60	837.67	837.67	837.60	837.51	837.41
← SALICE 1	837.47	837.60	837.67	837.67	837.60	837.51	837.41
← PIER 1	837.47	837.60	837.67	837.67	837.60	837.51	837.41
← SALICE 2	837.47	837.60	837.67	837.67	837.60	837.51	837.41
← PIER 2	837.46	837.59	837.66	837.66	837.59	837.50	837.40
← SALICE 3	837.41	837.54	837.61	837.61	837.54	837.45	837.35
← PIER 3	837.37	837.50	837.57	837.57	837.50	837.41	837.31
← BORG S. ABUT	837.24	837.37	837.44	837.44	837.37	837.28	837.18

* ELEVATIONS REFER TO TOP OF TOP FLANGES OF ACTUAL ROLLED BEAMS. DOES NOT INCLUDE SOLICE PLATE OR COVER PLATES. THESE ELEVATIONS ARE THEORETICAL AND ARE TO BE USED FOR FABRICATION OF STRUCTURAL STEEL AND DO NOT INCLUDE ANY ALLOWANCE FOR DEFLECTION.

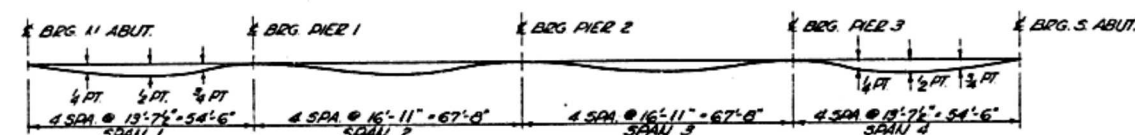




DEAD LOAD DEFLECTION DIAGRAM

WEIGHT OF STRUCTURAL STEEL NOT INCLUDED. DIAGRAM FOR
REFERENCE ONLY AND IS NOT REQ'D. FOR CONSTRUCTION PURPOSES

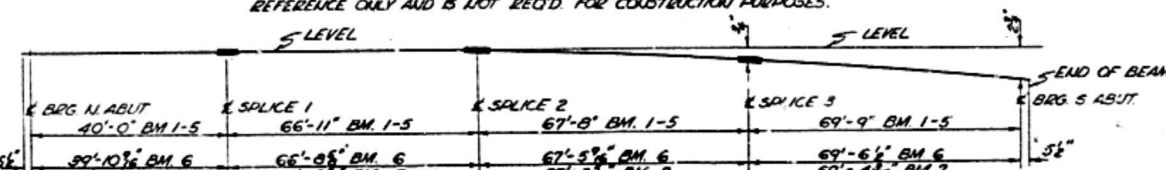





PROFILE OF BEAMS






STRUCTURAL STEEL - WEST STRUCTURE
F.A.I. RTE. 74 SEC. 37-24 HWB
F.A.I. 74 OVER C.B. & Q. RR. & S.B.I. RT. 83
HENRY CO., ILLINOIS
STA. 22+64.70

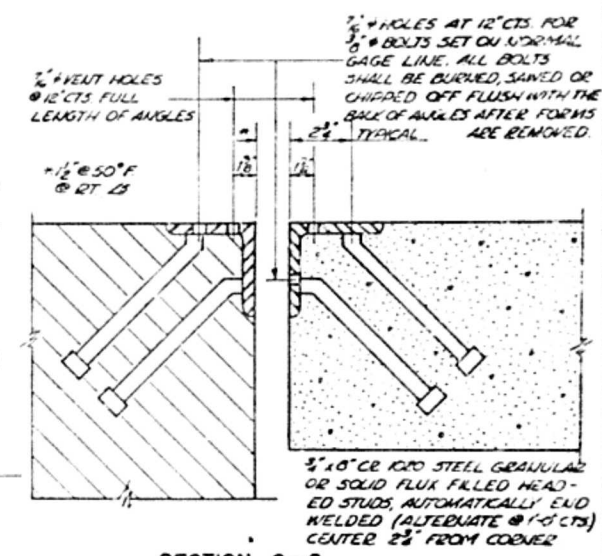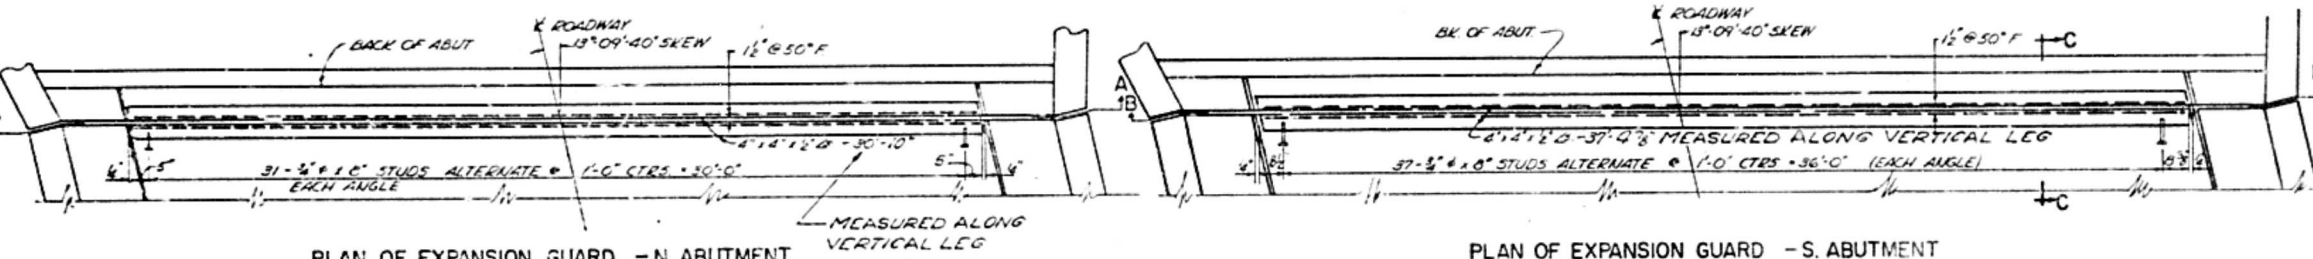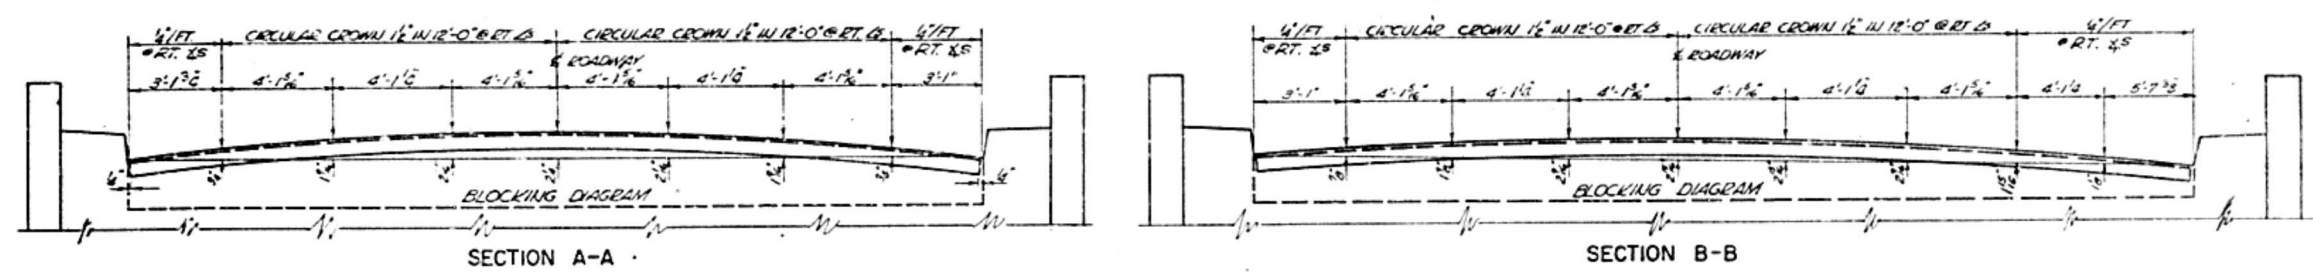

NOTE: ROADWAY EXPANSION GUARD SHALL BE FABRICATED TO FIT THE ROADWAY. GUARD SHALL BE ASSEMBLED IN PROPER POSITION IN SHOP FOR INSPECTION. ALL EXPOSED SURFACES SHALL BE GIVEN TWO SHOP COATS OF RED LEAD PAINT. THE CONTACT SURFACES SHALL BE GIVEN ONE COAT OF RED LEAD PAINT. ANCHOR STUDS SHALL NOT BE PAINTED. E.S.: WEIGHT OF STRUCTURAL STEEL REQUIRED FOR EXPANSION GUARDS 1850 LBS. THE WEIGHTS OF THE ANGLES AND STUDS ARE INCLUDED IN THE QUANTITY OF STRUCTURAL STEEL.

The location of the anchor bolts and vertical alignment of the expansion bearings shall be adjusted to the temperature of the time of erection. See Art. 54.9(f). Anchor bolts shall be grouted into drilled holes of the bedrock in place, or bolts at fixed pier may be built into the masonry.

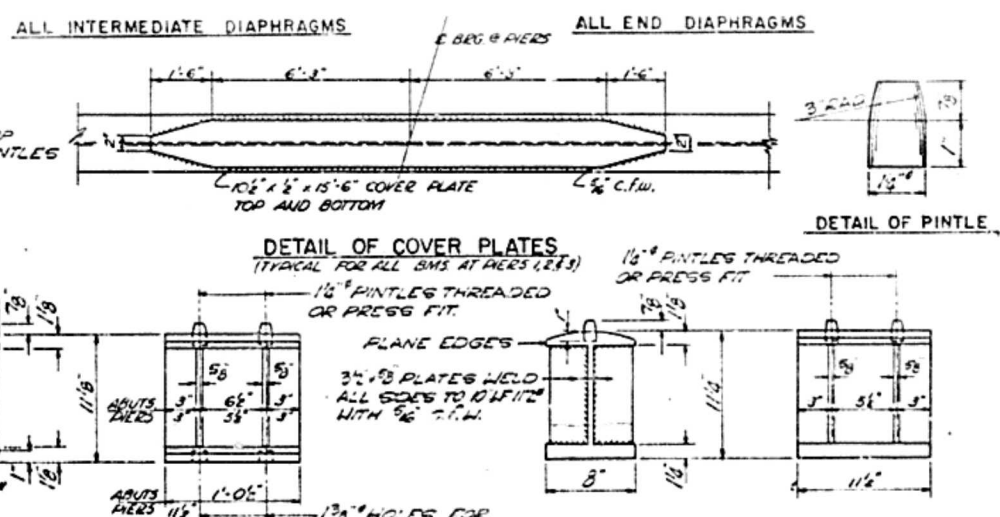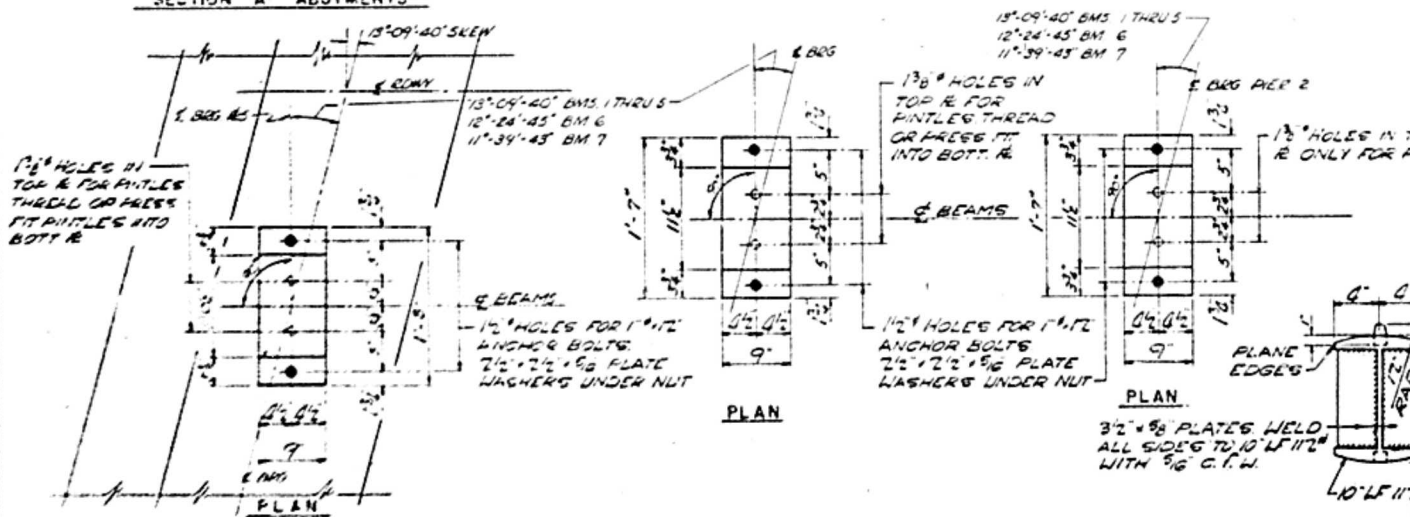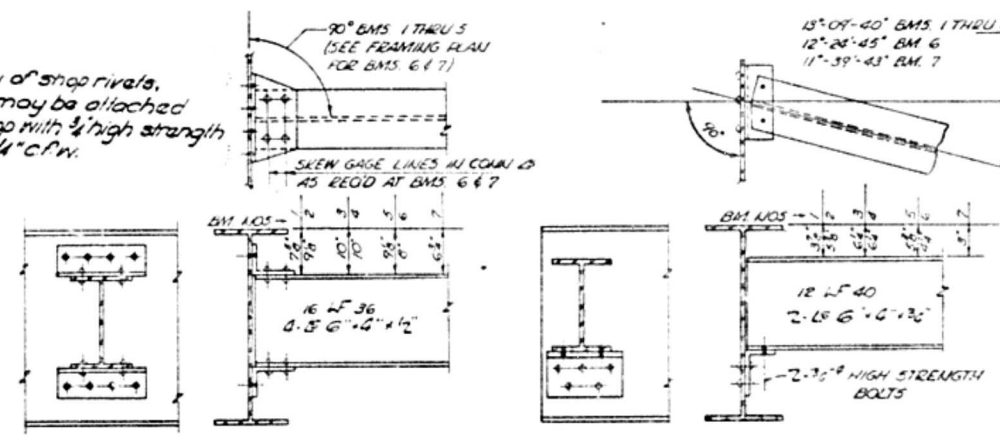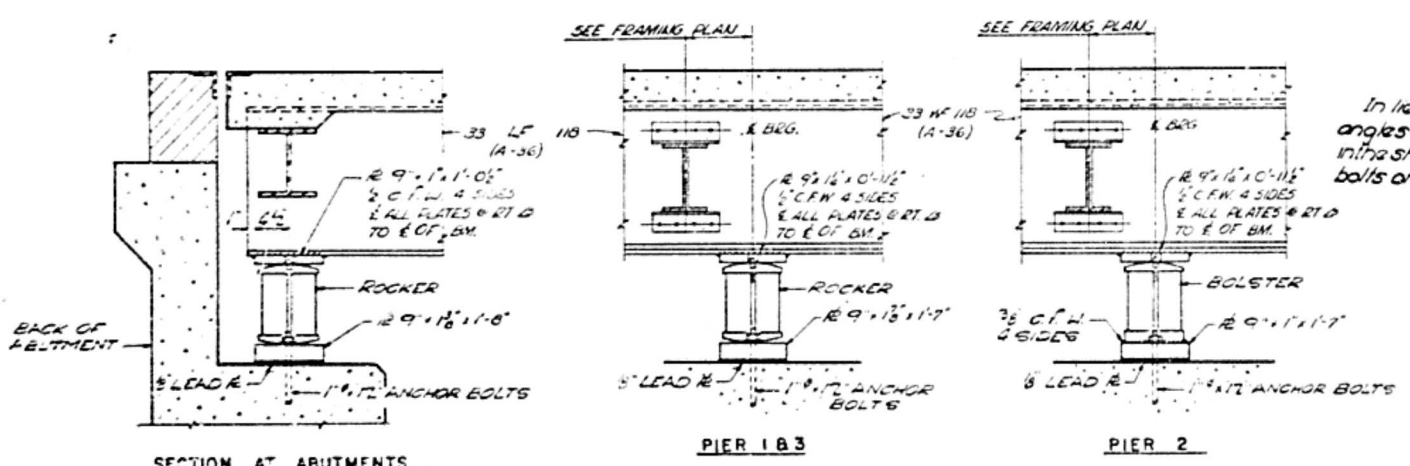

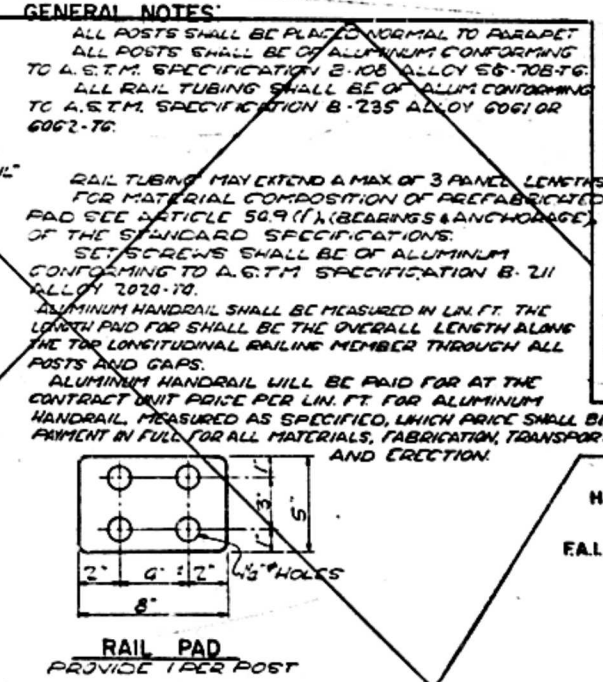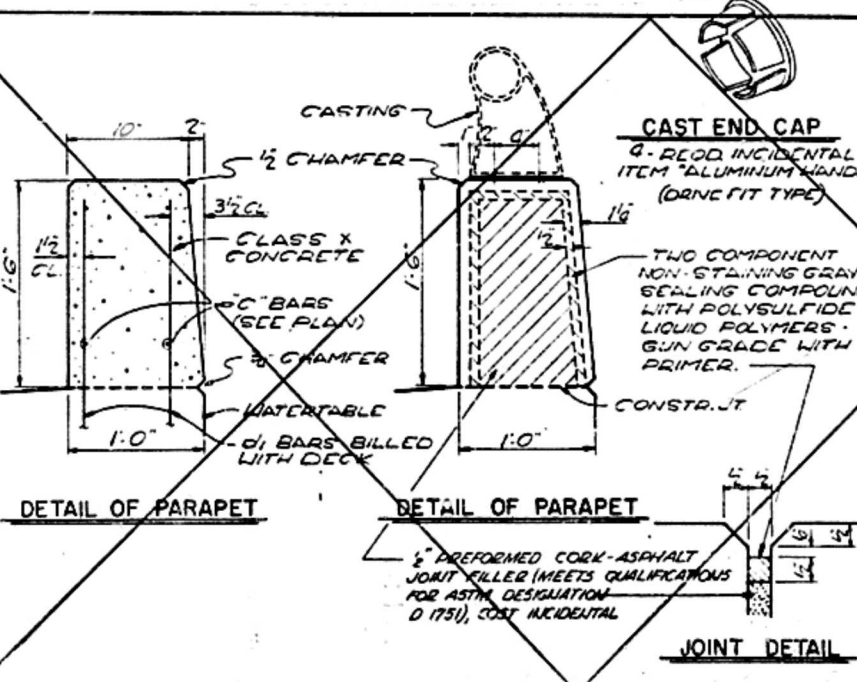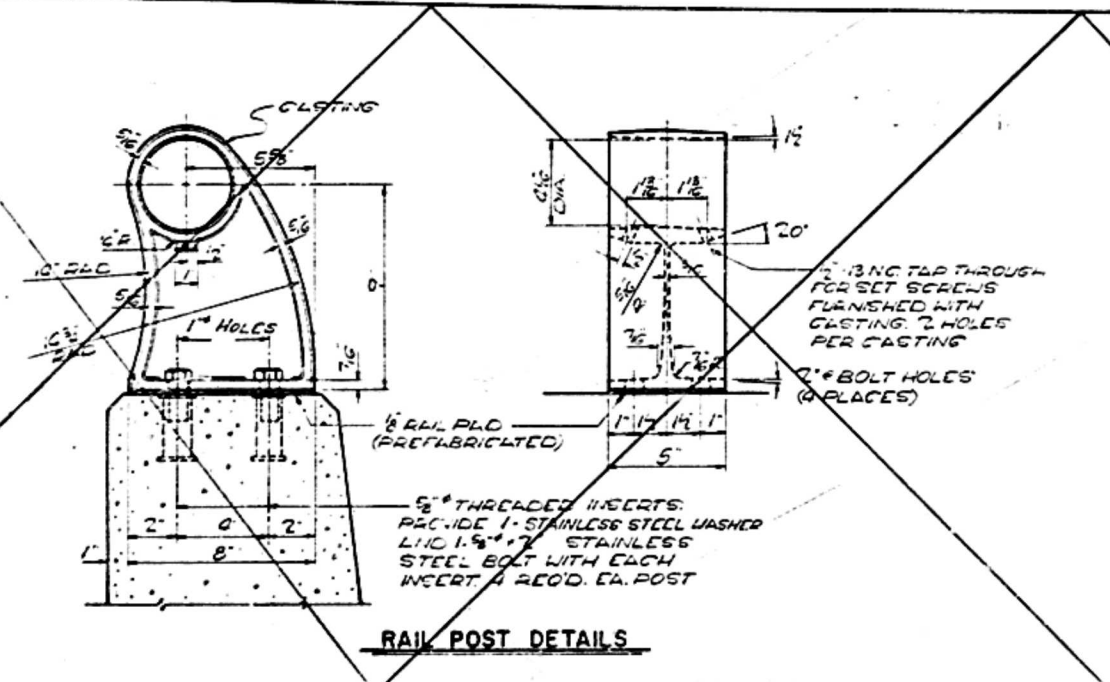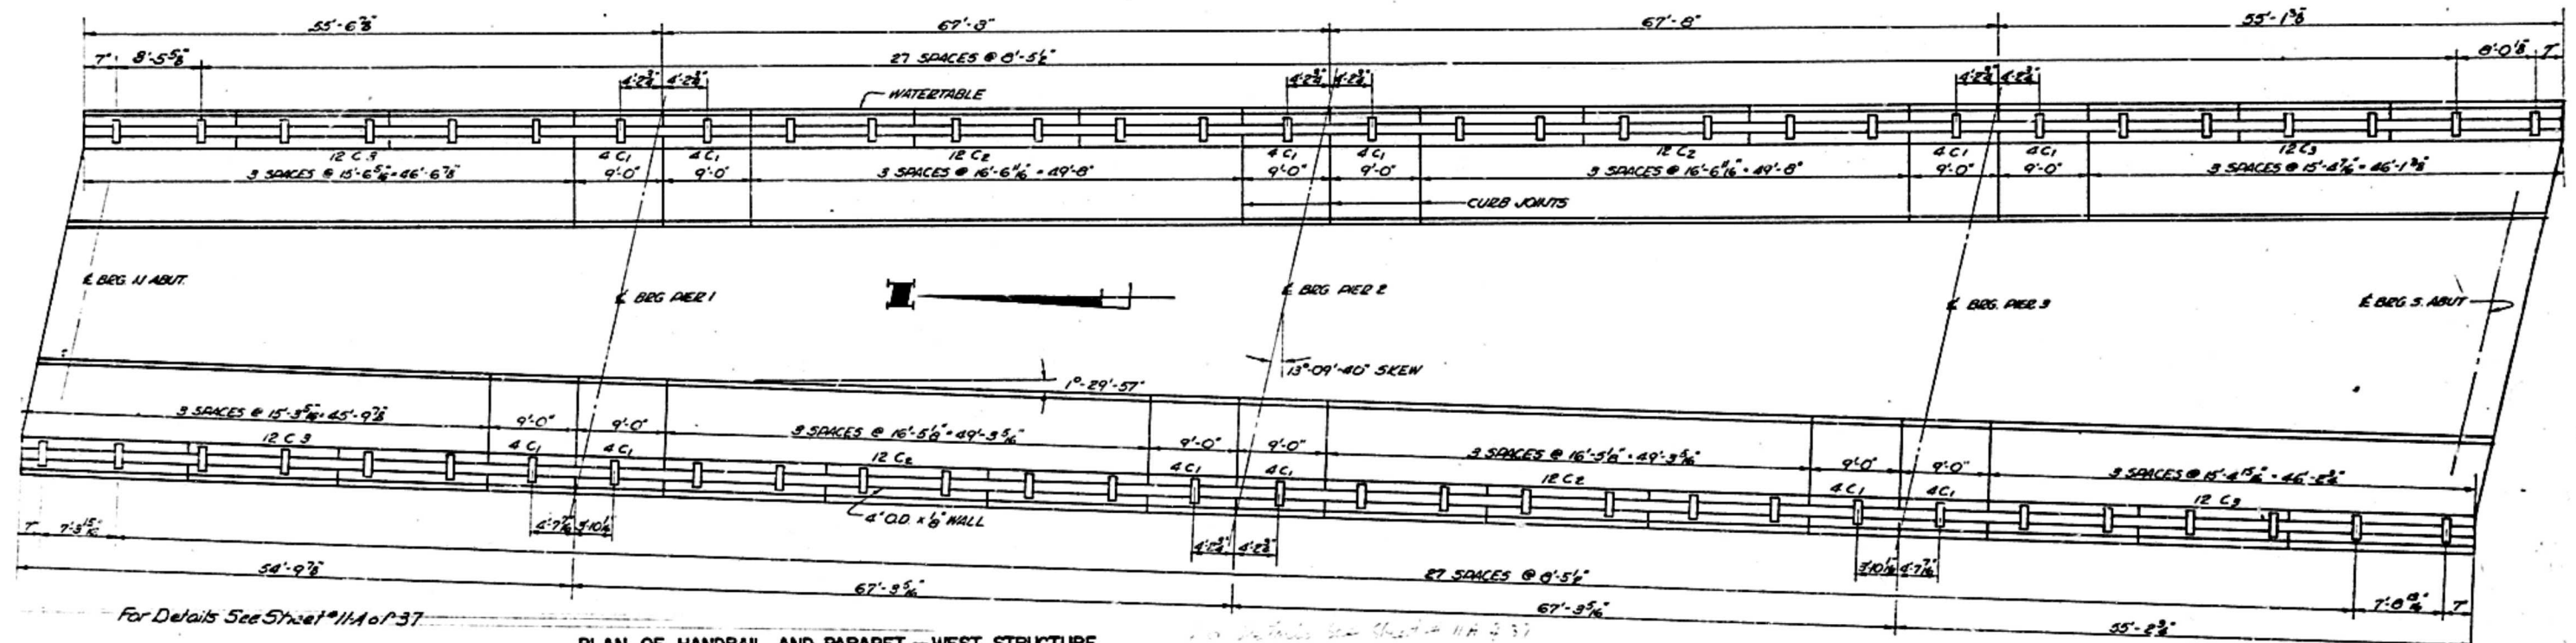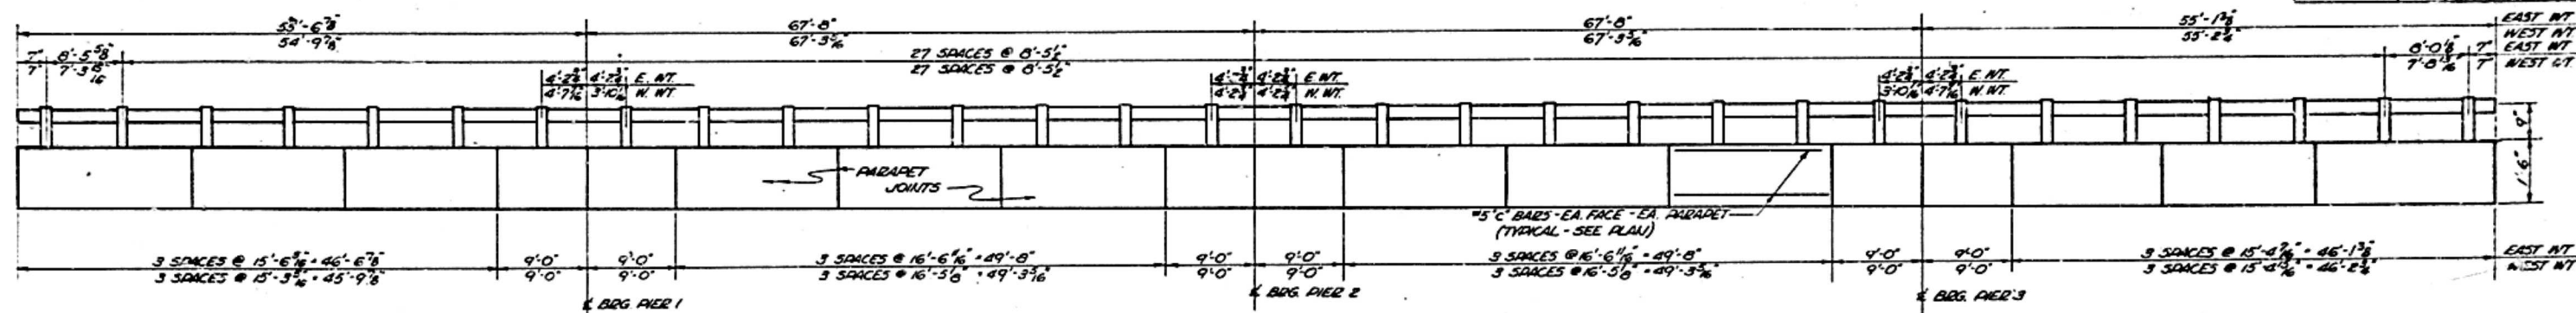

GENERAL NOTES:

ALL POSTS SHALL BE PLACED NORMAL TO PARAPET
ALL POSTS SHALL BE OF ALUMINUM CONFORMING TO A.S.T.M. SPECIFICATION B-108 ALLOY 6061-T6
ALL RAIL TUBING SHALL BE OF ALUMINUM CONFORMING TO A.S.T.M. SPECIFICATION B-235 ALLOY 6061 OR 6062-T6

RAIL TUBING MAY EXTEND A MAX OF 3 PANEL LENGTHS FOR MATERIAL COMPOSITION OF PREFABRICATED PAD SEE ARTICLE 50.9 (1) (B) BEARINGS & ANCHORAGE OF THE STANDARD SPECIFICATIONS
SET SCREWS SHALL BE OF ALUMINUM CONFORMING TO A.S.T.M. SPECIFICATION B-211 ALLOY 2020-T3
ALUMINUM HANDRAIL SHALL BE MEASURED IN LIN. FT. THE LENGTH PAD FOR SHALL BE THE OVERALL LENGTH ALONG THE TOP LONGITUDINAL RAILING MEMBER THROUGH ALL POSTS AND GAPS
ALUMINUM HANDRAIL WILL BE PAID FOR AT THE CONTRACT UNIT PRICE PER LIN. FT. FOR ALUMINUM HANDRAIL, MEASURED AS SPECIFIED, WHICH PRICE SHALL BE PAYMENT IN FULL FOR ALL MATERIALS, FABRICATION, TRANSPORTATION AND ERECTION.


BILL OF MATERIAL

BAR	NO	SIZE	LENGTH	SHAPE
C ₁	40	#5	0'-9"	---
C ₂	40	#5	16'-2"	---
C ₃	40	#5	15'-0"	---
CLASS X CONCRETE CURBS				25.0
REINFORCEMENT BARS LBS				2000
ALUMINUM HANDRAIL LIN. FT				491


WEST STRUCTURE
HANDRAIL AND PARAPET DETAILS
F.A.I. RTE. 74 SEC 37-24 HVB
FAL 74 OVER C.B. & Q. R.R. & S.B.I. RT 83
HENRY CO., ILLINOIS
STA. 22+64.70

REPORT NO.	SECTION	LENGTH	DATE	TIME	NO.
G.S.L. 76	ST-2 HVB	HEAVY	5	16	
FIELD GROUP SHEET NO. 2		DATE: JUL 22 1964			

R-17 Dm 5-28-64

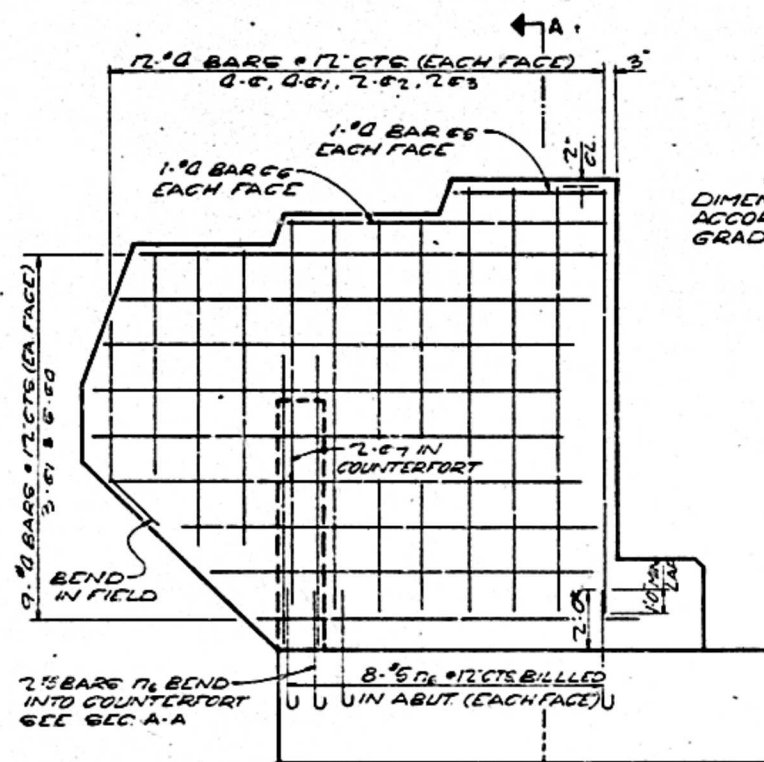

ELEVATION

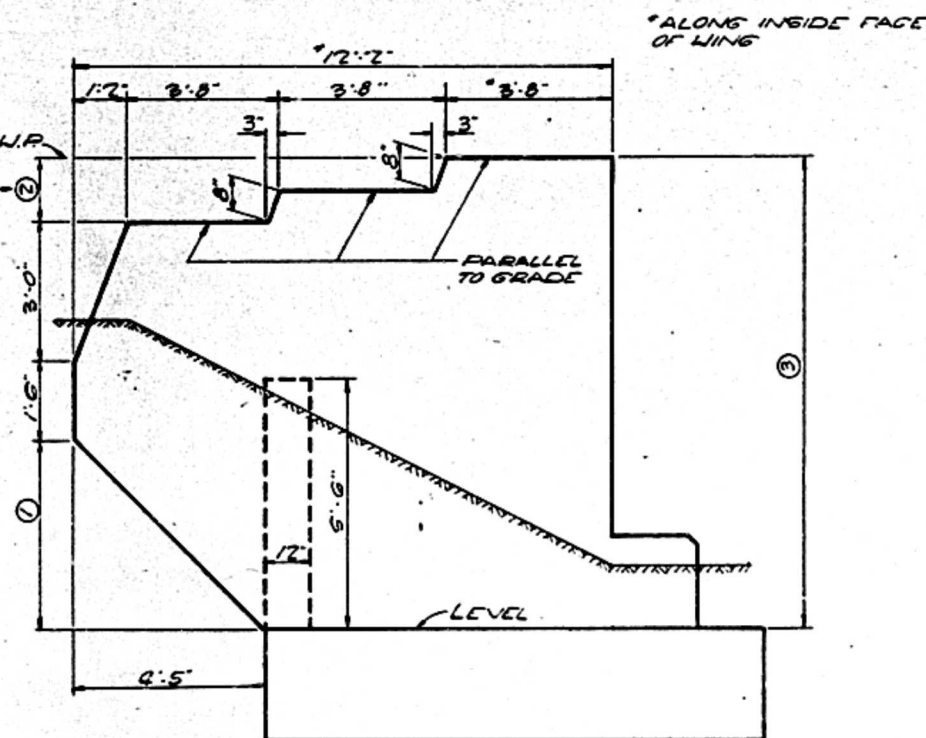


ELEVATION


TABLE FOR END POST DIMENSIONS

END POST	DIM. ①	②	③	PL. CONC. CLIPS
A	3'-11 1/2"	1'-7"	10'-0 1/2"	3.90
B	3'-11 1/2"	1'-7"	10'-0 1/2"	3.90
C	4'-0"	1'-7"	10'-1"	3.90
D	3'-10 3/4"	1'-7"	9'-11 1/4"	3.90


SEE ABUTMENT SHEETS FOR END POST DESIGNATION

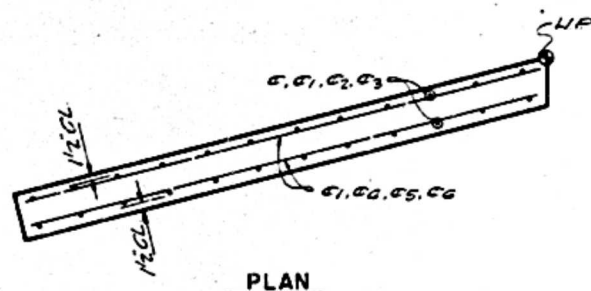


PLAN

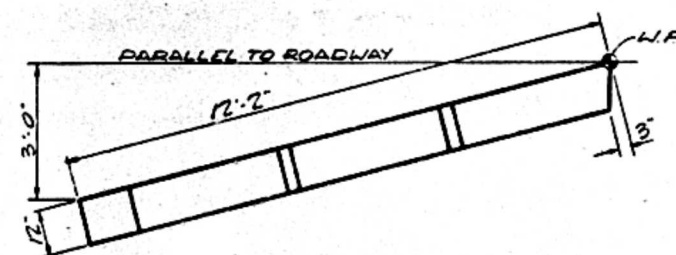

PLAN

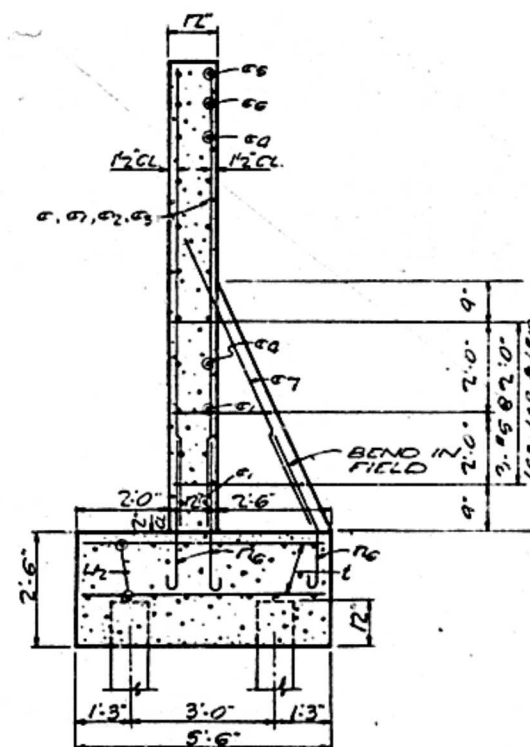

SECTION A-A

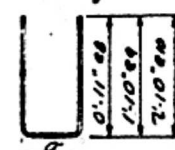

BARS #8, #9, #8, #10

4 END POSTS

BILL OF MATERIAL

BAR	NO.	SIZE	LENGTH	SHAPE
E	32	#4	9'-3"	—
E1	36	#4	8'-6"	—
E2	16	#4	6'-6"	—
E3	16	#4	5'-0"	—
E4	40	#4	10'-6"	—
E5	8	#4	3'-6"	—
E6	8	#4	7'-0"	—
E7	8	#5	7'-0"	—
E8	4	#5	7'-7"	U
E9	4	#5	6'-5"	U
E10	4	#5	6'-5"	U

CLASS X CONCRETE CURE 158

REINFORCEMENT BARS 1150

* THESE QUANTITIES INCLUDED WITH TOTALS SHOWN ON ABUT. SHEETS

END POST DETAILS — WEST STRUCTURE
FAL RTE. 74 SEC. 37-24 HVB
EAL 74 OVER C.B. & Q. R.R. & S.B. RT. 83
HENRY CO., ILLINOIS
STA. 22 + 64.70


[illegible]

Diagram of a chair with dimensions: seat height 2'10", seat width 2'1", and backrest height 1'6". The label "BAR h18" is written below the seat.

SOUTH ABUTMENT — WEST STRUCTURE
F.A.I. RTE. 74 SEC. 37-24 HVB
F.A.I. 74 OVER C.B. & Q. R.R. & S.B.I. RT. 83
HENRY CO., ILLINOIS
STA. 22+64.70

NOTE: SPACE MAIN REINF. IN CAP TO MISS ANCHOR BOLTS. ALL EDGES SHALL HAVE $\frac{3}{4}$ " CHAMFER EXCEPT FOOTINGS. POUR STEPS MONOLITHICALLY WITH CAP.


E. B.R.G. PIER 1
STA 21+50.66
CB EL 639.36

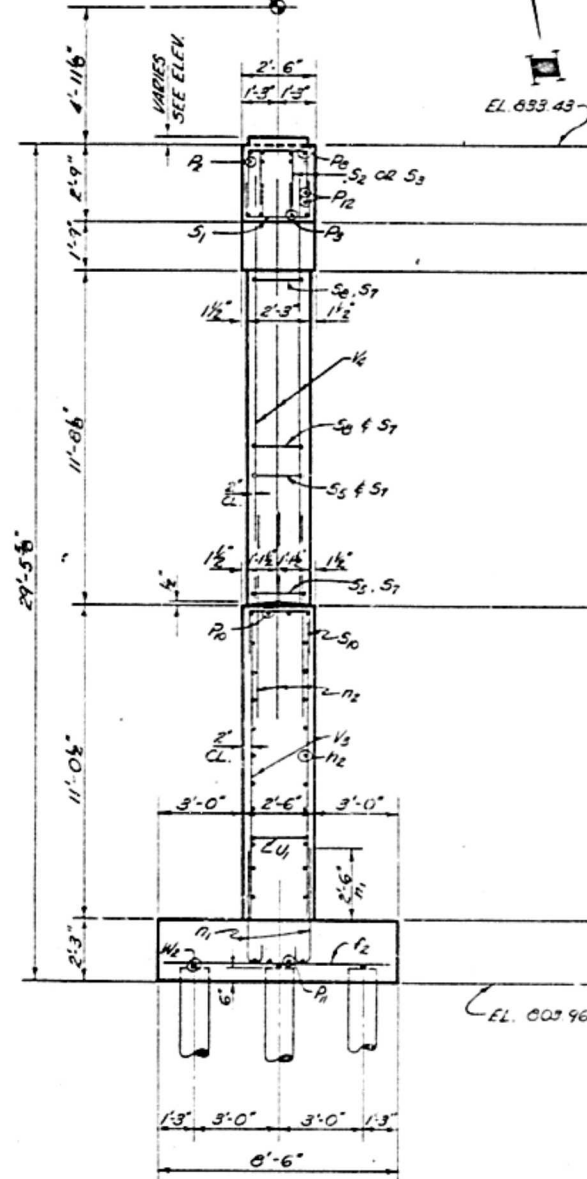


END VIEW
SCALE: $\frac{1}{4}$ " = 1'-0"

PILE DATA

TYPE: CREOSOTED TIMBER
MAX CAPACITY: 20 TON
EST. LENGTH: 35 FT.
NO. REQ'D: 27

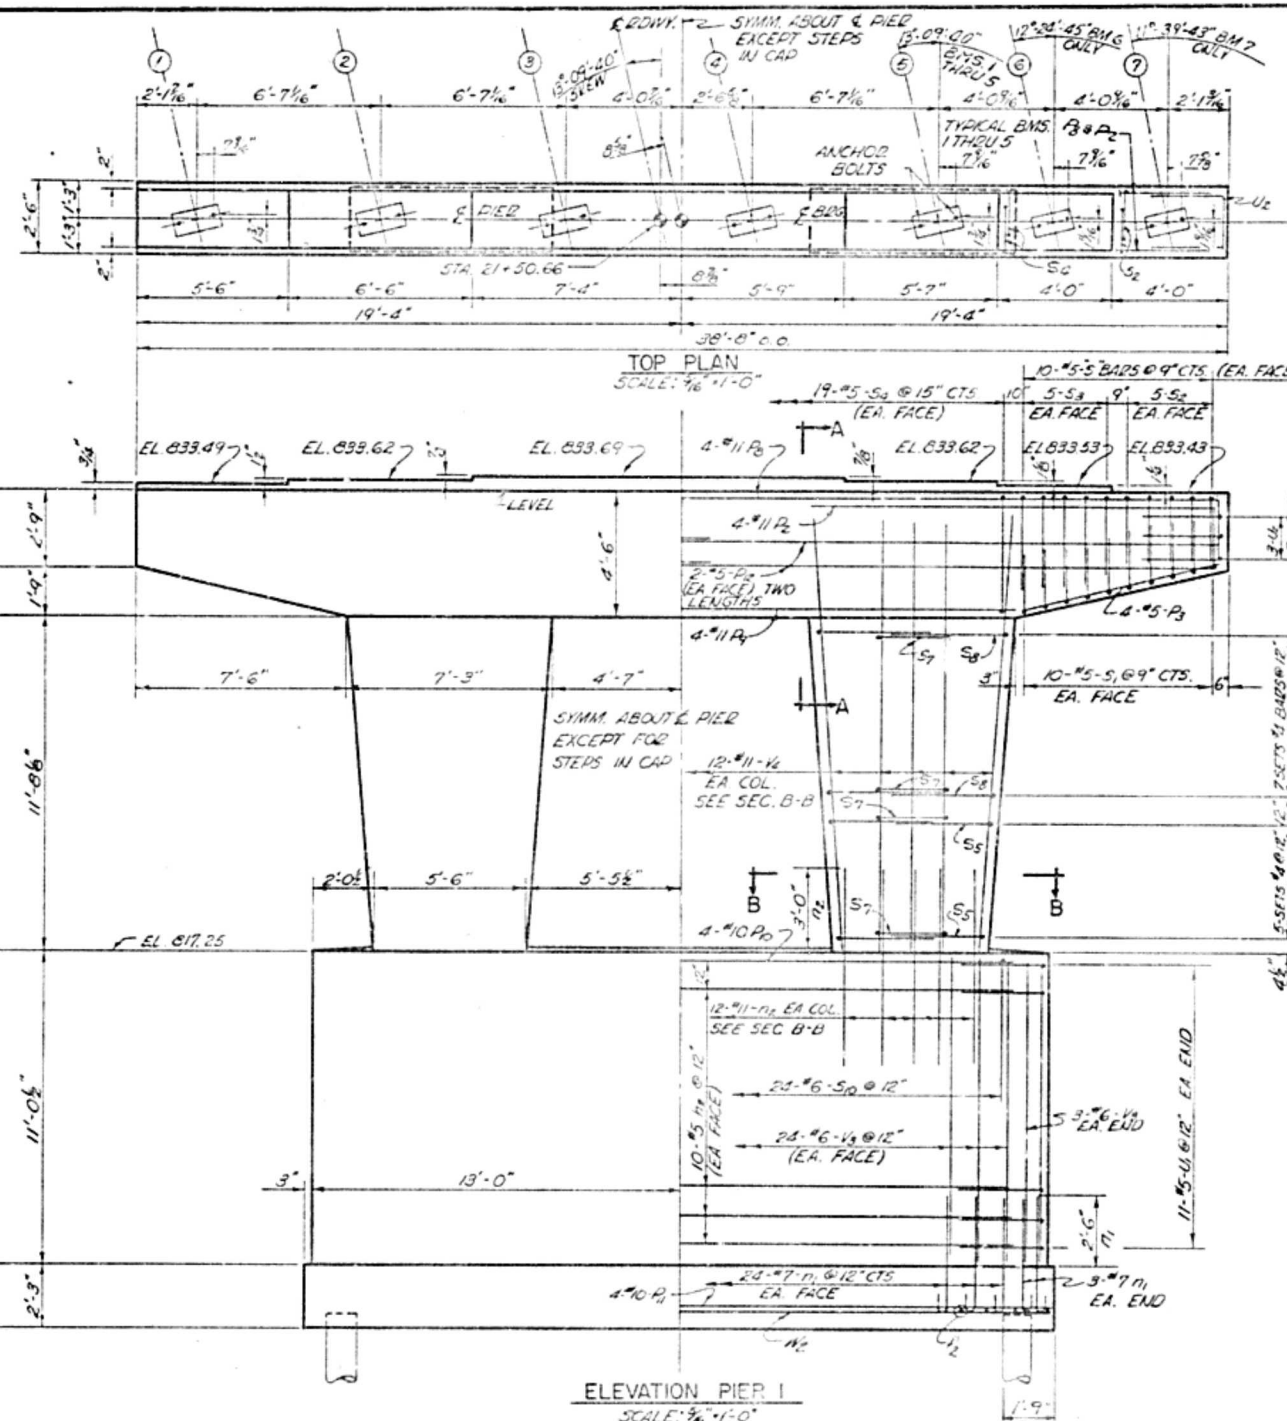

ELEVATION PIER 1
SCALE: $\frac{1}{4}$ " = 1'-0"

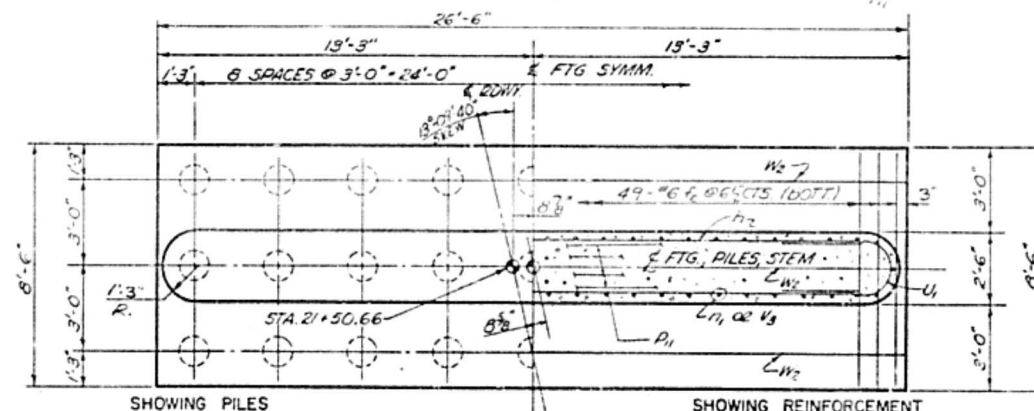

FOOTING PLAN PIER 1
SCALE: $\frac{1}{4}$ " = 1'-0"


NOTE: CARE SHOULD BE TAKEN IN LAYING OUT PIER IN FIELD AS $\frac{1}{2}$ PIER AND E. ROW. DO NOT COINCIDE. SEE FOOTING PLAN AND TOP 1" AN.




BAR S4 & S7




BAR U1

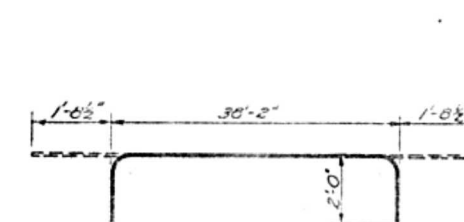


BAR P1

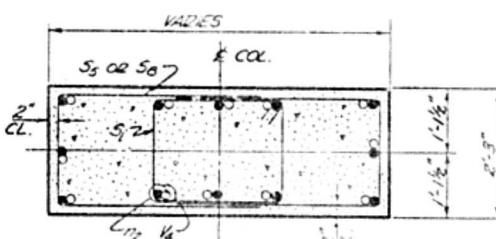

É. BRG. PIER 2
STA. 22+10.33
CR. ELEV. 839.37

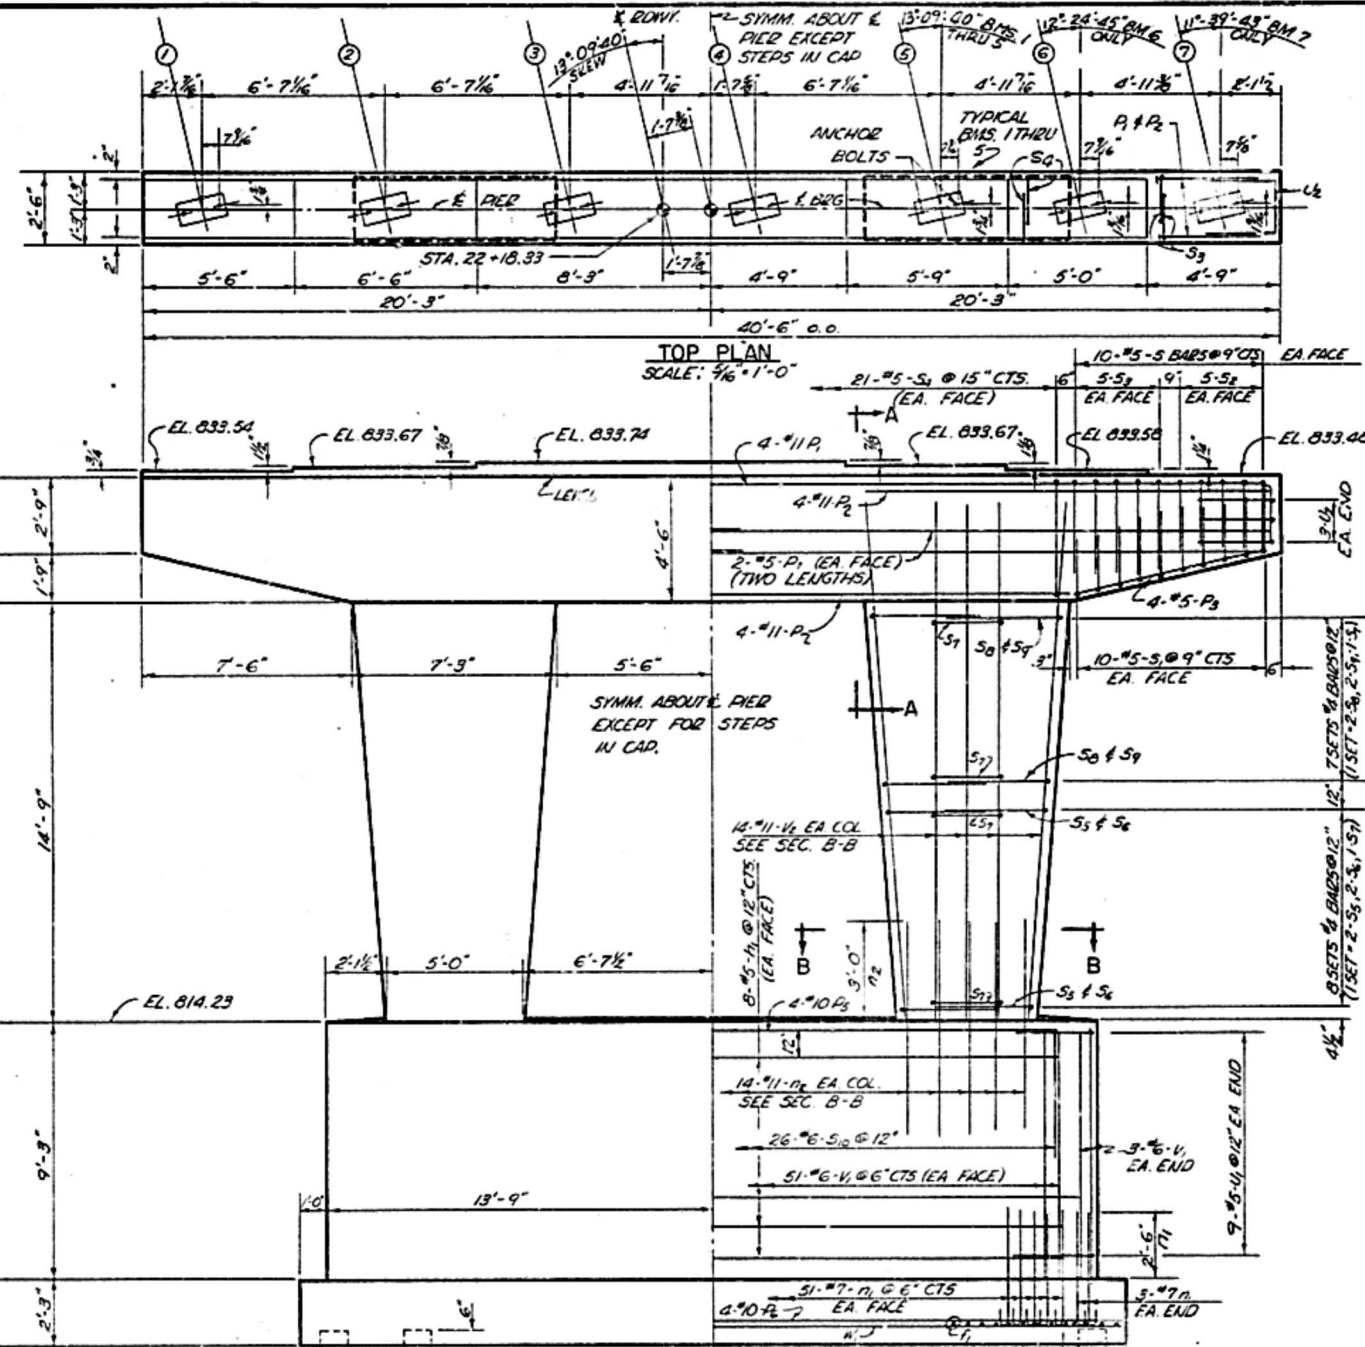

ELEVATION PIER 2
SCALE: $\frac{3}{16}'' = 1'-0''$

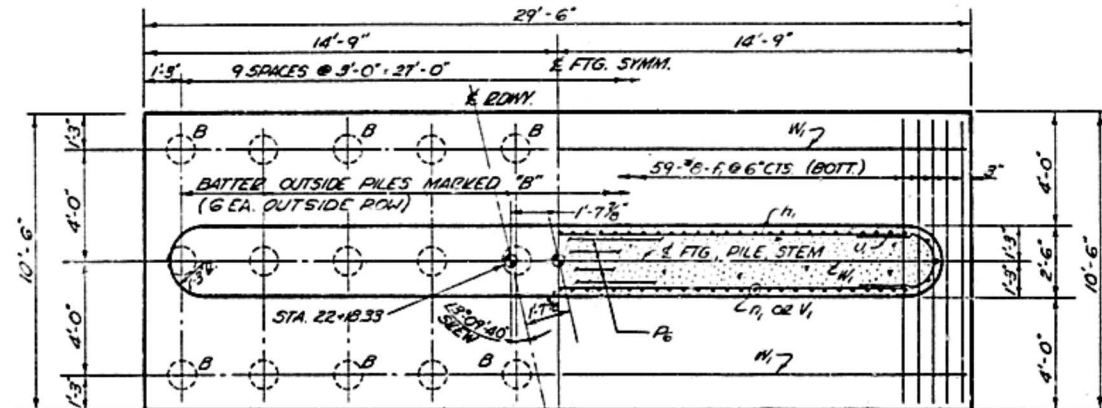


FOOTING PLAN PIER 2
SCALE: $\frac{5}{16}'' = 1'-0''$


FILE DATA

TYPE: CREOSOTED TIMBER
MIN. CAPACITY: 20 TONS
EST. LENGTH: 35 FT.
NO. REQUIRED: 30
TEST PILE: DRIVE ONE TIMBER TEST PILE
IN VICINITY OF PIER 2


NOTE: CARE SHOULD BE TAKEN IN LAYING OUT PIER IN FIELD AS ϕ PIER & ϕ ROWY. DO NOT COINCIDE. SEE FOOTING PLAN AND TOP PLAN.

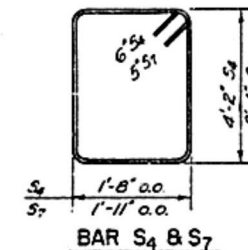


BAR S_4 & S_7

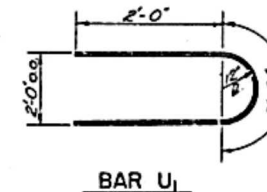


BAR U

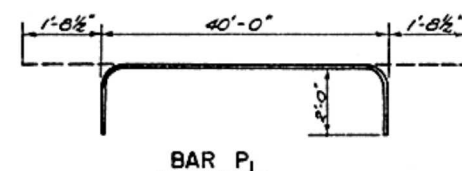

BAR P₁

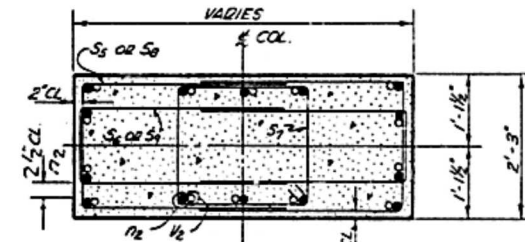


SECTION B-B

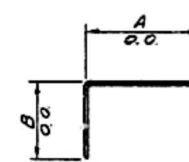


BARS

BAR	A	B
S_1	$1'-0"$	$2'-0"$
S_2	$1'-0"$	$2'-6"$
S_3	$1'-0"$	$3'-0"$
S_4	$1'-11"$	$3'-7"$
S_5	$1'-3"$	$3'-7"$
S_6	$1'-11"$	$4'-1"$
S_7	$1'-3"$	$4'-1"$
S_8	$2'-2"$	$1'-9"$
U_9	$2'-0"$	$3'-0"$

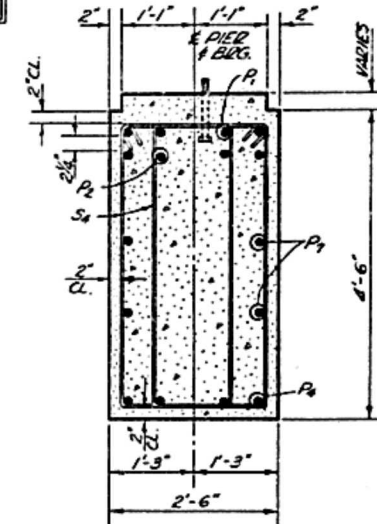 $S_1, S_2, S_3, S_5, S_6, S_8, S_9, S_{10}, U_2$ 

SECTION A-A

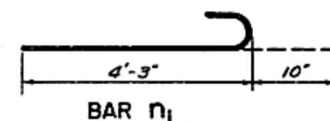

BAR n_i

BILL OF MATERIAL


BAR	NO	SIZE	LENGTH	SHAPE
S ₁	40	#5	5'-0"	U
S ₂	20	#5	6'-0"	U
S ₃	20	#5	8'-0"	U
S ₄	42	#5	12'-0"	□
S ₅	32	#4	9'-1"	□
S ₆	32	#4	8'-5"	□
S ₇	30	#4	9'-4"	□
S ₈	28	#4	10'-1"	□
S ₉	28	#4	9'-5"	□
S ₁₀	26	#6	5'-0"	□
n ₁	108	#7	5'-1"	J
n ₂	28	#11	7'-0"	—
P ₁	4	#11	43'-5"	J
P ₂	8	#11	14'-6"	—
P ₃	8	#5	7'-3"	—
P ₄	4	#9	25'-3"	—
P ₅	4	#10	25'-0"	—
P ₆	4	#10	29'-0"	—
P ₇	8	#5	21'-0"	—
U ₁	18	#5	7'-2"	—
U ₂	6	#6	8'-0"	—
N ₁	3	#6	29'-0"	—
f ₁	59	#8	10'-3"	—
h ₁	16	#5	25'-0"	—
V ₁	108	#6	9'-0"	—
V ₂	23	#11	18'-6"	—

CLASS A CONCRETE	CU YDS	79.7
REINFORCEMENT BARS	LBS	14240
CREDOSOTED PILES	LIN. FT.	1050
TEST PILE (TIMBER)	EA.	1
CLASS A EXCAV. FOR STR	CU YD	106








PIER 2 — WEST STRUCTURE
F.A.I. RTE. 74 SEC. 37-24 HVB
F.A.I. 74 OVER C.B. & Q. R.R. & S.B.I. RT. 83
HENRY CO., ILLINOIS
STA. 22 +64.70

NOTE: SPACE MAIN REIN IN CAP TO MISS ANCHOR BOLTS. ALL EDGES SHALL HAVE 3/4" CHAMFER EXCEPT FOOTINGS. POUR STEPS MONOLITHICALLY WITH CAP.

EL. BGS. PIER 3
STA. 22+86.00
CR. EL. 833.26

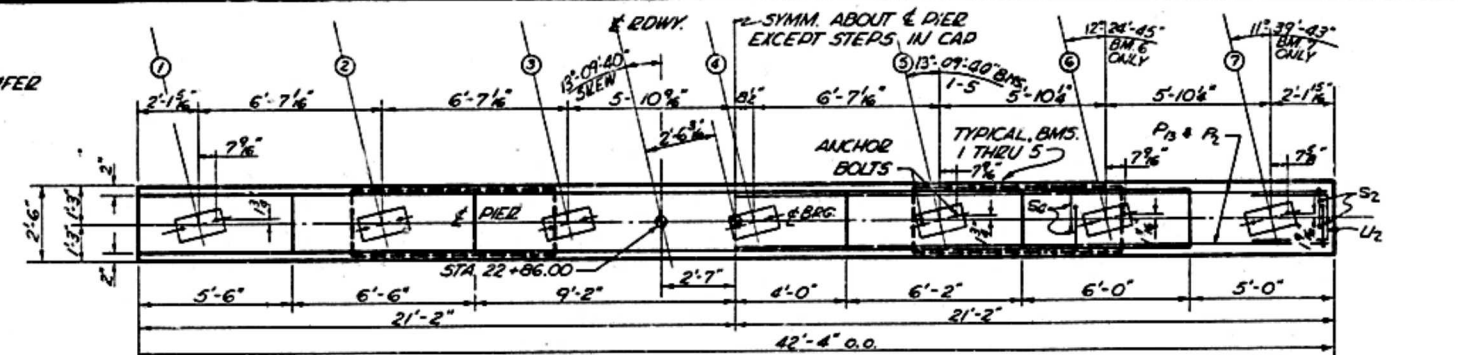




NOTE: CARE SHOULD BE TAKEN IN LAYING OUT PIER IN FIELD AS PIER AND R.D.W.Y. DO NOT COINCIDE. SEE FOOTING PLAN AND TOP PLAN.

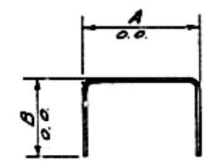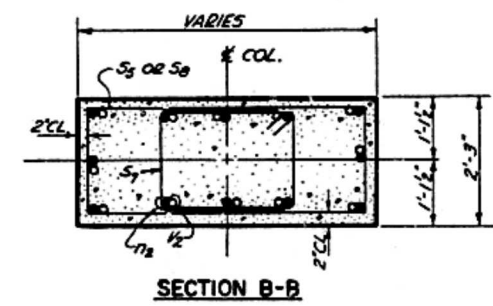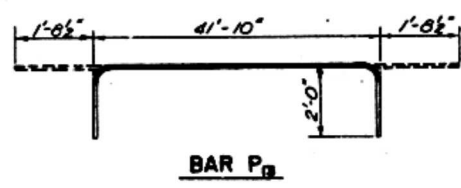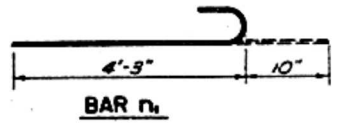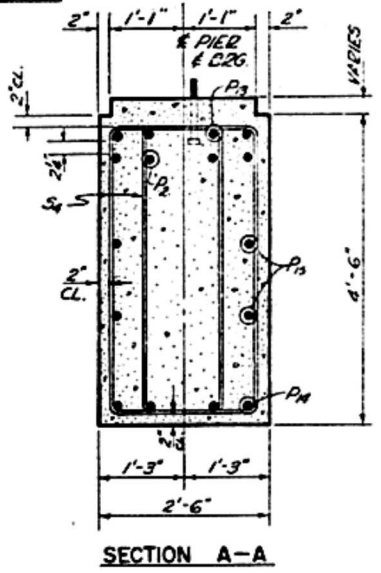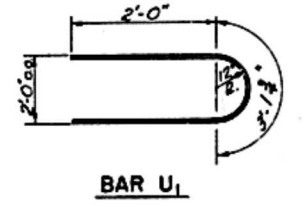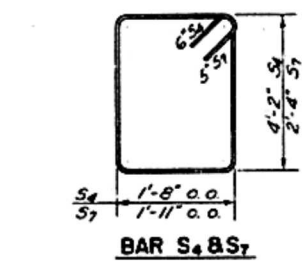


BAR	A	B
S1	1'-8"	2'-0"
S2	1'-8"	2'-6"
S3	1'-8"	3'-8"
S4	1'-11"	3'-7"
S5	1'-11"	4'-1"
U2	2'-0"	3'-0"
U3	2'-2"	4'-0"
U4	2'-2"	6'-0"

BILL OF MATERIAL				
BAR NO	SIZE	LENGTH	SHAPE	
S1	40	45	5'-0"	U
S2	20	45	6'-8"	U
S3	20	45	8'-8"	U
S4	44	44	12'-8"	U
S5	32	44	9'-1"	U
S7	30	44	9'-8"	U
S8	28	44	10'-1"	U
n1	6	47	5'-1"	U
n2	24	41	7'-0"	U
P2	8	41	14'-6"	U
P3	8	45	7'-3"	U
P4	4	41	45'-3"	U
P5	4	41	27'-3"	U
P6	8	45	22'-0"	U
P7	8	41	26'-9"	U
P8	6	40	29'-9"	U
U4	28	46	14'-2"	U
U1	12	45	7'-2"	U
U2	6	46	8'-0"	U
U3	28	47	10'-2"	U
W3	3	46	29'-9"	U
f1	55	46	8'-3"	U
f2	10	45	26'-9"	U
V3	6	46	6'-0"	U
V2	24	41	18'-6"	U
CLASS 1 CONCRETE CU YDS				69.4
REINFORCEMENT BARS LBS				11600
CREOSOTED PILES LBS				999
CLASS A EXCAV. FOR STR. CU YD				55

PIER 3 — WEST STRUCTURE
F.A.I. RTE. 74 SEC. 37-24 HVB
F.A.I. 74 OVER C.B. & Q. R.R. & S.B.I. RT. 83
HENRY CO., ILLINOIS
STA. 22+64.70

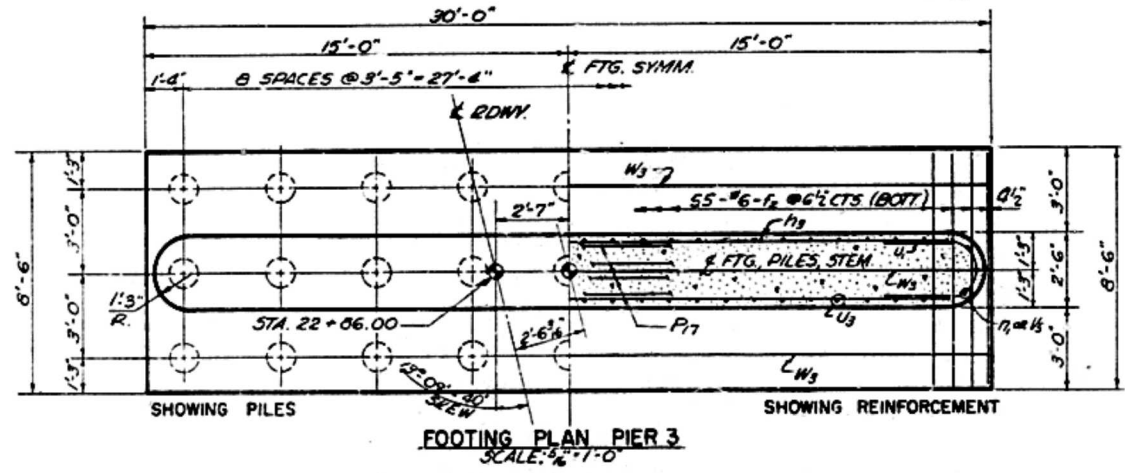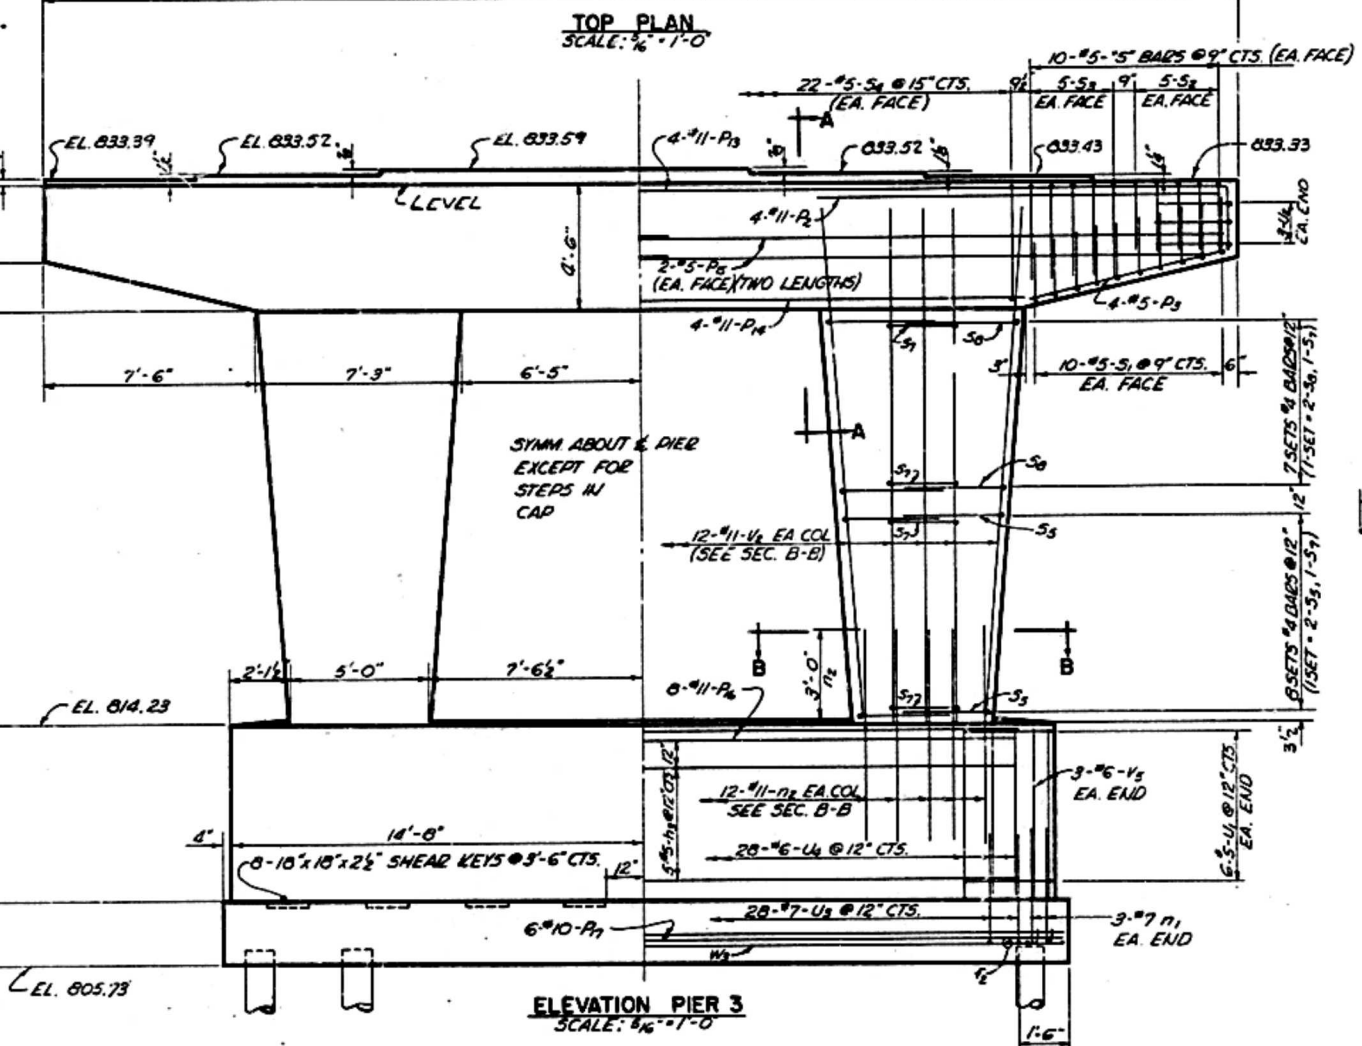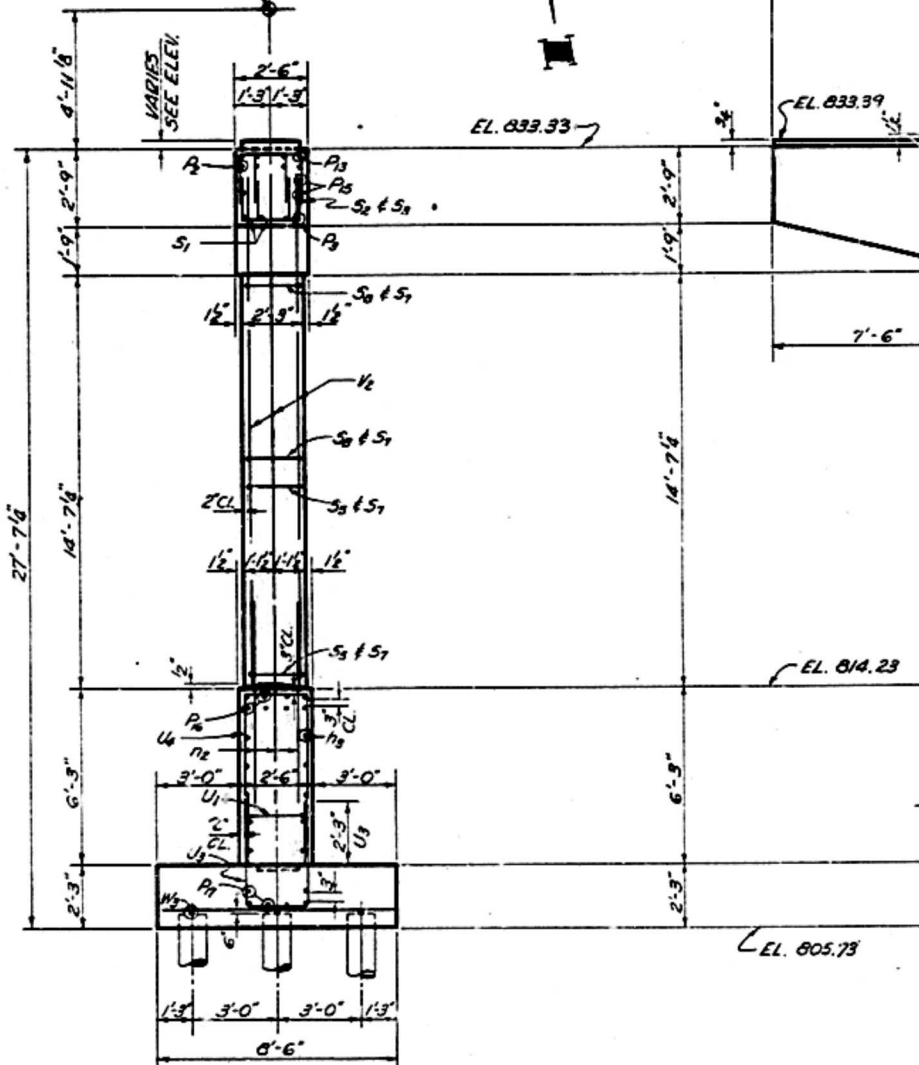

PILE DATA
TYPE: CREOSOTED TIMBER
MIN. CAPACITY: 20 TONS
EST. LENGTH: 37 FT.
NO. REQ'D.: 27

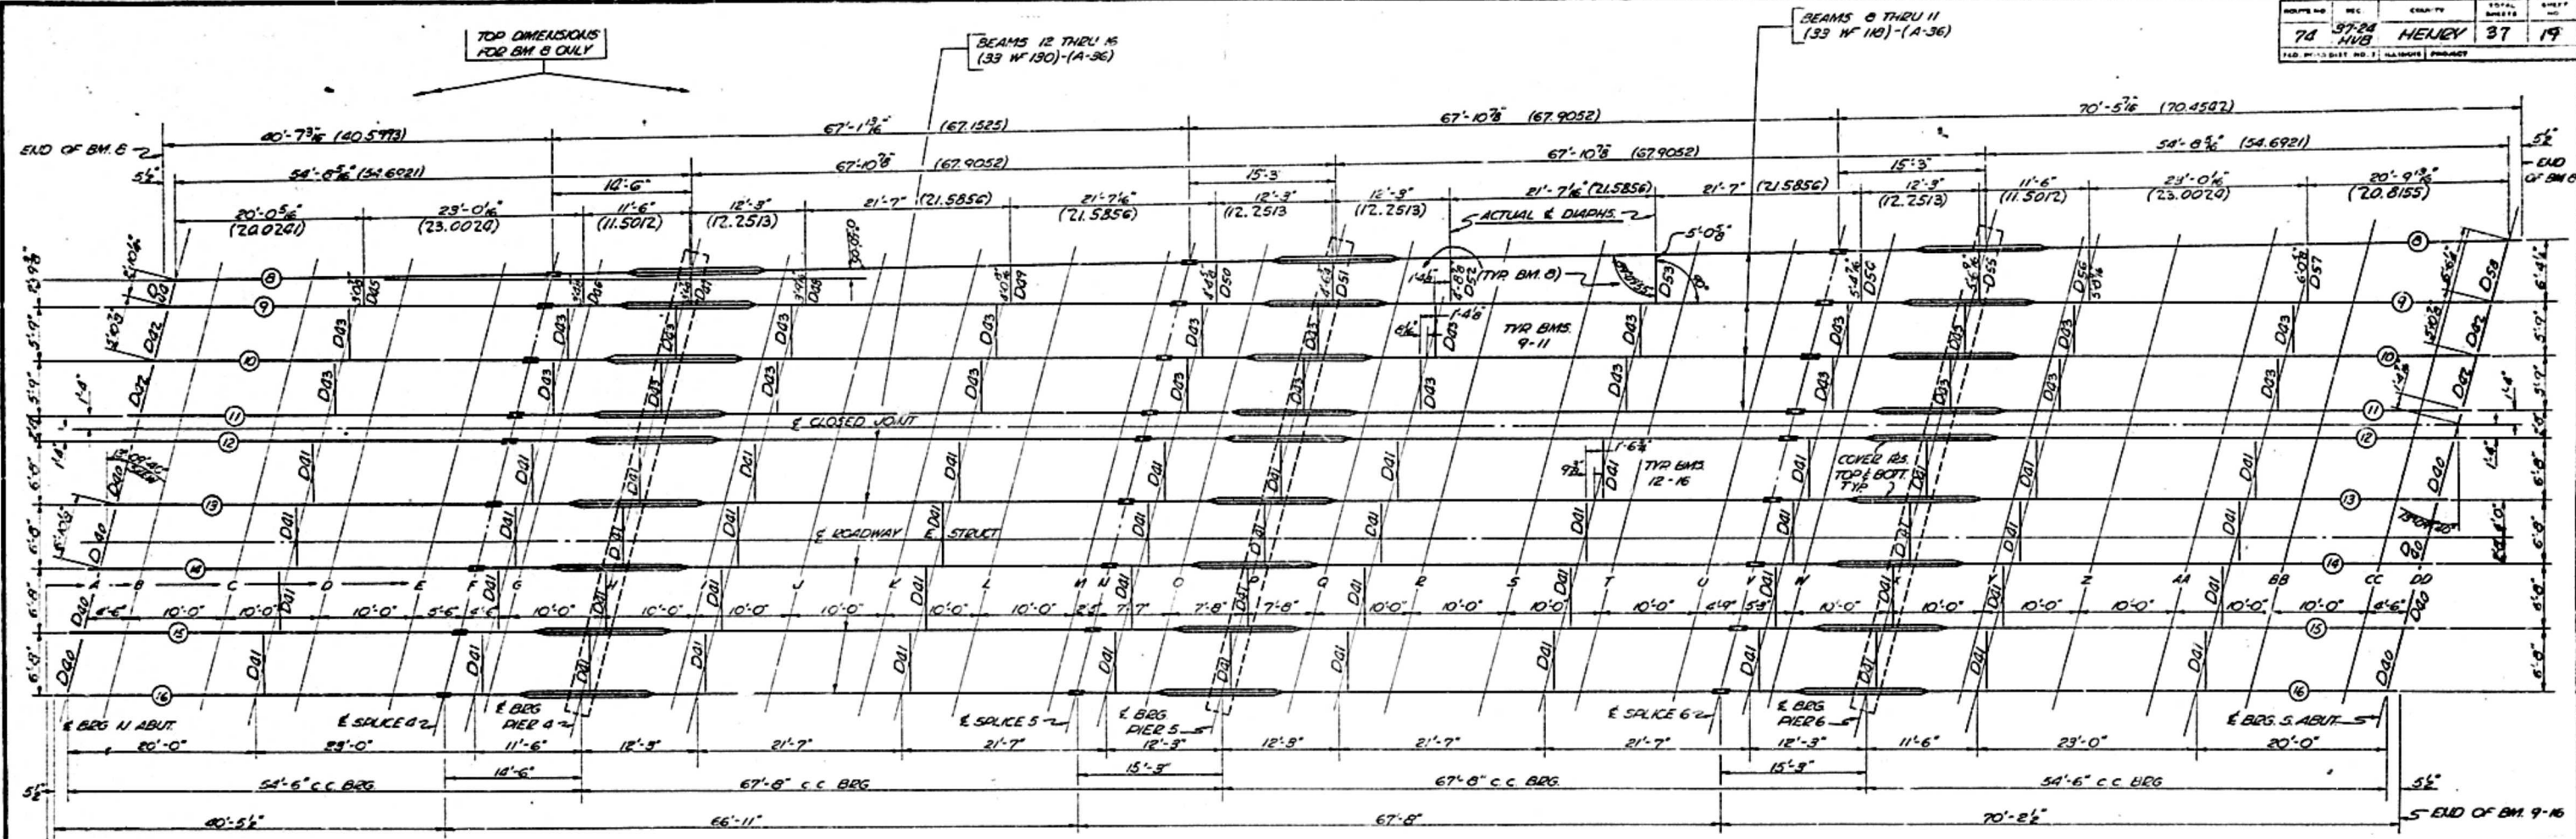

FRAMING PLAN - EAST STRUCTURE

NOTE: ALL INTERMEDIATE DIAPHRAGMS AT RT ANGLES TO E. ROADWAY. DIMENSIONS SHOWN AT DIAPHRAGMS BETWEEN BEAMS 8 & 9 ARE C. TO C. BEAMS MEASURED ALONG E. DIAPHRAGMS.

TABLE OF DEAD LOAD DEFLECTIONS


LOCATION	BM. 8	BM. 9	BM. 10	BM. 11	BM. 12	BM. 13	BM. 14	BM. 15	BM. 16
1/4 PT. SPAN 1	11 3/32	3 1/16	7 3/32	5 3/32	3 3/32	7 3/32	5 3/32	3 3/32	11 3/32
1/2 PT. SPAN 1	12 1/32	3 1/16	7 3/32	5 3/32	3 3/32	7 3/32	5 3/32	3 3/32	12 1/32
3/4 PT. SPAN 1	13 1/32	3 1/16	7 3/32	5 3/32	3 3/32	7 3/32	5 3/32	3 3/32	13 1/32
1/4 PT. SPAN 2	5 3/32	3 1/16	7 3/32	5 3/32	3 3/32	7 3/32	5 3/32	3 3/32	5 3/32
1/2 PT. SPAN 2	6 1/32	3 1/16	7 3/32	5 3/32	3 3/32	7 3/32	5 3/32	3 3/32	6 1/32
3/4 PT. SPAN 2	7 1/32	3 1/16	7 3/32	5 3/32	3 3/32	7 3/32	5 3/32	3 3/32	7 1/32
1/4 PT. SPAN 3	17 3/32	3 1/16	7 3/32	5 3/32	3 3/32	7 3/32	5 3/32	3 3/32	17 3/32
1/2 PT. SPAN 3	18 1/32	3 1/16	7 3/32	5 3/32	3 3/32	7 3/32	5 3/32	3 3/32	18 1/32
3/4 PT. SPAN 3	19 1/32	3 1/16	7 3/32	5 3/32	3 3/32	7 3/32	5 3/32	3 3/32	19 1/32
1/4 PT. SPAN 4	3 3/32	3 1/16	7 3/32	5 3/32	3 3/32	7 3/32	5 3/32	3 3/32	3 3/32
1/2 PT. SPAN 4	4 1/32	3 1/16	7 3/32	5 3/32	3 3/32	7 3/32	5 3/32	3 3/32	4 1/32
3/4 PT. SPAN 4	5 1/32	3 1/16	7 3/32	5 3/32	3 3/32	7 3/32	5 3/32	3 3/32	5 1/32

* ELEVATIONS OF TOP OF WF BEAMS


LOCATION	BM. 8	BM. 9	BM. 10	BM. 11	BM. 12	BM. 13	BM. 14	BM. 15	BM. 16
E. BRG. 11 ABUT.	837.21	837.32	837.44	837.56	837.61	837.70	837.70	837.64	837.50
E. SPALICE 4	837.21	837.32	837.44	837.56	837.61	837.70	837.70	837.64	837.50
E. PIER 4	837.21	837.32	837.44	837.56	837.61	837.70	837.70	837.64	837.50
E. SPALICE 5	837.21	837.32	837.44	837.56	837.61	837.70	837.70	837.64	837.50
E. PIER 5	837.18	837.29	837.41	837.53	837.59	837.67	837.67	837.61	837.47
E. SPALICE 6	837.09	837.19	837.31	837.43	837.48	837.57	837.57	837.51	837.37
E. PIER 6	837.09	837.19	837.31	837.43	837.48	837.57	837.57	837.51	837.37
E. BRG. 5 ABUT.	836.87	836.98	837.10	837.22	837.27	837.36	837.36	837.30	837.16

* ELEVATIONS REFER TO TOP OF TOP FLANGES OF ACTUAL ROLLED BEAMS. DOES NOT INCLUDE SPLICE PLATE OR COVER PLATES. THESE ELEVATIONS ARE THEORETICAL AND ARE TO BE USED FOR FABRICATION OF STRUCTURAL STEEL AND DO NOT INCLUDE ANY ALLOWANCE FOR DEFLECTION.

GRADE ELEVATIONS ADJUSTED FOR DEAD LOAD DEFLECTIONS									
LOCATION	BM. 8	BM. 9	BM. 10	BM. 11	BM. 12	BM. 13	BM. 14	BM. 15	BM. 16
A	837.87	837.93	838.05	838.16	838.21	838.30	838.30	838.23	838.10
B	837.87	837.94	838.06	838.18	838.23	838.31	838.32	838.24	838.12
C	837.92	837.97	838.09	838.20	838.25	838.34	838.35	838.27	838.15
D	837.93	837.98	838.10	838.22	838.27	838.36	838.36	838.29	838.17
E	837.93	837.98	838.11	838.22	838.27	838.36	838.36	838.29	838.17
F	837.92	837.99	838.11	838.22	838.27	838.36	838.36	838.29	838.17
G	837.92	837.99	838.11	838.22	838.27	838.36	838.36	838.30	838.17
H	837.91	837.99	838.10	838.22	838.27	838.36	838.37	838.30	838.16
I	837.92	837.99	838.12	838.23	838.28	838.37	838.38	838.31	838.18
J	837.94	838.00	838.13	838.24	838.29	838.38	838.39	838.32	838.20
K	837.94	838.01	838.13	838.24	838.29	838.38	838.40	838.33	838.21
L	837.93	838.00	838.12	838.24	838.29	838.38	838.39	838.32	838.21
M	837.91	837.98	838.11	838.22	838.27	838.37	838.38	838.31	838.19
N	837.90	837.98	838.10	838.22	838.27	838.36	838.37	838.30	838.18
O	837.87	837.96	838.08	838.20	838.26	838.34	838.35	838.29	838.16
P	837.85	837.95	838.07	838.19	838.24	838.33	838.34	838.27	838.14
Q	837.85	837.94	838.06	838.18	838.24	838.32	838.33	838.27	838.14
R	837.85	837.94	838.06	838.18	838.23	838.32	838.33	838.27	838.15
S	837.84	837.93	838.05	838.16	838.22	838.31	838.32	838.25	838.14
T	837.81	837.90	838.03	838.14	838.19	838.29	838.30	838.24	838.12
U	837.77	837.87	838.00	838.11	838.17	838.26	838.27	838.21	838.09
V	837.74	837.85	837.97	838.09	838.15	838.24	838.25	838.19	838.06
W	837.72	837.83	837.96	838.08	838.13	838.22	838.23	838.17	838.05
X	837.68	837.79	837.92	838.04	838.10	838.19	838.20	838.13	838.01
Y	837.65	837.77	837.89	838.01	838.07	838.16	838.17	838.11	837.99
Z	837.62	837.74	837.87	837.99	838.04	838.13	838.15	838.08	837.97
AA	837.60	837.71	837.84	837.95	838.01	838.10	838.12	838.06	837.94
BB	837.55	837.67	837.79	837.91	837.97	838.06	838.08	838.01	837.90
CC	837.48	837.61	837.74	837.86	837.92	838.01	838.03	837.96	837.84
DD	837.45	837.59	837.71	837.84	837.89	837.98	838.00	837.94	837.81

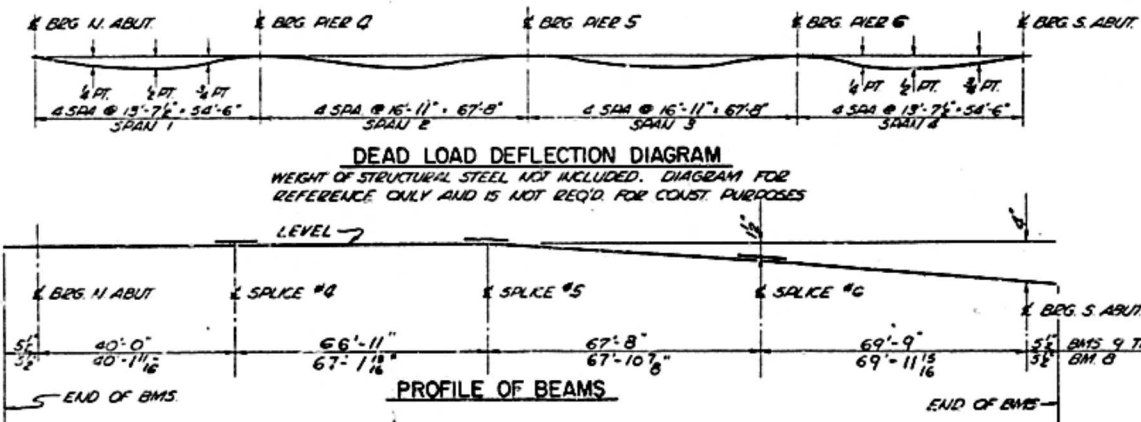

STRUCTURAL STEEL - EAST STRUCTURE
F.A.I. RTE. 74 SEC. 37-24 HVB
F.A.I. 74 OVER C.B. & O. R.R. & S.B.I. RT. 83
HENRY CO., ILLINOIS
STA. 22+64.70

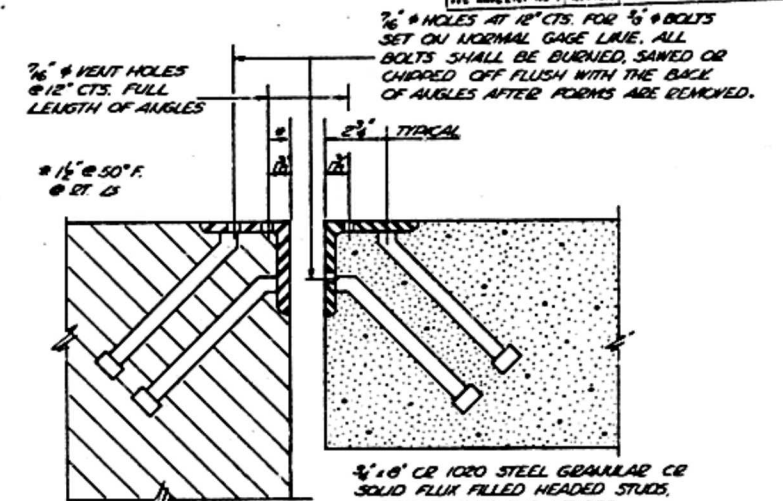

SECTION C-C


NOTE: ROADWAY EXPANSION GUARD SHALL BE FABRICATED TO FIT THE ROADWAY. GUARD SHALL BE ASSEMBLED IN PROPER POSITION IN SHOP FOR INSPECTION. ALL EXPOSED SURFACES SHALL BE GIVEN TWO SHOP COATS OF RED LEAD PAINT. THE CONTACT SURFACES SHALL BE GIVEN ONE COAT OF RED LEAD PAINT. ANCHOR STUDS SHALL NOT BE PAINTED. EST. WEIGHT OF STRUCTURAL STEEL REQUIRED FOR EXPANSION GUARDS = 2460 LBS. THE WEIGHTS OF THE ANGLES AND STUDS ARE INCLUDED IN THE QUANTITY OF STRUCTURAL STEEL.

In L. 20 of shop rivets,
angles may be attached
in the shop with $\frac{3}{4}$ " high strength
bolts or $\frac{1}{4}$ " C.F.R.


Bearings and Anchorage

The location of the anchor bolts and vertical alignment of the expansion bearings shall be adjusted to the temperature at the time of erection. See Art. 5.4.9(f)


Anchor Bolts shall be grouted into drilled holes after bedrms are in place, or bolts at fixed pier may be built into the masonry

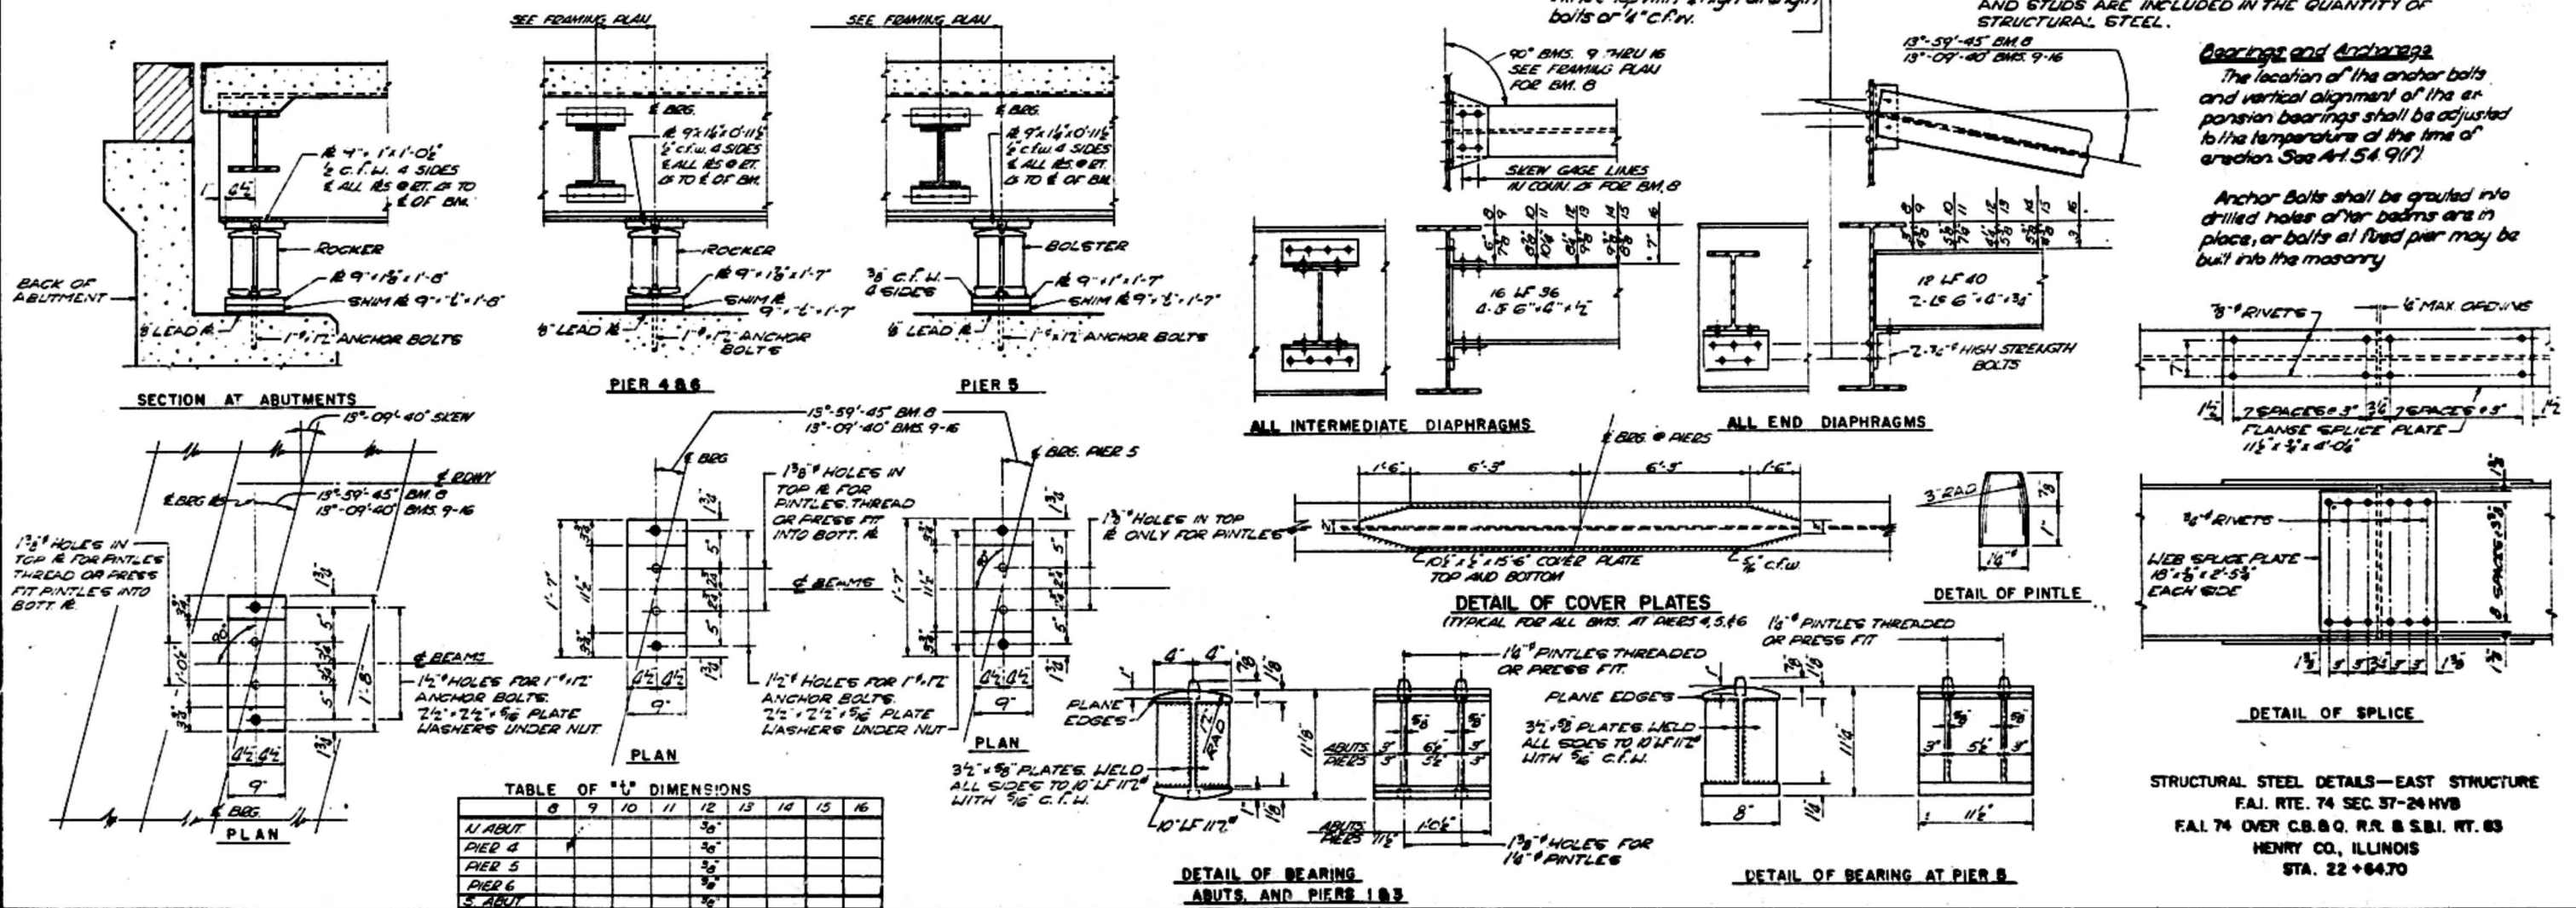

STRUCTURAL STEEL DETAILS—EAST STRUCTURE
F.A.I. RTE. 74 SEC. 37-24 NVD
F.A.I. 74 OVER C.B. & O. R.R. & S.B.I. RT. 63
HENRY CO., ILLINOIS
STA. 22 + 64.70

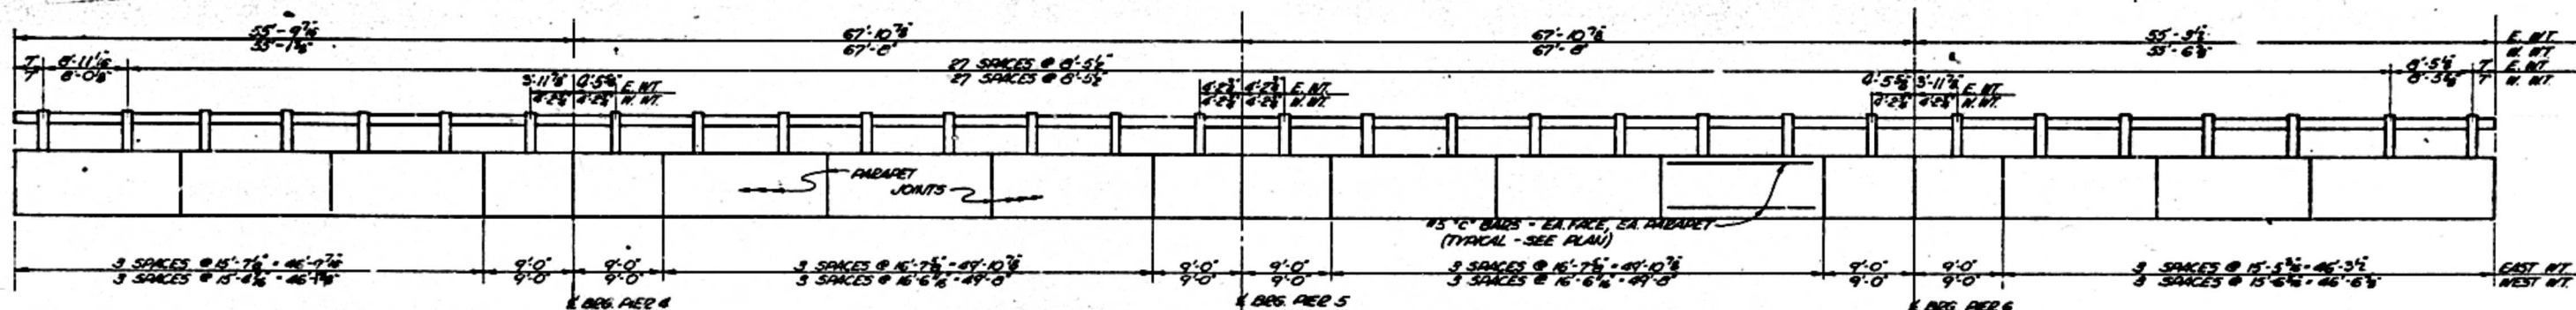


ELEVATION OF HANDRAIL AND PARAPET - EAST STRUCTURE

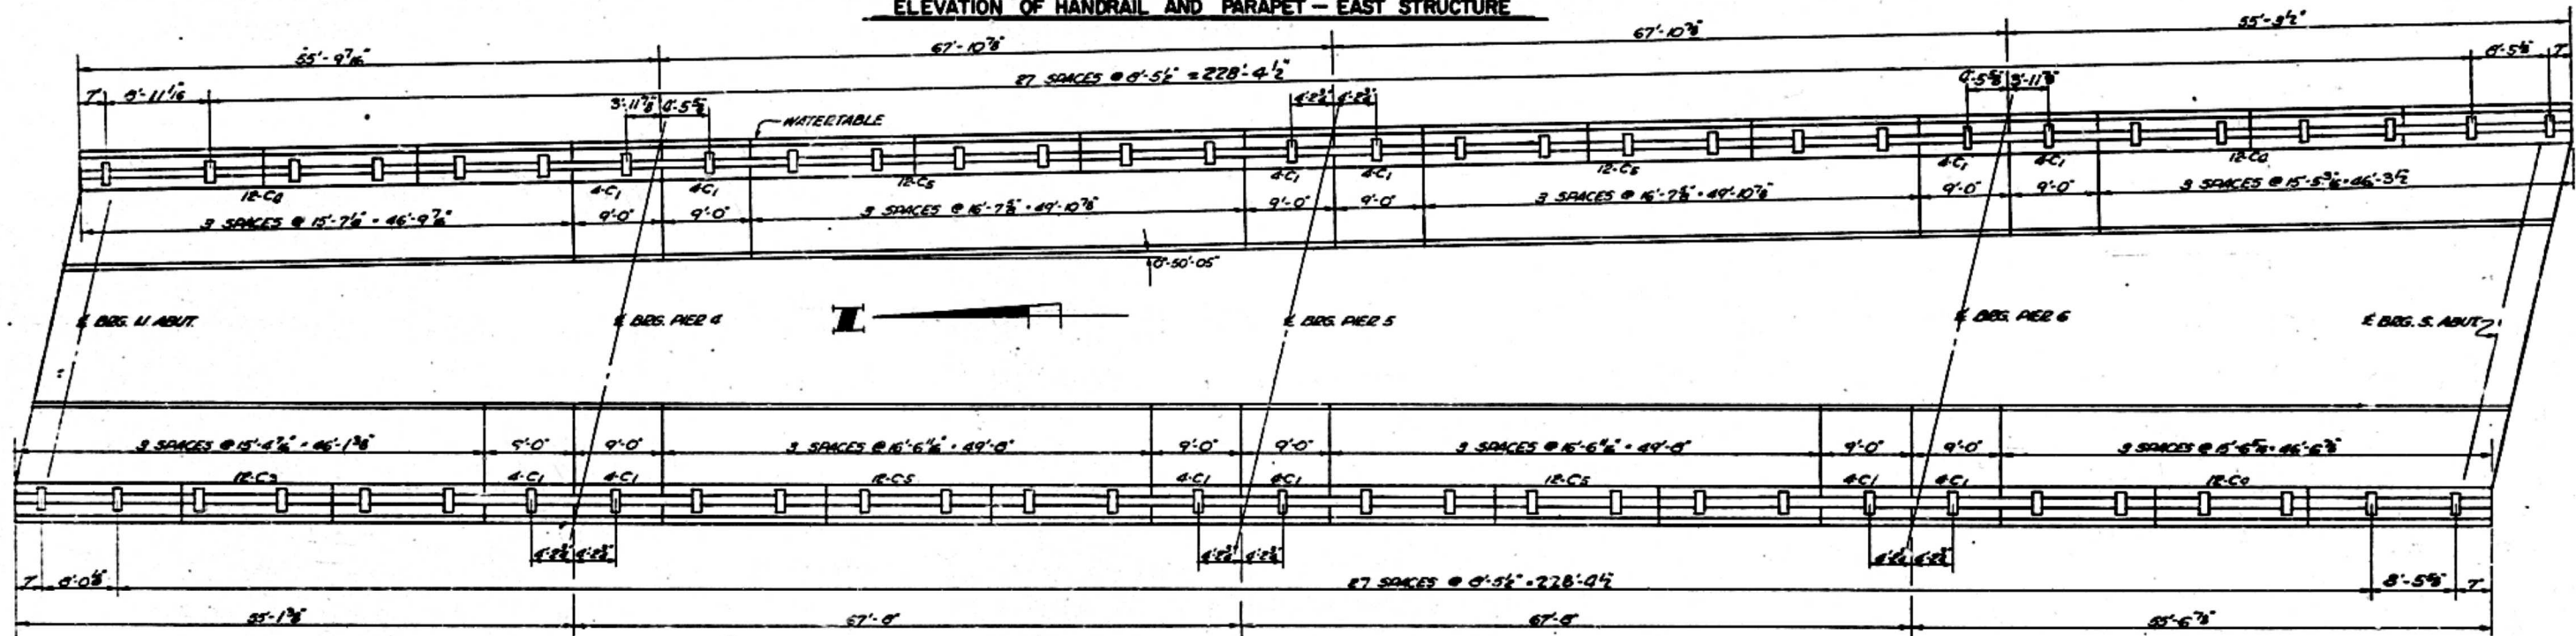


PLAN OF HANDRAIL AND PARAPET - EAST STRUCTURE


For Details See Sheet # 24A of 37

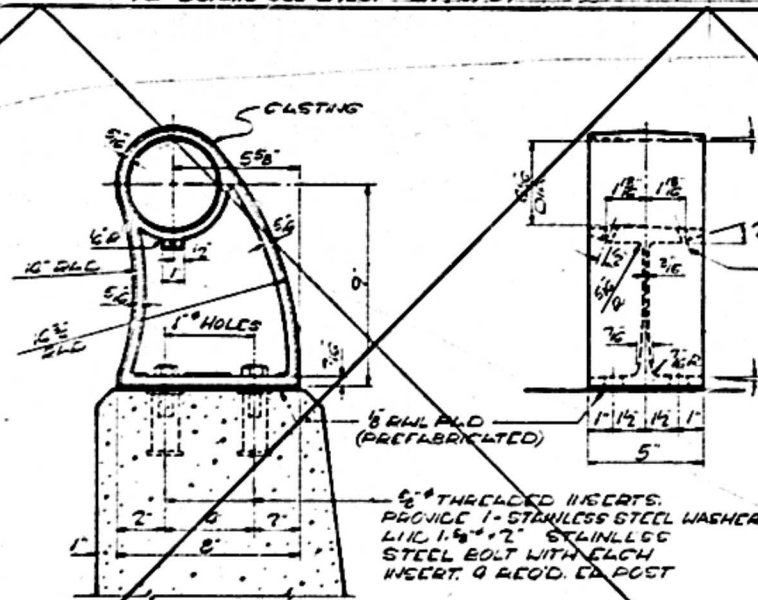


RAIL POST DETAILS

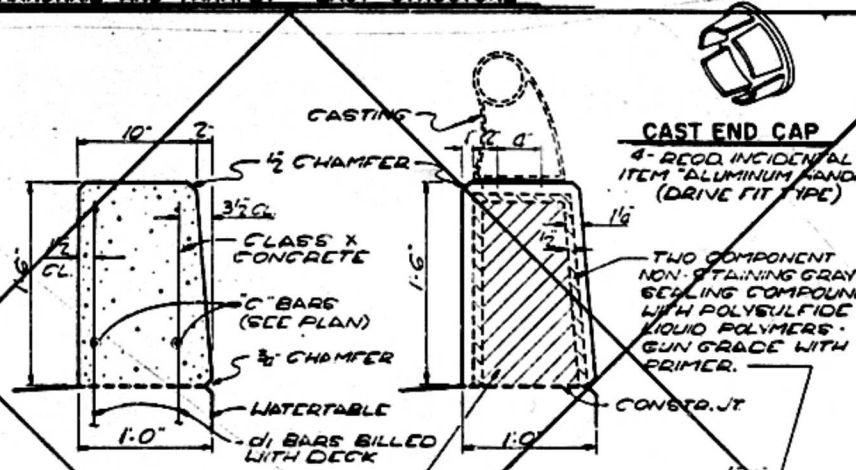

DETAIL OF PARAPET

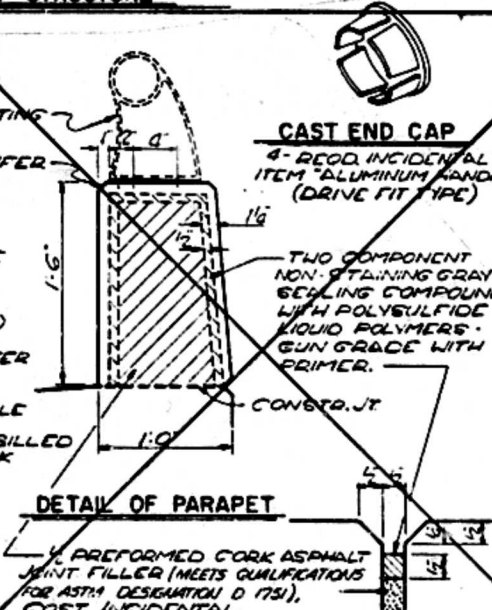

DETAIL OF PARAPET

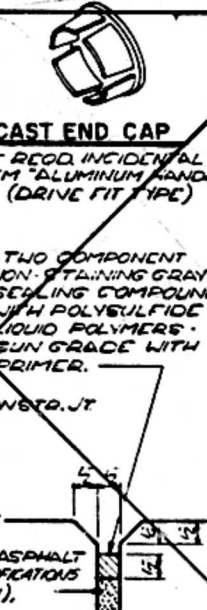

JOINT DETAIL

GENERAL NOTES.
 ALL POSTS SHALL BE PLACED NORMAL TO PARAPET
 ALL POSTS SHALL BE OF ALUMINUM CONFORMING
 TO A.S.T.M. SPECIFICATION B-108 ALLOY 6061-T6
 ALL RAIL TUBING SHALL BE OF ALUM. CONFORMING
 TO A.S.T.M. SPECIFICATION B-235 ALLOY 6061 OR
 6062-T6.
 RAIL TUBING MAY EXTEND A MAX OF 3 PANEL LENGTH
 FOR MATERIAL COMPOSITION OF PREFABRICATED
 PAD SEE ARTICLE 56.9.1 (BEARINGS & ANCHORAGE)
 OF THE STANDARD SPECIFICATIONS.
 SET SCREWS SHALL BE OF ALUMINUM
 CONFORMING TO A.S.T.M. SPECIFICATION B-211
 ALLOY 2024-T3.
 ALUMINUM HANDRAIL SHALL BE MEASURED IN LIN. FT.
 THE LENGTH PAID FOR SHALL BE THE OVERALL LENGTH
 ALONG THE TOP LONGITUDINAL RAILING MEMBER
 THROUGH ALL POSTS AND GAPS.
 ALUMINUM HANDRAIL WILL BE PAID FOR AT THE CONTRACT
 UNIT PRICE PER LIN. FT. FOR ALUMINUM HANDRAIL, MEASURED
 AS SPECIFIED, WHICH PRICE SHALL BE PAYMENT IN FULL FOR
 ALL MATERIALS, FABRICATION, TRANSPORTATION & ERECTION.

BILL OF MATERIAL

BAR	NO.	SIZE	LENGTH	SHAPE
C1	40	#5	8'-9"	
C2	12	#5	15'-0"	
C3	36	#5	8'-3"	
C4	40	#5	15'-6"	
CLASS X CONCRETE CYDS				25.1
REINFORCEMENT BARS LBS				2020
ALUMINUM HANDRAIL LIN. FT.				493

EAST STRUCTURE
 HANDRAIL & PARAPET DETAILS
 F&I RTE. 74 SEC. 37-24 HVB
 F&I 74 OVER C.B. & O. R.R. & S.B. RT. 83
 HENRY CO., ILLINOIS
 STA. 22+64.70

ROUTE NO.	SECTION	LENGTH	TOTAL SHEETS	SHEET NO.
F.S. 1 P. 2 76	3726 HVB	HENRY	57	21A
FED. ROAD DIST. NO. 7		ALIGNMENT	FED. AID PROJECT	

[illegible]

SECTION A-A

RAIL POST DETAILS

DESIGNED
CHECKED
DRAWN <i>Wm. M. Best</i>
CHECKED

April 12, 1965
EXAMINED Carl E. Hummer
COMMISSIONER OF BRIDGE AND TRAFFIC STRUCTURES
PASSED H. J. Alton
DESIGNED BY DESIG-
APPROVED H. J. Alton
BY H. J. Alton

Note: Seal perimeter of base of post to parapet with two component non-staining gray sealing compound with polysulfide liquid polymers - gun grade with primer.

SEC. THRU ELLIPTICAL
RAIL SECTION

SEC THRU SPLICE

RAIL SPLICE

Two component non-staining gray
sealing compound with polysulfide
liquid polymers — gun grade
with primer.

PARAPET JOINT DETAIL

5 Preformed Cork
Asphalt Joint Filler.
(meets qualifications for
ASTM Designation D 1751)
Cost incidental.

NOTES:

All Posts shall be normal to parapet.

All Aluminum Alloy Extruded Rail shall conform to ASTM specification B-235 alloy 6061-T6, or 6062-T6, and shall extend a minimum of 2 panel lengths (attached to minimum of 3 posts) except at ends or at open joints where a minimum of 1 panel length is required. All joints in railing must be spliced per detail.

See Special Provisions for following Material Specifications:

Cast Aluminum Alloy Bridge Post—Alloy 344-T4.

Stainless Steel Welded Stud Bolts, Washers, and Locknuts
Fabric Bearing Pad.

METHOD of MEASUREMENT: Aluminum handrail shall be measured in lineal feet. The length paid for shall be the over all length along the top longitudinal railing member thru all posts and gaps.

BASIS of PAYMENT: Aluminum handrail shall be paid for at the contract unit price per lineal foot for ALUMINUM HANDRAIL, measured as specified, which price shall be payment in full for all materials, fabrication, transportation, and erection.

Cost of rail splice, end caps, and hardware to be incidental to item ALUMINUM HANDRAIL.

Provide 1-3 and 2-1/2 Aluminum Spins for 25 % of the Posts. Rail element shall be parallel to Grade-high Spots shall be ground and low spots shall be shimmed.

ELEVATION - END POST

SEC. THRU CURB


BILL OF MATERIAL

Item	Unit	Quantity
ALUMINUM HANDRAIL	Lin. Ft.	493


ALUMINUM HANDRAIL

EAST STRUCTURE
FAL 74 SEC 37 24 HVB
HENRY COUNTY
STA 22+64.70


SECTION A-A

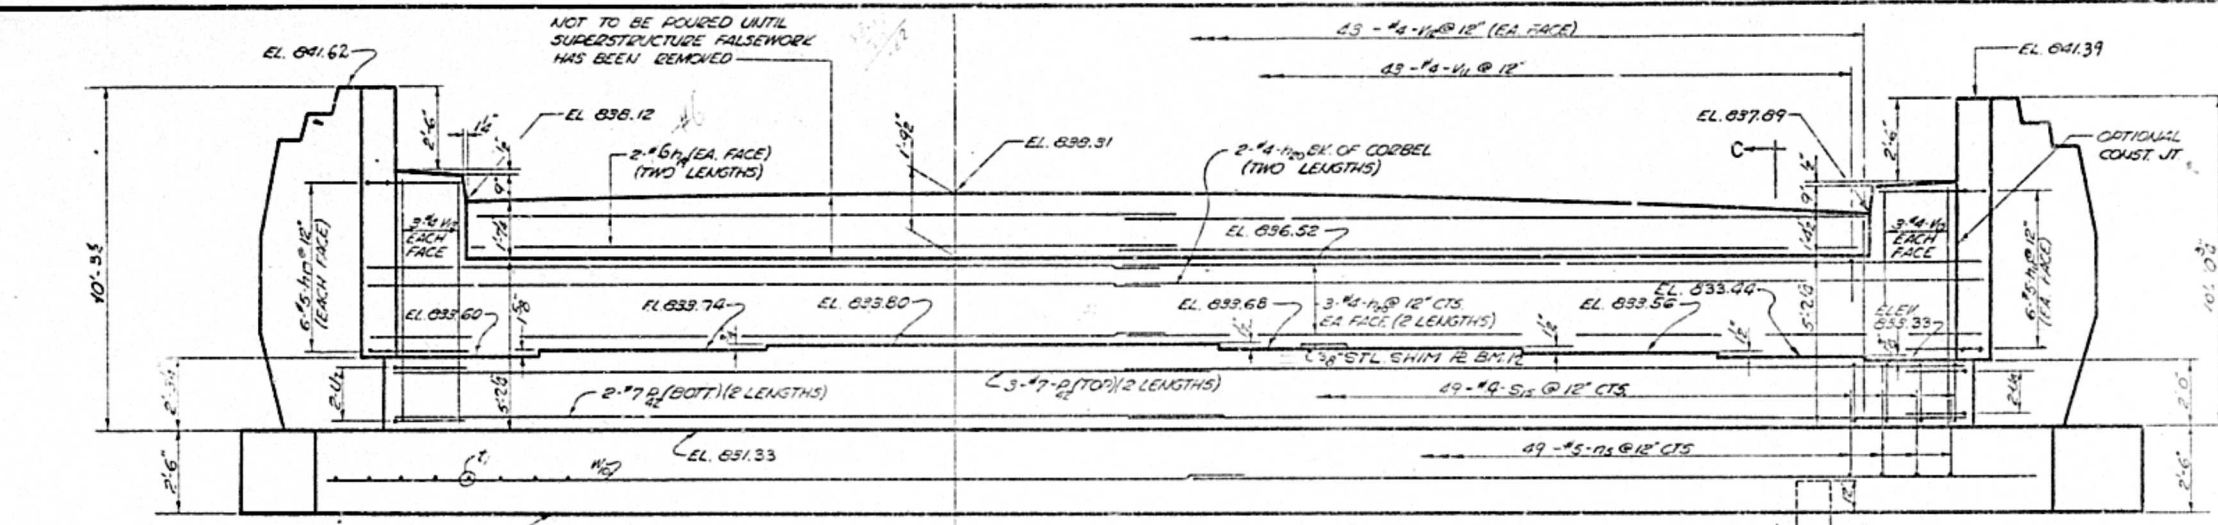


ELEVATION
(AT RT. 1 TO E. ROADWAY)

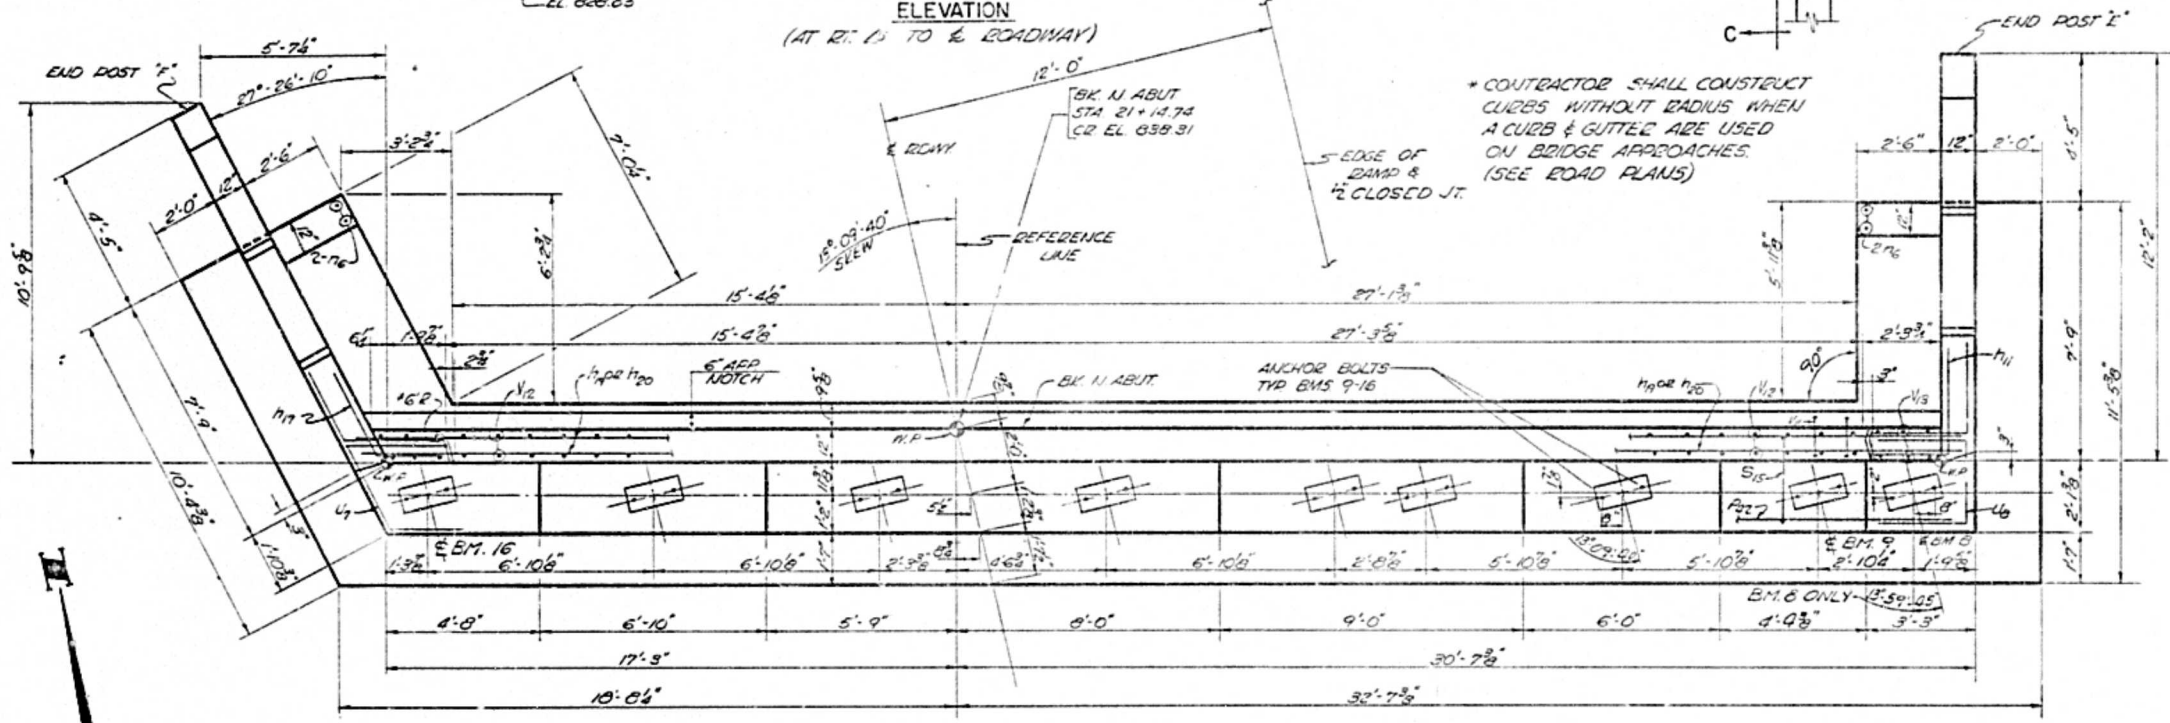


TOP PLAN
SCALE: 3/8\"/>

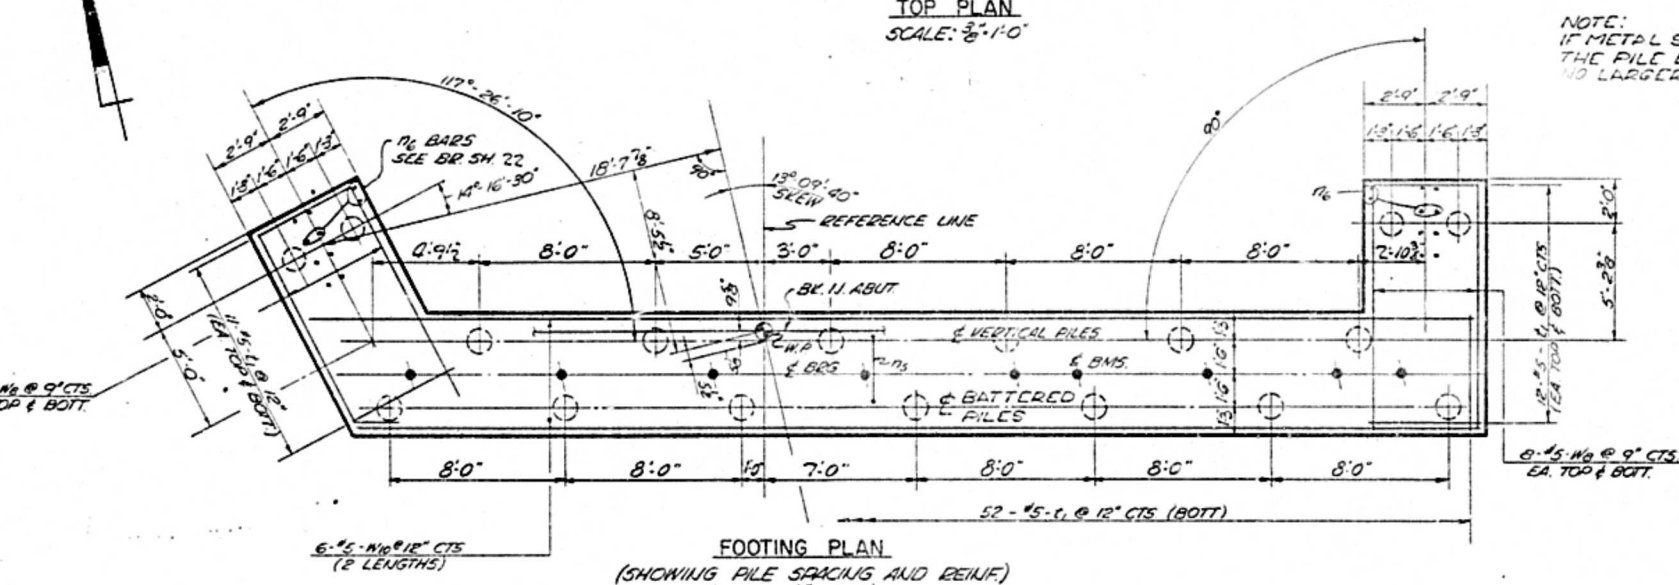

FOOTING PLAN
(SHOWING PILE SPACING AND REINIF.)
SCALE: 3/8\"/>

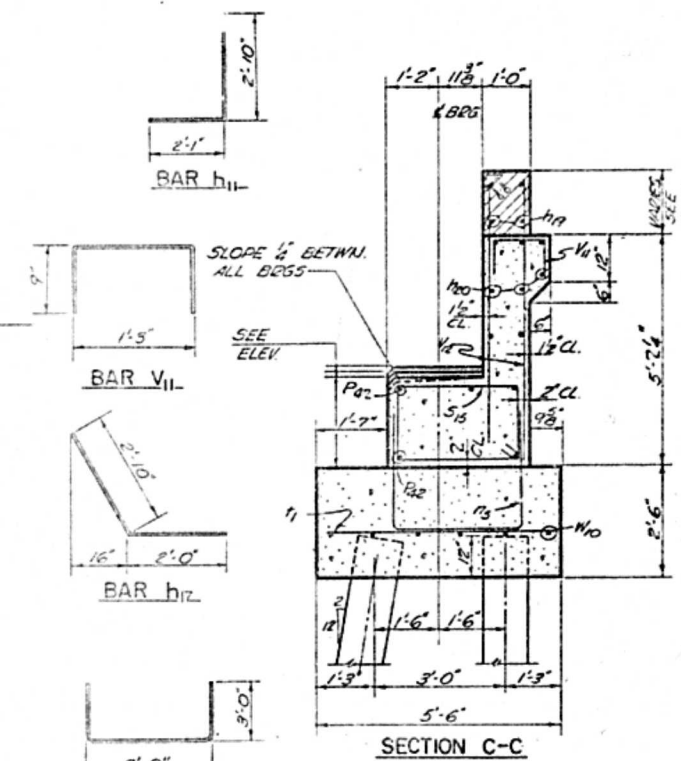

SECTION C-C

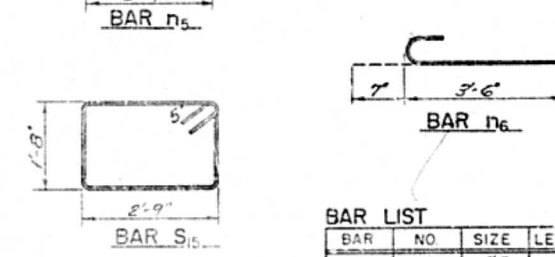


BAR LIST

BAR NO.	SIZE	LENGTH	SHAPE
h11	12	45	4'11"
h12	12	45	4'10"
h13	8	40	22'0"
h14	16	40	25'0"
h15	49	45	8'9"
h16	36	45	8'7"
h17	10	47	25'9"
h18	2	46	9'11"
h19	2	46	8'8"
h20	98	45	5'3"
h21	49	44	9'8"
h22	43	44	2'9"
h23	86	44	6'3"
h24	12	44	7'0"
h25	32	45	10'6"
h26	12	45	27'0"

BILL OF MATERIALS

ITEM	UNIT	QUAN.
CLASS X CONCRETE	CU. YDS	59.5
REINFORCEMENT BARS	LBS	4300
CONCRETE PILES	LINEAL FT.	1000
TEST PILE (CONCRETE)	EACH	1

NOTE: BILL OF MATERIAL INCLUDES REINFORCEMENT BARS AND CLASS X CONCRETE FOR END POSTS

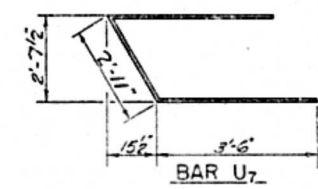


PILE DATA

TYPE	CONCRETE
MIN. CAPACITY:	05 TONS
EST. LENGTH:	65 FT.
NO. REQD.:	16 1/2 TEST PILE

NORTH ABUTMENT — EAST STRUCTURE
F.A.I. RTE. 74 SEC. 37-24 HVB
F.A.I. 74 OVER C.B. & Q. RR. & S.B.I. RT. 83
HENRY CO. ILLINOIS
STA. 22+64.70

**SOUTH ABUTMENT — EAST STRUCTURE
FAL RTE. 74 SEC 37-34 HWB
FAL 74 OVER C.B.&Q. R.R. & S.B.J. RT. 63
HENRY CO., ILLINOIS
STA. 22+64.70**

NOTE: CARE SHOULD BE TAKEN IN LAYING OUT PIER IN FIELD AS PIER AND R. ROWY. DO NOT COINCIDE. SEE FOOTING PLAN AND TOP PLAN.





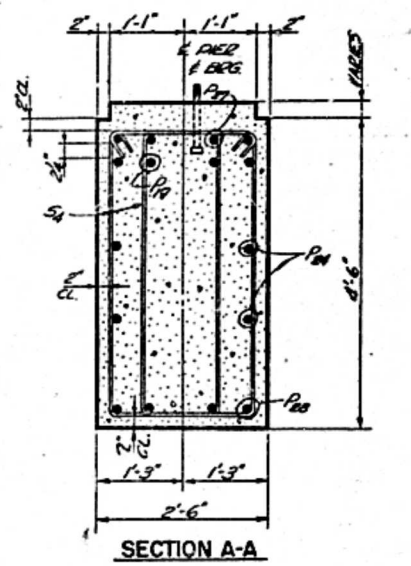


BILL OF MATERIALS

BAR NO	SIZE	LENGTH	SHAPE
S1	36	5'-8"	□
S2	16	6'-8"	□
S3	20	5'-4"	□
S4	72	12'-8"	□
S5	42	9'-1"	□
S6	36	9'-4"	□
S7	36	5'-8"	□
S8	30	8'-3"	□
S9	60	5'-1"	□
S10	36	7'-0"	□
S11	4	52'-7"	□
S12	8	13'-0"	□
S13	8	6'-6"	□
S14	4	36'-0"	□
S15	8	26'-0"	□
S16	4	36'-6"	□
S17	4	39'-6"	□
S18	22	7'-8"	□
S19	6	8'-0"	□
S20	3	39'-6"	□
S21	41	8'-3"	□
S22	40	19'-0"	□
S23	30	10'-9"	□
S24	36	15'-3"	□

CLASS 1 CONCRETE CU YDS 104.5
REINFORCEMENT BARS LBS. 14270
CORRODED PILES LIN. FT. 1155
CLASS A EXCAV. FOR STR. C.Y. 96




PIER 4 - EAST STRUCTURE
F.A.I. RTE. 74 SEC. 37-24 HVB
F.A.I. 74 OVER C.B. & Q. R.R. & S.B.I. RT. 83
HENRY CO., ILLINOIS
STA. 22+64.70

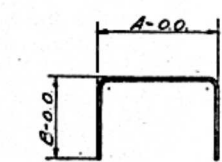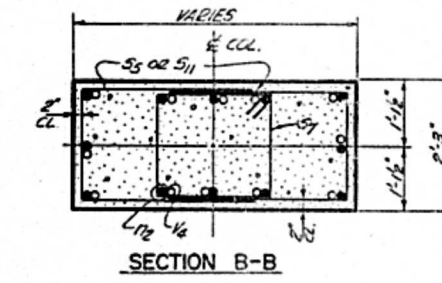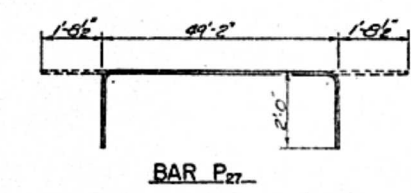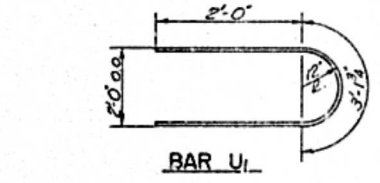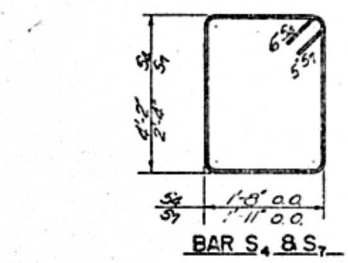

BARS


BAR	A	B
S1	1'-8"	2'-0"
S2	1'-8"	2'-6"
S3	1'-8"	3'-0"
S4	1'-11"	3'-7"
S5	2'-2"	1'-9"
S6	1'-11"	3'-2"
U1	2'-0"	3'-0"

S1, S2, S3, S4, S5, S6, S7, S8, S9, S10, S11, U2.

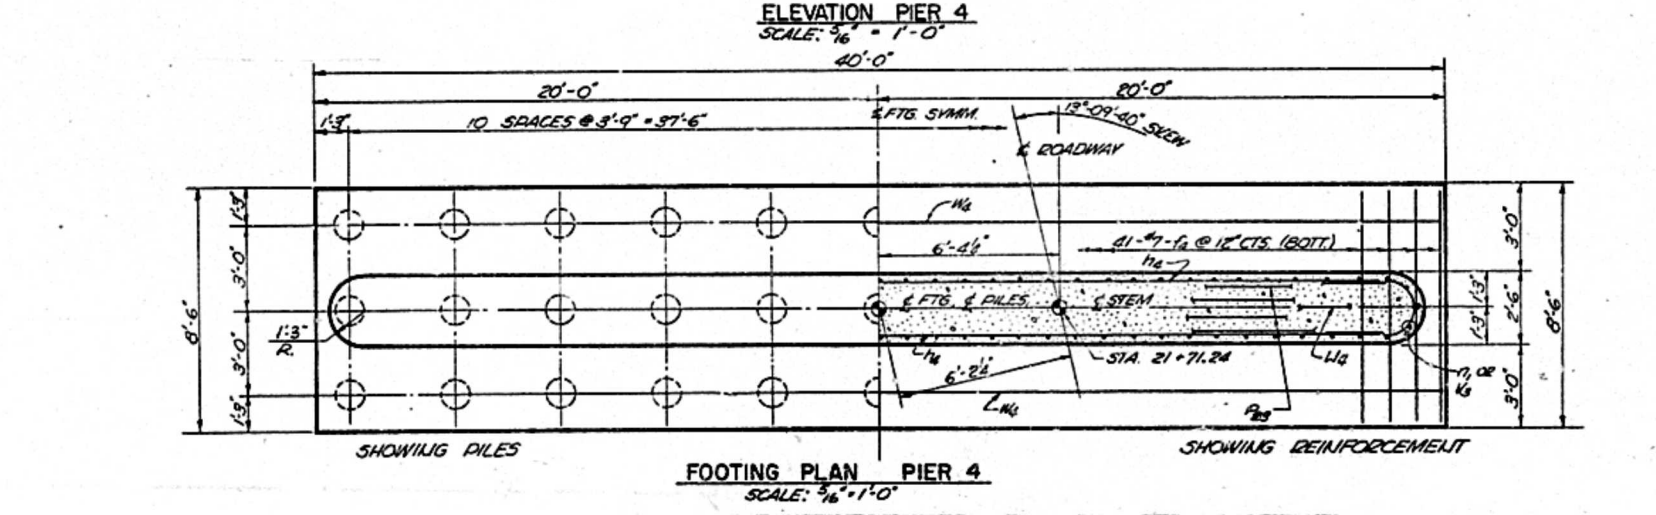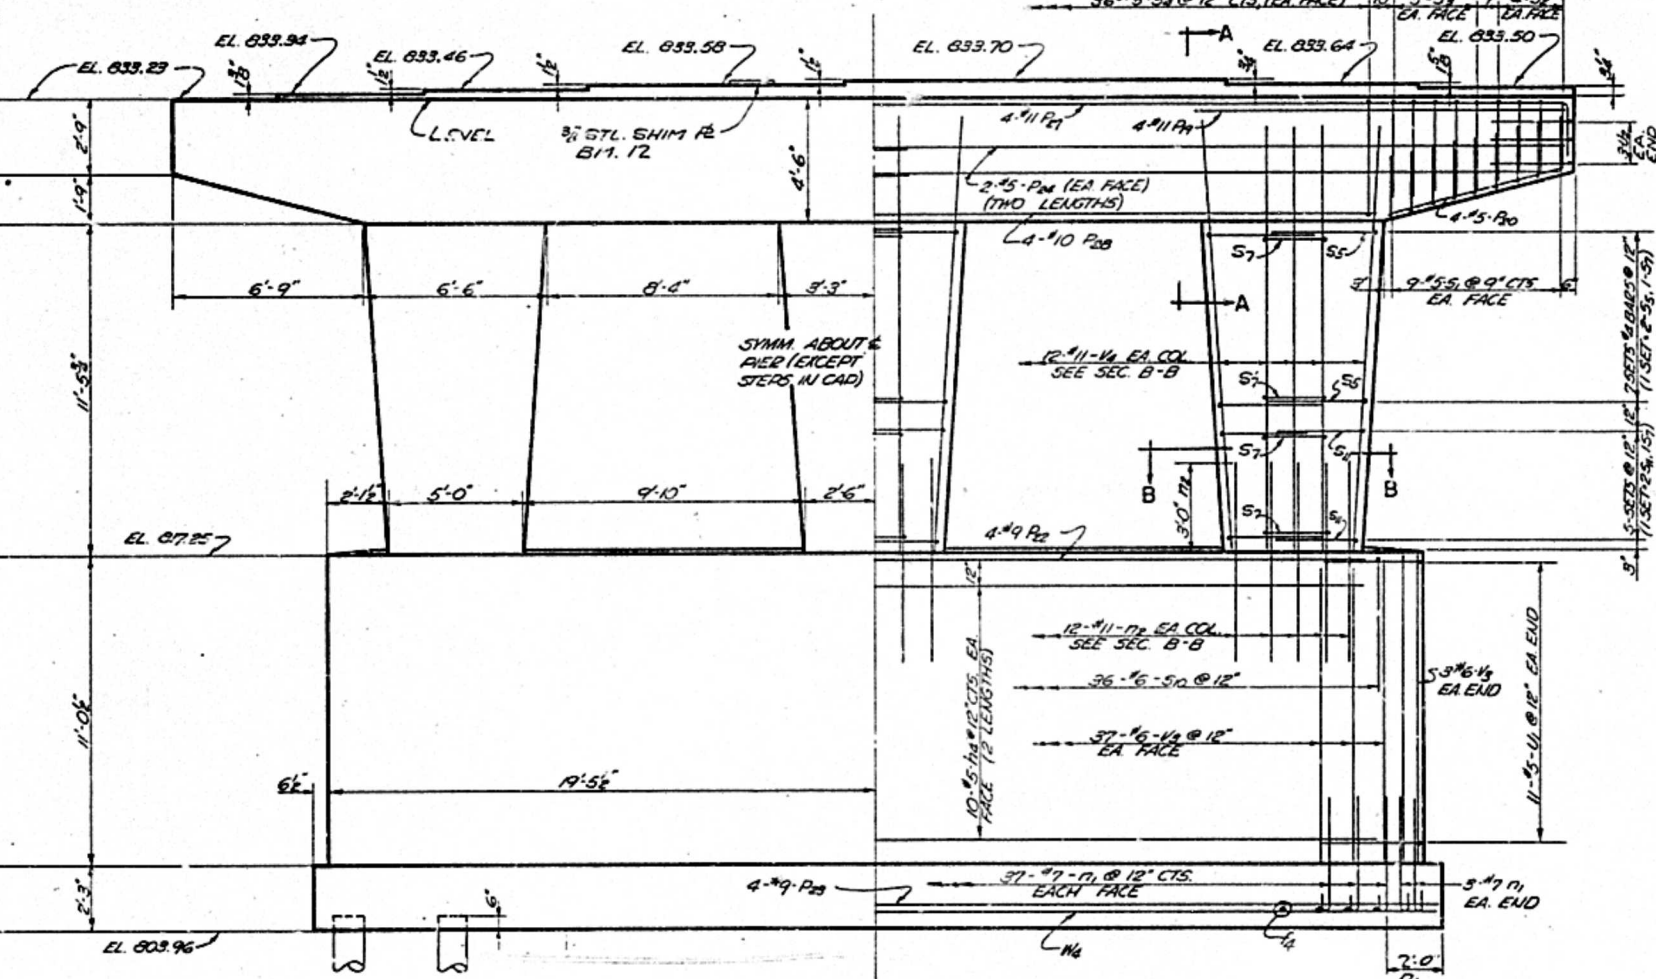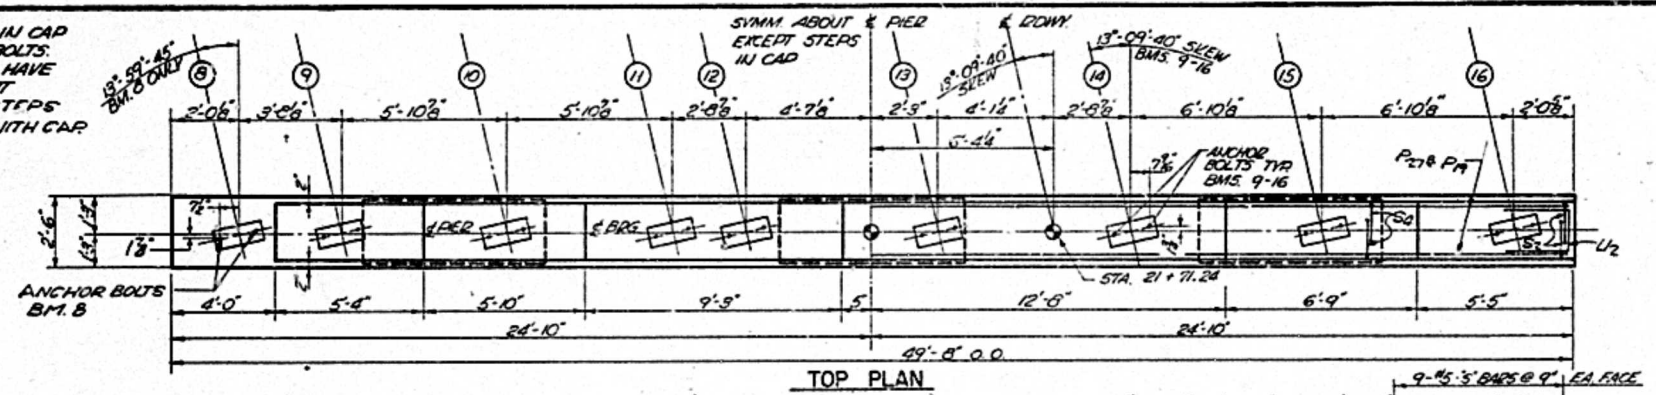

NOTE: SPACE MAIN REIN IN CAP TO MISS ANCHOR BOLTS. ALL EDGES SHALL HAVE 1/2" CHAMFER EXCEPT FOOTINGS. FOUR STEPS MONOLITHICALLY WITH CAP.





1 BRG. PIER 4
STA. 21+71.24
CR. EL. 839.37

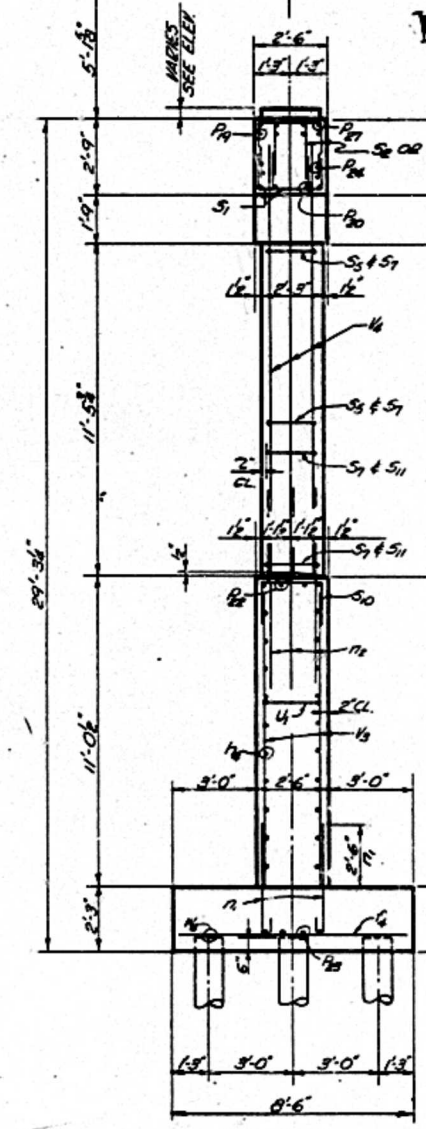

PILE DATA
TYPE: CORRODED TIMBER
MINI. CAPACITY: 20 TON
EST. LENGTH: 35 FT.
NO. REQD.: 33



NOTE: SPACE MAIN BEAR IN CAP TO MISS ANCHOR BOLTS.
ALL EDGES SHALL HAVE 3" CHAMFER EXCEPT FOOTINGS.
FOUR STEPS MONOLITHICALLY WITH CAP.

NOTE: CARE SHOULD BE TAKEN IN LAYING OUT REB IN FIELD AS REB AND E BONY DO NOT COINCIDE.
SEE FOOTING PLAN AND TOP PLAN

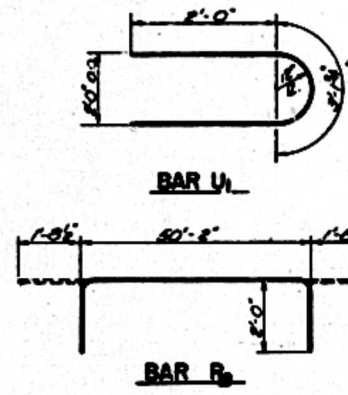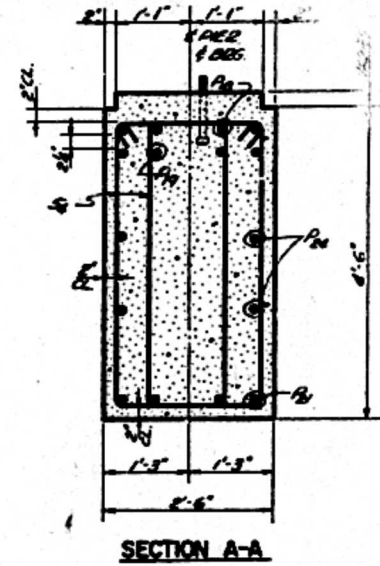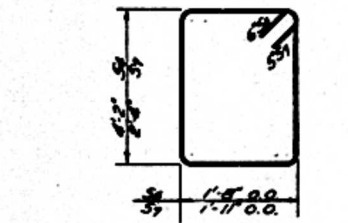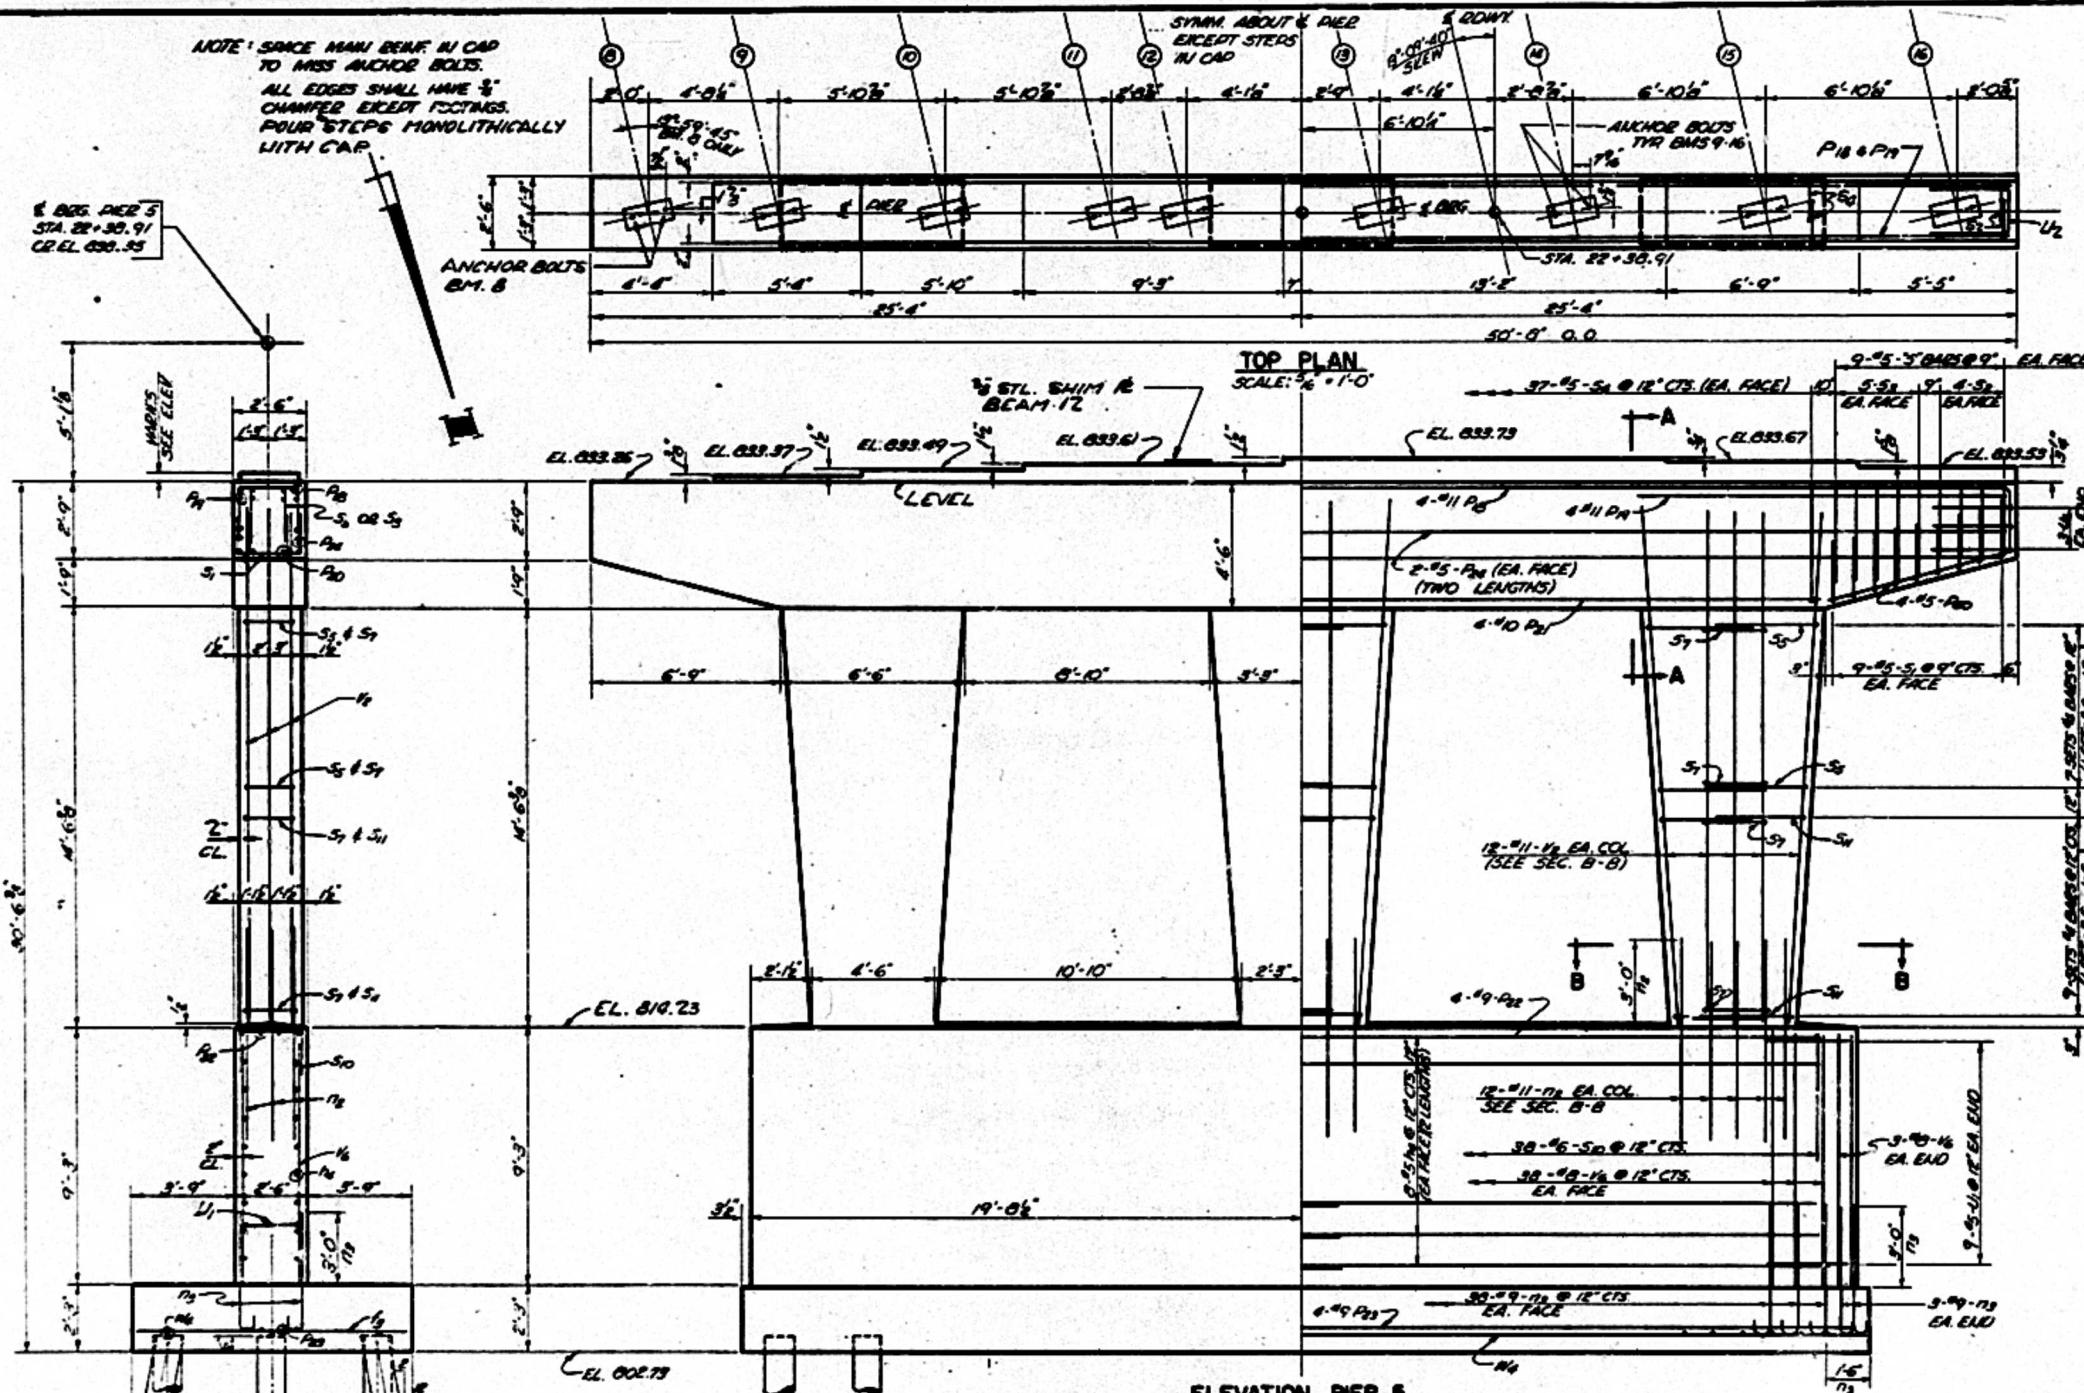


BILL OF MATERIAL

BAR NO.	SIZE	LENGTH	SHAPE
S1	3/8"	5'-0"	U
S2	3/8"	5'-0"	U
S3	3/8"	5'-0"	U
S100	3/8"	5'-0"	U

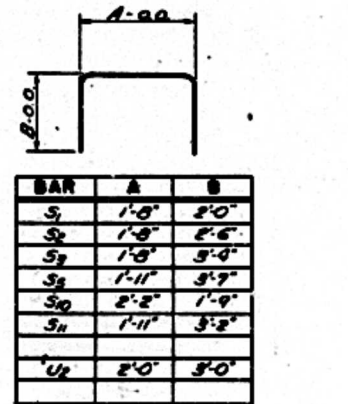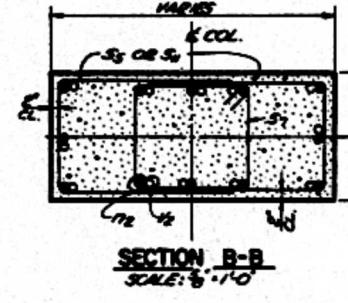

PILE DATA
TYPE: CRIPPLED TIMBER
MAX CAPACITY: 20 TONS
EST LENGTH: 30'
ID. REQ: 39'
TEST PILE: DRIVE ONE TIMBER TEST PILE IN VICINITY OF PIER 5.

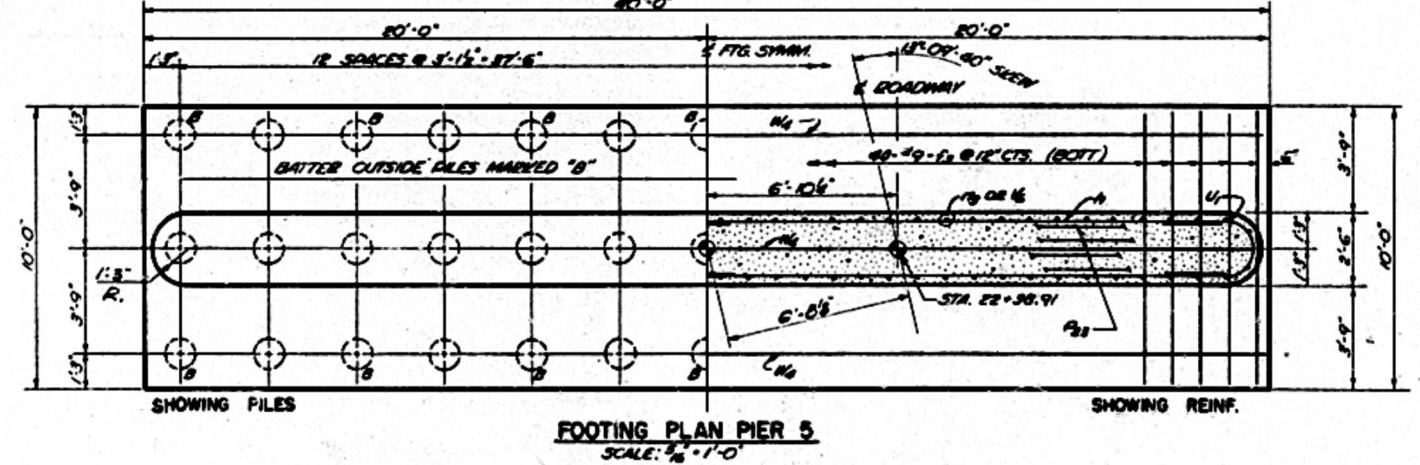

PIER 5 - EAST STRUCTURE
F.A.I. RTE. 74 SEC. 37-24 HVB
F.A.I. 74 OVER C.B.Q. R.R. & S.B.I. RT. 83
HENRY CO. ILLINOIS
STA. 22+64.70

E BRG. DER 6
 STA. 23 + 06.58
 CR FL 339.20

ANCHOR
BOLTS B.M. &

TOP PLAN
SCALE: $\frac{5}{8}'' = 1'-0''$

NOTE: CARE SHOULD BE TAKEN IN
LAYING OUT PIER IN FIELD AS E
PIER AND E EDWY DO NOT COINCIDE.
SEE FOOTING PLAN AND TOP PLAN.

ROUTE NO.	SEC.	COUNTY	TOTL SHEETS	SHEET NO.
74	37-28 HVB	HENRY	37	27
FED. ROAD DIST. NO. 1		ALLIANCE	SHEET 27	

BAR S₄ & S₇

BAR U_1

SECTION A-A

BAR n₁

BILL OF MATERIAL

BAR	NO.	SIZE	LENGTH	SHAPE
S ₁	36	#5	5'-8"	U
S ₂	16	#5	6'-8"	U
S ₃	20	#5	6'-8"	U
S ₄	26	#5	12'-8"	□
S ₅	42	#4	9'-1"	□
S ₇	45	#4	9'-4"	□
S ₁₁	48	#4	8'-3"	U
n ₁	6	#7	5'-1"	U
n ₂	36	#11	7'-0"	
P ₇₀	8	#11	13'-0"	—
P ₇₀	8	#5	6'-6"	—
P ₇₁	4	#10	38'-0"	—
P ₇₂	8	#5	26'-0"	—
P ₇₅	4	#11	34'-7"	—
P ₇₆	6	#10	37'-9"	—
P ₇₆	6	#10	60'-6"	—
U ₁	10	#5	7'-2"	U
U ₂	6	#6	8'-0"	□
U ₃	39	#7	10'-8"	□
U ₅	39	#6	11'-8"	□
N ₃	3	#6	40'-5"	—
P ₄	41	#7	8'-3"	—
n ₅	16	#5	19'-9"	—
V ₂	36	#11	43'-6"	—
V ₄	6	#6	5'-0"	—

CLASS 1 CONCRETE CU. YDS	89.3
REINFORCEMENT BARS LBS	14790
CROSSTED PILES LIN. FT.	1721
CLASS A EXCAV. FOR STR. CK	73

PIER 6 — EAST STRUCTURE
F.A.I. RTE. 74 SEC. 37-24 HWY
F.A.I. 74 OVER C.B.&O. R.R. & S.B.I. RT. 83
HENRY CO., ILLINOIS
STA. 22 +64.70

SECTION B-B
SCALE: 5"=1'-0"

BARS

$$S_1, S_2, S_3, S_4, S_5, S_{11}, U_2, U_3, U_4$$

FILE DATA





TYPE: CREOSOTED TIMBER
MIN. CAPACITY: 20 TONS
EST. LENGTH: 37 FT.
NO. REQ'D.: 33

SHOWING FILES

SHOWING REINF.


FOOTING PLAN PIER 6
SCALE: $\frac{3}{8}" = 1'-0"$

ELEVATION PIER 6
SCALE: 5" = 1'-0"

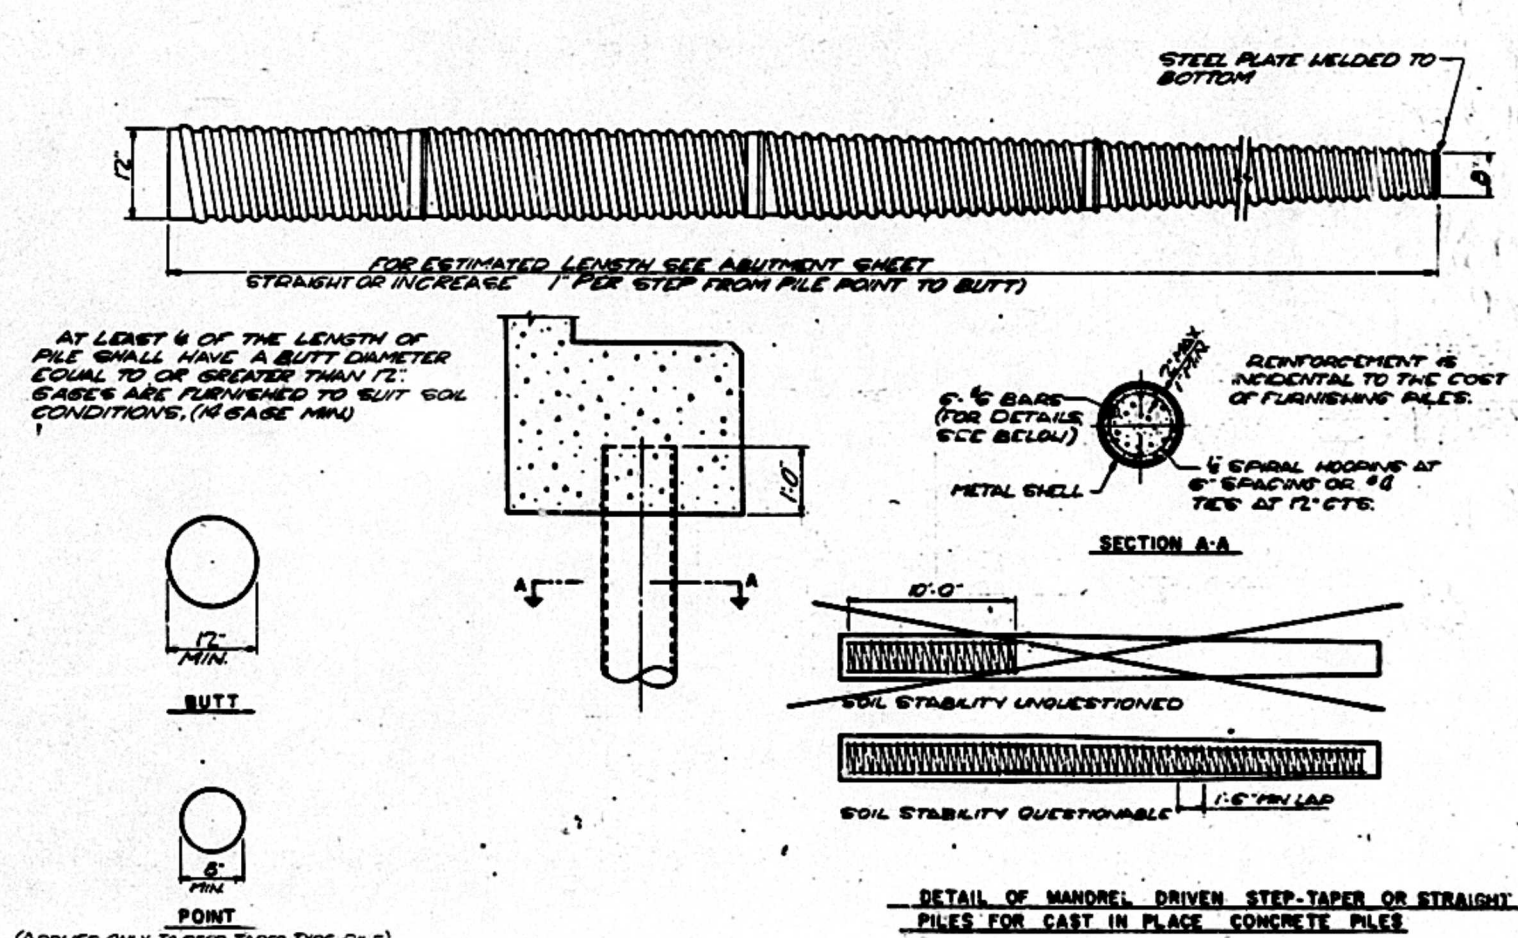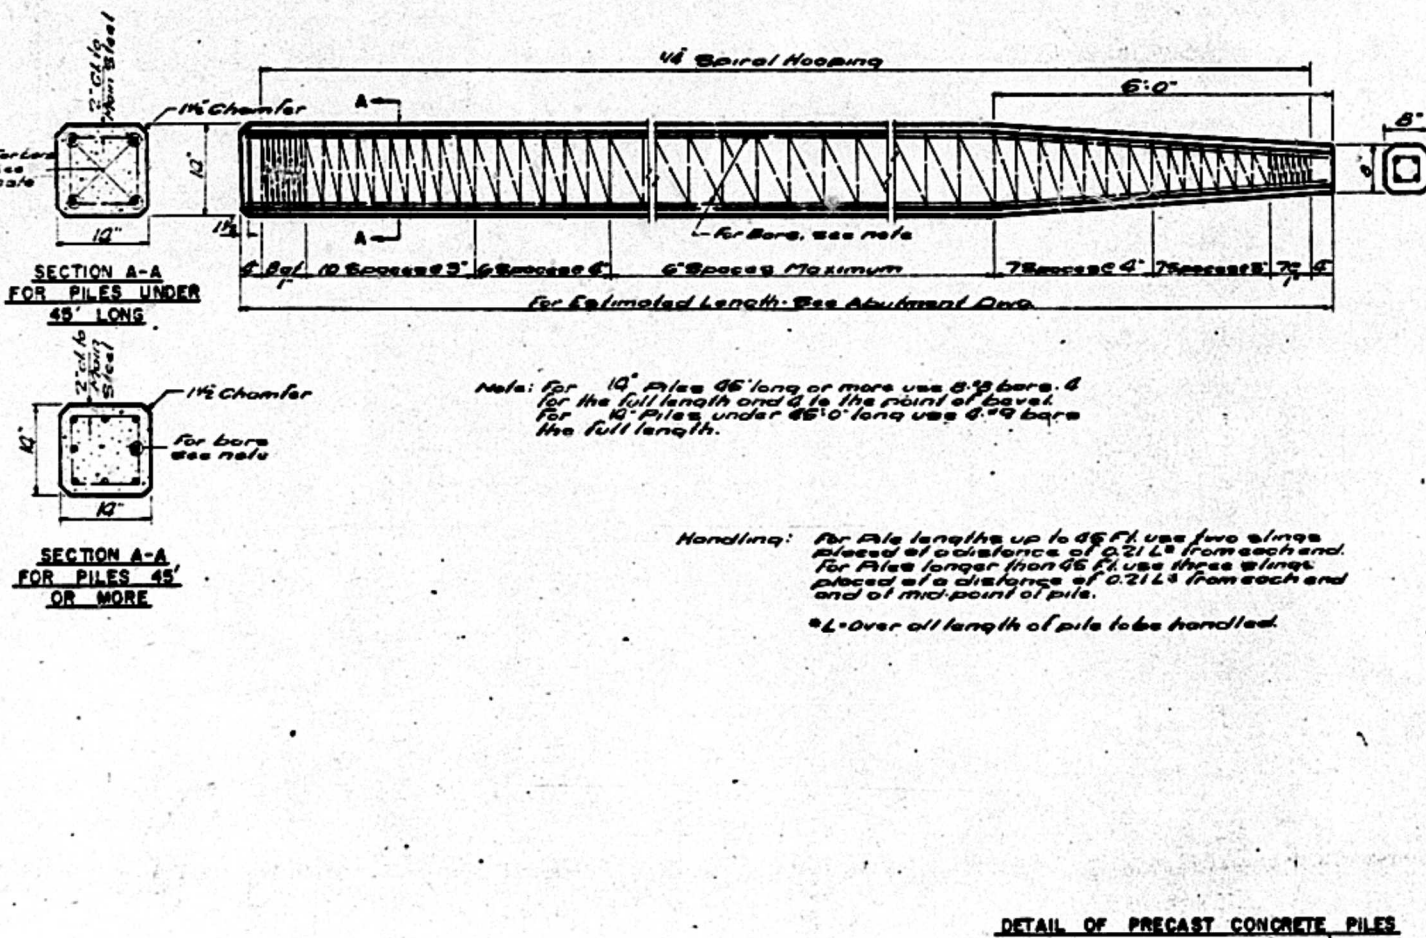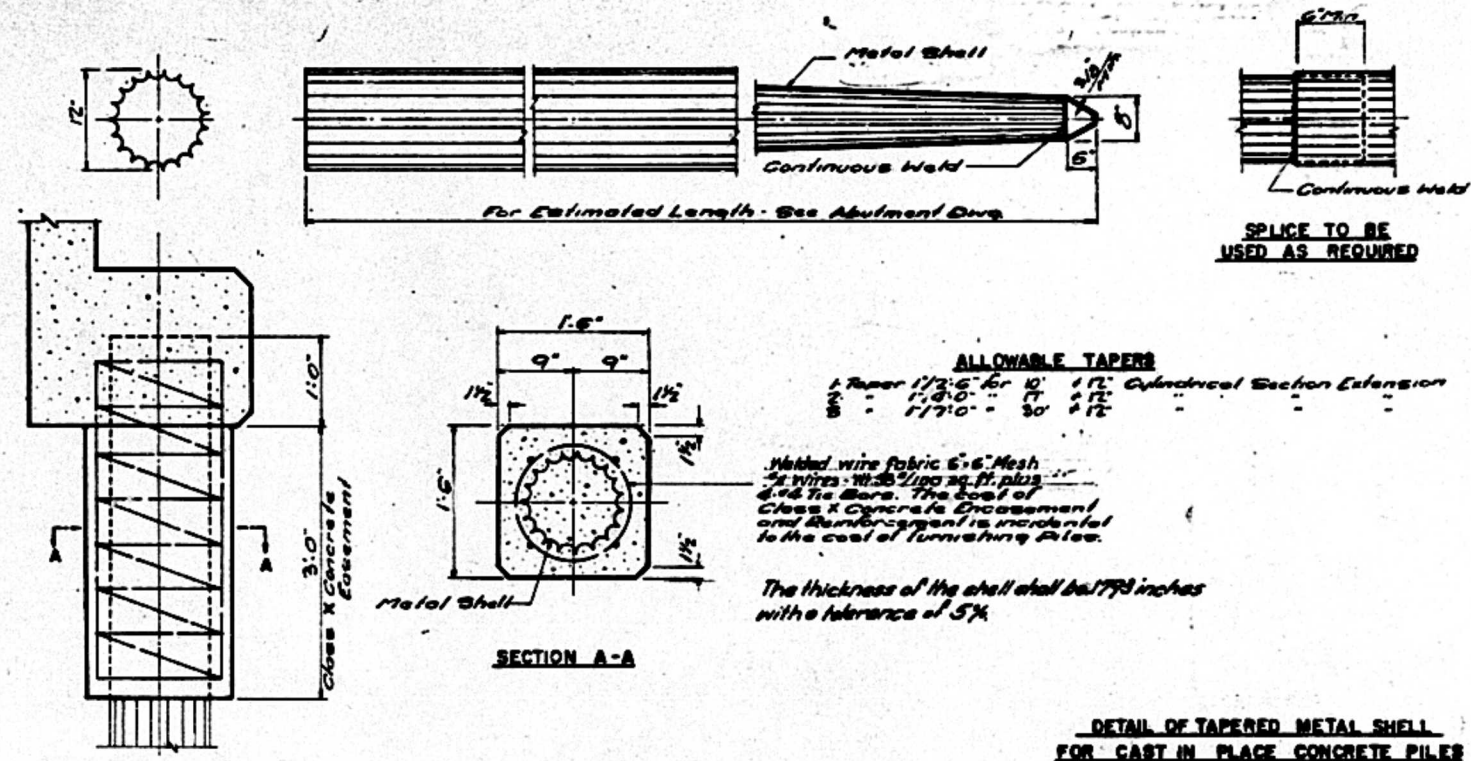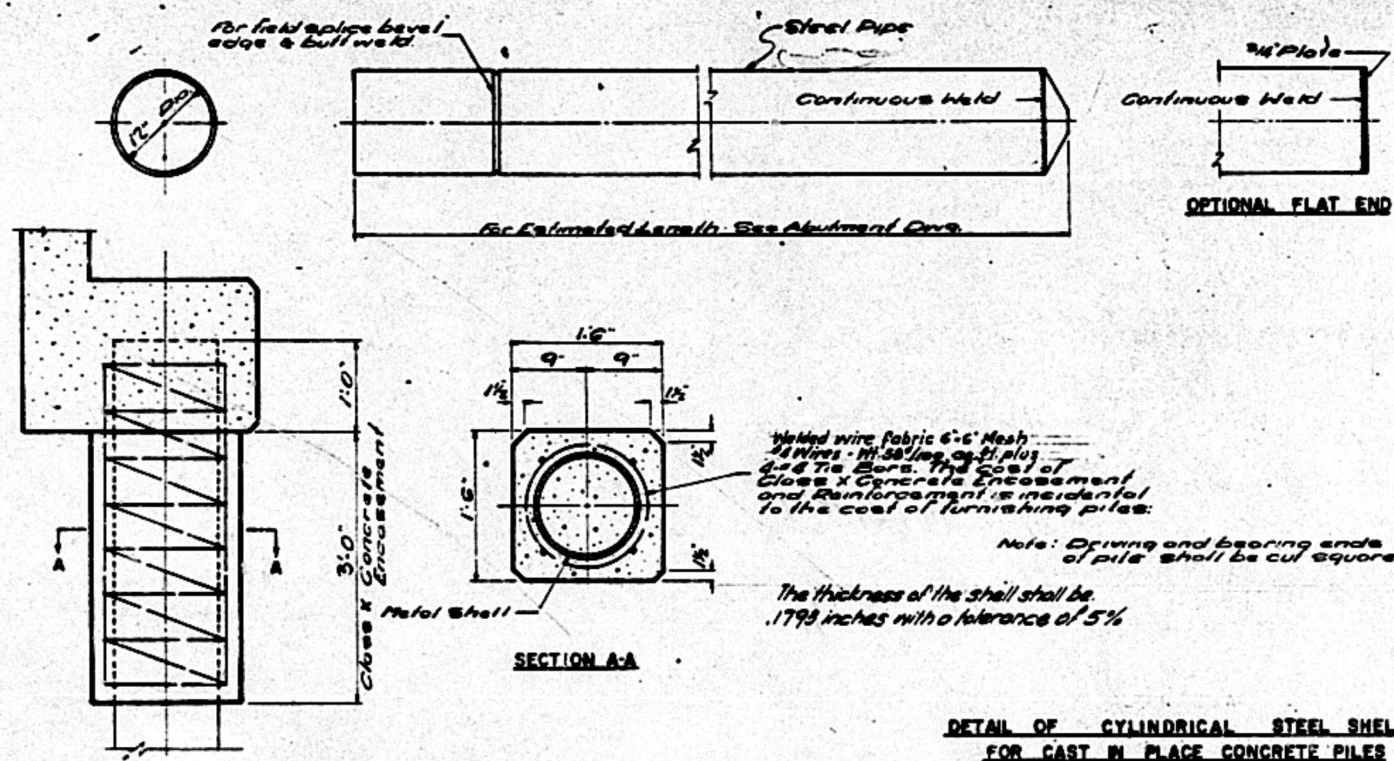

DATE
BY
CHECKED
DESIGNED
PLANNED
TEMPLATE
FINAL CHECKED


DATE
BY
CHECKED
DESIGNED
PLANNED
TEMPLATE
FINAL CHECKED

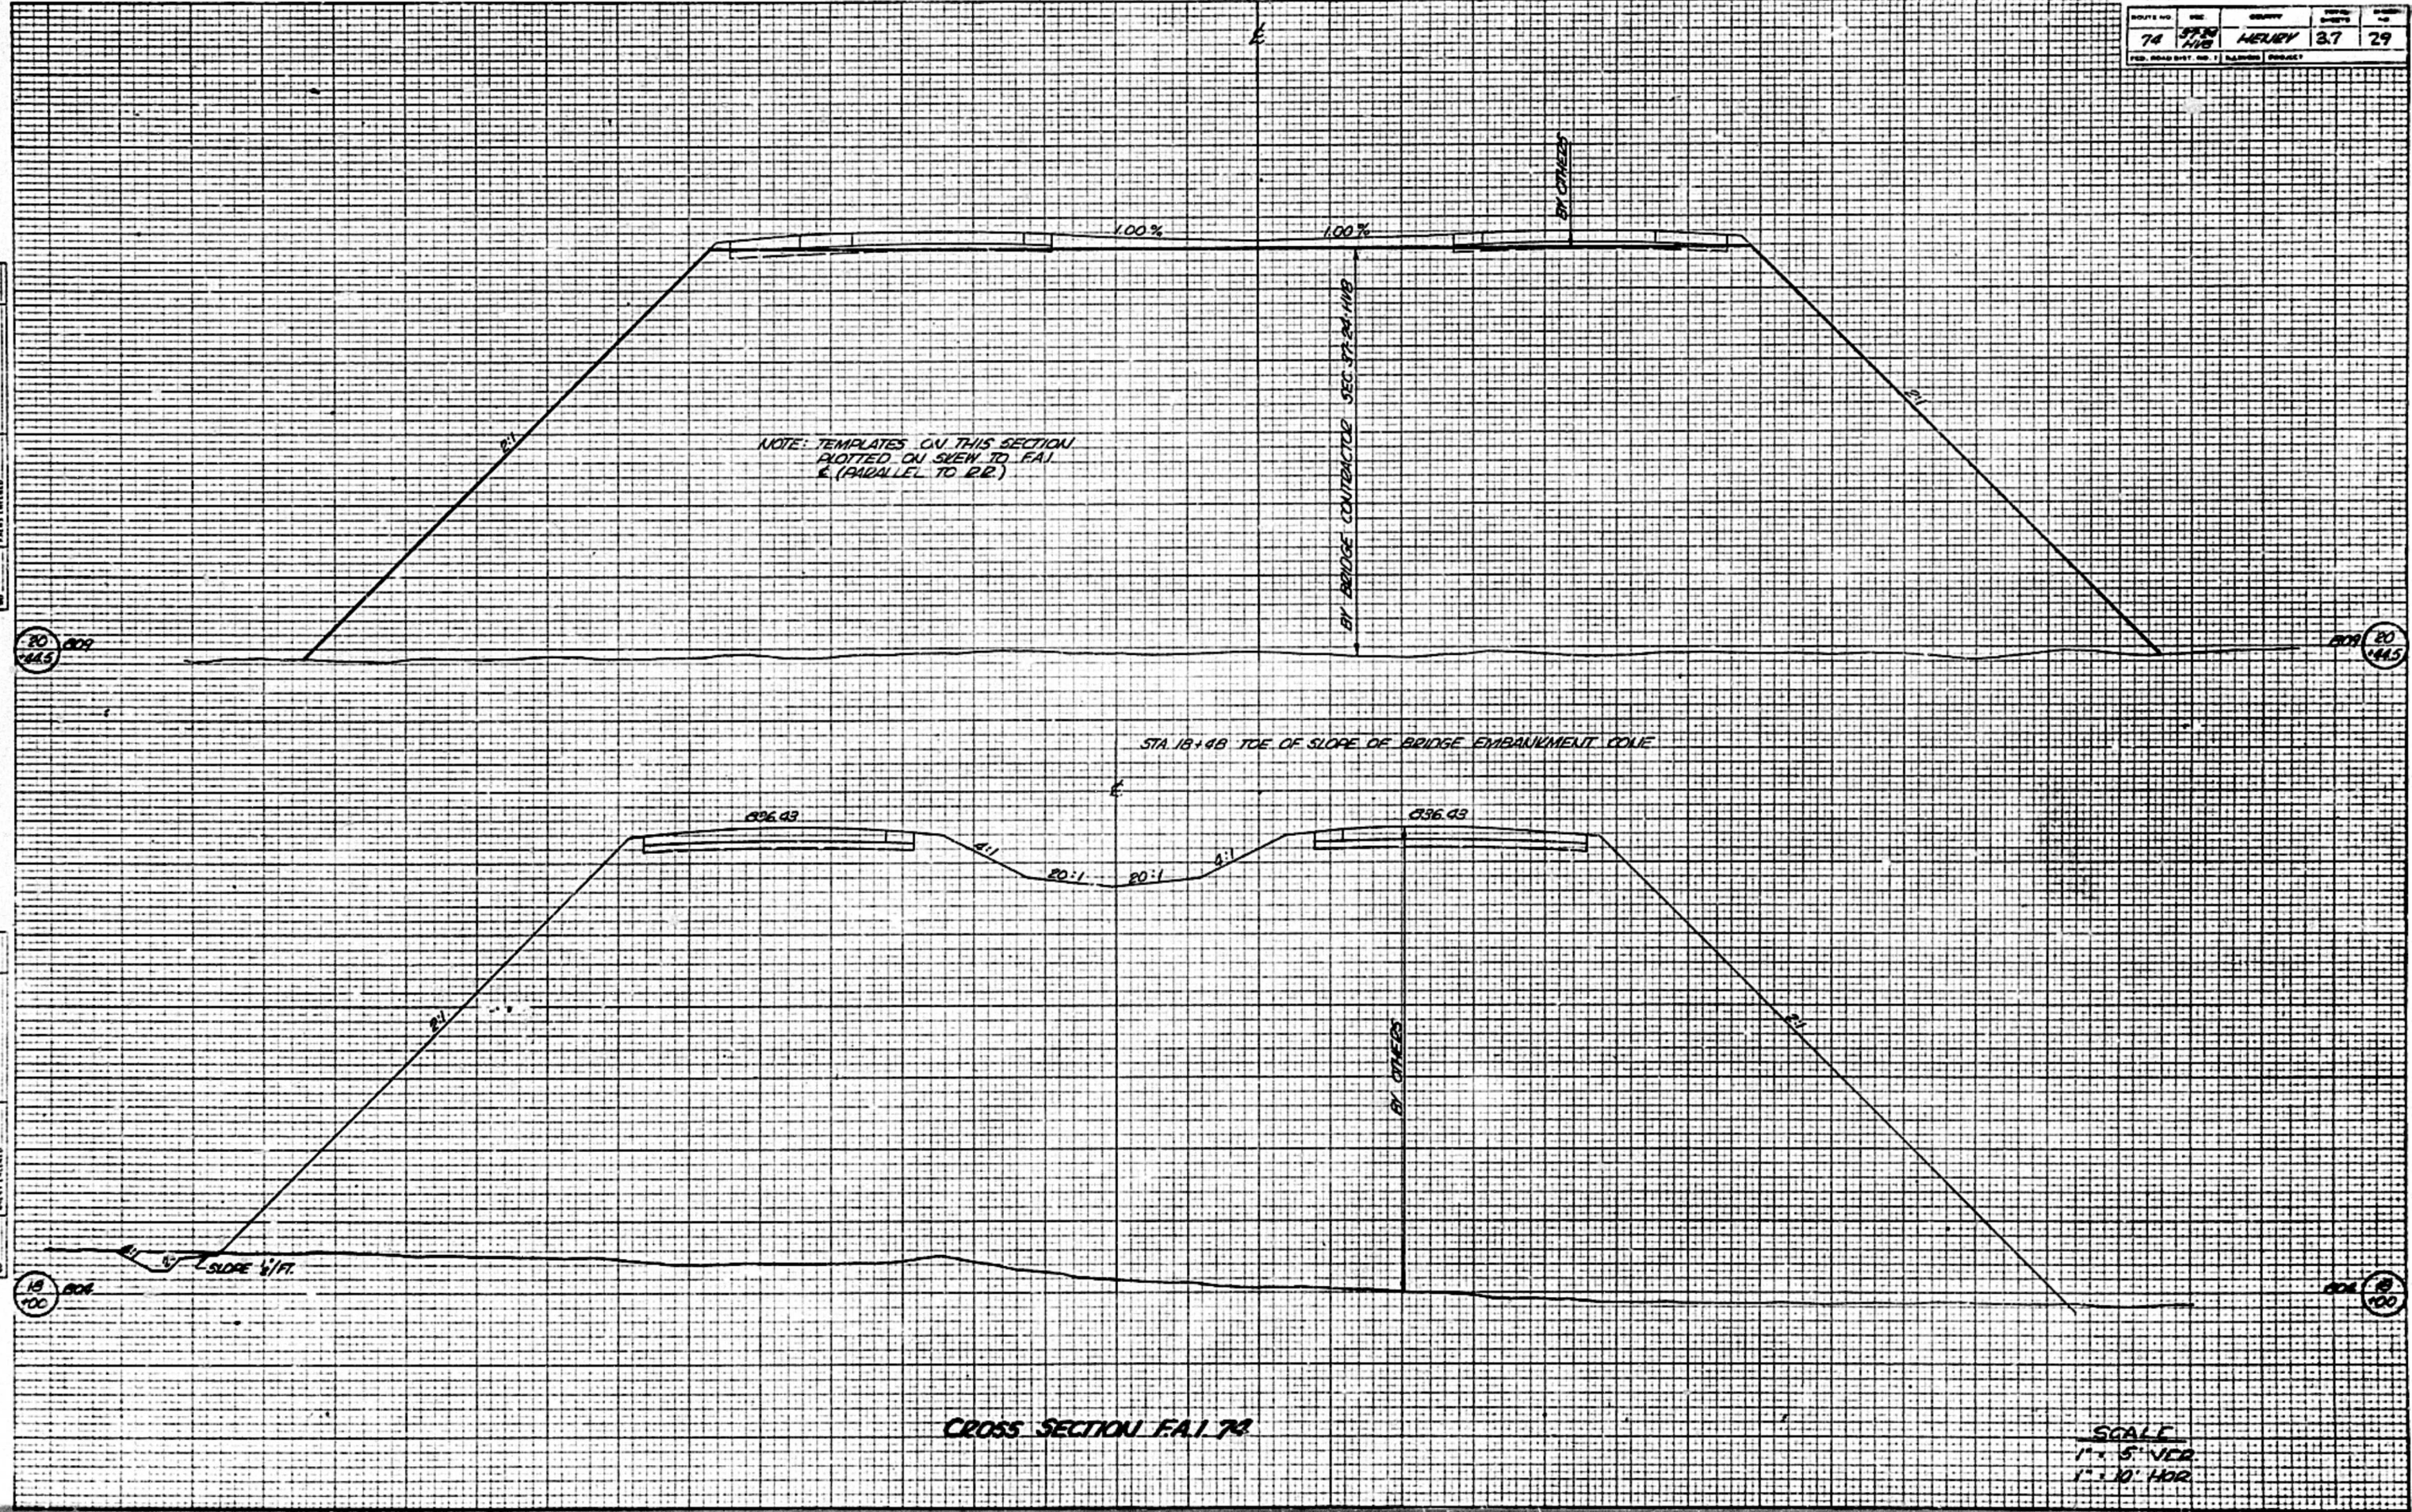

CROSS SECTION F.A.I. 74

FINAL
 SURVEY
 DATE 7/23/58
 BY HENRY

DESIGN
 SURVEY
 DATE 7/23/58
 BY HENRY

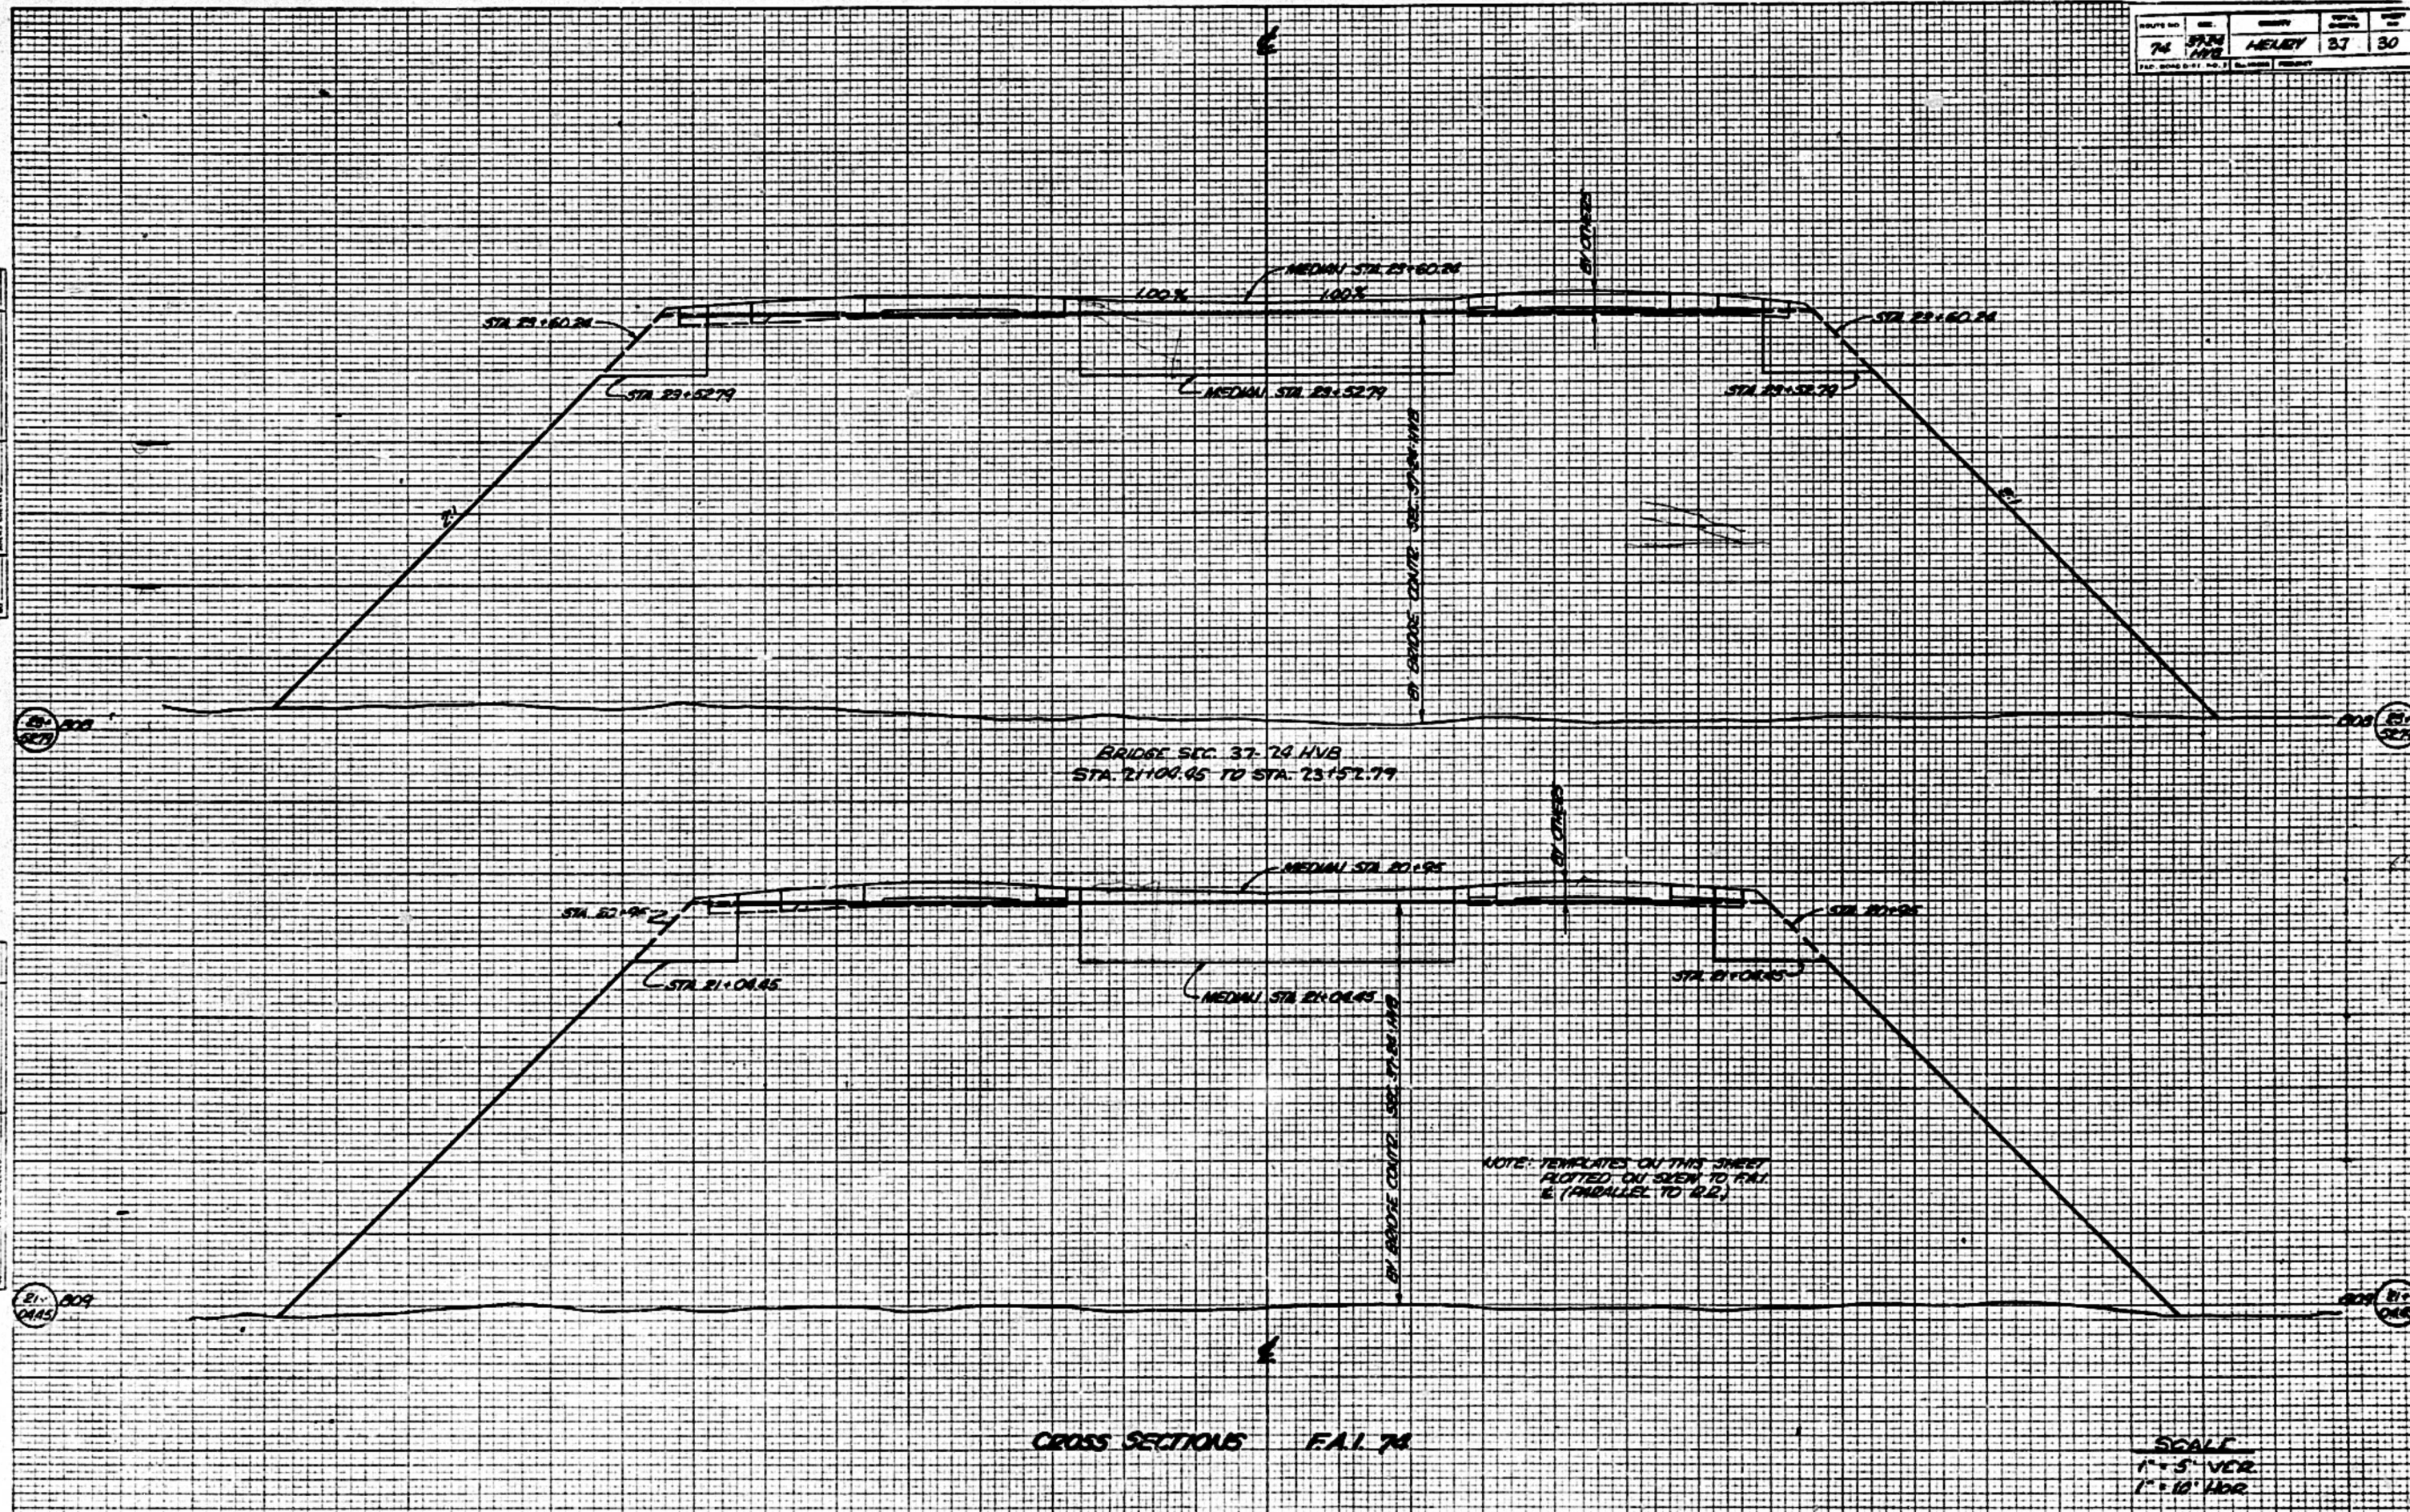


CROSS SECTIONS F.A.I. 74

SCALE
 1" = 5' VERT
 1" = 10' HOR

ROUTE NO.	SP.	COUNTY	SHEET NO.	TOTAL SHEETS
74	37.34	HENRY	37	31
FED. ROAD DIST. NO. 1				

DATE	
BY	
REVIEWED	
DATE	
BY	
REVIEWED	
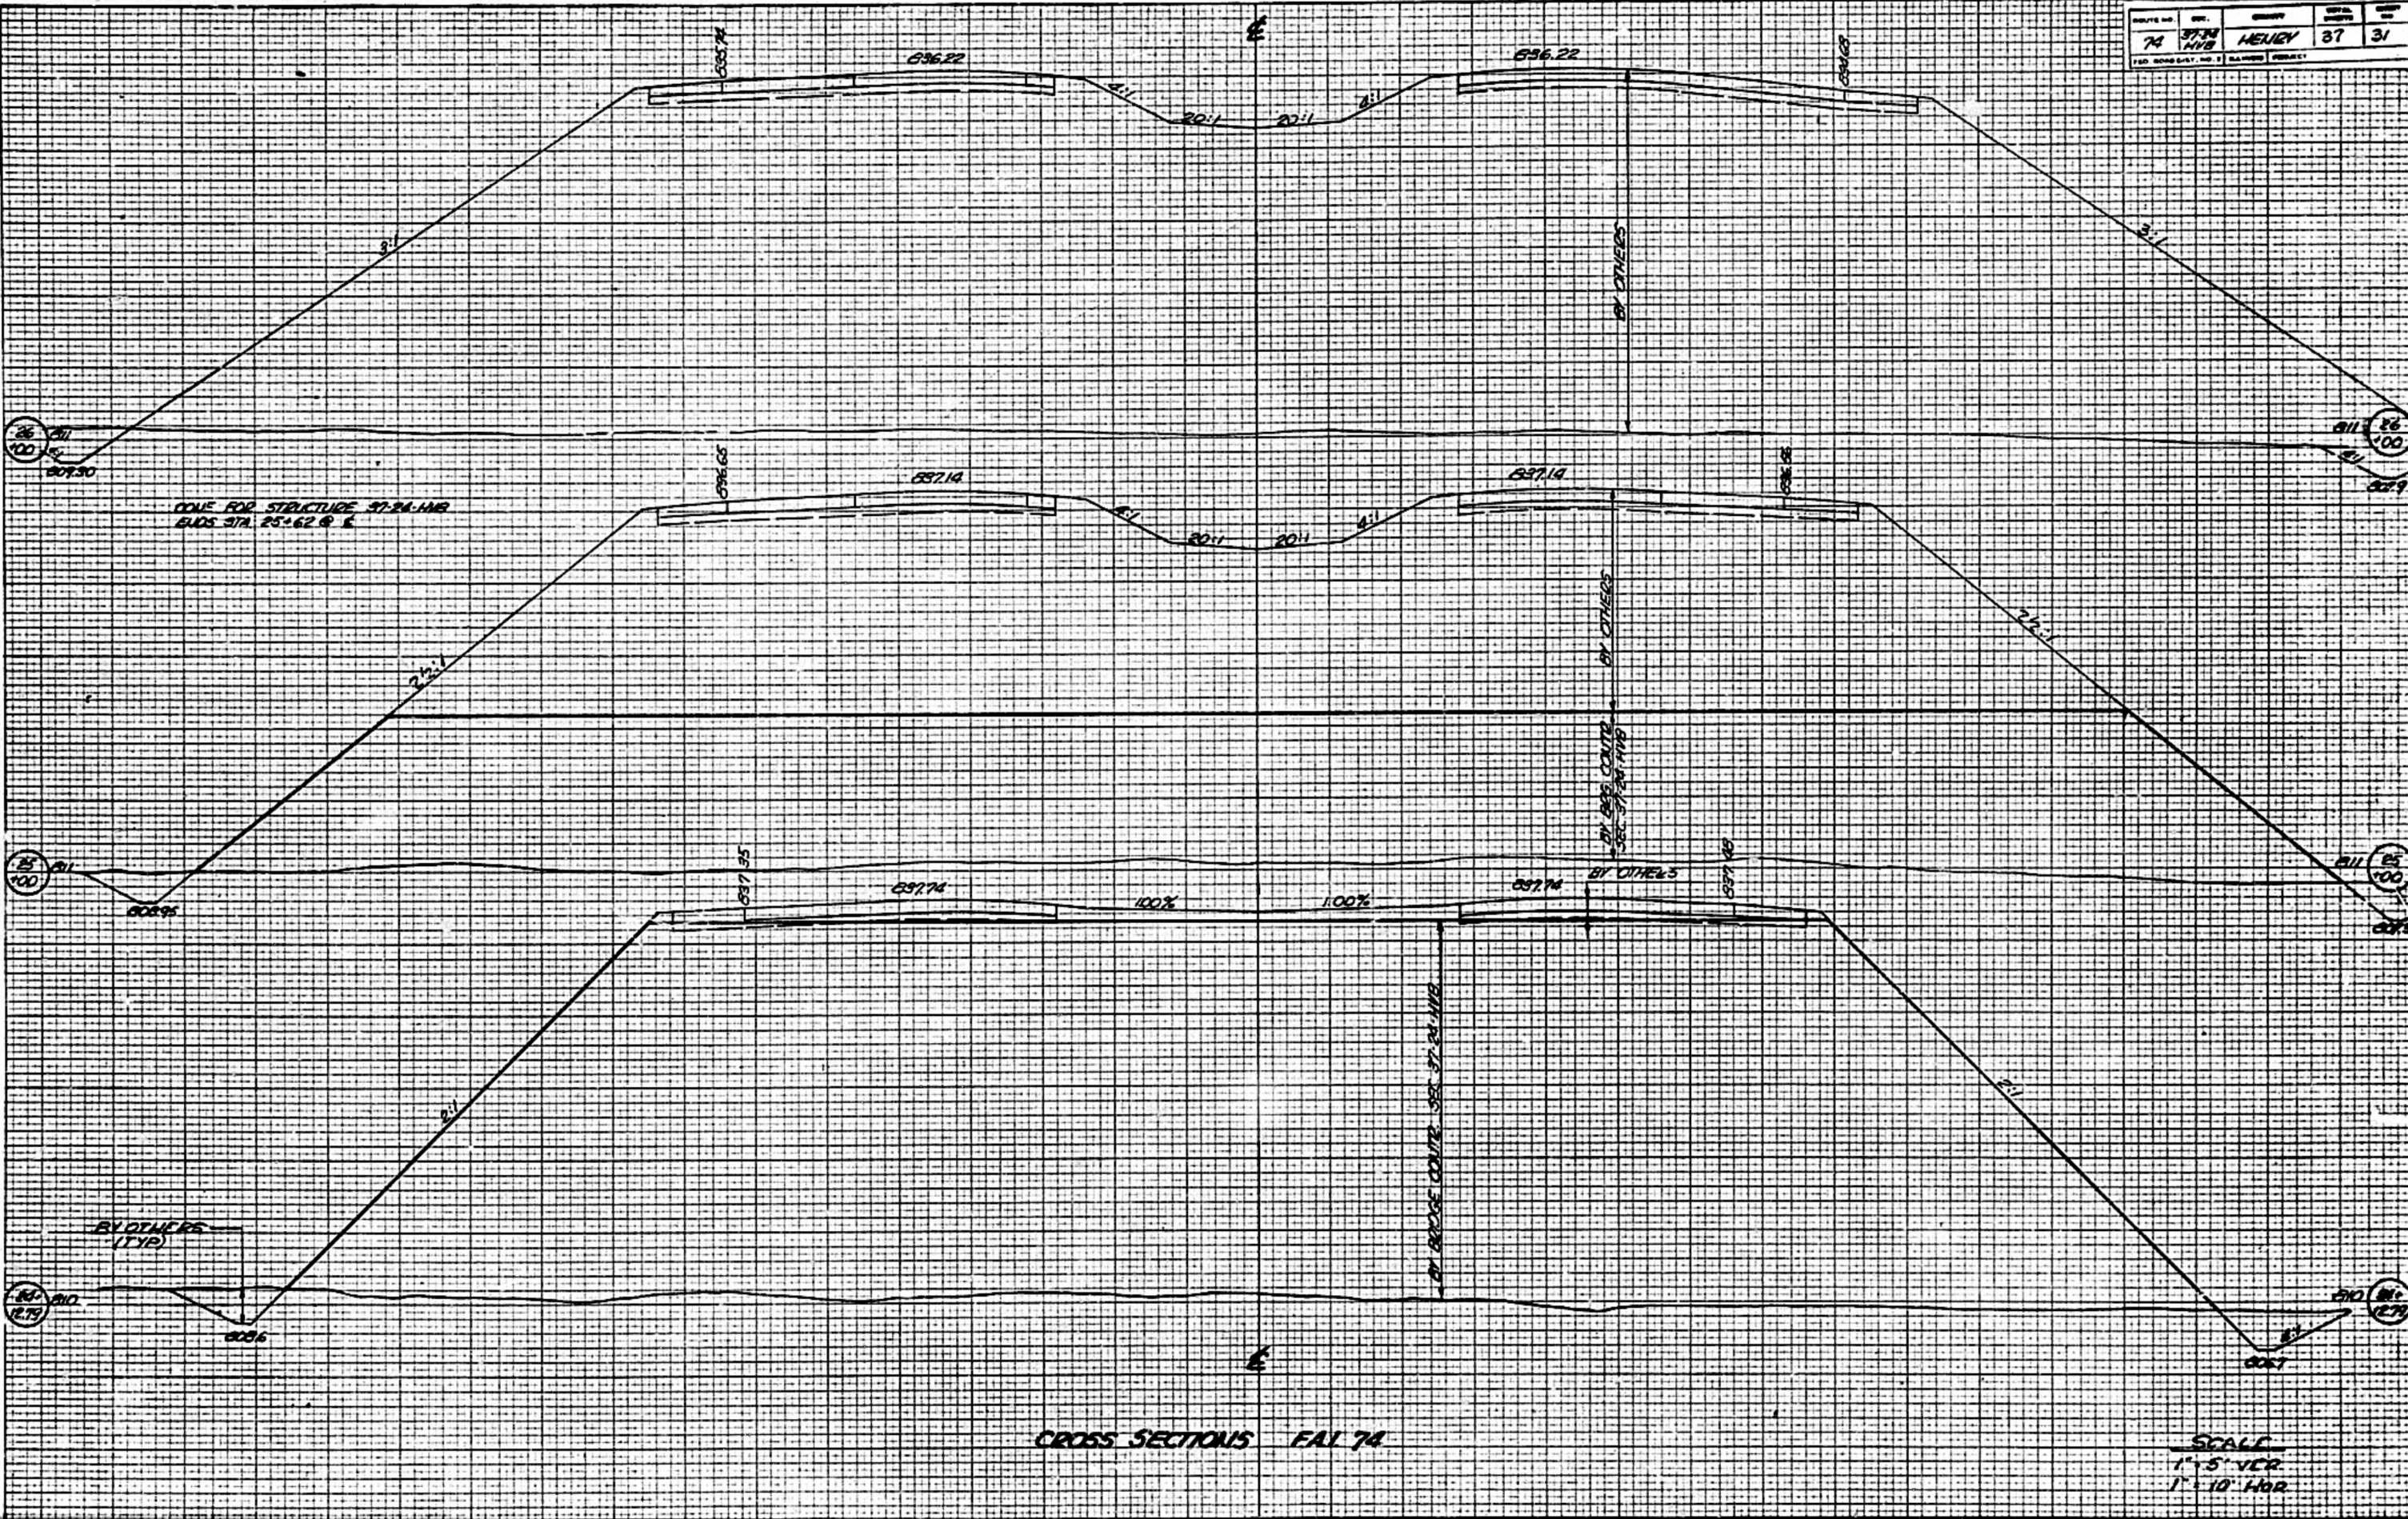

CROSS SECTIONS FAI 74

SCALE
1" = 5' VCR
1" = 10' HOR

