STATE OF ILLINOIS

DEPARTMENT OF TRANSPORTATION

**DIVISION OF HIGHWAYS** 

# PROPOSED HIGHWAY PLANS

F.A.U. ROUTE 1319: BALLARD RD. RAND RD. TO GREENWOOD AVE.

2009–067 RS

RESURFACING


PROJECT: ESP-1319(001)

COOK COUNTY C-91-781-09

FOR INDEX OF SHEETS, SEE SHEET NO. 2

THE PROJECT IS LOCATED IN THE VILLAGES OF DES PLAINES, GLENVIEW, NILES, AND PARK RIDGE.

TRAFFIC DATA:
2007 ADT = 12,800
POSTED SPEED LIMIT = 35-40 MPH

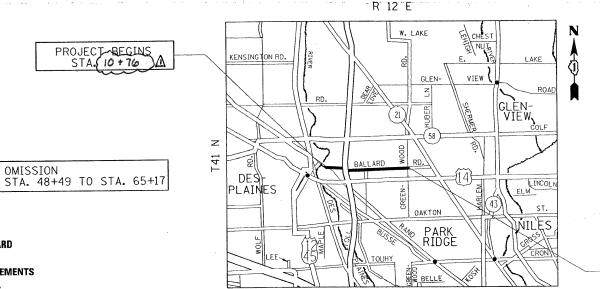

FULL SIZE PLANS HAVE BEEN PREPARED USING STANDARD ENGINEERING SCALES. REDUCED SIZED PLANS WILL NOT CONFORM TO STANDARD SCALES. IN MAKING MEASUREMENTS ON REDUCED PLANS, THE ABOVE SCALES MAY BE USED.

J.U.L.I.E.
JOINT UTILITY LOCATION INFORMATION FOR EXCAVATION
1-800-892-0123
OR 811

PROJECT ENGINEER ROBERT BORO (847) 705-4178
PROJECT MANAGER KEN ENG

CONTRACT NO. 60H73


GROSS LENGTH OF PROJECT = 9,330 FEET = 1.77 MILES

NET LENGTH OF PROJECT = 8,184 FEET = 1.55 MILES

MAINE TOWNSHIP

D-91-781-09



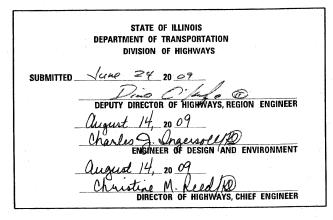

PRINTED BY THE AUTHORITY OF THE STATE OF ILLINOIS

1 Rev. 8:31:09

### INDEX OF SHEETS

18 DISTRICT ONE TYPICAL PAVEMENT MARKINGS (TC-13)

21 ARTERIAL ROAD INFORMATION SIGN (TC-22)

#### STANDARD NO. DESCRIPTION 1 TITLE SHEET CLASS C AND D PATCHES 442201 - 03 2 INDEX OF SHEETS, STATE STANDARDS, AND GENERAL NOTES CONCRETE CURB TYPE B AND COMBINATION CONCRETE 606001-04 CURB AND GUTTER SUMMARY OF QUANTITIES LANE CLOSURE, 2L, 2W, SHORT TIME OPERATIONS 701301-*03* 4-5 TYPICAL SECTIONS URBAN LANE CLOSURE, 2L, 2W UNDIVIDED 701501-*05* ROADWAY AND PAVEMENT MARKING PLAN URBAN LANE CLOSURE, MULTILANE INTERSECTION 701701-00 10-12A DETECTOR LOOPS REPLACEMENT PLANS 701901-01 TRAFFIC CONTROL DEVICES 13 PAVEMENT PATCHING FOR HMA SURFACED PAVEMENT (BD-22) 14 CURB OR CURB AND GUTTER REMOVAL AND REPLACEMENT (BD-24) 15 BUTT JOINT AND HMA TAPER DETAILS (BD-32) 16 TRAFFIC CONTROL AND PROTECTION FOR SIDE ROADS, INTERSECTIONS AND DRIVEWAYS (TC-10)

## STATE STANDARDS

## GENERAL NOTES

BEFORE STARTING ANY EXCAVATION, THE CONTRACTOR SHALL CALL "JULIE" AT 800-892-0123 or 811 FOR FIELD LOCATIONS OF BURIED ELECTRIC. TELEPHONE AND GAS FACILITIES. (48 HOUR NOTIFICATION IS REQUIRED)

THE CONTRACTOR SHALL COORDINATE CONSTRUCTION ACTIVITIES WITH UTILITY COMPANIES, AND THE VILLAGES OF DES PLAINES, GLENVIEW, NILES, AND PARK RIDGE.

THE CONTRACTOR WILL NOT BE ALLOWED TO SET UP A YARD OR FIELD OFFICE ON STATE PROPERTY WITHOUT WRITTEN PERMISSION FROM THE DEPARTMENT.

WHEN MILLED PAVEMENT IS OPEN TO TRAFFIC THE MAXIMUM GRADE DIFFERENTIAL BETWEEN PASSES OF THE MILLING MACHINE SHALL NOT EXCEED 1 1/2 INCHES (40 MM ) WHERE THE SPEED LIMIT IS 40 MPH (80 KM/H) OR LESS AND 1 INCH (25 MM) WHERE THE SPEED LIMIT IS GREATER THAN 45 MPH (80 KM/H). WITH WRITTEN APPROVAL FROM THE ENGINEER, A MAXIMUM GRADE DIFFERENTIAL OF 3 INCHES (75 MM) MAY BE ALLOWED IF THE EDGE OF THE MILLING IS SLOPED A MINIMUM 1.3 (V:H)

BUTT JOINTS WILL BE INSTALLED AT THE ENDS OF ALL RESURFACING (WHERE RESURFACING MEETS EXISTING PAVEMENT), IN ACCORDANCE WITH THE "BUTT JOINT AND HOT-MIX ASPHALT TAPER DETAILS" SHEET INCLUDED IN THE PLANS, UNLESS OTHERWISE SPECIFIED.

UNLESS OTHER CONDITIONS WARRANT EXTENDED LANE CLOSURE AS DETERMINED AND APPROVED IN WRITING BY THE ENGINEER OR AS PROVIDED FOR IN THE CONTRACT SPECIFICATIONS, OVERNIGHT CLOSURES SHALL NOT BE ALLOWED FOR REHABILITATION PROJECTS INVOLVING DAYTIME MILLING AND RESURFACING OPERATIONS AND CLASS D PATCHING.

THE RESIDENT ENGINEER SHALL CONTACT WALLY CZARNY, AREA TRAFFIC FIELD ENGINEER AT (773) 685 8366 A MINIMUM OF 2 WEEKS PRIOR TO PLACEMENT OF PERMANENT PAVEMENT MARKING.

BEFORE BEGINING ANY WORK, THE CONTRACTOR SHALL RETAIN AND RECORD FOR FUTURE REFERANCE, ALL EXISTING PAVEMENT MARKING LINES (AND RAISED REFLECTIVE PAVEMENT MARKINGS) IN ORDER THAT THESE LOCATIONS CAN BE RE-ESTABLISHED FOR STRIPING. EXACT LOCATIONS OF ALL PAVEMENT MARKINGS SHALL BE AS DIRECTED BY THE ENGINEER.

ALL DAMAGE TO EXISTING PAVEMENT MARKINGS OR RAISED REFLECTIVE PAVEMENT MARKINGS OUTSIDE THE REMOVAL LINE SHOWN ON THE PLANS SHALL BE REPLACED AT NO ADDITIONAL COST TO THE DEPARTMENT.

PAVEMENT MARKING TAPE, TYPE III SHALL BE USED FOR SHORT TERM PAVEMENT MARKINGS ON ALL FINAL SURFACES. THE COST OF THE PAVEMENT MARKING TAPE, TYPE III AND ITS REMOVAL SHALL BE INCLUDED IN THE COST OF SHORT TERM PAVEMENT MARKING.

THE CONTRACTOR SHALL CONTACT THE DISTRICT ONE TRAFFIC CONTROL SUPERVISOR AT (847) 705-4470. A MINIMUM OF 72 HOURS IN ADVANCE OF BEGINING OF WORK.

ALL PAVEMENT PATCHING LOCATIONS WILL BE DETERMINED IN THE FIELD BY THE ENGINEER.

IT SHALL BE THE CONTRACTOR'S RESPONSIBILITY TO VERIFY ALL DIMENSIONS AND CONDITIONS EXISTING IN THE FIELD PRIOR TO CONSTRUCTION AND ORDERING OF MATERIALS.

THE CONTRACTOR SHALL BE REQUIRED TO PROVIDE ACCESS TO ABUTTING PROPERTY AT ALL TIMES DURING THE CONSTRUCTION OF THIS PROJECT.

DO NOT SCALE PLANS FOR CONSTRUCTION DIMENSIONS.

DOUBLE LANE MARKERS ARE TO BE USED AS SHOWN ON THE DISTRICT ONE DETAIL "TYPICAL APPLICATIONS- RAISED REFLECTIVE PAVEMENT MARKERS (SNOW-PLOW RESISTANT)" SHOWN IN THE PLANS.

THE ENGINEER SHALL REPORT CLEARANCES UNDER BRIDGE AFTER RESURFACING

DESIGNED Designed By REVISED Revised By1 FILE NAME = USER NAME = paraymoal DRAWN Drawn By REVISED Revised By2 PLOT SCALE = 50.0000 '/ IN. CHECKED Checked By REVISED Revised By3 Checked Date REVISED Revised By4 DATE

PLOT DATE = 6/25/2009

17 TYPICAL APPLICATIONS RAISED REFLECTIVE PAVEMENT MARKERS (SNOW PLOW RESISTANT) (TC-11)

19 TRAFFIC CONTROL & PROTECTION OF TURN BAYS (TO REMAIN OPEN TO TRAFFIC) (TC-14)

22 DISTRICT 1 DETECTOR LOOP INSTALLATION DETAILS FOR ROADWAY RESURFACING (TS-07)

PAVEMENT MARKING LETTERS & SYMBOLS FOR TRAFFIC STAGING (TC-16)


STATE OF ILLINOIS **DEPARTMENT OF TRANSPORTATION** 

BALLARD RD. (RAND RD. TO GREENWOOD AVE.) INDEX OF SHEETS, STATE STANDARDS AND GENERAL NOTES


SCALE: Scale

SECTION COUNTY COOK 22 2 CONTRACT NO. 60H73 1319 2009-067 RS Station To FED. ROAD DIST. NO. ILLINOIS FEE

	SUMMARY OF QUANTITIES		URBAN 1001. FEO.			CONSTRUC	TION TYPE	CODE			SUMMA	RY OF QUANTITIES		URBAN 1001. FEO.		CONST	RUCTION TYP	CODE	T
CODE NO	ITEM	UNIT	TOTAL OUANTITIES	URBAN 1000-2A		2 2 2				CODE NO		ITEM	UNIT	TOTAL QUANTITIES	URBAN IOOO-2A				
20201006	GRADING AND SHAPING SHOULDERS	UNIT	92	92	3	-				70300210	1	/EMENT MARKING	SQ FT	521	521				
40600200	BITUMINOUS MATERIALS (PRIME COAT)	TON	7 30	30	)^						- LETTERS AND		5007	\ 20.744		$\Lambda$			
40600300	AGGREGATE (PRIME COAT)	TON	149	149	34					70300220	IEMPURARY PAY	/EMENT MARKING - LINE 4"	FOOT	29,743	29,743				
40600400	MIXTURE FOR CRACKS, JOINTS, AND FLANGEWAYS	TON	50	56	)					70300240	TEMPORARY PAY	EMENT MARKING - LINE 6"	FOOT	1,680	1,680 5				
40600895	CONSTRUCTING TEST STRIP	EACH	1	1						70300260	TEMPORARY PAN	EMENT MARKING - LINE 12"	FOOT	350	350				
40600982	HOT-MIX ASPHALT SURFACE REMOVAL - BUTT JOINT	SQ YD	415	415						70300280	TEMPORARY PAY	EMENT MARKING - LINE 24"	FOOT	200	200				
40601005	HOT-MIX ASPHALT REPLACEMENT OVER PATCHES	TON	416	416	$\Delta$					<del>X</del> 78000100	I .	PAVEMENT MARKING	SO FT	521	521				
40603340	HOT-MIX ASPHALT SURFACE COURSE, MIX "D", N7O	TON	3,117	3,//7	)					± 78000200	- LETTERS AND	C PAVEMENT MARKING - LINE 4"	FOOT	29,743	29,743	Δ			
42001300	PROTECTIVE COAT	SO YD	42	42						70000450	TUEDUCAL	DAVENENT HARVING LINE CO.	FOOT	1,680					
44000157	HOT-MIX ASPHALT SURFACE REMOVAL, 2"	SO YD	36,684	36,684	)					X 78000400	THERMUPLASTIC	C PAVEMENT MARKING - LINE 6"	1001		1,680				
44001700	COMBINATION CONCRETE CURB AND GUTTER REMOVAL AND REPLACEMENT	FOOT	275	275	3					X 78000600	THERMOPLASTIC	PAVEMENT MARKING - LINE 12"	FOOT	350	350				
44002212	HOT-MIX ASPHALT REMOVAL OVER PATCHES, 3"	SQ YD	2,469	2,469						<b>X</b> 78000650	THERMOPLASTIC	PAVEMENT MARKING - LINE 24"	FOOT	200	200				
44201749	CLASS D PATCHES, TYPE I, 9 INCH	SO YD	741	741			4 ,			<del>X</del> 78100100	RAISED REFLEC	CTIVE PAVEMENT MARKER	EACH	£ 152	152				
44201753	CLASS D PATCHES, TYPE II, 9 INCH	SQ YD	987	987						78300200	RAISED REFLEC	CTIVE PAVEMENT MARKER REMOVAL	EACH	1.15	115	1			
44201757	CLASS D PATCHES, TYPE III, 9 INCH	SQ YD	741	741	5					* 88600600	DETECTOR LOOF	P REPLACEMENT	FOOT	\$ 1089	1089				
48102100	AGGREGATE WEDGE SHOULDER, TYPE B	TON	389	389						x0322256		FORMATION SIGNING	SO FT	154. 2	154. 2				
60300305	FRAMES AND LIDS TO BE ADJUSTED	EACH	15	15								EVELING BINDER (MACHINE	TON	(1445	1445				
60300310	FRAMES AND LIDS TO BE ADJUSTED (SPECIAL)	EACH	19	19						0 55039700	METHOD), IL	-4. 75, N50 25 TO BE CLEANED	FOOT	100	100 \$4	7	-		
67000400	ENGINEER'S FIELD OFFICE, TYPE A	CAL MO	3	3						<b>/</b>		TRUCTURES TO	EACH	8	8				
67100100	MOBILIZATION	L SUM	1	1							BE CLEAN	IEO							
70102620	TRAFFIC CONTROL AND PROTECTION, STANDARD 701501	L SUM	1	1							* 50	ecially Hems							
70102635	TRAFFIC CONTROL AND PROTECTION, STANDARD 701701	L SUM	1	1							, , ,								
70300100	SHORT-TERM PAVEMENT MARKING	FOOT	6,696	6,696															
						~													
					,						\$								
											:								
											· ·								
												ONON·PARTICIPATING (100% STATE	E)						
				<u> </u>								1 Rev. B-31-09				EAU			TOTAL LOUS
(LE NAME = \pw_work\PWIDOT\P#	The state of the s	SIGNED - AWN -		REVISED REVISED			× = -14		STATE OF			BALLARD RD. (RAND	RD. TO GRE		Ε.)	F.A.U. RTE. 1319	SECTION 2009-067 RS	COUNTY	TOTAL SHEE NO.
		ECKED - TE -		REVISED REVISED			-	DEPART	MENT OF 1	TRANSPORT	ATION		SHEETS STA		O STA.	FED. ROAD DIS	T. NO. 1   ILLINOIS FEE	CONTRACT	

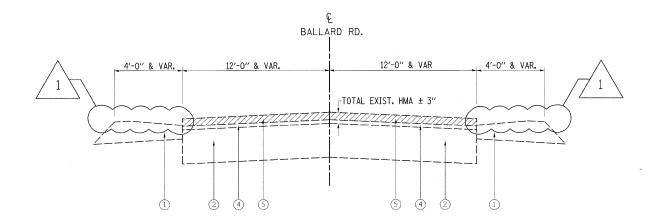

#### BALLARD RD. EXIST. TYPICAL SECTION STA. 15+98 TO STA. 48+49

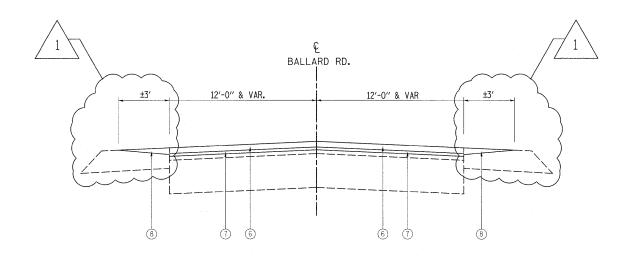

### BALLARD RD. EXIST. TYPICAL SECTION STA. 15+98 TO STA. 48+49

## LEGEND

- (1) EXIST. AGGREGATE SHOULDER
- ② EXIST. PCC BASE COURSE, (±)9"
- 3 EXIST. COMBINATION CONCRETE CURB AND GUTTER TYPE B-6.24
- 4 EXIST. REMAINING HMA AFTER MILLING, (±)1"
- (5) PROP. HOT-MIX ASPHALT SURFACE REMOVAL 2"
- 6 PROP. HOT-MIX ASPHALT SURFACE COURSE, MIX "D", N70, 11/2"
- 7 PROP. POLYMERIZED LEVELING BINDER (MM), IL-4.75, N50, 3/4"
- 8 PROP. AGGREGATE WEDGE SHOULDER, TYPE B

NOTE: CONTRACTOR SHALL PATCH FIRST BEFORE MILLING

## HOT-MIX ASPHALT MIXTURE REQUIREMENTS


MIXTURE TYPE	AC TYPE	AIR VOIDS			
HOT-MIX ASPHALT SURFACE COURSE, MIX "D", N70 (IL 9.5 mm)	PG 64-22	4% @ 70 GYR			
POLYMERIZED LEVELING BINDER, (MM), IL-4.75, N50	SBS/SBR PG 76-28/-22	4% @ 50 GYR			
CLASS D PATCHES, (HMA BINDER IL-19 mm)	PG 64-22*	4% @ 70 GYR			
HMA REPLACEMENT OVER PATCHES (HMA BINDER IL-19 mm)	PG 64-22 / 58-22	4% @ 70 GYR			


THE UNIT WEIGHT USED TO CALCULATE ALL HOT-MIX ASPHALT SURFACE MIXTURE QUANTITIES IS 112 LBS/SQYD/IN.


\*WHEN RAP EXCEEDS 20%, THE NEW ASPHALT BINDER IN THE MIX SHALL BE PG 58-22




											- 1
FILE NAME =	USER NAME = paraynoal	DESIGNED -	REVISED -		RΔ	LLARD RD. (RAND RD. TO GREENWOOD AVE.)	F.A.U.	SECTION	COUNTY	TOTAL SH	EET
c:\pw_work\pw:dot\paraynoal\d0145755\D178109-sht-plan.dgn		DRAWN - REVISED -		STATE OF ILLINOIS			1319	2009-067 RS	COOK	22 N	10.
	PLOT SCALE = 50.0000 '/ IN.	CHECKED -	REVISED -	DEPARTMENT OF TRANSPORTATION		TYPICAL SECTIONS	1313	2003 001 113		T NO. 60H	173
	PLOT DATE = 8/28/2009	DATE -	REVISED -		SCALE:	SHEET NO. OF SHEETS STA. TO STA.	FED. ROAD	D DIST, NO. 1 ILLINOIS FED. A'	ID PROJECT	1 1101 0011	

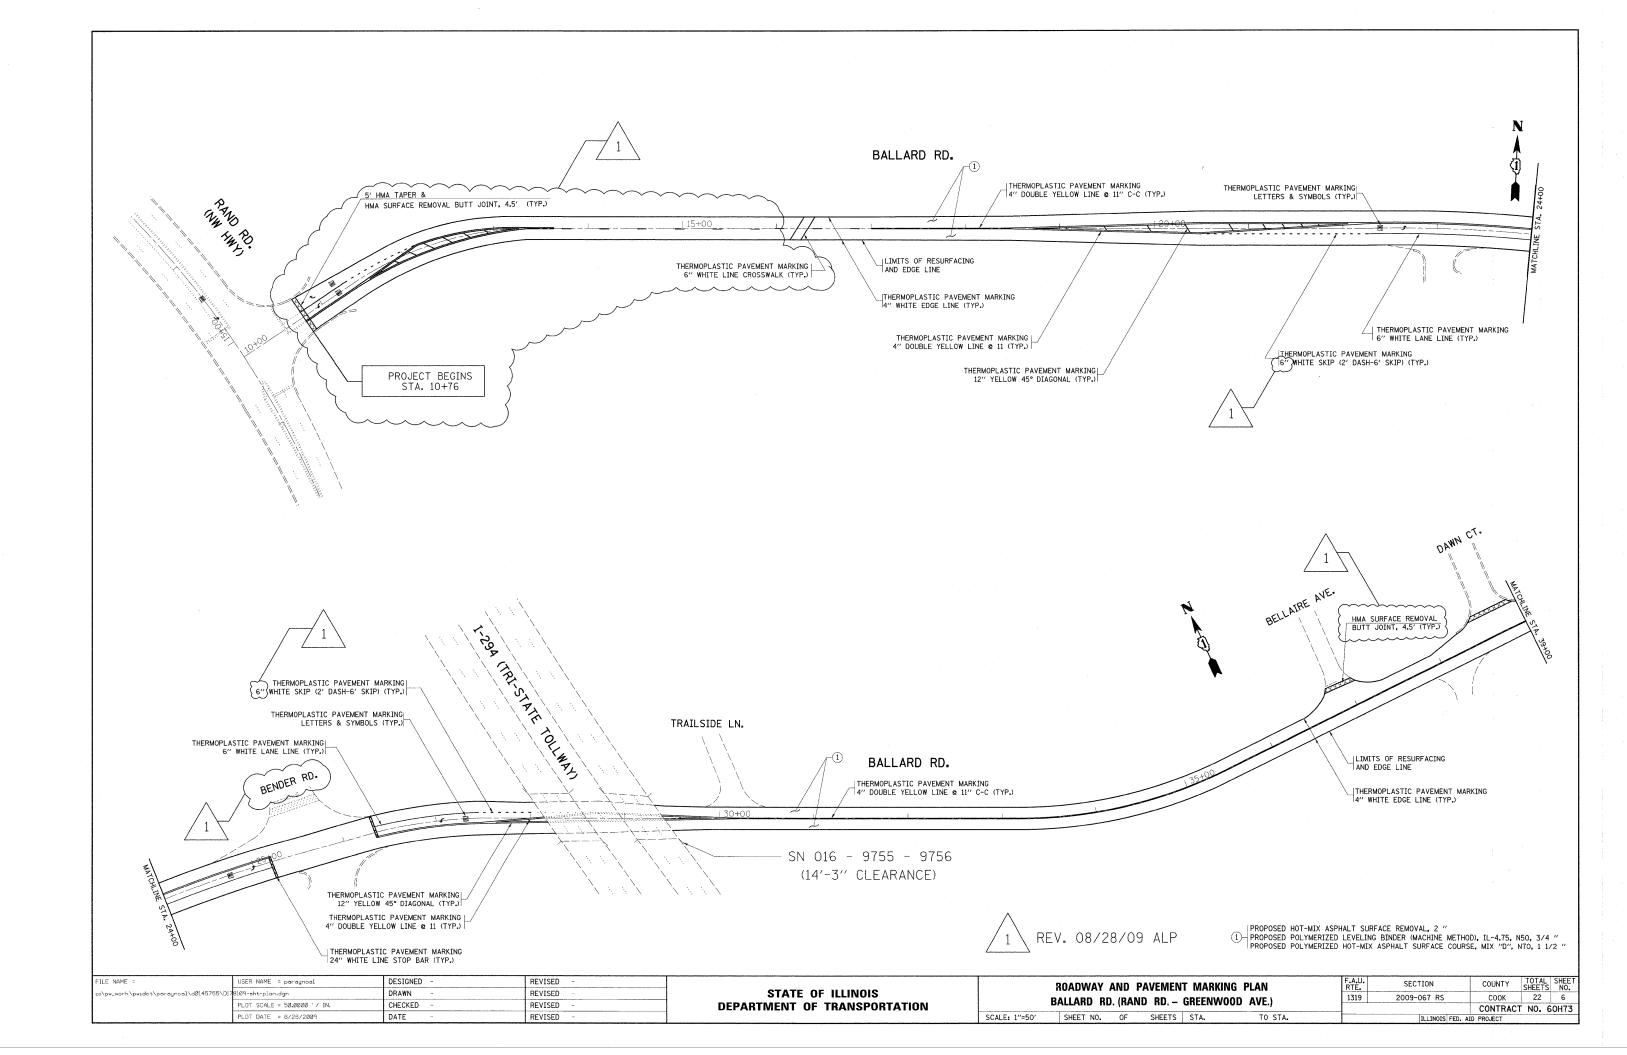

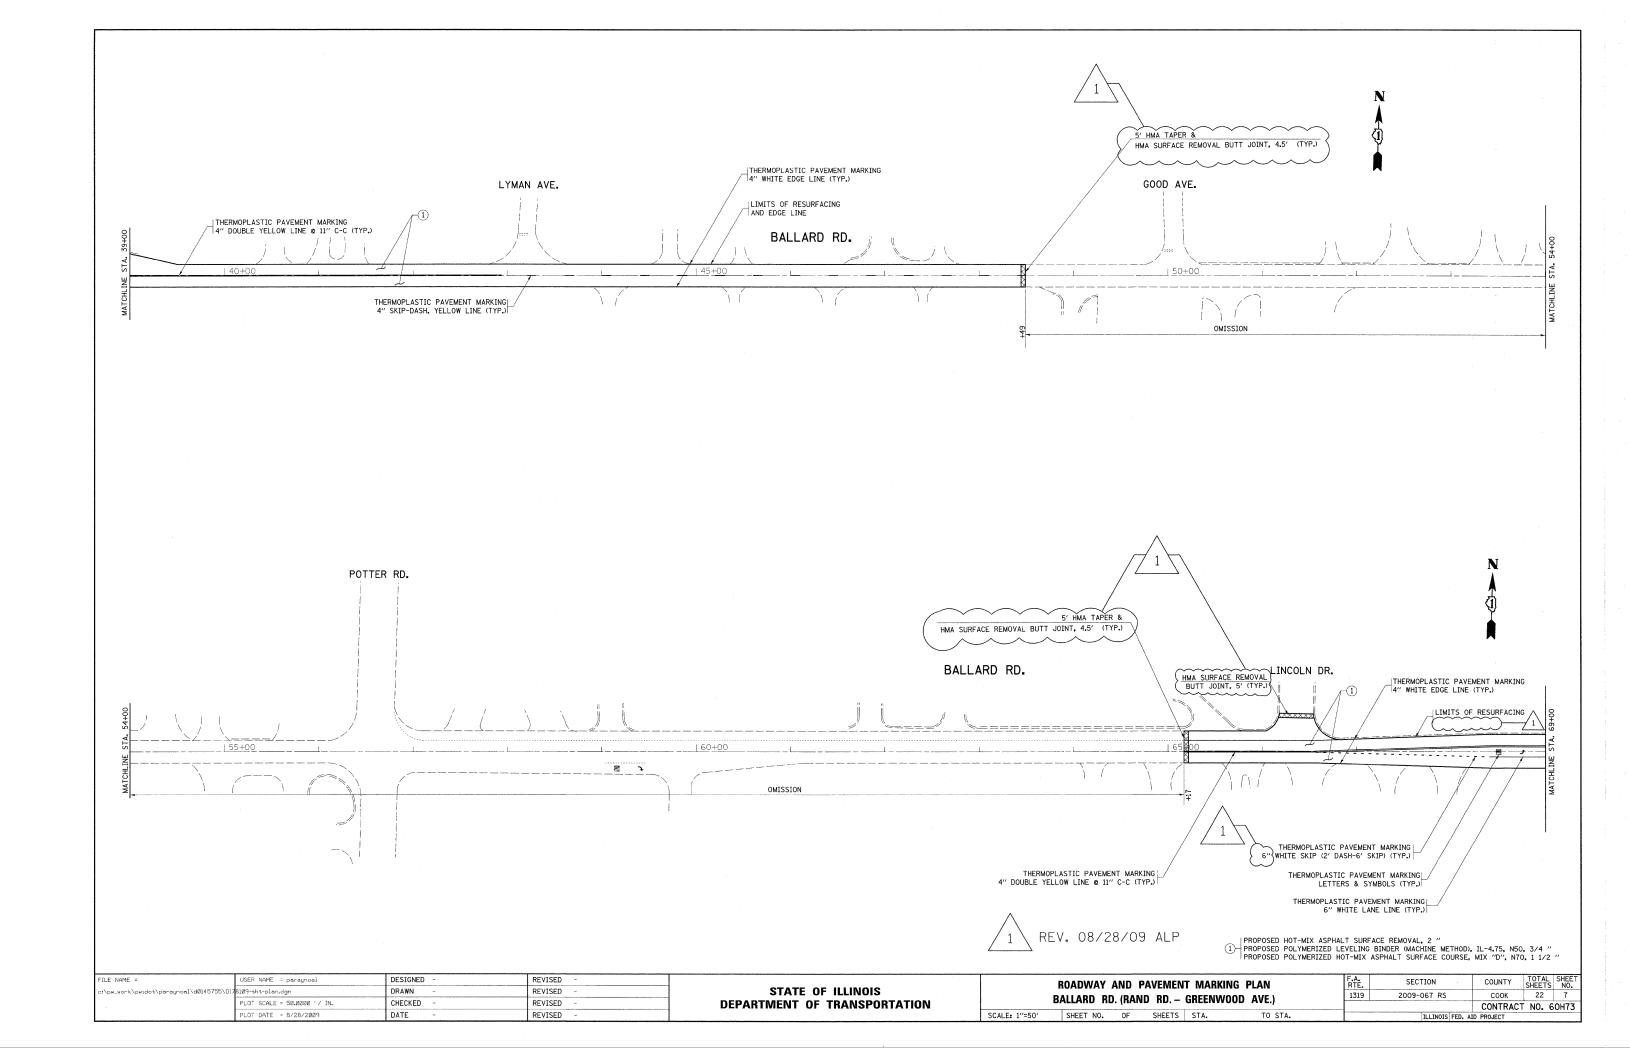

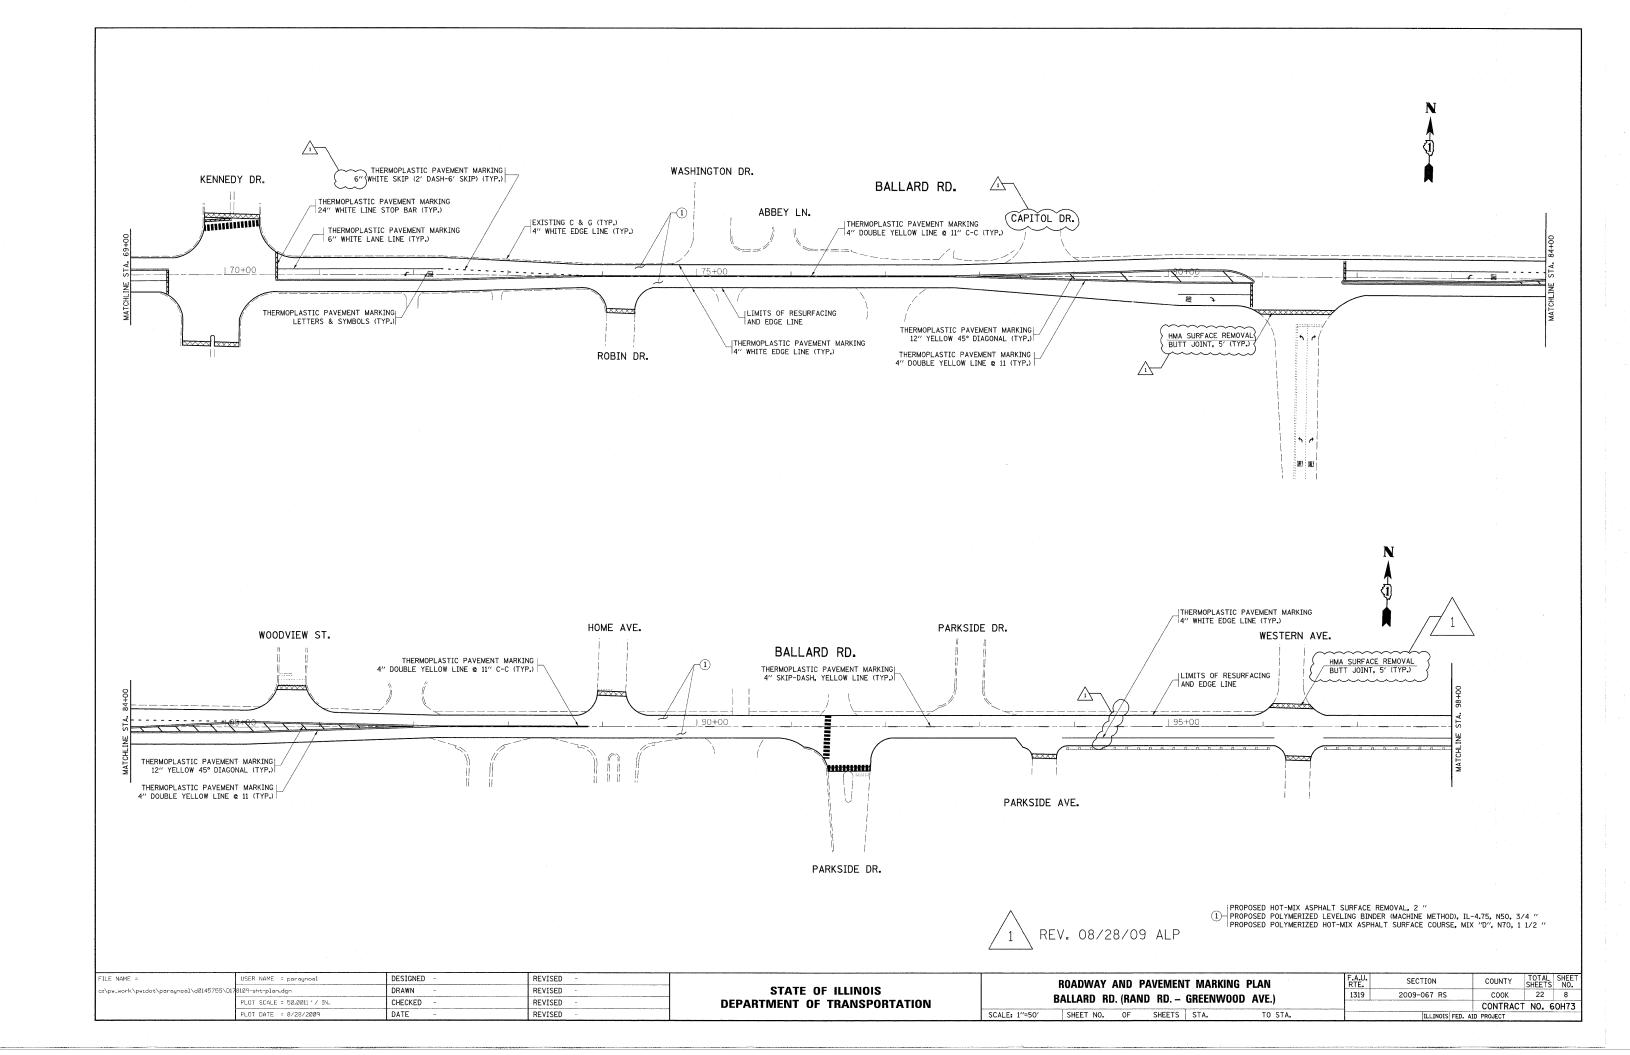

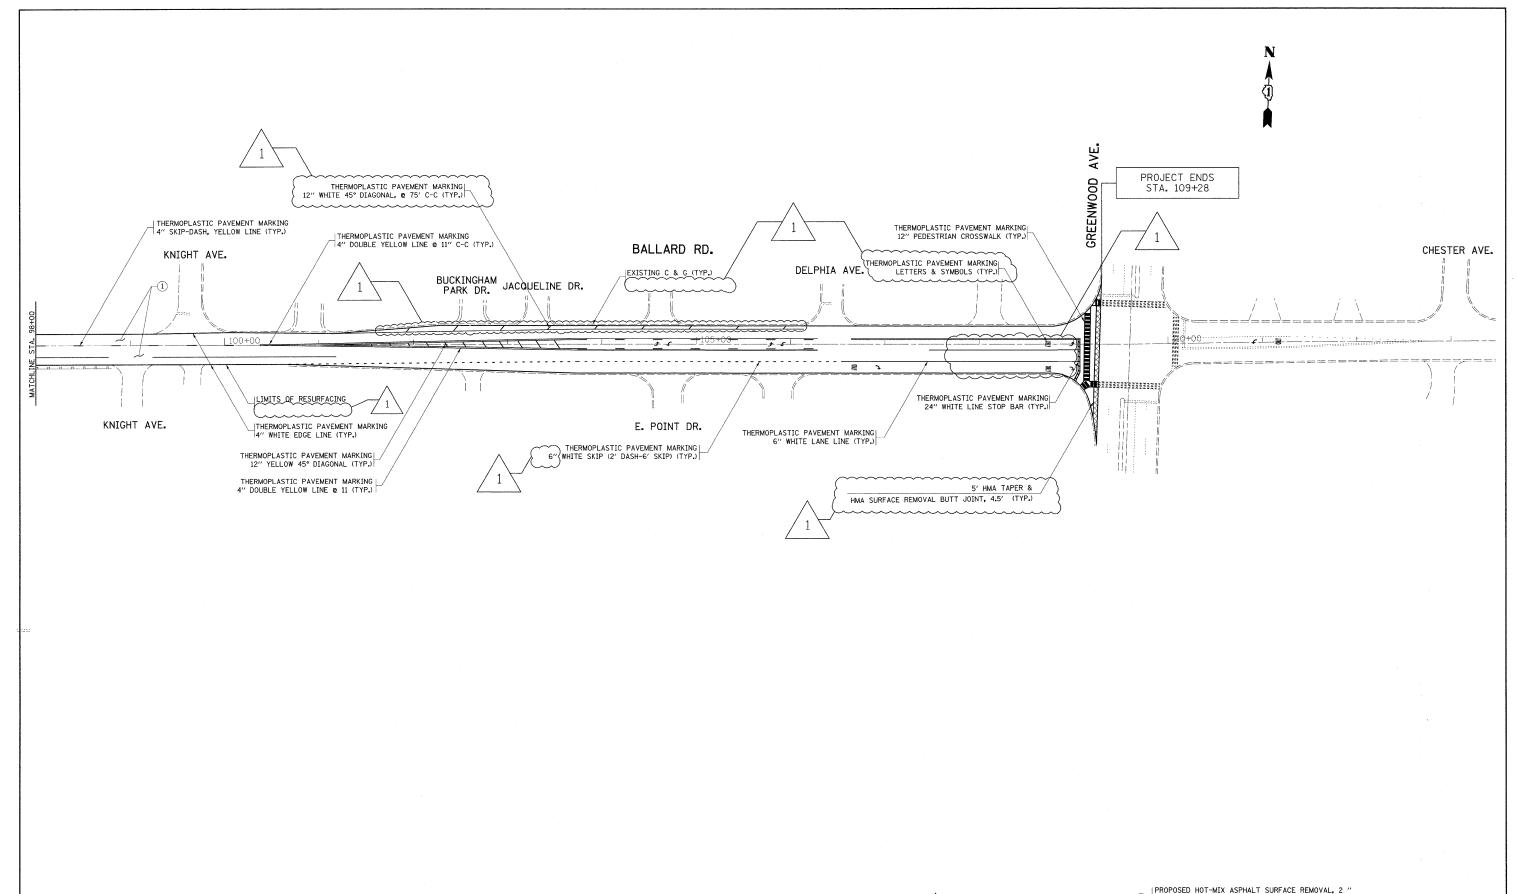

1 REV. 08/28/09 ALP

PROPOSED HOT-MIX ASPHALT SURFACE REMOVAL, 2 "
PROPOSED POLYMERIZED LEVELING BINDER (MACHINE METHOD), IL-4.75, N50, 3/4 "
PROPOSED POLYMERIZED HOT-MIX ASPHALT SURFACE COURSE, MIX "D", N70, 1 1/2 "

FILE NAME =	USER NAME = paraynoal	DESIGNED -	REVISED -	STATE OF ILLINOIS DEPARTMENT OF TRANSPORTATION SCAL		ROADWAY AND PAVEMENT MARKING PLAN						F.A.U.	SECTION	COUNTY	TOTAL	SHEET
o:\pw_work\pwidot\paraynoal\d0145755\D17	8109-sht-plan.dgn	DRAWN	REVISED -	STATE OF ILLINOIS								1319	2009-067 RS	СООК	22	9
	PLOT SCALE = 50.0000 '/ IN.	CHECKED ~	REVISED -	DEPARTMENT OF TRANSPORTATION	BALLARD RD. (RAND RD. – GREENWOOD AVE.)						D AVE.)			CONTRAC		60H73
	PLOT DATE = 8/28/2009	DATE -	REVISED -		SCALE: 1"=50'	SHEET NO.	OF	SHE	ETS	STA.	TO STA.		ILLINOIS FED.	AID PROJECT		

