09-20-2024 LETTING ITEM 070

STATE OF ILLINOIS

DEPARTMENT OF TRANSPORTATION

FOR INDEX OF SHEETS, SEE SHEET NO. 2

0

0

 \bigcirc

PROPOSED HIGHWAY PLANS

THIS IMPROVEMENT IS LOCATED IN THE CITY OF DES PLAINES. AND THE VILLAGES OF MORTON GROVE AND NILES.

TRAFFIC DATA IL 58 (GOLF ROAD) 2021 ADT: 34,700

POSTED SPEED LIMIT: 35 - 40 MPH

LOCATION #1:

FAP ROUTE 339 - IL 58 (GOLF RD)

FROM I-294 (TRI-STATE TOLLWAY) TO LINCOLN ST

SMART OVERLAY WITH ADA IMPROVEMENTS


OR ROUTE 1320 - ELK BLV

FROM US12/45 TO US 12

DESIGNED OVERLAY

LOCATION #2: OR ROUTE 1320 - ELK BLVD

SECTION: FAP 0339 22 RS PROJECT: NHPP-P6GK(045)

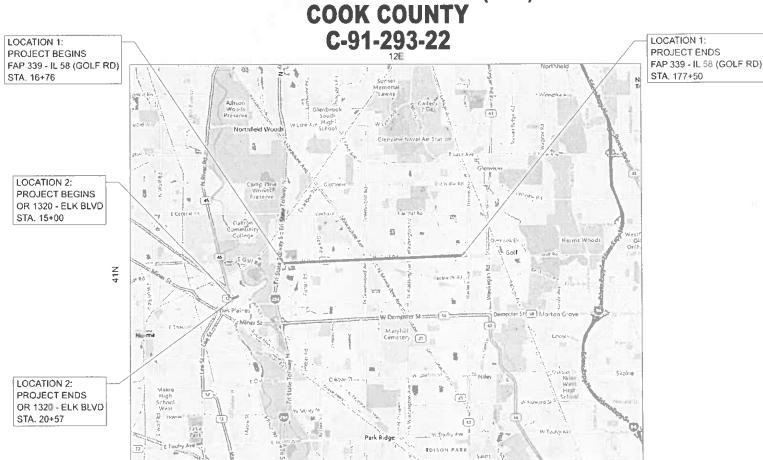

PROJECT ENGINEER: RODRIGO LEDEZMA (847) 705-4580 PROJECT MANAGER: J. ALAIN MIDY (847) 221-3056

GROSS LENGTH = 16,624 FT. = 3.148 MILE NET LENGTH = 16,624 FT. = 3.148 MILE

MAINE TOWNSHIP

CONTRACT NO. 62T11

1-800-892-0123 OR 811

ENGINEERING SCALES. REDUCED SIZED PLANS WILL NOT

ON REDUCED PLANS, THE ABOVE SCALES MAY BE USED.

JOINT UTILITY LOCATION INFORMATION FOR EXCAVATION

CONFORM TO STANDARD SCALES. IN MAKING MEASUREMENTS

PRINTED BY THE AUTHORITY OF THE STATE OF ILLINOIS

STATE OF ILLINOIS DEPARTMENT OF TRANSPORTATION

REVISED SHEET 9/6/2024

REV-SEP



INDEX OF SHEETS

SHEET

DESCRIPTION STANDARD NO. NO. MANNE THE RESTRICTION OF THE PERSON OF THE P COVER SHEET 000001-07 INDEX OF SHEETS, STATE STANDARDS, AND GENERAL NOTES 2 - 2a 701101-05 3 - 5 SUMMARY OF QUANTITIES 701106-02 6 - 7 TYPICAL SECTIONS 701427-05 8 - 13 IL 58 ROADWAY PLAN 701456-05 14 ELK BLVD ROADWAY PLAN 701601-09 14a CENTRAL RD DRAINAGE PLAN 701606-10 ADA IMPROVEMENT DETAILS 701611-01 15 - 22 23a - 31b APS AND DETECTOR LOOP SIGNAL PLANS 701701-10 32 FRAMES AND LIDS ADJUSTMENT WITH MILLING (BD-08) 701801-06 33 PAVEMENT PATCHING FOR HMA SURFACED PAVEMENT (BD-22) 701901-09 34 CURB OR CURB AND GUTTER REMOVAL AND REPLACEMENT (BD-24) 35 BUTT JOINTS AND HMA TAPER (BD-32) 36 ENTRANCE AND EXIT RAMP CLOSURE DETAILS (TC-08) 37 TRAFFIC CONTROL AND PROTECTION FOR SIDEROADS, INTERSECTIONS, AND DRIVEWAYS (TC-10) 38 RAISED REFLECTIVE PAVEMENT MARKERS (SNOW PLOW RESISTANT) (TC-11) DISTRICT ONE TYPICAL PAVEMENT MARKINGS (TC-13) 39 40 TRAFFIC CONTROL AND PROTECTION AT TURN BAYS (TO REMAIN OPEN TO TRAFFIC) (TC-14) SHORT-TERM PAVEMENT MARKING LETTERS AND SYMBOLS (TC-16) 41 42 ARTERIAL ROAD INFORMATION SIGN (TC-22) 43 DRIVEWAY ENTRANCE SIGNING (TC-26) 44 - 50 STANDARD TRAFFIC CONTROL SIGNAL DESIGN DETAILS (TS-05) DETECTOR LOOP INSTALLATION DETAIL FOR ROADWAY RESURFACING (TS-07) 51

STATE STANDARDS

STANDARD SYMBOLS, ABBREVIATIONS, AND PATTERNS

DESCRIPTION

OFF-RD OPERATIONS, MULTILANE, 15' (4.5 m) TO 24" (600 mm) FROM PAVEMENT EDGE
OFF-RD OPERATIONS, MULTILANE, MORE THAN 15' (4.5 m) AWAY
LANE CLOSURE, MULTILANE, INTERMITTENT OR MOVING OPER., FOR SPEEDS < 40 MPH
PARTIAL EXIT RAMP CLOSURE, FREEWAY/EXPRESSWAY
URBAN LANE CLOSURE, MULTILANE, 1W OR 2W WITH NONTRAVERSABLE MEDIAN
URBAN SINGLE LANE CLOSURE, MULTILANE, 2W WITH MOUNTABLE MEDIAN
URBAN HALF ROAD CLOSURE, MULTILANE, 2W WITH MOUNTABLE MEDIAN
URBAN LANE CLOSURE, MULTILANE INTERSECTION
SIDEWALK, CORNER OR CROSSWALK CLOSURE
TRAFFIC CONTROL DEVICES


GENERAL NOTES

- THE CONTRACTOR WILL NOT BE ALLOWED TO SET UP A YARD OR FIELD OFFICE ON STATE PROPERTY WITHOUT WRITTEN PERMISSION FROM THE DEPARTMENT.
- ALL MILLED SURFACES SHALL BE A UNIFORM CROSS SLOPE PER LANE AND FREE OF RIDGES BETWEEN PASSES. ANY DEVIATIONS SHALL BE CORRECTED AT NO COST TO THE DEPARTMENT.
- BUTT JOINTS SHALL BE INSTALLED AT THE ENDS OF ALL RESURFACING (WHERE RESURFACING MEETS EXISTING PAVEMENT) ACCORDING TO THE "BUTT JOINT AND HOT-MIX ASPHALT TAPER DETAILS" SHEET INCLUDED IN THE PLANS, UNLESS OTHERWISE SPECIFIED.
- ALL PAVEMENT PATCHING LOCATIONS WILL BE DETERMINED IN THE FIELD BY THE ENGINEER.
- LOCATION OF COMBINATION CONCRETE CURB AND GUTTER REMOVAL AND REPLACEMENT [OR COMBINATION CURB AND GUTTER (THE TYPE SPECIFIED ON THE PLANS)], WILL BE DETERMINED IN THE FIELD BY THE ENGINEER.
- TEN (10) FOOT TRANSITIONS SHALL BE USED TO MATCH PROPOSED CURB AND GUTTER AND MEDIAN ITEMS OF WORK TO EXISTING CURBS AND GUTTER AND MEDIANS IN THE FIELD,
- DRAINAGE ADJUSTMENT OR RECONSTRUCTION LOCATIONS WILL BE DETERMINED IN THE FIELD BY THE ENGINEER.
- IT SHALL BE THE CONTRACTOR'S RESPONSIBILITY TO VERIFY ALL DIMENSIONS AND CONDITIONS EXISTING IN THE FIELD PRIOR TO CONSTRUCTION AND ORDERING OF MATERIALS.
- FRAMES AND GRATES ADJUSTMENT OF PRIVATE UTILITIES WITHIN THE LIMITS OF THE IMPROVEMENTS SHALL BE DONE BY THEIR RESPECTIVE OWNERS AND ARE NOT PART OF THIS CONTRACT.
- THE CONTRACTOR SHALL BE REQUIRED TO KEEP A RECORD OF THE LOCATIONS OF PLATED STRUCTURES BY STATION AND OFFSET LEFT OR RIGHT OF THE CENTERLINE OF PAVEMENT.
- THE CONTRACTOR SHALL BE REQUIRED TO KEEP A RECORD OF THE LOCATIONS OF THE BURIED STRUCTURES ACCORDING TO THE STATION AND DISTANCE LEFT OR RIGHT OF THE CENTERLINE OF PAVEMENT. UPON COMPLETION OF THE WORK, THE CONTRACTOR SHALL DELIVER THE RECORD TO THE ENGINEER.
- EXISTING BROKEN FRAMES AND LIDS SHALL BE REMOVED AND DISPOSED OF BY THE CONTRACTOR AND SHALL BE REPLACED AS DIRECTED BY THE ENGINEER. REPLACEMENT FRAMES AND LIDS WILL BE PAID FOR ACCORDING TO ARTICLE 109.04 OF THE STANDARD SPECIFICATIONS UNLESS A SEPARATE PAY ITEM HAS BEEN PROVIDED.
- 13 THE CONTRACTOR SHALL CONTACT THE DISTRICT ONE TRAFFIC CONTROL SUPERVISOR AT KALPANA.KANNAN-HOSADURGA@ILLINOIS.GOV A MINIMUM OF 72 HOURS IN ADVANCE OF BEGINNING WORK
- 14 THE ENGINEER SHALL CONTACT FADI SULTAN, AREA TRAFFIC FIELD ENGINEER, AT (847) 772-4058 A MINIMUM OF TWO (2) WEEKS PRIOR TO THE PLACEMENT OF PERMANENT PAVEMENT MARKINGS.
- 15 PAVEMENT MARKING TAPE, TYPE IV SHALL BE USED FOR SHORT TERM PAVEMENT MARKINGS ON ALL FINAL SURFACES.
- OVERNIGHT LANE CLOSURES SHALL NOT BE ALLOWED FOR REHABILITATION PROJECTS INVOLVING DAYTIME MILLING AND RESURFACING OPERATIONS AND CLASS D PATCHING UNLESS OTHER CONDITIONS WARRANT EXTENDED LANE CLOSURES AS DETERMINED AND APPROVED IN WRITING BY THE ENGINEER OR AS PROVIDED FOR IN THE CONTRACT

/1\REVISED SHEET 8/28/2024



LOCATION #1 ILLINOIS ROUTE 58 (GOLF ROAD) FROM I-294 (TRI-STATE TOLLWAY) TO LINCOLN STREET

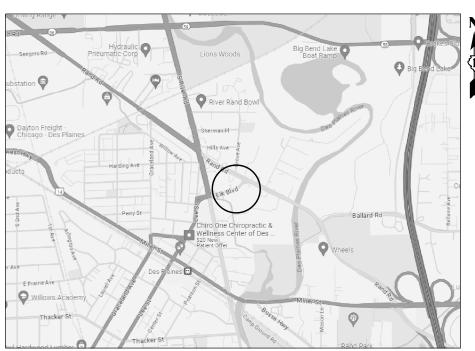



Take 5 Oil Change Golf Mill Chevrolet S Auto repair sh

> LOCATION #3 CENTRAL ROAD AT LOTUS LANE

ADDED ENTIRE SHEET 8/28/2024

USER NAME = Jacob.Roth	DESIGNED -	BBB	REVISED - /	1 JPR 8/27/2024
	DRAWN -	CCC	REVISED -	RV2
PLOT SCALE = \$SCALE\$	CHECKED -	AAA	REVISED -	RV3
PLOT DATE = 8/27/2024	DATE _	XX/XX/XX	REVISED -	RV4

STATE OF ILLINOIS DEPARTMENT OF TRANSPORTATION

•			•	GENERAL NOTES WAY) TO LINCOLN ST
SHEET 1	OF	SHEETS	STA.	TO STA.


			OHLLI	0/20/2	.02-
F.A.P RTE.	SECTION		COUNTY	TOTAL SHEETS	SHEE NO.
339	FAP 0399 22 RS		соок	51	2a
			CONTRACT	NO. 62	Γ11
	ILLINOIS	EED AI	D PROJECT		


 Λ

IL R SCALE:

	SUMMARY OF QUANTITIES			IL 58 80% FED 20% STATE 0004	IL 58 80% FED 20% STATE 0021	IL 58 100% STATE 0044	}	LOTUS LANE 100% STATE 0044	3				SUMMARY	OF QUA	ANTITIE	S				IL 58 80% FED 20% STATE 0004	IL 58 80% FED 20% STATE 0021	IL 58 100% STATE 0044	EIK BIVD-LO	OTUS LANE 100% STATE 0044	\triangle
Code No.	ltem	Unit	Total Quantity							ļ	Code No.			Item			ı	Jnit	Total Quantity					uu	
20101400	NITROGEN FERTILIZER NUTRIENT	POUND	4	4							44000200	DRIVEWAY PAVEMENT	REMOVAL				sc) YD	60.4	52			8.4		
00404500	DUODDUO FERTILIZED MUTDIENT	BOLIND	4								44000000	OIDEMALK DEMOVAL							5000	5000					
20101500	PHOSPHORUS FERTILIZER NUTRIENT	POUND	4	4							44000600	SIDEWALK REMOVAL					50	Q FT	5238	5238					
20101600	POTASSIUM FERTILIZER NUTRIENT	POUND	4	4							44002207	HOT-MIX ASPHALT REM	MOVAL OVER PATCHES,	1 3/4"			so	YD	759	759					
			~~~				(	~~~																	
20200100	EARTH EXCAVATION		180	28.5	<u></u>	$\sim$	$\longrightarrow$	151.5			44201761	CLASS D PATCHES, TY	PE I, 10 INCH				so	YD	4				4		
71 1	TRENCH BACKFILL  TOPSOIL FURNISH AND PLACE, 4"	CUYD	3	سيب			<del></del>	3	K —																
21101615	TOPSOIL FURNISH AND PLACE, 4"	SQYD	210	172			38				44201765	CLASS D PATCHES, TY	PE II, 10 INCH				SC	) YD	82				82		
25200110	SODDING, SALT TOLERANT	SQ YD	210	172			38				44201769	CLASS D PATCHES, TY	PE III, 10 INCH				so	) YD	48				48		
25200200	SUPPLEMENTAL WATERING	UNIT	2	2							44201771	CLASS D PATCHES, TY	PE IV, 10 INCH				SC	Q YD	38				38		
35501316	HOT-MIX ASPHALT BASE COURSE, 8"	SQ YD	17	17							44201773	CLASS D PATCHES, TY	PE I 11 INCH				90	) YD	8	8					
00001010	TICHNIX ACITIALI BACE COCIACE, C	OQ ID	- ''	''							44201770	OLAGO D'I ATORILO, TI	121, 1111011				- 00			1				+	
40600290	BITUMINOUS MATERIALS (TACK COAT)	POUND	59618	57485			2133				44201777	CLASS D PATCHES, TY	PE II, 11 INCH				sc	YD	359	351			7	8	/1\
																		4	w	<del>)</del>			<u> </u>		/
40600370	LONGITUDINAL JOINT SEALANT	FOOT	56410	54760			1650				44201781	CLASS D PATCHES, TY	PE III, 11 INCH	~~~~	~~~~	· · · · · · · · · · · · · · · · · · ·	SC	YD	200	200		~~~	~~~	~~	
										] }	54213660	PRECAST REINFORCED CO	ONCRETE FLARED END SEC	TIONS 15"			EA	СН	1						<u>/1</u>
40600400	MIXTURE FOR CRACKS, JOINTS, AND FLANGEWAYS	TON	240	192			48			] }	44201783	CLASS D PATCHES, TY	PE IV, 11 INCH			<u>~~~</u>	SC	W .	200	200		$\frac{1}{2}$	<u>~~~</u>	$\frac{1}{2}$	)— <u> </u>
										] }		CATCH BASINS, TYPE A, 4					EA		1					1	1
40600982	HOT-MIX ASPHALT SURFACE REMOVAL - BUTT JOINT	SQ YD	705	604			101				60252800	CATCH BASINS TO BE I	RECONSTRUCTED				EA	ACH	2	1			1		
40601005	HOT-MIX ASPHALT REPLACEMENT OVER PATCHES	TON	75	75							60262700	INLETS TO BE RECONS	STRUCTED				E/	ACH	1	1					
40602978	HOT-MIXASPHALT BINDER COURSE, IL- 9.5, N50	TON	310				310				60266600	VALVE BOXES TO BE A	DJUSTED				EA	СН	3	3					
40604060	HOT-MIX ASPHALT SURFACE COURSE, IL-9.5, MIX "D", N50	TON	313	3			310				60300105	FRAMES AND GRATES	TO BE ADJUSTED				EA	ACH	41	41					
40605026	POLYMERIZED HOT-MIX ASPHALT SURFACE COURSE, STONE MATRIXASPHALT, 9.5, MIX "F", N80	D TON	12519	12519							60300305	FRAMES AND LIDS TO	BE ADJUSTED				EA	ACH	9	8			1		
42001300	PROTECTIVE COAT	SQ YD	1054	1000			54				60404950	FRAMES AND GRATES,	, TYPE 24				EA	АСН	5	5					
42300400	PORTLAND CEMENT CONCRETE DRIVEWAY PAVEMENT, 8 INCH	SQ YD	35.4	27			8.4				60406000	FRAMES AND LIDS, TY	PE 1, OPEN LID				EA	ACH	3	2			1		
42400200	PORTLAND CEMENT CONCRETE SIDEWALK 5 INCH	SQ FT	5238	5238						-	60406100	FRAMES AND LIDS, TY	PE 1, CLOSED LID				EA	АСН	26	26		+			
000																			~~~	$\triangle$					
42400800	DETECTABLE WARNINGS	SQ FT	228	228						*	66900200	NON-SPECIAL WASTE I	DISPOSAL				CL	JYD	180	28.5			}	151.5	1
44000156	HOT-MIX ASPHALT SURFACE REMOVAL, 1 3/4"	SQ YD	127744	127744						- k	66900530	SOIL DISPOSAL ANALYS	SIS				EA	АСН	4	4					
Did in the second secon	·									] 1															
44000163	HOT-MIX ASPHALT SURFACE REMOVAL, 3 1/2"	SQ YD	3160				3160			*	66901001	REGULATED SUBSTAN	ICES PRE-CONSTRUCTION	ON PLAN			LS	SUM	1	1					
**************************************																	A DEVI	SED (	פטבר	T 9/20/	2024	% C □	ECIA!	   TV   T	
ğ 	USER NAME = Jacob.Roth DESIGNED - BBB	REVISED	) - F	RV1	I							I		A::====	V 05 0::::		/ REVIS	י חםכ	F.#	A.P	2024 SECTION		COUNTY		
NAME	DRAWN - CCC	REVISED	) - F	RV2					STATE C				IL ROUTE 58 (GOL		Y OF QUAN (Tri-State		Y) TO I INCO	LN C1	RI	TE.	FAP 0399 22		COOK		SHEET NO.
<b>4</b>	CHECKED - AAA	REVISED		RV3 RV4			D	EPARTM	IENT OI	F TRAN	SPORTATIO			T 1 OF 3			TO STA.	-H 3	<u>'</u>		[	INOIS   FED. AID		ACT NO. 6	

	SUMMARY OF QUANTITIES			IL 58 80% FED 20% STATE 0004	IL 58 80% FED 20% STATE 0021	IL 58 100% STATE 0044	100%	( STATE	8/1	<b>\</b>	SUMMARY OF QUANTIT	ΓΙES		80% FED 20% STATE	IL 58 80% IL 58 FED 100% 20% STATE STATE 0044 0021	ELK BLVD- 100% ( STATE (	LOTUS LANE 100% STATE 0044
Code No.	. Item	Unit	Total Quantity					the	₩_	Code No.	ltem	Unit	Total Quantity				wy'
X603031	0 FRAMES AND LIDS TO BE ADJUSTED (SPECIAL)	EACH		84									Quantity				
X670040	7 ENGINEER'S FIELD OFFICE, TYPE A (D1)	CAL MC	12	12													
X701101	5 TRAFFIC CONTROL AND PROTECTION (EXPRESSWAYS)	LSUM	1	1													
	` '																
X876020	0 ACCESSIBLE PEDESTRIAN SIGNALS	EACH	52		52												
														+			
X878001	2 CONCRETE FOUNDATION, TYPE A 12-INCH DIAMETER	FOOT	68		68												
X886010	5 DETECTOR LOOP REPLACEMENT	FOOT	200		200												
		+						+						+			
X889100	9 VIDEO VEHICLE DETECTION SYSTEM, SINGLE APPROACH	EACH	11		11		+	+						+			
		1	<del>  "</del>		<u> </u>		+	+	+					+			
Z001850	0 DRAINAGE STRUCTURES TO BE CLEANED	EACH	297			297		+						+			
		1	+			-51	+	+						+			
Z003085	0 TEMPORARY INFORMATION SIGNING	SQ FT	411.2	411.2			+	+						+			
		50,11	111.2	111.2				+						+			
7003304	4 RE-OPTIMIZE TRAFFIC SIGNAL SYSTEM LEVEL 1	FACH	8		8												
	4 RE-OPTIMIZE TRAFFIC SIGNAL SYSTEM LEVEL 1  0 STORM SEWER (WATER MAIN REQ UIREMENTS) 15 INCH	EACH FOOT	240	<u>4777</u>	m	<u> </u>	<del>                                      </del>	240	/   <i> </i> /								
	0 TRAINEES	- 1		1500	huu	<del>                                     </del>			n 🗀	7				+			
Z007660		HOUR	1	500				<u> </u>						+			
2007000	TVAINTEES - TVAINTING TROOTAN GRADUATE	HOOK	500	500										+			
														+			
								<u> </u>									
														+			
														++			
		+						-						+			
		+					+	+						+			
			1	1			+	+						+			
		+						+						+			
		+					+	+						+			
		-					-	+						+			
		+						+						+			
		-					-	+		_				+			
		+	+				-	+	+					+			
		-						+						+			
		-	1				-	-						+			
		+						+						+			
		-				<u> </u>		+						+			
											A DEL	ISED SHEET 9/99/9994			2042 : 1	ב הבריי	1 T\/ 1 T C N
	USER NAME = Jacob.Roth DESIGNED - BBB	REVISI	ED -	RV1	I							ISED SHEET 8/28/2024	[F	F.A.P RTE.	0042 <b>*</b> Section	COLINT	TOTAL SHE
	DRAWN - CCC	REVISI	ED -	RV2						OF ILLINOIS	SUMMARY OF QUIL ROUTE 58 (GOLF RD) - I-294 (TRI-SI				FAP 0399 22 RS	COOK	51 (
	CHECKED - AAA	REVISI	ED -	RV3 RV4		!		DEPAR1	<b>IMENT</b>	OF TRANSPORTATION			<u> </u>				ACT NO. 62T11

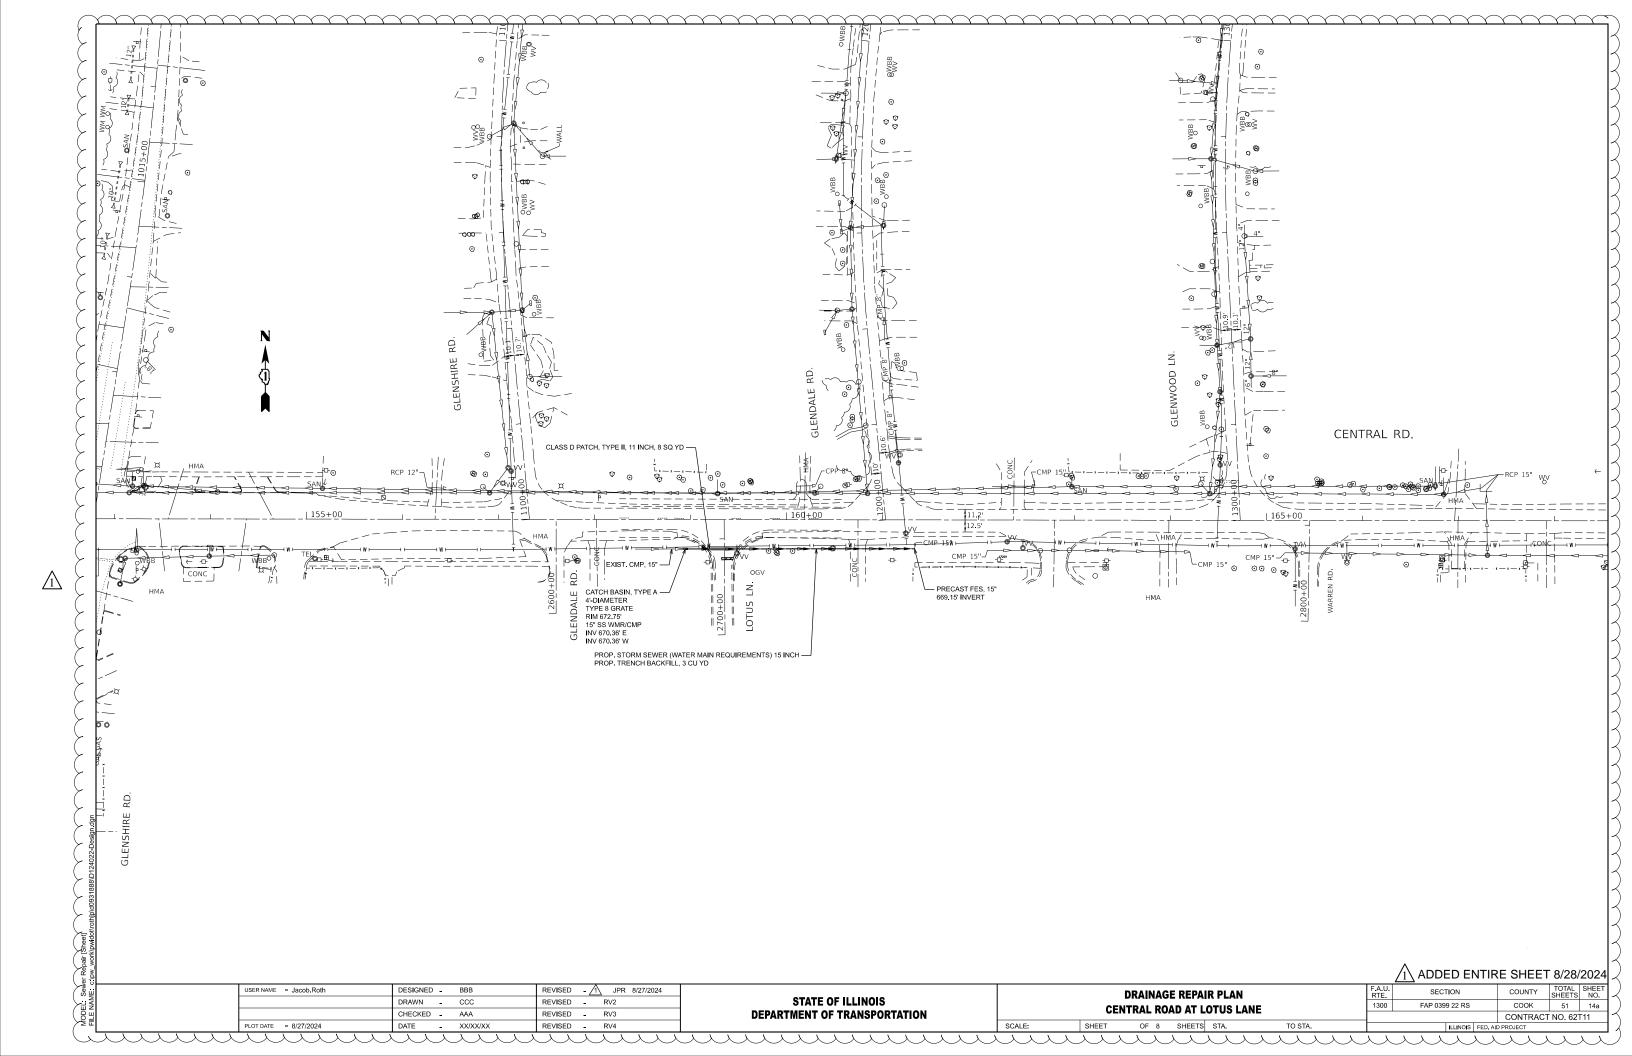

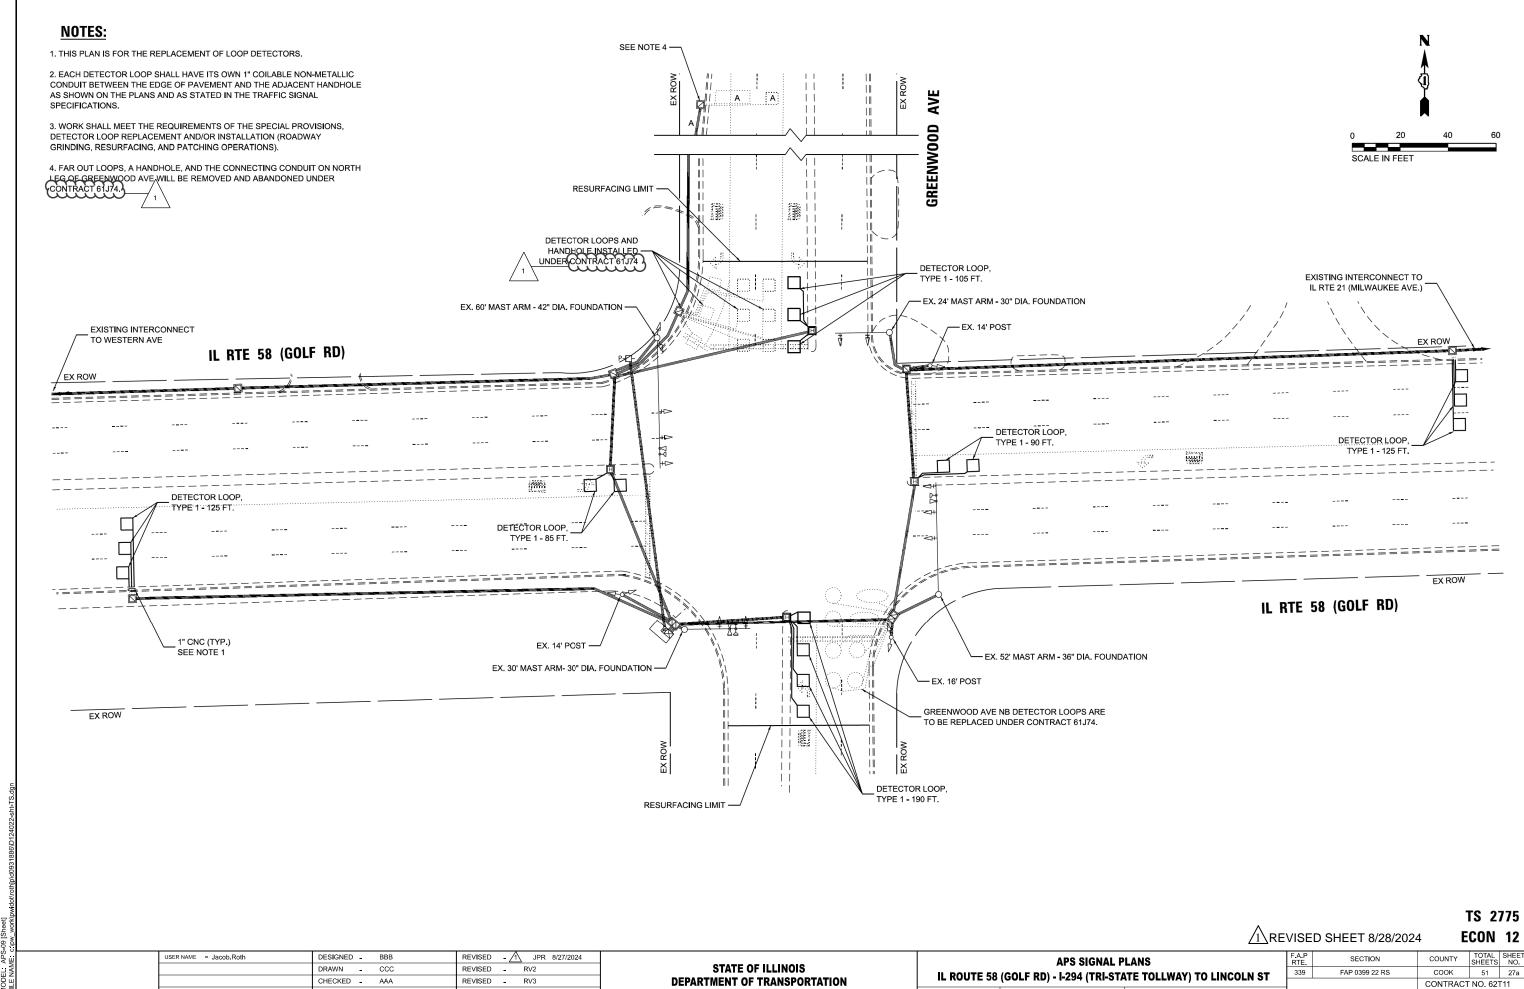

SHEET 1 OF 22 SHEETS STA.

MODEL APS-09 IShoot

PLOT DATE = 8/27/2024


DATE

XX/XX/XX


REVISED - RV4

#### **NOTES:**

- 1. THIS PLAN IS FOR THE REPLACEMENT OF LOOP DETECTORS.
- 2. EACH DETECTOR LOOP SHALL HAVE ITS OWN 1" COILABLE NON-METALLIC CONDUIT BETWEEN THE EDGE OF PAVEMENT AND THE ADJACENT HANDHOLE AS SHOWN ON THE PLANS AND AS STATED IN THE TRAFFIC SIGNAL SPECIFICATIONS.
- WORK SHALL MEET THE REQUIREMENTS OF THE SPECIAL PROVISIONS, DETECTOR LOOP REPLACEMENT AND/OR INSTALLATION (ROADWAY GRINDING, RESURFACING, AND PATCHING OPERATIONS).
- 4. EASTBOUND AND WESTBOUND FAR OUT LOOPS ARE TO BE REPLACED UNDER CONTRACT 61J74, AND THE CONTRACTOR SHALL COORDINATE WITH CONTRACT 61J74 REGARDING THESE LOOPS,

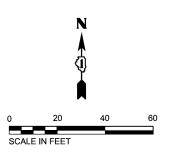

### **GOLF MILL PLAZA**

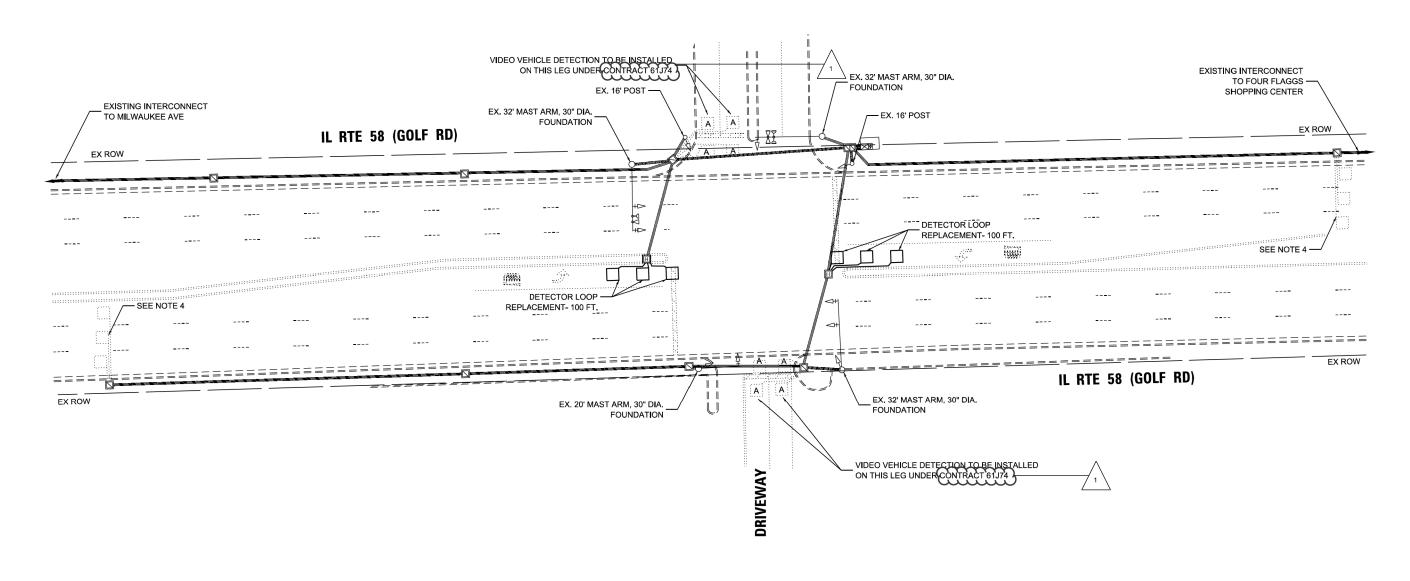

REVISED SHEET 8/28/2024


TS 11210 ECON 12


USER NAME = Jacob.Roth	DESIGNED -	BBB	REVISED	- 1 JPR 8/27/2024
	DRAWN -	CCC	REVISED	- RV2
	CHECKED -	AAA	REVISED	- RV3
PLOT DATE = 8/27/2024	DATE _	XX/XX/XX	REVISED	- RV4

STATE OF ILLINOIS	
DEPARTMENT OF TRANSPORTATION	

### **NOTES**:

- 1. THIS PLAN IS FOR THE REPLACEMENT OF LOOP DETECTORS.
- 2. EACH DETECTOR LOOP SHALL HAVE ITS OWN 1" COILABLE NON-METALLIC CONDUIT BETWEEN THE EDGE OF PAVEMENT AND THE ADJACENT HANDHOLE AS SHOWN ON THE PLANS AND AS STATED IN THE TRAFFIC SIGNAL SPECIFICATIONS.
- 3. WORK SHALL MEET THE REQUIREMENTS OF THE SPECIAL PROVISIONS, DETECTOR LOOP REPLACEMENT AND/OR INSTALLATION (ROADWAY GRINDING, RESURFACING, AND PATCHING OPERATIONS).
- 4. WESTBOUND FAR OUT LOOPS ARE TO BE REPLACED UNDER CONTRACT 61J74, AND THE CONTRACTOR SHALL COORDINATE WITH CONTRACT 61J74 REGARDING THESE LOOPS.

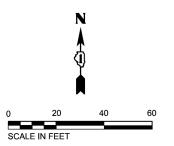

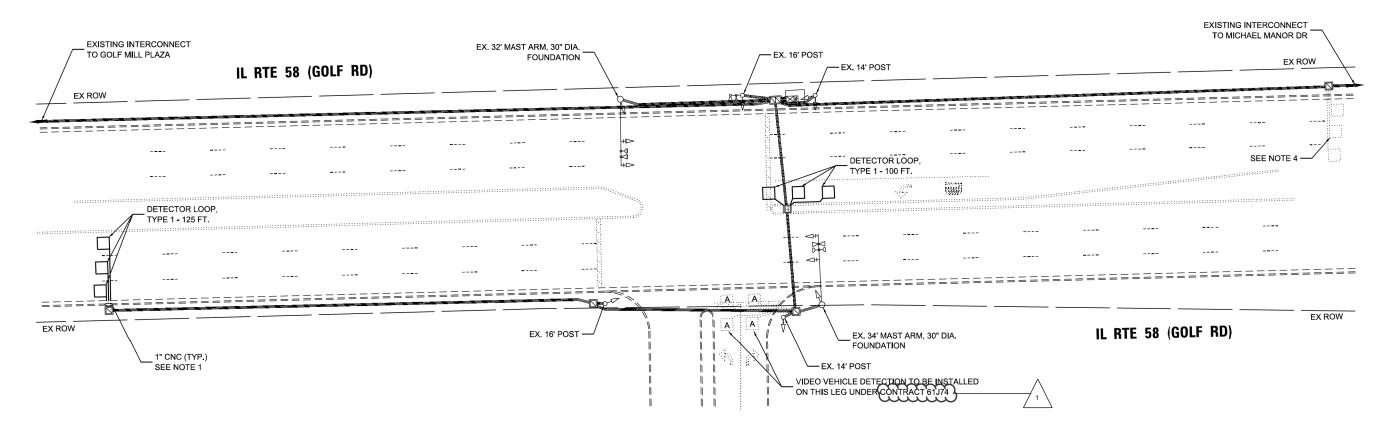


FOUR FLAGGS SHOPPING CENTER

↑ REVISED SHEET 8/28/2024

TS 2885

				⚠RE	VISED SHEET 8/28/2024	4 ECON 1	12
USER NAME = Jacob.Roth	DESIGNED - BBB	REVISED - 1 JPR 8/27/2024		DETECTOR LOOP REPLACEMENT PLAN	F.A.P SECTION	COUNTY TOTAL SI	HEET
	DRAWN - CCC	REVISED - RV2	STATE OF ILLINOIS	IL RTE 58 (GOLF RD) AT FOUR FLAGGS SHOPPING CENTER	339 FAP 0399 22 RS	COOK 51	28e
	CHECKED - AAA	REVISED - RV3	DEPARTMENT OF TRANSPORTATION	IL KIE 30 (GOLF KD) AI FOOK FLAGGS SHOPPING CENTER		CONTRACT NO. 62T1	11
PLOT DATE = 8/27/2024	DATE - XX/XX/XX	REVISED - RV4		SCALE: SHEET 1 OF 22 SHEETS STA. TO STA.	ILLINOIS FED. AII	D PROJECT	

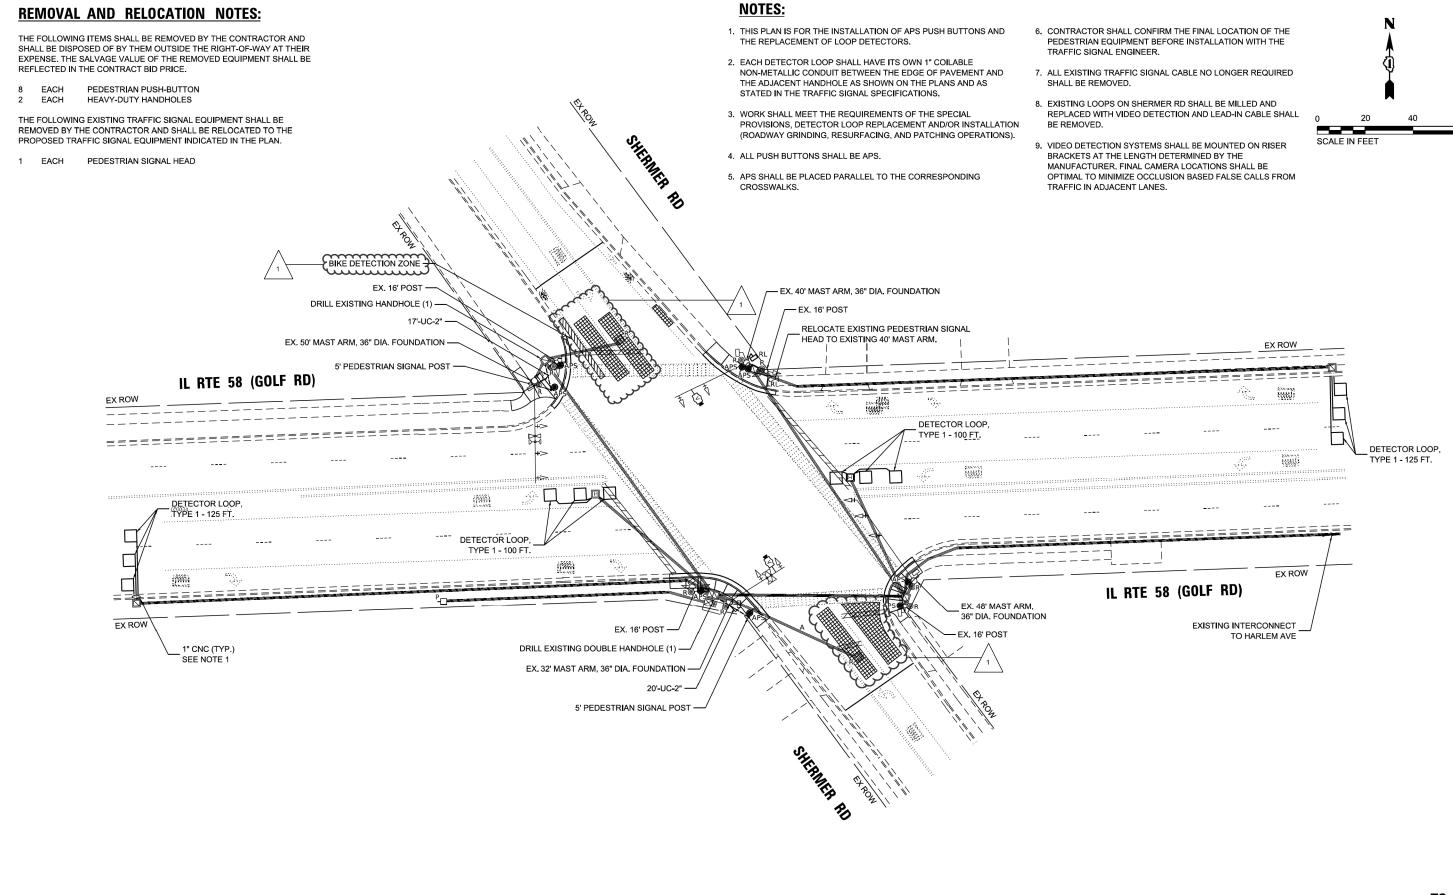

TS 2845
<a href="https://revised.sheet.8/28/2024">TS 2845</a>
<a href="https://revised.sheet.8/28/2024">ECON 8</a>

OSERTAMIC - JACOBITOUT	DESIGNED =	000	INLVIOLD	'	1 JFR 0/2//2024
	DRAWN -	CCC	REVISED	-	RV2
	CHECKED -	AAA	REVISED	-	RV3
PLOT DATE = 8/27/2024	DATE -	XX/XX/XX	REVISED	_	RV4

STATE OF ILLINOIS
DEPARTMENT OF TRANSPORTATION

SCALE:

F.A.P RTE.	SECTION		COUNTY	TOTAL SHEETS	SHEE NO.
339	FAP 0399 22 RS		COOK	51	31a
			CONTRACT NO. 62T11		
	ILLINOIS FE	PROJECT			