

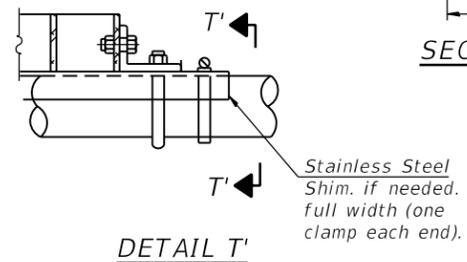
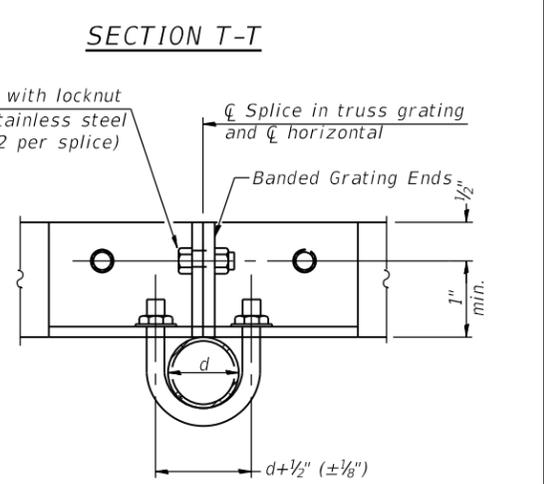
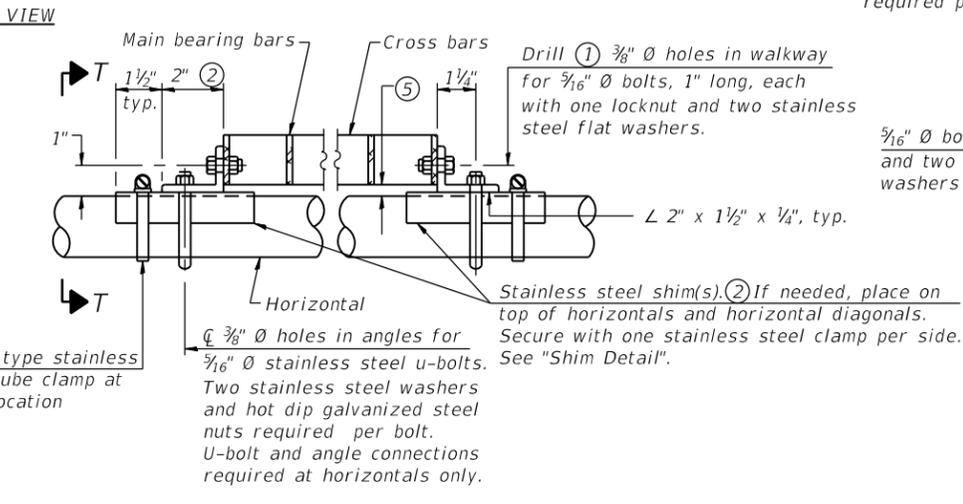
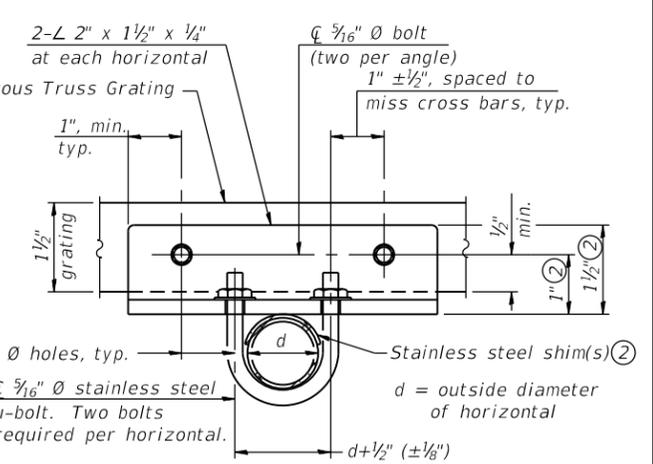
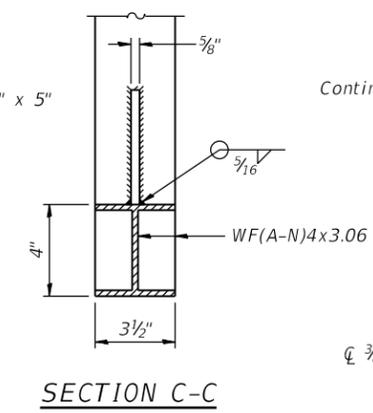
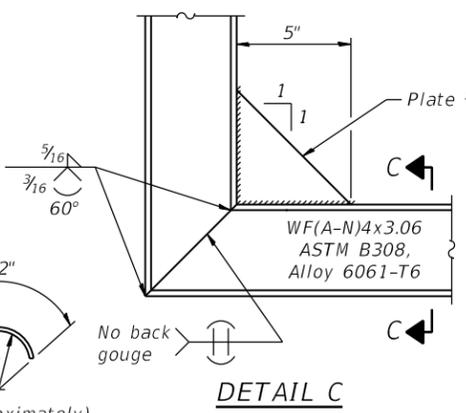
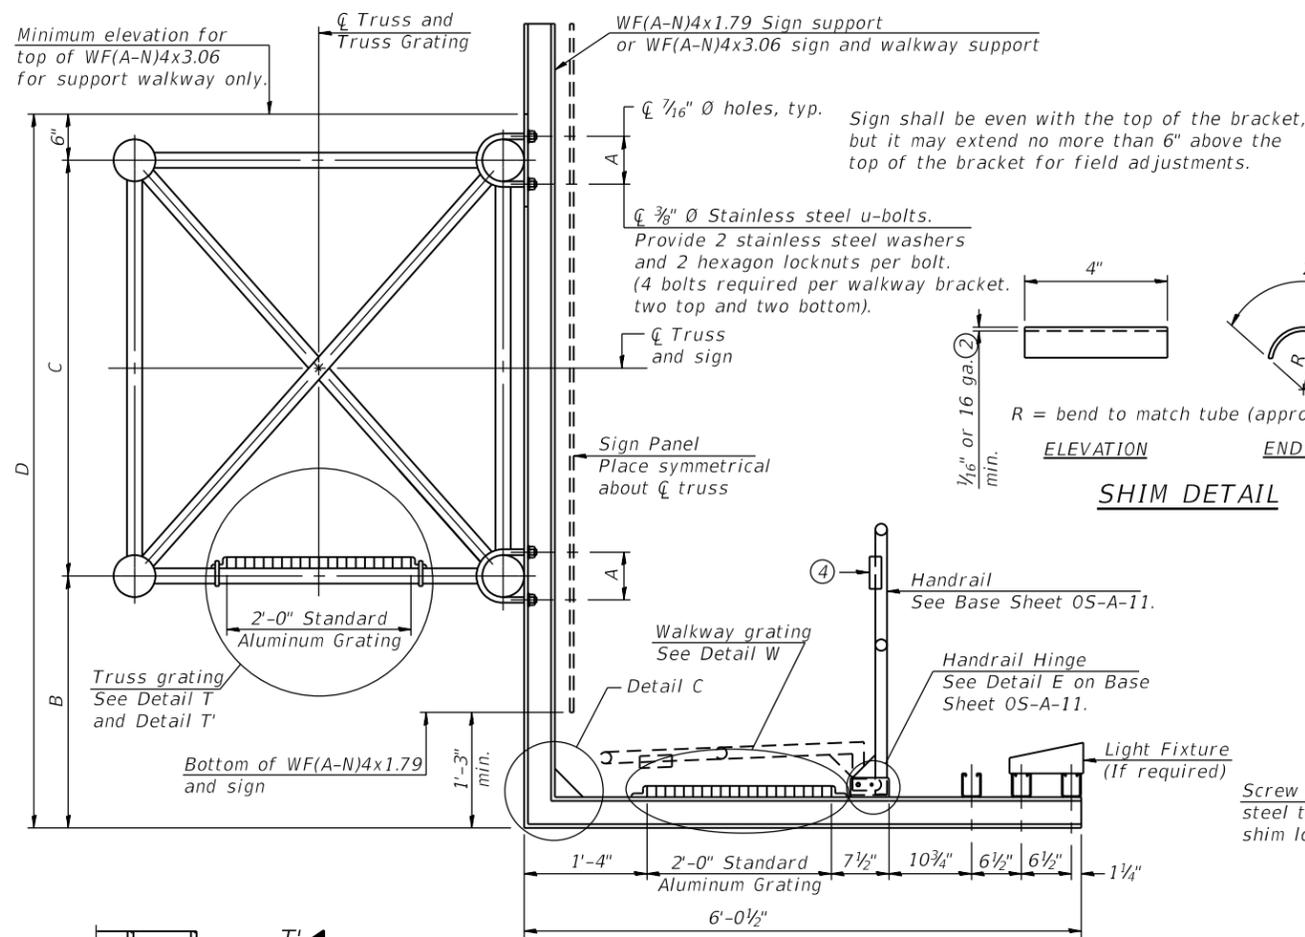
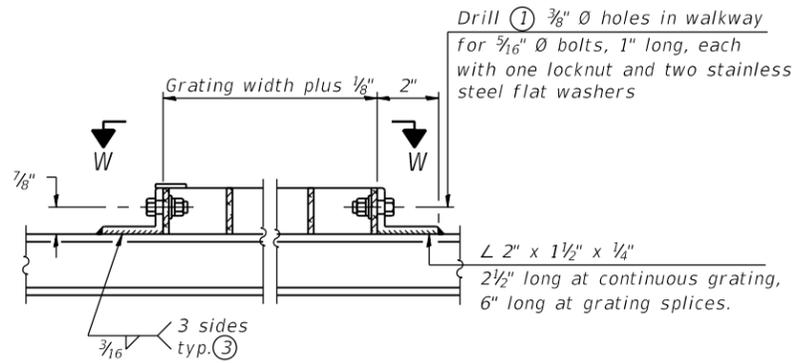


FILE NAME: D:\VAECOM\NA-AWS1\recomonline-local\VAECOM_DS02_NAVDocuments\01_Americas\Transportation\60269938_Circle\Phase_I\000_CAD\008_Structural\Sign_Structure\62131-Span-SS150-Sign-Struct.dgn

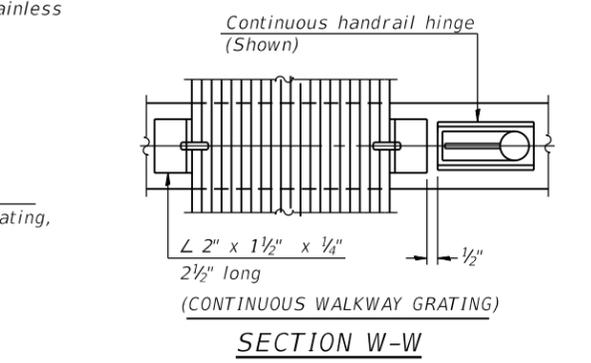

DETAIL T'
(Truss grating splice)
Details not shown same as Detail T.
Alternate materials may be used subject to the Engineer's review and approval.

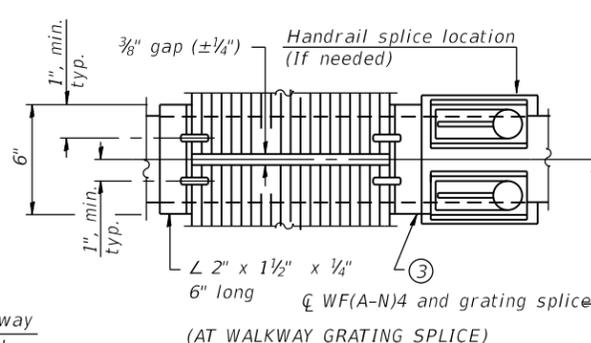

DETAIL W
(Walkway grating)

SPECIFICATIONS FOR STANDARD ALUMINUM GRATING

Main Bearing Bars shall be 3/16" x 1 1/2" on 1 3/16" centers and conform to ASTM B221 Alloy 6061-T6.
Cross bars shall be 3/16" x 1 1/2" on 4" centers and conform to ASTM B221 Alloy 6063-T5 or 6061-T6.
OR
Aluminum Grating with modified "t" sections for main bearing bars shall meet the following requirements:
Main bars shall conform to ASTM B221 Alloy 6061-T6 and have a minimum section modulus equal to 0.0705 in.³ per bar, a depth of 1 1/2", spaced on 1 3/16" centers.
Cross bars shall conform to ASTM B221 Alloy 6063-T5 or T-42 and spaced on 4" centers.

Structure Number	Station	A	⑥ B	C	⑥ D
ISO161094R050.1	1400+40.09	6"	3'-6"	4'-6"	8'-6"

- ① Drilling holes in grating may be done in shop or field, based on Contractor's preference and subject to accurate alignment.
- ② Stainless steel shims shall be placed as shown in Detail T if needed to compensate for alignment variations between horizontal and diagonal pipes beyond adjustment provided by angles. Thicker shims may be used subject to shims performing properly.
- ③ If Handrail Joint present, weld angle to WF(A-N)4 and 1/4" extension bars. (See Base Sheet OS-A-11.)
- ④ R 1/8" x 1/2" x 2" welded to handrail posts to protect locations that contact grating.
- ⑤ Tube to grating gap may vary from 0 to 1/2", max. to align walkway, allow for camber, etc.
- ⑥ Based on actual height of tallest sign given on OS-A-1.

OS-A-10

2-17-2017



USER NAME = marian.agamy	DESIGNED - JJS, AMS	REVISED -
PLOT SCALE = N.T.S	CHECKED - MI, MAI	REVISED -
PLOT DATE = 8/16/2019	DRAWN - AMS	REVISED -
	CHECKED - MI, MAI	REVISED -



STATE OF ILLINOIS
DEPARTMENT OF TRANSPORTATION

OVERHEAD SIGN STRUCTURES
ALUMINUM WALKWAY DETAILS

SHEET SS-08 OF SS-10 SHEETS

F.A.I. RTE. 90/94/290	SECTION 2019-054-I	COUNTY COOK	TOTAL SHEETS 400	SHEET NO. 201
CONTRACT NO. 62J31			ILLINOIS FED. AID PROJECT	

FILE NAME: D:\V\AECOM-NA-AWS1\ecomonline\local\AECOM_DS02_NAVDocuments\01_Americas\Transportation\60269938_Circle\Phase\Structural\Sign_Structures\62J11-Span-SS10-SS15-SignStructure.dgn

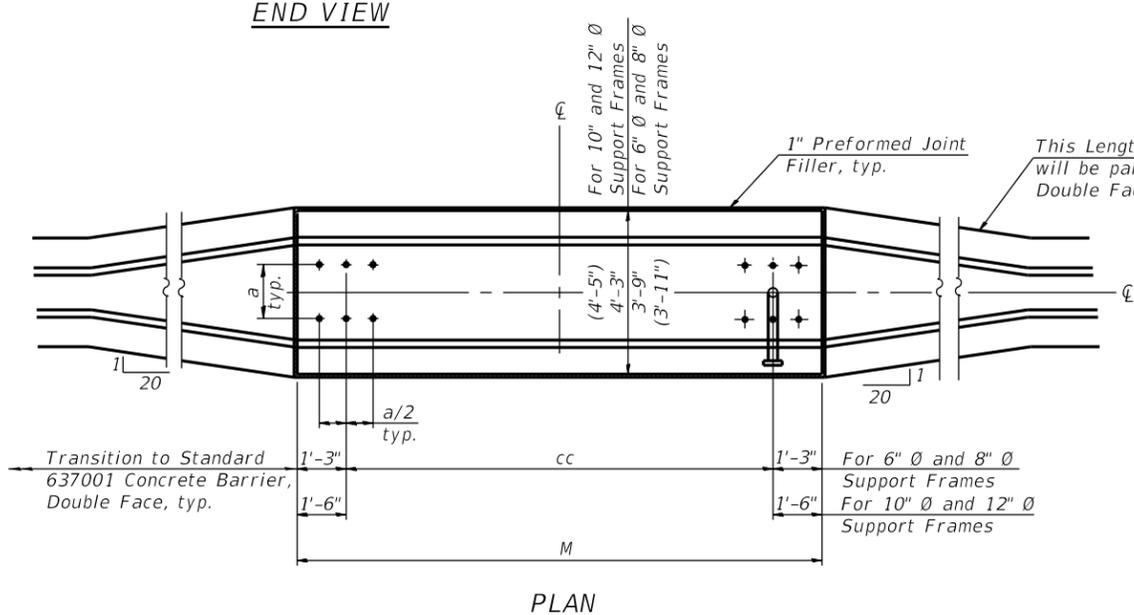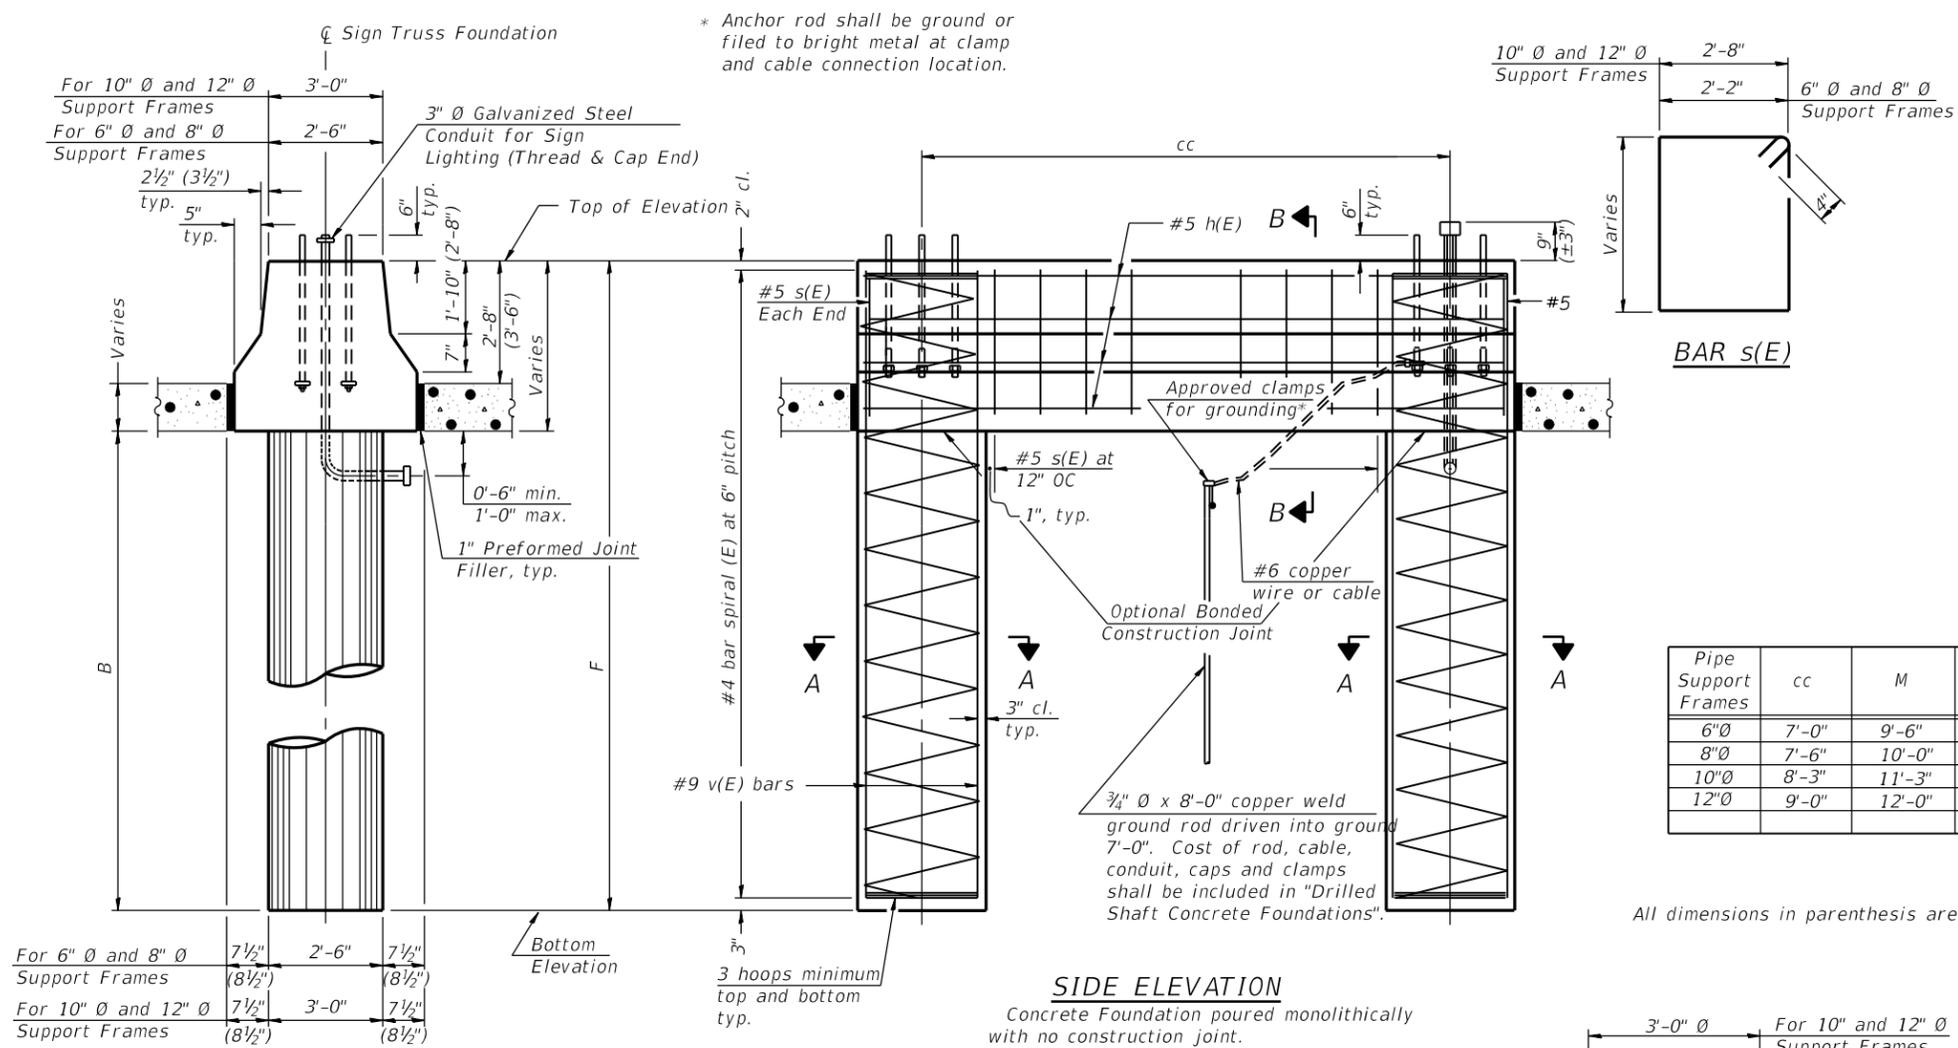

NOTES:
 The foundation dimensions shown are based on the presence of mostly cohesive soils with an average Unconfined Compressive Strength (Qu) of at least 1.25 tsf, which must be determined by previous soil investigations at the jobsite. When other conditions are indicated, the boring data will be included in the plans and the foundation dimensions shown will be the result of site specific designs.
 If the conditions encountered are different than those indicated, the Contractor shall notify the Engineer to determine if the foundation dimensions need to be modified. If dimensions "B" or "F" are revised by more than 12" by the Contractor, "as-built" plans shall be prepared and submitted to the District Bureau of Operations for future reference.
 No sonotubes or decomposable forms shall be used below the lower conduit entrance. Permanent metal forms or other shielding may not be left in place below that elevation without the Engineer's written permission.
 Concrete shall be placed monolithically, without construction joints.
 Backfill shall be placed per Article 502 of Standard Specification and prior to erection of support column.
 A normal surface finish followed by a Concrete Sealer application will be required on concrete surfaces above the lowest elevation 6" below finished ground line. Cost included in Drilled Shaft Concrete Foundation.


BAR LIST - EACH FOUNDATION

Pipe Support Frames	cc	M	a	a/2
6"Ø	7'-0"	9'-6"	0'-11"	5 1/2"
8"Ø	7'-6"	10'-0"	1'-1 1/2"	6 3/4"
10"Ø	8'-3"	11'-3"	1'-3"	7 1/2"
12"Ø	9'-0"	12'-0"	1'-6"	9"

Bar	Number	Size	Length	Shape
h(E)	10	#5	M less 4"	—
s(E)	Varies	#5	Varies	□
v(E)	16	#9	F less 0'-5"	—
v(E)	24	#9	F less 0'-5"	—

6" Ø and 8" Ø Support Frame
 10" Ø and 12" Ø Support Frame
 #4(E) bar spiral see Side Elevation

All dimensions in parenthesis are for 42" high barrier.

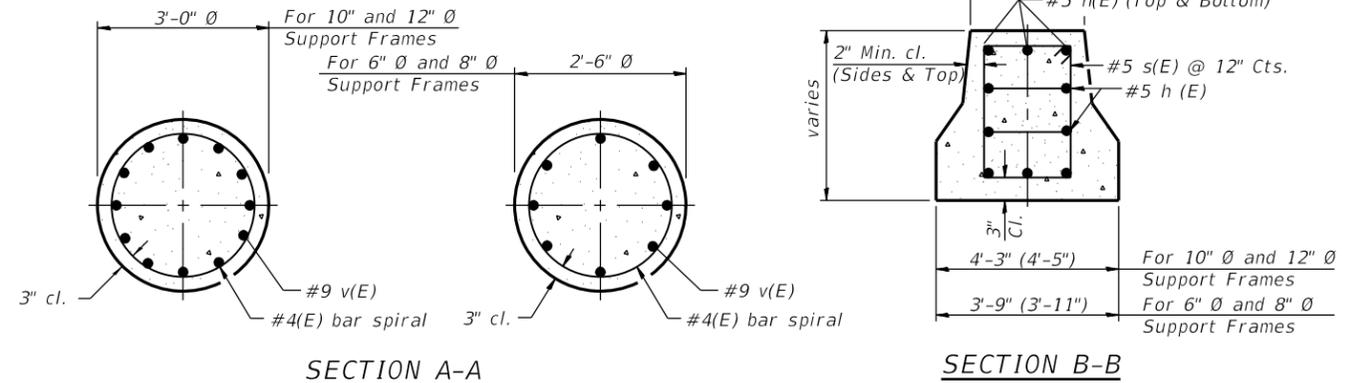

Structure Number	Station	Left Foundation				Right Foundation				Class DS Concrete (Cu. Yds.)
		Elevation Top	Elevation Bottom	B	F	Elevation Top	Elevation Bottom	B	F	
ISO16I094R050.1	1400+40.09	583.45	564.66	13'-6"	18'-9 1/2"	-	-	-	-	11.4

FILE NAME: D:\V\AECOM-NA-AWS1\arecomonline\local\AECOM_ID502_NAD\Documents\01_Americas\Transportation\60269938_Circle\Phase_I\000_CAD\008_Structural\Sign_Structures\62J31-Span-SS152-SignStruct.dgn

BAR LIST - EACH FOUNDATION

Bar	Number	Size	Length	Shape
v4(E)	16	#9	F less 5"	—
#4 bar spiral (E) - see Side Elevation				

NOTES:

The foundation dimensions shown are based on the presence of mostly cohesive soils with an average Unconfined Compressive Strength (Qu) of at least 1.25 tsf, which must be determined by previous soil investigations at the jobsite. When other conditions are indicated, the boring data will be included in the plans and the foundation dimensions shown will be the result of site specific designs.

If the conditions encountered are different than those indicated, the Contractor shall notify the Engineer to determine if the foundation dimensions need to be modified. If dimensions "B" or "F" are revised by more than 12" by the Contractor, "as-built" plans shall be prepared and submitted to the District Bureau of Operations for future reference.


No sonotubes or decomposable forms shall be used below the lower conduit entrance.

Permanent metal forms or other shielding may not be left in place below that elevation without the Engineer's written permission.

Concrete shall be placed monolithically, without construction joints.

Backfill shall be placed per Article 502 of Standard Specification and prior to erection of support column.


A normal surface finish followed by a Concrete Sealer application will be required on concrete surfaces above the lowest elevation 6" below finished ground line. Cost included in Drilled Shaft Concrete Foundation.

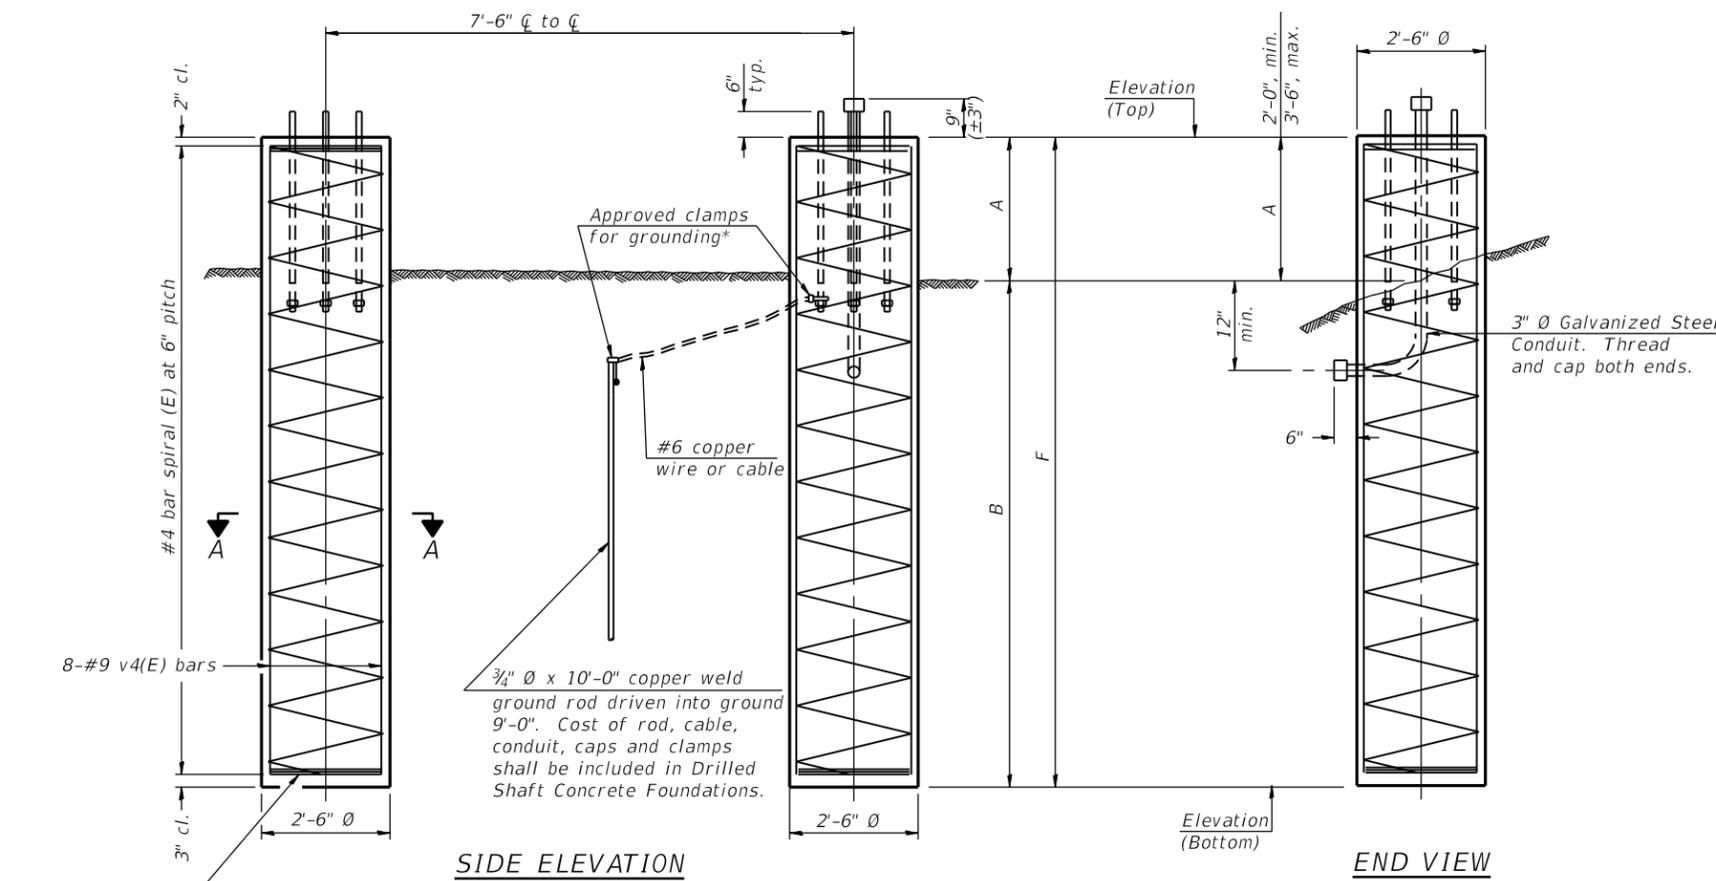


3 hoops minimum top and bottom

SIDE ELEVATION

END VIEW

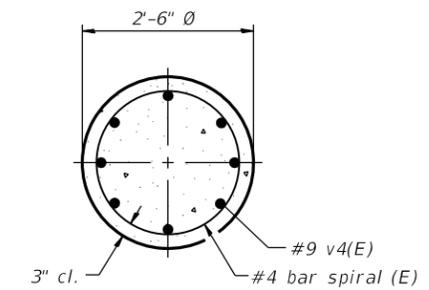

SECTION A-A

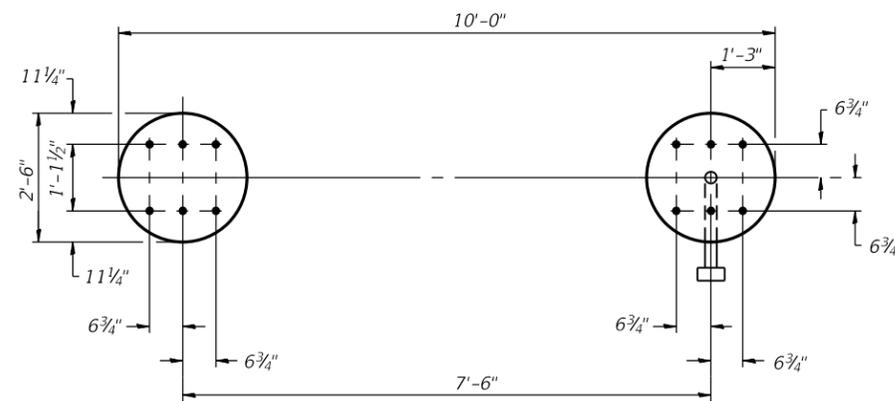

PLAN

For anchor rod size and placement, see Support Frame Detail Sheet.

* Anchor rod shall be ground or filed to bright metal at clamp and cable connection location.

DETAILS FOR 8" Ø SUPPORT FRAME TYPE I-A TRUSS

Structure Number	Station			Left Foundation			Right Foundation			Class DS Concrete (Cu. Yds.)		
		Elevation Top	Elevation Bottom	A	B	F	Elevation Top	Elevation Bottom	A		B	F
ISO161094R050.1	1400+40.09	-	-	-	-	-	581.45	565.15	2'-9 1/2"	13'-6"	16'-3 1/2"	6.0

054-F2

2-17-2017



USER NAME = marian.agamy	DESIGNED - JJS, AMS	REVISED -
PLOT SCALE = N.T.S	CHECKED - MI, MAI	REVISED -
PLOT DATE = 8/16/2019	DRAWN - AMS	REVISED -
	CHECKED - MI, MAI	REVISED -

STATE OF ILLINOIS
DEPARTMENT OF TRANSPORTATION

OVERHEAD SIGN STRUCTURES
DRILLED SHAFT DETAILS

SHEET SS-10 OF SS-10 SHEETS

F.A.I. RTE.	SECTION	COUNTY	TOTAL SHEETS	SHEET NO.
90/94/290	2019-054-I	COOK	400	203
CONTRACT NO. 62J31				
ILLINOIS FED. AID PROJECT				

FILE PATH = p:\naecom\na-ansi\encom\local\ecdm_0502_na_documents\01_Americas\Transportation\60269938_Circle Phase\11000_CAD\01E_Electrical\Sheets\62J31_Contract\0162J31-sht-Light-01

- LIGHT TOWER:**
LED LUMINAIRES, TYPE I
NUMBER INDICATES TOWER TYPE
- TYPE TOWER HEIGHT
13 - 130 FEET
15 - 150 FEET
- LIGHTING UNIT: TYPE AS INDICATED
- 47'-6" M.H., 6 FT. DAVIT ARM
LED M-C-III LUMINAIRE.
MOUNTED ON PARAPET WALL
- 47'-6" M.H., 12 FT. DAVIT ARM
LED M-C-III LUMINAIRE.
MOUNTED ON PARAPET WALL
- 47'-6" M.H., 2-6 FT. DAVIT ARM
2-LED M-C-III LUMINAIRES.
MOUNTED ON PARAPET WALL
- TEMPORARY LED LUMINAIRE AND POLE;
80 FOOT WOOD POLE
- TEMPORARY LIGHTING UNIT: 80 FOOT WOOD
POLE WITH FOUR TYPE I LED HIGH MAST
LUMINAIRES
- UNDERPASS LUMINAIRE:
LED, TYPE AS SHOWN ON PLANS (PRIMARY
DISTRIBUTION PATTERN DIRECTION AS
INDICATED BY ARROW)
- MANHOLE
- ELECTRIC HANDHOLE: TYPE AS INDICATED
TYPE E1: PRECAST CONCRETE, 21.5"x21.5"x30",
IDOT STANDARD 814001
TYPE E2: PRECAST CONCRETE-HEAVY DUTY,
22"x22"x30", IDOT STANDARD 814001
TYPE C1: COMMUNICATIONS VAULT, 49 7/8"x32 1/8"x57"
TYPE S1: PRECAST CONCRETE-HEAVY DUTY,
22"x22"x36"
TYPE S2: PRECAST CONCRETE-HEAVY DUTY SPECIAL,
30"x30"x36"
- DOUBLE ELECTRIC HANDHOLE
- JUNCTION BOX: TYPE AND SIZE AS INDICATED
ON PLANS
- PULL BOX: TYPE AND SIZE AS INDICATED
ON PLANS
- TELEPHONE CONNECTION
- FIBER OPTIC COMMUNICATIONS HUT
- EXISTING LIGHT TOWER
- EXISTING LIGHTING UNIT, TWIN LUMINAIRE
- EXISTING LIGHTING UNIT
- EXISTING TEMPORARY LIGHTING UNIT
- EXISTING CDOT LIGHTING UNIT
- EXISTING UNDERPASS LUMINAIRE
- EXISTING ELECTRIC MANHOLE
- EXISTING ELECTRIC HANDHOLE
- EXISTING JUNCTION BOX
- EXISTING PULL BOX
- EXISTING TELEPHONE CONNECTION
- EXISTING FIBER OPTIC COMMUNICATIONS HUT
- EXISTING ELECTRIC HANDHOLE/MANHOLE
- EXISTING CDOT SURVEILLANCE CABINET

ELECTRICAL SYMBOLS FOR PROPOSED WORK


- LIGHTED SIGN STRUCTURE-CANTILEVER TYPE
(NUMBER OF FLUORESCENT FIXTURES AS
INDICATED - TYP.)
- LIGHTED SIGN STRUCTURE-TRUSS TYPE
- LIGHTED SIGN STRUCTURE-BRIDGE MOUNT TYPE
- DYNAMIC MESSAGE SIGN
- FLASHING BEACON SIGN
- CLOSED CIRCUIT TELEVISION CAMERA
- MICROWAVE DETECTOR
- DETECTOR LOOP
- CONTROLLER CABINET: LIGHTING, RADIO CONTROL
DUPLX TYPE WITH SCADA (DOOR SIDE AS
INDICATED)
- CONTROLLER CABINET: SURVEILLANCE
- CONTROLLER CABINET: SURVEILLANCE, TYPE 334
- RAMP METER SIGNAL POLE/HEAD
- RAMP METER FLASHER POST
- TEMPORARY WOOD POLE, LENGTH AS
INDICATED ON THE PLANS
- HIGHWAY ADVISORY RADIO ANTENNA
- ELECTRIC UTILITY POLE
- CCTV CAMERA POLE
- POLE MOUNTED ELECTRIC UTILITY TRANSFORMER(S)

ELECTRICAL SYMBOLS FOR EXISTING CONDITIONS

- EXISTING CDOT ELECTRIC HANDHOLE/MANHOLE
- EXISTING LIGHTED SIGN STRUCTURE-
CANTILEVER TYPE
- EXISTING LIGHTED SIGN STRUCTURE-TRUSS TYPE
- EXISTING LIGHTED SIGN STRUCTURE-
BRIDGE MOUNT TYPE
- EXISTING DYNAMIC MESSAGE SIGN
- EXISTING FLASHING BEACON SIGN
- EXISTING CLOSED CIRCUIT TELEVISION CAMERA
- EXISTING MICROWAVE DETECTOR
- EXISTING DETECTOR LOOP
- EXISTING LIGHTING CONTROLLER, DUPLX
- EXISTING CONTROLLER CABINET
- EXISTING RAMP METER FLASHER

- PAD MOUNTED ELECTRIC UTILITY TRANSFORMER
- GROUND ROD
- MAIN SERVICE FUSED DISCONNECT SWITCH
(RATING AS INDICATED)
- PHOTOCELL
- AERIAL CABLE
- FLEXIBLE CONDUIT
- RACEWAY EMBEDDED IN STRUCTURE
- EXPOSED CONDUIT
- RACEWAY OR DIRECT BURIAL CABLE
UNDERGROUND WITHOUT ENCASEMENT
- TYPE AS SHOWN ON PLANS CONDUIT
SLEEVE, INSTALLED BELOW PAVEMENT
- UNDERGROUND REINFORCED CONCRETE ENCASED
CONDUIT DUCTBANK, UNLESS NOTED OTHERWISE.
(NUMBER, TYPE, AND SIZE OF DUCTS AS SHOWN)
- CONDUIT TURNED DOWN
- CONDUIT TURNED UP
- TEMPORARY ITS WOOD POLE
- EXISTING HIGHWAY ADVISORY RADIO ANTENNA
- EXISTING CCTV CAMERA POLE
- EXISTING UTILITY SERVICE CONNECTION,
POLE MOUNTED
- EXISTING UTILITY SERVICE CONNECTION,
PAD MOUNTED
- EXISTING CONCEALED CONDUIT IN STRUCTURE
- EXISTING EXPOSED CONDUIT
- EXISTING RACEWAY OR DIRECT BURIED CABLE
WITHOUT ENCASEMENT
- EXISTING CONCEALED CONDUIT UNDERGROUND,
TRENCHED OR PUSHED
- EXISTING ELECTRIC CABLE IN CONDUIT SLEEVE
- EXISTING AERIAL CABLE TO REMAIN
- EXISTING ELECTRICAL EQUIPMENT
TO BE ABANDONED

GENERAL ELECTRICAL CALLOUTS

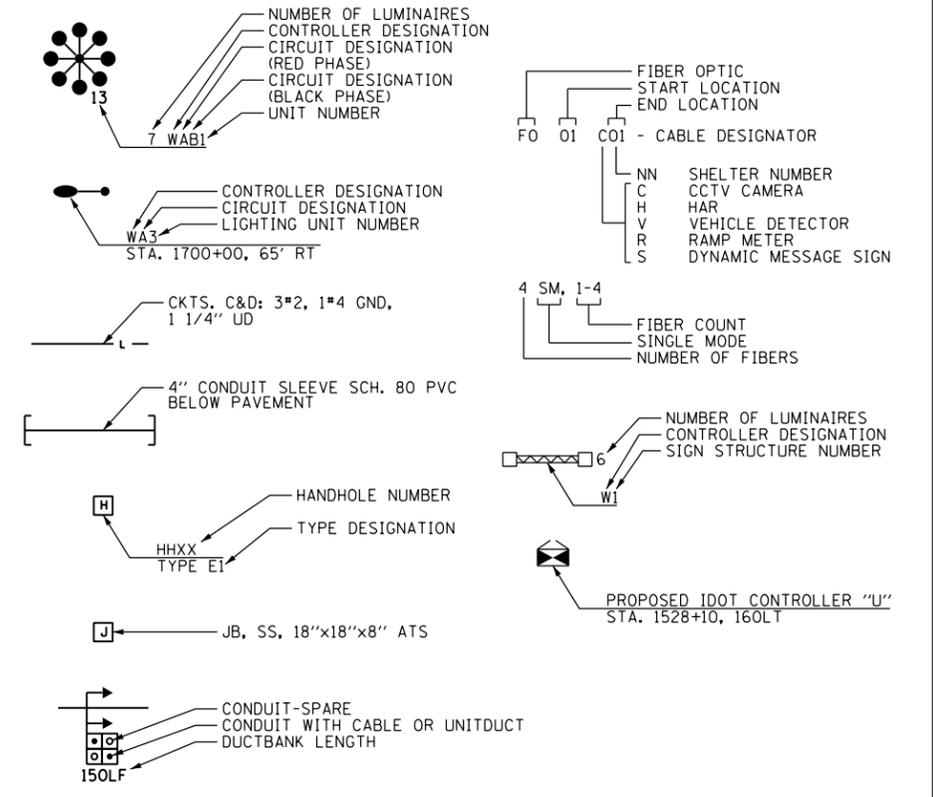

TYPICAL EXISTING TO BE REMOVED SYMBOLS

- EXISTING LIGHTING UNIT TO BE REMOVED
- EXISTING UNDERPASS LUMINAIRE TO BE REMOVED
- EXISTING JUNCTION BOX TO BE REMOVED
- EXISTING LIGHTED SIGN STRUCTURE-
CANTILEVER TYPE TO BE REMOVED
- DYNAMIC MESSAGE SIGN TO BE REMOVED
- FLASHING BEACON SIGN TO BE REMOVED
- EXISTING LIGHTING CONTROLLER, DUPLX
TO BE REMOVED
- EXISTING CONTROLLER CABINET TO BE REMOVED
- EXISTING DETECTOR LOOP TO BE REMOVED
- EXISTING RAMP METER SIGNAL POLE/HEAD TO BE
REMOVED
- EXISTING RAMP METER FLASHER TO BE REMOVED
- EXISTING POLE MOUNTED UTILITY SERVICE CONNECTION
TO BE REMOVED
- EXISTING LIGHT TOWER, PAD, AND FOUNDATION TO
BE REMOVED
- EXISTING TEMPORARY LIGHTING UNIT TO
BE REMOVED





D162J31-sht-Light-01	DESIGNED - TJL	REVISED -
USER NAME = myersc	DRAWN - CAM	REVISED -
PLOT SCALE = 2,0000' / in.	CHECKED - WDS	REVISED -
PLOT DATE = 8/14/2019	DATE - 8/16/2019	REVISED -

STATE OF ILLINOIS
DEPARTMENT OF TRANSPORTATION

IDOT ELECTRICAL SYMBOLS

SCALE: N.T.S. SHEET 1 OF 11 SHEETS STA. TO STA.

F.A.I. RTE.	SECTION	COUNTY	TOTAL SHEETS	SHEET NO.
90/94/290	2019-054-I	COOK	400	204
CONTRACT NO. 62J31				
ILLINOIS FED. AID PROJECT				

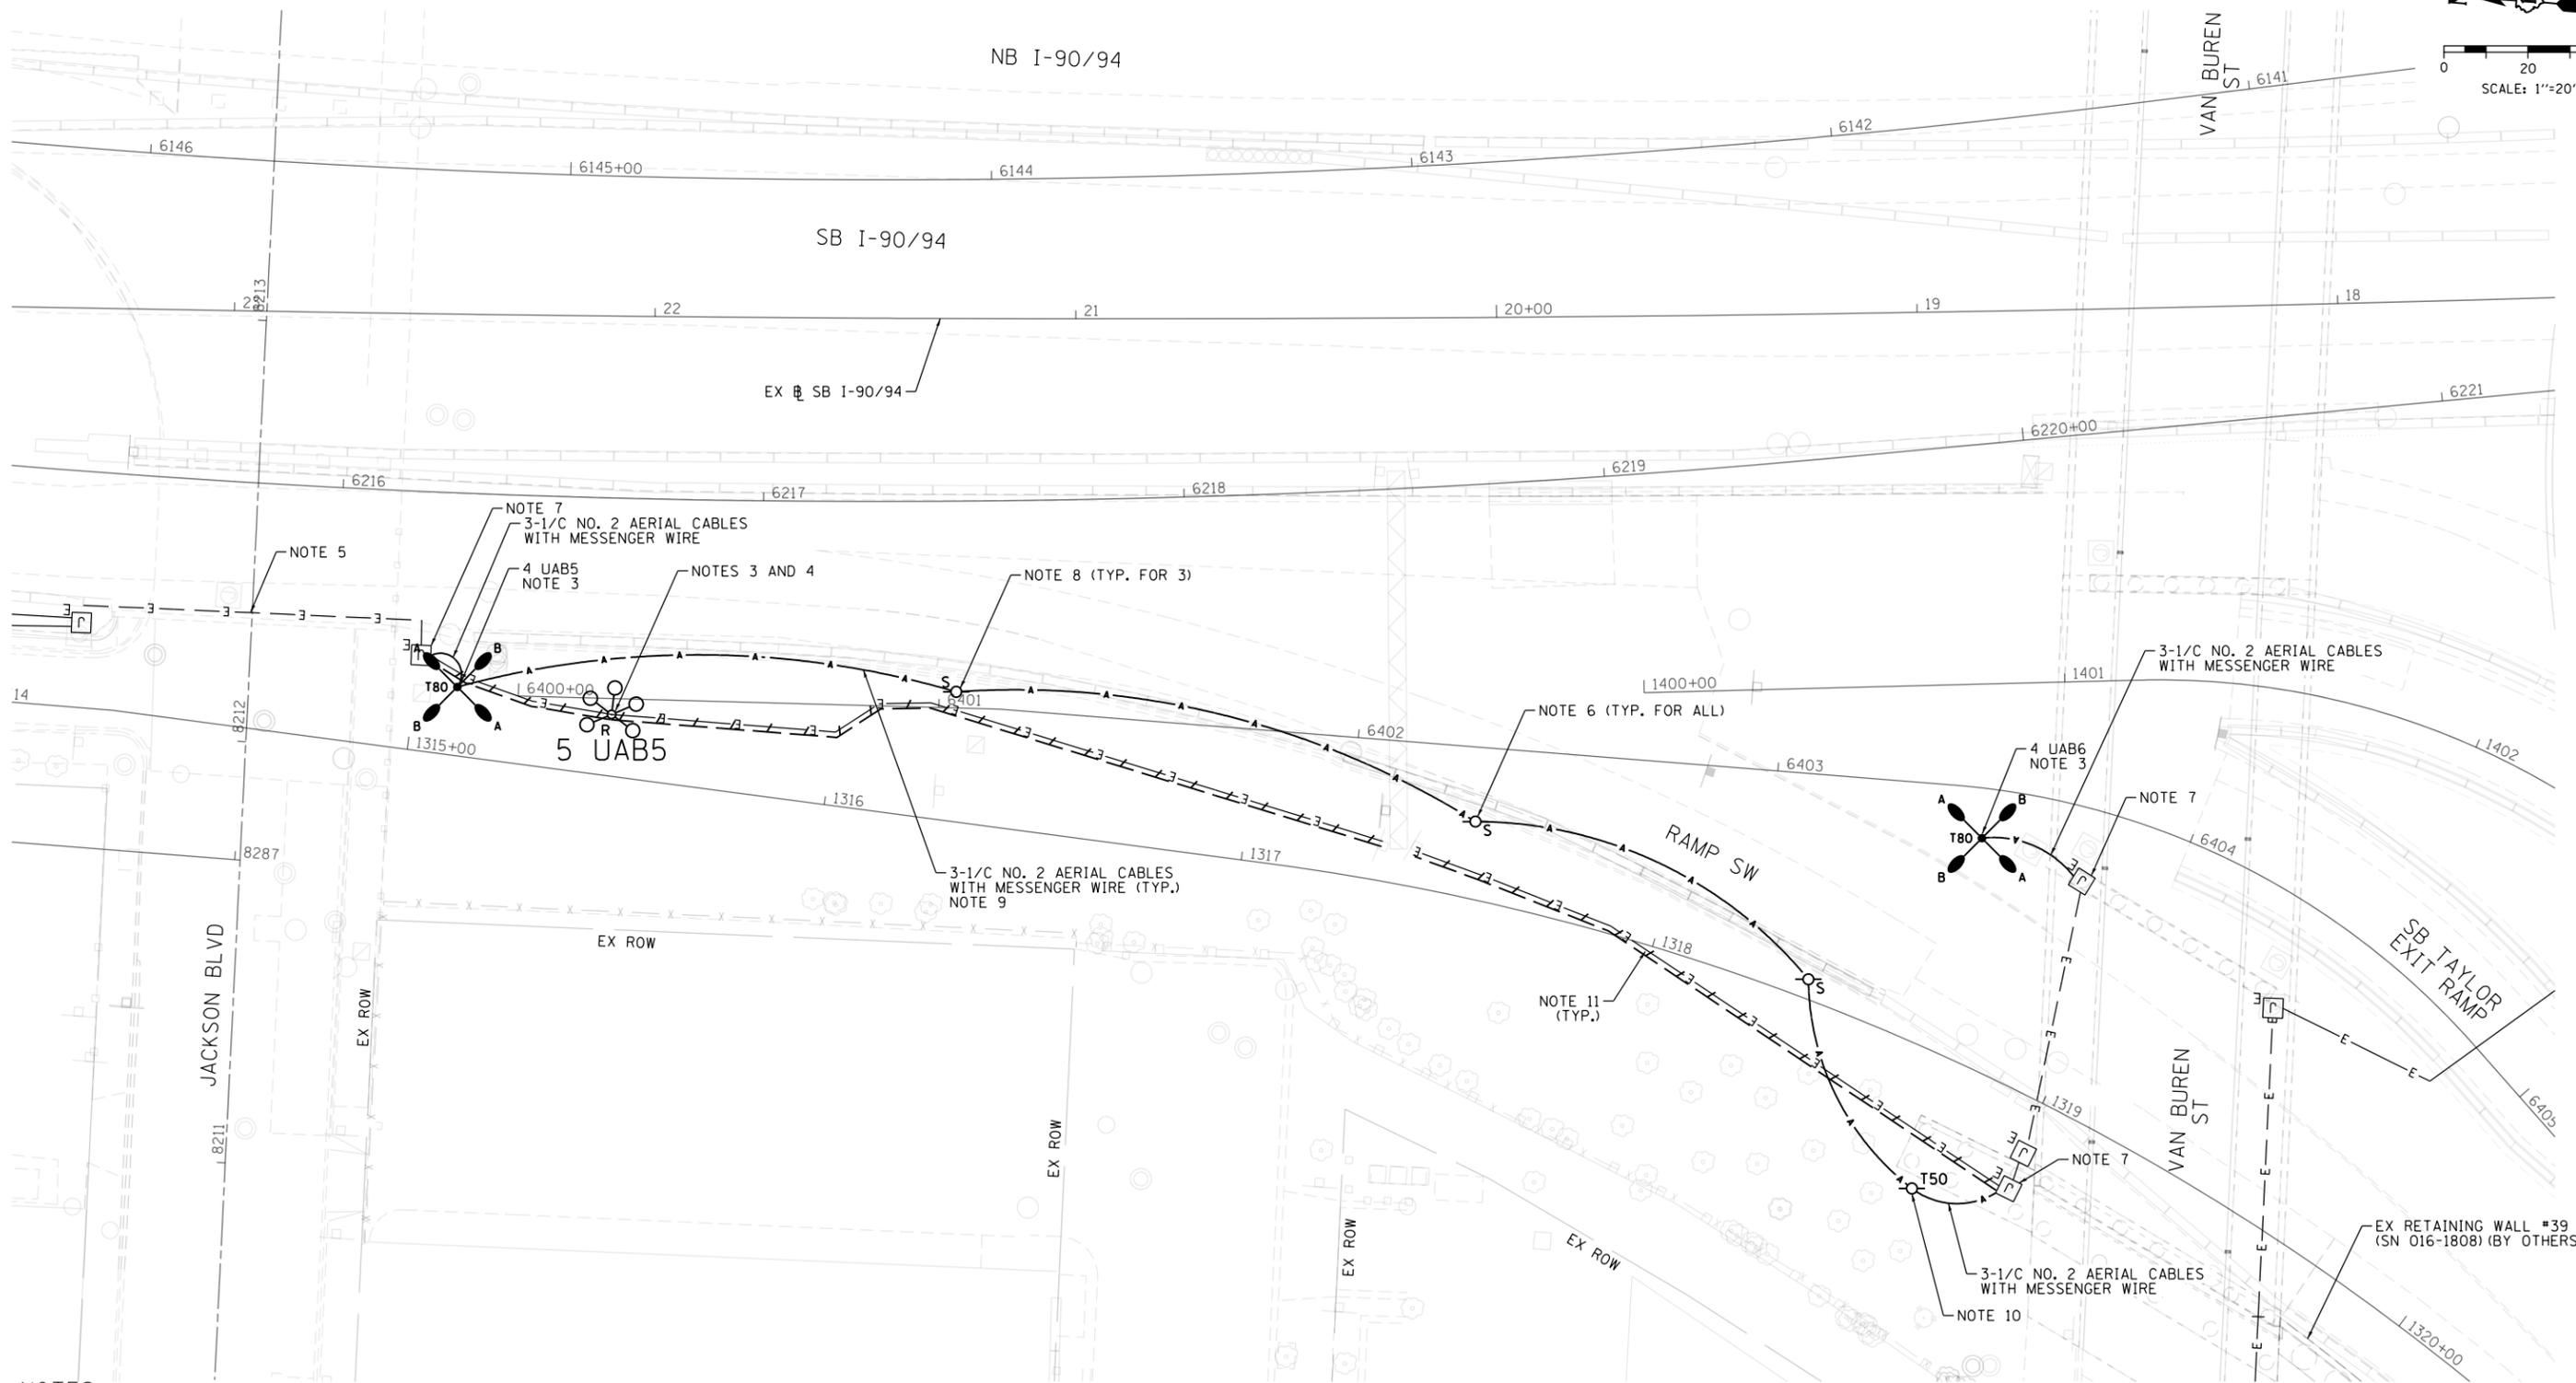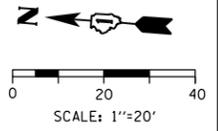

NOTES:

1. SEE DRAWING E-01 FOR IDOT ELECTRICAL SYMBOLS AND ABBREVIATIONS.
2. LOCATIONS OF EXISTING ELECTRICAL EQUIPMENT SHOWN ON THIS DRAWING ARE APPROXIMATIONS AND MUST BE VERIFIED IN THE FIELD BY THE CONTRACTOR.
3. THE EXISTING LIGHT TOWER 5 UAB5 SHALL NOT BE REMOVED UNTIL THE TEMPORARY LIGHTING UNITS HAVE BEEN INSTALLED, ENERGIZED, TESTED, AND APPROVED BY IDOT. THIS WORK SHALL BE STAGED SUCH THAT THE EXISTING, TEMPORARY, OR PROPOSED LIGHTING UNITS ARE OPERATIONAL DURING NIGHTTIME HOURS.
4. ALL EXISTING LIGHT TOWERS SHOWN TO BE REMOVED SHALL BE DISPOSED OF PROPERLY OFFSITE. THE HIGH MAST LUMINAIRES SHALL BE SALVAGED TO IDOT, UNLESS NOTED OTHERWISE.
5. THE EXISTING CONDUITS, JUNCTION BOXES, AND LIGHTING CIRCUIT FEEDS ATTACHED TO THE WEST JACKSON ABUTMENT SHALL REMAIN AND BE PROTECTED DURING CONSTRUCTION.
6. PROVIDE 50 FEET OF SLACK CABLE AT EACH TEMPORARY WOOD POLE TO ALLOW FOR RELOCATION OF AERIAL CABLES DURING THE DIFFERENT STAGES OF CONSTRUCTION.
7. SEE IDOT STANDARD BE-801 FOR AERIAL CABLE INSTALLATION DETAILS FOR ROUTING THE AERIAL CABLES INTO THE EXISTING JUNCTION BOX ATTACHED TO STRUCTURE. CONNECT THE TEMPORARY AERIAL CABLES TO THE LIGHTING CIRCUIT CABLES WITHIN THE JUNCTION BOX.
8. THE TEMPORARY AERIAL CABLES SHALL BE ATTACHED TO THE WOOD POLES INSTALLED FOR THE TEMPORARY AERIAL FIBER OPTIC CABLES. SEE THE STAGE 1 ITS DRAWINGS FOR THE INSTALLATION LOCATIONS OF THE TEMPORARY WOOD POLES.
9. THE TEMPORARY AERIAL FEED SHALL BE REMOVED AND RELOCATED BEHIND PROPOSED RETAINING WALL 38, AS SHOWN ON DRAWING E-03, TO AVOID CONFLICT WITH PROPOSED CONSTRUCTION.
10. THE LOCATION OF THE WOOD POLE SHOWN IS AN APPROXIMATION. THE FINAL INSTALLATION LOCATION OF THE POLE SHALL BE STAKED IN THE FIELD AND APPROVED BY THE ENGINEER PRIOR TO INSTALLATION TO IDENTIFY ANY CONFLICTS WITH EXISTING/PROPOSED UTILITIES AND WORK TO BE PERFORMED BY OTHER DISCIPLINES.
11. EXISTING LIGHTING CIRCUITS TO BE ABANDONED IN PLACE, UNLESS NOTED OTHERWISE.

E-02

FILE PATH = p:\AECOM\NA-ANSI\encom\line\local\AECOM_DS02_NA\Documents\01_Americas\Transportation\60269938_Circle Phase 1\000_CAD\01E_Electrical\Sheets\62J31-SHT-Light-02





D162J31-SHT-Light-02		DESIGNED - TJL	REVISED -
USER NAME = myersc		DRAWN - CAM	REVISED -
PLOT SCALE = 40.0000' / in.		CHECKED - WDS	REVISED -
PLOT DATE = 8/14/2019		DATE - 8/16/2019	REVISED -

**STATE OF ILLINOIS
DEPARTMENT OF TRANSPORTATION**

EXISTING/TEMPORARY LIGHTING PLAN - STAGE 1	
I-90/94	
SCALE: 1"=20'	SHEET 2 OF 11 SHEETS
STA. 6215+50.00 TO STA. 6221+05.00	

F.A.I. RTE.	SECTION	COUNTY	TOTAL SHEETS	SHEET NO.
90/94/290	2019-054-I	COOK	400	205
CONTRACT NO. 62J31				
ILLINOIS FED. AID PROJECT				

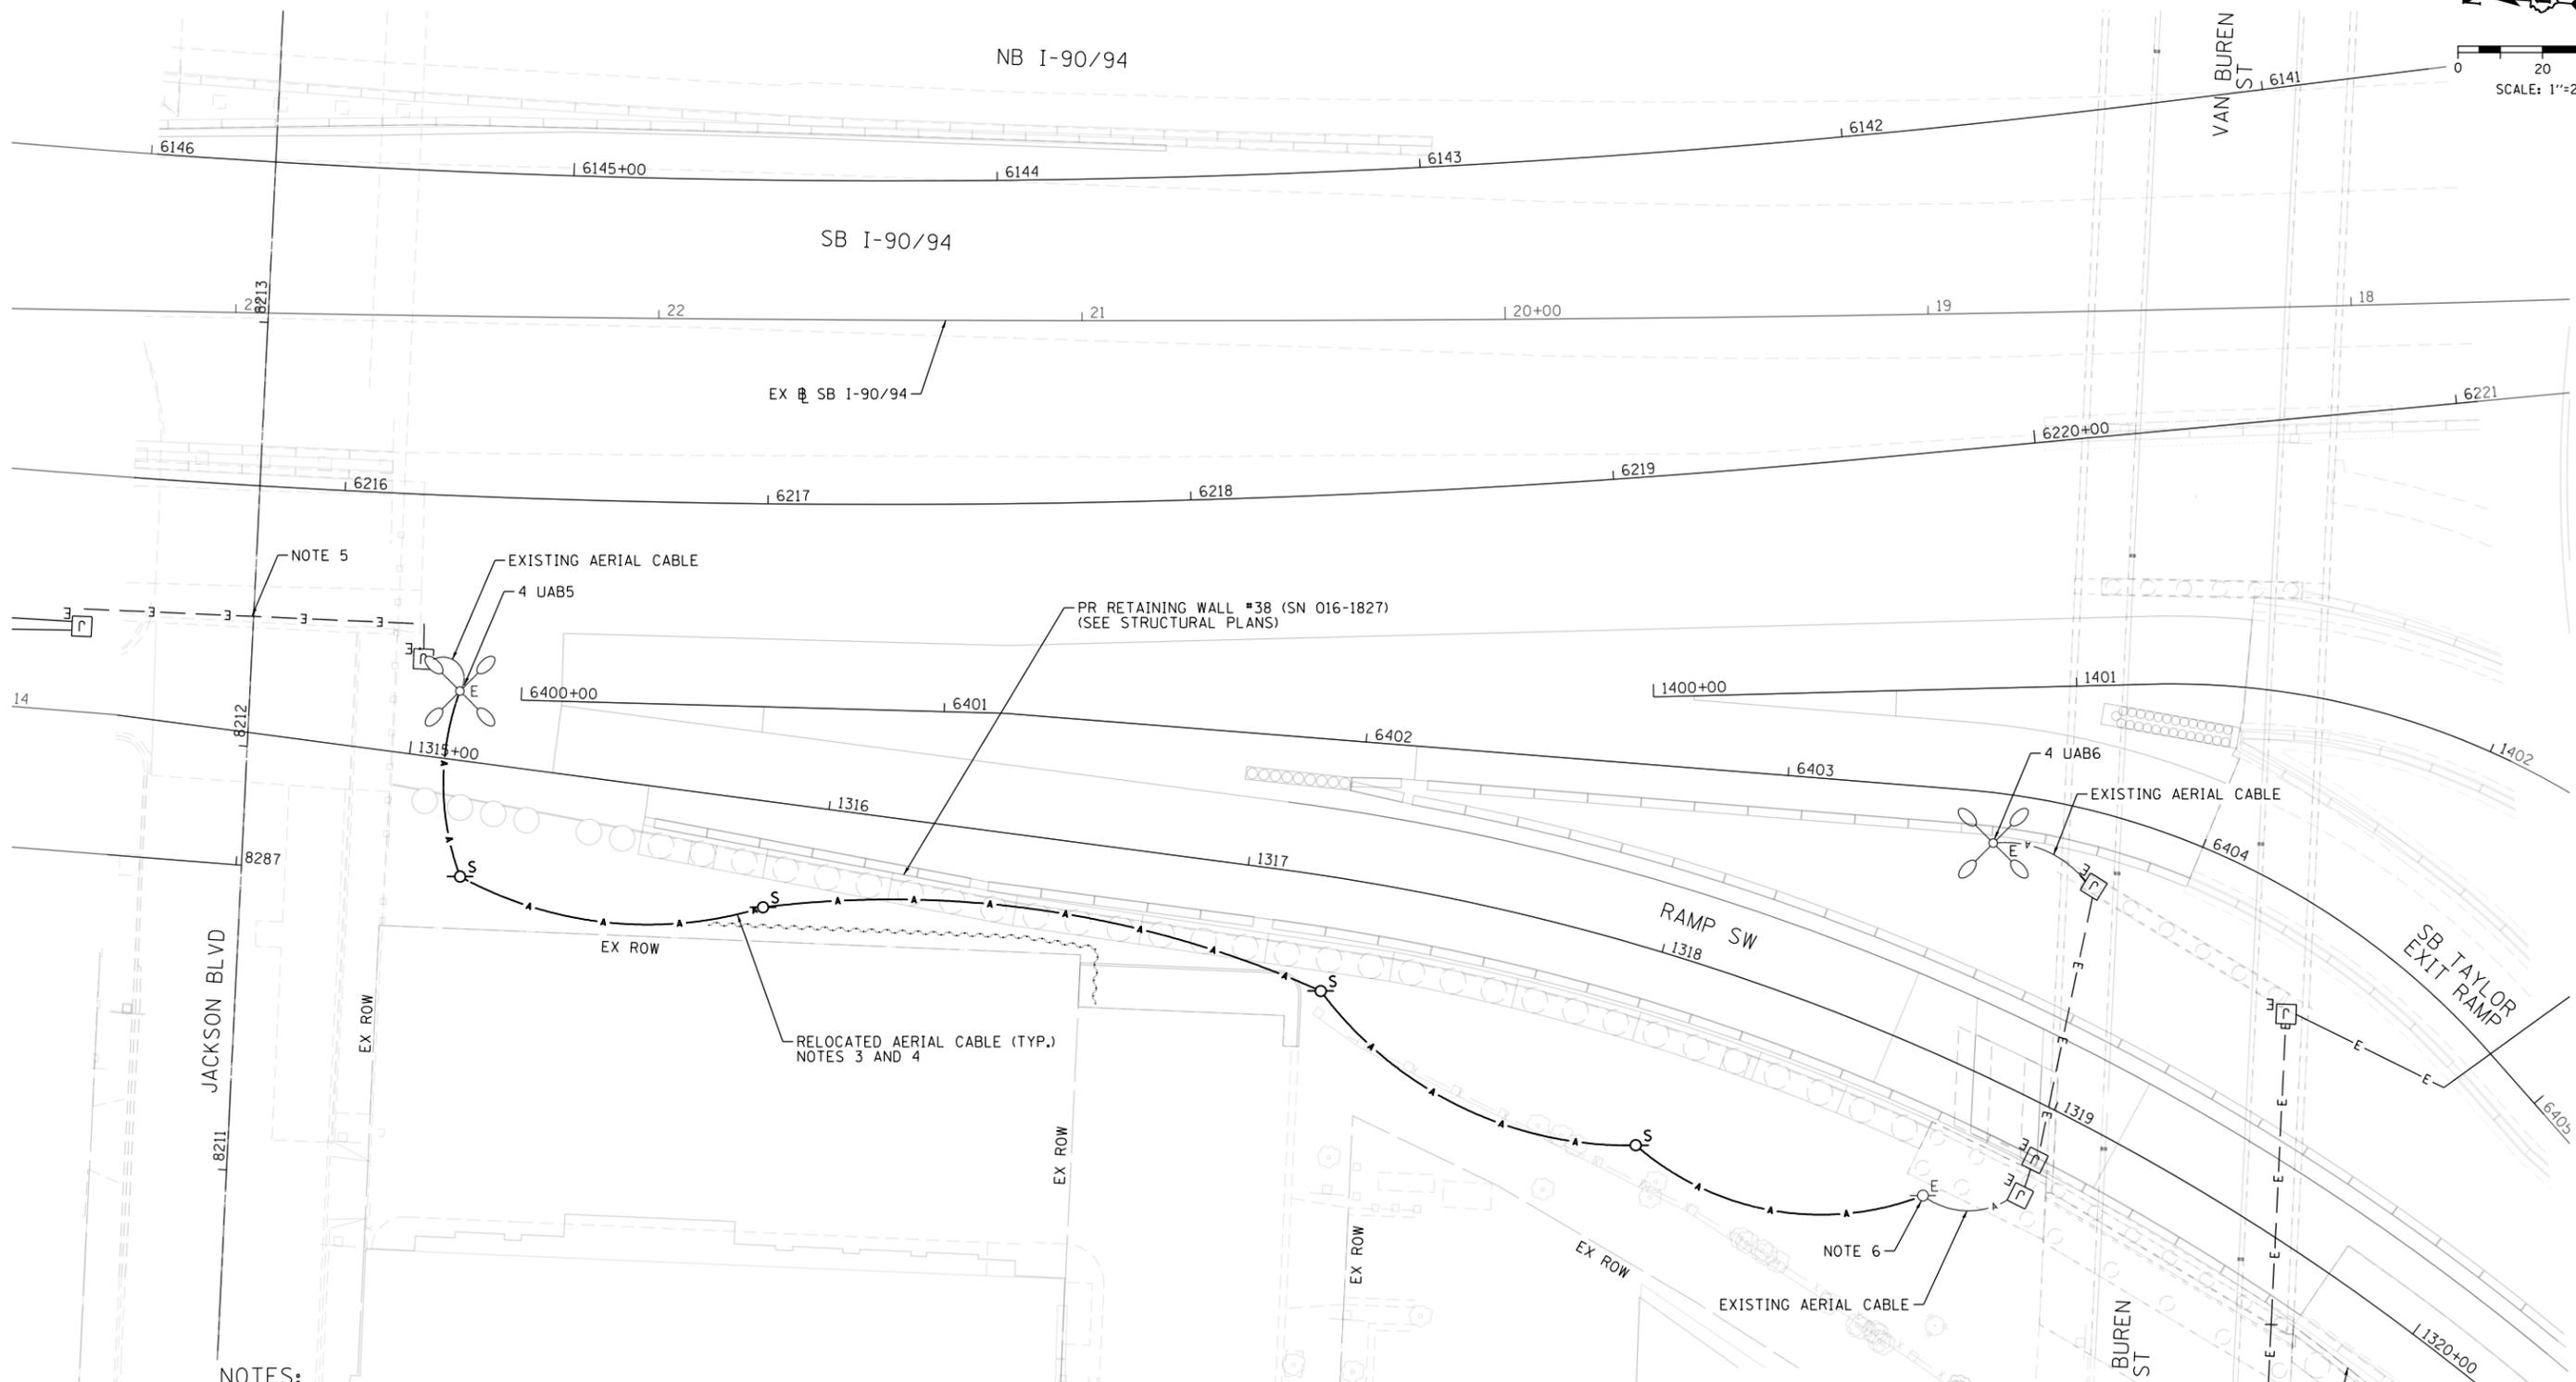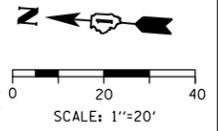

NOTES:

1. SEE DRAWING E-01 FOR IDOT ELECTRICAL SYMBOLS AND ABBREVIATIONS.
2. LOCATIONS OF EXISTING ELECTRICAL EQUIPMENT SHOWN ON THIS DRAWING ARE APPROXIMATIONS AND MUST BE VERIFIED IN THE FIELD BY THE CONTRACTOR.
3. RELOCATE THE EXISTING AERIAL CABLES SHOWN ON E-02 TO THE TEMPORARY ITS WOOD POLES INSTALLED BEHIND PROPOSED RETAINING WALL 38. THE REMOVAL AND RELOCATION WORK SHALL BE INCLUDED IN THE COST OF "REMOVE AND REINSTALL AERIAL CABLE" PAY ITEM. SEE THE ITS STAGE 2 DRAWINGS FOR THE INSTALLATION LOCATIONS OF THE TEMPORARY WOOD POLES.
4. THE TEMPORARY AERIAL CABLES ATTACHED TO THE TEMPORARY ITS WOOD POLES SHALL BE REMOVED ONCE THE PERMANENT LIGHTING FEEDS SHOWN ON E-05 HAVE BEEN INSTALLED, ENERGIZED, TESTED, AND APPROVED BY IDOT, UNLESS NOTED OTHERWISE. THE REMOVAL OF THESE TEMPORARY AERIAL CABLES SHALL BE PAID FOR BY THE "REMOVE AERIAL CABLE" PAY ITEM.
5. THE EXISTING CONDUITS, JUNCTION BOXES, AND LIGHTING CIRCUIT FEEDS ATTACHED TO THE WEST JACKSON ABUTMENT SHALL REMAIN AND BE PROTECTED DURING CONSTRUCTION.
6. THE TEMPORARY WOOD POLE SHALL BE REMOVED ONCE THE PERMANENT LIGHTING FEEDS SHOWN ON E-05 HAVE BEEN INSTALLED, ENERGIZED, TESTED, AND APPROVED BY IDOT, UNLESS NOTED OTHERWISE. THE REMOVAL OF THE AERIAL CABLES ATTACHED TO THE WOOD POLE WILL NOT BE PAID FOR SEPARATELY AND SHALL BE INCLUDED IN THE COST OF "REMOVE TEMPORARY WOOD POLE" PAY ITEM.

E-03

FILE PATH = p:\V\AECOM\NA-ANSI\encom\line\local\AECOM_0502_NA\Documents\01_Americas\Transportation\60269938_Circle\Phase_1\1000_CAD\01E\Electrical\Sheets\62J31_Contract\0162J31-SHT-Light-03



D162J31-SHT-Light-03	DESIGNED - TJL	REVISED -
USER NAME = myersc	DRAWN - CAM	REVISED -
PLOT SCALE = 40.0000' / in.	CHECKED - WDS	REVISED -
PLOT DATE = 8/14/2019	DATE - 8/16/2019	REVISED -



**STATE OF ILLINOIS
DEPARTMENT OF TRANSPORTATION**

TEMPORARY LIGHTING PLAN - STAGE 2	
I-90/94	
SCALE: 1"=20'	SHEET 3 OF 11 SHEETS
STA. 6215+50.00 TO STA. 6221+05.00	

F.A.I. RTE.	SECTION	COUNTY	TOTAL SHEETS	SHEET NO.
90/94/290	2019-054-I	COOK	400	206
CONTRACT NO. 62J31				
ILLINOIS FED. AID PROJECT				

NOTES:

1. SEE DRAWING E-01 FOR IDOT ELECTRICAL SYMBOLS.
2. LOCATIONS OF EXISTING ELECTRICAL EQUIPMENT SHOWN ON THIS DRAWING ARE APPROXIMATIONS AND MUST BE VERIFIED IN THE FIELD BY THE CONTRACTOR.
3. THE REMOVAL OF EXISTING UNDERPASS LUMINAIRES MUST INCLUDE THE REMOVAL OF ALL CABLES, CONDUIT, JUNCTION BOXES, AND HARDWARE ASSOCIATED WITH THE EXISTING UNDERPASS LIGHTING. COST FOR THIS WORK WILL NOT BE PAID FOR SEPARATELY BUT WILL BE INCLUDED AS PART OF THE "REMOVAL OF LIGHTING UNIT, SALVAGE" PAY ITEM.
4. THE EXISTING CONDUITS, JUNCTION BOXES, AND LIGHTING CIRCUIT FEEDS ROUTED ACROSS THE ABUTMENTS SHALL REMAIN AND BE PROTECTED DURING CONSTRUCTION.
5. SEE DRAWINGS E-02, E-03 AND E-05 FOR THE CONTINUATION OF THE FEEDS FOR THE VARIOUS TEMPORARY AND PERMANENT CONDITIONS.

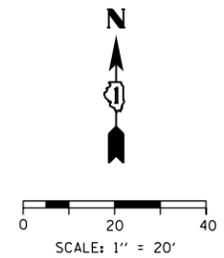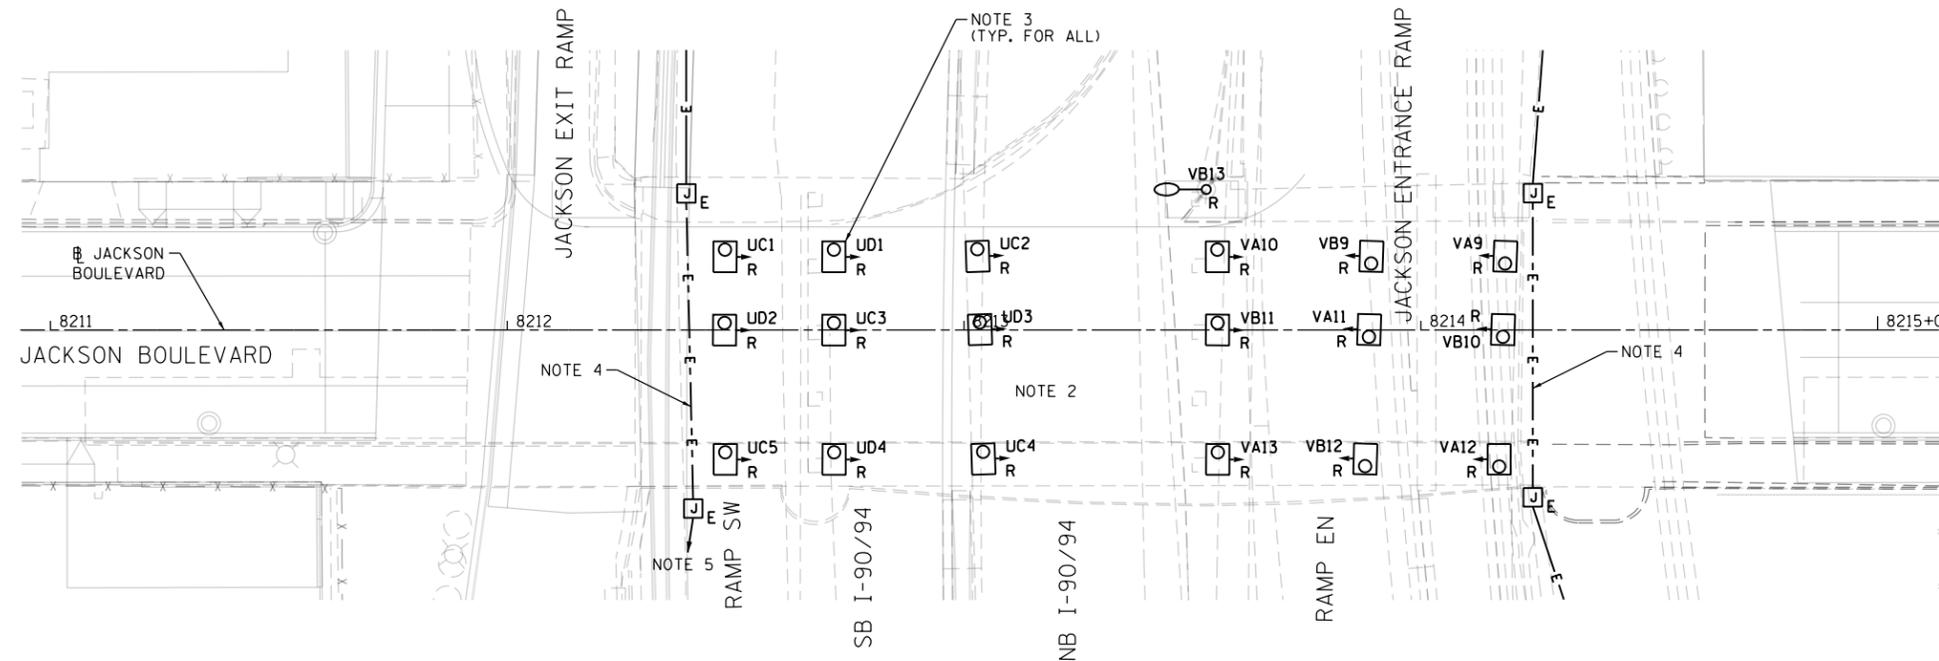

E-04

FILE PATH = p:\AECOM\NA-AVSI\ecommon\line\local\AECOM_DS02_NA\Documents\01_Americas\Transportation\60269938_Circle\Phase\1\000_CAD\01E_Electrical\Sheets\62J31_Contract\0162J31-sht-Light-04





D162J31-sht-Light-04	DESIGNED - TJL	REVISED -
USER NAME = myersc	DRAWN - CAM	REVISED -
PLOT SCALE = 40.0000' / in.	CHECKED - WDS	REVISED -
PLOT DATE = 8/14/2019	DATE - 8/16/2019	REVISED -

**STATE OF ILLINOIS
DEPARTMENT OF TRANSPORTATION**

**EXISTING LIGHTING PLAN
JACKSON BOULEVARD**

SCALE: 1"=20' SHEET 4 OF 11 SHEETS STA. TO STA.

F.A.I. RTE.	SECTION	COUNTY	TOTAL SHEETS	SHEET NO.
90/94/290	2019-054-I	COOK	400	207
CONTRACT NO. 62J31				
ILLINOIS FED. AID PROJECT				

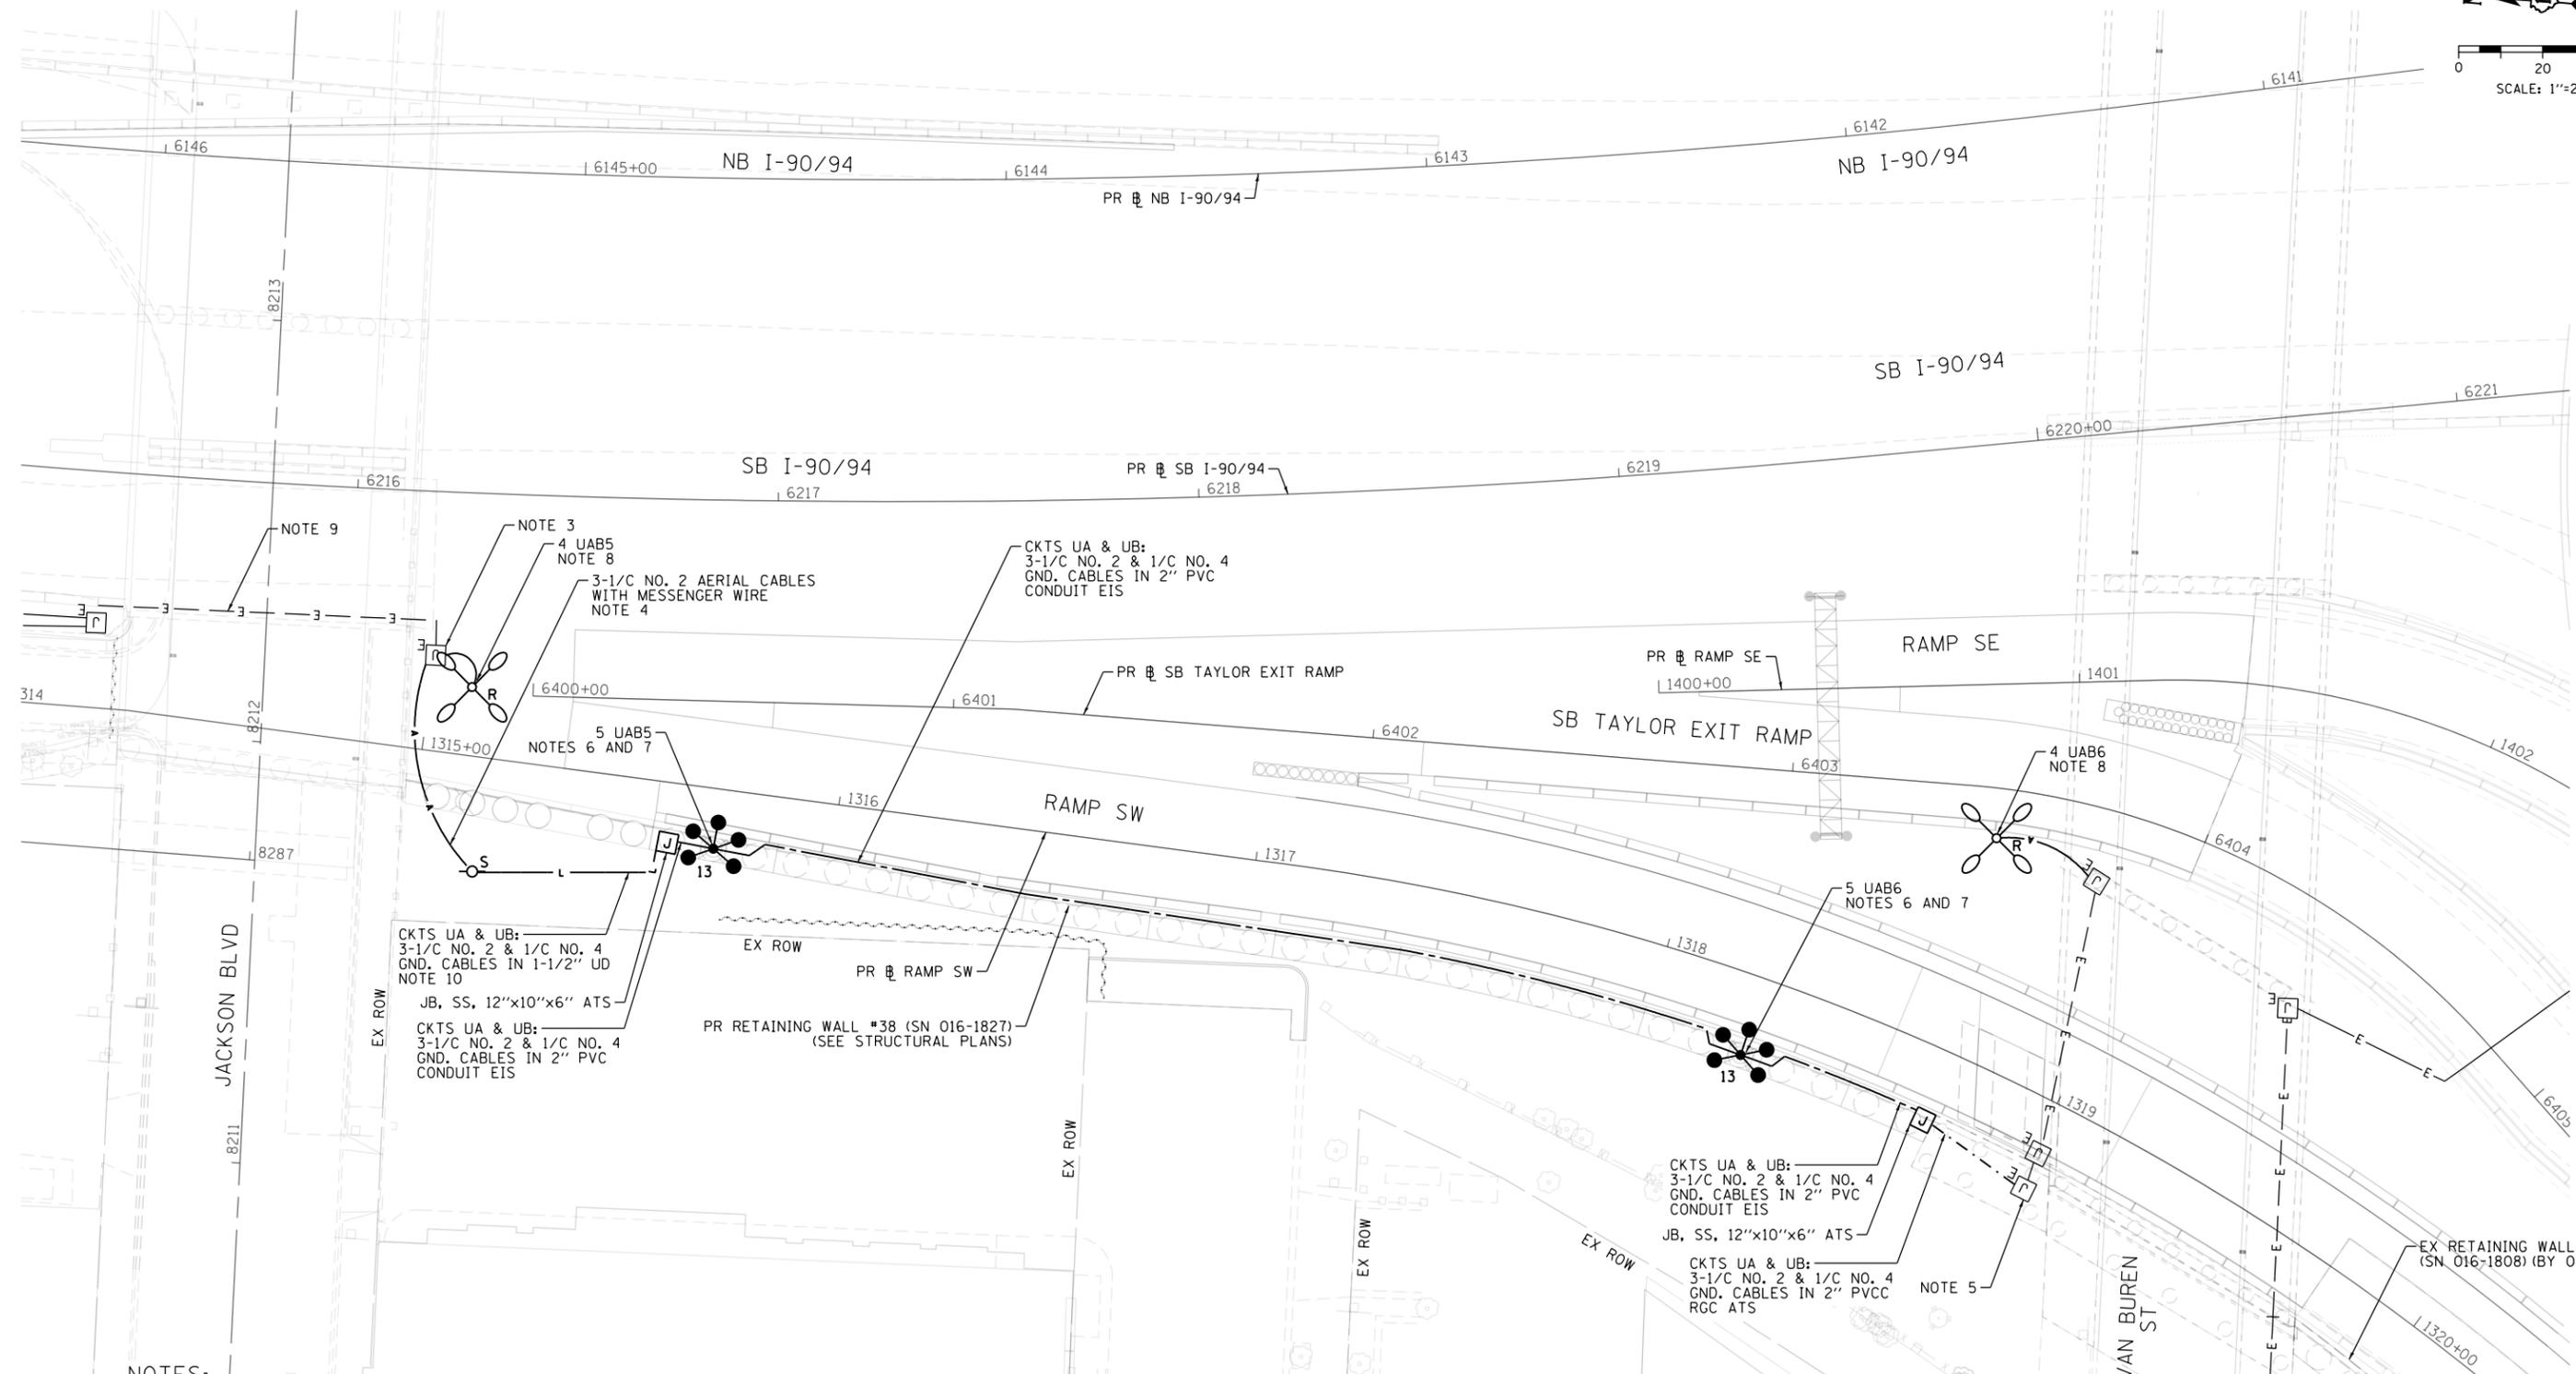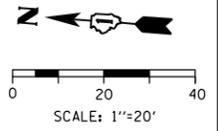

NOTES:

1. SEE DRAWING E-01 FOR IDOT ELECTRICAL SYMBOLS AND ABBREVIATIONS.
2. LOCATIONS OF EXISTING ELECTRICAL EQUIPMENT SHOWN ON THIS DRAWING ARE APPROXIMATIONS AND MUST BE VERIFIED IN THE FIELD BY THE CONTRACTOR.
3. SEE IDOT STANDARD BE-801 FOR AERIAL CABLE INSTALLATION DETAILS FOR ROUTING THE AERIAL CABLES INTO THE EXISTING JUNCTION BOX ATTACHED TO STRUCTURE. CONNECT THE TEMPORARY CABLES TO THE LIGHTING CIRCUIT CABLES WITHIN THE JUNCTION BOX.
4. THE TEMPORARY AERIAL CABLE SHALL BE ATTACHED TO THE WOOD POLE INSTALLED FOR THE TEMPORARY AERIAL FIBER OPTIC CABLES. PROVIDE 50 FEET OF SLACK CABLE FOR ANY FUTURE RELOCATION. THE TEMPORARY AERIAL FEED SHALL REMAIN AT THE END OF THE CONTRACT. SEE THE ITS DRAWINGS FOR THE INSTALLATION LOCATIONS OF THE TEMPORARY WOOD POLE.
5. DRILL THE EXISTING JUNCTION BOX ATTACHED TO THE BACK SIDE OF THE VAN BUREN STREET WING WALL FOR THE PROPOSED 2" CONDUIT ATTACHED TO STRUCTURE. ROUTE THE PROPOSED LIGHTING CIRCUIT CABLES THROUGH THE 2" CONDUIT INTO THE EXISTING JUNCTION BOX AND MAKE ALL NECESSARY CONNECTIONS.
6. SEE DRAWING E-09 FOR THE CONDUIT INSTALLATION DETAIL FOR HIGH MAST LIGHT TOWER FOUNDATION IN RETAINING WALL.
7. SEE THE STRUCTURAL PLANS FOR THE HIGH MAST LIGHT TOWER FOUNDATION LOCATION AND DETAILS.
8. THE EXISTING TEMPORARY LIGHT TOWER SHALL NOT BE REMOVED UNTIL THE PROPOSED LIGHT TOWERS 5 UAB5 AND 5 UAB6 HAVE BEEN INSTALLED, ENERGIZED, TESTED, AND APPROVED BY IDOT. THIS WORK SHALL BE STAGED SUCH THAT THE EXISTING, TEMPORARY, OR PROPOSED LIGHTING UNITS ARE OPERATIONAL DURING NIGHTTIME HOURS.
9. THE EXISTING CONDUITS, JUNCTION BOXES, AND LIGHTING CIRCUIT FEEDS ATTACHED TO THE WEST JACKSON ABUTMENT SHALL REMAIN AND BE PROTECTED DURING CONSTRUCTION.
10. SEE DRAWING E-08 FOR THE RW #38 CONDUIT ROUTING DETAIL FOR ROUTING THE UNIT DUCT FROM THE TEMPORARY WOOD POLE TO THE CONDUIT EMBEDDED IN THE RETAINING WALL FOR THE WALL MOUNTED HIGH MAST LIGHT TOWERS.

E-05

FILE PATH = p:\AECOM\NA-ANSI\encom\line\local\AECOM_D502_NA\Documents\01_Americas\Transportation\60269938_Circle Phase\11000_CAD\01E\Electrical\Sheets\62J31-SHT-Light-05



D162J31-SHT-Light-05	DESIGNED - TJL	REVISED -
USER NAME = myersc	DRAWN - CAM	REVISED -
PLOT SCALE = 40.0000' / in.	CHECKED - WDS	REVISED -
PLOT DATE = 8/14/2019	DATE - 8/16/2019	REVISED -

**STATE OF ILLINOIS
DEPARTMENT OF TRANSPORTATION**

**PROPOSED LIGHTING PLAN
I-90/94**

SCALE: 1"=20' SHEET 5 OF 11 SHEETS STA. 6215+50.00 TO STA. 6221+05.00


F.A.I. RTE.	SECTION	COUNTY	TOTAL SHEETS	SHEET NO.
90/94/290	2019-054-I	COOK	400	208
CONTRACT NO. 62J31				
ILLINOIS FED. AID PROJECT				

SYMBOLS LEGEND

-  IDOT LIGHTING CONTROLLER
-  HIGH MAST LIGHT TOWER
400 WATT HPS LUMINAIRE
(BLACK PHASE - SOLID SYMBOL
RED PHASE - OPEN SYMBOL)
-  HIGH MAST LIGHT TOWER
LED LUMINAIRE
(BLACK PHASE - SOLID SYMBOL
RED PHASE - OPEN SYMBOL)
-  UNDERPASS LIGHTING UNIT
55 WATT LPS LUMINAIRE
(BLACK PHASE - SOLID SYMBOL
RED PHASE - OPEN SYMBOL)
-  UNDERPASS LIGHTING UNIT
70 OR 100 WATT HPS LUMINAIRE
(BLACK PHASE - SOLID SYMBOL
RED PHASE - OPEN SYMBOL)
-  UNDERPASS LIGHTING UNIT
LED LUMINAIRE
(BLACK PHASE - SOLID SYMBOL
RED PHASE - OPEN SYMBOL)

LOAD TABLE LIGHTING CONTROLLER "V"					
CIRCUIT	RED PHASE		CIRCUIT	BLACK PHASE	
	AMPS	WATTS		AMPS	WATTS
A	13.1	3133	B	14.8	3546
C	25.1	6019	D	20.2	4855
E	30.1	7214	F	28.2	6758
G	20.6	4932	H	16.8	4020
I	20.9	5027	J	20.3	4866
K	-	-	L	-	-
M	-	-	N	-	-
O	-	-	P	-	-
TOTAL	109.7	26,325	TOTAL	100.2	24,045

LIGHTING CONTROLLER "V"
240/480, 1 PHASE, 3 WIRE
(2)-175A, 2-POLE MAIN BREAKERS
(2)-200A, 2-POLE CONTACTORS
(16)-70A, 1-POLE, BRANCH BREAKERS

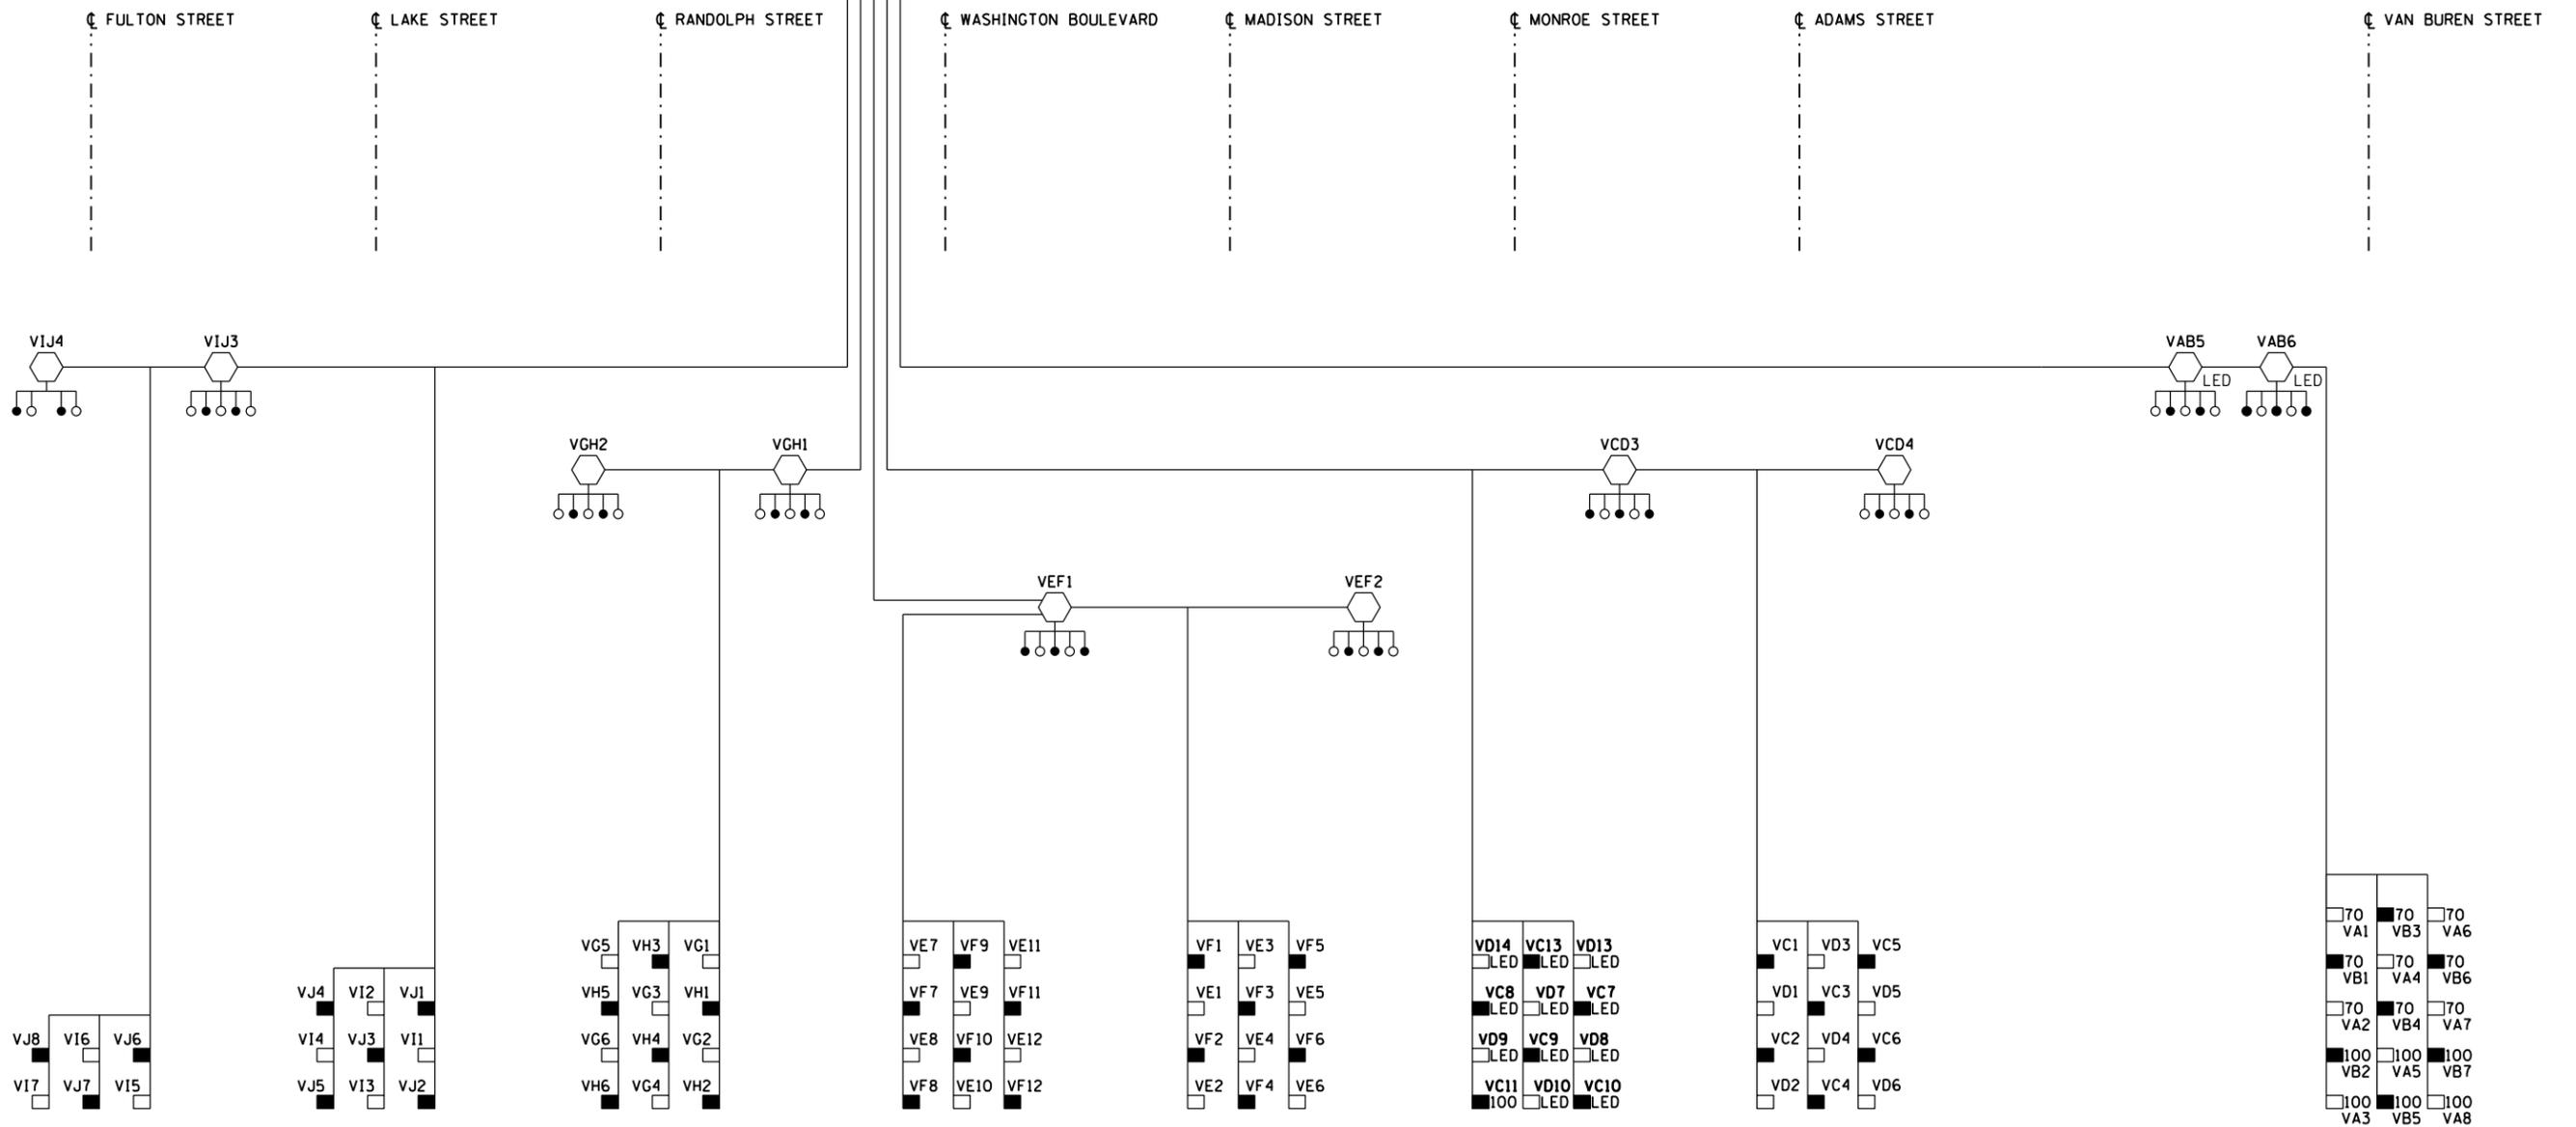

FILE PATH = p:\AECOM\NA-A\SI\ecommon\line\local\AECOM_DS02_IL\000_CAD\01E\Electrical\Sheets\62J31_Contract\0162J31-sht-Light-06



D162J31-sht-Light-06
USER NAME = myersc
PLOT SCALE = 40.0000' / in.
PLOT DATE = 8/14/2019

DESIGNED - T.JL
DRAWN - CAM
CHECKED - WDS
DATE - 8/16/2019


STATE OF ILLINOIS
DEPARTMENT OF TRANSPORTATION

IDOT LIGHTING CONTROLLER "V"
WIRING DIAGRAM

SCALE: N.T.S. SHEET 6 OF 11 SHEETS STA. TO STA.

F.A.I. RTE.	SECTION	COUNTY	TOTAL SHEETS	SHEET NO.
90/94/290	2019-054-I	COOK	400	209
CONTRACT NO. 62J31				
ILLINOIS FED. AID PROJECT				

FILE PATH = p:\na\ecom\na-ansi\encom\line\local\ecom\0502\NA\Documents\01_Americas\Transportation\60269938_Circle Phase\1\000_CAD\01E_Electrical\Sheets\62J31_Contract\0162J31-sht-Light-07

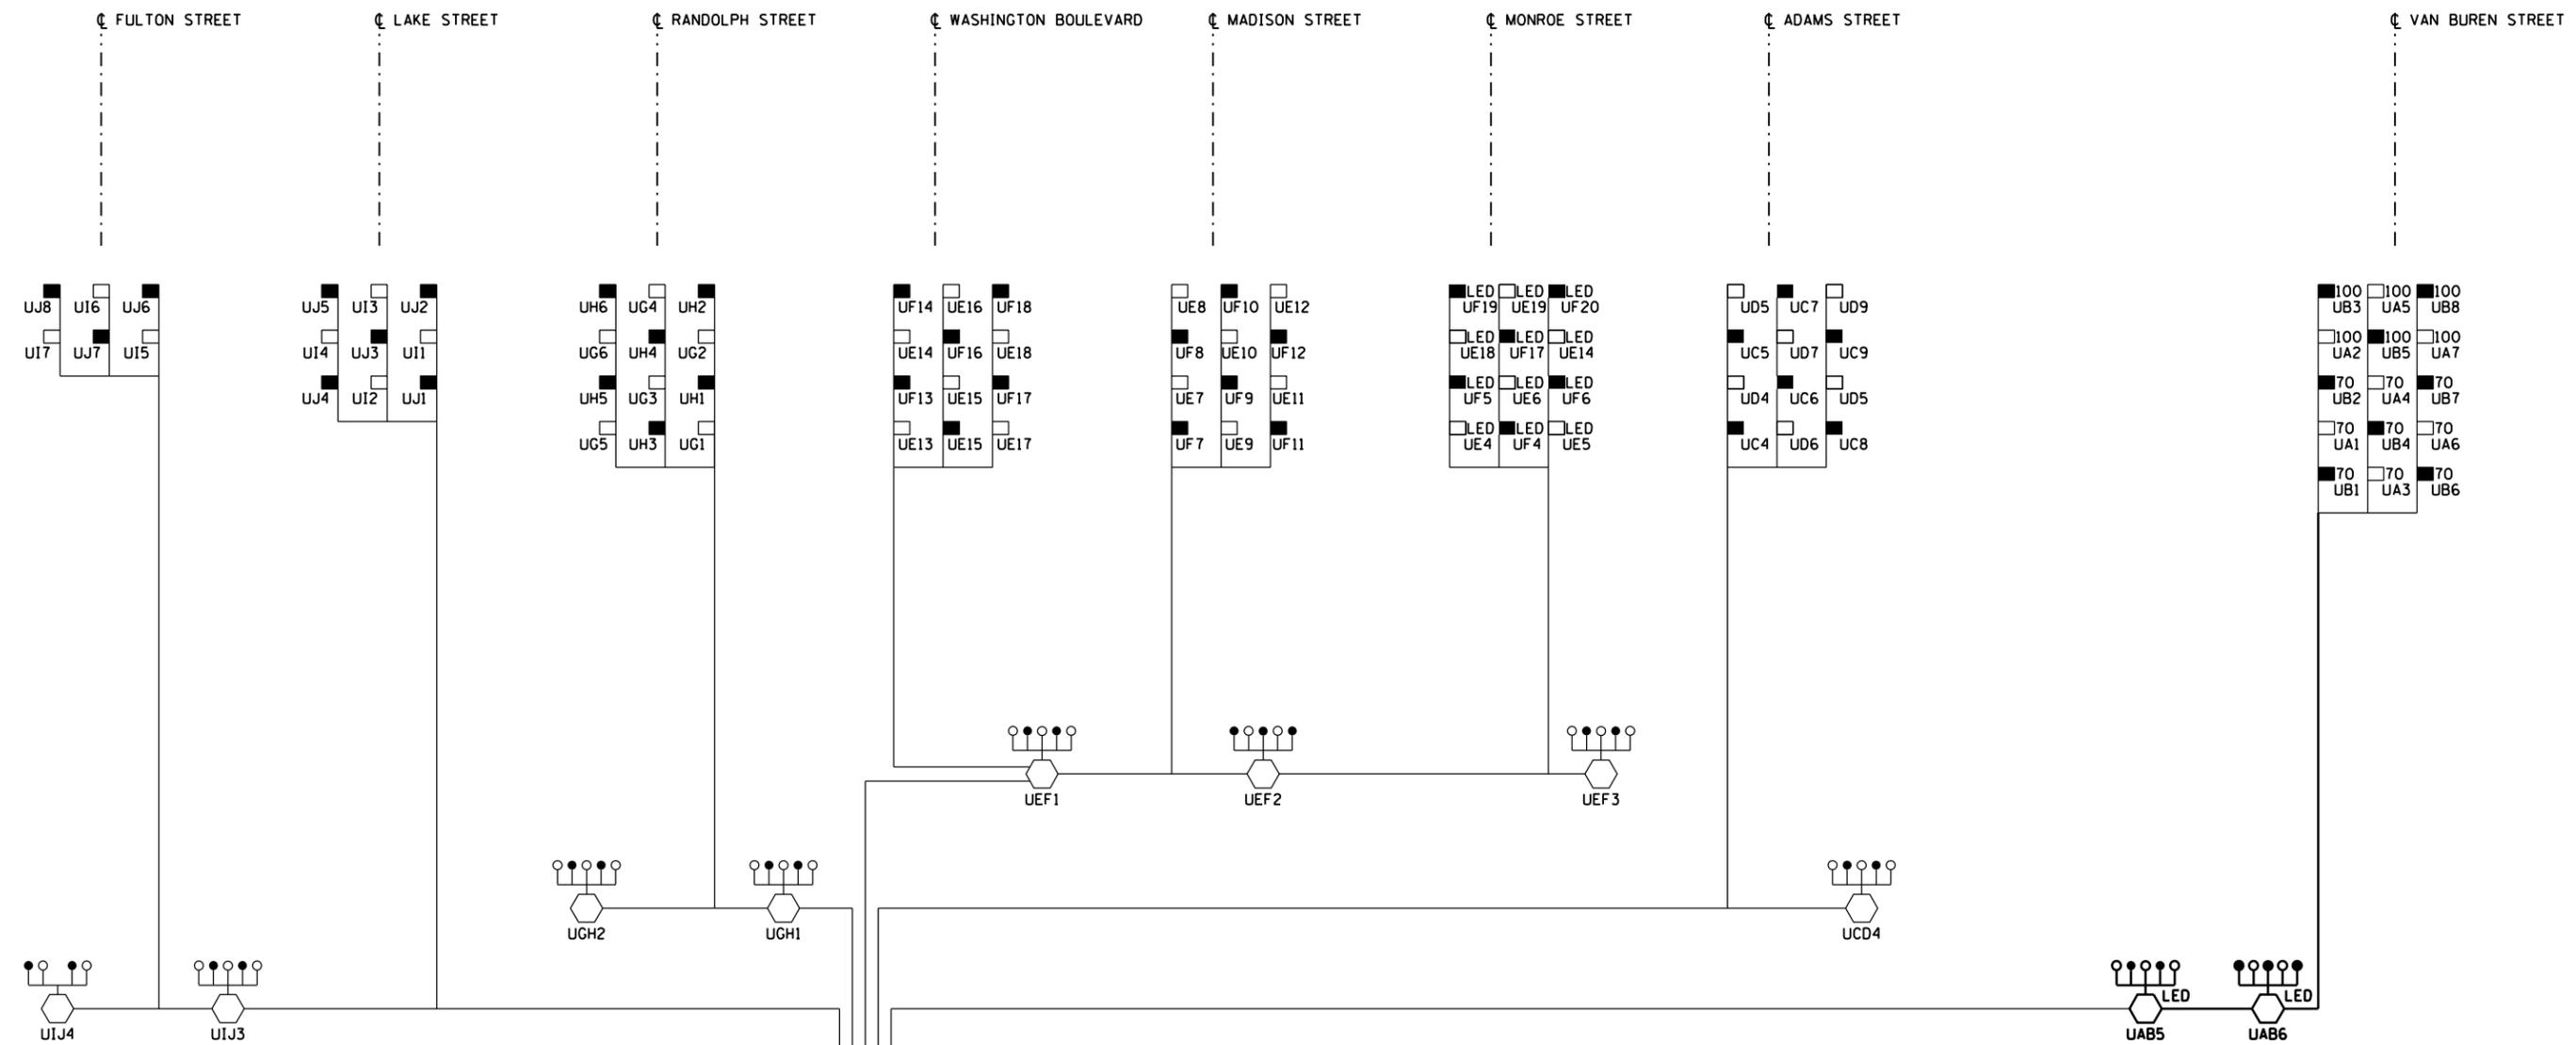


SYMBOLS LEGEND

-  IDOT LIGHTING CONTROLLER
-  HIGH MAST LIGHT TOWER
400 WATT HPS LUMINAIRE
(BLACK PHASE - SOLID SYMBOL
RED PHASE - OPEN SYMBOL)
-  HIGH MAST LIGHT TOWER
LED LUMINAIRE
(BLACK PHASE - SOLID SYMBOL
RED PHASE - OPEN SYMBOL)
-  UNDERPASS LIGHTING UNIT
55 WATT LPS LUMINAIRE
(BLACK PHASE - SOLID SYMBOL
RED PHASE - OPEN SYMBOL)
-  UNDERPASS LIGHTING UNIT
70 OR 100 WATT HPS LUMINAIRE
(BLACK PHASE - SOLID SYMBOL
RED PHASE - OPEN SYMBOL)
-  UNDERPASS LIGHTING UNIT
LED LUMINAIRE
(BLACK PHASE - SOLID SYMBOL
RED PHASE - OPEN SYMBOL)

LIGHTING CONTROLLER 'U'
240/480, 1 PHASE, 3 WIRE
(2)-175A, 2-POLE MAIN BREAKERS
(2)-200A, 2-POLE CONTACTORS
(16)-70A, 1-POLE, BRANCH BREAKERS

LOAD TABLE LIGHTING CONTROLLER "U"					
CIRCUIT	RED PHASE		CIRCUIT	BLACK PHASE	
	AMPS	WATTS		AMPS	WATTS
A	11.9	2862	B	12.4	2965
C	11.2	2683	D	13.1	3139
E	32.4	7766	F	30.5	7310
G	18.8	4507	H	15.0	3595
I	18.1	4346	J	17.4	4186
K	-	-	L	-	-
M	-	-	N	-	-
O	-	-	P	-	-
TOTAL	92.4	22,165	TOTAL	88.3	21,196

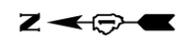

E-07



D162J31-sht-Light-07
USER NAME = myersc
PLOT SCALE = 40.0000' / in.
PLOT DATE = 8/14/2019


DESIGNED - T.JL
DRAWN - CAM
CHECKED - WDS
DATE - 8/16/2019

STATE OF ILLINOIS
DEPARTMENT OF TRANSPORTATION


IDOT LIGHTING CONTROLLER 'U'
WIRING DIAGRAM
SCALE: N.T.S. SHEET 7 OF 11 SHEETS STA. TO STA.

F.A.I. RTE.	SECTION	COUNTY	TOTAL SHEETS	SHEET NO.
90/94/290	2019-054-I	COOK	400	210
CONTRACT NO. 62J31				
ILLINOIS FED. AID PROJECT				

FILE PATH = p:\AECOM\NA-AVSI\ecommon\line\local\AECOM_DS02_NA\Documents\01_Americas\Transportation\60269938_Circle Phase\1\000_CAD\01E\Electrical\Sheets\62J31_Contract\0162J31-sht-Light-08

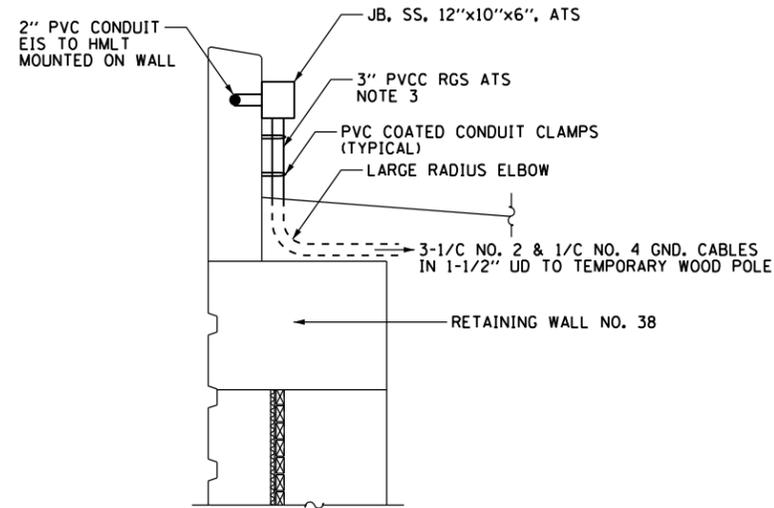

RETAINING WALL NO. 38 CONDUIT ROUTING DETAIL
NOT TO SCALE

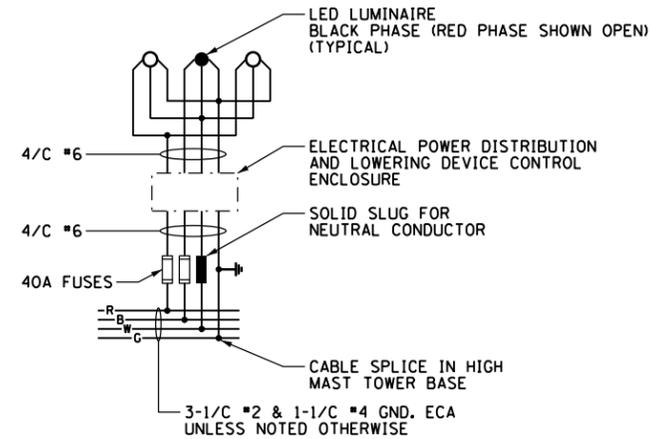

TYPICAL HIGH MAST LIGHT TOWER WIRING DIAGRAM
NOT TO SCALE

NOTES:

1. SEE DRAWING E-01 FOR IDOT ELECTRICAL SYMBOLS.
2. THE FUSES, FUSE HOLDERS, AND SOLID SLUGS SHALL BE PROVIDED ACCORDING TO ARTICLE 1065.01 OF THE IDOT STANDARDS. THE COST OF PROVIDING THE FUSES, FUSE HOLDERS, AND SOLID SLUGS IN THE JUNCTION BOX WILL NOT BE PAID FOR SEPARATELY AND WILL BE INCLUDED IN THE COST OF THE JUNCTION BOX IN WHICH THEY ARE INSTALLED.
3. PROVIDE A 3-INCH PVCC COATED RIGID STEEL CONDUIT AND 90-DEGREE ELBOW ATTACHED TO STRUCTURE FROM THE JUNCTION BOX TO BELOW FINAL GRADE. ROUTE UNIT DUCT FROM THE TEMPORARY WOOD POLE THROUGH THE CONDUIT TO THE JUNCTION BOX AS SHOWN ON DRAWING E-04.





D162J31-sht-Light-08	DESIGNED - TJL	REVISED -
USER NAME = myersc	DRAWN - CAM	REVISED -
PLOT SCALE = 40.0000' / in.	CHECKED - WDS	REVISED -
PLOT DATE = 8/14/2019	DATE - 8/16/2019	REVISED -

STATE OF ILLINOIS
DEPARTMENT OF TRANSPORTATION



ELECTRICAL DETAILS

SCALE: N.T.S. SHEET 8 OF 11 SHEETS STA. TO STA.

F.A.I. RTE.	SECTION	COUNTY	TOTAL SHEETS	SHEET NO.
90/94/290	2019-054-I	COOK	400	211
CONTRACT NO. 62J31				
ILLINOIS FED. AID PROJECT				

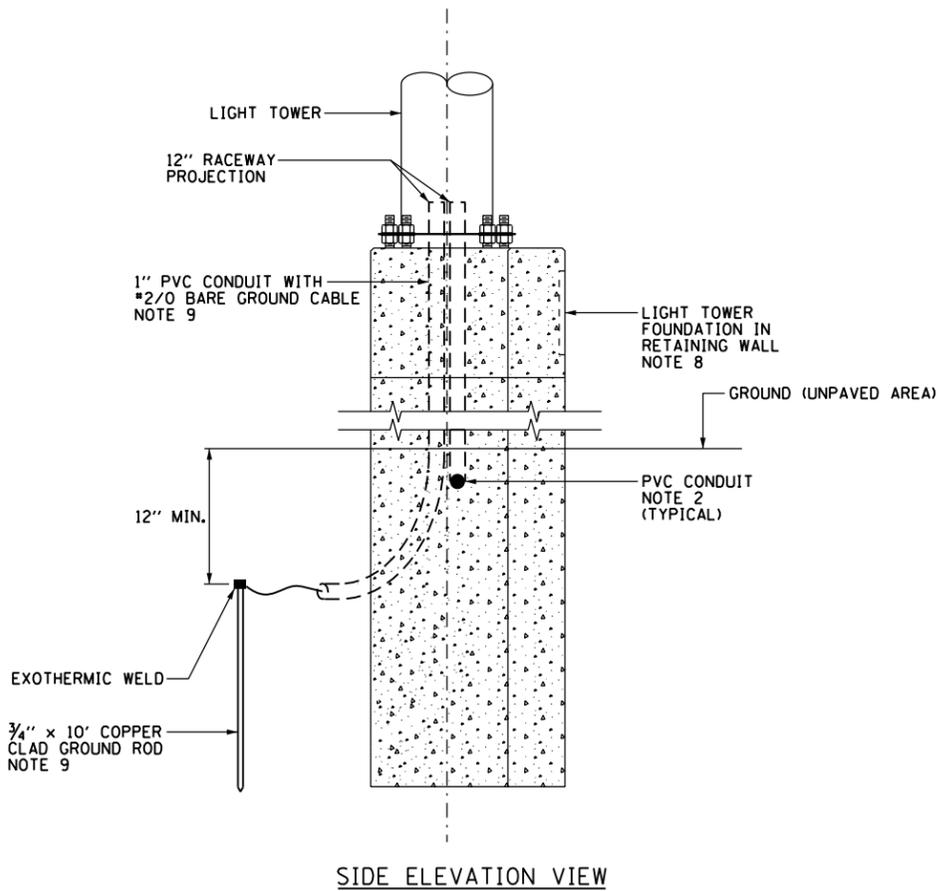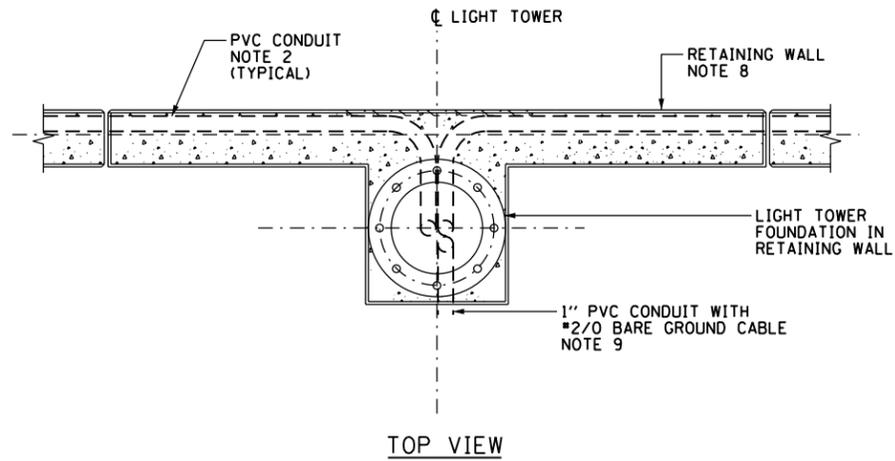

CONDUIT INSTALLATION DETAIL
FOR HIGH MAST LIGHT TOWER FOUNDATION
IN RETAINING WALL
NOT TO SCALE

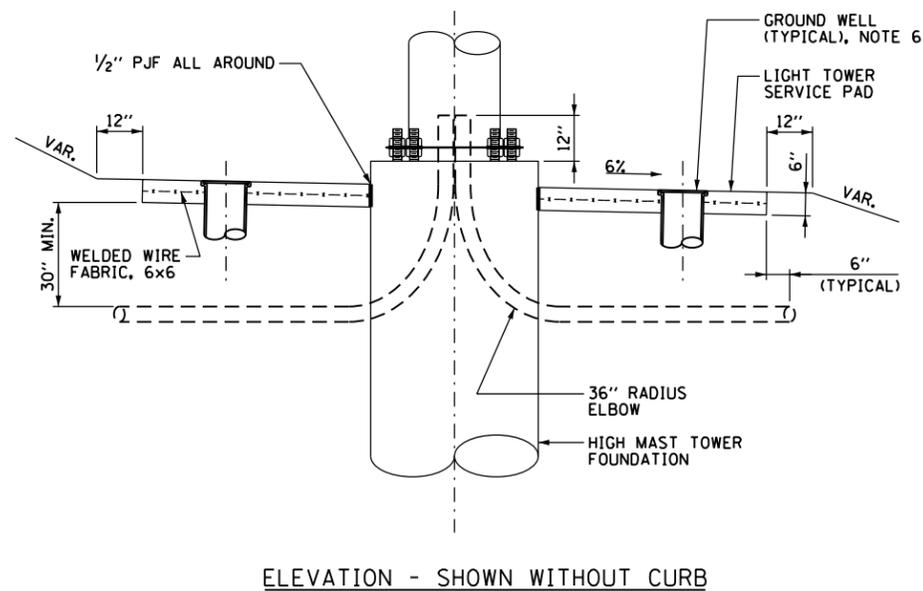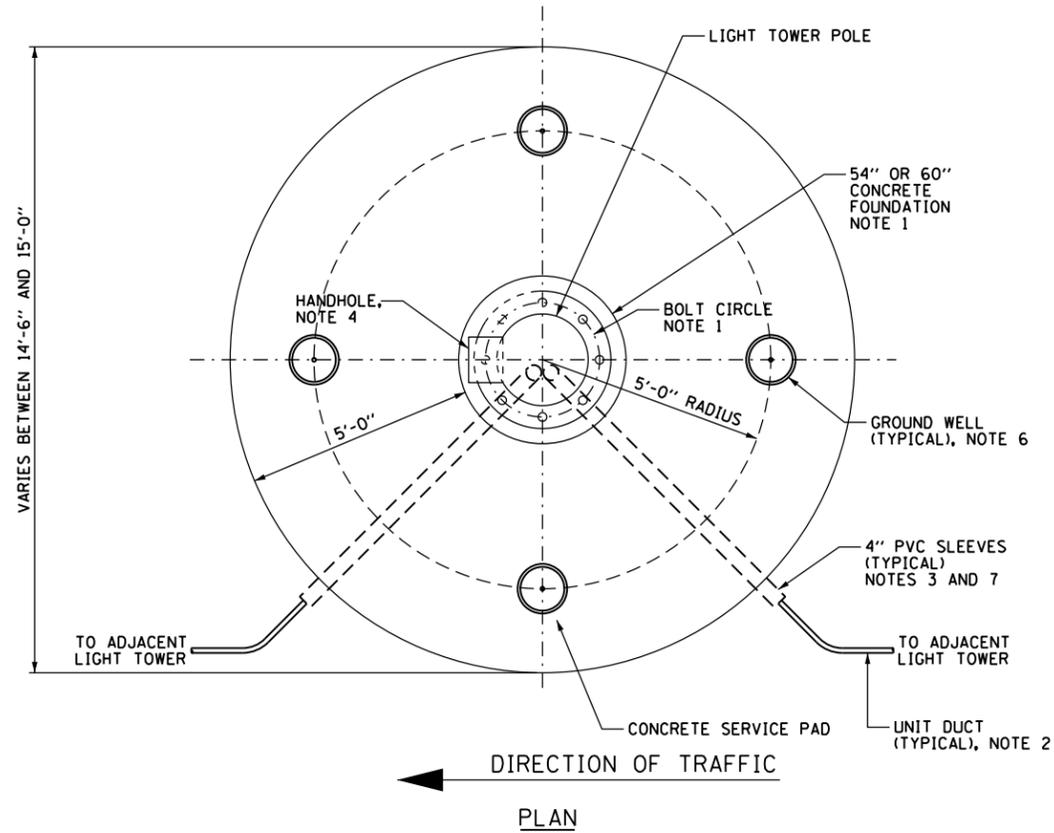

GROUND MOUNTED HIGH MAST TOWER SERVICE PAD,
GROUNDING AND CONDUIT INSTALLATION DETAILS
NOT TO SCALE

- NOTES:**
- SEE IDOT STANDARD DRAWING BE-506 OR BE-511 FOR ADDITIONAL HIGH MAST LIGHT TOWER FOUNDATION AND GROUND WELL DETAILS.
 - SEE ELECTRICAL PLAN DRAWINGS FOR QUANTITY, SIZE, AND TYPE OF RACEWAY AND LIGHTING CIRCUITS ROUTED TO EACH HIGH MAST LIGHT TOWER FOUNDATION.
 - PVC SLEEVES MUST BE EXTENDED 6 INCHES BEYOND THE EDGE OF THE CONCRETE PAD.
 - THE HANDHOLE FOR THE HIGH MAST LIGHTING UNIT MUST BE ORIENTED SUCH THAT IT IS MOUNTED ON THE SIDE OF THE POLE THAT IS OPPOSITE THE DIRECTION OF TRAFFIC.
 - ALL EMPTY SLEEVES MUST BE CAPPED UNLESS NOTED OTHERWISE ON THE PLANS.
 - INSTALL GROUND WELLS 5'-0" AS MEASURED FROM THE CENTER LINE OF THE HIGH MAST TOWER TO THE CENTER LINE OF THE WELL.
 - PVC CONDUIT SLEEVES SHALL BE INCLUDED IN THE COST OF THE LIGHT TOWER FOUNDATION AND SHALL NOT BE PAID FOR SEPARATELY.
 - SEE STRUCTURAL PLANS FOR THE FOUNDATION INSTALLATION DESIGN DETAILS.
 - ALL NECESSARY WORK AND MATERIALS FOR GROUNDING SHALL BE INCLUDED IN THE COST OF THE RETAINING WALL.

FILE PATH = p:\VACOM\NA-AWSI\elecmon\line\local\AECOM_0582_NA\Documents\01_Americas\Transportation\60269938_Circle Phase\1\000_CAD\01E.Electrical\Sheets\62J31_Contract\0162J31-sht-Light-09



D162J31-sht-Light-09
USER NAME = myersc
PLOT SCALE = 2.0000' / in.
PLOT DATE = 8/14/2019

DESIGNED - TJL
DRAWN - CAM
CHECKED - WDS
DATE - 8/16/2019

REVISED -
REVISED -
REVISED -
REVISED -


STATE OF ILLINOIS
DEPARTMENT OF TRANSPORTATION

LIGHT TOWER SERVICE PAD AND CONDUIT DETAILS



SCALE: N.T.S. SHEET 9 OF 11 SHEETS STA. TO STA.

F.A.I. RTE.	SECTION	COUNTY	TOTAL SHEETS	SHEET NO.
90/94/290	2019-054-I	COOK	400	212
CONTRACT NO. 62J31				
ILLINOIS FED. AID PROJECT				

FILE PATH = p:\naecom\na-ansi\encom\line\local\AECOM_0502_NA.Documents\01_Americas\Transportation\60269938_Circle Phase 1\1000_CAD\01E.Electrical\Sheets\62J31_Contract\0162J31-sht-Light-10

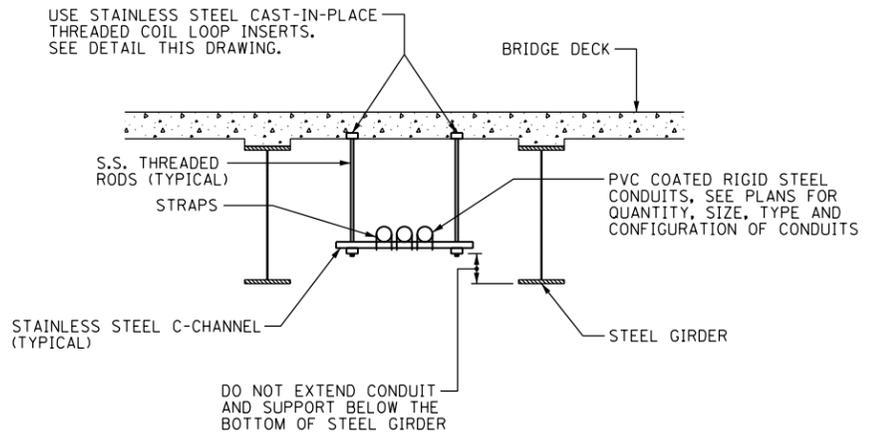

TYPICAL CONDUIT SUPPORT ATTACHED TO BRIDGE DECK DETAIL
SCALE: NOT TO SCALE
NOTES 3 & 5

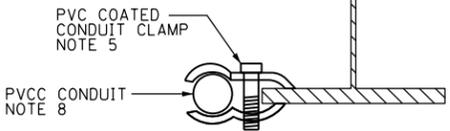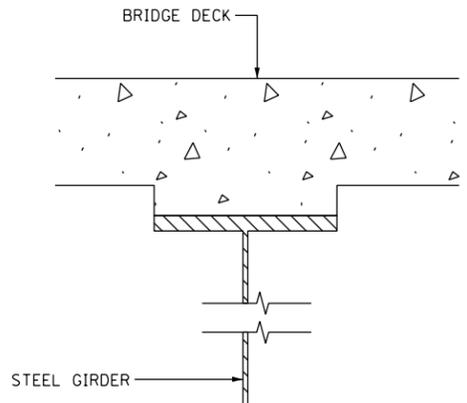


CONDUIT BEAM CLAMPED INSTALLATION DETAIL


PVC COATED CONDUIT BEAM CLAMP
NOT TO SCALE NOTE 7

NOTES:


1. THE CONTRACTOR IS RESPONSIBLE FOR DETERMINING THE MEANS AND METHODS FOR ATTACHING CONDUITS AND JUNCTION BOXES TO A STRUCTURE. ALL WORK REQUIRED TO ATTACH CONDUIT TO STRUCTURES MUST COMPLY WITH SECTION 811 OF THE STANDARD SPECIFICATIONS AND ALL MATERIALS MUST COMPLY WITH SECTION 1088 OF THE STANDARD SPECIFICATIONS.
2. THE CONTRACTOR MUST COORDINATE THREADED ROD END SIZES WITH THE C-CHANNEL AND FLARED LOOP INSERT MANUFACTURERS.
3. THE CONDUIT SUPPORT SYSTEM ATTACHED TO THE BRIDGE STRUCTURE, INCLUDING THE CONCRETE INSERTS AND MOUNTING HARDWARE, WILL NOT BE PAID FOR SEPARATELY, AND SHALL BE INCLUDED IN THE COST FOR THE "CONDUIT ATTACHED TO STRUCTURE" PAY ITEM.
4. SEE PLAN DRAWINGS FOR THE PROPOSED CONDUIT ROUTING.
5. ALL MOUNTING HARDWARE FOR THE PVCC RGC CONDUIT MUST BE PVC COATED.
6. THE CONTRACTOR MUST USE APPROVED SINGLE COIL FLARED LOOP INSERTS WHEN PENDANT MOUNTING THREADED RODS TO A NEW BRIDGE DECK. THE FLARED LOOP INSERTS MUST BE CAST INTO THE CONCRETE DECK. THE CONTRACTOR IS RESPONSIBLE FOR LOCATING THE INSERT LOCATIONS IN THE FIELD AND COORDINATING ALL WORK WITH THE BRIDGE DECK CONSTRUCTION.
7. SECURE THE CONDUIT WITH PVC COATED CONDUIT CLAMPS OR CONDUIT BEAM CLAMPS AS SHOWN AT 5'-0" INTERVALS FOR LATERALS AND WITHIN 2'-0" MAXIMUM FROM ANY JUNCTION BOX, FLEXIBLE CONDUIT, OR CHANGE IN DIRECTION. ALL PVC COATED CONDUIT CLAMPS OR BEAM CLAMPS WILL BE INCLUDED WITH THE COST OF THE "CONDUIT ATTACHED TO STRUCTURE" PAY ITEM.
8. ALL CONDUIT ATTACHED TO STRUCTURE SHALL BE PVC COATED RIGID STEEL CONDUIT (PVCC RGC) TYPICAL.

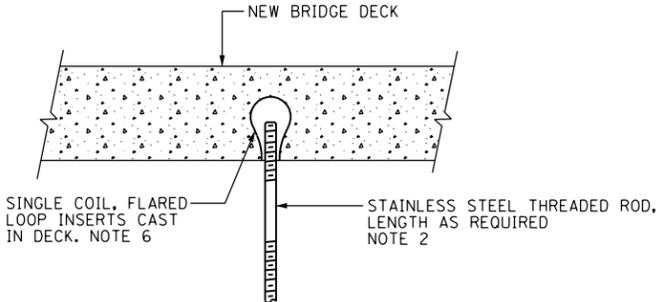


NEW BRIDGE DECK THREADED ROD INSTALLATION ANCHOR DETAILS
SCALE: NOT TO SCALE

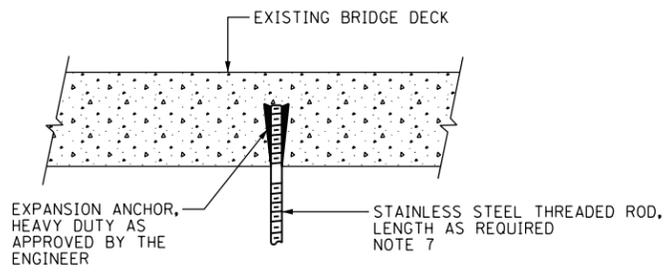


EXISTING BRIDGE DECK THREADED ROD INSTALLATION ANCHOR DETAILS

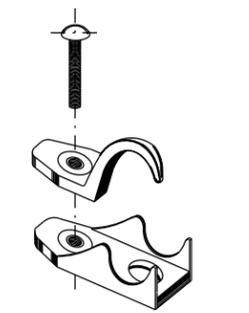


PVC COATED CONDUIT CLAMP
NOT TO SCALE NOTE 7

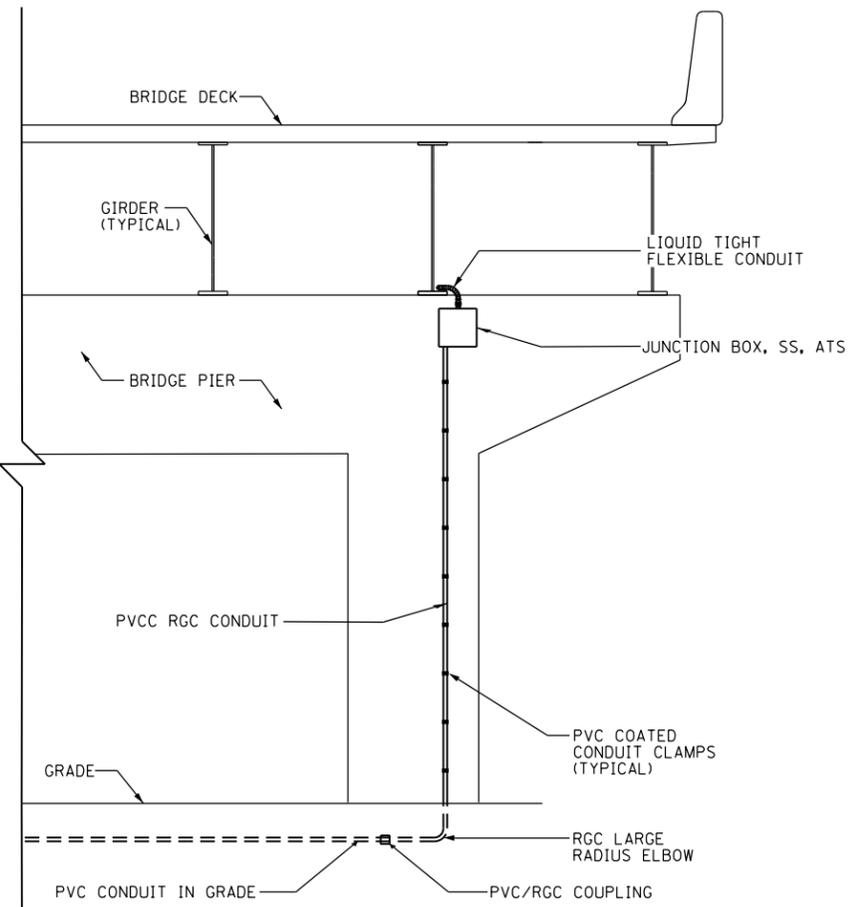

VERTICAL CONDUIT ATTACHED TO STRUCTURE DETAIL
NOT TO SCALE

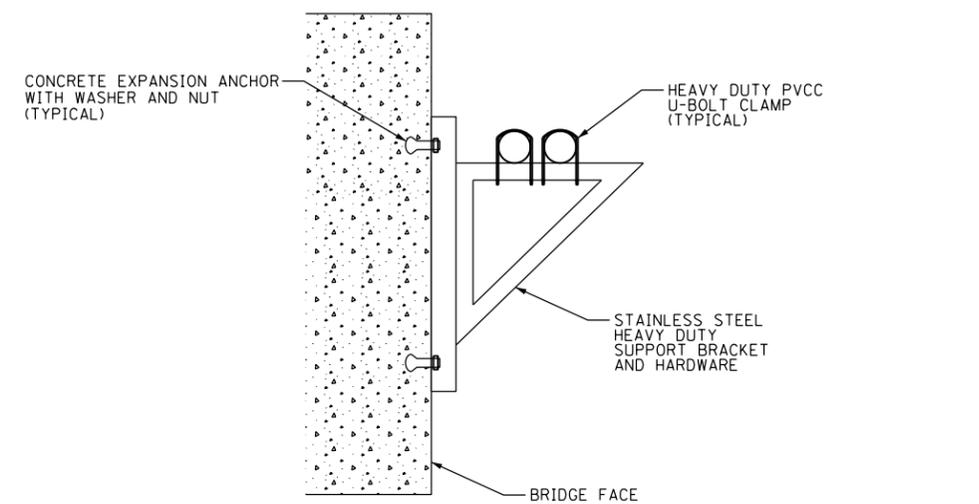

MOUNTING BRACKET FOR MULTIPLE CONDUITS
NOT TO SCALE

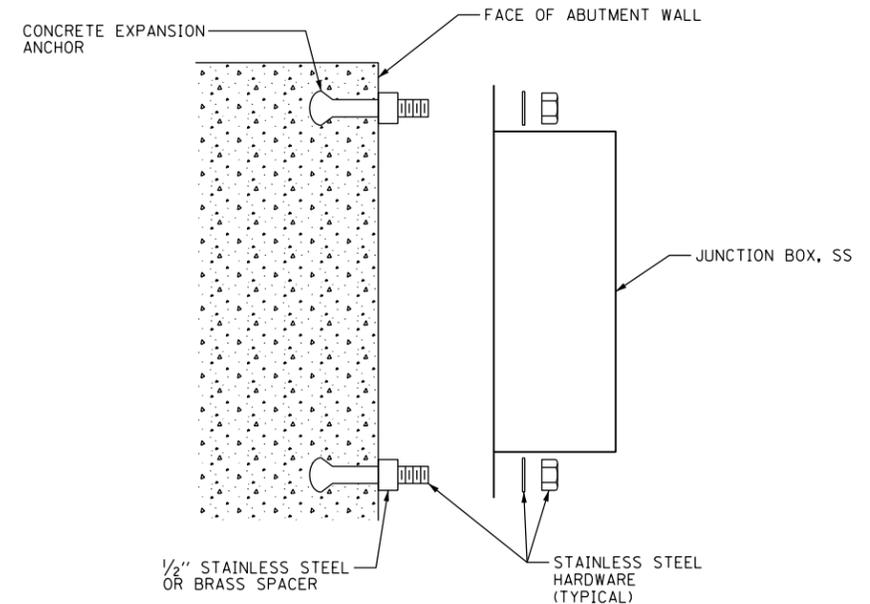

JUNCTION BOX MOUNTED TO STRUCTURE
NOT TO SCALE



D162J31-sht-Light-10
USER NAME = myersc
PLOT SCALE = 40.0000' / in.
PLOT DATE = 8/14/2019

DESIGNED - TJL
DRAWN - CAM
CHECKED - WDS
DATE - 8/16/2019


**STATE OF ILLINOIS
DEPARTMENT OF TRANSPORTATION**

MISCELLANEOUS ELECTRICAL DETAILS


SCALE: N.T.S. SHEET 10 OF 11 SHEETS STA. TO STA.

F.A.I. RTE.	SECTION	COUNTY	TOTAL SHEETS	SHEET NO.
90/94/290	2019-054-I	COOK	400	213
CONTRACT NO. 62J31				
ILLINOIS FED. AID PROJECT				

FILE PATH = p:\na\ecom\na-ansi\elecmon\line\local\ecom_0502_na_documents\01_america\Transportation\60269938_Circle Phase 1\000_CAD\01E.Electrical\Sheets\62J31_Contract\0162J31-sht-Light-11

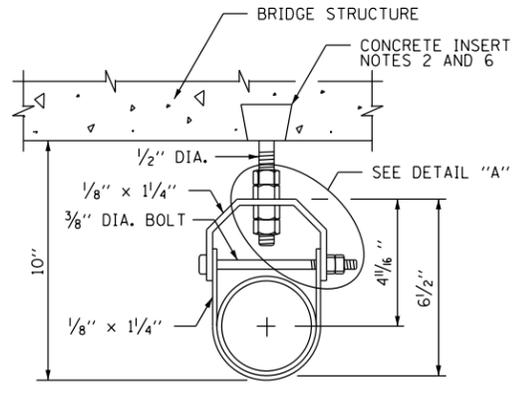


CONDUIT HANGER DETAIL

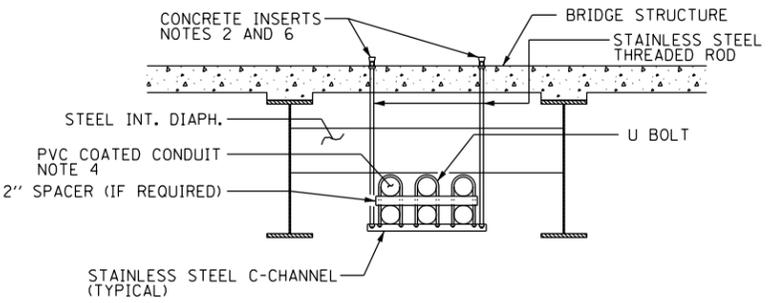


TYPICAL CONDUIT SUPPORT ATTACHED TO BRIDGE DECK WITH DIAPHRAGM DETAIL

NOTES 2 AND 3

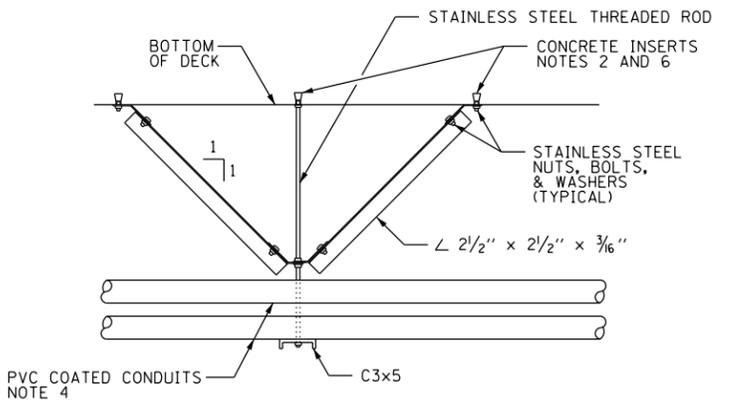


CENTERING DEVICE DETAIL - SIDE VIEW


(LOCATED ONLY ON A HANGER ADJACENT TO PIER)

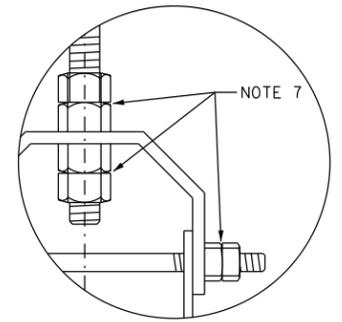

DETAIL "A"

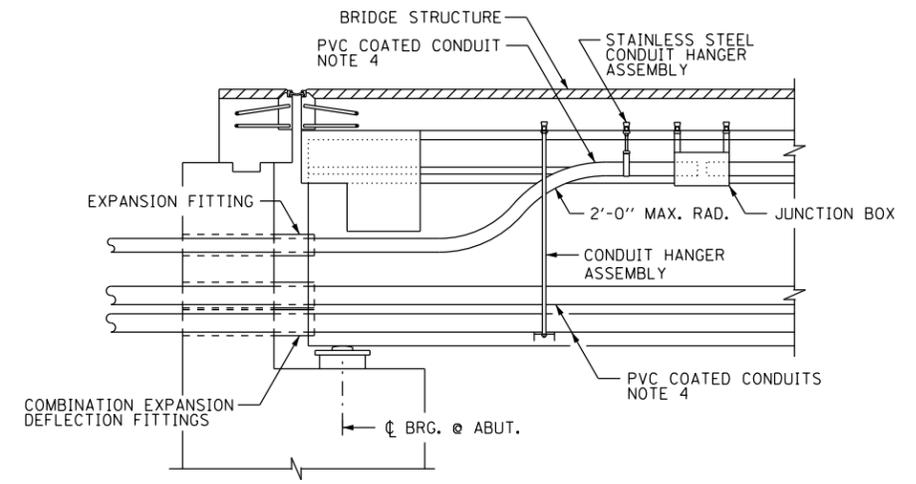


LONGITUDINAL SECTION

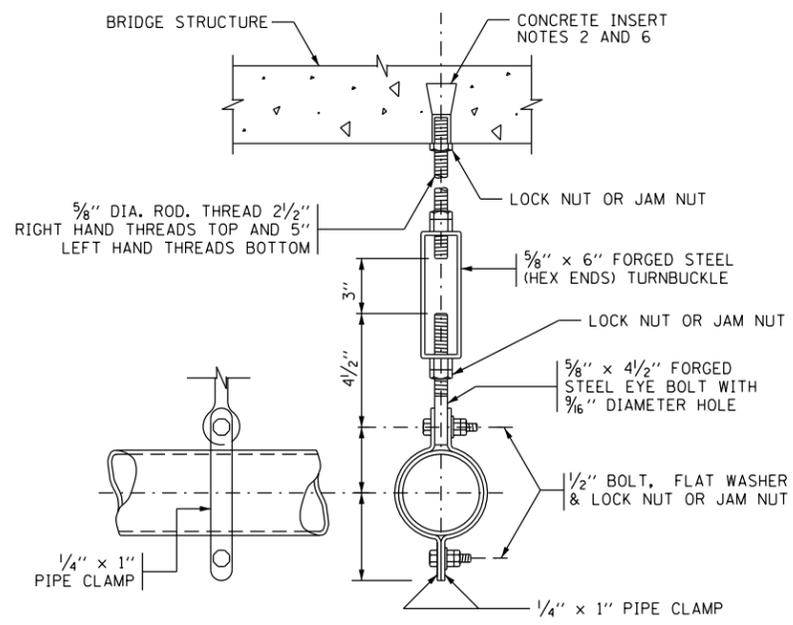

HANGER ASSEMBLY

EACH HANGER ASSEMBLY SHALL CONSIST OF CONCRETE INSERT, STAINLESS STEEL ROD, PIPE CLAMPS, NUTS, BOLTS, WASHERS, TURNBUCKLE AND EYE BOLT

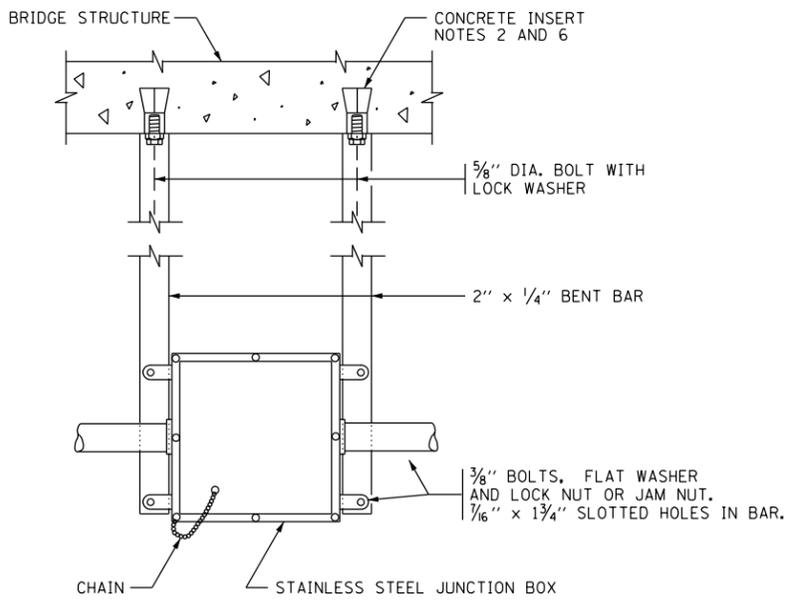

JUNCTION BOX SUSPENDED FROM STRUCTURE DETAILS

NOTE 5

NOTES:

1. THE CONTRACTOR IS RESPONSIBLE FOR DETERMINING THE MEANS AND METHODS FOR ATTACHING CONDUITS AND JUNCTION BOXES TO A STRUCTURE. ALL WORK REQUIRED TO ATTACH CONDUIT TO STRUCTURES MUST COMPLY WITH SECTION 811 OF THE STANDARD SPECIFICATIONS AND ALL MATERIALS MUST COMPLY WITH SECTION 1088 OF THE STANDARD SPECIFICATIONS.
2. SEE DRAWING E-10 FOR ADDITIONAL CONDUIT MOUNTING DETAILS AND FOR DETAILS REGARDING THE INSTALLATION OF CONCRETE INSERTS.
3. THE CONDUIT SUPPORT SYSTEM ATTACHED TO THE BRIDGE STRUCTURE, INCLUDING THE CONCRETE INSERTS AND MOUNTING HARDWARE, WILL NOT BE PAID FOR SEPARATELY, AND SHALL BE INCLUDED IN THE COST FOR THE "CONDUIT ATTACHED TO STRUCTURE" PAY ITEM.
4. SEE THE PLAN DRAWINGS FOR THE PROPOSED CONDUIT ROUTING.
5. THE JUNCTION BOX SUPPORT SYSTEM ATTACHED TO THE BRIDGE STRUCTURE, INCLUDING THE CONCRETE INSERTS AND ALL MOUNTING HARDWARE, WILL NOT BE PAID FOR SEPARATELY, AND SHALL BE INCLUDED IN THE COST FOR THE "JUNCTION BOX, STAINLESS STEEL, ATTACHED TO STRUCTURE" PAY ITEM.
6. SPACE INSERTS AT 10 FOOT (MAXIMUM) CENTERS.
7. PROVIDE STAINLESS STEEL DOUBLE NUTS, JAM NUTS OR LOCK NUTS FOR THIS INSTALLATION.
8. PROVIDE CONDUIT SLEEVES IN THE BRIDGE ABUTMENT AS REQUIRED TO ROUTE THE CONDUITS THROUGH THE STRUCTURE AS SHOWN. THE DIAMETER OF THE SLEEVES SHALL BE A MINIMUM OF 2 INCHES LARGER IN DIAMETER THAN THE DIAMETER OF THE CONDUIT. PROVIDE WATERPROOF SEALANT IN THE INTERSTITIAL SPACE BETWEEN THE SLEEVE AND THE CONDUIT.



D162J31-sht-Light-11
 USER NAME = myersc
 PLOT SCALE = 40.0000' / in.
 PLOT DATE = 8/14/2019

DESIGNED - TJL	REVISED -
DRAWN - CAM	REVISED -
CHECKED - WDS	REVISED -
DATE - 8/16/2019	REVISED -

**STATE OF ILLINOIS
DEPARTMENT OF TRANSPORTATION**

MISCELLANEOUS ELECTRICAL DETAILS

SCALE: N.T.S. SHEET 11 OF 11 SHEETS STA. TO STA.

F.A.I. RTE.	SECTION	COUNTY	TOTAL SHEETS	SHEET NO.
90/94/290	2019-054-I	COOK	400	214
CONTRACT NO. 62J31				
ILLINOIS FED. AID PROJECT				

SEQUENCING NOTES

- DUE TO WORK PERFORMED BY OTHERS, SEQUENCING MAY REQUIRE ALTERATION AS DEFINED BY THE AVAILABLE WORK AREAS AND SEQUENCING REQUIREMENTS SPECIAL PROVISION.

STAGE 1 (SHEETS ITS-05 TO ITS-07)

- GENERALLY COINCIDES WITH SUGGESTED CONSTRUCTION STAGE 1.
- JACKSON BOULEVARD SUPERSTRUCTURE CANNOT BE REMOVED UNTIL EXISTING FIBER OPTIC AND COPPER COMMUNICATION CABLES HAVE BEEN RELOCATED FROM CONDUIT ATTACHED TO THE BRIDGE.
- MAINTAIN EXISTING TEMPORARY WOOD POLES ALONG THE WEST SIDE OF I-90/94 BETWEEN JACKSON BOULEVARD AND THE HALSTED COMMUNICATION HUT. RELOCATE TEMPORARY WOOD POLES AS DEEMED NECESSARY FOR CONTRACTOR OPERATIONS.
- MAINTAIN OPERATIONS OF THE EXISTING CCTV CAMERA ATTACHED TO THE TEMPORARY WOOD POLE AT THE SOUTHWEST CORNER OF JACKSON BOULEVARD BRIDGE.
- MAINTAIN OPERATIONS OF THE EXISTING WIRELESS VEHICLE DETECTION SYSTEM MOUNTED TO THE TEMPORARY WOOD POLE ON THE WEST SIDE OF SOUTHBOUND I-90/94.
- INSTALL PROPOSED INFRASTRUCUTRE INCLUDING TEMPORARY WOOD POLES, HANDHOLES, AND CONDUIT FROM JACKSON BOULEVARD NORTH TO LAKE STREET.
- INSTALL NEW AERIAL CABLE ALONG THE TEMPORARY CABLE ROUTE BETWEEN LAKE ST. AND JACKON BLVD. AND MAKE THE NECESSARY CONNECTIONS AS DESCRIBED IN THE BELOW SEQUENCING:
- COPPER COMUNICATIONS CABLE CONNECTIONS:
 - SPLICE NEW AERIAL CABLES TO THE EXISTING AERIAL CABLES IN THE PROPOSED 42"x36"x12" JUNCTION BOX ATTACHED TO THE TEMPORARY WOOD POLE AT JACKSON BOULEVARD.
 - REMOVE THE EXISTING NO. 19 6/C CABLE AT LAKE STREET BETWEEN HANDHOLES ADJACENT TO CABINETS Y28 AND Y30.
 - SPLICE THE EXISTING NO. 19 6/C CABLE AT Y28 AND Y30 TO THE PROPOSED (2) NO. 19 25 PAIR CABLES. MAINTAIN EXISTING CABLE ASSIGNMENTS.
 - SPLICE THE PROPOSED (2) NO. 19 25 PAIR CABLES TO THE EXISTING NO. 19 50 PAIR CABLE IN THE EXISTING JUNCTION BOX ATTACHED TO THE BACKSIDE OF THE NORTHBOUND I-90/94 MEDIAN WALL. CONTACT IDOT BUREAU OF TRAFFIC OPERATIONS/ELECTRICAL FIELD OFFICE TO CONFIRM PROPOSED COPPER WIRE ASSIGNMENTS.
 - INSTALL NEW NO. 19 6 PAIR CABLE BETWEEN CABINETS Y26, Y22, Y18, Z12, AND Z8 AND THE ADJACENT WOOD POLE NEAR EACH CABINET. SPLICE THE NEW NO. 19 6 PAIR CABLES TO THE PROPOSED (2) NO. 19 25 PAIR CABLES IN THE PROPOSED JUNCTION BOX ATTACHED TO THE TEMPORARY WOOD POLE. PROPOSED NO. 19 6 PAIR CABLES SHALL BE CONNECTED TO THE CABINET TERMINAL BLOCKS TO MAINTAIN COMMUNICATIONS TO SURVEILLANCE CABINETS BETWEEN LAKE STREET AND ADAMS STREET. CONTACT IDOT BUREAU OF TRAFFIC OPERATIONS/ELECTRICAL FIELD OFFICE TO CONFIRM PROPOSED COPPER WIRE ASSIGNMENTS FOR THE AFFECTED CABINETS.
- FIBER OPTIC CABLE CONNECTIONS:
 - AFTER THE APPROPRIATE SPLICES HAVE BEEN MADE AS DESCRIBED IN THE PREVIOUS "COPPER COMMUNICATIONS CABLE CONNECTION" SECTION, REMOVE THE EXISTING NO. 19 6/C CABLE ROUTED THROUGH CONDUIT ATTACHED TO RANDOLPH STREET BRIDGE.
 - PULL FIBER OPTIC CABLE THROUGH EXISTING CONDUIT ATTACHED TO RANDOLPH STREET BRIDGE TO THE HANDHOLE ADJACENT TO CABINET Y27 CONTAINING THE EXISTING MAINLINE FIBER OPTIC SPLICE.
 - SPLICE PROPOSED FIBER OPTIC CABLE IN THE PROPOSED 42"x36"x12" JUNCTION BOX ATTACHED TO THE TEMPORARY WOOD POLE AT JACKSON BOULEVARD AND AT THE EXISTING MAINLINE SPLICE POINT IN THE RANDOLPH STREET HANDHOLE ADJACENT TO CABINET Y27. THE CONTRACTOR SHALL COORDINATE ALL DISCONNECTION AND SPLICING WORK WITH IDOT/OAK PARK TSC. THIS WORK SHALL ONLY OCCUR OVERNIGHT AFTER THE PM PEAK HOUR AND BEFORE THE AM PEAK HOUR THE NEXT MORNING. ALL SPLICING AND TERMINATION WORK SHALL BE ACCOMPLISHED IN ONE NIGHT. CONTACT IDOT BUREAU OF TRAFFIC OPERATIONS/ELECTRICAL FIELD OFFICE TO CONFIRM PROPOSED FIBER OPTIC CABLE ASSIGNMENTS.

SEQUENCING NOTES (CONTINUED)

STAGE 2 (SHEETS ITS-08)

- GENERALLY COINCIDES WITH SUGGESTED CONSTRUCTION STAGES 2 AND 3.
- JACKSON BOULEVARD SUPERSTRUCTURE CANNOT BE REMOVED UNTIL EXISTING FIBER OPTIC AND COPPER COMMUNICATION CABLES HAVE BEEN RELOCATED FROM CONDUIT ATTACHED TO THE BRIDGE.
- STAGE 1 PROPOSED INFRASTRUCTURE AS SHOWN IN THE PLANS FOR ITS-05 AND ITS-06 SHALL BE MAINTAINED THROUGH STAGE 2.
- INSTALL NEW TEMPORARY WOOD POLES BEHIND RETAINING WALL 38 DRILLED SHAFTS AND CONCRETE CAP.
- DISCONNECT AND RELOCATE THE EXISTING CCTV CAMERA AND EQUIPMENT CABINET AND RELOCATE TO THE NEW TEMPORARY WOOD POLE.
- DISCONNECT AND RELOCATE THE EXISTING WIRELESS VEHICLE DETECTION SYSTEM AND EQUIPMENT CABINET AND RELOCATE TO THE NEW TEMPORARY WOOD POLE.
- REMOVE AERIAL CABLES FROM THE EXISTING TEMPORARY WOOD POLES SOUTH OF JACKSON AND RELOCATE CABLES TO THE NEW TEMPORARY WOOD POLE CABLE ROUTE. STORE EXCESS CABLE SLACK ON EACH WOOD POLE.
- REMOVE TEMPORARY WOOD POLES NO LONGER IN USE.

MAINTAIN THE TEMPORARY CABLE ROUTE THROUGH THE REMAINDER OF THE CONTRACT. TEMPORARY WOOD POLES AND CABLES ARE TO REMAIN AT THE CONCLUSION OF THE CONTRACT.

ABBREVIATIONS:

- ATS - ATTACHED TO STRUCTURE
- EIS - EMBEDDED IN STRUCTURE
- ENC - ENCASED IN CONCRETE
- UG - UNDERGROUND
- PVCC GS - PVC COATED GALVANIZED STEEL
- SS - STAINLESS STEEL
- HDHH - HEAVY-DUTY HANDHOLE
- JB - JUNCTION BOX
- SMF - SINGLE MODE FIBER
- WVDS - WIRELESS VEHICLE DETECTION SYSTEM

FILE PATH = p:\na\ecom\na-ans\elecmon\local\ecom\0502_n\documents\01_america's Transportation\60269938_Circle Phase 1\000_CAD\006_Roadway\Sheets\62J31_Contract\0162J31-SHT-ITS-01

ITS-01



D162J31-SHT-ITS-01	DESIGNED - MJL	REVISED -
USER NAME = myersc	DRAWN - CAM	REVISED -
PLOT SCALE = 2.0000' / in.	CHECKED - PTJ	REVISED -
PLOT DATE = 8/14/2019	DATE - 8/16/2019	REVISED -


**STATE OF ILLINOIS
DEPARTMENT OF TRANSPORTATION**

ITS SEQUENCING AND ABBREVIATIONS


SCALE: N.T.S. SHEET 1 OF 11 SHEETS STA. TO STA.

F.A.I. RTE.	SECTION	COUNTY	TOTAL SHEETS	SHEET NO.
90/94/290	2019-054-I	COOK	400	215
CONTRACT NO. 62J31			ILLINOIS FED. AID PROJECT	

FILE PATH = p:\naecom\na-ansi\encom\line\local\AECOM_0502_NA\Documents\01_Americas\Transportation\60269938_Circle Phase 1\1000_CAD\046_Roadway\Sheets\62J31_Contract\162J31-SHT-ITS-02

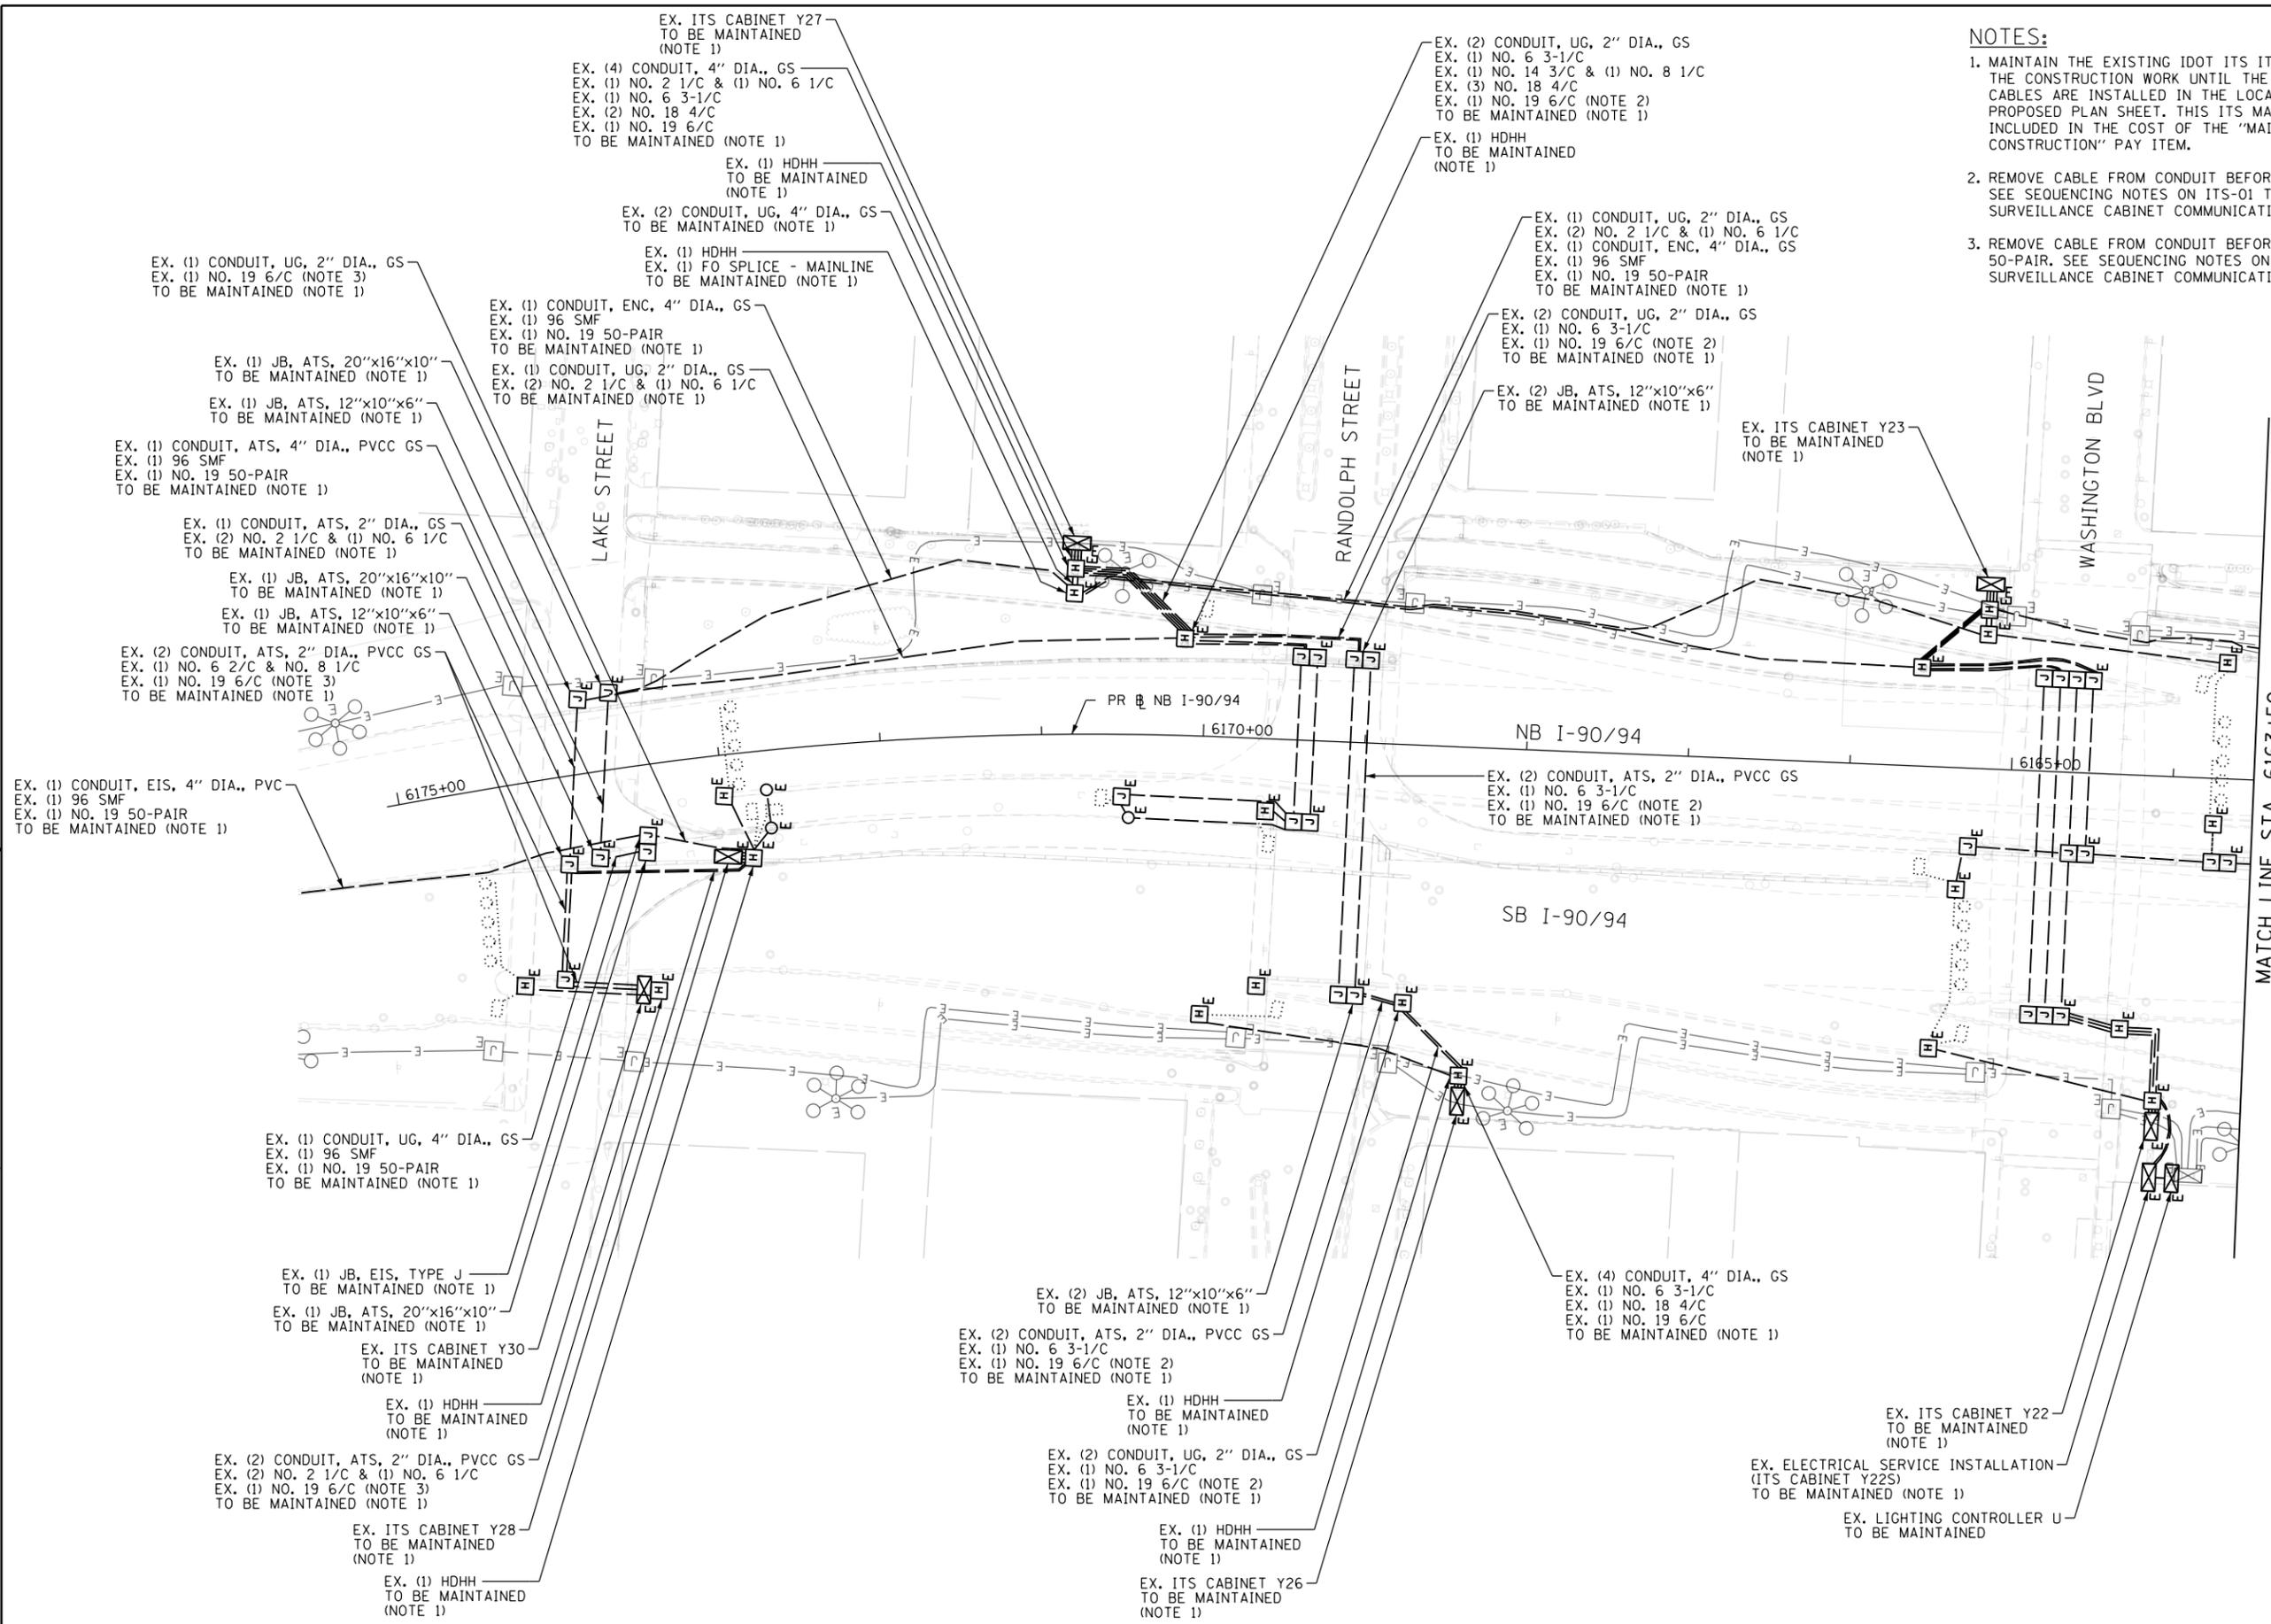

- NOTES:**
1. MAINTAIN THE EXISTING IDOT ITS ITEMS THAT WILL BE AFFECTED BY THE CONSTRUCTION WORK UNTIL THE NEW INFRASTRUCTURE AND CABLES ARE INSTALLED IN THE LOCATIONS INDICATED IN THE PROPOSED PLAN SHEET. THIS ITS MAINTENANCE WORK SHALL BE INCLUDED IN THE COST OF THE "MAINTAINING ITS DURING CONSTRUCTION" PAY ITEM.
 2. REMOVE CABLE FROM CONDUIT BEFORE INSTALLING PROPOSED 96 SMF. SEE SEQUENCING NOTES ON ITS-01 TO REDUCE DOWNTIME TO SURVEILLANCE CABINET COMMUNICATIONS.
 3. REMOVE CABLE FROM CONDUIT BEFORE INSTALLING PROPOSED NO. 19 50-PAIR. SEE SEQUENCING NOTES ON ITS-01 TO REDUCE DOWNTIME TO SURVEILLANCE CABINET COMMUNICATIONS.

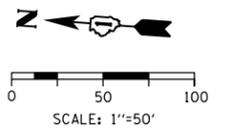

ITS-02





D162J31-SHT-ITS-02	DESIGNED - MJL	REVISED -
USER NAME = myersc	DRAWN - CAM	REVISED -
PLOT SCALE = 100.0000' / in.	CHECKED - PTJ	REVISED -
PLOT DATE = 8/14/2019	DATE - 8/16/2019	REVISED -

**STATE OF ILLINOIS
DEPARTMENT OF TRANSPORTATION**

EXISTING ITS PLAN I-90/94	
SCALE: 1"=50'	SHEET 2 OF 11 SHEETS
STA.	TO STA. 6163+50

F.A.I. RTE.	SECTION	COUNTY	TOTAL SHEETS	SHEET NO.
90/94/290	2019-054-I	COOK	400	216
CONTRACT NO. 62J31				
ILLINOIS FED. AID PROJECT				

NOTES:
 1. MAINTAIN THE EXISTING IDOT ITS ITEMS THAT WILL BE AFFECTED BY THE CONSTRUCTION WORK UNTIL THE NEW INFRASTRUCTURE AND CABLES ARE INSTALLED IN THE LOCATIONS INDICATED IN THE PROPOSED PLAN SHEET. THIS ITS MAINTENANCE WORK SHALL BE INCLUDED IN THE COST OF THE "MAINTAINING ITS DURING CONSTRUCTION" PAY ITEM.

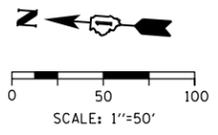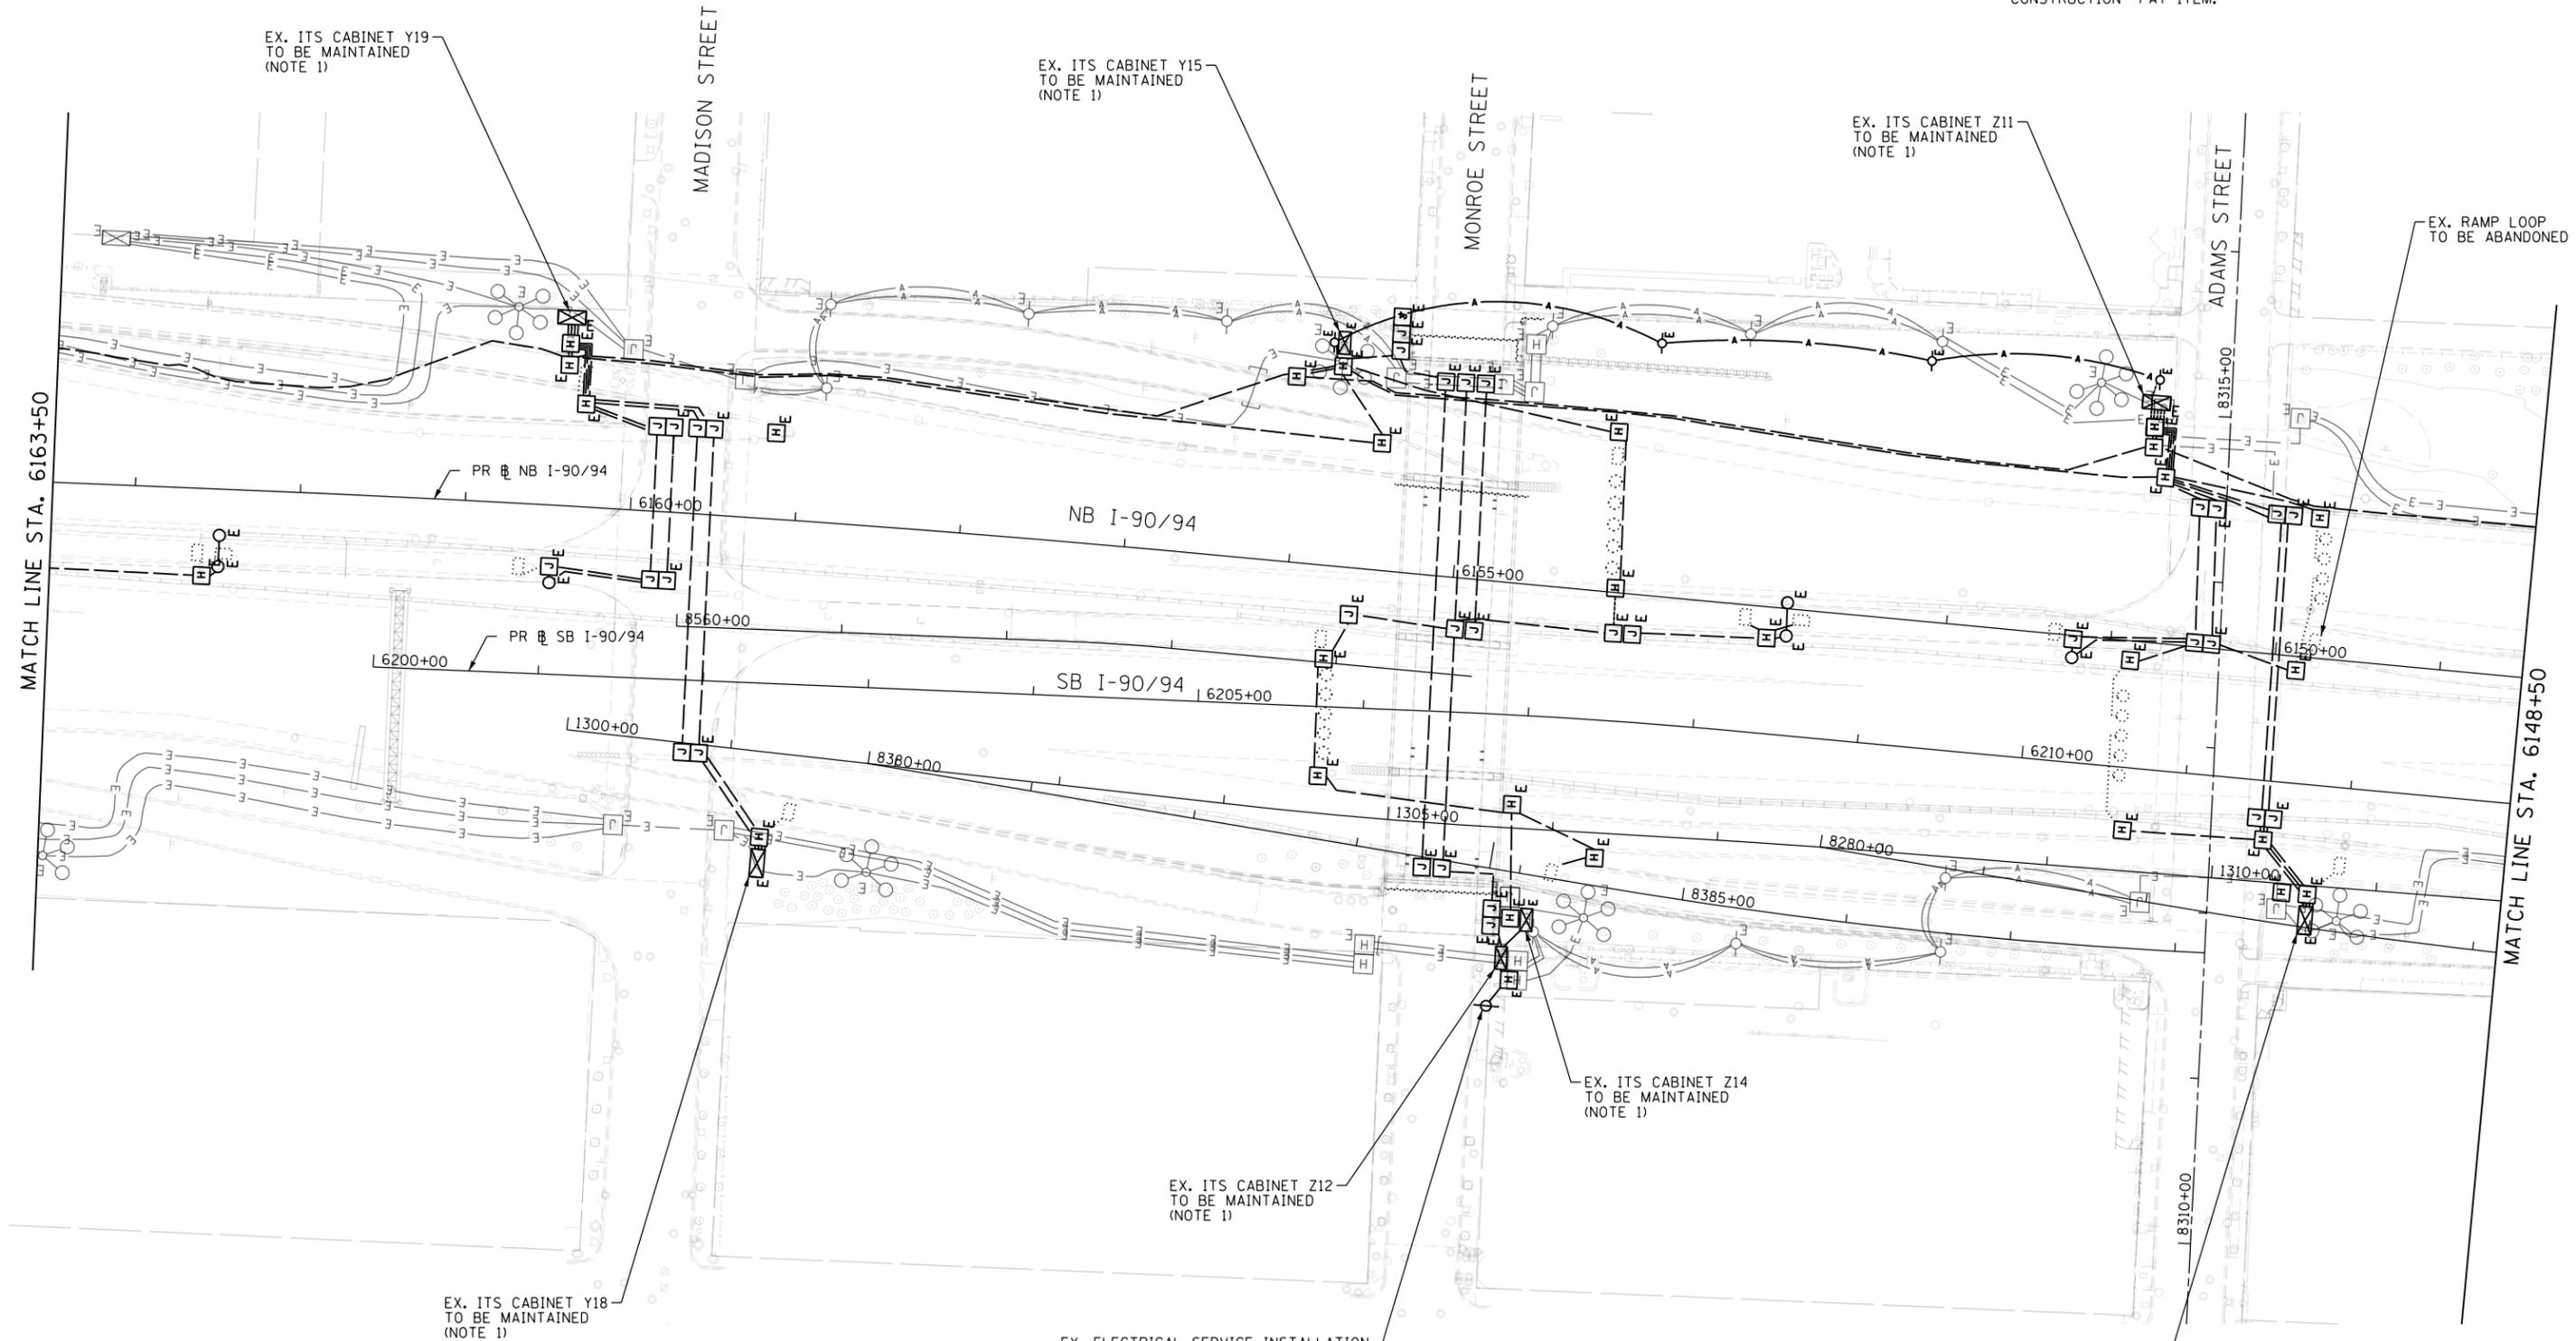

FILE PATH = p:\AECOM\NA-AWS\encom\line\local\AECOM_DS02_NA\Documents\01_Americas\Transportation\60269938_Circle Phase II\000_CAD\006_Roadway\Sheets\62J31_Contract\162J31-SHT-ITS-03



D162J31-SHT-ITS-03
 USER NAME = myersc
 PLOT SCALE = 100.0000' / 1" = 100'
 PLOT DATE = 8/14/2019

DESIGNED - MJL
 DRAWN - CAM
 CHECKED - PTJ
 DATE - 8/16/2019

REVISED -
 REVISED -
 REVISED -
 REVISED -

**STATE OF ILLINOIS
 DEPARTMENT OF TRANSPORTATION**


**EXISTING ITS PLAN
 I-90/94**

SCALE: 1"=50' SHEET 3 OF 11 SHEETS STA. 6163+50 TO STA. 6148+50

F.A.I. RTE.	SECTION	COUNTY	TOTAL SHEETS	SHEET NO.
90/94/290	2019-054-I	COOK	400	217
CONTRACT NO. 62J31				
ILLINOIS FED. AID PROJECT				


ITS-03

FILE PATH = p:\aecom\ms-ansi\electron\line\local\AECOM_0502_MIA\Documents\01_Americas\Transportation\60269938_Circle Phase II\000_CAD\006_Roadway_Sheets\62J31_Contract\0162J31-SHT-ITS-04

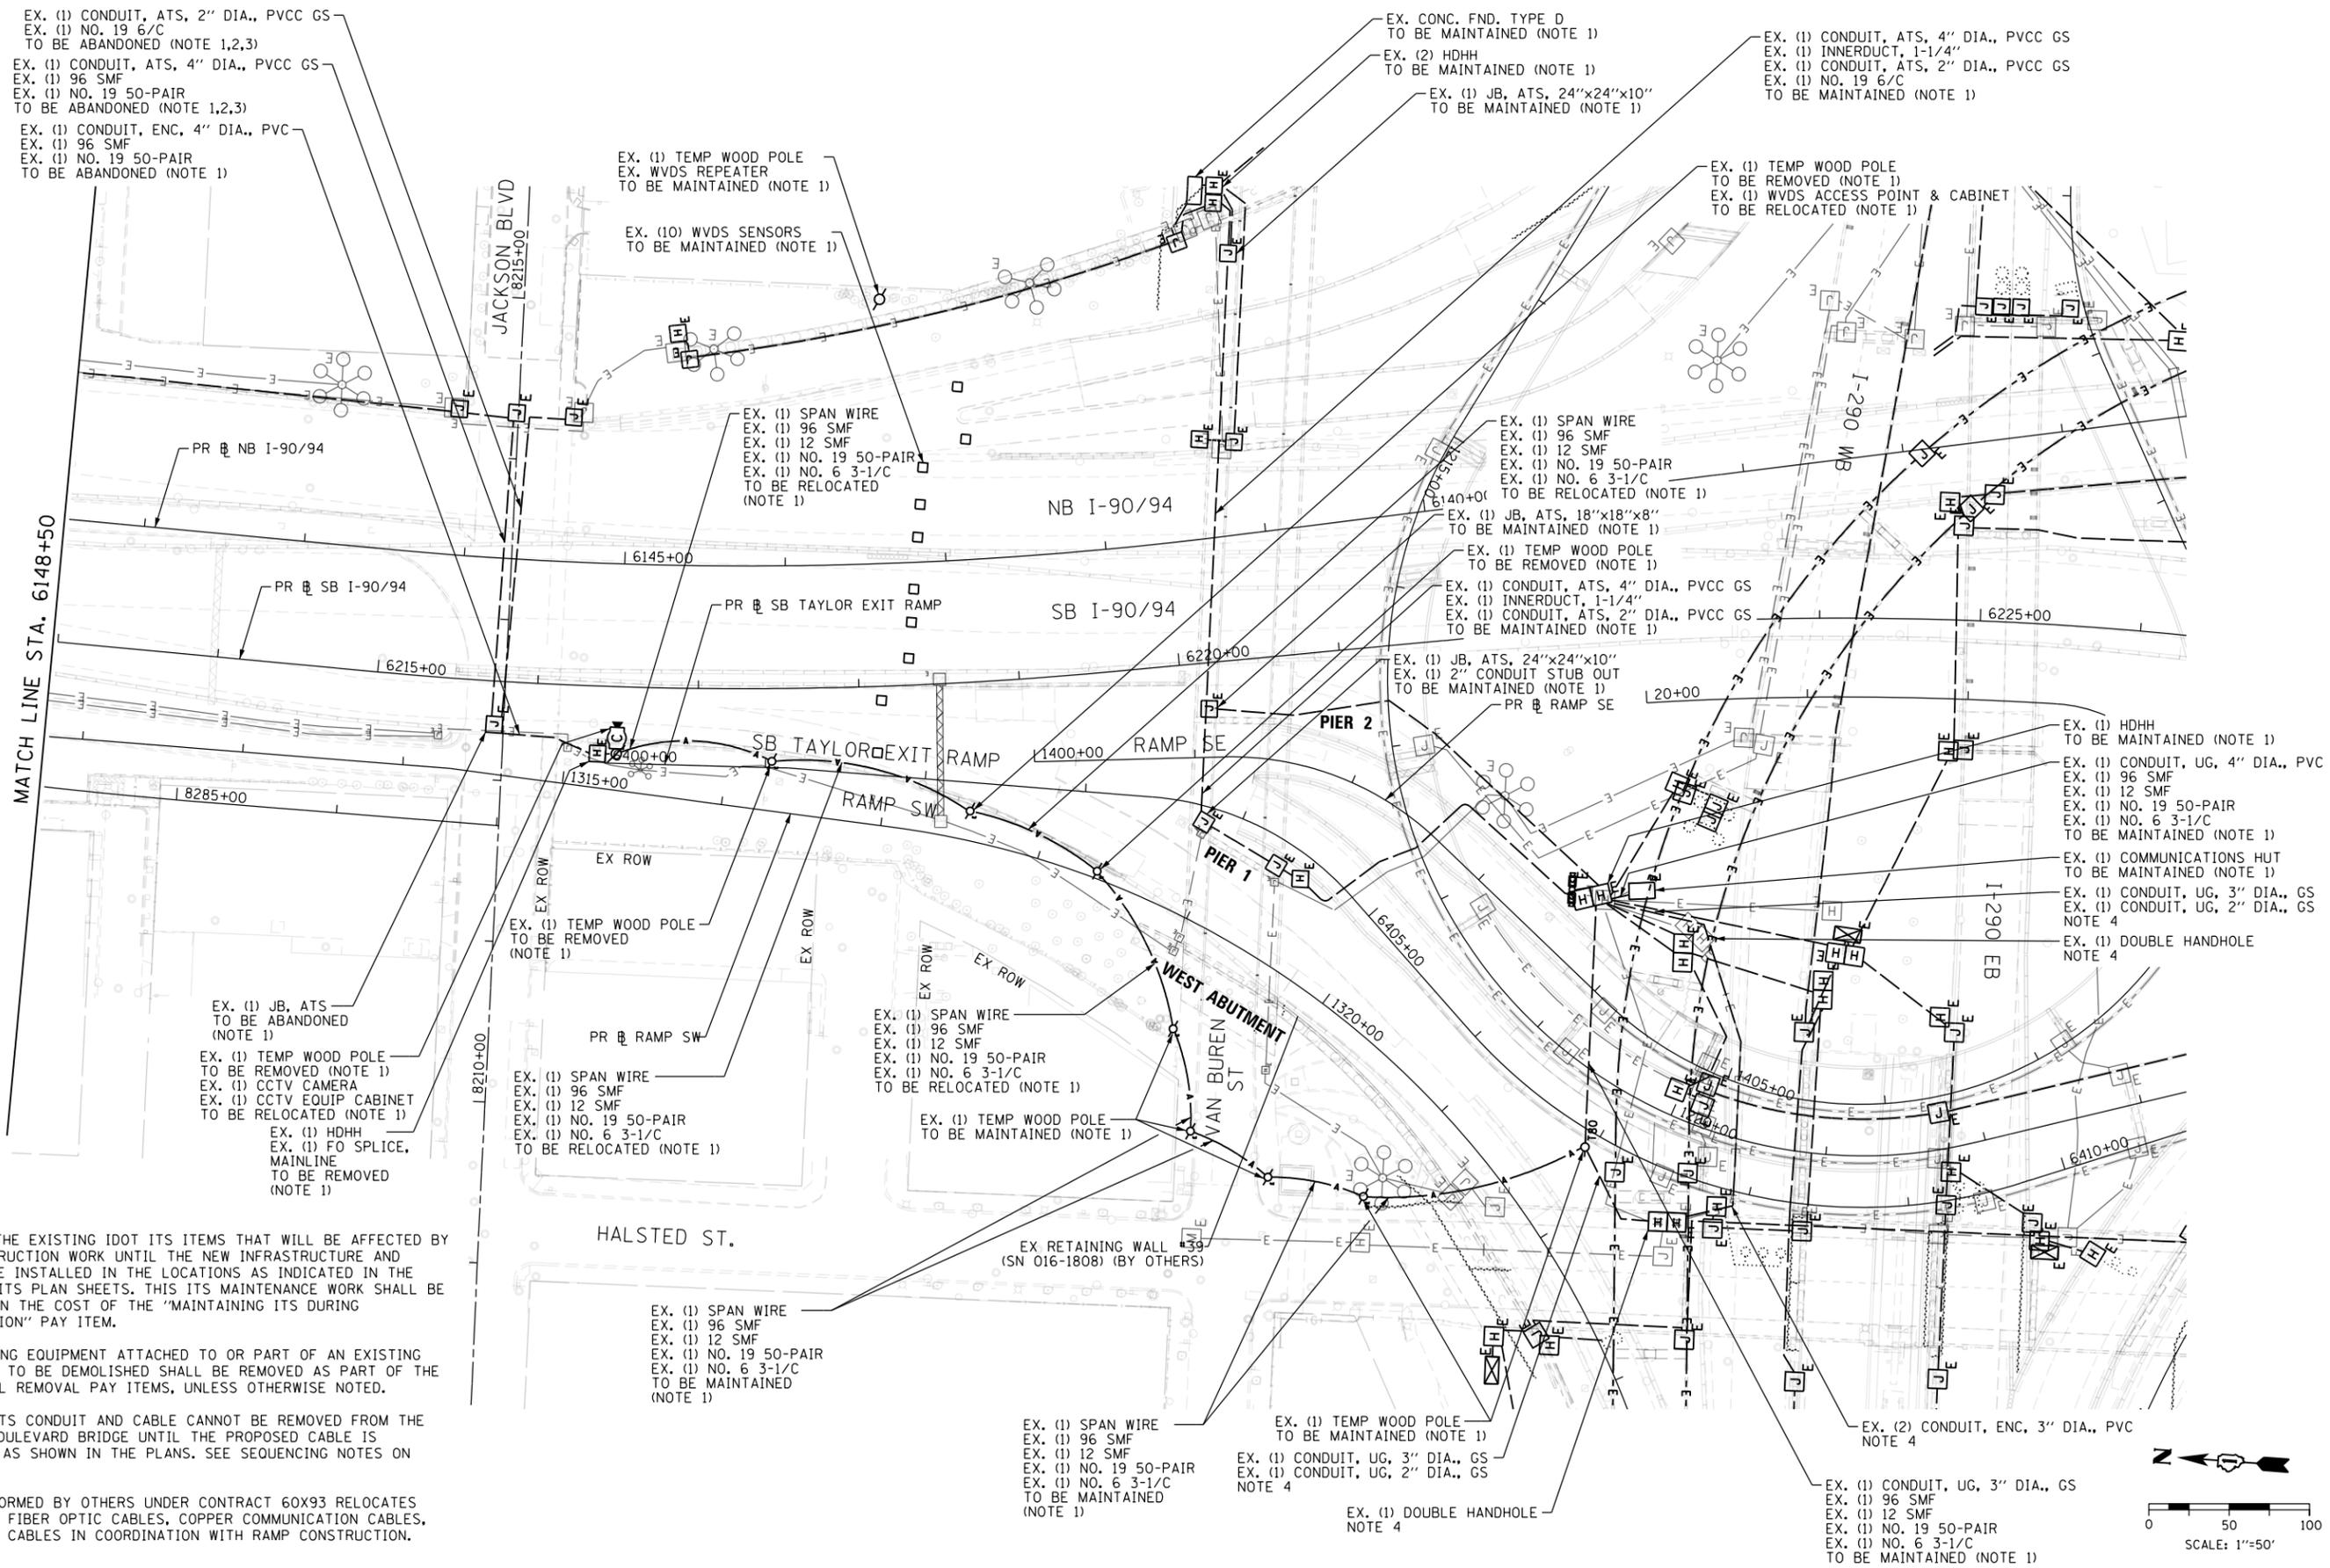

NOTES:

1. MAINTAIN THE EXISTING IDOT ITS ITEMS THAT WILL BE AFFECTED BY THE CONSTRUCTION WORK UNTIL THE NEW INFRASTRUCTURE AND CABLES ARE INSTALLED IN THE LOCATIONS AS INDICATED IN THE PROPOSED ITS PLAN SHEETS. THIS ITS MAINTENANCE WORK SHALL BE INCLUDED IN THE COST OF THE "MAINTAINING ITS DURING CONSTRUCTION" PAY ITEM.
2. ALL EXISTING EQUIPMENT ATTACHED TO OR PART OF AN EXISTING STRUCTURE TO BE DEMOLISHED SHALL BE REMOVED AS PART OF THE STRUCTURAL REMOVAL PAY ITEMS, UNLESS OTHERWISE NOTED.
3. EXISTING ITS CONDUIT AND CABLE CANNOT BE REMOVED FROM THE JACKSON BOULEVARD BRIDGE UNTIL THE PROPOSED CABLE IS INSTALLED AS SHOWN IN THE PLANS. SEE SEQUENCING NOTES ON ITS-01.
4. WORK PERFORMED BY OTHERS UNDER CONTRACT 60X93 RELOCATES TEMPORARY FIBER OPTIC CABLES, COPPER COMMUNICATION CABLES, AND POWER CABLES IN COORDINATION WITH RAMP CONSTRUCTION.

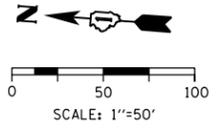

ITS-04



D162J31-SHT-ITS-04	DESIGNED - MJL	REVISED -
USER NAME = myersc	DRAWN - CAM	REVISED -
PLOT SCALE = 100.0000' / in.	CHECKED - PTJ	REVISED -
PLOT DATE = 8/14/2019	DATE - 8/16/2019	REVISED -

**STATE OF ILLINOIS
DEPARTMENT OF TRANSPORTATION**


**EXISTING ITS PLAN
I-90/94**

SCALE: 1"=50' SHEET 4 OF 11 SHEETS STA. 6148+50 TO STA.

F.A.I. RTE.	SECTION	COUNTY	TOTAL SHEETS	SHEET NO.
90/94/290	2019-054-I	COOK	400	218
CONTRACT NO. 62J31				
ILLINOIS FED. AID PROJECT				

NOTES:

1. MAINTAIN THE EXISTING IDOT ITS ITEMS THAT WILL BE AFFECTED BY THE CONSTRUCTION WORK UNTIL THE NEW INFRASTRUCTURE AND CABLES ARE INSTALLED IN THE LOCATIONS INDICATED IN THE PROPOSED PLAN SHEET. THIS ITS MAINTENANCE WORK SHALL BE INCLUDED IN THE COST OF THE "MAINTAINING ITS DURING CONSTRUCTION" PAY ITEM.
2. THE LOCATIONS OF THE WOOD POLES AND HANDHOLES SHOWN ON THE PLANS ARE APPROXIMATIONS. THE FINAL INSTALLATION LOCATIONS OF THE POLES SHALL BE STAKED IN THE FIELD AND APPROVED BY THE ENGINEER PRIOR TO INSTALLATION TO IDENTIFY ANY CONFLICTS WITH EXISTING/PROPOSED UTILITIES AND WORK PERFORMED BY OTHER DISCIPLINES.
3. SPLICE NEW FIBER OPTIC CABLE, 96 FIBERS TO EXISTING CABLE IN THE HANDHOLE. CONTACT IDOT BUREAU OF TRAFFIC OPERATIONS/ELECTRICAL FIELD OFFICE TO CONFIRM PROPOSED FIBER OPTIC ASSIGNMENTS.
4. CONNECT NEW NO. 19 6 PAIR COPPER COMMUNICATION CABLE TO THE EXISTING CABINET TERMINAL BLOCK AND SPLICE TO THE NO. 19 25 PAIR CABLES IN THE JUNCTION BOX ATTACHED TO THE TEMPORARY WOOD POLE. CONTACT IDOT BUREAU OF TRAFFIC OPERATIONS/ELECTRICAL FIELD OFFICE TO CONFIRM PROPOSED COPPER WIRE ASSIGNMENTS. THE COST FOR THIS WORK IS INCLUDED IN THE ELECTRICAL CABLE PAY ITEM.
5. TEMPORARY WOOD POLES AND CABLES TO REMAIN BEYOND THIS CONTRACT.
6. INSTALL 50 FEET OF SLACK OF ALL CABLES ON EACH WOOD POLE.
7. REMOVE EXISTING COMMUNICATION CABLE AND INSTALL NEW 96 SMF CABLE IN ITS PLACE.
8. REMOVE EXISTING COMMUNICATION CABLE AND INSTALL TWO NEW NO. 19 25-PAIR CABLES IN ITS PLACE.
9. SPLICE PROPOSED NO. 19 25-PAIR CABLES TO THE EXISTING NO. 19 50-PAIR CABLE IN THE JUNCTION BOX EMBEDDED IN THE MEDIAN BARRIER WALL. CONTACT IDOT BUREAU OF TRAFFIC OPERATIONS/ELECTRICAL FIELD OFFICE TO CONFIRM PROPOSED COPPER WIRE ASSIGNMENTS. THE COST FOR THIS WORK IS INCLUDED IN THE ELECTRICAL CABLE PAY ITEM.

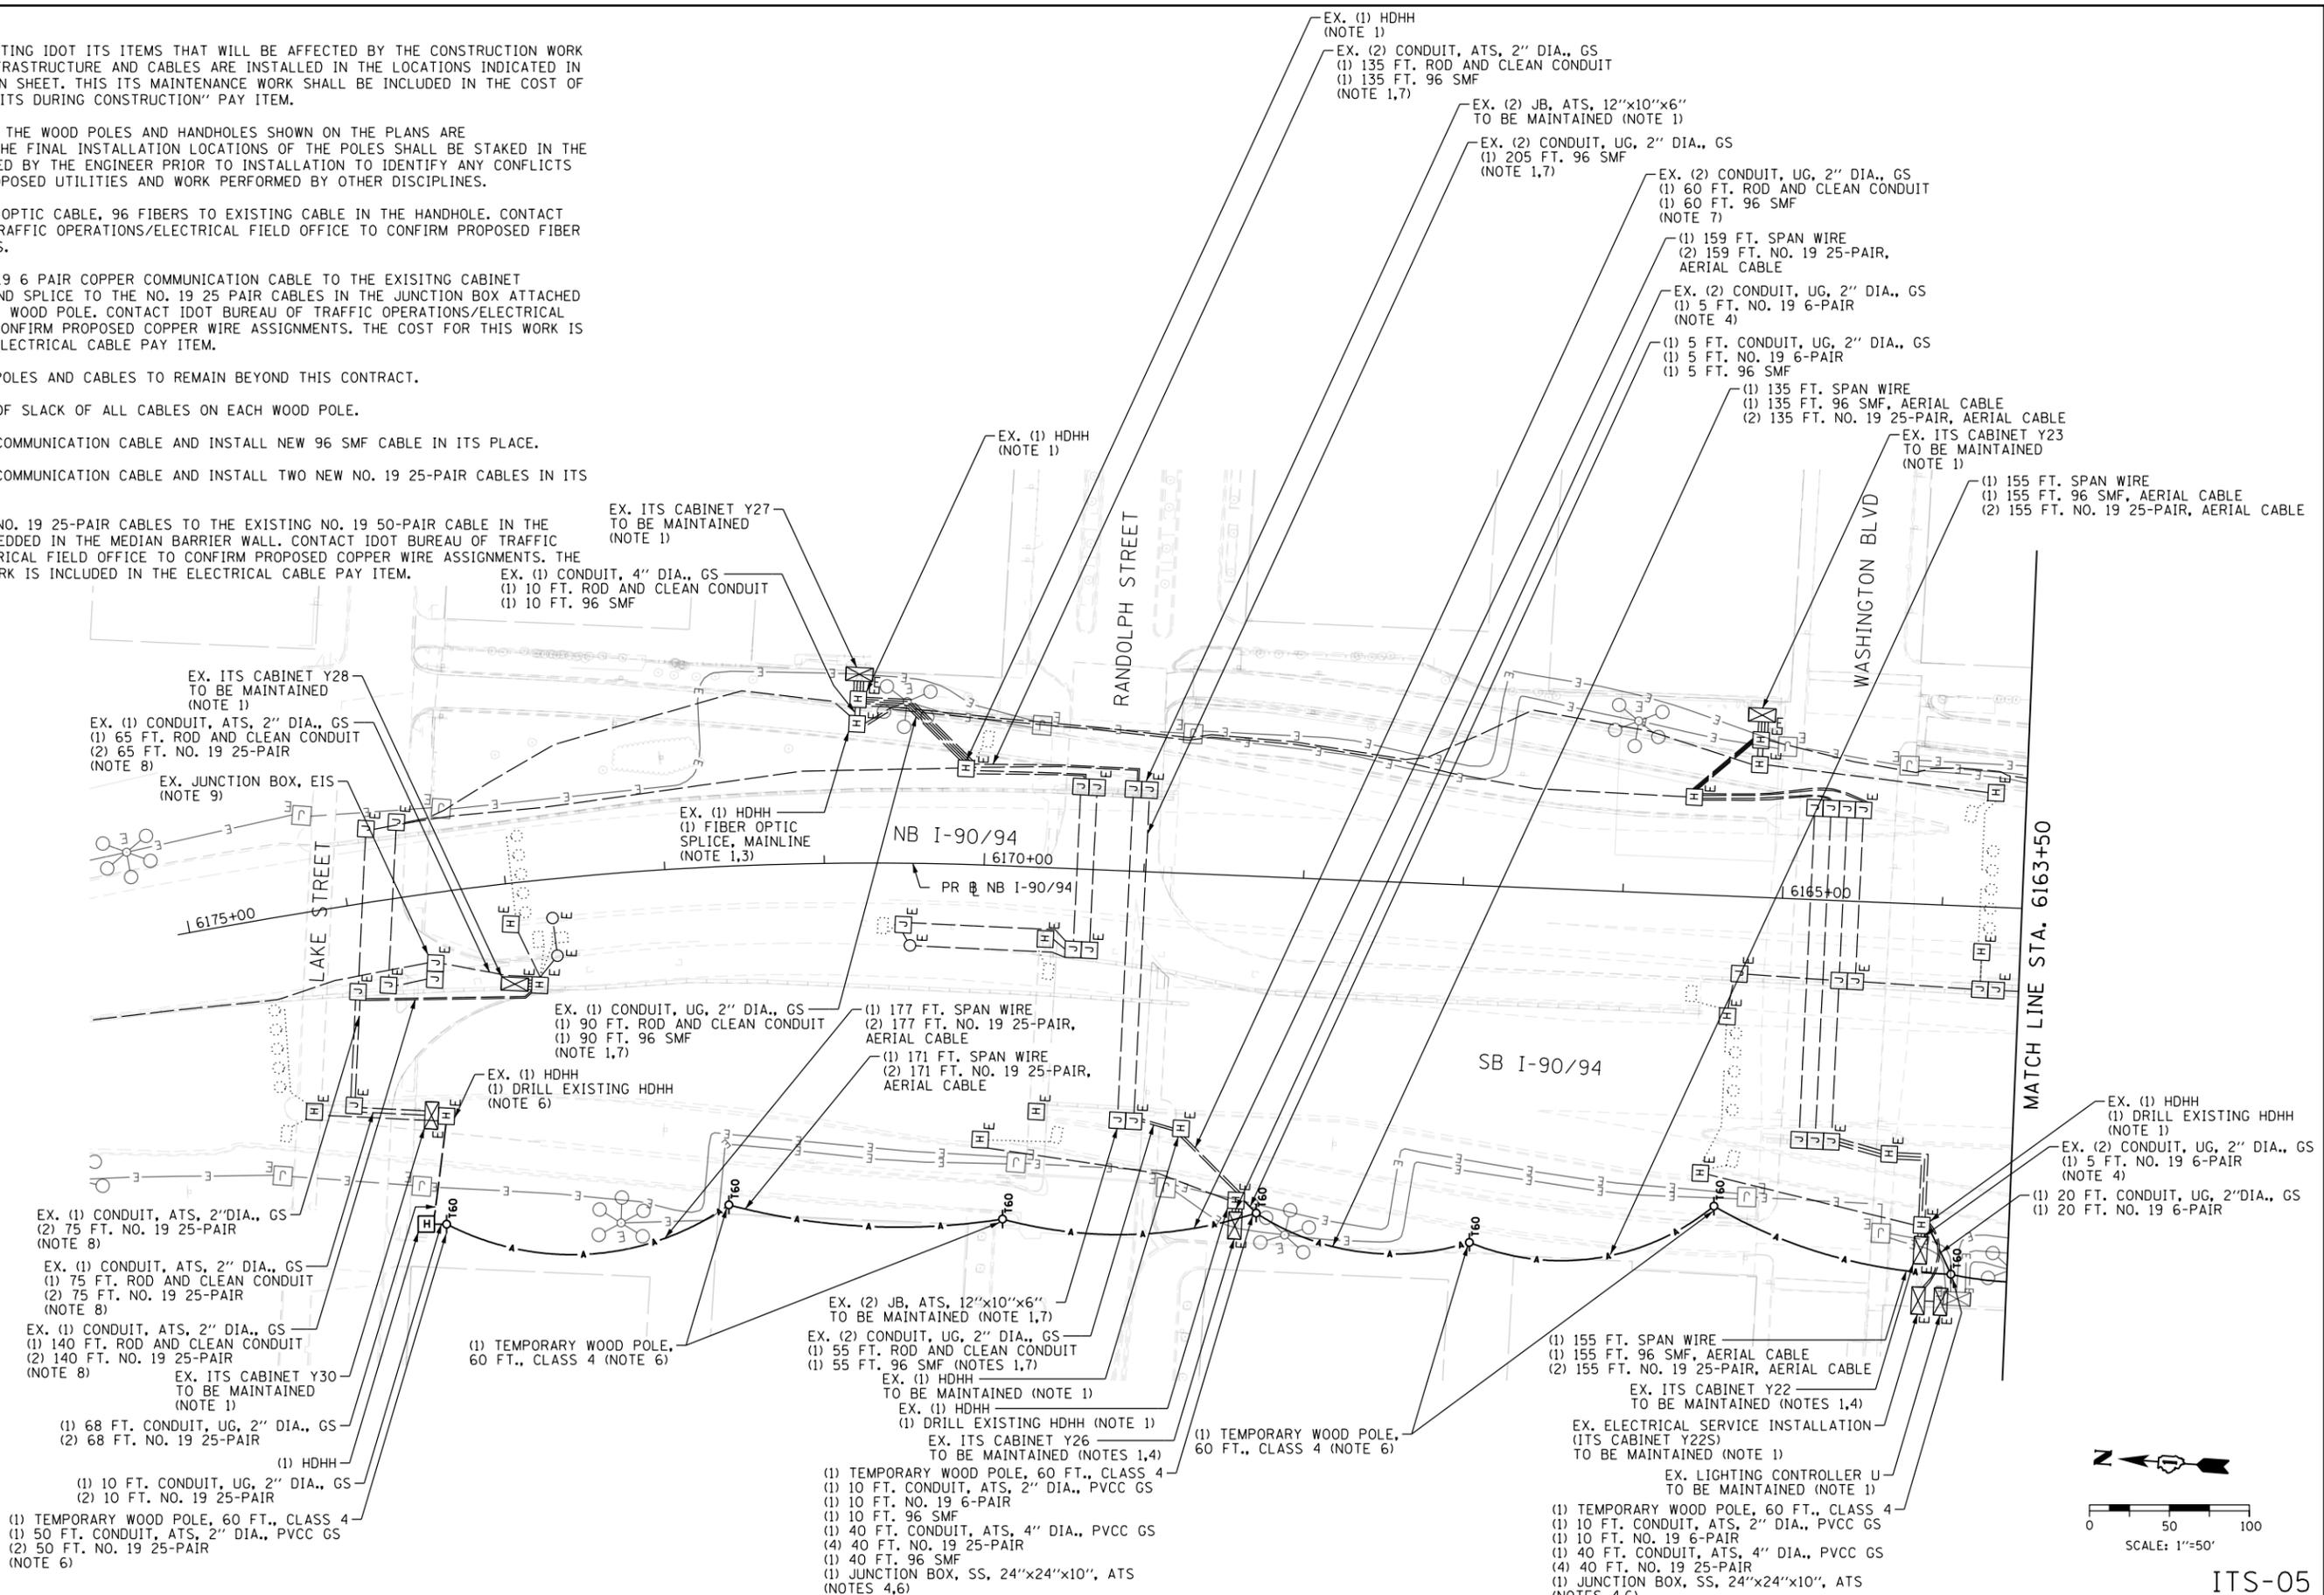

FILE PATH = p:\V\AECOM\NA\NSI\encom\line\local\AECOM_0502_NA\Documents\01_Americas\Transportation\60269938_Circle Phase 1\000_CAD\046_Roadway_Sheets\62J31_Contract\0162J31-SHT-ITS-05



D162J31-SHT-ITS-05
USER NAME = myersc
PLOT SCALE = 100.0000' / in.
PLOT DATE = 8/14/2019

DESIGNED - MJL	REVISED -
DRAWN - CAM	REVISED -
CHECKED - PTJ	REVISED -
DATE - 8/16/2019	REVISED -

**STATE OF ILLINOIS
DEPARTMENT OF TRANSPORTATION**


PROPOSED ITS PLAN - STAGE 1	
I-90/94	
SCALE: 1"=50'	SHEET 5 OF 11 SHEETS STA. TO STA. 6163+50

F.A.I. RTE. 90/94/290	SECTION 2019-054-I	COUNTY COOK	TOTAL SHEETS 400	SHEET NO. 219
CONTRACT NO. 62J31				
ILLINOIS FED. AID PROJECT				

ITS-05

NOTES:

1. MAINTAIN THE EXISTING IDOT ITS ITEMS THAT WILL BE AFFECTED BY THE CONSTRUCTION WORK UNTIL THE NEW INFRASTRUCTURE AND CABLES ARE INSTALLED IN THE LOCATIONS INDICATED IN THE PROPOSED PLAN SHEET. THIS ITS MAINTENANCE WORK SHALL BE INCLUDED IN THE COST OF THE "MAINTAINING ITS DURING CONSTRUCTION" PAY ITEM.
2. THE LOCATIONS OF THE WOOD POLES SHOWN ON THE PLANS ARE APPROXIMATIONS. THE FINAL INSTALLATION LOCATIONS OF THE POLES SHALL BE STAKED IN THE FIELD AND APPROVED BY THE ENGINEER PRIOR TO INSTALLATION TO IDENTIFY ANY CONFLICTS WITH EXISTING/PROPOSED UTILITIES AND WORK PERFORMED BY OTHER DISCIPLINES.
3. CONNECT NEW NO. 19 6 PAIR COPPER COMMUNICATION CABLE TO THE EXISTING CABINET TERMINAL BLOCK AND SPLICE TO THE NO. 19 25 PAIR CABLES IN THE JUNCTION BOX ATTACHED TO THE TEMPORARY WOOD POLE. CONTACT IDOT BUREAU OF TRAFFIC OPERATIONS/ELECTRICAL FIELD OFFICE TO CONFIRM PROPOSED COPPER WIRE ASSIGNMENTS. THE COST FOR THIS WORK IS INCLUDED IN THE ELECTRICAL CABLE PAY ITEM.
4. TEMPORARY WOOD POLES AND CABLES TO REMAIN BEYOND THIS CONTRACT.
5. INSTALL 50 FEET OF SLACK OF ALL CABLES ON EACH WOOD POLE.

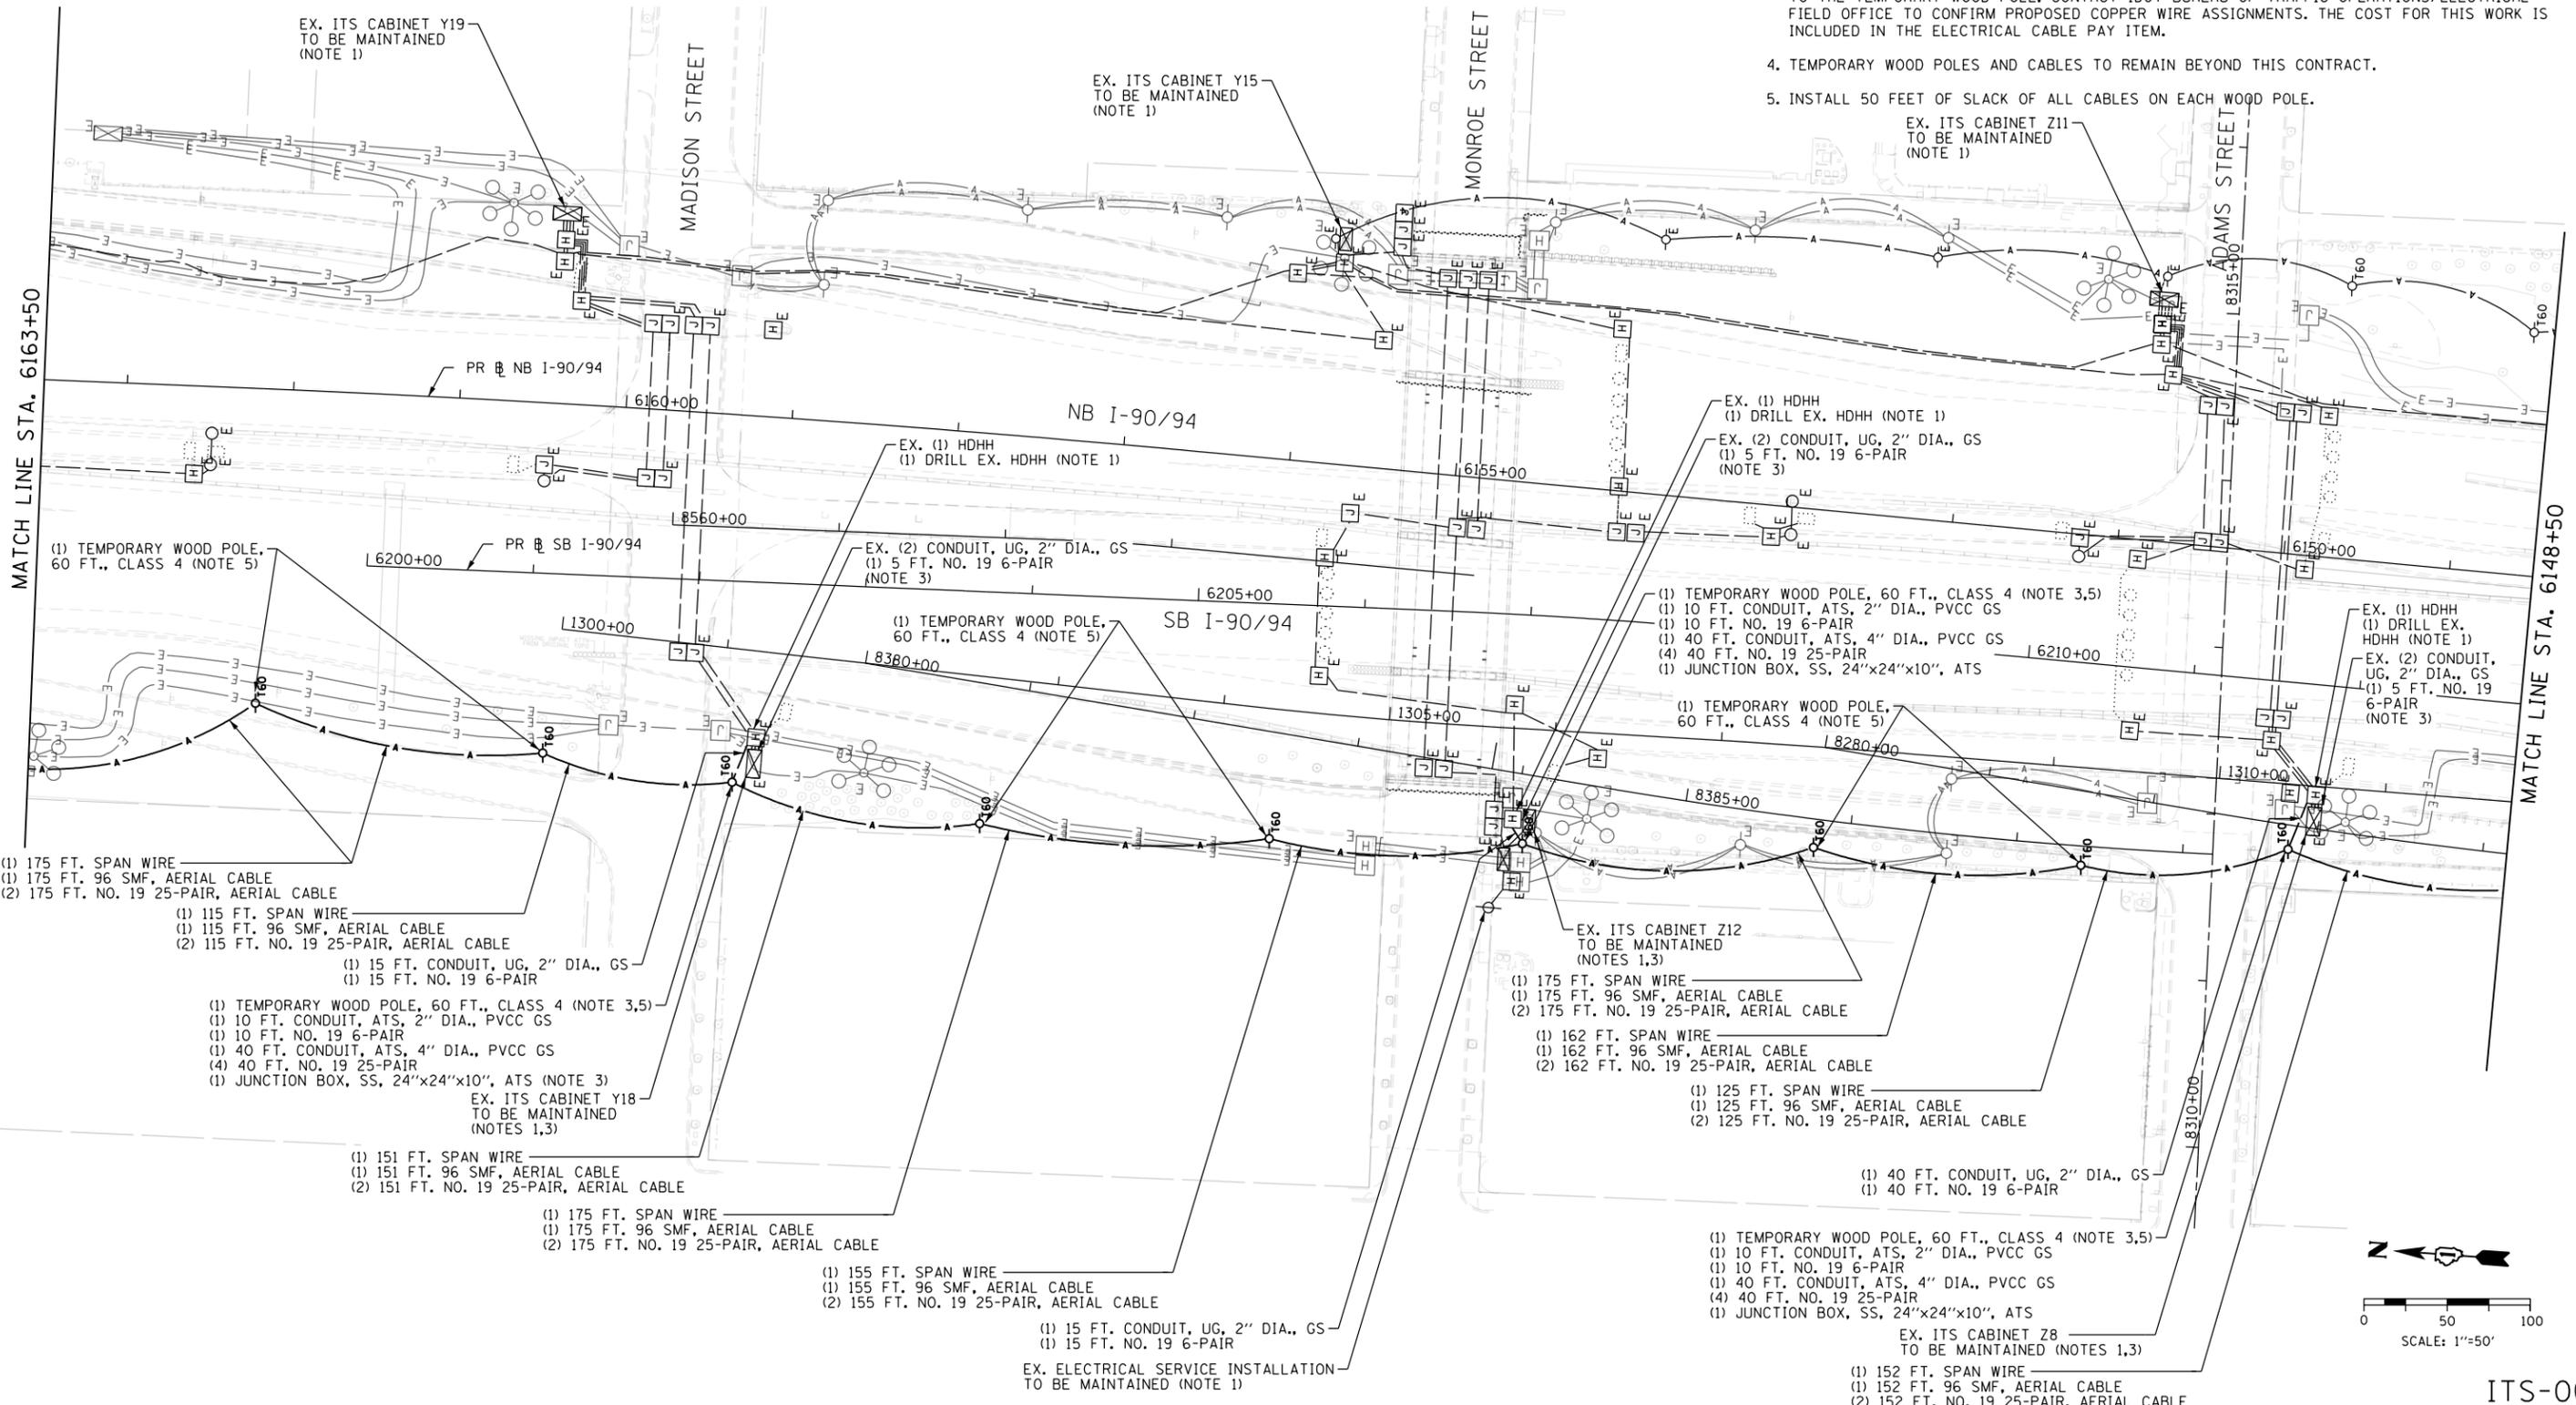


FILE PATH = p:\naecom\na-ansi\encom\line\local\i\ecom_0502_n\Documents\01_Americas\Transportation\60269938_Circle Phase II\000_CAD\046_Roadway\Sheets\62J31_Contract\162J31-SHT-ITS-06

- (1) 175 FT. SPAN WIRE
- (1) 175 FT. 96 SMF, AERIAL CABLE
- (2) 175 FT. NO. 19 25-PAIR, AERIAL CABLE
- (1) 115 FT. SPAN WIRE
- (1) 115 FT. 96 SMF, AERIAL CABLE
- (2) 115 FT. NO. 19 25-PAIR, AERIAL CABLE
- (1) 15 FT. CONDUIT, UG, 2" DIA., GS
- (1) 15 FT. NO. 19 6-PAIR
- (1) TEMPORARY WOOD POLE, 60 FT., CLASS 4 (NOTE 3,5)
- (1) 10 FT. CONDUIT, ATS, 2" DIA., PVCC GS
- (1) 10 FT. NO. 19 6-PAIR
- (1) 40 FT. CONDUIT, ATS, 4" DIA., PVCC GS
- (4) 40 FT. NO. 19 25-PAIR
- (1) JUNCTION BOX, SS, 24"x24"x10", ATS (NOTE 3)
- EX. ITS CABINET Y18 TO BE MAINTAINED (NOTES 1,3)
- (1) 151 FT. SPAN WIRE
- (1) 151 FT. 96 SMF, AERIAL CABLE
- (2) 151 FT. NO. 19 25-PAIR, AERIAL CABLE

- (1) 175 FT. SPAN WIRE
- (1) 175 FT. 96 SMF, AERIAL CABLE
- (2) 175 FT. NO. 19 25-PAIR, AERIAL CABLE
- (1) 155 FT. SPAN WIRE
- (1) 155 FT. 96 SMF, AERIAL CABLE
- (2) 155 FT. NO. 19 25-PAIR, AERIAL CABLE
- (1) 15 FT. CONDUIT, UG, 2" DIA., GS
- (1) 15 FT. NO. 19 6-PAIR
- EX. ELECTRICAL SERVICE INSTALLATION TO BE MAINTAINED (NOTE 1)

- EX. ITS CABINET Z12 TO BE MAINTAINED (NOTES 1,3)
- (1) 175 FT. SPAN WIRE
- (1) 175 FT. 96 SMF, AERIAL CABLE
- (2) 175 FT. NO. 19 25-PAIR, AERIAL CABLE
- (1) 162 FT. SPAN WIRE
- (1) 162 FT. 96 SMF, AERIAL CABLE
- (2) 162 FT. NO. 19 25-PAIR, AERIAL CABLE
- (1) 125 FT. SPAN WIRE
- (1) 125 FT. 96 SMF, AERIAL CABLE
- (2) 125 FT. NO. 19 25-PAIR, AERIAL CABLE

- (1) 40 FT. CONDUIT, UG, 2" DIA., GS
- (1) 40 FT. NO. 19 6-PAIR
- (1) TEMPORARY WOOD POLE, 60 FT., CLASS 4 (NOTE 3,5)
- (1) 10 FT. CONDUIT, ATS, 2" DIA., PVCC GS
- (1) 10 FT. NO. 19 6-PAIR
- (1) 40 FT. CONDUIT, ATS, 4" DIA., PVCC GS
- (4) 40 FT. NO. 19 25-PAIR
- (1) JUNCTION BOX, SS, 24"x24"x10", ATS
- EX. ITS CABINET Z8 TO BE MAINTAINED (NOTES 1,3)
- (1) 152 FT. SPAN WIRE
- (1) 152 FT. 96 SMF, AERIAL CABLE
- (2) 152 FT. NO. 19 25-PAIR, AERIAL CABLE

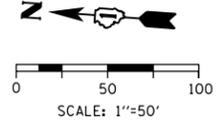

ITS-06



D162J31-SHT-ITS-06	DESIGNED - MJL	REVISED -
USER NAME = myersc	DRAWN - CAM	REVISED -
PLOT SCALE = 100.0000' / in.	CHECKED - PTJ	REVISED -
PLOT DATE = 8/14/2019	DATE - 8/16/2019	REVISED -



**STATE OF ILLINOIS
DEPARTMENT OF TRANSPORTATION**

PROPOSED ITS PLAN - STAGE 1		
I-90/94		
SCALE: 1"=50'	SHEET 6 OF 11 SHEETS	STA. 6163+50 TO STA. 6148+50

F.A.I. RTE.	SECTION	COUNTY	TOTAL SHEETS	SHEET NO.
90/94/290	2019-054-I	COOK	400	220
CONTRACT NO. 62J31				
ILLINOIS FED. AID PROJECT				

NOTES:

1. MAINTAIN THE EXISTING IDOT ITS ITEMS THAT WILL BE AFFECTED BY THE CONSTRUCTION WORK UNTIL THE NEW INFRASTRUCTURE AND CABLES ARE INSTALLED IN THE LOCATIONS INDICATED IN THE PROPOSED PLAN SHEET. THIS ITS MAINTENANCE WORK SHALL BE INCLUDED IN THE COST OF THE "MAINTAINING ITS DURING CONSTRUCTION" PAY ITEM.
2. THE LOCATIONS OF THE WOOD POLES SHOWN ON THE PLANS ARE APPROXIMATIONS. THE FINAL INSTALLATION LOCATIONS OF THE POLES SHALL BE STAKED IN THE FIELD AND APPROVED BY THE ENGINEER PRIOR TO INSTALLATION TO IDENTIFY ANY CONFLICTS WITH EXISTING/PROPOSED UTILITIES AND WORK PERFORMED BY OTHER DISCIPLINES.
3. SPLICE NEW FIBER OPTIC CABLE, 96 FIBERS AND NEW 25-PAIR CABLES TO EXISTING CABLES IN THE JUNCTION BOX ATTACHED TO THE TEMPORARY WOOD POLE. CONTACT IDOT BUREAU OF TRAFFIC OPERATIONS/ELECTRICAL FIELD OFFICE TO CONFIRM PROPOSED FIBER OPTIC ASSIGNMENTS.
4. TEMPORARY WOOD POLES AND CABLES TO REMAIN BEYOND THIS CONTRACT.
5. INSTALL 50 FEET OF SLACK OF ALL CABLES ON EACH WOOD POLE.
6. SPLICE PROPOSED NO. 19 25-PAIR CABLES TO THE EXISTING NO. 19 50-PAIR CABLE IN THE JUNCTION BOX ATTACHED TO THE TEMPORARY WOOD POLE. CONTACT IDOT BUREAU OF TRAFFIC OPERATIONS/ELECTRICAL FIELD OFFICE TO CONFIRM PROPOSED COPPER WIRE ASSIGNMENTS. THE COST FOR THIS WORK IS INCLUDED IN THE ELECTRICAL CABLE PAY ITEM.
7. A MINIMUM OF 2 POLES WILL BE RELOCATED AFTER INSTALLATION SUBJECT TO RIGHT OF WAY EASEMENT ACQUISITION.

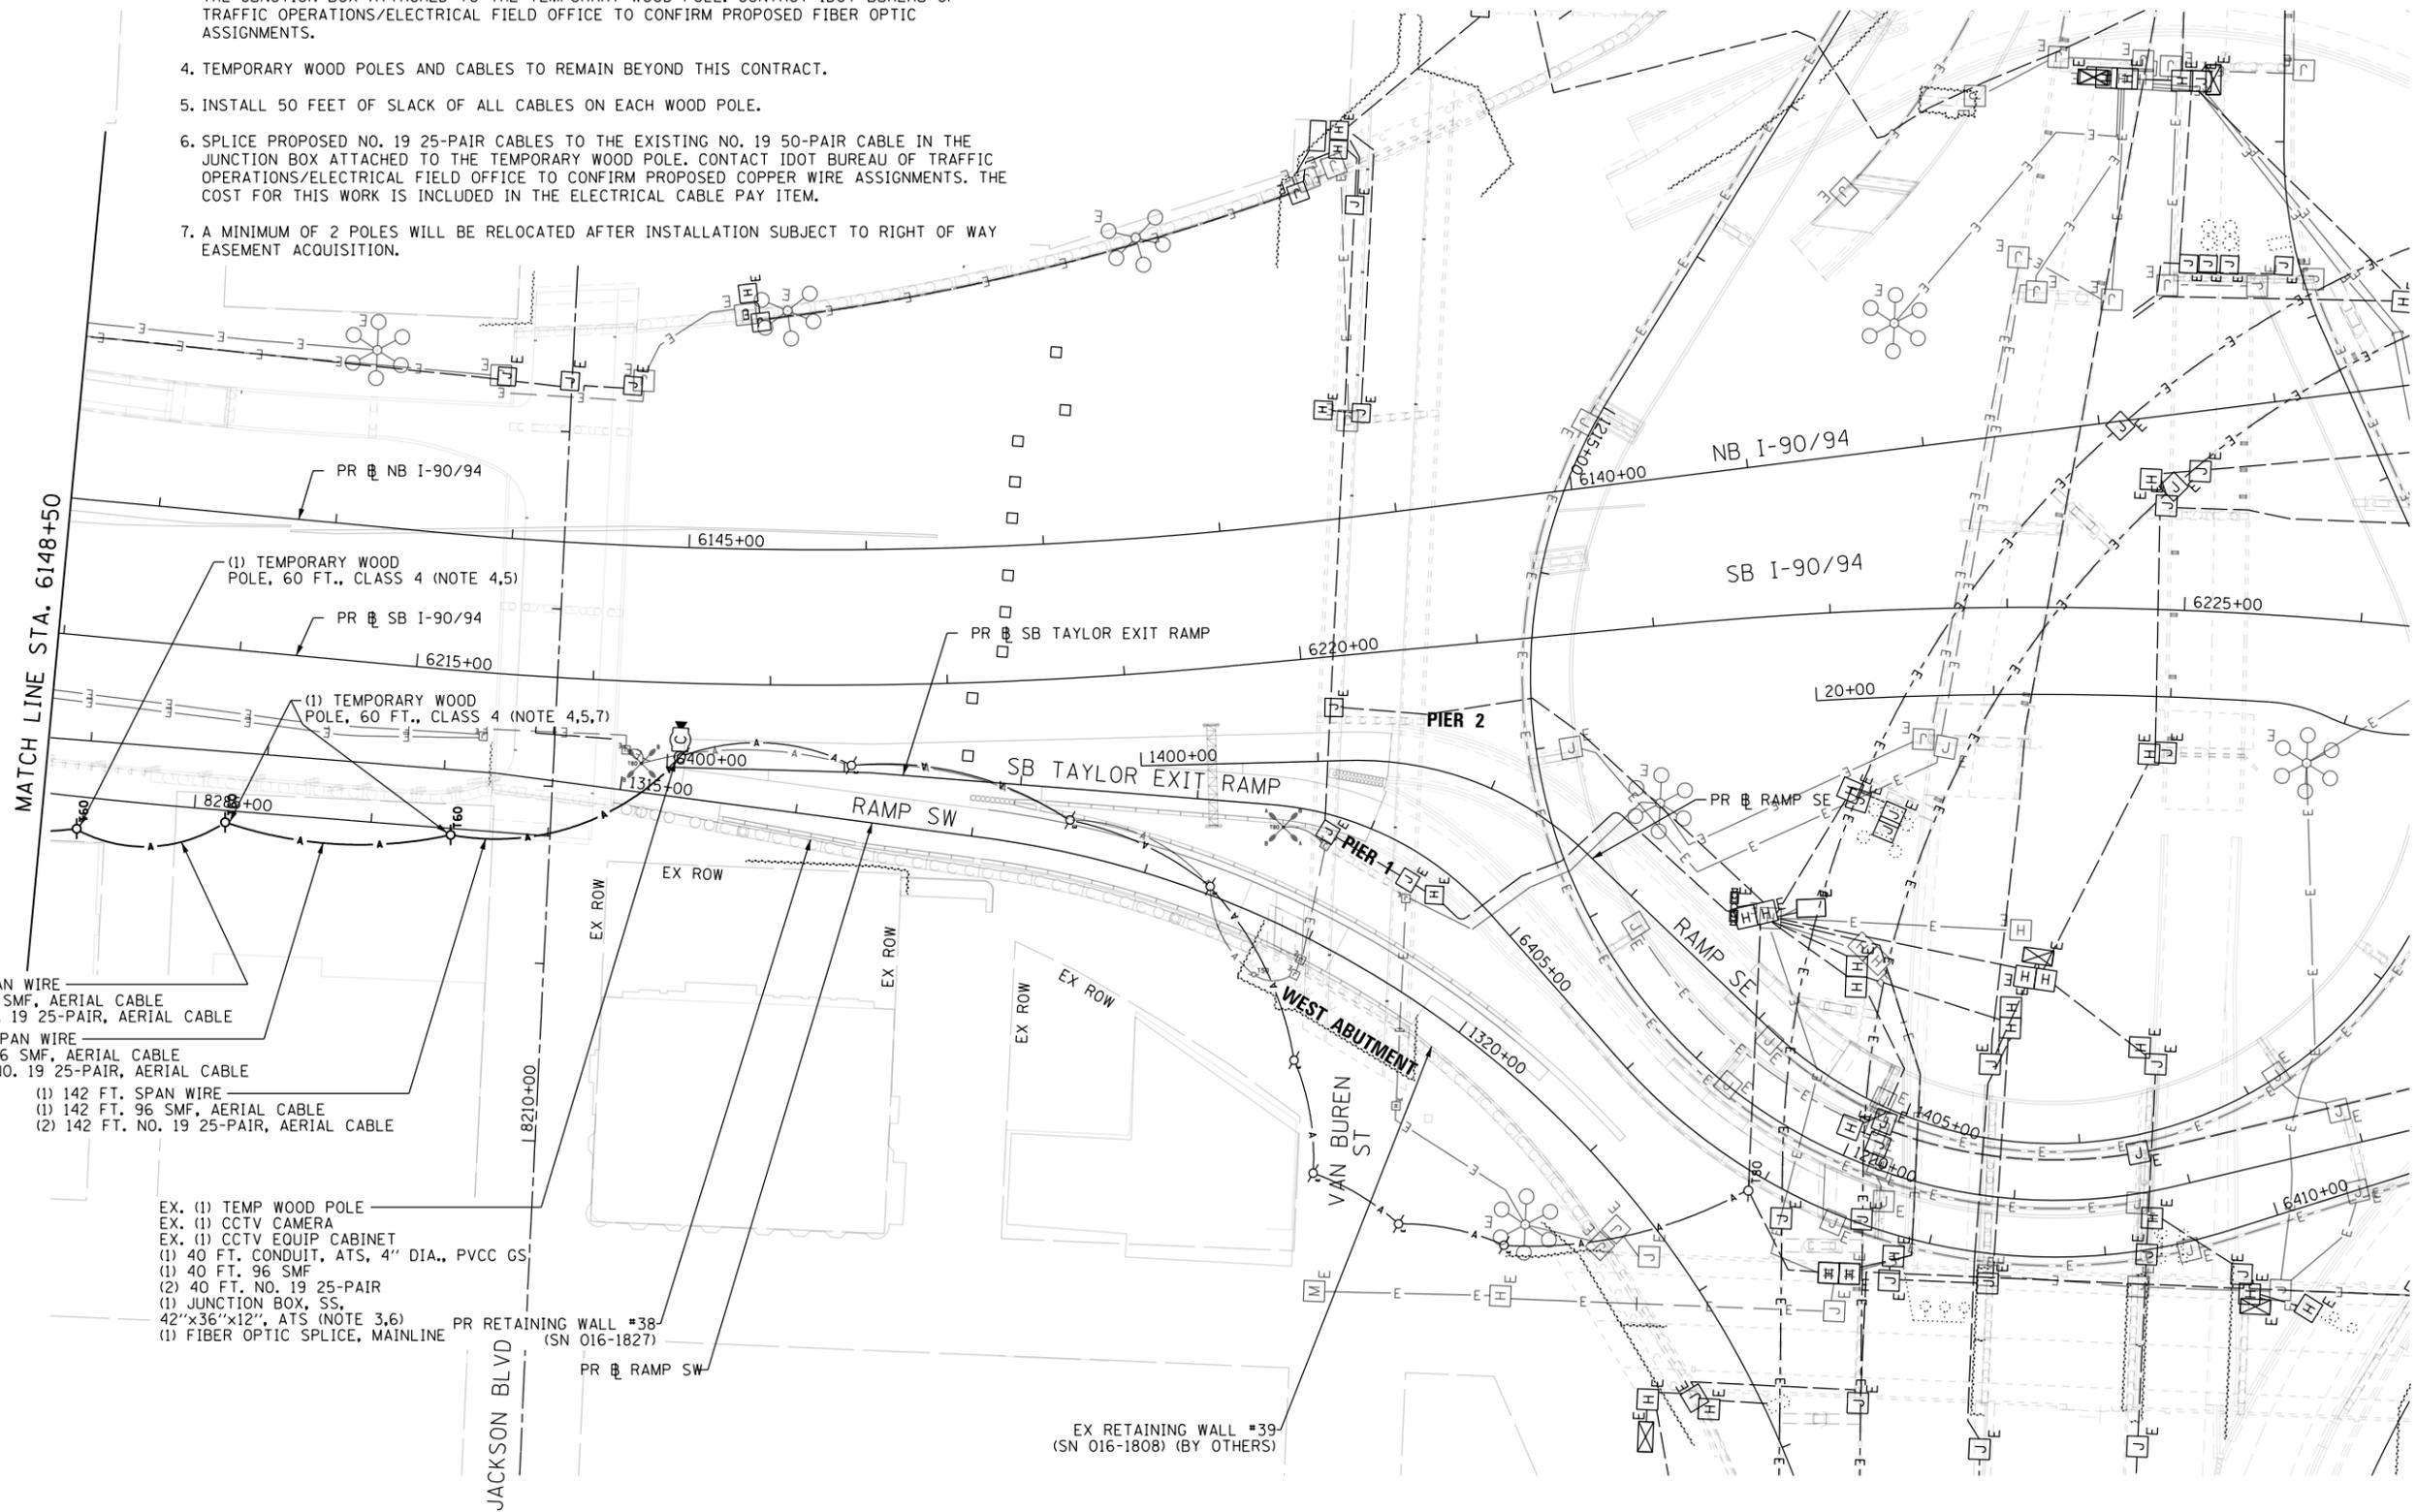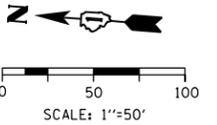

- (1) 85 FT. SPAN WIRE
- (1) 85 FT. 96 SMF, AERIAL CABLE
- (2) 85 FT. NO. 19 25-PAIR, AERIAL CABLE
- (1) 128 FT. SPAN WIRE
- (1) 128 FT. 96 SMF, AERIAL CABLE
- (2) 128 FT. NO. 19 25-PAIR, AERIAL CABLE
- (1) 142 FT. SPAN WIRE
- (1) 142 FT. 96 SMF, AERIAL CABLE
- (2) 142 FT. NO. 19 25-PAIR, AERIAL CABLE

- EX. (1) TEMP WOOD POLE
- EX. (1) CCTV CAMERA
- EX. (1) CCTV EQUIP CABINET
- (1) 40 FT. CONDUIT, ATS, 4" DIA., PVCC GS
- (1) 40 FT. 96 SMF
- (2) 40 FT. NO. 19 25-PAIR
- (1) JUNCTION BOX, SS, 42"x36"x12", ATS (NOTE 3,6)
- (1) FIBER OPTIC SPLICE, MAINLINE

FILE PATH = p:\a\ecdm\m-n\m\l\ecdm\l\local\ecdm\0502_MN\Documents\01_Americas\Transportation\60269938_Circle Phase II\000_CAD\006_Roadway\Sheets\62J31_Contract\162J31-SHT-ITS-07



D162J31-SHT-ITS-07
 USER NAME = myersc
 PLOT SCALE = 100.0000' / in.
 PLOT DATE = 8/14/2019

DESIGNED - MJL
 DRAWN - CAM
 CHECKED - PTJ
 DATE - 8/16/2019

REVISED -
 REVISED -
 REVISED -
 REVISED -

**STATE OF ILLINOIS
 DEPARTMENT OF TRANSPORTATION**


**PROPOSED ITS PLAN - STAGE 1
 I-90/94**

SCALE: 1"=50' SHEET 7 OF 11 SHEETS STA. 6148+50 TO STA.

F.A.I. RTE.	SECTION	COUNTY	TOTAL SHEETS	SHEET NO.
90/94/290	2019-054-I	COOK	400	221
CONTRACT NO. 62J31				
ILLINOIS FED. AID PROJECT				

ITS-07

FILE PATH = p:\VACOM\NA\NSI\encom\line\local\AECOM_DS02_NA\Documents\01_Americas\Transportation\60269938_Circle Phase II\000_CAD\006_Roadway\Sheets\62J31_Contract\162J31-SHT-ITS-08

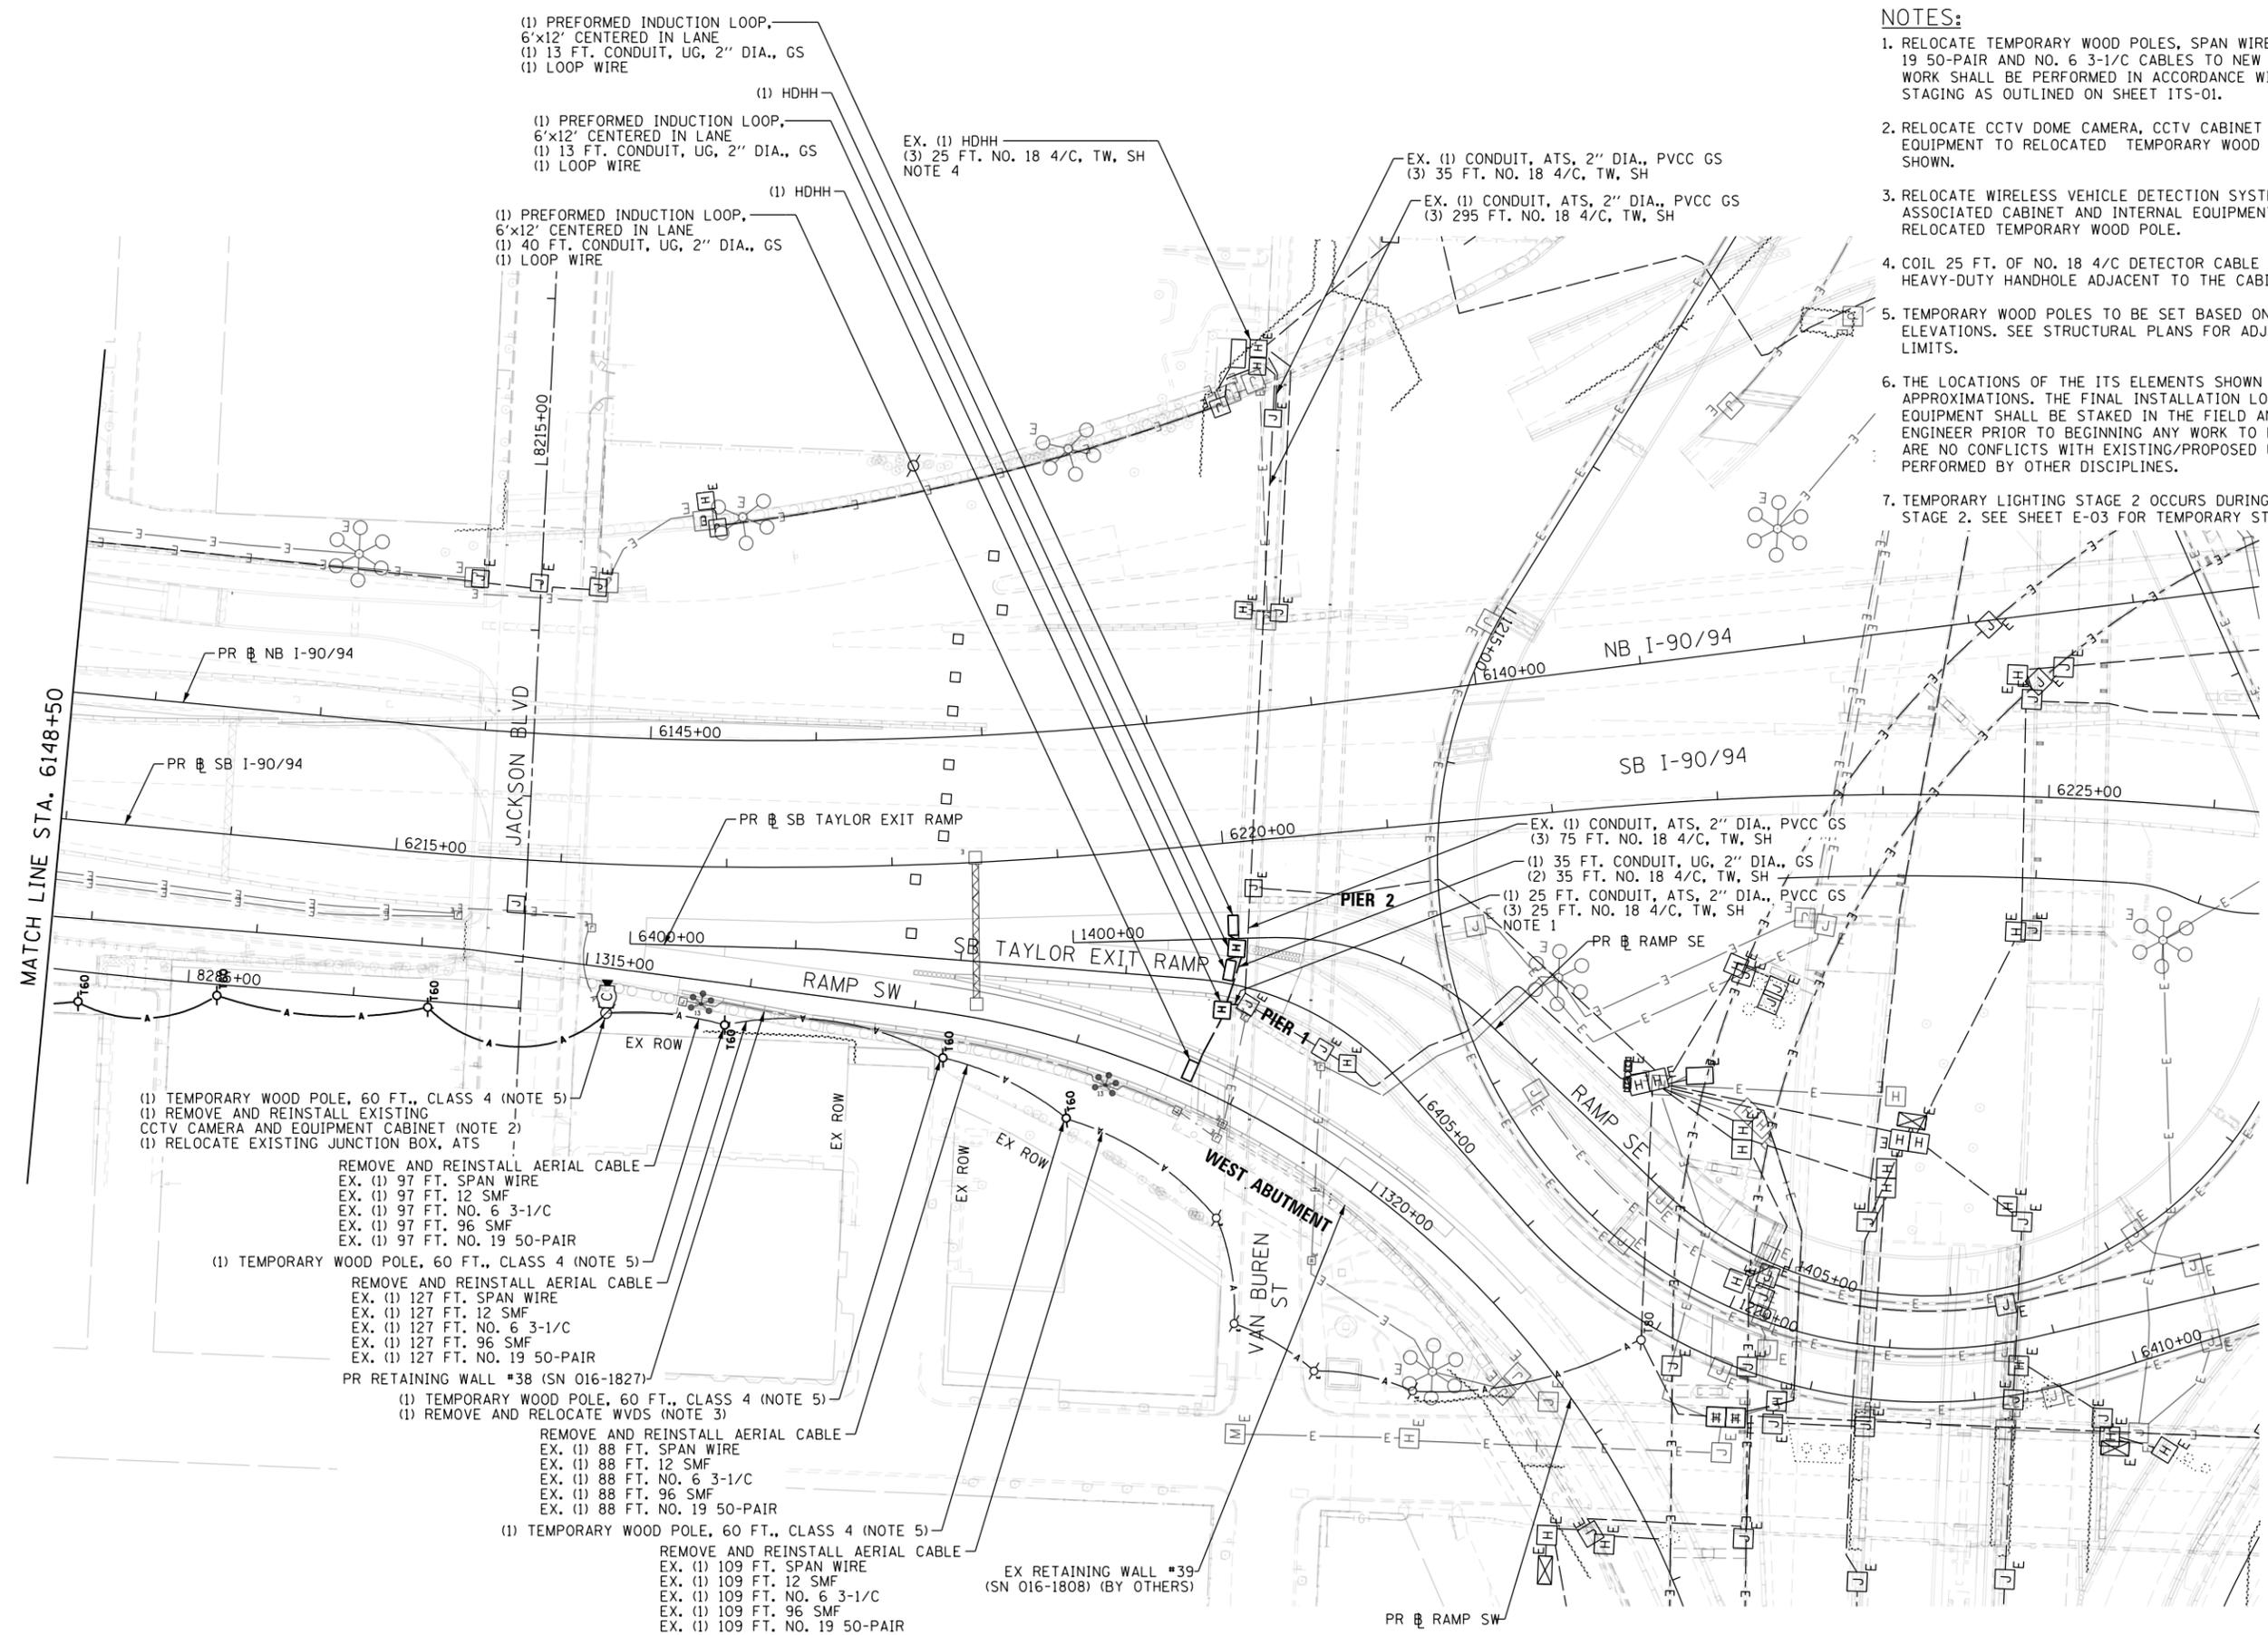

- NOTES:**
1. RELOCATE TEMPORARY WOOD POLES, SPAN WIRE, 12 SMF, 96 SMF, NO. 19 50-PAIR AND NO. 6 3-1/C CABLES TO NEW ROUTE AS SHOWN. THIS WORK SHALL BE PERFORMED IN ACCORDANCE WITH THE SEQUENCE AND STAGING AS OUTLINED ON SHEET ITS-01.
 2. RELOCATE CCTV DOME CAMERA, CCTV CABINET AND INTERNAL EQUIPMENT TO RELOCATED TEMPORARY WOOD POLE POSITION AS SHOWN.
 3. RELOCATE WIRELESS VEHICLE DETECTION SYSTEM ACCESS POINT AND ASSOCIATED CABINET AND INTERNAL EQUIPMENT TO NEAREST RELOCATED TEMPORARY WOOD POLE.
 4. COIL 25 FT. OF NO. 18 4/C DETECTOR CABLE SLACK IN THE HEAVY-DUTY HANDHOLE ADJACENT TO THE CABINET FOUNDATION.
 5. TEMPORARY WOOD POLES TO BE SET BASED ON INTERIM GRADING ELEVATIONS. SEE STRUCTURAL PLANS FOR ADJACENT EXCAVATION LIMITS.
 6. THE LOCATIONS OF THE ITS ELEMENTS SHOWN ON THE PLAN ARE APPROXIMATIONS. THE FINAL INSTALLATION LOCATIONS OF THE ITS EQUIPMENT SHALL BE STAKED IN THE FIELD AND APPROVED BY THE ENGINEER PRIOR TO BEGINNING ANY WORK TO ENSURE THAT THERE ARE NO CONFLICTS WITH EXISTING/PROPOSED UTILITIES AND WORK PERFORMED BY OTHER DISCIPLINES.
 7. TEMPORARY LIGHTING STAGE 2 OCCURS DURING THE PROPOSED ITS STAGE 2. SEE SHEET E-03 FOR TEMPORARY STAGE 2 LIGHTING PLANS.

(1) PREFORMED INDUCTION LOOP, 6'x12' CENTERED IN LANE
(1) 13 FT. CONDUIT, UG, 2" DIA., GS
(1) LOOP WIRE

(1) HDHH

EX. (1) HDHH
(3) 25 FT. NO. 18 4/C, TW, SH
NOTE 4

(1) PREFORMED INDUCTION LOOP, 6'x12' CENTERED IN LANE
(1) 13 FT. CONDUIT, UG, 2" DIA., GS
(1) LOOP WIRE

(1) HDHH

(1) PREFORMED INDUCTION LOOP, 6'x12' CENTERED IN LANE
(1) 40 FT. CONDUIT, UG, 2" DIA., GS
(1) LOOP WIRE

(1) HDHH

EX. (1) CONDUIT, ATS, 2" DIA., PVCC GS
(3) 35 FT. NO. 18 4/C, TW, SH

EX. (1) CONDUIT, ATS, 2" DIA., PVCC GS
(3) 295 FT. NO. 18 4/C, TW, SH

EX. (1) CONDUIT, ATS, 2" DIA., PVCC GS
(3) 75 FT. NO. 18 4/C, TW, SH
(1) 35 FT. CONDUIT, UG, 2" DIA., GS
(2) 35 FT. NO. 18 4/C, TW, SH
(1) 25 FT. CONDUIT, ATS, 2" DIA., PVCC GS
(3) 25 FT. NO. 18 4/C, TW, SH
NOTE 1

(1) TEMPORARY WOOD POLE, 60 FT., CLASS 4 (NOTE 5)
(1) REMOVE AND REINSTALL EXISTING CCTV CAMERA AND EQUIPMENT CABINET (NOTE 2)
(1) RELOCATE EXISTING JUNCTION BOX, ATS

REMOVE AND REINSTALL AERIAL CABLE
EX. (1) 97 FT. SPAN WIRE
EX. (1) 97 FT. 12 SMF
EX. (1) 97 FT. NO. 6 3-1/C
EX. (1) 97 FT. 96 SMF
EX. (1) 97 FT. NO. 19 50-PAIR

(1) TEMPORARY WOOD POLE, 60 FT., CLASS 4 (NOTE 5)
REMOVE AND REINSTALL AERIAL CABLE
EX. (1) 127 FT. SPAN WIRE
EX. (1) 127 FT. 12 SMF
EX. (1) 127 FT. NO. 6 3-1/C
EX. (1) 127 FT. 96 SMF
EX. (1) 127 FT. NO. 19 50-PAIR

PR RETAINING WALL #38 (SN 016-1827)
(1) TEMPORARY WOOD POLE, 60 FT., CLASS 4 (NOTE 5)
(1) REMOVE AND RELOCATE WVDS (NOTE 3)

REMOVE AND REINSTALL AERIAL CABLE
EX. (1) 88 FT. SPAN WIRE
EX. (1) 88 FT. 12 SMF
EX. (1) 88 FT. NO. 6 3-1/C
EX. (1) 88 FT. 96 SMF
EX. (1) 88 FT. NO. 19 50-PAIR

(1) TEMPORARY WOOD POLE, 60 FT., CLASS 4 (NOTE 5)
REMOVE AND REINSTALL AERIAL CABLE
EX. (1) 109 FT. SPAN WIRE
EX. (1) 109 FT. 12 SMF
EX. (1) 109 FT. NO. 6 3-1/C
EX. (1) 109 FT. 96 SMF
EX. (1) 109 FT. NO. 19 50-PAIR

EX RETAINING WALL #39 (SN 016-1808) (BY OTHERS)



D162J31-SHT-ITS-08
USER NAME = myersc
PLOT SCALE = 100.0000' / in.
PLOT DATE = 8/14/2019

DESIGNED - MJL	REVISED -
DRAWN - CAM	REVISED -
CHECKED - PTJ	REVISED -
DATE - 8/16/2019	REVISED -

**STATE OF ILLINOIS
DEPARTMENT OF TRANSPORTATION**

**PROPOSED ITS PLAN - STAGE 2
I-90/94**

SCALE: 1"=50' SHEET 8 OF 11 SHEETS STA. 6148+50 TO STA.


F.A.I. RTE. 90/94/290	SECTION 2019-054-I	COUNTY COOK	TOTAL SHEETS 400	SHEET NO. 222
CONTRACT NO. 62J31				ILLINOIS FED. AID PROJECT

ITS-08

FILE PATH = p:\AECOM\NA-AWS\ecommon\local\AECOM_DS02_NA\Documents\01_Americas\Transportation\60269938_Circle\Phase_1\000_CAD\006_Roadway_Sheets\62J31_Contract\0162J31_sht-ITS-09


EXISTING COMMUNICATIONS CABLE ROUTING

THIS DRAWING IS DIAGRAMMATICAL AND FOR INFORMATIONAL PURPOSES ONLY.

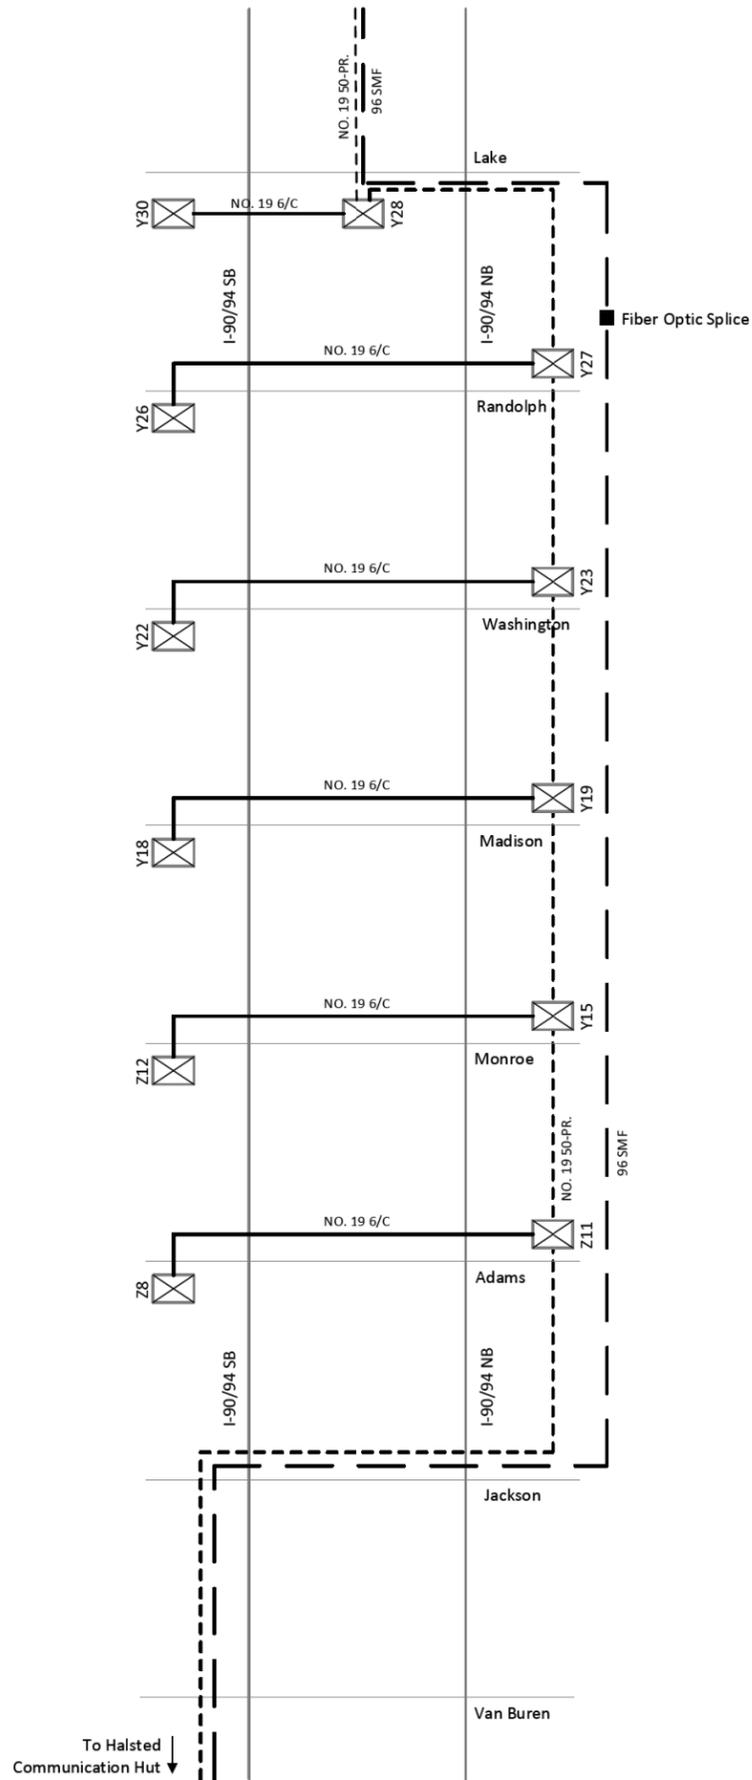

PROPOSED COMMUNICATIONS CABLE ROUTING

THIS DRAWING IS DIAGRAMMATICAL AND FOR INFORMATIONAL PURPOSES ONLY.

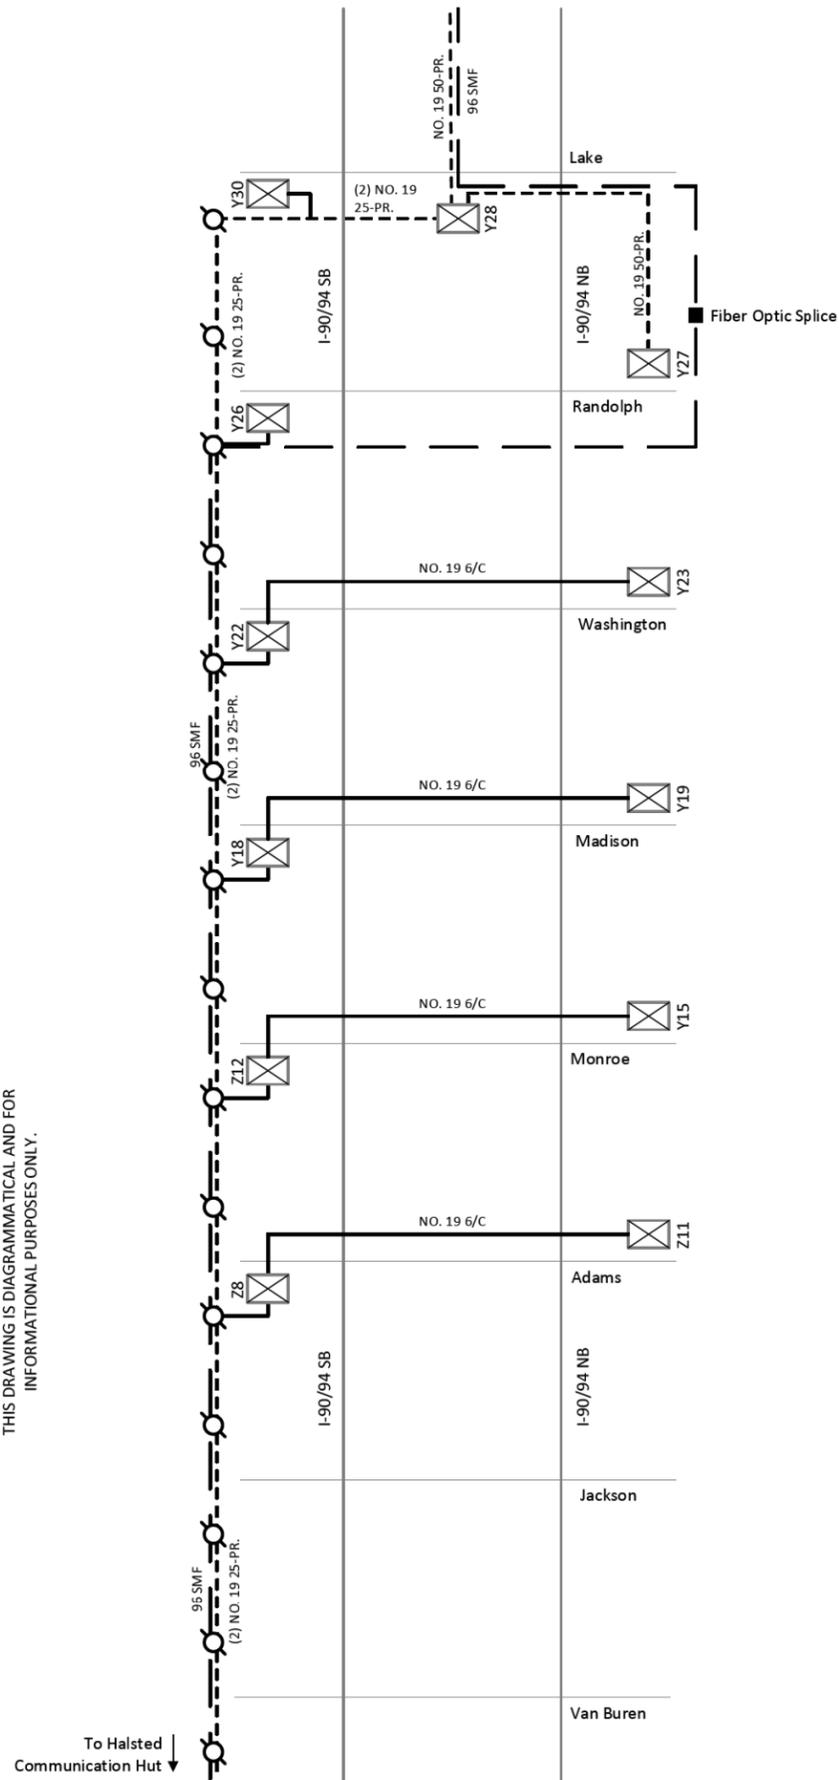

LEGEND

- NO. 19 6 PAIR NO. 19 6/C SURVEILLANCE CABINET
- NO. 19 25 PAIR NO. 19 50 PAIR TEMPORARY WOOD POLE
- 96 SMF



ITS-09



D162J31-sht-ITS-09
 USER NAME = myersc
 PLOT SCALE = 2,0000' / in.
 PLOT DATE = 8/14/2019

DESIGNED - MJL
 DRAWN - CAM
 CHECKED - PTJ
 DATE - 8/16/2019

REVISED -
 REVISED -
 REVISED -
 REVISED -




STATE OF ILLINOIS
 DEPARTMENT OF TRANSPORTATION

ITS COMMUNICATIONS SCHEMATIC

SCALE: N.T.S. SHEET 9 OF 11 SHEETS STA. TO STA.





F.A.I. RTE.	SECTION	COUNTY	TOTAL SHEETS	SHEET NO.
90/94/290	2019-054-I	COOK	400	223
CONTRACT NO. 62J31				
ILLINOIS FED. AID PROJECT				

FILE PATH = p:\aecom\ma-ansi\ecom\monline\local\AECOM_0502_MA\Documents\01_Americas\Transportation\60269938_Circle Phase II\000_CAD\006_Roadway\Sheets\62J31_Contract\162J31-sht-ITS-10

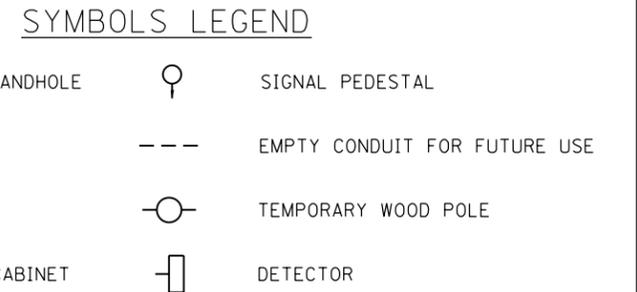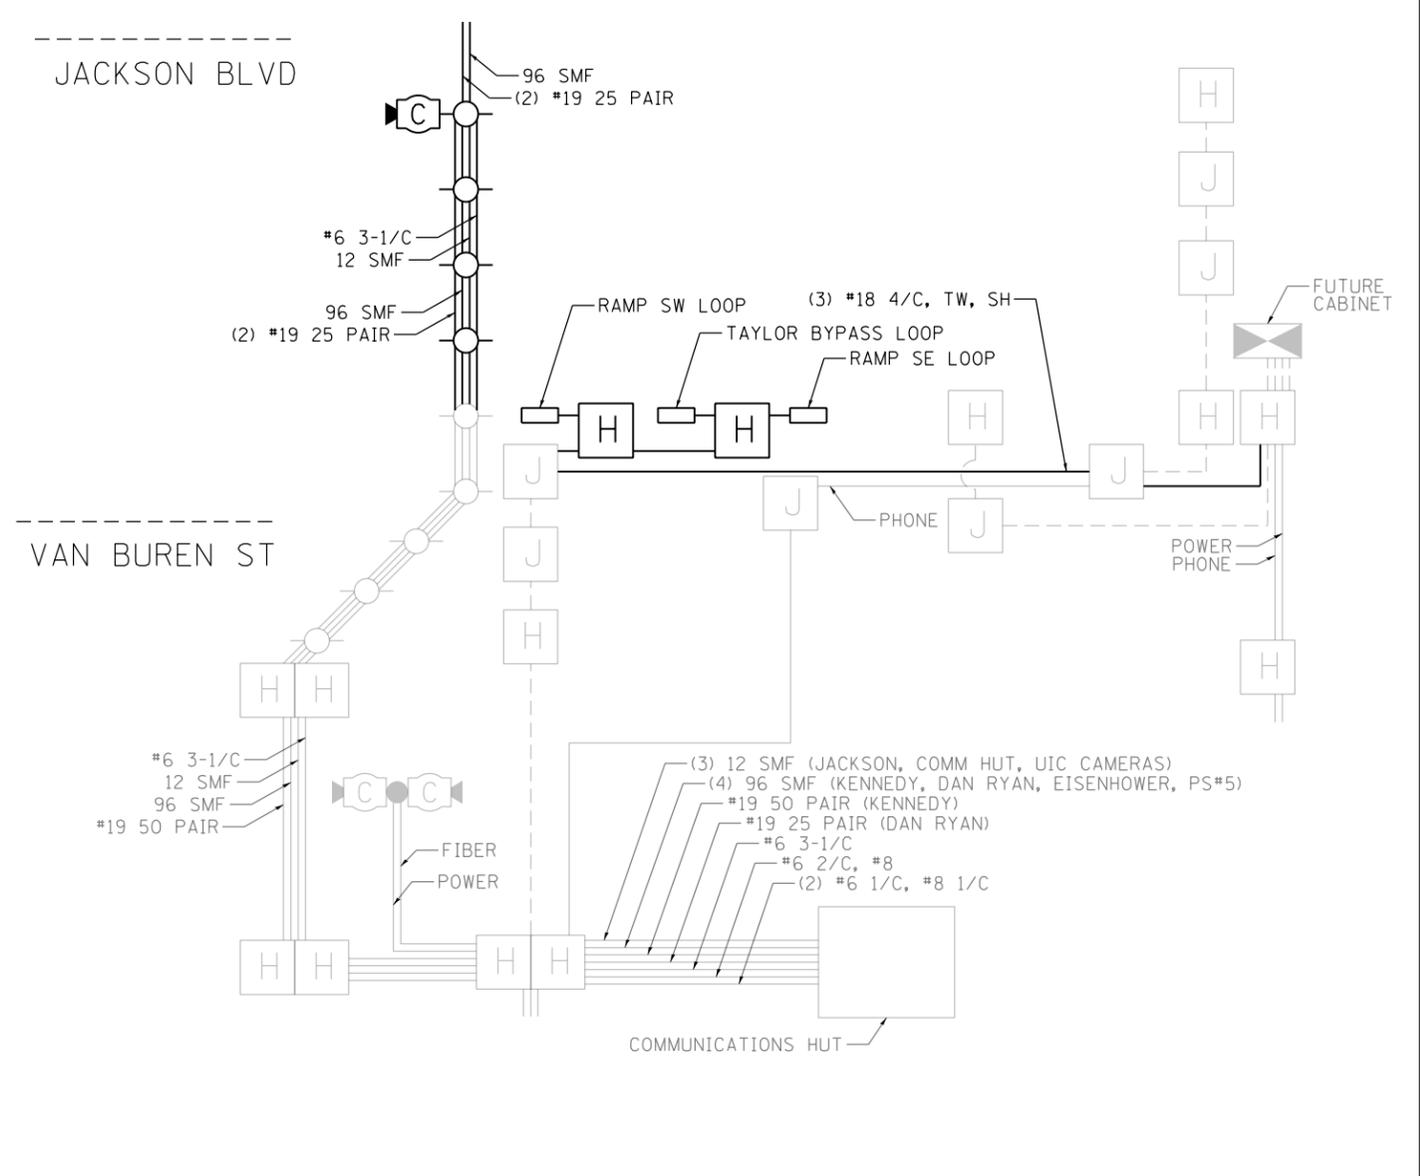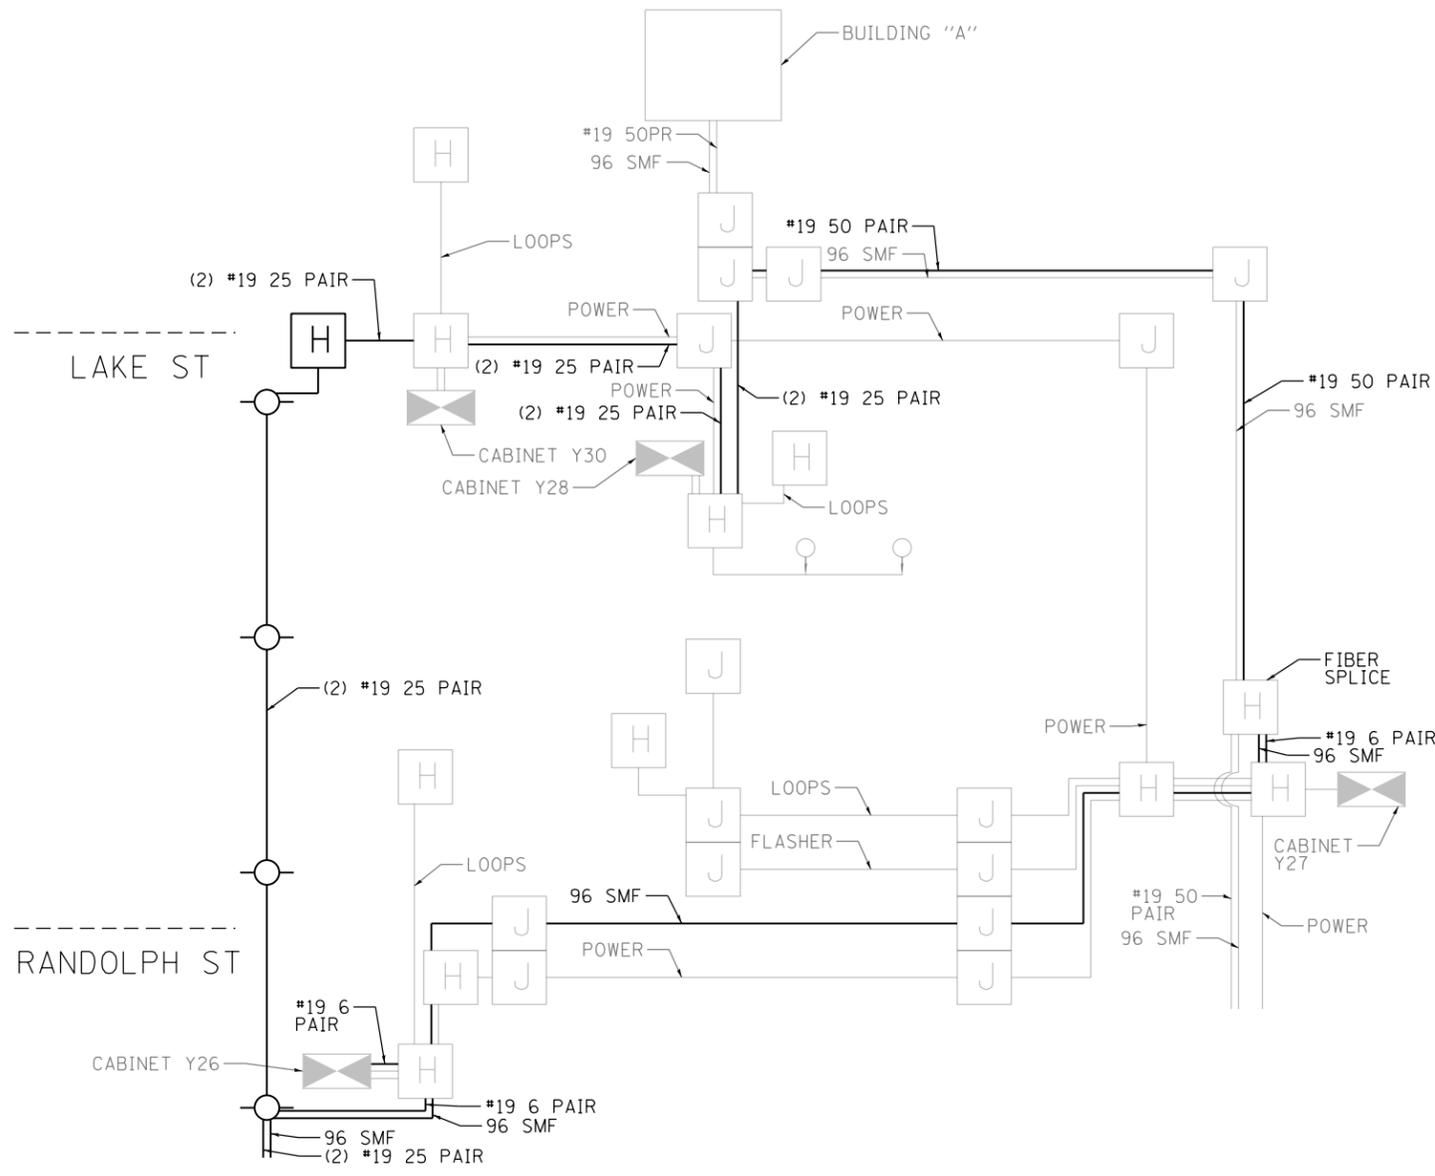

NOTES:

1. CONTRACT RELATED LINWORK APPEARS IN BOLD. ALL OTHER ITS INFRASTRUCTURE REPRESENTED ON THIS SHEET IS FOR INFORMATION ONLY.
2. NOT TO SCALE

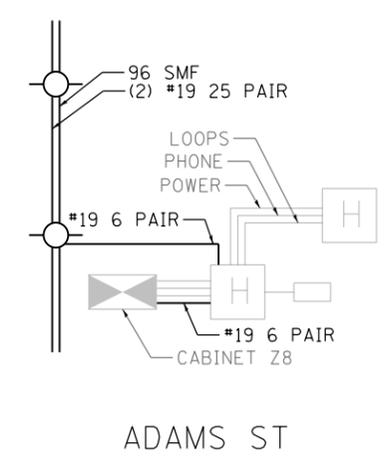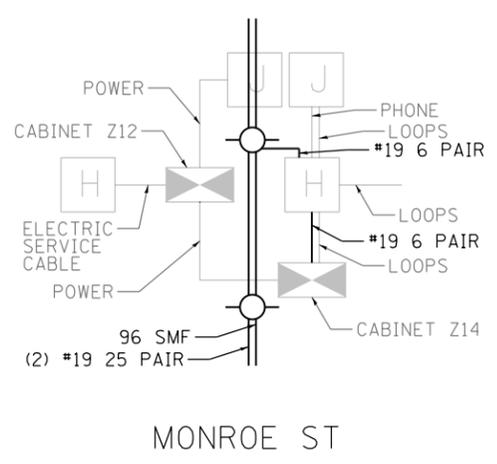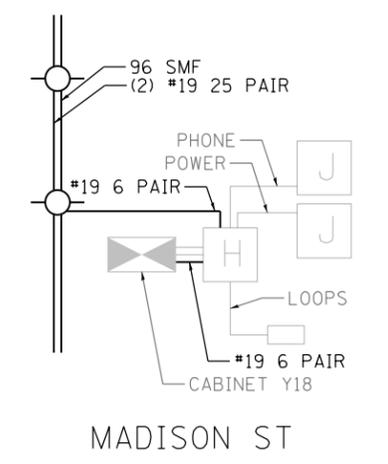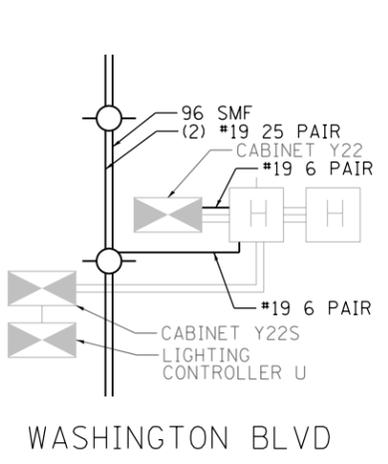

D162J31-sht-ITS-10
 USER NAME = myersc
 PLOT SCALE = 2,0000' / in.
 PLOT DATE = 8/14/2019

DESIGNED - MJL
 DRAWN - CAM
 CHECKED - PTJ
 DATE - 8/16/2019

STATE OF ILLINOIS
DEPARTMENT OF TRANSPORTATION


ITS WIRE DIAGRAM

SCALE: N.T.S. SHEET 10 OF 11 SHEETS STA. TO STA.


F.A.I. RTE.	SECTION	COUNTY	TOTAL SHEETS	SHEET NO.
90/94/290	2019-054-I	COOK	400	224
CONTRACT NO. 62J31				
ILLINOIS FED. AID PROJECT				

ITS-10

FILE PATH = p:\AECOM\NA-AVSI\ecommon\local\AECOM_D502_NA\Documents\01_Americas\Transportation\60269938_Circle Phase_1\000_CAD\006_Roadway\Sheets\62J31_Contract\0162J31-sht-ITS-11

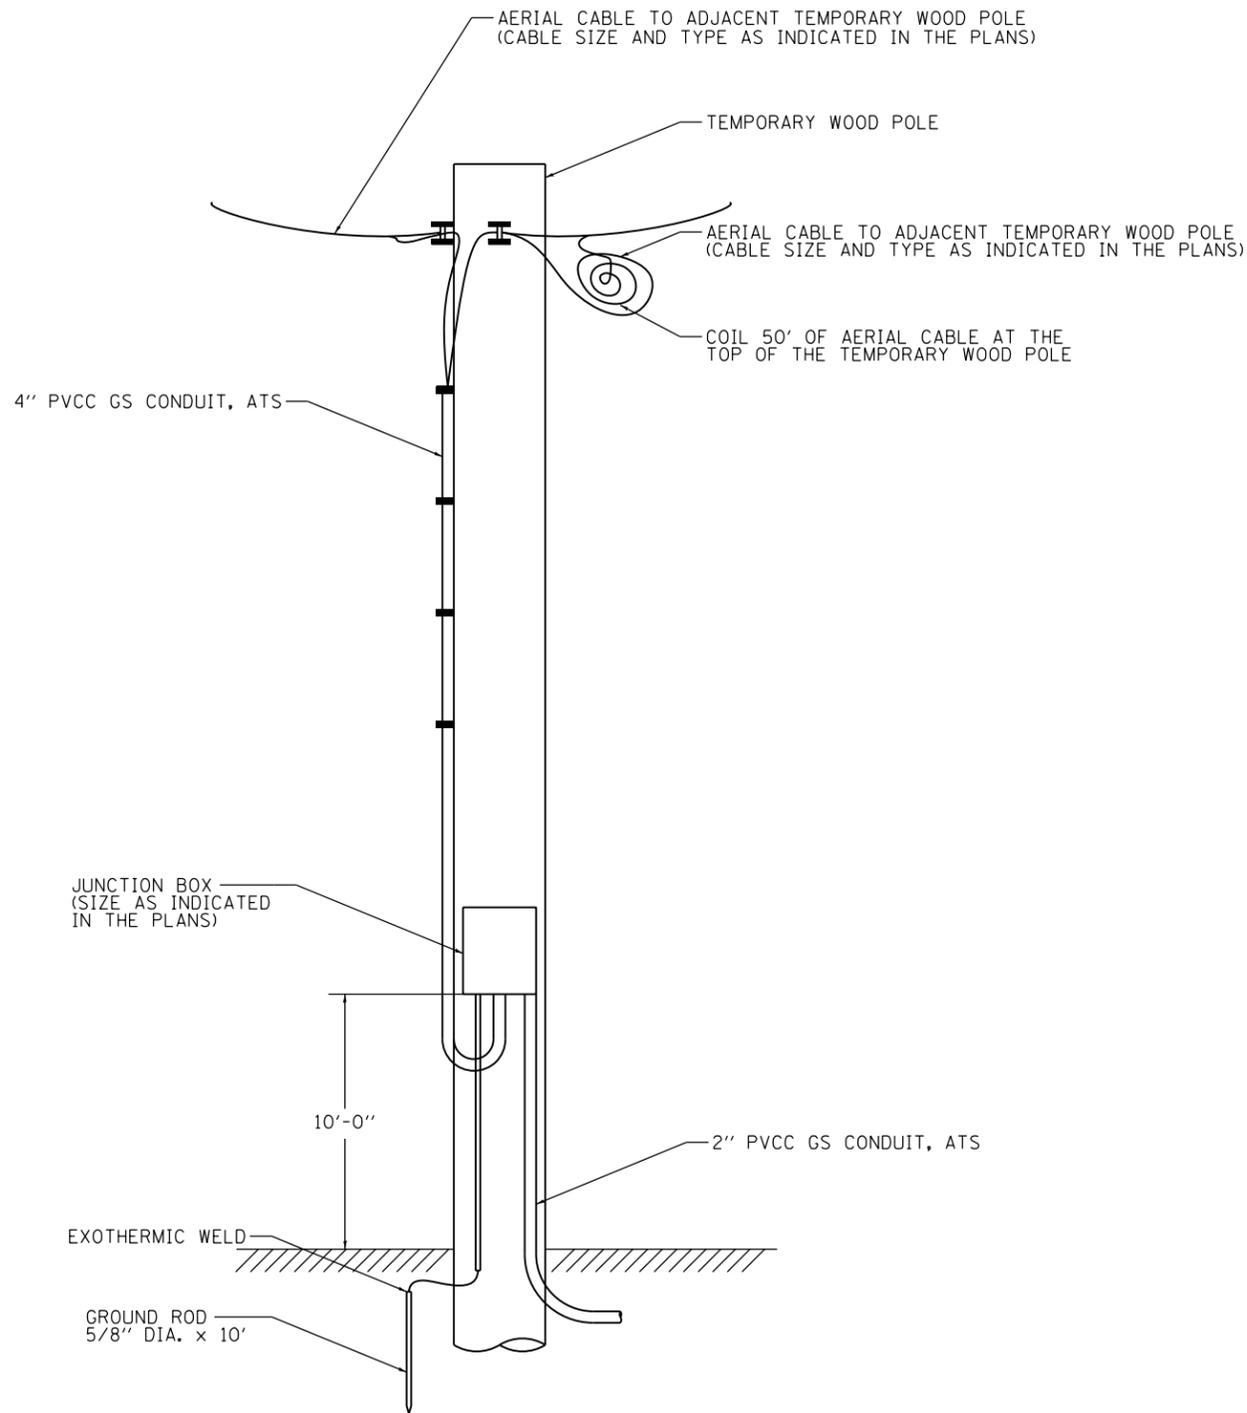

JUNCTION BOX ATTACHED TO WOOD POLE INSTALLATION DETAIL
NOT TO SCALE

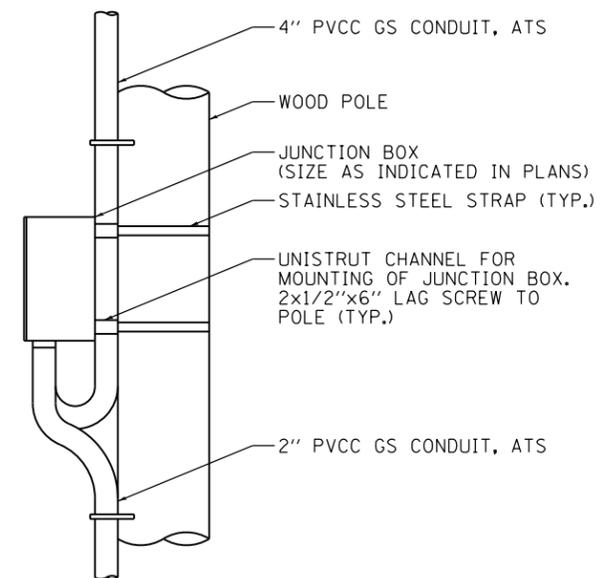

JUNCTION BOX MOUNTING DETAIL
NOT TO SCALE

ITS-11



D162J31-sht-ITS-11
USER NAME = myersc
PLOT SCALE = 2.0000' / in.
PLOT DATE = 8/14/2019

DESIGNED - MJL
DRAWN - CAM
CHECKED - PTJ
DATE - 8/16/2019


REVISED -
REVISED -
REVISED -
REVISED -

STATE OF ILLINOIS
DEPARTMENT OF TRANSPORTATION


ITS DETAIL

SCALE: N.T.S. SHEET 11 OF 11 SHEETS STA. TO STA.


F.A.I. RTE.	SECTION	COUNTY	TOTAL SHEETS	SHEET NO.
90/94/290	2019-054-I	COOK	400	225
CONTRACT NO. 62J31				
ILLINOIS FED. AID PROJECT				

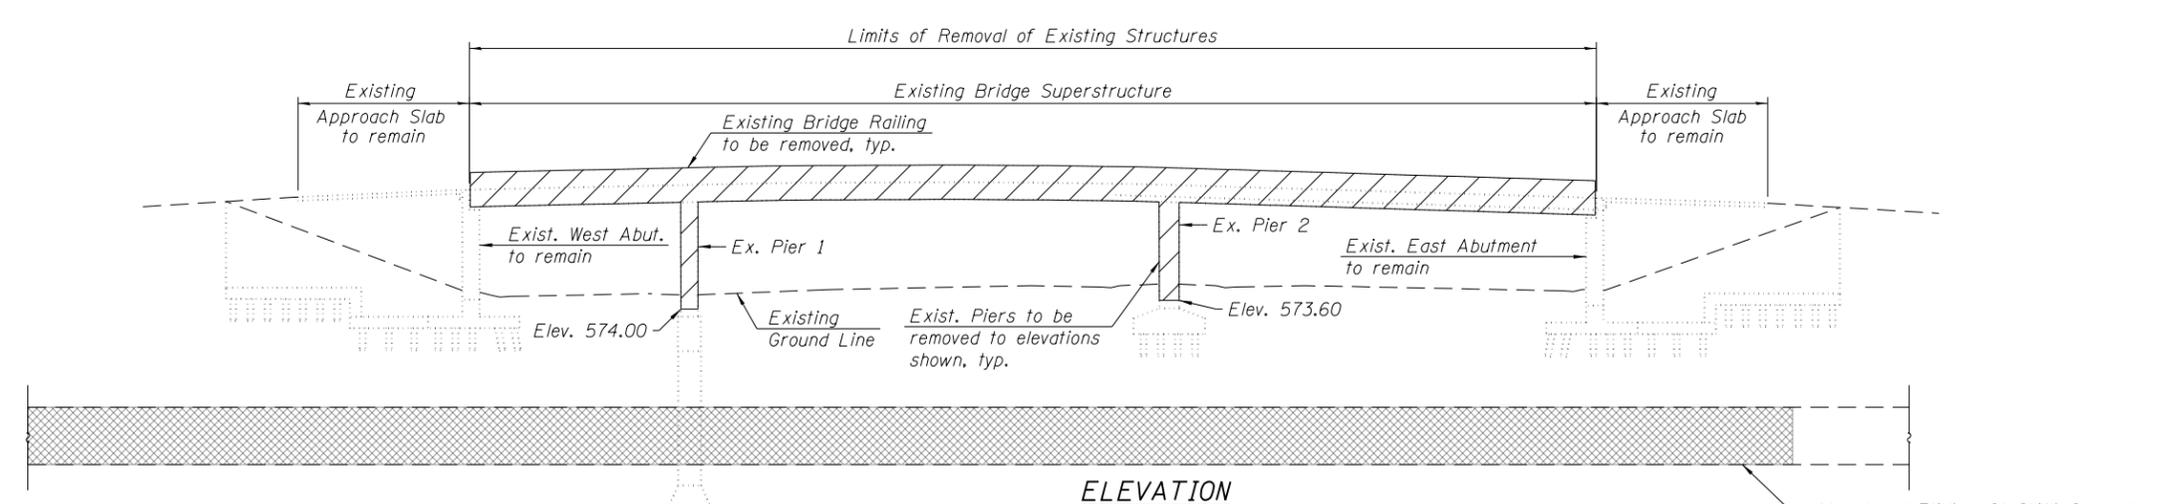

ELEVATION

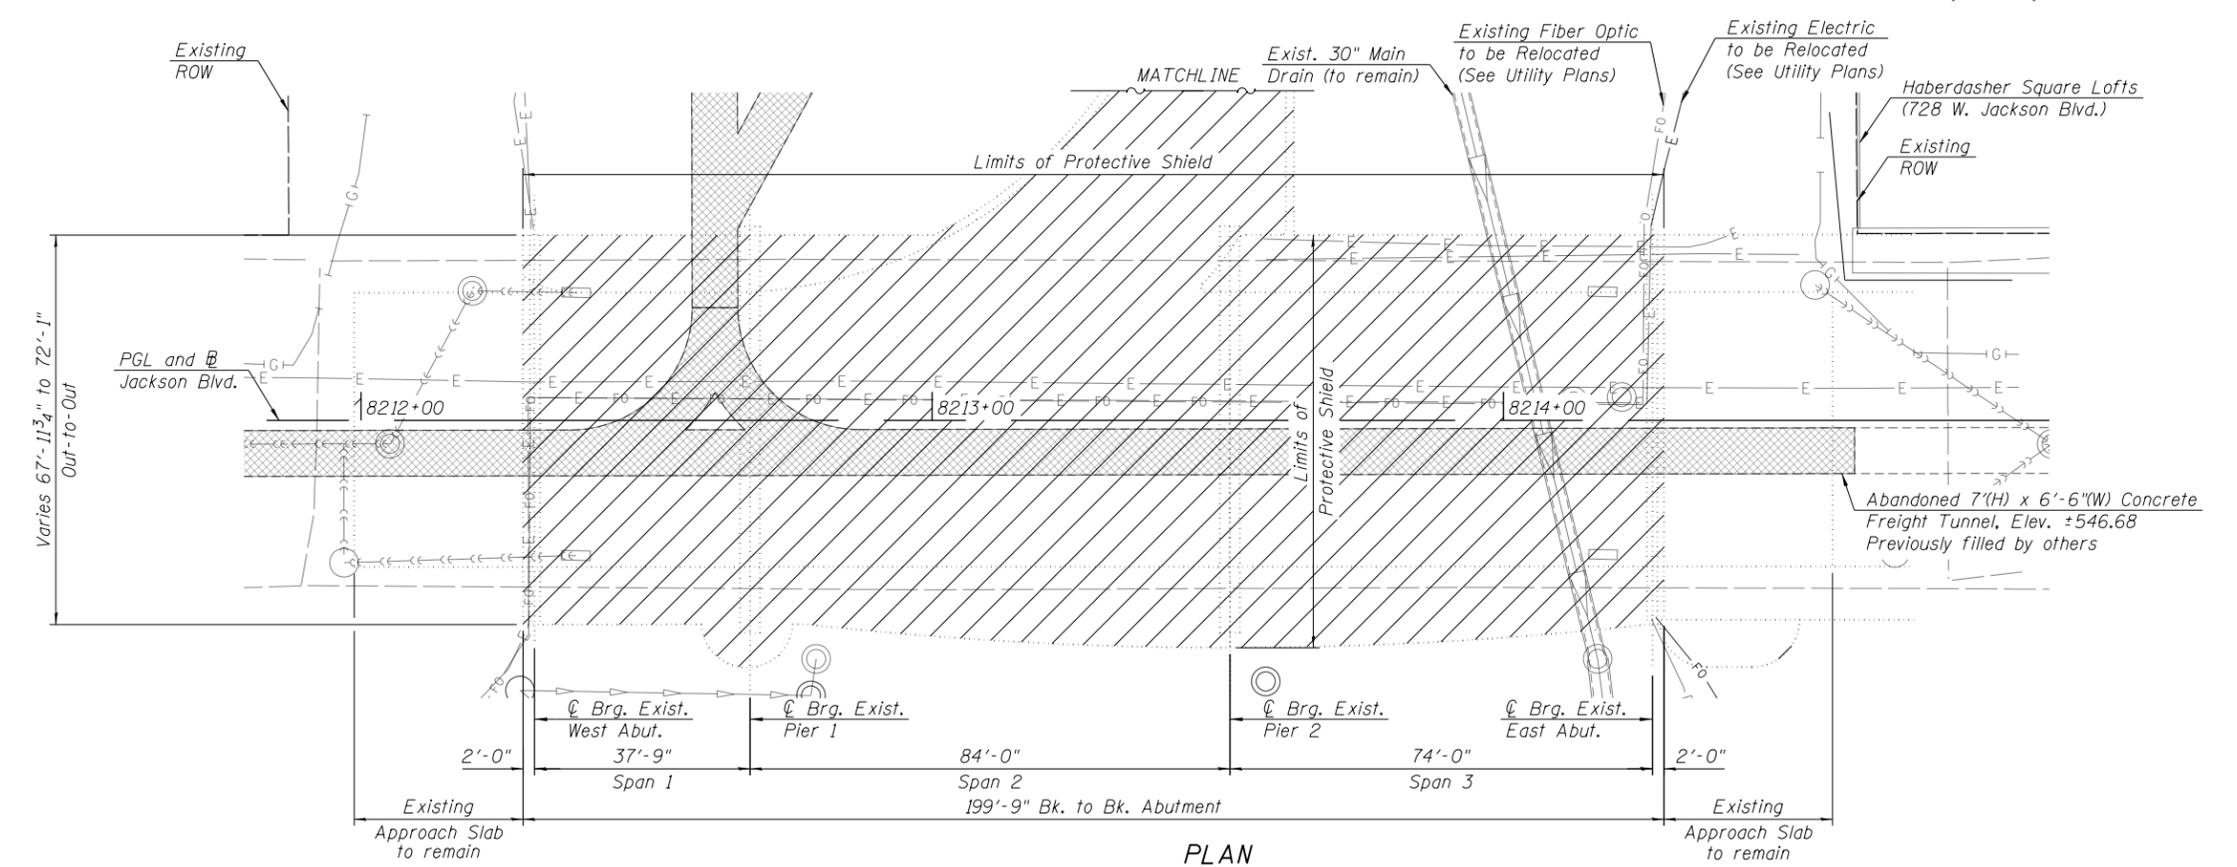

PLAN

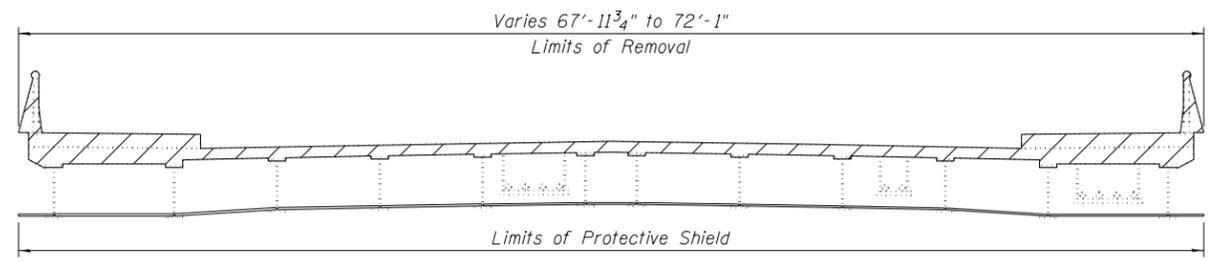

CROSS SECTION OF EXISTING SUPERSTRUCTURE
(Looking East)

LEGEND:

- Removal of Existing Structures
- Bulkhead and area filled with CLSM. Previously filled by others

Notes:
 Existing utilities between girders will be relocated to provide uninterrupted service during construction (by others).
 The Contractor is responsible to protect the roadway below from falling objects and debris during removal of the existing structure.
 Removal of existing structures shall be in accordance with Section 501 of the Standard Specifications. This item shall include complete removal of the concrete bridge rails, concrete deck and superstructure. This item also includes partial removal of the piers down to a minimum elevation as noted in plans.
 The existing structural steel coating contains lead. The Contractor shall take appropriate cautions to deal with the presence of lead on this project.
 Work this sheet with Sheet 2 of 2 .

8/11/58 AM 0160588-62J31-S001-Removal_Details.dgn




USER NAME = wjcolletti	DESIGNED - EH	REVISED
	CHECKED - WJC	REVISED
PLOT SCALE = 32x0 "/ in.	DRAWN - EH	REVISED
PLOT DATE = 9/12/2019	CHECKED - WJC	REVISED

STATE OF ILLINOIS
DEPARTMENT OF TRANSPORTATION


JACKSON BOULEVARD REMOVAL DETAILS 1
STRUCTURE NO. 016-0588

SHEET NO. 1 OF 2 SHEETS

F.A.U. RTE.	SECTION	COUNTY	TOTAL SHEETS	SHEET NO.
1422	2019-054-I	COOK	400	226
CONTRACT NO. 62J31			ILLINOIS FED. AID PROJECT	

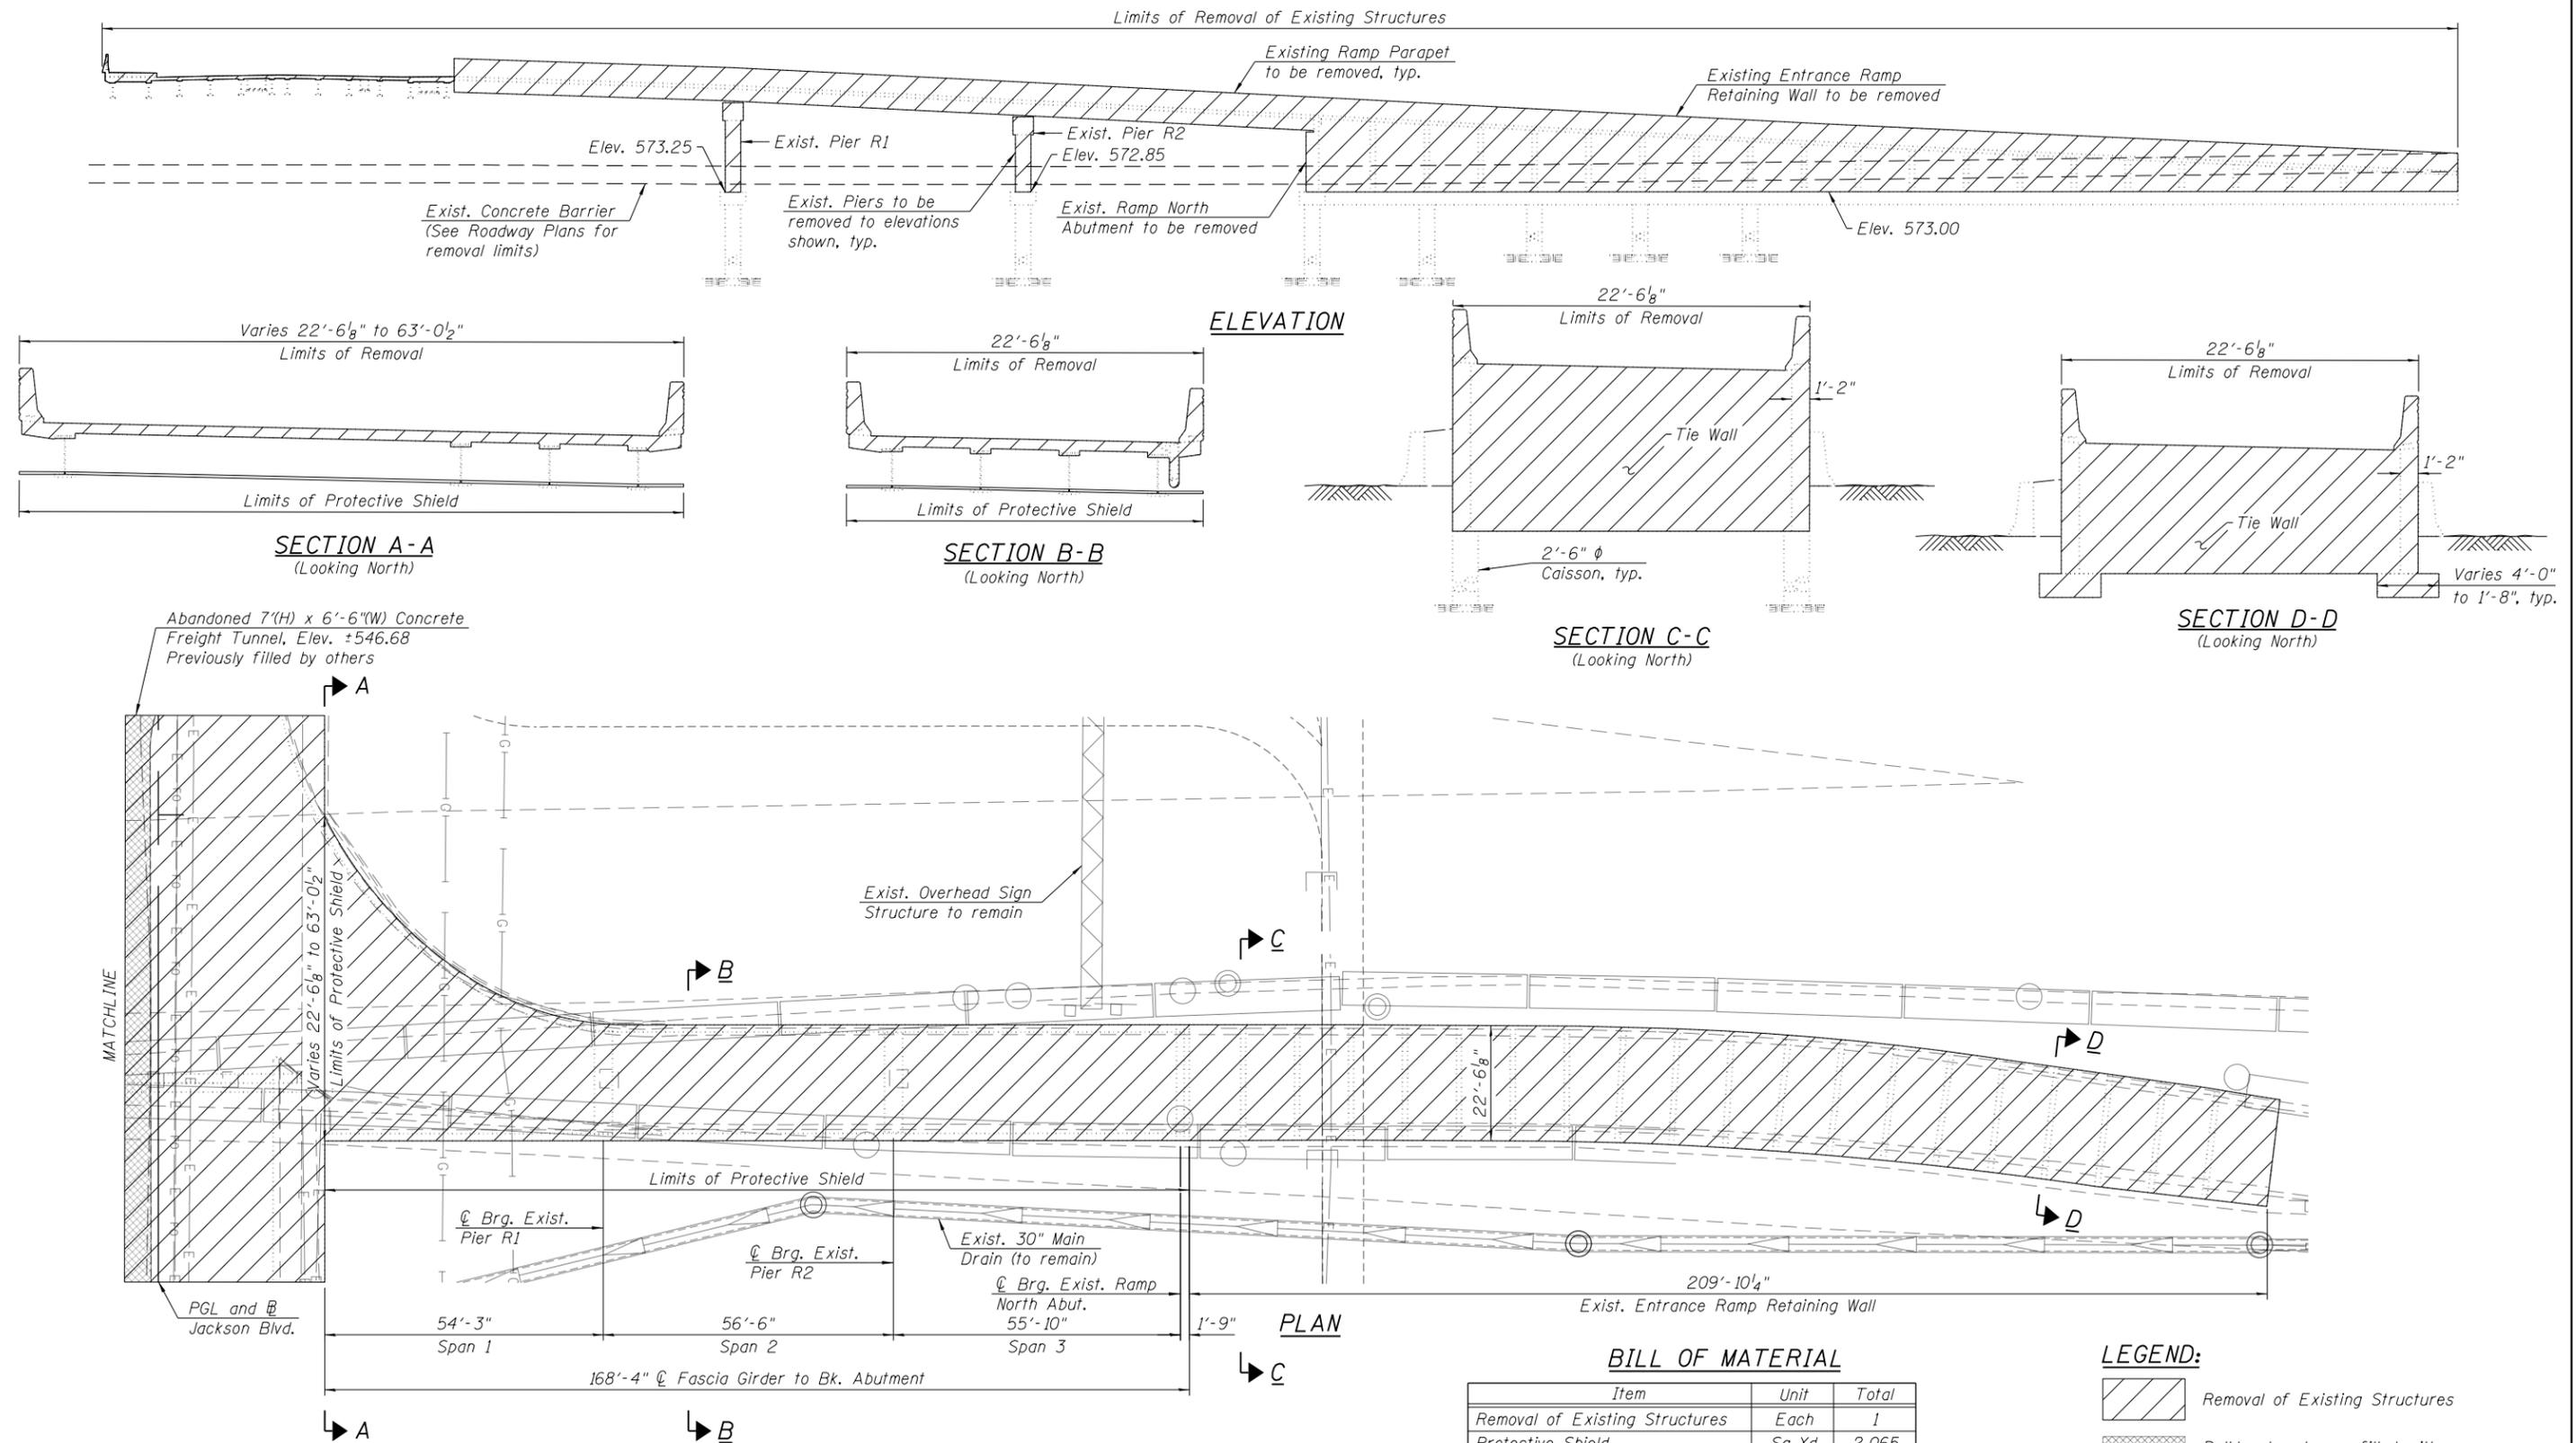

Notes:
See Sheet 1 of 2 for notes.

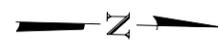

6:42:47 PM 0160588-62J31-S002-Removal_Details2.dgn



USER NAME = wjcolletti	DESIGNED - EH	REVISED
	CHECKED - WJC	REVISED
PLOT SCALE = 32:0 ' / in.	DRAWN - EH	REVISED
PLOT DATE = 8/14/2019	CHECKED - WJC	REVISED

**STATE OF ILLINOIS
DEPARTMENT OF TRANSPORTATION**

**JACKSON BOULEVARD REMOVAL DETAILS 2
STRUCTURE NO. 016-0588**

SHEET NO. 2 OF 2 SHEETS

F.A.U. RTE.	SECTION	COUNTY	TOTAL SHEETS	SHEET NO.
1422	2019-054-I	COOK	400	227
CONTRACT NO. 62J31				
ILLINOIS FED. AID PROJECT				

FOR INFORMATION ONLY

Structure Description: S.N. 016-0588, Built in 1958 as FA Route 173, Sec. 0101.2-2B. The Jackson Boulevard Bridge over I-90/94 is a three-span (11,506 m, 25,603 m, 22,555 m) continuous, multi-stringer steel bridge that carries four east bound traffic lanes and two sidewalks. Bridge width is 14,630 m with two 3,048 m sidewalks. Entrance Ramp "A" is a three-span, (16,764 m, 16,764 m, 16,764 m) simply supported, multi-stringer composite steel bridge. Ramp width is 5.48 m. Ramp "A" carries one lane of traffic from the north side of the Jackson Boulevard bridge onto north bound I-90/94 Kennedy Expressway.

Bench Mark: "A" Cut in South Sidewalk of Jackson Boulevard at N.W. Corner of #763 W. Jackson Boulevard (Sta. 1+275). El. 180.959.

Staging: Structure to be closed during construction.

Salvage: None.


Note: All dimensions are in millimeters (mm) unless otherwise noted.

90/94	0101-2-1B-R-1	COOK	226	22
STA. 1+350.230 TO STA.				
FED. ROAD DIST. NO. 7		ILLINOIS FED. AID PROJECT		
5-1 of 49				

STATION 01+350.230
REBUILT 2000 BY
STATE OF ILLINOIS
F.A.U. RTE. 1422
SEC 0101-2-1B-R-1
LOADING MS 18
STR. NO. 016-0588

NAME PLATE
Sta. 515001

Note: Clean existing name plates cost included with "Name Plates"
New name plate shall be attached adjacent to the existing name plate.

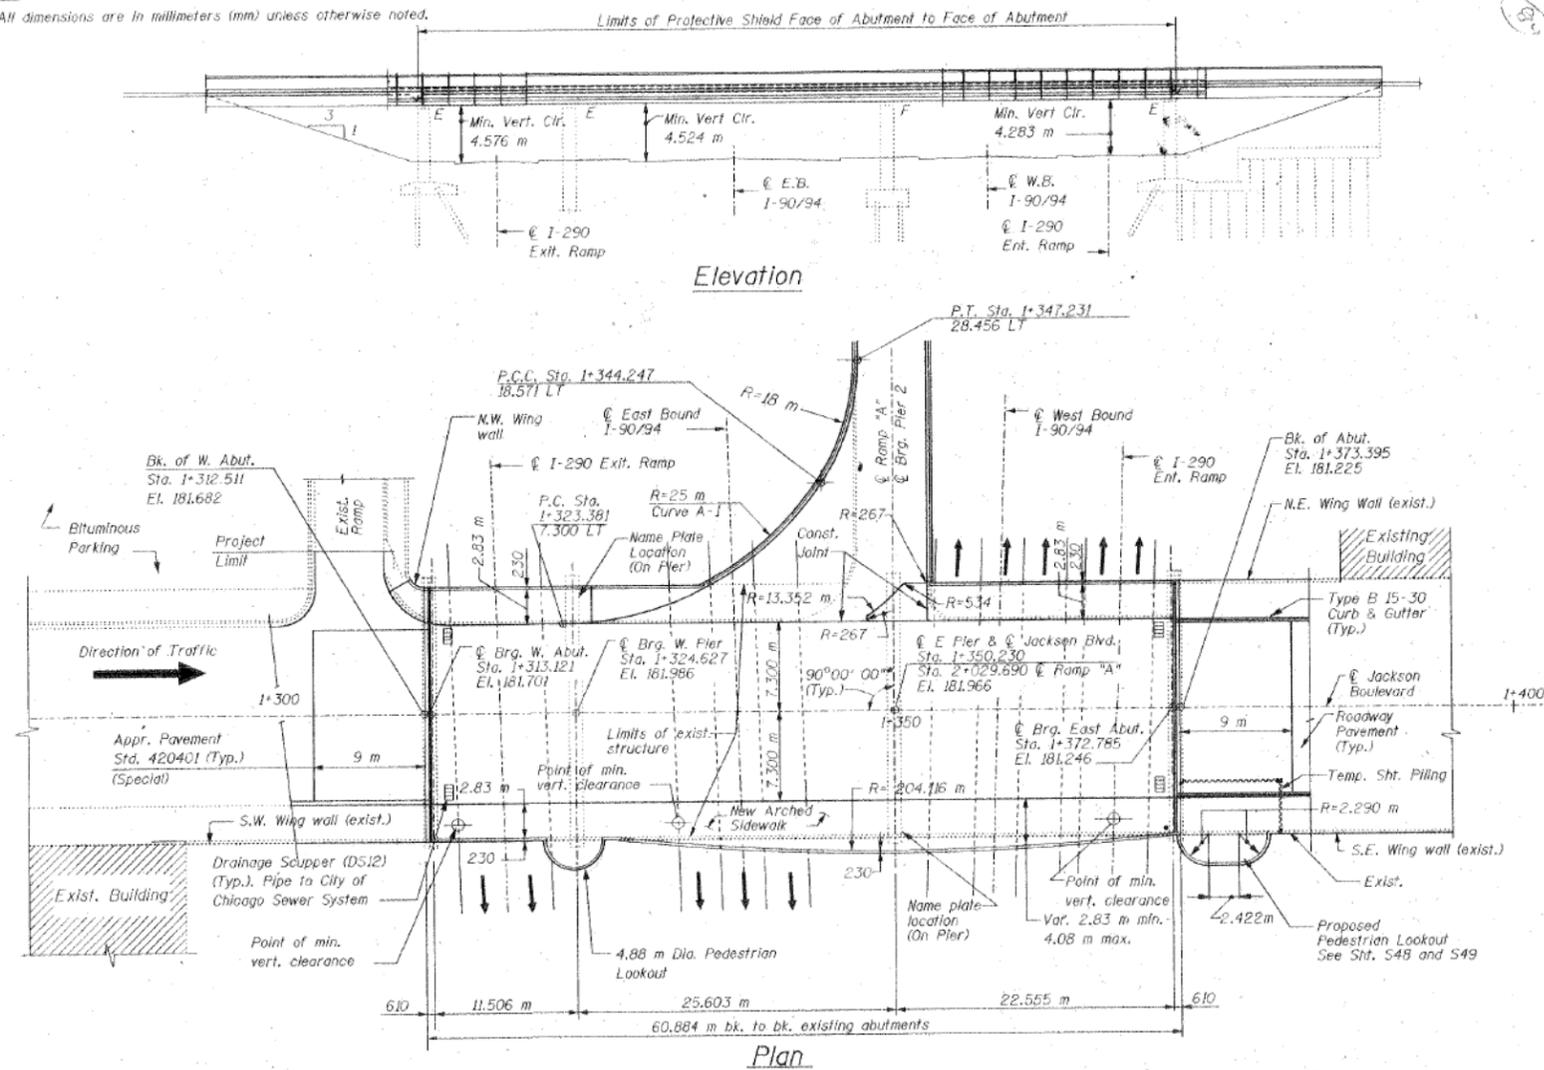

Design Specifications

1995 Seismic Retrofitting Manual for Highway Bridges (FHWA-RD-94-052)
1996 A.A.S.H.T.O. and 1997 & 1998 Interims.

Loading MS18

Allow 1.2 k/m² for future wearing surface

Design Stresses

New Construction

$f'_c = 24 \text{ MPa}$
 $f_y = 400 \text{ MPa (Reinf.)}$
 $f_y = 250 \text{ MPa (M270 M Grade 250)}$
 $f_y = 345 \text{ MPa (M270 M Grade 345)}$

Existing Construction

$f_c = 20 \text{ MPa}$
 $f_s = 275 \text{ MPa (Reinf.)}$
 $f_s = 230 \text{ MPa (Structural Steel)}$

Seismic Data

Seismic Performance Category (SPC) = A
Bedrock Acceleration Coefficient (A) = 0.04
Site Coefficient (S) = 2.0

* Angle Shown is taken from the plans of the existing structure. The contractor must verify the angle prior to fabrication of any material.



REVISIONS		ILLINOIS DEPARTMENT OF TRANSPORTATION GENERAL PLAN
NAME	DATE	
		JACKSON BOULEVARD, FAU 1422 OVER JOHN F. KENNEDY EXPRESSWAY, FAI 90/94 SECTION 0101-2-1B-R-1 COOK COUNTY STATION 1+350.230 STRUCTURE NO. 016-0588 DESIGNED BY J.D.G. DRAWN BY C.J.I. DATE: 4-00 CHECKED BY J.K. CHECKED BY J.D.G.

STV Incorporated
Engineers/Architects/Planners/Construction Managers
70 W. Madison St. Chicago, IL 60602-4207

6/3/11 PM 016231-SHT-AS-BUILT-01



USER NAME = wjcolletti	DESIGNED EH	REVISED
PLOT SCALE = 0x2.0000 '1' / in.	CHECKED WJC	REVISED
PLOT DATE = 8/13/2019	DRAWN EH	REVISED
	CHECKED WJC	REVISED

**STATE OF ILLINOIS
DEPARTMENT OF TRANSPORTATION**



EXISTING JACKSON BLVD BRIDGE PLANS (SN 016-0588)

SHEET NO. AB-01 OF AB-65 SHEETS



F.A.I. RTE. 90/94/290	SECTION 2014-017B	COUNTY COOK	TOTAL SHEETS 400	SHEET NO. 228
ILLINOIS FED. AID PROJECT			CONTRACT NO. 62J31	

FOR INFORMATION ONLY

F.A.I. RTE.	SECTION	COUNTY	TOTAL SHEETS NO.	SHEET NO.
90/94	0101-2-1B-R-1	COOK	226	23
STA. 1+350.230 TO STA.		ILLINOIS FED. AID PROJECT		
FED. ROAD DIST. NO. 7		5-2 of 49		

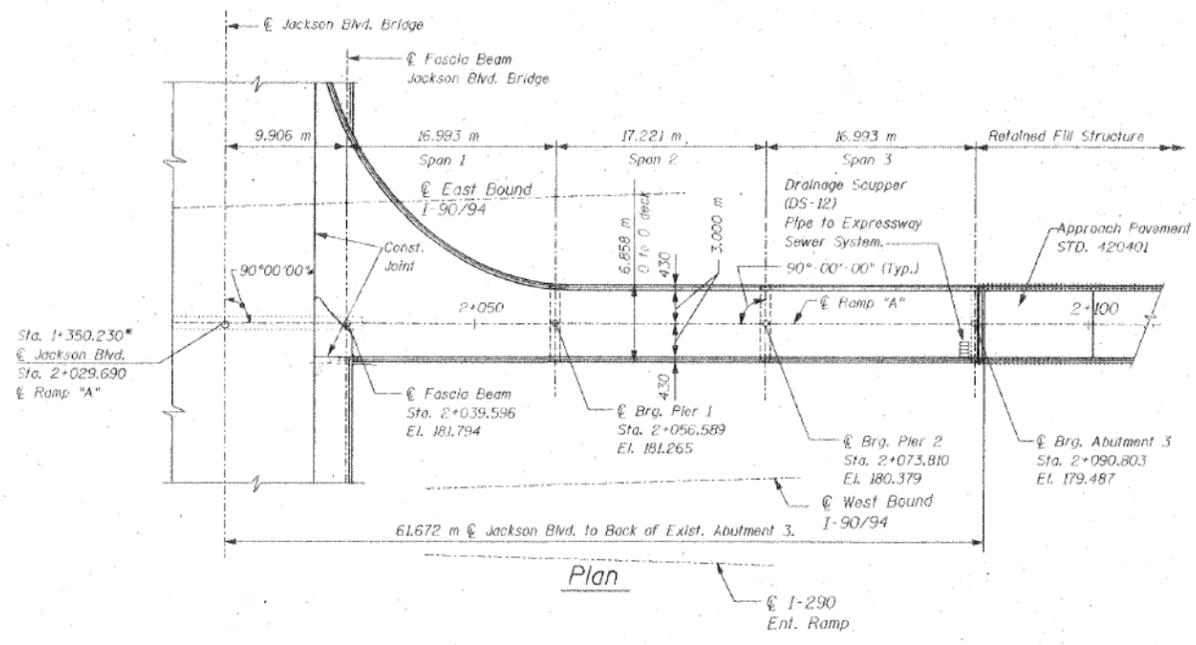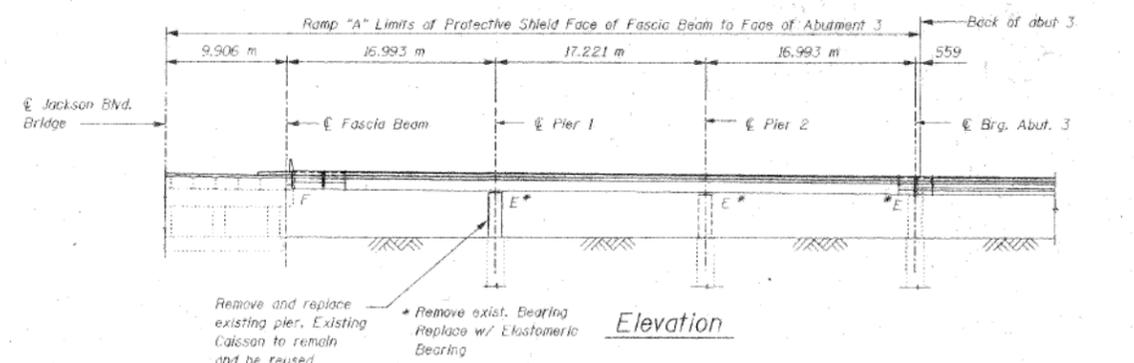

* Stationing and angle for ramp location is based on the plans of the existing structure. The contractor must verify the location prior to fabrication of any material.

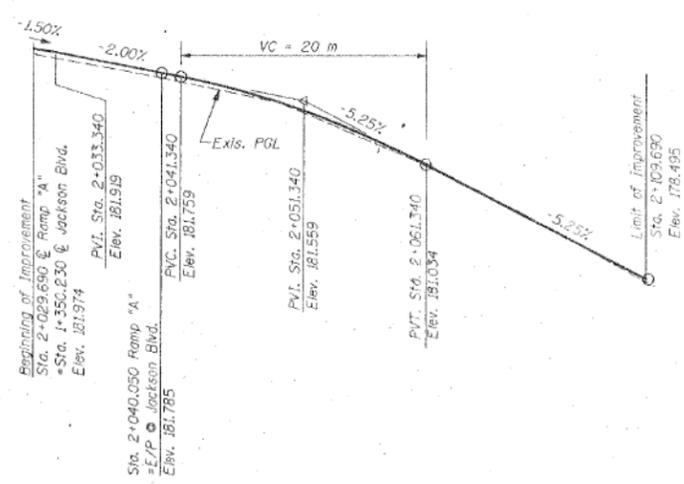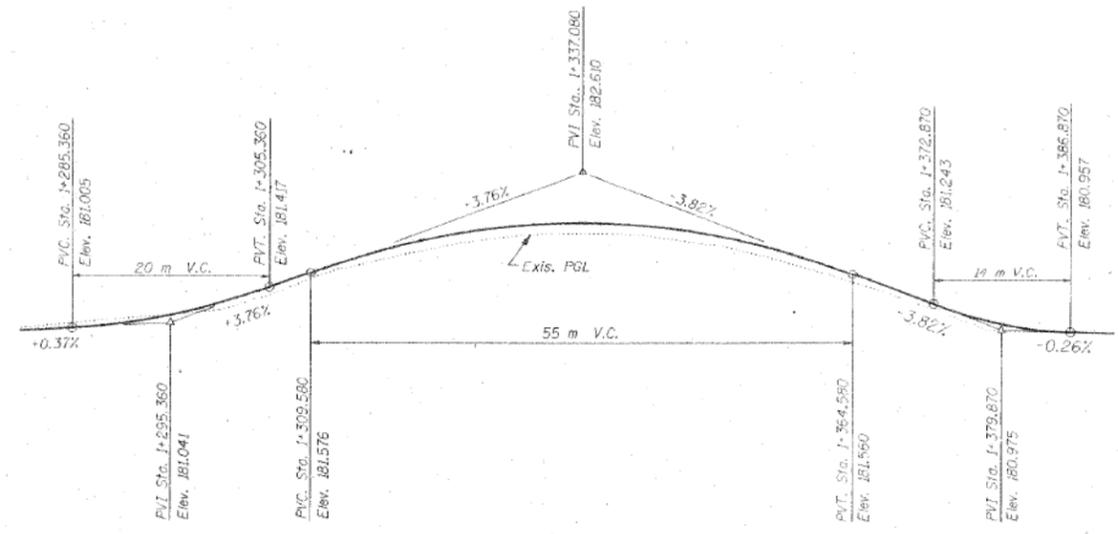

Note: All dimensions are in millimeters (mm) unless otherwise noted.

REVISIONS	
NAME	DATE

ILLINOIS DEPARTMENT OF TRANSPORTATION
GENERAL PLAN - RAMP "A"
JACKSON BOULEVARD, FAU 1422 OVER
JOHN F. KENNEDY EXPRESSWAY, FAI 90/94
SECTION 0101-2-1B-R-1 COOK COUNTY
STATION 1+350.230 STRUCTURE NO. 016-0588
DESIGNED BY J.D.G. DRAWN BY C.U.
DATE 4-00 CHECKED BY I.K. CHECKED BY J.D.G.

STV Incorporated
Engineers/Architects/Planners/Construction Managers
70 W. Madison St. Chicago, IL 60602-4207

6:37:38 PM
D162331-SHT-AS-BUILT-02



USER NAME = wjcolletti	DESIGNED EH	REVISED
PLOT SCALE = 0x2.0000 'x' / in.	CHECKED WJC	REVISED
PLOT DATE = 8/13/2019	DRAWN EH	REVISED
	CHECKED WJC	REVISED

STATE OF ILLINOIS
DEPARTMENT OF TRANSPORTATION

EXISTING JACKSON BLVD BRIDGE PLANS (SN 016-0588)

SHEET NO. AB-02 OF AB-65 SHEETS

F.A.I. RTE.	SECTION	COUNTY	TOTAL SHEETS	SHEET NO.
90/94/290	2014-017B	COOK	400	229
ILLINOIS FED. AID PROJECT				CONTRACT NO. 62J31

FOR INFORMATION ONLY

24/1/02

RTE.	SECTION	COUNTY	SHEETS NO.
90/94/0101-2-1B-R-1	COOK	226	25
STA. 1+350.230	TO STA.		
FED. ROAD DIST. NO. 7	ILLINOIS FED. AID PROJECT		

S-4 of 49

REINFORCEMENT BARS

Reinforcement bars shall conform to the requirements of AASHTO M-31M, M-42M or M-53M Grade 400.

CONCRETE CHAMFERS

All exposed concrete corners shall have 20 mm chamfers unless otherwise shown in the plans.

CONCRETE COVER

All reinforcement bars shall have a clear cover of 40 mm unless otherwise shown in the plans.

STRUCTURAL STEEL

The main load carrying member components subject to tensile stress shall conform to the supplemental requirements for notch toughness zone 2. These components are the wide flange beams, connection angles and plates as specified in the plans, cover plates, sidewalk connections and all splice plate material except fill plates.

FIELD WELDING

Field welding of construction accessories will not be permitted to the bottom flange of beams nor to the top flange for distance equal to one-fourth the span length each way from the pier supports. Field welding in other areas will be permitted only when approved by the Engineer.

BOLTED CONNECTIONS

Fasteners for structural steel shall be high strength bolts M22 with 24 mm ϕ holes unless otherwise noted.

PAINTING NEW STEEL

The inorganic zinc rich primer/acrylic/acrylic paint system shall be used for shop and field painting of new structural steel except where otherwise noted. The color of the final finish coat for all steel surfaces shall be gray, Munsell No. 5B 7/1. See special provision "Cleaning and Painting New Metal Structure".

PAINTING EXISTING STEEL OF HIGHWAY GRADE SEPARATION STRUCTURES

Cleaning and painting of the existing structural steel shall be as specified in the Special Provision for "Cleaning and Painting Existing Steel Structures". All existing structural steel within 1.5 meters of either side of expansion joints and all surfaces of the two beams adjacent to the existing open longitudinal joint shall be cleaned by method 1. The existing structural steel in the area of the proposed concrete counter-weights shall be cleaned prior to pouring of the bridge deck. All remaining existing structural steel shall be cleaned by method 2. The aluminum epoxy mastic/acrylic paint system shall be used for painting of the existing structural steel. The color of the final finish coat for all steel surfaces shall be gray, Munsell No. 5B 7/1.

The existing structural steel coating contains lead. The contractor should take appropriate precautions to deal with lead in this project.

BEARING PLATES

The structural steel bearing plates of the Steel bearing assembly shall conform to the requirements of AASHTO M 270M Grade 345.

BEARING SEAT SURFACES

Bearing seat surfaces shall be constructed or adjusted to the designated elevations within a tolerance of 3 mm. Adjustment shall be made either by grinding the surface or by shimming the bearing. Two 3 mm adjusting shims, of the dimensions of the bottom bearing plate, shall be provided for each bearing in addition to all other plates or shims. (For Type I Elastomeric Bearings, two 3 mm adjusting shims shall be provided for each bearing and placed as detailed).

ANCHOR BOLTS

Anchor bolts shall be set before bolting diaphragms (bolting cross frames) over supports.

PLAN DIMENSIONS

Plan dimensions and details relative to existing structure have been taken from existing plans and are subject to nominal construction variations. It shall be the Contractor's responsibility to verify such dimensions and details in the field and make necessary approved adjustments prior to construction or ordering of materials. Such variations shall not be cause for additional compensation for a change in the scope of the work, however, the Contractor will be paid for the quantity actually furnished at the unit price bid for the work.

STRUCTURAL STEEL

Calculated mass of structural steel M270M GR 270 = 20112 kg
Calculated mass of structural steel M270M GR 345 = 89480 kg.

SEAT SEALER

Bridge Seat Sealer shall be applied to the seat area of Jackson Boulevard Bridge Abutments & Ramp "A" Abutment.

DECK POUR

When the deck pour is stopped for the day at one or more of the Transverse Bonded Construction Joints in the deck Pouring Sequence as shown, the next pour shall not be made until both of the following requirements are met:

- At least 72 hours shall have elapsed from the end of the previous pour.
- The concrete strength shall have attained a minimum modulus of rupture of 4.5 MPa or a minimum compressive strength of 24 MPa.

DIMENSIONS

All dimensions are in millimeters (mm) except as noted.

TOTAL BILL OF MATERIAL

DESCRIPTION	UNIT	SUB-STRUCTURE	SUPER STRUCTURE	TOTAL QUANTITIES
Protective Shield	m ²		1,276	1,276
Removal of Existing Superstructure	Each		1	1
Removal of Existing Concrete Deck	Each		1	1
Structural Steel Removal	Kg		39820	39820
Jack and Remove Existing Bearings	Each		30	30
Temporary Sheet Pile	m ²	117		117
Concrete Removal	m ³	69		69
Blasting Residue Containment and Disposal	L Sum		0.5	0.5
Power Tool Cleaning Residue Containment and Disposal	L Sum		0.5	0.5
Cleaning & Painting Steel Bridge	L Sum		0.5	0.5
Stud Shear Connectors	Each		9,100	9,100
Furnishing & Erecting Structural Steel	L Sum		0.5	0.5
Elastomeric Bearing Assembly, Type I	Each		32	32
Elastomeric Bearing Assembly, Type II	Each		16	16
Preformed Joint Seal 102 mm	m		23	23
Preformed Joint Seal 64 mm	m		23	23
Neoprene Expansion Joint, 65 mm	m		8	8
Structure Excavation	m ³	190		190
Porous Granular Embankment	m ³	173		173
Concrete Superstructure	m ³		512	512
Concrete Structure	m ³	96		96
Reinforcement Bars, Epoxy Coated	kg	8220	63975	72195
Mechanical Splice	Each	12		12
Bridge Seat Sealer	m ²	10		10
High Performance Enhanced Shotcrete	m ²		91	91
Epoxy Crack Sealing	m		20	20
Protective Coat **	m ²		1,770	1,770
Bridge Deck Grooving	m ²		1,210	1,210
Drainage System	L Sum		0.5	0.5
Name Plates	Each	2		2
Drainage Scupper DS-12	Each		4	4

** Includes Deck surface and Top of sidewalk on bridge and ramp

DRAWING LIST

- S-1 General Plan
- S-2 General Plan - Ramp "A"
- S-3 Jackson Boulevard Bridge and Ramp "A" Removal Details
- S-4 Jackson Boulevard Bridge General Notes and Quantities
- S-5 Top Deck Elevations Locations Grid and Details
- S-6 Top Deck Elevations, Jackson Boulevard
- S-7 Top Deck Elevations, Jackson Boulevard
- S-8 Top Deck Elevations, Jackson Boulevard
- S-9 Top of Deck Elevations, Locations, Grid and Details, Ramp "A"
- S-10 Top Deck Elevations Ramp "A"
- S-11 Top of Deck Elevations, Locations, Grid and Details Radius Improvement, Ramp "A"
- S-12 Bridge Deck Plan and Cross Section
- S-13 Bridge Deck Details
- S-14 Bridge Sidewalk Plan and Details
- S-15 Bridge Sidewalk Section and Details
- S-16 Jackson Boulevard Bridge Counterweight Concrete Plan and Elevation
- S-17 Entrance Ramp "A" Deck Plan
- S-18 Entrance Ramp "A" Deck Cross Sections and Details
- S-19 Bridge Framing Plan
- S-20 Jackson Boulevard Bridge Beam Elevations and Details
- S-21 Jackson Boulevard Bridge and Ramp "A" Splice Details
- S-22 Jackson Boulevard Bridge and Ramp "A" Splice Details
- S-23 Jackson Boulevard Bridge Diaphragm Connection Details
- S-24 Entrance Ramp "A" Beam Connection Details
- S-25 Jackson Boulevard Bridge Sidewalk Framing Details
- S-26 Entrance Ramp "A" Framing
- S-27 Entrance Ramp "A" Beam Elevations and Diaphragm Details
- S-28 Entrance Ramp "A" Beam Connection Details
- S-29 Jackson Boulevard Bridge Moment and Reaction Tables
- S-30 Entrance Ramp "A" Moment and Reaction Tables
- S-31 Bridge Drainage Details
- S-32 Continuous Seal Type Neoprene Expansion Joints
- S-33 Elastomeric Bearing Details East and West Abutments
- S-34 Elastomeric Bearing Details - East and West Piers
- S-35 Entrance Ramp "A" Elastomeric Bearing Details Type II Abutment
- S-36 Entrance Ramp "A" Elastomeric Bearing Details Pier 1 & 2
- S-37 Anchor Bolt Details for Bearings
- S-38 West Abutment
- S-39 East Abutment
- S-40 West Pier
- S-41 East Pier
- S-42 Ramp "A" Reconstruction Pier 1
- S-43 Ramp "A" Rehabilitation Pier 2
- S-44 Entrance Ramp "A" Details, Abutment (Not Included)
- S-45 Wing Wall Rehabilitation Plans
- S-46 Entrance Ramp "A" Retaining Walls
- S-47 Lookout Details
- S-48 Lookout Details
- S-49 Lookout Details

REVISIONS		ILLINOIS DEPARTMENT OF TRANSPORTATION JACKSON BOULEVARD BRIDGE GENERAL NOTES & QUANTITIES JACKSON BOULEVARD, FAI 1422 OVER JOHN F. KENNEDY EXPRESSWAY, FAI 90/94 SECTION 0101-2-1B-R-1 COOK COUNTY STATION 1+350.230 STRUCTURE NO. 016-0588 DESIGNED BY J.D.G. DRAWN BY C.U. DATE 4-00 CHECKED BY J.K. CHECKED BY J.D.G.
NAME	DATE	

STV Incorporated
Engineers/Architects/Planners/Construction Managers
70 W. Madison St. Chicago, IL 60602-4207

6:38:01 PM D162331-SHT-AS-BUILT-03



USER NAME = wjcolletti	DESIGNED EH	REVISED
	CHECKED WJC	REVISED
PLOT SCALE = 0x2.0000 '1" / in.	DRAWN EH	REVISED
PLOT DATE = 8/13/2019	CHECKED WJC	REVISED

**STATE OF ILLINOIS
DEPARTMENT OF TRANSPORTATION**



EXISTING JACKSON BLVD BRIDGE PLANS (SN 016-0588)

SHEET NO. AB-03 OF AB-65 SHEETS

F.A.I. RTE.	SECTION	COUNTY	TOTAL SHEETS	SHEET NO.
90/94/290	2014-017B	COOK	400	230
CONTRACT NO. 62J31				
ILLINOIS FED. AID PROJECT				


FOR INFORMATION ONLY

F.A. RFE.	SECTION	COUNTY	TOTAL SHEETS	SHEET NO.
90/94	0101-2-1B-R-1	COOK	226	26
STA. 1+350.230 TO STA.		ILLINOIS FED. AID PROJECT		
FED. ROAD DIST. NO. 7		S-5 of 48		

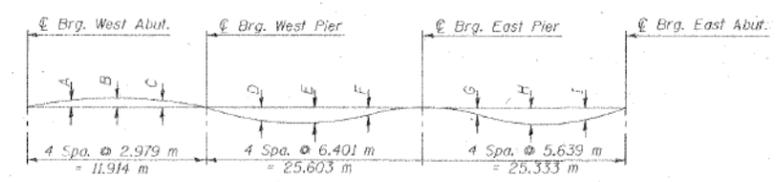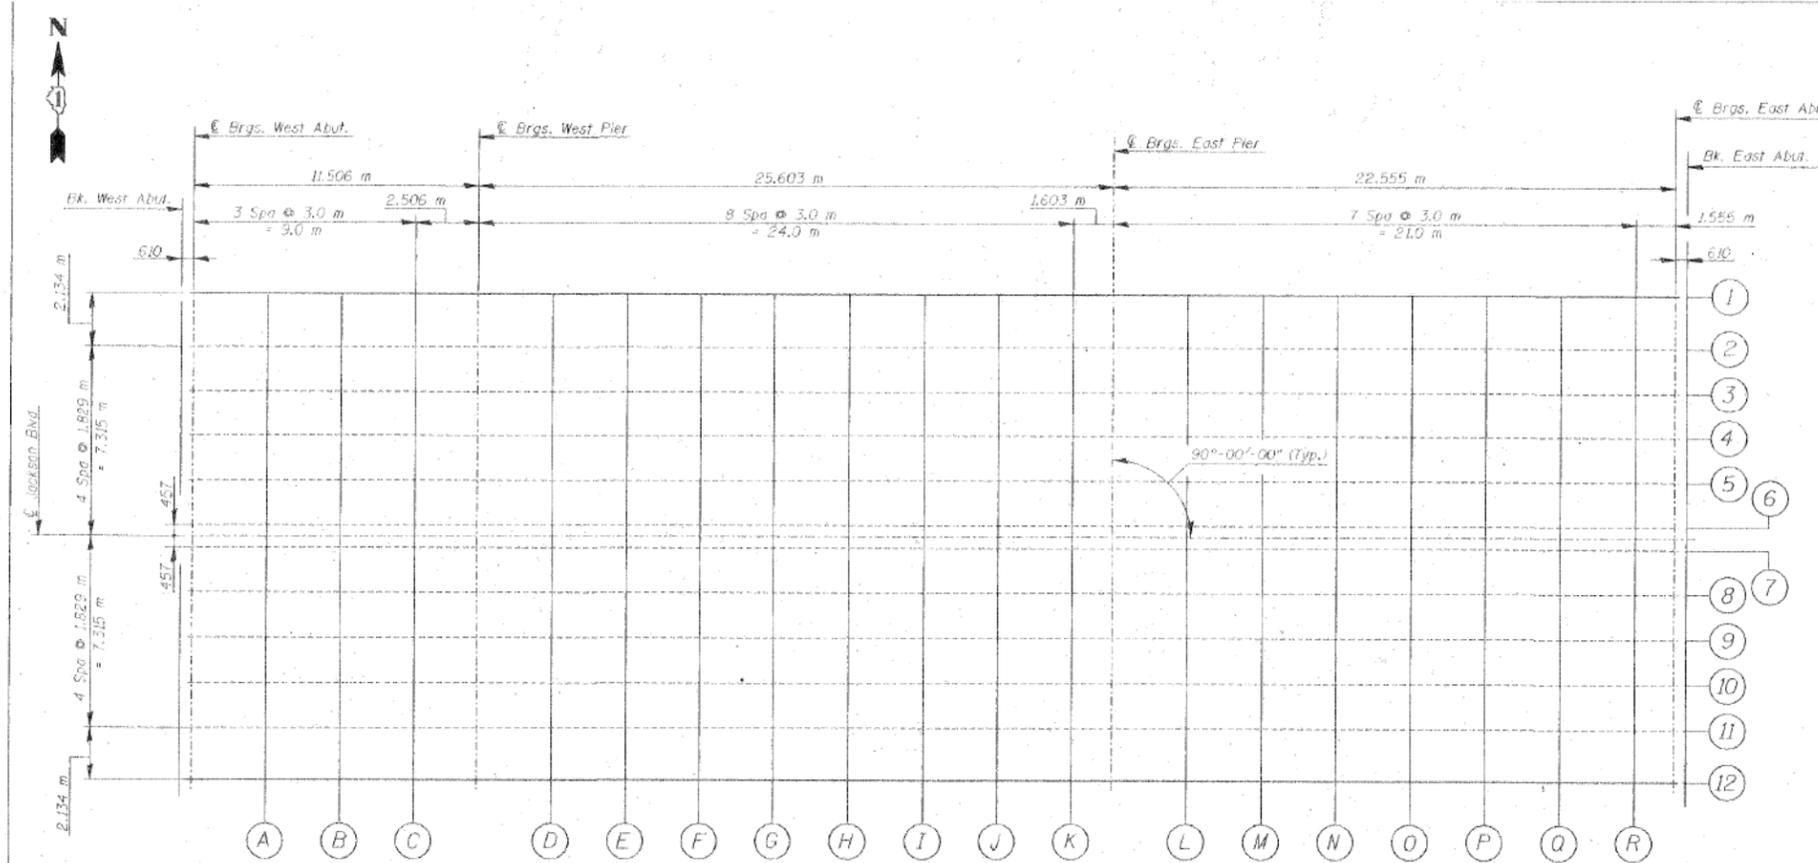


Note: The above deflections are not to be used in the field if the engineer is working from the grade elevations adjusted for dead load deflections as shown below. All dimensions are in millimeters (mm) except as noted. All offsets are in meters.

BEAM	A	B	C	D	E	F	G	H	I
Bm 1	-1	-3	-3	21	38	25	-1	6	7
Bm 2 & 11	0	-1	-2	14	20	9	8	19	16
Bm 3, 4, 5, 8, 9 & 10	-1	-1	-2	13	19	9	7	16	14
Bm 6 & 7	-1	-1	-1	11	16	8	6	14	11
Bm 12	-1	-2	-2	16	24	11	10	23	20

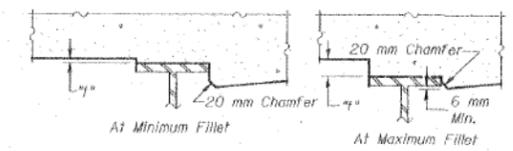

To determine "f": After all structural steel has been erected, elevations of the top flanges of the beams shall be taken at intervals shown above. These elevations subtracted from the "Theoretical Grade Elevations Adjusted for Dead Load Deflection" shown on S6 through S9, minus slab thickness, equals the fillet heights "f" above top flange of beams.

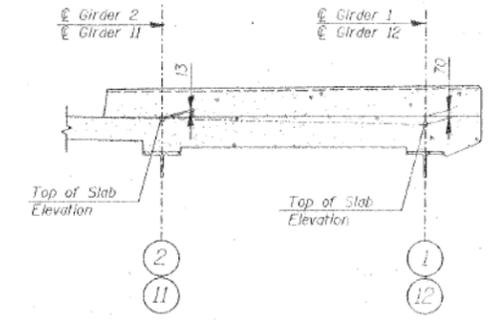

- NOTES:**
- All dimensions are in millimeters (mm) except as noted.
 - All elevations and offsets are in meters.
 - "+" Deflection is downward "-" Deflection is upward.

REVISIONS		ILLINOIS DEPARTMENT OF TRANSPORTATION TOP DECK ELEVATIONS LOCATIONS GRID AND DETAILS JACKSON BOULEVARD, FAU 1422 OVER JOHN F. KENNEDY EXPRESSWAY, FAI 90/94 SECTION 0101-2-1B-R-1 COOK COUNTY STATION 1+350.230 STRUCTURE NO. 016-0588 DESIGNED BY J.D.G. DRAWN BY: CUL.
NAME	DATE	

STV Incorporated
Engineers/Architects/Planners/Construction Managers
70 W. Madison St. Chicago, IL 60602-4207

6:38:25 PM D162331-SHT-AS-BUILT-04



USER NAME = wjcolletti	DESIGNED EH	REVISED
PLOT SCALE = 0x2.0000 '1" / in.	CHECKED WJC	REVISED
PLOT DATE = 8/13/2019	DRAWN EH	REVISED
	CHECKED WJC	REVISED

STATE OF ILLINOIS
DEPARTMENT OF TRANSPORTATION

EXISTING JACKSON BLVD BRIDGE PLANS (SN 016-0588)

SHEET NO. AB-04 OF AB-65 SHEETS

F.A.I. RFE.	SECTION	COUNTY	TOTAL SHEETS	SHEET NO.
90/94/290	2014-017B	COOK	400	231
ILLINOIS FED. AID PROJECT			CONTRACT NO. 62J31	

FOR INFORMATION ONLY

F.A.I. RTE.	SECTION	COUNTY	TOTAL SHEETS	SHEET NO.
90/94	0101-2-1B-R-1	COOK	226	23
STA. 1+350.230		TO STA.		
FED. ROAD DIST. NO. 7		ILLINOIS FED. AID PROJECT		

Beam 5

Location	Station	Offset	Theoretical Grade Elevations	Theoretical Grade Elevations Adjusted For Dead Load Deflection
Bk. of West Abut.	1+312.511	-2.286	181.646	181.646
⊕ Brg. West Abut.	1+313.121	-2.286	181.666	181.666
A	1+316.121	-2.286	181.758	181.757
B	1+319.121	-2.286	181.838	181.837
C	1+322.121	-2.286	181.905	181.904
⊕ West Pier	1+324.627	-2.286	181.951	181.951
D	1+327.627	-2.286	181.996	182.002
E	1+330.627	-2.286	182.028	182.040
F	1+333.627	-2.286	182.047	182.064
G	1+336.627	-2.286	182.055	182.074
H	1+339.627	-2.286	182.049	182.066
I	1+342.627	-2.286	182.032	182.044
J	1+345.627	-2.286	182.002	182.009
K	1+348.627	-2.286	181.959	181.960
⊕ East Pier	1+350.230	-2.286	181.932	181.932
L	1+353.230	-2.286	181.870	181.873
M	1+356.230	-2.286	181.796	181.803
N	1+359.230	-2.286	181.710	181.724
O	1+362.230	-2.286	181.612	181.628
P	1+365.230	-2.286	181.501	181.517
Q	1+368.230	-2.286	181.386	181.398
R	1+371.230	-2.286	181.272	181.276
⊕ Brgs East Abut.	1+372.785	-2.286	181.212	181.212
Bk. of East Abut.	1+373.395	-2.286	181.189	181.189

Beam 6

Location	Station	Offset	Theoretical Grade Elevations	Theoretical Grade Elevations Adjusted For Dead Load Deflection
Bk. of West Abut.	1+312.511	-0.457	181.673	181.673
⊕ Brg. West Abut.	1+313.121	-0.457	181.694	181.694
A	1+316.121	-0.457	181.786	181.785
B	1+319.121	-0.457	181.865	181.864
C	1+322.121	-0.457	181.932	181.931
⊕ West Pier	1+324.627	-0.457	181.979	181.979
D	1+327.627	-0.457	182.023	182.028
E	1+330.627	-0.457	182.055	182.065
F	1+333.627	-0.457	182.075	182.089
G	1+336.627	-0.457	182.082	182.098
H	1+339.627	-0.457	182.077	182.091
I	1+342.627	-0.457	182.059	182.069
J	1+345.627	-0.457	182.029	182.034
K	1+348.627	-0.457	181.987	181.988
⊕ East Pier	1+350.230	-0.457	181.959	181.959
L	1+353.230	-0.457	181.898	181.901
M	1+356.230	-0.457	181.824	181.830
N	1+359.230	-0.457	181.738	181.749
O	1+362.230	-0.457	181.639	181.652
P	1+365.230	-0.457	181.528	181.541
Q	1+368.230	-0.457	181.414	181.424
R	1+371.230	-0.457	181.299	181.302
⊕ Brgs East Abut.	1+372.785	-0.457	181.240	181.240
Bk. of East Abut.	1+373.395	-0.457	181.216	181.216

⊕ Jackson Blvd. & P.G.L.

Location	Station	Offset	Theoretical Grade Elevations	Theoretical Grade Elevations Adjusted For Dead Load Deflection
Bk. of West Abut.	1+312.511	0.000	181.680	181.680
⊕ Brg. West Abut.	1+313.121	0.000	181.701	181.701
A	1+316.121	0.000	181.792	181.791
B	1+319.121	0.000	181.872	181.871
C	1+322.121	0.000	181.939	181.938
⊕ West Pier	1+324.627	0.000	181.986	181.986
D	1+327.627	0.000	182.030	182.035
E	1+330.627	0.000	182.062	182.072
F	1+333.627	0.000	182.082	182.096
G	1+336.627	0.000	182.089	182.105
H	1+339.627	0.000	182.084	182.098
I	1+342.627	0.000	182.066	182.076
J	1+345.627	0.000	182.036	182.041
K	1+348.627	0.000	181.994	181.995
⊕ East Pier	1+350.230	0.000	181.966	181.966
L	1+353.230	0.000	181.905	181.908
M	1+356.230	0.000	181.831	181.837
N	1+359.230	0.000	181.745	181.756
O	1+362.230	0.000	181.646	181.659
P	1+365.230	0.000	181.535	181.548
Q	1+368.230	0.000	181.421	181.431
R	1+371.230	0.000	181.306	181.309
⊕ Brgs East Abut.	1+372.785	0.000	181.247	181.247
Bk. of East Abut.	1+373.395	0.000	181.223	181.223

All Elevations and Offsets are in Meters.
Negative Offsets are North.

Beam 7

Location	Station	Offset	Theoretical Grade Elevations	Theoretical Grade Elevations Adjusted For Dead Load Deflection
Bk. of West Abut.	1+312.511	0.457	181.673	181.673
⊕ Brg. West Abut.	1+313.121	0.457	181.694	181.694
A	1+316.121	0.457	181.786	181.785
B	1+319.121	0.457	181.865	181.864
C	1+322.121	0.457	181.932	181.931
⊕ West Pier	1+324.627	0.457	181.979	181.979
D	1+327.627	0.457	182.023	182.028
E	1+330.627	0.457	182.055	182.065
F	1+333.627	0.457	182.075	182.089
G	1+336.627	0.457	182.082	182.098
H	1+339.627	0.457	182.077	182.091
I	1+342.627	0.457	182.059	182.069
J	1+345.627	0.457	182.029	182.034
K	1+348.627	0.457	181.987	181.988
⊕ East Pier	1+350.230	0.457	181.959	181.959
L	1+353.230	0.457	181.898	181.901
M	1+356.230	0.457	181.824	181.830
N	1+359.230	0.457	181.738	181.749
O	1+362.230	0.457	181.639	181.652
P	1+365.230	0.457	181.528	181.541
Q	1+368.230	0.457	181.414	181.424
R	1+371.230	0.457	181.299	181.302
⊕ Brgs East Abut.	1+372.785	0.457	181.240	181.240
Bk. of East Abut.	1+373.395	0.457	181.216	181.216

Beam 8

Location	Station	Offset	Theoretical Grade Elevations	Theoretical Grade Elevations Adjusted For Dead Load Deflection
Bk. of West Abut.	1+312.511	2.286	181.646	181.646
⊕ Brg. West Abut.	1+313.121	2.286	181.666	181.666
A	1+316.121	2.286	181.758	181.757
B	1+319.121	2.286	181.838	181.837
C	1+322.121	2.286	181.905	181.904
⊕ West Pier	1+324.627	2.286	181.951	181.951
D	1+327.627	2.286	181.996	182.002
E	1+330.627	2.286	182.028	182.040
F	1+333.627	2.286	182.047	182.064
G	1+336.627	2.286	182.055	182.074
H	1+339.627	2.286	182.049	182.066
I	1+342.627	2.286	182.032	182.044
J	1+345.627	2.286	182.002	182.009
K	1+348.627	2.286	181.959	181.960
⊕ East Pier	1+350.230	2.286	181.932	181.932
L	1+353.230	2.286	181.870	181.873
M	1+356.230	2.286	181.796	181.803
N	1+359.230	2.286	181.710	181.724
O	1+362.230	2.286	181.612	181.628
P	1+365.230	2.286	181.501	181.517
Q	1+368.230	2.286	181.386	181.398
R	1+371.230	2.286	181.272	181.276
⊕ Brgs East Abut.	1+372.785	2.286	181.212	181.212
Bk. of East Abut.	1+373.395	2.286	181.189	181.189

All Elevations and Offsets are in Meters.
Negative Offsets are North.

Beam 9

Location	Station	Offset	Theoretical Grade Elevations	Theoretical Grade Elevations Adjusted For Dead Load Deflection
Bk. of West Abut.	1+312.511	4.115	181.616	181.616
⊕ Brg. West Abut.	1+313.121	4.115	181.636	181.636
A	1+316.121	4.115	181.728	181.727
B	1+319.121	4.115	181.808	181.807
C	1+322.121	4.115	181.875	181.874
⊕ West Pier	1+324.627	4.115	181.922	181.922
D	1+327.627	4.115	181.966	181.972
E	1+330.627	4.115	181.998	182.010
F	1+333.627	4.115	182.018	182.035
G	1+336.627	4.115	182.025	182.044
H	1+339.627	4.115	182.020	182.037
I	1+342.627	4.115	182.002	182.014
J	1+345.627	4.115	181.972	181.978
K	1+348.627	4.115	181.930	181.931
⊕ East Pier	1+350.230	4.115	181.902	181.902
L	1+353.230	4.115	181.841	181.844
M	1+356.230	4.115	181.767	181.774
N	1+359.230	4.115	181.680	181.694
O	1+362.230	4.115	181.582	181.598
P	1+365.230	4.115	181.471	181.487
Q	1+368.230	4.115	181.356	181.368
R	1+371.230	4.115	181.242	181.246
⊕ Brgs East Abut.	1+372.785	4.115	181.182	181.182
Bk. of East Abut.	1+373.395	4.115	181.159	181.159

REVISIONS	
NAME	DATE

ILLINOIS DEPARTMENT OF TRANSPORTATION
TOP DECK ELEVATIONS
JACKSON BOULEVARD
JACKSON BOULEVARD, FAU 1422 OVER
JOHN F. KENNEDY EXPRESSWAY, FAI 90/94
SECTION 0101-2-1B-R-1 COOK COUNTY
STATION 1+350.230 STRUCTURE NO. 016-0588
DESIGNED BY J.D.G. DRAWN BY C.U.
DATE 4-00 CHECKED BY T.K. CHECKED BY J.D.G.

STV Incorporated
Engineers/Architects/Planners/Construction Managers
70 W. Madison St., Chicago, IL 60602-4207

6/3/2016 PM 0162331-SHT-AS-BUILT-06



USER NAME = wjcolletti	DESIGNED EH	REVISED
	CHECKED WJC	REVISED
PLOT SCALE = 0x2.0000 '1" / in.	DRAWN EH	REVISED
PLOT DATE = 8/13/2019	CHECKED WJC	REVISED

**STATE OF ILLINOIS
DEPARTMENT OF TRANSPORTATION**

EXISTING JACKSON BLVD BRIDGE PLANS (SN 016-0588)

SHEET NO. AB-06 OF AB-65 SHEETS

F.A.I. RTE.	SECTION	COUNTY	TOTAL SHEETS	SHEET NO.
90/94/290	2014-017B	COOK	400	233
CONTRACT NO. 62J31				
ILLINOIS FED. AID PROJECT				

FOR INFORMATION ONLY

F.A.I. RTE.	SECTION	COUNTY	TOTAL SHEETS	SHEET NO.
90/94	0101-2-1B-R-1	COOK	229	29
STA. 1+350.230		TO STA.		
FED. ROAD DIST. NO. 7		ILLINOIS FED. AID PROJECT		

5-8 of 49

Beam 10

Location	Station	Offset	Theoretical Grade Elevations	Theoretical Grade Elevations Adjusted For Dead Load Deflection
Bk. of West Abut.	1+312.511	5.944	181.580	181.580
⊕ Brg. West Abut.	1+313.121	5.944	181.600	181.600
A	1+316.121	5.944	181.692	181.691
B	1+319.121	5.944	181.771	181.770
C	1+322.121	5.944	181.839	181.838
⊕ West Pier	1+324.627	5.944	181.885	181.885
D	1+327.627	5.944	181.930	181.936
E	1+330.627	5.944	181.962	181.974
F	1+333.627	5.944	181.981	181.998
G	1+336.627	5.944	181.988	182.007
H	1+339.627	5.944	181.983	182.000
I	1+342.627	5.944	181.966	181.978
J	1+345.627	5.944	181.936	181.942
K	1+348.627	5.944	181.893	181.894
⊕ East Pier	1+350.230	5.944	181.865	181.865
L	1+353.230	5.944	181.804	181.807
M	1+356.230	5.944	181.730	181.737
N	1+359.230	5.944	181.644	181.658
O	1+362.230	5.944	181.545	181.561
P	1+365.230	5.944	181.435	181.451
Q	1+368.230	5.944	181.320	181.332
R	1+371.230	5.944	181.205	181.209
⊕ Brgs East Abut.	1+372.785	5.944	181.146	181.146
Bk. of East Abut.	1+373.395	5.944	181.123	181.123

Beam 11

Location	Station	Offset	Theoretical Grade Elevations	Theoretical Grade Elevations Adjusted For Dead Load Deflection
Bk. of West Abut.	1+312.511	7.773	181.543	181.543
⊕ Brg. West Abut.	1+313.121	7.773	181.563	181.563
A	1+316.121	7.773	181.655	181.654
B	1+319.121	7.773	181.735	181.734
C	1+322.121	7.773	181.802	181.801
⊕ West Pier	1+324.627	7.773	181.849	181.849
D	1+327.627	7.773	181.893	181.899
E	1+330.627	7.773	181.925	181.938
F	1+333.627	7.773	181.945	181.963
G	1+336.627	7.773	181.952	181.971
H	1+339.627	7.773	181.947	181.964
I	1+342.627	7.773	181.929	181.940
J	1+345.627	7.773	181.899	181.905
K	1+348.627	7.773	181.857	181.858
⊕ East Pier	1+350.230	7.773	181.829	181.829
L	1+353.230	7.773	181.767	181.770
M	1+356.230	7.773	181.694	181.702
N	1+359.230	7.773	181.607	181.623
O	1+362.230	7.773	181.509	181.528
P	1+365.230	7.773	181.398	181.416
Q	1+368.230	7.773	181.283	181.297
R	1+371.230	7.773	181.169	181.174
⊕ Brgs East Abut.	1+372.785	7.773	181.109	181.109
Bk. of East Abut.	1+373.395	7.773	181.086	181.086

Beam 12

Location	Station	Offset	Theoretical Grade Elevations	Theoretical Grade Elevations Adjusted For Dead Load Deflection
Bk. of West Abut.	1+312.511	9.907	181.500	181.500
⊕ Brg. West Abut.	1+313.121	9.907	181.521	181.521
A	1+316.121	9.907	181.613	181.612
B	1+319.121	9.907	181.692	181.690
C	1+322.121	9.907	181.759	181.757
⊕ West Pier	1+324.627	9.907	181.806	181.806
D	1+327.627	9.907	181.850	181.857
E	1+330.627	9.907	181.882	181.898
F	1+333.627	9.907	181.902	181.923
G	1+336.627	9.907	181.909	181.933
H	1+339.627	9.907	181.904	181.925
I	1+342.627	9.907	181.886	181.900
J	1+345.627	9.907	181.856	181.862
K	1+348.627	9.907	181.814	181.815
⊕ East Pier	1+350.230	9.907	181.786	181.786
L	1+353.230	9.907	181.725	181.729
M	1+356.230	9.907	181.651	181.662
N	1+362.230	9.907	181.565	181.584
O	1+362.230	9.907	181.466	181.489
P	1+365.230	9.907	181.355	181.378
Q	1+368.230	9.907	181.241	181.258
R	1+371.230	9.907	181.126	181.132
⊕ Brgs East Abut.	1+372.785	9.907	181.067	181.067
Bk. of East Abut.	1+373.395	9.907	181.043	181.043

REVISIONS	
NAME	DATE

ILLINOIS DEPARTMENT OF TRANSPORTATION
TOP DECK ELEVATIONS
JACKSON BOULEVARD
JACKSON BOULEVARD, FAU 1422 OVER
JOHN F. KENNEDY EXPRESSWAY, FAI 90/94
SECTION 0101-2-1B-R-1 COOK COUNTY
STATION 1+350.230 STRUCTURE NO. 016-0588
DESIGNED BY J.D.G. DRAWN BY C.J.L.
DATE 4-00 CHECKED BY I.K. CHECKED BY J.D.G.

STV Incorporated
Engineers/Architects/Planners/Construction Managers
70 W. Madison St. Chicago, IL 60602-4207

6:39:42 PM D162J31-SHT-AS-BUILT-07



USER NAME = wjcollett1	DESIGNED EH	REVISED
	CHECKED WJC	REVISED
PLOT SCALE = 0x2.0000 '1" / in.	DRAWN EH	REVISED
PLOT DATE = 8/13/2019	CHECKED WJC	REVISED

**STATE OF ILLINOIS
DEPARTMENT OF TRANSPORTATION**


EXISTING JACKSON BLVD BRIDGE PLANS (SN 016-0588)

SHEET NO. AB-07 OF AB-65 SHEETS


F.A.I. RTE.	SECTION	COUNTY	TOTAL SHEETS	SHEET NO.
90/94/290	2014-017B	COOK	400	234
				CONTRACT NO. 62J31
ILLINOIS FED. AID PROJECT				

FOR INFORMATION ONLY

F.A.I. RTE.	SECTION	COUNTY	TOTAL SHEETS	SHEET NO.
90/94	0101-2-1B-R-1	COOK	226	30
STA. 1+350.230		TO STA.		
FED. ROAD DIST. NO.		ILLINOIS FED. AID PROJECT		
5-9 of 49				

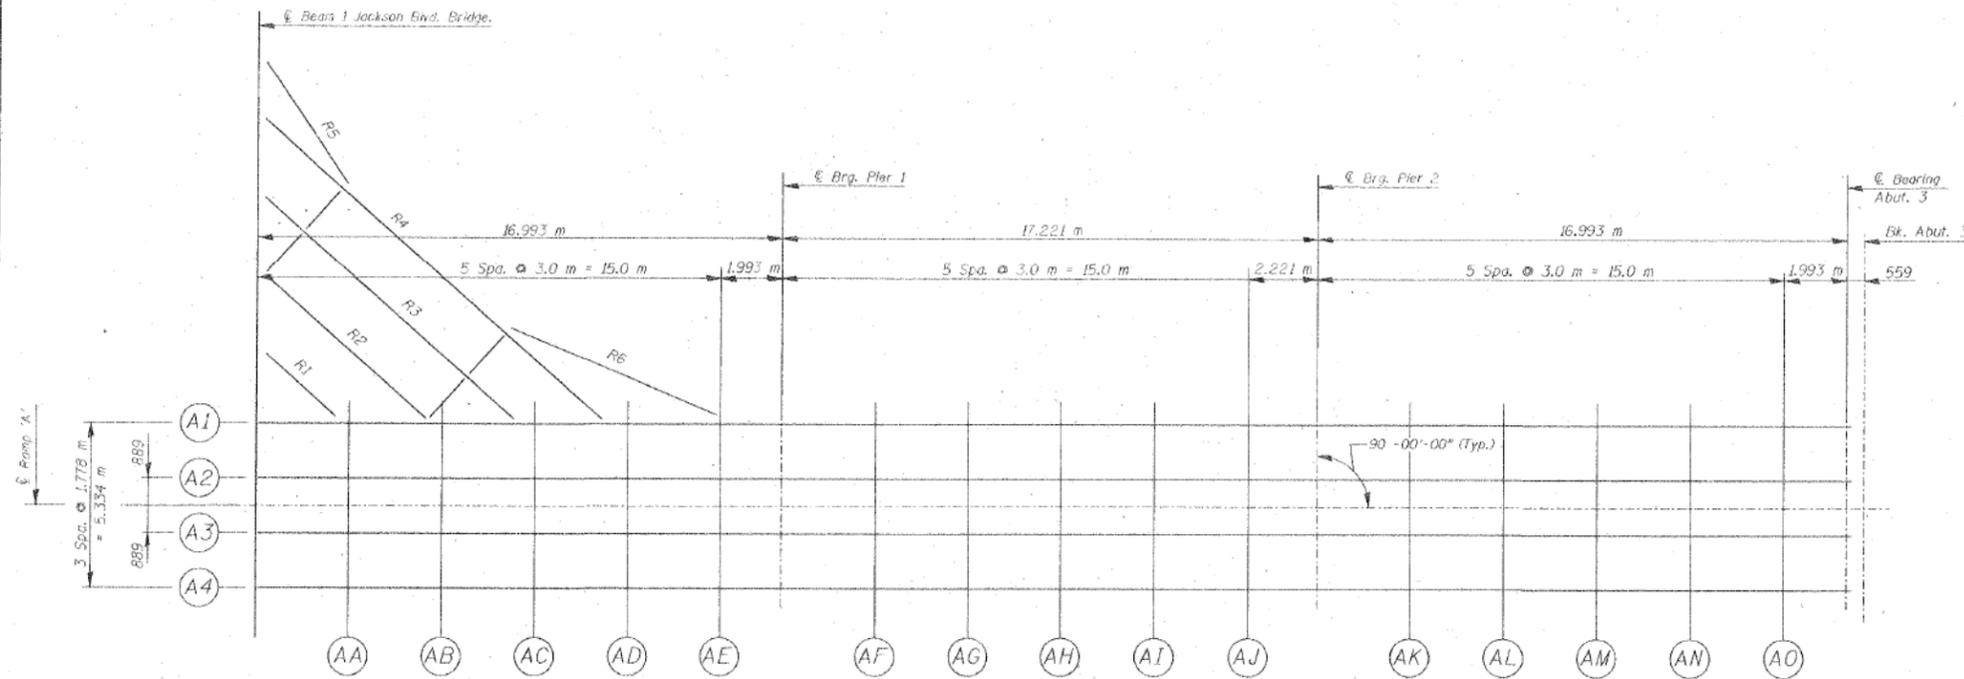

See sheet S12 for location grid and dead load deflection diagram for beams R1 - R6

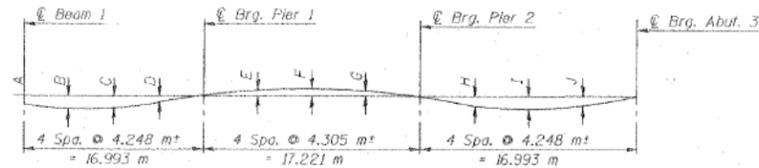


DEAD LOAD DEFLECTION DIAGRAM

(Includes weight of concrete only)
 Note: The above deflections are not to be used in the field if the engineer is working from the grade elevations adjusted for dead load deflections as shown below. Dead Load Deflection Diagrams include Deflections from Beam 1 which effects the deflection of each Beam. All dimensions are in millimeters (mm) except as noted. All offsets are in meters.

BEAM	A	B	C	D	E	F	G	H	I	J
A1	6	42	53	32	-7	-6	-3	8	13	10
A2	2	22	27	15	0	3	0	15	28	21
A3	-1	20	26	14	0	3	0	15	28	21
A4	-3	19	25	15	0	3	0	15	28	21

Note: Negative ("") Deflections are upward

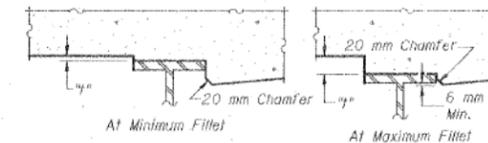

To determine "f": After all structural steel has been erected, elevations of the top flanges of the beams shall be taken at intervals shown above. These elevations subtracted from the "Theoretical Grade Elevations Adjusted for Dead Load Deflection" shown below, minus slab thickness, equals the fillet heights "f" above top flange of beams.

FILLET HEIGHTS

REVISIONS		ILLINOIS DEPARTMENT OF TRANSPORTATION TOP DECK ELEVATIONS LOCATIONS GRID AND DETAILS RAMP "A" JACKSON BOULEVARD, FAU 1422 OVER JOHN F. KENNEDY EXPRESSWAY, FAU 90/94 SECTION 0101-2-1B-R-1 COOK COUNTY STATION 1+350.230 STRUCTURE NO. 016-0588 DESIGNED BY J.O.G. DRAWN BY C.U.L.
NAME	DATE	
		DATE 4-00 CHECKED BY I.X. CHECKED BY J.O.G.

STV Incorporated
 Engineers/Architects/Planners/Construction Managers
 70 W. Madison St. Chicago, IL 60602-4207

6:40:05 PM D162331-SHT-AS-BUILT-08



USER NAME = wjcolletti	DESIGNED EH	REVISED
PLOT SCALE = 0x2.0000 '1" / in.	CHECKED WJC	REVISED
PLOT DATE = 8/13/2019	DRAWN EH	REVISED
	CHECKED WJC	REVISED

**STATE OF ILLINOIS
DEPARTMENT OF TRANSPORTATION**


EXISTING JACKSON BLVD BRIDGE PLANS (SN 016-0588)

SHEET NO. AB-08 OF AB-65 SHEETS


F.A.I. RTE.	SECTION	COUNTY	TOTAL SHEETS	SHEET NO.
90/94/290	2014-017B	COOK	400	235
				CONTRACT NO. 62J31
ILLINOIS FED. AID PROJECT				

FOR INFORMATION ONLY

F.A.I. RTE.	SECTION	COUNTY	TOTAL SHEETS NO.	SHEET NO.
90/94	0101-2-1B-R-1	COOK	226	32
STA. 1+350.230		TO STA.		
ILLINOIS FED. AID PROJECT				

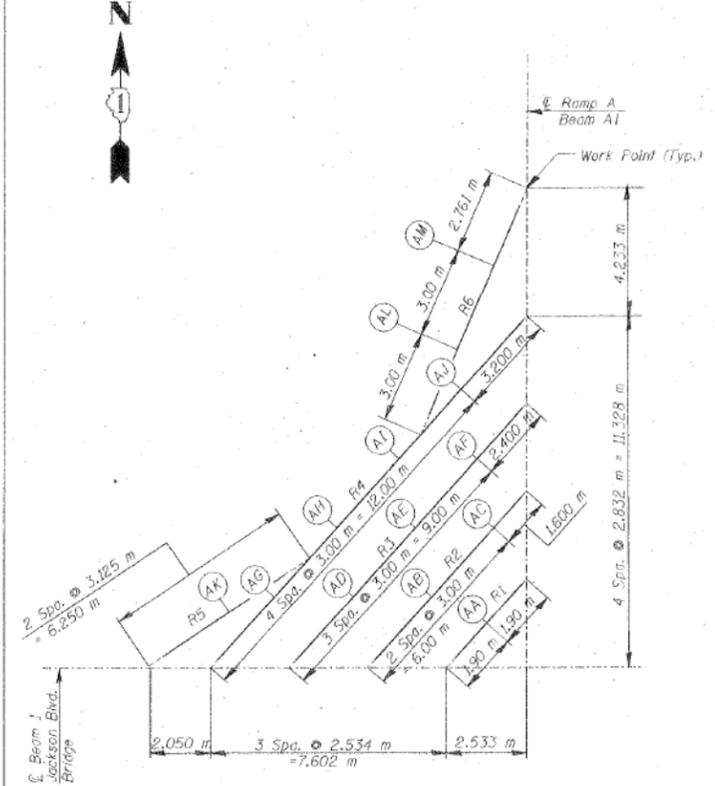


KEY PLAN

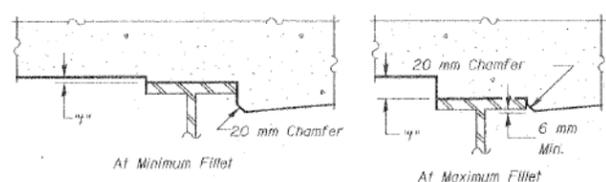

To determine "f": After all structural steel has been erected, elevations of the top flanges of the beams shall be taken at locations shown above. These elevations subtracted from the "Theoretical Grade Elevations Adjusted For Dead Load Deflection" shown below, minus slab thickness, equals the fillet heights "f" above top flange of beams.

FILLET HEIGHTS

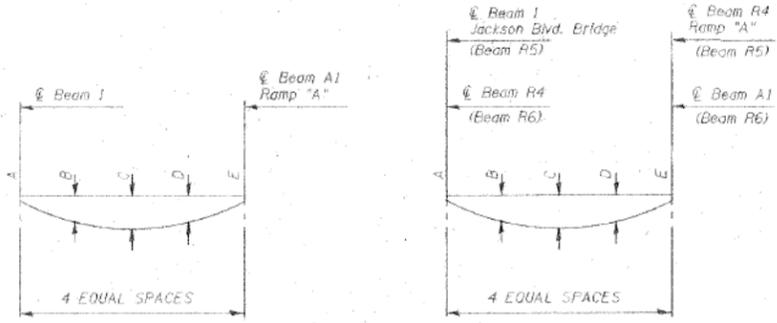

BEAMS R1 - R4 BEAMS R5 & R6

DEAD LOAD DEFLECTION DIAGRAM

(Includes weight of concrete only)

Notes: The above deflections are not to be used in the field if the engineer is working from the grade elevations adjusted for dead load deflections as shown below. All dimensions are in millimeters (mm) except as noted. All offsets are in meters.

BEAM	A	B	C	D	E
R1	10	16	21	26	31
R2	14	25	34	42	49
R3	16	34	46	52	53
R4	16	64	85	75	42
R5	15	30	44	58	71
R6	80	66	44	30	10

BEAM R1

Location	Station	Offset	Theoretical Grade Elevations	Theoretical Grade Elevations Adjusted For Dead Load Deflection
CL Beam 1	2+039.596	-5.201	181.853	181.868
AA	2+041.012	-3.934	181.903	181.825
CL Beam A1	2+042.428	-2.667	181.754	181.778

BEAM R2

Location	Station	Offset	Theoretical Grade Elevations	Theoretical Grade Elevations Adjusted For Dead Load Deflection
CL Beam 1	2+039.596	-7.736	181.878	181.890
AB	2+041.832	-5.735	181.797	181.825
AC	2+044.067	-3.735	181.717	181.750
CL Beam A1	2+045.260	-2.667	181.673	181.708

BEAM R3

Location	Station	Offset	Theoretical Grade Elevations	Theoretical Grade Elevations Adjusted For Dead Load Deflection
CL Beam 1	2+039.596	-10.270	181.893	181.904
AD	2+041.832	-8.269	181.814	181.840
AE	2+044.067	-6.269	181.735	181.778
AF	2+046.303	-4.268	181.654	181.697
CL Beam A1	2+048.092	-2.667	181.590	181.624

BEAM R4

Location	Station	Offset	Theoretical Grade Elevations	Theoretical Grade Elevations Adjusted For Dead Load Deflection
CL Beam 1	2+039.596	-12.804	181.899	181.909
AG	2+041.832	-10.804	181.824	181.858
AH	2+044.067	-8.803	181.750	181.796
AI	2+046.303	-6.802	181.672	181.744
AJ	2+048.538	-4.802	181.592	181.634
CL Beam A1	2+050.924	-2.667	181.505	181.528

BEAM R5

Location	Station	Offset	Theoretical Grade Elevations	Theoretical Grade Elevations Adjusted For Dead Load Deflection
CL Beam 1	2+039.596	-14.854	181.897	181.906
AK	2+041.345	-12.267	181.842	181.873
CL Beam R4	2+043.094	-9.674	181.782	181.823

BEAM R6

Location	Station	Offset	Theoretical Grade Elevations	Theoretical Grade Elevations Adjusted For Dead Load Deflection
CL Beam R4	2+047.094	-6.094	181.644	181.705
AL	2+049.855	-4.921	181.554	181.590
AM	2+052.616	-3.747	181.455	181.474
CL Beam A1	2+055.157	2.667	181.345	181.383

REVISIONS		ILLINOIS DEPARTMENT OF TRANSPORTATION TOP OF DECK ELEVATIONS LOCATIONS GRID & DETAILS RADIUS IMPROVEMENT - RAMP "A" JACKSON BOULEVARD, FAU 1422 OVER JOHN F. KENNEDY EXPRESSWAY, FAI 90/94 SECTION 0101-2-1B-R-1 COOK COUNTY STATION 1+350.230 STRUCTURE NO. 016-0588 DESIGNED BY J.D.G. DRAWN BY C.U. DATE 4-00 CHECKED BY I.K. CHECKED BY J.D.G.
NAME	DATE	

STV Incorporated
Engineers/Architects/Planners/Construction Managers
70 W. Madison St. Chicago, IL 60602-4207

6:40:51 PM
D162331-SHT-AS-BUILT-10



USER NAME = wjcolletti	DESIGNED EH	REVISED
	CHECKED WJC	REVISED
PLOT SCALE = 0x2.0000 '1" / in.	DRAWN EH	REVISED
PLOT DATE = 8/13/2019	CHECKED WJC	REVISED

STATE OF ILLINOIS
DEPARTMENT OF TRANSPORTATION


EXISTING JACKSON BLVD BRIDGE PLANS (SN 016-0588)

SHEET NO. AB-10 OF AB-65 SHEETS

F.A.I. RTE.	SECTION	COUNTY	TOTAL SHEETS	SHEET NO.
90/94/290	2014-017B	COOK	400	237
CONTRACT NO. 62J31				
ILLINOIS FED. AID PROJECT				


FOR INFORMATION ONLY

F.A. R.T.E.	SECTION	COUNTY	TOTAL SHEETS	SHEET NO.
90/94	0101-2-1B-R-1	COOK	226	33
STA. 1+350.230	TO STA.			
FED. ROAD DIST. NO.	ILLINOIS	FED. AID PROJECT	S-12 of 49	

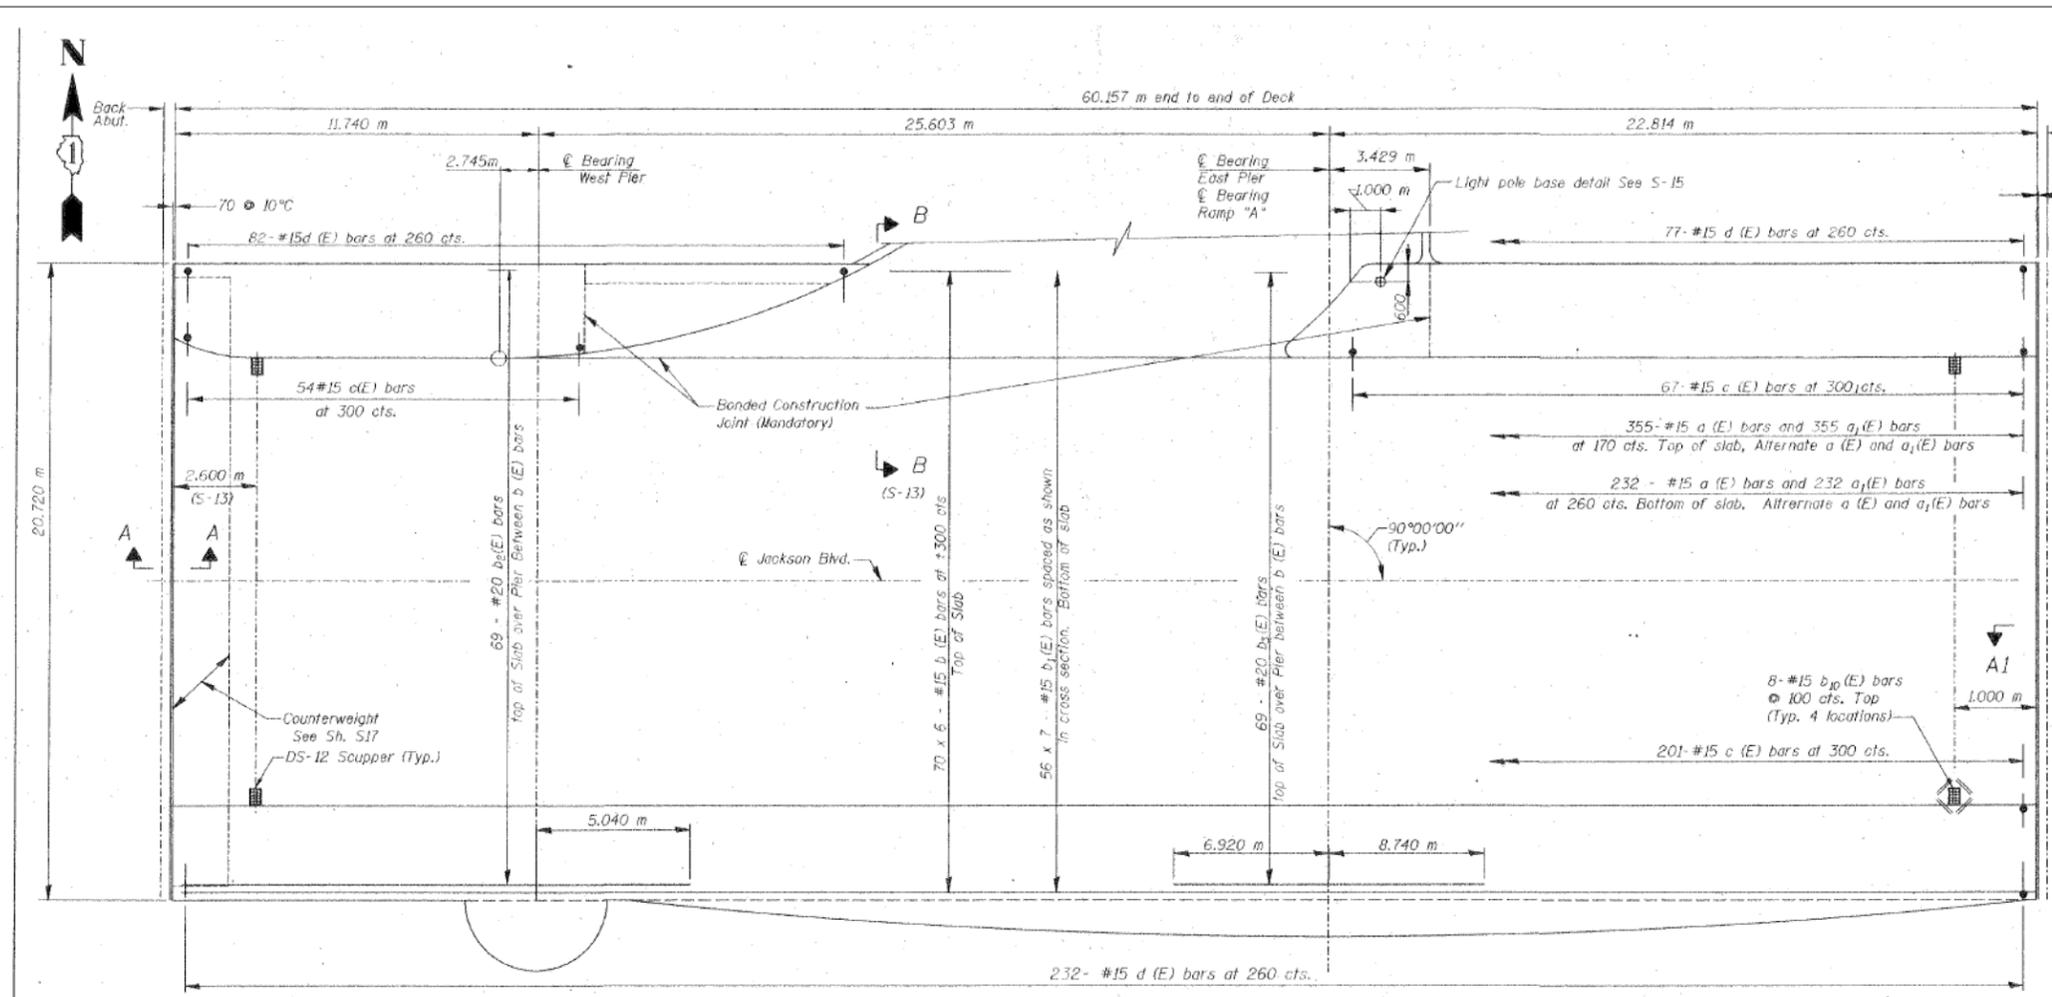

PLAN

Showing Deck Reinforcement Only

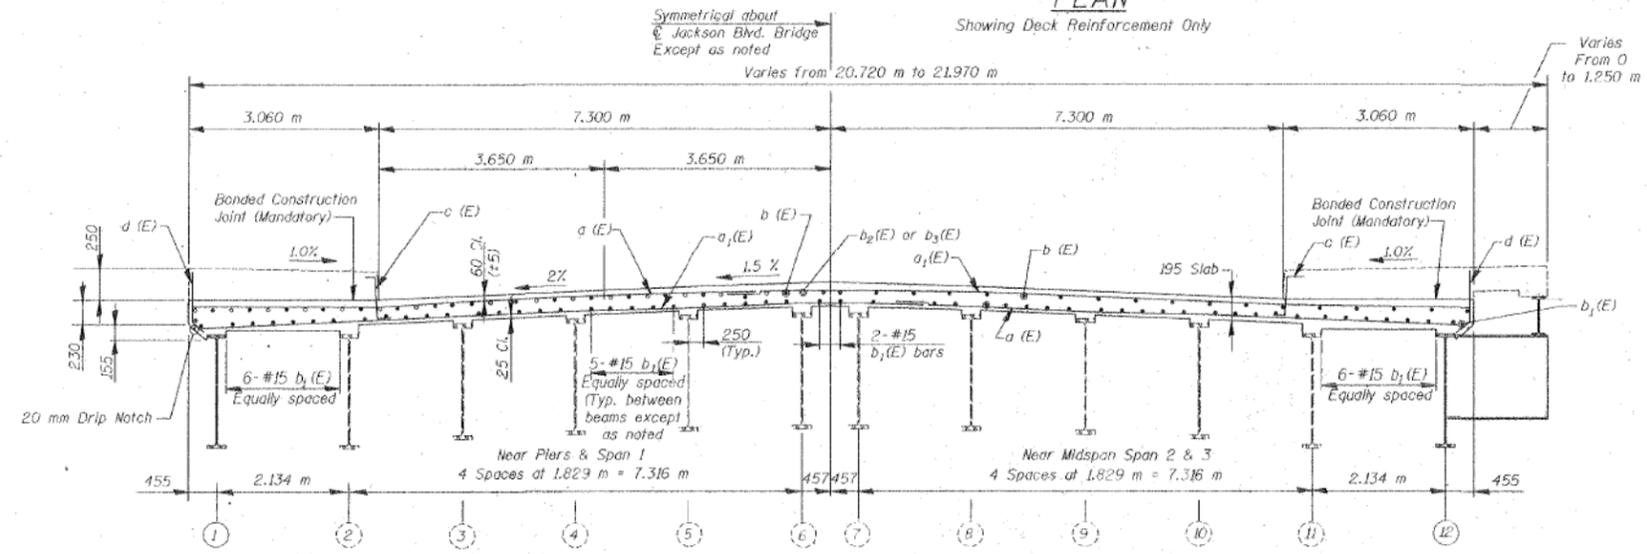

TYPICAL CROSS SECTION

(Looking East)

DECK GENERAL NOTES:

- All dimensions are in millimeters (mm) unless otherwise noted.
- Reinforcement bars designated (E) shall be epoxy coated.
- Bars indicated thus: 1x2-#15 etc., indicates 1 line of bars with 2 lengths per line.
- Typical splice length for #15 bars to be 640 mm min. and #20 790 mm min. unless otherwise noted.
- All exposed edges shall have 20 mm chamfers unless otherwise noted.
- Work this Sheet with electrical and architectural drawings for additional embedded items (conduits, etc.).

NOTES:

- For Bill of Material, see Sheet S-16.
- For Sidewalk reinforcement see Sheet S-14 and S-15.
- For details of attaching fascia panel & railing, see Architectural Sheets.
- For Expansion Joint Details see Sheet S-13.
- See Sheet S-16 for counterweight concrete plan & details.
- See Sheet S13 for Sections and details.
- For Scupper details see Sheet S-31.

3/01

REVISIONS		ILLINOIS DEPARTMENT OF TRANSPORTATION BRIDGE DECK PLAN AND CROSS SECTION JACKSON BOULEVARD, FAU 1422 OVER JOHN F. KENNEDY EXPRESSWAY, FAI 90/94 SECTION 0101-2-1B-R-1 COOK COUNTY STATION 1+350.230 STRUCTURE NO. 016-0588 DESIGNED BY J.D.G. DRAWN BY C.U.
NAME	DATE	
		DATE 4-00 CHECKED BY I.K. CHECKED BY J.D.G.

STV Incorporated
Engineers/Architects/Planners/Construction Managers
70 W. Madison St. Chicago, IL 60602-4207

6/4/16 PM D162331-SHT-AS-BUILT-11



USER NAME = wjcollett1	DESIGNED EH	REVISED
PLOT SCALE = 0x2.0000 'x' / in.	CHECKED WJC	REVISED
PLOT DATE = 8/13/2019	DRAWN EH	REVISED
	CHECKED WJC	REVISED

STATE OF ILLINOIS
DEPARTMENT OF TRANSPORTATION








EXISTING JACKSON BLVD BRIDGE PLANS (SN 016-0588)

SHEET NO. AB-11 OF AB-65 SHEETS

F.A.I. R.T.E.	SECTION	COUNTY	TOTAL SHEETS	SHEET NO.
90/94/290	2014-017B	COOK	400	238
				CONTRACT NO. 62J31
ILLINOIS FED. AID PROJECT				

FOR INFORMATION ONLY

F.A.I. RTE.	SECTION	COUNTY	TOTAL SHEETS	SHEET NO.
90/94	0101-2-1B-R-1	COOK	226	34
STA. 1+350.230 TO STA.				
FED. ROAD DIST. NO.		ILLINOIS FED. AID PROJECT		
		5-13 of 49		

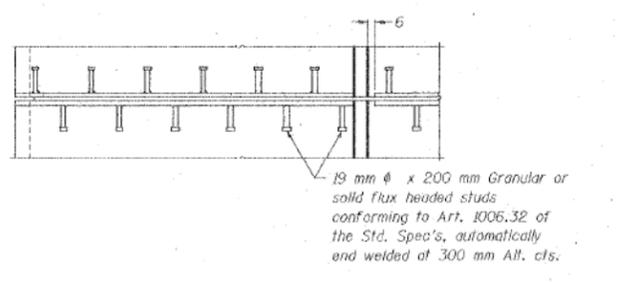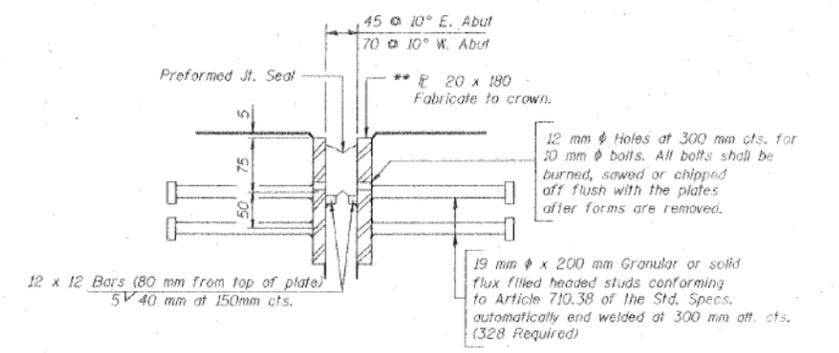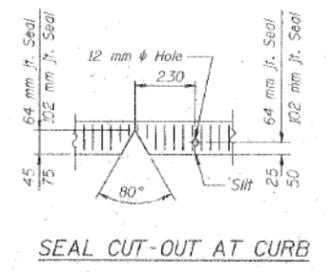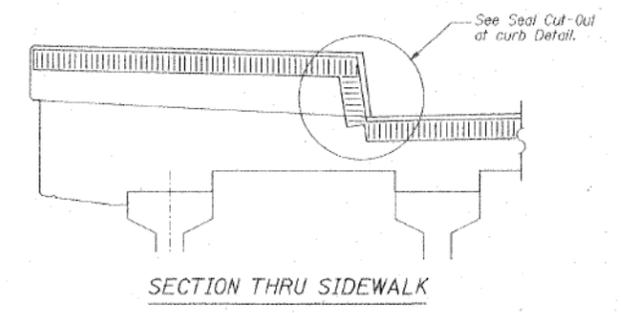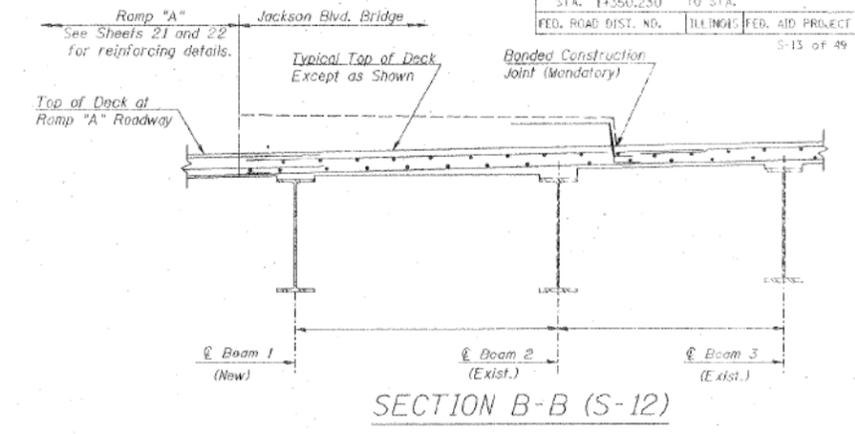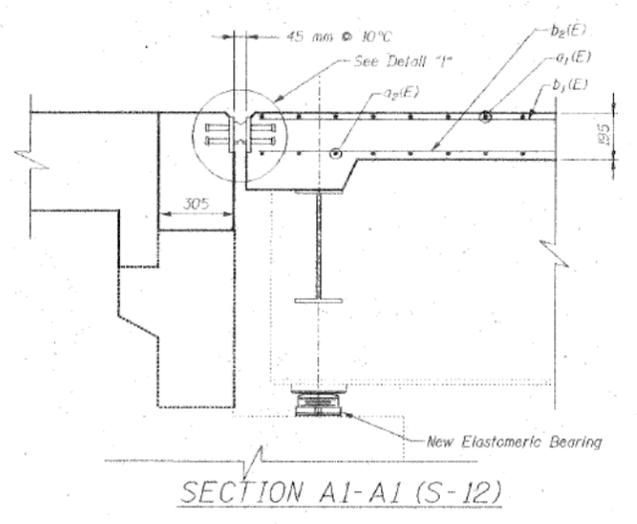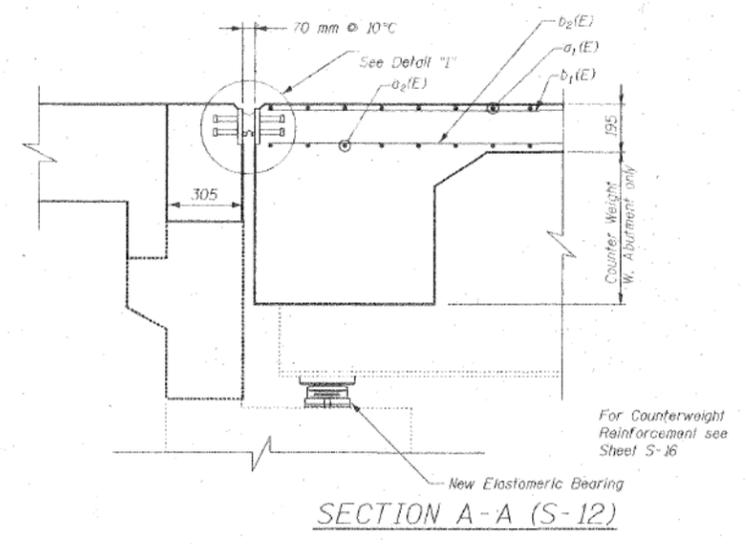

REVISIONS		ILLINOIS DEPARTMENT OF TRANSPORTATION BRIDGE DECK DETAILS JACKSON BOULEVARD, FAU 1422 OVER JOHN F. KENNEDY EXPRESSWAY, FAI 90/94 SECTION 0101-2-1B-R-1 COOK COUNTY STATION 1+350.230 STRUCTURE NO. 016-0588 DESIGNED BY J.D.G. DRAWN BY C.U.
NAME	DATE	
		DATE 4-00 CHECKED BY L.W. CHECKED BY J.D.G.

STV Incorporated
Engineers/Architects/Planners/Construction Managers
70 W. Madison St. Chicago, IL 60602-4207

STATE OF ILLINOIS
DEPARTMENT OF TRANSPORTATION

EXISTING JACKSON BLVD BRIDGE PLANS (SN 016-0588)

F.A.I. RTE.	SECTION	COUNTY	TOTAL SHEETS	SHEET NO.
90/94/290	2014-017B	COOK	400	239
				CONTRACT NO. 62J31
ILLINOIS FED. AID PROJECT				

SHEET NO. AB-12 OF AB-65 SHEETS


6:41:42 PM D:\6231-SHT-AS-BUILT-12



USER NAME = wjcolletti	DESIGNED EH	REVISED
	CHECKED WJC	REVISED
PLOT SCALE = 0x2.0000 '1" / in.	DRAWN EH	REVISED
PLOT DATE = 8/13/2019	CHECKED WJC	REVISED

FOR INFORMATION ONLY

F.A. RTE.	SECTION	COUNTY	TOTAL SHEETS	SHEET NO.
90/94	0101-2-1B-R-1	COOK	226	35
STA. 1+350.230 TO STA.		ILLINOIS FED. AID PROJECT		
FED. ROAD DIST. NO. 7		5-14 of 49		

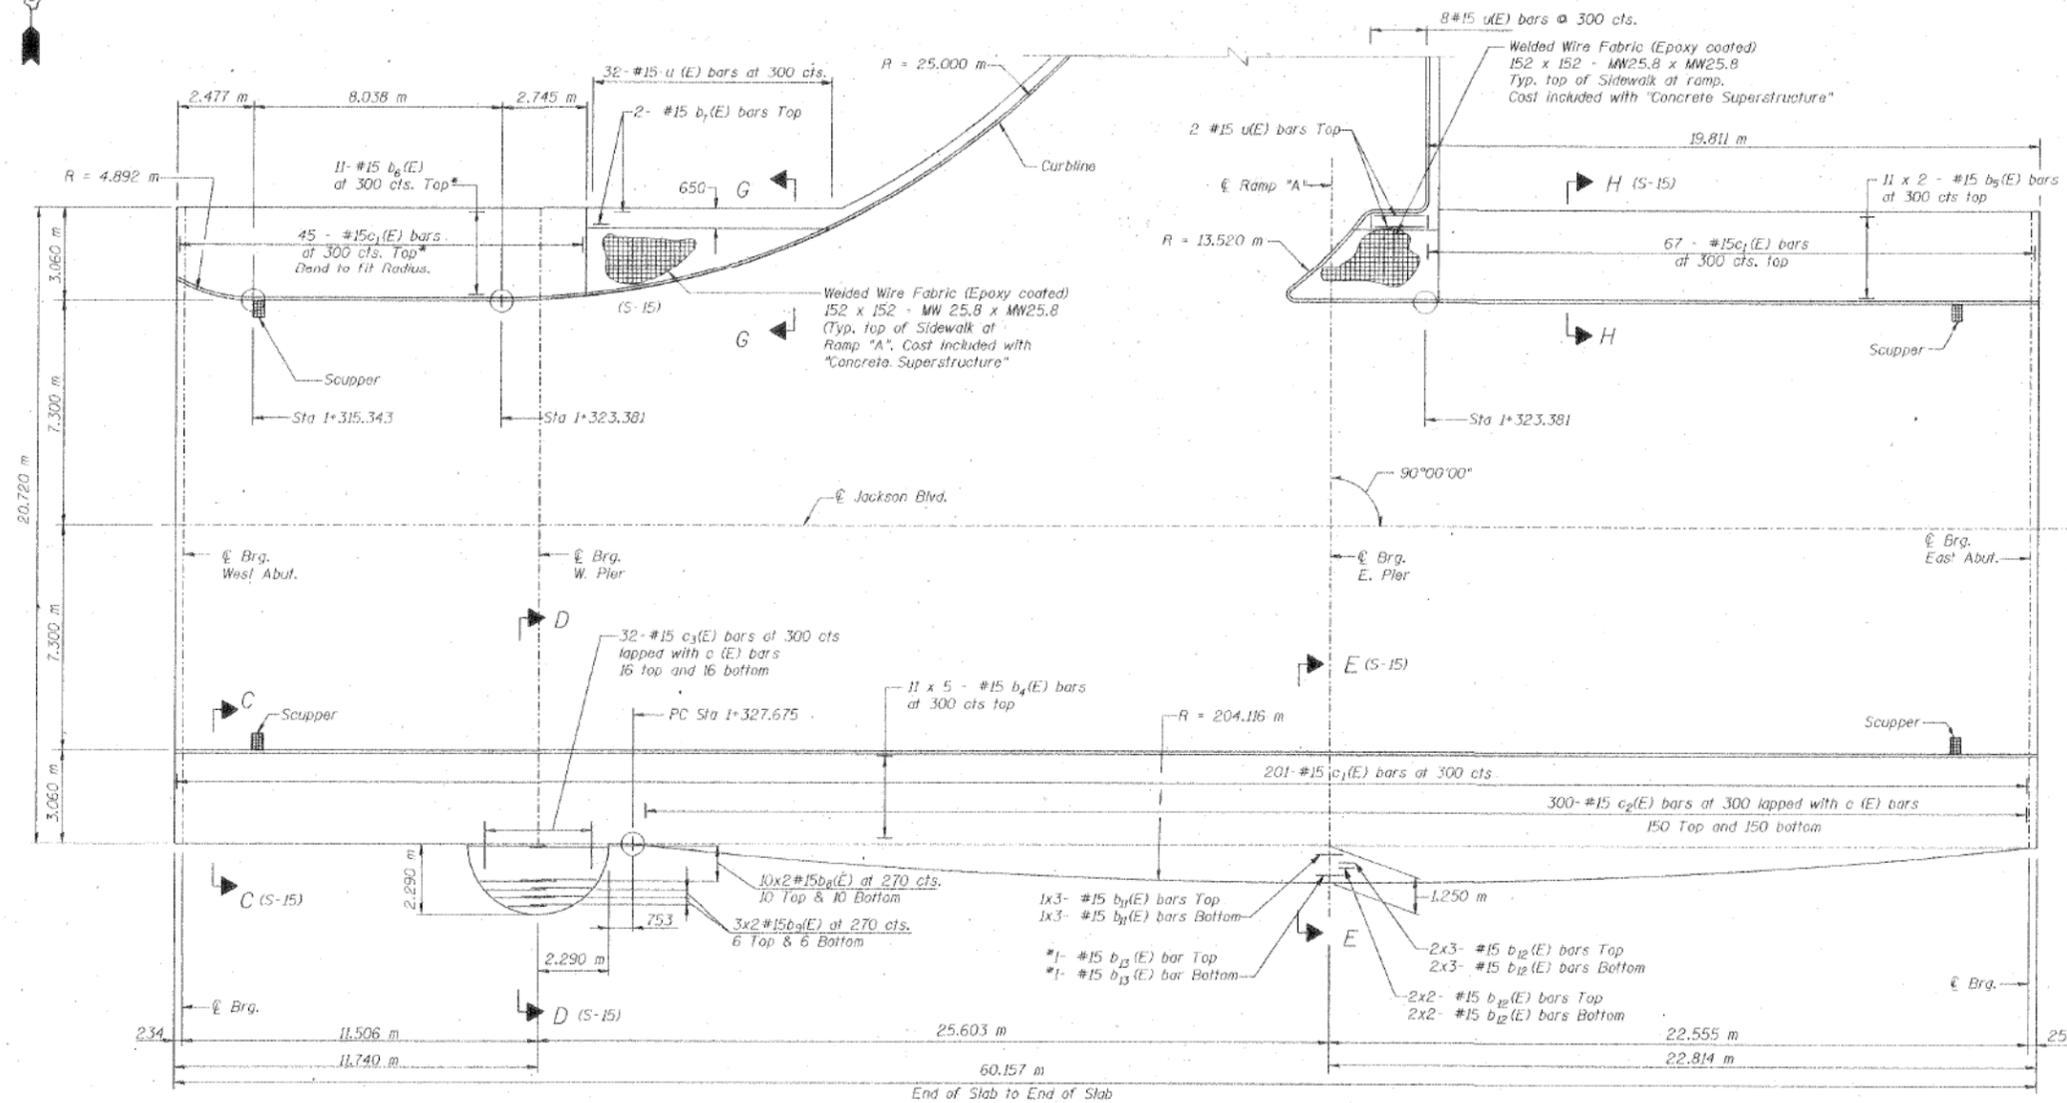

NOTES:

1. Work this sheet with Sheet S-12
2. See "Deck General Notes" on Sheet S-12
3. For total bill of material, see Sheet S-4.
4. For deck reinforcement, see Sheet S-12
5. For details of attaching fascia panel & railing, see Architectural Sheets.
6. For expansion joint details see Sheet S-13
7. For curb line geometry and details, see Sheet S-1.
8. 20 mm Deep Sawcut joint in sidewalk, locations shown in Architectural Sheets.
9. Minimum splice length for welded wire fabric shall be 300 mm.
10. See Sheet S-12 for Scupper Locations, sections and details.

PLAN

Showing Sidewalk Reinforcement

* Bend bars in field to fit curb curve.

Minimum Lap length

#15 640 mm

REVISIONS		NAME	DATE
NO.	DESCRIPTION		

ILLINOIS DEPARTMENT OF TRANSPORTATION
 BRIDGE SIDEWALK PLAN & DETAILS
 JACKSON BOULEVARD, FAU 1422 OVER
 JOHN F. KENNEDY EXPRESSWAY, FAI 90/94
 SECTION 0101-2-1B-R-1 COOK COUNTY
 STATION 1+350.230 STRUCTURE NO. 016-0588
 DESIGNED BY J.D.G. DRAWN BY C.J.
 DATE 4-00 CHECKED BY J.K. CHECKED BY J.D.G.

STV Incorporated
 Engineers/Architects/Planners/Construction Managers
 70 W. Madison St. Chicago, IL 60602-4207

6:42:05 PM
 D162331-SHT-AS-BUILT-13



USER NAME = wjcolletti	DESIGNED EH	REVISED
PLOT SCALE = 0x2.0000 '1" / in.	CHECKED WJC	REVISED
PLOT DATE = 8/13/2019	DRAWN EH	REVISED
	CHECKED WJC	REVISED

STATE OF ILLINOIS
 DEPARTMENT OF TRANSPORTATION




EXISTING JACKSON BLVD BRIDGE PLANS (SN 016-0588)

SHEET NO. AB-13 OF AB-65 SHEETS

F.A.I. RTE.	SECTION	COUNTY	TOTAL SHEETS	SHEET NO.
90/94/290	2014-017B	COOK	400	240
				CONTRACT NO. 62J31
ILLINOIS FED. AID PROJECT				

FOR INFORMATION ONLY

RTE.	SECTION	COUNTY	SHEETS	NO.
90/94	0101-2-1B-R-1	COOK	226	96
STA.	1+350.230	TO STA.		
FED. ROAD DIST. NO.	ILLINOIS	FED. AID PROJECT		

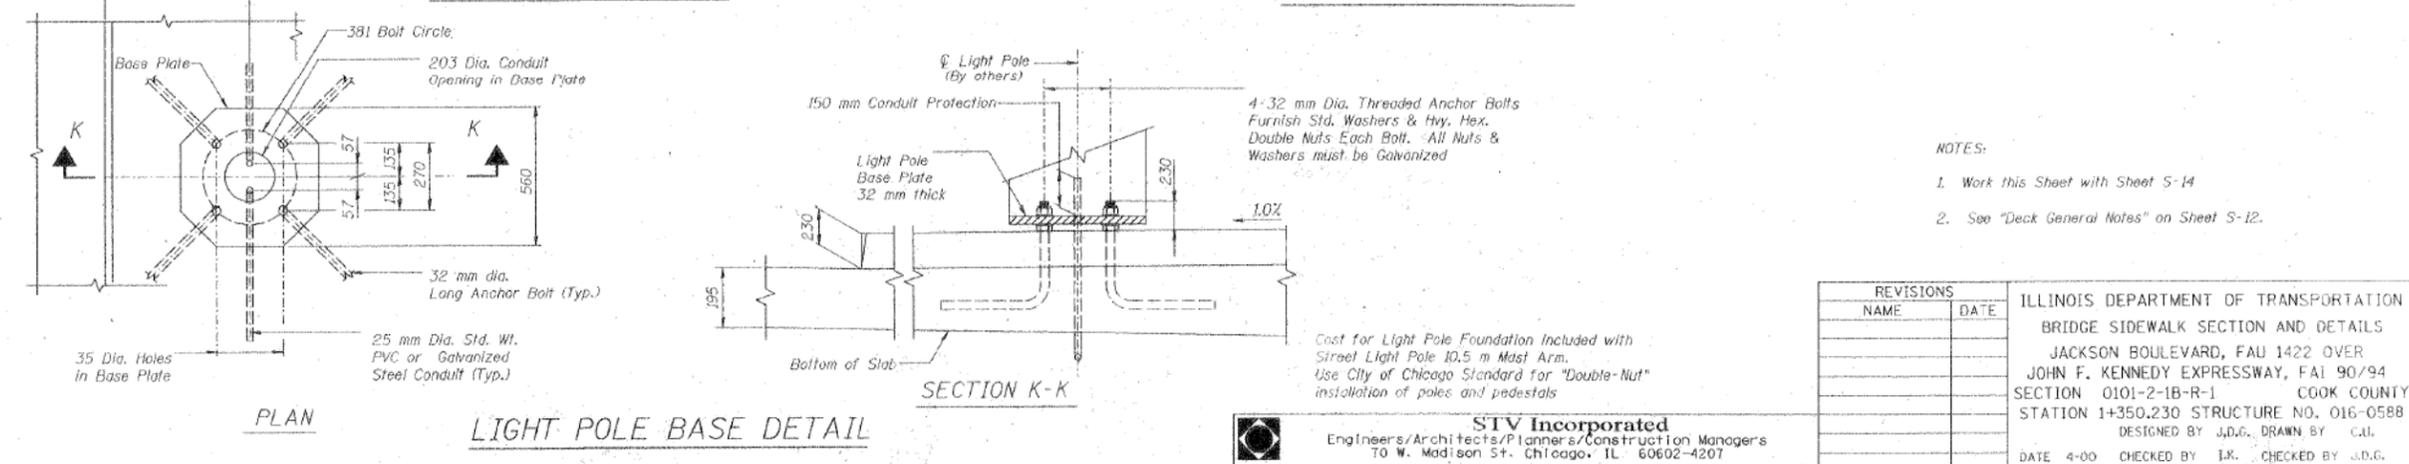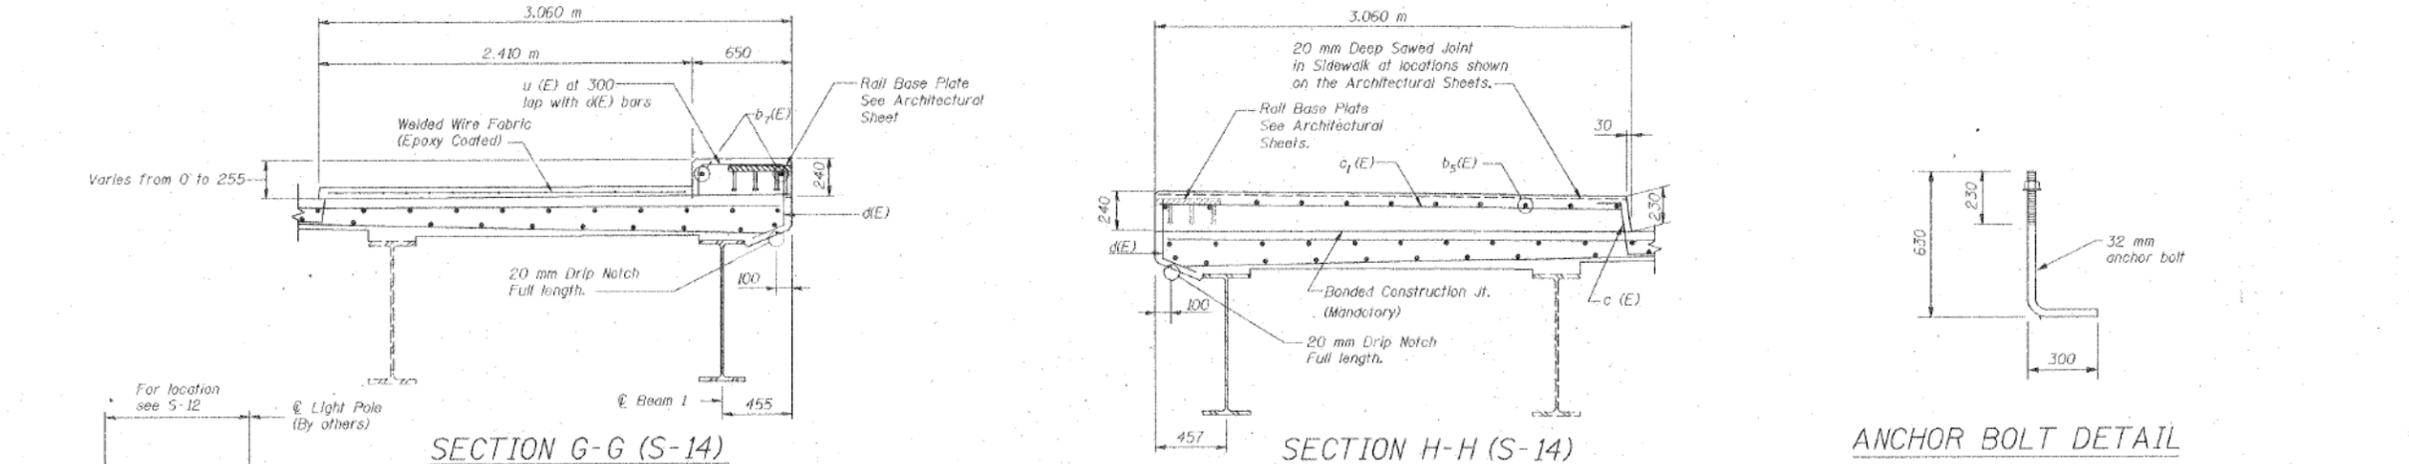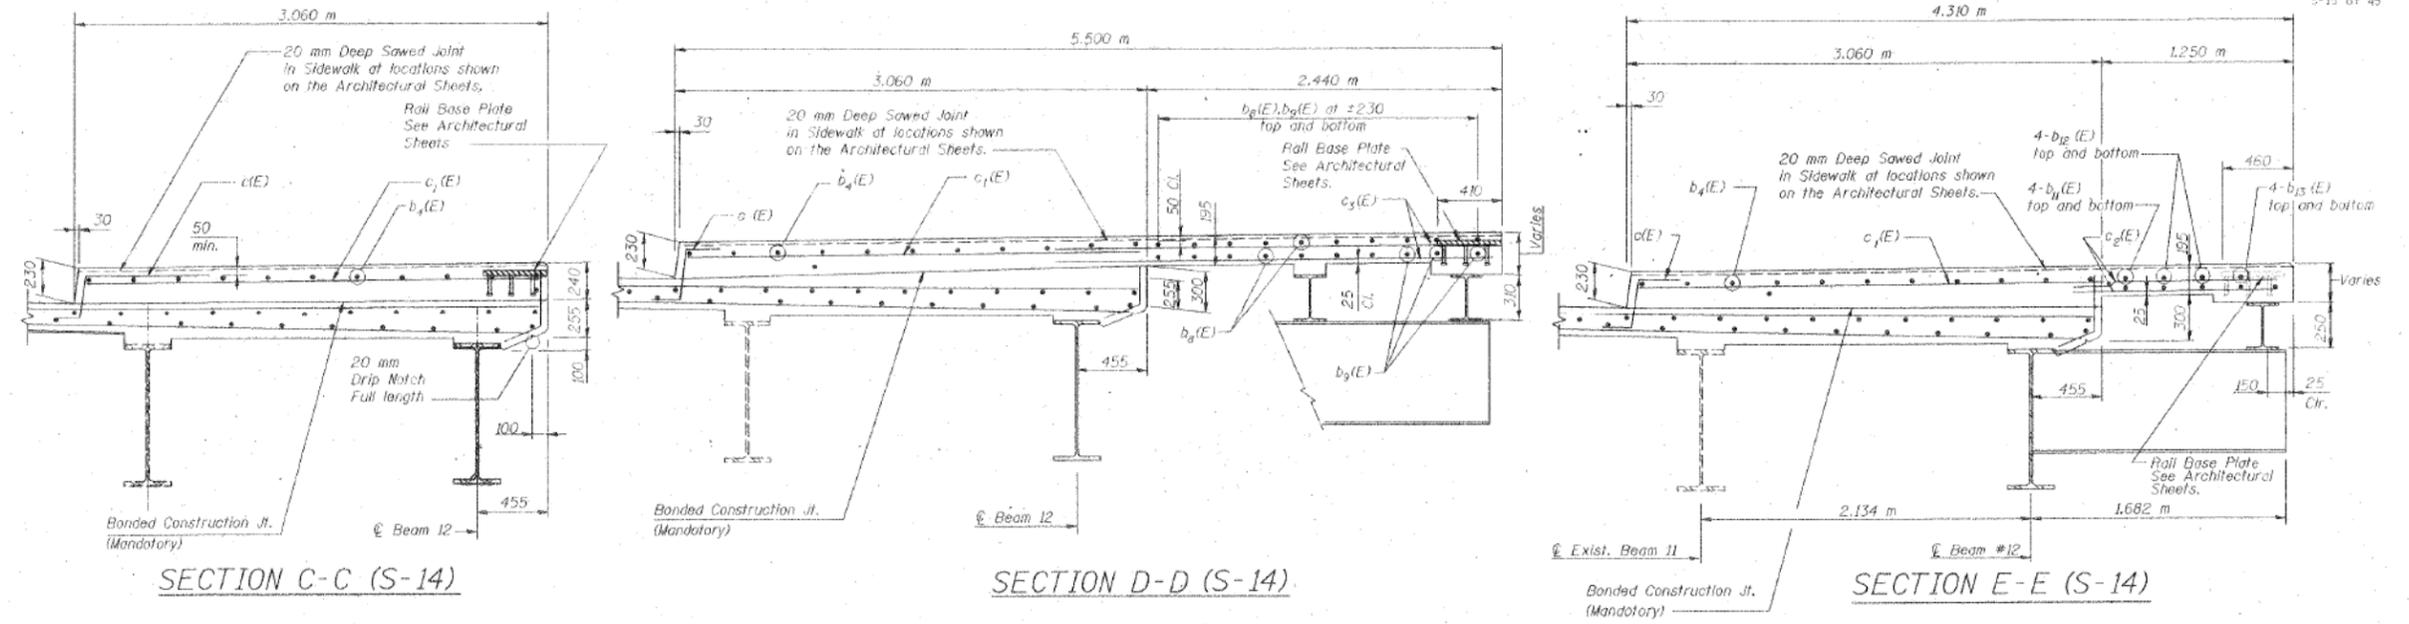

- NOTES:
1. Work this Sheet with Sheet S-14
 2. See "Deck General Notes" on Sheet S-12.

REVISIONS	
NAME	DATE

ILLINOIS DEPARTMENT OF TRANSPORTATION
 BRIDGE SIDEWALK SECTION AND DETAILS
 JACKSON BOULEVARD, FAU 1422 OVER
 JOHN F. KENNEDY EXPRESSWAY, FAI 90/94
 SECTION 0101-2-1B-R-1 COOK COUNTY
 STATION 1+350.230 STRUCTURE NO. 016-058B
 DESIGNED BY J.D.G. DRAWN BY C.U.
 DATE 4-00 CHECKED BY J.K. CHECKED BY J.D.G.

STV Incorporated
 Engineers/Architects/Planners/Construction Managers
 70 W. Madison St. Chicago, IL 60602-4207

6:42:29 PM D162351-SHT-AS-BUILT-14



USER NAME = wjcolletti	DESIGNED EH	REVISED
	CHECKED WJC	REVISED
PLOT SCALE = 0x2.0000 '1" / in.	DRAWN EH	REVISED
PLOT DATE = 8/13/2019	CHECKED WJC	REVISED

STATE OF ILLINOIS
DEPARTMENT OF TRANSPORTATION









EXISTING JACKSON BLVD BRIDGE PLANS (SN 016-0588)

SHEET NO. AB-14 OF AB-65 SHEETS

F.A.I. RTE.	SECTION	COUNTY	TOTAL SHEETS	SHEET NO.
90/94/290	2014-017B	COOK	400	241
			CONTRACT NO. 62J31	
ILLINOIS FED. AID PROJECT				

FOR INFORMATION ONLY

DATE	PROJECT	CONTRACT	SHEET NO.	TOTAL SHEETS
90/94	0101-2-1B-R-1	COOK	226	37
STA. 1+350.230 TO STA.				
FED. ROAD DIST. NO.		ILLINOIS FED. AID PROJECT		
5-16 of 49				

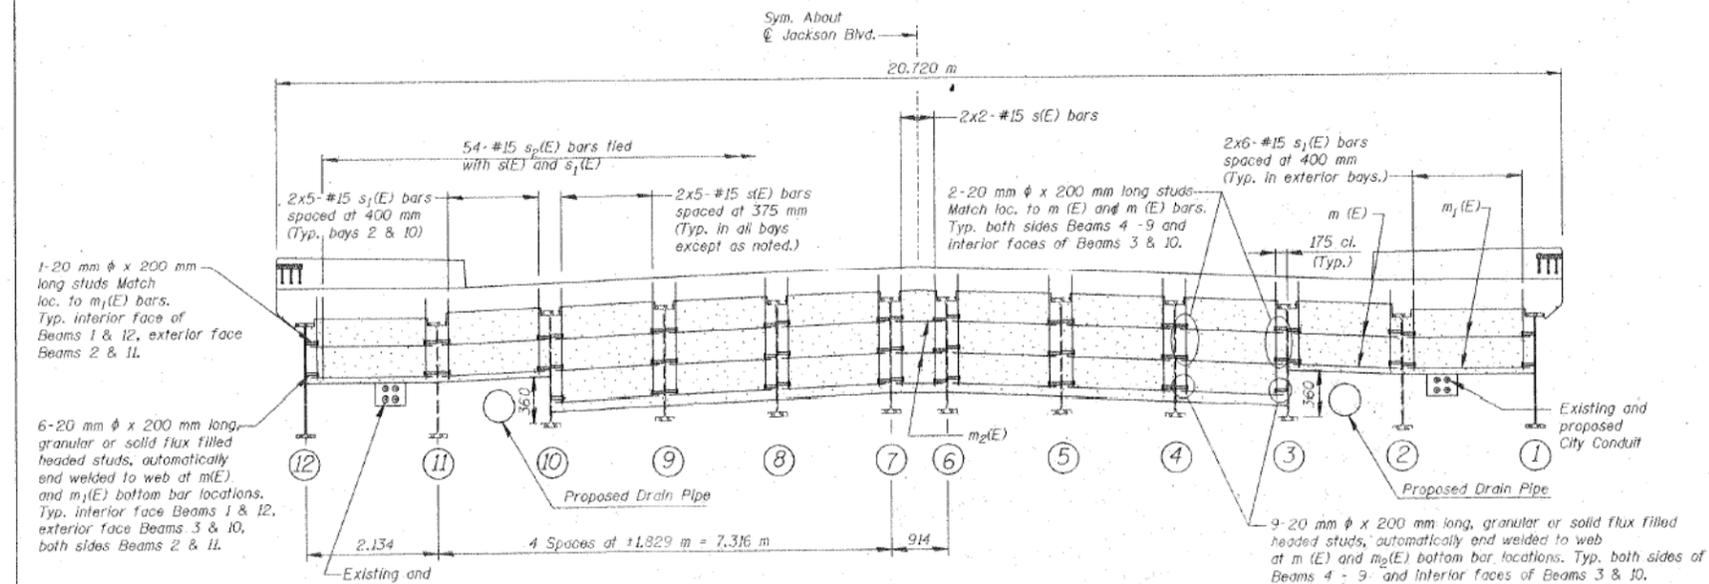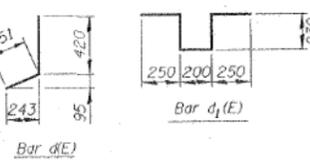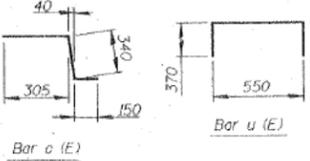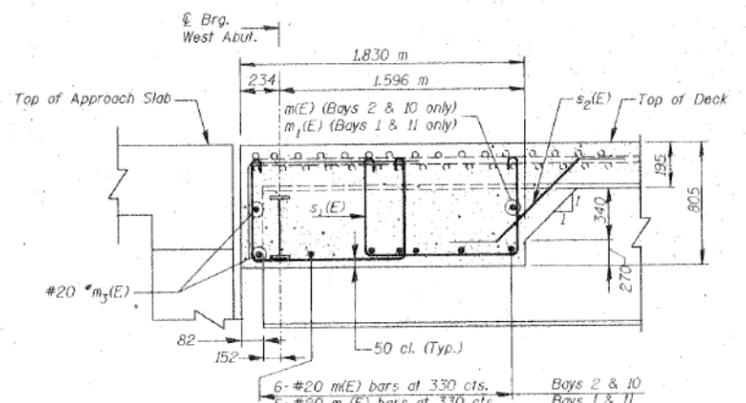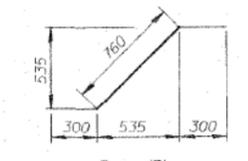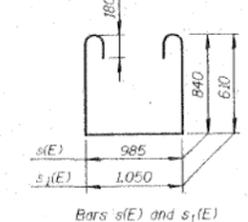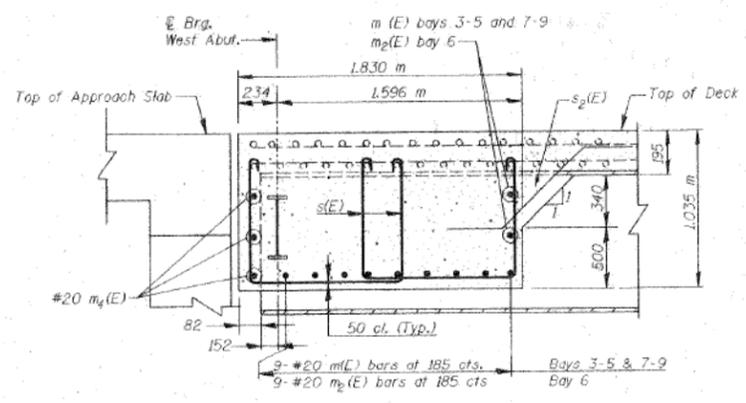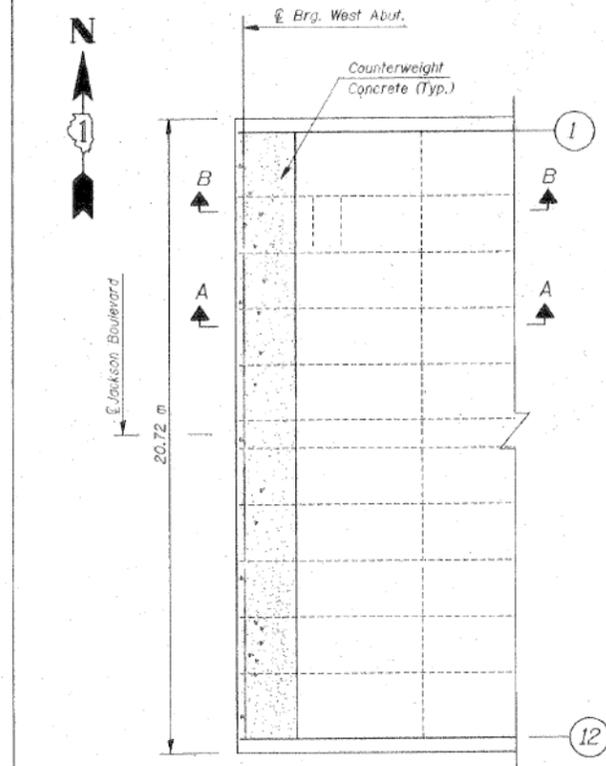

BILL OF MATERIAL				
BAR	NO.	SIZE	LENGTH(m)	SHAPE
a(E)	587	15	10.000 m	—
a1(E)	587	15	11.260 m	—
b(E)	420	15	10.550 m	—
b1(E)	392	15	9.130 m	—
b2(E)	69	20	16.730 m	—
b3(E)	69	20	15.660 m	—
b4(E)	55	15	12.522 m	—
b5(E)	22	15	10.420 m	—
b6(E)	11	15	13.260 m	—
b7(E)	2	15	8.260 m	—
b8(E)	20	15	3.010 m	—
b9(E)	12	15	2.510 m	—
b10(E)	32	15	1.000 m	—
b11(E)	6	15	13.930 m	—
b12(E)	20	15	11.740 m	—
b13(E)	2	15	12.663 m	—
b14(E)	2	15	3.400 m	—
c(E)	322	15	0.790 m	—
c1(E)	313	15	2.960 m	—
a2(E)	300	15	1.760 m	—
c3(E)	32	15	2.800 m	—
d(E)	391	15	0.671 m	—
m(E)	80	20	1.779 m	—
m1(E)	14	20	2.084 m	—
m2(E)	11	20	0.670 m	—
m3(E)	4	20	4.600 m	—
m4(E)	3	20	11.800 m	—
s(E)	64	15	3.025 m	—
s1(E)	44	15	2.630 m	—
s2(E)	54	15	1.360 m	—
u(E)	40	15	1.290 m	—
ITEM	UNIT	QUANTITY		
Reinforcement Bars (Epoxy Coated)	kg.	44,295		
Concrete Superstructure	m ³	398		
Drainage Scuppers DS-12		4		

- Notes:
- See "Deck General Notes" on Sheet S12
 - Work this Sheet with Sheets S12, S13, S14, S15
 - See sht. S-20 for Stud locations.

REVISIONS		ILLINOIS DEPARTMENT OF TRANSPORTATION JACKSON BOULEVARD BRIDGE COUNTERWEIGHT CONCRETE PLAN & ELEVATION JACKSON BOULEVARD, FAU 1422 OVER JOHN F. KENNEDY EXPRESSWAY, FAI 90/94 SECTION 0101-2-1B-R-1 COOK COUNTY STATION 1+350.230 STRUCTURE NO. 016-0588 DESIGNED BY J.D.G. DRAWN BY C.J.J.
NAME	DATE	
		DATE 4-00 CHECKED BY I.K. CHECKED BY J.D.G.

STV Incorporated
Engineers/Architects/Planners/Construction Managers
70 W. Madison St., Chicago, IL 60602-4207

6/4/2015 PM 0162331-SHT-AS-BUILD-15



USER NAME = wjcolletti	DESIGNED = EH	REVISED
CHECKED = WJC	WJC	REVISED
PLOT SCALE = 0x2.0000 '1' / in.	DRAWN = EH	REVISED
PLOT DATE = 8/13/2019	CHECKED = WJC	REVISED

**STATE OF ILLINOIS
DEPARTMENT OF TRANSPORTATION**


EXISTING JACKSON BLVD BRIDGE PLANS (SN 016-0588)

SHEET NO. AB-15 OF AB-65 SHEETS


F.A.I. RTE.	SECTION	COUNTY	TOTAL SHEETS	SHEET NO.
90/94/290	2014-017B	COOK	400	242
CONTRACT NO. 62J31				
ILLINOIS FED. AID PROJECT				

FOR INFORMATION ONLY


F.A. RTE.	SECTION	COUNTY	TOTAL SHEETS	SHEET NO.
90/94	0101-2-1B-R-1	COOK	228	39
STA. 1+350.230 TO STA.		ILLINOIS FED. AID PROJECT		
FED. ROAD DIST. NO. 7		5-18 of 49		

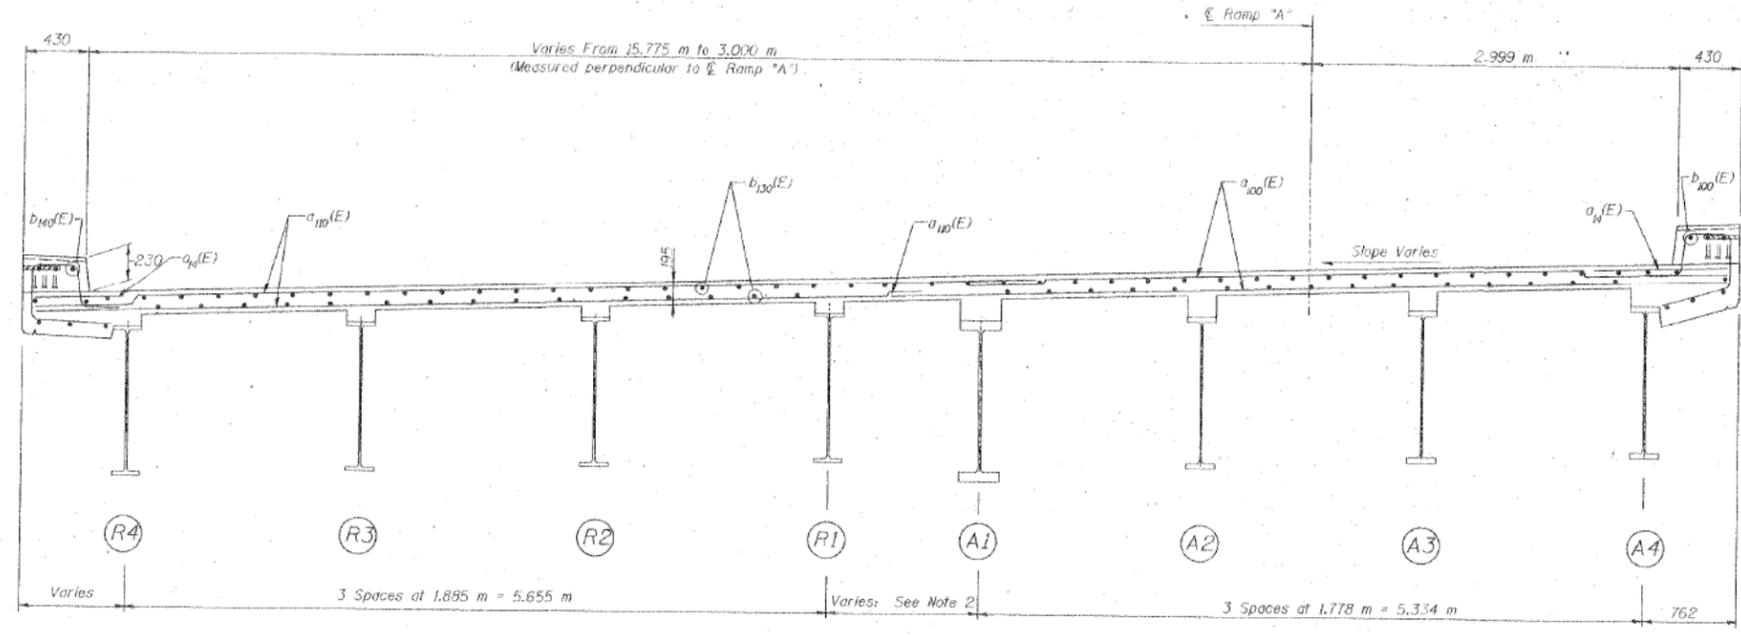


SECTION A-A (S-17)

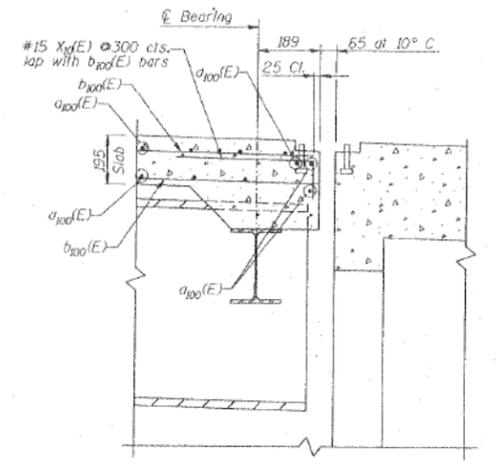

SECTION C-C (S-17)

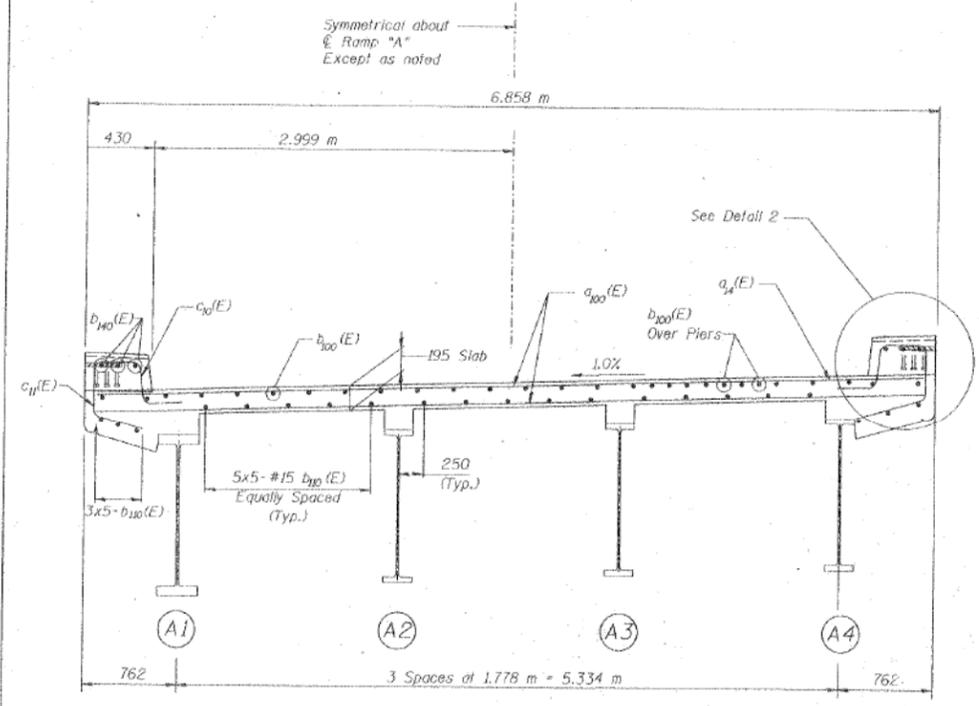

SECTION B-B (S-17)

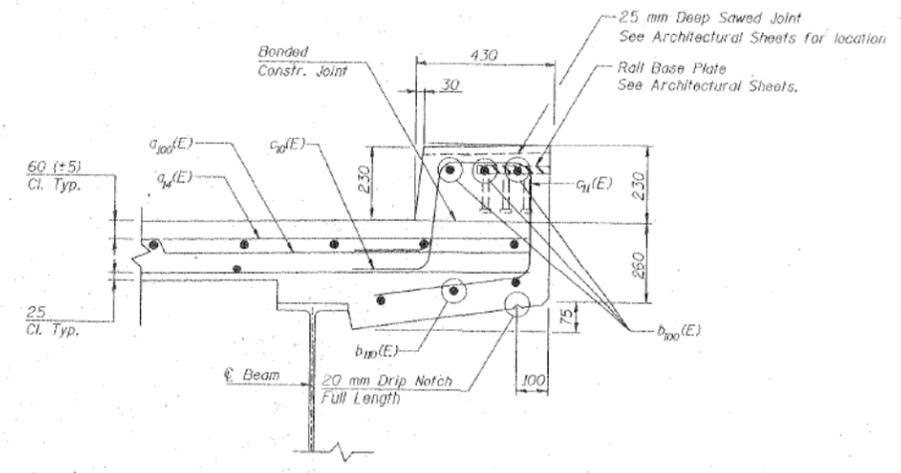

DETAIL 2

REVISIONS		ILLINOIS DEPARTMENT OF TRANSPORTATION ENTRANCE RAMP "A" DECK CROSS SECTIONS & DETAILS JACKSON BOULEVARD, FAU 1422 OVER JOHN F. KENNEDY EXPRESSWAY; FAI 90/94 SECTION 0101-2-1B-R-1 COOK COUNTY STATION 1+350.230 STRUCTURE NO. 016-0588 DESIGNED BY J.D.G. DRAWN BY C.U. DATE 4-00 CHECKED BY I.K. CHECKED BY J.D.G.
NAME	DATE	

STV Incorporated
Engineers/Architects/Planners/Construction Managers
70 W. Madison St. Chicago, IL 60602-4207

6:43:38 PM
D162J31-SHT-AS-BUILT-17



USER NAME = wjcolletti	DESIGNED EH	REVISED
PLOT SCALE = 0x2.0000 'x' / in.	CHECKED WJC	REVISED
PLOT DATE = 8/13/2019	DRAWN EH	REVISED
	CHECKED WJC	REVISED

STATE OF ILLINOIS
DEPARTMENT OF TRANSPORTATION



EXISTING JACKSON BLVD BRIDGE PLANS (SN 016-0588)

SHEET NO. AB-17 OF AB-65 SHEETS


F.A.I. RTE.	SECTION	COUNTY	TOTAL SHEETS	SHEET NO.
90/94/290	2014-017B	COOK	400	244
ILLINOIS FED. AID PROJECT				CONTRACT NO. 62J31

FOR INFORMATION ONLY


F.A. RTE.	SECTION	COUNTY	TOTAL SHEETS	SHEET NO.
90/94	0101-2-1B-R-1	COOK	226	41
STA. 1+350.230	TO STA.			
FED. ROAD DIST. NO.	ILLINOIS FED. AID PROJECT		5-26 of 49	

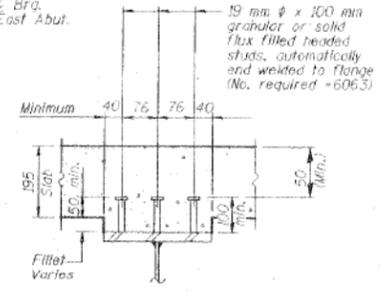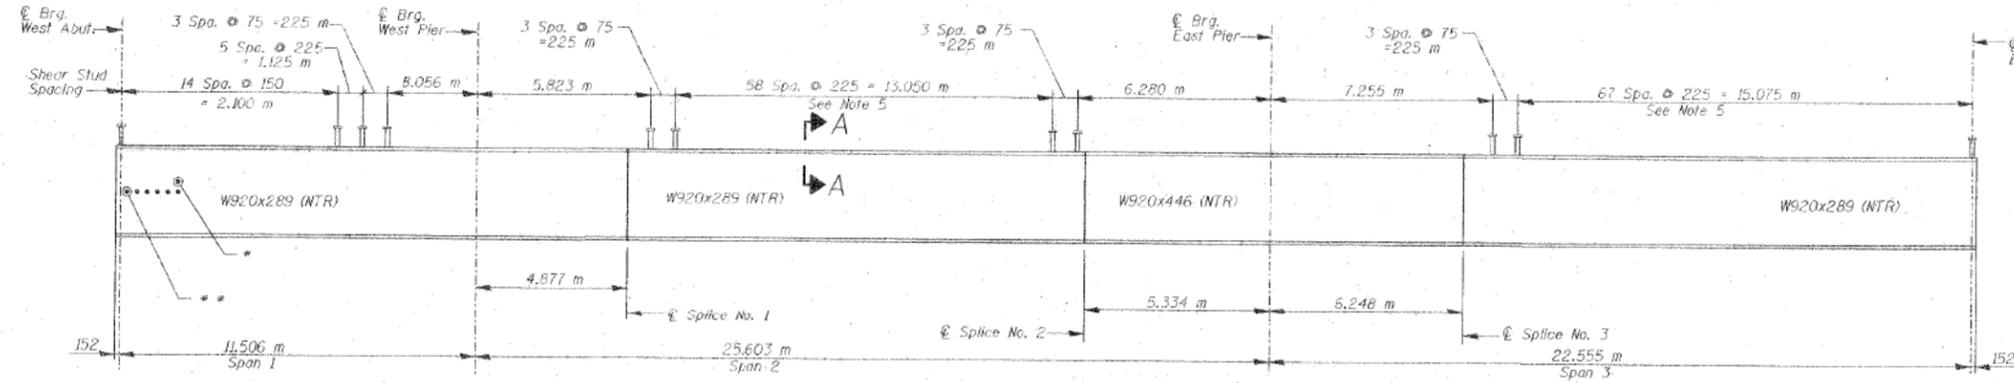

BEAM 1 ELEVATION

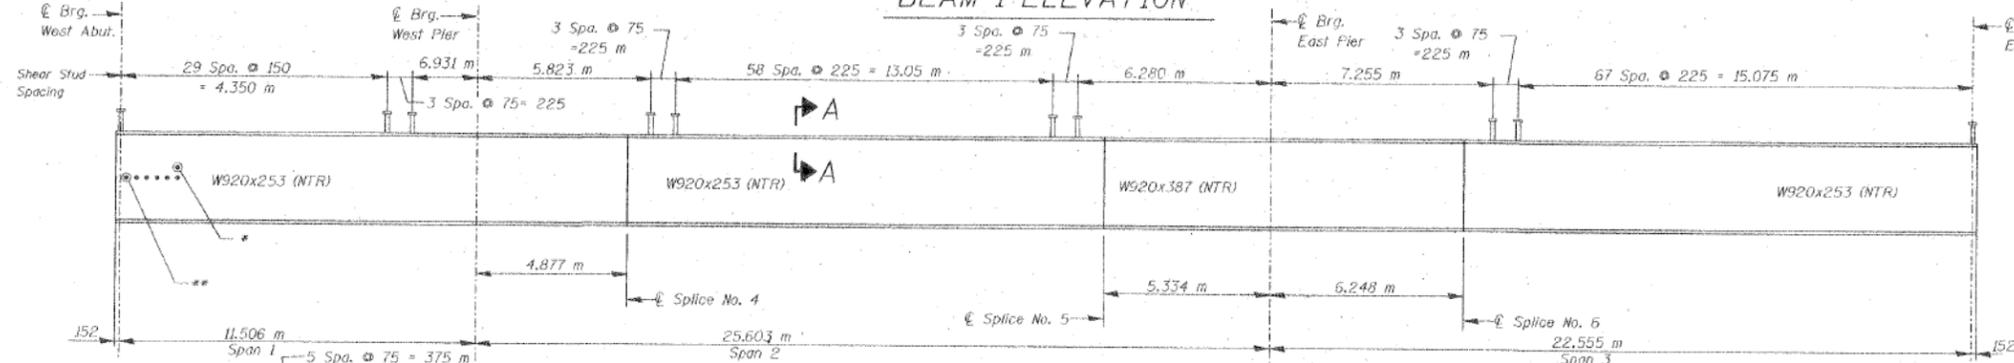

BEAM 12 ELEVATION

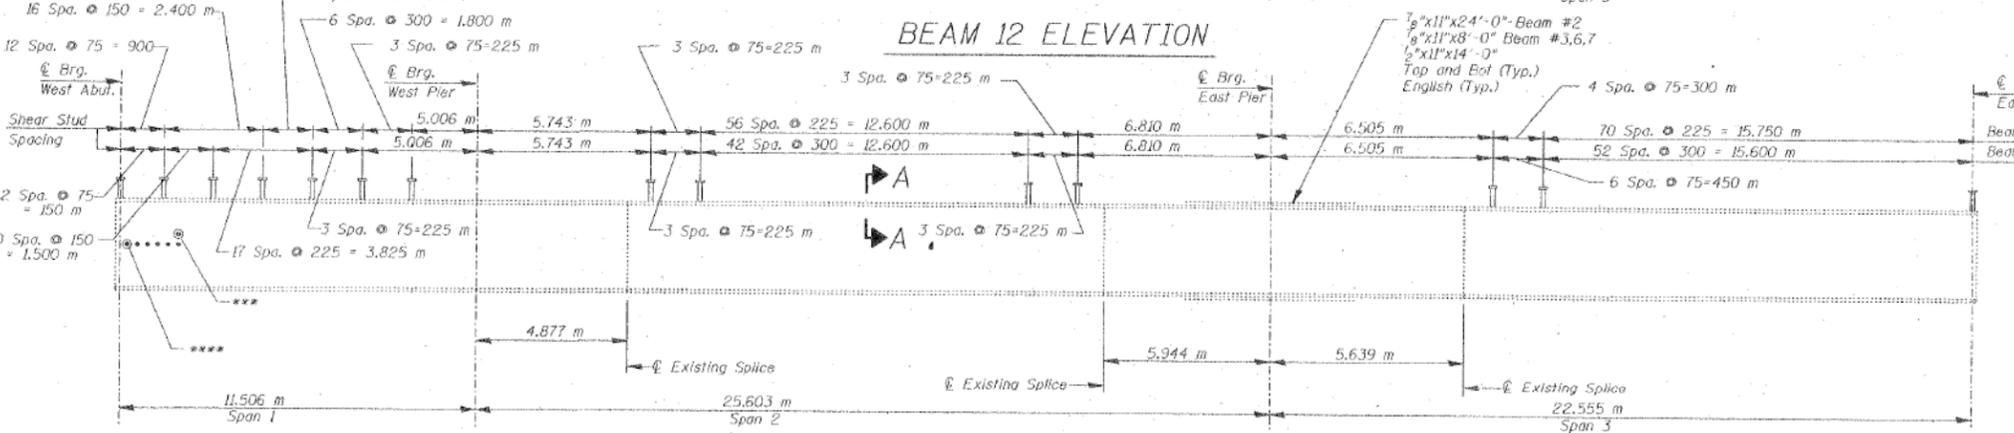

ELEVATION OF EXISTING BEAMS

- * 1-20 mm ϕ x 200 mm long studs Match loc. to $m_1(E)$ bars. Typ. Interior face of Beams 1 & 12, exterior face Beams 2 & 11.
- ** 6-20 mm ϕ x 200 mm long, granular or solid flux filled headed studs, automatically and welded to web at $m(E)$ and $m_1(E)$ bottom bar locations. Typ. Interior face Beams 1 & 12, exterior face Beams 3 & 10, both sides Beams 2 & 11.
- *** 2-20 mm ϕ x 200 mm long studs Match loc. to $m_1(E)$ and $m(E)$ bars. Typ. both sides Beams 4 - 9 and interior faces of Beams 3 & 10.
- **** 9-20 mm ϕ x 200 mm long, granular or solid flux filled headed studs, automatically and welded to web at $m(E)$ and $m_2(E)$ bottom bar locations. Typ. both sides of Beams 4 - 9 and interior faces of Beams 3 & 10.

For additional standard detail see S-16

- Notes:
1. All dimensions are in millimeters (mm) unless otherwise noted.
 2. NTR denotes members to which notch toughness requirements are applicable.
 3. For splice details see sheets S21 and S22.
 4. All structural steel for beams 1 & 12 shall be M270 M Grade 345.
 5. Adjust stud spacing to miss diaphragm strap plates.

REVISIONS	
NAME	DATE

STV Incorporated
 Engineers/Architects/Planners/Construction Managers
 70 W. Madison St., Chicago, IL 60602-4207

ILLINOIS DEPARTMENT OF TRANSPORTATION
 JACKSON BOULEVARD BRIDGE
 BEAM ELEVATIONS AND DETAILS
 JACKSON BOULEVARD, FAU 1422 OVER
 JOHN F. KENNEDY EXPRESSWAY, FAI 90/94
 SECTION 0101-2-1B-R-1 COOK COUNTY
 STATION 1+350.230 STRUCTURE NO. 016-0588
 DESIGNED BY J.D.G. DRAWN BY C.J.
 DATE 4-00 CHECKED BY J.K. CHECKED BY J.D.G.

6/4/01 PM D162331-SHT-AS-BUILT-18



USER NAME = wjcolletti	DESIGNED EH	REVISED
PLOT SCALE = 0x2.0000 '1' / in.	CHECKED WJC	REVISED
PLOT DATE = 8/13/2019	DRAWN EH	REVISED
	CHECKED WJC	REVISED

STATE OF ILLINOIS
 DEPARTMENT OF TRANSPORTATION

EXISTING JACKSON BLVD BRIDGE PLANS (SN 016-0588)


SHEET NO. AB-18 OF AB-65 SHEETS

F.A.I. RTE.	SECTION	COUNTY	TOTAL SHEETS	SHEET NO.
90/94/290	2014-017B	COOK	400	245
ILLINOIS FED. AID PROJECT				CONTRACT NO. 62J31

FOR INFORMATION ONLY

F.A. RTE.	SECTION	COUNTY	TOTAL SHEETS	SHEET NO.
90/94	0101-2-1B-R-1	COOK	226	40
STA. 1+350.230 TO STA.				
FED. ROAD DIST. NO.		ILLINOIS	FED. AID PROJECT	

S-19 of 49

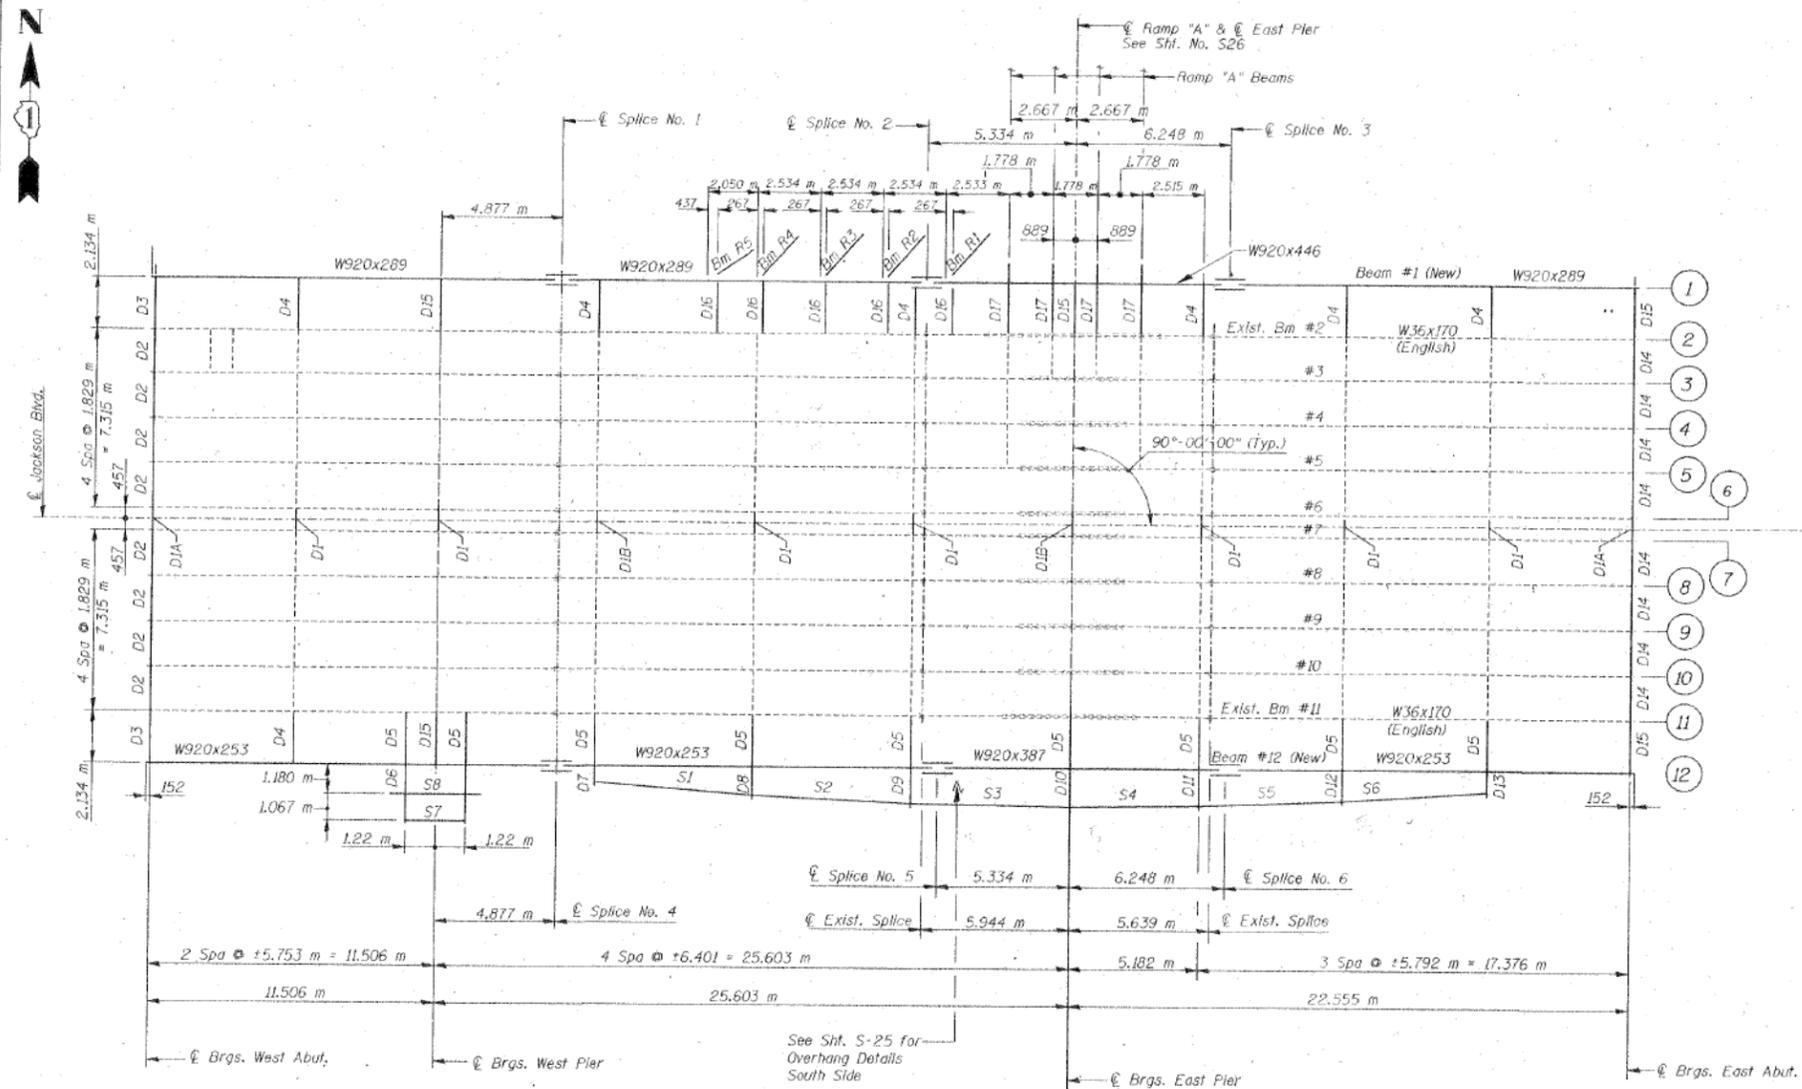

- Notes:**
- All dimensions are in millimeters (mm) unless otherwise noted.
 - For Entrance Ramp "A" framing plan, see sheet 26
 - See sheet S21, S22, S23, S24 and S25 for connection details.
 - Top of Beam elevations are given for fabrication only, and do not include the thicknesses of any cover plates or splice plates.
 - The contractor shall test the welds at the end of the existing welded cover plates for cracks after removal of the existing concrete deck. Tests shall be performed by qualified personnel using dye penetrant, magnetic particle, or other approved testing methods. If cracks are found, report them to the "Bureau of Bridges" and structures for further processing. The cost of testing is included in "Removal of Existing Concrete Deck". The cost of crack repair, if necessary, will be paid according to article 109.04 of the "Standard Specifications".
 - The Contractor shall survey and establish the top of beam elevations for beams 2 thru 11. The top of beam elevations shall be maintained following bearing replacement.

FRAMING PLAN

All existing beams are W36x134 (English) unless otherwise shown.

JACKSON BLVD. DIAPHRAGM LIST

Item	Size	No. Req'd
D1	W410x53	7
D1A	W460x74	2
D1B	W460x74	2
D2	W460x74	8
D3	W460x74	2
D4	W410x53	7
D5	W690x125	9
D6	W690x125	2
D7 thru D13	W690x125	7
D14	W460x74	8
D15	W460x74	5
D16	W760x147	5
D17	W760x147	5

JACKSON BLVD. TOP OF BEAM ELEVATIONS

LOCATION	ELEVATION
Beam 1 - W. Abutment	181.275
Beam 1 - W. Pier	181.504
Beam 1 - Splice 1	181.601
Beam 1 - Splice 2	181.569
Beam 1 - E. Pier	181.468
Beam 1 - Splice 3	181.349
Beam 1 - E. Abutment	180.822
Beam 12 - W. Abutment	181.275
Beam 12 - W. Pier	181.504
Beam 12 - Splice 4	181.601
Beam 12 - Splice 5	181.569
Beam 12 - E. Pier	181.468
Beam 12 - Splice 6	181.349
Beam 12 - E. Abutment	180.822

JACKSON BLVD. SIDEWALK FRAMING LIST

Item	Size
S1	W250 x 67
S2	W250 x 67
S3	W250 x 67
S4	W250 x 67
S5	W250 x 67
S6	W250 x 67
S7	W310 x 60
S8	W310 x 60

REVISIONS

NAME	DATE

3/01

ILLINOIS DEPARTMENT OF TRANSPORTATION
BRIDGE FRAMING PLAN
JACKSON BOULEVARD, FAU 1422 OVER
JOHN F. KENNEDY EXPRESSWAY, FAI 90/94
SECTION 0101-2-1B-R-1 COOK COUNTY
STATION 1+350.230 STRUCTURE NO. 016-0588
DESIGNED BY J.D.C. DRAWN BY C.U.
DATE 4-00 CHECKED BY I.K. CHECKED BY J.D.C.

STV Incorporated
Engineers/Architects/Planners/Construction Managers
70 W. Madison St. Chicago, IL 60602-4207

6/4/47 PM D16231-SHT-AS-BUILT-20



USER NAME = wjcolletti	DESIGNED EH	REVISED
PLOT SCALE = 0x2.0000 '1' / in.	CHECKED WJC	REVISED
PLOT DATE = 8/13/2019	DRAWN EH	REVISED
	CHECKED WJC	REVISED

**STATE OF ILLINOIS
DEPARTMENT OF TRANSPORTATION**



EXISTING JACKSON BLVD BRIDGE PLANS (SN 016-0588)

SHEET NO. AB-20 OF AB-65 SHEETS



F.A.I. RTE.	SECTION	COUNTY	TOTAL SHEETS	SHEET NO.
90/94/290	2014-017B	COOK	400	247
				CONTRACT NO. 62J31
ILLINOIS FED. AID PROJECT				

FOR INFORMATION ONLY



F.A.I. RTE.	SECTION	COUNTY	TOTAL SHEETS	SHEET NO.
90/94	0101-2-1B-R-1	COOK	226	41
STA. 1+350.230		TO STA.		
FED. ROAD DIST. NO.	ILLINOIS	FED. AID PROJECT		5-21 of 49

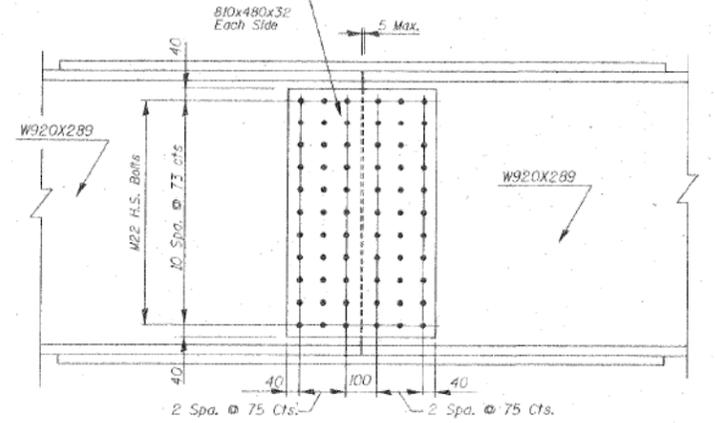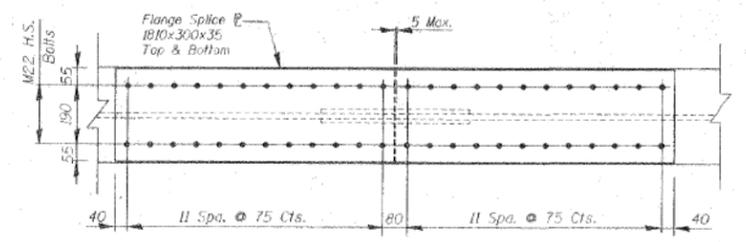



DETAIL SPLICE NO. 1

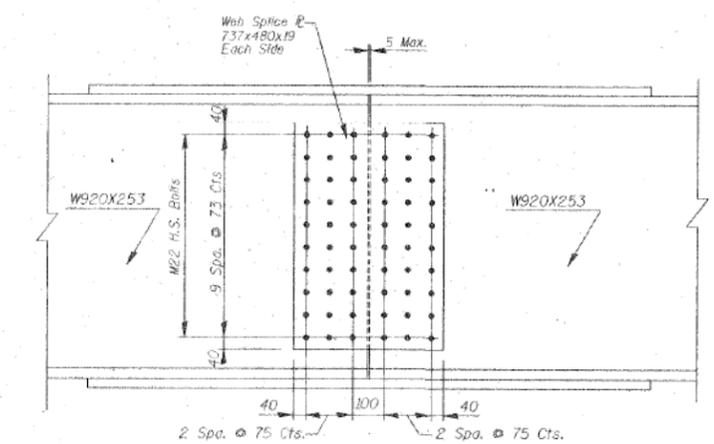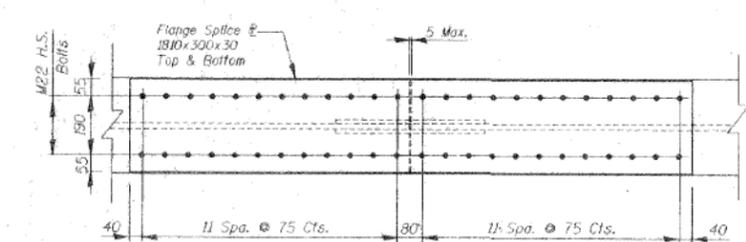

DETAIL SPLICE NO. 4

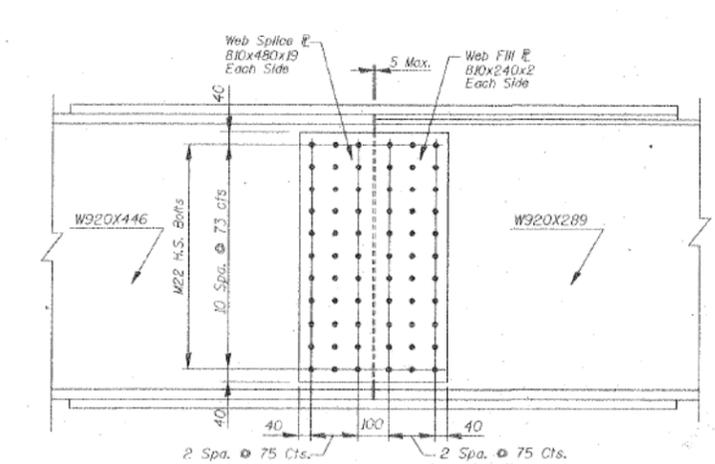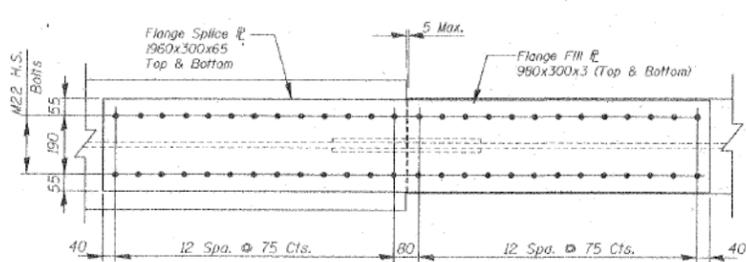

DETAIL SPLICE NO. 2 & 3

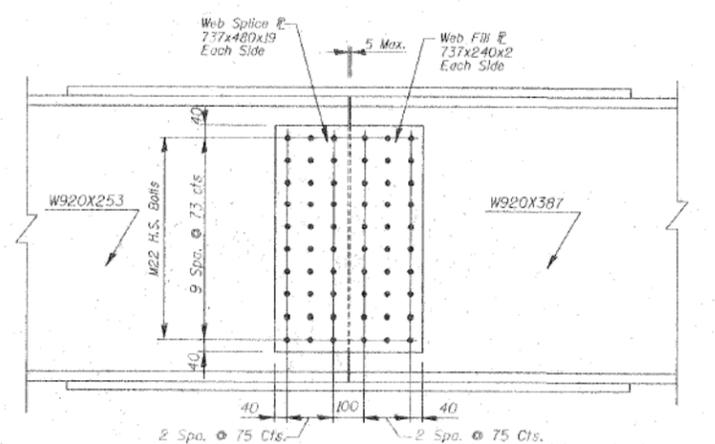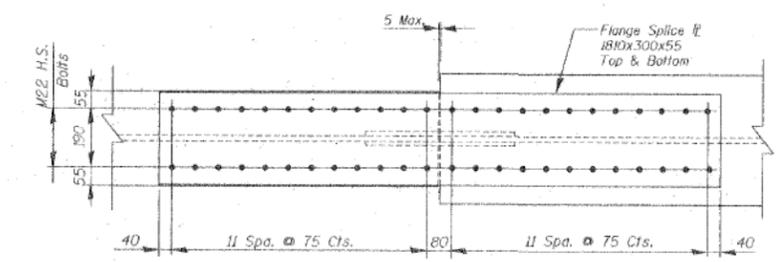

DETAIL SPLICE NO. 5 & 6

- NOTES:**
1. All dimensions are in millimeters (mm), except as noted.
 2. All material on this sheet except the fill plates shall be NTR
 3. All material on this sheet, except Fill Plates shall be M270M Grade 345

REVISIONS		ILLINOIS DEPARTMENT OF TRANSPORTATION JACKSON BOULEVARD BRIDGE AND RAMP "A" SPlice DETAILS JACKSON BOULEVARD, FAU 1422 OVER JOHN F. KENNEDY EXPRESSWAY, FAI 90/94 SECTION 0101-2-1B-R-1 COOK COUNTY STATION 1+350.230 STRUCTURE NO. 016-0588 DESIGNED BY J.D.G. DRAWN BY C.U. DATE 4-00 CHECKED BY J.K. CHECKED BY J.D.G.
NAME	DATE	

STV Incorporated
Engineers/Architects/Planners/Construction Managers
70 W. Madison St. Chicago, IL 60602-4207

6/4/09 9:09 PM D162331-SHT-AS-BUILT-21



USER NAME = wjcolletti	DESIGNED EH	REVISED
PLOT SCALE = 0x2.0000 '1" / in.	CHECKED WJC	REVISED
PLOT DATE = 8/13/2019	DRAWN EH	REVISED
	CHECKED WJC	REVISED

STATE OF ILLINOIS
DEPARTMENT OF TRANSPORTATION







EXISTING JACKSON BLVD BRIDGE PLANS (SN 016-0588)

SHEET NO. AB-21 OF AB-65 SHEETS

F.A.I. RTE.	SECTION	COUNTY	TOTAL SHEETS	SHEET NO.
90/94/290	2014-017B	COOK	400	248
ILLINOIS				FED. AID PROJECT
CONTRACT NO. 62J31				

FOR INFORMATION ONLY

F.A.I. RTE.	SECTION	COUNTY	TOTAL SHEETS	SHEET NO.
90/94	0101-2-1B-R-1	COOK	220	43
STA. 1+350.230	TO STA.			
FED. ROAD DIST. NO.	ILLINOIS	FED. AID PROJECT	5-22 of 49	

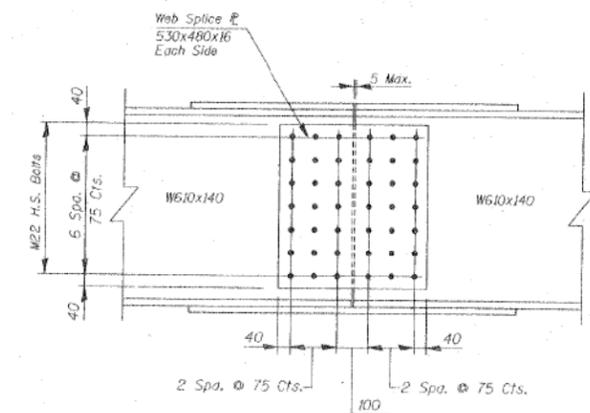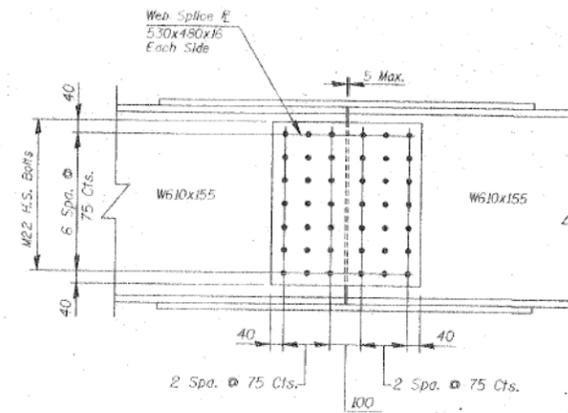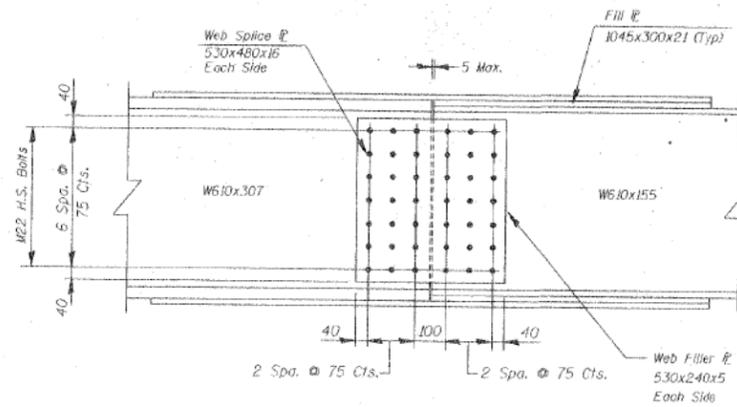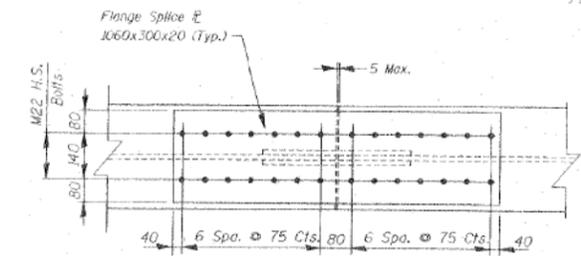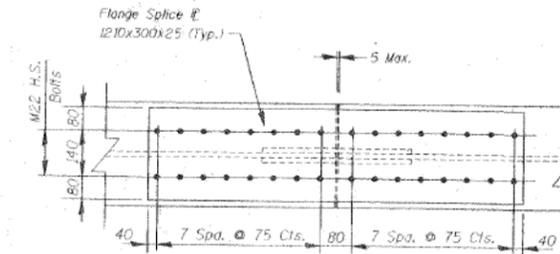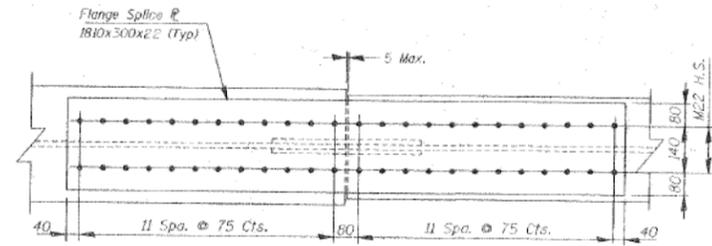

DETAIL SPLICE NO. 9

DETAIL SPLICE NO. 10

DETAIL SPLICE NO. 11 & 12

NOTES:

1. All dimensions are in millimeters (mm), except as noted.
2. All material on this sheet except the fill plates shall be NTR.
3. All material on this sheet, except Fill Plates shall be M270M Grade 345.

REVISIONS		ILLINOIS DEPARTMENT OF TRANSPORTATION JACKSON BOULEVARD BRIDGE AND RAMP "A" SPLICE DETAILS JACKSON BOULEVARD, FAU 1422 OVER JOHN F. KENNEDY EXPRESSWAY, FAI 90/94 SECTION 0101-2-1B-R-1 COOK COUNTY STATION 1+350.230 STRUCTURE NO. 016-0588 DESIGNED BY J.D.G. DRAWN BY C.U. DATE 4-00. CHECKED BY I.K. CHECKED BY J.D.G.
NAME	DATE	

STV Incorporated
Engineers/Architects/Planners/Construction Managers
70 W. Madison St. Chicago, IL 60602-4207

STATE OF ILLINOIS
DEPARTMENT OF TRANSPORTATION

EXISTING JACKSON BLVD BRIDGE PLANS (SN 016-0588)

SHEET NO. AB-22 OF AB-65 SHEETS


F.A.I. RTE.	SECTION	COUNTY	TOTAL SHEETS	SHEET NO.
90/94/290	2014-017B	COOK	400	249
				CONTRACT NO. 62J31
ILLINOIS FED. AID PROJECT				



USER NAME = wjcolletti	DESIGNED	EH	REVISED
	CHECKED	WJC	REVISED
PLOT SCALE = 0x2.0000 '1" / in.	DRAWN	EH	REVISED
PLOT DATE = 8/13/2019	CHECKED	WJC	REVISED

FOR INFORMATION ONLY



F.A.I. RTE.	SECTION	COUNTY	TOTAL SHEETS	SHEET NO.
90/94	0101-2-1B-R-1	COOK	226	44
STA. 1+350.230	TO STA.			
FED. ROAD DIST. NO.	ILLINOIS FED. AID PROJECT		5-23 of 49	

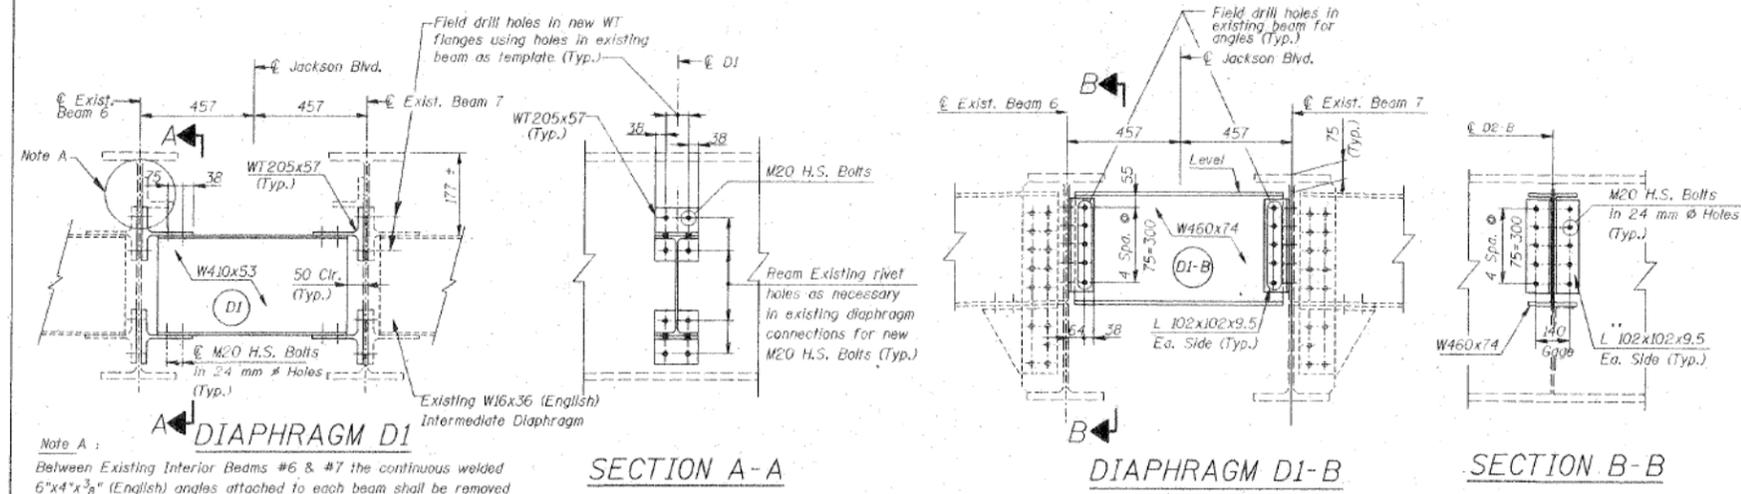


Note A:
Between Existing Interior Beams #6 & #7 the continuous welded 6"x4"x $\frac{3}{8}$ " (English) angles attached to each beam shall be removed to allow connections for new D1 Type Diaphragms. Cast included in "Structural Steel Removal"

Notes:
Weld detail applies at bottom Flange at mill to bear end of all supports. The Length of fillet welds at all other locations are full width of stiffener minus the horizontal clipped corner.

CONNECTION PLATE DETAIL

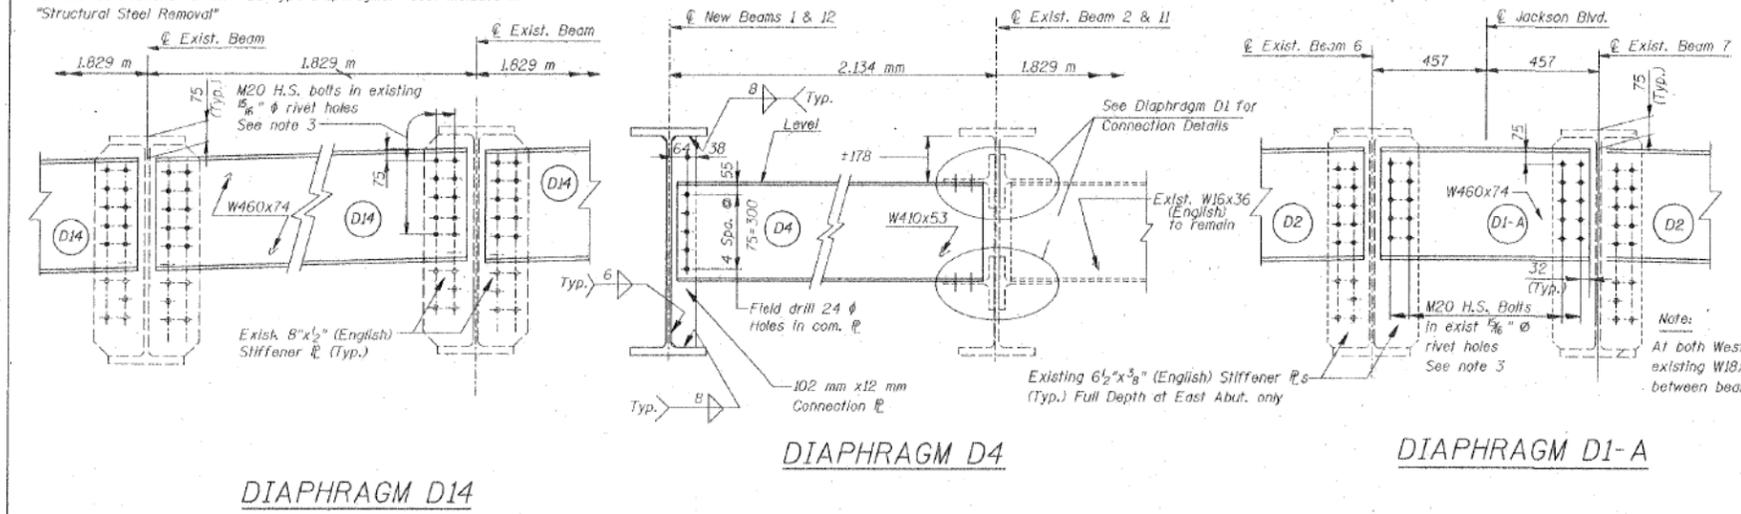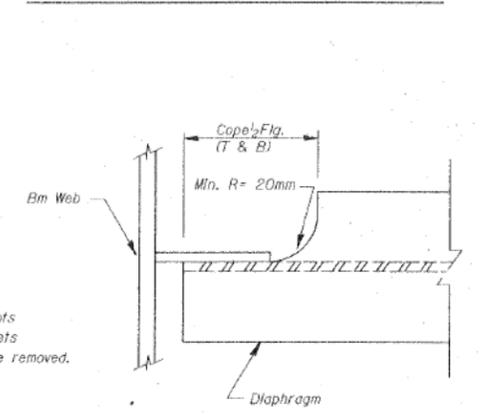

TYPICAL PLAN FLANGE COPE DETAIL

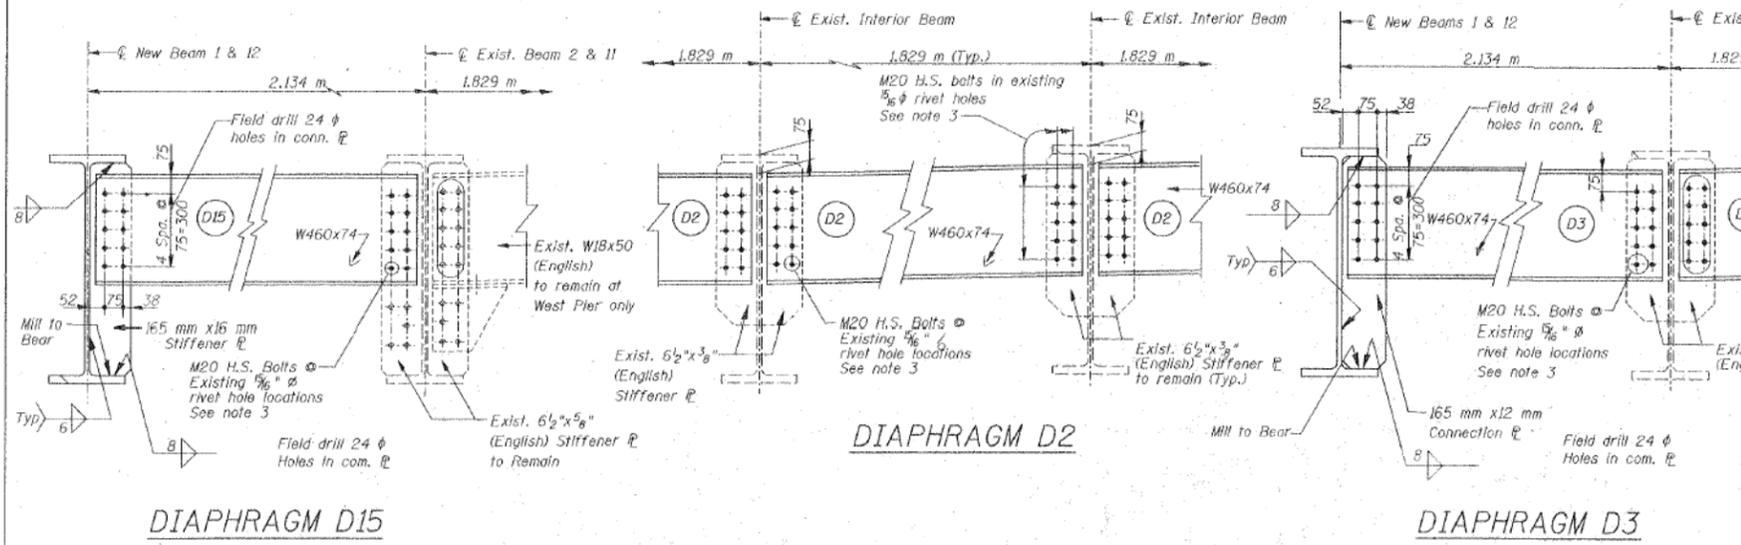

- Notes:**
1. Bolted connection to be M20 H.S. Bolts in 24 mm holes unless noted
 2. Two hardened washers shall be required over all oversized holes.
 3. Holes in Diaphragm to be drilled in the field to match existing holes. Field to verify existing holes as required.
 4. Minimum distance between edges of new connection plates and ϕ of field drilled holes shall be 40 mm

REVISIONS	
NAME	DATE

ILLINOIS DEPARTMENT OF TRANSPORTATION
JACKSON BOULEVARD BRIDGE
DIAPHRAGM CONNECTION DETAILS
JACKSON BOULEVARD, FAU 1422 OVER
JOHN F. KENNEDY EXPRESSWAY, FAJ 90/94
SECTION 0101-2-1B-R-1 COOK COUNTY
STATION 1+350.230 STRUCTURE NO. 016-0588
DESIGNED BY J.D.G. DRAWN BY C.J.J.
DATE 4-00 CHECKED BY I.K. CHECKED BY J.D.G.

6:45:55 PM D16231-SHT-AS-BUILT-23



USER NAME = wjcolletti	DESIGNED EH	REVISED
PLOT SCALE = 0x2.0000 '1' / in.	CHECKED WJC	REVISED
PLOT DATE = 8/13/2019	DRAWN EH	REVISED
	CHECKED WJC	REVISED

STATE OF ILLINOIS
DEPARTMENT OF TRANSPORTATION


EXISTING JACKSON BLVD BRIDGE PLANS (SN 016-0588)

SHEET NO. AB-23 OF AB-65 SHEETS


F.A.I. RTE.	SECTION	COUNTY	TOTAL SHEETS	SHEET NO.
90/94/290	2014-017B	COOK	400	250
				CONTRACT NO. 62J31
ILLINOIS FED. AID PROJECT				

FOR INFORMATION ONLY

F.A. RTE.	SECTION	COUNTY	TOTAL SHEETS	SHEET NO.
90/94	0101-2-1B-R-1	COOK	226	45
STA. 1+350.230 TO STA.		ILLINOIS FED. AID PROJECT		
FED. ROAD DIST. NO. 7		S-24 of 49		

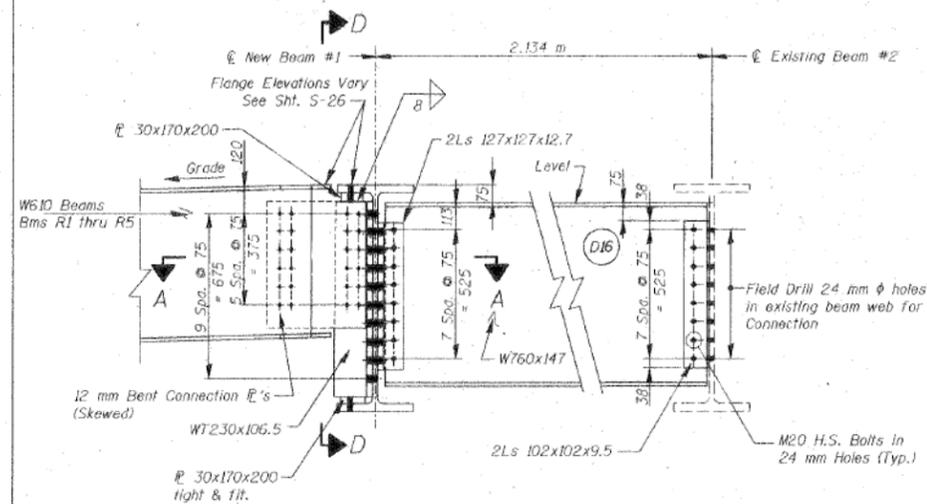


DIAPHRAGM D16

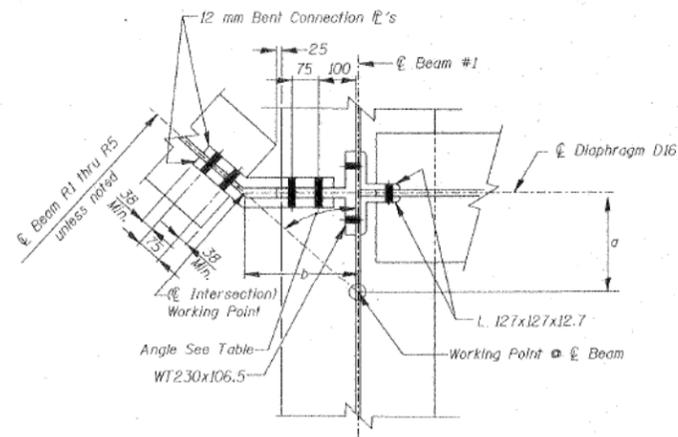


SECTION A-A


	Angle	a	b
R1 Thru R4	48°10'43"	267	298
R5	34°01'50"	437	295

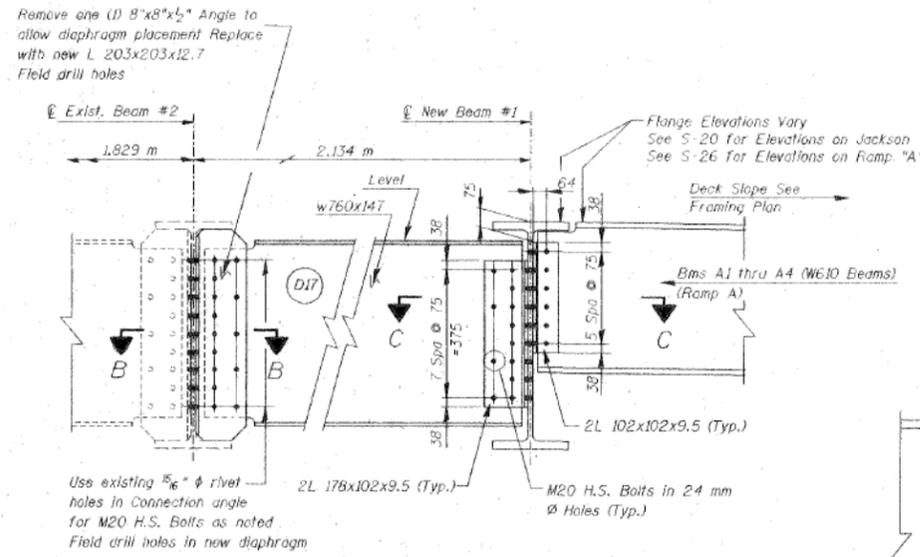


DIAPHRAGM D17

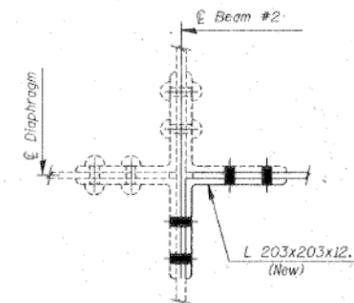

SECTION B-B

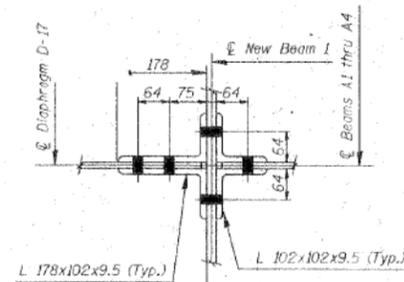

SECTION C-C

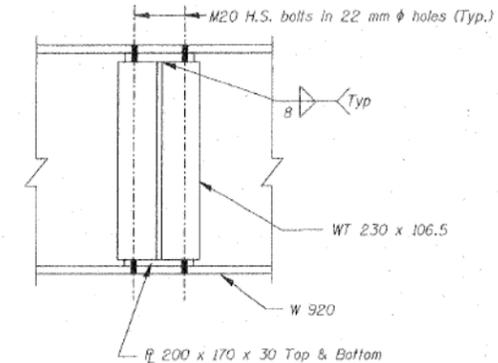

SECTION D-D

REVISIONS		ILLINOIS DEPARTMENT OF TRANSPORTATION ENTRANCE RAMP "A" BEAM CONNECTION DETAILS JACKSON BOULEVARD, FAU 1422 OVER JOHN F. KENNEDY EXPRESSWAY, FAI 90/94 SECTION 0101-2-1B-R-1 COOK COUNTY STATION 1+350.230 STRUCTURE NO. 016-0588 DESIGNED BY J.D.G. DRAWN BY C.J.L.
NAME	DATE	

STV Incorporated
Engineers/Architects/Planners/Construction Managers
70 W. Madison St. Chicago, IL 60602-4207

6:46:17 PM
D162J31-SHT-AS-BUILT-24



USER NAME = wjcolletti	DESIGNED EH	REVISED
PLOT SCALE = 0x2.0000 '1" / in.	CHECKED WJC	REVISED
PLOT DATE = 8/13/2019	DRAWN EH	REVISED
	CHECKED WJC	REVISED


STATE OF ILLINOIS
DEPARTMENT OF TRANSPORTATION

EXISTING JACKSON BLVD BRIDGE PLANS (SN 016-0588)

SHEET NO. AB-24 OF AB-65 SHEETS

F.A.I. RTE.	SECTION	COUNTY	TOTAL SHEETS	SHEET NO.
90/94/290	2014-017B	COOK	400	251
				CONTRACT NO. 62J31
ILLINOIS FED. AID PROJECT				

FOR INFORMATION ONLY

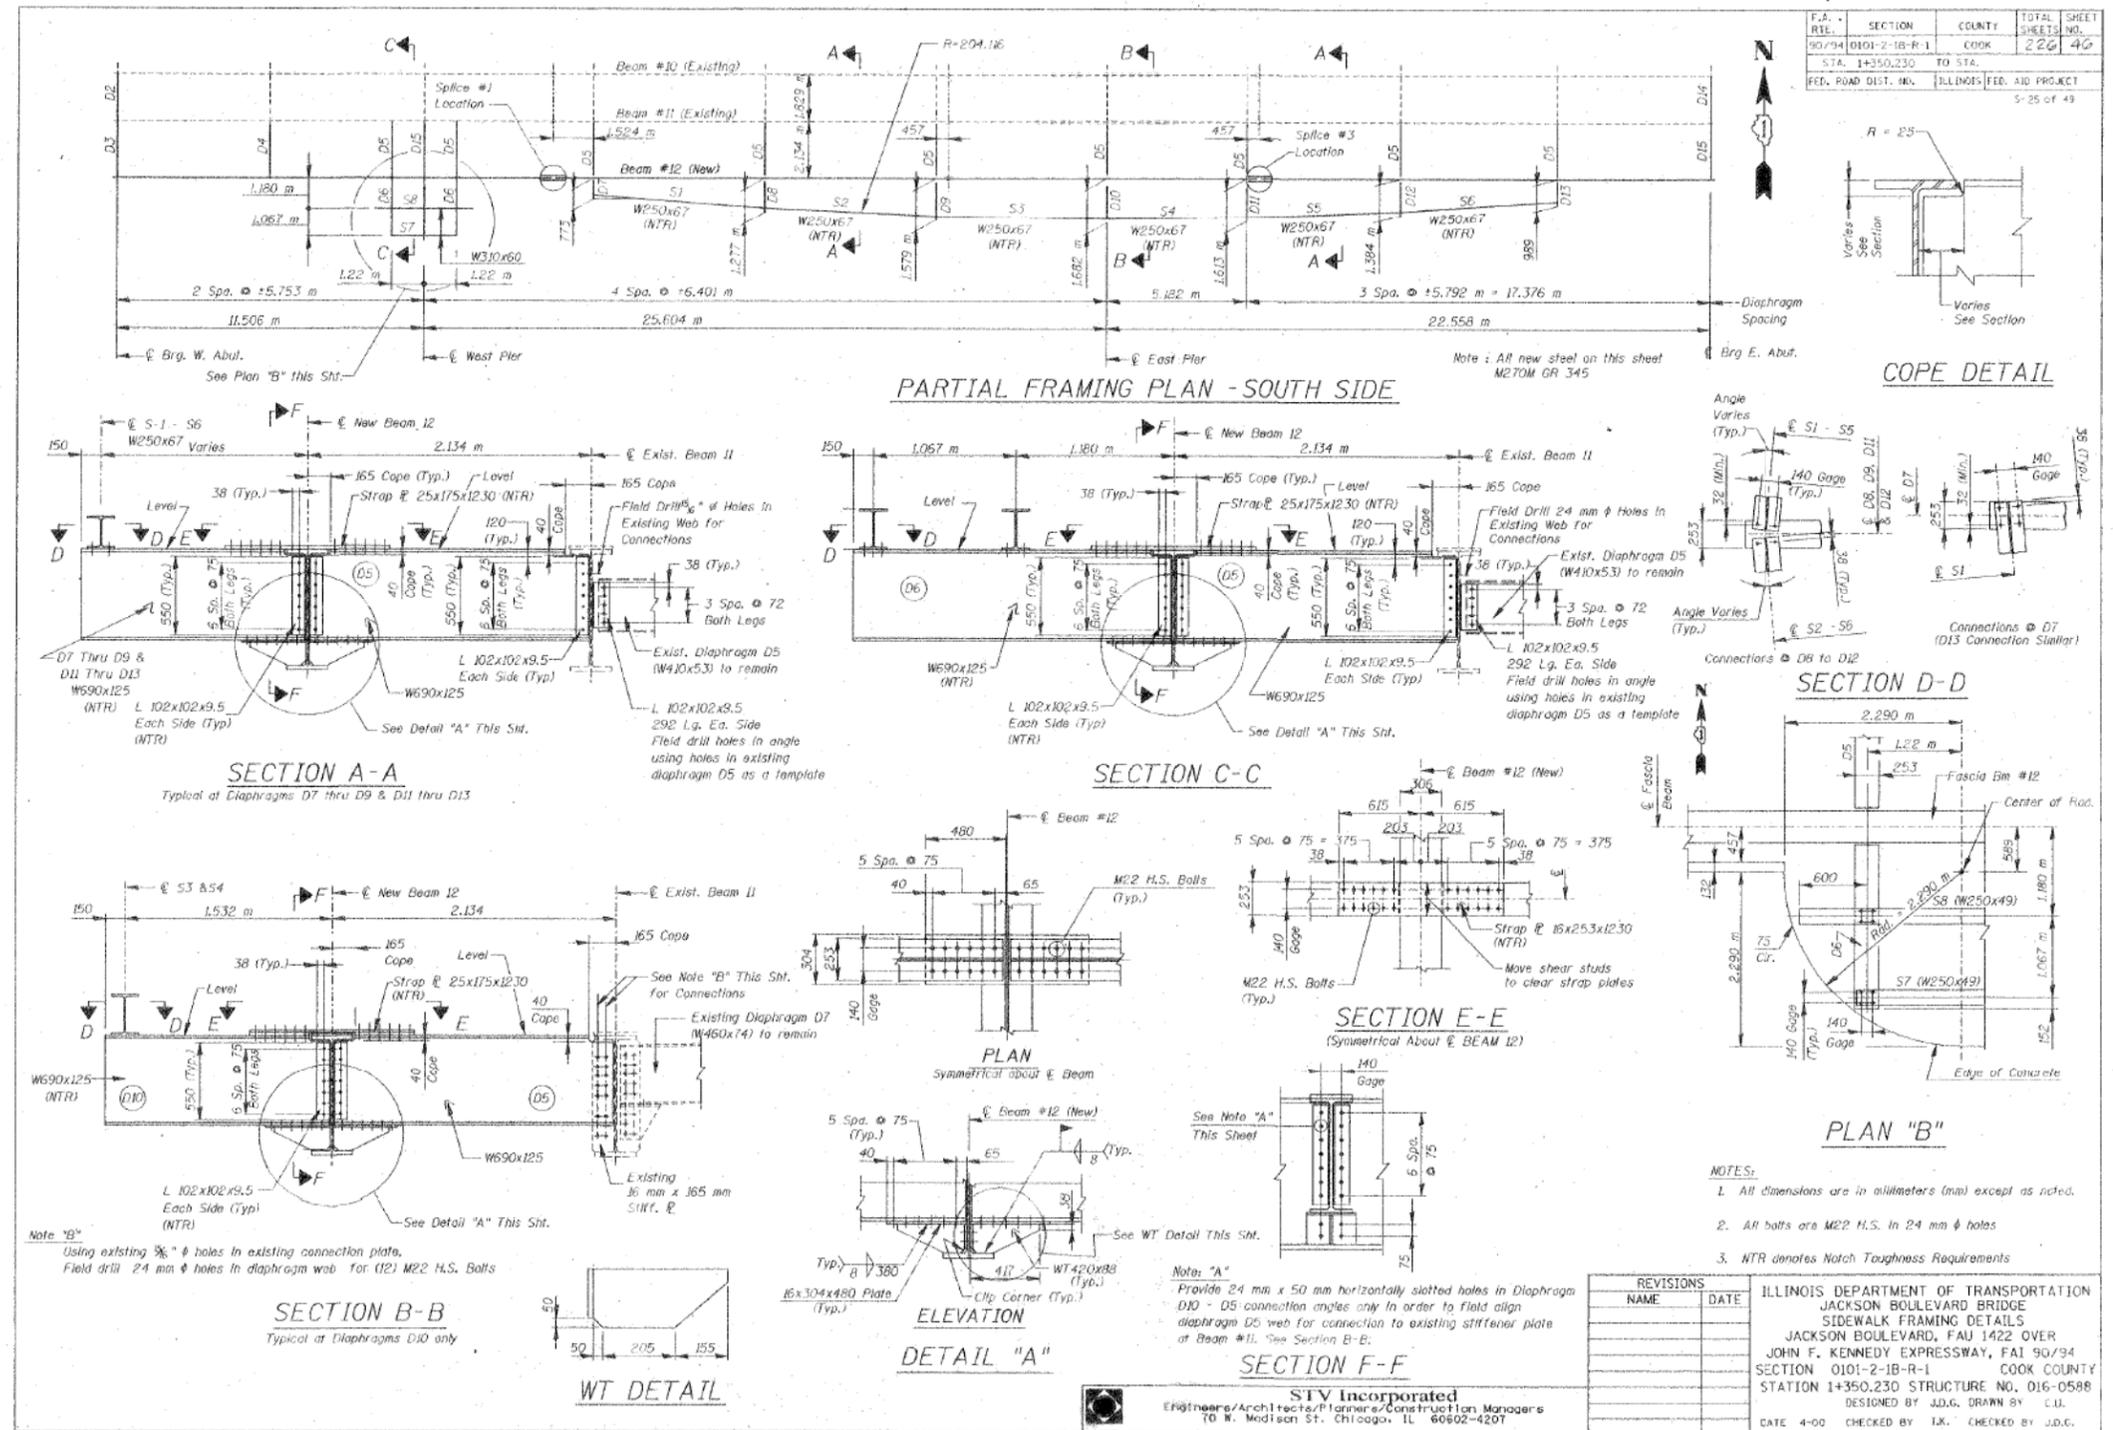

- NOTES:
- All dimensions are in millimeters (mm) except as noted.
 - All bolts are M22 H.S. in 24 mm ϕ holes
 - NTR denotes Notch Toughness Requirements

REVISIONS	NAME	DATE

ILLINOIS DEPARTMENT OF TRANSPORTATION
 JACKSON BOULEVARD BRIDGE
 SIDEWALK FRAMING DETAILS
 JACKSON BOULEVARD, FAU 1422 OVER
 JOHN F. KENNEDY EXPRESSWAY, FAU 90/94
 SECTION 0101-2-1B-R-1 COOK COUNTY
 STATION 1+350.230 STRUCTURE NO. 016-0588
 DESIGNED BY J.D.G. DRAWN BY C.U.
 DATE 4-00 CHECKED BY I.K. CHECKED BY J.D.G.

STV Incorporated
 Engineers/Architects/Planners/Construction Managers
 70 N. Madison St. Chicago, IL 60602-4207

6:46:39 PM
 D162331-SHT-AS-BUILT-25



USER NAME = wjcolletti	DESIGNED EH	REVISED
CHECKED WJC	REVISED	
PLOT SCALE = 0x2.0000 '1" / in.	DRAWN EH	REVISED
PLOT DATE = 8/13/2019	CHECKED WJC	REVISED

STATE OF ILLINOIS
 DEPARTMENT OF TRANSPORTATION


EXISTING JACKSON BLVD BRIDGE PLANS (SN 016-0588)

SHEET NO. AB-25 OF AB-65 SHEETS

F.A.I. R.T.E.	SECTION	COUNTY	TOTAL SHEETS	SHEET NO.
90/94/290	2014-017B	COOK	400	252
CONTRACT NO. 62J31				
ILLINOIS FED. AID PROJECT				

FOR INFORMATION ONLY

F.A.I. RTE.	SECTION	COUNTY	TOTAL SHEETS	SHEET NO.
90/94	0101-2-1B-R-1	COOK	226	47
STA. 1+350.230		TO STA.		
FED. ROAD DIST. NO.		ILLINOIS FED. AID PROJECT		

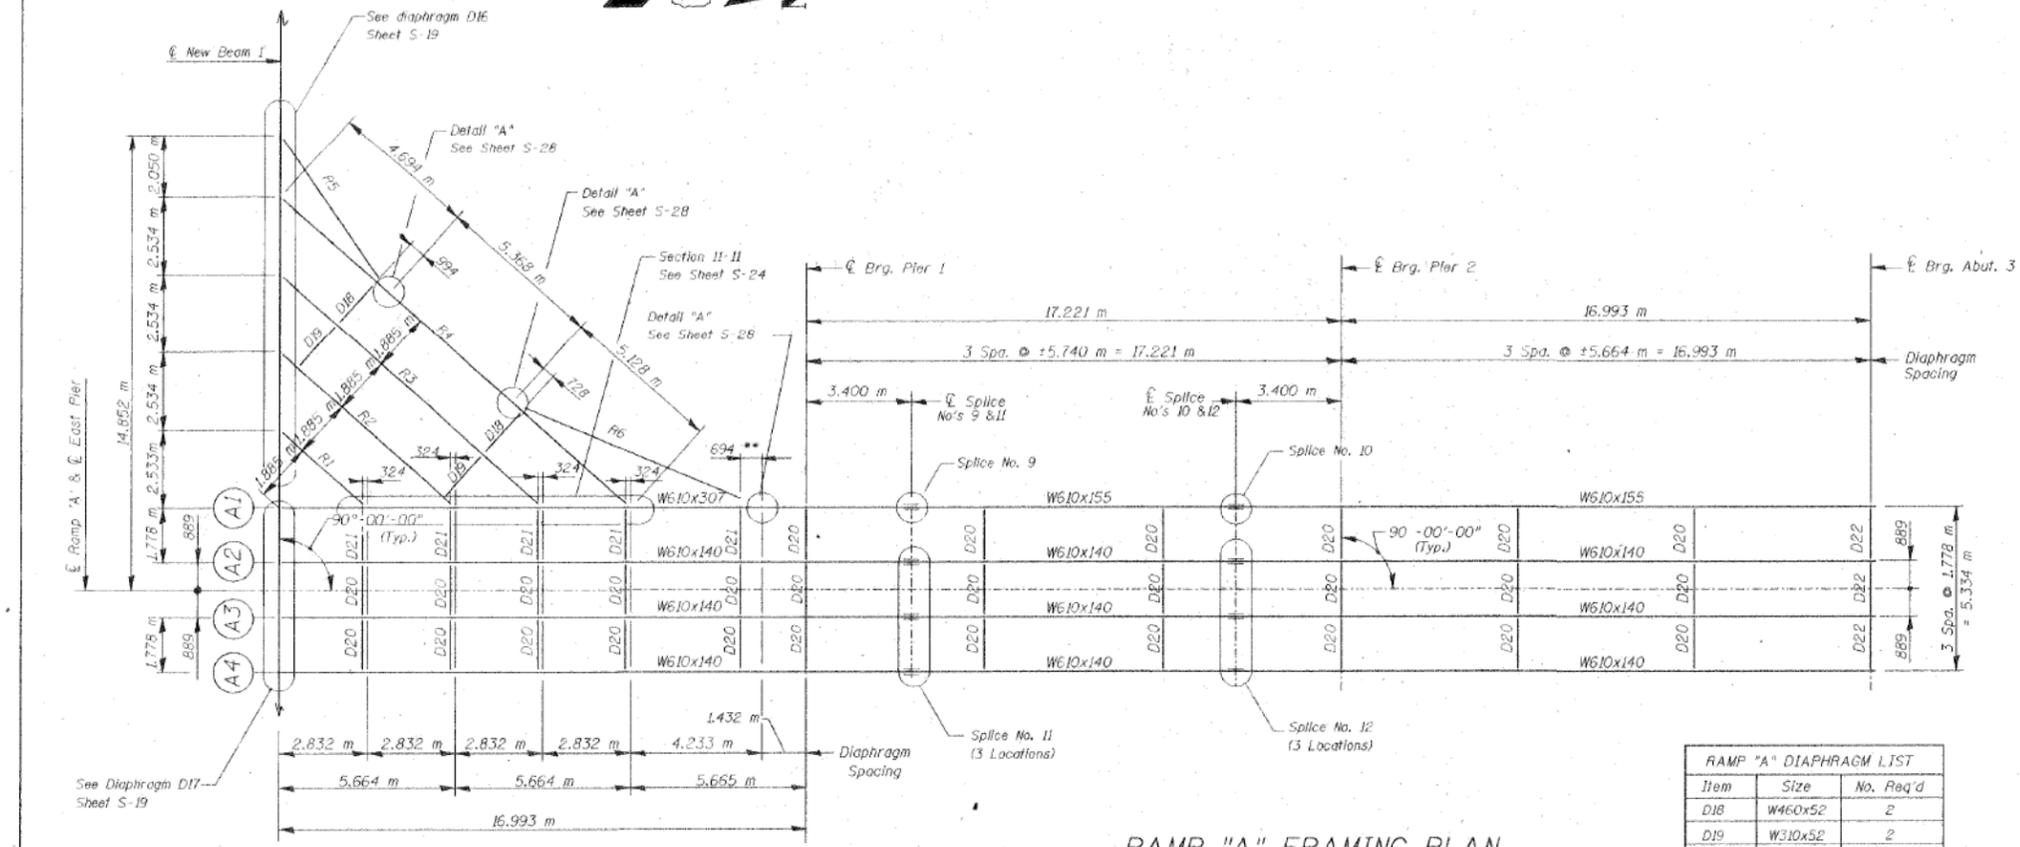

** Dimensions from centerline of diaphragm to theoretical work point. Typical for radius improvement framing.

RAMP "A" FRAMING PLAN
All W610 beams shall be M270M Grade 345

Item	Size	No. Req'd
D18	W460x52	2
D19	W310x52	2
D20	W310x52	28
D21	W460x52	5
D22	W250x49	3

LOCATION	ELEVATION
A1 - Beam 1	181.531
A1 - Pier 1	181.005
A1 - Splice 9	180.893
A1 - Splice 10	180.350
A1 - Pier 2	180.182
A1 - Abutment	179.308
A2 - Beam 1	181.495
A2 - Pier 1	180.969
A2 - Splice 11	180.865
A2 - Splice 12	180.324
A2 - Pier 2	180.166
A2 - Abutment	179.292
A3 - Beam 1	181.477
A3 - Pier 1	180.951
A3 - Splice 11	180.847
A3 - Splice 12	180.324
A3 - Pier 2	180.148
A3 - Abutment	179.274
A4 - Beam 1	181.459
A4 - Pier 1	180.933
A4 - Splice 11	180.829
A4 - Splice 12	180.306
A4 - Pier 2	180.130
A4 - Abutment	179.256
R1 - Beam 1	181.575
R1 - A1	181.443
R2 - Beam 1	181.588
R2 - A1	181.356
R3 - Beam 1	181.588
R3 - A1	181.268
R4 - Beam 1	181.588
R4 - A1	181.180
R5 - Beam 1	181.588
R5 - R4	181.462
R6 - R4	181.318
R6 - A1	181.049

- NOTES:
- All dimensions are in millimeters (mm) unless otherwise noted.
 - See sheet S28 for beam connection details and sheet S27 for diaphragm connection details.
 - Top of beam elevations are given for fabrication only and do not include thicknesses of splice plates.

REVISIONS	
NAME	DATE

ILLINOIS DEPARTMENT OF TRANSPORTATION
ENTRANCE RAMP "A" FRAMING
JACKSON BOULEVARD, FAU 1422 OVER
JOHN F. KENNEDY EXPRESSWAY, FAI 90/94
SECTION 0101-2-1B-R-1 COOK COUNTY
STATION 1+350.230 STRUCTURE NO. 016-0588
DESIGNED BY J.D.G. DRAWN BY C.U.
DATE 4-00 CHECKED BY T.K. CHECKED BY J.D.G.

STV Incorporated
Engineers/Architects/Planners/Construction Managers
70 W. Madison St. Chicago, IL 60602-4207

6:47:03 PM D162331-SHT-AS-BUILT-26



USER NAME = wjcolletti	DESIGNED EH	REVISED
PLOT SCALE = 0x2.0000 '1" / in.	CHECKED WJC	REVISED
PLOT DATE = 8/13/2019	DRAWN EH	REVISED
	CHECKED WJC	REVISED

STATE OF ILLINOIS
DEPARTMENT OF TRANSPORTATION











EXISTING JACKSON BLVD BRIDGE PLANS (SN 016-0588)

SHEET NO. AB-26 OF AB-65 SHEETS

F.A.I. RTE.	SECTION	COUNTY	TOTAL SHEETS	SHEET NO.
90/94/290	2014-017B	COOK	400	253
CONTRACT NO. 62J31				
ILLINOIS FED. AID PROJECT				

FOR INFORMATION ONLY

F.A. RTE.	SECTION	COUNTY	TOTAL SHEETS	SHEET NO.
90/94	0101-2-1B-R-1	COOK	226	48
STA. 1+350.230		TO STA.		
FED. ROAD DIST. NO. 7		ILLINOIS FED. AID PROJECT		
S-27 of 49				

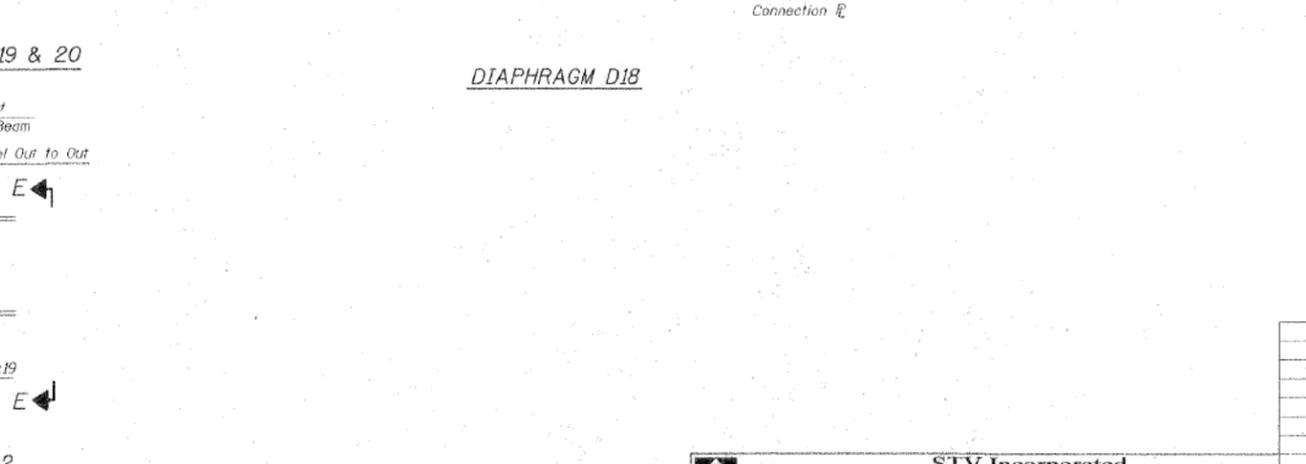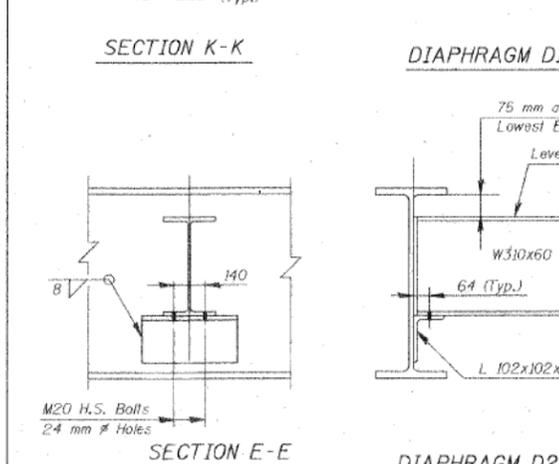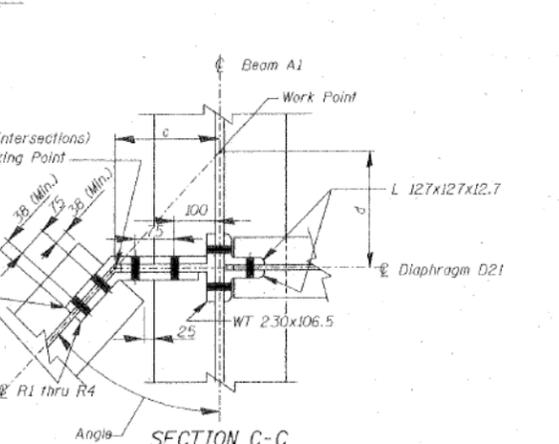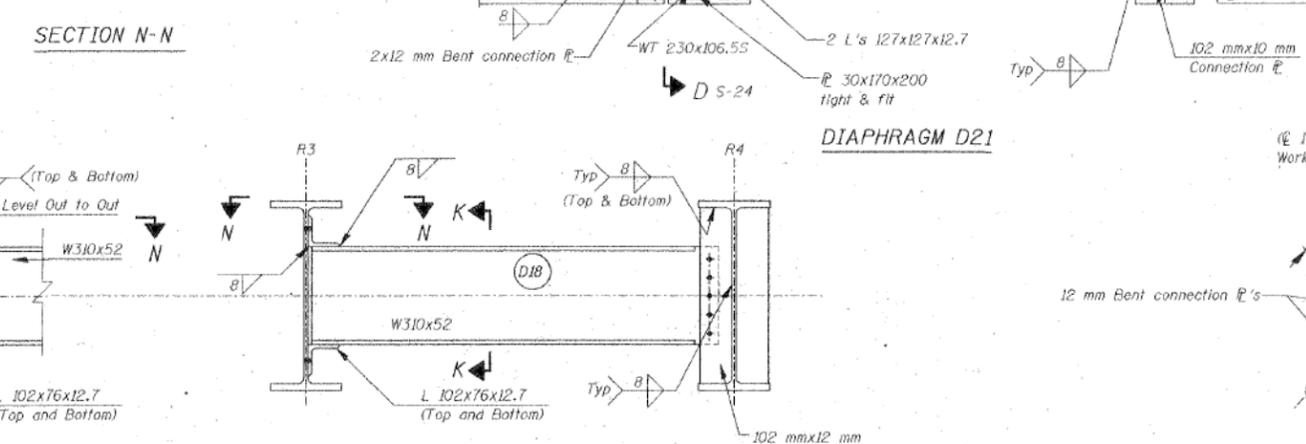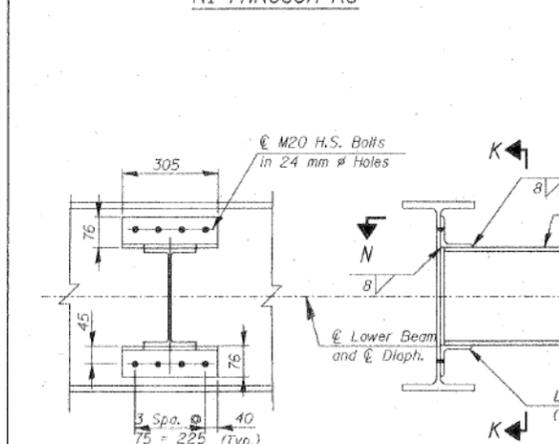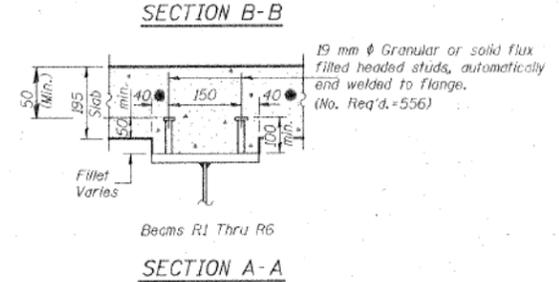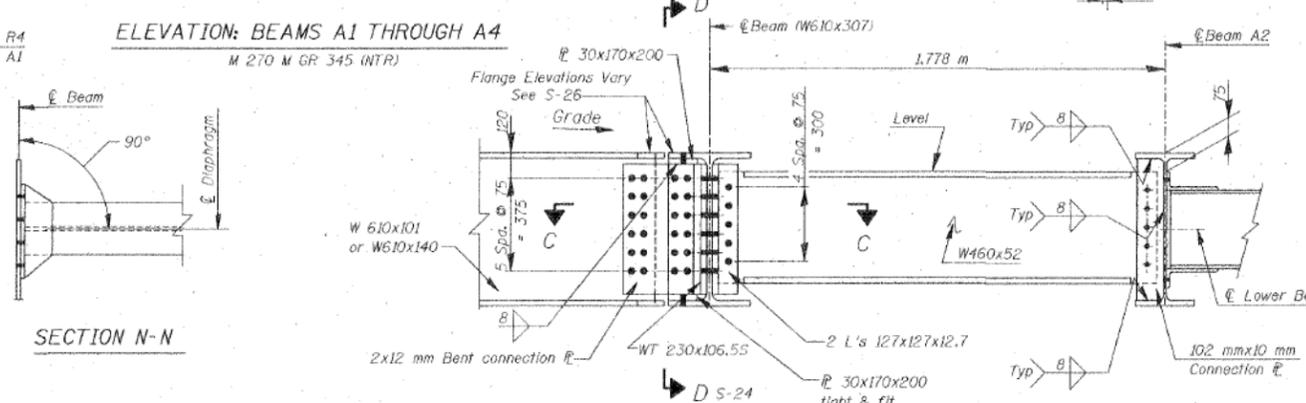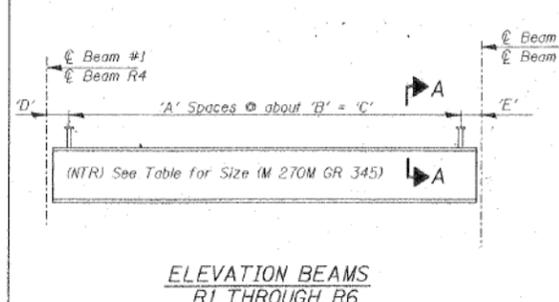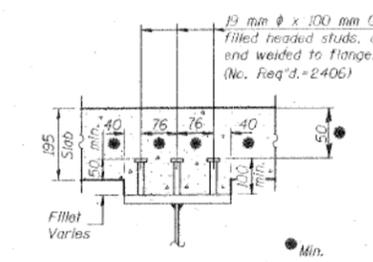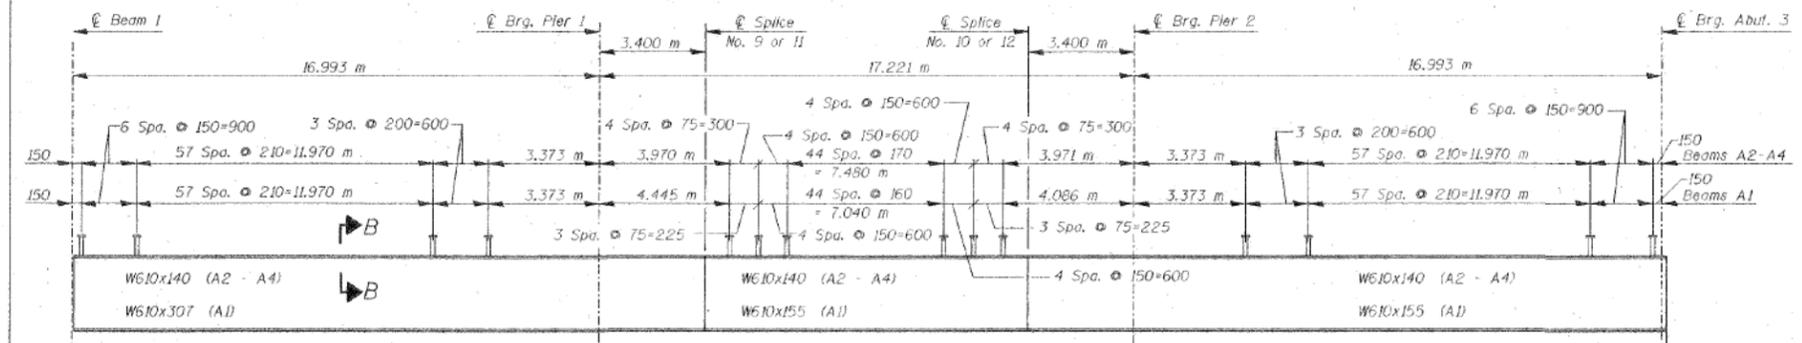

Beam	Size	'A'	'B'	'C'	'D'	'E'	C
R1	W610x101	19	150	2.850m	477	471	2.85
R2	W610x101	90	75	2.850m	392	454	6.75
R3	W610x101	48	220	2.850m	387	454	10.50
R4	W610x140	95	150	2.850m	437	504	14.25
R5	W610x101	8	560	2.850m	629	1.14m	4.48
R6	W610x101	12	560	6.720m	1027	1.013m	10.72



Angle	c	d	
R1 thru R4	41°49'17"	295	324

REVISIONS		ILLINOIS DEPARTMENT OF TRANSPORTATION ENTRANCE RAMP "A" BEAM ELEVATIONS & DIAPHRAGM DETAILS JACKSON BOULEVARD, FAU 1422 OVER JOHN F. KENNEDY EXPRESSWAY, FAI 90/94 SECTION 0101-2-1B-R-1 COOK COUNTY STATION 1+350.230 STRUCTURE NO. 016-0588 DESIGNED BY J.D.G. DRAWN BY C.U.
NAME	DATE	
		DATE 4-00 CHECKED BY I.K. CHECKED BY J.D.G.

STV Incorporated
Engineers/Architects/Planners/Construction Managers
70 W. Madison St. Chicago, IL 60602-4207

STATE OF ILLINOIS
DEPARTMENT OF TRANSPORTATION

EXISTING JACKSON BLVD BRIDGE PLANS (SN 016-0588)

SHEET NO. AB-27 OF AB-65 SHEETS

F.A.I. RTE.	SECTION	COUNTY	TOTAL SHEETS	SHEET NO.
90/94/290	2014-017B	COOK	400	254
CONTRACT NO. 62J31				ILLINOIS FED. AID PROJECT


6:47:25 PM 016231-SHT-AS-BUILT-27





USER NAME = wjcolletti	DESIGNED EH	REVISED
PLOT SCALE = 0x2.0000 '1' / in.	CHECKED WJC	REVISED
PLOT DATE = 8/13/2019	DRAWN EH	REVISED
	CHECKED WJC	REVISED

FOR INFORMATION ONLY

F.A.I. RTE.	SECTION	COUNTY	TOTAL SHEETS	SHEET NO.
90/94	0101-2-1B-R-1	COOK	226	49
STA. 1+350.230		TO STA.		
FED. ROAD DIST. NO.	ILLINOIS FED. AID PROJECT		5-28 of 49	

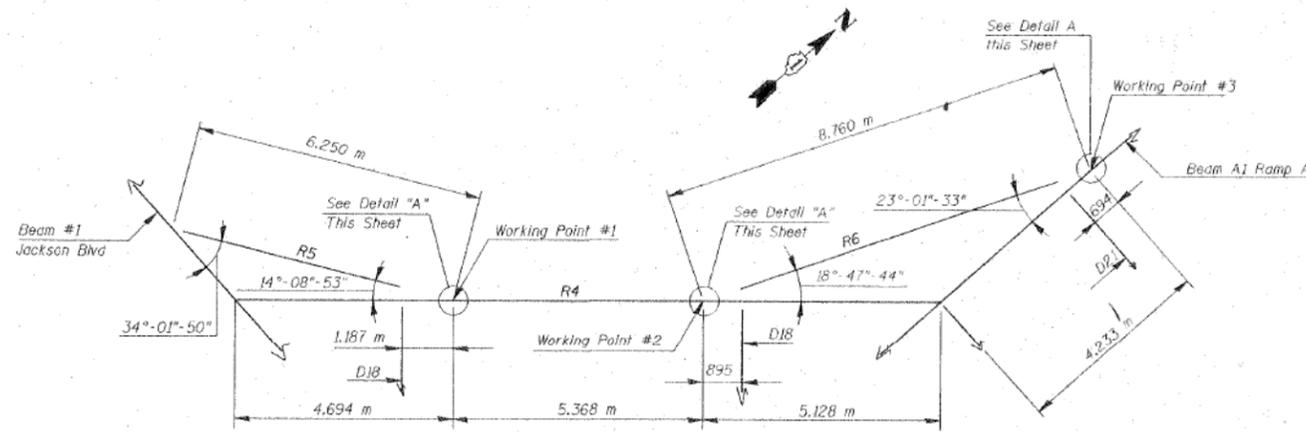

FASCIA BEAM FRAMING AT RAMP "A" WIDENING

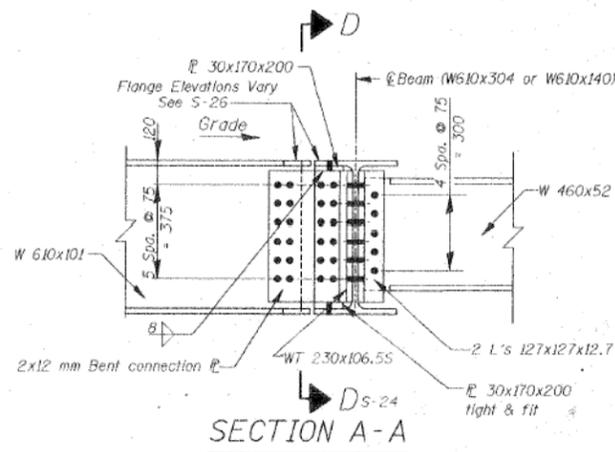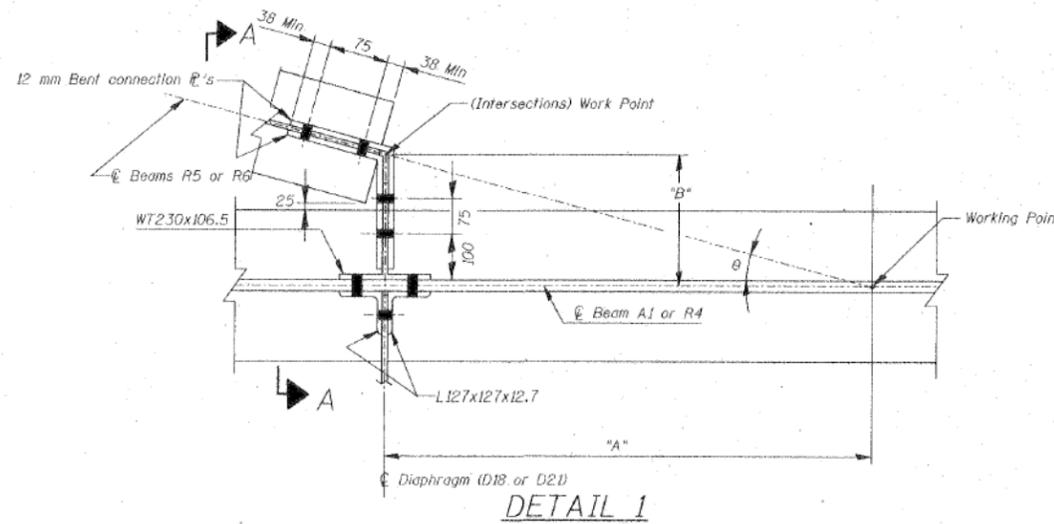

STV Incorporated
 Engineers/Architects/Planners/Construction Managers
 70 W. Madison St. Chicago, IL 60602-4207

REVISIONS	
NAME	DATE

ILLINOIS DEPARTMENT OF TRANSPORTATION
 ENTRANCE RAMP "A"
 BEAM CONNECTION DETAILS
 JACKSON BOULEVARD, FAU 1422 OVER
 JOHN F. KENNEDY EXPRESSWAY, FAI 90/94
 SECTION 0101-2-1B-R-1 COOK COUNTY
 STATION 1+350.230 STRUCTURE NO. 016-0585
 DESIGNED BY J.D.G. DRAWN BY C.J.I.
 DATE 4-00 CHECKED BY I.K. CHECKED BY J.D.G.

6:47:49 PM
 D:\6231-SHT-AS-BUILT-28



USER NAME = wjcolletti	DESIGNED EH	REVISED
PLOT SCALE = 0x2.0000 '1" / in.	CHECKED WJC	REVISED
PLOT DATE = 8/13/2019	DRAWN EH	REVISED
	CHECKED WJC	REVISED

STATE OF ILLINOIS
 DEPARTMENT OF TRANSPORTATION

EXISTING JACKSON BLVD BRIDGE PLANS (SN 016-0588)

SHEET NO. AB-28 OF AB-65 SHEETS

F.A.I. RTE.	SECTION	COUNTY	TOTAL SHEETS	SHEET NO.
90/94/290	2014-017B	COOK	400	255
				CONTRACT NO. 62J31
ILLINOIS FED. AID PROJECT				

FOR INFORMATION ONLY

F.A. RTE.	SECTION	COUNTY	TOTAL SHEETS	SHEET NO.
90/94	0101-2-1B-R-1	COOK	226	51
STA. 1+350.230		TO STA.		
FED. ROAD DIST. NO.		ILLINOIS FED. AID PROJECT		
5-30 of 49				

	0.4 Sp. 1	Pier 1	0.5 Sp. 2	Pier 2	0.6 Sp. 3
I_s (10^6 mm ⁴)	1123	1123	1123	1123	1123
I_c (in) (10^6 mm ⁴)	3520		3520		3520
I_c (sn) (10^6 mm ⁴)	2560		2560		2560
S_s (10^3 mm ³)	3632	3632	3632	3632	3632
S_c (in) (10^3 mm ³)	5819		5819		5819
S_c (sn) (10^3 mm ³)	5214		5214		5214
Z (10^3 mm ³)					
\bar{Q} (kN/m)	10.11	15.98	10.11	15.98	10.11
$M\bar{Q}$ (kN·m)	233	446	80	432	233
$s\bar{Q}$ (kN/m)	5.87		5.87		5.87
$M_s\bar{Q}$ (kN·m)	149		80		149
M_t (kN·m)	325	235	267	235	325
M (Imp) (kN·m)	90	66	73	66	90
$S_3(M_t + M_{Imp})$ (kN·m)	692	503	567	503	692
M_a (kN·m)	1341	1210	945	1216	1396
M_u (kN·m)	2008		2008		2008
$f_s\bar{Q}$ non-comp (MPa)	64	119		119	64
$f_s\bar{Q}$ (comp) (MPa)	29		15		29
$f_s^{5/8}(k + Imp)$ (MPa)	119	139	97	139	119
f_s (Overload) (MPa)	207	258	134	258	207
f_s (Total) (MPa)		335		335	
R (Total) (kN)	160	188	109	176	110

	R1	R2	R3	R4	R5	R6
I_s (10^6 mm ⁴)	764	764	764	1120	764	764
I_c (in) (10^6 mm ⁴)	2662	2662	2662	3386	2662	2662
I_c (sn) (10^6 mm ⁴)	2002	2002	2002	2434	2002	2002
S_s (10^3 mm ³)	2530	2530	2530	3630	2530	2530
S_c (in) (10^3 mm ³)	4264	4264	4264	5719	4264	4264
S_c (sn) (10^3 mm ³)	3848	3848	3848	5100	3848	3848
Z (10^3 mm ³)						
\bar{Q} (kN/m)	3.21	3.21	3.21	3.21	8.91	8.91
$M\bar{Q}$ (kN·m)	18	73	169	377	41	81
$s\bar{Q}$ (kN/m)	9.03	9.09	9.41	11.65	2.77	2.77
$M_s\bar{Q}$ (kN·m)	6	23	52	93	13	26
M_t (kN·m)	62	150	240	462	60	170
M (Imp) (kN·m)	25	45	72	139	24	51
$S_3(M_t + M_{Imp})$ (kN·m)	177	326	521	1004	174	369
M_a (kN·m)	262	549	965	1917	297	619
M_u (kN·m)	1471	1471	1471	1873	1471	1471
$f_s\bar{Q}$ non-comp (MPa)	7	29	67	94	10	20
$f_s\bar{Q}$ (comp) (MPa)	2	6	14	18	3	6
$f_s^{5/8}(k + Imp)$ (MPa)	44	76	122	176	30	65
f_s (Overload) (MPa)	53	111	203	288	43	91
f_s (Total) (MPa)						
R (Total) (kN)	82	130	211	211		

I_s and S_s are the moment of inertia and section modulus of the steel section used in computing f_s (Total & Overload).
 $I_{c(s)}$ and $S_{c(s)}$ are the moment of inertia and section modulus of the composite section used in computing stresses due to Live Load.
 $I_{c(w)}$ and $S_{c(w)}$ are the moment of inertia and section modulus of the composite section used in computing stresses due to superimposed dead loads. (see AASHTO 10.38)
 VR is the maximum Live Load + Impact shear range in span.
 Z is the plastic section modulus used to determine the fully plastic moments in the non-composite areas.
 M_a (Applied Moment) = $1.3(M\bar{Q} + M_s\bar{Q} + S_3(M_t + M_{Imp}))$.
 The Plastic Moment capacity (M_u) is computed according to AASHTO 10.48.1 and 10.50.1.1.
 f_s (Overload) is the sum of the stresses due to $M\bar{Q} + M_s\bar{Q} + S_3(M_t + M_{Imp})$.
 f_s (Total) (Non-compact section) is the sum of the stresses due to $1.3(M\bar{Q} + M_s\bar{Q} + S_3(M_t + M_{Imp}))$.
 Note: All dimensions are in millimeters (mm) except as noted.

	At Beam 1	Pier 1	Pier 2	Abut.
$R\bar{Q}$ (kN)	69	191	191	69
$R\bar{Q}$ (kN)	42	108	108	42
$R\bar{k}$ (kN)	199	241	241	199
$Imp.$ (kN)	55	66	66	55
R (Total) (kN)	365	606	606	365

	R1	R2	R3	R4	R5	R6
$R\bar{Q}$ (kN)	19	38	59	99	27	38
$R\bar{Q}$ (kN)	6	12	18	25	9	12
$R\bar{k}$ (kN)	118	149	191	215	93	107
$Imp.$ (kN)	35	45	57	64	28	32
R (Total) (kN)	178	244	325	403	157	190

	0.4 Sp. 1	Pier 1	0.5 Sp. 2	Pier 2	0.6 Sp. 3
I_s (10^6 mm ⁴)	2840	2840	1290	1290	1290
I_c (in) (10^6 mm ⁴)	6723		3737		3737
I_c (sn) (10^6 mm ⁴)	4719		2691		2691
S_s (10^3 mm ³)	8700	8700	4220	4220	4220
S_c (in) (10^3 mm ³)	12,432		6427		6427
S_c (sn) (10^3 mm ³)	10,944		5766		5766
Z (10^3 mm ³)					
\bar{Q} (kN/m)	5.98	12.80	9.12	12.80	9.12
$M\bar{Q}$ (kN·m)	505	650	31	379	302
$s\bar{Q}$ (kN/m)	2.14		3.68		3.68
$M_s\bar{Q}$ (kN·m)	118		37		95
M_t (kN·m)	595	254	246	231	323
M (Imp) (kN·m)	167	71	69	65	91
$S_3(M_t + M_{Imp})$ (kN·m)	1273	543	526	495	692
M_a (kN·m)	2465	1551	773	1137	1416
M_u (kN·m)	3002		1456		1456
$f_s\bar{Q}$ non-comp (MPa)	58	75	7	90	71
$f_s\bar{Q}$ (comp) (MPa)	10		6		15
$f_s^{5/8}(k + Imp)$ (MPa)	97	63	78	117	102
f_s (Overload) (MPa)	165	138	91	207	188
f_s (Total) (MPa)		180		270	
R (Total) (kN)	139		142		127

	At Beam 1	Pier 1	Pier 2	Abut.
$R\bar{Q}$ (kN)	126	340	239	96
$R\bar{Q}$ (kN)	26	82	67	25
$R\bar{k}$ (kN)	135	168	130	106
$Imp.$ (kN)	38	47	36	30
R (Total) (kN)	325	637	472	257

REVISIONS	
NAME	DATE

ILLINOIS DEPARTMENT OF TRANSPORTATION
 ENTRANCE RAMP "A"
 MOMENT AND REACTION TABLES
 JACKSON BOULEVARD, FAU 1422 OVER
 JOHN F. KENNEDY EXPRESSWAY, FAI 90/94
 SECTION 0101-2-1B-R-1 COOK COUNTY
 STATION 1+350.230 STRUCTURE NO. 016-0588
 DESIGNED BY J.D.G. DRAWN BY C.J.J.
 DATE 4-00 CHECKED BY I.K. CHECKED BY J.D.G.

STV Incorporated
 Engineers/Architects/Planners/Construction Managers
 70 W. Madison St. Chicago, IL 60602-4207

6:48:34 PM
 D16231-SHT-AS-BUILT-30



USER NAME = wjcolletti	DESIGNED EH	REVISED
PLOT SCALE = 0x2.0000 'x' / in.	CHECKED WJC	REVISED
PLOT DATE = 8/13/2019	DRAWN EH	REVISED
	CHECKED WJC	REVISED

STATE OF ILLINOIS
 DEPARTMENT OF TRANSPORTATION

EXISTING JACKSON BLVD BRIDGE PLANS (SN 016-0588)


SHEET NO. AB-30 OF AB-65 SHEETS

F.A.I. RTE.	SECTION	COUNTY	TOTAL SHEETS	SHEET NO.
90/94/290	2014-017B	COOK	400	257
				CONTRACT NO. 62J31
ILLINOIS FED. AID PROJECT				


FOR INFORMATION ONLY

F.A. RTE.	SECTION	COUNTY	TOTAL SHEETS	SHEET NO.
90/94	0101-2-1B-R-1	COOK	226	52
STA. 1+350.230		TO STA.		
FED. ROAD DIST. NO. 7		ILLINOIS FED. AID PROJECT		


5-31 of 49

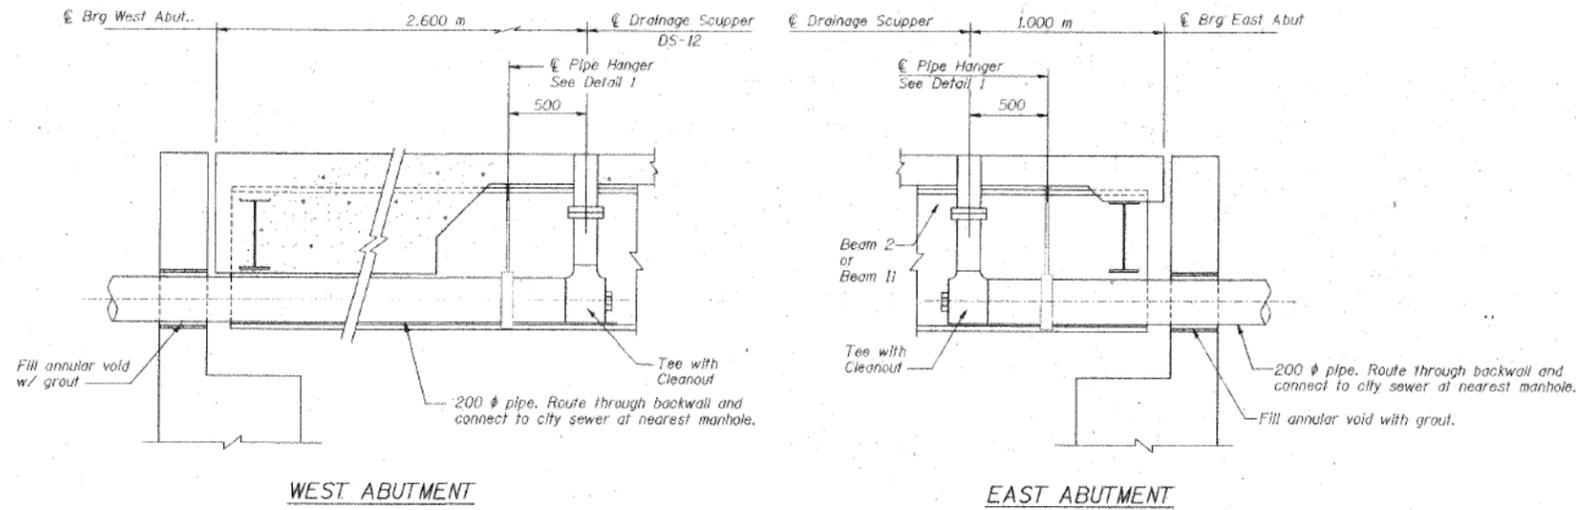

SCUPPER DETAIL AT EAST & WEST ABUTMENT

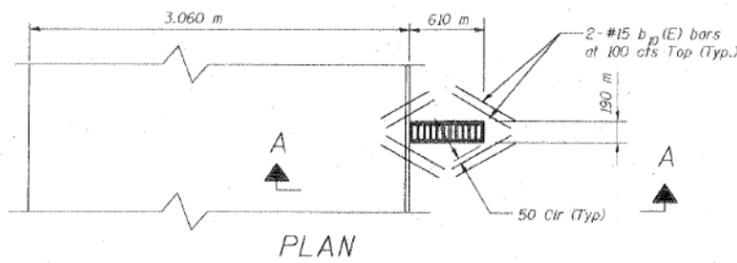


PLAN

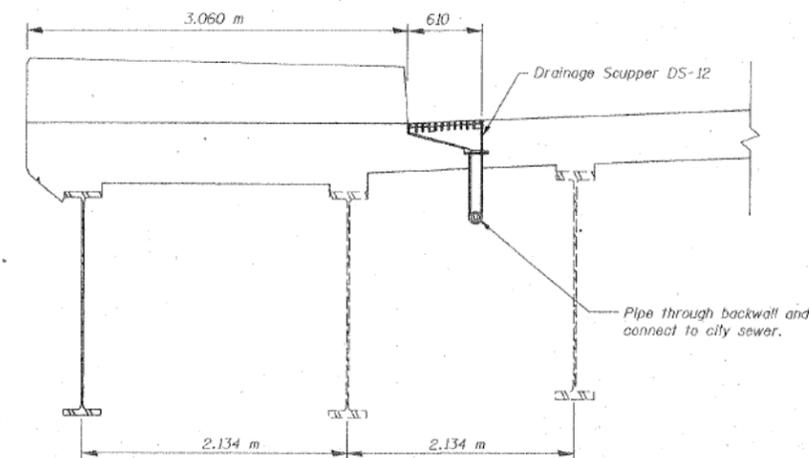

SECTION A-A


Note: Reinforcement bars designated (E) shall be epoxy coated. Cut longitudinal reinforcement to clear drainage scupper.

Note: See Special Provisions for Drainage System.

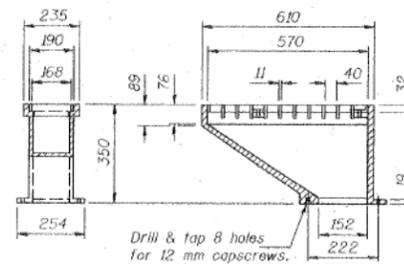

DRAINAGE SCUPPER DS-12

Notes:
 Floor drains need not be painted.
 Fiberglass pipe shall conform to ASTM D 2996, with short-time rupture strength hoop tensile stress of 200 MPa minimum.
 All cast iron parts shall be gray iron conforming to the requirements of AASHTO M 105, Class 35B.
 Bolts, nuts and washers shall conform to the requirements of ASTM A 307. All bolts and washers shall be galvanized according to AASHTO M 232. As an alternate, bolts and washers may be stainless steel conforming to the requirements of ASTM A 193M, Type 304.
 Cost of the Grate, Frame, Downspout, bolts and washers including complete installation of the scupper will be paid for at the unit bid price each for Drainage Scuppers. (DS-12)
 Structural steel weldments of equal sections may be substituted for cast iron. Details shall be submitted to the Engineer for approval.

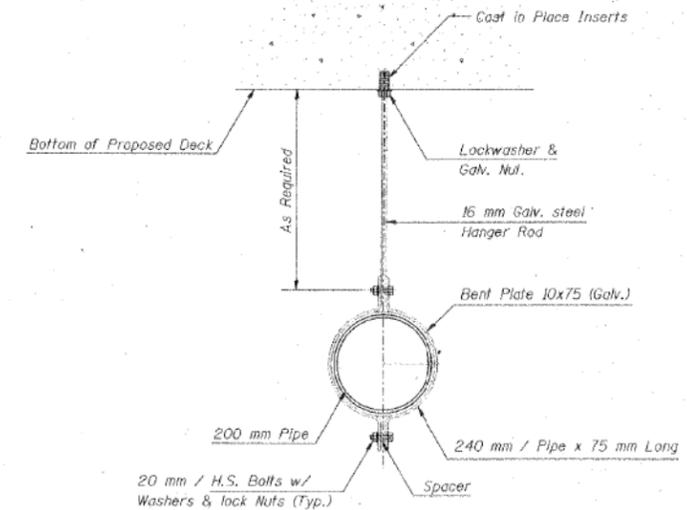

DETAIL 1

Note:
 1. The downspout connection may be threaded or a bolted flange, or other method approved by the Engineer.
 2. All dimensions are in millimeters (mm) except as noted.

REVISIONS		NAME	DATE
NO.	DESCRIPTION		

ILLINOIS DEPARTMENT OF TRANSPORTATION
 BRIDGE DRAINAGE DETAILS
 JACKSON BOULEVARD, FAU 1422 OVER
 JOHN F. KENNEDY EXPRESSWAY, FAI 90/94
 SECTION 0101-2-1B-R-1 COOK COUNTY
 STATION 1+350.230 STRUCTURE NO. 016-0588
 DESIGNED BY J.D.G. DRAWN BY C.U.
 DATE 4-00 CHECKED BY L.K. CHECKED BY J.D.G.

STV Incorporated
 Engineers/Architects/Planners/Construction Managers
 70 W. Madison St. Chicago, IL 60602-4207

STATE OF ILLINOIS
 DEPARTMENT OF TRANSPORTATION

EXISTING JACKSON BLVD BRIDGE PLANS (SN 016-0588)

SHEET NO. AB-31 OF AB-65 SHEETS

F.A.I. RTE.	SECTION	COUNTY	TOTAL SHEETS	SHEET NO.
90/94/290	2014-017B	COOK	400	258
				CONTRACT NO. 62J31
ILLINOIS FED. AID PROJECT				

6:48:56 PM
 D162331-SHT-AS-BUILT-31

TranSystems

USER NAME = wjcollett1	DESIGNED	EH	REVISED
	CHECKED	WJC	REVISED
PLOT SCALE = 0x2.0000 '1" / in.	DRAWN	EH	REVISED
PLOT DATE = 8/13/2019	CHECKED	WJC	REVISED

FOR INFORMATION ONLY


SCALE	SECTION	DATE	SHEET	5-32 of 49
		226	53	
FILE NO. (REV. NO.)	SCALE	FILE NO. (PROJECT)		

Joint Size	"C" at 10 °C	"D" at 10 °C
50	50	40 Min.
65	65	45 Min.
100	75	65 Min.

INSTALLATION NOTES

- Install continuous seal in roadway, parapet, curb, and sidewalk.
- Install anchor blocks as indicated.

NOTE A: Maximum spacing of anchor bolts shall be 300 centers.

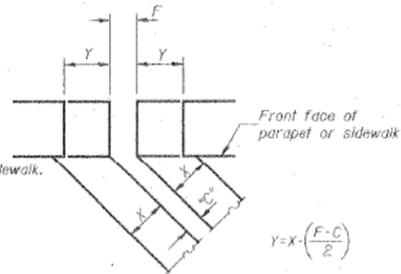


$$Y = X \cdot \left(\frac{F-C}{2} \right)$$

For dimension "F" see sheet # S17


FORMING BLOCKOUT SKETCH

SKREW LIMITATIONS

The details of the anchor blocks and the elastomeric membrane in the parapet, as shown, are for up to 50° skews. For skews greater than 50°, the anchor blocks and the elastomeric membrane, installed according to dimension "D", might require modifications to insure a minimum clearance of 40 mm from centerline of anchor studs to edge of parapet opening. The anchor blocks and the elastomeric membrane shall also be installed to the top of the parapet with the anchor studs spaced at ±300 cts.

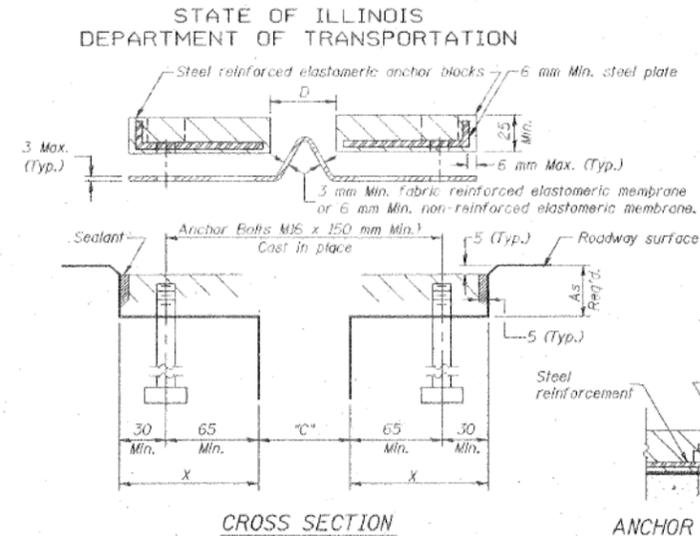


CROSS SECTION

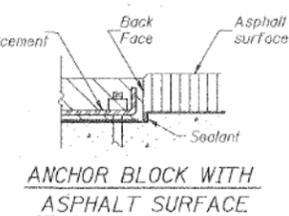


ANCHOR BLOCK WITH ASPHALT SURFACE

GENERAL NOTES


Continuous Seal Neoprene Expansion Joint shall consist of molded anchor blocks of elastomer and steel, field assembled over continuous lengths of elastomeric membrane.
 The elastomeric membrane shall be premolded with a single or a double upward convolution that will have a "memory" to return to its molded position upon joint closure.
 The convolution length shall be such that the extended length will not be greater than the manufactured length when the joint is fully expanded in its design range and will not protrude above the anchor blocks when the joint is fully compressed.
 Joint openings shall be adjusted according to Article 503.10(c) of the Standard Specifications when the deck is poured at an ambient temperature other than 10 °C.
 The parapet and roadway membrane shall be made continuous by an approved vulcanizing process. Lapping will not be permitted.
 All dimensions are in millimeters (mm) except as noted.

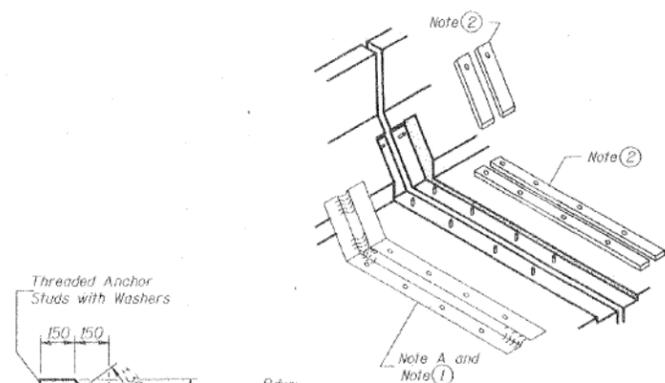


AT PARAPET

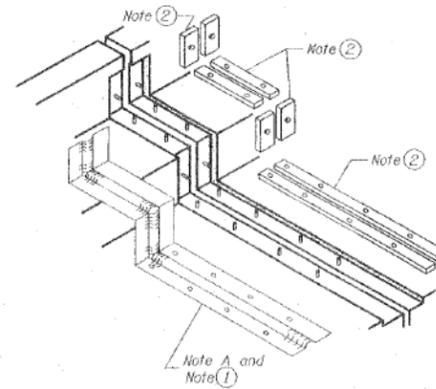


AT SIDEWALK OR MEDIAN

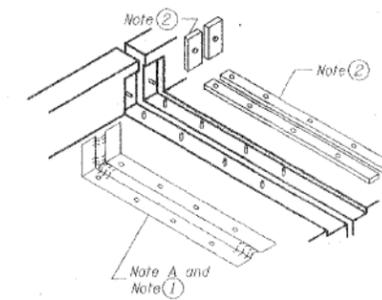


AT WALL

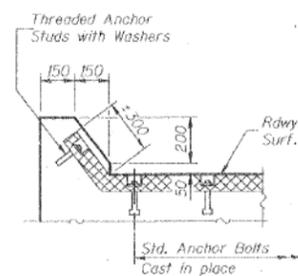


AT CURB

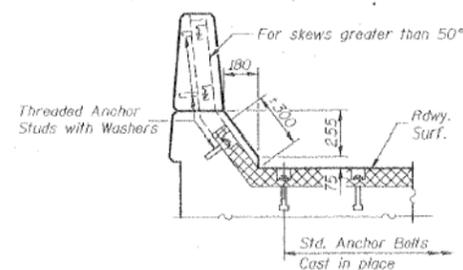

AT PARAPET

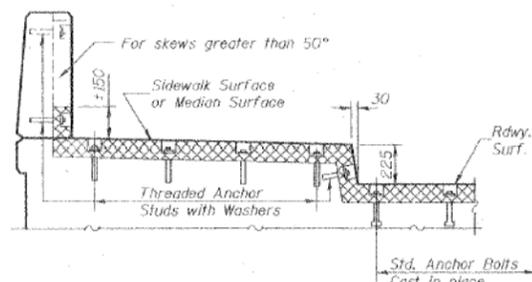

AT SIDEWALK OR MEDIAN
TYPICAL END TREATMENTS

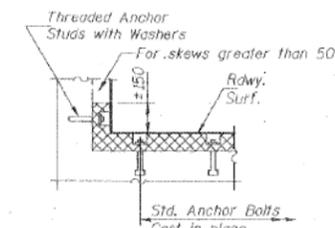

AT WALL AND CURB

CONTINUOUS SEAL TYPE
NEOPRENE EXPANSION JOINTS
For 50, 65 and 100 Movement

JACKSON BOULEVARD, FAU 1422 OVER
JOHN F. KENNEDY EXPRESSWAY, FAI 90/94
SECTION 0101-2-1B-R-1 COOK COUNTY
STATION 1+350.230 STRUCTURE NO. 016-0588

EJ-CS (M) 4-30-97

6:49:19 PM
D162331-SHT-AS-BUILT-32



USER NAME = wjcolletti	DESIGNED	EH	REVISED
	CHECKED	WJC	REVISED
PLOT SCALE = 0x2.0000 "1" / in.	DRAWN	EH	REVISED
PLOT DATE = 8/13/2019	CHECKED	WJC	REVISED

STATE OF ILLINOIS
DEPARTMENT OF TRANSPORTATION


EXISTING JACKSON BLVD BRIDGE PLANS (SN 016-0588)

SHEET NO. AB-32 OF AB-65 SHEETS


F.A.I. RTE.	SECTION	COUNTY	TOTAL SHEETS	SHEET NO.
90/94/290	2014-017B	COOK	400	259
ILLINOIS FED. AID PROJECT			CONTRACT NO. 62J31	

FOR INFORMATION ONLY


F.A. RTE.	SECTION	COUNTY	TOTAL SHEETS	SHEET NO.
90/94	0101-2-1B-R-1	COOK	220	54
STA. 1+350.230		TO STA.		
FED. ROAD DIST. NO. 7		ILLINOIS		FED. AID PROJECT

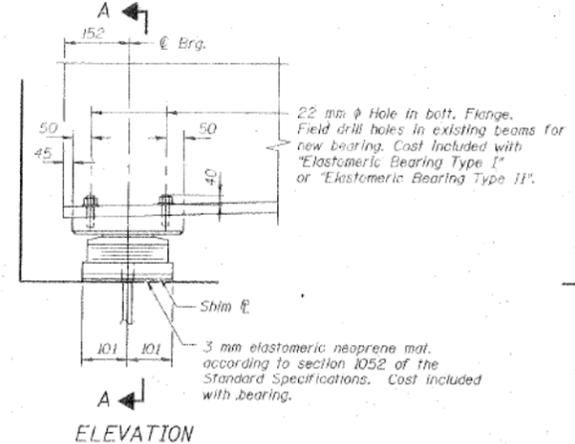


TYPE II ELASTOMERIC EXP. BRG. WEST ABUTMENT

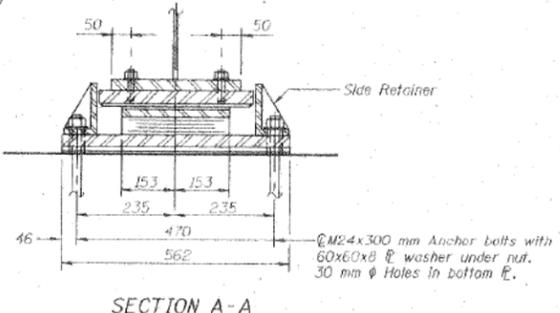


SECTION A-A
Notes: See sheet # 537 for Anchor Bolt installation. All dimensions are in millimeters (mm) except as noted.

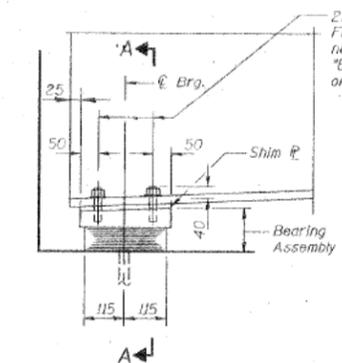


TYPE I ELASTOMERIC EXP. BRG. EAST ABUTMENT

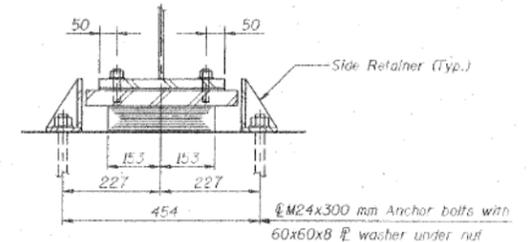


SECTION A-A

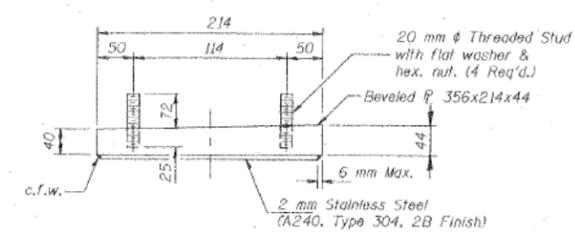

TOP BEARING ASSEMBLY WEST ABUT.

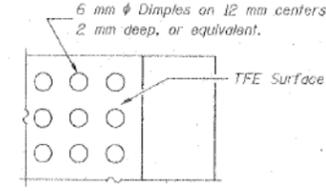


PLAN-TFE SURFACE

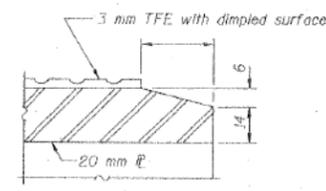

SECTION THRU TFE


Note: The 3 mm TFE sheet shall be bonded directly to the top steel plate with a two-component, medium viscosity epoxy resin, conforming to the requirements of the Federal Specification MMM-A-134, Type I. The bond agent shall be applied on the full area of the contact surfaces.

Bonding of 3 mm TFE sheet during vulcanizing process will be permitted provided the process and method of adjusting assembly height is approved by the Engineer.

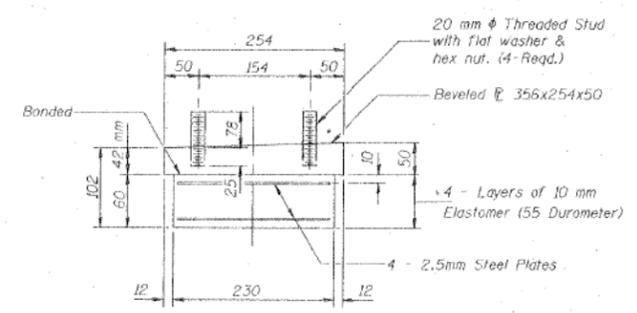

BEARING ASSEMBLY EAST ABUTMENT


Note: Shim plates shall not be placed under Bearing Assembly.

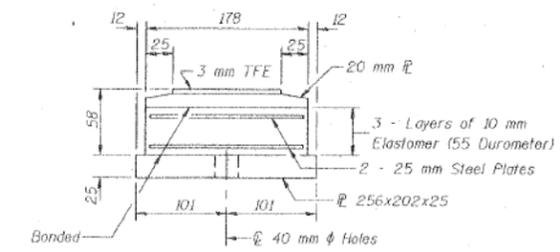


BOTTOM BEARING ASSEMBLY WEST ABUT.

BILL OF MATERIAL

Item	Unit	Total
Elastomeric Bearing Assembly Type I	Each	12
Elastomeric Bearing Assembly Type II	Each	12

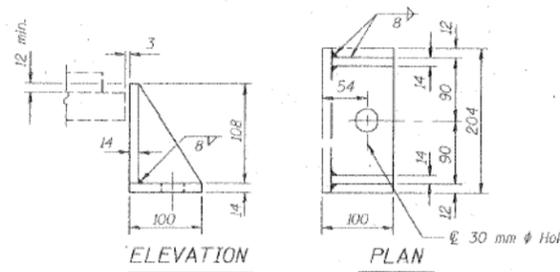

SIDE RETAINER
Equivalent rolled angle with stiffeners will be allowed in lieu of welded plates. Weight included with Structural Steel.

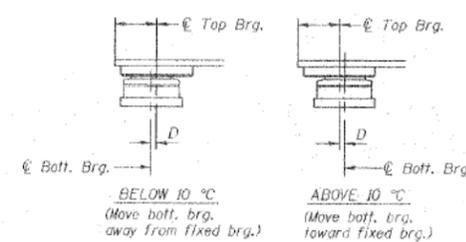

SETTING ANCHOR BOLTS AT EXP. BRG.
D = 1 mm per each 10 m of expansion for every 8 °C temp. change from the normal temp. of 10 °C.

- NOTES:**
- All dimensions in millimeters (mm) unless otherwise noted.
 - See Sheet S-35 for details of jacking and removal of existing bearings.

REVISIONS	
NAME	DATE

ILLINOIS DEPARTMENT OF TRANSPORTATION
ELASTOMERIC BEARING
DETAILS EAST & WEST ABUTMENTS
JACKSON BOULEVARD, FAU 1422 OVER
JOHN F. KENNEDY EXPRESSWAY, FAI 90/94
SECTION 0101-2-1B-R-1 COOK COUNTY
STATION 1+350.230 STRUCTURE NO. 016-0588
DESIGNED BY J.D.G. DRAWN BY C.J.J.
DATE 4-00 CHECKED BY J.K. CHECKED BY J.D.G.

STV Incorporated
Engineers/Architects/Planners/Construction Managers
70 W. Madison St. Chicago, IL 60602-4207

6:49:41 PM D162J31-SHT-AS-BUILT-33



USER NAME = wjcollett1	DESIGNED EH	REVISED
PLOT SCALE = 0x2.0000 '1" / in.	CHECKED WJC	REVISED
PLOT DATE = 8/13/2019	DRAWN EH	REVISED
	CHECKED WJC	REVISED

STATE OF ILLINOIS DEPARTMENT OF TRANSPORTATION



EXISTING JACKSON BLVD BRIDGE PLANS (SN 016-0588)

SHEET NO. AB-33 OF AB-65 SHEETS

F.A.I. RTE.	SECTION	COUNTY	TOTAL SHEETS	SHEET NO.
90/94/290	2014-017B	COOK	400	260
				CONTRACT NO. 62J31
				ILLINOIS FED. AID PROJECT



FOR INFORMATION ONLY

F.A. RTE.	SECTION	COUNTY	TOTAL SHEETS	SHEET NO.
90/94	0101-2-1B-R-1	COOK	226	56
STA. 1+350.230 TO STA.				
FED. ROAD DIST. NO. 7		ILLINOIS FED. AID PROJECT		
S-35 of 49				

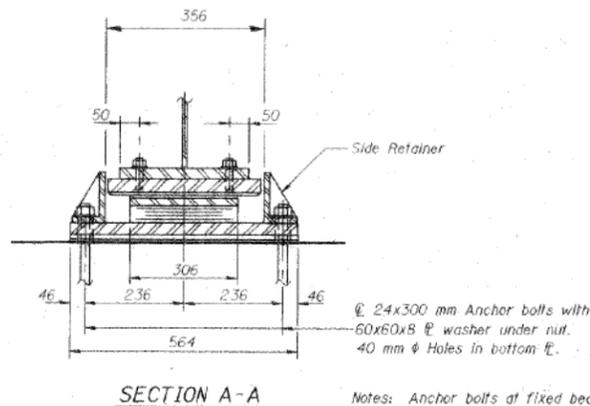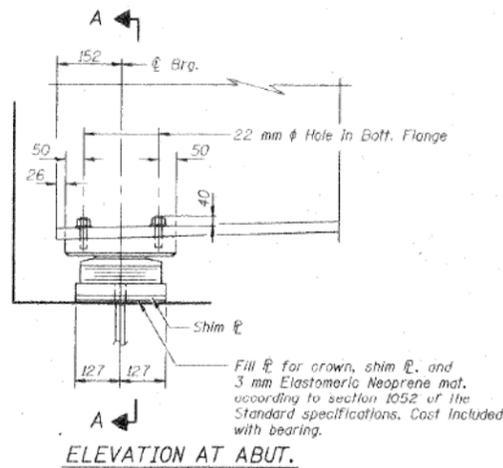




Notes: Anchor bolts at fixed bearings may be built into the masonry. See Sheet S-37 for Anchor Bolt Installation. All dimensions are in millimeters (mm) except as noted.

TYPE II ELASTOMERIC EXP. BRG.
Entrance Ramp "A"

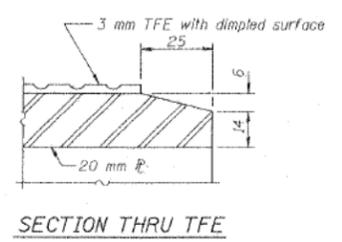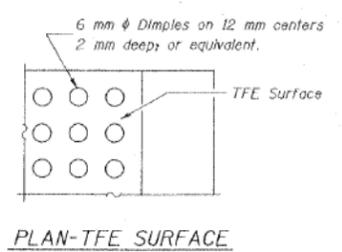


Note: The 3 mm TFE sheet shall be bonded directly to the top steel plate with a two-component, medium viscosity epoxy resin, conforming to the requirements of the Federal Specification MMM-A-134, Type I. The bond agent shall be applied on the full area of the contact surfaces.


Bonding of 3 mm TFE sheet during vulcanizing process will be permitted provided the process and method of adjusting assembly height is approved by the Engineer.

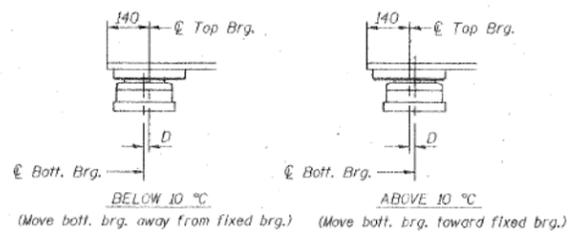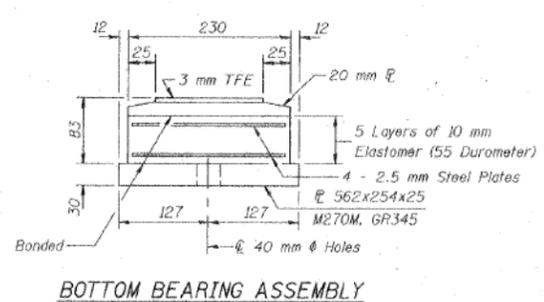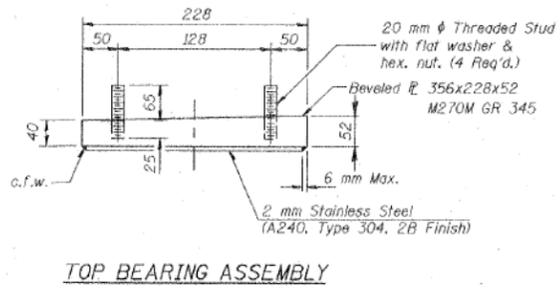

D = 1 mm per each 10 m of expansion for every 8 °C temp. change from the normal temp. of 10 °C.

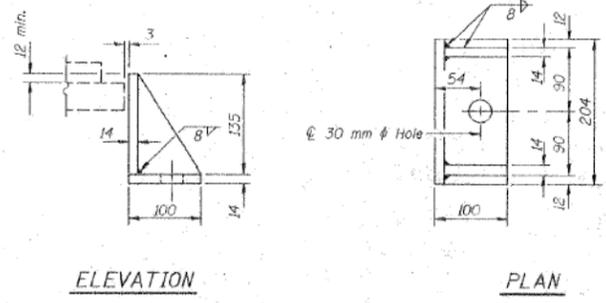

SIDE RETAINER
Equivalent rolled angle with stiffeners will be allowed in lieu of welded plates. Weight included with Structural Steel.

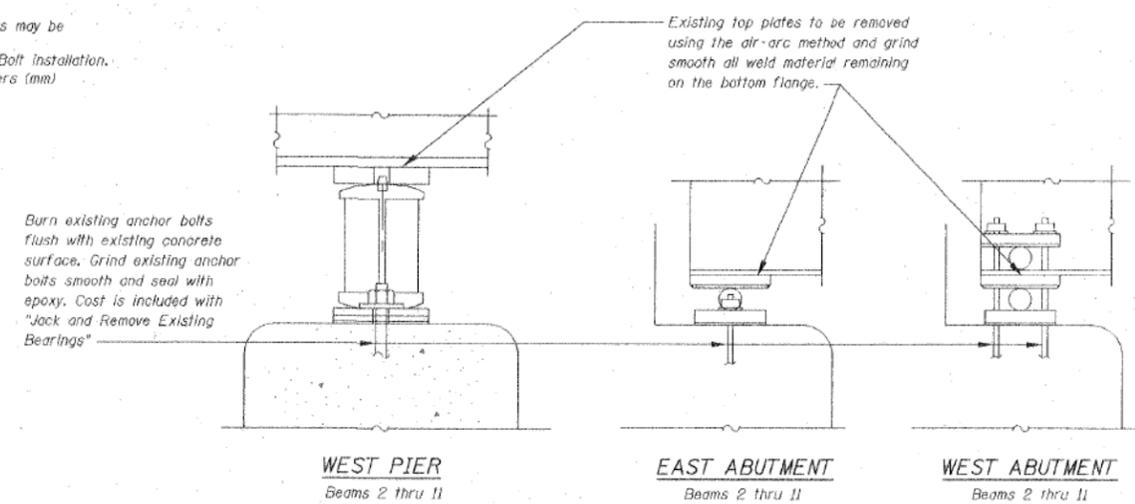

JACK AND REMOVE EXISTING BEARING PROCEDURE-JACKSON BLVD.

- The Contractor shall submit for approval by the Engineer, plans for jacking prior to commencing any work at the bearings.
- Jacking and removal of bearings shall be done after removal of existing deck is complete.
- The maximum differential lift between beams at any one substructure unit shall be limited to 7 mm. If simultaneous jacking of all beams at a substructure unit is utilized, then the maximum total lift shall be limited to 19 mm.
- The maximum reaction per bearing with the deck removed and minimum jack capacities are shown in S-29 table.
- The new bearings shall be in place and the jacks lowered before the new concrete deck is poured.

BILL OF MATERIAL ENTRANCE RAMP "A"

Item	Unit	Total
Elastomeric Bearing Assembly Type II	Each	4

NOTES:
1. All dimensions in millimeters (mm) unless otherwise noted.

REVISIONS	
NAME	DATE

ILLINOIS DEPARTMENT OF TRANSPORTATION
ENTRANCE RAMP "A" ELASTOMERIC BEARING
DETAILS TYPE II ABUTMENT
JACKSON BOULEVARD, FAU 1422 OVER
JOHN F. KENNEDY EXPRESSWAY, FAI 90/94
SECTION 0101-2-1B-R-1 COOK COUNTY
STATION 1+350.230 STRUCTURE NO. 016-0588
DESIGNED BY J.D.G. DRAWN BY C.J.
DATE 4-00 CHECKED BY I.K. CHECKED BY J.D.G.

STV Incorporated
Engineers/Architects/Planners/Construction Managers
70 W. Madison St. Chicago, IL 60602-4207

6:50:26 PM D162331-SHT-AS-BUILT-35



USER NAME = wjcolletti	DESIGNED EH	REVISED
PLOT SCALE = 0x2.0000 '1' / in.	CHECKED WJC	REVISED
PLOT DATE = 8/13/2019	DRAWN EH	REVISED
	CHECKED WJC	REVISED

STATE OF ILLINOIS
DEPARTMENT OF TRANSPORTATION


EXISTING JACKSON BLVD BRIDGE PLANS (SN 016-0588)

SHEET NO. AB-35 OF AB-65 SHEETS


F.A.I. RTE.	SECTION	COUNTY	TOTAL SHEETS	SHEET NO.
90/94/290	2014-017B	COOK	400	262
				CONTRACT NO. 62J31
ILLINOIS FED. AID PROJECT				

FOR INFORMATION ONLY


F.A.I. RTE.	SECTION	COUNTY	TOTAL SHEETS	SHEET NO.
90/94	0101-2-1B-R-1	COOK	220	57
STA. 1+350.230 TO STA.		FED. ROAD DIST. NO. 7 ILLINOIS FED. AID PROJECT		
5-36 of 49				

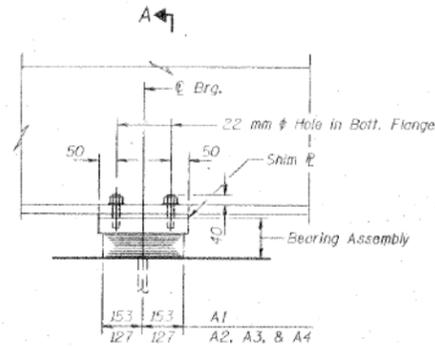


ELEVATION AT PIER 1

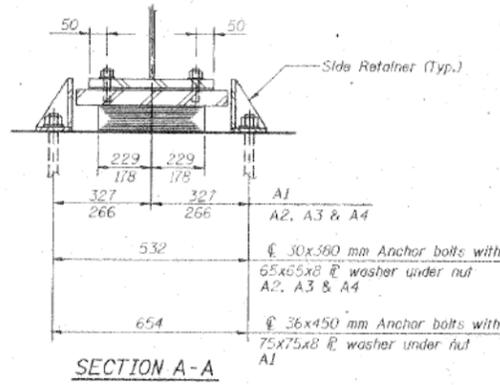


SECTION A-A

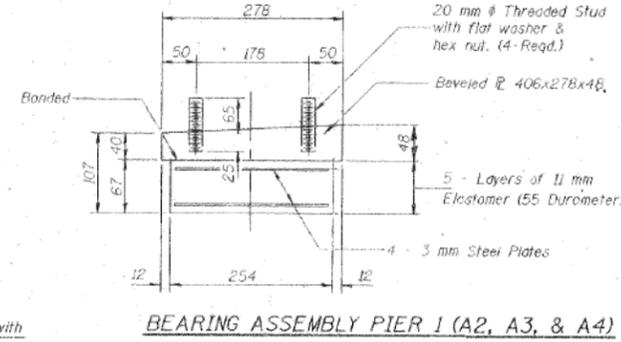


BEARING ASSEMBLY PIER 1 (A2, A3, & A4)

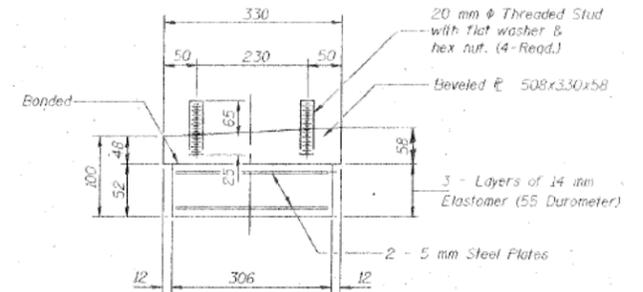


BEARING ASSEMBLY PIER 1 (A1)

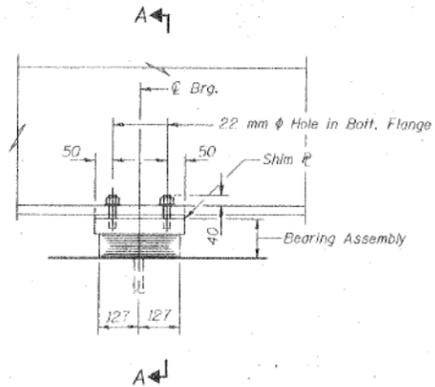

ELEVATION AT PIER 2

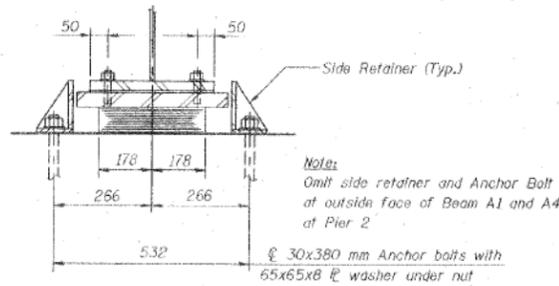

SECTION A-A

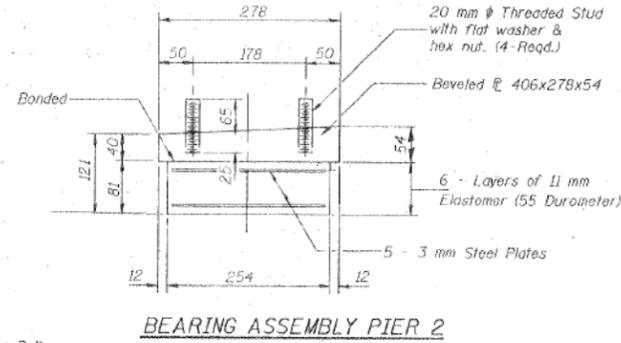


BEARING ASSEMBLY PIER 2

Notes:
Omit side retainer and Anchor Bolt at outside face of Beam A1 and A4 at Pier 2


BILL OF MATERIAL

Item	Unit	Total
Elastomeric Bearing Assembly Type 1	Each	8

NOTES:
1. All dimensions in millimeters (mm) unless otherwise noted.

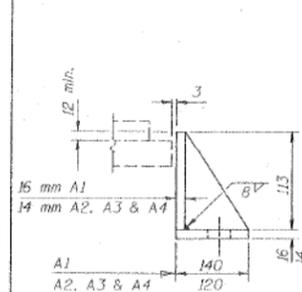


ELEVATION

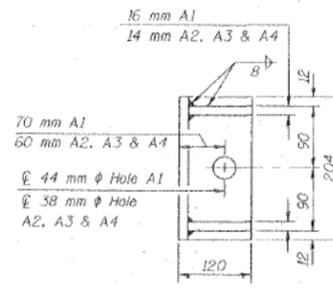


PLAN

SIDE RETAINER PIER 1
Equivalent rolled angle with stiffeners will be allowed in lieu of welded plates. Weight included with Structural Steel.

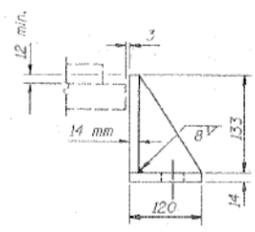

ELEVATION

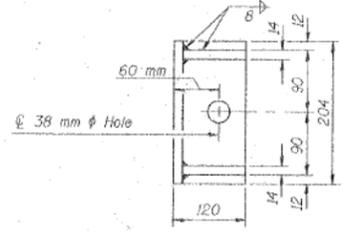

PLAN

SIDE RETAINER PIER 2
Equivalent rolled angle with stiffeners will be allowed in lieu of welded plates. Weight included with Structural Steel.

STV Incorporated
Engineers/Architects/Planners/Construction Managers
70 W. Madison St. Chicago, IL 60602-4207

REVISIONS	
NAME	DATE

ILLINOIS DEPARTMENT OF TRANSPORTATION
ENTRANCE RAMP "A"
ELASTOMERIC BEARING DETAILS-PIER 1 & 2
JACKSON BOULEVARD, FAJ 1422 OVER
JOHN F. KENNEDY EXPRESSWAY, FAJ 90/94
SECTION 0101-2-1B-R-1 COOK COUNTY
STATION 1+350.230 STRUCTURE NO. 016-0588
DESIGNED BY J.D.G. DRAWN BY C.J.
DATE 4-00 CHECKED BY I.K. CHECKED BY J.D.G.

6:50:49 PM 016231-SHT-AS-BUILT-36



USER NAME = wjcolletti	DESIGNED EH	REVISED
PLOT SCALE = 0x2.0000 '1" / in.	CHECKED WJC	REVISED
PLOT DATE = 8/13/2019	DRAWN EH	REVISED
	CHECKED WJC	REVISED

STATE OF ILLINOIS
DEPARTMENT OF TRANSPORTATION

EXISTING JACKSON BLVD BRIDGE PLANS (SN 016-0588)

SHEET NO. AB-36 OF AB-65 SHEETS

F.A.I. RTE.	SECTION	COUNTY	TOTAL SHEETS	SHEET NO.
90/94/290	2014-017B	COOK	400	263
CONTRACT NO. 62J31				
ILLINOIS FED. AID PROJECT				


FOR INFORMATION ONLY

The Illinois Coil-Lock Anchor Bolt is a proprietary item which is the property of the Illinois Department of Transportation. Use, reproduction or disclosure without express written permission is prohibited and protected under Federal copyright laws. The production and the fabrication of this bolt for use on highway projects in the State of Illinois shall be permitted and there shall be no incurred charges or fees to the manufacturer or the fabricator for producing or fabricating this bolt.

STATE OF ILLINOIS DEPARTMENT OF TRANSPORTATION

DATE	SECTION	COUNTY	SHEET	NO.
			226	58
S-37 of 49				

D	E	H	K	"d"
24	27	20	44	6
30	33	26	51	10
36	39	32	54	13
48	51	44	73	15
64	67	60	86	25

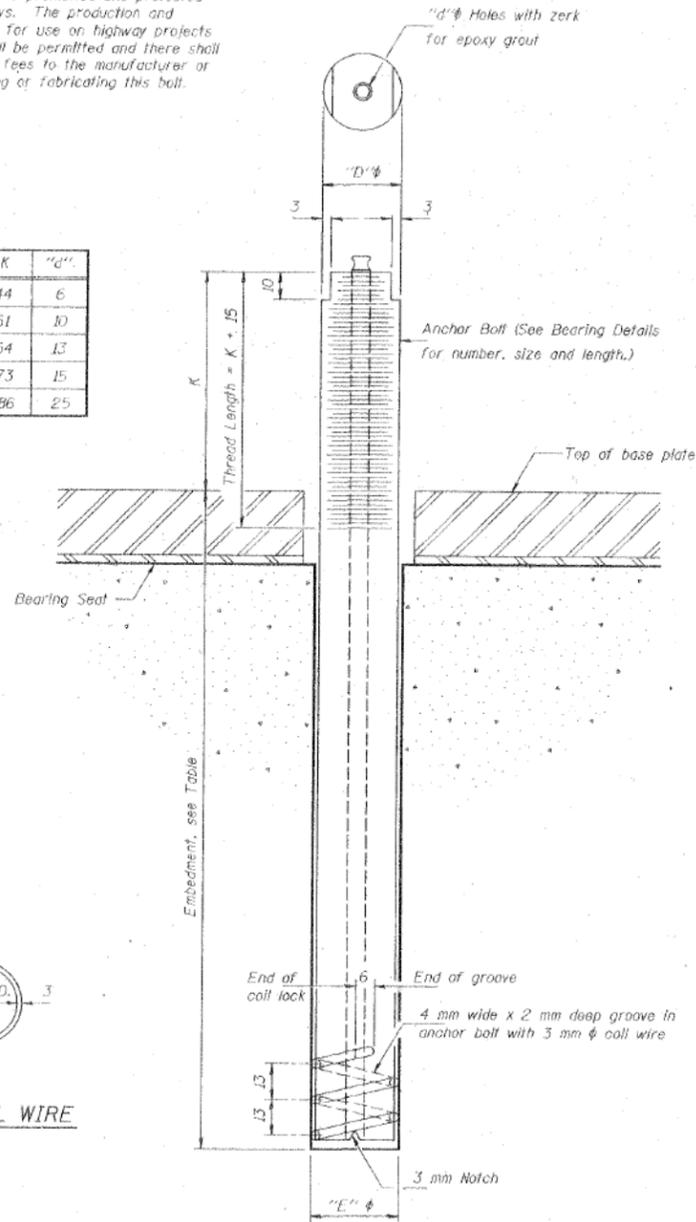

ILLINOIS COIL-LOCK ANCHOR BOLT

MATERIALS FOR ILLINOIS COIL-LOCK ANCHOR BOLT

The anchor bolt shall be fabricated from cold drawn or hot finished seamless carbon steel mechanical tubing conforming to ASTM A 519, Grade 1026, CW and supplied with hexagonal nuts and cut washers.

The coil wire shall be made of any suitable soft steel wire. The finished anchor bolt shall be cleaned of rust and other foreign materials and wrapped or packaged to prevent contamination until they are installed. The epoxy grout shall be a two-component, epoxy resin bonding system conforming to ASTM C 881, Type I, Grade 1 and of a Class suitable for the temperature at installation.

GENERAL NOTES

Holes in the masonry for anchor bolts shall be drilled through the base plates to the diameter and depth shown or according to the manufacturer's recommendation after beams or girders have been erected and adjusted. Prior to setting the bolts, the holes shall be dry and all dust and loose particles shall be removed by the use of compressed air or vacuuming. The anchor bolts, furnished and installed and including the epoxy grout or capsules shall not be paid for separately but shall be included in the unit bid price for "Furnishing and Erecting Structural Steel". All dimensions are in millimeters (mm) except as noted.

INSTALLATION PROCEDURE for the ILLINOIS COIL-LOCK ANCHOR BOLT

1. With the coil wire in place, the bolt shall be inserted into the hole and turned clockwise to a snug fit in the hole. Nut and washer shall be placed on the bolt. The nut shall be tensioned until the steel base plates are held securely to the concrete bearing seat.
2. Epoxy grout shall be pumped through the zerk fitting with a pressure gun. Pumping shall continue until the epoxy overflows the hole around the bolt shank. After pumping is discontinued, excess epoxy shall be immediately wiped off.

ALTERNATE ANCHOR BOLTS

The Contractor may use, at his option, the capsule or the adhesive cartridge type anchor rods that have been previously tested and given a prior approval by the Department. The Contractor shall install these anchor rods in pre-drilled holes according to the manufacturer's recommendations and procedures.

- The capsule or the adhesive cartridge type anchor rods shall be a two part system composed of:
1. A threaded rod stud with nut and washer of the type specified.
 2. A sealed glass capsule or a sealed glass adhesive cartridge containing premeasured amounts of the adhesive chemical.

Location	Size	Type	Embedment
Jackson Blvd Bridge Abutments	M24x300	A307	256
Jackson Blvd Bridge West Pier Beam 1	M36x450	A307	396
Jackson Blvd Bridge West Pier Beams 2-12	M30x380	A307	329
Jackson Blvd Bridge East Pier Beam 1	M48x630	A307	557
Jackson Blvd Bridge East Pier Beam 12	M48x630	A307	557
Ramp "A" Pier 1 & 2 Beam A1	M36x450	A307	396
Ramp "A" Pier 1 & 2 Beam A2, A3 & A4	M30x380	A307	329
Ramp "A" Abutment	M24x300	A307	256

ASTM F 1554 (F_y = 724 MPa), ASTM A 449 and AASHTO M 314 (F_y = 724 MPa) anchor bolts may be substituted for the anchor bolts shown above.


ABB-1 (M) 4-30-99

ANCHOR BOLT DETAILS
FOR BEARINGS
JACKSON BOULEVARD, FAU 1422 OVER
JOHN F. KENNEDY EXPRESSWAY, FAJ 90/94
SECTION 0101-2-1B-R-1 COOK COUNTY
STATION 1+350.230 STRUCTURE NO. 016-0588

USER NAME = wjcolletti	DESIGNED EH	REVISED
	CHECKED WJC	REVISED
PLOT SCALE = 0x2.0000 '1' / in.	DRAWN EH	REVISED
PLOT DATE = 8/13/2019	CHECKED WJC	REVISED

F.A.I. RTE.	SECTION	COUNTY	TOTAL SHEETS	SHEET NO.
90/94/290	2014-017B	COOK	400	264
CONTRACT NO. 62J31				

FOR INFORMATION ONLY

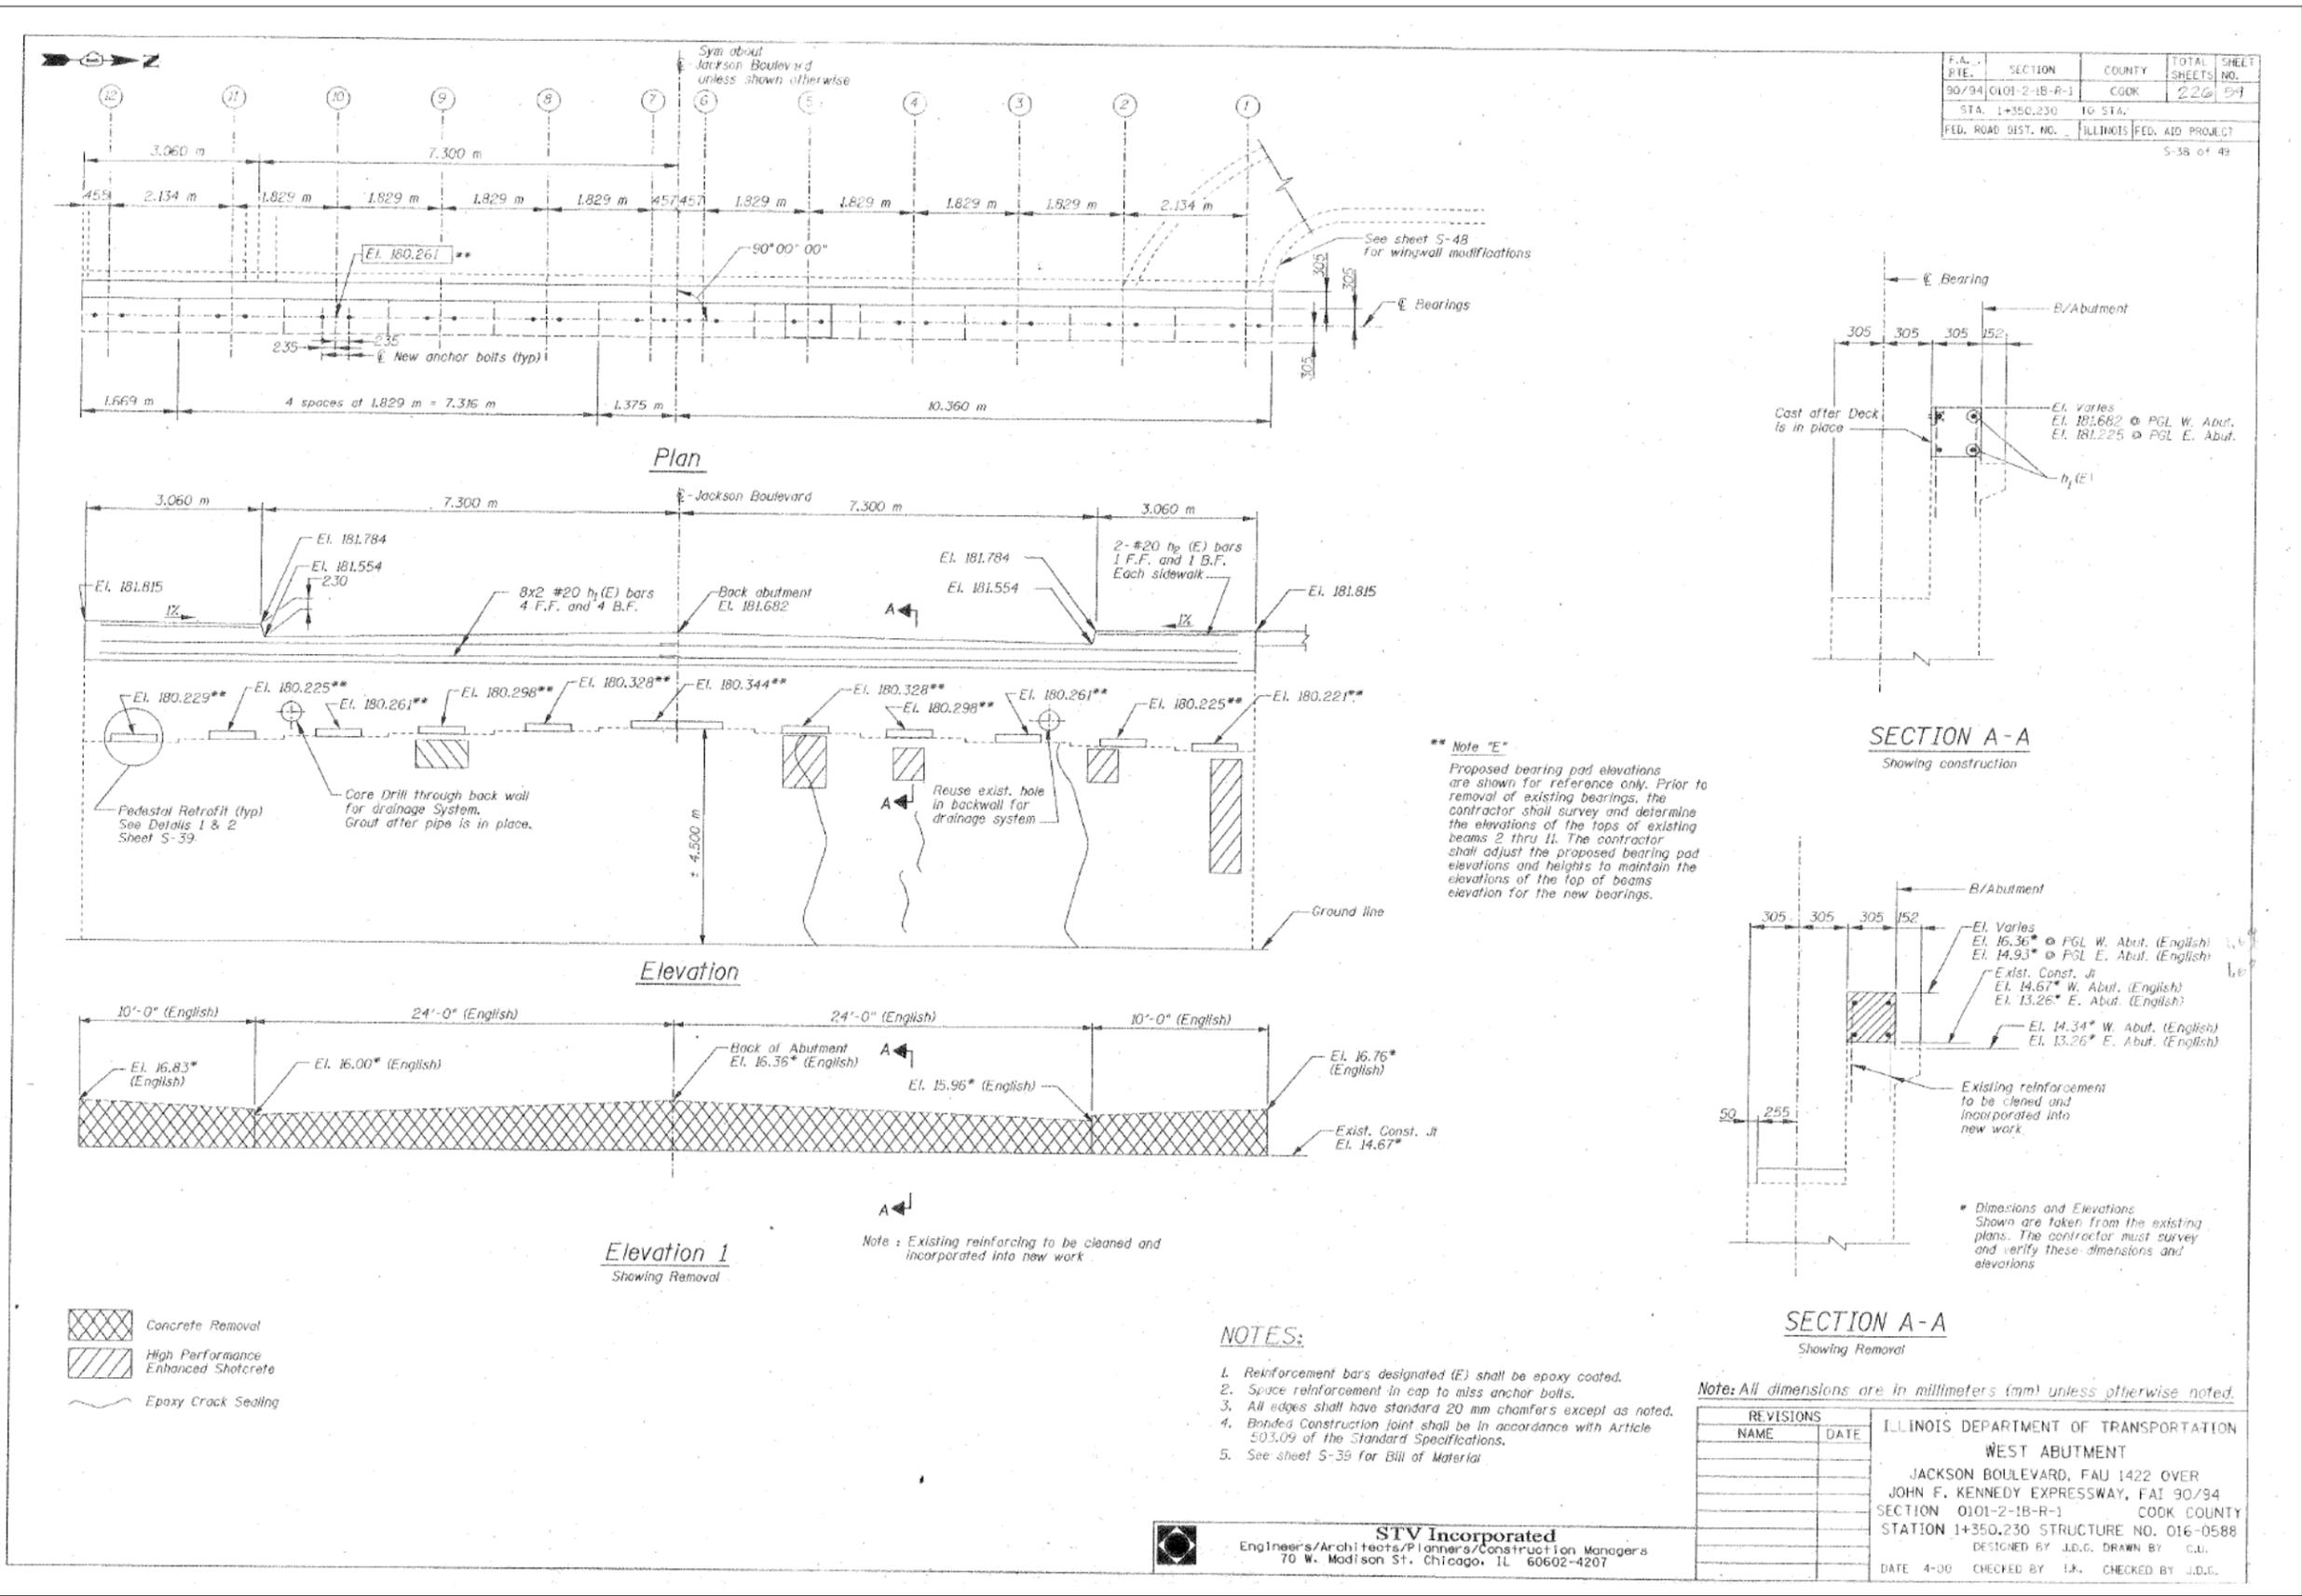

6/5/13 4:34 PM D162031-SHT-AS-BUILT-38



USER NAME = wjcolletti	DESIGNED EH	REVISED
	CHECKED WJC	REVISED
PLOT SCALE = 0x2.0000 '1" / in.	DRAWN EH	REVISED
PLOT DATE = 8/13/2019	CHECKED WJC	REVISED









**STATE OF ILLINOIS
DEPARTMENT OF TRANSPORTATION**

EXISTING JACKSON BLVD BRIDGE PLANS (SN 016-0588)

SHEET NO. AB-38 OF AB-65 SHEETS

F.A.I. RTE.	SECTION	COUNTY	TOTAL SHEETS	SHEET NO.
90/94/290	2014-017B	COOK	400	265
CONTRACT NO. 62J31				
ILLINOIS FED. AID PROJECT				

FOR INFORMATION ONLY

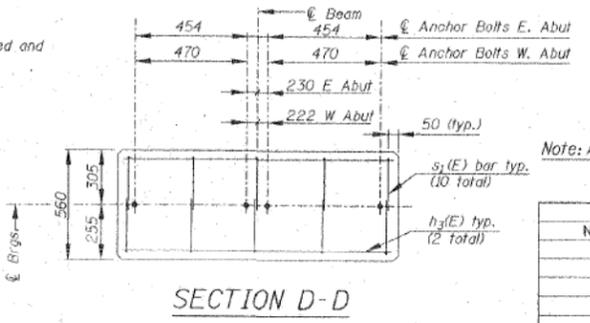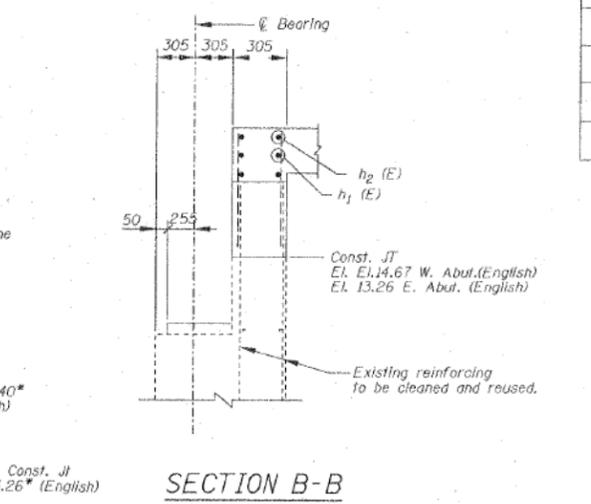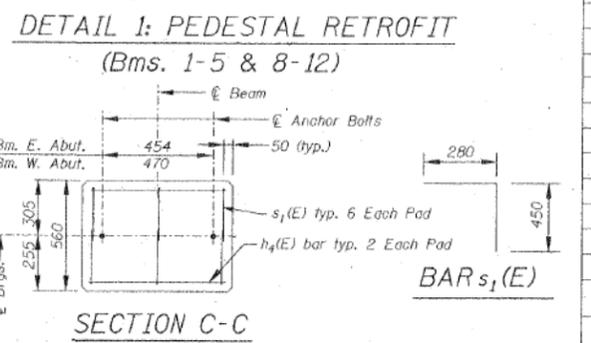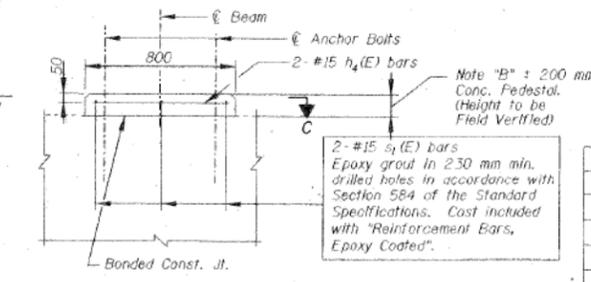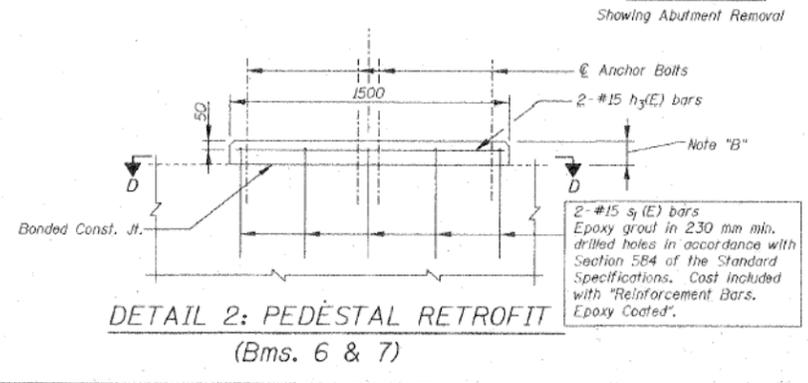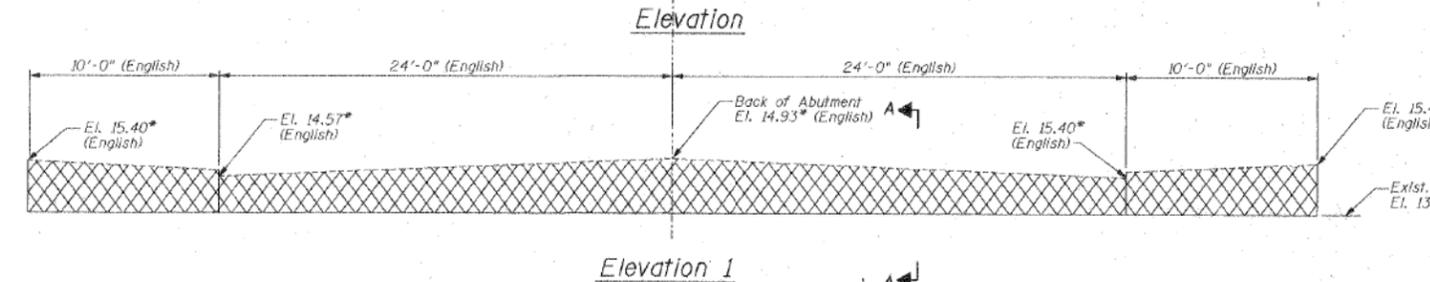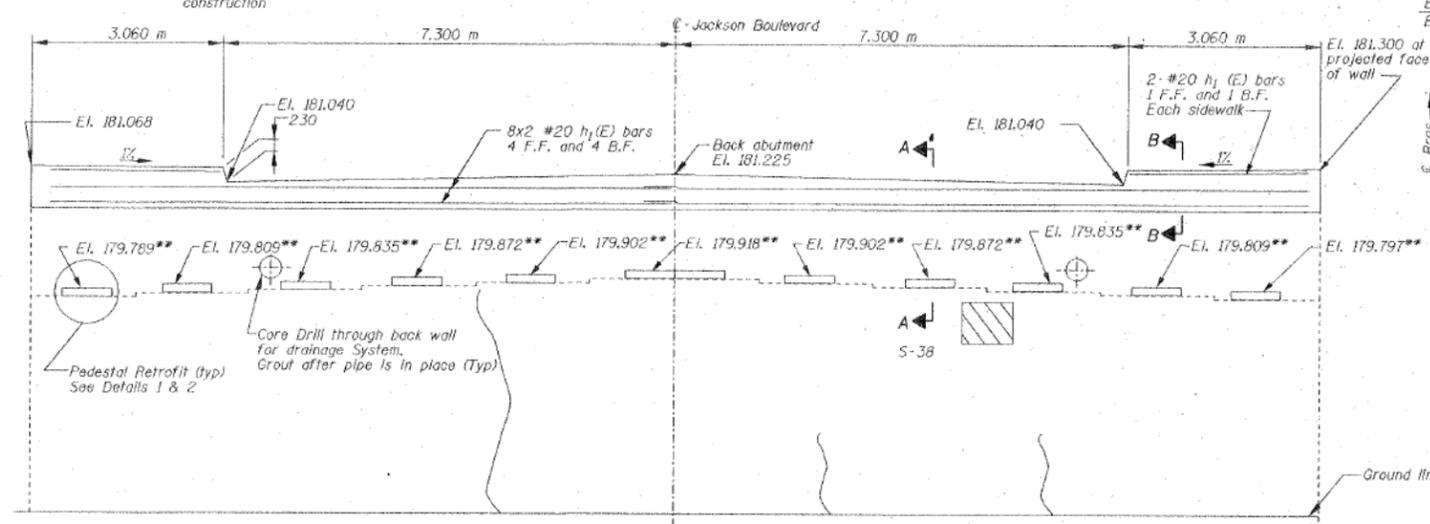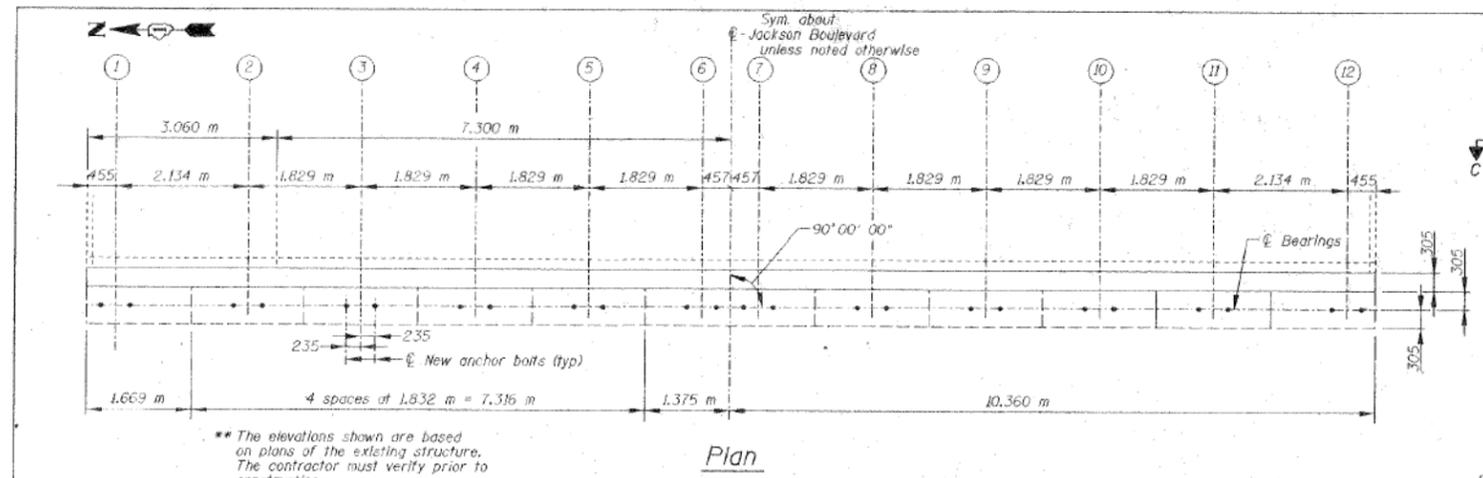

F.A. RTE.	SECTION	COUNTY	TOTAL SHEETS	SHEET NO.
90/94	0101-2-1B-R-1	COOK	226	60
STA. 1+350.230 TO STA.		ILLINOIS FED. AID PROJECT		
FED. ROAD DIST. NO.		S-39 of 49		

BILL OF MATERIAL
(For both abutments)

BAR	NO.	SIZE	LENGTH	SHAPE
h ₁ (E)	16	#20	11.100 m	
h ₂ (E)	8	#20	2.960 m	
h ₃ (E)	4	#15	1.400 m	
h ₄ (E)	48	#15	0.700 m	
s ₁ (E)	152	#15	0.730 m	

ITEM	UNIT	QUANTITY
Reinforcement Bars Epoxy Coated	kg	730
Concrete Removal	m ³	6
Concrete Structures	m ³	6
Epoxy Crack Sealing	m	20
Structure Excavation	m ³	20
Porous Granular Embankment	m ³	20
High Performance Enhanced Shotcrete	m ²	12

** See Note "E" S-38

Concrete Removal

High Performance Enhanced Shotcrete

Epoxy Crack Sealing

NOTES:

- Reinforcement bars designated (E) shall be epoxy coated.
- See Sheet S-38 for Sections A-A.

REVISIONS

NAME	DATE

ILLINOIS DEPARTMENT OF TRANSPORTATION

EAST ABUTMENT

JACKSON BOULEVARD, FAU 1422 OVER JOHN F. KENNEDY EXPRESSWAY, FAI 90/94 SECTION 0101-2-1B-R-1 COOK COUNTY STATION 1+350.230 STRUCTURE NO. 016-0588

DESIGNED BY J.D.G. DRAWN BY C.J.L.

DATE 4-00 CHECKED BY J.K. CHECKED BY J.D.G.

6:51:56 PM 0162331-SHT-AS-BUILT-39



USER NAME = wjcolletti	DESIGNED EH	REVISED
PLOT SCALE = 0x2.0000 '1" / in.	CHECKED WJC	REVISED
PLOT DATE = 8/13/2019	DRAWN EH	REVISED
	CHECKED WJC	REVISED



STATE OF ILLINOIS
DEPARTMENT OF TRANSPORTATION

EXISTING JACKSON BLVD BRIDGE PLANS (SN 016-0588)


SHEET NO. AB-39 OF AB-65 SHEETS

F.A.I. RTE.	SECTION	COUNTY	TOTAL SHEETS	SHEET NO.
90/94/290	2014-017B	COOK	400	266
ILLINOIS FED. AID PROJECT				CONTRACT NO. 62J31


FOR INFORMATION ONLY

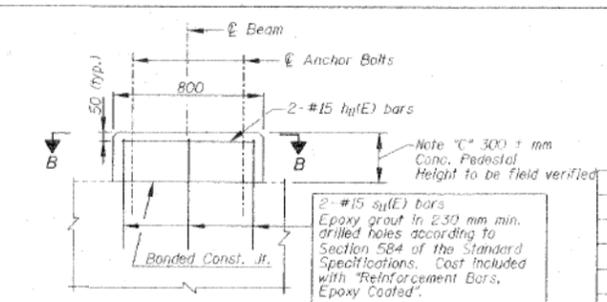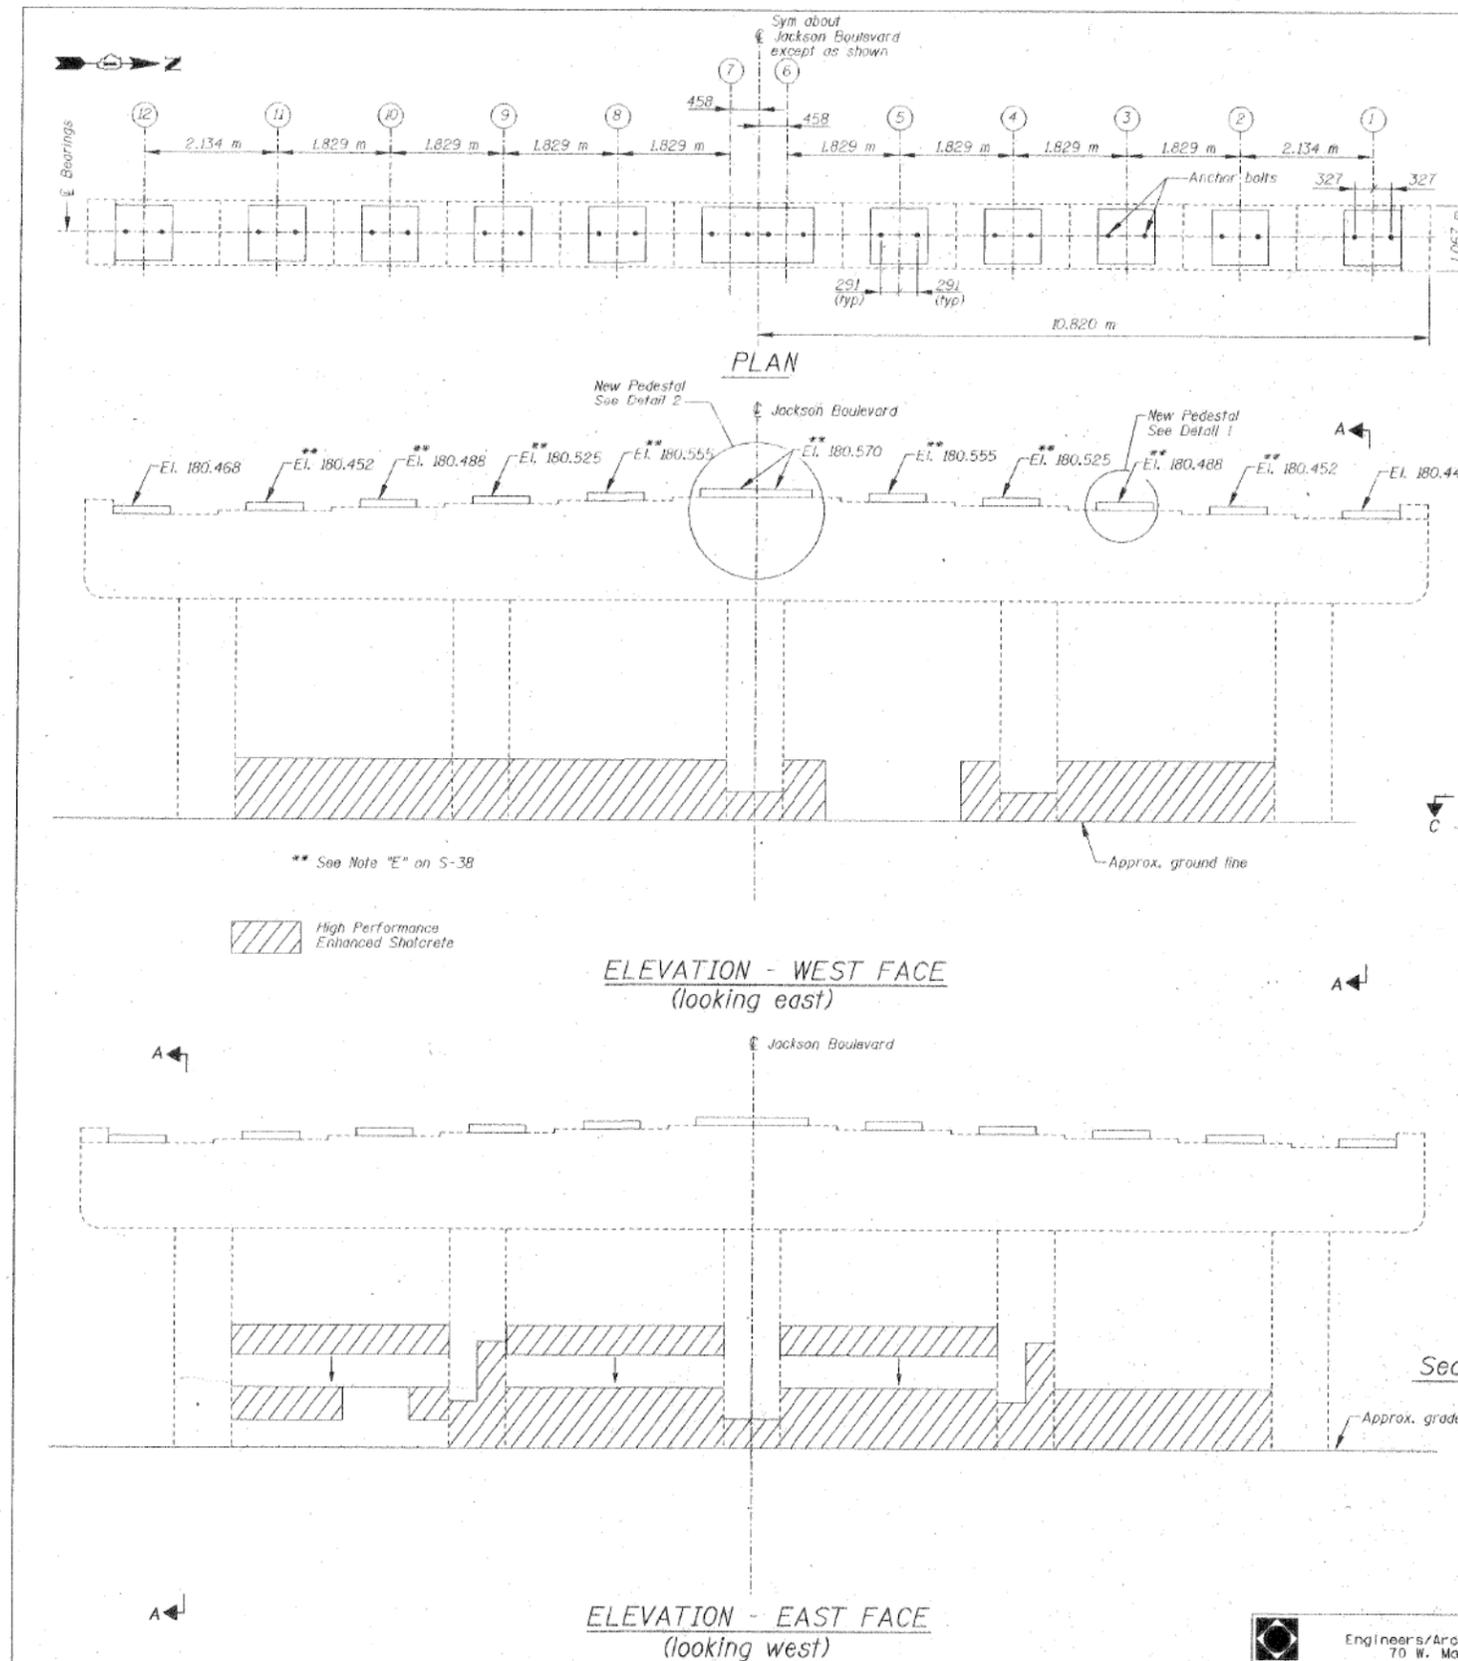


DETAIL 1: PEDESTAL RETROFIT (Bms. 1-6 & 9-12)

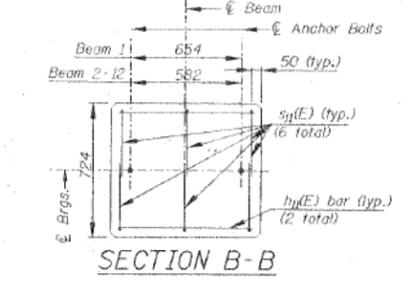


SECTION B-B

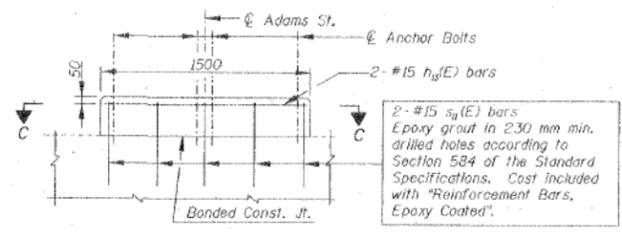

DETAIL 2: PEDESTAL RETROFIT (Bms. 7 & 8)

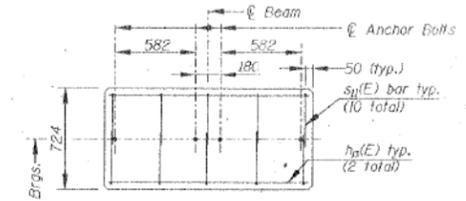

SECTION C-C

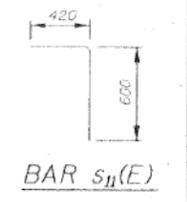

BAR s11(E)

NOTES:

1. Reinforcement bars designated (E) shall be epoxy coated.
2. Existing conduits extending through work areas shall be removed and re-installed as necessary. Cost included with "High Performance Shotcrete".
3. Contractor to verify location of existing reinforcement before drilling notes for new bars.

Note: All dimensions are in millimeters (mm) unless otherwise noted.

REVISIONS		ILLINOIS DEPARTMENT OF TRANSPORTATION WEST PIER JACKSON BOULEVARD, FAU 1422 OVER JOHN F. KENNEDY EXPRESSWAY, FAI 90/94 SECTION 0101-2-1B-R-1 COOK COUNTY STATION 1+350.230 STRUCTURE NO. 016-0588 DESIGNED BY J.D.G. DRAWN BY C.J.U.
NAME	DATE	
		DATE 4-08 CHECKED BY I.K. CHECKED BY J.D.G.

F.A.I. RTE.	SECTION	COUNTY	TOTAL SHEETS	SHEET NO.
90/94	0101-2-1B-R-1	COOK	226	41
STA. 1+350.230 TO STA.		ILLINOIS FED. AID PROJECT		
FED. ROAD DIST. NO.		5-40 OF 49		

BILL OF MATERIAL				
BAR NO.	NO.	SIZE	LENGTH	SHAPE
h1(E)	24	#15	0.700 m	—
h3(E)	2	#15	1.400 m	—
s11(E)	82	#15	1.020 m	—
ITEM		UNIT	QUANTITY	
Reinforcement Bars Epoxy Coated		kg	165	
Concrete Removal		m ³	3	
Concrete Structures		m ³	3	
High Performance Enhanced Shotcrete		m ²	36	

* Clean and Straighten and Incorporate into New Construction.

6:52:19 PM 0162331-SHT-AS-BUILT-40



USER NAME = wjcolletti	DESIGNED EH	REVISED
PLOT SCALE = 0x2.0000 'x' / in.	CHECKED WJC	REVISED
PLOT DATE = 8/13/2019	DRAWN EH	REVISED
	CHECKED WJC	REVISED

STATE OF ILLINOIS
DEPARTMENT OF TRANSPORTATION

STV Incorporated
Engineers/Architects/Planners/Construction Managers
70 W. Madison St. Chicago, IL 60602-4207


EXISTING JACKSON BLVD BRIDGE PLANS (SN 016-0588)

SHEET NO. AB-40 OF AB-65 SHEETS

F.A.I. RTE.	SECTION	COUNTY	TOTAL SHEETS	SHEET NO.
90/94/290	2014-017B	COOK	400	267
ILLINOIS FED. AID PROJECT				CONTRACT NO. 62J31



FOR INFORMATION ONLY

F.A. RTE.	SECTION	COUNTY	TOTAL SHEETS	SHEET NO.
90/94	0101-2-1B-R-1	COOK	226	62
STA. 1+350.230	TO STA.			
FED. ROAD DIST. NO.	ILLINOIS	FED. AID PROJECT		

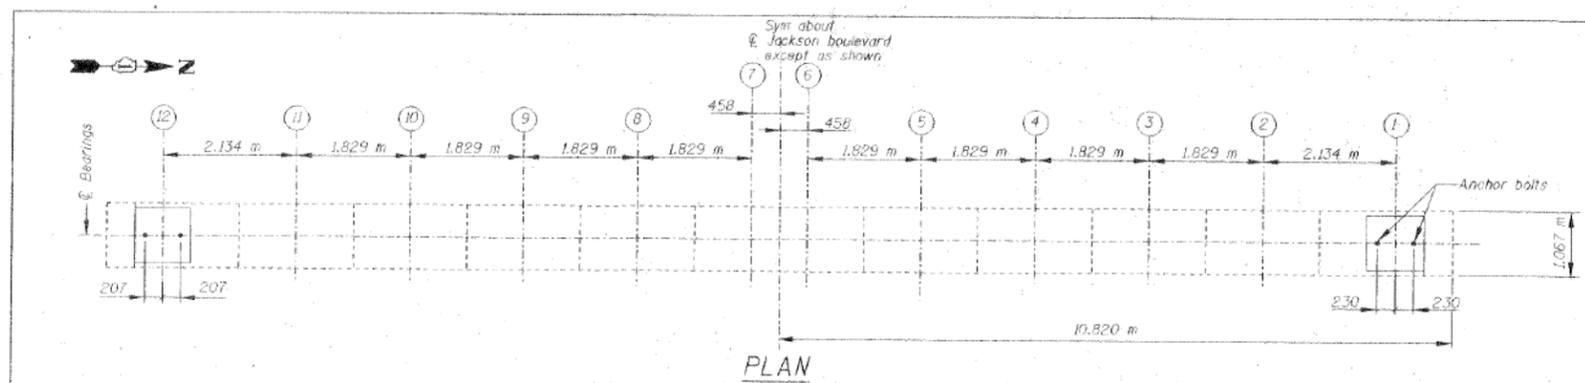


BILL OF MATERIAL

ITEM	UNIT	QUANTITY
High Performance Enhanced Shotcrete	m ²	52

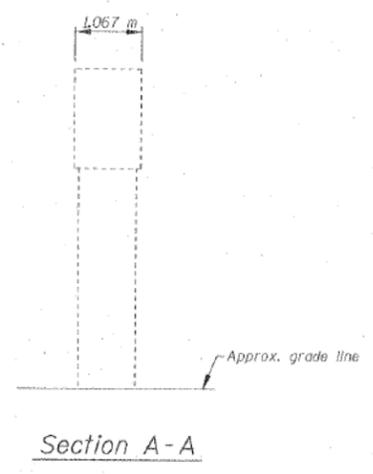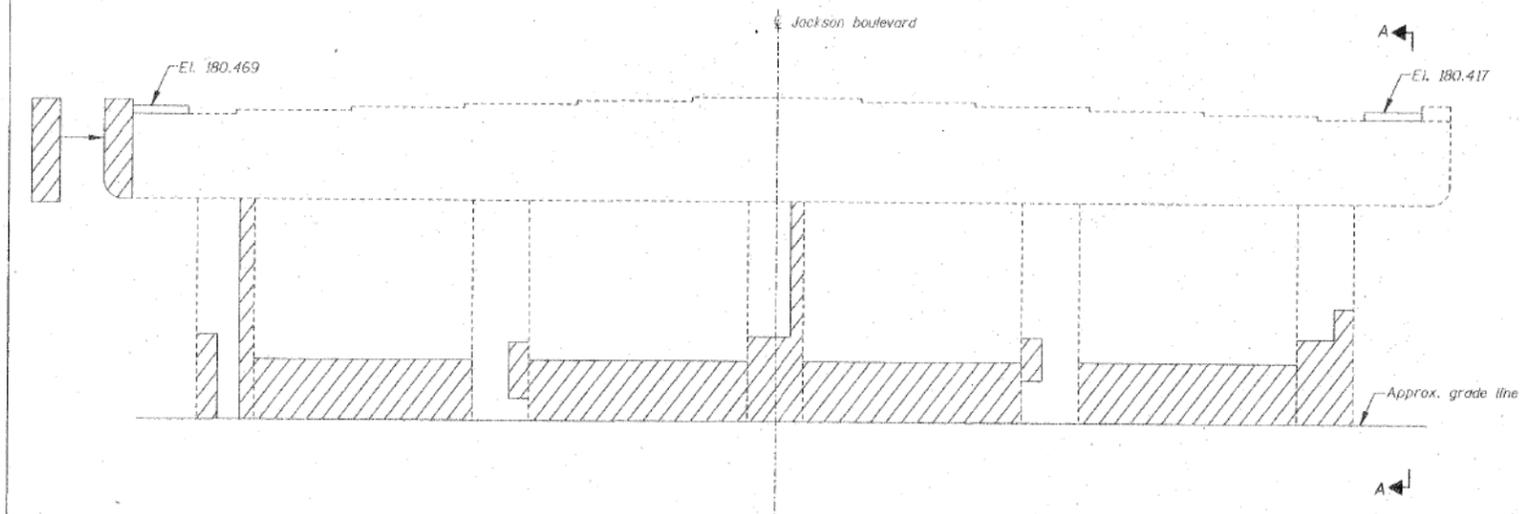

ELEVATION - WEST FACE
(looking east)

High Performance Enhanced Shotcrete

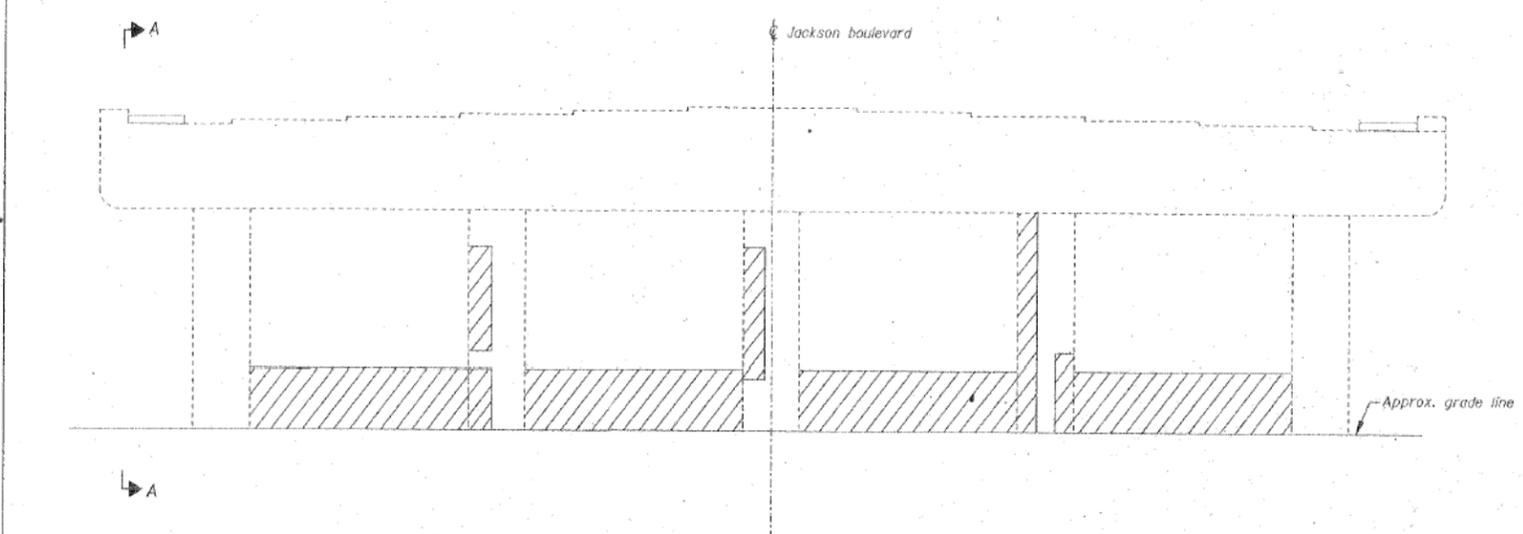

ELEVATION - EAST FACE
(looking west)

** Substructure repair quantities will be provided based on the results of a field inspection. Upon completion of the inspection, quantities will be provided.

NOTES:

- For pedestal details and reinforcement bars see drawing S-40.
- Bill of material included in West Pier.

Note: All dimensions are in millimeters (mm) unless otherwise noted.

REVISIONS	
NAME	DATE

ILLINOIS DEPARTMENT OF TRANSPORTATION
EAST PIER
JACKSON BOULEVARD, FAU 1422 OVER
JOHN F. KENNEDY EXPRESSWAY, FAI 90/94
SECTION 0101-2-1B-R-1 COOK COUNTY
STATION 1+350.230 STRUCTURE NO. 016-0588
DESIGNED BY J.D.G. DRAWN BY C.J.J.
DATE 4-00 CHECKED BY J.K. CHECKED BY J.D.G.

STV Incorporated
Engineers/Architects/Planners/Construction Managers
70 W. Madison St. Chicago, IL 60602-4207

6/5/2011 PM 0162031-SHT-AS-BUILT-41



USER NAME = wjcolletti	DESIGNED EH	REVISED
PLOT SCALE = 0:2.0000 '1" / in.	CHECKED WJC	REVISED
PLOT DATE = 8/13/2019	DRAWN EH	REVISED
	CHECKED WJC	REVISED

STATE OF ILLINOIS
DEPARTMENT OF TRANSPORTATION







EXISTING JACKSON BLVD BRIDGE PLANS (SN 016-0588)

SHEET NO. AB-41 OF AB-65 SHEETS

F.A.I. RTE.	SECTION	COUNTY	TOTAL SHEETS	SHEET NO.
90/94/290	2014-017B	COOK	400	268
				CONTRACT NO. 62J31
ILLINOIS FED. AID PROJECT				

FOR INFORMATION ONLY

F.A. RTE.	SECTION	COUNTY	TOTAL SHEETS	SHEET NO.
90/94	0101-2-1B-R-1	COOK	226	5
STA. 1+350.230	TO STA.			
FED. ROAD DIST. NO.	ILLINOIS	FED. AID PROJECT	S-42 of 49	

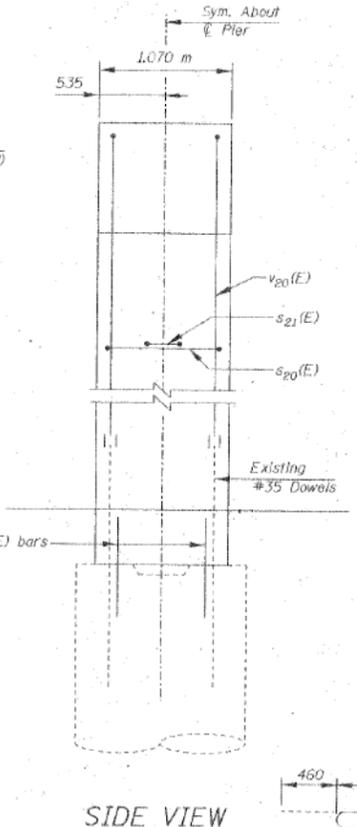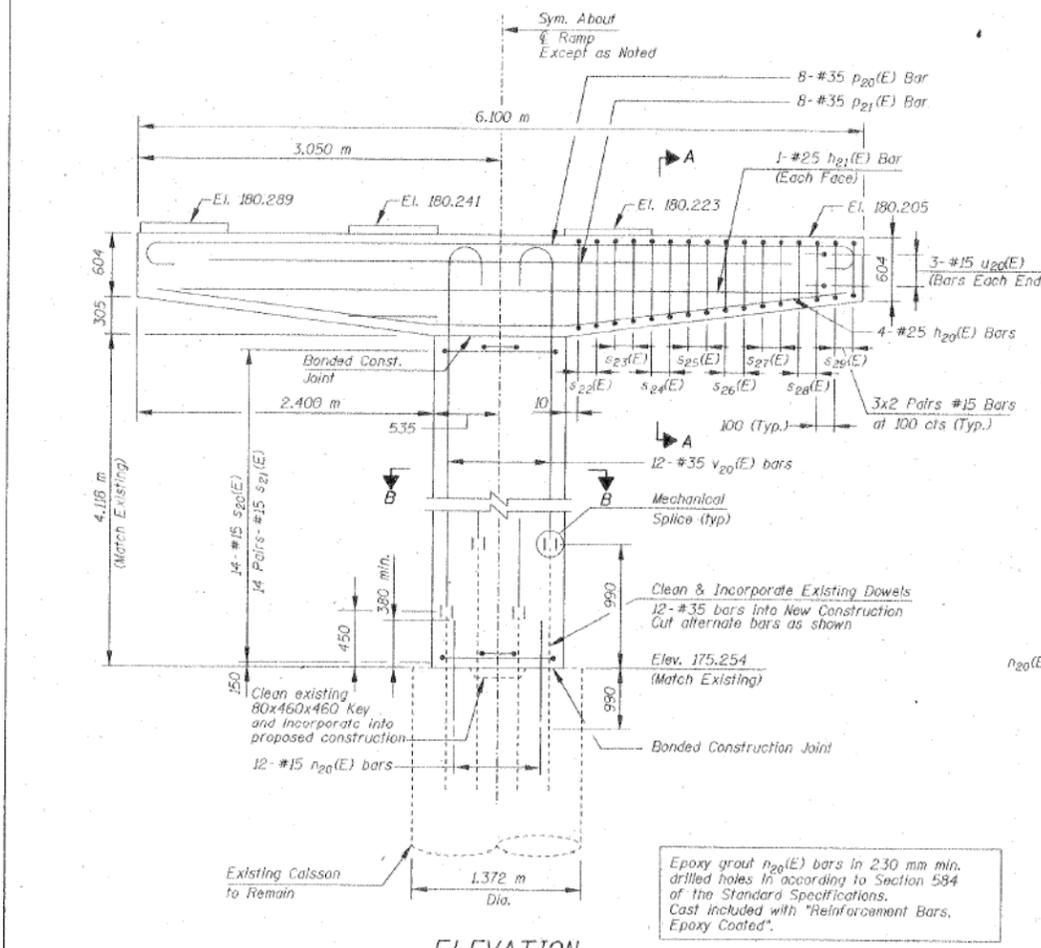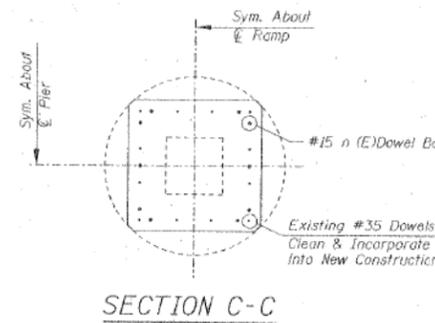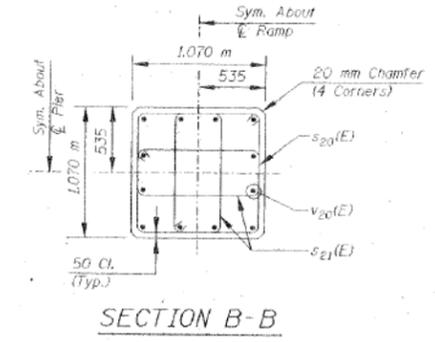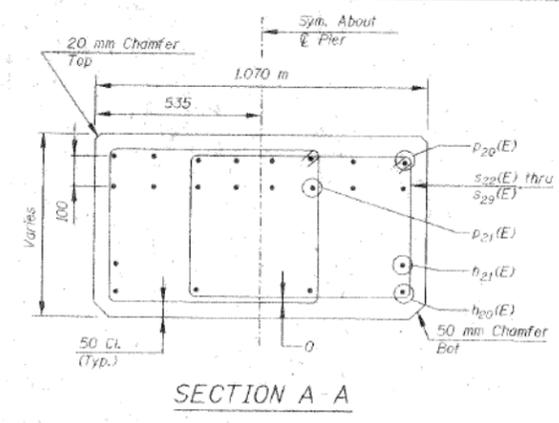
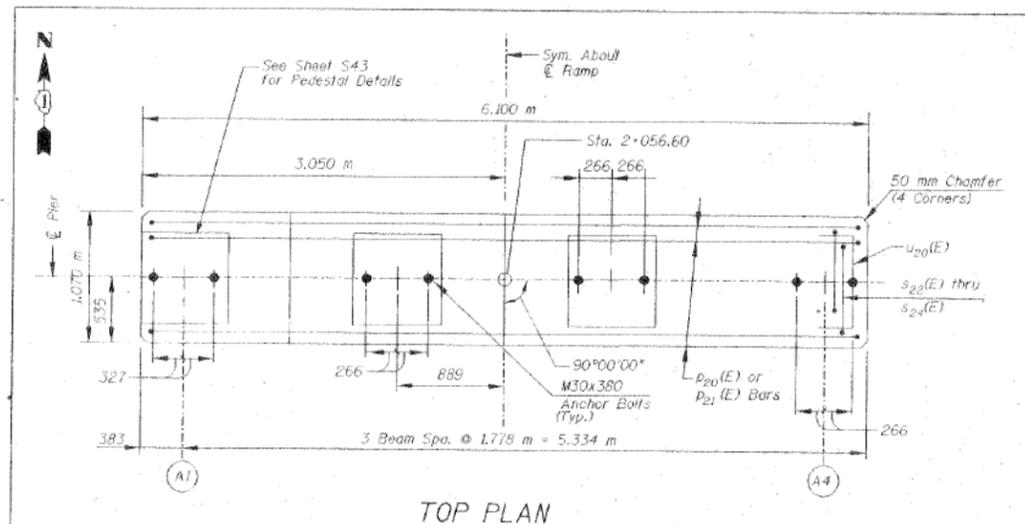


BILL OF MATERIAL

BAR	NO.	SIZE	LENGTH	SHAPE
h ₂₀ (E)	4	#25	7,000 m	
h ₂₁ (E)	2	#25	6,000 m	
h ₂₀ (E)	12	#15	0,610 m	
p ₂₀ (E)	8	#35	6,920 m	
p ₂₁ (E)	8	#35	5,000 m	
s ₂₀ (E)	14	#15	4,160 m	
s ₂₁ (E)	28	#15	2,960 m	
s ₂₂ (E)	12	#15	3,320 m	
s ₂₃ (E)	12	#15	3,240 m	
s ₂₄ (E)	12	#15	3,160 m	
s ₂₅ (E)	12	#15	3,080 m	
s ₂₆ (E)	12	#15	3,000 m	
s ₂₇ (E)	12	#15	2,920 m	
s ₂₈ (E)	12	#15	2,840 m	
s ₂₉ (E)	12	#15	2,760 m	
u ₂₀ (E)	6	#15	1,570 m	
v ₂₀ (E)	12	#35	4,460 m	
ITEM	UNIT	QUANTITY		
Reinforcement Bars Epoxy Coated	kg	2035		
Concrete Removal	m ³	10		
Concrete Structures	m ³	10		
Mechanical Splice	each	12		
Bridge Seat Sealer	m ²	1		

TABLE OF BAR DIMENSIONS

BAR	A	B	C
s ₂₀ (E)	970	970	140
s ₂₁ (E)	970	370	140
s ₂₂ (E)	809	710	140
s ₂₃ (E)	770	710	140
s ₂₄ (E)	731	710	140
s ₂₅ (E)	692	710	140
s ₂₆ (E)	653	710	140
s ₂₇ (E)	614	710	140
s ₂₈ (E)	575	710	140
s ₂₉ (E)	536	710	140

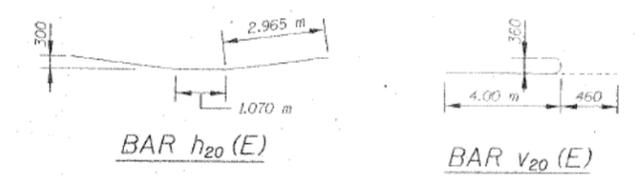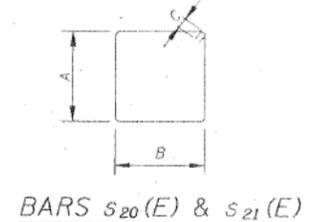

Note: All dimensions are in millimeters (mm) unless otherwise noted.

REVISIONS	
NAME	DATE

ILLINOIS DEPARTMENT OF TRANSPORTATION
 RAMP "A" RECONSTRUCTION PIER 1
 JACKSON BOULEVARD, FAU 1422 OVER
 JOHN F. KENNEDY EXPRESSWAY, FAI 90/94
 SECTION 0101-2-1B-R-1 COOK COUNTY
 STATION 1+350.230 STRUCTURE NO. 016-0588
 DESIGNED BY J.D.G. DRAWN BY C.U.
 DATE 4-00 CHECKED BY I.R. CHECKED BY J.D.G.

STV Incorporated
 Engineers/Architects/Planners/Construction Managers
 70 W. Madison St. Chicago, IL 60602-4207

- NOTES:
- All dimensions are in millimeters (mm) unless otherwise noted.
 - Reinforcement bars designated (E) shall be epoxy coated.
 - Space reinforcement in cap 10 miss anchor bolts.
 - All edges shall have standard 20 mm chamfers except as noted.
 - Four steps monolithically with cap.

6:53:04 PM
 D162331-SHT-AS-BUILT-42



USER NAME = wjcolletti	DESIGNED EH	REVISED
DESIGNED EH	CHECKED WJC	REVISED
DESIGNED EH	DRAWN EH	REVISED
DESIGNED EH	CHECKED WJC	REVISED

STATE OF ILLINOIS
 DEPARTMENT OF TRANSPORTATION






EXISTING JACKSON BLVD BRIDGE PLANS (SN 016-0588)

SHEET NO. AB-42 OF AB-65 SHEETS

F.A.I. RTE.	SECTION	COUNTY	TOTAL SHEETS	SHEET NO.
90/94/290	2014-017B	COOK	400	269
				CONTRACT NO. 62J31
ILLINOIS FED. AID PROJECT				

FOR INFORMATION ONLY

F.A.I. RTE.	SECTION	COUNTY	TOTAL SHEETS	SHEET NO.
90/94	0101-2-1B-R-1	COOK	226	64
STA. 1+350.230 TO STA.		ILLINOIS FED. AID PROJECT		
FED. ROAD DIST. NO.		5-43 of 49		

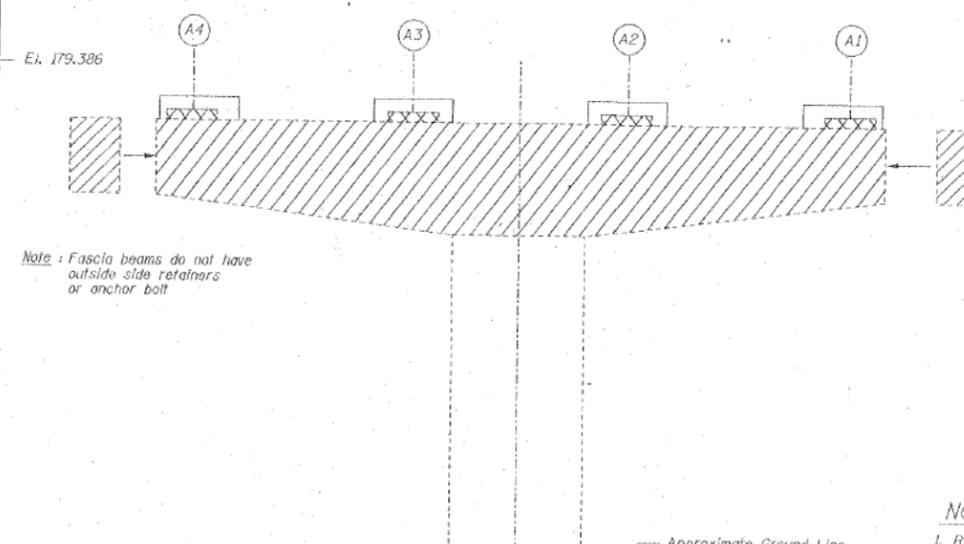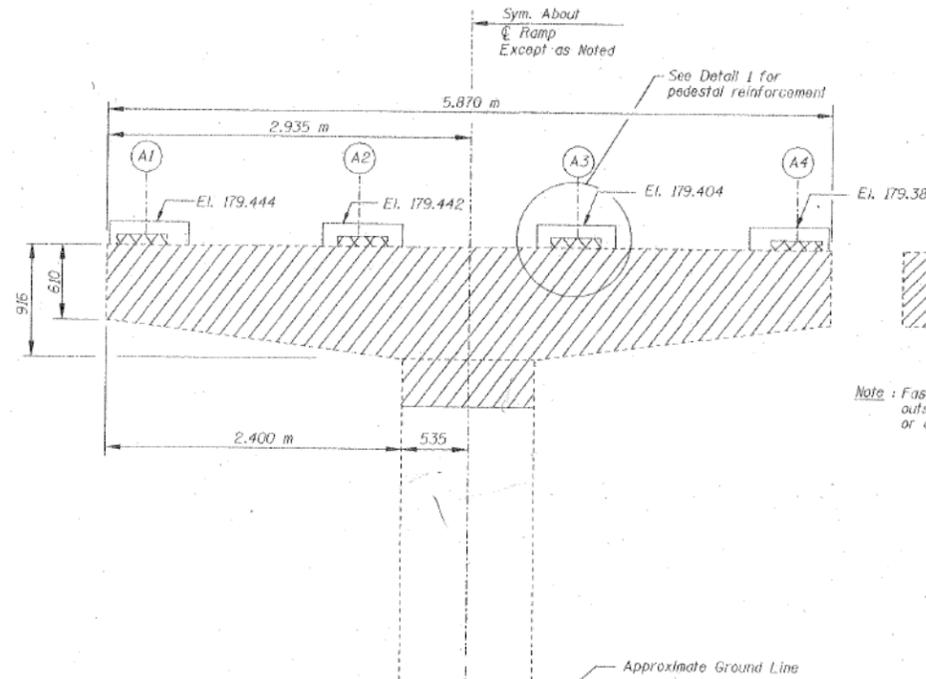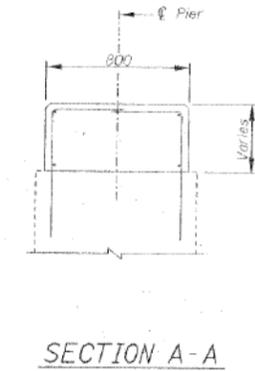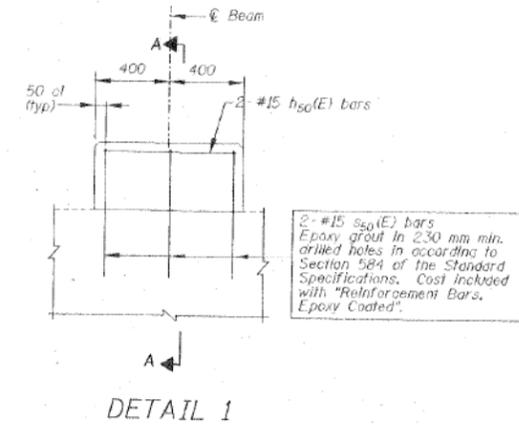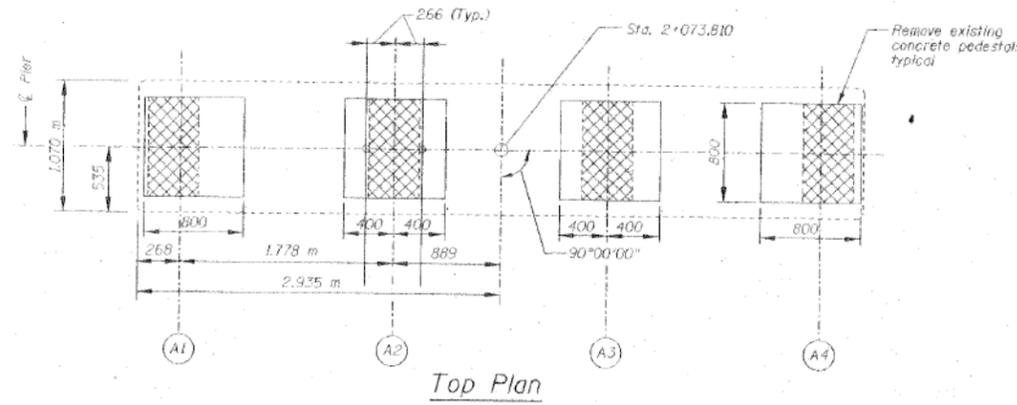

BILL OF MATERIAL

BAR	NO.	SIZE	LENGTH(m)	SHAPE
$s_{50}(E)$	12	#15	0.71	
$s_{20}(E)$	24	#15	1.210	
ITEM	UNIT	QUANTITY		
Reinforcement Bars Epoxy Coated	kg	60		
Concrete Removal	m^3	10		
Concrete Structures	m^3	10		
High Performance Enhanced Shotcrete	m^2	11		

LEGEND:



NOTES:

1. Reinforcement bars designated (E) shall be epoxy coated.
2. All edges shall have standard 20 mm chamfer except as noted.

Note: All dimensions are in millimeters (mm) unless otherwise noted.

REVISIONS	NAME	DATE

ILLINOIS DEPARTMENT OF TRANSPORTATION
 RAMP "A" REHABILITATION PIER 2
 JACKSON BOULEVARD, FAU 1422 OVER
 JOHN F. KENNEDY EXPRESSWAY, FAI 90/94
 SECTION 0101-2-1B-R-1 COOK COUNTY
 STATION 1+350.230 STRUCTURE NO. 016-0588
 DESIGNED BY J.D.G. DRAWN BY C.U.

STV Incorporated
 Engineers/Architects/Planners/Construction Managers
 70 W. Madison St. Chicago, IL 60602-4207

6:53:26 PM
 0162031-SHT-AS-BUILT-43



USER NAME = wjcolletti	DESIGNED	EH	REVISED
PLOT SCALE = 0:2.0000 '1" / in.	CHECKED	WJC	REVISED
PLOT DATE = 8/13/2019	DRAWN	EH	REVISED
	CHECKED	WJC	REVISED


STATE OF ILLINOIS
 DEPARTMENT OF TRANSPORTATION

EXISTING JACKSON BLVD BRIDGE PLANS (SN 016-0588)

SHEET NO. AB-43 OF AB-65 SHEETS

F.A.I. RTE.	SECTION	COUNTY	TOTAL SHEETS	SHEET NO.
90/94/290	2014-017B	COOK	400	270
ILLINOIS FED. AID PROJECT				CONTRACT NO. 62J31

FOR INFORMATION ONLY

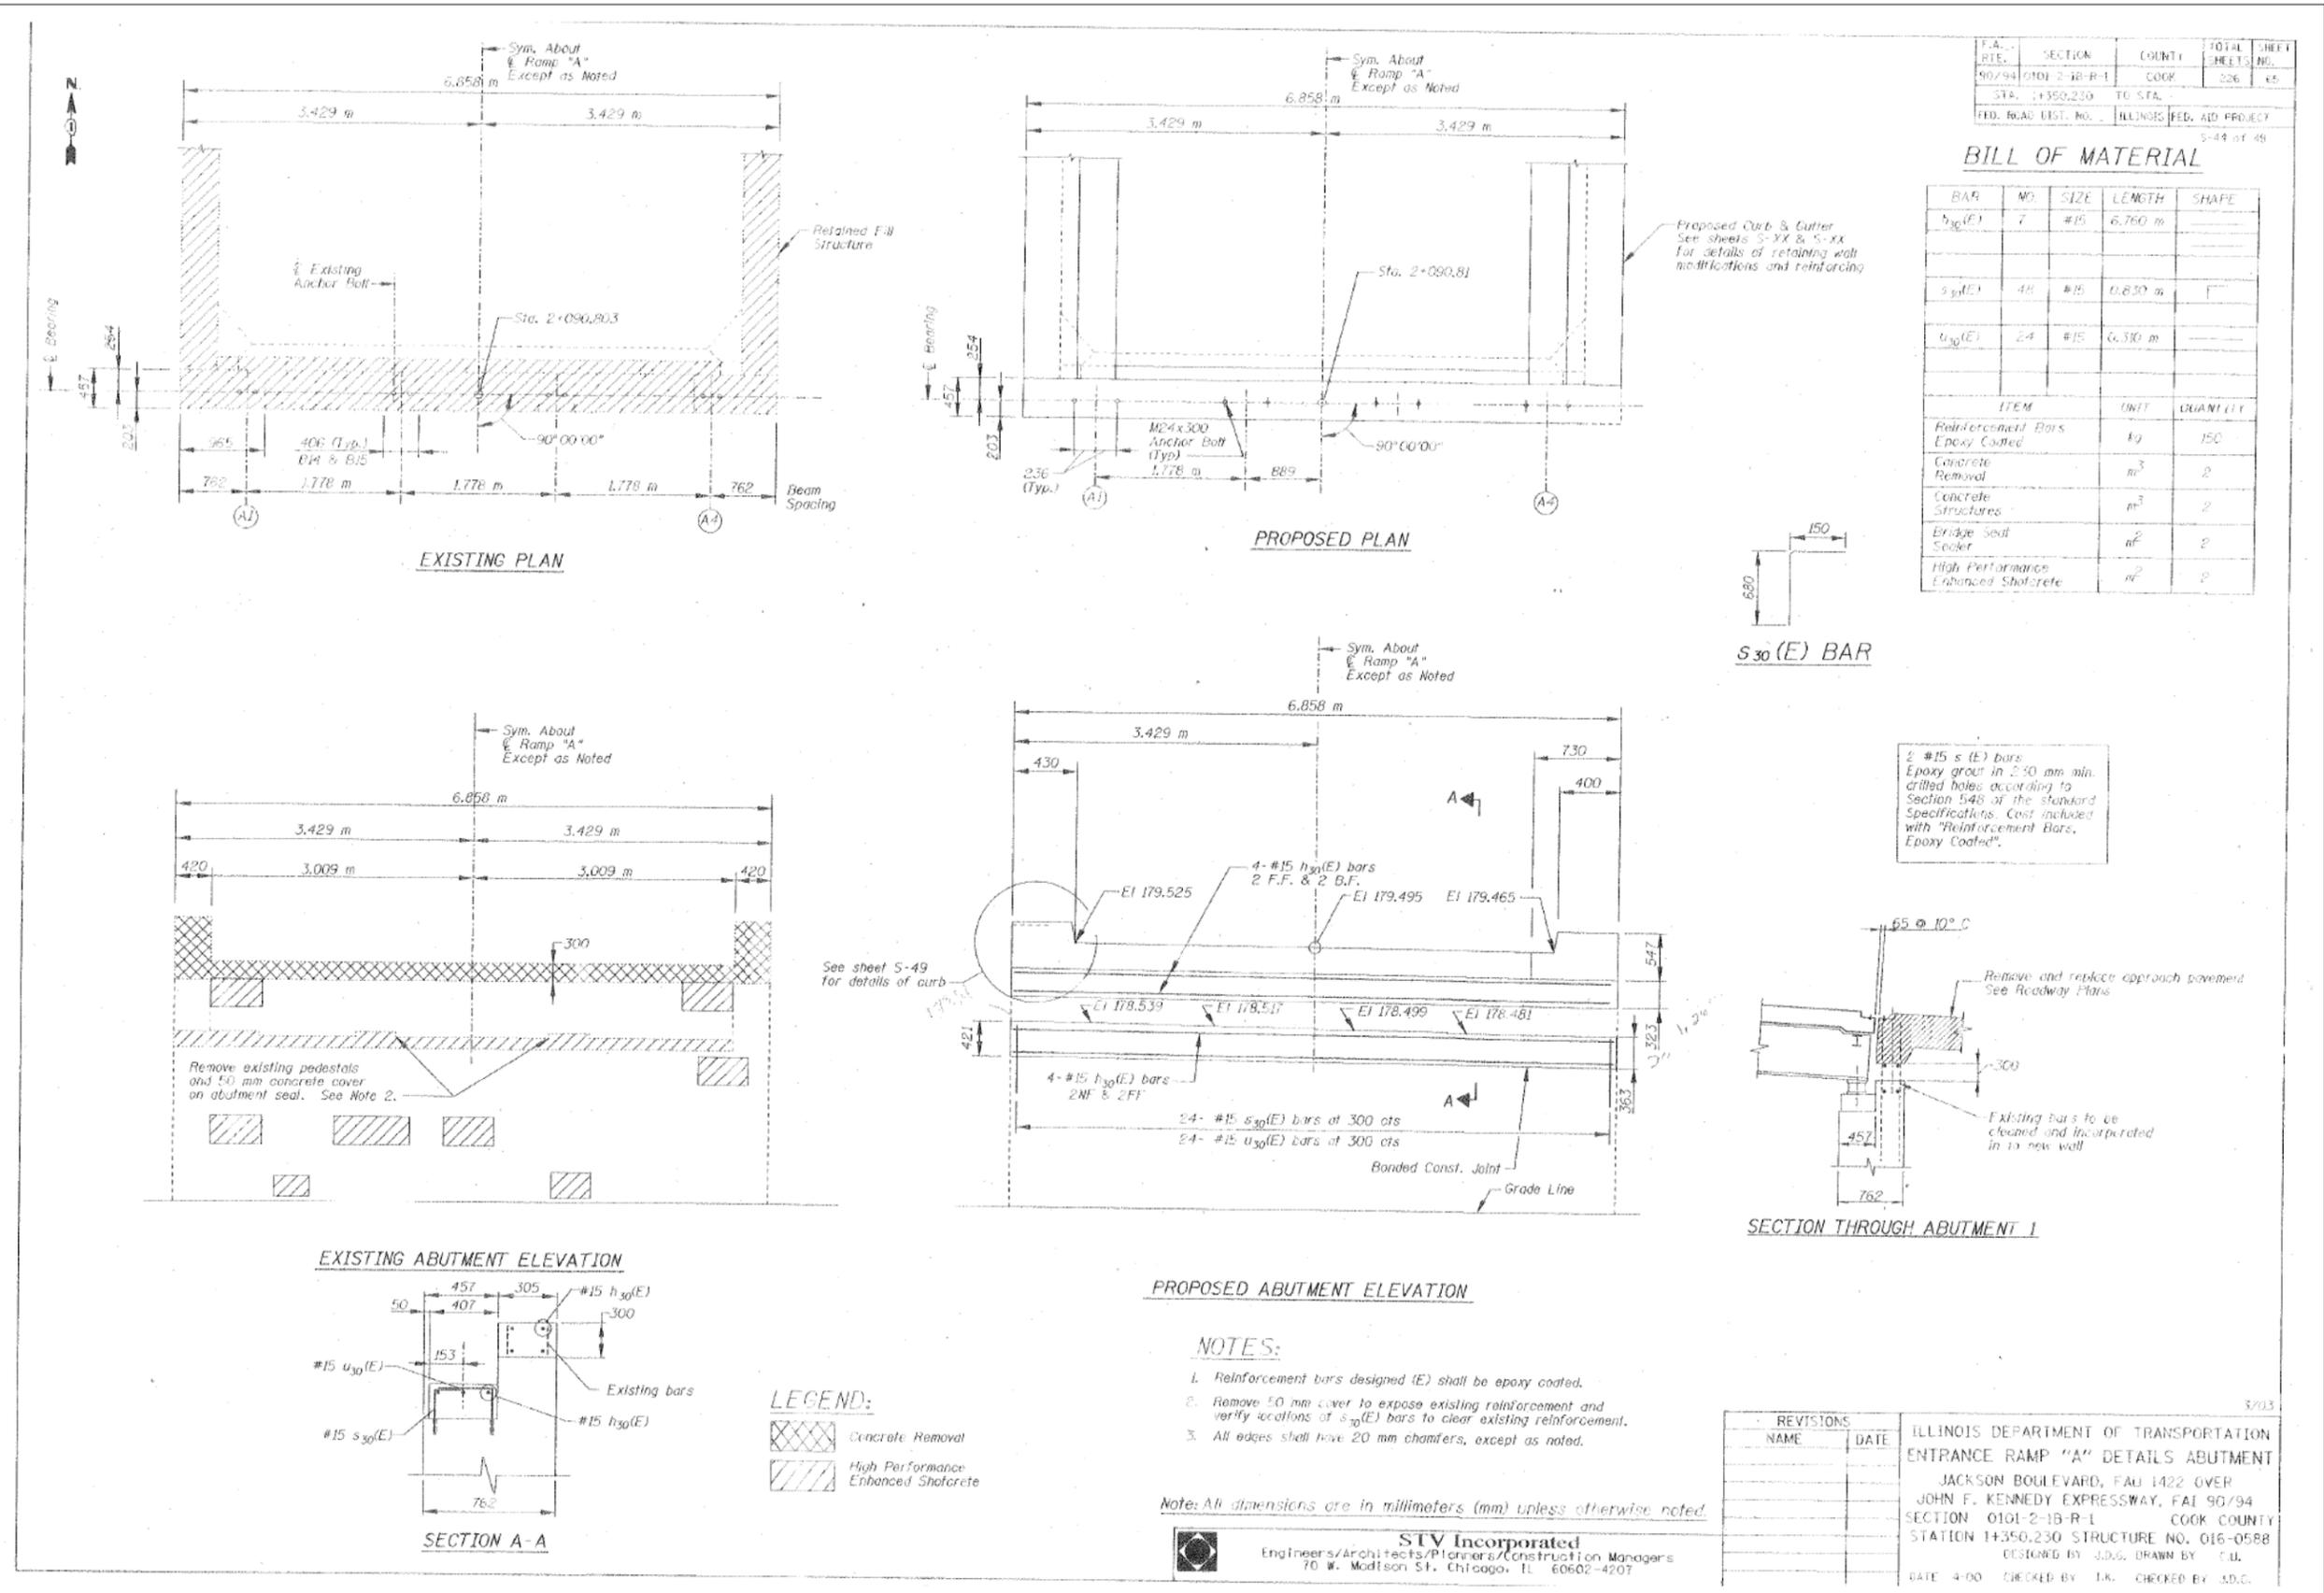

F.A.I. RTE.	SECTION	COUNTY	TOTAL SHEETS	SHEET NO.
90/94	01G1-2-1B-R-1	COOK	226	65
STA. 1+350.230 TO STA.		ILLINOIS FED. AID PROJECT		
FED. ROAD DIST. NO.		5-44 of 49		

BAR	NO.	SIZE	LENGTH	SHAPE
h ₃₀ (E)	7	#15	6.760 m	
s ₃₀ (E)	48	#15	0.830 m	
u ₃₀ (E)	24	#15	6.310 m	
ITEM	UNIT	QUANTITY		
Reinforcement Bars Epoxy Coated	kg	150		
Concrete Removal	m ³	2		
Concrete Structures	m ³	2		
Bridge Seal Sealer	m ²	2		
High Performance Enhanced Shotcrete	m ²	2		

2 #15 s (E) bars
Epoxy grout in 250 mm min. drilled holes according to Section 548 of the standard Specifications. Cost included with "Reinforcement Bars, Epoxy Coated".

- NOTES:**
1. Reinforcement bars designed (E) shall be epoxy coated.
 2. Remove 50 mm cover to expose existing reinforcement and verify locations of s₃₀(E) bars to clear existing reinforcement.
 3. All edges shall have 20 mm chamfers, except as noted.

Note: All dimensions are in millimeters (mm) unless otherwise noted.

STV Incorporated
Engineers/Architects/Planners/Construction Managers
70 W. Madison St., Chicago, IL 60602-4207

REVISIONS	NAME	DATE

ILLINOIS DEPARTMENT OF TRANSPORTATION
ENTRANCE RAMP "A" DETAILS ABUTMENT
JACKSON BOULEVARD, FAJ 1422 OVER
JOHN F. KENNEDY EXPRESSWAY, FAJ 90/94
SECTION 01G1-2-1B-R-1 COOK COUNTY
STATION 1+350.230 STRUCTURE NO. 016-0588
DESIGNED BY J.D.S. DRAWN BY C.J.L.
DATE 4-00 CHECKED BY J.A. CHECKED BY J.D.C.

6:53:49 PM
D162J31-SHT-AS-BUILT-44



USER NAME	DESIGNED	REVISIONS
wjcollett1	EH	
	WJC	
	EH	
	WJC	

STATE OF ILLINOIS
DEPARTMENT OF TRANSPORTATION


EXISTING JACKSON BLVD BRIDGE PLANS (SN 016-0588)

F.A.I. RTE.	SECTION	COUNTY	TOTAL SHEETS	SHEET NO.
90/94/290	2014-017B	COOK	400	271
				CONTRACT NO. 62J31
ILLINOIS FED. AID PROJECT				


SHEET NO. AB-44 OF AB-65 SHEETS

FOR INFORMATION ONLY


F.A.I. RYE.	SECTION	COUNTY	TOTAL SHEETS	SHEET NO.
90/94	0101-2-1B-R-1	COOK	226	67
STA. 14350.230 TO STA.		ILLINOIS FED. AID PROJECT		
FED. ROAD DIST. NO.		S-46 of 49		

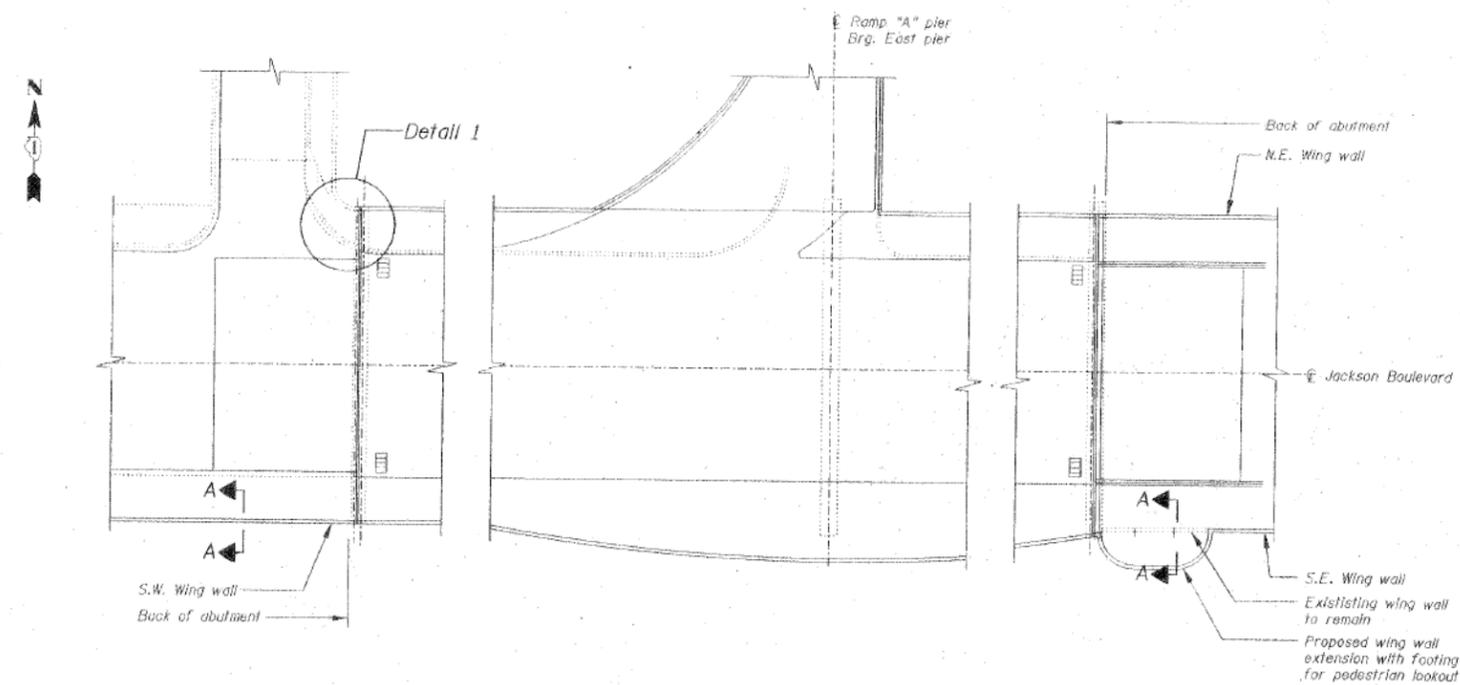

PLAN

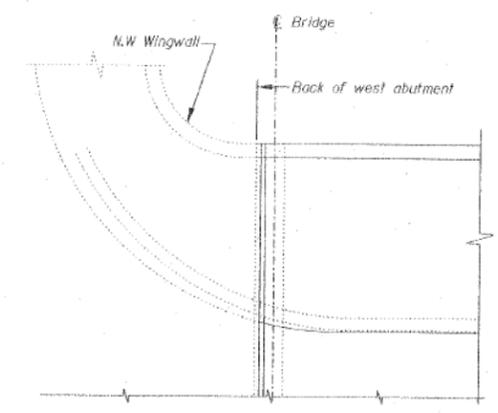

DETAIL 1

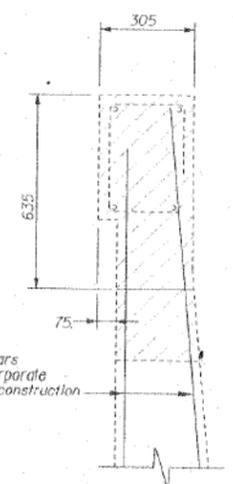

SECTION A-A

NOTES:
1. For railing details and base plate locations, see Architectural sheets

Note: All dimensions are in millimeters (mm) unless otherwise noted.

REVISIONS		ILLINOIS DEPARTMENT OF TRANSPORTATION WINGWALL REHABILITATION PLANS JACKSON BOULEVARD, FAU 1422 OVER JOHN F. KENNEDY EXPRESSWAY, FAJ 90/94 SECTION 0101-2-1B-R-1 COOK COUNTY STATION 14350.230 STRUCTURE NO. 016-0588 DESIGNED BY J.D.G. DRAWN BY C.J.
NAME	DATE	
		DATE 4-00 CHECKED BY LK. CHECKED BY J.D.G.

STV Incorporated
Engineers/Architects/Planners/Construction Managers
70 W. Madison St. Chicago, IL 60602-4207

6/5/4:11 PM 0162331-SHT-AS-BUILT-45



USER NAME = wjcolletti	DESIGNED EH	REVISED
PLOT SCALE = 0x2.0000 'x' / in.	CHECKED WJC	REVISED
PLOT DATE = 8/13/2019	DRAWN EH	REVISED
	CHECKED WJC	REVISED


STATE OF ILLINOIS
DEPARTMENT OF TRANSPORTATION

EXISTING JACKSON BLVD BRIDGE PLANS (SN 016-0588)


SHEET NO. AB-45 OF AB-65 SHEETS

F.A.I. RYE.	SECTION	COUNTY	TOTAL SHEETS	SHEET NO.
90/94/290	2014-017B	COOK	400	272
				CONTRACT NO. 62J31
ILLINOIS FED. AID PROJECT				

FOR INFORMATION ONLY

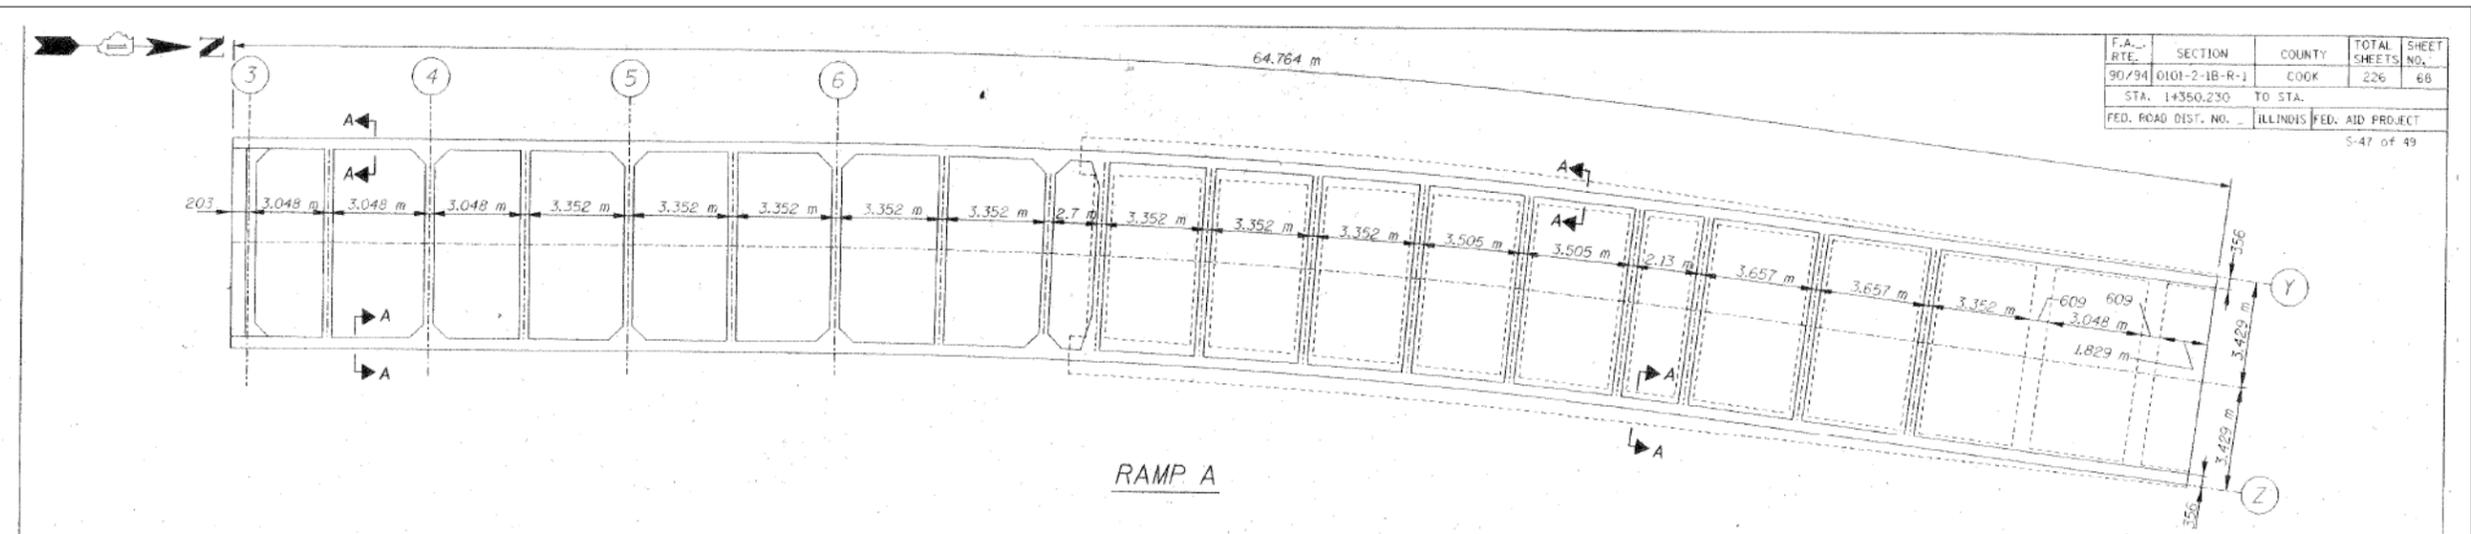

F.A. RTE.	SECTION	COUNTY	TOTAL SHEETS	SHEET NO.
90/94	0101-2-1B-R-1	COOK	226	68
STA. 1+350.230	TO STA.			
FED. ROAD DIST. NO.	ILLINOIS FED. AID PROJECT		S-47 of 49	

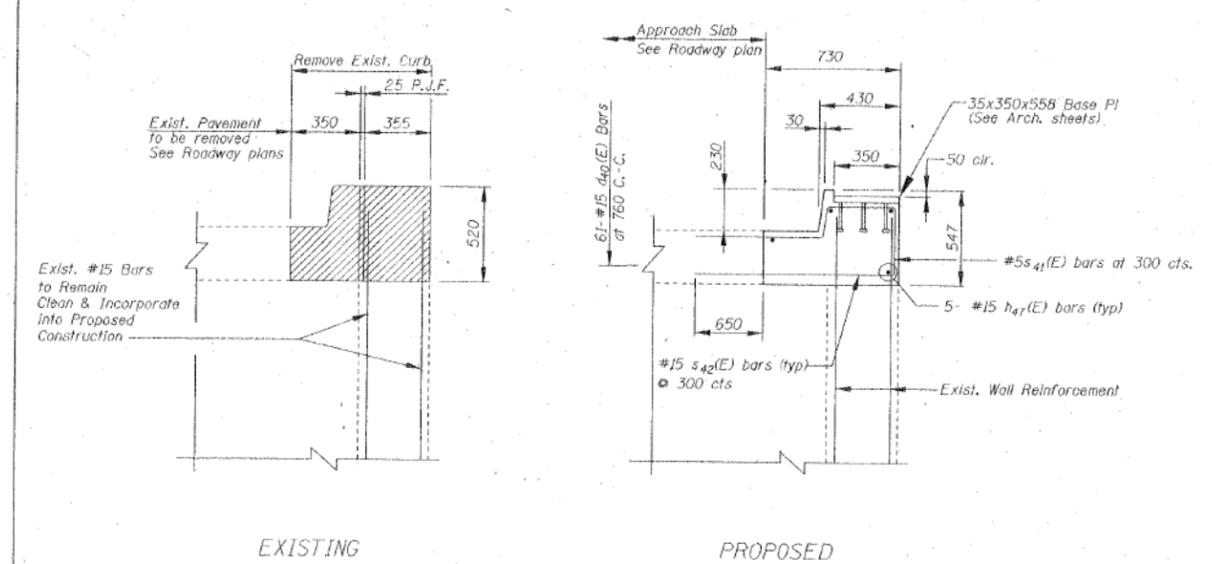


SECTION A-A
TYPICAL RAMP "A" WALLS

Curve Data
 $\Delta = 7^{\circ} 37' 16''$
 $T = 15.370 \text{ m}$
 $R = 230.76 \text{ m}$
 $L = 30.69 \text{ m}$
 P.C. Sta. 2+109.01
 P.I. Sta. 2+124.35
 P.T. Sta. 2+139.70

Ramp "A" Curve Data
 Curve A-2
 $\Delta = 33^{\circ} 18' 54''$ P.C. Sta. 1+344.247
 $D = .314 \text{ m}$ Offset 18.590 Lt
 $T = 5.386 \text{ m}$ P.I. Sta. 1+347.207
 $L = 10.466 \text{ m}$ Offset 23.084 Lt.
 $R = 18.0 \text{ m}$ P.C.C. Sta. 1+347.207
 Offset 28.470 Lt.

BILL OF MATERIAL

BAR NO.	SIZE	LENGTH	SHAPE
$h_{41}(E)$	30 #15	11.310 m	
$s_{41}(E)$	434 #15	1.757 m	
$s_{42}(E)$	434 #15	1.635 m	
ITEM	UNIT	QUANTITY	
Reinforcement Bars - Epoxy Coated	kg	2845	
Concrete Removal	m^3	43	
Concrete Structures	m^3	43	

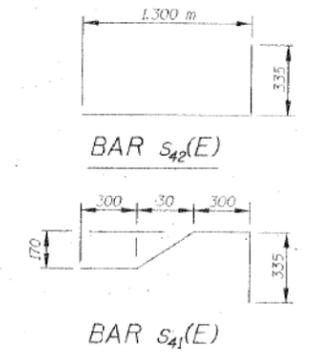

NOTES:

1. Reinforcement bars designated (E) shall be epoxy coated.
2. Space reinforcement in cap 10 mm miss anchor bolts.
3. All edges shall have standard 20 mm chamfers except as noted.
4. Pour steps monolithically with cap.
5. For railing details and base plate location, see sheets A-101 to A-408.

Note: All dimensions are in millimeters (mm) unless otherwise noted.

REVISIONS		ILLINOIS DEPARTMENT OF TRANSPORTATION ENTRANCE RAMP "A" RETAINING WALLS JACKSON BOULEVARD, FAU 1422 OVER JOHN F. KENNEDY EXPRESSWAY, FAI 90/94 SECTION 0101-2-1B-R-1 COOK COUNTY STATION 1+350.230 STRUCTURE NO. 016-0588 DESIGNED BY J.D.G. DRAWN BY C.U. DATE 4-00 CHECKED BY I.K. CHECKED BY J.D.G.
NAME	DATE	

STV Incorporated
 Engineers/Architects/Planners/Construction Managers
 70 W. Madison St. Chicago, IL 60602-4207

6/5/2014 4:34 PM D:\162\31-SHT-AS-BUILT-46



USER NAME = wjcollett1	DESIGNED EH	REVISED
PLOT SCALE = 0x2.0000 '1" / in.	CHECKED WJC	REVISED
PLOT DATE = 8/13/2019	DRAWN EH	REVISED
	CHECKED WJC	REVISED

STATE OF ILLINOIS
DEPARTMENT OF TRANSPORTATION




EXISTING JACKSON BLVD BRIDGE PLANS (SN 016-0588)

SHEET NO. AB-46 OF AB-65 SHEETS

F.A.I. RTE.	SECTION	COUNTY	TOTAL SHEETS	SHEET NO.
90/94/290	2014-017B	COOK	400	273
ILLINOIS FED. AID PROJECT			CONTRACT NO. 62J31	

FOR INFORMATION ONLY

F.A. RTE.	SECTION	COUNTY	TOTAL SHEETS	SHEET NO.
90/94	0101-2-1B-R-1	COOK	226	69
STA. 1+350.230		TO STA.		
FED. ROAD DIST. NO.		ILLINOIS	FED. AID PROJECT	5-48 of 49

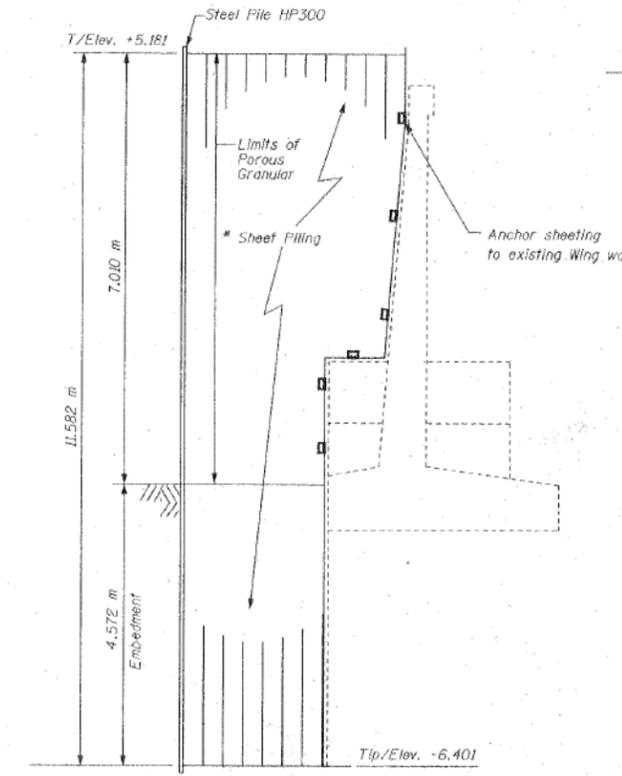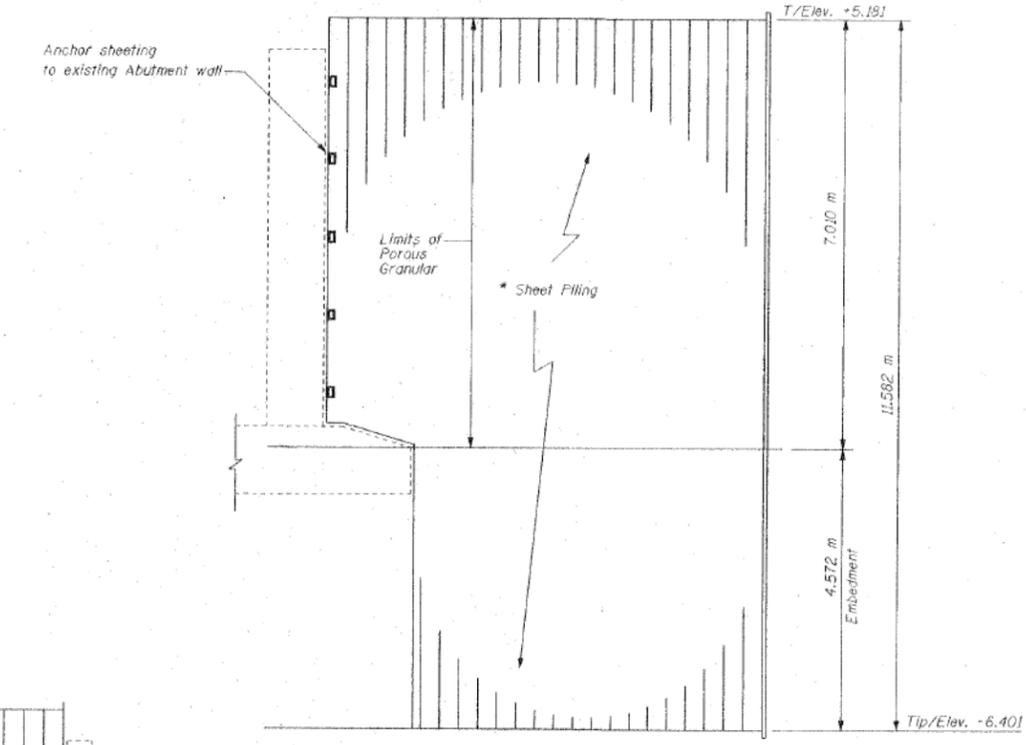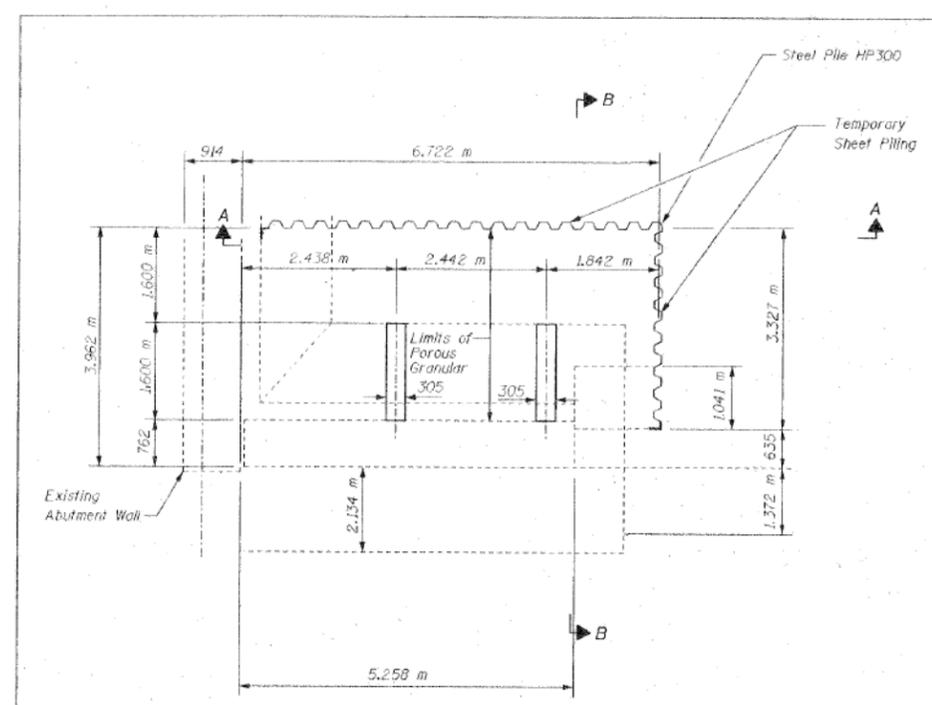

BILL OF MATERIAL

BAR	NO.	SIZE	LENGTH(m)	SHAPE
n (E)	24	15	8.900	—
h ₁ (E)	8	15	3.800	—
h ₂ (E)	6	15	3.300	—
h ₃ (E)	2	15	3.000	—
h ₄ (E)	44	15	1.955	—
x (E)	18	20	6.220	□
x ₁ (E)	16	20	5.850	□
x ₂ (E)	16	20	5.110	□
x ₃ (E)	9	15	3.300	—
x ₄ (E)	8	15	3.000	—
x ₅ (E)	8	15	2.400	—
x ₆ (E)	7	15	3.930	□
n (E)	76	20	0.900	—
v (E)	32	20	6.550	□
b (E)	31	15	4.420	□
ITEM	UNIT	QUANTITY		
Reinforcement Bars Epoxy Coated	kg	2255		
Concrete Removal	m ³	2		
Concrete Structures	m ³	29		
Structure Excavation	m ³	157		
Porous Granular Embankment	m ³	151		

* "If the contractor chooses to alter the temporary cantilevered sheet piling design requirements shown on the plans for lesser design requirements, then full design submittals with the required seals will be expected by the Department, for review and approval."

³ Minimum Sheet Piling section Modulus per meter length shall be 2.059,000 m³

REVISIONS	
NAME	DATE

ILLINOIS DEPARTMENT OF TRANSPORTATION
LOOKOUT DETAILS
JACKSON BOULEVARD, FAU 1422 OVER
JOHN F. KENNEDY EXPRESSWAY, FAU 90/94
SECTION 0101-2-1B-R-1 COOK COUNTY
STATION 1+350.230 STRUCTURE NO. 016-0588
DESIGNED BY J.D.G. DRAWN BY C.U.
DATE 4-00 CHECKED BY I.K. CHECKED BY J.D.G.

STV Incorporated
Engineers/Architects/Planners/Construction Managers
70 W. Madison St., Chicago, IL 60602-4207

6:54:57 PM 0162031-SHT-AS-BUILT-47



USER NAME = wjcolletti	DESIGNED EH	REVISED
PLOT SCALE = 0x2.0000 'x' / in.	CHECKED WJC	REVISED
PLOT DATE = 8/13/2019	DRAWN EH	REVISED
	CHECKED WJC	REVISED

STATE OF ILLINOIS
DEPARTMENT OF TRANSPORTATION


EXISTING JACKSON BLVD BRIDGE PLANS (SN 016-0588)

SHEET NO. AB-47 OF AB-65 SHEETS


F.A. RTE.	SECTION	COUNTY	TOTAL SHEETS	SHEET NO.
90/94/290	2014-017B	COOK	400	274
				CONTRACT NO. 62J31
ILLINOIS FED. AID PROJECT				

FOR INFORMATION ONLY


F.A.I. R.T.E.	SECTION	COUNTY	TOTAL SHEETS	SHEET NO.
90/94	0101-2-1B-R-1	COOK	226	70
STA. 1+350.230 TO STA.		ILLINOIS FED. AID PROJECT		
FED. ROAD DIST. NO.		5-49 of 49		

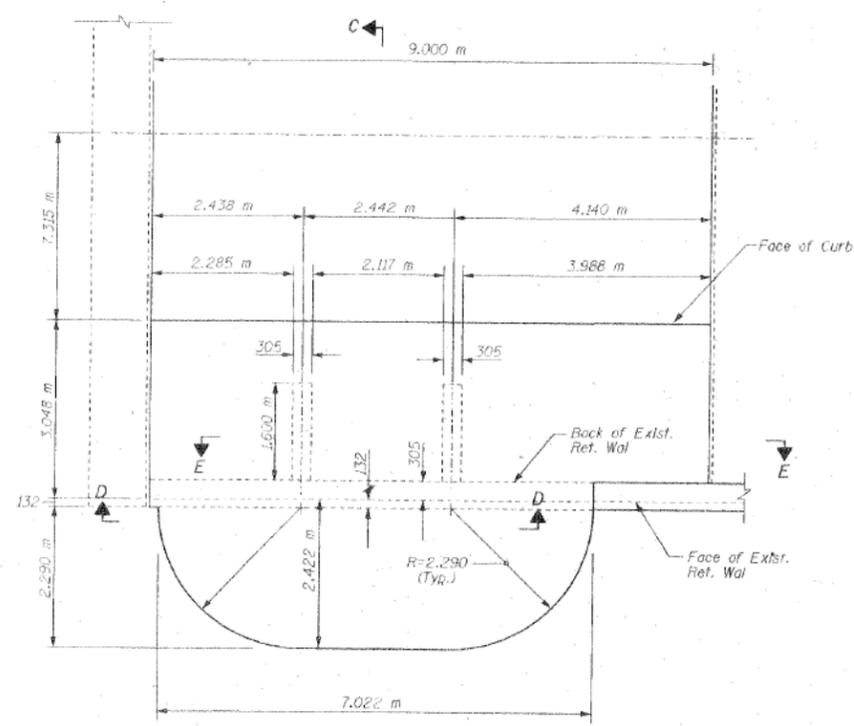


PLAN

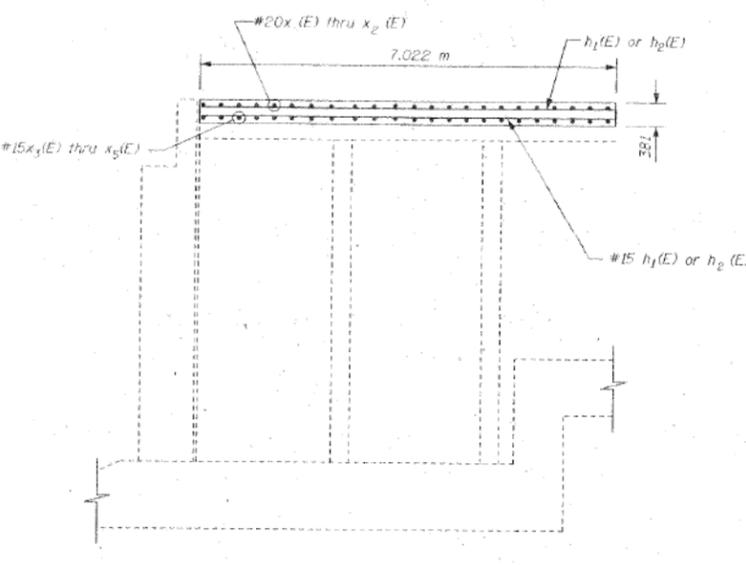


SECTION D-D

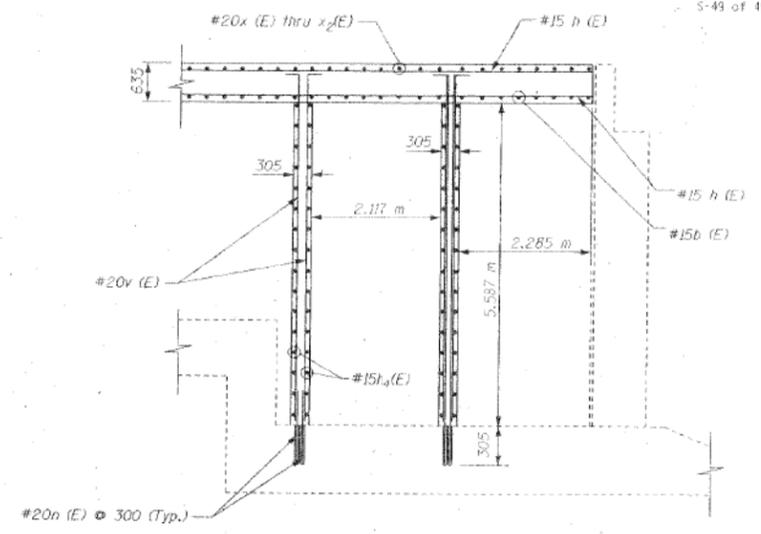


SECTION E-E

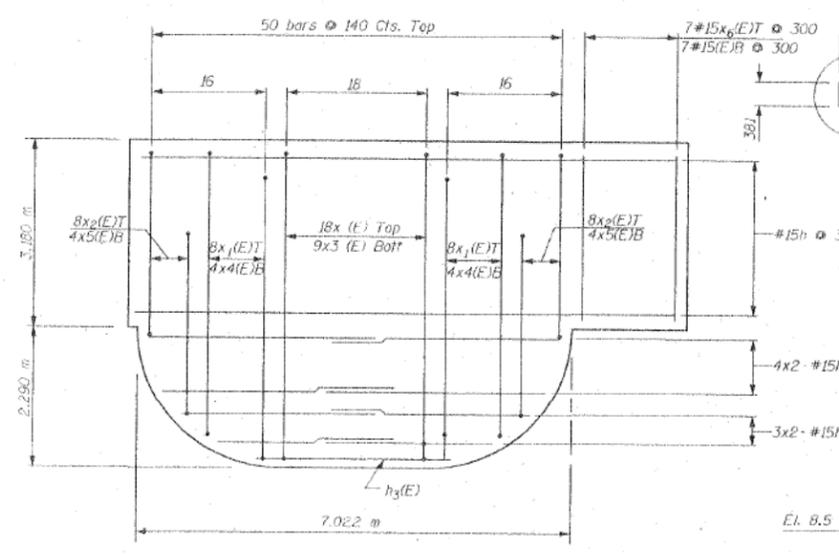

TOP PLAN

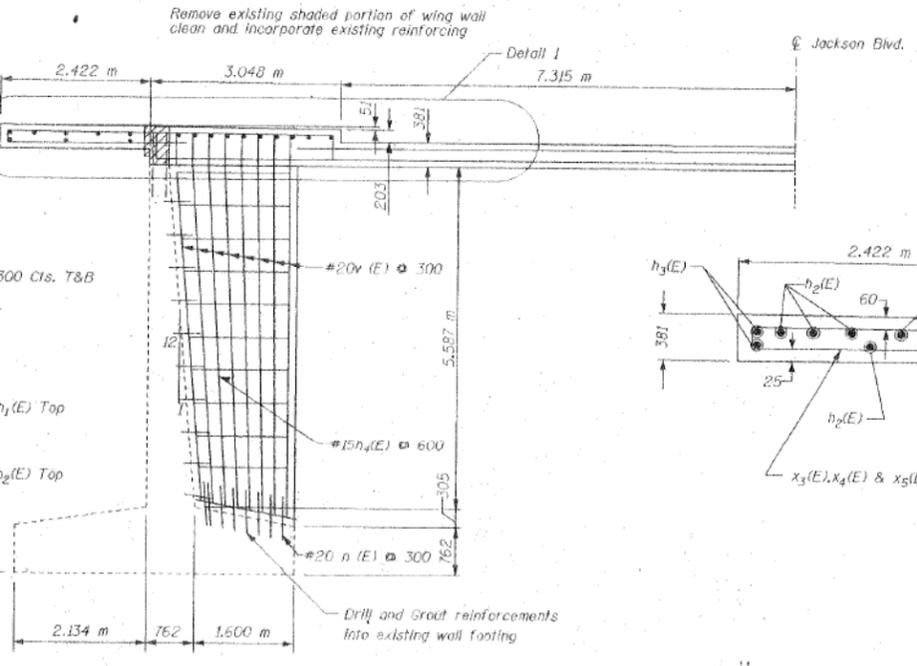

SECTION C-C

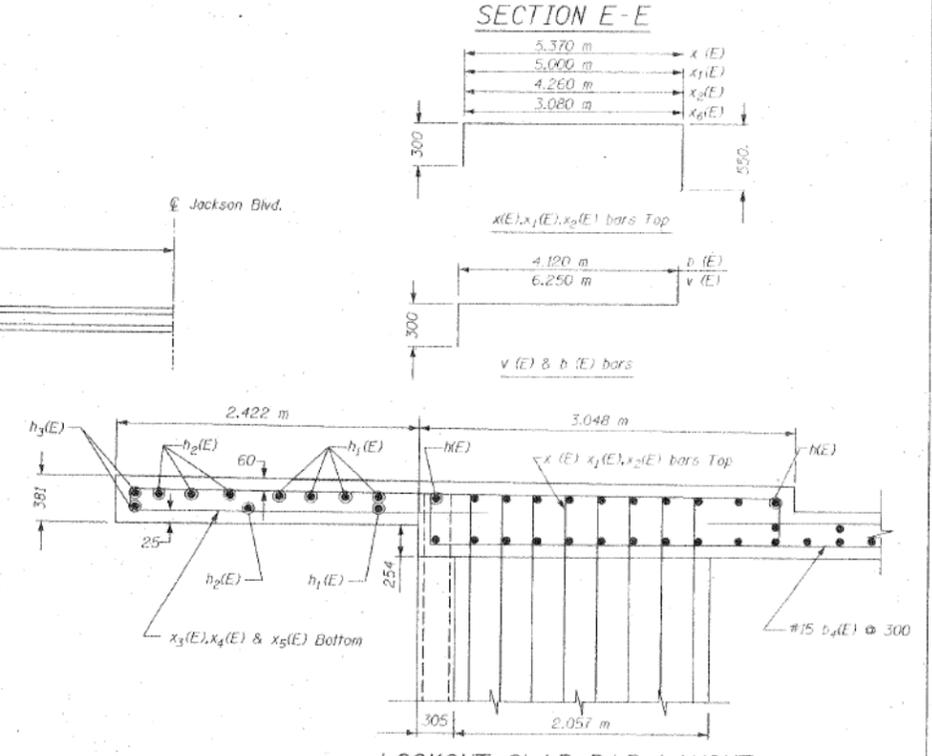

LOOKOUT SLAB BAR LAYOUT

REVISIONS		ILLINOIS DEPARTMENT OF TRANSPORTATION LOOKOUT DETAILS
NAME	DATE	
		JACKSON BOULEVARD, FAU 1422 OVER JOHN F. KENNEDY EXPRESSWAY, FAI 90/94 SECTION 0101-2-1B-R-1 COOK COUNTY STATION 1+350.230 STRUCTURE NO. 016-0588 DESIGNED BY J.D.G. DRAWN BY C.U. DATE 4-00 CHECKED BY J.K. CHECKED BY J.D.G.

STV Incorporated
 Engineers/Architects/Planners/Construction Managers
 70 W. Madison St. Chicago, IL 60602-4207

6:55:21 PM
 D162331-SHT-AS-BUILT-48



USER NAME = wjcolletti	DESIGNED EH	REVISED
PLOT SCALE = 0x2.0000 'x' / in.	CHECKED WJC	REVISED
PLOT DATE = 8/13/2019	DRAWN EH	REVISED
	CHECKED WJC	REVISED

STATE OF ILLINOIS
 DEPARTMENT OF TRANSPORTATION

EXISTING JACKSON BLVD BRIDGE PLANS (SN 016-0588)

SHEET NO. AB-48 OF AB-65 SHEETS

F.A.I. R.T.E.	SECTION	COUNTY	TOTAL SHEETS	SHEET NO.
90/94/290	2014-017B	COOK	400	275
ILLINOIS FED. AID PROJECT				CONTRACT NO. 62J31

FOR INFORMATION ONLY


STATE OF ILLINOIS
CITY OF CHICAGO
DEPARTMENT OF PUBLIC WORKS
BUREAU OF ENGINEERING

NORTHWEST ROUTE SUPERHIGHWAY
PLANS FOR
JACKSON BOULEVARD BRIDGE
SECTION 0101.2-2B
F.A. ROUTE NO. 173 PROJECT UI 265 (4)

SHEET NO.	DESCRIPTION	PAGE NO.
GENERAL PLANS		
0-1	TITLE SHEET	1
0-2	GENERAL PLAN AND ELEVATION	2
0-3	EXISTING CONDITIONS AND DETON	3
0-4	CONSTRUCTION PLAN AND PAY LIMITS	4
STRUCTURAL PLANS		
0-1	FOOTING PLAN	5
0-2	EAST PIER	6
0-3	WEST PIER	7
0-4	WEST ABUTMENT	8
0-5	EAST ABUTMENT	9
0-6	SOUTH WINDGALLS	10
0-7	NORTHEAST WINDGALLS AND CONDUIT DETAILS	11
0-8	FRAMING PLAN AND DETAILS	12
0-9	STRUCTURAL STEEL DETAILS	13
0-10	BEARING DETAILS	14
0-11	EXPANSION DEVICES	15
0-12	DECK REINFORCEMENT AND DETAILS	16
0-13	SLAB DETAILS AND RAMP PARAPETS	17
0-14	APPROACH SLABS AND DETAILS	18
0-15	BAR LIST	19
ARCHITECTURAL PLANS		
A-1	RAILING DETAILS AND RAMP PLATES	20
A-2	UNUSUAL TYPING AND BRASSWORK DETAILS	21
FINISH PLANS		
B-1	PAVEMENT AND SIDEWALK DETAILS	22
B-2	PAVEMENT DETAILS AND FINISHES	23
ELECTRICAL PLANS		
E-1	ELECTRICAL LAYOUT	24
E-2	TEMPORARY DETON LIGHTING	25
E-3	WATER SYSTEM	26
E-4	WATER SYSTEM DETON	27
E-5	ELECTRICAL PANELS	28
E-6	ELECTRICAL PANELS	29
E-7	SPECIAL HANDLE DETAILS	30
E-8	SPECIAL HANDLE DETAILS	31
E-9	SPECIAL HANDLE DETAILS	32
E-10	SPECIAL HANDLE DETAILS	33
E-11	ELECTRICAL DETAILS	34
E-12	HANDLE FRAMES & COVERS	35
CROSS-SECTIONS		
C-1	CROSS-SECTIONS - STATIONS 1+00 TO 1+70	36
C-2	CROSS-SECTIONS - STATIONS 4+70 TO 5+00	37
C-3	CROSS-SECTIONS - DETON	38

CONVENTIONAL SIGNS

PIPE UTILITY	○	PIPE
ENGINEERING STANDARDS	○	ENGINEERING STANDARDS
EXISTING SIGN	○	EXISTING SIGN
HANDLE ON CATCH BARS, TO BE ADJUSTED	○	HANDLE ON CATCH BARS, TO BE ADJUSTED
R.A.V. LINE	—	R.A.V. LINE
NEW LIGHT STANDARD	○	NEW LIGHT STANDARD
HANDLE TO BE FILED	○	HANDLE TO BE FILED
NEW CATCH BARS	○	NEW CATCH BARS
CONCRETE/STEEL BRIDGE OR	□	CONCRETE/STEEL BRIDGE OR
PEPPERLAW LIGHT & SIGNAL CO.	□	PEPPERLAW LIGHT & SIGNAL CO.
CITY WATER	○	CITY WATER
CITY SEWER	○	CITY SEWER
STREET DISTRICT	□	STREET DISTRICT

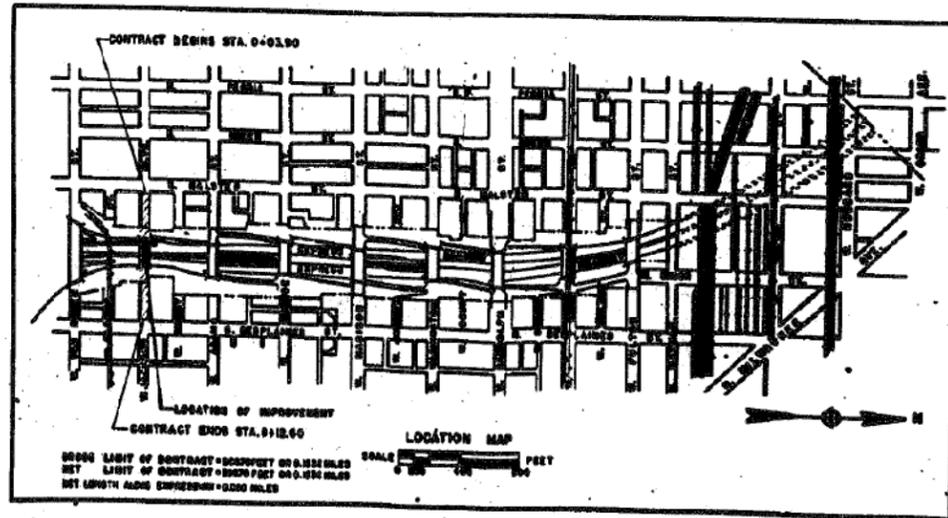

PREPARED FOR
THE CITY OF CHICAGO
BY
CONSOER, TOWNSEND AND ASSOCIATES
CONSULTING ENGINEERS
PLANS APPROVED
BY THE STATE DIVISION OF HIGHWAYS

ROUTE NO.	SECTION	COUNTY	TOTAL SHEETS	SHEET NO.
F.A. 173	0101.2	COOK	400	276
PREPARED BY NO. 4 BILLING PROJECT OF BRIDGE				

SUMMARY OF ITEMS

RETURN THIS PLAN
TO MAINTENANCE
ROOM 706

DRAWER

3A

CITY OF CHICAGO
DEPARTMENT OF PUBLIC WORKS
BUREAU OF ENGINEERING
DATE: JUL 1994

APPROVED: [Signature]

APPROVED: [Signature]

APPROVED: [Signature]

THE DEPARTMENT OF
PUBLIC WORKS AND BUILDINGS
BUREAU OF BRIDGES

APPROVED: [Signature]

APPROVED: [Signature]

DEPARTMENT OF CHICAGO
BUREAU OF PUBLIC WORKS

APPROVED: [Signature]

APPROVED: [Signature]

SHEET NO. 0-1 OF 38 SHEETS

6:55:43 PM
D162331-SHT-AS-BUILT-49



USER NAME = wjcollett1	DESIGNED EH	REVISED
	CHECKED WJC	REVISED
PLOT SCALE = 0x2.0000 '1" / in.	DRAWN EH	REVISED
PLOT DATE = 8/13/2019	CHECKED WJC	REVISED



STATE OF ILLINOIS
DEPARTMENT OF TRANSPORTATION

EXISTING JACKSON BLVD BRIDGE PLANS (SN 016-0588)

SHEET NO. AB-49 OF AB-65 SHEETS

F.A.I. RTE.	SECTION	COUNTY	TOTAL SHEETS	SHEET NO.
90/94/290	2014-017B	COOK	400	276
CONTRACT NO. 62J31				
ILLINOIS FED. AID PROJECT				

FOR INFORMATION ONLY

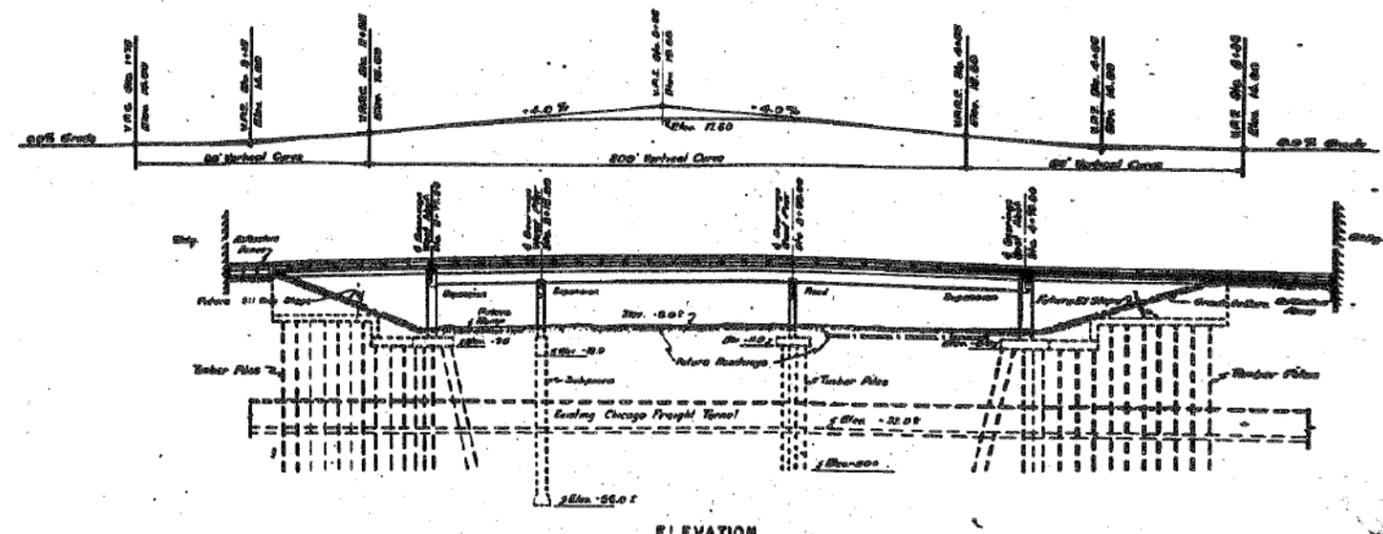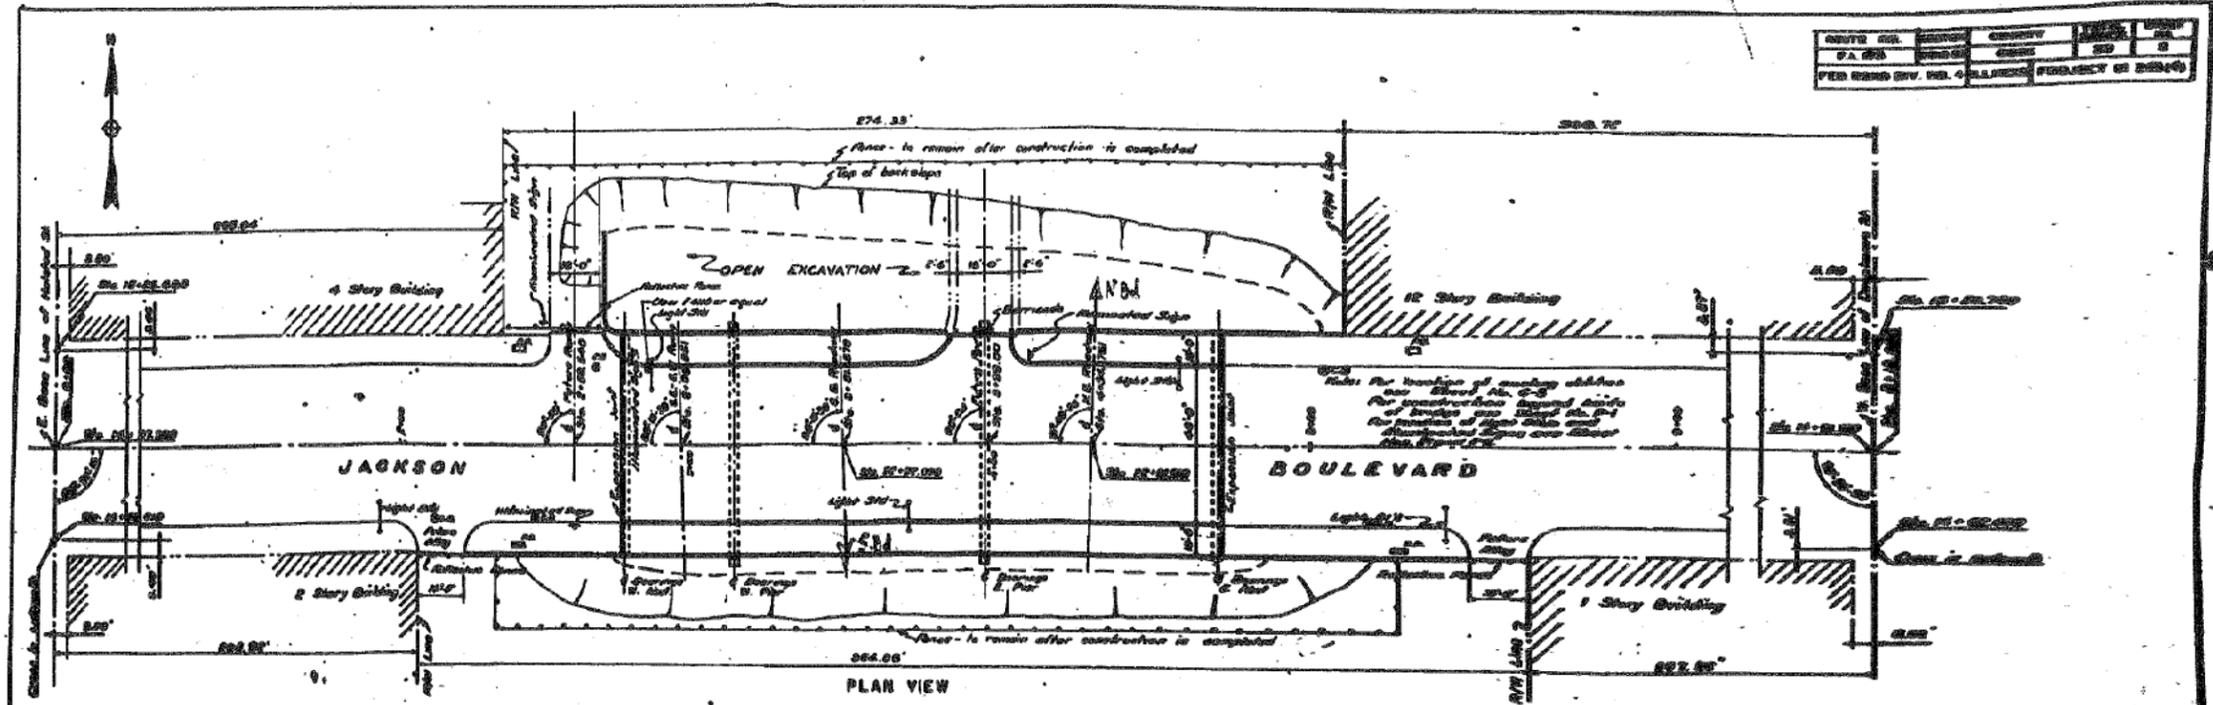

GENERAL NOTES

Design Data
 Maximum
 Structural steel - 5 - 10,000 p.s.i.
 Reinforcing steel - 5 - 50,000 p.s.i.
 Reinforcing concrete - 5 - 4,000 p.s.i.
 Reinforcing concrete - 5 - 4,000 p.s.i.
 Spandrel concrete - 5 - 4,000 p.s.i.
 Under piles - 20 tons - Min. Capacity
 Subgrade - 12 tons per sq. ft. bearing
 Loading
 Live Load - MS-20-44 - AASHTO 2000 Spec.
 Max. Earth Pressure - 45 lbs./sq. ft.
 Min. Earth Pressure - 30 lbs./sq. ft.
 2" Asphalt Wearing Surface - 25 lbs./sq. ft.
 Reinforcing Steel
 Dimensions of reinforcing bars shall conform to
 ASTM Spec. A 675 - 68 T. Minimum lap of reinforcing
 bars shall be 20 bar diameters unless otherwise shown.
 Chambers
 Chamber of exposed concrete to which otherwise shown
 Columns and Connections
 Dimensions are referred to Chicago City Datum
 Dimensions are measured horizontally and at 90°
 unless otherwise shown.

OFFICE OF CHIEF ENGINEER
 DEPARTMENT OF PUBLIC WORKS
 STATE OF ILLINOIS
NORTHWEST ROUTE SUPERHIGHWAY
 ROUTE 20, 201B-20
JACKSON BOULEVARD BRIDGE
GENERAL PLAN AND ELEVATION
 GENERAL CONTRACTOR'S RECORD
 CONTRACT NO. 90-2790
 SHEET NO. AB-50 OF AB-65 SHEETS

315
277.5
377.5
352.5

399
317.5
384

473
380
74
74.6

74
21.9
712.3

6:56:07 PM
 D162331-SHT-AS-BUILT-50



USER NAME = wjcolletti	DESIGNED	EH	REVISED
	CHECKED	WJC	REVISED
PLOT SCALE = 0x2.0000 '1" / in.	DRAWN	EH	REVISED
PLOT DATE = 8/13/2019	CHECKED	WJC	REVISED


STATE OF ILLINOIS
 DEPARTMENT OF TRANSPORTATION

EXISTING JACKSON BLVD BRIDGE PLANS (SN 016-0588)

SHEET NO. AB-50 OF AB-65 SHEETS

F.A.I. R.T.E.	SECTION	COUNTY	TOTAL SHEETS	SHEET NO.
90/94/290	2014-017B	COOK	400	277
			CONTRACT NO. 62J31	
ILLINOIS FED. AID PROJECT				

FOR INFORMATION ONLY

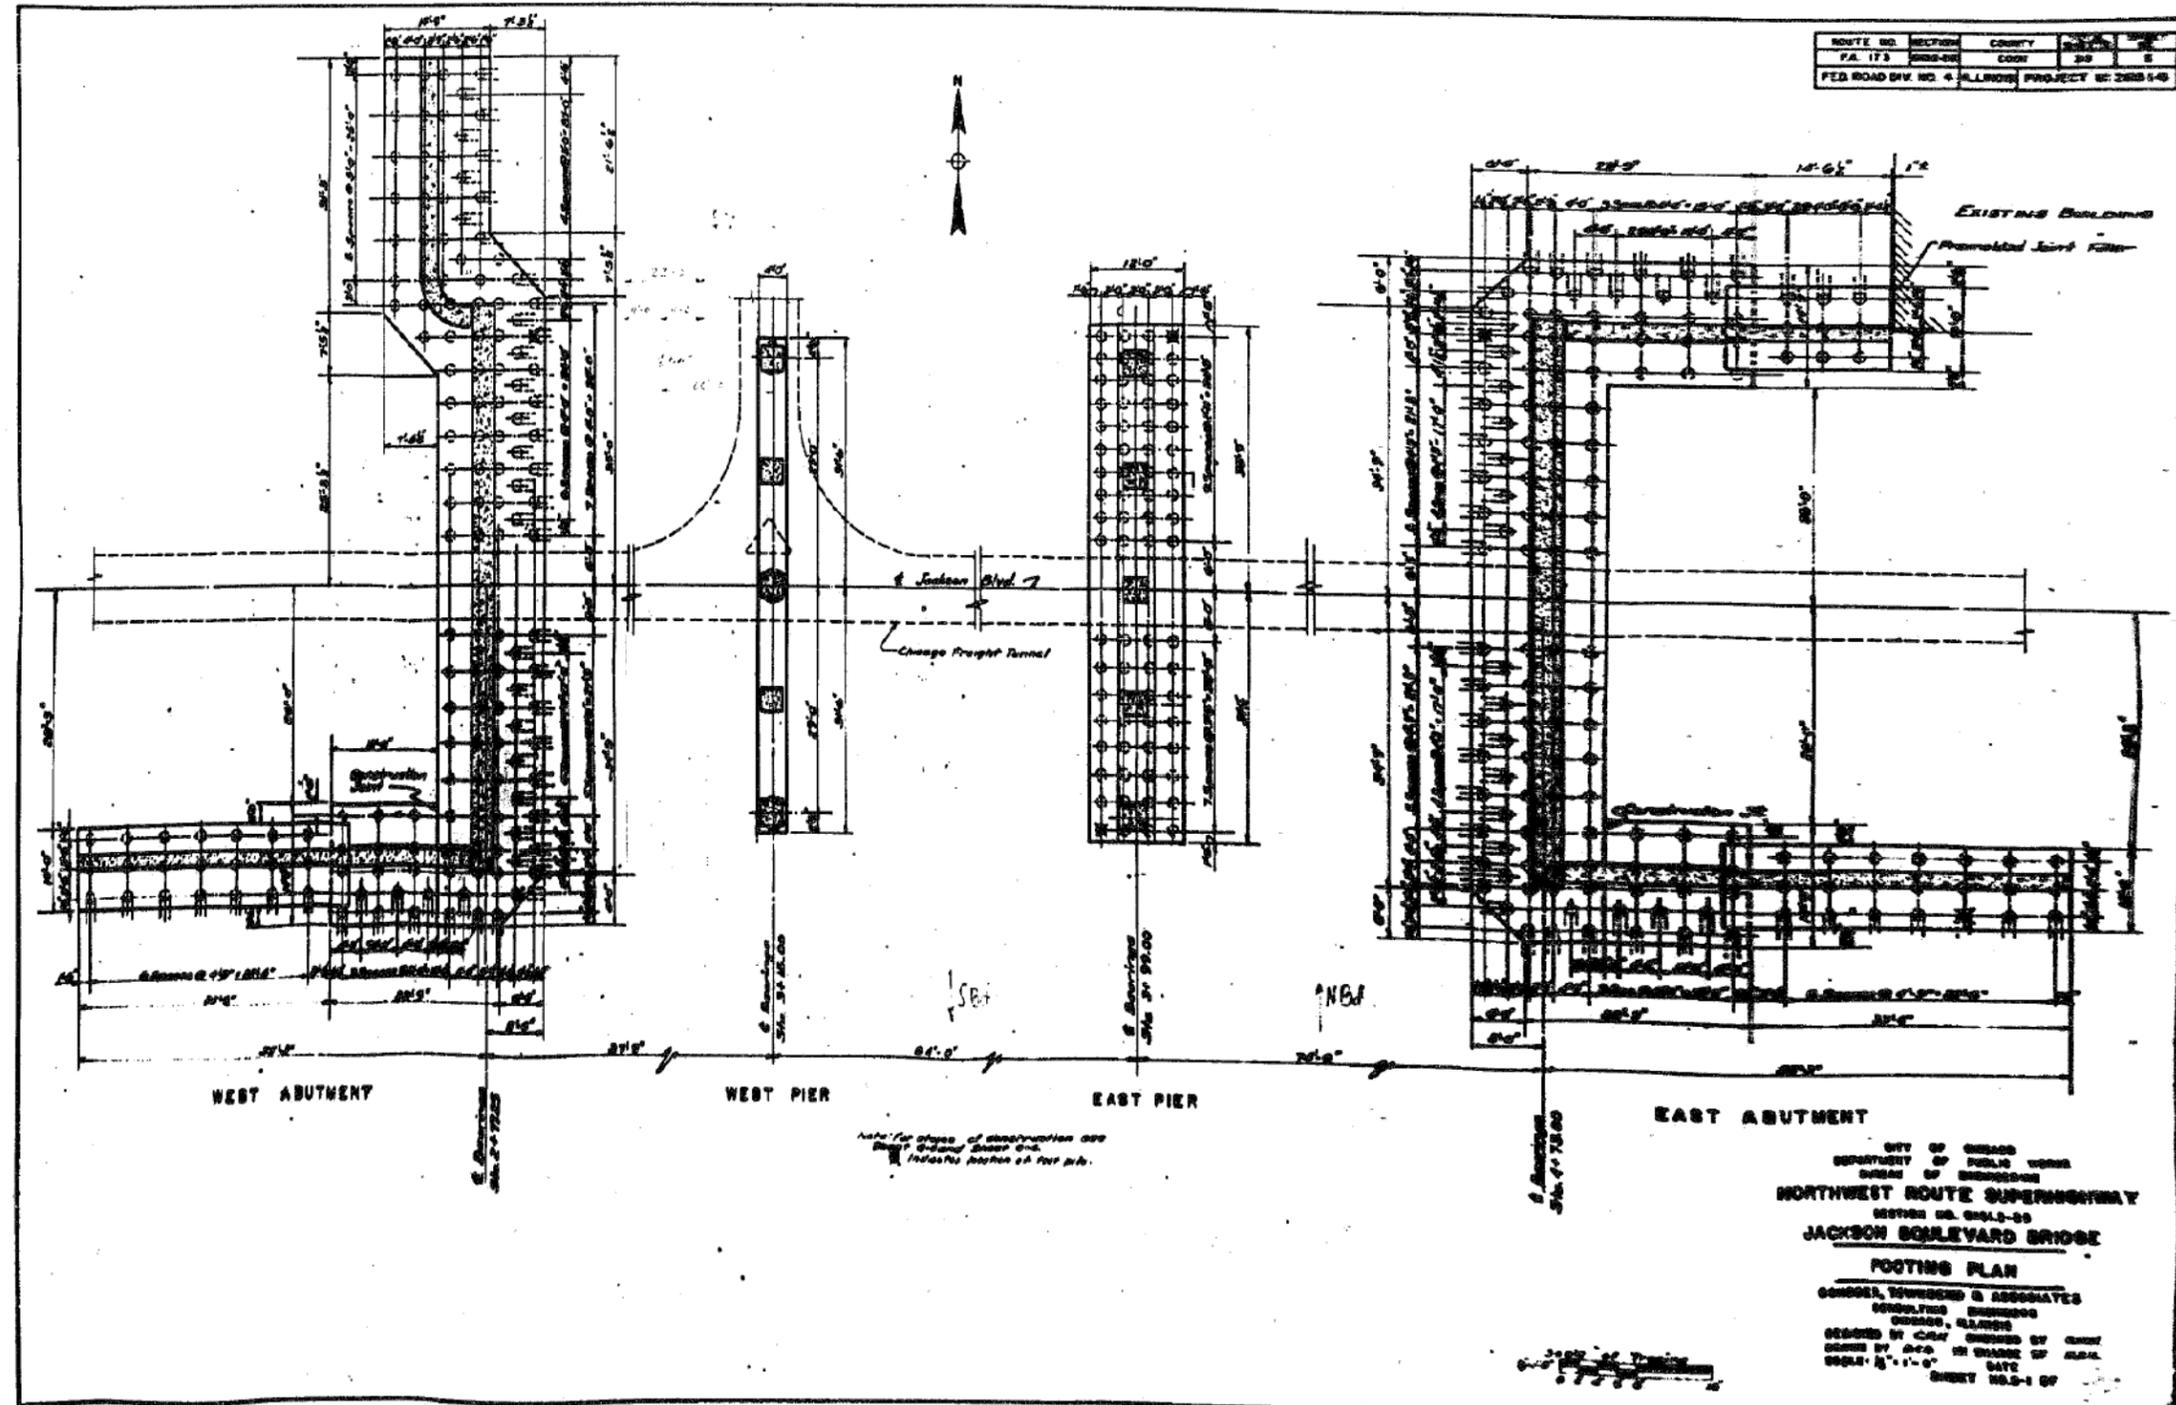

ROUTE NO.	SECTION	COUNTY	SHEET NO.	TOTAL SHEETS
PA. 173	0000-00	COOK	30	8
FED. ROAD DIV. NO. 4 ILLINOIS PROJECT NO. 2888-1-48				

CITY OF CHICAGO
 DEPARTMENT OF PUBLIC WORKS
 BUREAU OF BRIDGES
NORTHWEST ROUTE SUPERHIGHWAY
 SECTION NO. 0013-00
JACKSON BOULEVARD BRIDGE
FOOTING PLAN
 CONDER, TOWNSEND & ASSOCIATES
 CONSULTING ENGINEERS
 CHICAGO, ILLINOIS
 DESIGNED BY C.T. CHECKED BY C.H.T.
 DRAWN BY A.C.C. IN CHARGE OF ALPH. DATE
 SCALE 1/4" = 1'-0" SHEET NO. 51 OF

STATE OF ILLINOIS
 DEPARTMENT OF TRANSPORTATION

EXISTING JACKSON BLVD BRIDGE PLANS (SN 016-0588)

SHEET NO. AB-51 OF AB-65 SHEETS


F.A.I. R.E.	SECTION	COUNTY	TOTAL SHEETS	SHEET NO.
90/94/290	2014-017B	COOK	400	278
CONTRACT NO. 62J31				
ILLINOIS FED. AID PROJECT				

6:56:29 PM
 D162331-SHT-AS-BUILT-51



USER NAME = wjcolletti	DESIGNED	EH	REVISED
	CHECKED	WJC	REVISED
PLOT SCALE = 0:2.0000 '1" / 1n.	DRAWN	EH	REVISED
PLOT DATE = 8/13/2019	CHECKED	WJC	REVISED

FOR INFORMATION ONLY

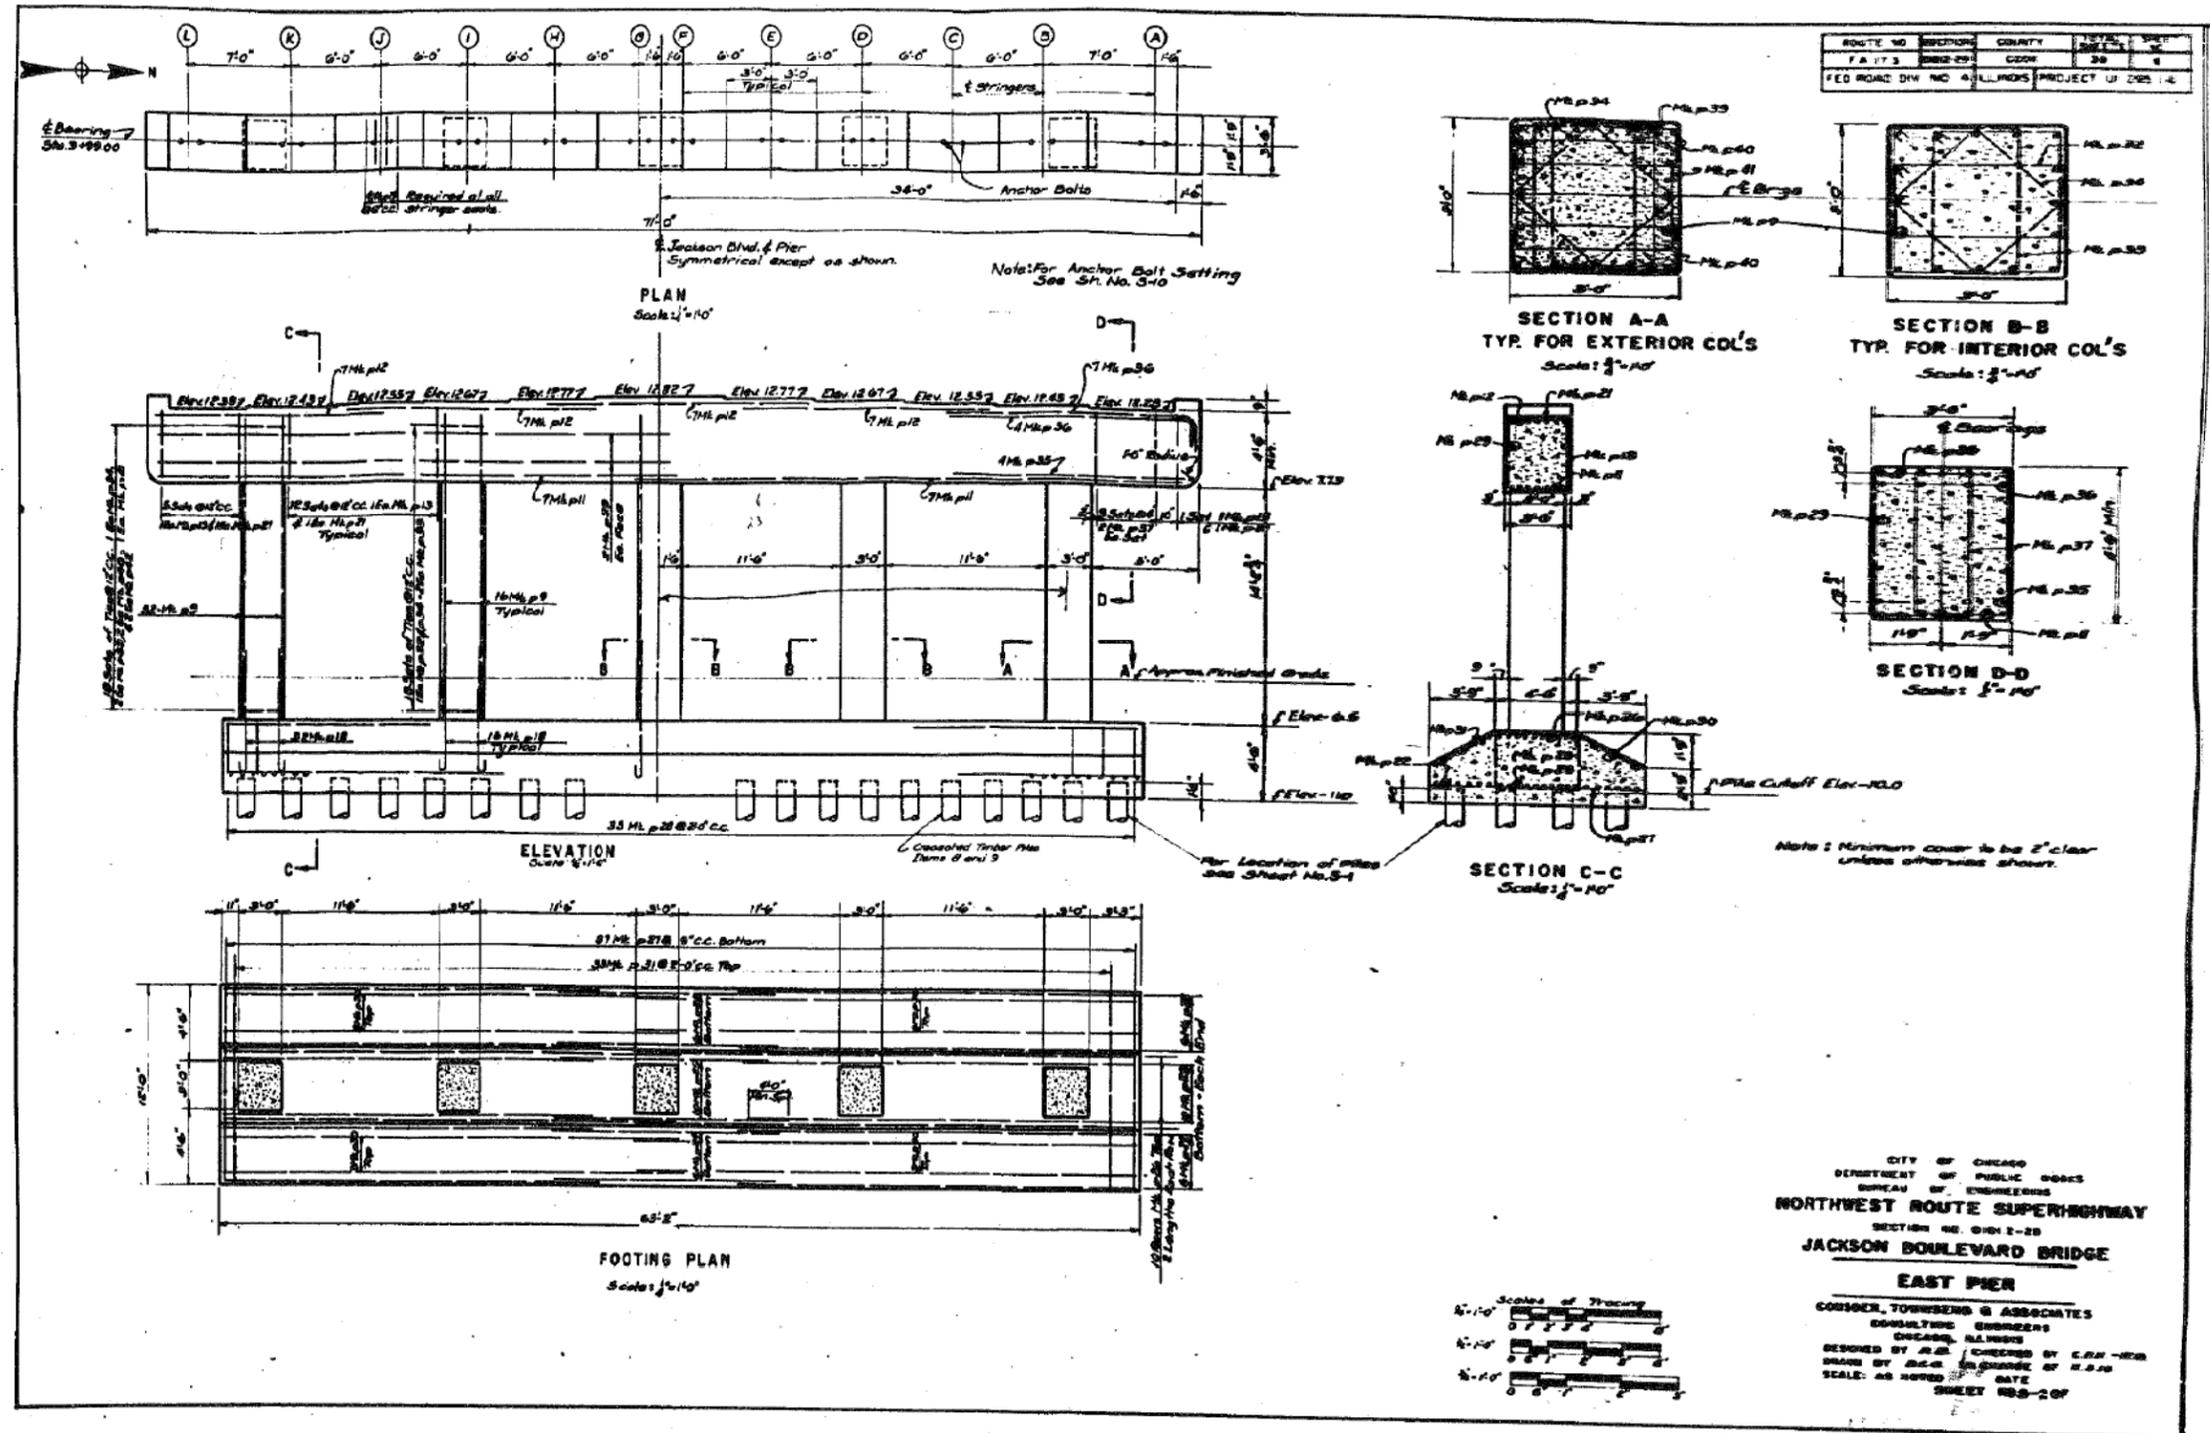

CITY OF CHICAGO
DEPARTMENT OF PUBLIC WORKS
BUREAU OF ENGINEERING
NORTHWEST ROUTE SUPERHIGHWAY
SECTION NO. 0141 E-28
JACKSON BOULEVARD BRIDGE
EAST PIER
CONSON, TOWNSEND & ASSOCIATES
CONSULTING ENGINEERS
DESIGNED BY R.E. CONNOR BY C.R.H.-H.M.
DRAWN BY B.C. HARRIS BY H.S.H.
SCALE AS NOTED DATE
SHEET NO. 207



6:56:52 PM
D:\162331-SHT-AS-BUILT-52



USER NAME = wjcollett1	DESIGNED	EH	REVISED
	CHECKED	WJC	REVISED
PLOT SCALE = 0:2.0000 " / in.	DRAWN	EH	REVISED
PLOT DATE = 8/13/2019	CHECKED	WJC	REVISED

STATE OF ILLINOIS
DEPARTMENT OF TRANSPORTATION


EXISTING JACKSON BLVD BRIDGE PLANS (SN 016-0588)

SHEET NO. AB-52 OF AB-65 SHEETS

F.A.I. RTE.	SECTION	COUNTY	TOTAL SHEETS	SHEET NO.
90/94/290	2014-017B	COOK	400	279

CONTRACT NO. 62J31
ILLINOIS FED. AID PROJECT

FOR INFORMATION ONLY

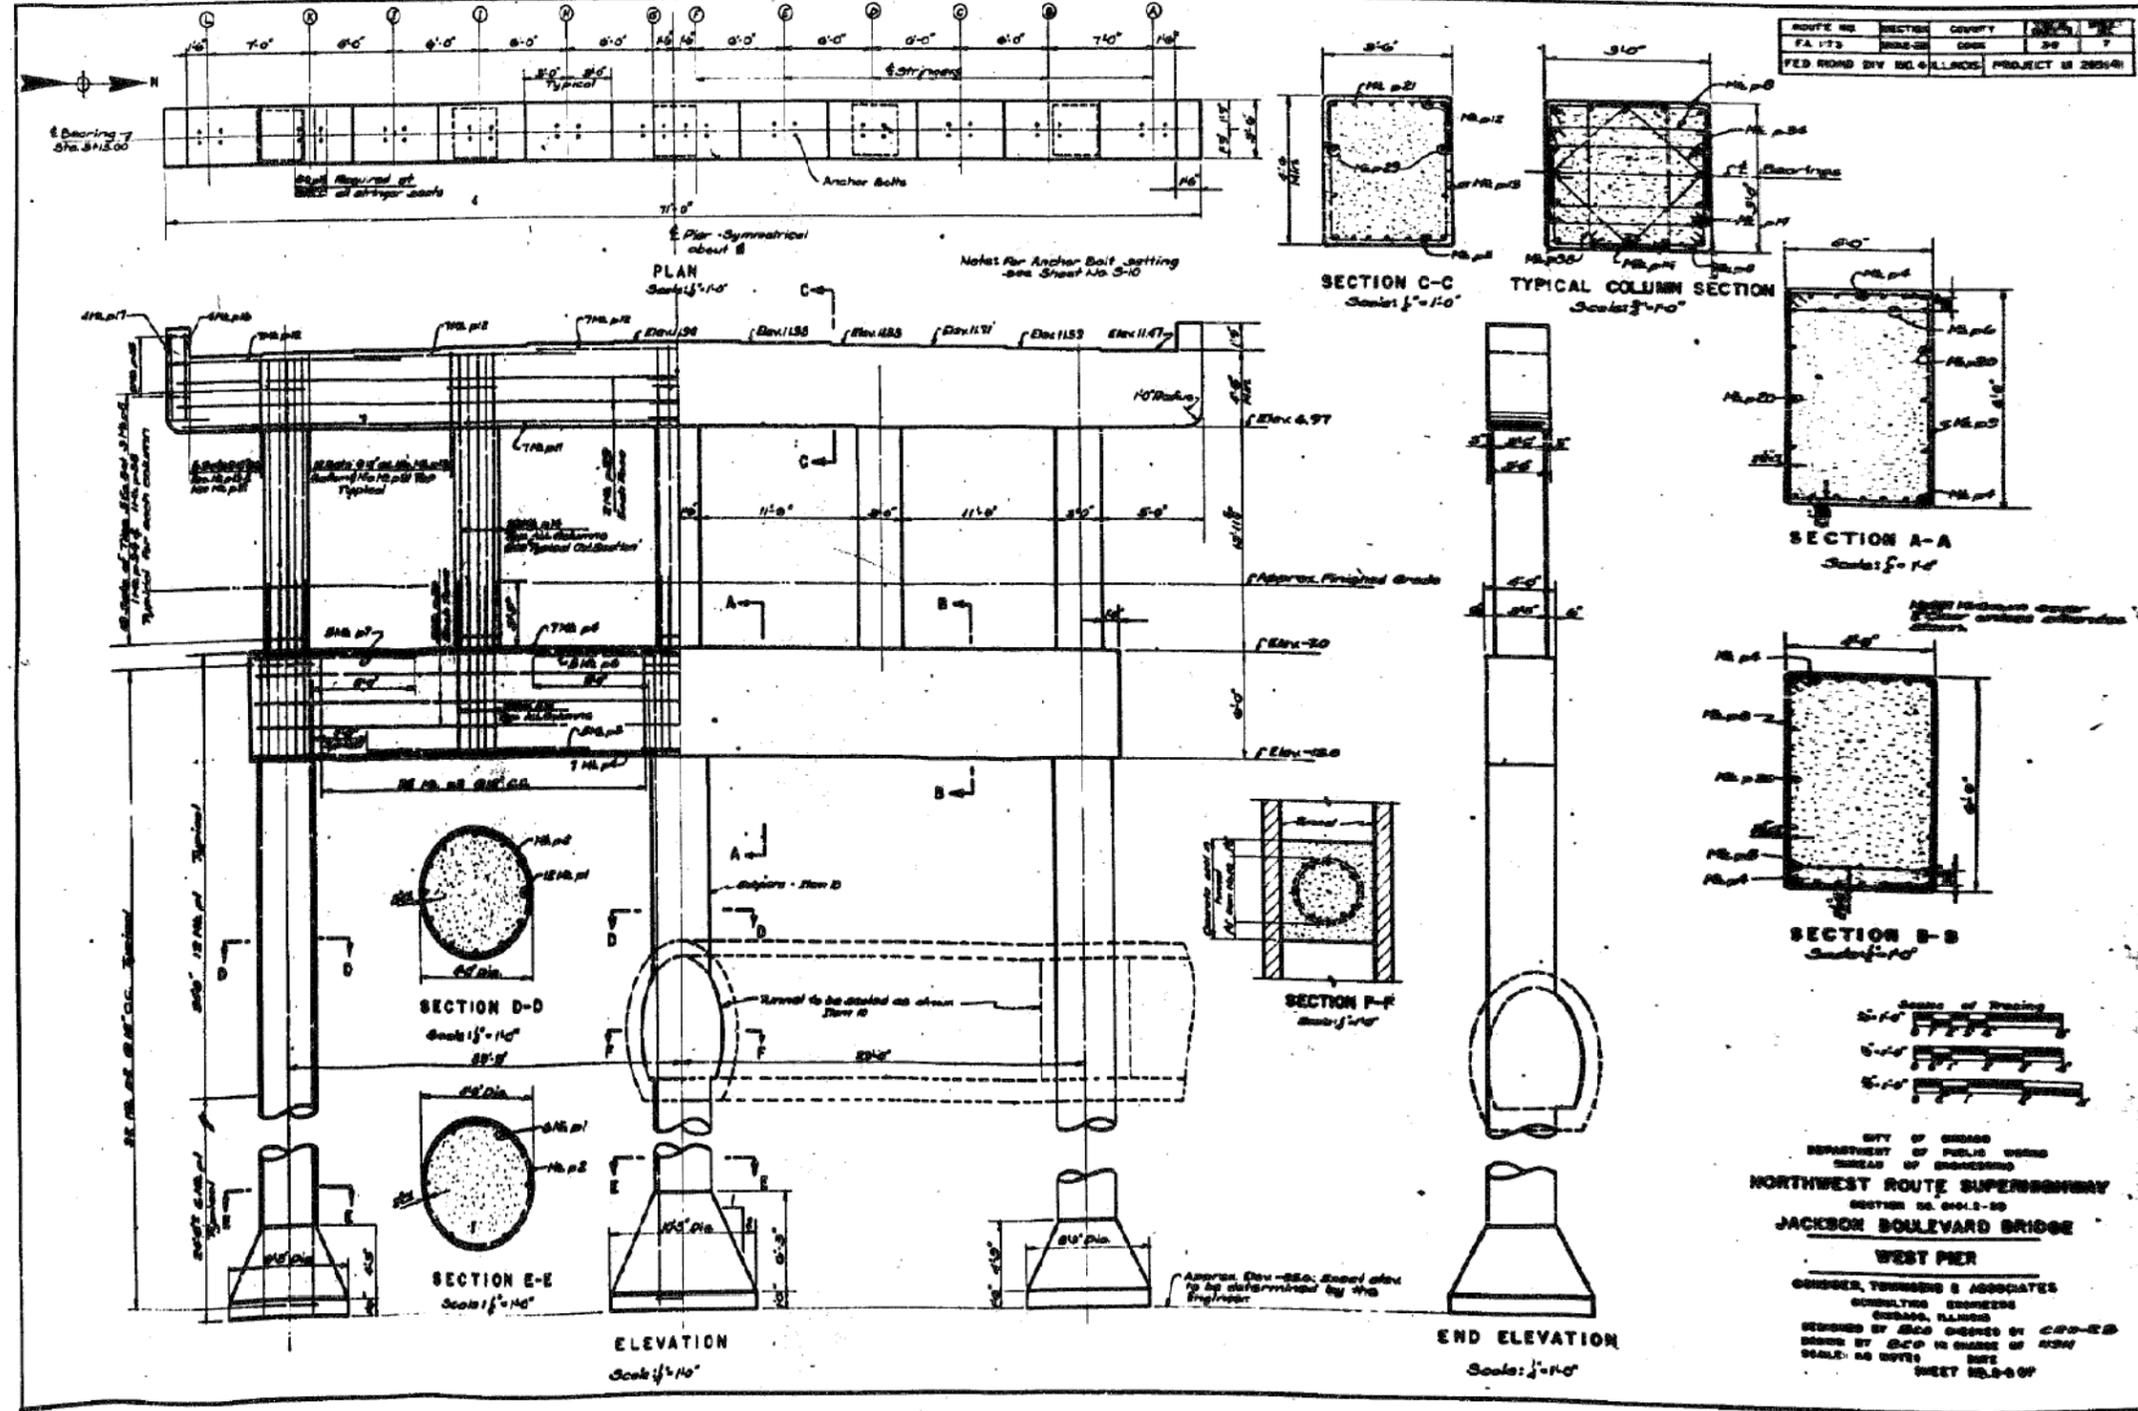

CITY OF CHICAGO
 DEPARTMENT OF PUBLIC WORKS
 BUREAU OF ENGINEERING
NORTHWEST ROUTE SUPERBWAY
 SECTION NO. 0112-28
JACKSON BOULEVARD BRIDGE
WEST PIER
 CONSULTING ENGINEERS
 GEORGE ALMON
 DESIGNED BY G.A.O. CHECKED BY C.D.D.-E.B.
 DRAWN BY G.C.P. IN CHARGE OF NEW
 SCALE: AS NOTED DATE
 SHEET NO. 53-09

6:57:15 PM
 D162331-SHT-AS-BUILT-53



USER NAME = wjcollett1	DESIGNED	EH	REVISED
	CHECKED	WJC	REVISED
PLOT SCALE = 0x2.0000 "/>			
PLOT DATE = 8/13/2019	CHECKED	WJC	REVISED


STATE OF ILLINOIS
 DEPARTMENT OF TRANSPORTATION

EXISTING JACKSON BLVD BRIDGE PLANS (SN 016-0588)

SHEET NO. AB-53 OF AB-65 SHEETS

F.A.I. R.E.	SECTION	COUNTY	TOTAL SHEETS	SHEET NO.
90/94/290	2014-017B	COOK	400	280
				CONTRACT NO. 62J31
ILLINOIS FED. AID PROJECT				

FOR INFORMATION ONLY

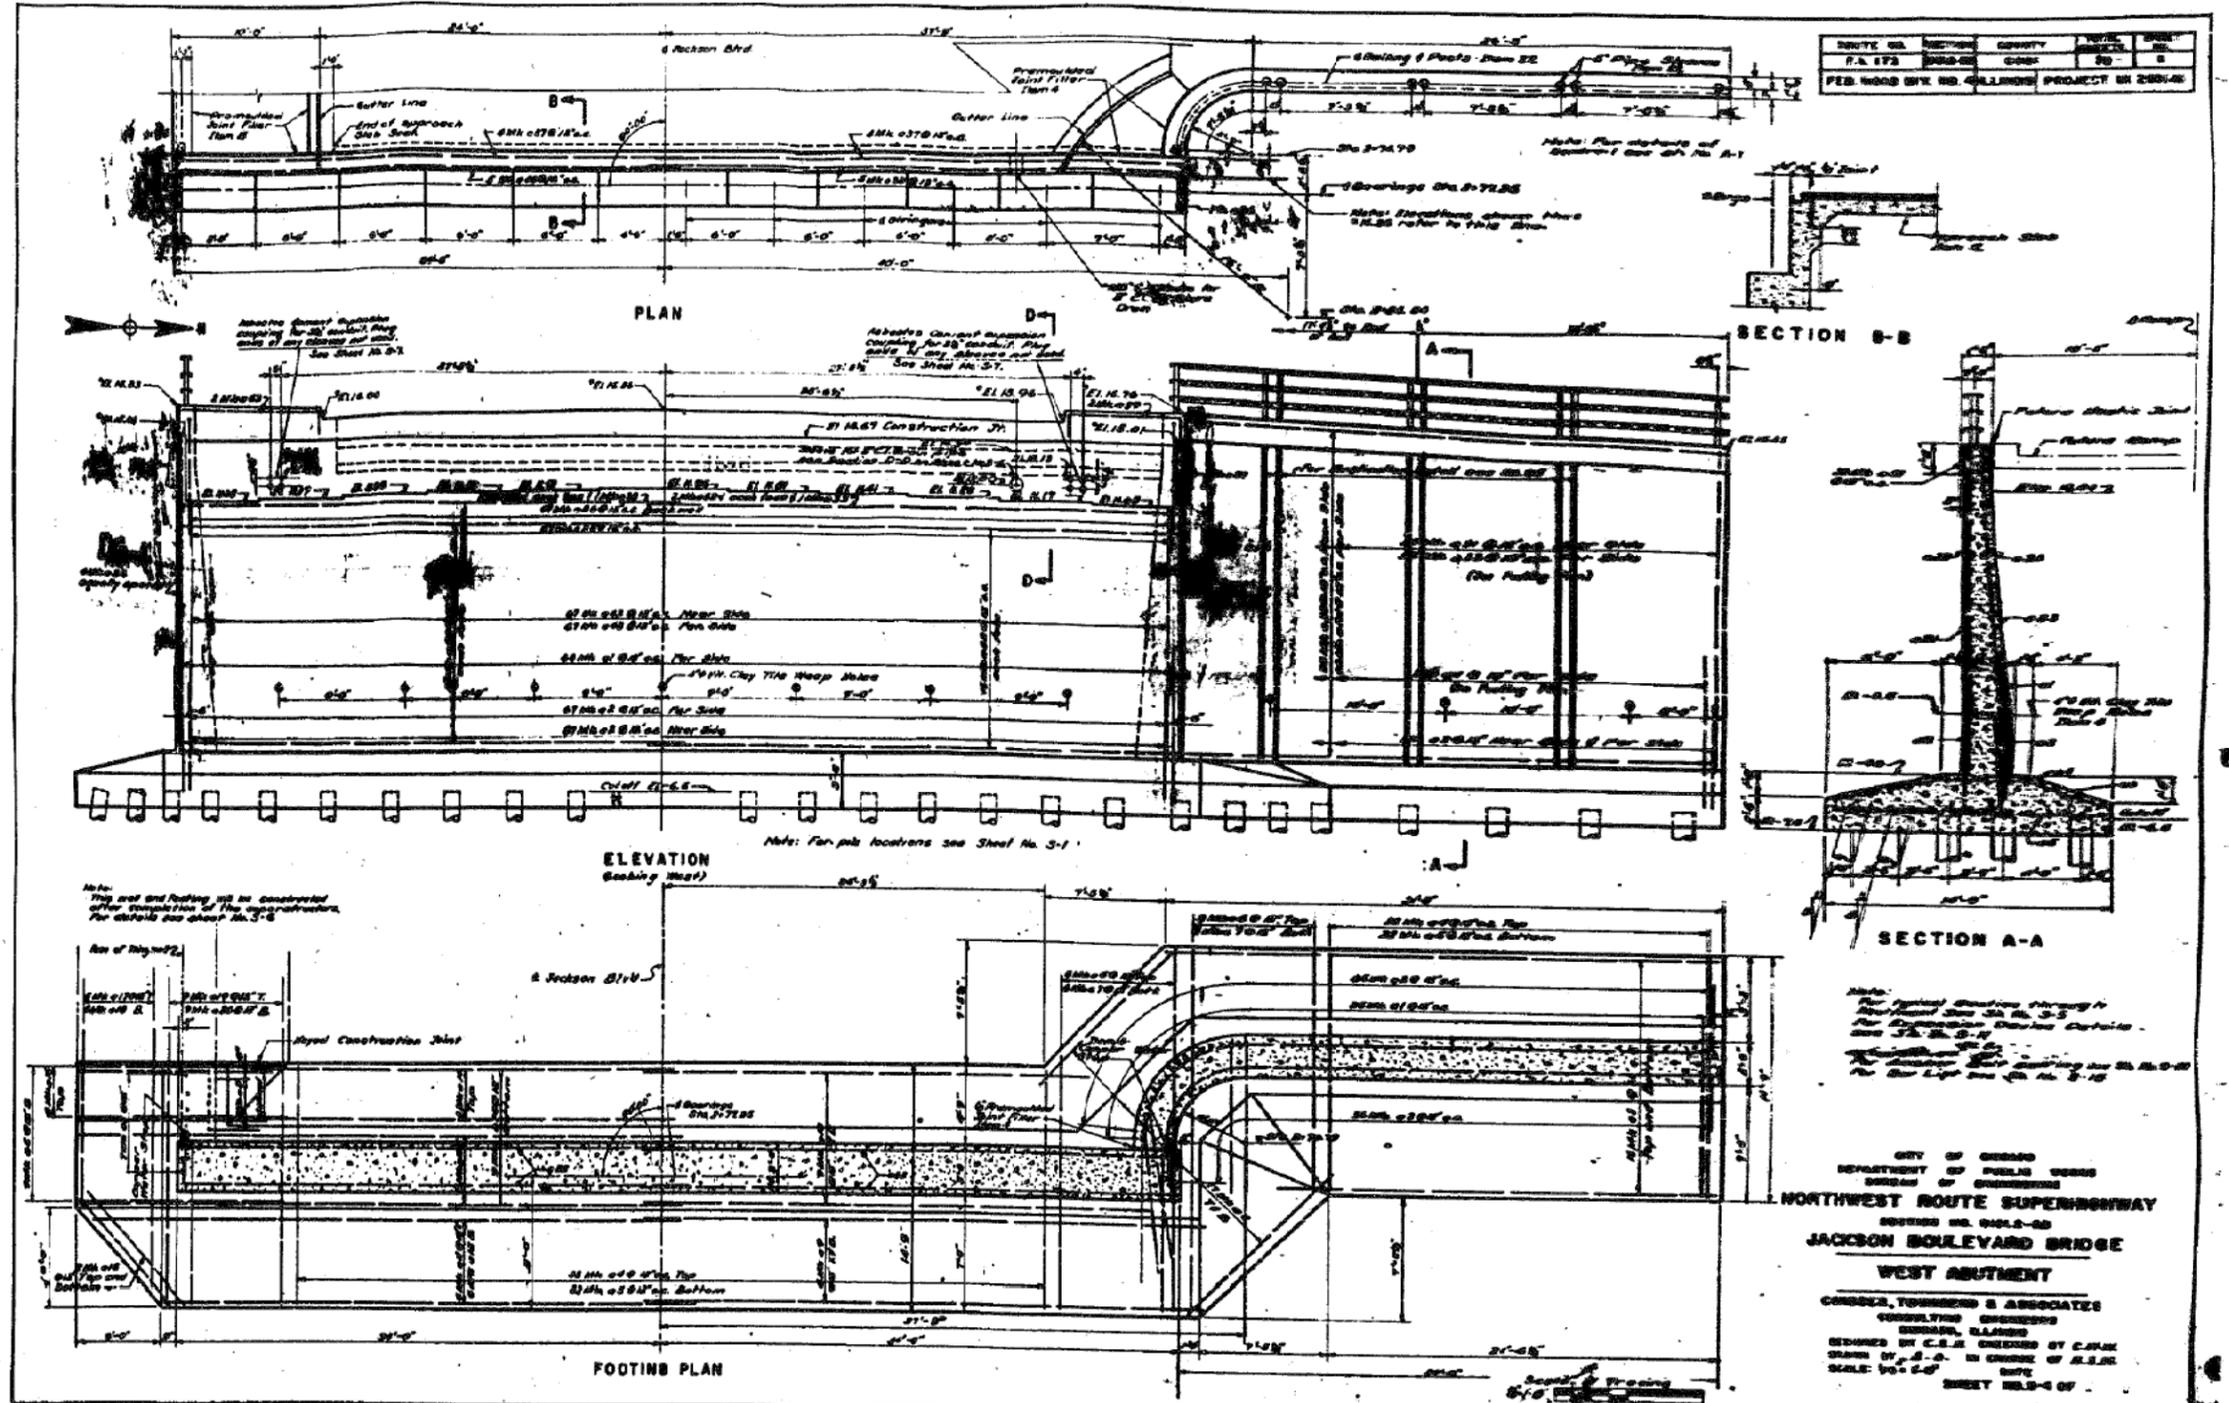

6:57:38 PM
D:\6231-SHT-AS-BUILT-54



USER NAME = wjcolletti	DESIGNED EH	REVISED
	CHECKED WJC	REVISED
PLOT SCALE = 0.2,0000 '1" / in.	DRAWN EH	REVISED
PLOT DATE = 8/13/2019	CHECKED WJC	REVISED


STATE OF ILLINOIS
DEPARTMENT OF TRANSPORTATION

EXISTING JACKSON BLVD BRIDGE PLANS (SN 016-0588)

SHEET NO. AB-54 OF AB-65 SHEETS

F.A.I. RTE. 90/94/290	SECTION 2014-017B	COUNTY COOK	TOTAL SHEETS 400	SHEET NO. 281
				CONTRACT NO. 62J31
ILLINOIS FED. AID PROJECT				

FOR INFORMATION ONLY

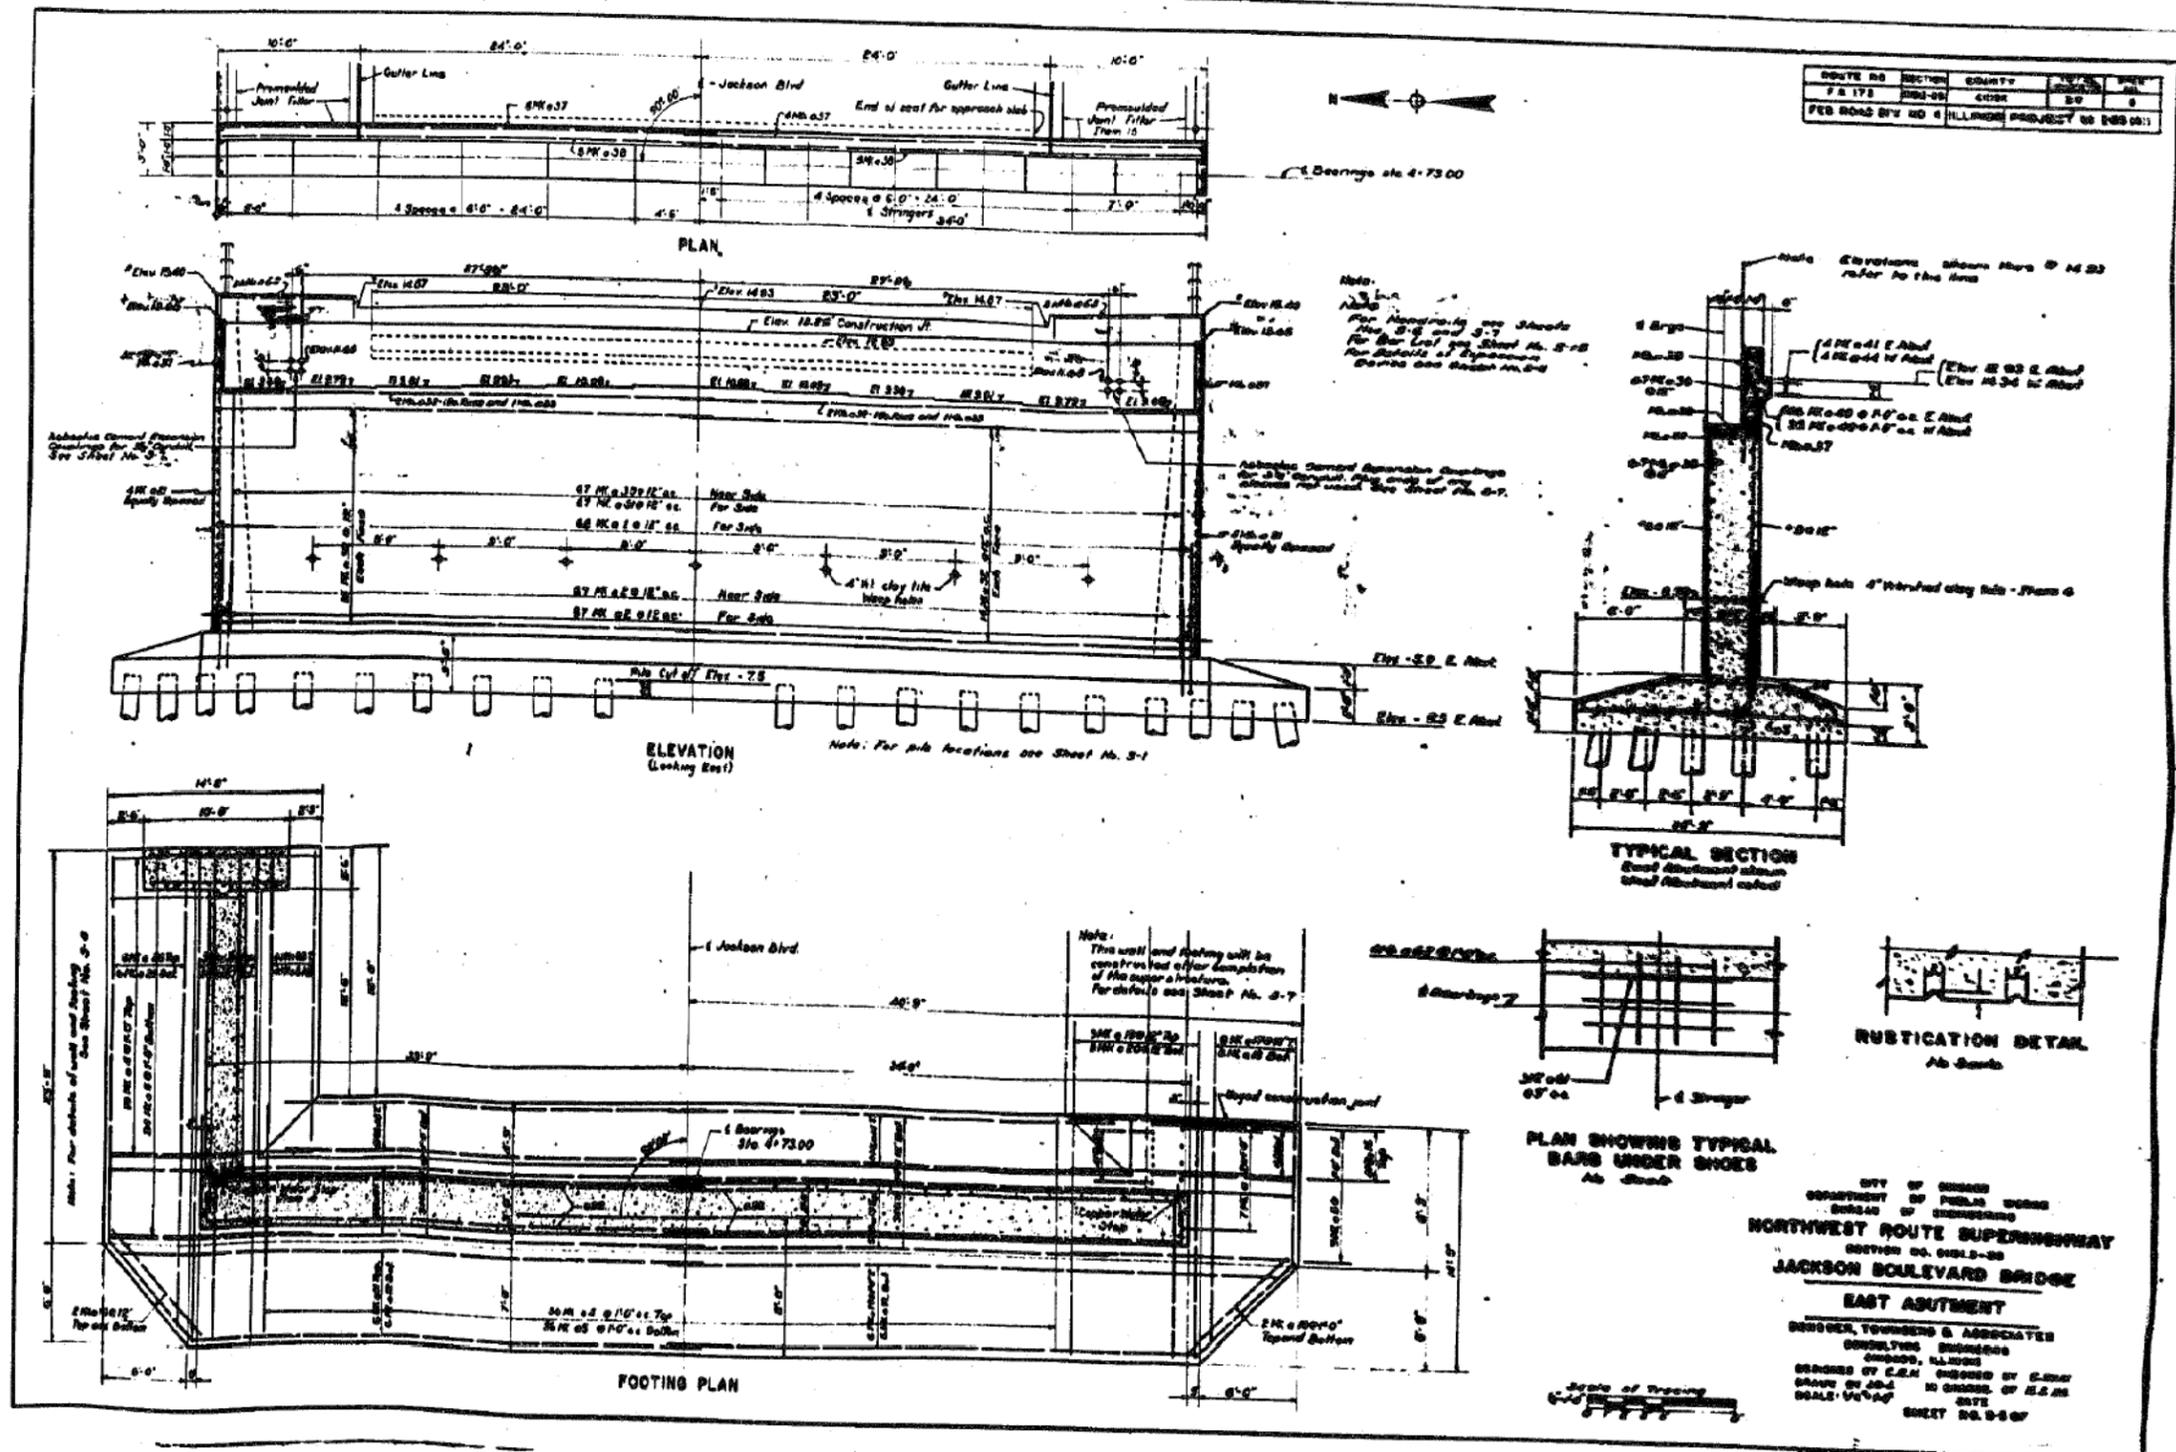

6:58:01 PM
D:\6231-SHT-AS-BUILT-55



USER NAME = wjcolletti	DESIGNED EH	REVISED
DESIGNED WJC	CHECKED WJC	REVISED
DRAWN EH	CHECKED WJC	REVISED
REVISIONS		
1	WJC	8/13/2019


STATE OF ILLINOIS
DEPARTMENT OF TRANSPORTATION

EXISTING JACKSON BLVD BRIDGE PLANS (SN 016-0588)

SHEET NO. AB-55 OF AB-65 SHEETS

F.A.I. R.T.E.	SECTION	COUNTY	TOTAL SHEETS	SHEET NO.
90/94/290	2014-017B	COOK	400	282
CONTRACT NO. 62J1				

ILLINOIS FED. AID PROJECT

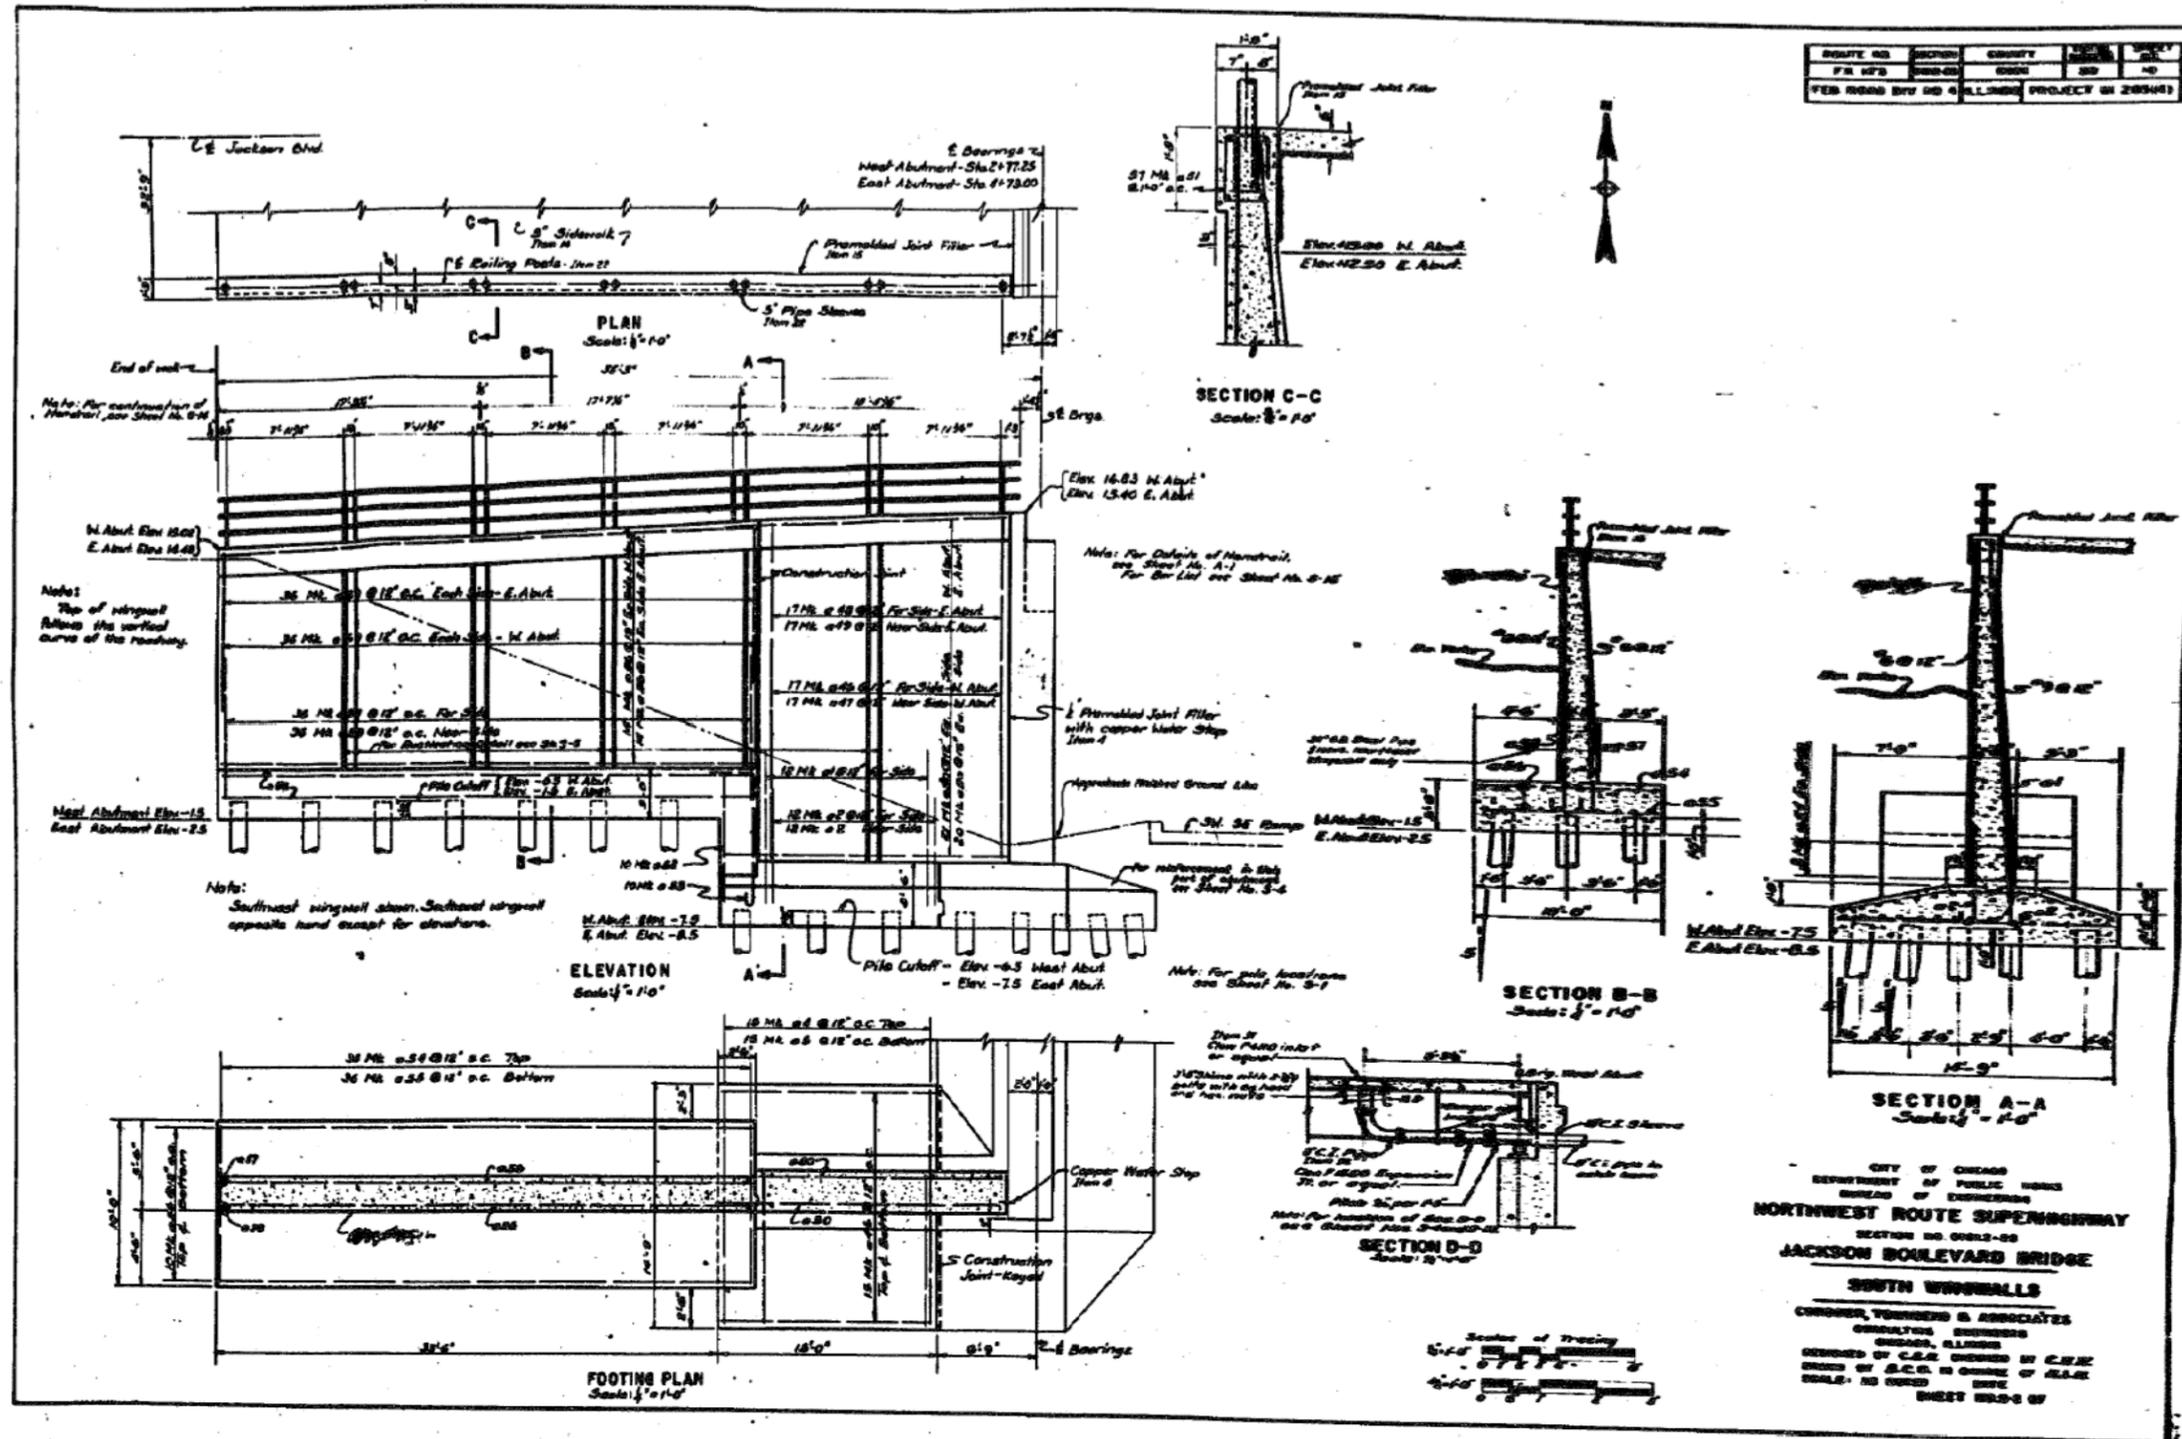

ROUTE NO.	SECTION	COUNTY	SHEET NO.	TOTAL SHEETS
FM 1275	000-00	COOK	56	60
FEB 1998 DIV 08 6 ILLINOIS PROJECT 01 200401				

CITY OF CHICAGO
 DEPARTMENT OF PUBLIC WORKS
 BUREAU OF ENGINEERING
NORTHWEST ROUTE SUPERHIGHWAY
 SECTION NO. 0012-00
JACKSON BOULEVARD BRIDGE
SOUTH WINDBALLS
 CHONGER, YOUNGERS & ASSOCIATES
 CONSULTING ENGINEERS
 CHICAGO, ILLINOIS
 DESIGNED BY C.E.R. CHECKED BY C.E.R.
 DRAWN BY S.C.S. IN CHARGE OF ASSE.
 SCALE: AS SHOWN DATE
 SHEET 0012-00 OF

6:58:24 PM
 016231-SHT-AS-BUILT-56




USER NAME = wjcolletti	DESIGNED EH	REVISED
	CHECKED WJC	REVISED
PLOT SCALE = 0x2.0000 '1" / in.	DRAWN EH	REVISED
PLOT DATE = 8/13/2019	CHECKED WJC	REVISED

STATE OF ILLINOIS
 DEPARTMENT OF TRANSPORTATION

EXISTING JACKSON BLVD BRIDGE PLANS (SN 016-0588)

SHEET NO. AB-56 OF AB-65 SHEETS

F.A.I. RTE.	SECTION	COUNTY	TOTAL SHEETS	SHEET NO.
90/94/290	2014-017B	COOK	400	283
CONTRACT NO. 62J31				
ILLINOIS FED. AID PROJECT				

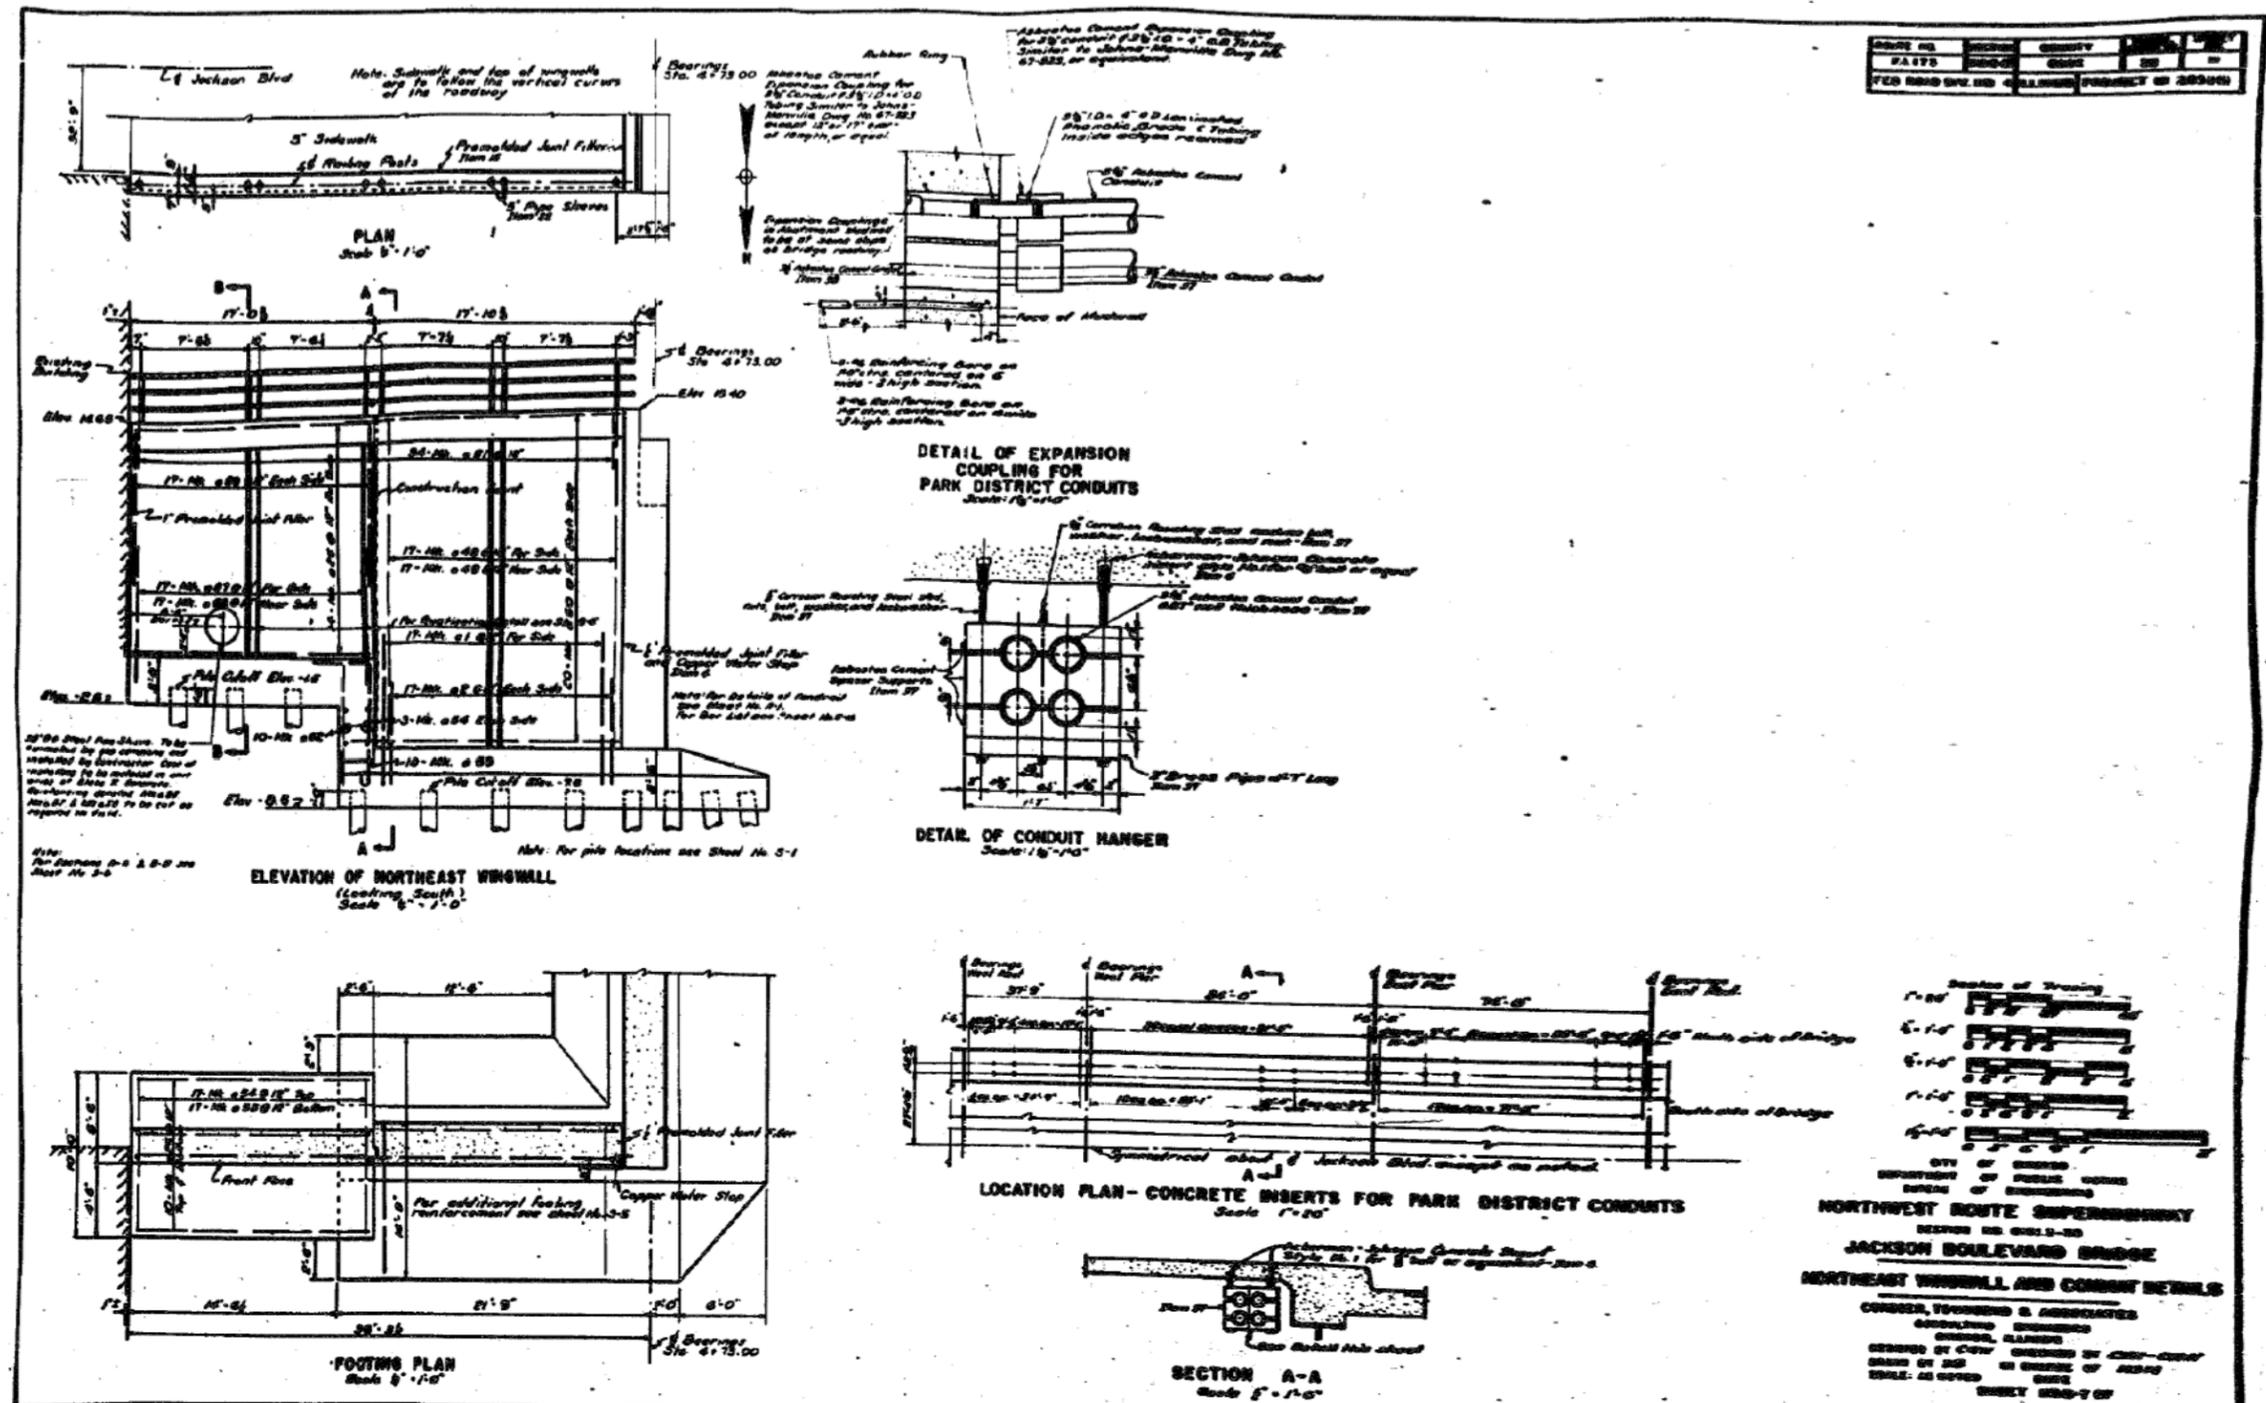

6:58:47 PM
D:\6231-SHT-AS-BUILD-57




USER NAME = wjcolletti	DESIGNED EH	REVISED
	CHECKED WJC	REVISED
PLOT SCALE = 0.2,0000 '1' / in.	DRAWN EH	REVISED
PLOT DATE = 8/13/2019	CHECKED WJC	REVISED

STATE OF ILLINOIS
DEPARTMENT OF TRANSPORTATION


EXISTING JACKSON BLVD BRIDGE PLANS (SN 016-0588)

SHEET NO. AB-57 OF AB-65 SHEETS

F.A.I. R.T.E.	SECTION	COUNTY	TOTAL SHEETS	SHEET NO.
90/94/290	2014-017B	COOK	400	284
			CONTRACT NO. 62J31	
ILLINOIS FED. AID PROJECT				

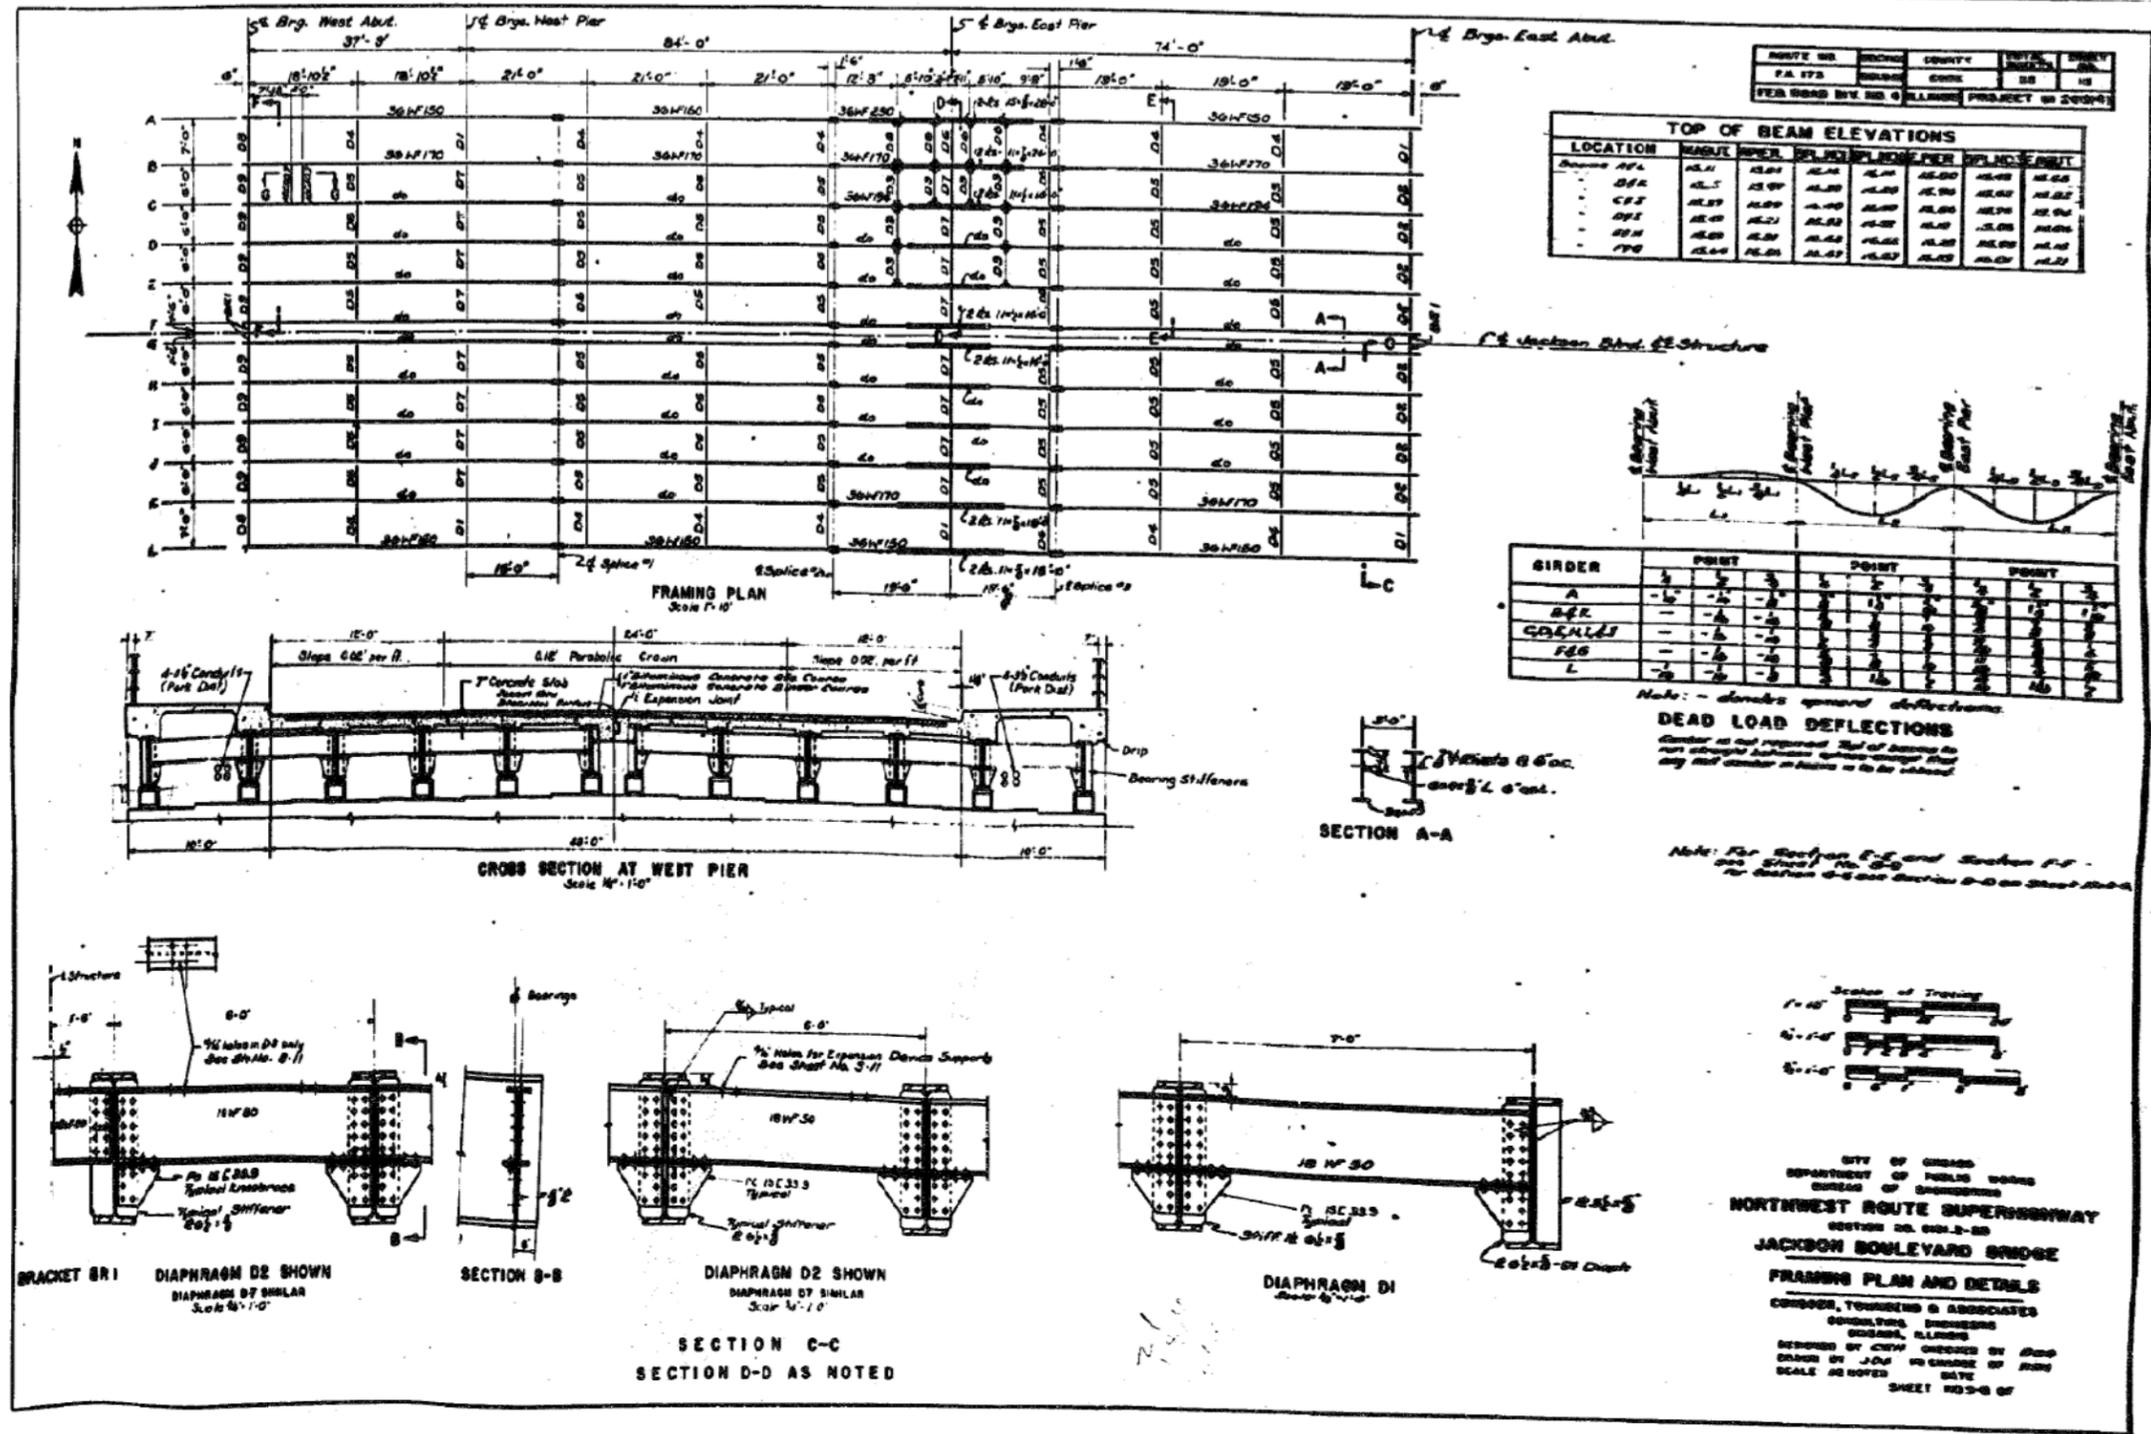

FOR INFORMATION ONLY

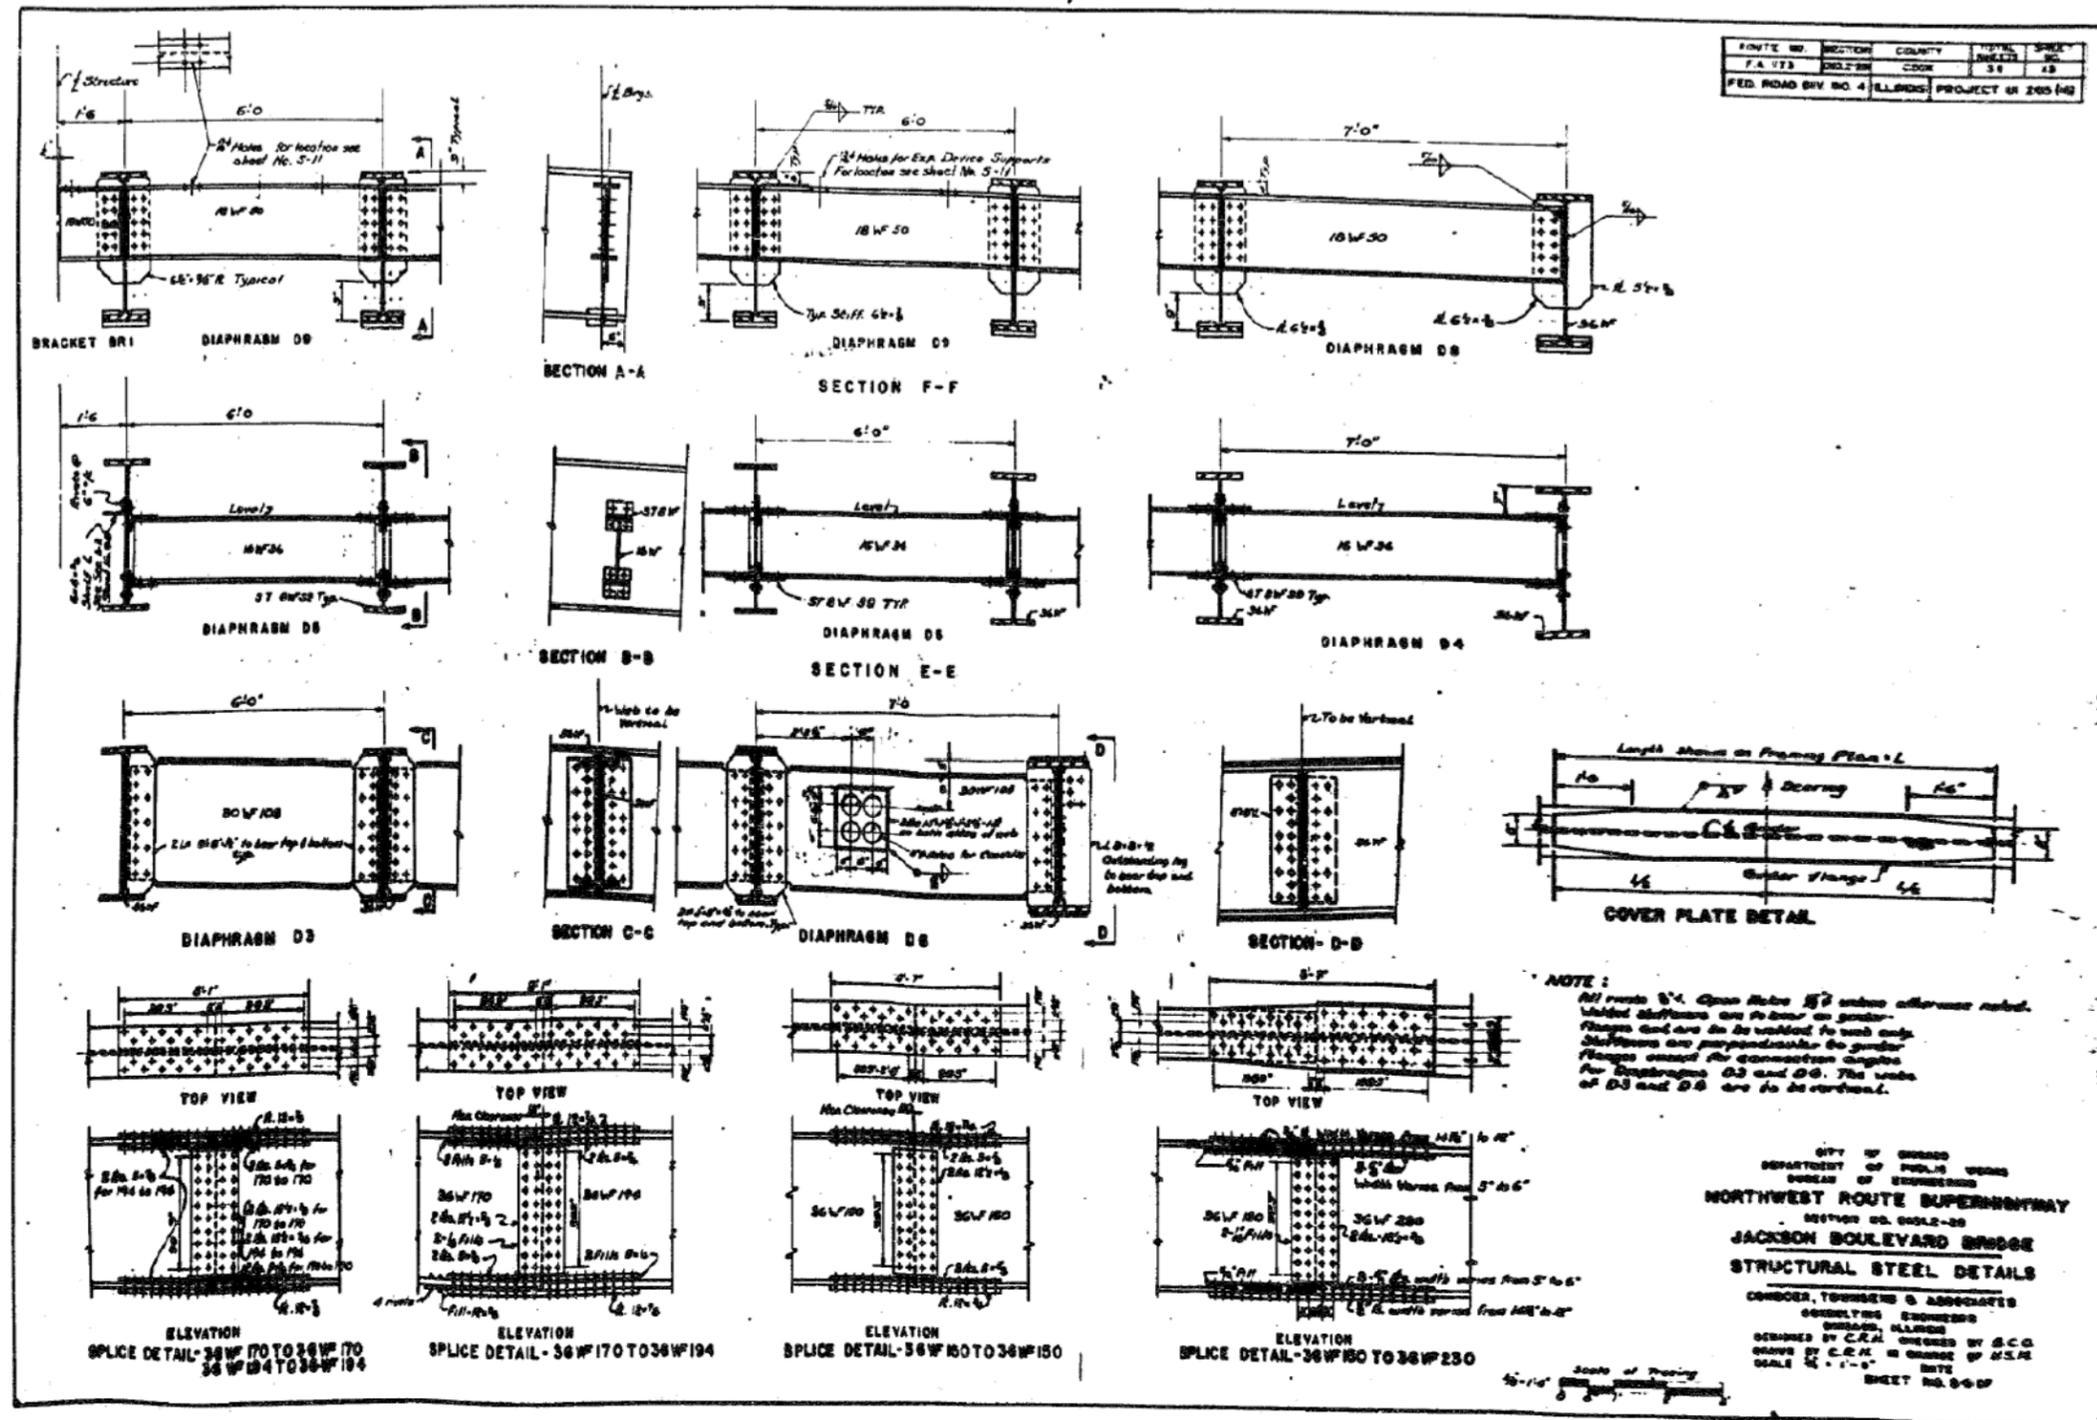

USER NAME = wjcolletti	DESIGNED EH	REVISED
DESIGNED EH	CHECKED WJC	REVISED
PLOT SCALE = 0.2:0.000 '1\"/>		

STATE OF ILLINOIS
DEPARTMENT OF TRANSPORTATION


EXISTING JACKSON BLVD BRIDGE PLANS (SN 016-0588)

SHEET NO. AB-59 OF AB-65 SHEETS

F.A.I. RTE. 90/94/290	SECTION 2014-017B	COUNTY COOK	TOTAL SHEETS 400	SHEET NO. 286
			CONTRACT NO. 62J31	
ILLINOIS FED. AID PROJECT				

6:59:33 PM
D162331-SHT-AS-BUILT-59

FOR INFORMATION ONLY

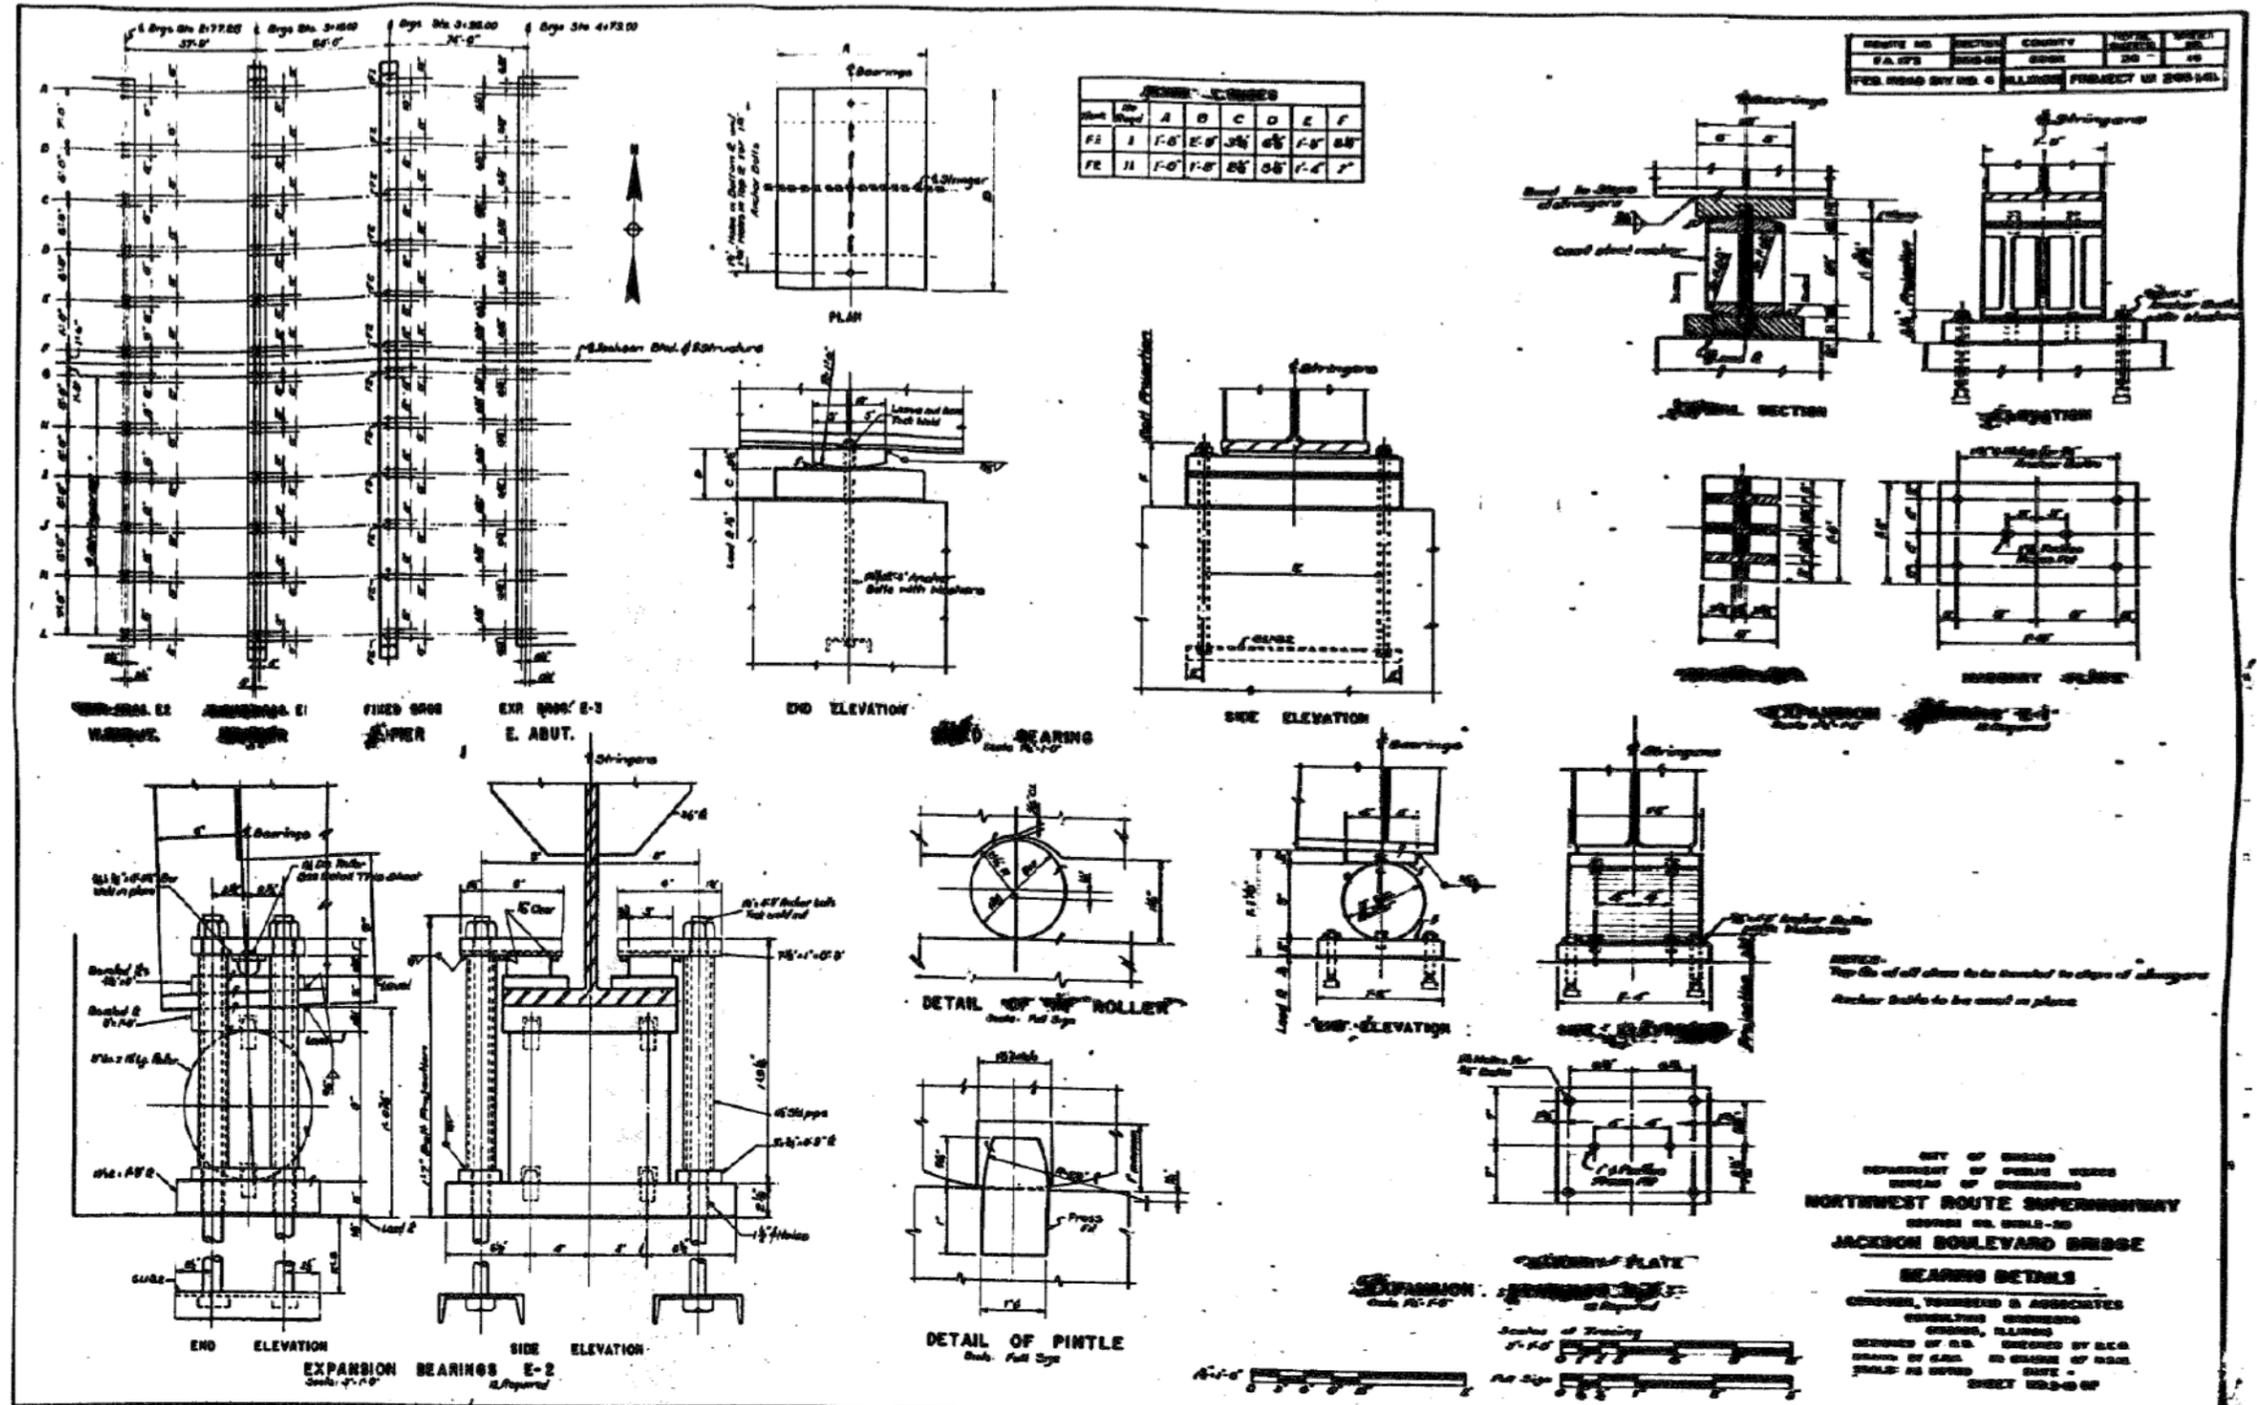

6:59:56 PM
D162331-SHT-AS-BUILT-60




USER NAME = wjcollett1	DESIGNED	EH	REVISED
	CHECKED	WJC	REVISED
PLOT SCALE = 0x2.0000 '1" / in.	DRAWN	EH	REVISED
PLOT DATE = 8/13/2019	CHECKED	WJC	REVISED

STATE OF ILLINOIS
DEPARTMENT OF TRANSPORTATION

EXISTING JACKSON BLVD BRIDGE PLANS (SN 016-0588)

SHEET NO. AB-60 OF AB-65 SHEETS

F.A.I. R.T.E.	SECTION	COUNTY	TOTAL SHEETS	SHEET NO.
90/94/290	2014-017B	COOK	400	287
				CONTRACT NO. 62J31
ILLINOIS FED. AID PROJECT				

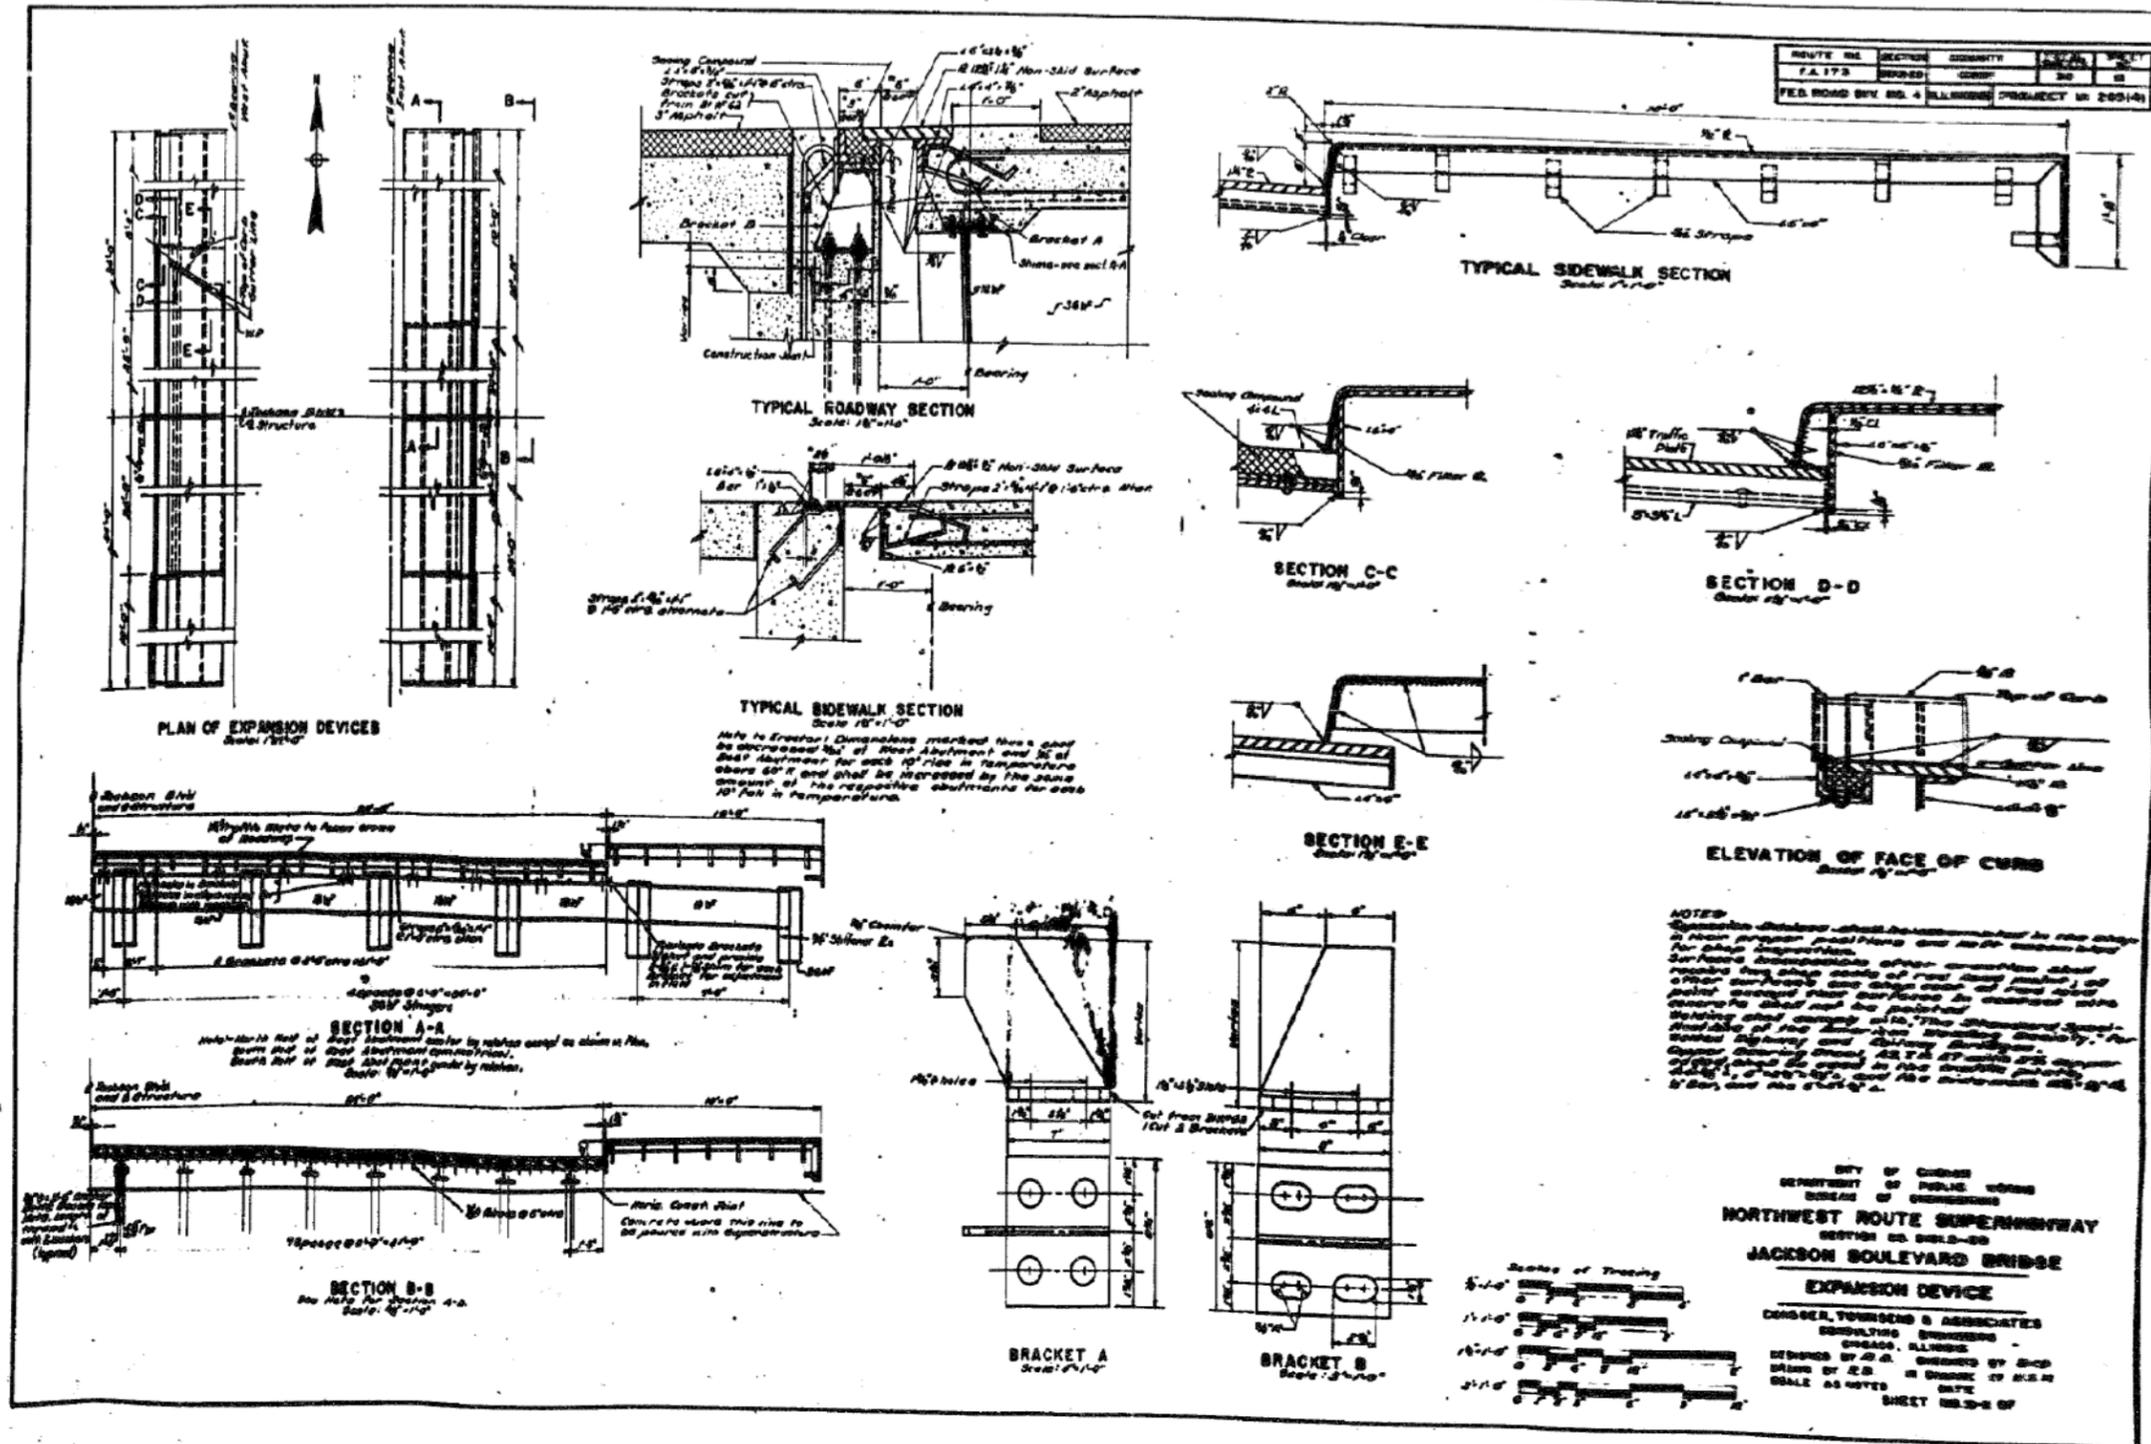

7:00:19 PM
D:\6231-SHT-AS-BUILT-61



USER NAME = wjcolletti	DESIGNED EH	REVISED
	CHECKED WJC	REVISED
PLOT SCALE = 0.2,0000 " / in.	DRAWN EH	REVISED
PLOT DATE = 8/13/2019	CHECKED WJC	REVISED


STATE OF ILLINOIS
DEPARTMENT OF TRANSPORTATION

EXISTING JACKSON BLVD BRIDGE PLANS (SN 016-0588)

SHEET NO. AB-61 OF AB-65 SHEETS

F.A.I. R.T.E. 90/94/290	SECTION 2014-017B	COUNTY COOK	TOTAL SHEETS 400	SHEET NO. 288
CONTRACT NO. 62J31				ILLINOIS FED. AID PROJECT

FOR INFORMATION ONLY

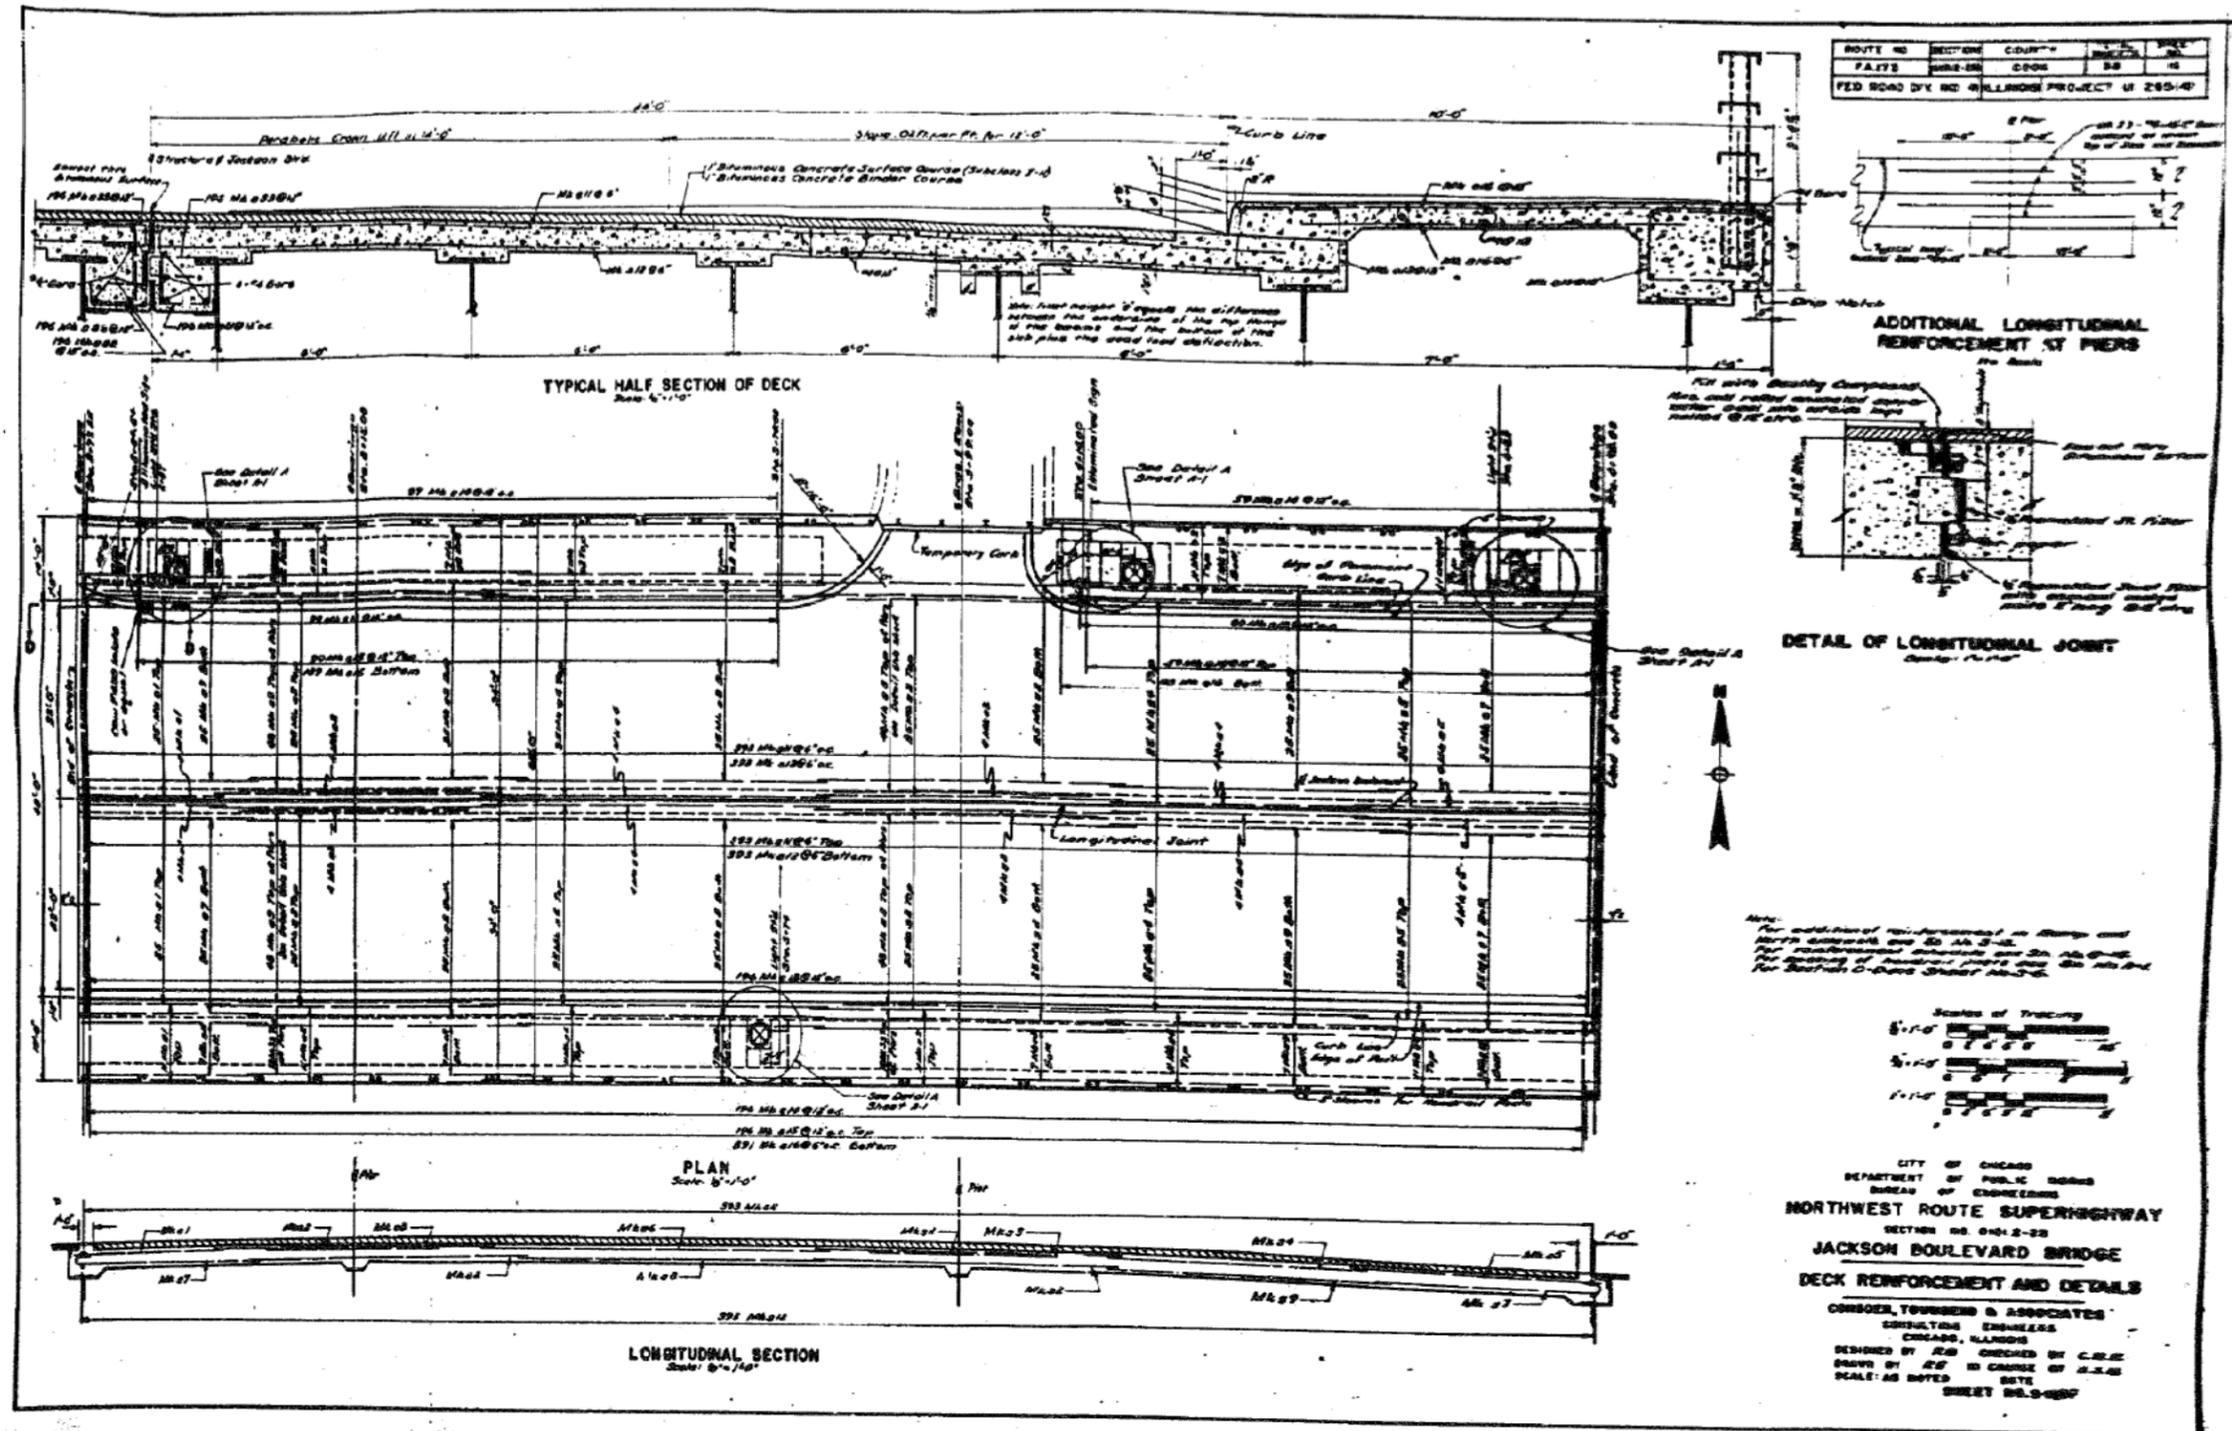

7:00:42 PM
D:\62351-SHT-AS-BUILD-62



USER NAME = wjcolletti	DESIGNED EH	REVISED
PLOT SCALE = 0x2.0000 'x' / in.	CHECKED WJC	REVISED
PLOT DATE = 8/13/2019	DRAWN EH	REVISED
	CHECKED WJC	REVISED


STATE OF ILLINOIS
DEPARTMENT OF TRANSPORTATION

EXISTING JACKSON BLVD BRIDGE PLANS (SN 016-0588)

SHEET NO. AB-62 OF AB-65 SHEETS

F.A.I. R.T.E.	SECTION	COUNTY	TOTAL SHEETS	SHEET NO.
90/94/290	2014-017B	COOK	400	289
CONTRACT NO. 62J31				
ILLINOIS FED. AID PROJECT				

FOR INFORMATION ONLY

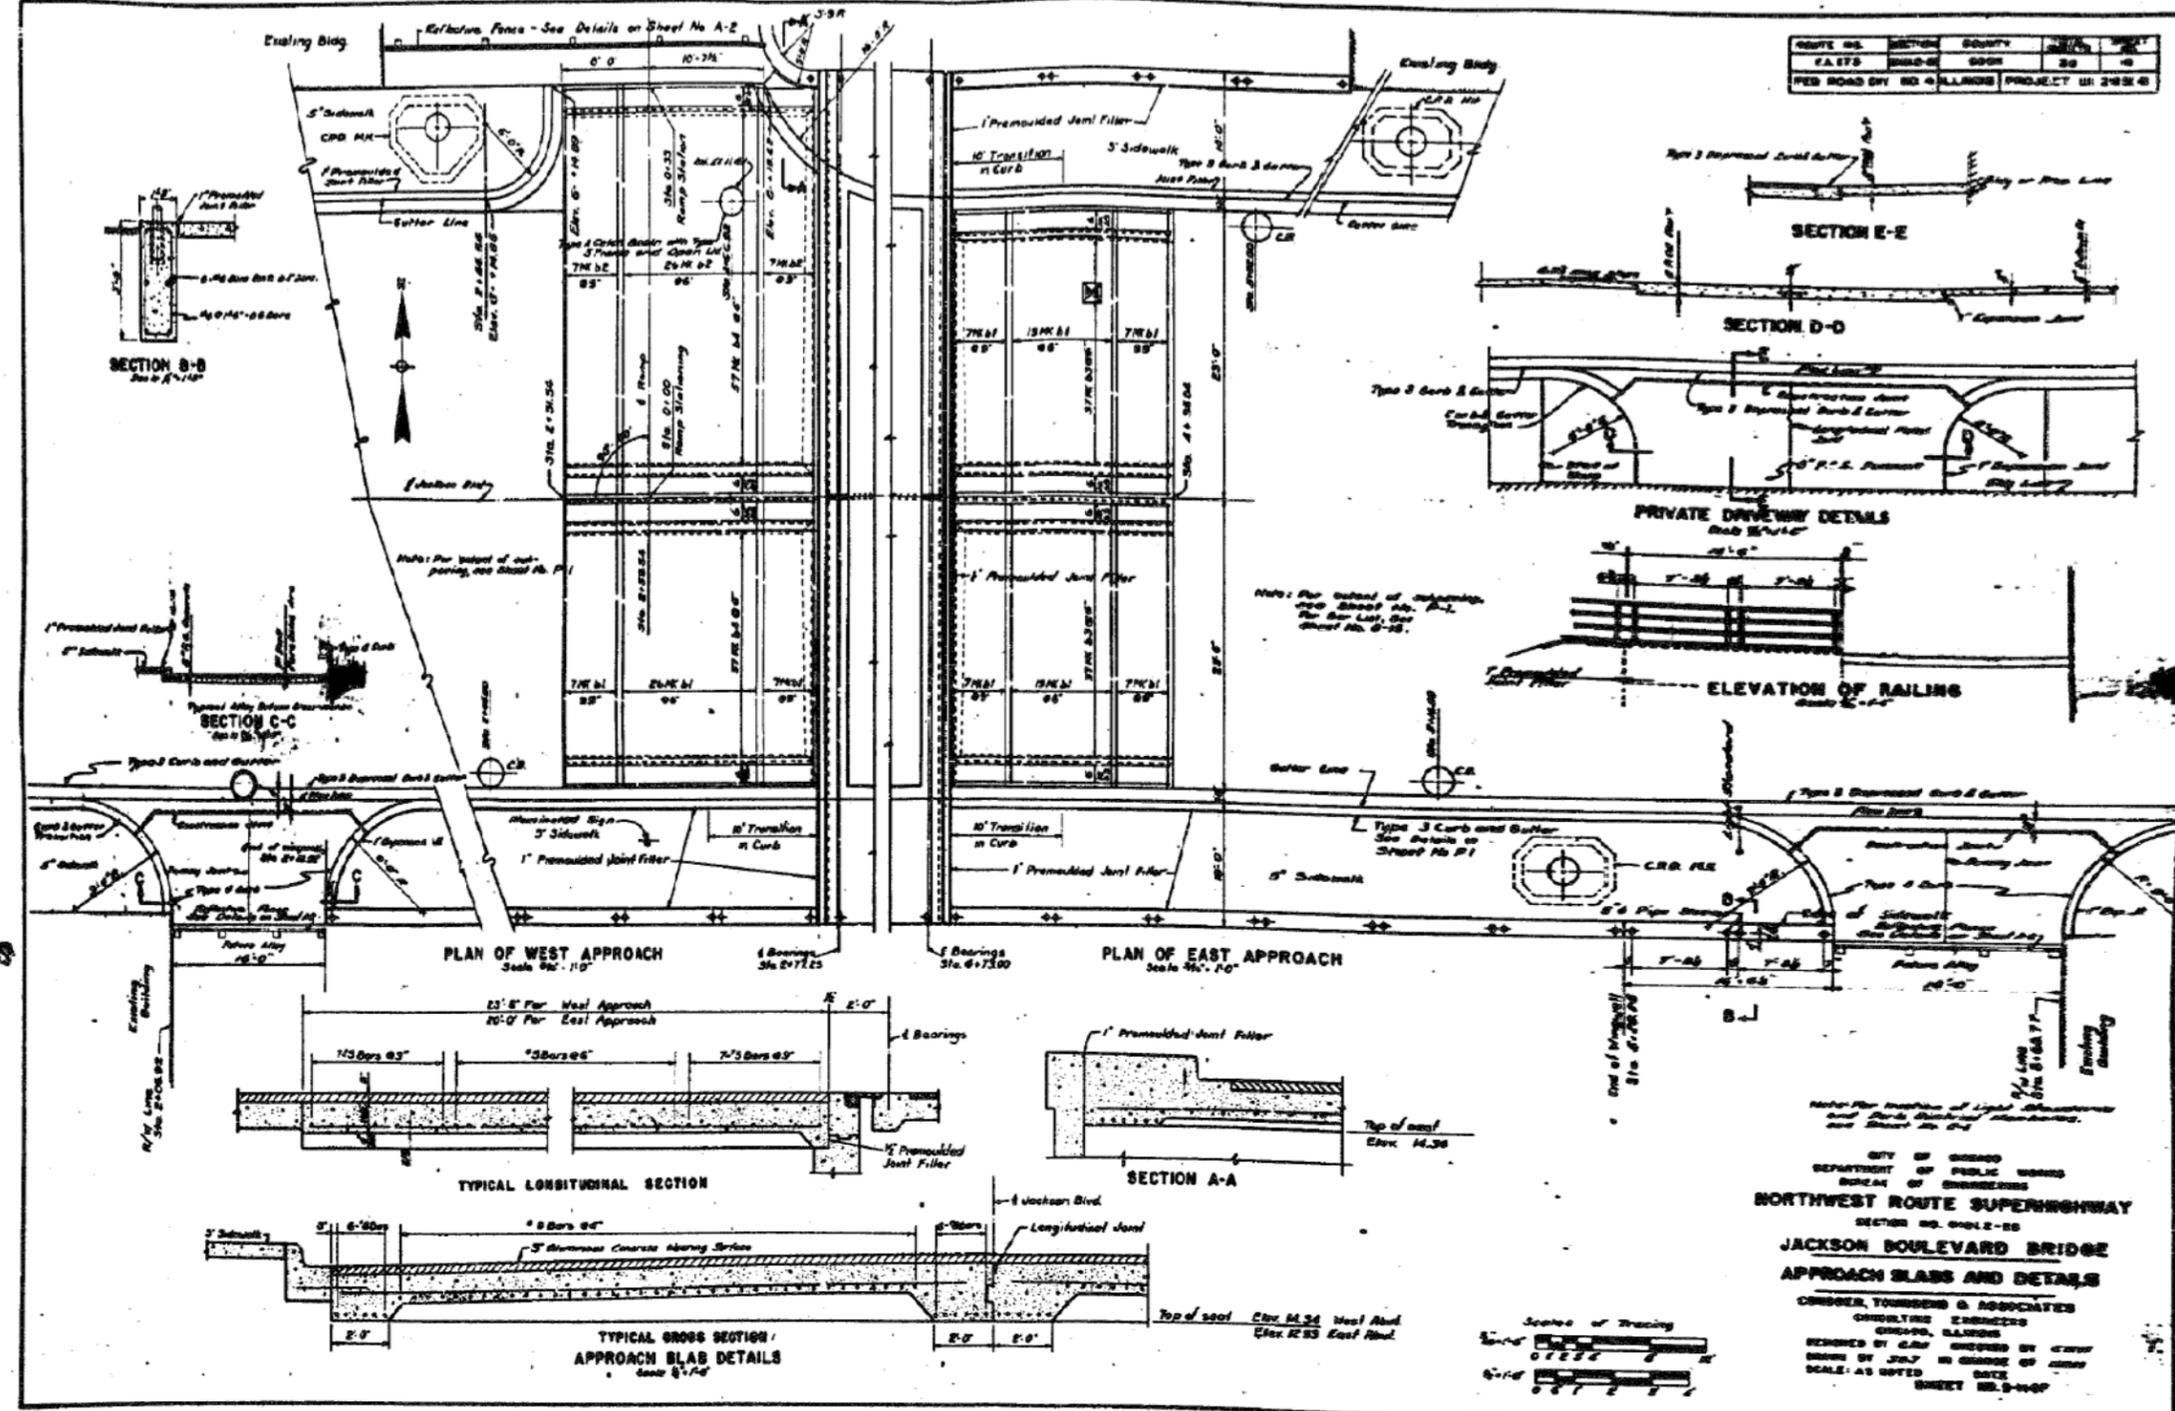

ROUTE NO.	SECTION	COUNTY	TOTAL SHEETS	SHEET NO.
CA. 175	017B-01	COOK	400	291
PUB. ROAD BY RD. 4 ILL. HIGHWAY PROJECT 111 2432 4				

CITY OF CHICAGO
 DEPARTMENT OF PUBLIC WORKS
 BUREAU OF ENGINEERING
NORTHWEST ROUTE SUPERHIGHWAY
 SECTION NO. 017B-01
JACKSON BOULEVARD BRIDGE
APPROACH SLAB AND DETAILS
 CONDER, TOWNSEND & ASSOCIATES
 CIVIL ENGINEERS
 CHICAGO, ILLINOIS
 DESIGNED BY C.T.P. ENGINEER BY C.T.P.
 DRAWN BY J.L.J. IN CHARGE OF SHOP
 SCALE: AS NOTED DATE
 SHEET NO. 291-400

7:01:28 PM
 D162331-SHT-AS-BUILT-64



USER NAME = wjcolletti	DESIGNED	EH	REVISED
	CHECKED	WJC	REVISED
PLOT SCALE = 0.2,0000 "/>			
PLOT DATE = 8/13/2019	CHECKED	WJC	REVISED


STATE OF ILLINOIS
 DEPARTMENT OF TRANSPORTATION

EXISTING JACKSON BLVD BRIDGE PLANS (SN 016-0588)

SHEET NO. AB-64 OF AB-65 SHEETS

F.A.I. RTE.	SECTION	COUNTY	TOTAL SHEETS	SHEET NO.
90/94/290	2014-017B	COOK	400	291
CONTRACT NO. 62J31				
ILLINOIS FED. AID PROJECT				

FOR INFORMATION ONLY

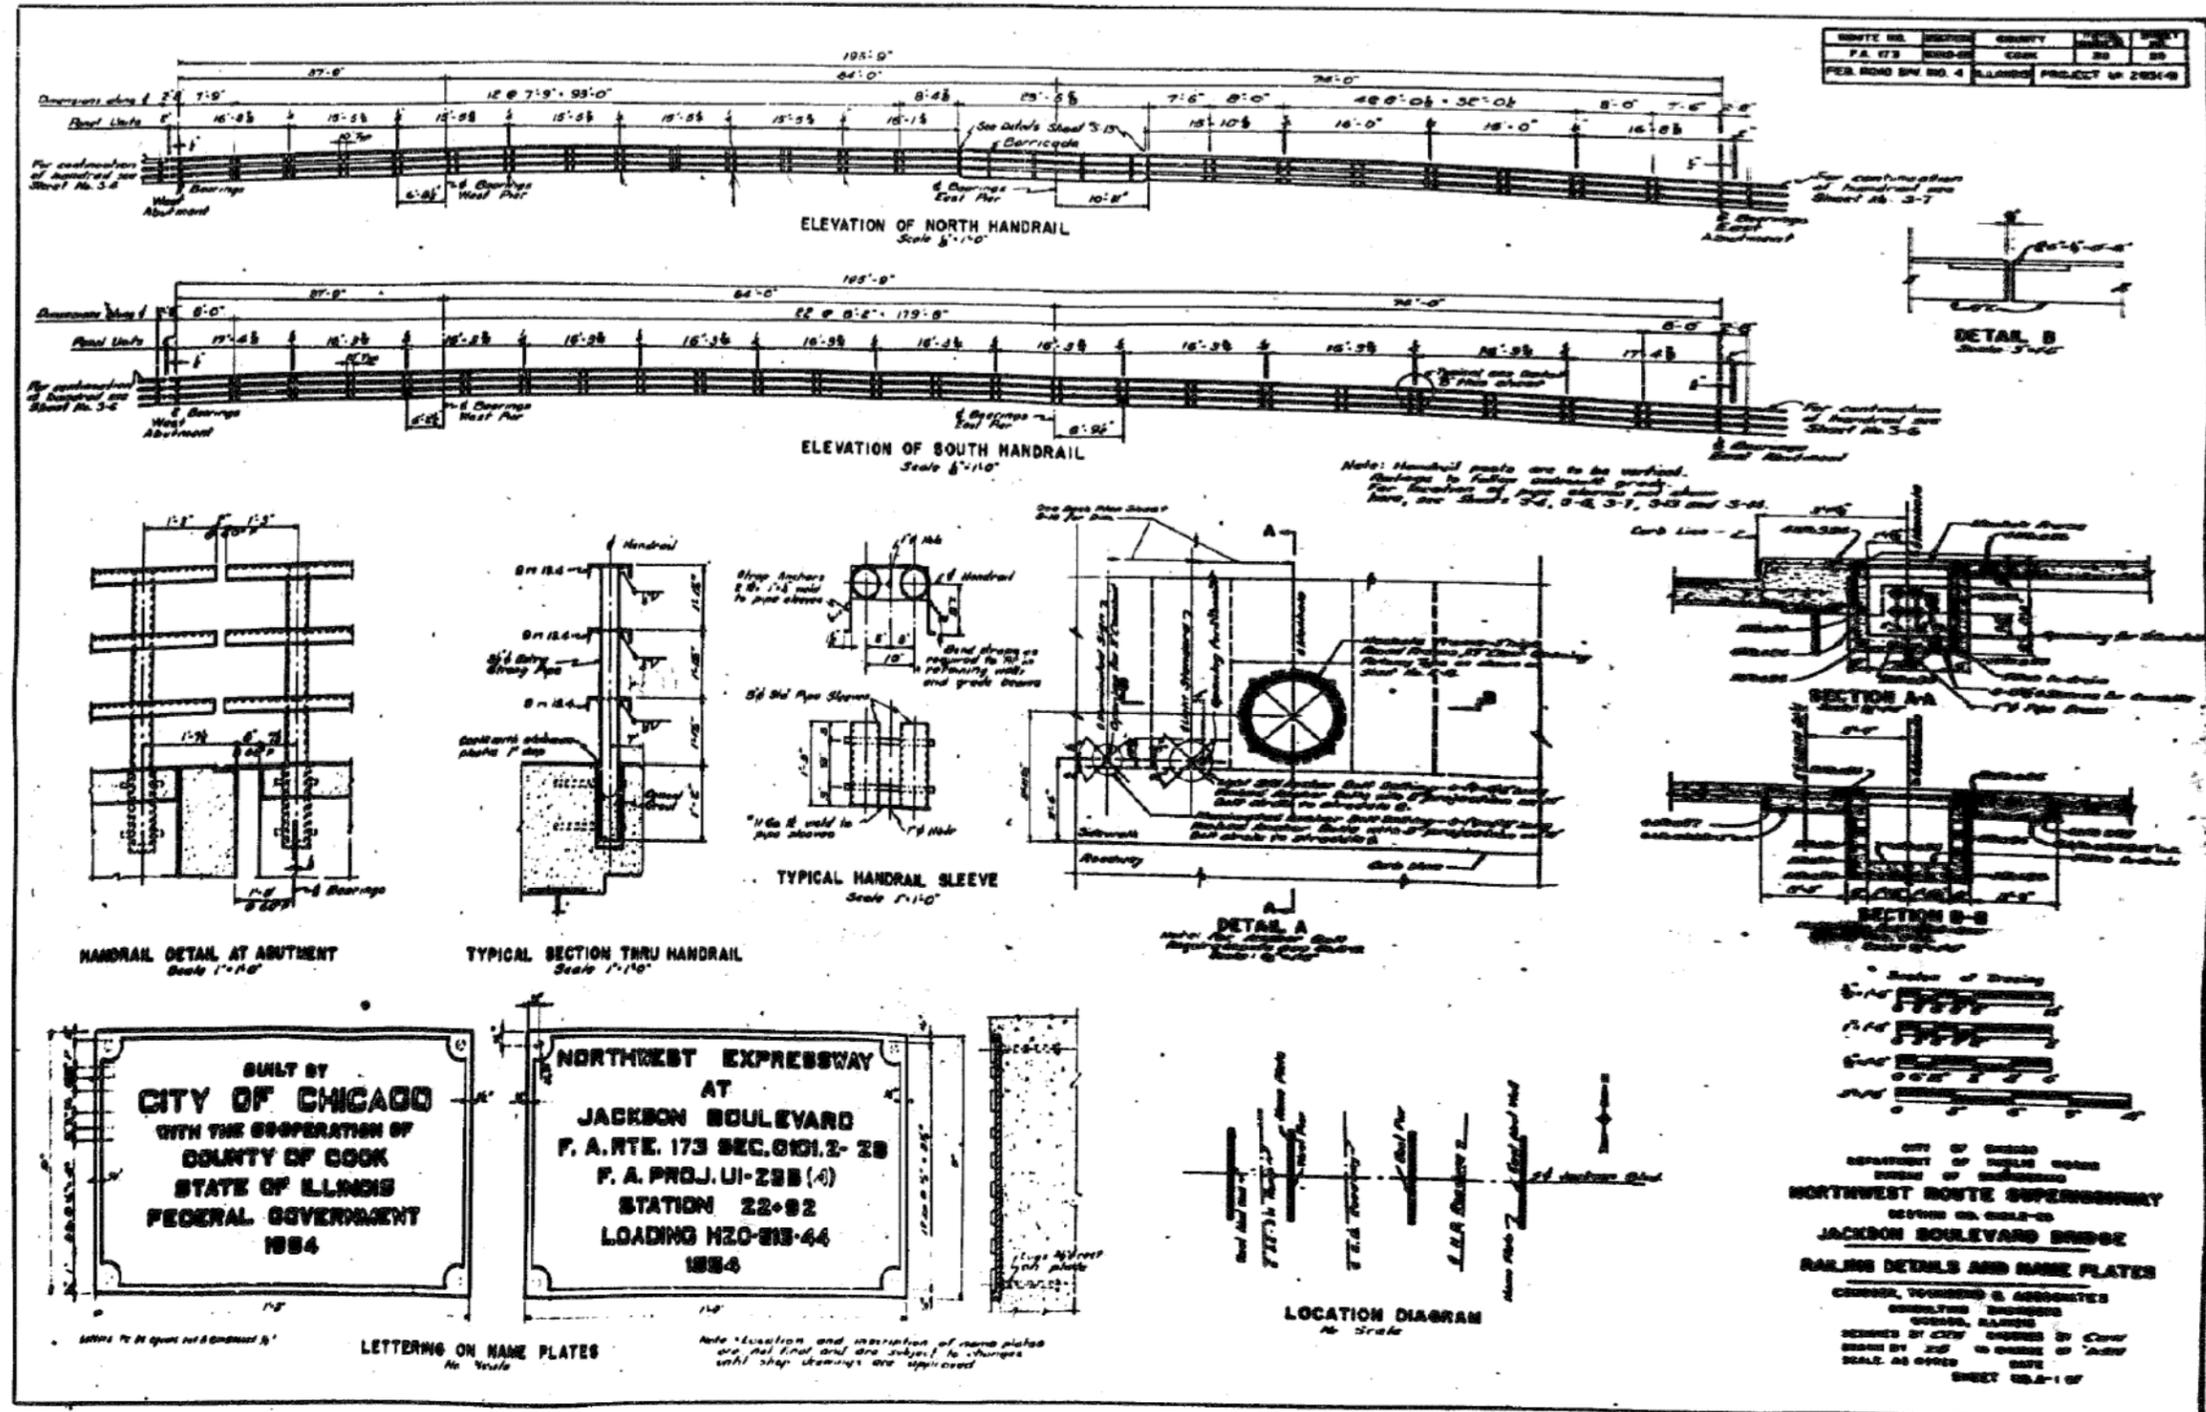

7:01:51 PM
D16231-SHT-AS-BUILT-65



USER NAME = wjcolletti	DESIGNED EH	REVISED
	CHECKED WJC	REVISED
PLOT SCALE = 0x2.0000 '1" / in.	DRAWN EH	REVISED
PLOT DATE = 8/13/2019	CHECKED WJC	REVISED

STATE OF ILLINOIS
DEPARTMENT OF TRANSPORTATION

EXISTING JACKSON BLVD BRIDGE PLANS (SN 016-0588)


SHEET NO. AB-65 OF AB-65 SHEETS

F.A.I. RTE. 90/94/290	SECTION 2014-017B	COUNTY COOK	TOTAL SHEETS 400	SHEET NO. 292
			CONTRACT NO. 62J31	
ILLINOIS FED. AID PROJECT				

Bench Mark: Cut "X" on southwest balcony of Jackson Blvd. Bridge. Elev. 597.26.

Existing Structure: None.

Traffic is to be maintained during construction.

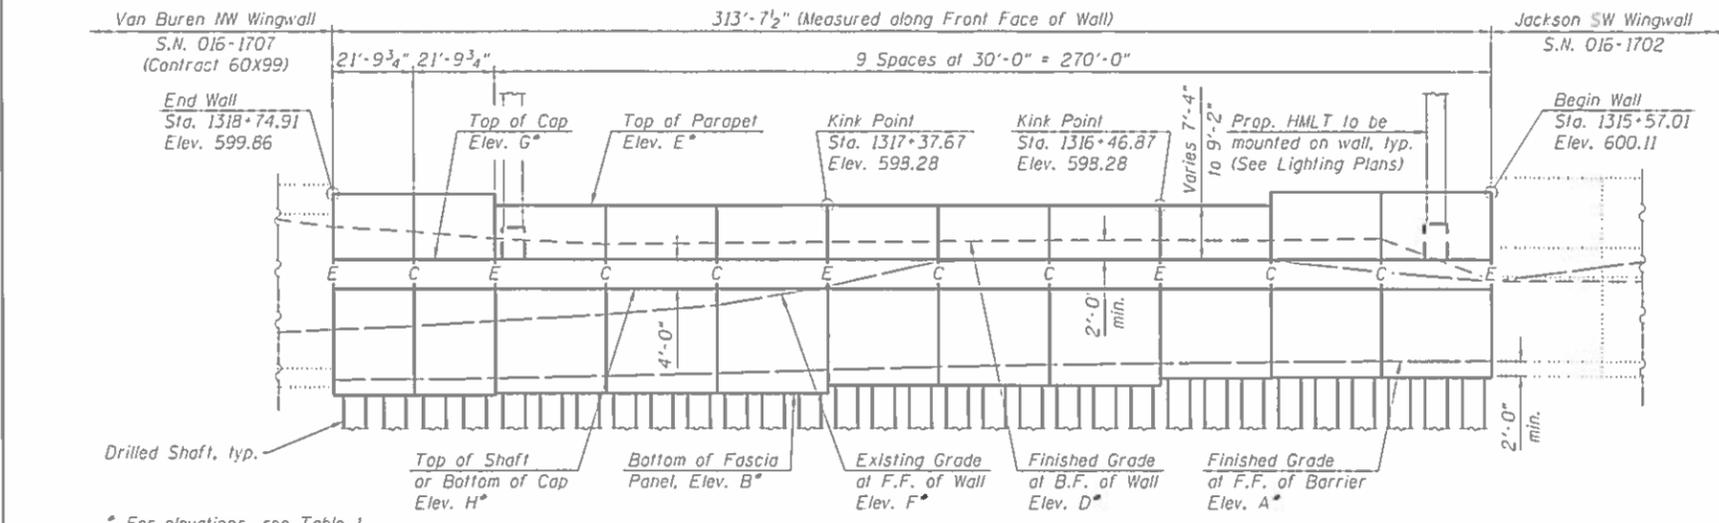


* For elevations, see Table 1 on Sheet S1-02 of S1-15.

ELEVATION

(Looking West at F.F. of Wall. Proposed Concrete Barrier not shown for clarity.)

Notes:

Wall offsets are measured from the @ of Proposed Ramp SW to the front face of cast-in-place fascia panels. C denotes Construction Joint. E denotes Expansion Joint. F.F. denotes Front Face. B.F. denotes Back Face.

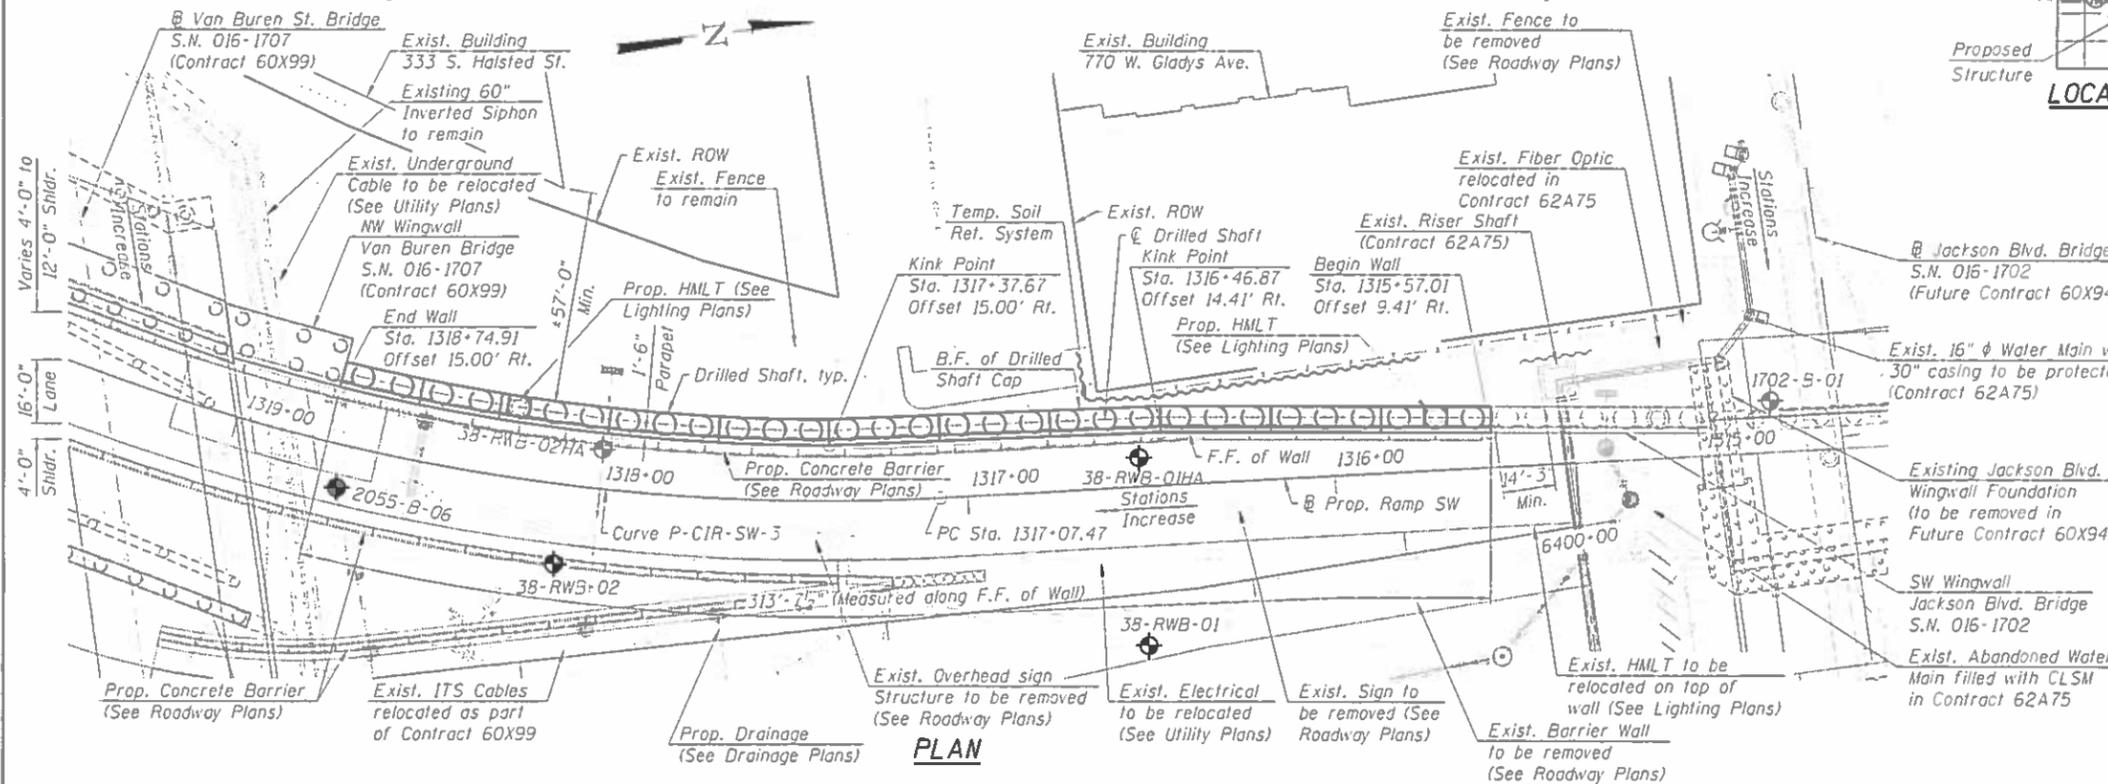

PLAN

CURVE DATA

(Ramp SW)
 Prop. Curve P-CIR-SW-3
 P.I. Sta. = 1322+16.98
 $\Delta = 83^\circ 35' 08''$ (RT)
 $D = 10^\circ 03' 07''$
 $R = 570.00'$
 $T = 509.51'$
 $L = 831.54'$
 $E = 194.53'$
 $e = 5.40\%$
 $T.R. = NA$
 $S.E. Run = 101'$
 $P.C. Sta. = 1317+07.47$
 $P.T. Sta. = 1325+39.01$

DESIGN SPECIFICATIONS

2017 AASHTO LRFD Bridge Design Specifications 8th Edition


DESIGN STRESSES

FIELD UNITS

$f'_c = 7,000$ psi (Drilled Shafts)
 $f'_c = 3,500$ psi (All other concrete)
 $f_y = 60,000$ psi (Reinforcement)



08-27-2019
 MATTHEW D. SANTEFORD, P.E., S.E.
 NO. 081-007244
 EXP. DATE 11/30/2020

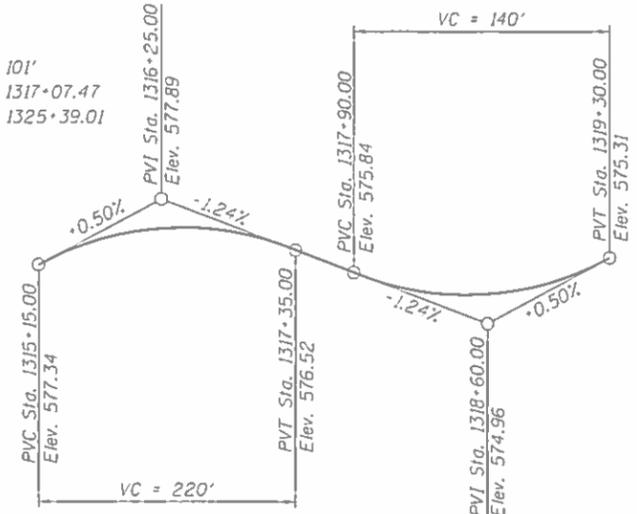


PROFILE GRADE

(Along @ Ramp SW)

SUGGESTED CONSTRUCTION SEQUENCE

1. Construct drilled shaft 1 thru 31.
2. Construct Temporary Soil Retention System.
3. Construct drilled shaft cap & parapet.
4. Remove Temporary Soil Retention System.
5. Excavate in front of shafts to Finished grade, installing lagging system in the process.
6. Construct concrete fascia panel and install drainage in front of the wall.
7. Backfill behind wall to finished grade.

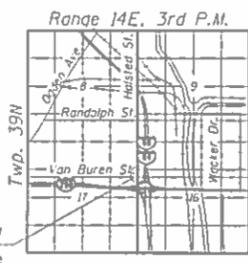

LOCATION SKETCH

APPROVED

For Structural Adequacy Only

Signature of Engineer of Bridges & Structures

LEGEND:

- Ex. Chain Link Fence — x —
- Combined Sewer —>>>>
- Electric — E —
- Water — W —
- Fiber Optic — FO —
- Ex. Storm Sewer — S —
- Prop. Storm Sewer — S —
- Soil Boring — ⊕ —
- Existing Catch Basin — ○ —
- Proposed Catch Basin — ● —
- Existing Manhole — ⊙ —
- Proposed Inlet — ■ —

**GENERAL PLAN AND ELEVATION
 RETAINING WALL 38 ALONG RAMP SW
 F.A.I. RTE. 290 (EISENHOWER EXPRESSWAY)
 SECTION 2019-054-I
 COOK COUNTY
 STATION 1315+57.01 TO STATION 1318+74.91
 STRUCTURE NO. 016-1827**

11:28:39 AM 01/16/21-6231-5001-GPE.dgn



USER NAME : AJDHREL	DESIGNED - KRS	REVISED -
PLDT SCALE : 48.00' / 1" =	CHECKED - DJG	REVISED -
PLDT DATE : 8/27/2019	DRAWN - AJD	REVISED -
	CHECKED - KRS	REVISED -

**STATE OF ILLINOIS
 DEPARTMENT OF TRANSPORTATION**

SHEET NO. S1-01 OF S1-15 SHEETS

F.A.I. RTE.	SECTION	COUNTY	TOTAL SHEETS	SHEET NO.
290	2019-054-I	COOK	400	293
CONTRACT NO. 62J31			ILLINOIS FED. AID PROJECT	

GENERAL NOTES:

- Reinforcement bars designated (E) shall be epoxy coated.
- The Contractor shall exercise extreme caution during construction to make certain that construction activities, live load surcharge and other loads applied to the structures will not have detrimental effects on the adjacent building foundations. Any damage during construction shall be repaired by the Contractor at his expense and no charge to the department. Driving piles and temporary sheet piling is not allowed.
- The Contractor shall provide vibration and displacement monitoring at the locations specified in the Special Provisions for Construction Vibration Monitoring and Monitoring Adjacent Structures, to ensure that removal/construction activities in the vicinity of the structures do not have detrimental effects on building foundations. No additional compensation shall be provided to the Contractor for alternative means and methods, or additional precautionary measures, required during removal/ construction activities to satisfy these requirements. See Contract Special Provisions for details.
- Drilled shaft construction above existing grade shall not be paid separately but shall be included with Drilled Shaft in Soil.
- Slipforming of parapets is not allowed.
- The Contractor shall field verify locations of existing underground utilities. The Contractor shall take precautions to protect existing utilities during construction of the wall. Any damage to the existing utilities shall be the responsibility of the Contractor.
- Concrete for the Drilled Shafts shall be in accordance with Section 516 of Standard Specifications and shall have the minimum compressive strength of 7,000 psi prior to excavation in front of shafts and installation of lagging system.
- Wall to be built along straight chords between construction and expansion joints.
- Concrete Sealer shall be applied to the exposed top, front, and back faces of the parapet, and to the exposed front faces of cap and fascia panels.
- Limited groundwater elevation data is available in the boring logs. In addition, groundwater may also be present in deeper granular layers. The groundwater may rise in the shafts to an elevation above the top of granular layers. The Contractor shall consider this information when choosing construction methods. The Contractor will not be compensated for issues related to the groundwater elevation.
- The Contractor shall take all necessary precautions not to contaminate groundwater during the drilled shaft construction operation. Contractor is responsible for the proper containment and disposal of the contaminated groundwater and spoils resulting from the Contractor's means and methods. No additional cost will be paid for this effort.
- Due to the squeeze potential of the clay soils, the use of temporary casing will be required to properly construct the shafts. Casing may be pulled or remain in place, as determined by the Contractor at no cost to the Department.
- The contractor shall coordinate the construction of the proposed structure with the construction of the Proposed Bridge and Southwest Wingwall of the Jackson Blvd. Bridge. See MOT plan sheets and special provisions, including the Available Work Areas and Sequencing Requirements special provision, for additional construction and coordination requirements.

STATION 1315+57.01 TO 1318+74.91
 BUILT 20__ BY
 STATE OF ILLINOIS
 F.A.I. RT. 290 SEC. 2019-054-1
 LOADING HL-93
 STR. NO. 016-1827

NAME PLATE
 See Std. 515001

INDEX OF SHEETS

- S1-01 General Plan and Elevation
- S1-02 General Data
- S1-03 Plan and Elevation 1
- S1-04 Plan and Elevation 2
- S1-05 Plan and Elevation 3
- S1-06 Plan and Elevation 4
- S1-07 Wall Sections and Details 1
- S1-08 Wall Sections and Details 2
- S1-09 Wall Sections and Details 3
- S1-10 Architectural Details
- S1-11 Bar Splicer Assembly and Mechanical Splicer Details
- S1-12 Boring Logs 1
- S1-13 Boring Logs 2
- S1-14 Boring Logs 3
- S1-15 Boring Logs 4

TOTAL BILL OF MATERIAL


Item	Unit	Total Quantity
Structure Excavation	Cu. Yd.	783
Concrete Structures	Cu. Yd.	325.3
Concrete Superstructure	Cu. Yd.	144.6
Reinforcement Bars	Pound	572,630
Reinforcement Bars, Epoxy Coated	Pound	28,730
Mechanical Splicers	Each	744
Name Plates	Each	1
Drilled Shaft in Soil	Cu. Yd.	2,434.8
Temporary Soil Retention System	Sq. Ft.	393
Concrete Sealer	Sq. Ft.	9,454
Class SI Concrete (Miscellaneous)	Cu. Yd.	237.1
Crosshole Sonic Logging Access Ducts	Foot	2,325
Crosshole Sonic Logging Testing	Each	7
Slope Inclinometer	Each	1
Bonded Preformed Joint Sealer, 2"	Foot	28
Pipe Underdrains for Structures 4"	Foot	314

TABLE 1 - WALL ELEVATIONS

Station	Offset	Elevation A	Elevation B	Elevation C	Elevation D	Elevation E	Elevation F	Elevation G	Elevation H
1315+57.01	9.41' Rt.	577.18	574.94	580.68	588.61	600.11	587.97	590.94	586.94
1315+86.97	11.08' Rt.	577.13	574.94	580.63	593.80	600.11	589.25	590.94	586.94
† 1316+16.92	12.75' Rt.	577.01	574.94	580.51	593.53	600.11	590.77	590.94	586.94
‡ 1316+16.92	12.75' Rt.	577.01	574.78	580.51	593.53	598.28	590.77	590.94	586.94
1316+46.87	14.41' Rt.	576.83	574.78	580.33	593.53	598.28	590.95	590.94	586.94
1316+76.87	14.87' Rt.	576.63	573.86	580.13	594.28	598.28	590.90	590.94	586.94
1317+06.87	15.32' Rt.	576.36	573.86	579.86	594.28	598.28	590.65	590.94	586.94
1317+37.67	15.00' Rt.	575.91	573.86	579.41	593.29	598.28	587.24	590.94	586.94
1317+68.48	15.00' Rt.	575.46	572.78	578.96	593.15	598.28	584.69	590.94	586.94
† 1317+99.29	15.00' Rt.	575.08	572.78	578.58	592.97	598.28	583.44	590.94	586.94
‡ 1318+30.10	15.00' Rt.	574.79	572.78	578.29	593.75	598.28	582.56	590.94	586.94
1318+30.10	15.00' Rt.	574.79	572.53	578.29	593.75	599.86	582.56	590.94	586.94
† 1318+52.51	15.00' Rt.	574.65	572.53	578.15	594.68	599.86	581.85	590.94	586.94
‡ 1318+74.91	15.00' Rt.	574.58	572.53	578.08	595.86	599.86	581.41	590.94	586.94

Elevation A- Finished Grade at Front Face of Barrier
 Elevation B- Bottom of Fascia Panel
 Elevation C- Top of Barrier at Front Face of Wall
 Elevation D- Finished Grade at Back Face of Wall
 Elevation E- Top of Parapet

Elevation F- Existing Grade at Front Face of Wall
 Elevation G- Top of Cap
 Elevation H- Top of Shaft / Bottom of Cap
 † Elevations just to the right of joint
 ‡ Elevations just to the left of joint

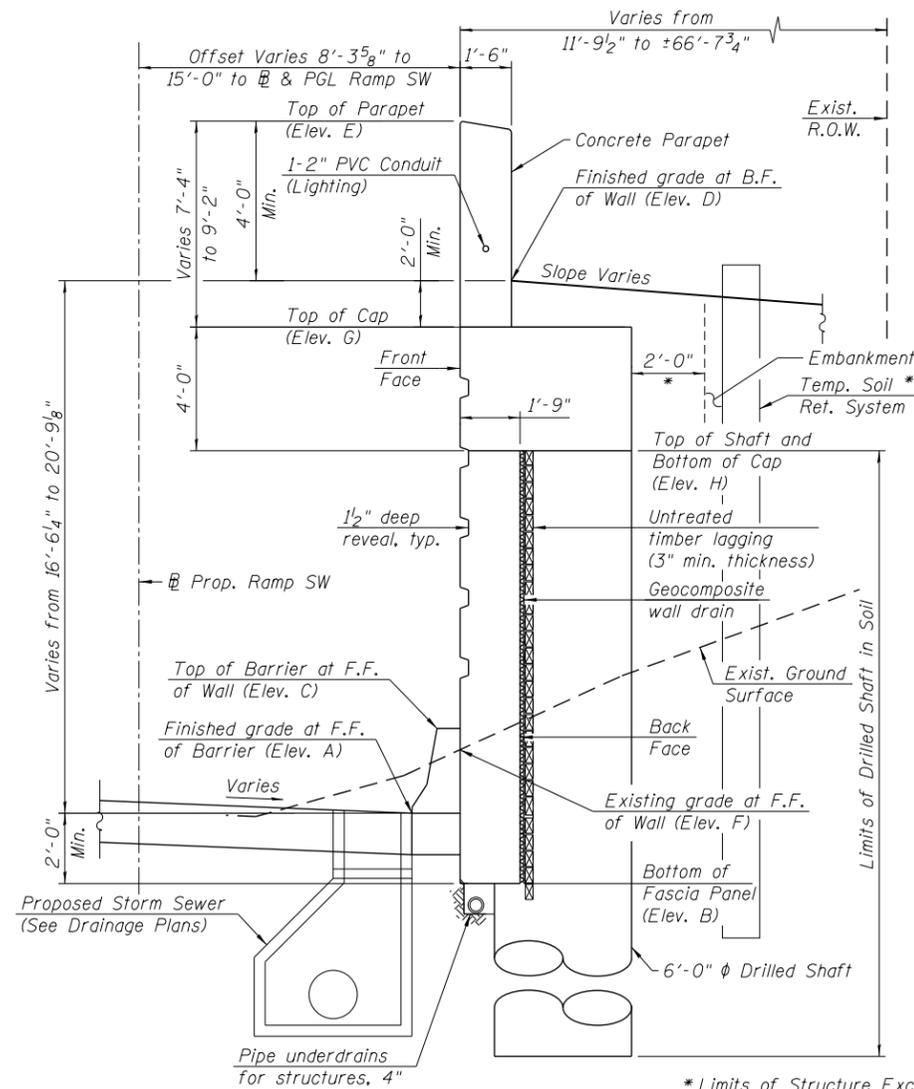

TYPICAL CROSS SECTION
 (Looking Upstation)

* Limits of Structure Excavation.
 ** See Sheet S1-03 of S1-15 for Limits of Temporary Soil Retention System.

11:28:50 AM 0161827-62J31-S002-GenNote.dgn




USER NAME = AJDKEL	DESIGNED - KRS	REVISED -
	CHECKED - DJG	REVISED -
PLOT SCALE = 0.1667' / in.	DRAWN - AJD	REVISED -
PLOT DATE = 8/27/2019	CHECKED - KRS	REVISED -

STATE OF ILLINOIS
DEPARTMENT OF TRANSPORTATION


GENERAL DATA
RETAINING WALL 38 (STRUCTURE NO. 016-1827)

SHEET NO. S1-02 OF S1-15 SHEETS

F.A.I. RTE. 290	SECTION 2019-054-1	COUNTY COOK	TOTAL SHEETS 400	SHEET NO. 294
CONTRACT NO. 62J31			ILLINOIS FED. AID PROJECT	

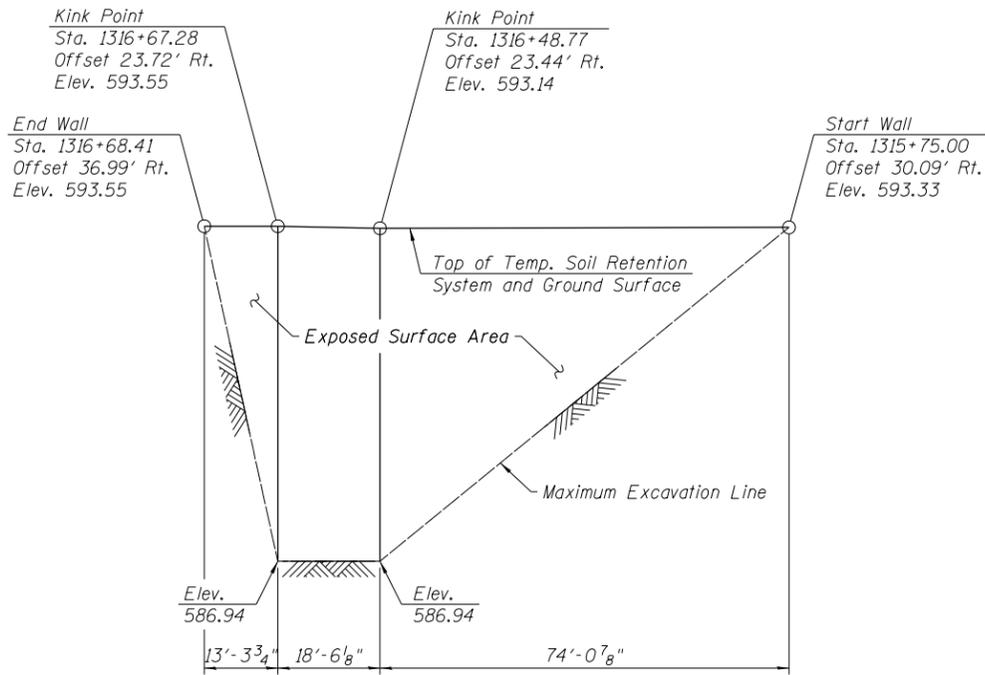


TEMPORARY SOIL RETENTION SYSTEM - ELEVATION
(Unfolded View, Measured along F.F. of Wall)

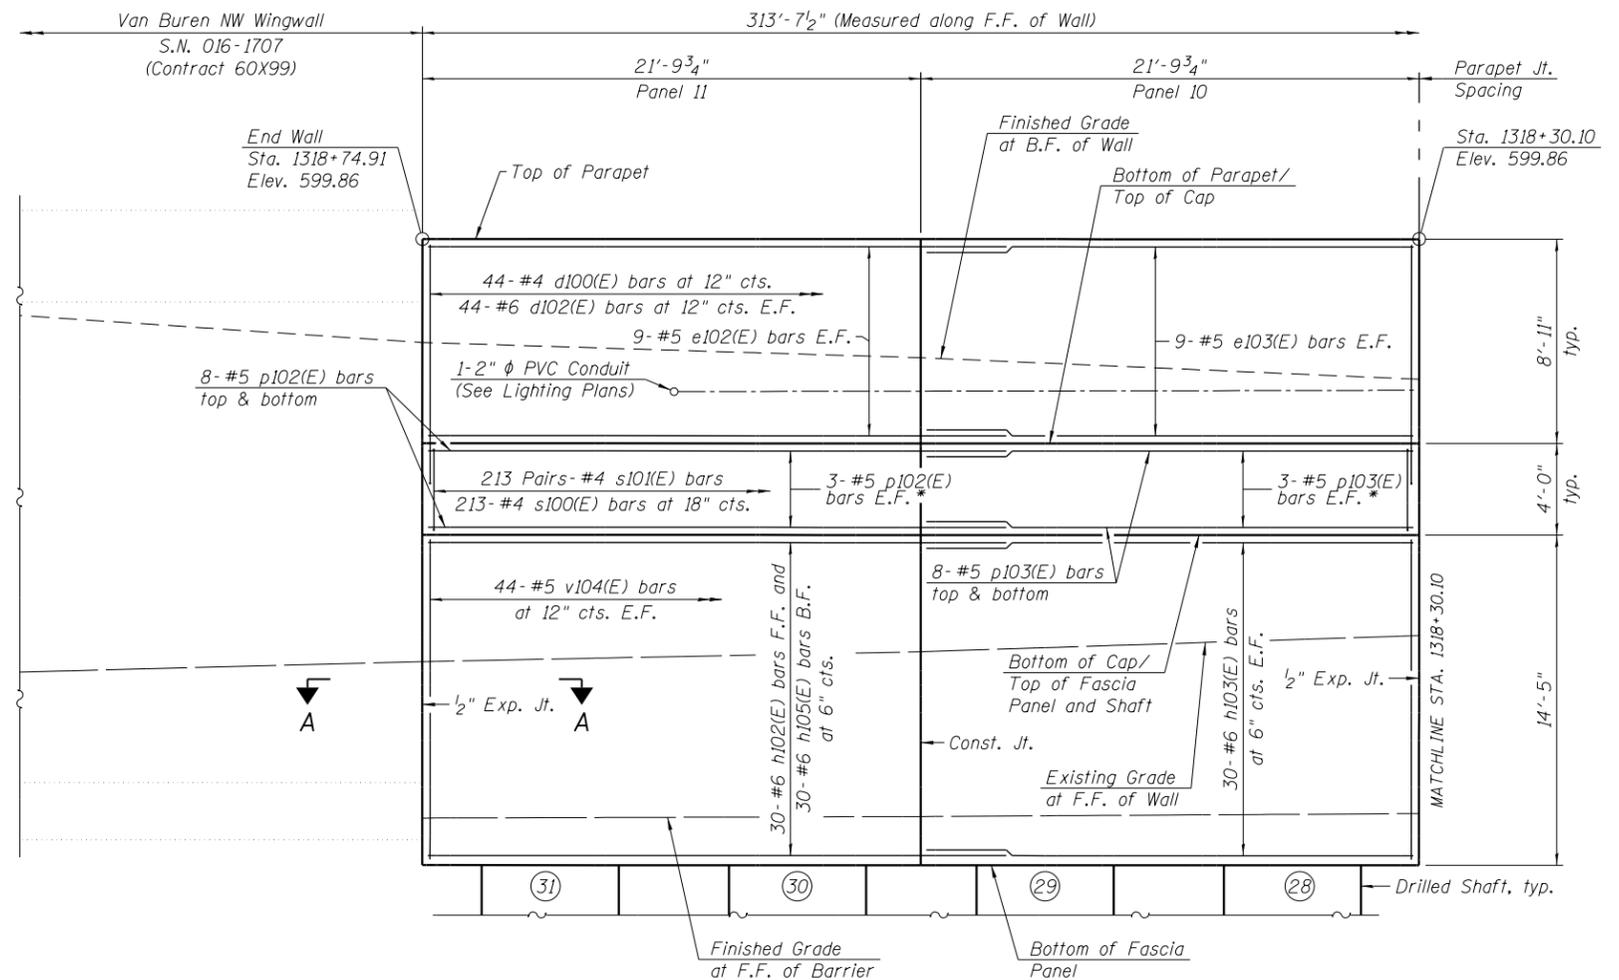

WALL ELEVATION

(Looking West)
Drilled shaft reinforcement not shown for clarity

* Spaced evenly between shown bars.

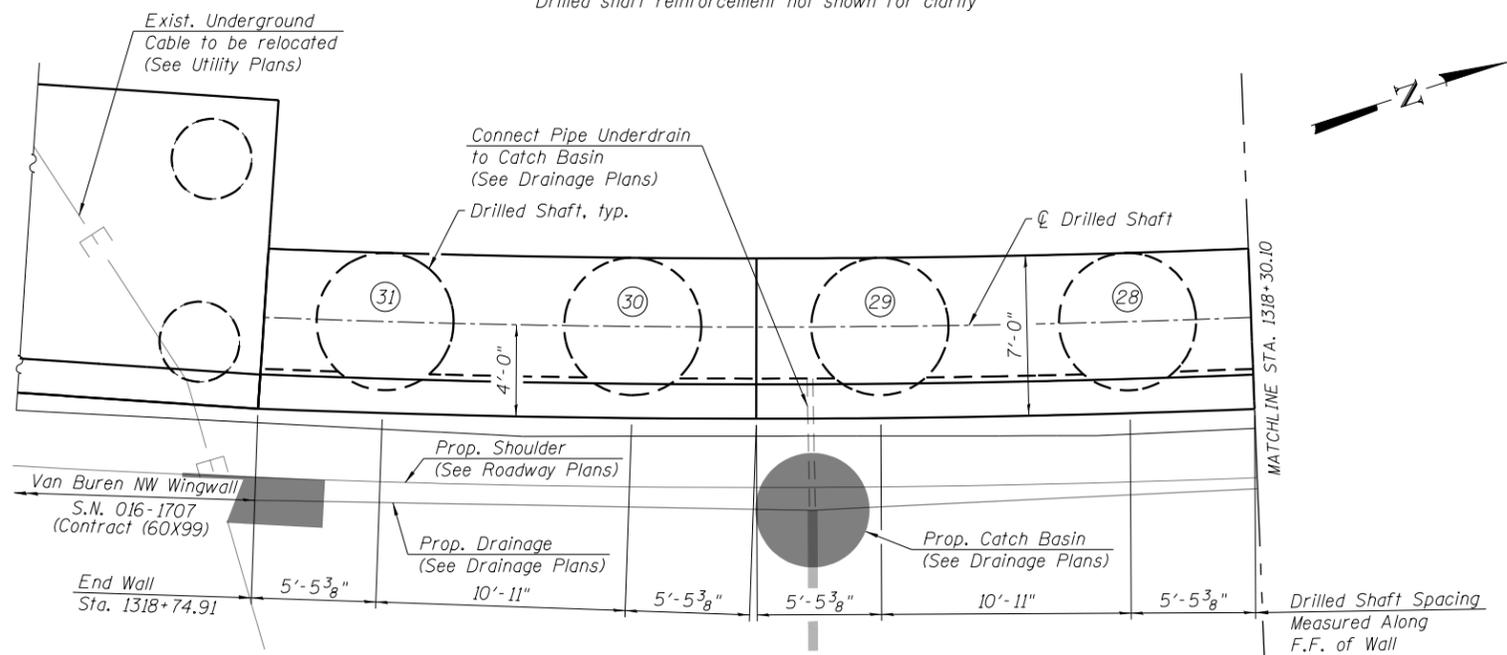

PLAN

(Parapet and cap reinforcement not shown for clarity)

Notes:
Work this sheet with Sheets S1-03 to S1-09 of S1-15.
F.F. = Front Face
B.F. = Back Face
E.F. = Each Face
Parapet concrete shall be paid for as Concrete Superstructure.
Shaft Cap shall be paid for as Concrete Structures.
Concrete fascia panels shall be paid as Class SI Concrete (Miscellaneous).
Drilled Shafts shall be tested in accordance with Special Provision for Crosshole Sonic Logging Testing of Drilled Shafts.
See Drilled Shaft Layout Table on Sheet S1-09 of S1-15.
See Sheet S1-10 of S1-15 for details on architectural reveals and joint between cap and fascia panels.
A cantilevered sheet piling design does not appear feasible and additional members or other retention systems may be necessary. The Contractor shall submit a temporary soil retention system design including plan details and calculations for review and acceptance by the Engineer.

11/15/27 PM 0161827-62J31-S003-ElevDetails.dgn



USER NAME = AJDINKEL	DESIGNED - KRS	REVISED -
	CHECKED - DJG	REVISED -
PLOT SCALE = 0.2" = 1'-0"	DRAWN - AJD	REVISED -
PLOT DATE = 8/27/2019	CHECKED - KRS	REVISED -


**STATE OF ILLINOIS
DEPARTMENT OF TRANSPORTATION**

**PLAN AND ELEVATION 1
RETAINING WALL 38 (STRUCTURE NO. 016-1827)**

SHEET NO. S1-03 OF S1-15 SHEETS


F.A.I. RTE.	SECTION	COUNTY	TOTAL SHEETS	SHEET NO.
290	2019-054-1	COOK	400	295
CONTRACT NO.			62J31	

ILLINOIS FED. AID PROJECT

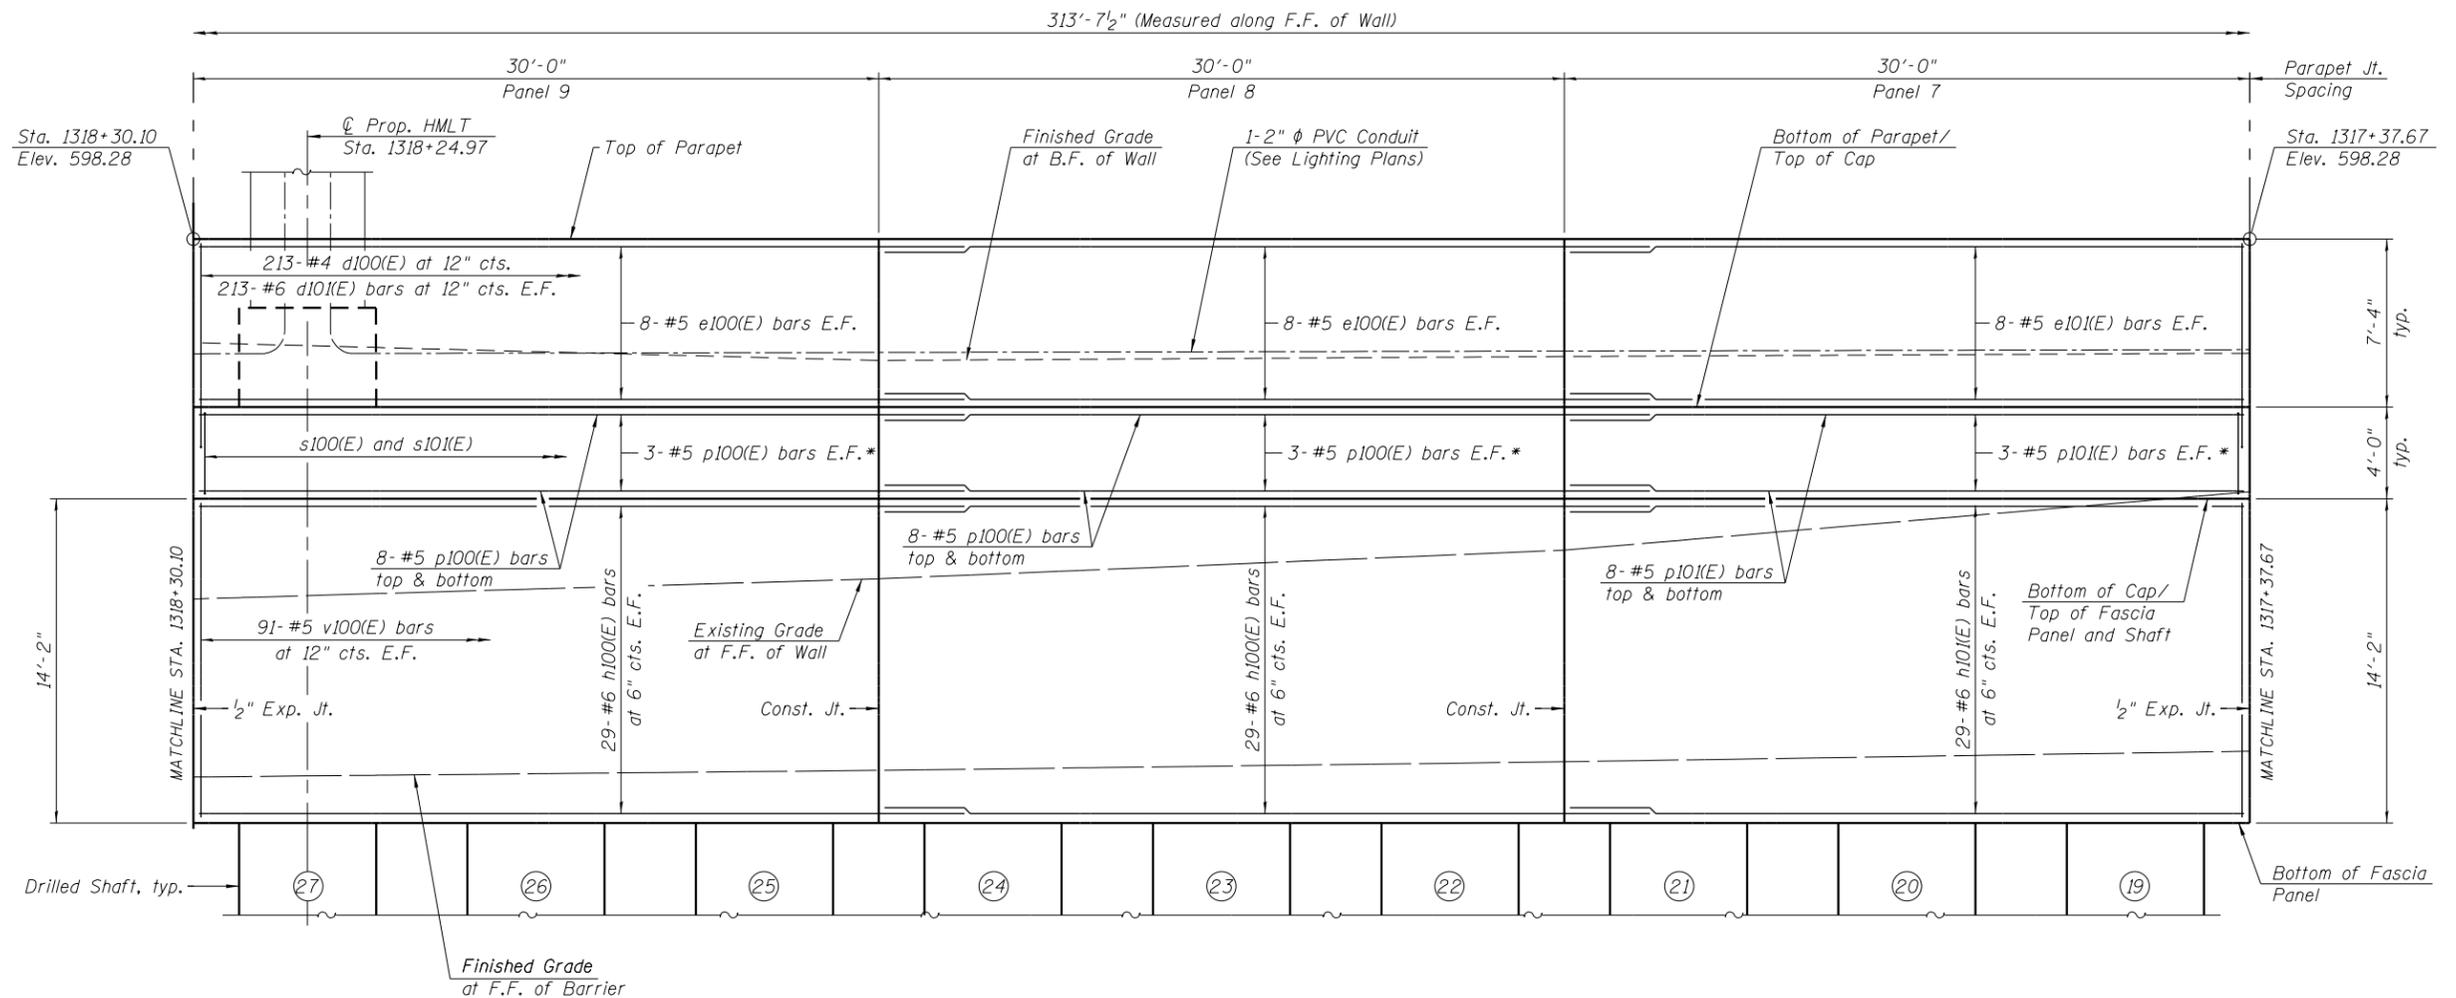

WALL ELEVATION

(Looking West)
Drilled shaft reinforcement not shown for clarity

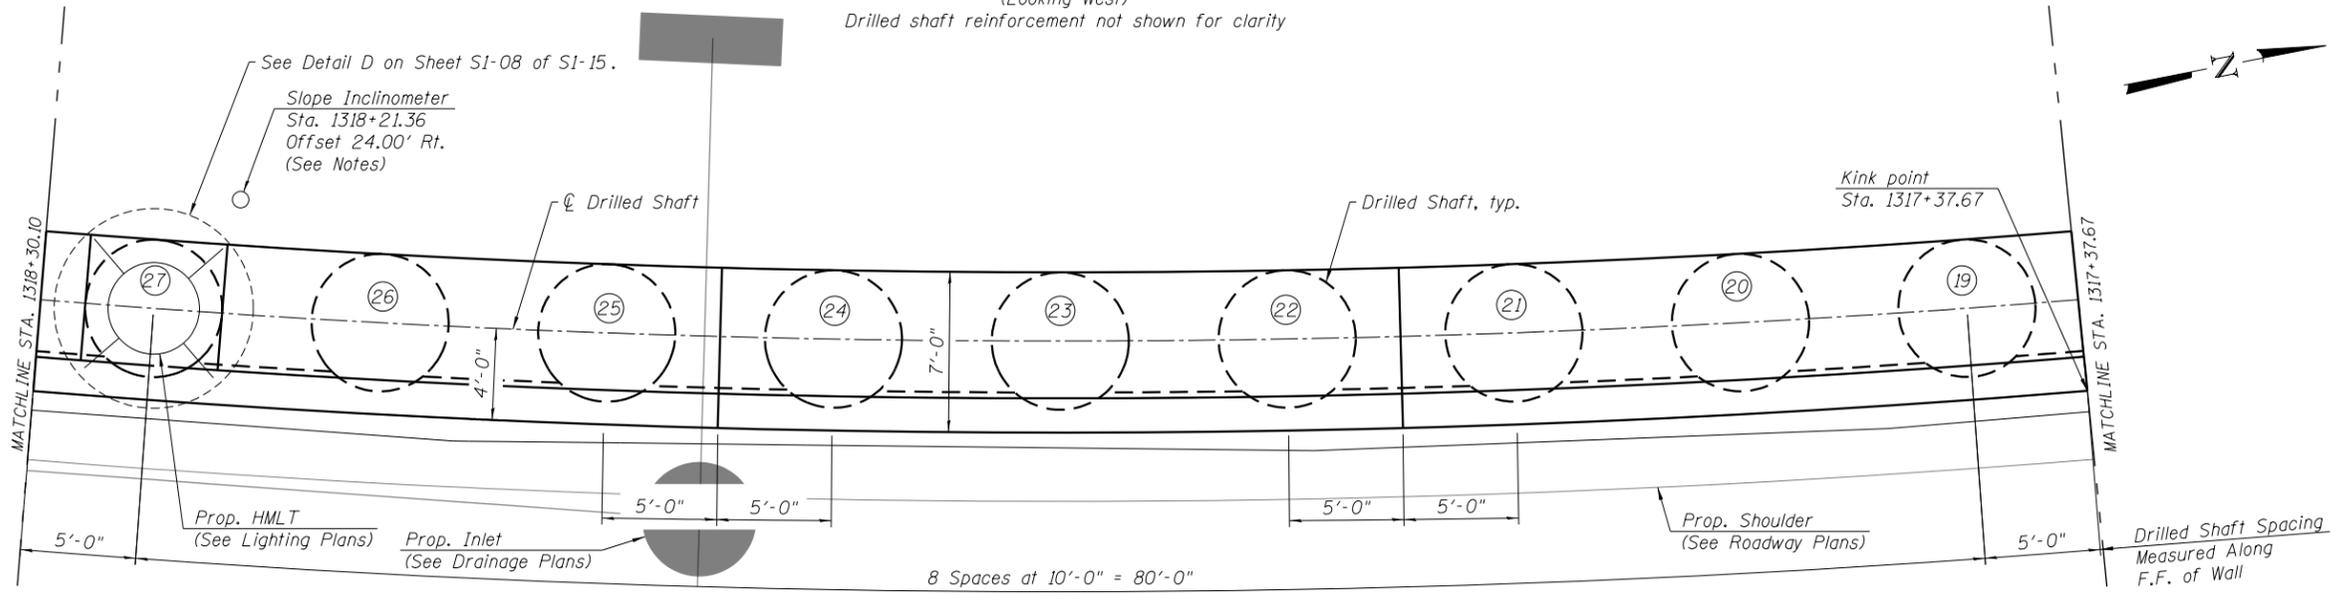

Notes:
 F.F. = Front Face
 B.F. = Back Face
 E.F. = Each Face
 See additional notes on Sheet S1-03 of S1-15.
 In addition to vibration and displacement monitoring, the Contractor shall monitor movements with Slope Inclometers. All inclinometers shall be installed prior to drilling. See special provision for Slope Inclometers.

11:29:19 AM 0161827-62J31-S004-ElevDetail.s2.dgn




USER NAME = AJDINKEL	DESIGNED - KRS	REVISED -
PLOT SCALE = 0.1667' / 1"	CHECKED - DJG	REVISED -
PLOT DATE = 8/27/2019	DRAWN - AJD	REVISED -
	CHECKED - KRS	REVISED -

**STATE OF ILLINOIS
DEPARTMENT OF TRANSPORTATION**

**PLAN AND ELEVATION 2
RETAINING WALL 38 (STRUCTURE NO. 016-1827)**

SHEET NO. S1-04 OF S1-15 SHEETS


F.A.I. RTE. 290	SECTION 2019-054-1	COUNTY COOK	TOTAL SHEETS 400	SHEET NO. 296
CONTRACT NO. 62J31			ILLINOIS FED. AID PROJECT	

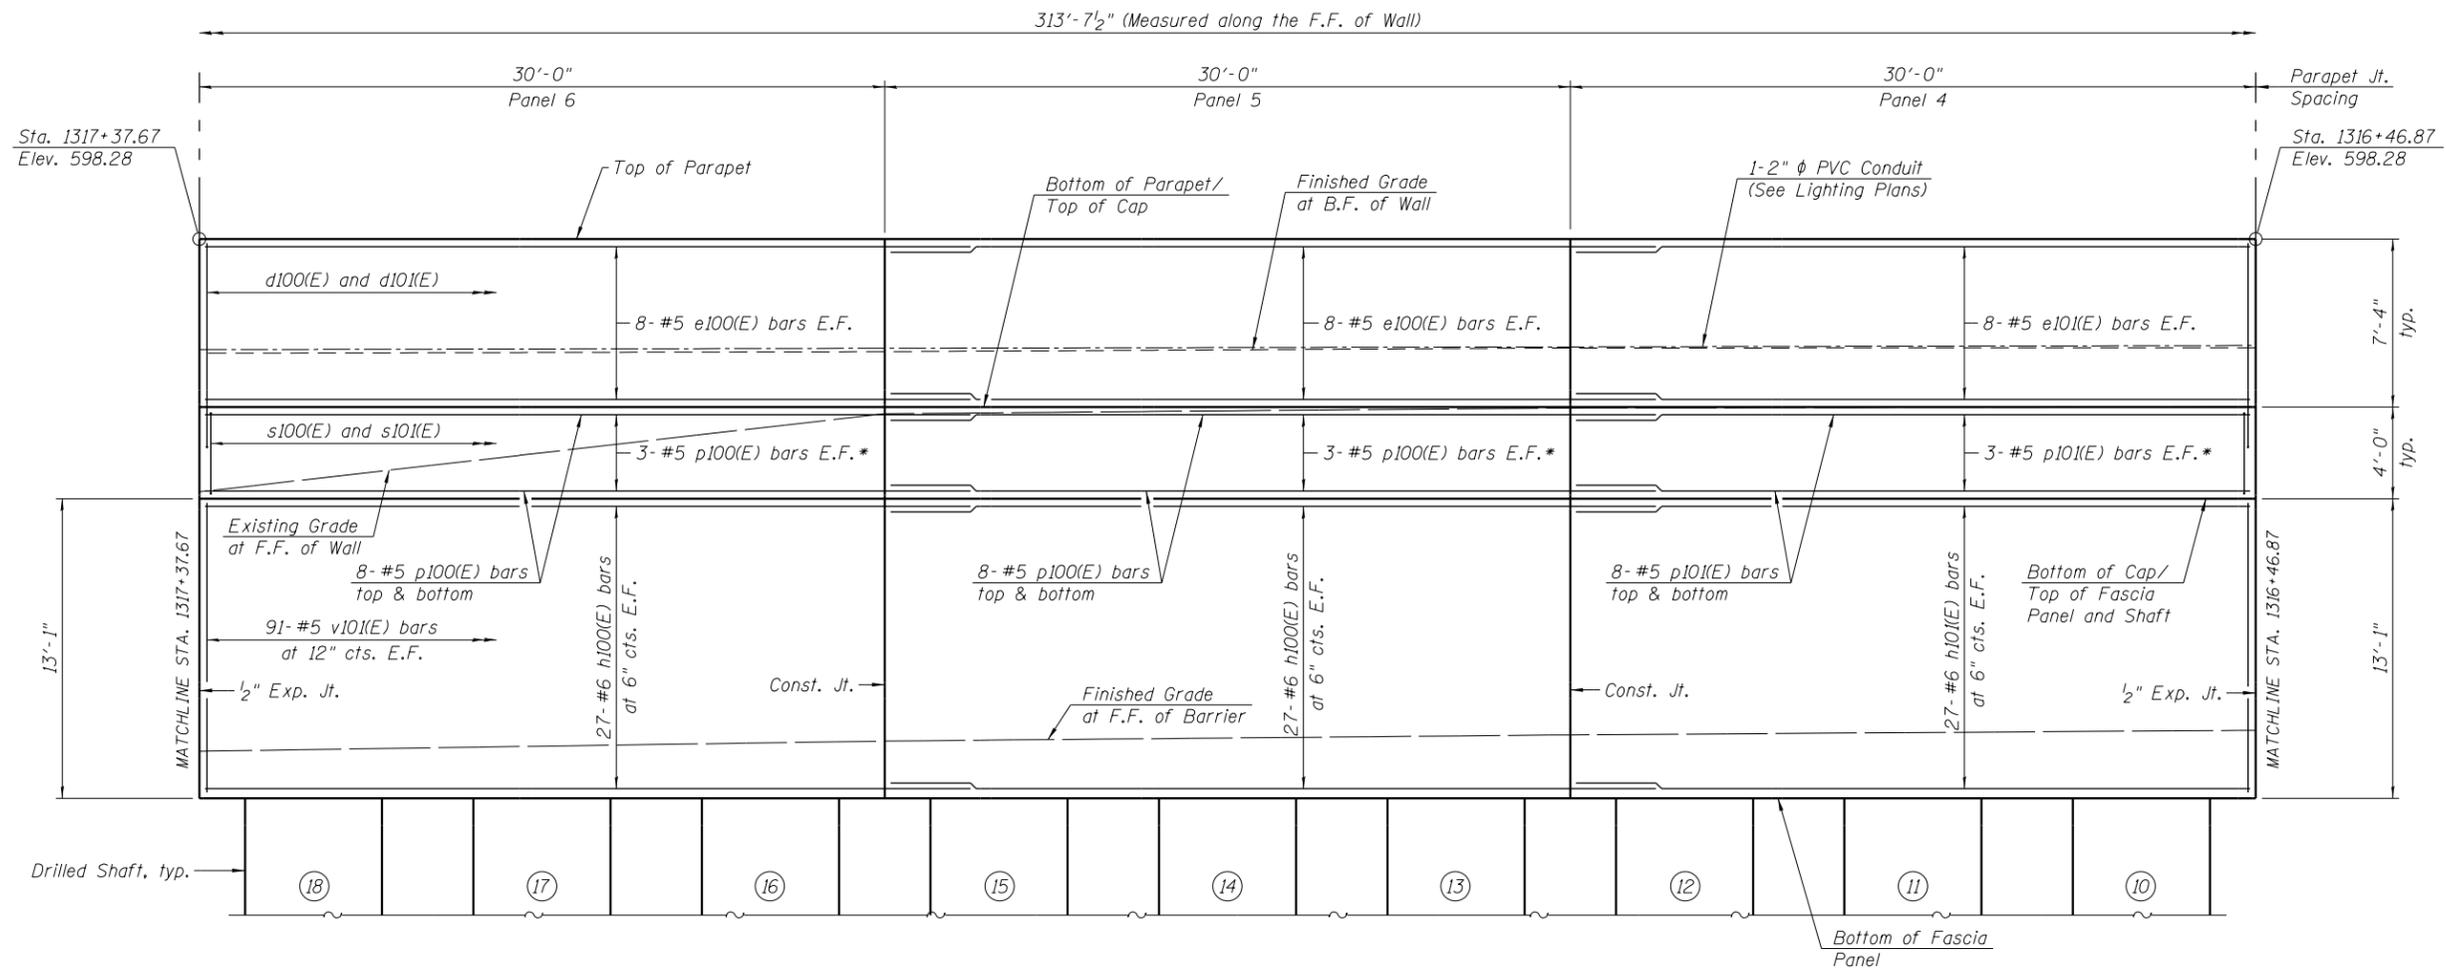

WALL ELEVATION

(Looking West)
Drilled shaft reinforcement not shown for clarity

* Spaced evenly between shown bars.

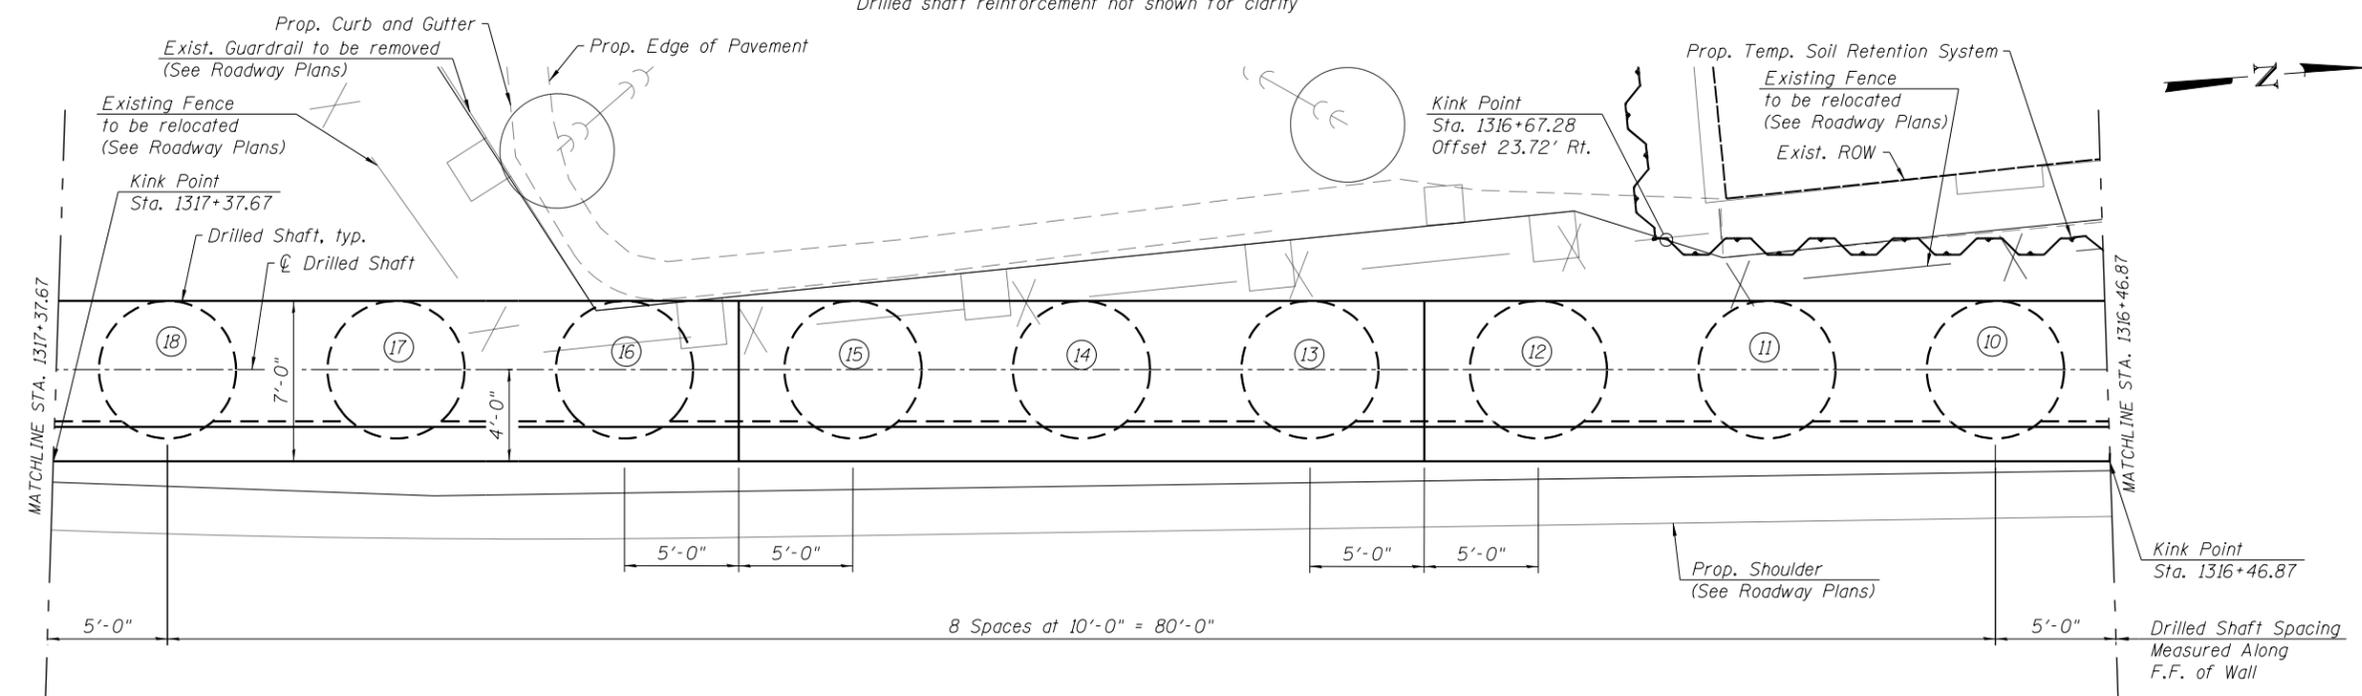

PLAN

(Parapet and cap reinforcement not shown for clarity)

Notes:
F.F. = Front Face
B.F. = Back Face
E.F. = Each Face
See additional notes on Sheet S1-03 of S1-15.

1:44:54 PM 0161827-62J31-S005-ElevDetails_3.dgn




USER NAME = AJDKEL	DESIGNED - KRS	REVISED -
PLOT SCALE = 0.1667' / 1"	CHECKED - DJG	REVISED -
PLOT DATE = 8/27/2019	DRAWN - AJD	REVISED -
	CHECKED - KRS	REVISED -

**STATE OF ILLINOIS
DEPARTMENT OF TRANSPORTATION**

**PLAN AND ELEVATION 3
RETAINING WALL 38 (STRUCTURE NO. 016-1827)**


SHEET NO. S1-05 OF S1-15 SHEETS

F.A.I. RTE.	SECTION	COUNTY	TOTAL SHEETS	SHEET NO.
290	2019-054-1	COOK	400	297
CONTRACT NO.			62J31	
ILLINOIS FED. AID PROJECT				

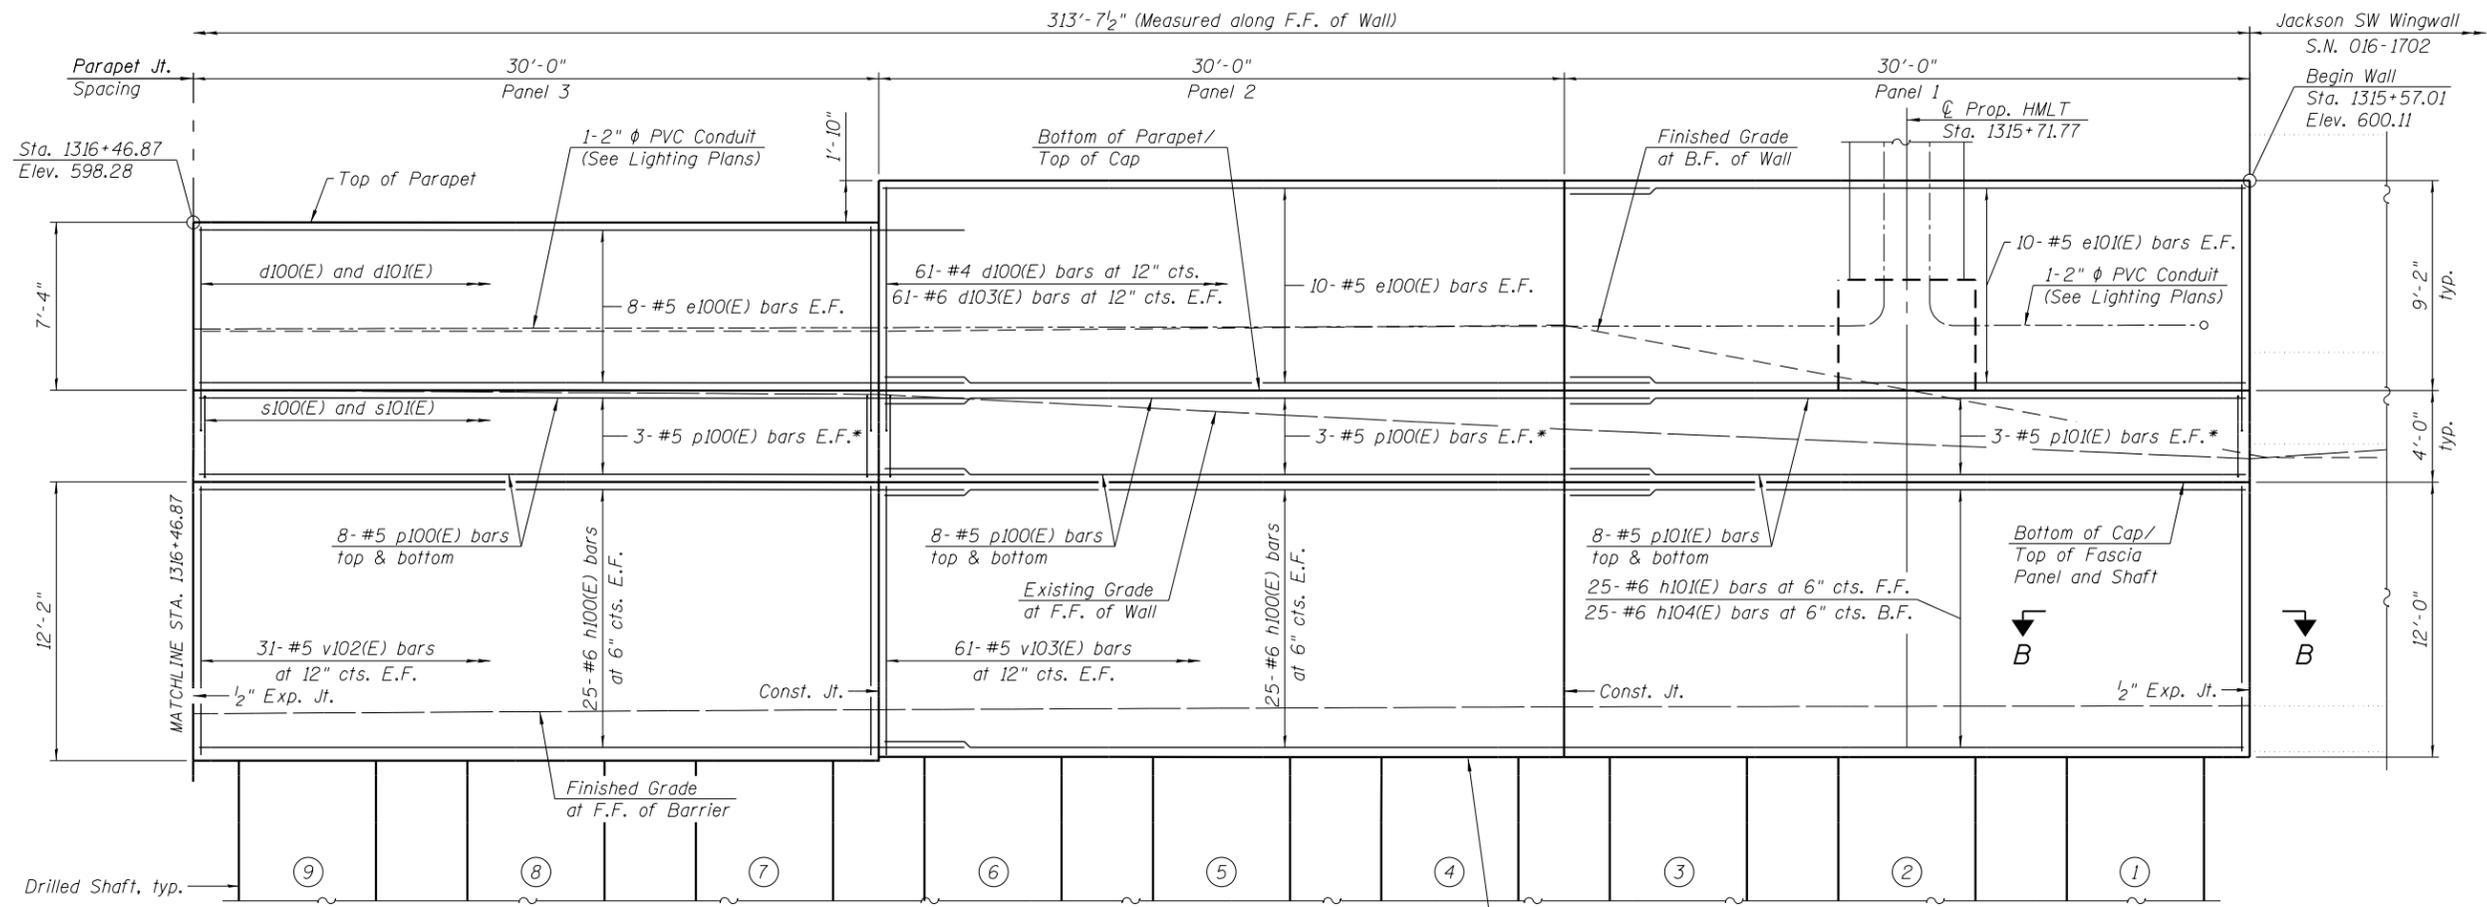

WALL ELEVATION

(Looking West)
Drilled shaft reinforcement not shown for clarity

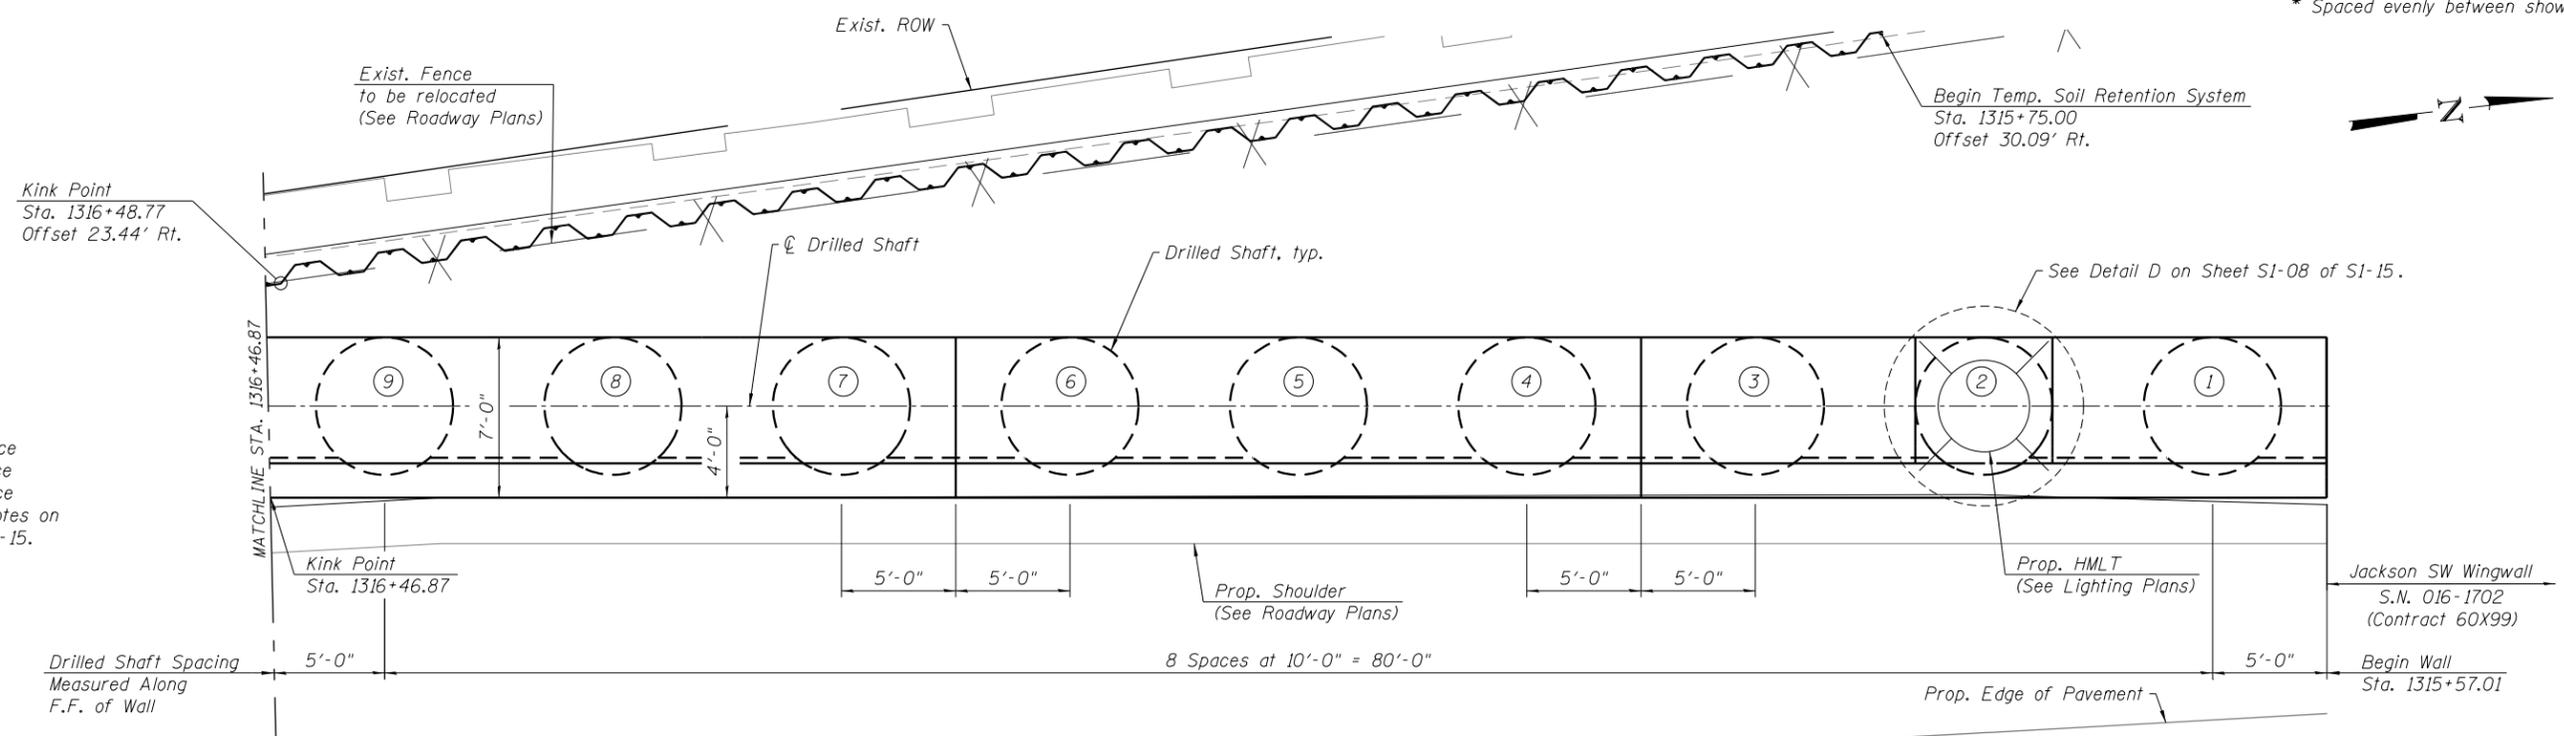

PLAN

(Parapet and cap reinforcement not shown for clarity)

Notes:
F.F. = Front Face
B.F. = Back Face
E.F. = Each Face
See additional notes on Sheet S1-03 of S1-15.

* Spaced evenly between shown bars.

1:45:02 PM 0161827-62J31-S006-ElevDetails_4.dgn



USER NAME = AJDINKEL	DESIGNED - KRS	REVISED -
	CHECKED - DJG	REVISED -
PLOT SCALE = 0.1667' / 1"	DRAWN - AJD	REVISED -
PLOT DATE = 8/27/2019	CHECKED - KRS	REVISED -


**STATE OF ILLINOIS
DEPARTMENT OF TRANSPORTATION**

**PLAN AND ELEVATION 4
RETAINING WALL 38 (STRUCTURE NO. 016-1827)**

SHEET NO. S1-06 OF S1-15 SHEETS


F.A.I. RTE.	SECTION	COUNTY	TOTAL SHEETS	SHEET NO.
290	2019-054-1	COOK	400	298
CONTRACT NO.			62J31	

ILLINOIS FED. AID PROJECT

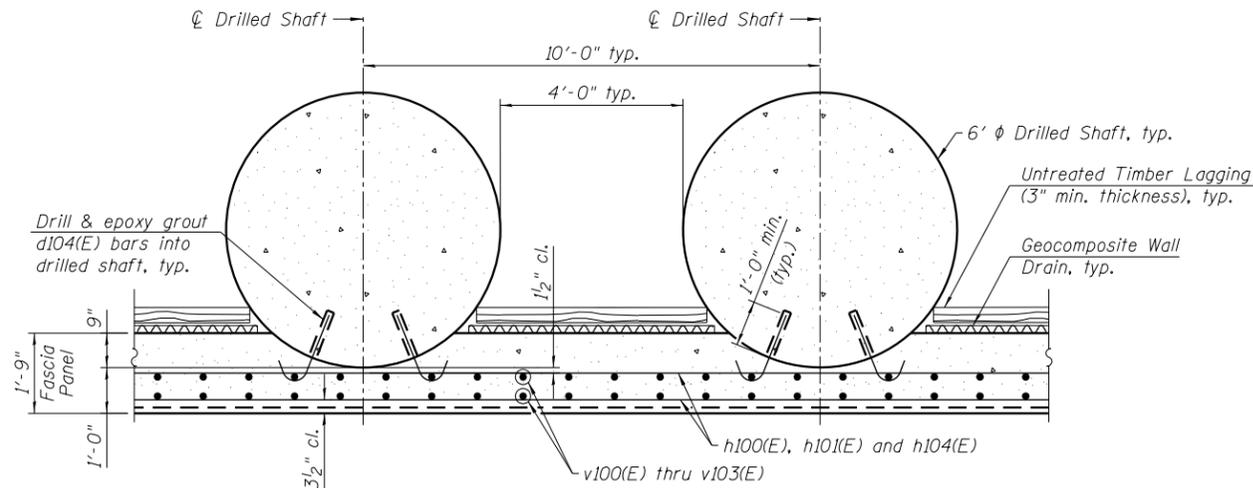


TYPICAL WALL SECTION - PANELS 1-9

(Shaft reinforcement not shown for clarity)

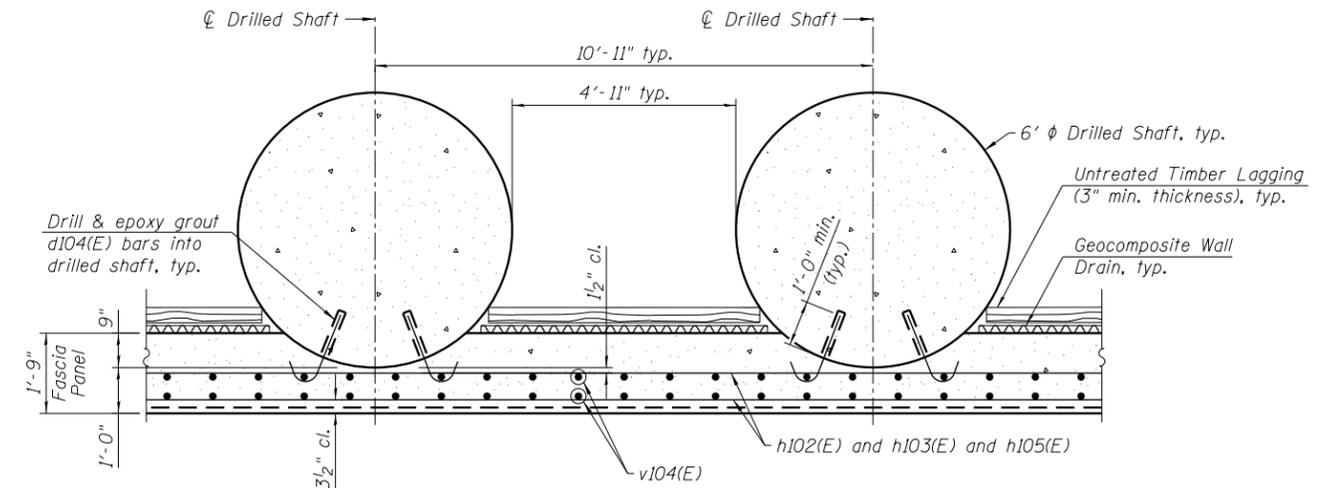


TYPICAL WALL SECTION - PANELS 10-11

(Shaft reinforcement not shown for clarity)

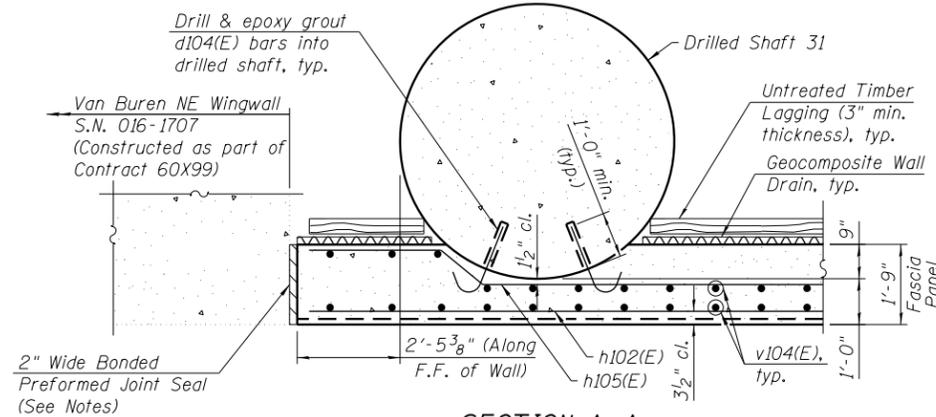

SECTION A-A

(Shaft reinforcement not shown for clarity)

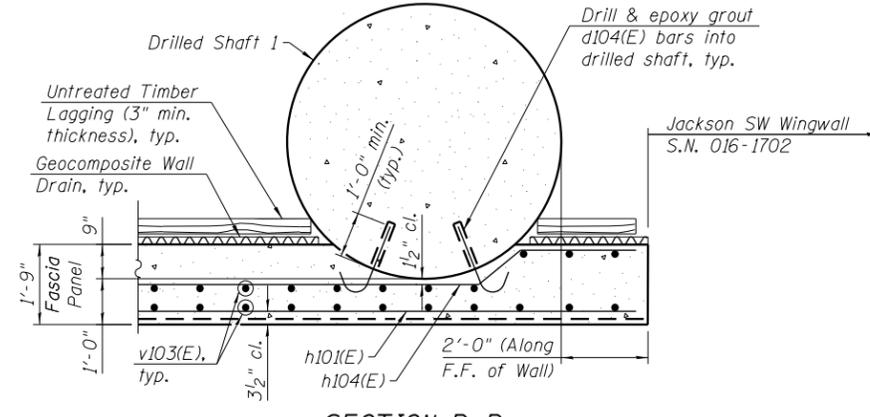

SECTION B-B

(Shaft reinforcement not shown for clarity)

Notes:

F.F. = Front Face.

B.F. = Back Face.

E.F. = Each Face.

Work this sheet with Sheets S1-03 thru S1-06 of S1-15.

The 2 inch gap between the new structure and the existing wingwall is a nominal dimension and shall be field verified prior to ordering the bonded preformed joint seal. See supplemental specification for Bonded Preformed Joint Seal for additional placement requirements.

Install lagging and Geocomposite Wall Drain from top down as excavation proceeds. Minimize over-excavation and backfill voids with dry loose sand. Cost included with Class SI Concrete (Miscellaneous).

The Contractor is responsible for the design and performance of the lagging system, the deflection of the lagging shall be limited to 1" maximum using no less than a 3 in. nominal rough-sawn thickness and timber with a minimum allowable bending stress of 1000 psi, until the concrete facing is installed. The Contractor shall submit design calculations and details prepared by an Illinois Licensed Structural Engineer for the attachment of the lagging to the shaft for approval by the Engineer. Alternative equivalent systems may be submitted for approval by the Engineer. Cost included with Class SI Concrete (Miscellaneous).

11:29:50 AM
0161827-62J31-S007-WellDetails-1.dgn




USER NAME = AJDINKEL	DESIGNED - KRS	REVISED -
	CHECKED - DJG	REVISED -
PLOT SCALE = 0/2 1/4" = 1"	DRAWN - AJD	REVISED -
PLOT DATE = 8/27/2019	CHECKED - KRS	REVISED -

**STATE OF ILLINOIS
DEPARTMENT OF TRANSPORTATION**


**WALL SECTIONS AND DETAILS 1
RETAINING WALL 38 (STRUCTURE NO. 016-1827)**

SHEET NO. S1-07 OF S1-15 SHEETS


F.A.I. RTE.	SECTION	COUNTY	TOTAL SHEETS	SHEET NO.
290	2019-054-1	COOK	400	299
CONTRACT NO.			62J31	
ILLINOIS FED. AID PROJECT				

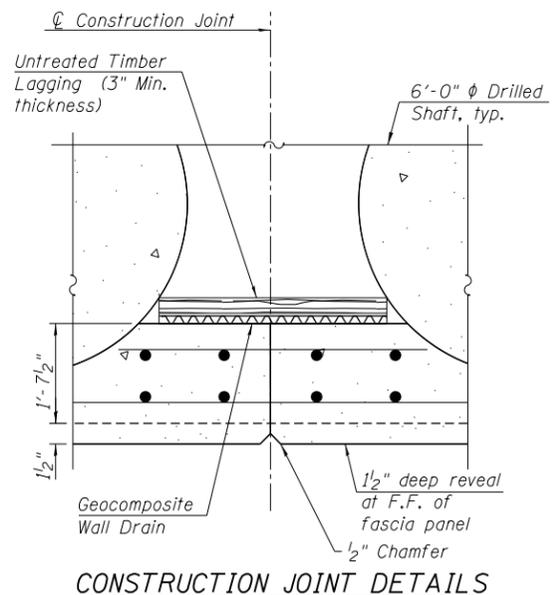


CONSTRUCTION JOINT DETAILS

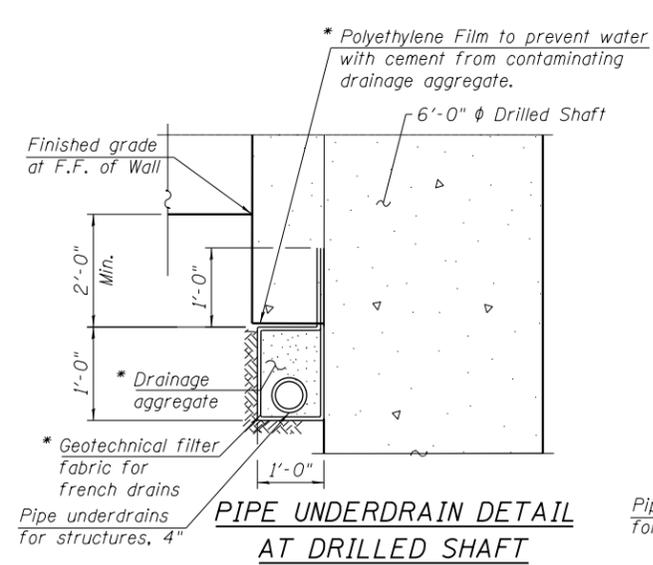

PIPE UNDERDRAIN DETAIL AT DRILLED SHAFT

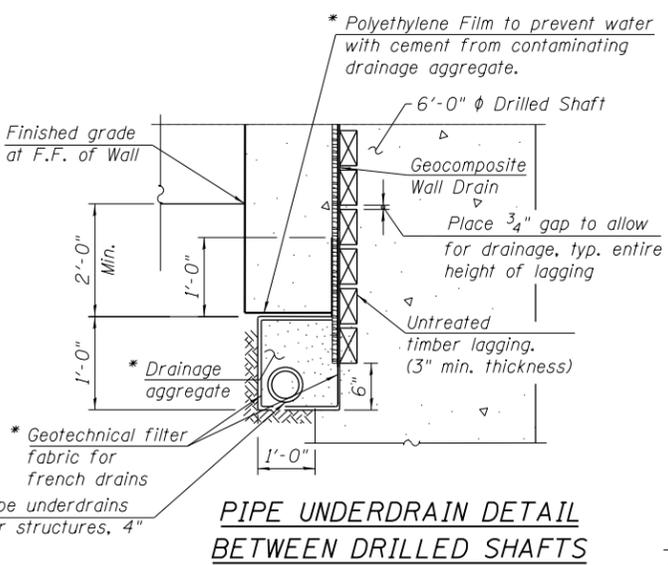


PIPE UNDERDRAIN DETAIL BETWEEN DRILLED SHAFTS

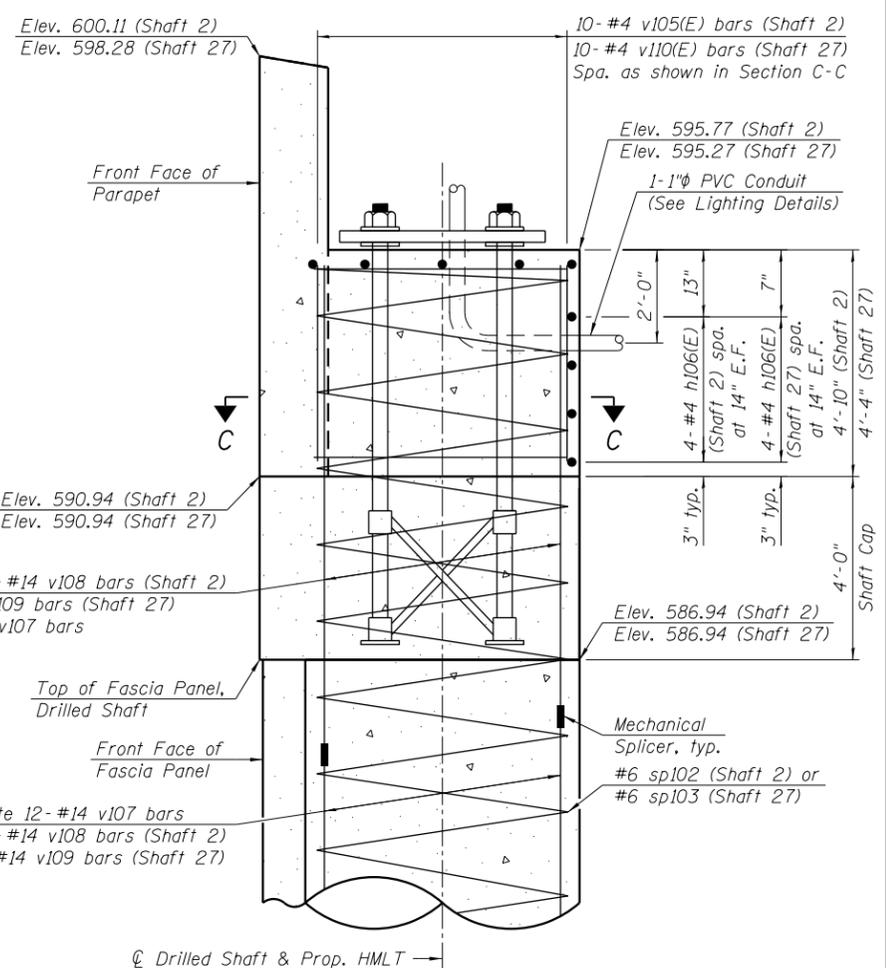


HMLT PEDESTAL ELEVATION

(Drilled Shafts 2 and 27 only)
(Parapet Reinforcement not shown for clarity)

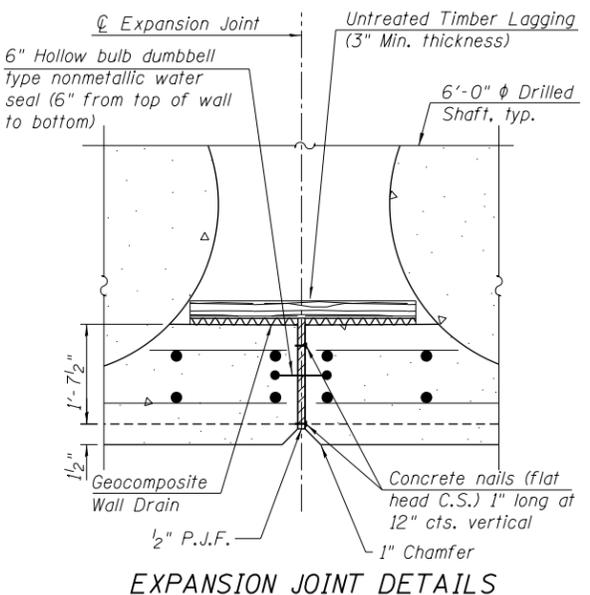

EXPANSION JOINT DETAILS

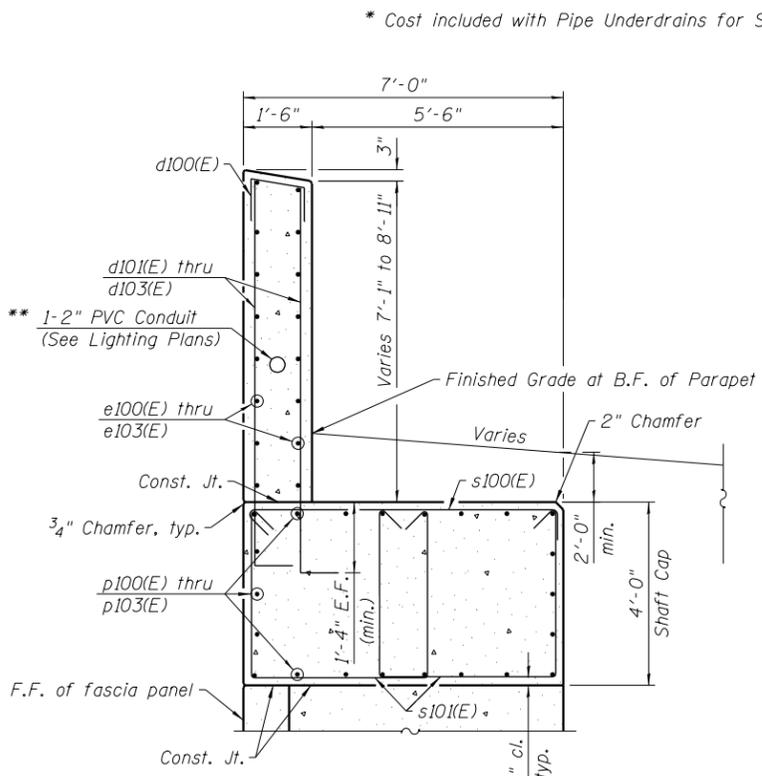


TYPICAL SECTION OF PARAPET AND CAP


(Shaft and fascia panel reinforcement not shown for clarity)

** Maintain 1/2\"/>

Notes:
F.F. = Front Face.
B.F. = Back Face.
E.F. = Each Face.
Work this sheet with Sheets S1-03 thru S1-06 of S1-15
The Polyurethane Sealant shall be according to Article 1050.04 of Std. Spec. and the color shall be gray.
HMLT Pedestal Concrete included in the cost of Concrete Superstructure.
For Anchor Rod Cage Details, see IDOT Standard BE-506.
Cost of Anchor Rod Cage and Grounding Conduit included in the cost of Concrete Superstructure.

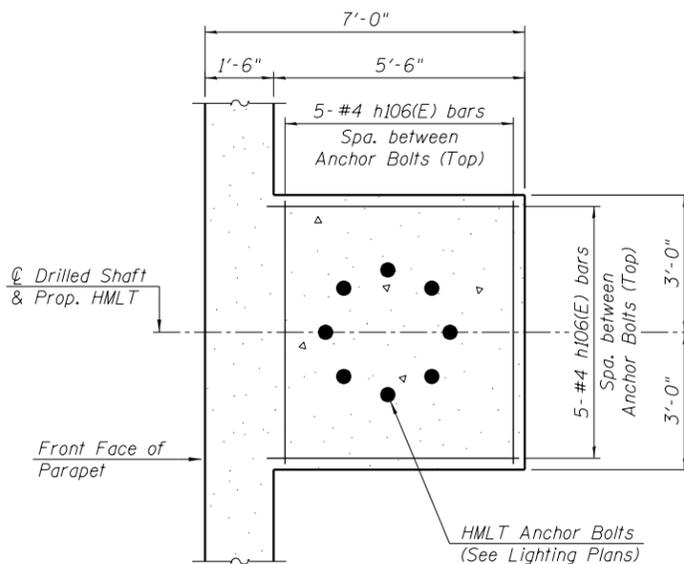

DETAIL D

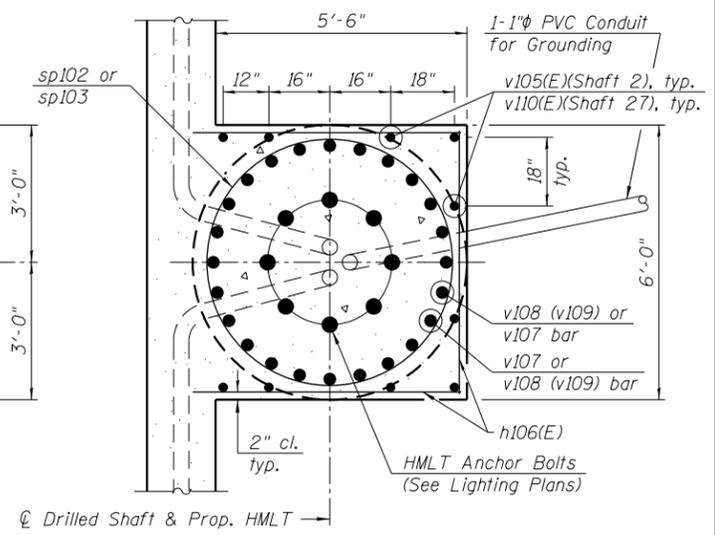

SECTION C-C

(Parapet Reinforcement not shown for clarity)

11:29:57 AM 0161827-62J31-S008-WallDetails-2.dgn



USER NAME = AJDINKEL	DESIGNED - KRS	REVISED -
PLOT SCALE = 0.1667' / in.	CHECKED - DJG	REVISED -
PLOT DATE = 8/27/2019	DRAWN - AJD	REVISED -
	CHECKED - KRS	REVISED -

**STATE OF ILLINOIS
DEPARTMENT OF TRANSPORTATION**

**WALL SECTIONS AND DETAILS 2
RETAINING WALL 38 (STRUCTURE NO. 016-1827)**

SHEET NO. S1-08 OF S1-15 SHEETS

F.A.I. RTE. 290	SECTION 2019-054-1	COUNTY COOK	TOTAL SHEETS 400	SHEET NO. 300
CONTRACT NO. ILLINOIS FED. AID PROJECT			62J31	