

STATE OF ILLINOIS
DEPARTMENT OF TRANSPORTATION

**PROPOSED
HIGHWAY PLANS**


FAI 57 AND WALDRON ROAD (FAU 6184)

**SECTION 139 HBR-6
PROJECT NHPP QL8L(443)**

**ROADWAY IMPROVEMENTS AND
BRIDGE REPLACEMENT
KANKAKEE COUNTY**

INDEX OF SHEETS

1		COVER SHEET
2		INDEX OF SHEETS, GENERAL NOTES, STANDARDS
3		SIGNATURE SHEET
4	TO 17	SUMMARY OF QUANTITIES
18	TO 20	TYPICAL SECTIONS
21	TO 22	REMOVAL SCHEDULE OF QUANTITIES
23		EARTHWORK SCHEDULE OF QUANTITIES
24		ROADWAY SCHEDULE QUANTITIES
25		MOT SCHEDULE OF QUANTITIES
26		EROSION CONTROL SCHEDULE OF QUANTITIES
27	TO 28	DRAINAGE SCHEDULE OF QUANTITIES
29		PMK AND SIGNING SCHEDULE OF QUANTITIES
30		ALIGNMENT, TIES, AND BENCHMARKS
31	TO 33	REMOVAL PLANS
34	TO 38	PLAN AND PROFILES
39		ADA RAMP PLAN
40	TO 69	SUGGESTED STAGES OF CONSTRUCTION
70	TO 72	EROSION AND SEDIMENT CONTROL PLANS
73	TO 78	DRAINAGE AND UTILITY PLANS
79		GRADING PLAN
80	TO 83	PLAT OF HIGHWAYS
84	TO 87	SIGNING AND PAVEMENT MARKING PLANS
88		SIGNING DETAIL
89		PAVEMENT MARKING DETAIL
90	TO 143	STRUCTURE SN 046-0153
144	TO 166	RETAINING WALLS A & B
167		BYCYCLE RAILING DETAIL
168		ROADWAY DETAIL
169	TO 170A	PAVEMENT CONNECTOR DETAIL
170B		CONCRETE BARRIER TRANSITION DETAIL
171		PATTERN
172	TO 184	CROSS SECTIONS, I-57
185	TO 199	CROSS SECTIONS, WALDRON ROAD
200	TO 202	CROSS SECTIONS, MUNI 2530

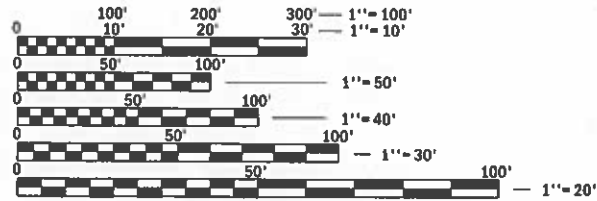


FULL SIZE PLANS HAVE BEEN PREPARED USING STANDARD
ENGINEERING SCALES. REDUCED SIZED PLANS WILL NOT
CONFORM TO STANDARD SCALES. IN MAKING MEASUREMENTS
ON REDUCED PLANS, THE ABOVE SCALES MAY BE USED.

J.U.L.I.E.
JOINT UTILITY LOCATION INFORMATION FOR EXCAVATION
1-800-892-0123
OR 811

DISTRICT 3 NO. (815) 434-6131
PROJECT ENGINEER: BRAD DUNCAN P.E.
UNIT CHIEF: LUIS CALDERON P.E.

CONTRACT NO. 66997

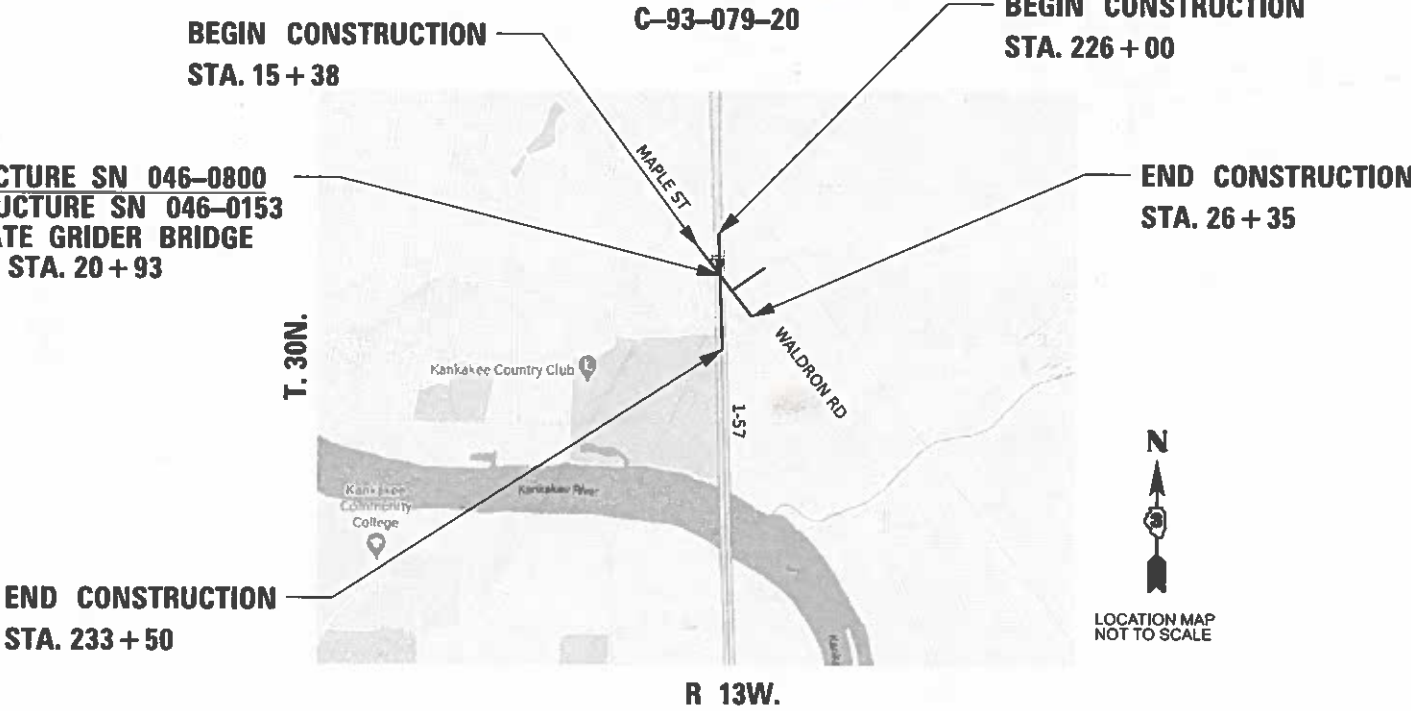

GROSS LENGTH = 2047.00 FT = 00.388 MILE
NET LENGTH = 2047.00 FT = 00.388 MILE

AS BUILTS

F.A.I. RTE.	SECTION	COUNTY	TOTAL SHEETS	SHEET NO.
57	139 HBR-6	KANKAKEE	202	1
CONTRACT NO. 66997				
ILLINOIS FED. AID PROJECT				

P-93-020-20 * 202+2= 204 TOTAL SHEETS
D-93-043-20
R-93-005-20



FUNCTIONAL CLASSIFICATION
MINOR ARTERIAL
2016 ADT = 4,770
INTERSTATE URBAN HIGHWAY
2016 ADT = 28,000
P.V. = 68% S.U. = 4% M.U. = 28%

STATE OF ILLINOIS
DEPARTMENT OF TRANSPORTATION

SUBMITTED March 24, 2021
Mark Almond REGIONAL ENGINEER
August 13, 2021
Scott A. Elk ENGINEER OF DESIGN AND ENVIRONMENT
August 13, 2021
James J. Quinn DIRECTOR OF HIGHWAYS PROJECT IMPLEMENTATION

PRINTED BY THE AUTHORITY
OF THE STATE OF ILLINOIS

GENERAL NOTES

THE HMA SURFACE OF ALL MAILBOX TURNOUTS, PRIVATE ENTRANCES, COMMERCIAL ENTRANCES, AND SIDE ROADS SHALL BE MADE NEATLY, IN A WORKMANLIKE MANNER, AND SHALL ACCURATELY CONFORM TO THE SHAPES AND DIMENSIONS SHOWN ON THE PLAN DETAILS. IF REQUIRED BY THE ENGINEER, THE CONTRACTOR SHALL SAW CUT THE HMA SURFACE TO CONFORM TO THE SHAPES AND DIMENSIONS SHOWN ON THE PLAN DETAILS. THIS WORK WILL BE INCLUDED IN THE COST OF THE HMA SURFACE.

THE BASE COURSE WIDENING SHALL BE CARRIED THROUGH ALL ENTRANCES, SIDE ROADS, AND MAILBOX TURNOUTS. EXCEPTIONS WILL BE SHOWN ON THE PLANS.

THE FINISHED EARTHWORK SHALL HAVE A VEGETATION SUSTAINING SOIL COVERING THE TOP FOUR INCHES (100 MILLIMETERS) IN AREAS TO BE SEEDED OR SODDED. THE VEGETATION SUSTAINING SOIL REQUIRED WILL NOT BE PAID FOR SEPARATELY BUT WILL BE INCLUDED IN THE COST OF TOPSOIL EXCAVATION AND PLACEMENT.

SHORT TERM PAVEMENT MARKING SHALL BE USED TO OUTLINE EXIT AND ENTRANCE RAMPS FOR THE PRIME COAT APPLICATION AND EACH RESURFACING LIFT.

ON EXISTING PAVEMENT WHICH MAY BE RESURFACED, THE NEW HMA PAVEMENT SHALL BE BUILT WITH THE SAME CROSS SLOPE UNLESS NEW CROSS SLOPE RATES ARE GIVEN ON THE PLANS.

ALL ELEVATIONS REFERRING TO U.S.G.S. MEAN SEA LEVEL DATUM.

UNLESS OTHERWISE NOTED IN THE PLAN SHEETS, STATIONS AND OFFSETS REFERENCES ARE FROM THE PROPOSED CENTERLINE OF THE PARTICULAR ROADWAY SHOWN.

THE ABANDONED AT&T CONDUIT ATTACHED TO THE BRIDGE DECK SHALL BE INCLUDED IN THE COST OF REMOVAL OF EXISTING STRUCTURES

THE CONTRACTOR'S ATTENTION IS DIRECTED TO THE PRESENCE OF DEPARTMENT-OWNED UNDERGROUND ELECTRICAL CABLE WITHIN THE LIMITS OF THE PROPOSED IMPROVEMENT. THE CONTRACTOR SHALL REQUEST THE ILLINOIS DEPARTMENT OF TRANSPORTATION IN OTTAWA (815-434-8417) TO LOCATE THE UNDERGROUND FACILITIES, PROVIDING A MINIMUM OF 72 HOURS NOTICE. THE DEPARTMENT IS NOT A MEMBER OF THE JOINT UTILITY LOCATING INFORMATION FOR EXCAVATORS (JULIE) SYSTEM.

ALL DAMAGE TO DEPARTMENT OWNED UNDERGROUND FACILITIES, CAUSED BY THE CONTRACTOR SHALL BE REPAIRED TO THE SATISFACTION OF THE ENGINEER AND AT NO EXPENSE TO THE DEPARTMENT. THIS SHALL INCLUDE ALL TEMPORARY REPAIRS REQUIRED TO KEEP THE FACILITY OPERATIONAL WHILE MATERIAL IS BEING OBTAINED TO MAKE PERMANENT REPAIRS. SPLICING OF ELECTRIC CABLE WILL NOT BE ALLOWED. ELECTRIC CABLE SHALL BE REPLACED FROM POLE TO POLE OR CONTROLLER.

THE WORK REQUIRED TO CONNECT ANY SEWER TO AN EXISTING DRAINAGE STRUCTURE OR PIPE WILL NOT BE PAID FOR SEPARATELY, BUT WILL BE CONSIDERED AS INCLUDED IN THE CONTRACT UNIT PRICE BID FOR THE SEWER ITEMS.

MEMBERS OF JULIE KNOWN TO BE WITHIN THE LIMITS OF THE IMPROVEMENT ARE: (SEE STATUS OF UTILITIES TO BE ADJUSTED SPECIAL PROVISION FOR CONTACT INFORMATION)

- 1. COMMONWEALTH EDISON COMPANY
- 2. AT&T
- 3. AQUA IL (WATER)
- 4. CMS (FIBER OPIC)
- 5. COMCAST
- 6. NICOR
- 7. CITY OF KANKAKEE (SANITARY SEWER)

THE CONTRACTOR SHALL CONTACT JULIE AT LEAST 48 HOURS PRIOR TO EXCAVATION TO DETERMINE WHICH UTILITIES ARE WITHIN THE AREA.

THE FOLLOWING RATES OF APPLICATION HAVE BEEN USED IN CALCULATING PLAN QUANTITIES:

GRANULAR MATERIALS	2.05	TONS / CU YD
SHORT TERM PAVEMENT MARKING	10	FT / 100 FT OF PROPOSED
HMA	SEE MIXTURE TABLE	

COMMITMENTS

DUE TO THE POSSIBLE PRESENCE OF THE INDIANA BAT AND NORTHERN LONG EARED BAT, TREES WITH A DIAMETER 3 INCHES OR GREATER AT BREAST HEIGHT WILL NOT BE CLEARED BETWEEN APRIL 1ST AND SEPTEMBER 30TH.

ENVIRONMENTAL COORDINATION

LETTER OF UNDERSTANDING

TRANSPORTATION MANAGEMENT PLAN

IDOT HIGHWAY STANDARDS

BLR 17-4	TRAFFIC CONTROL DEVICES - DAY LABOR CONSTRUCTION
BLR 25-1	TYPE 1A BARRICADE FOR NON-NHS ROUTES
BLR 28	CONCRETE CURB TYPE B AND COMBINATION CONCRETE CURB AND GUTTER
000001-08	STANDARD SYMBOLS, ABBREVIATIONS AND PATTERNS
001001-02	AREAS OF REINFORCEMENT BARS
001006	DECIMAL OF AN INCH AND OF A FOOT
202001-01	EARTH MEDIAN DITCH CHECK
280001-07	TEMPORARY EROSION CONTROL SYSTEMS
420001-09	PAVEMENT JOINTS
424001-11	PERPENDICULAR CURB RAMPS FOR SIDEWALKS
442201-03	CLASS C AND D PATCHES
515001-04	NAME PLATE FOR BRIDGES
542301-03	PRECAST REINFORCED CONCRETE FLARED END SECTION
602001-02	CATCH BASIN, TYPE A
602011-02	CATCH BASIN, TYPE C
602301-04	INLET, TYPE A
602401-07	PRECAST MANHOLE, TYPE A, 4' (1.22M) DIAMETER
602416-09	PRECAST MANHOLE, TYPE A, 8' (2.44 M) DIAMETER
604001-05	FRAME AND LIDS, TYPE 1
604041-03	FRAME AND GATE, TYPE 9
604101-01	MEDIAN INLET FOR 24 (600 MM) REINFORCED CONCRETE PIPE
630001-12	STEEL PLATE BEAM GUARDRAIL
630116	BACKSIDE PROTECTION OF GUARDRAIL
630301-09	SHOULDER WIDENING FOR TYPE 1 (SPECIAL) GUARDRAIL TERMINALS
631026-06	TRAFFIC BARRIER TERMINAL TYPE 5
631031-17	TRAFFIC BARRIER TERMINAL TYPE 6
635001-02	DELINEATORS
642001-02	SHOULDER RUMBLE STRIPS, 16 INCH
667101-02	PERMANENT SURVEY MARKER
701001-02	OFF-ROAD OPERATIONS, 2L, 2W, MORE THAN 15' (4.5M) AWAY
701006-05	OFF-ROAD OPERATIONS, 2L, 2W, 15' (4.5M) TO 24" (600MM) FROM PAVEMENT EDGE
701011-04	OFF-ROAD MOVING OPERATION, 2L, 2W, DAY ONLY
701201-05	LANE CLOSURE, 2L, 2W, DAY ONLY, FOR SPEED > 45 MPH
701301-04	LANE CLOSURE, 2L, 2W, SHORT TIME OPERATIONS
701321-18	LANE CLOSURE, 2L, 2W, BRIDGE REPAIR WITH BARRIER
701326-04	LANE CLOSURE, 2L, 2W, PAVEMENT WIDENING, FOR SPEED > 45 MPH
701400-10	APPROACH TO LANE CLOSURE, FREEWAY/EXPRESSWAY
701401-12	LANE CLOSURE, FREEWAY/EXPRESSWAY
701406-12	LANE CLOSURE, FREEWAY/EXPRESSWAY, DAY OPERATIONS ONLY
701901-08	TRAFFIC CONTROL DEVICES
704001-08	TEMPORARY CONCRETE BARRIER
720001-01	SIGN PANEL MOUNTING DETAILS
720006-04	SIGN PANEL ERECTION DETAILS
720011-01	METAL POSTS FOR SIGNS, MARKERS & DELINEATORS
725001-01	OBJECT AND TERMINAL MARKERS
782006-01	GUARDRAIL AND BARRIER WALL REFLECTOR MOUNTING DETAILS

STATE OF ILLINOIS
DEPARTMENT OF TRANSPORTATION

GENERAL NOTES,
STANDARDS AND COMMITMENTS

SCALE SHEET OF SHEETS STA. TO STA.

F.A.I. RTE.	SECTION	COUNTY	TOTAL SHEETS	SHEET NO.
57	139 HBR-6	KANKAKEE	202	2
CONTRACT NO. 86997				
ILLINOIS FED. AID PROJECT				

TRANSMART, INC.
THOMAS M. WALSH, P.E.
#062-054595

Thomas M. Walsh

DATE: 03/26/2021

SIGNATURE AND SEAL
APPLY TO DRAWINGS:
1-24, 27-28, 30-39
73-79, 167-202

EXPIRATION DATE: 11-30-2021



HUTCHISON ENGINEERING, INC.
LUKE D. ZELLER, P.E.
#062-064201

Luke D. Zeller

DATE: 03/26/2021

SIGNATURE AND SEAL
APPLY TO DRAWINGS:
25-26, 29, 40-72
84-89

EXPIRATION DATE: 11-30-2021



SIGNATURES AND SEALS THAT
APPLY TO DRAWINGS
80-83, 90-143, AND 144-166
ARE ON THE FIRST SHEET
OF THOSE RESPECTIVE DRAWINGS

STATE OF ILLINOIS
DEPARTMENT OF TRANSPORTATION
DISTRICT THREE
AS BUILT INFORMATION

ALAN HARWOOD
SUPERVISING CONSTRUCTION FIELD ENGINEER

SCOTT JULIAN
RESIDENT ENGINEER / TECHNICIAN

START & END DATES
OF CONSTRUCTION:

INSPECTORS: *DAVE MOLODIN*

GREGG PRAIRIE, MR GREEN

ADEL GHOLEH, QVIGG

KATOSKA SIMBALL

STATE OF ILLINOIS
DEPARTMENT OF TRANSPORTATION
DISTRICT THREE

PREPARED BY: _____
DISTRICT STUDIES & PLANS ENGINEER

DATE: _____

EXAMINED BY: _____
DISTRICT CONSTRUCTION ENGINEER

DISTRICT MATERIALS ENGINEER

DISTRICT OPERATIONS ENGINEER

STATE OF ILLINOIS
DEPARTMENT OF TRANSPORTATION

RE FIELD ENGINEER & DISTRICT STUDIES
SIGNATURE

SCALE: SHEET OF SHEETS STA. TO STA.

FAI RTE	SECTION	COUNTY	TOTAL SHEETS	SHEET NO.
57	139 MBR-6	KANKAKEE	202	3
CONTRACT NO. 66997				
ILLINOIS FED. AID PROJECT				

TranSmart
411 South Wells Street Suite 1000
Chicago, Illinois 60607

USER NAME	Resolution	DESIGNED	-	REVISED	-
		DRAWN	-	REVISED	-
PLOT SCALE	0.186608" = 1 ft.	CHECKED	-	REVISED	-
PLOT DATE	3/26/2021	DATE	2021/03/26	REVISED	-

CODE NO.	ITEM	UNIT	TOTAL QUANTITY	CONSTRUCTION CODE			
				NHPP 90% FED / 10% STATE	NHPP 90% FED / 10% STATE	NHPP 90% FED / 10% STATE	NHPP 90% FED / 10% STATE
				BRIDGE	RETAINING WALL	RETAINING WALL	ROADWAY
				0010 046-0153	0044 WALL A	0044 WALL B	0004 URBAN
			1844				
20100110	TREE REMOVAL (6 TO 15 UNITS DIAMETER)	UNIT	1003				1063
			960.2				
20100210	TREE REMOVAL (OVER 15 UNITS DIAMETER)	UNIT	283				333
20200100	EARTH EXCAVATION	CU YD	13720				13720
20800150	TRENCH BACKFILL	CU YD	940				940
			1312.5				
21101505	TOPSOIL EXCAVATION AND PLACEMENT	CU YD	1243				1245
			2123.2				
25000210	SEEDING, CLASS 2A	ACRE	2294.0				2.25
25000400	NITROGEN FERTILIZER NUTRIENT	POUND	180 353.5				190
25000500	PHOSPHORUS FERTILIZER NUTRIENT	POUND	180 353.5				190
25000600	POTASSIUM FERTILIZER NUTRIENT	POUND	180 353.5				190
25100115	MULCH, METHOD 2	ACRE	2.25				2.25
25100630	EROSION CONTROL BLANKET	SQ YD	9516	18900.8			9516
25100900	TURF REINFORCEMENT MAT	SQ YD	362	227.6			362
28000250	TEMPORARY EROSION CONTROL SEEDING	POUND	180				250
28000305	TEMPORARY DITCH CHECKS	FOOT	180	40.0			180
28000400	PERIMETER EROSION BARRIER	FOOT	2008	2039			2008

* SPECIALTY ITEMS

MODEL: Plan 1
FILE NAME: C:\Users\Bj\Documents\Bj_8001.dgn

TranSmart
4111 South Wells Street Suite 1000
Chicago, Illinois 60607

USER NAME	• nashirvan	DESIGNED	• BJD	REVISED	•
		DRAWN	• BJD	REVISED	•
PLOT SCALE	• 0.18000033" / in.	CHECKED	• TW	REVISED	•
PLOT DATE	• 3/29/2021	DATE	• 2021/03/26	REVISED	•

STATE OF ILLINOIS
DEPARTMENT OF TRANSPORTATION

I-57 & WALDRON ROAD
SUMMARY OF QUANTITIES

SCALE: NTS SHEET 1 OF 14 SHEETS STA. TO STA.

F.A.I. RTE.	SECTION	COUNTY	TOTAL SHEETS	SHEET NO.
57	138 HBR-6	KANKAKEE	202	4
CONTRACT NO. 66997				
ILLINOIS FED. AID PROJECT				

REV. 8/26/21 REV. 5/12/21 REV. 4/29/21 REV. 4/9/21

CODE NO.	ITEM	UNIT	TOTAL QUANTITY	CONSTRUCTION CODE			
				NHPP 90% FED / 10% STATE	NHPP 90% FED / 10% STATE	NHPP 90% FED / 10% STATE	NHPP 90% FED / 10% STATE
				BRIDGE	RETAINING WALL	RETAINING WALL	ROADWAY
				0010 046-0153	0044 WALL A	0044 WALL B	0004 URBAN
28000500	INLET AND PIPE PROTECTION	EACH	1				1
28000510	INLET FILTERS	EACH	18				18
28100105	STONE RIPRAP, CLASS A3	SQ YD	175	265.3			175
28200200	FILTER FABRIC	SQ YD	175	265.3			175
30300118	AGGREGATE SUBGRADE IMPROVEMENT 18"	SQ YD	2673	3146.1			2673
31100200	SUBBASE GRANULAR MATERIAL, TYPE A	CU YD	10009	488			10009
35100500	AGGREGATE BASE COURSE, TYPE A 6"	SQ YD	467	468.9			467
35501288	HOT-MIX ASPHALT BASE COURSE, 2 1/2"	SQ YD	58	51.9			58
35501308	HOT-MIX ASPHALT BASE COURSE, 6"	SQ YD	257	404.5			257
35600702	HOT-MIX ASPHALT BASE COURSE WIDENING, 6 1/2"	SQ YD	8				8
40201000	AGGREGATE FOR TEMPORARY ACCESS	TON	36				36
40603080	HOT-MIX ASPHALT BINDER COURSE, IL-19.0, N50	TON	118	205.5			118
40604050	HOT-MIX ASPHALT SURFACE COURSE, IL-9.5, MIX "C", N50	TON	81	60			81
40604060	HOT-MIX ASPHALT SURFACE COURSE, IL-9.5, MIX "D", N50	TON	79	293.6			79

* SPECIALTY ITEMS

INCHES: 1/8" = 1'
FEET: 1/4" = 1'

TransSmart
411 South Wells Street Suite 1000
Chicago, Illinois 60607

USER NAME	DESIGNED - BJD	REVISED -
PLOT SCALE - 1/8" = 100'	DRAWN - BJD	REVISED -
PLOT DATE - 3/29/2021	CHECKED - TW	REVISED -
	DATE - 2021/03/28	REVISED -

STATE OF ILLINOIS
DEPARTMENT OF TRANSPORTATION

I-57 & WALDRON ROAD
SUMMARY OF QUANTITIES

SCALE: SHEET 2 OF 14 SHEETS STA. TO STA.

F.A.I. RTE.	SECTION	COUNTY	TOTAL SHEETS	SHEET NO.
57	139 H&R-6	KANKAKEE	202	5
CONTRACT NO. 86997				

REV. 8/26/21 REV. 4/9/21

				CONSTRUCTION CODE			
				NHPP 90% FED / 10% STATE	NHPP 90% FED / 10% STATE	NHPP 90% FED / 10% STATE	NHPP 90% FED / 10% STATE
				BRIDGE	RETAINING WALL	RETAINING WALL	ROADWAY
				0010	0044	0044	0004
				046-0153	WALL A	WALL B	URBAN
CODE NO.	ITEM	UNIT	TOTAL QUANTITY				
40604170	POLYMERIZED HOT-MIX ASPHALT SURFACE COURSE, IL-9.5, MIX "E", N50	TON	330 φ				310
40700100	BITUMINOUS MATERIALS (TACK COAT)	POUND	954	3702.4			954
40701886	HOT-MIX ASPHALT PAVEMENT (FULL-DEPTH), 10 1/4"	SQ YD	2119	2278.7			2119
42000060	WELDED WIRE REINFORCEMENT	SQ YD	402	412.2			402
42000080	PAVEMENT CONNECTOR (PCC) FOR BRIDGE APPROACH SLAB	SQ YD	402	412.2			402
42001300	PROTECTIVE COAT	SQ YD	1181	355			1181
42400410	PORTLAND CEMENT CONCRETE SIDEWALK 8 INCH	SQ FT	331	339.9			331
* 42400800	DETECTABLE WARNINGS	SQ FT	56	54.6			56
44000100	PAVEMENT REMOVAL	SQ YD	2472	2784.5			2472
44000157	HOT-MIX ASPHALT SURFACE REMOVAL, 2"	SQ YD	2764	2738.7			2764
44000164	HOT-MIX ASPHALT SURFACE REMOVAL, 3 3/4"	SQ YD	922	1583.6			922
44000200	DRIVEWAY PAVEMENT REMOVAL	SQ YD	223	142			223
44000480	GUTTER REMOVAL	FOOT	358	654.5			358
44000500	COMBINATION CURB AND GUTTER REMOVAL	FOOT	508	701			508
44000600	SIDEWALK REMOVAL	SQ FT	27				27

SPECIALTY ITEMS

MODEL: Plan 1
FILE NAME: D:\66997\ENR_S0001.dgn

TranSmart
411 South Wells Street Suite 1000
Chicago, Illinois 60607

USER NAME = msharlan
PLOT SCALE = 0.16666633 / in.
PLOT DATE = 3/29/2021

DESIGNED - BJD
DRAWN - BJD
CHECKED - TW
DATE = 2021/03/26

REVISED -
REVISED -
REVISED -
REVISED -

STATE OF ILLINOIS
DEPARTMENT OF TRANSPORTATION

I-57 & WALDRON ROAD
SUMMARY OF QUANTITIES

SCALE: SHEET 3 OF 14 SHEETS STA. TO STA.

F.A.I. RTE.	SECTION	COUNTY	TOTAL SHEETS	SHEET NO.
57	139 HBR-6	KANKAKEE	202	6
CONTRACT NO. 66997				
ILLINOIS FED. AID PROJECT				

				CONSTRUCTION CODE			
				NHPP 90% FED / 10% STATE	NHPP 90% FED / 10% STATE	NHPP 90% FED / 10% STATE	NHPP 90% FED / 10% STATE
				BRIDGE	RETAINING WALL	RETAINING WALL	ROADWAY
				0010	0044	0044	0004
CODE NO.	ITEM	UNIT	TOTAL QUANTITY	046-0153	WALL A	WALL B	URBAN
44001980	CONCRETE BARRIER REMOVAL	FOOT	1007	1016			1081
44004250	PAVED SHOULDER REMOVAL	SQ YD	1109	896.5			1109
44200099	PAVEMENT PATCHING, TYPE III, 8 INCH	SQ YD	18	58.9			18
44200101	PAVEMENT PATCHING, TYPE IV, 8 INCH	SQ YD	25	41.2			25
48100500	AGGREGATE SHOULDERS, TYPE A 6"	SQ YD	75	58			75
48203021	HOT-MIX ASPHALT SHOULDERS, 6"	SQ YD	1449	1448.9			1449
50100100	REMOVAL OF EXISTING STRUCTURES	EACH	1	1			
50104400	CONCRETE HEADWALL REMOVAL	EACH	2				2
50105220	PIPE CULVERT REMOVAL	FOOT	26	1047			26
50157300	PROTECTIVE SHIELD	SQ YD	443	378.2	443		
50200100	STRUCTURE EXCAVATION	CU YD	2046	775	833	438	
50200400	ROCK EXCAVATION FOR STRUCTURES	CU YD	102	172.1	102		380
50300225	CONCRETE STRUCTURES	CU YD	366.4	868.1	277.6	146.2	
50300255	CONCRETE SUPERSTRUCTURE	CU YD	508.1	511.6	508.1		

* SPECIALTY ITEMS

MODEL: Plan 1
FILE NAME: D08883 BLS_5004.dgn

TranSmart
411 South Wells Street Suite 1000
Chicago, Illinois 60607

USER NAME : nashlan
PLOT SCALE : 0.18888933" / ft.
PLOT DATE : 3/29/2021

DESIGNED : BJD
DRAWN : BJD
CHECKED : TW
DATE : 2021/03/28

REVISED :
REVISED :
REVISED :
REVISED :

STATE OF ILLINOIS
DEPARTMENT OF TRANSPORTATION

I-57 & WALDRON ROAD
SUMMARY OF QUANTITIES

SCALE: SHEET 4 OF 14 SHEETS STA. TO STA.

F.A.I. RTE.	SECTION	COUNTY	TOTAL SHEETS	SHEET NO.
57	139 HBR-6	KANKAKEE	202	7
CONTRACT NO. 68997				
ILLINOIS FED. AID PROJECT				

URBAN				CONSTRUCTION CODE			
				NHPP 90% FED / 10% STATE	NHPP 90% FED / 10% STATE	NHPP 90% FED / 10% STATE	NHPP 90% FED / 10% STATE
				BRIDGE	RETAINING WALL	RETAINING WALL	ROADWAY
				0010	0044	0044	0004
				046-0153	WALL A	WALL B	URBAN
CODE NO.	ITEM	UNIT	TOTAL QUANTITY				
50300260	BRIDGE DECK GROOVING	SQ YD	1324 1099	1324			
50300300	PROTECTIVE COAT	SQ YD	1961 2022.2	1961			
50500105	FURNISHING AND ERECTING STRUCTURAL STEEL	L SUM	1	1			
50500505	STUD SHEAR CONNECTORS	EACH	11710	9389	1615	706	
50800205	REINFORCEMENT BARS, EPOXY COATED	POUND	208540 204014	208540	52950	29370	
50800515	BAR SPLICERS	EACH	1167 1109	1167			
50901720	BICYCLE RAILING	FOOT	469 471.9				469
50901730	BRIDGE FENCE RAILING	FOOT	324 343.5	324			
50901750	PARAPET RAILING	FOOT	324 363.5	334			
51100100	SLOPE WALL 4 INCH	SQ YD	43 91.5	43			
51500100	NAME PLATES	EACH	1	1			
* 51603000	DRILLED SHAFT IN SOIL	CU YD	87.3 94.8	87.3			
* 51604000	DRILLED SHAFT IN ROCK	CU YD	51.2 40.0	51.2			
52000110	PREFORMED JOINT STRIP SEAL	FOOT	158	158			

* SPECIALTY ITEMS

MODEL: Plan 1
FILE NAME: COMB133.DWG, 5008.dwg

TranSmart
411 South Wells Street Suite 1000
Chicago, Illinois 60607

USER NAME : nashirah
PLOT SCALE : 0.18000033 / in.
PLOT DATE : 3/29/2021

DESIGNED : BJD
DRAWN : BJD
CHECKED : TW
DATE : 2021/03/26

REVISED :
REVISED :
REVISED :
REVISED :

STATE OF ILLINOIS
DEPARTMENT OF TRANSPORTATION

I-57 & WALDRON ROAD
SUMMARY OF QUANTITIES

SCALE: SHEET 5 OF 14 SHEETS STA. TO STA.

F.A.I. RTE.	SECTION	COUNTY	TOTAL SHEETS	SHEET NO.
57	130 HBR-6	KANKAKEE	202	8
CONTRACT NO. 66997				
ILLINOIS FED. AID PROJECT				

				CONSTRUCTION CODE			
				NHPP 90% FED / 10% STATE	NHPP 90% FED / 10% STATE	NHPP 90% FED / 10% STATE	NHPP 90% FED / 10% STATE
				BRIDGE	RETAINING WALL	RETAINING WALL	ROADWAY
				0010	0044	0044	0004
CODE NO.	ITEM	UNIT	TOTAL QUANTITY	046-0153	WALL A	WALL B	URBAN
52100010	ELASTOMERIC BEARING ASSEMBLY, TYPE I	EACH	12	12			
52100530	ANCHOR BOLTS, 1 1/4"	EACH	24	24			
52100540	ANCHOR BOLTS, 1 1/2"	EACH	12	12			
52200020	TEMPORARY SOIL RETENTION SYSTEM	SQ FT	2050	835	640		1410
52200105	FURNISHING SOLDIER PILES (W SECTION)	FOOT	3542	8516.86	266	2390	856
52200200	DRILLING AND SETTING SOLDIER PILES (IN SOIL)	CU FT	11710	1034.9	984	8739	1987
52200205	DRILLING AND SETTING SOLDIER PILES (IN ROCK)	CU FT	6492	6744.5	351	3593	2488
52200250	UNTREATED TIMBER LAGGING	SQ FT	5575	8567.27		6234	3345
542A5509	PIPE CULVERTS, CLASS A, TYPE 1 EQUIVALENT ROUND-SIZE 54"	FOOT	588	600.2			589
54213657	PRECAST REINFORCED CONCRETE FLARED END SECTIONS 12"	EACH	4				4
54213660	PRECAST REINFORCED CONCRETE FLARED END SECTIONS 15"	EACH	3				3
550A0050	STORM SEWERS, CLASS A, TYPE 1 12"	FOOT	96	94.5			96
550A0070	STORM SEWERS, CLASS A, TYPE 1 15"	FOOT	268	254.5			268
550A0340	STORM SEWERS, CLASS A, TYPE 2 12"	FOOT	208	210.8			209

* SPECIALTY ITEMS

MODEL: PLOT1
FILE NAME: C:\WORK\BID_6008.dgn

TranSmart
411 South Wells Street Suite 1000
Chicago, Illinois 60607

USER NAME	= rescheyan	DESIGNED	= BJD	REVISED	=
PLOT SCALE	= 0.10000033' / in.	DRAWN	= BJD	REVISED	=
PLOT DATE	= 3/29/2021	CHECKED	= TW	REVISED	=
		DATE	= 2021/03/26	REVISED	=

STATE OF ILLINOIS
DEPARTMENT OF TRANSPORTATION

I-57 & WALDRON ROAD
SUMMARY OF QUANTITIES

SCALE: SHEET 6 OF 14 SHEETS STA. TO STA.

F.A.I. RTE.	SECTION	COUNTY	TOTAL SHEETS	SHEET NO.
57	139 HBR-6	KANKAKEE	202	9
CONTRACT NO. 66997				

REV. 8/26/21 REV. 5/12/21 REV. 4/29/21 REV. 4/9/21

CODE NO.	ITEM	UNIT	TOTAL QUANTITY	CONSTRUCTION CODE			
				NHPP 90% FED / 10% STATE	NHPP 90% FED / 10% STATE	NHPP 90% FED / 10% STATE	NHPP 90% FED / 10% STATE
				BRIDGE	RETAINING WALL	RETAINING WALL	ROADWAY
				0010 046-0153	0044 WALL A	0044 WALL B	0004 URBAN
550A0360	STORM SEWERS, CLASS A, TYPE 2 15"	FOOT	190	369			190
550A0380	STORM SEWERS, CLASS A, TYPE 2 18"	FOOT	282	302.5			282
550A0640	STORM SEWERS, CLASS A, TYPE 3 12"	FOOT	34	36			34
550A0660	STORM SEWERS, CLASS A, TYPE 3 15"	FOOT	120	124			120
55100500	STORM SEWER REMOVAL 12"	FOOT	116	56			116
58600101	GRANULAR BACKFILL FOR STRUCTURES	CU YD	439	292.6	439		
58700300	CONCRETE SEALER	SQ FT	15673	14657.5	2780	8395	4388
59100100	GEOCOMPOSITE WALL DRAIN	SQ YD	230	834.85	230	473	268
60108501	PIPE UNDERDRAINS, TYPE 3	FOOT	63	35			63
60200105	CATCH BASINS, TYPE A, 4'-DIAMETER, TYPE 1 FRAME, OPEN LID	EACH	8				8
60209005	CATCH BASINS, TYPE C, WITH MEDIAN INLET (604101)	EACH	1				1
60218300	MANHOLES, TYPE A, 4'-DIAMETER, TYPE 1 FRAME, OPEN LID	EACH	4				4
60218400	MANHOLES, TYPE A, 4'-DIAMETER, TYPE 1 FRAME, CLOSED LID	EACH	5				5
60224459	MANHOLES, TYPE A, 8'-DIAMETER, TYPE 1 FRAME, CLOSED LID	EACH	5				5

* SPECIALTY ITEMS

MODEL: PWS 1
FILE NAME: C:\WORKS\SH\6007.dgn

TranSmart
411 South Wells Street Suite 1000
Chicago, Illinois 60607

USER NAME = maclelan	DESIGNED - BJD	REVISED -
	DRAWN - BJD	REVISED -
PLOT SCALE = 0.10000000 1/8"	CHECKED - TW	REVISED -
PLOT DATE = 3/28/2021	DATE - 2021/03/28	REVISED -

STATE OF ILLINOIS
DEPARTMENT OF TRANSPORTATION

I-57 & WALDRON ROAD
SUMMARY OF QUANTITIES

SCALE: SHEET 7 OF 14 SHEETS STA. TO STA.

F.A.I. RTE.	SECTION	COUNTY	TOTAL SHEETS	SHEET NO.
57	139 HBR-6	KANKAKEE	202	10
CONTRACT NO. 66997				

REV. 8/26/21 REV. 4/9/21

				CONSTRUCTION CODE			
				NHPP 90% FED / 10% STATE	NHPP 90% FED / 10% STATE	NHPP 90% FED / 10% STATE	NHPP 90% FED / 10% STATE
				BRIDGE	RETAINING WALL	RETAINING WALL	ROADWAY
				0010	0044	0044	0004
CODE NO.	ITEM	UNIT	TOTAL QUANTITY	046-0153	WALL A	WALL B	URBAN
60234200	INLETS, TYPE A, TYPE 1 FRAME, OPEN LID	EACH	5				5
60236600	INLETS, TYPE A, TYPE 9 FRAME AND GRATE	EACH	1				1
60406000	FRAMES AND LIDS, TYPE 1, OPEN LID	EACH	6 0				6
60500050	REMOVING CATCH BASINS	EACH	2 3				2
60500060	REMOVING INLETS	EACH	2				2
60602500	CONCRETE GUTTER, TYPE A	FOOT	180 188				190
60602800	CONCRETE GUTTER, TYPE B	FOOT	900 993.9				900
60603800	COMBINATION CONCRETE CURB AND GUTTER, TYPE B-6.12	FOOT	574 643.9				574
60605000	COMBINATION CONCRETE CURB AND GUTTER, TYPE B-6.24	FOOT	965 972				965
63000001	STEEL PLATE BEAM GUARDRAIL, TYPE A, 6 FOOT POSTS	FOOT	150 125				150
63000035	BACK SIDE PROTECTION OF GUARDRAIL	FOOT	207 181.5				207
63100070	TRAFFIC BARRIER TERMINAL, TYPE 5	EACH	2				2
63100085	TRAFFIC BARRIER TERMINAL, TYPE 6	EACH	2				2
63100167	TRAFFIC BARRIER TERMINAL, TYPE 1 (SPECIAL) TANGENT	EACH	4				4

• SPECIALTY ITEMS

MODEL: PWA 1
FILE NAME: D:\66983_01N_5003.dgn

TransSmart
411 South Wells Street Suite 1000
Chicago, Illinois 60607

USER NAME : rmlshen
PLOT SCALE : 0.10000000 / IN.
PLOT DATE : 3/29/2021

DESIGNED : BJD
DRAWN : BJD
CHECKED : TW
DATE : 2021/03/28

REVISED :
REVISED :
REVISED :
REVISED :

STATE OF ILLINOIS
DEPARTMENT OF TRANSPORTATION

I-57 & WALDRON ROAD
SUMMARY OF QUANTITIES

SCALE: SHEET 8 OF 14 SHEETS STA. TO STA.

F.A.I. RTE.	SECTION	COUNTY	TOTAL SHEETS	SHEET NO.
57	139 HBR-6	KANKAKEE	202	11
CONTRACT NO. 66987				
ILLINOIS FED. AID PROJECT				

REV. 4/9/21

				CONSTRUCTION CODE			
				NHPP 90% FED / 10% STATE	NHPP 90% FED / 10% STATE	NHPP 90% FED / 10% STATE	NHPP 90% FED / 10% STATE
				BRIDGE	RETAINING WALL	RETAINING WALL	ROADWAY
				0010	0044	0044	0004
CODE NO.	ITEM	UNIT	TOTAL QUANTITY	046-0153	WALL A	WALL B	URBAN
63200310	GUARDRAIL REMOVAL	FOOT	1130				1130
63700805	CONCRETE BARRIER TRANSITION	FOOT	50	86			50
63800910	MODULAR GLARE SCREEN SYSTEM, PERMANENT	FOOT	50	84.5			50
63700900	CONCRETE BARRIER BASE	FOOT	50	86			50
64200116	SHOULDER RUMBLE STRIPS, 16 INCH	FOOT	3109	8603			3109
64300260	IMPACT ATTENUATORS (FULLY REDIRECTIVE, NARROW), TEST LEVEL 3	EACH	1				1
64301090	ATTENUATOR BASE	SQ YD	10	0			10
* 66700205	PERMANENT SURVEY MARKERS, TYPE I	EACH	1				1
* 66900200	NON-SPECIAL WASTE DISPOSAL	CU YD	780	0			780
* 66900530	SOIL DISPOSAL ANALYSIS	EACH	3				3
* 66901001	REGULATED SUBSTANCES PRE-CONSTRUCTION PLAN	LSUM	1				1
* 66901003	REGULATED SUBSTANCES FINAL CONSTRUCTION REPORT	LSUM	1				1
* 66901006	REGULATED SUBSTANCES MONITORING	CAL DA	58	62			58
67000400	ENGINEER'S FIELD OFFICE, TYPE A	CAL MO	18				18
67100100	MOBILIZATION	L SUM	1				1
70100405	TRAFFIC CONTROL AND PROTECTION, STANDARD 701321	EACH	1				1
70100700	TRAFFIC CONTROL AND PROTECTION, STANDARD 701406	L SUM	1				1

* SPECIALTY ITEMS

MODEL: Plan 1
FILE NAME: C086953.dwg, 3/29/2021

TranSmart
411 South Wells Street Suite 1000
Chicago, Illinois 60607

USER NAME : mshahin
PLOT SCALE : 0.1800000033" = 1'-0"
PLOT DATE : 3/29/2021

DESIGNED : BJD
DRAWN : BJD
CHECKED : TW
DATE : 2021/03/26

REVISED :
REVISED :
REVISED :
REVISED :

STATE OF ILLINOIS
DEPARTMENT OF TRANSPORTATION

I-57 & WALDRON ROAD
SUMMARY OF QUANTITIES

SCALE: SHEET 9 OF 14 SHEETS STA. TO STA.

F.A.I. RTE.	SECTION	COUNTY	TOTAL SHEETS	SHEET NO.
57	130 HBR-6	KANKAKEE	202	12
CONTRACT NO. 66997				
ILLINOIS FED. AID PROJECT				

				CONSTRUCTION CODE			
				NHPP 90% FED / 10% STATE	NHPP 90% FED / 10% STATE	NHPP 90% FED / 10% STATE	NHPP 90% FED / 10% STATE
				BRIDGE	RETAINING WALL	RETAINING WALL	ROADWAY
				0010	0044	0044	0004
CODE NO.	ITEM	UNIT	TOTAL QUANTITY	046-0153	WALL A	WALL B	URBAN
70103815	TRAFFIC CONTROL SURVEILLANCE	CAL DA	300	407.18			300
70106500	TEMPORARY BRIDGE TRAFFIC SIGNALS	EACH	1				1
70107025	CHANGEABLE MESSAGE SIGN	CAL DA	840	454			840
70200100	NIGHTTIME WORK ZONE LIGHTING	L SUM	1				1
70300100	SHORT TERM PAVEMENT MARKING	FOOT	4379	0			4379
70300150	SHORT TERM PAVEMENT MARKING REMOVAL	SQ FT	731	0			731
70300220	TEMPORARY PAVEMENT MARKING - LINE 4"	FOOT	8200	5252.5			8200
70300280	TEMPORARY PAVEMENT MARKING - LINE 24"	FOOT	156	34			156
70300904	PAVEMENT MARKING TAPE, TYPE IV 4"	FOOT	92430	8564			92430
70400100	TEMPORARY CONCRETE BARRIER	FOOT	5825	4425			5825
70400200	RELOCATE TEMPORARY CONCRETE BARRIER	FOOT	4175	987.5			4175
70600250	IMPACT ATTENUATORS, TEMPORARY (NON- REDIRECTIVE), TEST LEVEL 3	EACH	11	2			11
70600260	IMPACT ATTENUATORS, TEMPORARY (FULLY REDIRECTIVE, NARROW), TEST LEVEL 3	EACH	4	8			4
70600332	IMPACT ATTENUATORS, RELOCATE (FULLY REDIRECTIVE, NARROW), TEST LEVEL 3	EACH	3	1			3

SPECIALTY ITEMS

MODEL: Plan 1
FILE NAME: D:\385933_00_00010.dwg

TranSmart
411 South Wells Street Suite 1000
Chicago, Illinois 60607

USER NAME : rnsdhan
PLOT SCALE : 0.18888833' / in.
PLOT DATE : 3/29/2021

DESIGNED - BJD
DRAWN - BJD
CHECKED - TW
DATE - 2021/03/28

REVISED -
REVISED -
REVISED -
REVISED -

STATE OF ILLINOIS
DEPARTMENT OF TRANSPORTATION

I-57 & WALDRON ROAD
SUMMARY OF QUANTITIES

SCALE: SHEET 10 OF 14 SHEETS STA. TO STA.

FAI RTE	SECTION	COUNTY	TOTAL SHEETS	SHEET NO.
57	139 HBR-6	KANKAKEE	202	13
CONTRACT NO. 68997				
ILLINOIS FED. AID PROJECT				

				CONSTRUCTION CODE			
				NHPP 90% FED / 10% STATE	NHPP 90% FED / 10% STATE	NHPP 90% FED / 10% STATE	NHPP 90% FED / 10% STATE
				BRIDGE	RETAINING WALL	RETAINING WALL	ROADWAY
				0010 046-0153	0044 WALL A	0044 WALL B	0004 URBAN
CODE NO.	ITEM	UNIT	TOTAL QUANTITY				
70600350	IMPACT ATTENUATORS, RELOCATE (NON- REDIRECTIVE), TEST LEVEL 3	EACH	21	1			21
X9300100	HMA SURF C&E 1L9.5. MIX D, N70	TON	239.78				
72000100	SIGN PANEL - TYPE 1	SQ FT	42	42.5			43
X9300101	STRUCT STEEL FHL PLATES	EA	2.0				
72000200	SIGN PANEL - TYPE 2	SQ FT	20				20
X9300500	REPL Ty 1 w/ IN F&G	EA	14				
72400100	REMOVE SIGN PANEL ASSEMBLY - TYPE A	EACH	6				6
X9302700	CHAIN LINK FENCE, 6'	FOOT	850.5				
72501000	TERMINAL MARKER - DIRECT APPLIED	EACH	8	4			8
X9302900	MOD. URETHANE PAINT MARK LINE - 4"	FOOT	832				
73000100	WOOD SIGN SUPPORT	FOOT	127	133.5			127
X9304000	ANTI-GRAFFITI TREATMENT	SF	9640.8				
78000200	THERMOPLASTIC PAVEMENT MARKING - LINE 4"	FOOT	2273	13071.4			2273
X9304001	TCP SHLDR CLOSURES	LSUM	1.0				
78000400	THERMOPLASTIC PAVEMENT MARKING - LINE 6"	FOOT	342	358.5			442
XXX16100	CREDIT Non-Compliant Work	\$	450				
78000600	THERMOPLASTIC PAVEMENT MARKING - LINE 12"	FOOT	185	177			165
78008210	POLYUREA PAVEMENT MARKING TYPE I - LINE 4"	FOOT	10566	0			10556
78008230	POLYUREA PAVEMENT MARKING TYPE I - LINE 6"	FOOT	110	0			110
78100100	RAISED REFLECTIVE PAVEMENT MARKER	EACH	128	188			123
78200005	GUARDRAIL REFLECTORS, TYPE A	EACH	18	11			16
78300200	RAISED REFLECTIVE PAVEMENT MARKER REMOVAL	EACH	123	0			123

SPECIALTY ITEMS

MODEL: Pw1
FILE NAME: 030803 EN 50211.dgn

TranSmart
411 South Wells Street Suite 1000
Chicago, Illinois 60607

USER NAME	DESIGNED	REVISED
BJD	BJD	
PLOT SCALE	CHECKED	REVISED
3/29/2021	TW	
PLOT DATE	DATE	REVISED
3/29/2021	2021/03/26	

STATE OF ILLINOIS
DEPARTMENT OF TRANSPORTATION

I-57 & WALDRON ROAD
SUMMARY OF QUANTITIES

SCALE: SHEET 11 OF 14 SHEETS STA. TO STA.

SECTION	COUNTY	TOTAL SHEETS	SHEET NO.
139 HBR-6	KANKAKEE	202	14
CONTRACT NO. 68997			

CODE NO.	ITEM	UNIT	TOTAL QUANTITY	CONSTRUCTION CODE			
				NHPP 90% FED / 10% STATE	NHPP 90% FED / 10% STATE	NHPP 90% FED / 10% STATE	NHPP 90% FED / 10% STATE
				BRIDGE	RETAINING WALL	RETAINING WALL	ROADWAY
				0010 046-0153	0044 WALL A	0044 WALL B	0004 URBAN
	URBAN						
X0326208	ALTERNATE ROUTE SIGNING	L SUM	1				1
FR000300	GR REPAIR	\$	5715.48				
X0326649	LINEAR DELINEATOR PANELS, 6 INCH	EACH	20	15			20
FR000400	ELEC. POLE REM.	\$	1600.84				
X0326880	MESSAGE BOARD VEHICLE DRIVER	HOUR	1020	124.5			1920
FR000800	SAN. SEWER ADJ.	\$	4760.87				
X0326907	PORTABLE, VEHICLE MOUNTED, CHANGEABLE MESSAGE SIGN	CAL MO	38	1			15
FR000900	PIPE DRAIN	\$	35816.46				
X0327809	LINEAR DELINEATOR PANELS, 4 INCH	EACH	8				8
FR001000	TIE BARS	\$	3069.77				
78300202	PAVEMENT MARKING REMOVAL - WATER BLASTING	SQ FT	558	815.9			558
FR001100	HMA SHOULDER, SPL	\$	20099.34				
X0327991	REMOVAL OF EXISTING PROTECTIVE SHIELD	SQ YD	387	398.2	391		
FR001300	DETOUR SIGNS WALDRON	\$	683.39				
X0328004	REAL-TIME TRAFFIC CONTROL SENSOR UNIT	WEEK	240	151.72			240
FR001400	RESBT PRECAST APP SLABS	\$	15892.12				
X0900020	THERMAL INTEGRITY PROFILE TESTING	EACH	12	12			
FR001500	TEMP STEEL PLATES	\$	6409.26				
X0900044	THERMAL INTEGRITY PROFILE DATA COLLECTION	FOOT	313	313			
FR001600	STEEL PLATE MH LID	\$	2157.65				
X2700001	TEMPORARY RUMBLE STRIPS (SPECIAL)	EACH	6	6			8
X2700006	PREFORMED PLASTIC PAVEMENT MARKING, TYPE D - LINE 4"	FOOT	1230				1230
X2700010	PREFORMED PLASTIC PAVEMENT MARKING, TYPE D - LINE 6"	FOOT	1230	1570			1230
X2700015	PREFORMED PLASTIC PAVEMENT MARKING, TYPE D - LINE 24"	FOOT	41	32.6			41
X4810200	AGGREGATE SHOULDER REMOVAL	CU YD	67	42.6			67

* SPECIALTY ITEMS

MODEL: P101
FILE NAME: C:\WORK\1000\1000.DWG

TranSmart
411 South Wells Street Suite 1000
Chicago, Illinois 60607

USER NAME - nash/ten	DESIGNED - BJD	REVISED -
PLOT/SCALE - 0.18000033 / in.	DRAWN - BJD	REVISED -
PLOT DATE - 3/29/2021	CHECKED - YW	REVISED -
	DATE - 2021/03/26	REVISED -

STATE OF ILLINOIS
DEPARTMENT OF TRANSPORTATION

I-57 & WALDRON ROAD
SUMMARY OF QUANTITIES

SCALE: SHEET 12 OF 14 SHEETS STA. TO STA.

F.A.I. RTE.	SECTION	COUNTY	TOTAL SHEETS	SHEET NO.
	138 HBR-6	KANKAKEE	202	15
CONTRACT NO. 66997				

REV. 8/27/21 REV. 4/29/21 REV. 4/9/21

				CONSTRUCTION CODE			
URBAN				NHPP 90% FED / 10% STATE	NHPP 90% FED / 10% STATE	NHPP 90% FED / 10% STATE	NHPP 90% FED / 10% STATE
CODE NO.	ITEM	UNIT	TOTAL QUANTITY	BRIDGE	RETAINING WALL	RETAINING WALL	ROADWAY
				0010	0044	0044	0004
				046-0153	WALL A	WALL B	URBAN
X5030305	CONCRETE WEARING SURFACE, 5"	SQ YD	299	299			
FR001800	SOLDIER PILE SPACE	\$	1081.68				
X5040100	PRECAST BRIDGE APPROACH SLAB	SQ FT	2804	2636.6	2604		
X6380207	GLARE SCREEN REPAIR	EACH	35	554			35
X7010216	TRAFFIC CONTROL AND PROTECTION, (SPECIAL)	L SUM	1				1
FR001900	DRAIN STRUC 3' MH	\$	2687.62				
X7010239	CHANGEABLE MESSAGE SIGN, SPECIAL	CAL WK	840	531.02			840
FR002200	RELOCATE TL DEVICES NB ST	\$	3600.31				
X7010805	TRAFFIC CONTROL AND PROTECTION, STANDARD 701401 (SPECIAL)	L SUM	1				1
FR002400	GRIND CROWN OF APP SLAB SECT	\$	669.78				
X7030005	TEMPORARY PAVEMENT MARKING REMOVAL	SQ FT	33597	3095.9			33597
FR002500	DRAIN SWALE	\$	1973.39				
X7040125	SPINNING TEMPORARY CONCRETE BARRIER	EACH	729	309			729
FR003200	TEMP RAMPS	\$	1196.98				
X7830070	GROOVING FOR RECESSED PAVEMENT MARKING 5"	FOOT	11997	13903.4			11997
FR003300	DECK PROFILE GRIND	\$	5322.93				
X7830074	GROOVING FOR RECESSED PAVEMENT MARKING 7"	FOOT	1580	1840			1580
FR003400	LANDSCAPE REPAIR	\$	5068.81				
X8570002	SMART TRAFFIC MONITORING SYSTEM	CAL WK	120	75.86			120
FR003600	EX MH CLEANING	\$	886.57				
X8570004	SMART TRAFFIC MONITORING DEVICE	CAL WK	600	379.3			600
FR003700	BRUSH REM LEFT ROAD	\$	347.75				
Z0013798	CONSTRUCTION LAYOUT	L SUM	1				1
FR003800	BARRIER WALL INSTALL	\$	56070.96				
Z0018700	DRAINAGE STRUCTURE TO BE REMOVED	EACH	1				1
Z0022800	FENCE REMOVAL	FOOT	110	886			110

* SPECIALTY ITEMS

MODEL: Plan 1
FILE NAME: D:\00005 BR 50013.dgn

TranSmart
411 South Wells Street Suite 1000
Chicago, Illinois 60607

USER NAME = resolution	DESIGNED = BJD	REVISED =
	DRAWN = BJD	REVISED =
PLOT SCALE = 0.18888833 1/in.	CHECKED = TW	REVISED =
PLOT DATE = 3/29/2021	DATE = 2021/03/26	REVISED =

STATE OF ILLINOIS
DEPARTMENT OF TRANSPORTATION

I-57 & WALDRON ROAD
SUMMARY OF QUANTITIES

SCALE SHEET 13 OF 14 SHEETS STA. TO STA.

F.A.I RTE.	SECTION	COUNTY	TOTAL SHEETS	SHEET NO.
	139 HBR-0	KANKAKEE	202	18
CONTRACT NO. 66997				
ILLINOIS FED. AID PROJECT				

REV. 5/12/21 REV. 4/29/21 REV. 4/9/21

				CONSTRUCTION CODE			
				NHPP 90% FED / 10% STATE	NHPP 90% FED / 10% STATE	NHPP 90% FED / 10% STATE	NHPP 90% FED / 10% STATE
				BRIDGE	RETAINING WALL	RETAINING WALL	ROADWAY
				0010	0044	0044	0004
CODE NO.	ITEM	UNIT	TOTAL QUANTITY	046-0153	WALL A	WALL B	URBAN
Z0030850	TEMPORARY INFORMATION SIGNING	SQ FT	42				42
Z0046304	PIPE UNDERDRAINS FOR STRUCTURES 4"	FOOT	1372	1852.5	352	660	360
Z0056608	STORM SEWER (WATER MAIN REQUIREMENTS) 12 INCH	FOOT	29	22.94			29
Ø Z0076600	TRAINEES	HOUR	2,000	2895			2,000
Z0056610	STORM SEWER (WATER MAIN REQUIREMENTS) 15 INCH	FOOT	22	0			22
Ø Z0076604	TRAINEES - TRAINING PROGRAM GRADUATE	HOUR	0		2,000		
* Z0062456	TEMPORARY PAVEMENT	SQ YD	652	640.6			652
* SPECIALTY ITEMS							
Ø 0042							

MODEL: PWS 1
PWA NAME: US0003 804 80014-00

TranSmart
411 South Wells Street Suite 1000
Chicago, Illinois 60607

USER NAME	• muelhagen	DESIGNED	• BJD	REVISED	•
		DRAWN	• BJD	REVISED	•
PLOT SCALE	• 0.1888833 1/in.	CHECKED	• TW	REVISED	•
PLOT DATE	• 3/29/2021	DATE	• 2021/03/26	REVISED	•

STATE OF ILLINOIS
DEPARTMENT OF TRANSPORTATION

I-57 & WALDRON ROAD
SUMMARY OF QUANTITIES

SCALE: SHEET 14 OF 14 SHEETS STA. TO STA.

F.A.I. RTE.	SECTION	COUNTY	TOTAL SHEETS	SHEET NO.
	139 HBR-6	KANKAKEE	202	17
CONTRACT NO. 06907				

REV. 8/27/21 REV. 4/29/21 REV. 4/20/21 REV. 4/9/21



STA 15+38.36 TO 17+06.80
(1) TRANSITION 4% AT STA 16+15.00 TO 2% AT STA 16+45.00
(2) TRANSITION 4% AT STA 16+85.00 TO 2% AT STA 17+45.00
(3) STA 16+83.76 TO STA 17+06.80 LEFT
(4) SHARED USE PATH BEGINS AT STA 16+26.67



STA 17+06.80 TO 17+94.25
* FACE OF GUARDRAIL TO BE 6 IN. FROM FACE OF CURB
** TACK COAT TO BE APPLIED BETWEEN HMA LIFTS
(1) TRANSITION 4% AT STA 16+85.00 TO 2% AT STA 17+45.80
(2) STA 17+06.80 TO STA 18+05.36 LEFT
STA 17+43.54 TO STA 18+46.81 RIGHT



NOTE: BICYCLE RAILING TO BE INSTALLED
STA 17+00.00 TO STA 18+33.63
STA 21+64.90 TO STA 24+95.50


EXISTING LEGEND

- (A) BITUMINOUS PAVEMENT
(B) AGGREGATE BASE
(C) COMBINATION CONCRETE CURB AND GUTTER, B-6.12
(D) AGGREGATE SHOULDER

PROPOSED LEGEND


- | | | |
|---|---|--|
| ① HOT-MIX ASPHALT SURFACE COURSE, IL 9.5, MIX "D", N50 1.5" | ⑥ COMBINATION CONCRETE CURB AND GUTTER, TYPE B-6.24 | ⑪ TOPSOIL EXCAVATION AND PLACEMENT |
| ② HOT-MIX ASPHALT BINDER COURSE, IL 19.0, N50 2.25" | ⑦ COMBINATION CONCRETE CURB AND GUTTER, TYPE B-6.12 | ⑫ STEEL PLATE BEAM GUARDRAIL, TYPE A, 6 FOOT POSTS |
| ③ HOT-MIX ASPHALT PAVEMENT (FULL DEPTH), 10 1/4" | ⑧ CONCRETE GUTTER, TYPE A | ⑬ BACK SIDE PROTECTION OF GUARDRAIL |
| ④ BITUMINOUS MATERIALS (TACK COAT) | ⑨ BICYCLE RAILING | |
| ⑤ AGGREGATE SUBGRADE IMPROVEMENT, 18" | ⑩ HOT MIX ASPHALT SURFACE COURSE, IL-9.5, MIX "C", N50 2" | |
| | AGGREGATE BASE COURSE TYPE A, 6" | |

CLEAR ZONE					
ROADWAY	STATION	STATION	DESIGN SPEED (MPH)	CLEAR ZONE (FT)	OBSTRUCTION-FREE CLEARANCE (FT)
EAST MAPLE STREET	15+40.00	17+93.10	30	10	1.5
WALDRON ROAD	17+93.10	26+35.00	40	10	1.5
DUANE BOULEVARD			30	10	1.5
MUN 2530	10+13.20	12+00.00	30	7	

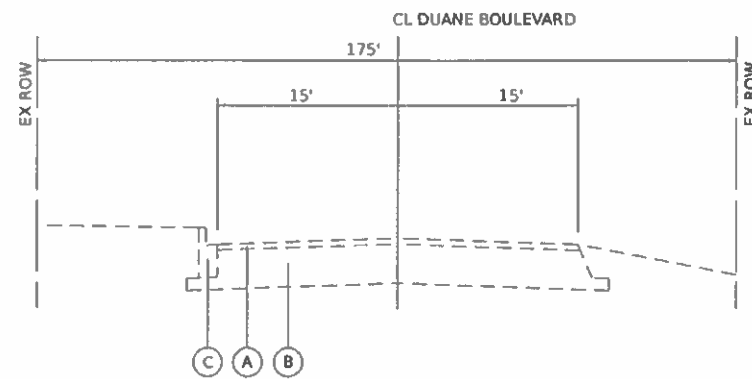


EXISTING SECTION EAST DUANE BOULEVARD

STA 31+46.02 TO 31+78.85

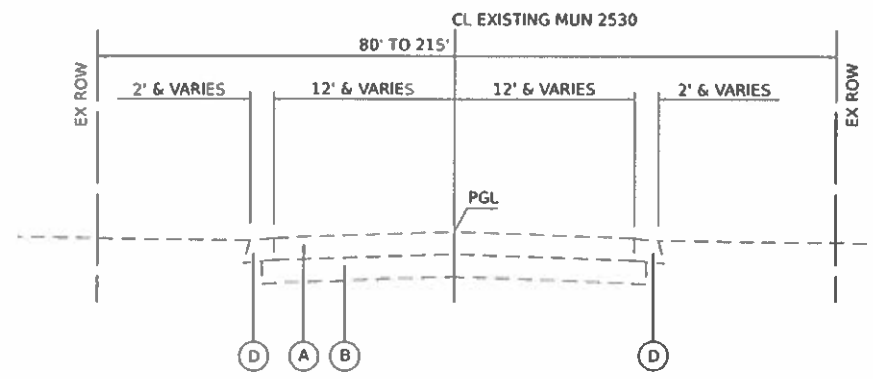


EXISTING SECTION MUN 2530

STA 10+13.20 TO STA 12+00.00

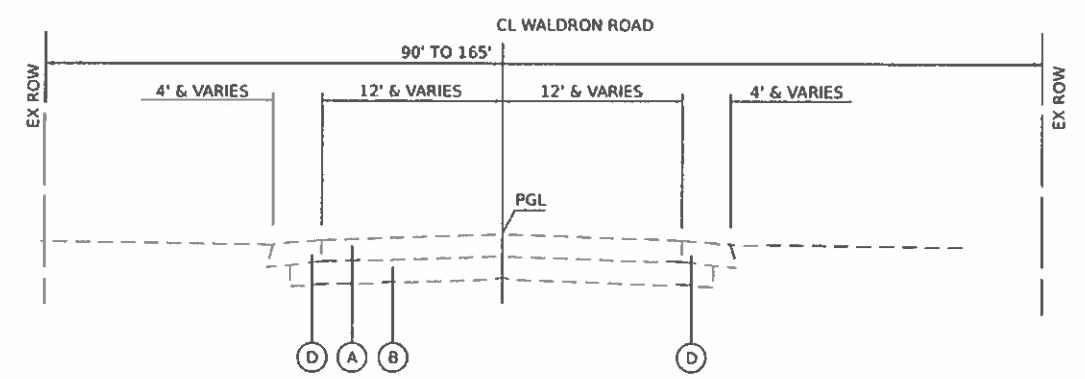

EXISTING SECTION WALDRON ROAD


STA 20+75.15 TO STA 26+35.00

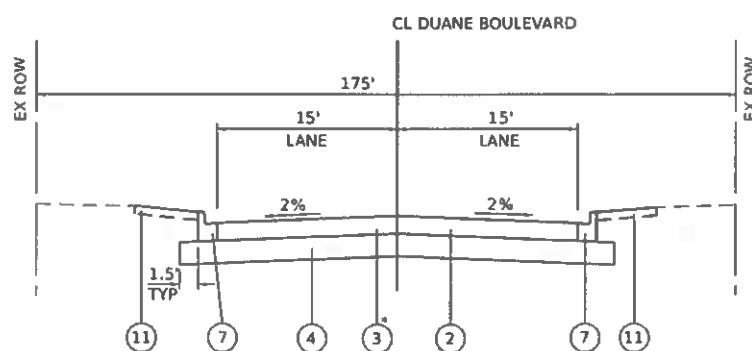

PROPOSED SECTION EAST DUANE BOULEVARD

STA 31+46.02 TO 31+78.85


* TACK COAT TO BE APPLIED BETWEEN HMA LIFTS

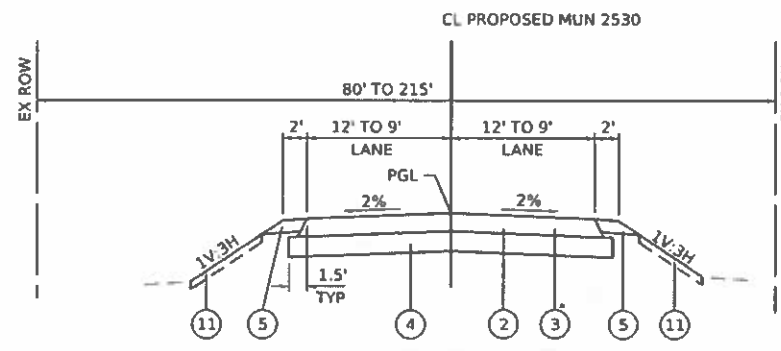

PROPOSED SECTION MUN 2530

STA 10+13.20 TO 12+00.00

* TACK COAT TO BE APPLIED BETWEEN HMA LIFTS

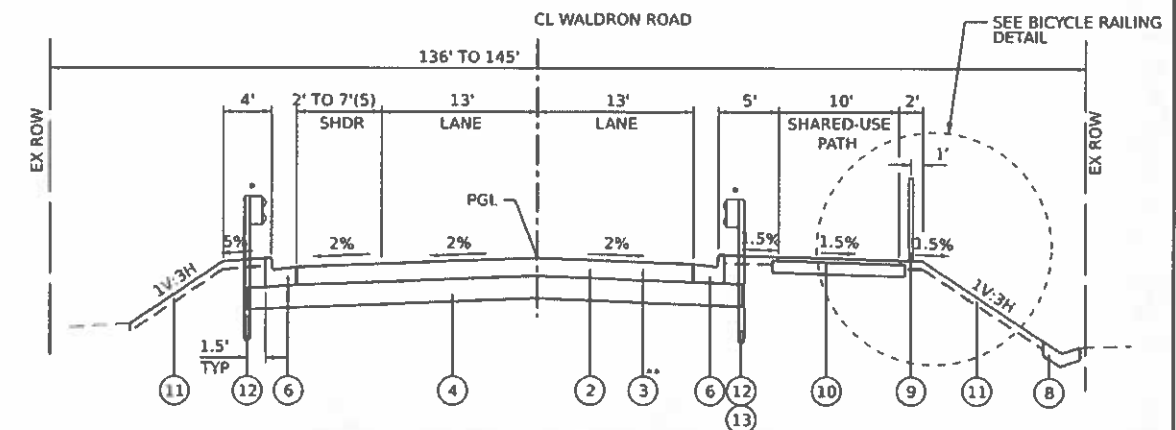

PROPOSED SECTION WALDRON ROAD


EAST OF I-57

STA 21+23.85 TO 22+00.00

* FACE OF GUARDRAIL TO BE 6 IN. FROM FACE OF CURB

** TACK COAT TO BE APPLIED BETWEEN HMA LIFTS

(5) STA 21+13.76 TO STA 21+96.17 LEFT

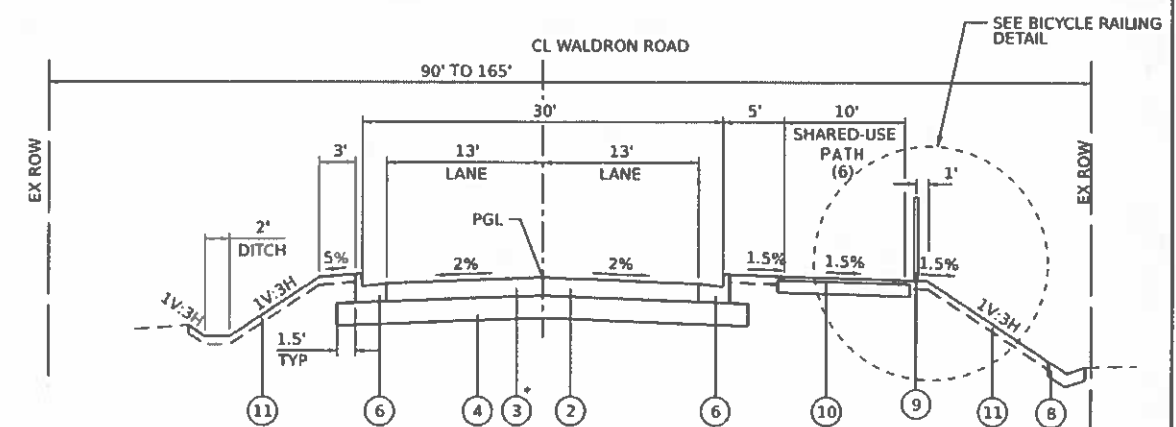

PROPOSED SECTION WALDRON ROAD

EAST OF I-57

STA 22+00.00 TO 26+35.00

* TACK COAT TO BE APPLIED BETWEEN HMA LIFTS

(6) SHARED-USE PATH ENDS AT STA 24+95.50

EXISTING LEGEND

- (A) EXISTING BITUMINOUS SURFACE
- (B) EXISTING AGGREGATE BASE
- (C) EXISTING COMBINATION CONCRETE CURB AND GUTTER, B-6.12
- (D) EXISTING AGGREGATE SHOULDER

PROPOSED LEGEND

- (1) HOT-MIX ASPHALT SURFACE COURSE, IL 9.5, MIX "D", N50 1.5"
- (2) HOT-MIX ASPHALT BINDER COURSE, IL 19.0, N50 2.25"
- (3) HOT-MIX ASPHALT PAVEMENT (FULL DEPTH), 10 1/4"
- (4) BITUMINOUS MATERIALS (TACK COAT)
- (5) AGGREGATE SUBGRADE IMPROVEMENT, 18"
- (6) AGGREGATE SHOULDERS, TYPE A 6"
- (6) COMBINATION CONCRETE CURB AND GUTTER, TYPE B-6.24
- (7) COMBINATION CONCRETE CURB AND GUTTER, TYPE B-6.12
- (8) CONCRETE GUTTER, TYPE A
- (9) BICYCLE RAILING
- (10) HOT MIX ASPHALT SURFACE COURSE, IL-9.5, MIX "C", N50 2"
- (10) AGGREGATE BASE COURSE TYPE A, 6"
- (11) TOPSOIL EXCAVATION AND PLACEMENT
- (12) STEEL PLATE BEAM GUARDRAIL, TYPE A, 6 FOOT POSTS
- (13) BACK SIDE PROTECTION OF GUARDRAIL

TranSmart
411 South Wells Street Suite 1000
Chicago, Illinois 60607

USER NAME	malikhan
DESIGNED	NS
DRAWN	NS
CHECKED	TW
DATE	2021/03/26
REVISION	
REVISION	
REVISION	
REVISION	

STATE OF ILLINOIS
DEPARTMENT OF TRANSPORTATION

I-57 & WALDRON ROAD			
TYPICAL SECTIONS			
SCALE: NTS	SHEET 3	OF 3	SHEETS
STA	TO STA		

F.A.I. RTE	SECTION	COUNTY	TOTAL SHEETS	SHEET NO.
57	139 HDR-6	KANKAKEE	202	20
CONTRACT NO. 66997				
ILLINOIS FED. AID PROJECT				

REMOVAL SCHEDULE																
START STATION	OFFSET	END STATION	OFFSET	PAVEMENT REMOVAL 44000100	HOT-MIX ASPHALT SURFACE REMOVAL, 3 3/4" 44000164	DRIVEWAY PAVEMENT REMOVAL 44000200	GUTTER REMOVAL 44000400	COMBINATION CURB AND GUTTER REMOVAL 44000500	SIDEWALK REMOVAL 44000600	CONCRETE BARRIER REMOVAL 44001980	PAVED SHOULDER REMOVAL 44000250	PAVEMENT PATCHING, TYPE III, 8 INCH 44200099	PAVEMENT PATCHING, TYPE IV, 8 INCH 44200101	GUARDRAIL REMOVAL 63200310	AGGREGATE SHOULDER REMOVAL X4810200	FENCE REMOVAL Z0022800
	FOOT		FOOT	SQ YD		SQ YD	FOOT	FOOT	SQ FT	FOOT	SQ YD	SQ YD	SQ YD	FOOT	CU YD	FOOT
I-57																
226+56.74	30.4 RT	233+50.19	30.9 RT								608.9					
226+54.19	47.0 RT	228+71.89	40.8 RT				218.2									
226+56.73	41.4 RT	233+04.56	42.2 RT							648.2						
232+88.79	40.6 RT	233+47.33	41.4 RT											58.6		
229+39.93	30.3 LT	235+50.78	33.7 LT								500.1					
229+30.04	44.3 LT	230+71.28	37.7 LT				139.8									
229+39.91	41.0 LT	233+04.05	43.4 LT							364.5						
233+16.71	42.9 LT	235+38.34	44.0 LT											221.7		
229+98.00		230+23.00								25.0						
230+75.00		231+18.00								43.0						
E MAPLE ST																
15+38.36		17+06.80			921.6											
17+06.80		17+96.08		360.2												
15+41.17	22.6 RT	15+57.89	22.8 RT			52.9										
15+38.35	21.9 RT	16+45.39	53.9 RT					129.2								
16+77.64	44.0 RT	18+14.98	16.2 RT					147.3								
17+05.21	24.7 RT	18+60.41	12.6 RT											155.5		
15+40.73	21.9 LT	17+71.23	15.8 LT					231.0								
15+43.02	22.8 LT	18+26.27	13.1 LT											283.9		
18+10.38	66.4 RT	18+84.34	66.2 RT													110.0
18+27.94	66.4 RT	18+36.40	54.3 RT						26.7							
16+13.54		16+17.34										17.9				
16+17.60	18.3 LT	17+06.80	15.3 LT									25.2				
WALDRON RD																
21+21.72		26+35.00		1399.4												
20+98.52	12.2 RT	23+20.36	12.2 RT												33.6	
21+01.32	13.1 RT	23+08.53	16.7 RT											207.3		
24+78.39	12.3 RT	25+35.50	12.6 RT			169.9										
25+35.50	12.5 RT	26+35.00	12.6 RT												4.6	
20+57.56	12.7 LT	21+63.27	16.9 LT											105.8		
22+31.30	18.2 LT	26+35.00	12.1 LT												27.8	
22+38.87	16.8 LT	23+36.49	16.5 LT											97.6		
23+16.50	50.4 RT	24+96.00	43.7 RT	264.8												
MUN 2530																
10+12.37		10+50.00		140.7												
10+50.00		12+00.00		307.0												
TOTALS				2472.1	921.6	222.8	358.0	507.5	26.7	1080.7	1109.0	17.9	25.2	1130.4	66.1	110.0

DRAINAGE STRUCTURE REMOVAL SCHEDULE				
STATION	OFFSET	REMOVING CATCH BASINS 60500050	REMOVING INLETS 60500060	DRAINAGE STRUCTURE TO BE REMOVED Z0018700
	FOOT	EACH	EACH	EACH
I-57				
229+93	41.5 LT	1		
228+64	40.3 RT	1		
E MAPLE ST				
18+14	13.0 LT		1	
18+52	13.5 RT		1	
WALDRON RD				
25+29	34.9 RT			1
TOTALS		2	2	1

DRAINAGE PIPE REMOVAL SCHEDULE					
START STATION	OFFSET	END STATION	OFFSET	PIPE CULVERT REMOVAL 50105220	STORM SEWER REMOVAL 12" 55100500
	FOOT		FOOT	FOOT	FOOT
I-57					
229+93	41.5 LT	229+92	36.5 LT		5.0
228+62	39.1 RT	228+57	36.6 RT		9.0
E MAPLE ST					
18+14	13.1 LT	18+93	45.4 RT		97.0
WALDRON RD					
24+95	34.2 RT	25+22	32.4 RT	25.0	
25+23	41.6 RT	25+28	36.4 RT		4.7
TOTALS				25	116

MODEL: Plan 1
FILE NAME: C:\Users\jg\Documents\Schedule.dgn

TransSmart
411 South Wells Street Suite 1000
Chicago, Illinois 60607

USER NAME = jg@tsc
PLOT SCALE = 0.16666633' / in.
PLOT DATE = 7/8/2021

DESIGNED - NS
DRAWN - NS
CHECKED - TW
DATE - 2021/03/26

REVISED -
REVISED -
REVISED -
REVISED -

STATE OF ILLINOIS
DEPARTMENT OF TRANSPORTATION

REMOVAL SCHEDULE

SCALE: NTS SHEET 1 OF 1 SHEETS STA. TO STA.

F.A.I. RTE.	SECTION	COUNTY	TOTAL SHEETS	SHEET NO.
57	139 HBR-6	KANKAKEE	202	21
CONTRACT NO. 66997				
ILLINOIS FED. AID PROJECT				

TREE REMOVAL SCHEDULE									
TREE #	# OF STEMS	INDIVIDUAL STEM MEASUREMENTS					REMOVAL BY UNIT DIAMETER		
		1	2	3	4	5	6 TO 15	OVER 15	
							UNIT	UNIT	
					20100110			20100210	
SE QUADRANT									
1	1	24						24	
2	1	21						21	
3	1	16						16	
4	1	19						19	
SUBTOTAL							0	80	
NE QUADRANT									
5	1	21						21	
6	1	24						24	
7	1	8					8		
8	2	20	16					36	
9	1	6					6		
10	1	8					8		
11	1	11					11		
12	1	6					6		
13	2	10	10				20		
14	1	9					9		
15	1	12					12		
16	1	8					8		
17	1	13					13		
18	3	7	5	5			7		
19	1	7					7		
20	1	10					10		
21	2	7	3				7		
22	2	6	2				6		
23	1	8					8		
24	1	8					8		
25	2	11	7				18		
26	1	11					11		
27	1	10					10		
28	1	10					10		
29	1	10					10		
30	1	12					12		
31	2	8	4				6		
32	1	8					8		
33	1	6					6		
34	1	10					10		
35	2	6	4				6		
36	1	10					10		
37	1	6					6		
38	1	10					10		
39	2	7	4				7		
40	1	7					7		
41	1	6					6		
42	1	10					10		
43	1	8					8		
44	1	6					6		
45	1	6					6		
46	1	7					7		
47	1	6					6		
48	1	7					7		
SUBTOTAL							357	81	

TREE REMOVAL SCHEDULE									
TREE #	# OF STEMS	INDIVIDUAL STEM MEASUREMENTS					REMOVAL BY UNIT DIAMETER		
							6 TO 15	OVER 15	
		1	2	3	4	5	UNIT	UNIT	
					20100110			20100210	
NW QUADRANT									
72	2	6	8				14		
73	1	13					13		
74	1	8					8		
75	2	8	8				16		
76	1	10					10		
77	1	10					10		
78	2	8	5				8		
79	1	8					8		
80	1	6					6		
81	1	9					9		
82	1	7					7		
83	1	7					7		
84	1	7					7		
85	1	14					14		
86	2	6	6				12		
87	1	15					15		
88	1	8					8		
89	1	7					7		
90	2	7	7				14		
91	2	10	12				22		
92	1	10					10		
93	2	7	5				7		
94	1	8					8		
95	3	6	5	4			6		
96	1	14					14		
97	1	10					10		
98	1	6					6		
99	2	6	5				6		
100	1	6					6		
101	2	13	7				20		
102	1	10					10		
103	3	11	8	5			19		
104	1	8					8		
105	1	8					8		
106	2	10	4				10		
107	4	6	6	2	3		12		
108	1	6					6		
109	5	6	6	5	4	2	12		
110	4	6	5	4	3		6		
111	1	8					8		
SUBTOTAL							407	0	

TREE REMOVAL SCHEDULE									
TREE #	# OF STEMS	INDIVIDUAL STEM MEASUREMENTS					REMOVAL BY UNIT DIAMETER		
							6 TO 15	OVER 15	
		1	2	3	4	5	UNIT	UNIT	
					20100110			20100210	
SW QUADRANT									
49	1	16						16	
50	1	10					10		
51	3	7	5	10			17		
52	1	28						28	
53	1	28						28	
54	1	10					10		
55	1	8					8		
56	1	6					6		
57	1	15					15		
58	1	12					12		
59	1	10					10		
60	3	6	5	7			13		
61	1	6					6		
62	1	6					6		
63	1	6					6		
64	2	13	13				26		
65	1	13					13		
66	1	12					12		
67	1	7					7		
68	1	13					13		
69	1	7					7		
70	1	8					8		
71	1	30						30	
SUBTOTAL							205	102	
SE OF COUNTY RD S 089 E									
112	1	40						40	
113	1	30						30	
114	2	9	3				9		
115	1	8					8		
116	1	8					8		
117	1	8					8		
118	1	8					8		
119	4	8	7	5	7		22		
120	1	8					8		
121	1	7					7		
122	1	6					6		
123	1	6					6		
124	1	6					6		
SUBTOTAL							94	70	
TOTALS							1,063	333	

MOORE, Plan 1
FILE NAME: D:\6693\Sht Tree Removal Schedule.dgn

TranSmart
411 South Wells Street Suite 1000
Chicago, Illinois 60607

USER NAME = rmlshian
PLOT SCALE = 0.1860833" / ft.
PLOT DATE = 3/29/2021

DESIGNED - NS
DRAWN - NS
CHECKED - TW
DATE - 2021/03/26

REVISED -
REVISED -
REVISED -
REVISED -

STATE OF ILLINOIS
DEPARTMENT OF TRANSPORTATION

TREE REMOVAL SCHEDULE

SCALE: NTS SHEET 1 OF 1 SHEETS STA. TO STA.

F.A.I. RTE	SECTION	COUNTY	TOTAL SHEETS	SHEET NO.
57	139 HBR-6	KANKAKEE	202	22
CONTRACT NO. 66997				
ILLINOIS FED. AID PROJECT				

shrinkage= 25%																
STATION	EARTH EXCAVATION (CU YD)		ROCK EXCAVATION (CU YD)		EXCAVATION ADJUSTED FOR SHRINKAGE (CU YD)		EMBANKMENT (CU YD)		EARTHWORK BALANCE WASTE (+) / SHORT (-) (CU YD)		TOPSOIL STRIPPING (CU YD)		TOPSOIL PLACEMENT (CU YD)		TOPSOIL BALANCE WASTE (+) / SHORT (-) (CU YD)	
	A		B		C=A*S		D		E=C-D		F		G		H=F-G	
	STAGE 1	STAGE 2	STAGE 1	STAGE 2	STAGE 1	STAGE 2	STAGE 1	STAGE 2	STAGE 1	STAGE 2	STAGE 1	STAGE 2	STAGE 1	STAGE 2	STAGE 1	STAGE 2
MAINLINE I-57																
226+00																
226+50	0.0	0.0	0.0	0.0	0.0	0.0	0.0	0.0	0.0	0.0	0.0	0.1	0.0	0.1	0.0	0.0
227+00	0.0	135.1	0.0	0.0	0.0	101.3	0.0	0.0	0.0	101.3	0.0	11.6	0.0	13.1	0.0	-1.5
227+50	0.0	428.4	0.0	0.0	0.0	321.3	0.0	0.0	0.0	321.3	0.0	29.3	0.0	29.7	0.0	-0.4
228+00	0.0	579.0	0.0	0.0	0.0	434.2	0.0	0.0	0.0	434.2	0.0	32.8	0.0	31.5	0.0	1.3
228+50	0.0	641.0	0.0	0.0	0.0	480.8	0.0	0.0	0.0	480.8	0.0	27.9	0.0	26.7	0.0	1.2
229+00	0.0	789.1	0.0	9.2	0.0	591.8	0.0	0.0	0.0	591.8	0.0	21.8	0.0	20.8	0.0	0.9
229+50	0.0	917.1	0.0	14.9	0.0	687.9	0.0	0.6	0.0	687.3	0.0	28.2	0.0	29.9	0.0	-1.7
230+00	0.0	1312.1	0.0	15.3	0.0	984.1	0.0	0.6	0.0	983.5	0.0	51.5	0.0	53.4	0.0	-2.0
230+50	325.0	1360.8	0.0	23.7	243.8	1020.6	0.0	0.0	243.8	1020.6	11.7	54.9	9.5	53.1	2.2	1.8
231+00	571.1	865.6	21.1	14.1	428.3	649.2	0.0	0.0	428.3	649.2	27.9	33.0	24.0	29.6	3.9	3.4
231+50	756.8	333.5	44.2	0.0	567.6	250.1	0.0	0.0	567.6	250.1	39.7	10.4	35.9	8.9	3.8	1.5
232+00	891.7	0.0	48.4	0.0	668.8	0.0	0.0	0.0	668.8	0.0	45.3	0.0	41.3	0.0	4.0	0.0
232+50	666.3	0.0	58.7	0.0	499.7	0.0	0.0	0.0	499.7	0.0	42.3	0.0	39.2	0.0	3.0	0.0
233+00	498.7	0.0	78.9	0.0	374.0	0.0	2.0	0.0	372.1	0.0	42.0	0.0	39.3	0.0	2.7	0.0
233+50	321.8	0.0	47.8	0.0	241.3	0.0	7.8	0.0	233.5	0.0	41.9	0.0	41.5	0.0	0.4	0.0
234+00	113.1	0.0	2.3	0.0	84.8	0.0	5.9	0.0	79.0	0.0	35.1	0.0	36.1	0.0	-1.0	0.0
234+50	9.6	0.0	0.0	0.0	7.2	0.0	0.0	0.0	7.2	0.0	14.7	0.0	14.6	0.0	0.1	0.0
235+00	9.3	0.0	0.0	0.0	7.0	0.0	0.0	0.0	7.0	0.0	0.0	0.0	0.0	0.0	0.0	0.0
235+50	9.0	0.0	0.0	0.0	6.7	0.0	0.0	0.0	6.7	0.0	0.0	0.0	0.0	0.0	0.0	0.0
236+00	4.4	0.0	0.0	0.0	3.3	0.0	0.0	0.0	3.3	0.0	0.0	0.0	0.0	0.0	0.0	0.0
SUBTOTAL	4176.9	7361.8	301.3	77.1	3132.7	5521.3	15.6	1.2	3117.0	5520.2	300.6	301.4	281.4	296.9	19.1	4.6
WALDRON RD																
15+00																
15+50	27.2	30.5	0.0	0.0	20.4	22.9	0.6	3.0	19.8	19.9	0.0	2.2	0.0	2.1	0.0	0.0
16+00	55.2	62.1	0.0	0.0	41.4	46.6	1.1	11.7	40.3	34.9	0.6	9.1	0.8	8.9	-0.2	0.3
16+50	98.9	61.2	0.0	0.0	74.2	45.9	0.5	24.8	73.7	21.1	0.6	15.2	0.8	14.5	-0.2	0.7
17+00	101.0	53.5	0.0	0.0	75.8	40.1	17.9	46.4	57.9	-6.3	8.5	16.7	4.1	15.8	4.4	0.9
17+50	47.2	33.9	0.0	0.0	35.4	25.4	112.2	56.6	-76.8	-31.2	21.4	16.0	14.5	15.4	6.9	0.5
18+00	18.6	43.0	0.0	0.0	13.9	32.2	232.8	46.0	-218.8	-13.8	27.2	10.9	22.1	11.2	5.1	-0.2
18+50	116.1	33.0	0.0	0.0	87.1	24.7	275.5	19.6	-188.4	5.1	28.7	3.4	23.2	3.8	5.6	-0.4
18+75	253.5	0.0	0.0	0.0	190.1	0.0	102.7	0.0	87.4	0.0	15.4	0.0	13.2	0.0	2.2	0.0
19+50	588.4	0.0	0.0	0.0	441.3	0.0	102.5	0.0	338.8	0.0	24.6	0.0	22.4	0.0	2.2	0.0
20+00	0.0	0.0	0.0	0.0	0.0	0.0	0.0	0.0	0.0	0.0	0.0	0.0	0.0	0.0	0.0	0.0
20+50	0.0	0.0	0.0	0.0	0.0	0.0	0.0	3.2	0.0	-3.2	0.0	10.9	0.0	9.3	0.0	1.6
21+00	0.0	0.0	0.0	0.0	0.0	0.0	17.5	162.2	-17.5	-162.2	0.0	21.2	0.0	17.6	0.0	3.6
21+50	0.0	0.0	0.0	0.0	0.0	0.0	254.1	349.1	-254.1	-349.1	8.4	22.2	6.3	17.5	2.1	4.8
22+00	0.0	0.0	0.0	0.0	0.0	0.0	559.9	252.0	-559.9	-252.0	26.4	11.9	22.6	11.9	3.8	0.0
22+50	0.0	0.0	0.0	0.0	0.0	0.0	574.1	279.5	-574.1	-279.5	36.7	11.3	33.5	9.6	3.2	1.6
23+00	4.8	3.8	0.0	0.0	3.6	2.8	414.4	279.2	-410.7	-276.3	32.2	19.3	29.4	15.1	2.8	4.1
23+50	20.8	14.0	0.0	0.0	15.6	10.5	266.7	100.2	-251.1	-89.7	24.9	15.5	18.5	15.8	6.4	-0.3
24+00	37.7	25.3	0.0	0.0	28.3	19.0	184.3	61.9	-156.0	-42.9	22.6	14.2	12.5	14.1	10.1	0.1
24+50	48.5	33.3	0.0	0.0	36.4	25.0	147.7	34.2	-111.3	-9.2	22.3	11.8	12.2	11.8	10.0	0.0
25+00	52.1	36.1	0.0	0.0	39.1	27.1	117.3	15.3	-78.2	11.8	27.0	8.0	6.0	8.2	21.0	-0.2
25+50	48.0	35.4	0.0	0.0	36.0	26.5	56.1	9.4	-20.1	17.2	19.6	5.2	3.3	5.5	16.2	-0.3
26+00	46.5	35.1	0.0	0.0	34.9	26.3	7.1	9.8	27.8	16.5	4.4	4.9	6.5	5.2	-2.1	-0.3
26+50	23.9	17.6	0.0	0.0	17.9	13.2	1.9	5.0	16.0	8.2	0.8	2.6	3.1	2.6	-2.4	-0.1
27+00	0.0	0.0	0.0	0.0	0.0	0.0	0.0	0.0	0.0	0.0	0.0	0.0	0.0	0.0	0.0	0.0
SUBTOTAL	1588.5	517.7	0.0	0.0	1191.4	388.3	3446.9	1769.1	-2255.5	-1380.9	352.0	232.5	255.1	216.0	96.8	16.5
MUN 2530																
10+50																
11+00	0.0	7.0	0.0	0.0	0.0	5.3	0.0	292.6	0.0	-287.3	0.0	31.8	0.0	19.1	0.0	12.7
11+50	0.0	36.1	0.0	0.0	0.0	27.1	0.0	86.4	0.0	-59.3	0.0	16.6	0.0	9.6	0.0	7.0
12+00	0.0	29.1	0.0	0.0	0.0	21.8	0.0	2.2	0.0	19.6	0.0	4.8	0.0	1.7	0.0	3.1
12+50	0.0	0.0	0.0	0.0	0.0	0.0	0.0	0.0	0.0	0.0	0.0	0.8	0.0	0.0	0.0	0.8
SUBTOTAL	0.0	72.2	0.0	0.0	0.0	54.2	0.0	381.1	0.0	-327.0	0.0	54.0	0.0	30.4	0.0	23.7
TOTALS	5765.4	7951.6	301.3	77.1	4324.1	5963.7	3462.5	2151.4	861.6	3812.3	652.5	587.9	536.6	543.2	116.0	44.8
	13717.1		378.4		10287.8		5613.9		4673.9		1240.5		1079.8		160.7	

NOTE: ROCK EXCAVATION SHALL COMPLY WITH REQUIREMENTS
OF ARTICLE 205.04 PRIOR TO REUSE IN THE EMBANKMENT.

PAY ITEM	DESCRIPTION	UNIT	QUANTITY	CALCULATION
20200100	EARTH EXCAVATION	CU YD	13720	A
21101505	TOPSOIL EXCAVATION AND PLACEMENT	CU YD	1245	F
50200400	ROCK EXCAVATION FOR STRUCTURES	CU YD	380	B

SCHEDULE OF QUANTITIES
EARTHWORK

F.A.I. RTE.	SECTION	COUNTY	TOTAL SHEETS	SHEET NO.
57	139 HBR-6	KANKAKEE	202	23
CONTRACT NO. 66997				
ILLINOIS FED. AID PROJECT				

SCALE: NTS SHEET 1 OF 1 SHEETS STA. TO STA.

STATE OF ILLINOIS
DEPARTMENT OF TRANSPORTATION

DESIGNED - BJD	REVISED - 5/7/2021
DRAWN - BJD	REVISED -
CHECKED - TW	REVISED -
DATE - 2021/03/26	REVISED -

TransSmart
411 South Wells Street Suite 1000
Chicago, Illinois 60607

MODEL: Plan 1
FILE NAME: C:\66997-23\Illinois\66997-23.dgn

ROADWAY SCHEDULE																										
START STATION	OFFSET	END STATION	OFFSET	HMA PAVT FD 10 1/4 40701886	BIT MATLS TACK CT 40700100	AGG SUBGRADE IMPR 18 30300118	HMA SC IL-9.5 D N50 40604060	HMA SC IL-9.5 C N50 40604050	HMA BC IL-19.0 N50 40603080	AGG BASE CSE A 6 35100500	HMA BASE CSE 2 1/2 35501288	HMA BASE CSE 6 35501308	COMB CC&G TB6.12 60603800	COMB CC&G TB6.24 60605000	BICYCLE RAILING 50901720	CONC GUTTER TA 60602500	CONC GUTTER TB 60602800	AGGREGATE SHLDS A 6 48100500	SUB GRAN MAT A 31100200	HMA SHOULDERS 6 48203021	PC CONC SIDEWALK 8 42400410	PVT CON PCC BR APP SL 42000080	CONC BAR TRANS 63700805	CONCRETE BARRIER BASE 63700900	MOD GLAR SCR SYS PERM 63800910	HMA BC WID 6 1/2 35600702
	FOOT		FOOT	SQ YD	POUND	SQ YD	TON	TON	TON	SQ YD	SQ YD	SQ YD	FOOT	FOOT	FOOT	FOOT	FOOT	SQ YD	CU YD	SQ YD	SQ FT	SQ YD	FOOT	FOOT	FOOT	SQ YD
I-57																										
226+56.74	30.5 RT	233+50.19	30.9 RT																	5322.2	771.4					
229+39.93	30.3 LT	235+50.78	33.7 LT																4686.7	677.8						
227+50.00	70.6 RT	233+50.00	70.6 RT														600									
230+50.00	70.6 LT	233+50.00	70.6 LT														300									
229+30.05	42.7 LT	229+39.9	42.8 LT													10										
229+98.00		230+23.00																								
230+93.00		231+18.00																					25.0	25.0	25.0	
E MAPLE ST																							25.0	25.0	25.0	
17+06.80		17+06.80					78.7		118.1																	
17+06.80		17+59.88		227.7	102.4	227.7																				
15+38.35	22.6 RT	15+61.45	22.6 RT					6.5			57.7															
16+23.45	27.0 RT	16+31.45	27.0 RT																		135.4					
16+91.47	27.0 RT	17+05.55	27.0 RT																		195.6					
17+05.55	27.0 RT	18+11.91	19.5 RT				13.2			117.5																
15+38.35	21.0 RT	16+46.22	53.9 RT										127.9													
16+76.49	54.0 RT	17+06.80	21 RT										50.2													
17+06.80	21.0 RT	18+11.91	16.7 RT			36.0							158.9													
15+38.36	21.0 LT	17+74.88	15.3 LT			23.4							237.1													
16+91.60	37.6 RT	18+33.64	29.8 RT												141.9											
17+59.88		17+96.08																				163.9				
16+26.26	22.7 RT	16+46.22	50.3 RT																							6.2
16+77.34	44.1 RT	16+82.29	26.5 RT																							1.9
WALDRON RD																										
21+75.67		25+35.00		1462.1	657.9	1462.1																				
21+75.67	19.1 RT	24+85.41	20 RT				39.2		349.7																	
24+82.00	15.6 RT	25+35.00	15.6 RT				17.6					157.5														
21+75.68	13.0 RT	26+35.00	13.0 RT			208.9								459.3												
21+00.91	15 LT	22+06.07	30.5 LT			49.6							109.0													
22+46.03	33.1 LT	22+06.07	13.0 LT			179.5							396.9													
23+16.40	47.9 RT	24+96.00	46.8 RT													179.6										
21+64.85	29.6 RT	24+91.96	30.7 RT												327.1											
23+16.52	50.9 RT	24+96.00	49.8 RT				4.5				99.7															
21+21.72		21+75.67																				237.75				
MUN 2530																										
10+32.50		12+00.00		429.6	193.3	485.8																				
10+35.00	22.6 LT	12+00.00	9.0 LT															37.8								
10+30.60	17.2 RT	12+00.00	9.0 RT															37.1								
TOTALS				2119.3	953.7	2672.9	79	81	118	467.2	57.7	257.3	574.1	965.2	469.0	189.6	900	74.8	10008.9	1449.2	331.0	401.6	50.0	50.0	50.0	8.1

GUARDRAIL SCHEDULE

START STATION	OFFSET	END STATION	OFFSET	SPBGR TY A 6FT POSTS 63000001	BCK SD PROT OF GRDRL 63000035	TR BAR TRM T1 SPL TAN 63100167	TRAF BAR TERM T5 63100070	TRAF BAR TERM T6 63100085	TERMINAL MARKER - DA 72501000	GRDRAIL REF TYPE A 78200005	LINEAR DELIN PANELS 6 X0326649	LINEAR DELIN PANELS 4 X0327809
	FOOT		FOOT	FOOT	FOOT	EACH	EACH	EACH	EACH	EACH	EACH	EACH
I-57												
227+50.00	68.0 RT	233+50.00	68.0 RT								8	
230+50.00	68.0 LT	233+50.00	68.0 LT								4	
E MAPLE ST												
17+15.00	22.0 RT	18+11.91	17.9 RT	25	97	1		1	2	4		2
17+04.00	20.8 LT	17+90.37	15.5 LT	37.5		1	1		2	4		2
18+11.91	17.9 RT	21+50.45	15.0 RT								4	
17+90.37	15.5 LT	20+85.94	16.0 LT								4	
WALDRON RD												
21+50.45	15.0 RT	22+60.00	15.0 RT	62.5	110	1	1		2	4		2
20+85.94	16.0 LT	21+82.00	22.6 LT	25		1		1	2	4		2
TOTALS				150	207	4	2	2	8	16	20	8

LOCATION	GUARDRAIL LENGTH OF NEED (FT)
NE QUADRANT	96
NW QUADRANT	86
SW QUADRANT	97
SE QUADRANT	110

TranSmart
411 South Wells Street Suite 1000
Chicago, Illinois 60607

USER NAME = resolution
PLOT SCALE = 0.18000033" = 1'
PLOT DATE = 7/8/2021

DESIGNED - NS
DRAWN - NS
CHECKED - TW
DATE - 2021/07/08

REVISED -
REVISED -
REVISED -
REVISED -

STATE OF ILLINOIS
DEPARTMENT OF TRANSPORTATION

ROADWAY AND GUARDRAIL SCHEDULE

SCALE: NTS SHEET 1 OF 1 SHEETS STA. TO STA.

P.A.T. RTE.	SECTION	COUNTY	TOTAL SHEETS	SHEET NO.
57	139 HBR-8	KANKAKEE	202	24
CONTRACT NO. 66997				
ILLINOIS FED. AID PROJECT				

TEMPORARY PAVEMENT SCHEDULE								
LOCATION				FOR INFORMATION ONLY				TEMPORARY PAVEMENT
				SUBBASE GRANULAR MATERIAL, TYPE A 4"	BITUMINOUS MATERIALS (TACK COAT)	HOT MIX ASPHALT BINDER COURSE, IL-19.0, N70, 4"	HOT MIX ASPHALT SURFACE COURSE, MIX "C", N70, 2"	
STATION	TO	STATION	SIDE	SQ YD	POUND	TON	TON	SQ YD
								Z0062456
WALDRON ROAD								
PRE-STAGE 1								
20+72	TO	21+75	LT	42	14	7	4	31
22+35	TO	27+55	LT	288	104	52	26	230
STAGE 1								
17+06	TO	18+34	RT	106	35	18	9	77
21+39	TO	27+45	RT	422	142	71	36	314
TOTAL								652

SEE STAGING TYPICAL AND SPECIAL PROVISION

AGGREGATE FOR TEMPORARY ACCESS SCHEDULE										
LOCATION		TYPE	WIDTH	LENGTH	THICKNESS	TON				
STATION +/-	SIDE			FOOT +/-						
40201000										
STAGE 1										
E MAPLE ST										
15+49	RT	PE	13	25	0.5	13				
WALDRON RD										
25+09	RT	CE	25	16	0.75	23				
TOTAL						36				
REMOVAL OF THE TEMPORARY AGGREGATE IS TO BE CONSIDERED INCLUDED IN THE COST OF AGGREGATE FOR TEMPORARY ACCESS.										
LENGTHS MAY VARY DUE TO FIELD REQUIREMENTS.										
WIDTHS OF ENTRANCES SHOULD MATCH EXISTING ENTRANCES.										

TEMPORARY CONCRETE BARRIER SCHEDULE									
STATION +/-	TO	STATION +/-	SIDE	TEMPORARY CONCRETE BARRIER FOOT	PINNING TEMPORARY CONCRETE BARRIER EACH	RELOCATE TEMPORARY CONCRETE BARRIER FOOT	IMPACT ATTENUATORS, TEMPORARY (NON-REDIRECTIVE), TEST LEVEL EACH	IMPACT ATTENUATORS, TEMPORARY (FULLY REDIRECTIVE, NARROW) TEST EACH	IMPACT ATTENUATORS, RELOCATE (FULLY REDIRECTIVE, NARROW), TEST EACH
				70400100	X7040125	70400200	70600250	70600260	70600332
									70600350
STAGE 1									
I-57 INSIDE LANE									
225+99	TO	234+63	RT	2587.5			3		
229+06	TO	235+06	LT	1800.0			3		
231+07	TO	232+45	LT	412.5			3		
I-57 OUTSIDE LANE									
225+99	TO	234+60	RT			300.0			3
229+06	TO	235+06	LT			300.0			3
WALDRON ROAD									
16+42	TO	26+66	LT/RT	1025.0	246		1	1	
STAGE 2									
I-57 INSIDE LANE									
225+99	TO	234+63	RT			300.0			3
229+06	TO	235+06	LT			300.0			3
I-57 OUTSIDE LANE									
225+99	TO	234+63	RT			300.0			3
229+06	TO	235+06	LT			300.0			3
WALDRON ROAD									
16+43	TO	21+53	LT		123	512.5		1	1
18+16	TO	21+78	RT			362.5		2	
22+35	TO	27+23	LT		207	487.5	1		1
STAGE 2A									
WALDRON ROAD									
21+53	TO	22+02	RT		12	50.0		1	
22+86	TO	27+30	RT					1	
STAGE 3									
WALDRON ROAD									
17+03	TO	26+65	RT		231	962.5			2
TOTAL									
				5825.0	729	4175.0	11	4	3
									21

ASSUME 3 TOTAL INSTALLATIONS/RELOCATIONS OF TEMPORARY CONCRETE BARRIER WALL ON I-57

WORK ZONE PAVEMENT MARKING SCHEDULE								
LOCATION	TEMPORARY PAVEMENT MARKING				PAVEMENT MARKING TAPE, TYPE		TEMPORARY PAVEMENT MARKING REMOVAL SQ FT	
	LINE 4"		LINE 24"	LINE 4"	LINE 4"			
	SOLID	SKIP DASH	SOLID	SOLID	SOLID			
	WHITE	YELLOW	WHITE	WHITE	YELLOW			
	FOOT			FOOT				
70300220			70300280		70300904		X7030005	
STAGE 1								
I-57 INSIDE LANE								
210+25	TO	235+63				4875	7614	4183
228+06	TO	249+87				3738	6525	3421
I-57 OUTSIDE LANE								
210+25	TO	235+63				7608	5040	4216
228+06	TO	249+87				6525	4290	3805
WALDRON ROAD								
15+13	TO	29+71	2477	16	36			843
MUNI 2530								
10+14	TO	13+43	344		9			118
STAGE 2								
I-57 INSIDE LANE								
210+25	TO	233+75				4875	7614	4183
229+50	TO	249+87				3738	6525	3421
I-57 OUTSIDE LANE								
210+26	TO	234+60				7608	5040	4216
229+50	TO	249+87				6525	4290	3805
WALDRON ROAD								
15+13	TO	28+92	2447	16	36			833
MUNI 2530								
10+14	TO	13+43	433		9			148
STAGE 2A								
WALDRON ROAD								
14+63	TO	28+91	WALDRON ROAD TEMPORARY MARKING TO REMAIN FROM STAGE 2					
MUNI 2530								
10+00	TO	13+43	465		9			158
STAGE 3								
WALDRON ROAD								
15+13	TO	28+77	1986	16	36			680
MUNI 2530								
10+36	TO	10+36			21			7
			8152	48	156	45492	46938	33597
TOTAL			8200		156	92430		33597

ASSUME 3 TOTAL APPLICATIONS OF PAVEMENT MARKING TAPE ON I-57

MODEL: Plan 1
FILE NAME: D:\2020\13-Shed407 Schedule.dgn

Hutchison Engineering, Inc.
Jacksonville Moline Peoria Shorewood
Since 1945

USER NAME = nealshlan
PLOT SCALE = 0.18688833 / in.
PLOT DATE = 3/29/2021

DESIGNED -
DRAWN -
CHECKED -
DATE - 2021/03/26

REVISED -
REVISED -
REVISED -
REVISED -

STATE OF ILLINOIS
DEPARTMENT OF TRANSPORTATION

MAINTENANCE OF TRAFFIC
SCHEDULE

SCALE: SHEET 1 OF 1 SHEETS STA. TO STA.

F.A.L. RTE.	SECTION	COUNTY	TOTAL SHEETS	SHEET NO.
139	139 HBR-6	KANKAKEE	202	25
CONTRACT NO. 66997				
ILLINOIS FED. AID PROJECT				

INLET AND PIPE PROTECTION SCHEDULE		
STATION	OFFSET	EACH
28000500		
WALDRON RD		
17+89	67' RT	1
TOTAL 1		

INLET FILTERS SCHEDULE		
STATION	OFFSET	EACH
28000510		
I-57		
229+34	44' LT	1
229+92	36' LT	1
230+33	54' LT	1
E MAPLE ST		
16+15	21' RT	1
16+16	21' LT	1
17+43	17' LT	1
17+44	21' RT	1
17+65	16' LT	1
17+65	20' RT	1
WALDRON RD		
21+95	21' LT	1
21+95	14' RT	1
22+72	15' LT	1
22+73	14' RT	1
24+74	14' RT	1
24+74	46' RT	1
24+76	14' LT	1
26+30	14' LT	1
26+31	14' RT	1
TOTAL 18		

PERIMETER EROSION BARRIER SCHEDULE				
STATION	TO	STATION	SIDE	LENGTH FOOT
28000400				
I-57				
226+57	TO	228+14	RT	168
229+40	TO	231+02	LT	183
230+32	TO	234+10	RT	398
232+92	TO	235+50	LT	276
E MAPLE ST				
15+41	TO	17+03	LT	196
15+55	TO	16+45	RT	146
16+78	TO	18+95	RT	198
WALDRON RD				
20+53	TO	21+93	LT	131
22+10	TO	23+17	RT	112
MUN 2530				
10+31	TO	12+00	LT	28
10+37	TO	12+00	RT	172
TOTAL 2008				
PERIMETER EROSION BARRIER IS SILT FENCE.				

TEMPORARY DITCH CHECKS SCHEDULE		
LOCATION		LENGTH FOOT
STATION	OFFSET	FOOT
28000305		
I-57		
227+90	66' RT	10
229+30	66' RT	10
230+70	66' RT	10
231+00	66' LT	10
232+10	66' RT	10
232+20	66' LT	10
233+40	66' LT	10
233+45	66' RT	10
234+17	66' LT	10
234+20	66' RT	10
E MAPLE ST		
17+76	66' RT	10
17+99	62' RT	10
WALDRON ROAD		
23+12	49' RT	10
24+90	30' LT	10
25+50	30' LT	10
25+50	30' RT	10
26+35	30' LT	10
26+35	30' RT	10
TOTAL 180		

TEMPORARY EROSION CONTROL SEEDING SCHEDULE								
STATION +/-	TO	STATION +/-	SIDE	TEMP SEED	POUNDS PER APPLICATION PER ACRE	NUMBER OF APPLICATIONS	TOTAL	MULCH, METHOD 2
				ACRES			POUND	ACRE
							28000250	25100115
I-57								
226+57	TO	234+11	RT	0.78	100	1	78	0.78
229+40	TO	235+51	LT	0.51	100	1	51	0.51
E MAPLE ST								
15+41	TO	17+70	LT	0.10	100	1	10	0.10
15+55	TO	16+44	RT	0.01	100	1	1	0.01
16+78	TO	18+34	RT	0.11	100	1	11	0.11
WALDRON RD								
21+04	TO	22+04	LT	0.07	100	1	7	0.07
21+72	TO	26+35	RT	0.23	100	1	23	0.23
22+48	TO	26+35	LT	0.15	100	1	15	0.15
MUN 2530								
10+31	TO	12+00	LT	0.02	100	1	2	0.02
10+37	TO	12+00	RT	0.06	100	1	6	0.06
TOTAL							204	2.04
USE							250	2.25

MULCH METHOD 2 IS USED FOR TEMPORARY MULCHING

SEEDING, EROSION CONTROL BLANKET & NUTRIENTS SCHEDULE									
LOCATION				SEEDING, CLASS 2A	NITROGEN FERTILIZER NUTRIENT	PHOSPHORUS FERTILIZER NUTRIENT	POTASSIUM FERTILIZER NUTRIENT	EROSION CONTROL BLANKET	TURF REINFORCEMENT MAT
STATION +/-	TO	STATION +/-	SIDE	ACRE	POUND	POUND	POUND	SQ YD	SQ YD
				25000210	25000400	25000500	25000600	25100630	25100900
I-57									
226+57	TO	234+11	RT	0.78	71	71	71	3776	
229+40	TO	235+51	LT	0.51	46	46	46	2469	
E MAPLE ST									
15+41	TO	17+70	LT	0.10	9	9	9	484	
15+55	TO	16+44	RT	0.01	1	1	1	49	
16+78	TO	18+34	RT	0.11	10	10	10	533	
WALDRON RD									
21+04	TO	22+04	LT	0.07	7	7	7	236	103
21+72	TO	26+35	RT	0.23	21	21	21	855	259
22+48	TO	26+35	LT	0.15	14	14	14	726	
MUN 2530									
10+31	TO	12+00	LT	0.02	2	2	2	97	
10+37	TO	12+00	RT	0.06	6	6	6	291	
TOTAL				2.04	187	187	187	9516	362
USE				2.25	190	190	190	9516	362

MODEL: Rev 1
FILE NAME: 1208057_S&S-Erosion Schedule.dgn

IL-57 DRAINAGE STRUCTURE SCHEDULE

STRUCTURE NUMBER	STATION	ALIGNMENT	OFFSET	STRUCTURE TYPE	FRAME AND GRATE	RIM ELEV.	INVERTS				PAY ITEM	STANDARD NO.	SHEET NO.
							NORTH	SOUTH	EAST	WEST			
1-01	227+40	CL PR I-57	96.9 RT	MANHOLE, TYPE A 4' DIA	TYPE 1 FRAME, CLOSED LID	644.00	-	639.00	637.50	-	60218400 *	602401-06/604001-05	74
1-02	227+13	CL PR I-57	62.9 RT	MANHOLES, TYPE A, 8' DIAMETER	TYPE 1 FRAME, CLOSED LID	632.35	-	625.45	-	-	60224459 *	602416-08/604001-05	74
1-03	229+08	CL PR I-57	62.7 RT	MANHOLES, TYPE A, 8' DIAMETER	TYPE 1 FRAME, CLOSED LID	631.14	624.67	624.57	-	-	60224459 *	602416-08/604001-05	74
1-04	230+32	CL PR I-57	54.1 LT	CATCH BASIN, TYPE A 4' DIA	TYPE 1 FRAME, OPEN LID	631.00	626.83	-	-	-	60200105 *	602001-02/604001-05	74
1-05	230+44	CL PR I-57	61.8 LT	CATCH BASIN, TYPE A 4' DIA	TYPE 1 FRAME, OPEN LID	630.91	-	625.62	-	-	60200105 *	602401-06/604001-05	74
1-06	230+21	CL PR I-57	62.7 LT	MANHOLES, TYPE A, 8' DIAMETER	TYPE 1 FRAME, CLOSED LID	630.81	624.12	624.02	-	-	60224459 *	602416-08/604001-05	74
1-07	231+39	CL PR I-57	62.4 RT	MANHOLES, TYPE A, 8' DIAMETER	TYPE 1 FRAME, CLOSED LID	630.40	623.55	623.45	-	-	60224459 *	602416-08/604001-05	74
1-08	232+52	CL PR I-57	61.6 RT	MANHOLE, TYPE A 4' DIA	TYPE 1 FRAME, CLOSED LID	629.49	624.83	624.82	-	-	60218400 *	602001-02/604001-05	74
1-09	233+44	CL PR I-57	61.7 LT	MANHOLE, TYPE A 4' DIA	TYPE 1 FRAME, CLOSED LID	629.34	624.54	-	-	-	60218400 *	602401-06/604001-05	74
1-10	233+42	CL PR I-57	62.8 LT	MANHOLES, TYPE A, 8' DIAMETER	TYPE 1 FRAME, CLOSED LID	629.4	622.64	-	-	-	60224459 *	602416-08/604001-05	74
1-11	229+35	CL PR I-58	43.5 LT	CATCH BASINS, TYPE C, WITH MEDIAN INLET (604101)	-	637.28	-	626.97	-	-	60209005 *	602011/604101-01	74
1-12	227+40	CL PR I-57	69.7 LT	PRECAST REINFORCED CONCRETE FLARED END SECTIONS 15"	-	-	-	-	-	635.00	54213660 *	542301-03	74

WALDRON ROAD DRAINAGE STRUCTURE SCHEDULE

STRUCTURE NUMBER	STATION	ALIGNMENT	OFFSET	STRUCTURE TYPE	FRAME AND GRATE	RIM ELEV.	INVERTS				PAY ITEM	STANDARD NO.	SHEET NO.
							NORTH	SOUTH	EAST	WEST			
3-01	16+15	WALDRON RD.	21.0 RT	INLET, TYPE A	TYPE 1 FRAME, OPEN LID	659.88	656.13	-	-	-	60234200 *	602301-04/604001-05	76
3-02	16+16	WALDRON RD.	21.0 LT	MANHOLE, TYPE A 4' DIA	TYPE 1 FRAME, OPEN LID	659.88	-	655.74	654.12	-	60218300 *	602401-06/604001-05	76
3-03	17+43	WALDRON RD.	17.1 LT	CATCH BASIN, TYPE A 4' DIA	TYPE 1 FRAME, OPEN LID	658.72	646.95	647.05	653.72	652.27	60200105 *	602001-02/604001-05	76
3-04	17+44	WALDRON RD.	21.0 RT	MANHOLE, TYPE A 4' DIA	TYPE 1 FRAME, OPEN LID	658.63	647.40	-	647.50	-	60218300 *	602401-06/604001-05	76
3-05	17+89	WALDRON RD.	66.3 RT	PRECAST REINFORCED CONCRETE FLARED END SECTIONS 12"	-	-	648.22	-	-	-	54213657 *	542301-03	76
3-06	17+64.57	WALDRON RD.	15.9 LT	INLET, TYPE A	TYPE 1 FRAME, OPEN LID	658.71	-	-	-	654.16	60234200 *	602301-04/604001-05	76
3-07	17+64.57	WADRON RD.	19.7 RT	CATCH BASIN, TYPE A 4' DIA	TYPE 1 FRAME, OPEN LID	658.64	-	647.77	-	647.67	60200105 *	602001-02/604001-05	76
4-01	21+95	WADRON RD.	13.0 RT	INLET, TYPE A	TYPE 1 FRAME, OPEN LID	651.06	646.47	-	-	-	60234200 *	602301-04/604001-05	77
4-02	21+95	WADRON RD.	21.5 LT	MANHOLE, TYPE A 4' DIA	TYPE 1 FRAME, OPEN LID	650.86	-	646.15	643.45	-	60218300 *	602401-06/604001-05	77
4-03	22+72	WADRON RD.	13.0 RT	INLET, TYPE A	TYPE 1 FRAME, OPEN LID	647.30	642.71	-	-	-	60234200 *	602301-04/604001-05	77
4-04	22+73	WADRON RD.	13.3 LT	MANHOLE, TYPE A 4' DIA	TYPE 1 FRAME, OPEN LID	647.25	-	641.45	641.35	642.71	60218300 *	602401-06/604001-05	77
4-05	24+76	WADRON RD.	13.0 LT	CATCH BASIN, TYPE A 4' DIA	TYPE 1 FRAME, OPEN LID	637.34	633.48	-	-	633.48	60200105 *	602001-02/604001-05	77
4-06	24+76	WADRON RD.	32.1 LT	PRECAST REINFORCED CONCRETE FLARED END SECTIONS 15"	-	-	-	633.37	-	-	54213660 *	542301-03	77
4-07	24+74	WADRON RD.	13.0 RT	INLET, TYPE A	TYPE 1 FRAME, OPEN LID	637.40	-	633.50	-	-	60234200 *	602301-04/604001-05	77
4-08	24+74	WADRON RD.	25.0 RT	CATCH BASIN, TYPE A 4' DIA	TYPE 1 FRAME, OPEN LID	636.77	633.11	631.67	631.67	-	60200105 *	602001-02/604001-05	77
4-09	24+74	WADRON RD.	45.7 RT	INLETS, TYPE A	TYPE 9 FRAME AND GRATE	634.15	631.84	-	-	-	60236600 *	602301-04/604041-03	77
4-10	26+30	WADRON RD.	13.0 LT	CATCH BASIN, TYPE A 4' DIA	TYPE 1 FRAME, OPEN LID	631.77	629.33	-	-	-	60200105 *	602001-02/604001-05	77
4-11	26+30	WADRON RD.	28.2 LT	PRECAST REINFORCED CONCRETE FLARED END SECTIONS 12"	-	-	-	629.26	-	-	54213657 *	542301-03	77
4-12	26+31	WADRON RD.	13.0 RT	CATCH BASIN, TYPE A 4' DIA	TYPE 1 FRAME, OPEN LID	631.7498	-	629.19	-	-	60200105 *	602001-02/604001-05	77
4-13	26+31	WADRON RD.	29.1 RT	PRECAST REINFORCED CONCRETE FLARED END SECTIONS 12"	-	-	629.10	-	-	-	54213657 *	542301-03	77
4-14	25+37	WADRON RD.	28.4 RT	PRECAST REINFORCED CONCRETE FLARED END SECTIONS 15"	-	-	-	-	-	631.00	54213660 *	542301-03	77
4-15	25+31	WADRON RD.	24.1 RT	MANHOLE, TYPE A 4' DIA	TYPE 1 FRAME, CLOSED LID	634.00	-	-	631.10	631.10	60218400 *	602401-06/604001-05	77
4-16	25+33	WADRON RD.	36.1 RT	PRECAST REINFORCED CONCRETE FLARED END SECTIONS 12"	-	-	-	-	631.00	-	54213657 *	542301-03	77
4-17	25+23	WADRON RD.	39.9 RT	MANHOLE, TYPE A 4' DIA	TYPE 1 FRAME, CLOSED LID	634.00	-	EX. INVERT	631.05	-	60218400 *	602401-06/604001-05	77

NOTE:

1. FOR STRUCTURES ALONG WALDRON ROAD CURB AND GUTTER, THE RIM ELEVATIONS AND OFFSETS ARE GIVEN AT EDGE OF PAVEMENT.
2. FOR STRUCTURES NOT LOCATED WITHIN CURB AND GUTTER, THE RIM ELEVATIONS AND OFFSETS ARE GIVEN AT CENTER OF STRUCTURES.

MODEL: PWS-1
FILE NAME: C:\WORK\2021\IL-57\DRainage\STRUCTURE-01.dwg

TranSmart
411 South Wells Street Suite 1000
Chicago, Illinois 60607

USER NAME	AKC	DESIGNED	AKC	REVISED	-
DRAWN	AKC	CHECKED	PKT	REVISED	-
PLOT SCALE	0.18698633" = 1'	DATE	2021/07/09	REVISED	-
PLOT DATE	7/9/2021				

STATE OF ILLINOIS
DEPARTMENT OF TRANSPORTATION

DRAINAGE STRUCTURE SCHEDULE

SCALE: NTS SHEET 1 OF 2 SHEETS STA. TO STA.

F.A.I. RTE.	SECTION	COUNTY	TOTAL SHEETS	SHEET NO.
57	139 HBR-6	KANKAKEE	202	27
CONTRACT NO. 68997				
ILLINOIS FED. AID PROJECT				

IL-57 PIPE SCHEDULE

PIPE NO.	STRUCTURE		PIPE SIZE (INCHES)	LENGTH (FEET)	SLOPE (%)	PAY ITEM	PAY ITEM DESCRIPTION	TRENCH BACKFILL (CUBIC YARD)	SHEET NO.
	FROM	TO							
1-01	1-01	1-12	15	18.9	13.23%	550A0360	STORM SEWERS, CLASS A, TYPE 2 15"	-	74
1-02	1-02	1-03	43 X 68	185.1	0.42%	542A5509	PIPE CULVERTS, CLASS A, TYPE 1 EQUIVALENT ROUND-SIZE 54"	176.8	74
1-03	1-03	1-06	43 X 68	102.4	0.44%	542A5509	PIPE CULVERTS, CLASS A, TYPE 1 EQUIVALENT ROUND-SIZE 54"	94.1	74
1-04	1-04	EX STR	12	40.4	1.00%	550A0050	STORM SEWERS, CLASS A, TYPE 1 12"	6.3	74
1-05	1-05	1-08	18	203.8	0.39%	550A0380	STORM SEWERS, CLASS A, TYPE 2 18"	73.0	74
1-06	1-06	1-07	43 X 68	108.7	0.43%	542A5509	PIPE CULVERTS, CLASS A, TYPE 1 EQUIVALENT ROUND-SIZE 54"	107.7	74
1-07	1-07	1-10	43 X 68	192.6	0.42%	542A5509	PIPE CULVERTS, CLASS A, TYPE 1 EQUIVALENT ROUND-SIZE 54"	197.7	74
1-08	1-08	1-09	18	87.8	0.32%	550A0380	STORM SEWERS, CLASS A, TYPE 2 18"	28.1	74
1-09	1-11	EX STR	12	53.9	1.00%	550A0340	STORM SEWERS, CLASS A, TYPE 2 12"	24.9	74

WALDRON ROAD PIPE SCHEDULE

PIPE NO.	STRUCTURE		PIPE SIZE (INCHES)	LENGTH (FEET)	SLOPE (%)	PAY ITEM	PAY ITEM DESCRIPTION	TRENCH BACKFILL (CUBIC YARD)	SHEET NO.
	FROM	TO							
3-01	3-01	3-02	12	39.3	1.00%	550A0050	STORM SEWERS, CLASS A, TYPE 1 12"	5.2	76
3-02	3-02	3-03	15	101.2	1.50%	550A0360	STORM SEWERS, CLASS A, TYPE 2 15"	43.4	76
			15	22.0		Z0056610	STORM SEWER (WATER MAIN REQUIREMENTS) 15 INCH		
3-03	3-03	1-01	15	120.1	6.62%	550A0660	STORM SEWERS, CLASS A, TYPE 3 15"	-	76
3-04	3-04	3-03	12	34.0	1.03%	550A0640	STORM SEWERS, CLASS A, TYPE 3 12"	46.0	76
3-05	3-05	3-07	12	44.5	1.01%	550A0340	STORM SEWERS, CLASS A, TYPE 2 12"	20.4	76
3-06	3-06	3-03	12	17.5	2.50%	550A0340	STORM SEWERS, CLASS A, TYPE 2 12"	3.0	76
3-07	3-07	3-04	12	17.0	1.00%	550A0340	STORM SEWERS, CLASS A, TYPE 2 12"	21.9	76
4-01	4-01	4-02	12	32.0	0.44%	550A0340	STORM SEWERS, CLASS A, TYPE 2 12"	5.2	77
4-02	4-02	4-04	15	74.0	1.00%	550A0360	STORM SEWERS, CLASS A, TYPE 2 15"	22.6	77
4-03	4-03	4-04	15	25.3	4.99%	550A0340	STORM SEWERS, CLASS A, TYPE 2 15"	5.4	77
4-04	4-04	4-05	15	199.0	3.96%	550A0070	STORM SEWERS, CLASS A, TYPE 1 15"	35.5	77
4-05	4-05	4-06	15	11.0	1.00%	550A0070	STORM SEWERS, CLASS A, TYPE 1 15"	-	77
4-07	4-07	4-08	12	7.8	5.00%	Z0056608	STORM SEWER (WATER MAIN REQUIREMENTS) 12 INCH	1.9	77
4-08	4-08	4-15	15	56.9	1.00%	550A0070	STORM SEWERS, CLASS A, TYPE 1 15"	15.4	77
4-09	4-09	4-08	12	21.4	0.81%	Z0056608	STORM SEWER (WATER MAIN REQUIREMENTS) 12 INCH	5.1	77
4-10	4-10	4-11	12	7.0	0.99%	550A0050	STORM SEWERS, CLASS A, TYPE 1 12"	-	77
4-11	4-12	4-13	12	6.2	1.49%	550A0050	STORM SEWERS, CLASS A, TYPE 1 12"	-	77
4-12	4-15	4-14	15	1.1	9.09%	550A0070	STORM SEWERS, CLASS A, TYPE 1 15"	-	77
4-13	4-17	4-16	12	3.1	1.64%	550A0050	STORM SEWERS, CLASS A, TYPE 1 12"	-	77

PIPE UNDERDRAINS SCHEDULE

FROM			TO			LENGTH (FT)	PAYITEM	PAY ITEM DESCRIPTION	SHEET NO.
STATION	ALIGNMENT	OFFSET	STATION	ALIGNMENT	OFFSET				
17+64	WALDRON RD.	0.6 LT	17+65	WALDRON RD.	16.4 LT	16	60108501	PIPE UNDERDRAINS, TYPE 2	76
17+64	WALDRON RD.	1.0 RT	17+65	WALDRON RD.	17.7 RT	17	60108501	PIPE UNDERDRAINS, TYPE 1	76
26+34	WALDRON RD.	0.6 LT	26+32	WALDRON RD.	13.9 LT	15	60108501	PIPE UNDERDRAINS, TYPE 8	77
26+34	WALDRON RD.	0.4 RT	26+32	WALDRON RD.	14.0 RT	15	60108501	PIPE UNDERDRAINS, TYPE 6	77



USER NAME = gnh00
PLOT SCALE = 0.10000033 / 1 in.
PLOT DATE = 7/9/2021

DESIGNED - AKC
DRAWN - AKC
CHECKED - PKT
DATE - 2021/07/09

REVISED -
REVISED -
REVISED -
REVISED -

STATE OF ILLINOIS
DEPARTMENT OF TRANSPORTATION

DRAINAGE PIPE SCHEDULE

SCALE: NTS SHEET 2 OF 2 SHEETS STA. TO STA.

F.A.I. RTE.	SECTION	COUNTY	TOTAL SHEETS	SHEET NO.
67	139 HBR-6	KANKAKEE	202	26
CONTRACT NO. 66997				
ILLINOIS FED. AID PROJECT				

PAVEMENT MARKING SCHEDULE																		
LOCATION	PREFORMED PLASTIC PAVEMENT MARKING, TYPE D				POLYUREA PAVEMENT MARKING TYPE 1				THERMOPLASTIC PAVEMENT MARKING				GROOVING FOR RECESSED PAVEMENT MARKING					
	6"		24"		4"		6"		4"		6"		12"		5"		7"	
	SKIP DASH		STOP BAR		SOLID		SKIP DASH		SOLID		SKIP DASH		SOLID		SOLID		SKIP DASH	
	WHITE		WHITE		WHITE		YELLOW		YELLOW		WHITE		YELLOW		WHITE		WHITE	
	X2700010		X2700015		78008210		78008230		78000200		78000400		78000600		X7830070		X7830074	
STATION	TO	STATION	DIRECTION	FOOT														
I-57																		
210+25	TO	236+00	SB	650		2575	2575								5150	650		
227+00	TO	249+87	NB	580		2287	2287								4574	580		
E MAPLE ST																		
11+55	TO	17+60	EB/WB		15					883	160	92	165		883	160		
17+60	TO	21+76	EB/WB			832	110											
WALDRON RD																		
21+76	TO	29+11	EB/WB		26					1390	190				1390	190		
SUB-TOTAL				1230	41	5694	4862	110	2273	350	92	165	11997	1580				
TOTAL				1230	41	10556		110	2273	442		165	11997	1580				

RAISED REFLECTIVE PAVEMENT MARKER SCHEDULE				
LOCATION				1-WAY CRYSTAL
STATION	TO	STATION	DIRECTION	EACH
				78100100
I-57				
210+25.0	TO	236+00.0	SB	65
227+00.0	TO	249+87.0	NB	58
SUB-TOTAL				123
TOTAL				123

RAISED REFLECTIVE PAVEMENT MARKER REMOVAL SCHEDULE				
LOCATION				EACH
STATION	TO	STATION	DIRECTION	
				78300200
I-57				
210+25	TO	236+00	SB	65
227+00	TO	249+87	NB	58
TOTAL				123

SHOULDER RUMBLE STRIPS SCHEDULE				
LOCATION				16 INCH
STATION	TO	STATION	DIRECTION	FOOT
				64200116
I-57				
218+82.0	TO	235+61.0	SB	1679
228+05.0	TO	242+35.0	NB	1430
SUB-TOTAL				3109
TOTAL				3109

SIGNING REMOVAL SCHEDULE			
STATION	SIDE	SIGN DESCRIPTION	REMOVE SIGN PANEL ASSEMBLY - TYPE A
			EACH
			72400100
E MAPLE ST			
16+60	23.4' LT	SPEED LIMIT	1
16+84	38.0' RT	STOP SIGN	1
17+02	27.5' RT	SPEED LIMIT	1
WALDRON RD			
21+85	37.9' LT	STOP SIGN	1
26+36	24.8' LT	SPEED LIMIT	1
26+37	20.0' RT	SPEED LIMIT	1
TOTAL			6

SIGN PANEL AND SIGN SUPPORTS SCHEDULE					
LOCATION		SIGN DESIGNATION	SIGN	SIGN	WOOD SIGN SUPPORT
			TYPE 1	TYPE 2	
STATION	SIDE		SQ FT	SQ FT	FOOT
			72000100	72000200	73000100
I-57					
229+05	RT	SEE SIGN DETAIL SHEET FOR MORE INFORMATION		9.75	23.0
232+00	LT			9.75	23.0
E MAPLE ST					
16+50	LT	R2-1	7.50		13.0
16+84	RT	R1-1	6.25		14.5
17+15	RT	R2-1	7.50		13.0
WALDRON RD					
21+96	LT	R1-1	6.25		14.5
26+30	LT	R2-1	7.50		13.0
	RT	R2-1	7.50		13.0
TOTAL			42.50	19.50	127.0
USE			43	20	127

PAVEMENT MARKING REMOVAL - WATER BLASTING				
STATION	TO	STATION	LOCATION	LINES 4" SQ FT
X0327980				
I-57				
210+25	TO	236+00	SB	217
227+00	TO	249+87	NB	194
WALDRON ROAD				
11+54	TO	29+11	CL	147
TOTAL				558

SHORT TERM PAVEMENT MARKING REMOVAL SCHEDULE				
		DIRECTION	WHITE	YELLOW
			SQ FT	
70300150				
I-57				
210+25	TO	236+00	SB	320
227+00	TO	249+87	NB	285
E MAPLE ST				
11+55	TO	21+25	EB/WB	54
WALDRON RD				
21+25	TO	29+11	EB/WB	72
SUB-TOTAL			605	126
TOTAL			731	

SHORT TERM PAVEMENT MARKING SCHEDULE							
STATION	TO	STATION	DIRECTION	SKIP DASH	SOLID	SOLID	SKIP DASH
				WHITE	WHITE	WHITE	YELLOW
				TURN LANE	EDGE DIAGONAL	STOP BAR	CENTERLINE
				FOOT			
				70300100			
I-57							
210+25	TO	236+00	SB	650	309	0	0
227+00	TO	249+87	NB	580	274	0	0
I-57 SUB-TOTAL				1230	583	0	0
2 APPLICATIONS				2460	1167	0	0
E MAPLE ST							
11+55	TO	21+25	EB/WB	0	0	0	160
E MAPLE ST SUB-TOTAL				0	0	0	160
2 APPLICATIONS				0	0	0	320
WALDRON RD							
21+25	TO	29+11	EB/WB	0	0	26	190
WALDRON RD SUB-TOTAL				0	0	26	190
2 APPLICATIONS				0	0	52	380
SUB-TOTAL				2460	1167	52	700
TOTAL				4379			

Hutchinson Engineering, Inc.
Jacksonville Moline Peoria Shorewood
Since 1945

USER NAME = gahz	DESIGNED -	REVISED -
PLOT SCALE = 0.1888833' / in.	DRAWN -	REVISED -
PLOT DATE = 7/8/2021	CHECKED -	REVISED -
	DATE = 2021/03/26	REVISED -

STATE OF ILLINOIS
DEPARTMENT OF TRANSPORTATION


PAVEMENT MARKING AND
SIGNING SCHEDULE

SCALE: SHEET 1 OF 1 SHEETS STA. TO STA.


F.A.I. RTE.	SECTION	COUNTY	TOTAL SHEETS	SHEET NO.
87	139 HBR-6	KANKAKEE	202	29
CONTRACT NO. 66997				
ILLINOIS FED. AID PROJECT				

PR CURVE PR-WALDRON
PI STA = 17+07.05
Δ = 01°16'24" (RT)
D = 01°05'44"
R = 5,230.00'
T = 58.12'
E = 0.32'
e = N/A
TR = N/A
SE RUN = N/A
PC STA = 16+48.93
PT STA = 17+65.17

PR CURVE MUN2530
PI STA = 11+48.82
Δ = 13°47'32" (RT)
D = 19°05'55"
R = 300.00'
T = 36.28'
E = 2.19'
e = N/A
TR = N/A
SE RUN = N/A
PC STA = 11+12.54
PT STA = 11+84.76

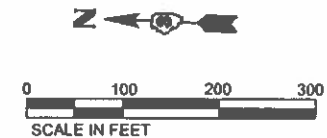


DESCRIPTION	COORDINATE	
	NORTHING	EASTING
PROPOSED EAST MAPLE STREET / WALDRON ROAD		
POT STA. 13+17.47	1,618,503.62	1,121,118.78
PC STA 16+48.93	1,618,246.98	1,121,328.52
PI STA 17+07.05	1,618,201.97	1,121,365.30
PT STA 17+65.17	1,618,156.17	1,121,401.07
POT STA 31+64.25	1,617,053.43	1,122,262.12
PROPOSED MUN 2530		
POT STA 10+00.00	1,617,786.33	1,121,689.85
PC STA 11+12.54	1,617,869.95	1,121,765.17
PI STA 11+48.82	1,617,896.90	1,121,789.46
PT STA 11+84.76	1,617,917.29	1,121,819.47
POT STA 14+06.67	1,618,042.00	1,122,003.03
PROPOSED FAI ROUTE 57		
POT STA 224+00.00	1,618,650.99	1,121,496.65
POT STA 245+00.00	1,616,558.42	1,121,573.09
PROPOSED DUANE BOULEVARD		
POT STA. 30+00.00	1,618,109.87	1,121,182.26
POT STA. 32+00.00	1,618,237.09	1,121,336.58
EXISTING FAI ROUTE 57		
POT STA. 225+00.00	1,618,557.09	1,121,500.08
POT STA. 243+00.00	1,616,758.29	1,121,565.79

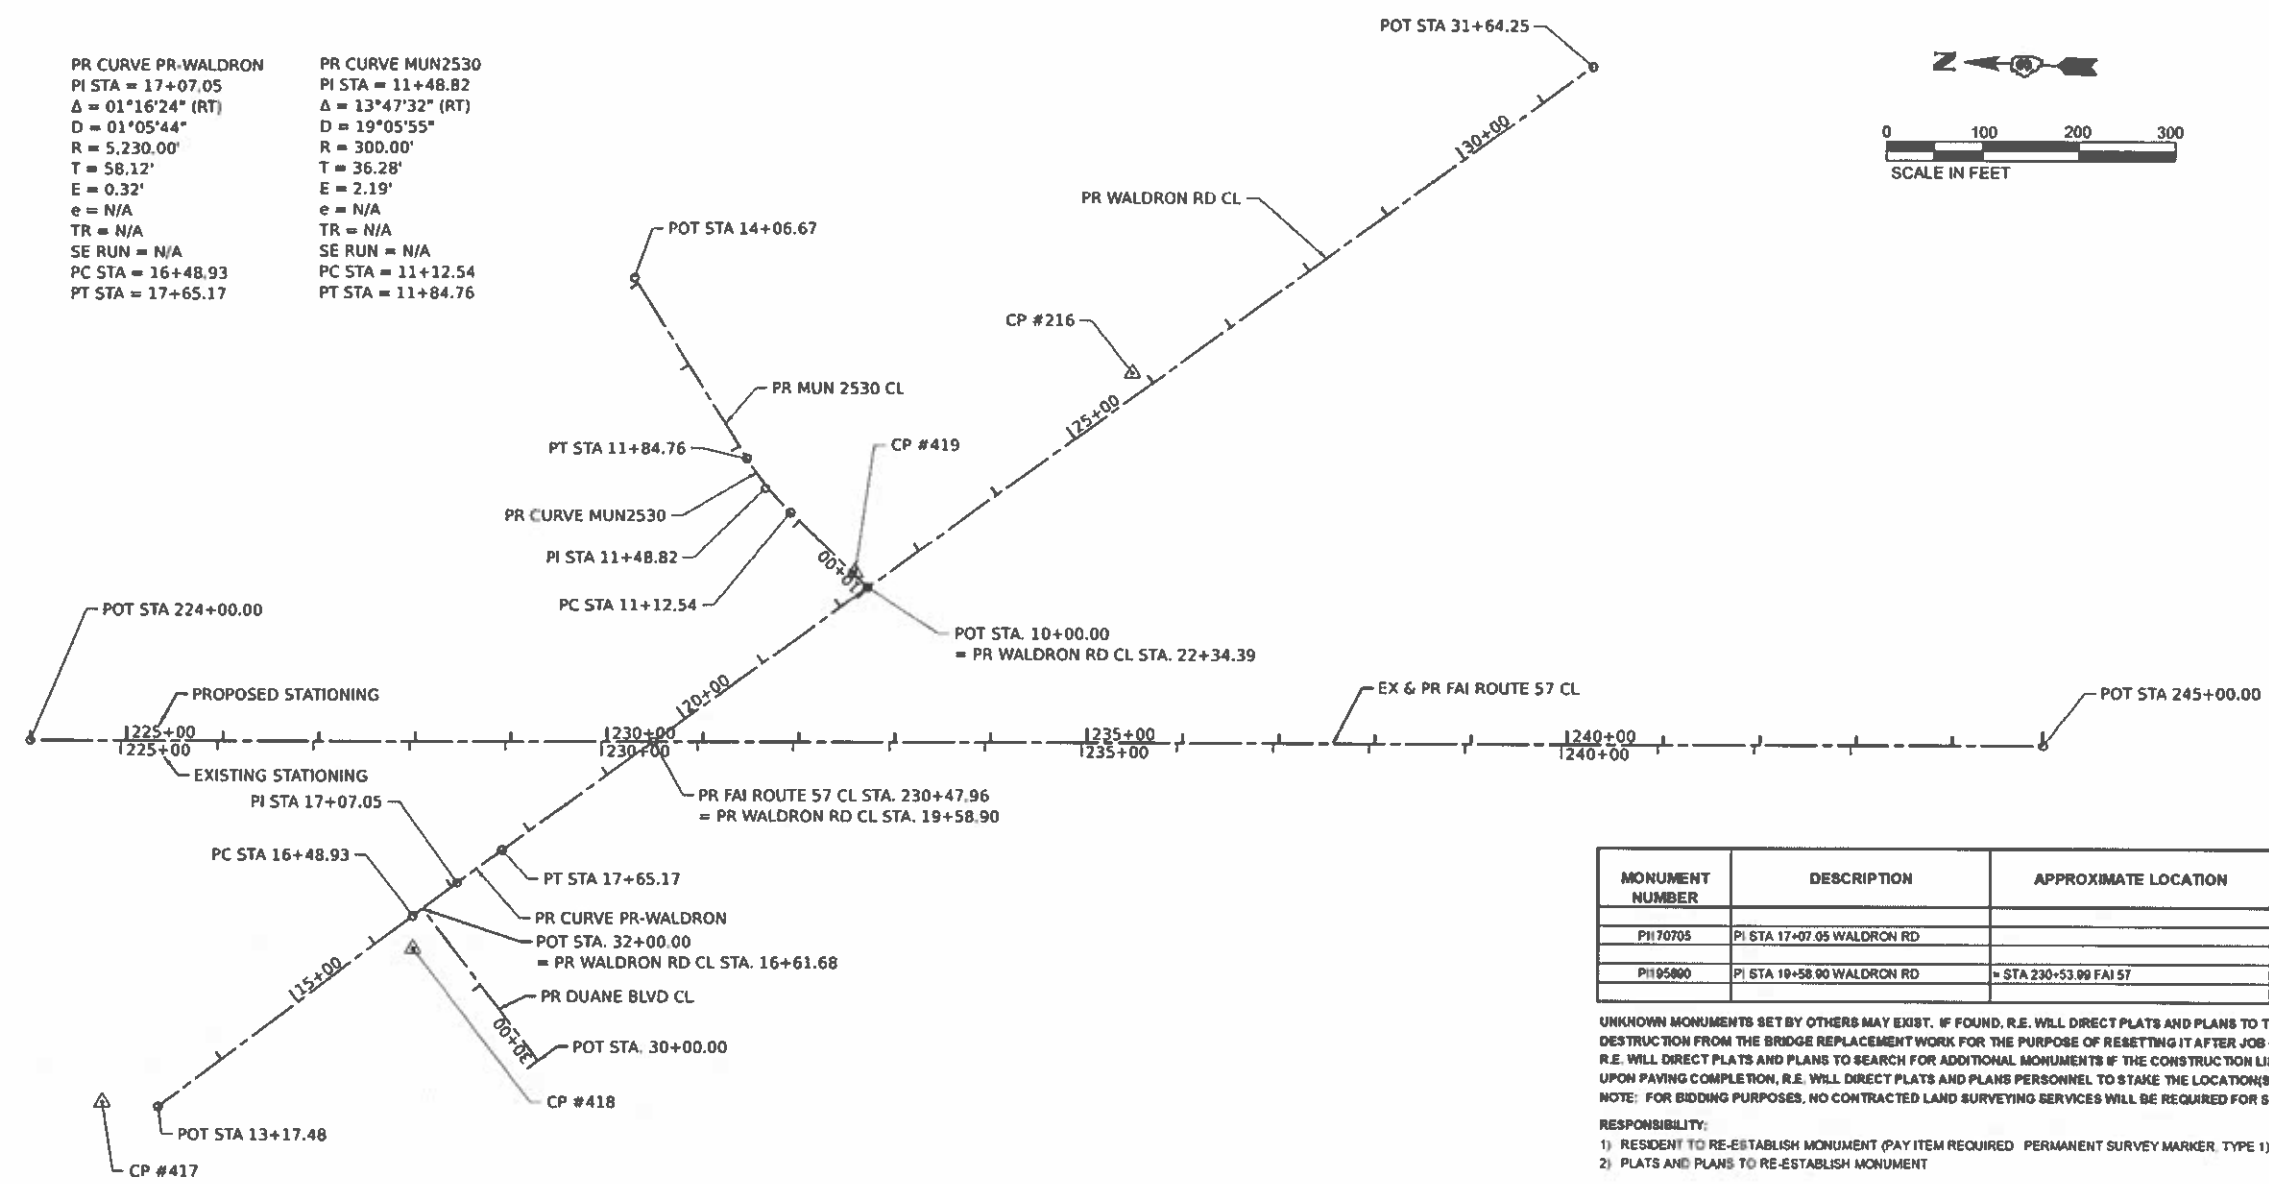


MONUMENT NUMBER	DESCRIPTION	APPROXIMATE LOCATION	EXISTING MONUMENT TYPE	PROPOSED MONUMENT TYPE	MONUMENT RECORD TO BE RECORDED	RESPONSIBILITY
PI170705	PI STA 17+07.05 WALDRON RD			TYPE 1	NO	2
PI195900	PI STA 19+58.90 WALDRON RD	= STA 230+53.99 FAI 57		CUT CROSS	NO	2

UNKNOWN MONUMENTS SET BY OTHERS MAY EXIST. IF FOUND, R.E. WILL DIRECT PLATS AND PLANS TO TO GPS ANY MONUMENT SUBJECT TO DESTRUCTION FROM THE BRIDGE REPLACEMENT WORK FOR THE PURPOSE OF RESETTling IT AFTER JOB COMPLETION.
R.E. WILL DIRECT PLATS AND PLANS TO SEARCH FOR ADDITIONAL MONUMENTS IF THE CONSTRUCTION LIMITS ARE EXPANDED DURING CONSTRUCTION.
UPON PAVING COMPLETION, R.E. WILL DIRECT PLATS AND PLANS PERSONNEL TO STAKE THE LOCATION(S) FOR TYPE 1 MONUMENT CORING.
NOTE: FOR BIDDING PURPOSES, NO CONTRACTED LAND SURVEYING SERVICES WILL BE REQUIRED FOR SETTING THE LISTED PERMANENT SURVEY MARKER.


RESPONSIBILITY:
1) RESIDENT TO RE-ESTABLISH MONUMENT (PAY ITEM REQUIRED PERMANENT SURVEY MARKER, TYPE 1)
2) PLATS AND PLANS TO RE-ESTABLISH MONUMENT

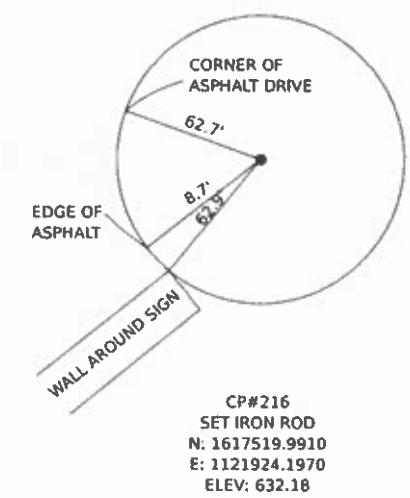


CP#216
SET IRON ROD
N: 1617519.9910
E: 1121924.1970
ELEV: 632.18

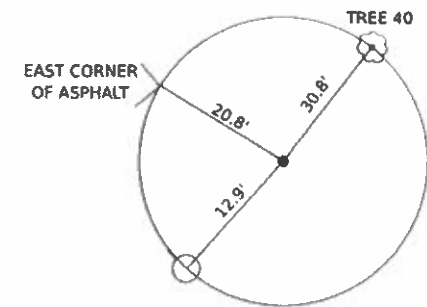

CP#417
SET IRON ROD
N: 1618561.3120
E: 1121120.9930
ELEV: 666.67

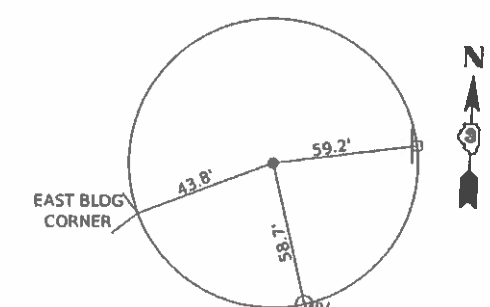

CP#418
SET IRON ROD
N: 1618245.13
E: 1121294.49
ELEV: 659.75

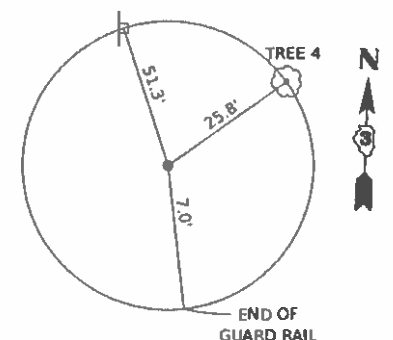

CP#419
SET IRON ROD
N: 1617800.1581
E: 1121705.1039
ELEV: 646.64

MODEL: Plan 1
FILE NAME: C:\Users\jsh\Documents\...



TranSmart
411 South Wells Street Suite 1000
Chicago, Illinois 60607

USER NAME	regulation	DESIGNED	BJD	REVISED	
		DRAWN	BJD	REVISED	
PLOT SCALE	0.19666633 / in.	CHECKED	TW	REVISED	
PLOT DATE	3/29/2021	DATE	2021/03/26	REVISED	


STATE OF ILLINOIS
DEPARTMENT OF TRANSPORTATION

I-57 & WALDRON ROAD
ALIGNMENT & TIES
SCALE: 1" = 100' SHEET 1 OF 1 SHEETS STA. TO STA.


F.A.I. RTE	SECTION	COUNTY	TOTAL SHEETS	SHEET NO.
57	139 HBR-6	KANKAKEE	202	30
CONTRACT NO. 66997				
ILLINOIS FED. AID PROJECT				

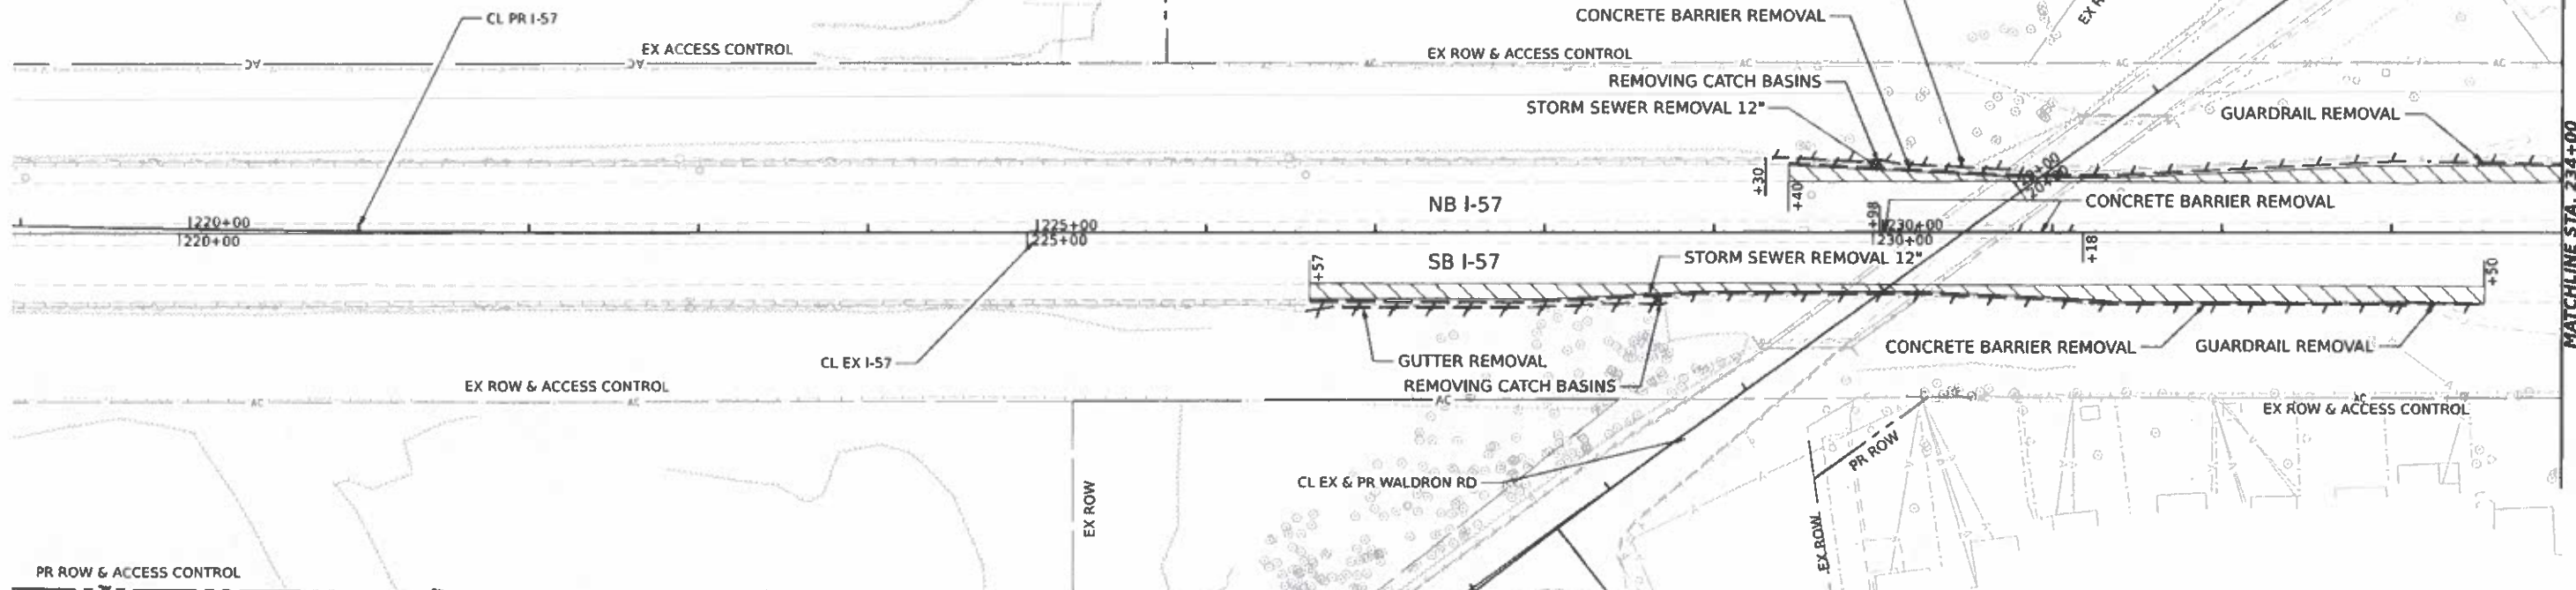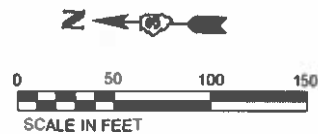

NOTE: SEE TREE REMOVAL SCHEDULE FOR TREES TO BE REMOVED

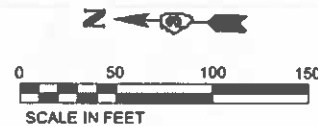

	PAVEMENT REMOVAL (44000100)		DRIVEWAY PAVEMENT REMOVAL (44000200)		INDIVIDUAL REMOVAL ITEM AS NOTED		LINEAR REMOVAL ITEM AS NOTED
	AGGREGATE SHOULDER REMOVAL (X4810200)		PAVED SHOULDER REMOVAL (44004250)		REMOVING CATCH BASINS (60500050)		GUTTER REMOVAL (44000400)
	HOT-MIX ASPHALT SURFACE REMOVAL, 3 3/4\"/>		SIDEWALK REMOVAL (44000600)		REMOVING INLETS (60500060)		COMBINATION CURB AND GUTTER REMOVAL (44000500)
					CONCRETE HEADWALL REMOVAL (50104400)		CONCRETE BARRIER REMOVAL (44001980)
					DRAINAGE STRUCTURE TO BE REMOVED (Z0018700)		PIPE CULVERT REMOVAL (50105220)
							STORM SEWER REMOVAL 12\"/>
							GUARDRAIL REMOVAL (63200310)
							FENCE REMOVAL (Z0022800)

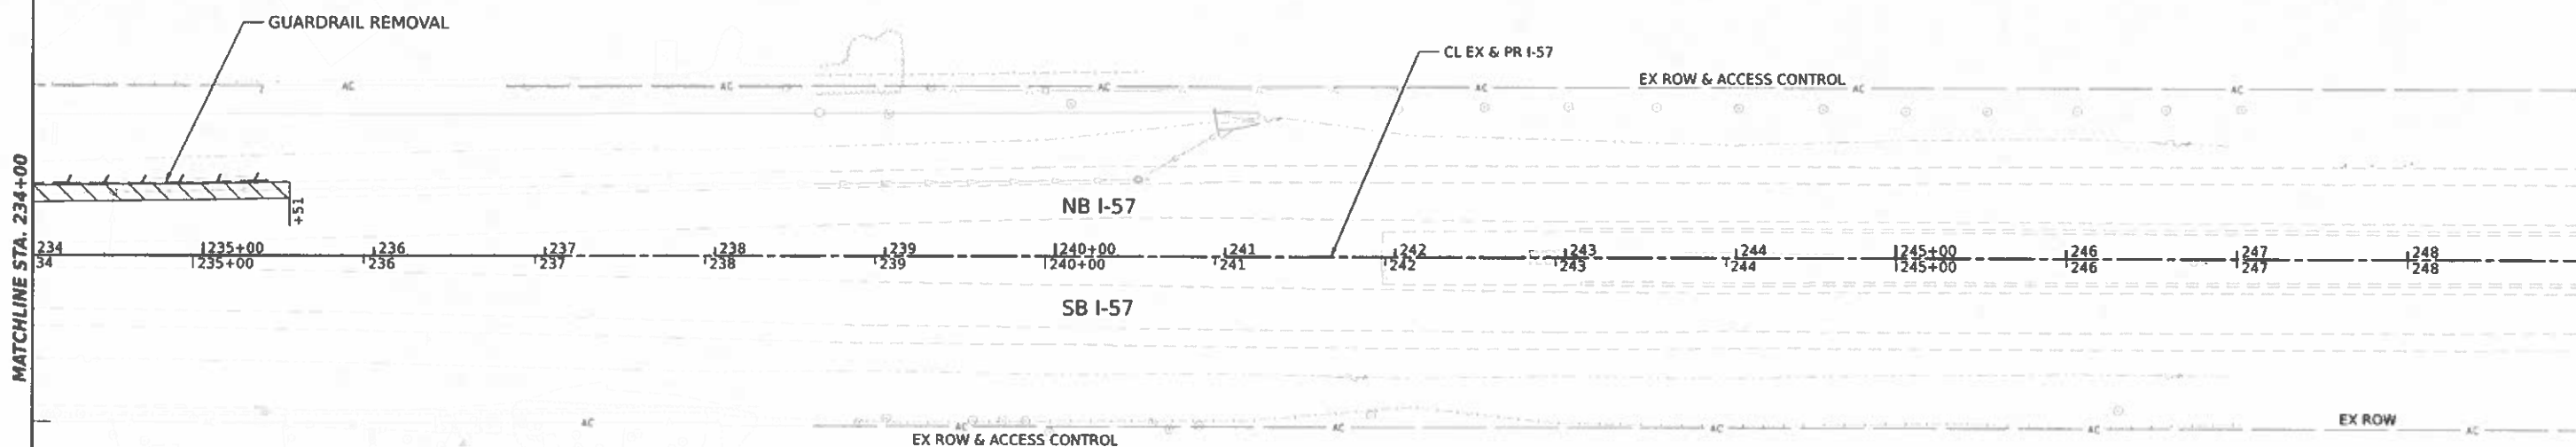

MODEL: Plan 1
FILE NAME: C:\Users\j\OneDrive\Documents\I-57 & Waldron Road Removal 1.dwg



TransSmart
411 South Wells Street Suite 1000
Chicago, Illinois 60607

USER NAME: j	DESIGNED: NS	REvised: 5/5/2021
PLOT SCALE: 1" = 50'	DRAWN: NS	REvised: -
PLOT DATE: 3/29/2021	CHECKED: TW	REvised: -
	DATE: 2021/03/26	REvised: -

STATE OF ILLINOIS
DEPARTMENT OF TRANSPORTATION



I-57 & WALDRON ROAD REMOVAL PLAN			
SCALE: 1" = 50'	SHEET 1	OF 3 SHEETS	STA. TO STA.

F.A.I. RTE.	SECTION	COUNTY	TOTAL SHEETS	SHEET NO.
57	139 HBR-6	KANKAKEE	202	31
CONTRACT NO. 66997				
ILLINOIS FED. AID PROJECT				

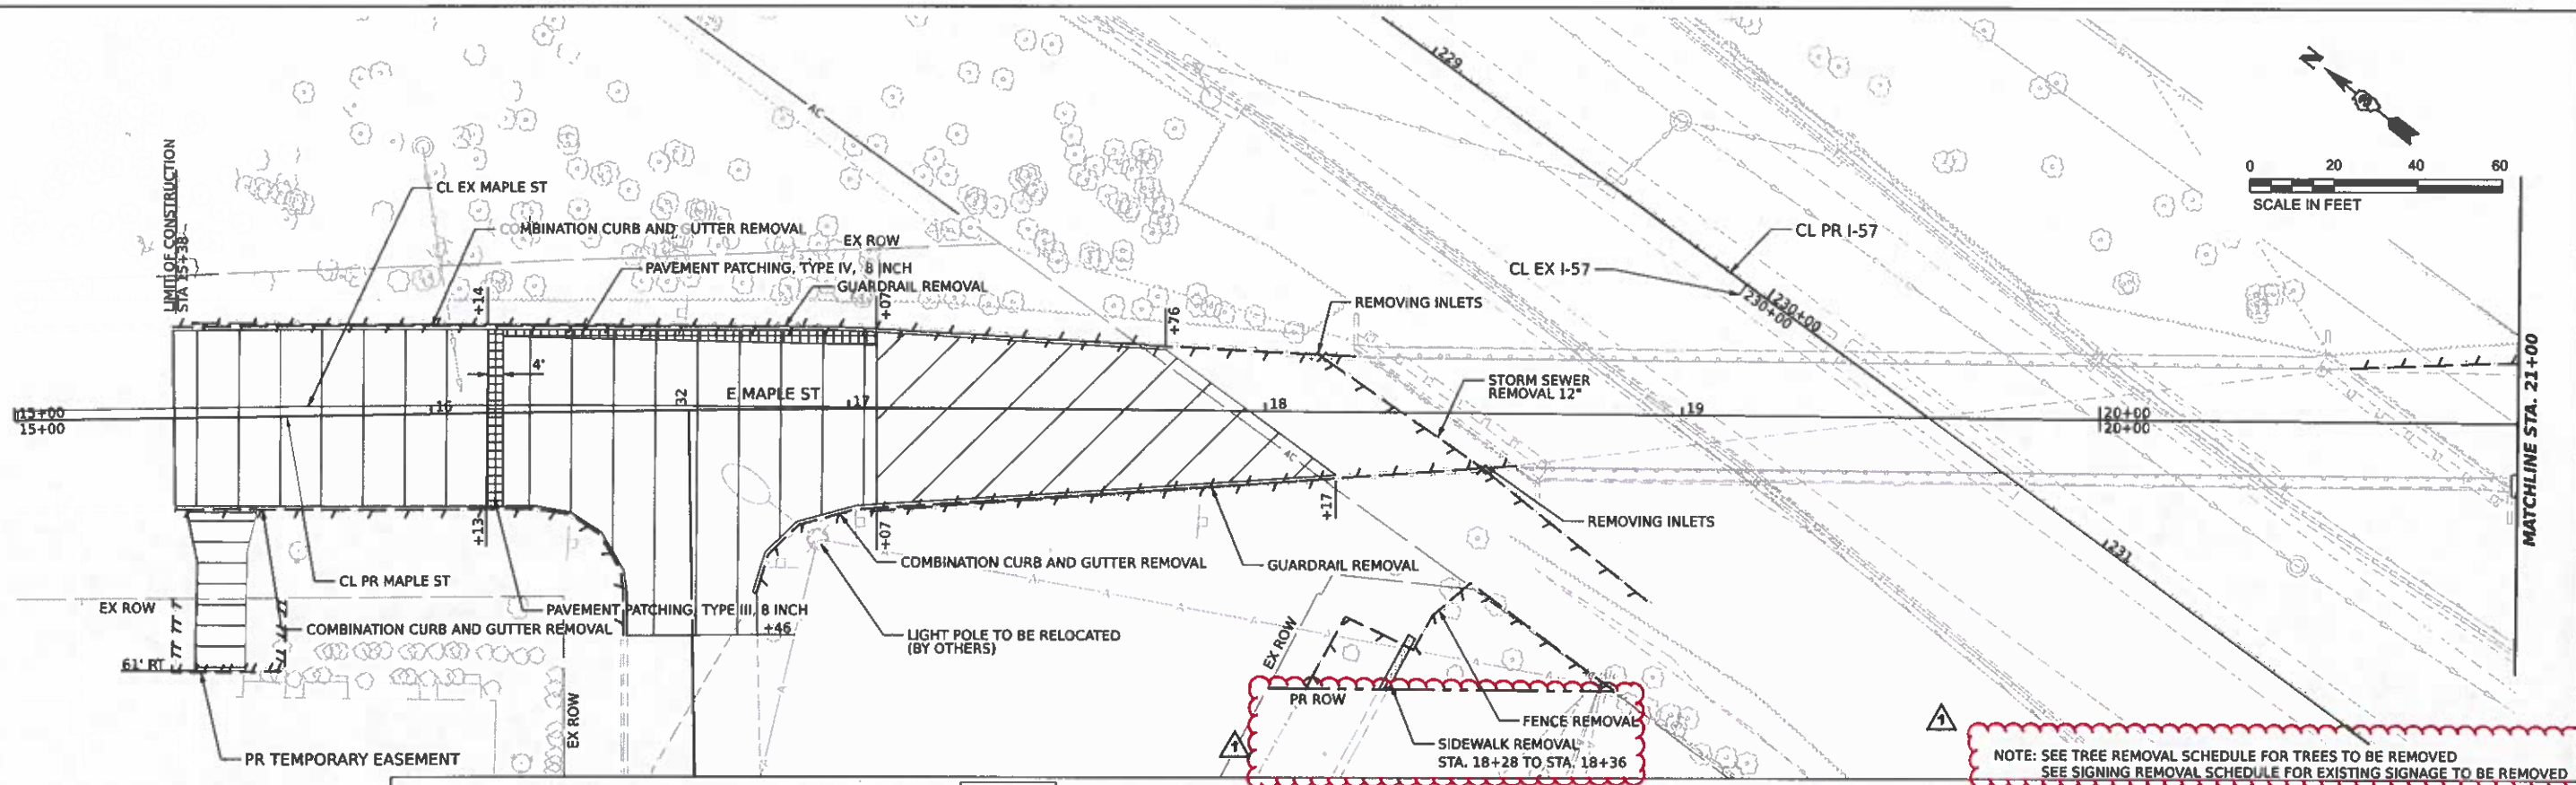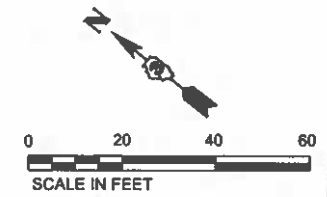

NOTE: SEE TREE REMOVAL SCHEDULE FOR TREES TO BE REMOVED
SEE SIGNING REMOVAL SCHEDULE FOR EXISTING SIGNAGE TO BE REMOVED

--- LINEAR REMOVAL ITEM AS NOTED
GUTTER REMOVAL (44000400)
COMBINATION CURB AND GUTTER REMOVAL (44000500)
CONCRETE BARRIER REMOVAL (44001980)
PIPE CULVERT REMOVAL (50105220)
STORM SEWER REMOVAL 12\"/>

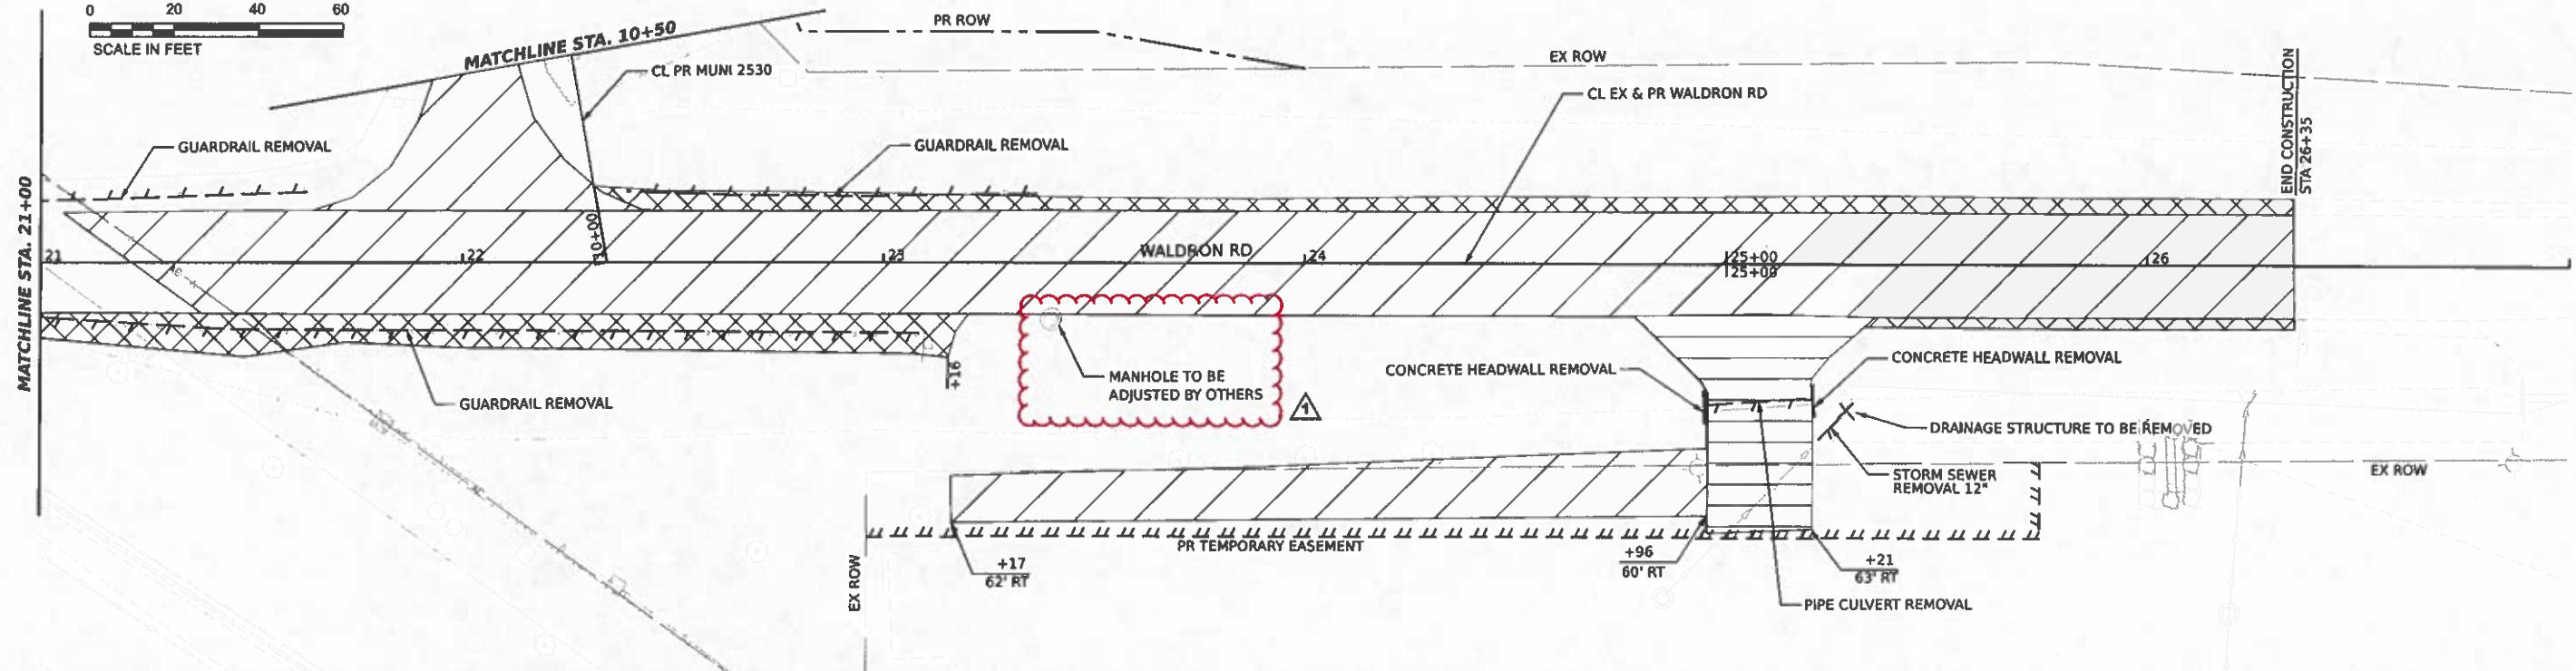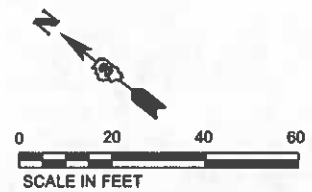

MODEL: Plan 1
FILE NAME: C:\Users\jgarcia\OneDrive\Documents\I-57

TransSmart
411 South Wells Street Suite 1000
Chicago, Illinois 60607

USER NAME	= dsh/c	DESIGNED	= NS	REVISED	=
PLOT SCALE	= 0.10000033' / in.	DRAWN	= NS	REVISED	=
PLOT DATE	= 7/6/2021	CHECKED	= TW	REVISED	=
		DATE	= 2021/03/26	REVISED	=



STATE OF ILLINOIS
DEPARTMENT OF TRANSPORTATION

I-57 & WALDRON ROAD
REMOVAL PLAN

SCALE: 1" = 20' SHEET 2 OF 3 SHEETS STA. TO STA.

F.A.I. RTE.	SECTION	COUNTY	TOTAL SHEETS	SHEET NO.
57	139 HBR-6	KANKAKEE	202	32
CONTRACT NO. 86897				
ILLINOIS FED. AID PROJECT				

REV. 08/25/21

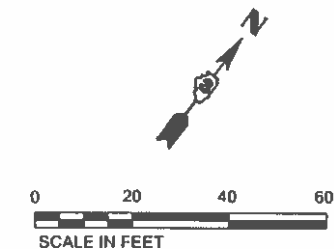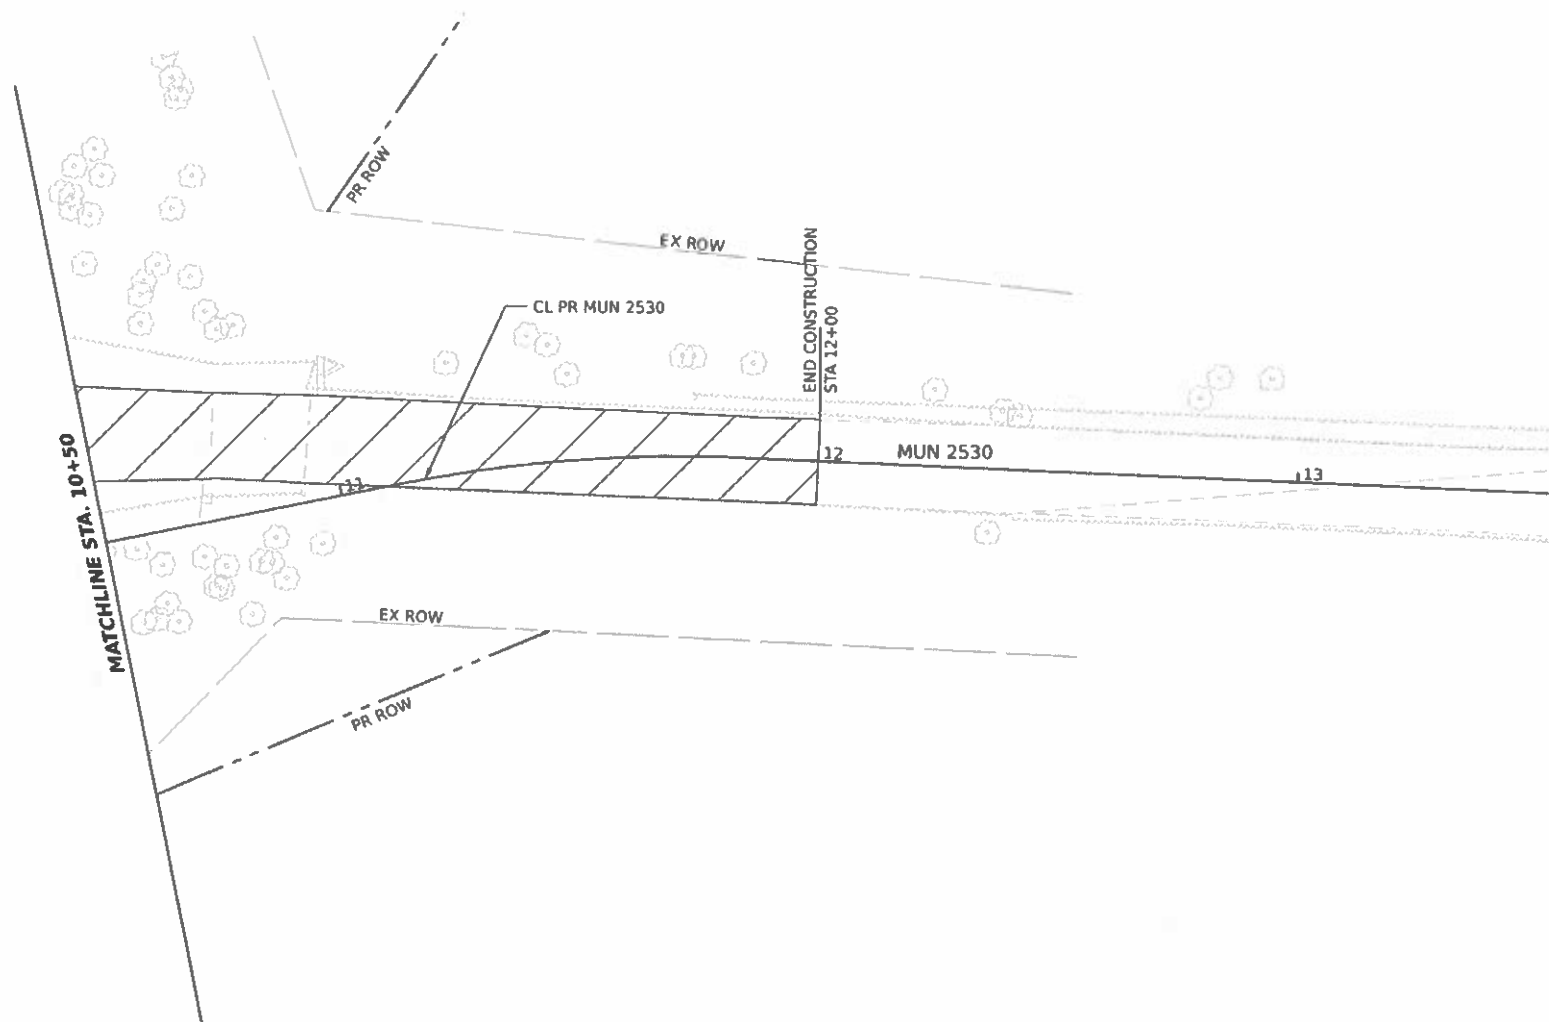

NOTE: SEE TREE REMOVAL SCHEDULE FOR TREES TO BE REMOVED

	PAVEMENT REMOVAL (44000100)		DRIVEWAY PAVEMENT REMOVAL (44000200)		INDIVIDUAL REMOVAL ITEM AS NOTED REMOVING CATCH BASINS (60500050) REMOVING INLETS (60500060) CONCRETE HEADWALL REMOVAL (50104400) DRAINAGE STRUCTURE TO BE REMOVED (Z0018700)		LINEAR REMOVAL ITEM AS NOTED GUTTER REMOVAL (44000400) COMBINATION CURB AND GUTTER REMOVAL (44000500) CONCRETE BARRIER REMOVAL (44001980) PIPE CULVERT REMOVAL (50105220) STORM SEWER REMOVAL 12" (55100500) GUARDRAIL REMOVAL (63200310) FENCE REMOVAL (Z0022800)
	AGGREGATE SHOULDER REMOVAL (X4810200)		PAVED SHOULDER REMOVAL (44004250)				
	HOT-MIX ASPHALT SURFACE REMOVAL, 3 3/4" (44000164)		SIDEWALK REMOVAL (44000600)		PAVEMENT PATCHING		

MODEL: Plan 5
FILE NAME: C:\Users\jsharpe\OneDrive\Documents\1-57 & Waldron Road\1-57 & Waldron Road\1-57 & Waldron Road 3.dgn

TranSmart
411 South Wells Street Suite 1000
Chicago, Illinois 60607


USER NAME	• rsharpe	DESIGNED	• NS	REVISED	•
DRAWN	• NS	CHECKED	• TW	REVIS	•
PLOT SCALE	• 0.1960833" = 1' in	DATE	• 2021/03/26	REVIS	•
PLOT DATE	• 3/29/2021				

STATE OF ILLINOIS
DEPARTMENT OF TRANSPORTATION


1-57 & WALDRON ROAD
REMOVAL PLAN

SCALE: 1" = 20' SHEET 3 OF 3 SHEETS STA. TO STA.


F.A.I. RTE.	SECTION	COUNTY	TOTAL SHEETS	SHEET NO.
57	139 HBR-6	KANKAKEE	202	33
CONTRACT NO. 66997				
ILLINOIS FED. AID PROJECT				

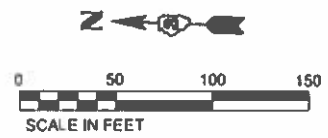




NOTE: STATIONS AND OFFSETS SHOWN FOR RIGHT OF WAY AND EASEMENTS REFERENCE THE EXISTING I-57 CENTERLINE AND THE PROPOSED MAPLE STREET/WALDRON ROAD CENTERLINE. SEE RIGHT OF WAY PLATS FOR FURTHER INFORMATION.

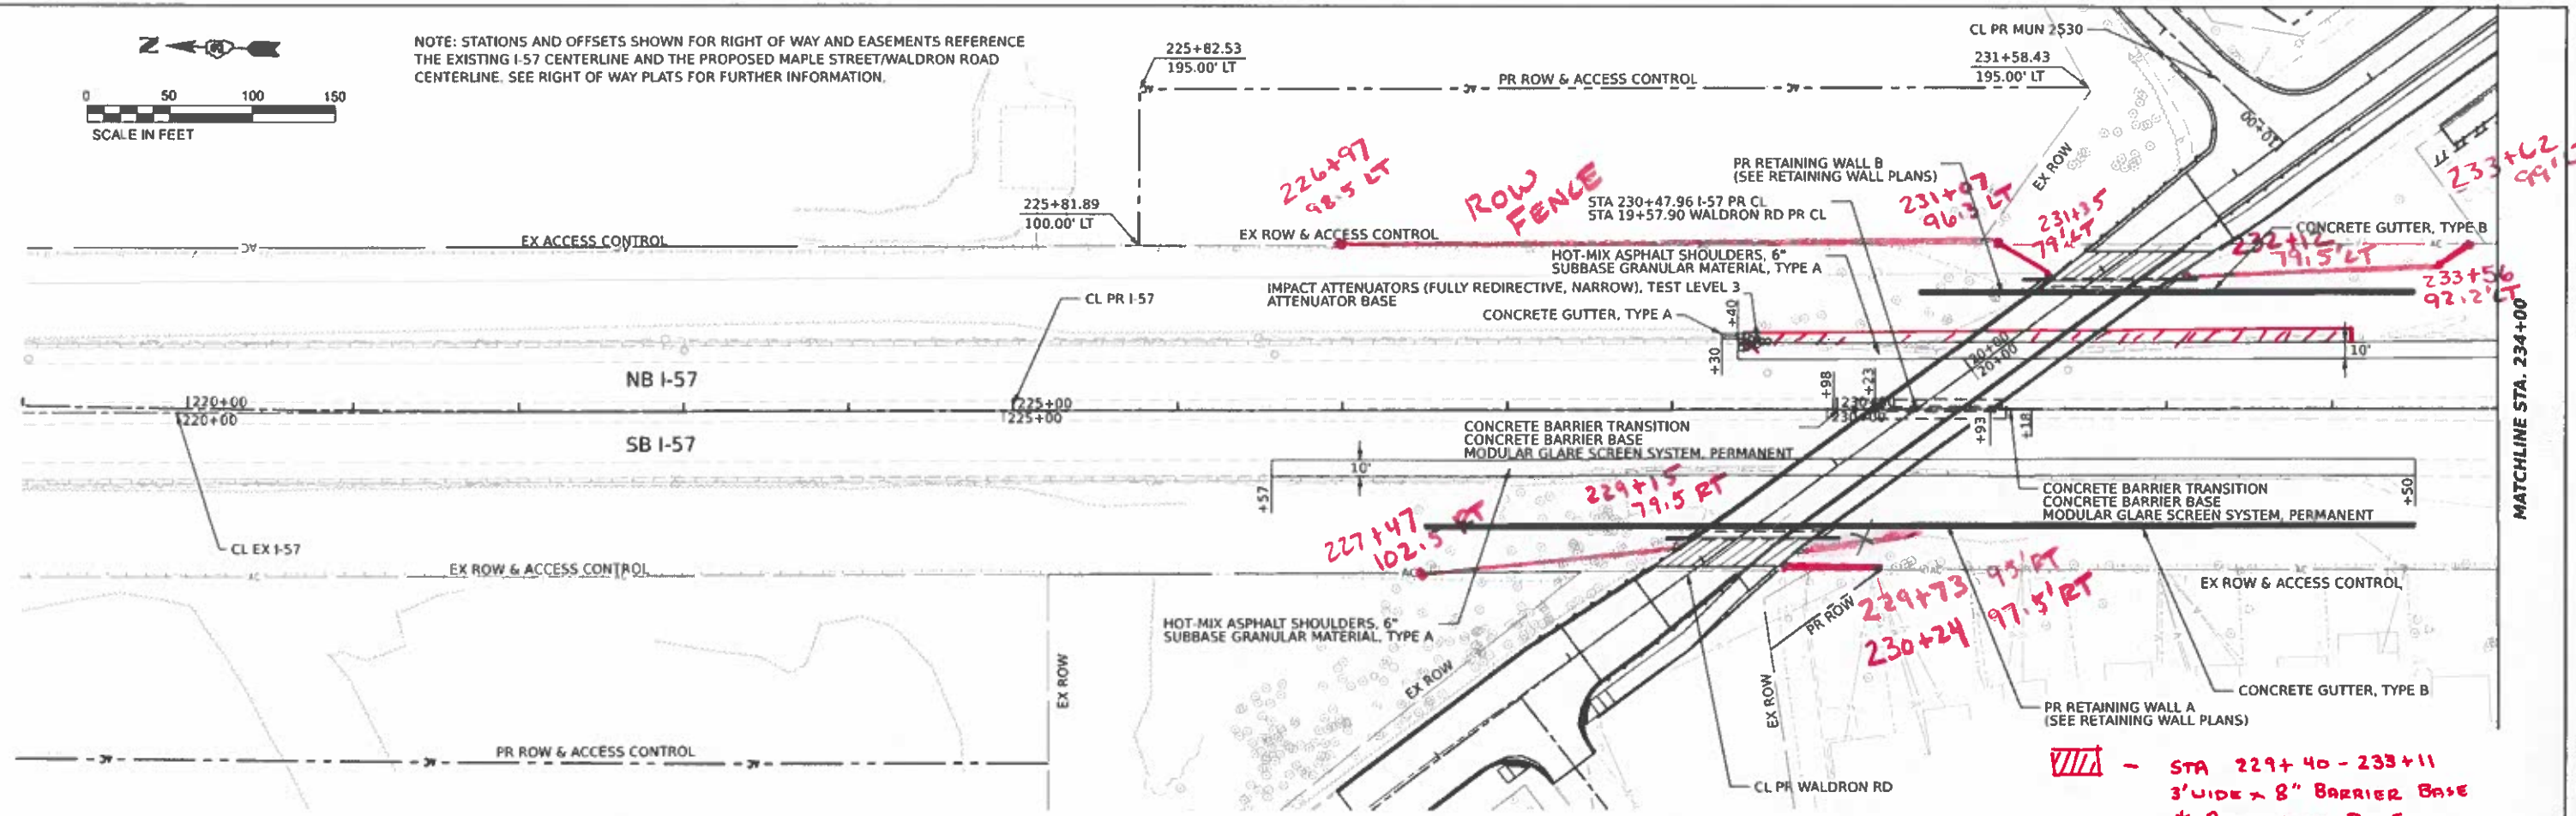

VI - STA 229+40 - 233+11
3' WIDE x 8" BARRIER BASE
+ ATTENUATOR BASE
350' TCB PINNED + ATTENUATOR
FULLY REDIRECTIVE, NARROW

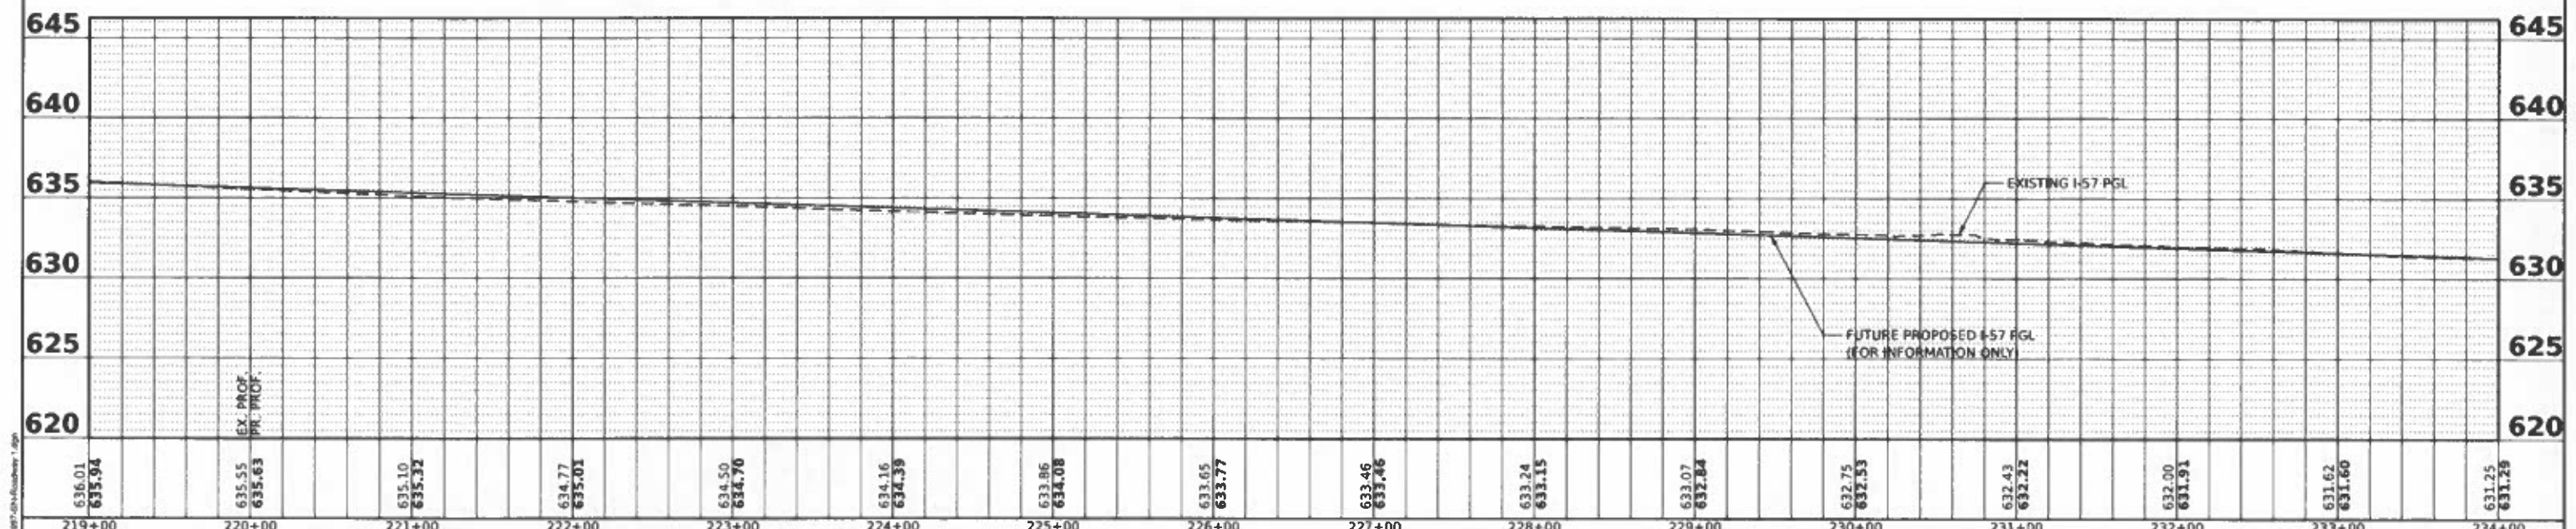

TransSmart 411 South Wells Street Suite 1000 Chicago, Illinois 60607				USER NAME : matorian DESIGNED : NS DRAWN : NS CHECKED : TW DATE : 2021/03/26				PLOT SCALE : 0.10000000 / IN. PLOT DATE : 3/29/2021				DESIGNED : NS REVISD : 5/5/2021 DRAWN : NS REVISD : CHECKED : TW REVISD : DATE : 2021/03/26 REVISD :				STATE OF ILLINOIS DEPARTMENT OF TRANSPORTATION				I-57 & WALDRON ROAD PLAN AND PROFILE				SCALE: 1" = 50' SHEET 1 OF 5 SHEETS STA. TO STA.				F.A.L. RTE. 57 SECTION 139 HBR-6 COUNTY KANKAKEE TOTAL SHEETS 202 SHEET NO. 34 CONTRACT NO. 66697 ILLINOIS FED. AID PROJECT			
---	--	--	--	--	--	--	--	--	--	--	--	---	--	--	--	---	--	--	--	---	--	--	--	---	--	--	--	---	--	--	--

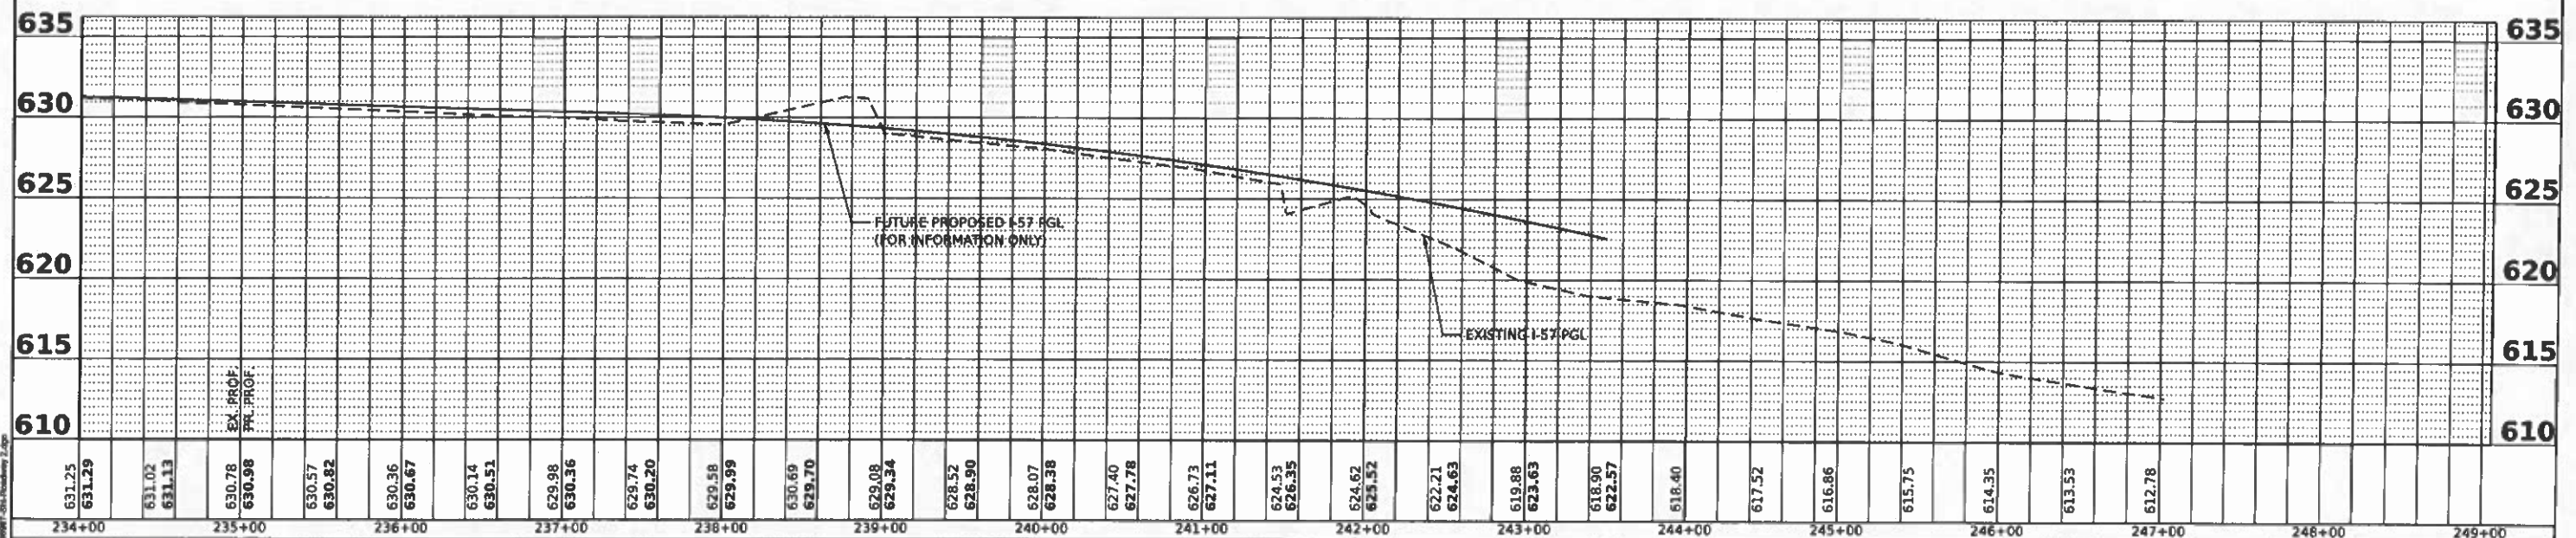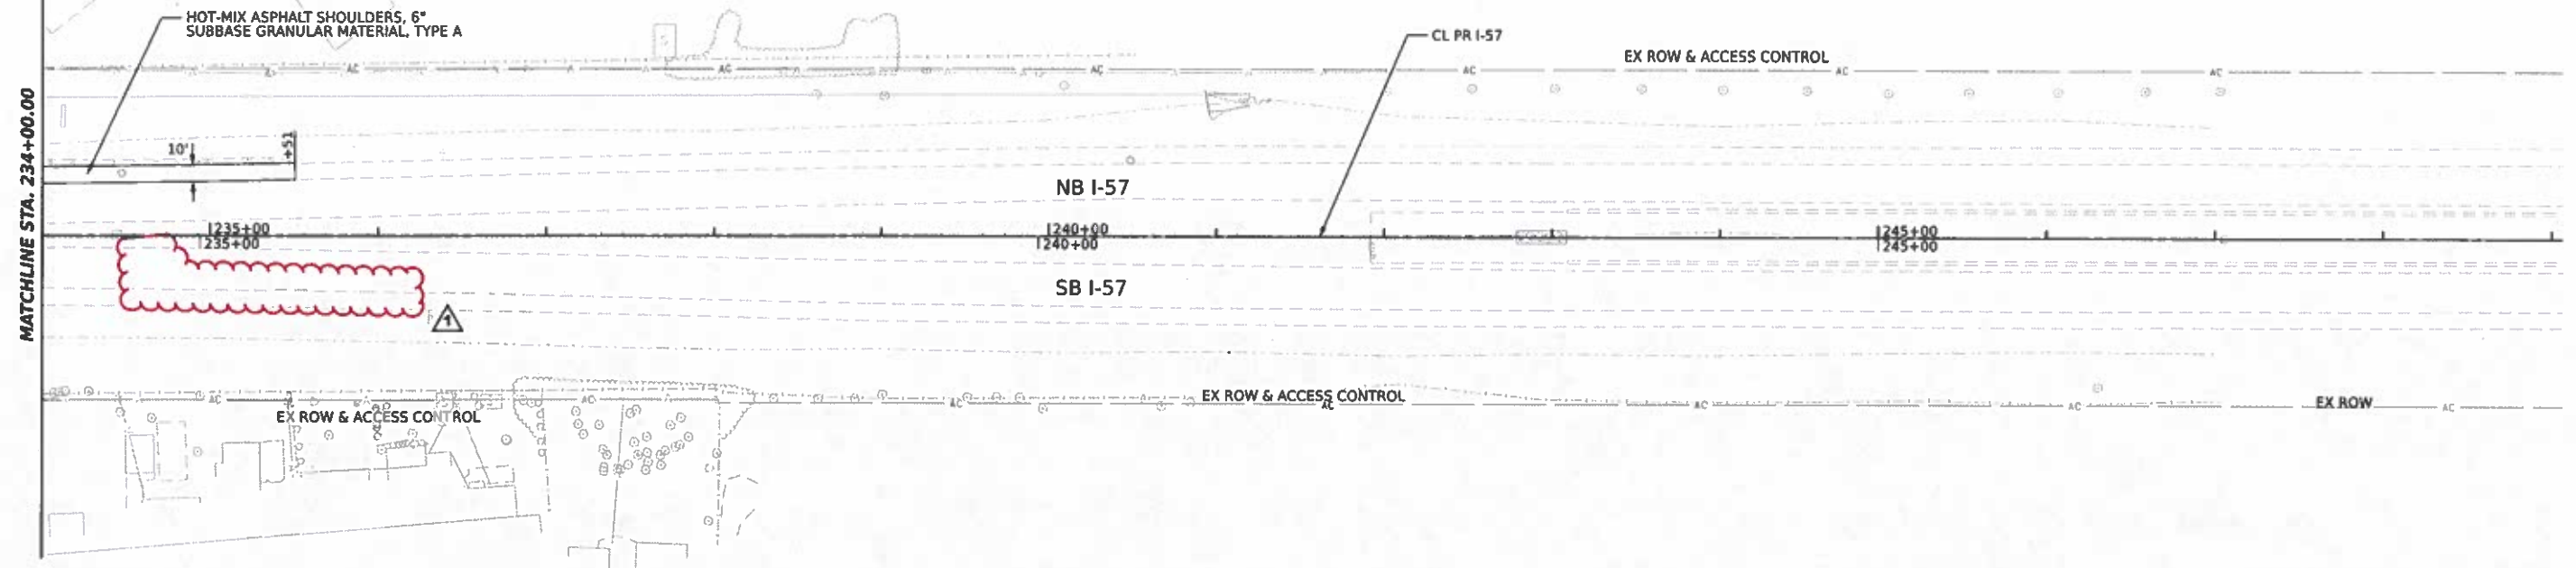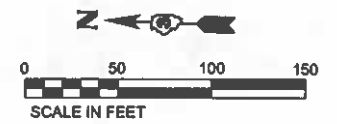

MODEL: Pen-3
FILE NAME: C:\projects\I-57\I-57.dgn

TransSmart
411 South Wells Street Suite 1000
Chicago, Illinois 60607

USER NAME	ns/bs	DESIGNED	NS	REVISED	-
PLOT SCALE	0.10000033 1/1 in.	DRAWN	NS	REVISED	-
PLOT DATE	7/9/2021	CHECKED	TW	REVISED	-
		DATE	2021/03/28	REVISED	-

STATE OF ILLINOIS
DEPARTMENT OF TRANSPORTATION


I-57 & WALDRON ROAD
PLAN AND PROFILE
SCALE: 1" = 50'
SHEET 2 OF 5 SHEETS STA. TO STA.

F.A.I. RTE.	SECTION	COUNTY	TOTAL SHEETS	SHEET NO.
57	139 HBR-0	KANKAKEE	202	35
CONTRACT NO. 68997				


14704





F.A.I. RTE.	SECTION	COUNTY	TOTAL SHEETS	SHEET NO.
67	139 HBR-6	KANKAKEE	202	36
CONTRACT NO. 66987				

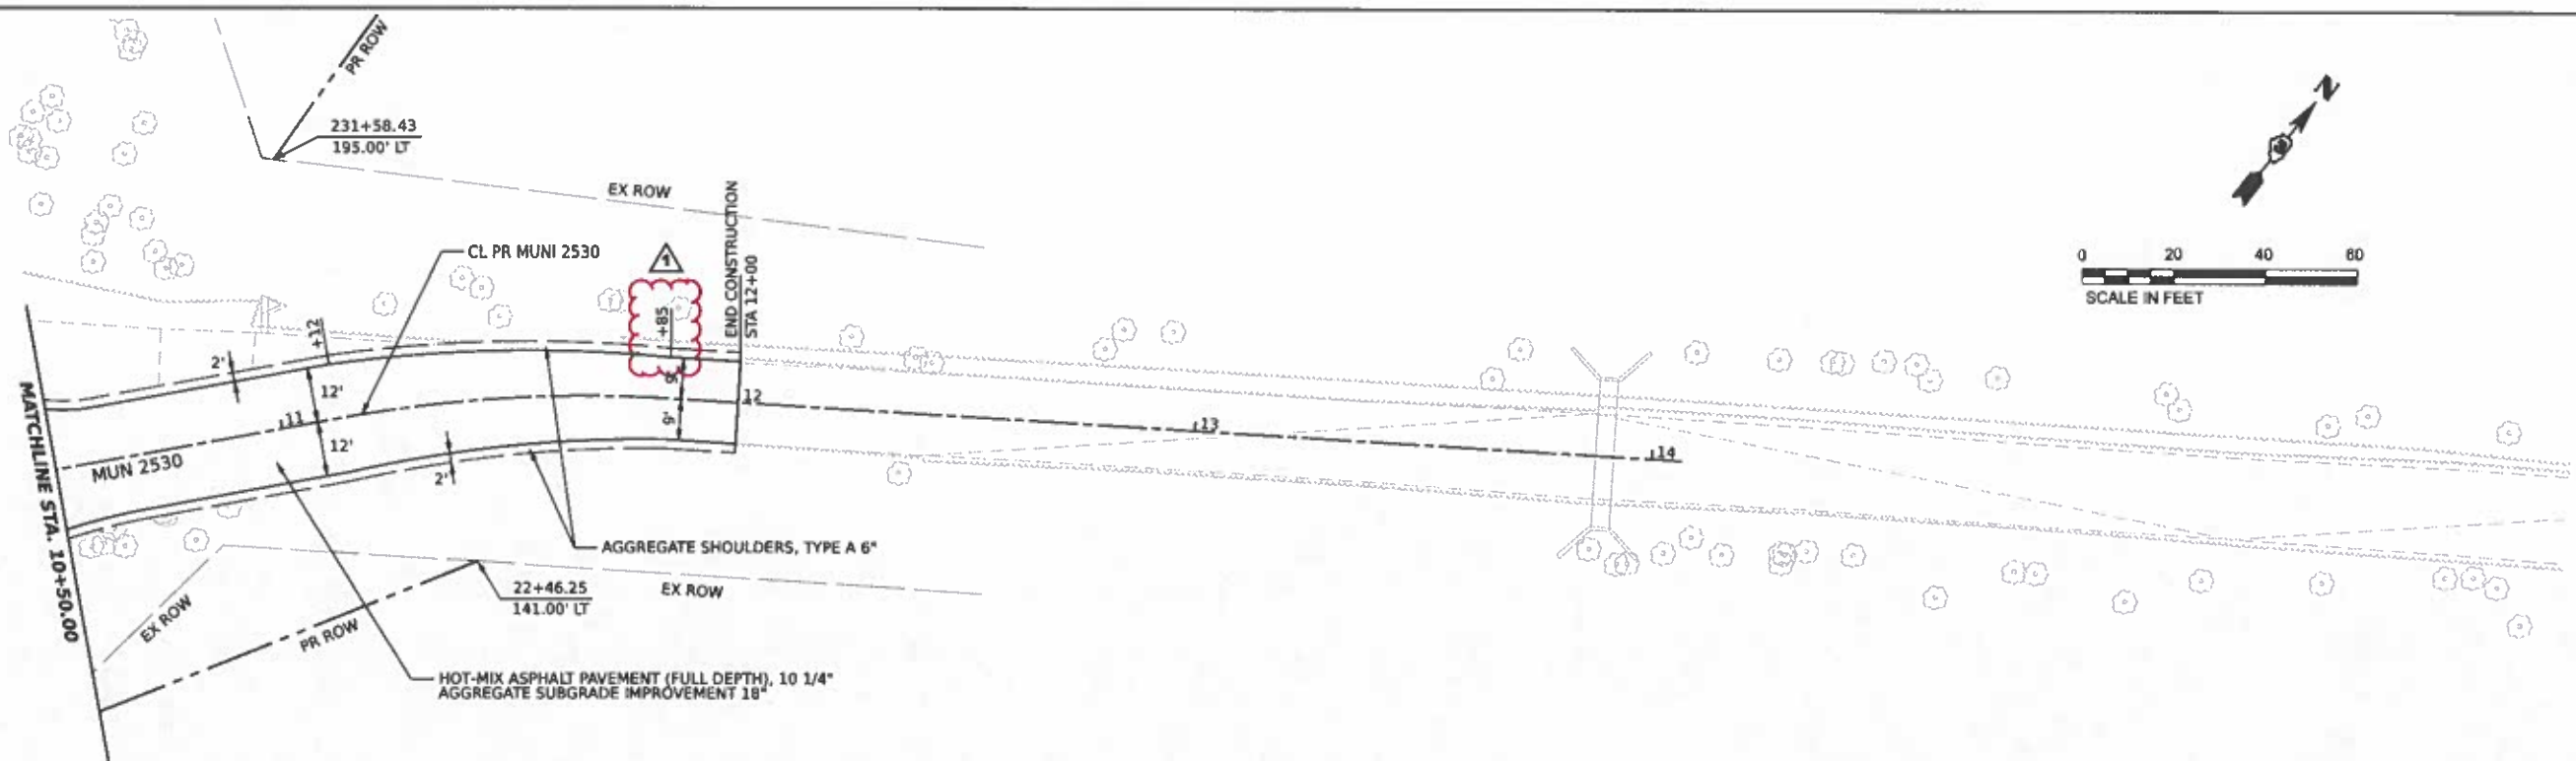

NOTE: STATIONS AND OFFSETS SHOWN FOR RIGHT OF WAY AND EASEMENTS REFERENCE THE EXISTING I-57 CENTERLINE AND THE PROPOSED MAPLE STREET/WALDRON ROAD CENTERLINE. SEE RIGHT OF WAY PLATS FOR FURTHER INFORMATION.

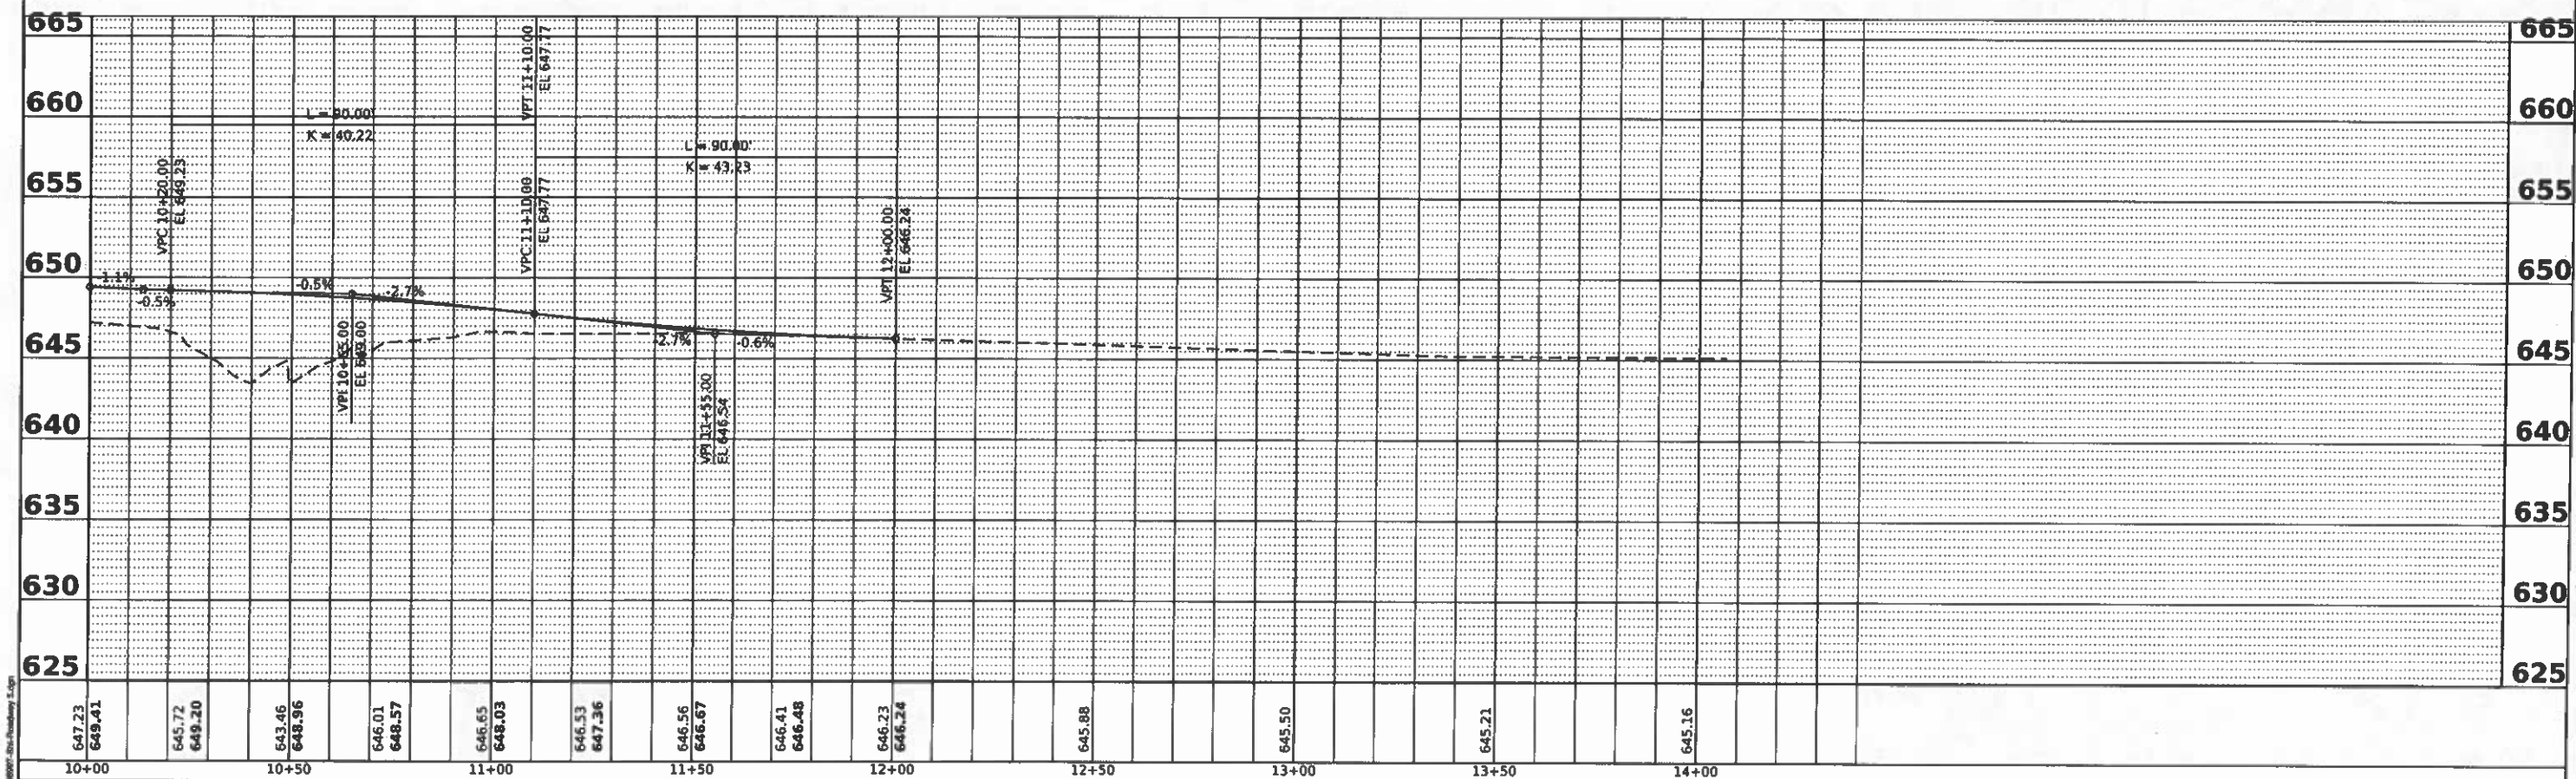

TransSmart 411 South Wells Street Suite 1000 Chicago, Illinois 60607		USER NAME = gshko PLOT SCALE = 0.10000033" / ft. PLOT DATE = 7/6/2021	DESIGNED - NS DRAWN - NS CHECKED - TW DATE - 2021/03/28	REVISED - REVISED - REVISED - REVISED -	STATE OF ILLINOIS DEPARTMENT OF TRANSPORTATION		I-57 & WALDRON ROAD PLAN AND PROFILE		F.A.I. RTE. 57 SECTION 139 HBR-6 COUNTY KANKAKEE TOTAL SHEETS 202 SHEET NO. 38 CONTRACT NO. 66997	SCALE: 1" = 20' SHEET 6 OF 5 SHEETS STA. TO STA.	ILLINOIS FED. AID PROJECT
---	--	---	--	--	---	--	---	--	--	---	---------------------------

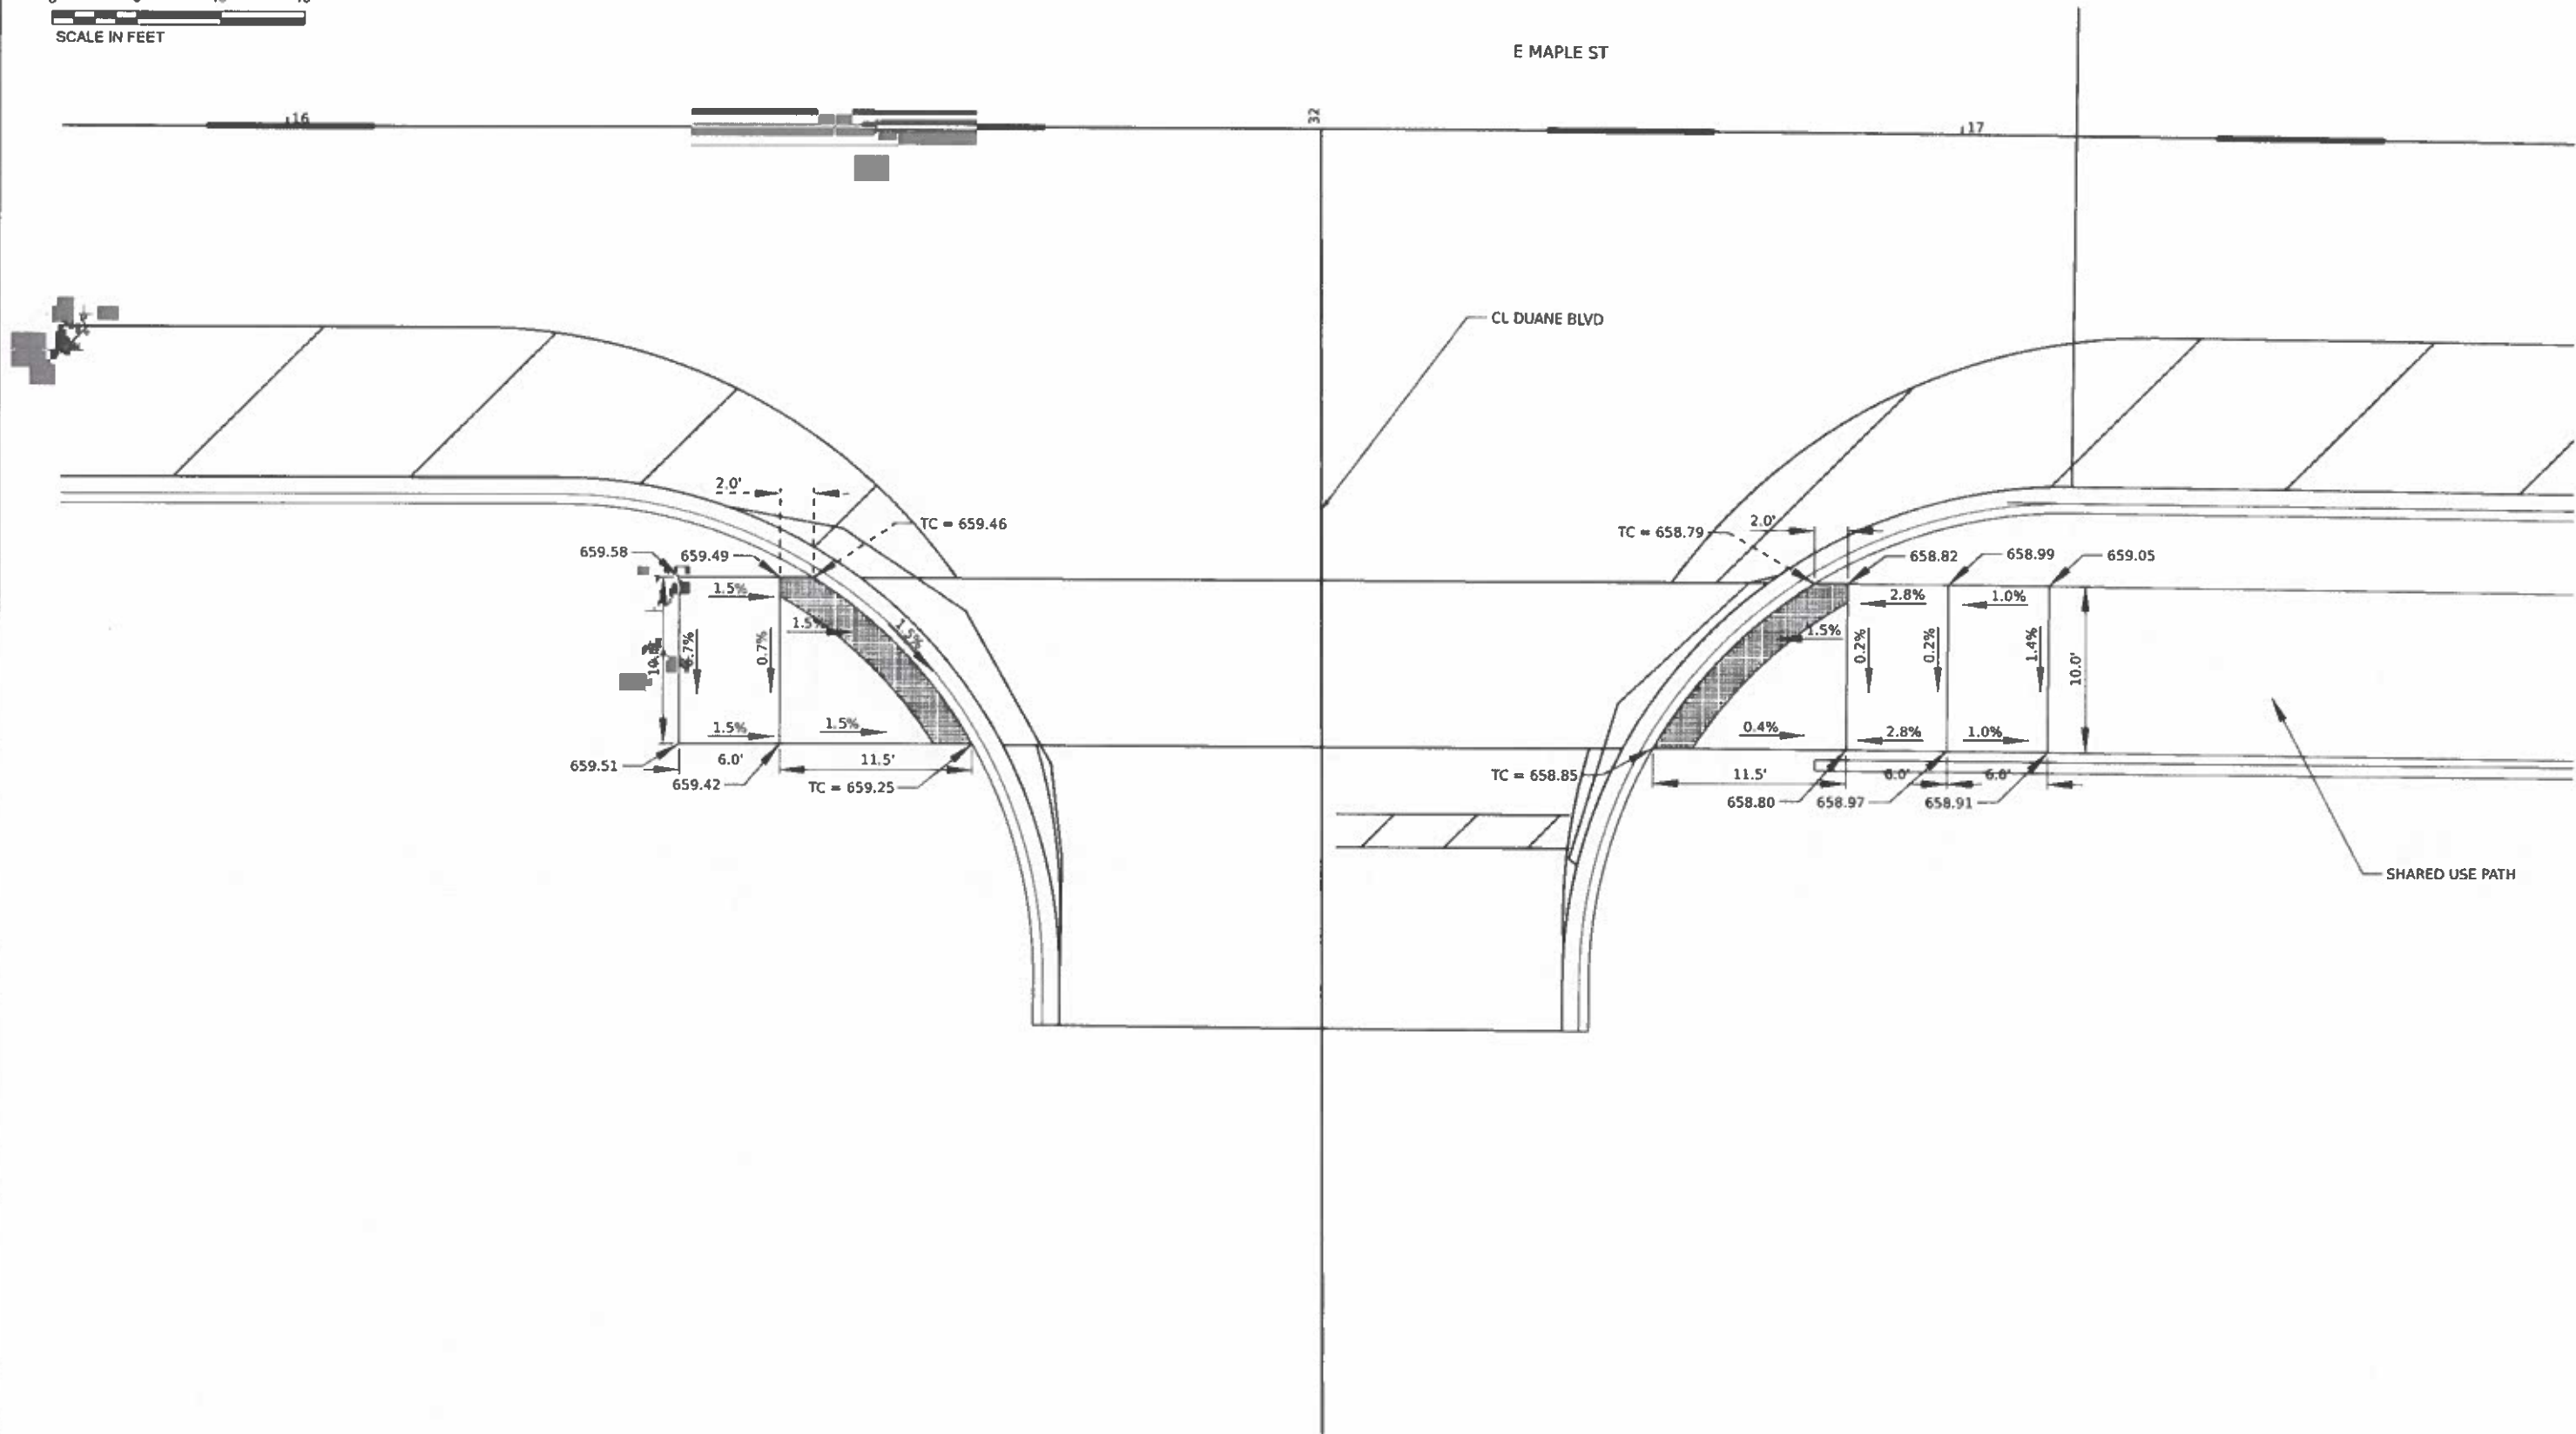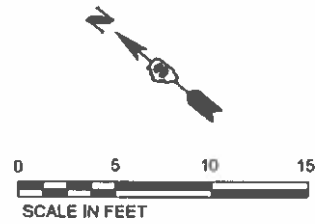

MODEL: Plan 1
FILE NAME: D:\00001314_ADA.dgn

TranSmart
411 South Wells Street Suite 1000
Chicago, Illinois 60607

USER NAME: nrsalehian
PLOT SCALE: 1" = 0.16666667' / in
PLOT DATE: 3/29/2021

DESIGNED - WD
DRAWN - WD
CHECKED - TW
DATE - 2021/03/26

REVISED -
REVISED -
REVISED -
REVISED -

STATE OF ILLINOIS
DEPARTMENT OF TRANSPORTATION

WALDRON ROAD
ADA DESIGN

SCALE: 1" = 5' SHEET 1 OF 1 SHEETS STA. TO STA.

F.A.I. RTE	SECTION	COUNTY	TOTAL SHEETS	SHEET NO.
57	139 HBR-6	KANKAKEE	202	39
CONTRACT NO. 66997				
ILLINOIS FED. AID PROJECT				

PRE-STAGE 1 CONSTRUCTION

INSTALL TRAFFIC CONTROL SIGNING.

CONSTRUCT NORTHBOUND SHOULDER REPAIR ALONG I-57 FROM STA 228+05 TO 242+35 AND SOUTHBOUND SHOULDER REPAIR ALONG I-57 FROM STA 218+82 TO 235+61.

CONSTRUCT TEMPORARY WIDENING ALONG WALDRON ROAD AS SHOWN IN THE PRE-STAGE 1 PLANS.

CONSTRUCT PROPOSED STORM SEWER LATERAL ALONG WALDRON ROAD AT STA 16+15.

TRAFFIC CONTROL AND PROTECTION

TRAFFIC CONTROL AND PROTECTION SHALL BE PERFORMED IN ACCORDANCE WITH THE TRAFFIC CONTROL PLAN, SECTION 701 OF THE STANDARD SPECIFICATIONS AND THE SPECIAL PROVISIONS.

I-57

TWO LANES OF TRAFFIC IN EACH DIRECTION SHALL BE ACCOMMODATED AT ALL TIMES ON EXISTING PAVEMENT, EXCEPT DURING ISOLATED DAYTIME LANE CLOSURES UTILIZING HIGHWAY STANDARD 701406.

WALDRON ROAD

TWO-WAY TRAFFIC SHALL BE ACCOMMODATED AT ALL TIMES ON EXISTING PAVEMENT, EXCEPT DURING ISOLATED FLAGGER CONTROLLED LANE CLOSURES.


EXISTING TRAFFIC CONTROL SIGNS AND DEVICES WILL BE REMOVED BY THE CONTRACTOR AFTER THE PROPOSED TRAFFIC CONTROL REQUIREMENTS ARE MET, OR AS AUTHORIZED BY THE ENGINEER. SIGNS OR DEVICES LEFT IN PLACE AT THIS TIME ARE TO BE PROTECTED FROM DAMAGE BY THE CONTRACTOR.

THE CONTRACTOR SHALL SCHEDULE OPERATIONS TO ENSURE THAT NO DROP-OFF OF GREATER THAN 12", WITHIN 3' OF THE TRAVEL LANE, IS PRESENT FOR 48 HOURS OR MORE.

DRUMS WITH STEADY-BURNING LIGHTS SHALL BE REQUIRED TO DELINEATE THE TRAVEL WAY. THE MAXIMUM SPACING SHALL BE 100 FEET, CENTER TO CENTER ALONG TANGENTS (50 FEET ALONG TAPERS); AND 25 FEET (CENTER TO CENTER) ALONG RADII TO SIDE ROADS AND ENTRANCES.

THE FOLLOWING TRAFFIC CONTROL STANDARDS ARE THE MINIMUM REQUIREMENTS FOR THE TRAFFIC FOR THIS PROJECT: 701001, 701006, 70101, 701201, 701301, 701326, 701400, 701401, 701406, 701901, AND 704001.

CHANGEABLE MESSAGE SIGNS ARE TO BE IN PLACE 2 WEEKS PRIOR TO THE BEGINNING OF CONSTRUCTION.

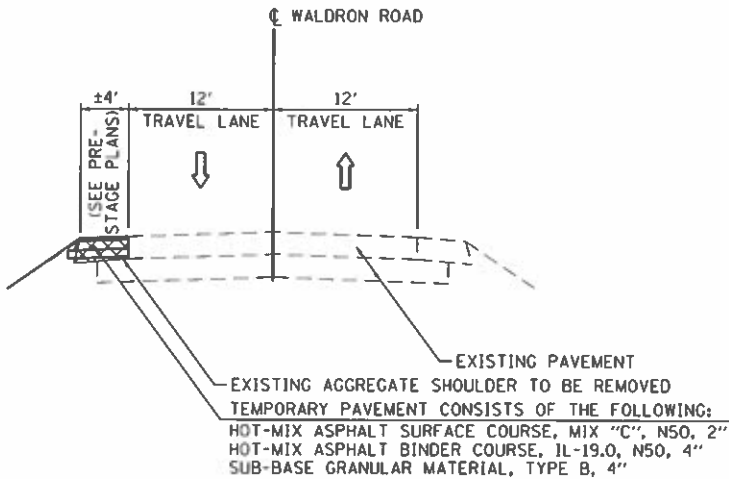


**PRE-STAGE 1 TYPICAL SECTION
WALDRON ROAD**

STA 20+72.26 TO 27+55.00

PRE-STAGE 1 TEMPORARY PAVEMENT CONSTRUCTION REQUIREMENTS

THE CONTRACTOR SHALL SCHEDULE OPERATIONS TO ENSURE THAT NO DROP-OFF OF >12", WITHIN 3' OF THE TRAVEL LANE, IS PRESENT FOR 48 HOURS OR MORE.

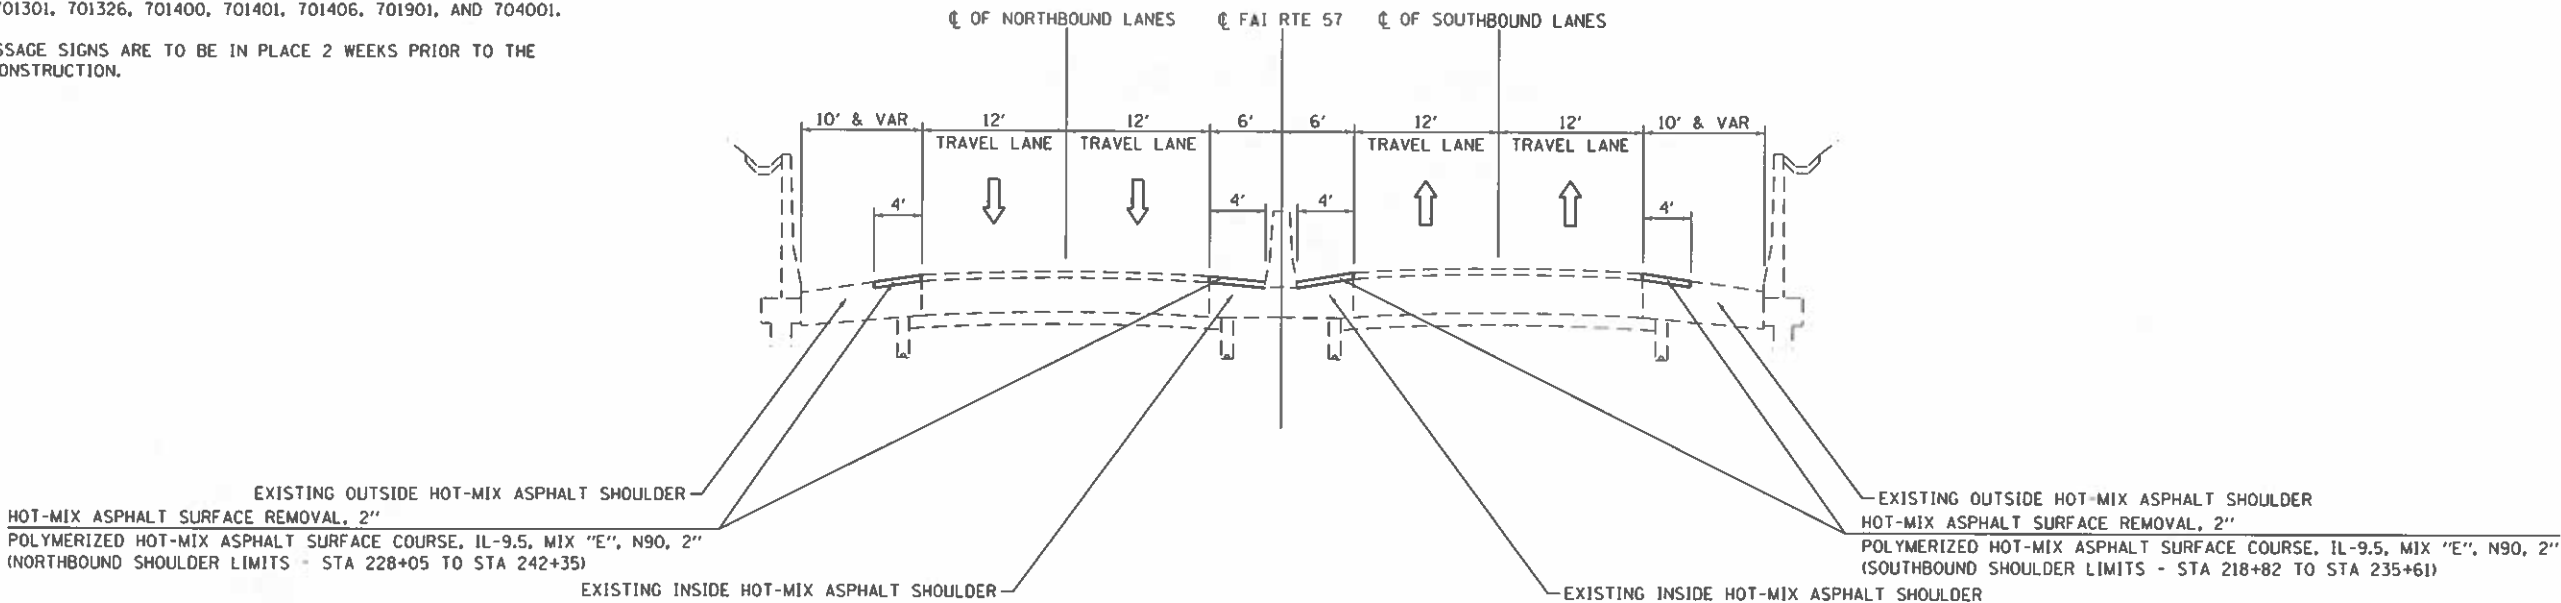

**PRE-STAGE 1 TYPICAL SECTION
FAI 57**

STA 218+82.00 TO 242+35.00

MODEL: Plan 1
FILE NAME: C:\Users\jshelton\OneDrive\Documents\Typical Section - Lgh

Hutchinson Engineering, Inc.
Jacksonville Moline Peoria Shawnee
Since 1945


USER NAME = rshelton	DESIGNED -	REVISED -
PLOT SCALE = 0.1667" / ft.	DRAWN -	REVISED -
PLOT DATE = 3/29/2021	CHECKED -	REVISED -
	DATE = 2021/03/26	REVISED -

**STATE OF ILLINOIS
DEPARTMENT OF TRANSPORTATION**

**FAI 57 & WALDRON ROAD
PRE-STAGE 1 TYPICAL SECTION**

SCALE: N.T.S. SHEET 1 OF 1 SHEETS STA. TO STA.


F.A.I. RTE.	SECTION	COUNTY	TOTAL SHEETS	SHEET NO.
57	139 HBR-6	KANKAKEE	202	40
CONTRACT NO. 66997				
ILLINOIS FED. AID PROJECT				

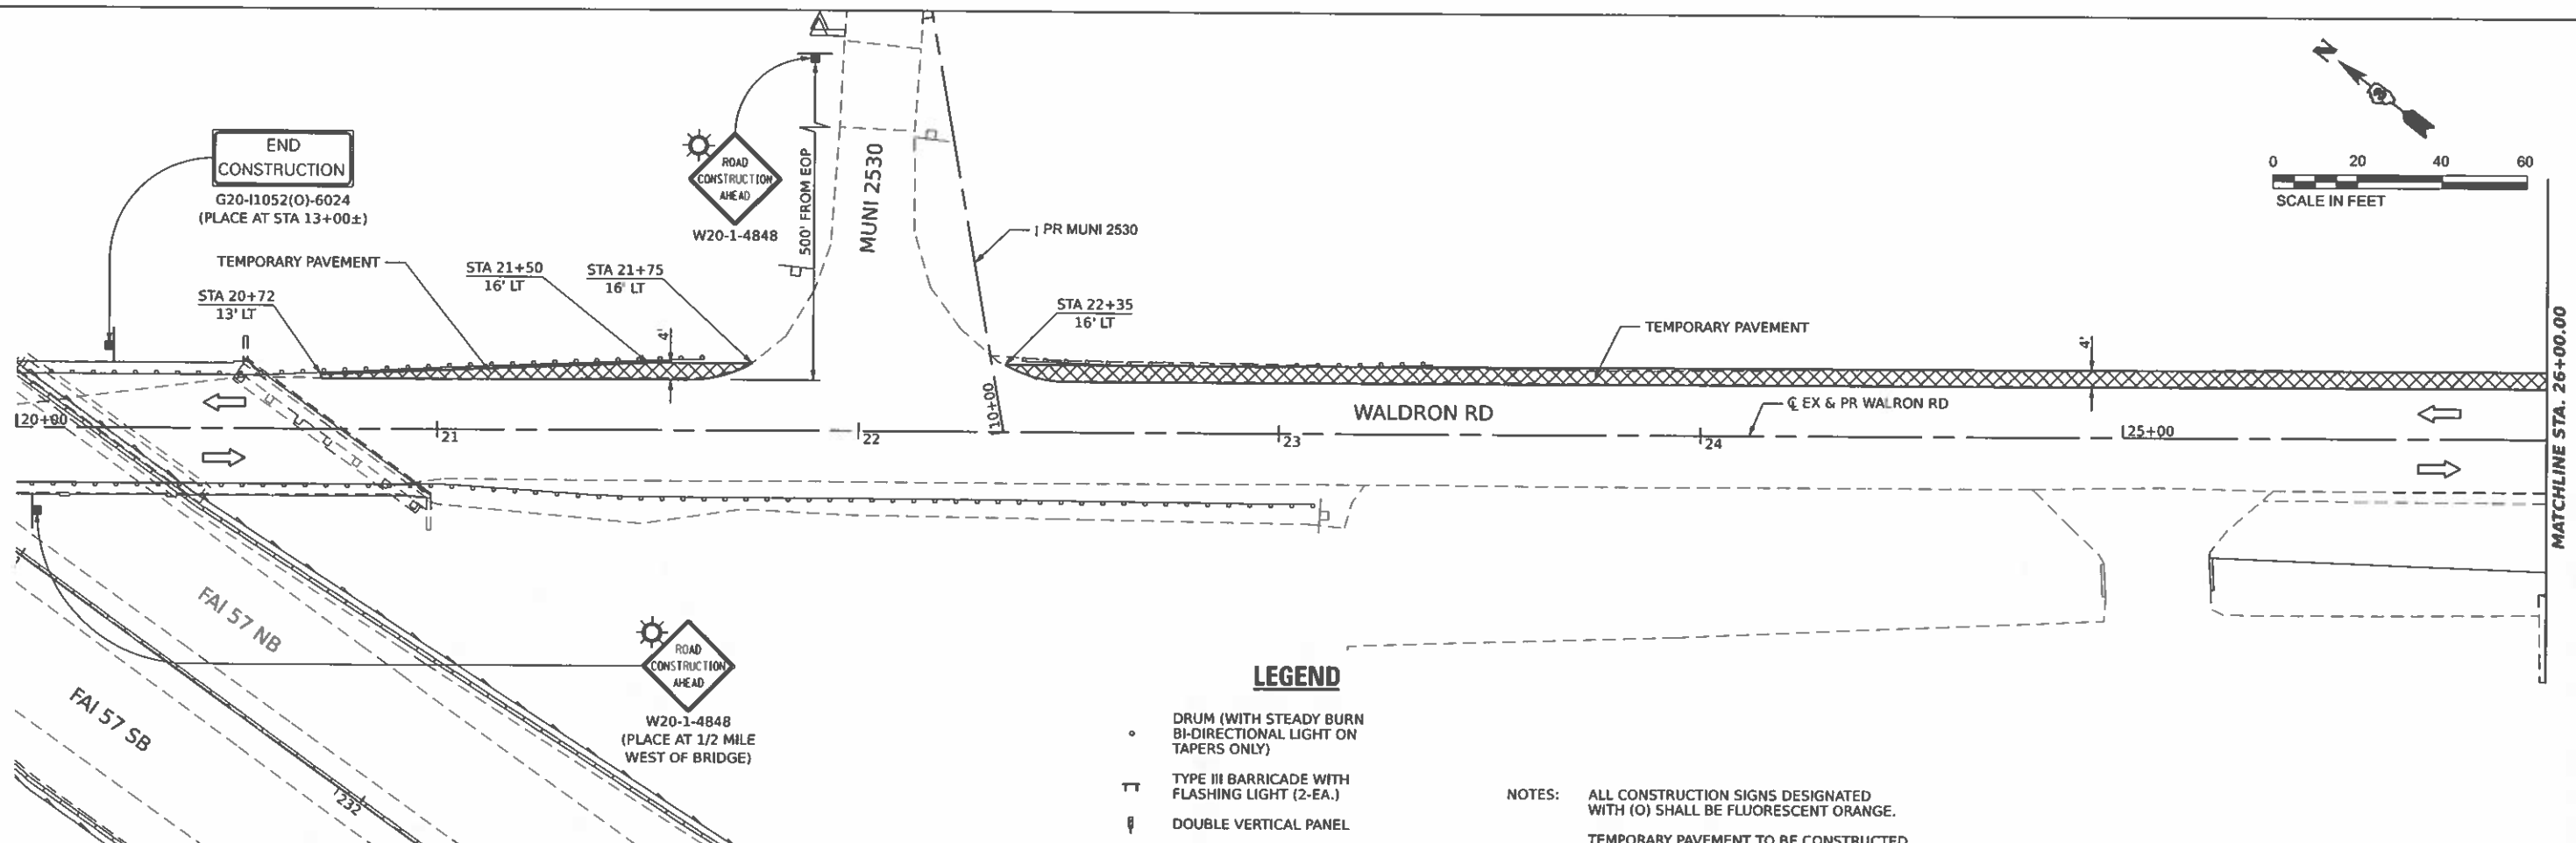

LEGEND

- DRUM (WITH STEADY BURN BI-DIRECTIONAL LIGHT ON TAPERS ONLY)
- ⌋ TYPE III BARRICADE WITH FLASHING LIGHT (2-EA.)
- ⌋ DOUBLE VERTICAL PANEL
- ⊠ WORK AREA
- ➡ ARROW BOARD
- ⌋ CONSTRUCTION SIGN
- ➡ DIRECTION OF TRAFFIC
- TEMPORARY CONCRETE BARRIER
- IMPACT ATTENUATOR, TEMPORARY (FULLY REDIRECTIVE, NARROW) TEST LEVEL 3
- ⊛ FLASHING MONO-DIRECTIONAL LIGHT

NOTES: ALL CONSTRUCTION SIGNS DESIGNATED WITH (O) SHALL BE FLUORESCENT ORANGE.
 TEMPORARY PAVEMENT TO BE CONSTRUCTED UTILIZING HIGHWAY STANDARD 701326.
 INSTALL TEMPORARY INFORMATION SIGNS ALONG WALDRON RD / E MAPLE ST ACCORDING TO TEMPORARY INFORMATION SIGNING DETAIL.

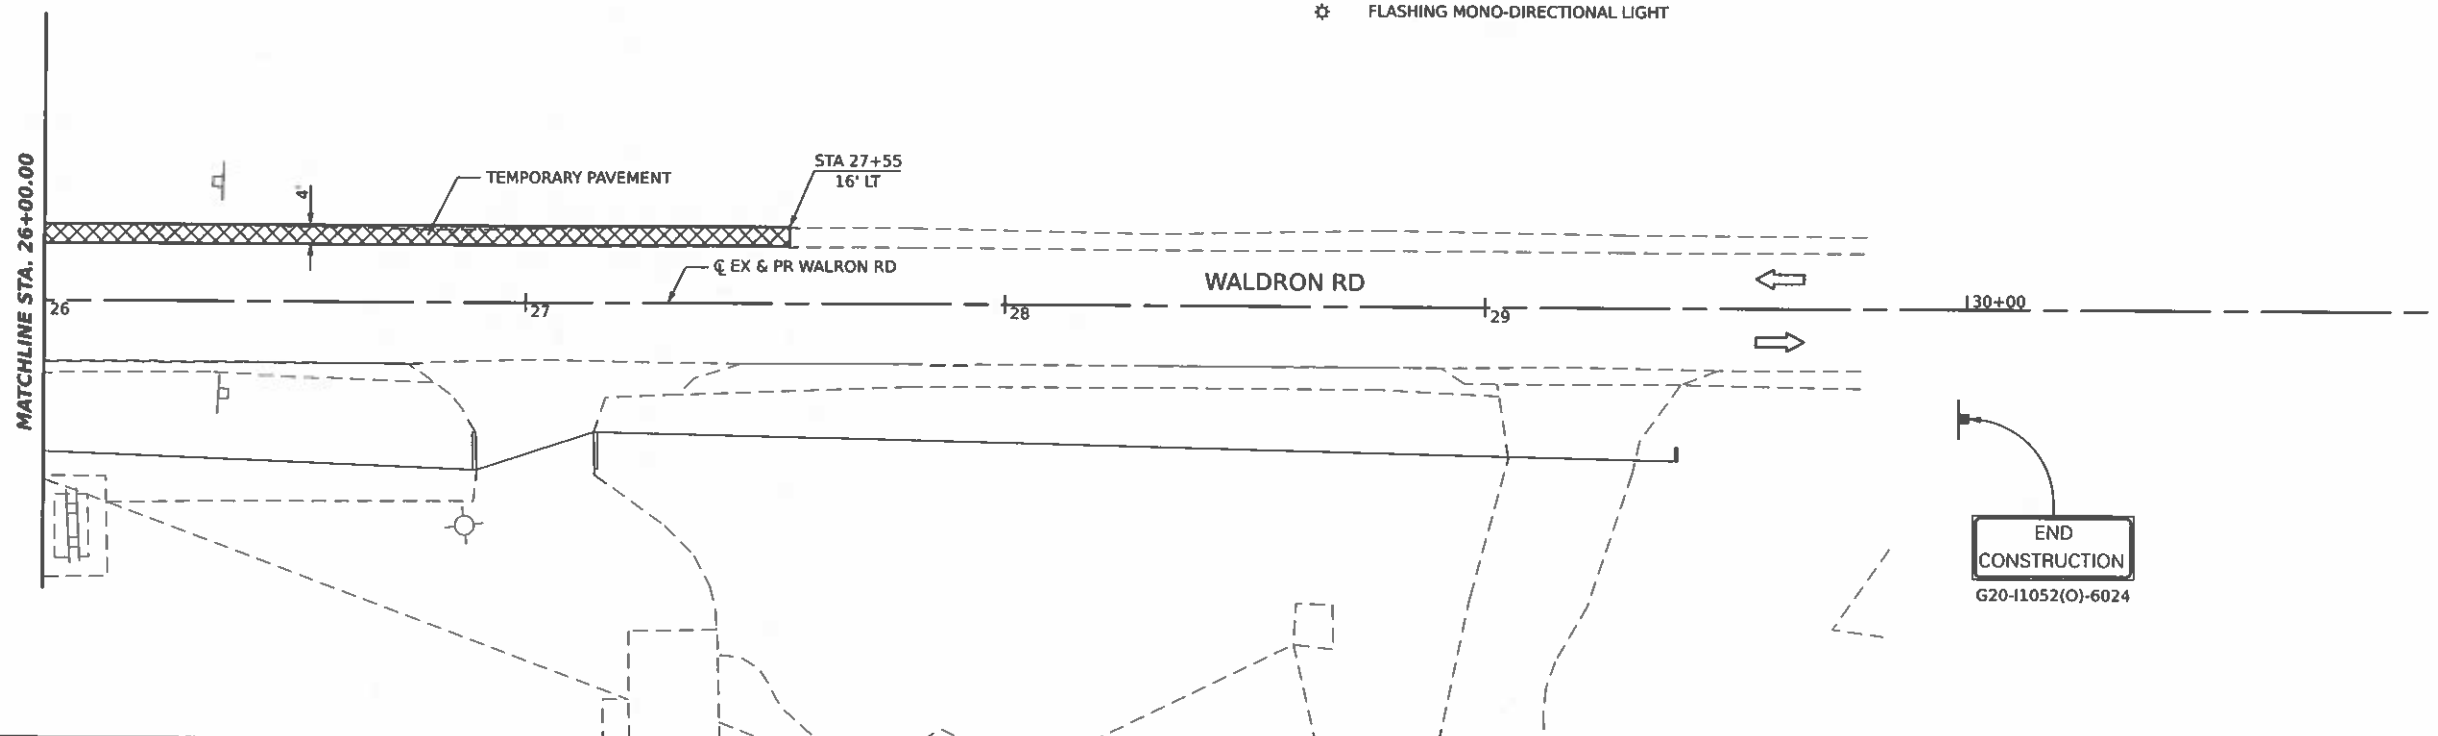

MODEL: Plan 7
 FILE NAME: D:\0005-Sub-Prop-Stag-1-1.dgn

Hutchinson Engineering, Inc.
 Jacksonville Moline Peoria Shorewood
 Since 1945

USER NAME = nsestorian	DESIGNED -	REVISED -
PLOT SCALE = 0.10666633" / ft.	DRAWN -	REVISED -
PLOT DATE = 3/29/2021	CHECKED -	REVISED -
	DATE = 2021/03/26	REVISED -

STATE OF ILLINOIS
 DEPARTMENT OF TRANSPORTATION

FAI 57 & WALDRON ROAD
 PRE-STAGE 1 CONSTRUCTION AND TRAFFIC CONTROL

SCALE: 1"=20' SHEET 1 OF 1 SHEETS STA. 20+00 TO STA. 31+00

F.A.I. RTE.	SECTION	COUNTY	TOTAL SHEETS	SHEET NO.
57	139 HBR-6	KANKAKEE	202	41
CONTRACT NO. 66997				
ILLINOIS FED. AID PROJECT				

STAGE 1 CONSTRUCTION

INSTALL TRAFFIC CONTROL SIGNING.

INSTALL TEMPORARY BRIDGE SIGNALS ACCORDING TO STAGE 1 PLANS.

CONSTRUCT PERMANENT EASTBOUND LANE ON WALDRON ROAD (MINUS THE SURFACE COURSE) FROM STA 17+07 TO STA 17+96 AND FROM STA 21+22 TO STA 26+35. CONSTRUCT CURB AND GUTTER FROM STA 15+38 TO STA 17+07.

CONSTRUCT MUN 2530 ACCORDING TO STAGE 1 PLANS. MUN 2530 TO REMAIN OPEN AT ALL TIMES DURING STAGE 1 UNLESS A FLAGGER CONTROLLED LANE CLOSURE IS PROVIDED.

CONSTRUCT PROPOSED STORM SEWER ALONG WALDRON ROAD AND I-57 WITHIN THE STAGE 1 CONSTRUCTION LIMITS AS SHOWN IN THE STAGE 1 PLANS.

REMOVE EASTBOUND SUBSTRUCTURE AND SUPERSTRUCTURE OF EXISTING SN 046-0080 WITHIN THE STAGE 1 LIMITS AS SHOWN IN THE STRUCTURE PLANS. CONSTRUCT EASTBOUND SUBSTRUCTURE AND SUPERSTRUCTURE OF PROPOSED SN 046-0153 WITHIN THE STAGE 1 LIMITS AS SHOWN IN THE STRUCTURE PLANS.

REMOVE EXISTING RETAINING WALL WITHIN THE STAGE 1 LIMITS. CONSTRUCT STAGE 1 PORTIONS OF RETAINING WALLS A AND B AS SHOWN IN THE RETAINING WALL PLANS.

TRAFFIC CONTROL AND PROTECTION

TRAFFIC CONTROL AND PROTECTION SHALL BE PERFORMED IN ACCORDANCE WITH THE TRAFFIC CONTROL PLAN, SECTION 701 OF THE STANDARD SPECIFICATIONS AND THE SPECIAL PROVISIONS.

I-57

MAINTAIN ONE LANE OF TRAFFIC IN EACH DIRECTION AT ALL TIMES.

DURING SUPERSTRUCTURE DEMOLITION, LIVE TRAFFIC ON I-57 UNDERNEATH THE BRIDGE WILL ONLY BE PERMITTED FOR ADVANCE DEMOLITION PERPARATIONS (SAWCUTTING, PARTIAL CHIPPING) WITH PROTECTIVE SHIELDING IN PLACE. ALL OTHER DEMOLITION OPERATIONS TO THE BRIDGE WILL DIVERT THE I-57 TRAFFIC UTILIZING A DETOUR PROVIDED IN THE "TOTAL INTERSTATE CLOSURE AT NIGHT" DETAIL. CHANGEABLE MESSAGE SIGNS SHALL BE IN PLACE 2 WEEKS PRIOR TO ANY INTERSTATE CLOSURE.

FOR BEAM PLACEMENT, DIVERT THE I-57 TRAFFIC UTILIZING THE DETOUR AS SHOWN IN THE "TOTAL INTERSTATE CLOSURE AT NIGHT" DETAIL.

DURING INSTALLATION OF FORMS FOR THE CONCRETE DECK, LANE CLOSURES WILL BE ALLOWED SO THAT NO FORMING WORK IS PERFORMED ABOVE LIVE TRAFFIC.

WALDRON ROAD

MAINTAIN ONE LANE OF TRAFFIC AT ALL TIMES UTILIZING HIGHWAY STANDARD 701321. DUANE BLVD WILL BE CLOSED DURING STAGE 1.

EXISTING TRAFFIC CONTROL SIGNS AND DEVICES WILL BE REMOVED BY THE CONTRACTOR AFTER THE PROPOSED TRAFFIC CONTROL REQUIREMENTS ARE MET, OR AS AUTHORIZED BY THE ENGINEER. SIGNS OR DEVICES LEFT IN PLACE AT THIS TIME ARE TO BE PROTECTED FROM DAMAGE BY THE CONTRACTOR.

THE CONTRACTOR SHALL SCHEDULE OPERATIONS TO ENSURE THAT NO DROP-OFF OF GREATER THAN 12", WITHIN 3' OF THE TRAVEL LANE, IS PRESENT FOR 48 HOURS OR MORE.


NO DROP-OFF GREATER THAN 24" WITHIN 12' OF THE TRAVEL LANE WILL BE ALLOWED UNLESS A FLAGGER CONTROLLED LANE CLOSURE IS PROVIDED. SEGMENTS WHERE THESE CONDITIONS OCCUR DURING NON-WORKING HOURS MUST BE PROTECTED WITH TEMPORARY CONCRETE BARRIER. UNLESS AUTHORIZED BY THE ENGINEER, THE CONTRACTOR WILL ONLY BE PAID FOR TEMPORARY CONCRETE BARRIER ALONG SEGMENTS SHOWN IN THE PLANS.

DRUMS WITH STEADY-BURNING LIGHTS SHALL BE REQUIRED TO DELINEATE THE TRAVEL WAY. THE MAXIMUM SPACING SHALL BE 100 FEET, CENTER TO CENTER ALONG TANGENTS (50 FEET ALONG TAPERS); AND 25 FEET (CENTER TO CENTER) ALONG RADII TO SIDE ROADS AND ENTRANCES.

THE CONTRACTOR MUST MAINTAIN ACCESS TO ALL PROPERTIES AT ALL TIMES. THE PAY ITEM AGGREGATE FOR TEMPORARY ACCESS HAS BEEN PROVIDED TO AID THE CONTRACTOR IN MAINTAINING THIS ACCESS.

THE FOLLOWING TRAFFIC CONTROL STANDARDS ARE THE MINIMUM REQUIREMENTS FOR THE TRAFFIC FOR THIS PROJECT: 701001, 701006, 70101, 701201, 701301, 701326, 701400, 701401, 701406, 701901 AND 704001.



CHANGEABLE MESSAGE SIGNS ARE TO BE IN PLACE 2 WEEKS PRIOR TO THE BEGINNING OF CONSTRUCTION.

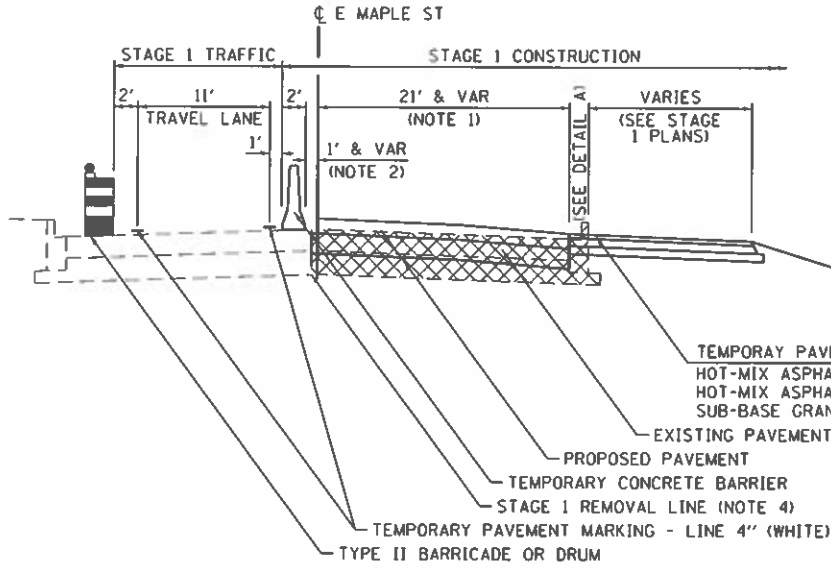

STAGE 1 TYPICAL SECTION

E MAPLE ST


STA 17+06.78 TO 17+96.21

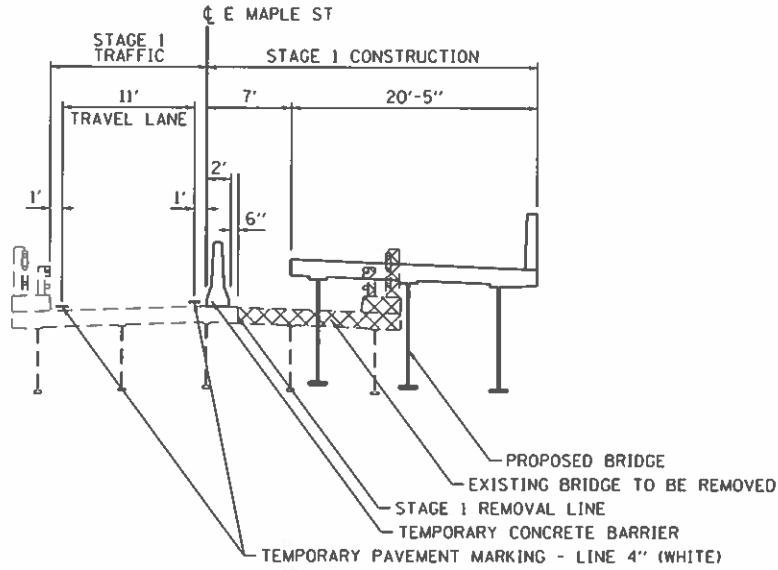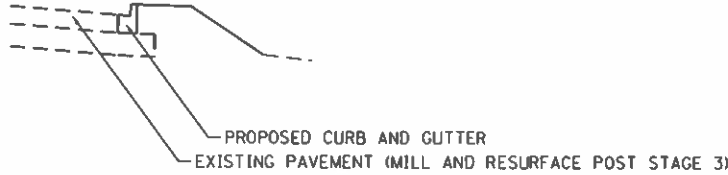

STAGE 1 BRIDGE TYPICAL SECTION

E MAPLE ST

STA 17+96.21 TO 21+21.73

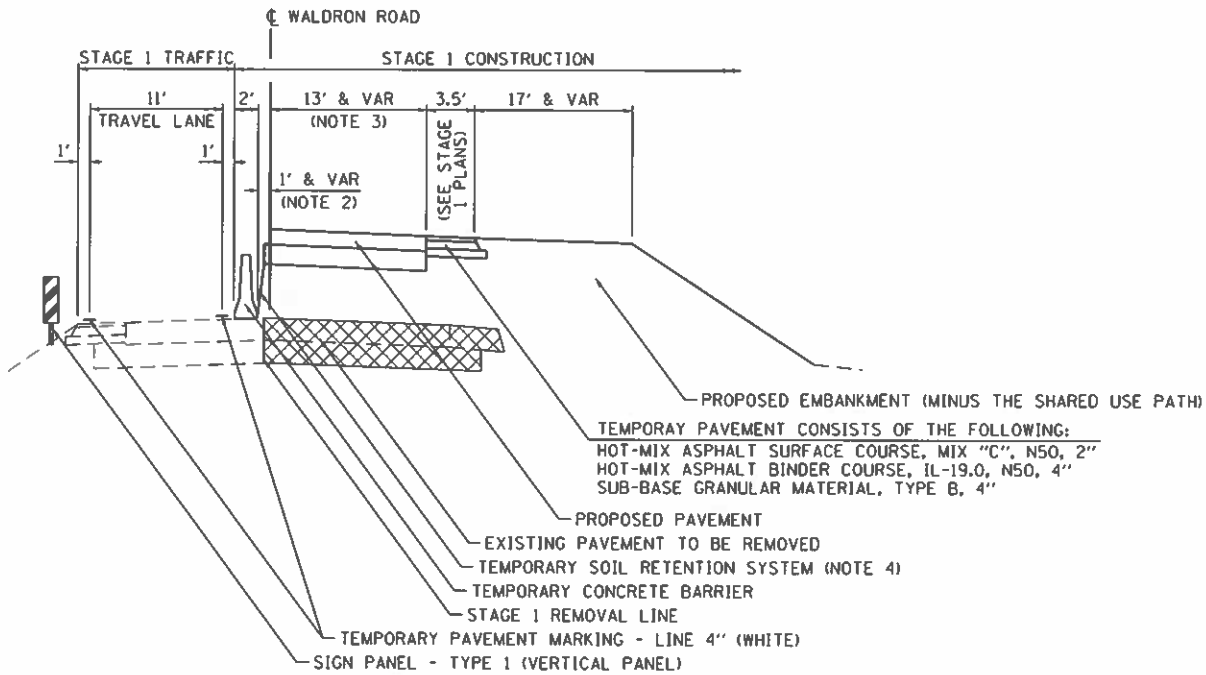

STAGE 1 TYPICAL SECTION

WALDRON ROAD

STA 21+21.73 TO 26+35.00

STATE OF ILLINOIS
DEPARTMENT OF TRANSPORTATION

FAI 57 & WALDRON ROAD
STAGE 1 TYPICAL SECTIONS

SCALE: N.T.S.

SHEET 1


OF 2

SHEETS


STA.

TO STA.

F.A.I. RTE.	SECTION	COUNTY	TOTAL SHEETS	SHEET NO.
57	139 HBR-6	KANKAKEE	202	42
CONTRACT NO. 66997				
ILLINOIS FED. AID PROJECT				

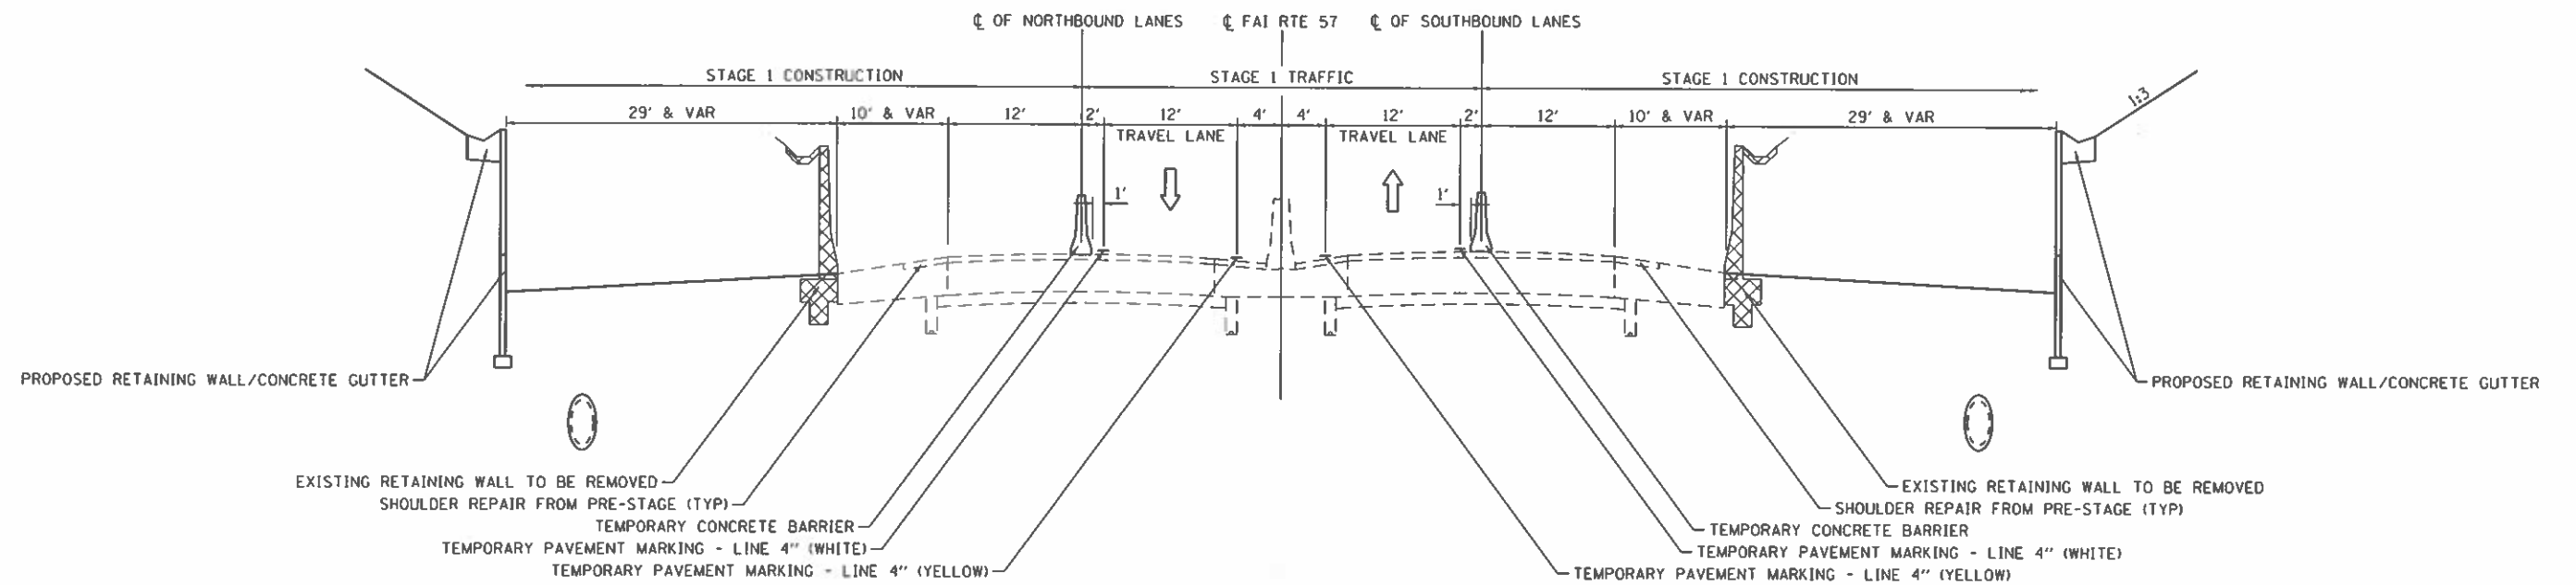


STAGE 1 TYPICAL SECTION
FAI 57 - OUTSIDE LANE WORKZONE
 STA 227+00.00 TO 233+75.00

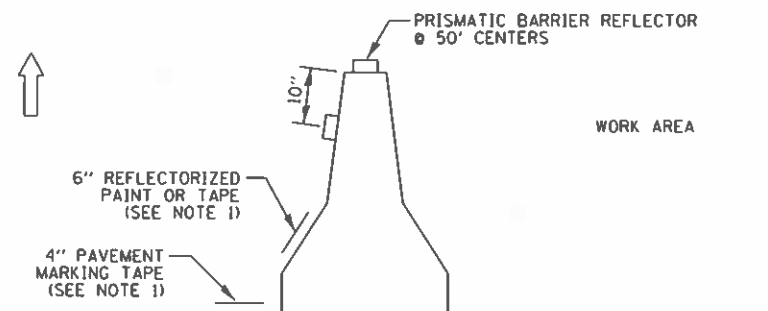

NOTES:

1. THE CONTRACTOR HAS THE OPTION OF USING EITHER THE LINE ON THE TEMPORARY CONCRETE BARRIER OR ON THE PAVEMENT.
2. THE COST OF THE REFLECTORS IS INCLUDED IN THE COST OF THE TEMPORARY CONCRETE BARRIER.

TEMPORARY CONCRETE BARRIER WALL DETAILS

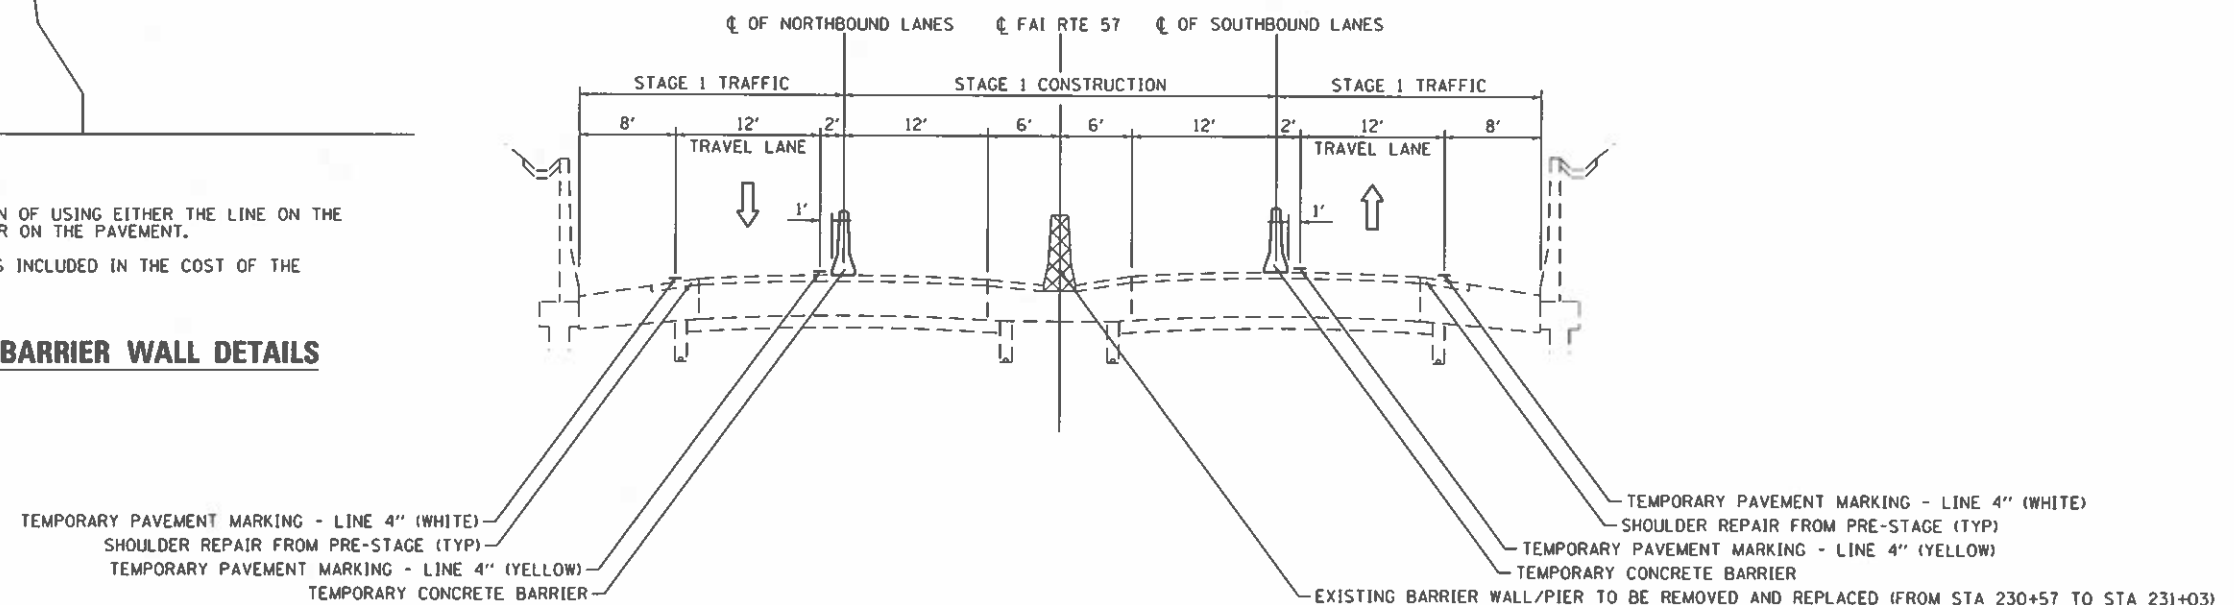

STAGE 1 TYPICAL SECTION
FAI 57 - INSIDE LANE WORKZONE
 STA 227+00.00 TO 233+75.00

MODEL: Plan 1
 FILE NAME: D:\66997-57-Stage 1 Typical Section-2.dgn

Hutchison Engineering, Inc.
 Jacksonville Moline Peoria Shorewood
 Since 1945

USER NAME	= crossthen	DESIGNED	-	REVISED	-
PLOT SCALE	= 0.1867 / 1 in.	DRAWN	-	REVISED	-
PLOT DATE	= 3/28/2021	CHECKED	-	REVISED	-
		DATE	= 2021/03/26	REVISED	-

STATE OF ILLINOIS
DEPARTMENT OF TRANSPORTATION



FAI 57 & WALDRON ROAD
STAGE 1 TYPICAL SECTIONS

SCALE: N.T.S. SHEET 2 OF 2 SHEETS STA. TO STA.

FAI RTE.	SECTION	COUNTY	TOTAL SHEETS	SHEET NO.
57	139 HBR-6	KANKAKEE	202	43
CONTRACT NO. 66997				
ILLINOIS FED. AID PROJECT				



W20-I103(O)-4848
(PLACE ON IL 17/SOUTHBOUND
I-57 ENTRANCE RAMP)

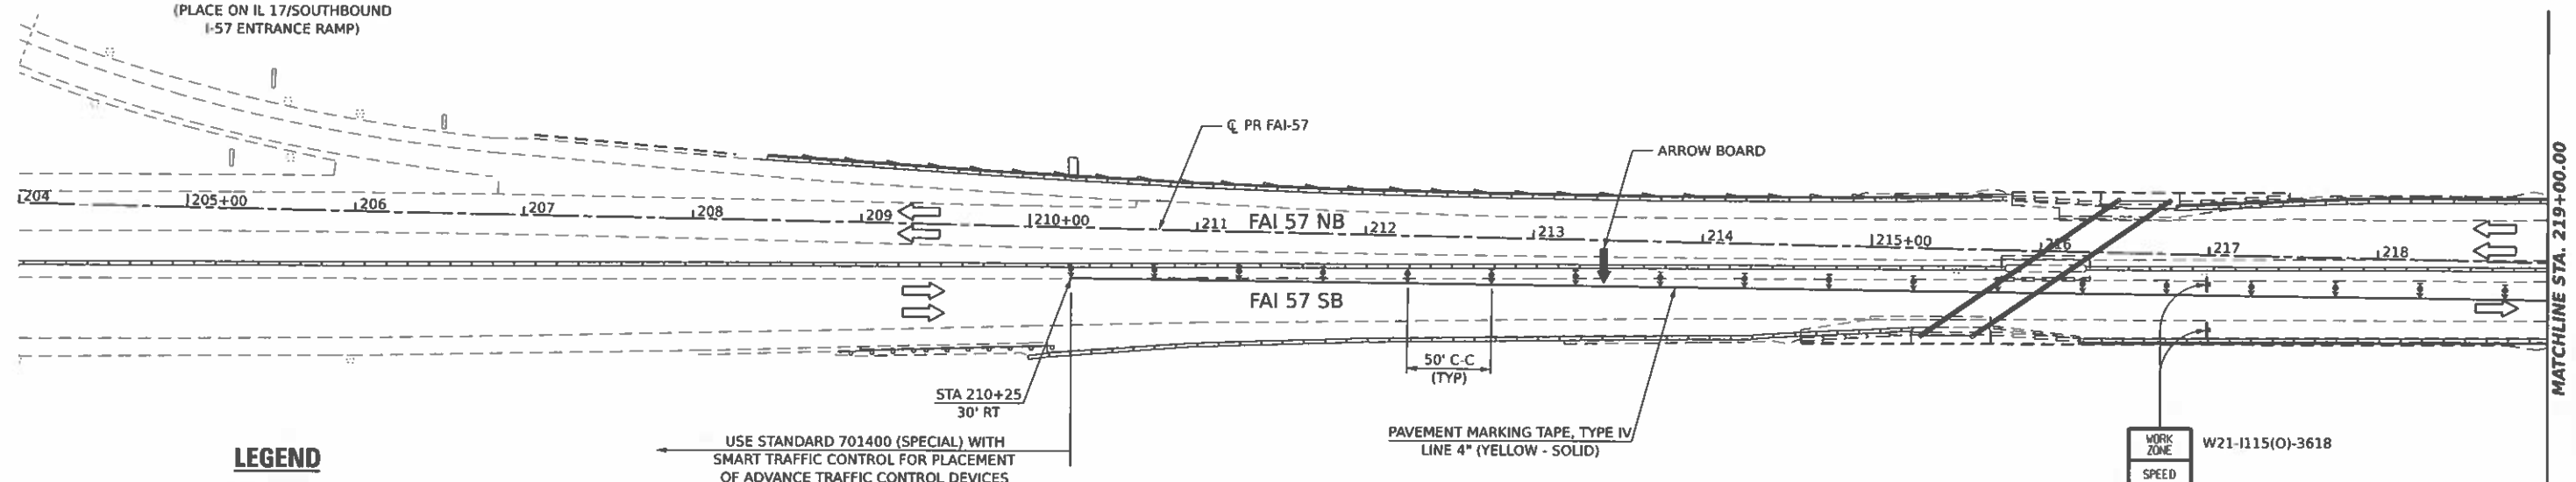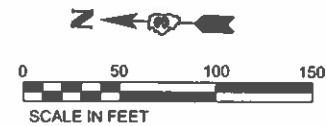


LEGEND

- DIRECTION INDICATOR BARRICADE WITH STEADY BURN MONDIRECTIONAL LIGHT
- DRUM (WITH STEADY BURN BI-DIRECTIONAL LIGHT ON TAPERS ONLY)
- TYPE III BARRICADE WITH FLASHING LIGHT (2-EA.)
- DOUBLE VERTICAL PANEL
- WORK AREA
- ARROW BOARD
- CONSTRUCTION SIGN
- DIRECTION OF TRAFFIC
- TEMPORARY CONCRETE BARRIER
- IMPACT ATTENUATOR, TEMPORARY (NON-REDIRECTIVE), TEST LEVEL 3
- FLASHING MONO-DIRECTIONAL LIGHT

NOTE: ALL CONSTRUCTION SIGNS DESIGNATED WITH (O) SHALL BE FLUORESCENT ORANGE.

WORK ZONE	W21-I115(O)-3618
SPEED LIMIT	R2-1-3648
55	
PHOTO ENFORCED	R10-19aP-3618
XXXX FINE MINIMUM	R2-I106-3618

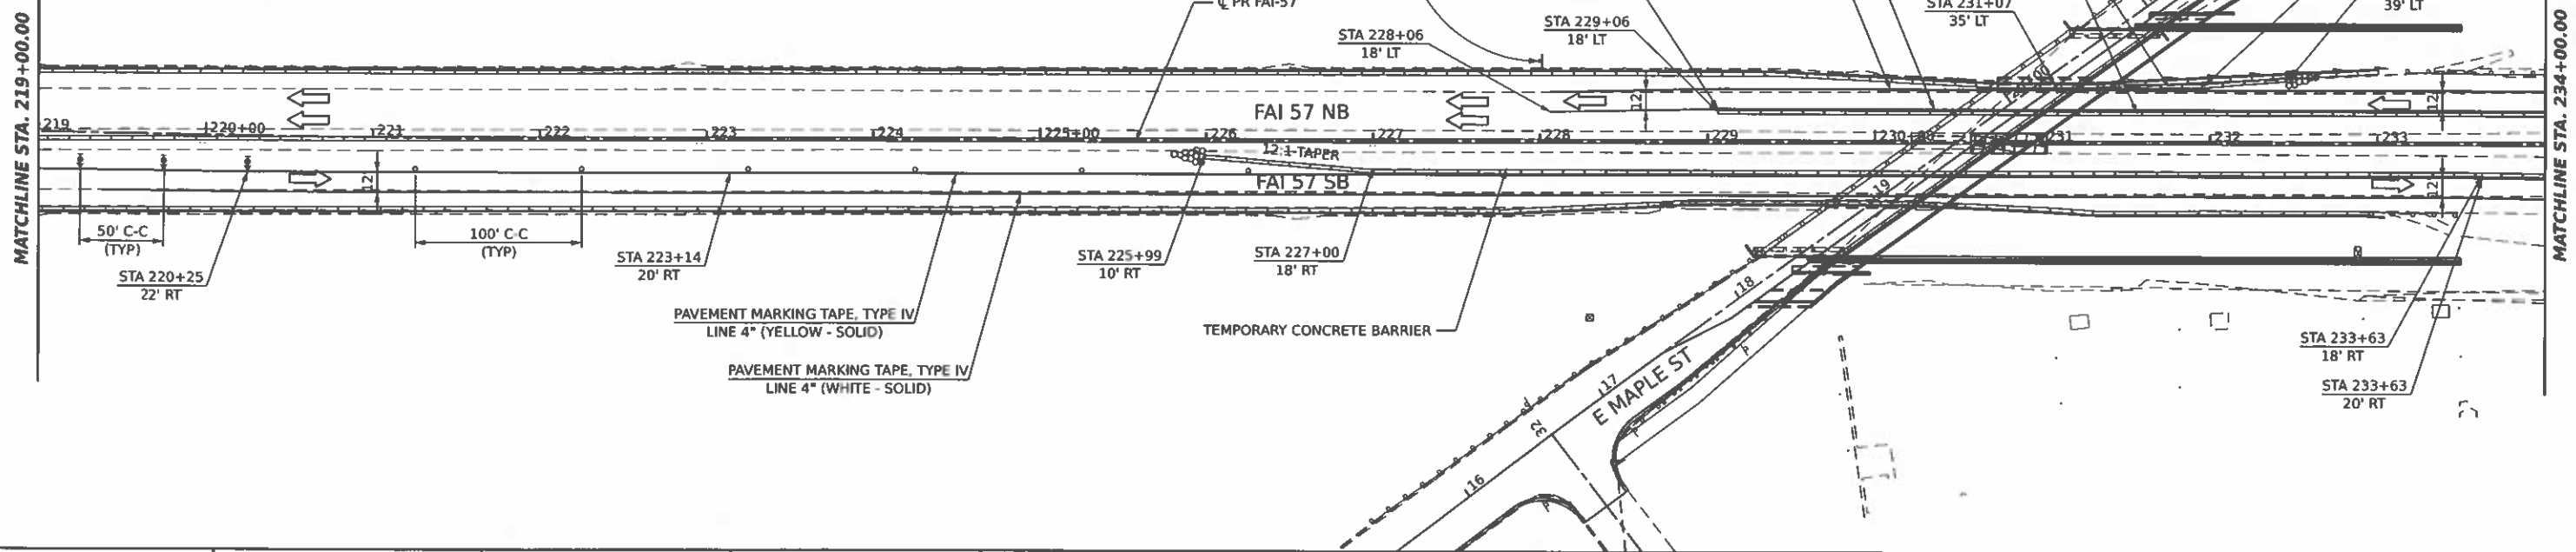

MODEL: Plan 1
FILE NAME: 020003-SN-02001.dgn

Hutchinson Engineering, Inc.
Jacksonville Moline Peoria Shorewood
Since 1945

USER NAME = realsthan	DESIGNED -	REVISED -
PLOT SCALE = 0.106988"/in.	DRAWN -	REVISED -
PLOT DATE = 3/20/2021	CHECKED -	REVISED -
	DATE -	REVISED -

STATE OF ILLINOIS
DEPARTMENT OF TRANSPORTATION

FAI 57 & WALDRON ROAD
STAGE 1 FAI 57 INSIDE LANE CONSTRUCTION AND TRAFFIC CONTROL
SCALE: 1"=50' SHEET 1 OF 7 SHEETS STA. 204+00 TO STA. 234+00

F.A.I. RTE.	SECTION	COUNTY	TOTAL SHEETS	SHEET NO.
57	139 HBR-6	KANKAKEE	202	44
CONTRACT NO. 66997				
ILLINOIS FED. AID PROJECT				

MODEL: Plan 3
FILE NAME: D:\88831-SH-Stage 1-2.dgn

Hutchinson Engineering, Inc.
Jacksonville Moline Peoria Shorewood
Since 1945

USER NAME = rnsalehian
PLOT SCALE = 0.16666633 1/In.
PLOT DATE = 3/29/2021

DESIGNED -
DRAWN -
CHECKED -
DATE = 2021/03/26


REVISED -
REVISED -
REVISED -
REVISED -

**STATE OF ILLINOIS
DEPARTMENT OF TRANSPORTATION**

**FAI 57 & WALDRON ROAD
STAGE 1 FAI 57 INSIDE LANE CONSTRUCTION AND TRAFFIC CONTROL**

SCALE: 1"=50' SHEET 2 OF 7 SHEETS STA. 234+00 TO STA. 264+00

F.A.I. RTE.	SECTION	COUNTY	TOTAL SHEETS	SHEET NO.
57	139 HBR-6	KANKAKEE	202	45
CONTRACT NO. 66997				
ILLINOIS FED. AID PROJECT				

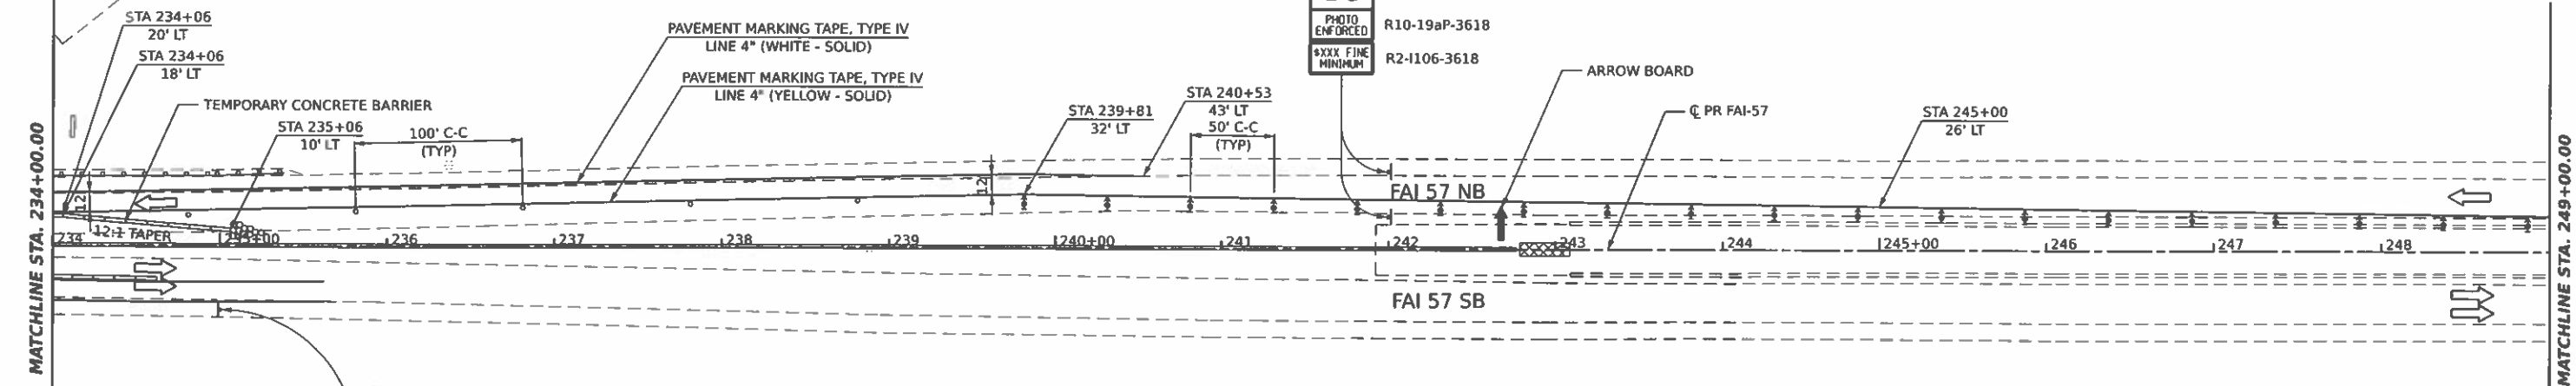




END
WORK ZONE
SPEED LIMIT
G20-I103-6036

LEGEND

- DIRECTION INDICATOR BARRICADE WITH STEADY BURN MONDIRECTIONAL LIGHT
- DRUM (WITH STEADY BURN BI-DIRECTIONAL LIGHT ON TAPERS ONLY)
- TYPE III BARRICADE WITH FLASHING LIGHT (2-EA.)
- DOUBLE VERTICAL PANEL
- WORK AREA
- ARROW BOARD
- CONSTRUCTION SIGN
- DIRECTION OF TRAFFIC
- TEMPORARY CONCRETE BARRIER
- IMPACT ATTENUATOR, TEMPORARY (NON-REDIRECTIVE) TEST LEVEL 3
- FLASHING MONO-DIRECTIONAL LIGHT

NOTE: ALL CONSTRUCTION SIGNS DESIGNATED WITH (O) SHALL BE FLUORESCENT ORANGE.

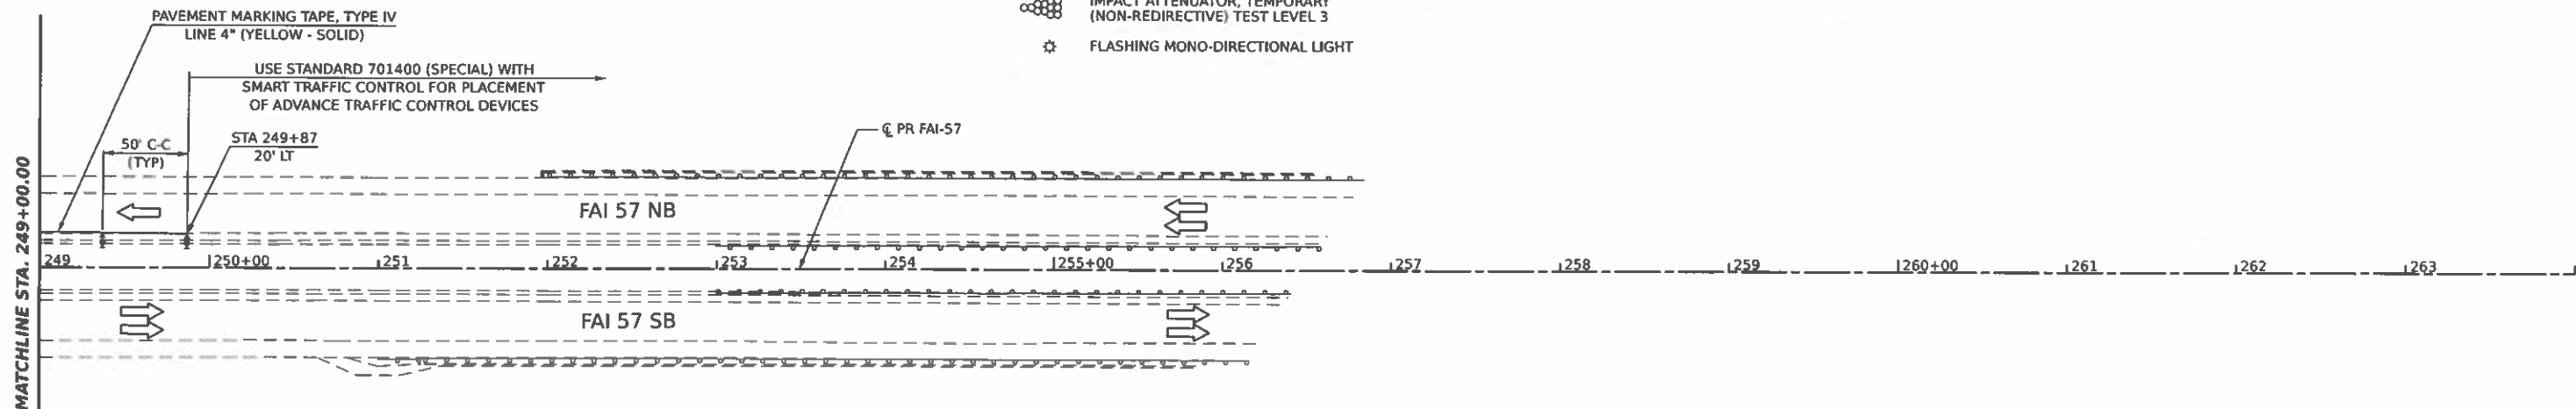

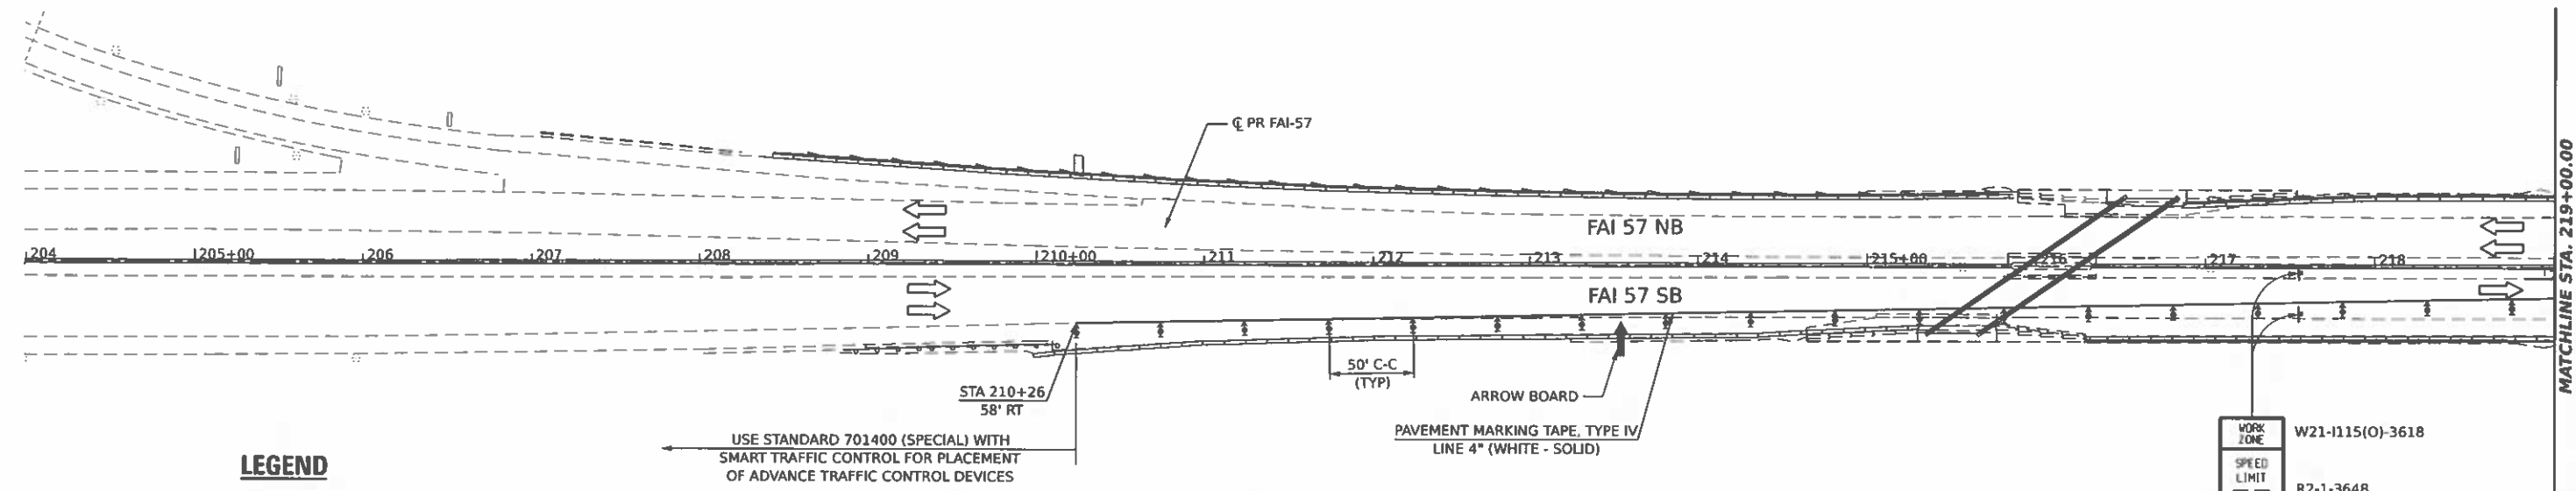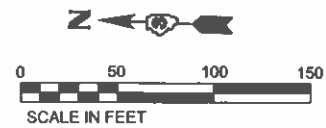

LEGEND

- DIRECTION INDICATOR BARRICADE WITH STEADY BURN MONODIRECTIONAL LIGHT
- DRUM (WITH STEADY BURN BI-DIRECTIONAL LIGHT ON TAPERS ONLY)
- TYPE III BARRICADE WITH FLASHING LIGHT (2-EA.)
- DOUBLE VERTICAL PANEL
- WORK AREA
- ARROW BOARD
- CONSTRUCTION SIGN
- DIRECTION OF TRAFFIC
- TEMPORARY CONCRETE BARRIER
- IMPACT ATTENUATOR, TEMPORARY (NON-REDIRECTIVE) TEST LEVEL 3
- FLASHING MONO-DIRECTIONAL LIGHT

NOTE: ALL CONSTRUCTION SIGNS DESIGNATED WITH (O) SHALL BE FLUORESCENT ORANGE.

WORK ZONE

SPEED LIMIT

55

PHOTO ENFORCED



8XXX FINE MINIMUM

W21-1115(O)-3618



R2-1-3648

R10-19aP-3618

R2-1106-3618

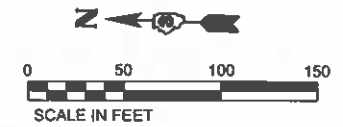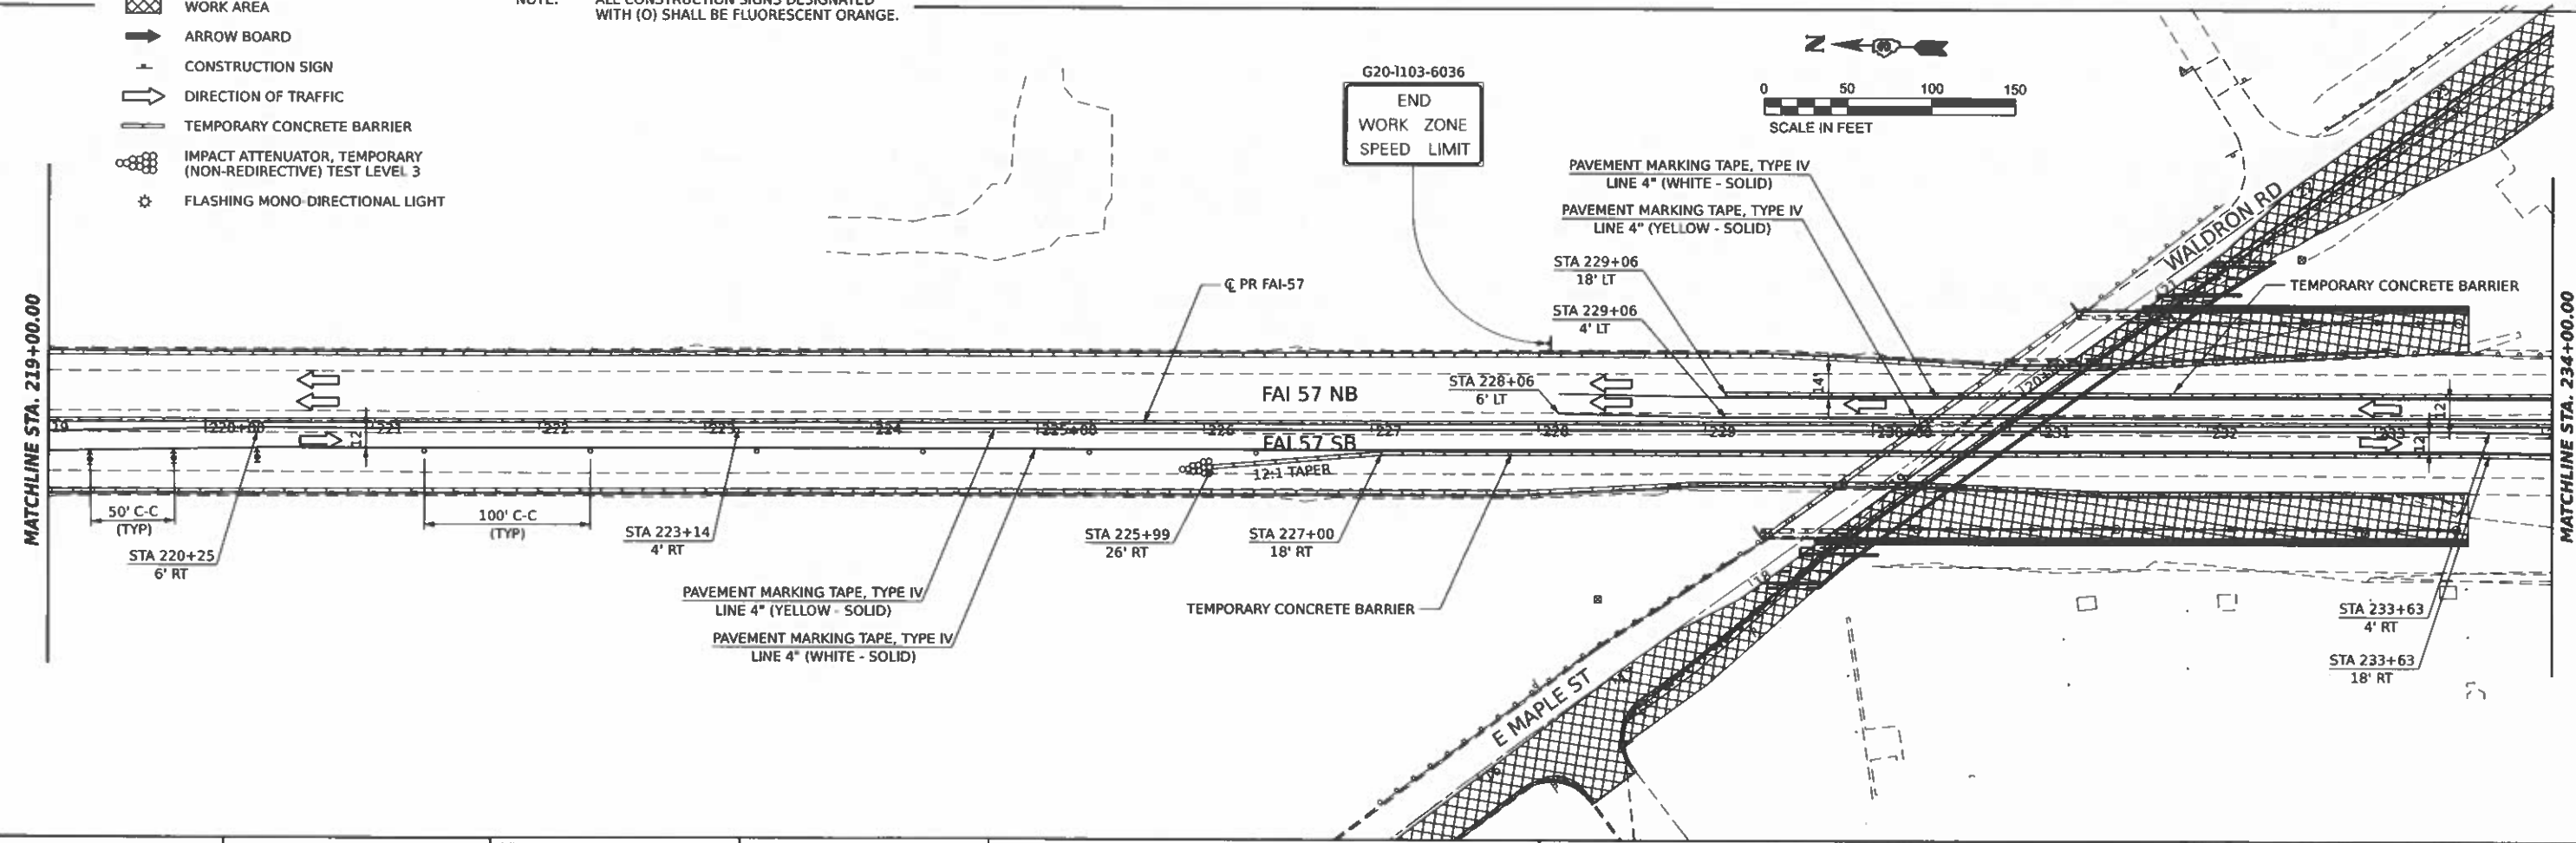

G20-1103-6036
END
WORK ZONE
SPEED LIMIT

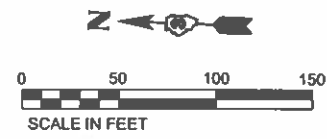
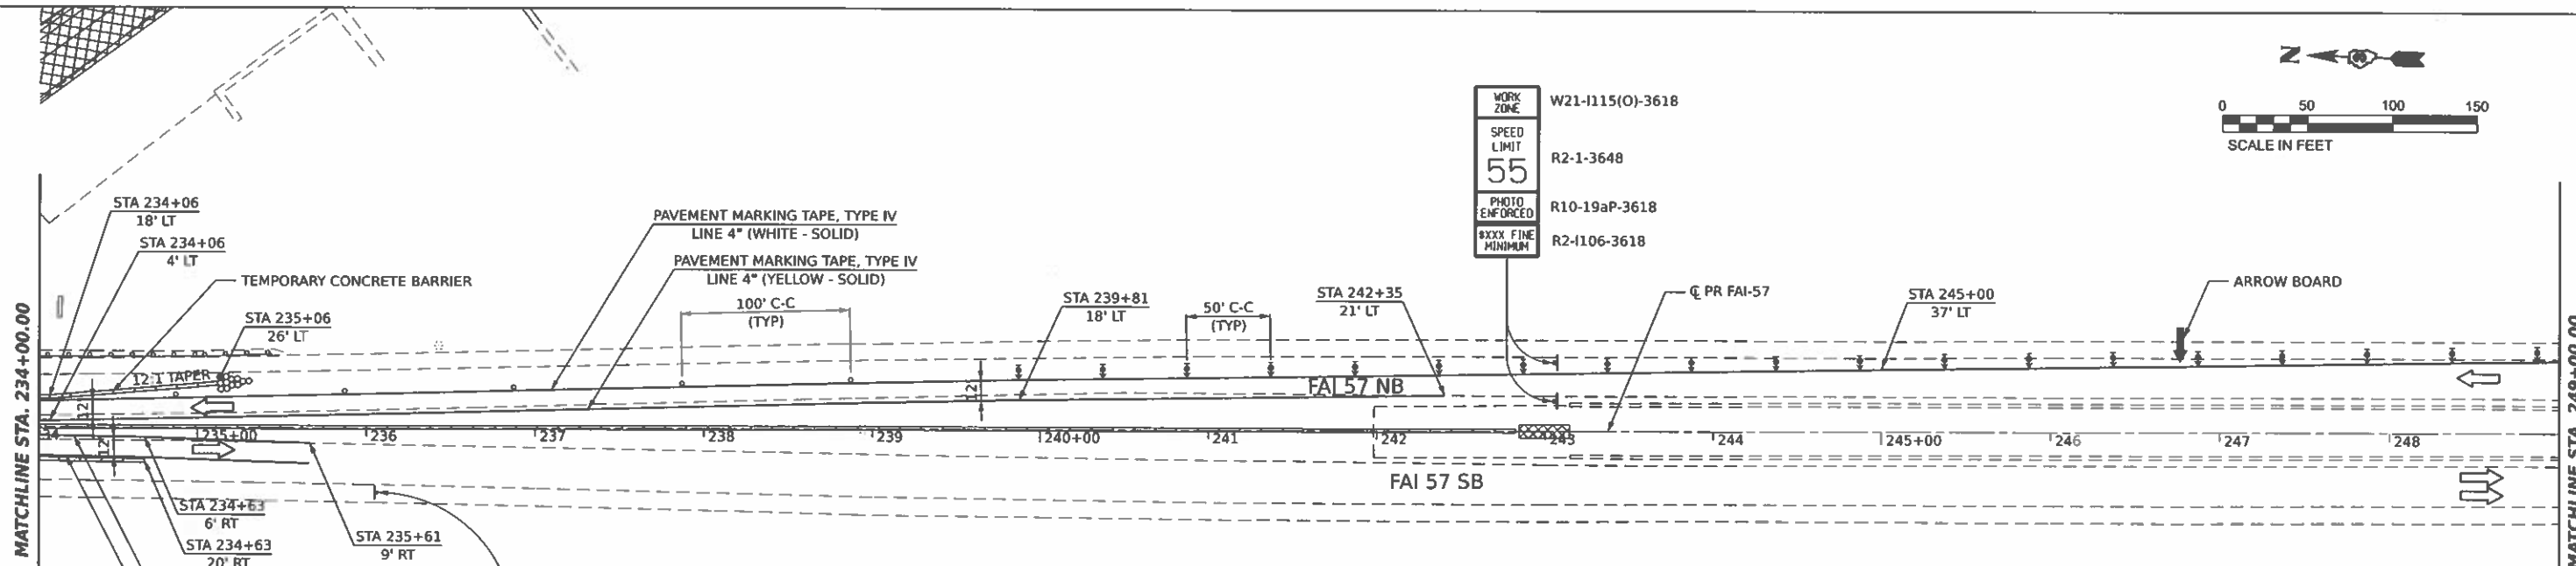


END
WORK ZONE
SPEED LIMIT
G20-I103-6036

LEGEND

- DIRECTION INDICATOR BARRICADE WITH STEADY BURN MONDIRECTIONAL LIGHT
- DRUM (WITH STEADY BURN BI-DIRECTIONAL LIGHT ON TAPERS ONLY)
- TYPE III BARRICADE WITH FLASHING LIGHT (2-EA.)
- DOUBLE VERTICAL PANEL
- WORK AREA
- ARROW BOARD
- CONSTRUCTION SIGN
- DIRECTION OF TRAFFIC
- TEMPORARY CONCRETE BARRIER
- IMPACT ATTENUATOR, TEMPORARY (NON-REDIRECTIVE) TEST LEVEL 3
- FLASHING MONO-DIRECTIONAL LIGHT

NOTE: ALL CONSTRUCTION SIGNS DESIGNATED WITH (O) SHALL BE FLUORESCENT ORANGE.

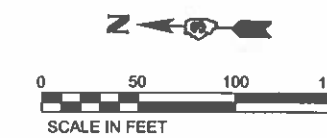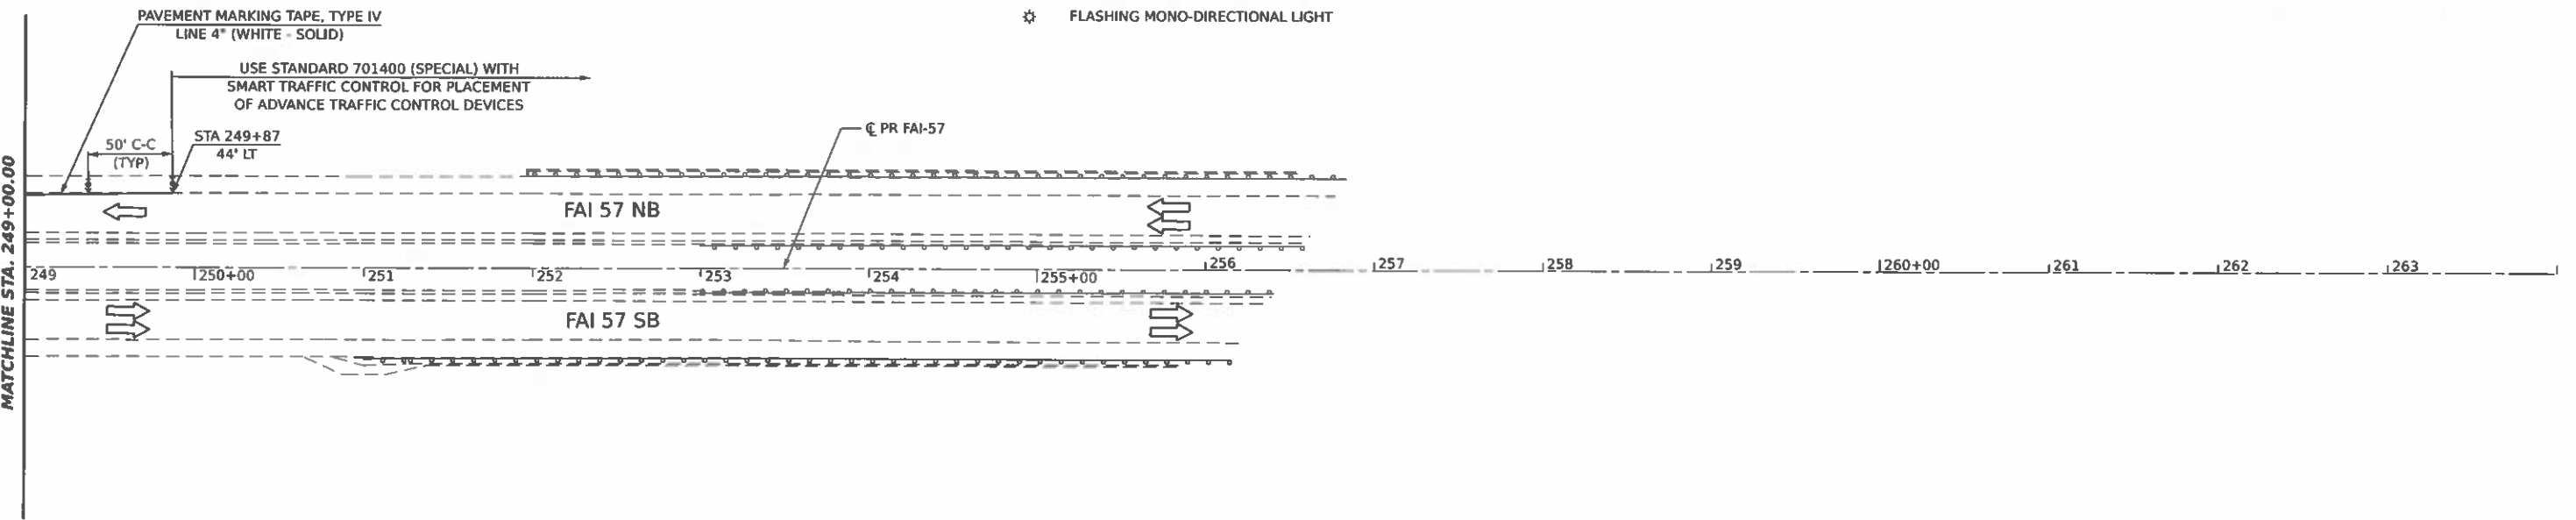

MODEL: Plan 3
FILE NAME: D088053-Sht-Stage 1.dgn

Hutchinson Engineering, Inc.
Jacksonville Moline Peoria Shorewood
Since 1945



USER NAME = mshahar	DESIGNED -	REVISED -
PLOT SCALE = 0.10666633' / in.	DRAWN -	REVISED -
PLOT DATE = 3/20/2021	CHECKED -	REVISED -
	DATE = 2021/03/26	REVISED -



**STATE OF ILLINOIS
DEPARTMENT OF TRANSPORTATION**

**FAI 57 & WALDRON ROAD
STAGE 1 FAI 57 OUTSIDE LANE CONSTRUCTION AND TRAFFIC CONTROL**
SCALE: 1"=50' SHEET 4 OF 7 SHEETS STA. 234+00 TO STA. 264+00

F.A.I. RTE.	SECTION	COUNTY	TOTAL SHEETS	SHEET NO.
57	139 HBR-6	KANKAKEE	202	47
CONTRACT NO. 66997				

ILLINOIS FED. AID PROJECT

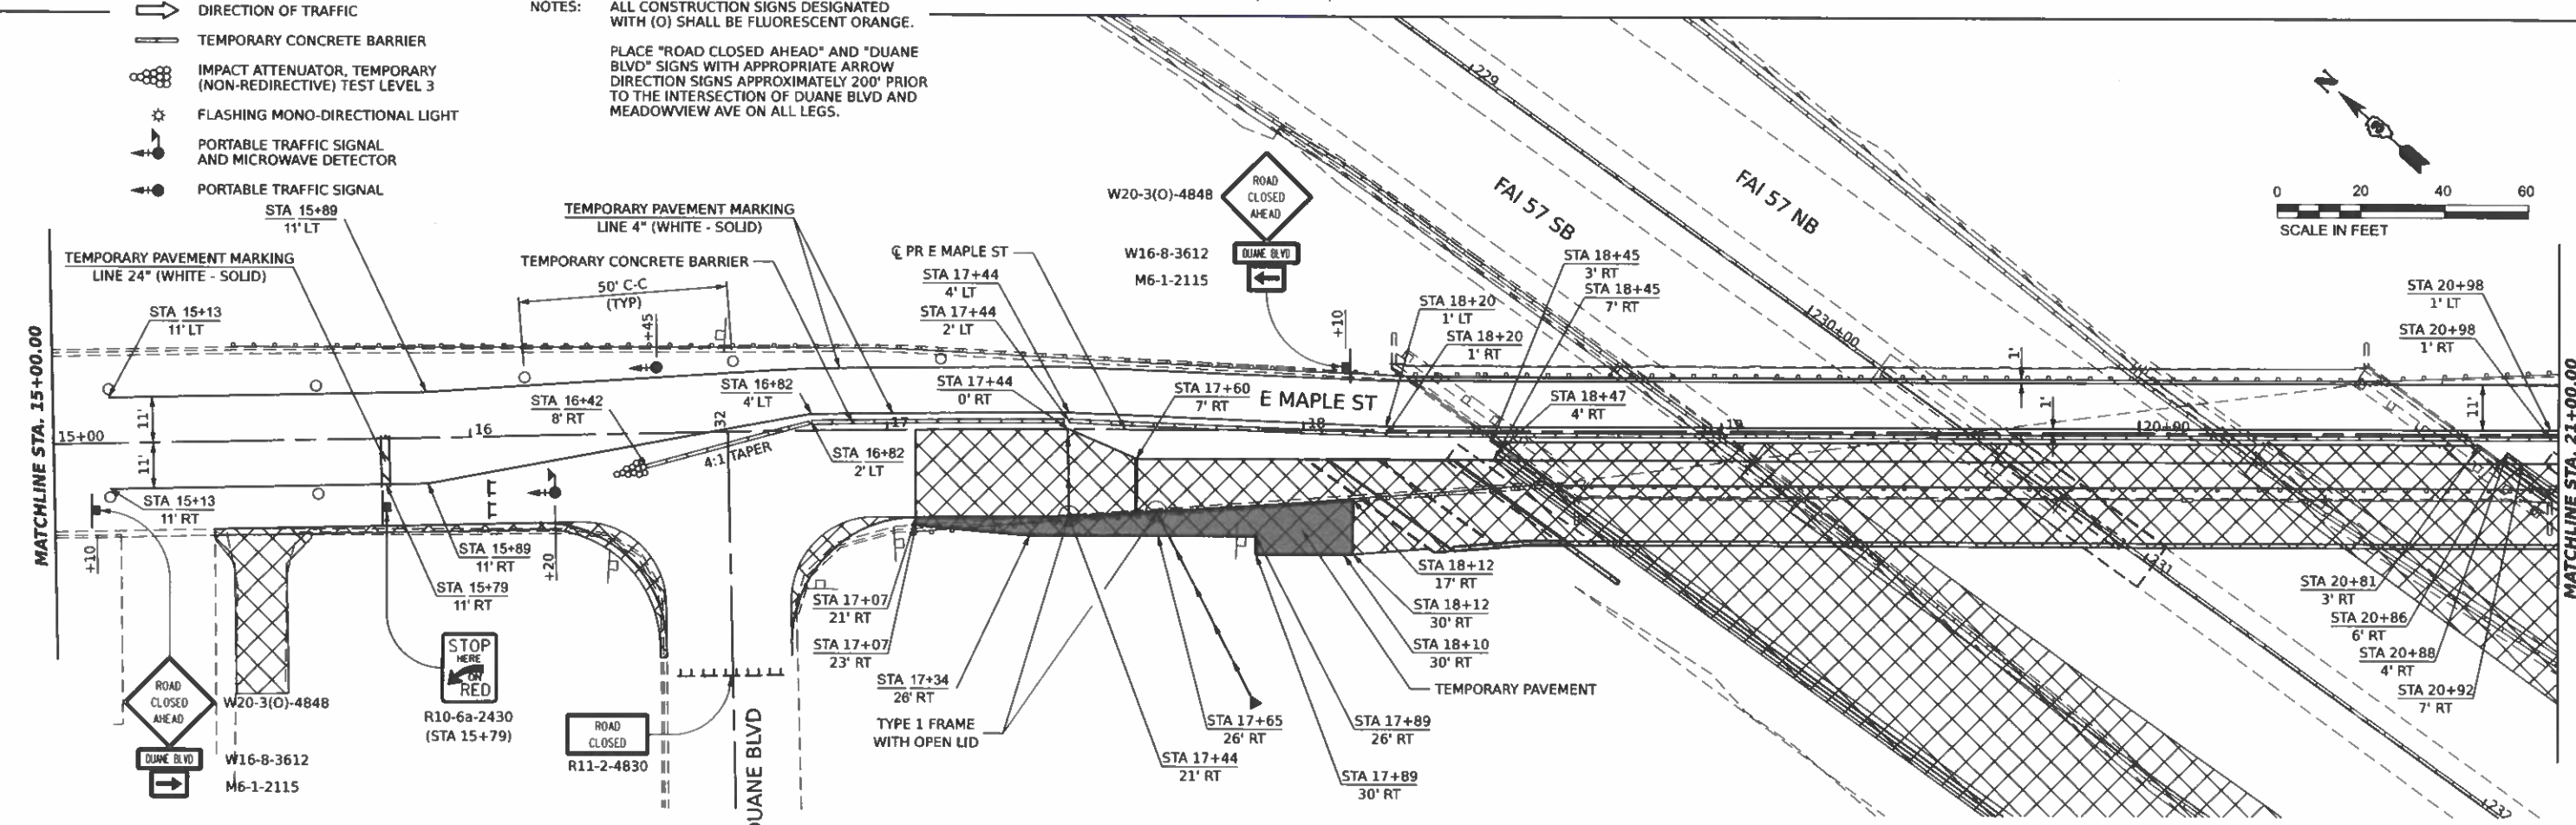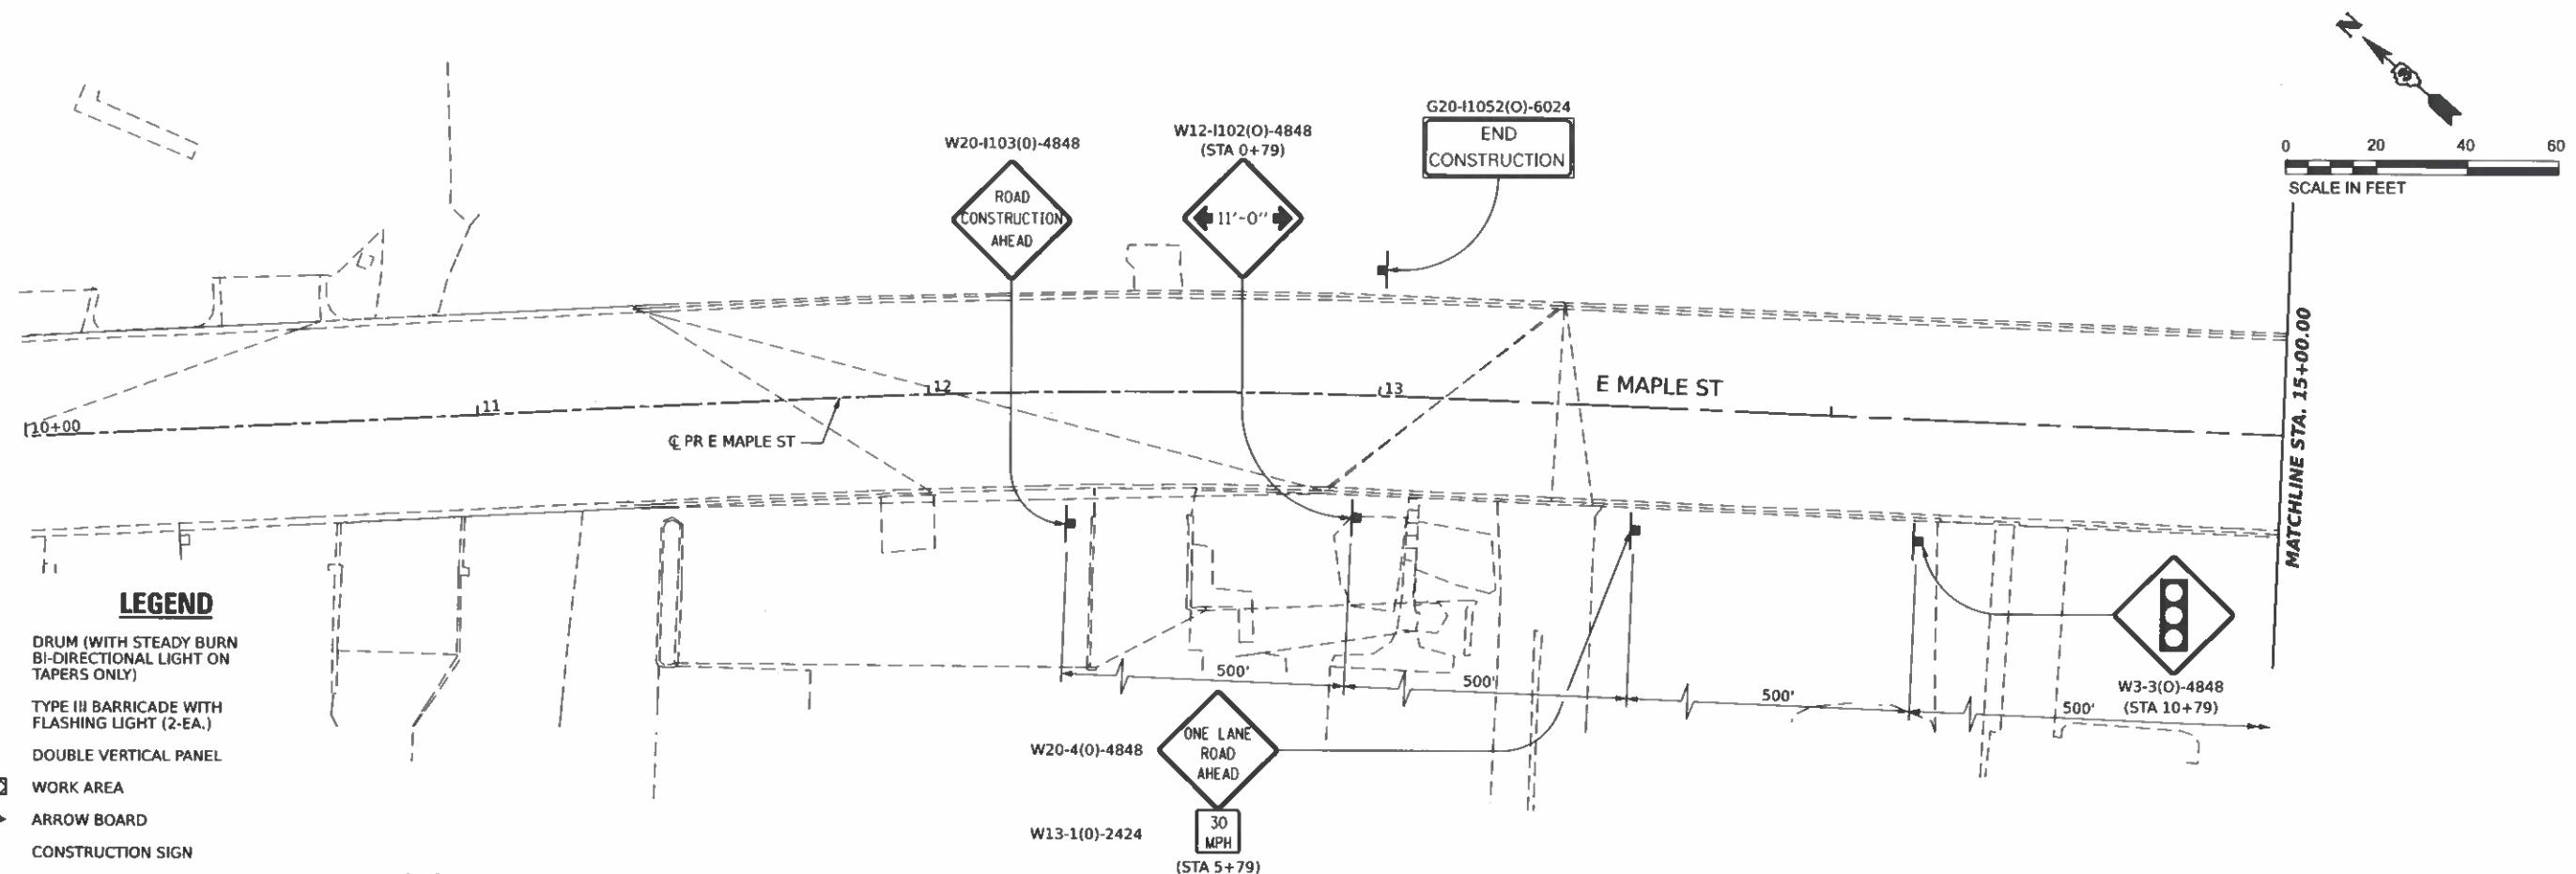

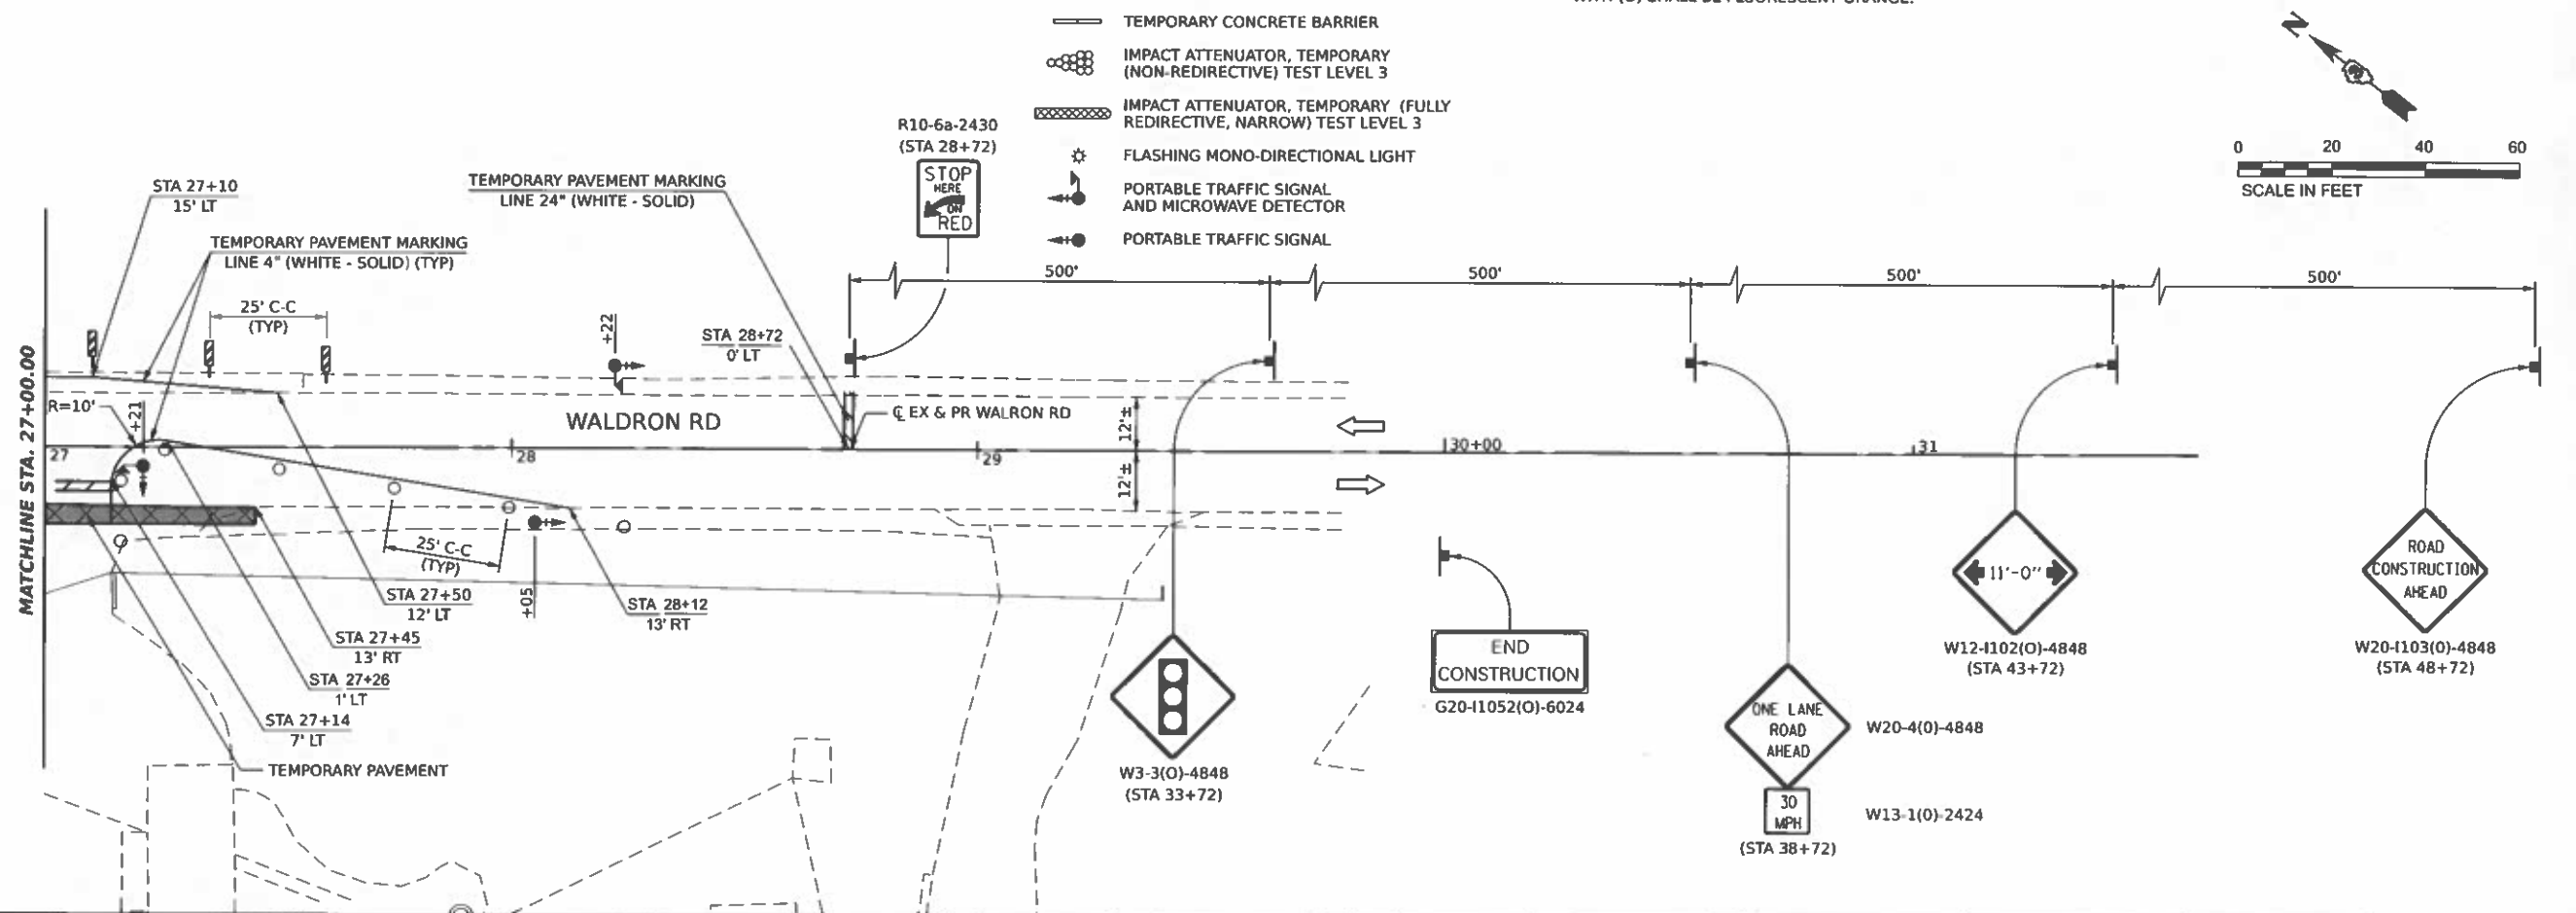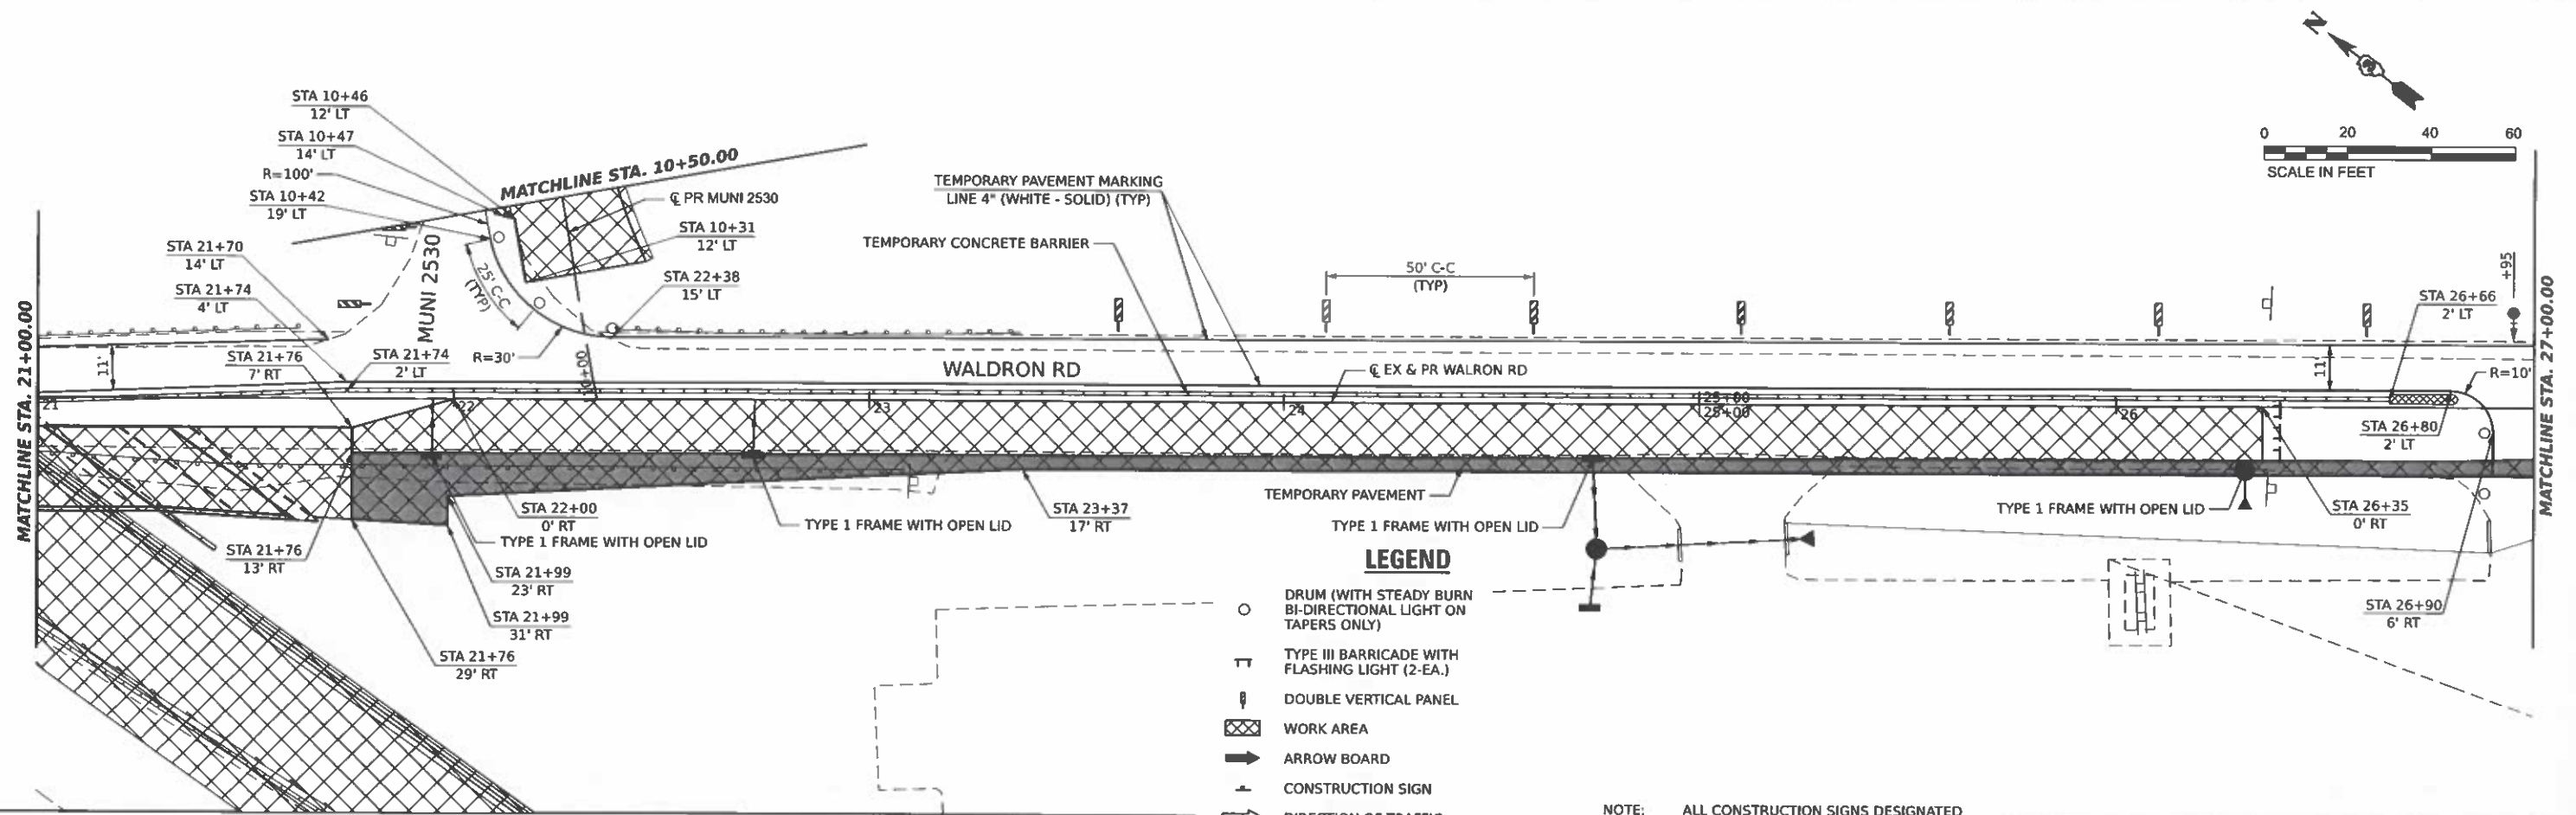

MODEL: Plan 7
FILE NAME: 10000003-000-Stage 1.dgn

Hutchinson Engineering, Inc.
Jacksonville Maine Peoria Shorewood
Since 1945

USER NAME = neal@hutchinson.com
PLOT SCALE = 0.18668633" / in.
PLOT DATE = 3/29/2021

DESIGNED -
DRAWN -
CHECKED -
DATE -


REVISED -
REVISED -
REVISED -
REVISED -

**STATE OF ILLINOIS
DEPARTMENT OF TRANSPORTATION**

**FAI 57 & WALDRON ROAD
STAGE 1 CONSTRUCTION AND TRAFFIC CONTROL**

SCALE: 1"=20' SHEET 6 OF 7 SHEETS STA. 21+00 TO STA. 31+50

FAI RTE	SECTION	COUNTY	TOTAL SHEETS	SHEET NO.
57	139 HBR-6	KANKAKEE	202	49
CONTRACT NO. 66997				
ILLINOIS FED. AID PROJECT				

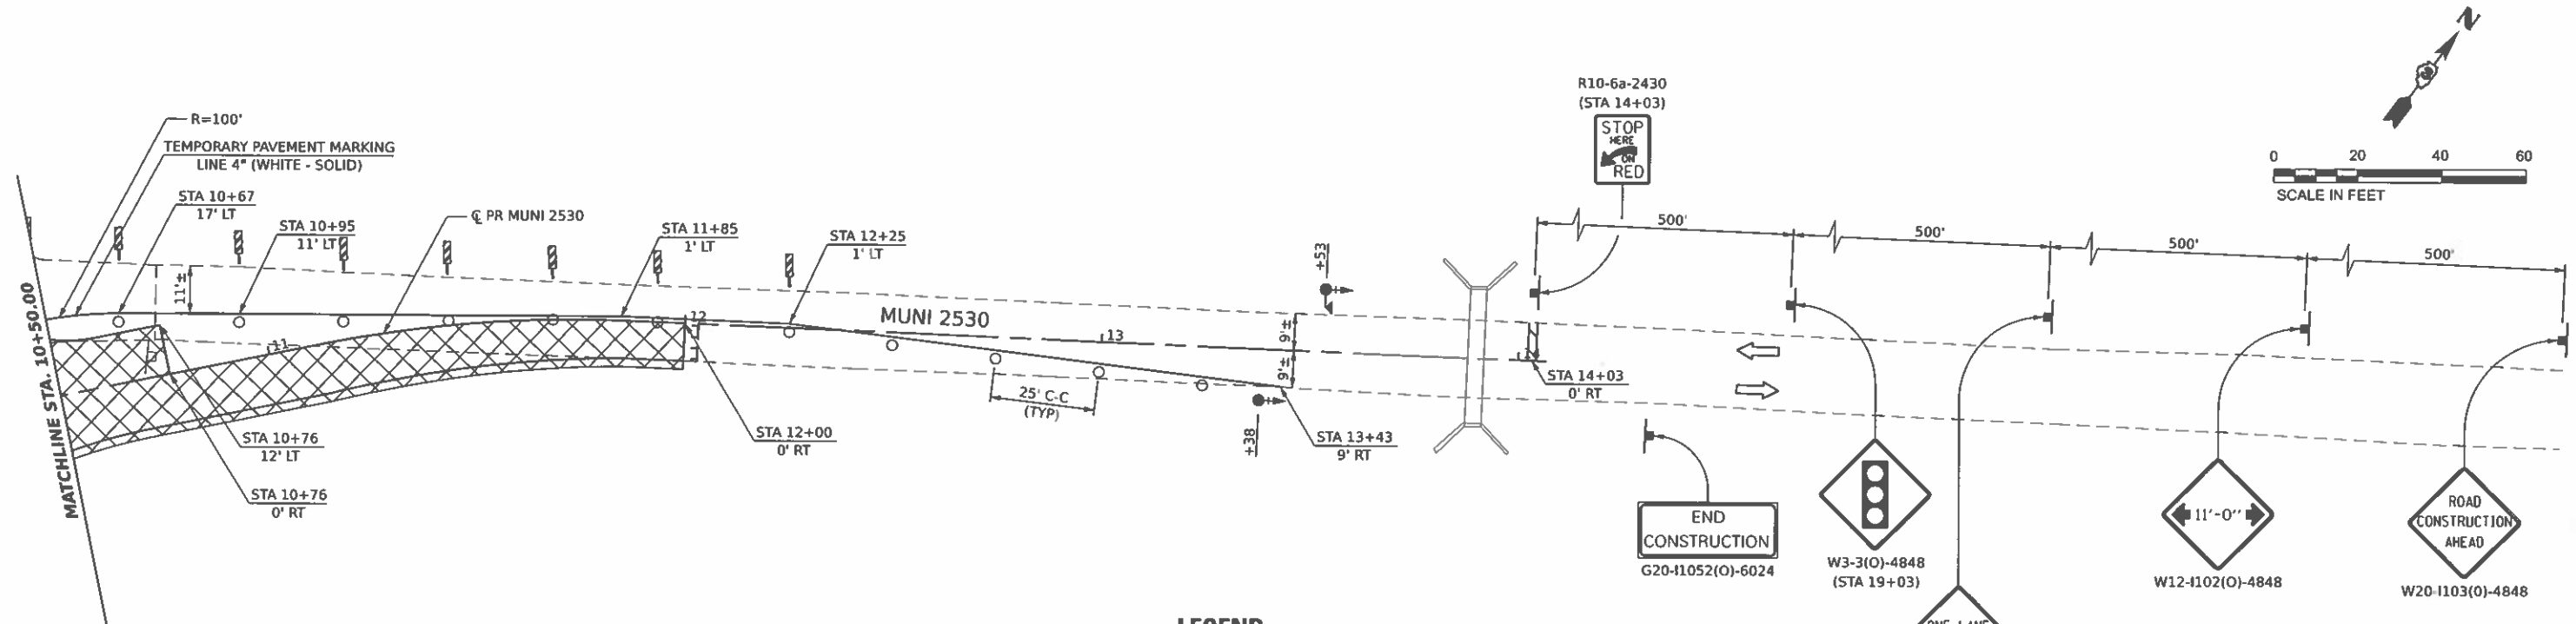

LEGEND

- DRUM (WITH STEADY BURN BI-DIRECTIONAL LIGHT ON TAPERS ONLY)
- ⌌ TYPE III BARRICADE WITH FLASHING LIGHT (2-EA.)
- ⌌ DOUBLE VERTICAL PANEL
- ⊗ WORK AREA
- ➡ ARROW BOARD
- ⌌ CONSTRUCTION SIGN
- ➡ DIRECTION OF TRAFFIC
- ⌌ TEMPORARY CONCRETE BARRIER
- ⊗ IMPACT ATTENUATOR, TEMPORARY (NON-REDIRECTIVE) TEST LEVEL 3
- ⌌ FLASHING MONO-DIRECTIONAL LIGHT
- ⌌ PORTABLE TRAFFIC SIGNAL AND MICROWAVE DETECTOR
- ⌌ PORTABLE TRAFFIC SIGNAL

NOTE: ALL CONSTRUCTION SIGNS DESIGNATED WITH (O) SHALL BE FLUORESCENT ORANGE.

MODEL: Plan 9
FILE NAME: D:\06083-SH-Stage 1.dgn

Hutchison Engineering, Inc.
Jacksonville Moline Peoria Shorewood
Since 1945

USER NAME = neashian	DESIGNED -	REVISED -
PLOT SCALE = 0.10000000377 in.	DRAWN -	REVISED -
PLOT DATE = 3/29/2021	CHECKED -	REVISED -
	DATE = 2021/03/26	REVISED -

STATE OF ILLINOIS
DEPARTMENT OF TRANSPORTATION

FAI 57 & WALDRON ROAD
STAGE 1 CONSTRUCTION AND TRAFFIC CONTROL

SCALE: 1"=20' SHEET 7 OF 7 SHEETS STA. 10+50 TO STA. 14+06.67

F.A.I. RTE.	SECTION	COUNTY	TOTAL SHEETS	SHEET NO.
57	139 HBR-6	KANKAKEE	202	50
CONTRACT NO. 66997				
ILLINOIS FED. AID PROJECT				

STAGE 2 CONSTRUCTION

INSTALL TRAFFIC CONTROL SIGNING.

ADJUST TEMPORARY BRIDGE SIGNALS ACCORDING TO STAGE 2 PLANS.

CONSTRUCT PERMANENT WESTBOUND LANE ON WALDRON ROAD (MINUS THE SURFACE COURSE) FROM STA 17+07 TO STA 17+96 AND FROM STA 22+22 TO STA 26+35. CONSTRUCT CURB AND GUTTER FROM STA 15+38 TO STA 17+07.

CONSTRUCT MUN 2530 ACCORDING TO STAGE 2 PLANS. MUN 2530 TO REMAIN OPEN AT ALL TIMES DURING STAGE 2 UNLESS A FLAGGER CONTROLLED LANE CLOSURE IS PROVIDED. A TEMPORARY RAMP SHALL BE CONSTRUCTED TO PROVIDE ACCESS TO THE WALDRON ROAD PAVEMENT CONSTRUCTED IN STAGE 1.

CONSTRUCT PROPOSED STORM SEWER ALONG WALDRON ROAD AND I-57 WITHIN THE STAGE 2 CONSTRUCTION LIMITS AS SHOWN IN THE STAGE 2 PLANS.

REMOVE WESTBOUND SUBSTRUCTURE AND SUPERSTRUCTURE OF EXISTING SN 046-0080 WITHIN THE STAGE 2 LIMITS AS SHOWN IN THE STRUCTURE PLANS. CONSTRUCT WESTBOUND SUBSTRUCTURE AND SUPERSTRUCTURE OF PROPOSED SN 046-0153 WITHIN THE STAGE 2 LIMITS AS SHOWN IN THE STRUCTURE PLANS.

REMOVE EXISTING RETAINING WALL WITHIN THE STAGE 2 LIMITS. CONSTRUCT STAGE 2 PORTIONS OF RETAINING WALLS A AND B AS SHOWN IN THE RETAINING WALL PLANS.

STAGE 2A CONSTRUCTION

CONSTRUCT REMAINING PERMANENT WESTBOUND LANE ON WALDRON ROAD (MINUS THE SURFACE COURSE) FROM STA 21+22 TO STA 22+22.

CONSTRUCT REMAINING MUN 2530 ACCORDING TO STAGE 2A PLANS. MUN 2530 TO REMAIN OPEN AT ALL TIMES DURING STAGE 2A UNLESS A FLAGGER CONTROLLED LANE CLOSURE IS PROVIDED.

CONSTRUCT PROPOSED STORM SEWER ALONG WALDRON ROAD WITHIN THE STAGE 2A CONSTRUCTION LIMITS AS SHOWN IN THE STAGE 2A PLANS.

TRAFFIC CONTROL AND PROTECTION

TRAFFIC CONTROL AND PROTECTION SHALL BE PERFORMED IN ACCORDANCE WITH THE TRAFFIC CONTROL PLAN, SECTION 701 OF THE STANDARD SPECIFICATIONS AND THE SPECIAL PROVISIONS.

I-57

MAINTAIN ONE LANE OF TRAFFIC IN EACH DIRECTION AT ALL TIMES.


DURING SUPERSTRUCTURE DEMOLITION, LIVE TRAFFIC ON I-57 UNDERNEATH THE BRIDGE WILL ONLY BE PERMITTED FOR ADVANCE DEMOLITION PERPARATIONS (SAWCUTTING, PARTIAL CHIPPING) WITH PROTECTIVE SHIELDING IN PLACE. ALL OTHER DEMOLITION OPERATIONS TO THE BRIDGE WILL DIVERT THE I-57 TRAFFIC UTILIZING A DETOUR PROVIDED IN THE "TOTAL INTERSTATE CLOSURE AT NIGHT" DETAIL. CHANGEABLE MESSAGE SIGNS SHALL BE IN PLACE 2 WEEKS PRIOR TO ANY INTERSTATE CLOSURE.

FOR BEAM PLACEMENT, DIVERT THE I-57 TRAFFIC UTILIZING THE DETOUR AS SHOWN IN THE "TOTAL INTERSTATE CLOSURE AT NIGHT" DETAIL.

DURING INSTALLATION OF FORMS FOR THE CONCRETE DECK, LANE CLOSURES WILL BE ALLOWED SO THAT NO FORMING WORK IS PERFORMED ABOVE LIVE TRAFFIC.

WALDRON ROAD

MAINTAIN ONE LANE OF TRAFFIC AT ALL TIMES UTILIZING HIGHWAY STANDARD 701321. DUANE BLVD WILL BE CLOSED DURING STAGE 2.

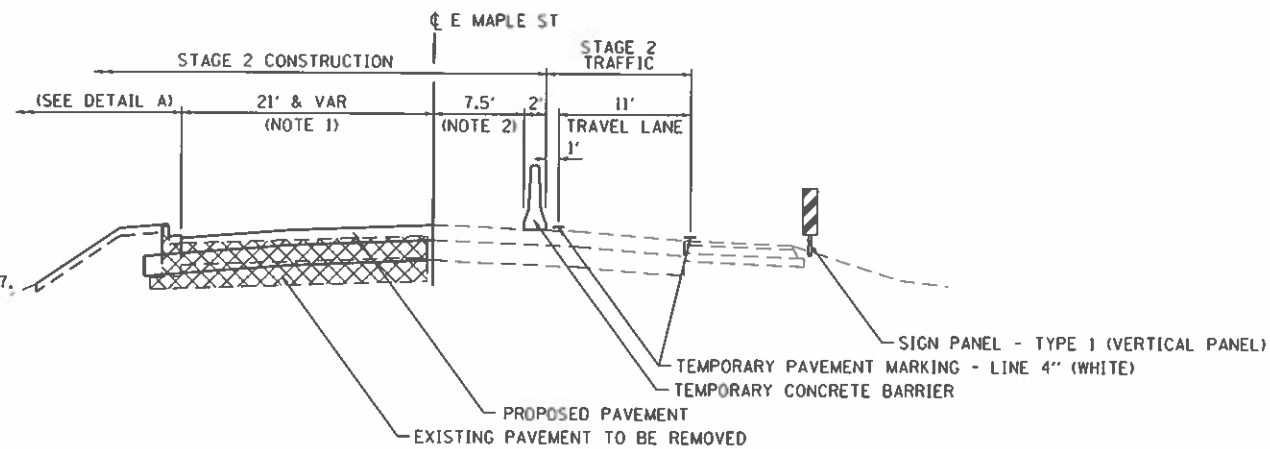


STAGE 2 TYPICAL SECTION E MAPLE ST

STA 17+06.78 TO 17+96.21

NOTES:

- VARIES FROM 21' AT STA 16+84 TO 22' AT STA 17+62.
- VARIES FROM 1' AT STA 17+07 TO 7.5' AT STA 17+34, VARIES FROM 7.5' AT STA 21+56 TO 0.5' AT STA 23+37.

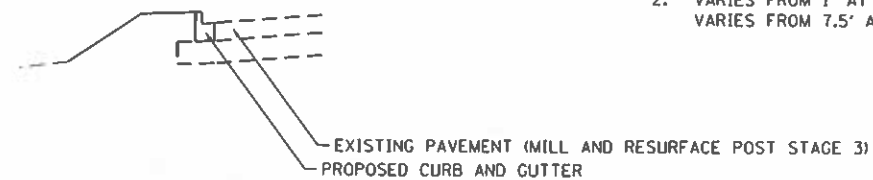

DETAIL A

STA 15+38.36 TO 17+06.78

EXISTING TRAFFIC CONTROL SIGNS AND DEVICES WILL BE REMOVED BY THE CONTRACTOR AFTER THE PROPOSED TRAFFIC CONTROL REQUIREMENTS ARE MET, OR AS AUTHORIZED BY THE ENGINEER. SIGNS OR DEVICES LEFT IN PLACE AT THIS TIME ARE TO BE PROTECTED FROM DAMAGE BY THE CONTRACTOR.


THE CONTRACTOR SHALL SCHEDULE OPERATIONS TO ENSURE THAT NO DROP-OFF OF GREATER THAN 12\"/>

NO DROP-OFF GREATER THAN 24\"/>

DRUMS WITH STEADY-BURNING LIGHTS SHALL BE REQUIRED TO DELINEATE THE TRAVEL WAY. THE MAXIMUM SPACING SHALL BE 100 FEET, CENTER TO CENTER ALONG TANGENTS (50 FEET ALONG TAPERS); AND 25 FEET (CENTER TO CENTER) ALONG RADII TO SIDE ROADS AND ENTRANCES.

THE FOLLOWING TRAFFIC CONTROL STANDARDS ARE THE MINIMUM REQUIREMENTS FOR THE TRAFFIC FOR THIS PROJECT: 701001, 701006, 70101, 701201, 701301, 701326, 701400, 701401, 701406, 701901 AND 704001.


CHANGEABLE MESSAGE SIGNS ARE TO BE IN PLACE 2 WEEKS PRIOR TO THE BEGINNING OF CONSTRUCTION.

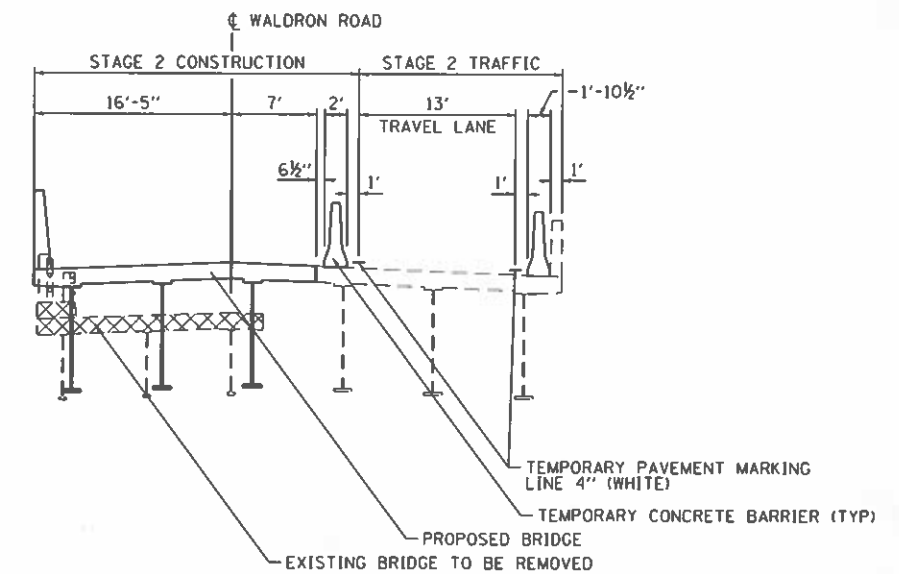

STAGE 2 BRIDGE TYPICAL SECTION WALDRON ROAD

STA 17+96.21 TO 21+21.73

TEMPORARY PAVEMENT MARKING ON FINAL WEARING SURFACE SHALL BE PAVEMENT MARKING TAPE, TYPE IV

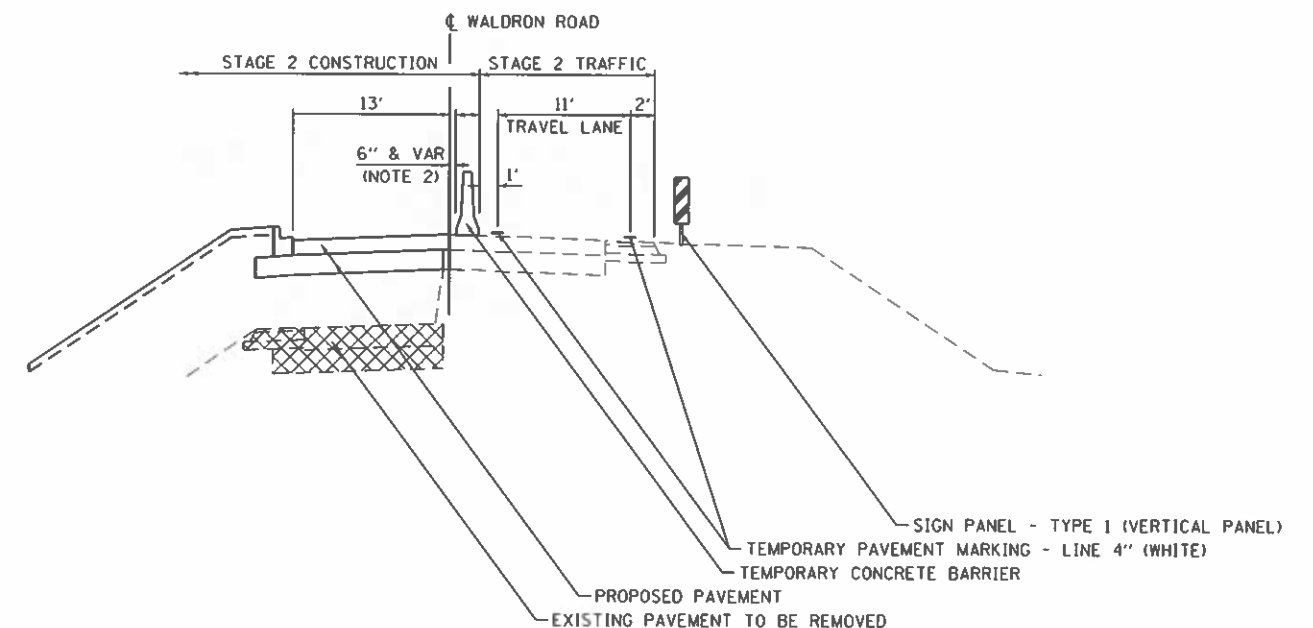

STAGE 2 TYPICAL SECTION WALDRON ROAD

STA 22+22.20 TO 26+35.00

MODEL: Plan 1
FILE NAME: C:\06083-SH-Stage 2 Typical Sections.dgn

Hutchinson Engineering, Inc.
Jacksonville Moline Peoria Shawnee
Since 1945

USER NAME	= rnschlan
DESIGNED	-
DRAWN	-
CHECKED	-
DATE	= 2021/03/26


REVISED	-
REVISED	-
REVISED	-
REVISED	-

STATE OF ILLINOIS
DEPARTMENT OF TRANSPORTATION


FAI 57 & WALDRON ROAD
STAGE 2 TYPICAL SECTIONS

SCALE: N.T.S. SHEET 1 OF 2 SHEETS STA. TO STA.

FAI RTE	SECTION	COUNTY	TOTAL SHEETS	SHEET NO.
57	139 HBR-6	KANKAKEE	202	51
CONTRACT NO. 66997				
ILLINOIS FED. AID PROJECT				

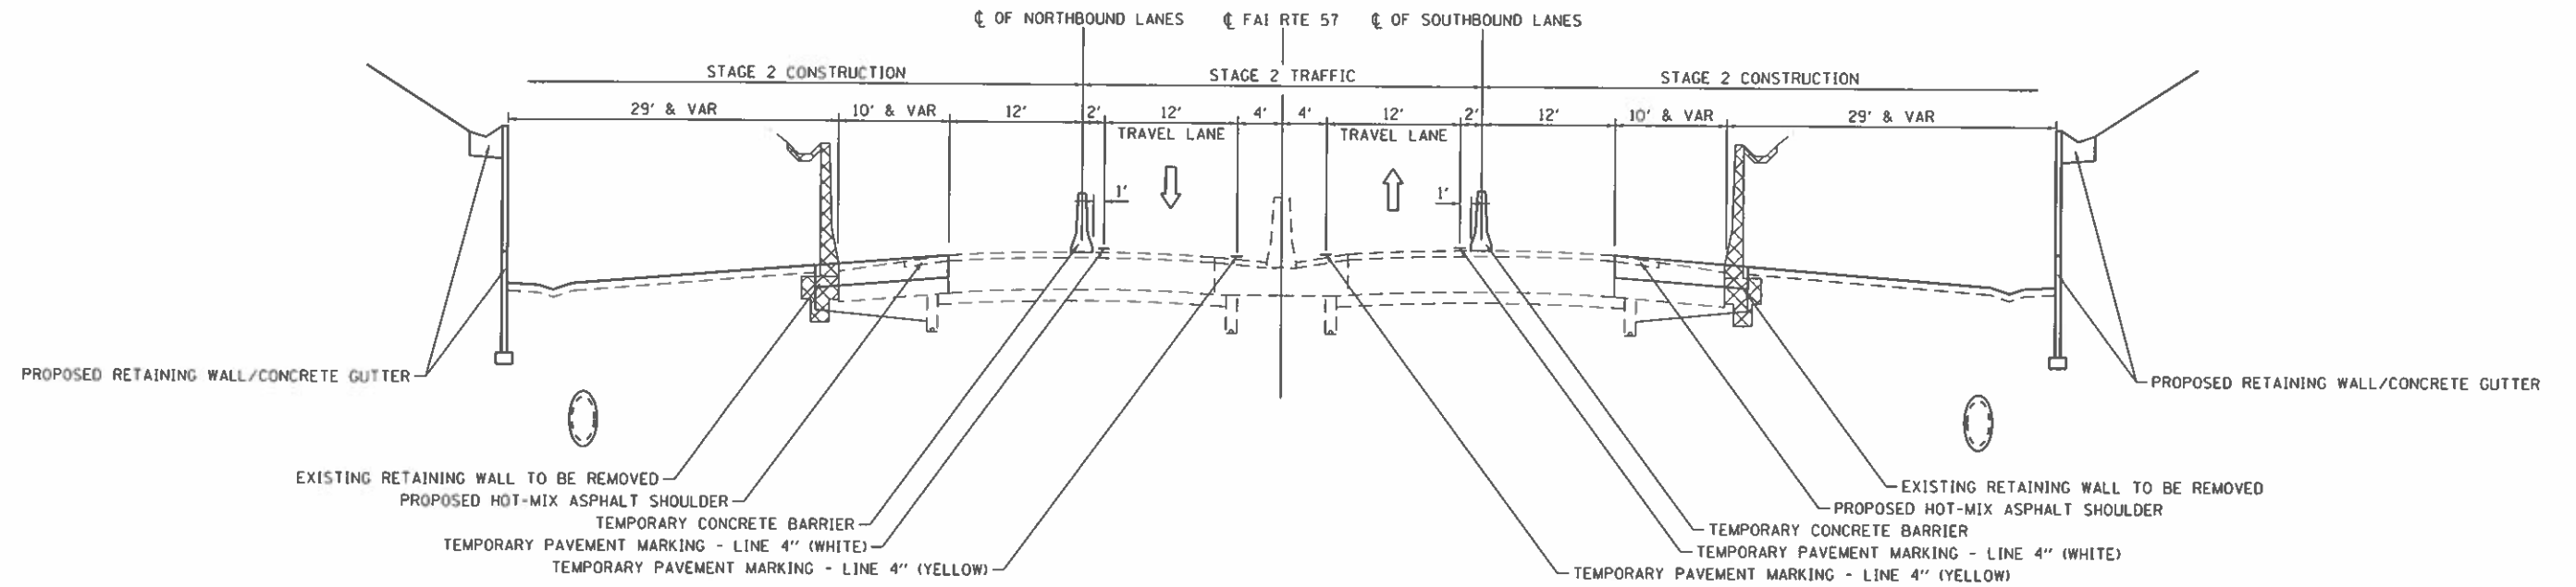


**STAGE 2 TYPICAL SECTION
FAI 57 - OUTSIDE LANE WORKZONE**
STA 227+00.00 TO 233+75.00

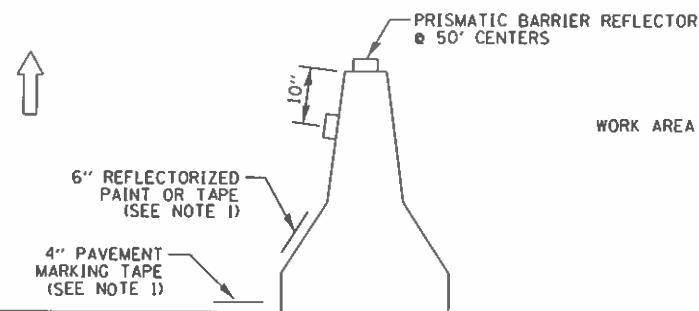

- NOTES:
1. THE CONTRACTOR HAS THE OPTION OF USING EITHER THE LINE ON THE TEMPORARY CONCRETE BARRIER OR ON THE PAVEMENT.
 2. THE COST OF THE REFLECTORS IS INCLUDED IN THE COST OF THE TEMPORARY CONCRETE BARRIER.

TEMPORARY CONCRETE BARRIER WALL DETAILS

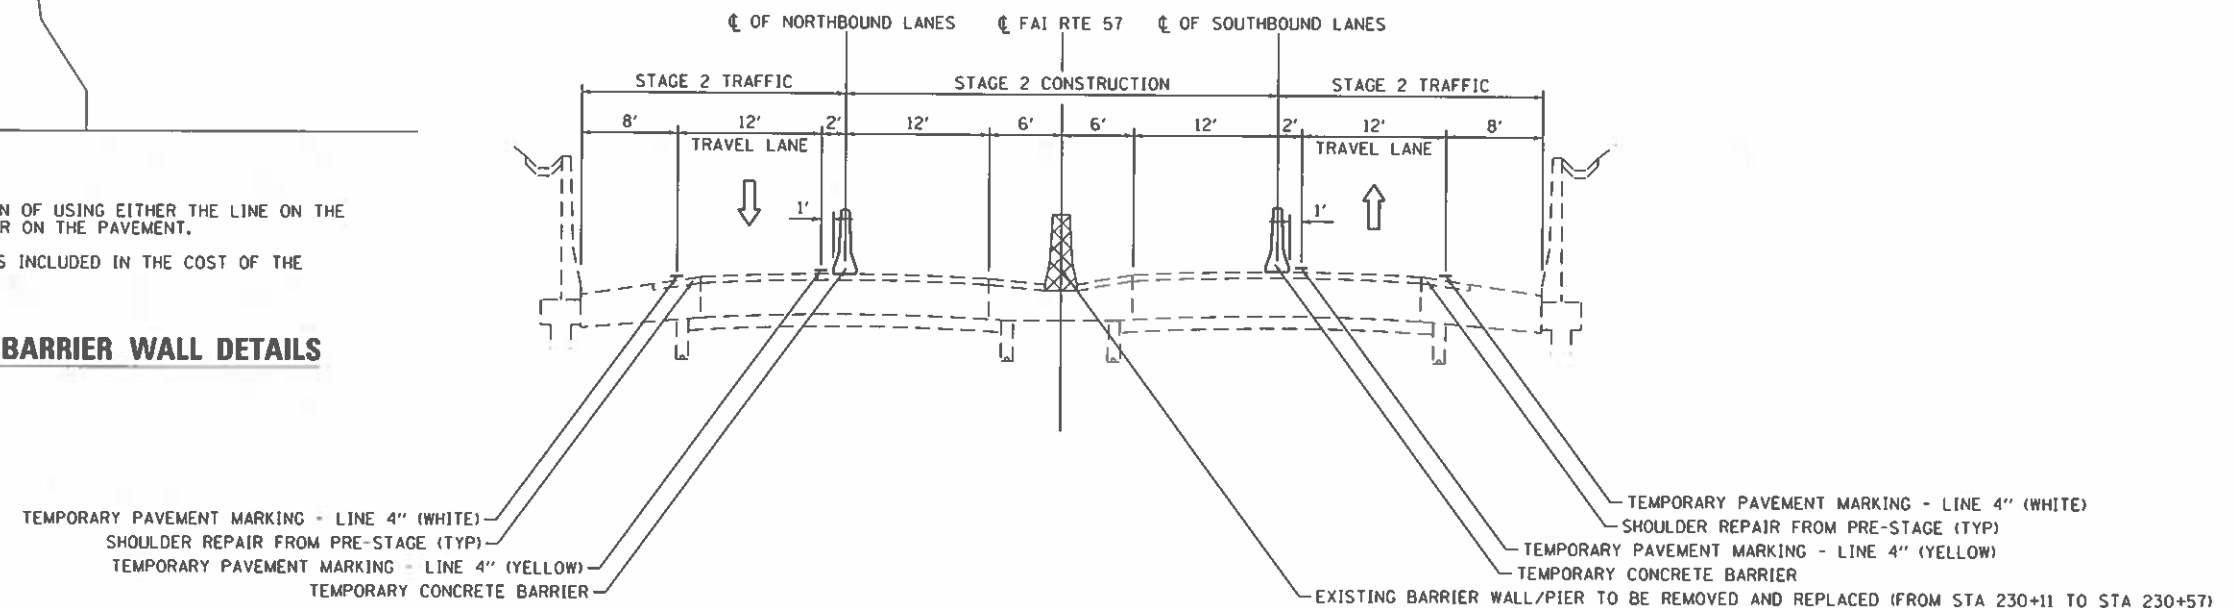

**STAGE 2 TYPICAL SECTION
FAI 57 - INSIDE LANE WORKZONE**
STA 227+00.00 TO 233+75.00

MODEL: Plan 1
FILE NAME: C:\Users\jshelton\Documents\Staging\2 Typical Sections-2.dgn

Hutchinson Engineering, Inc.
Jacksonville Moine Peoria Shorewood
Since 1945

USER NAME = jshelton	DESIGNED =	REVISED =
PLOT SCALE = 0.1867"/in.	DRAWN =	REVISED =
PLOT DATE = 3/29/2021	CHECKED =	REVISED =
	DATE = 2021/03/26	REVISED =

**STATE OF ILLINOIS
DEPARTMENT OF TRANSPORTATION**



**FAI 57 & WALDRON ROAD
STAGE 2 TYPICAL SECTIONS**

SCALE: N.T.S. SHEET 2 OF 2 SHEETS STA. TO STA.

F.A.I. RTE.	SECTION	COUNTY	TOTAL SHEETS	SHEET NO.
57	139 HBR-6	KANKAKEE	202	52
CONTRACT NO. 66997				
ILLINOIS FED. AID PROJECT				




W20-I103(O)-4848
(PLACE ON I17/SOUTHBOUND
I-57 ENTRANCE RAMP)

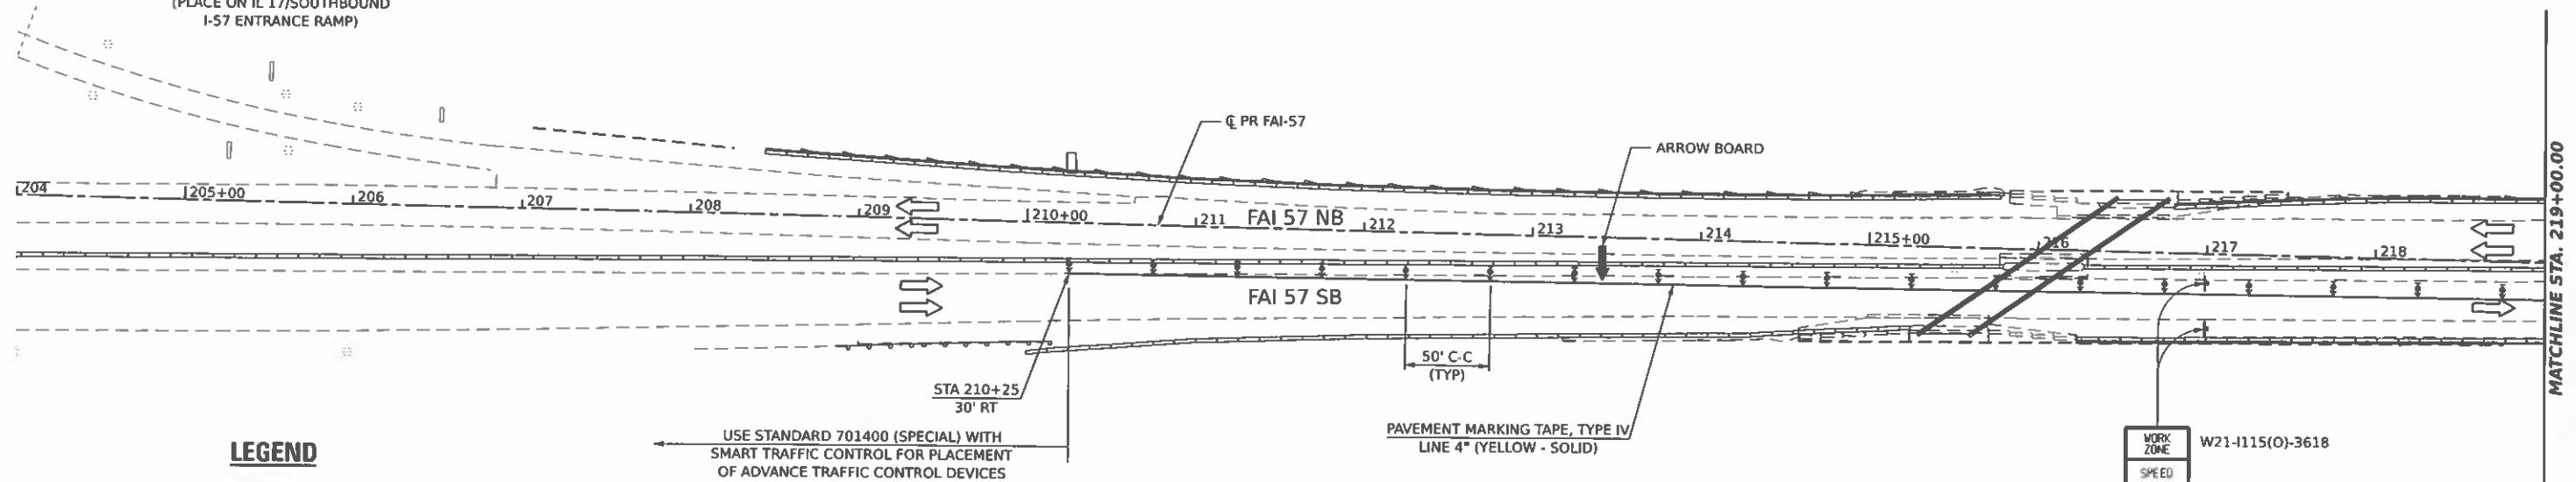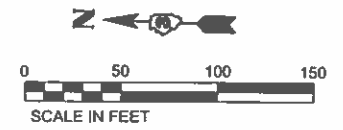

LEGEND

- DIRECTION INDICATOR BARRICADE WITH STEADY BURN MONDIRECTIONAL LIGHT
- DRUM (WITH STEADY BURN BI-DIRECTIONAL LIGHT ON TAPERS ONLY)
- TYPE III BARRICADE WITH FLASHING LIGHT (2-EA.)
- DOUBLE VERTICAL PANEL
- WORK AREA
- ARROW BOARD
- CONSTRUCTION SIGN
- DIRECTION OF TRAFFIC
- TEMPORARY CONCRETE BARRIER
- IMPACT ATTENUATOR, TEMPORARY (NON-REDIRECTIVE) TEST LEVEL 3
- FLASHING MONO-DIRECTIONAL LIGHT

NOTE: ALL CONSTRUCTION SIGNS DESIGNATED WITH (O) SHALL BE FLUORESCENT ORANGE.

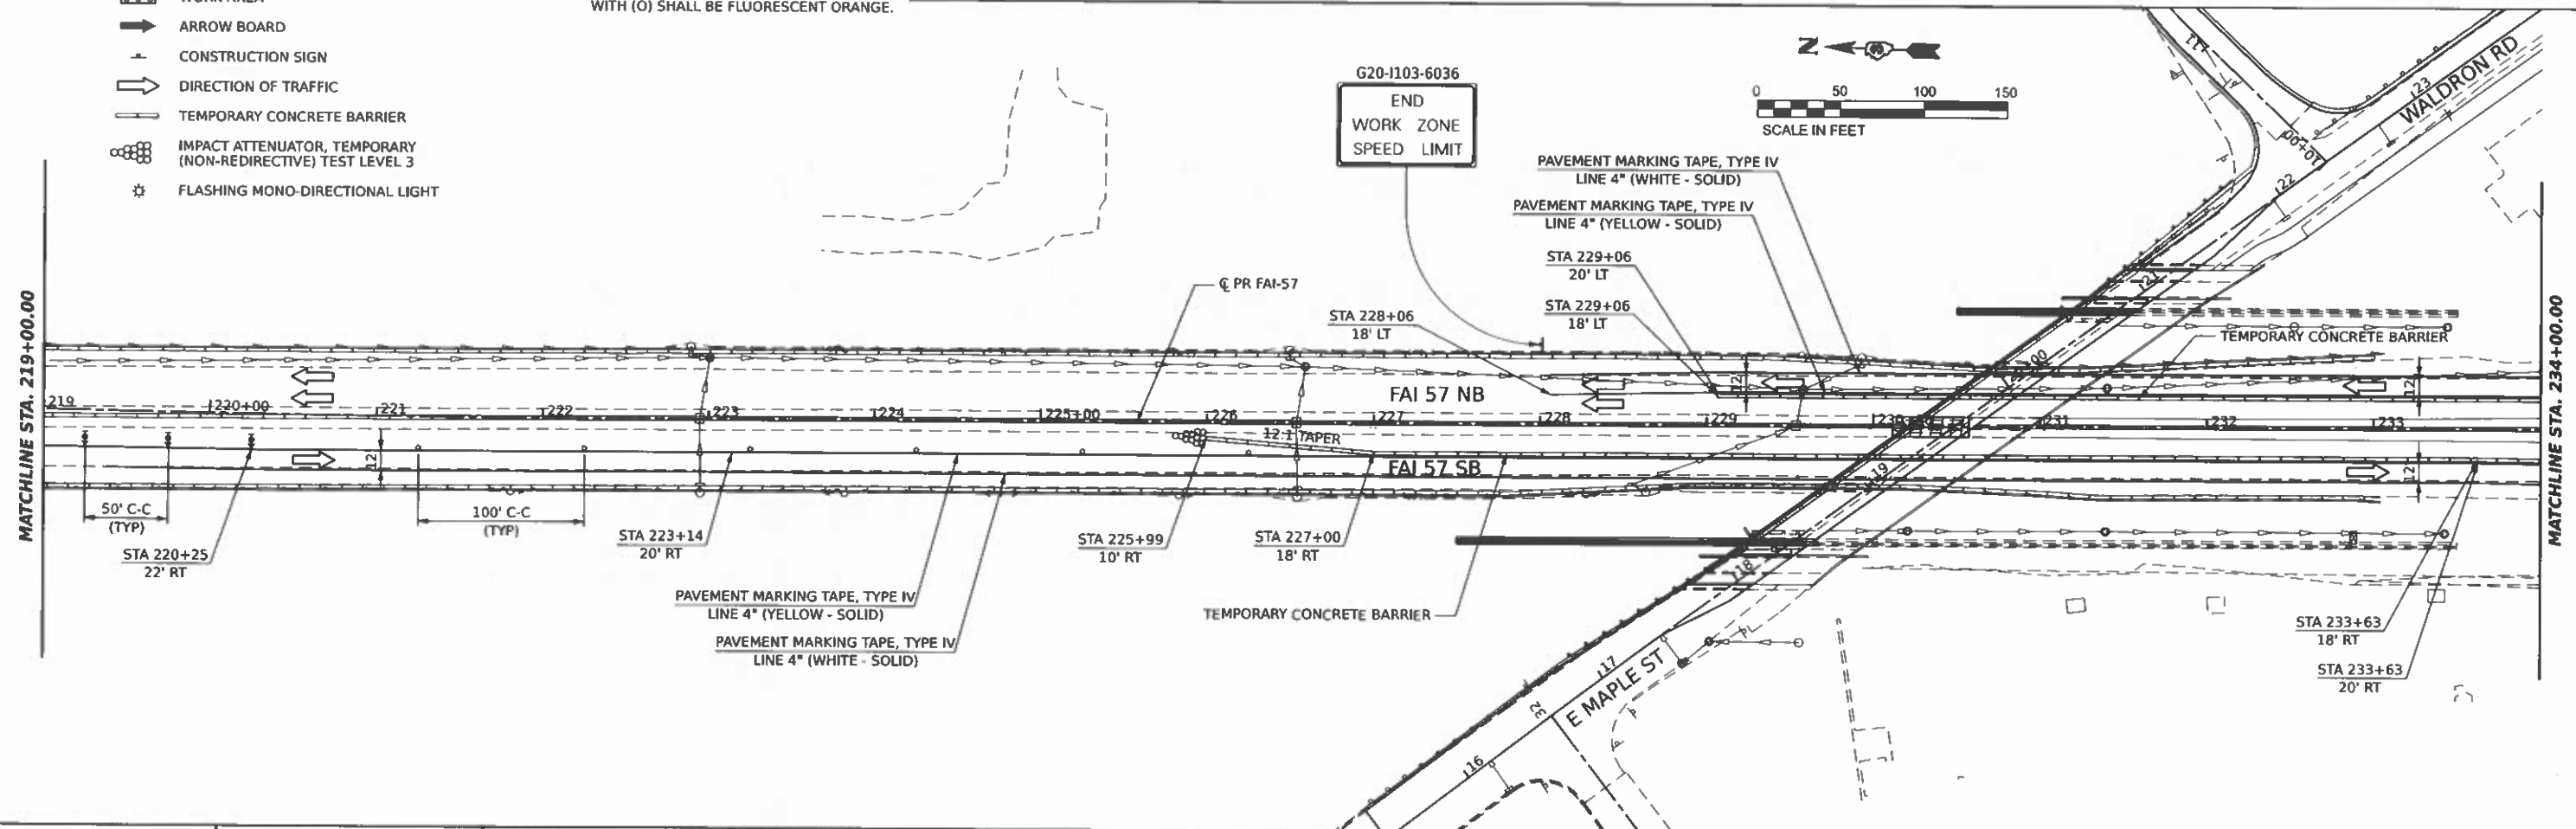

MODEL: Plan 1
FILE NAME: C:\Users\jason\OneDrive\Documents\Stage 2-1.dwg

Hutchinson Engineering, Inc.
Jacksonville Moline Peoria Shorewood
Since 1945

USER NAME = nrsalman
PLOT SCALE = 0.106086" = 1' IN.
PLOT DATE = 3/29/2021

DESIGNED -
DRAWN -
CHECKED -
DATE -



REVISED -
REVISED -
REVISED -
REVISED -

STATE OF ILLINOIS
DEPARTMENT OF TRANSPORTATION

FAI 57 & WALDRON ROAD
STAGE 2 FAI 57 INSIDE LANE CONSTRUCTION AND TRAFFIC CONTROL

SCALE: 1"=50' SHEET 1 OF 7 SHEETS STA. 204+00 TO STA. 234+00

FAI RTE.	SECTION	COUNTY	TOTAL SHEETS	SHEET NO.
57	139 HBR-6	KANKAKEE	202	53
CONTRACT NO. 66997				
ILLINOIS FED. AID PROJECT				

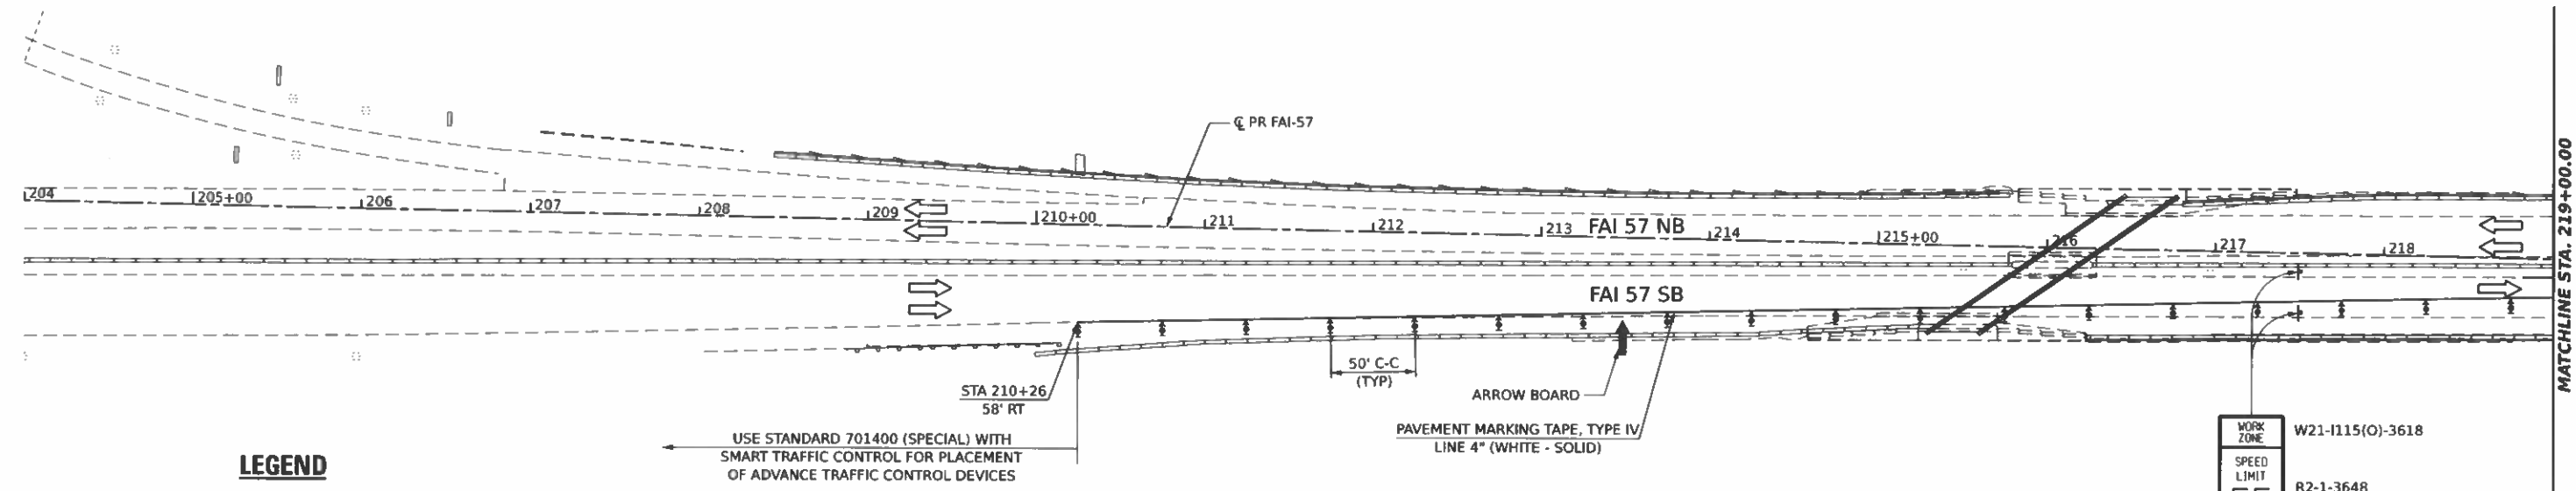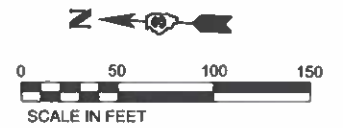


LEGEND

- DIRECTION INDICATOR BARRICADE WITH STEADY BURN MONODIRECTIONAL LIGHT
- DRUM (WITH STEADY BURN BI-DIRECTIONAL LIGHT ON TAPERS ONLY)
- TYPE III BARRICADE WITH FLASHING LIGHT (2-BA.)
- DOUBLE VERTICAL PANEL
- WORK AREA
- ARROW BOARD
- CONSTRUCTION SIGN
- DIRECTION OF TRAFFIC
- TEMPORARY CONCRETE BARRIER
- IMPACT ATTENUATOR, TEMPORARY (NON-REDIRECTIVE) TEST LEVEL 3
- FLASHING MONO-DIRECTIONAL LIGHT

NOTE: ALL CONSTRUCTION SIGNS DESIGNATED WITH (O) SHALL BE FLUORESCENT ORANGE.

WORK ZONE	W21-1115(O)-3618
SPEED LIMIT	R2-1-3648
55	
PHOTO ENFORCED	R10-19aP-3618
XXX FINE MINIMUM	R2-1106-3618

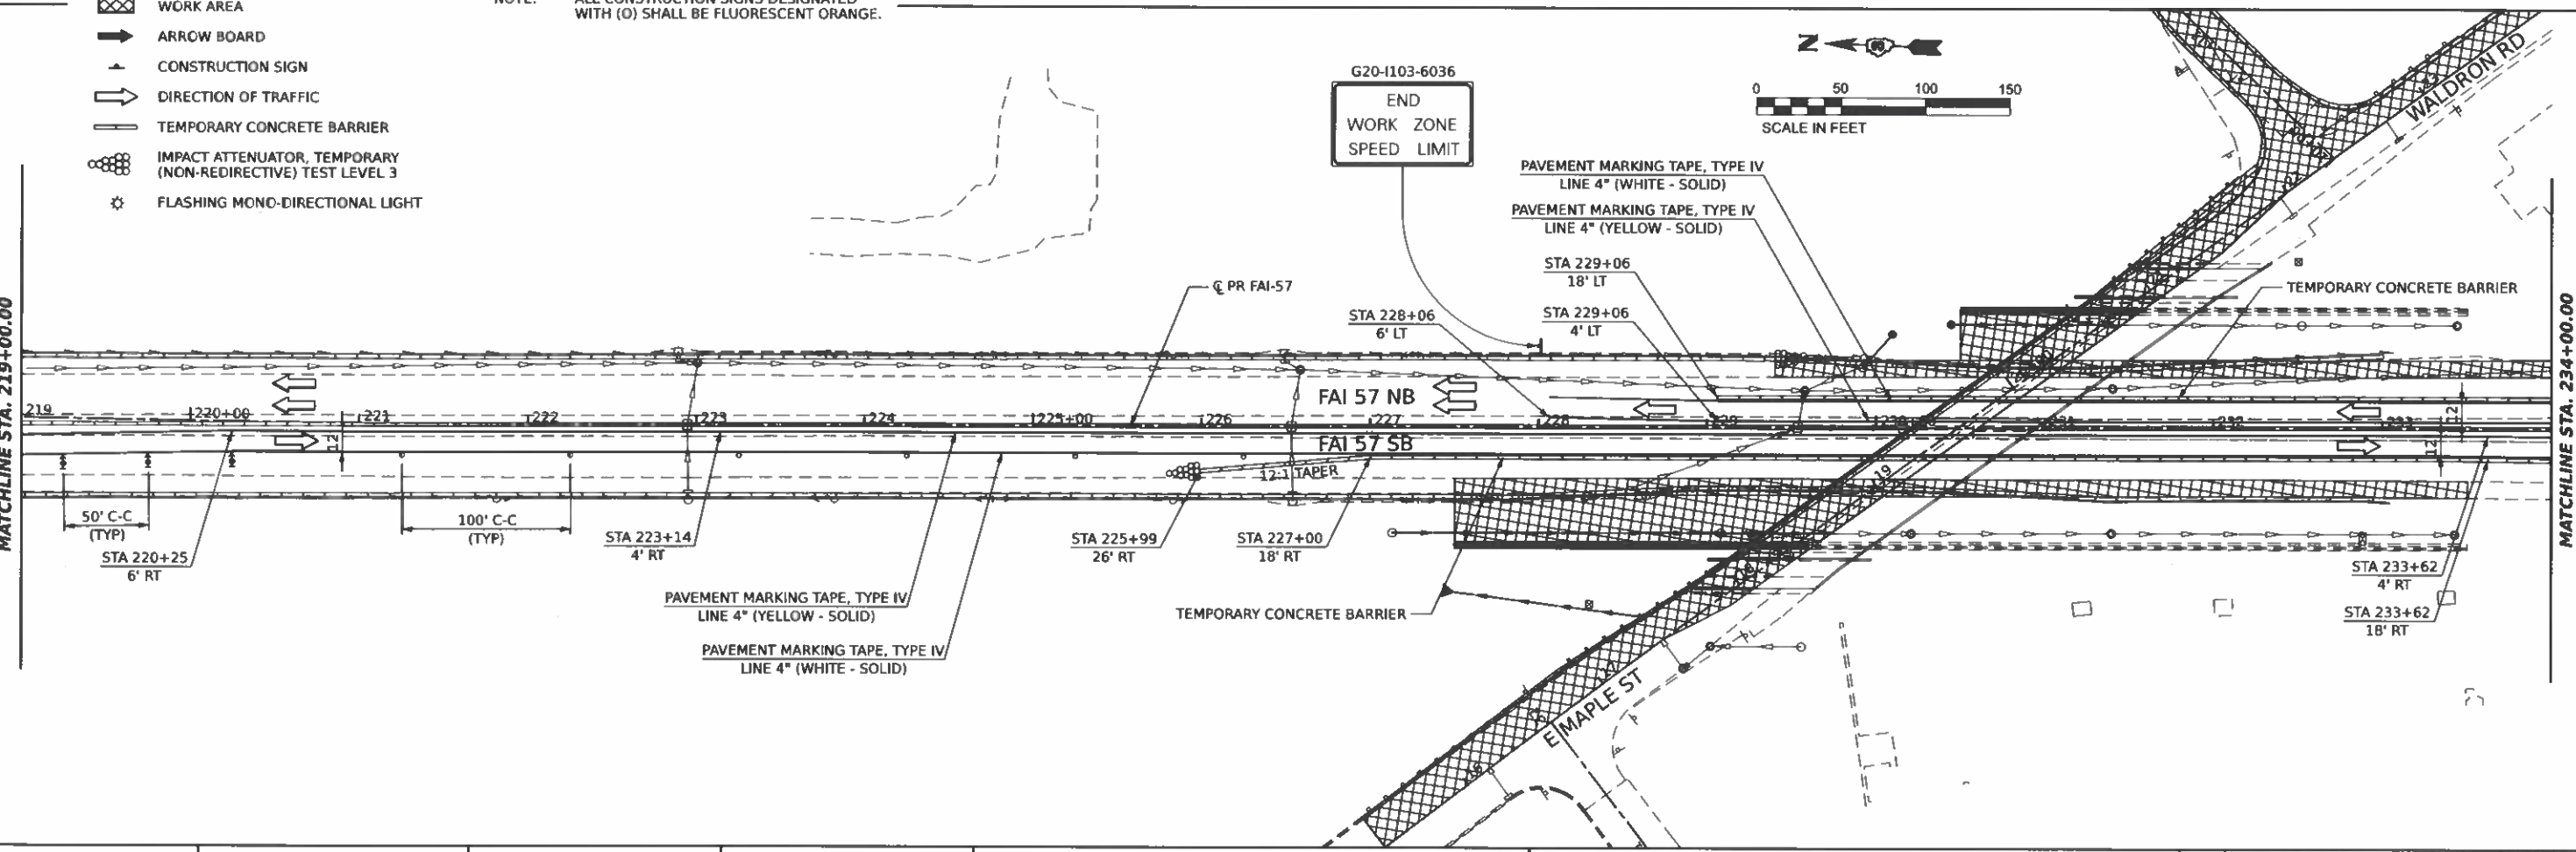

MODEL: Plan 1
FILE NAME: C:\Users\jshah\OneDrive\Documents\FAI 57 & WALDRON RD.dwg

Hutchinson Engineering, Inc.
Jacksonville Moline Peoria Shorewood
Since 1945


USER NAME = rnsalehian	DESIGNED -	REVISED -
PLOT SCALE = 0.100000" = 1'	DRAWN -	REVISED -
PLOT DATE = 3/29/2021	CHECKED -	REVISED -
	DATE -	REVISED -

**STATE OF ILLINOIS
DEPARTMENT OF TRANSPORTATION**

**FAI 57 & WALDRON ROAD
STAGE 2 FAI 57 OUTSIDE LANE CONSTRUCTION AND TRAFFIC CONTROL**
SCALE: 1"=50' SHEET 3 OF 7 SHEETS STA. 204+00 TO STA. 234+00

F.A.I. RTE.	SECTION	COUNTY	TOTAL SHEETS	SHEET NO.
57	139 HBR-6	KANKAKEE	202	55
CONTRACT NO. 66997				

ILLINOIS FED. AID PROJECT

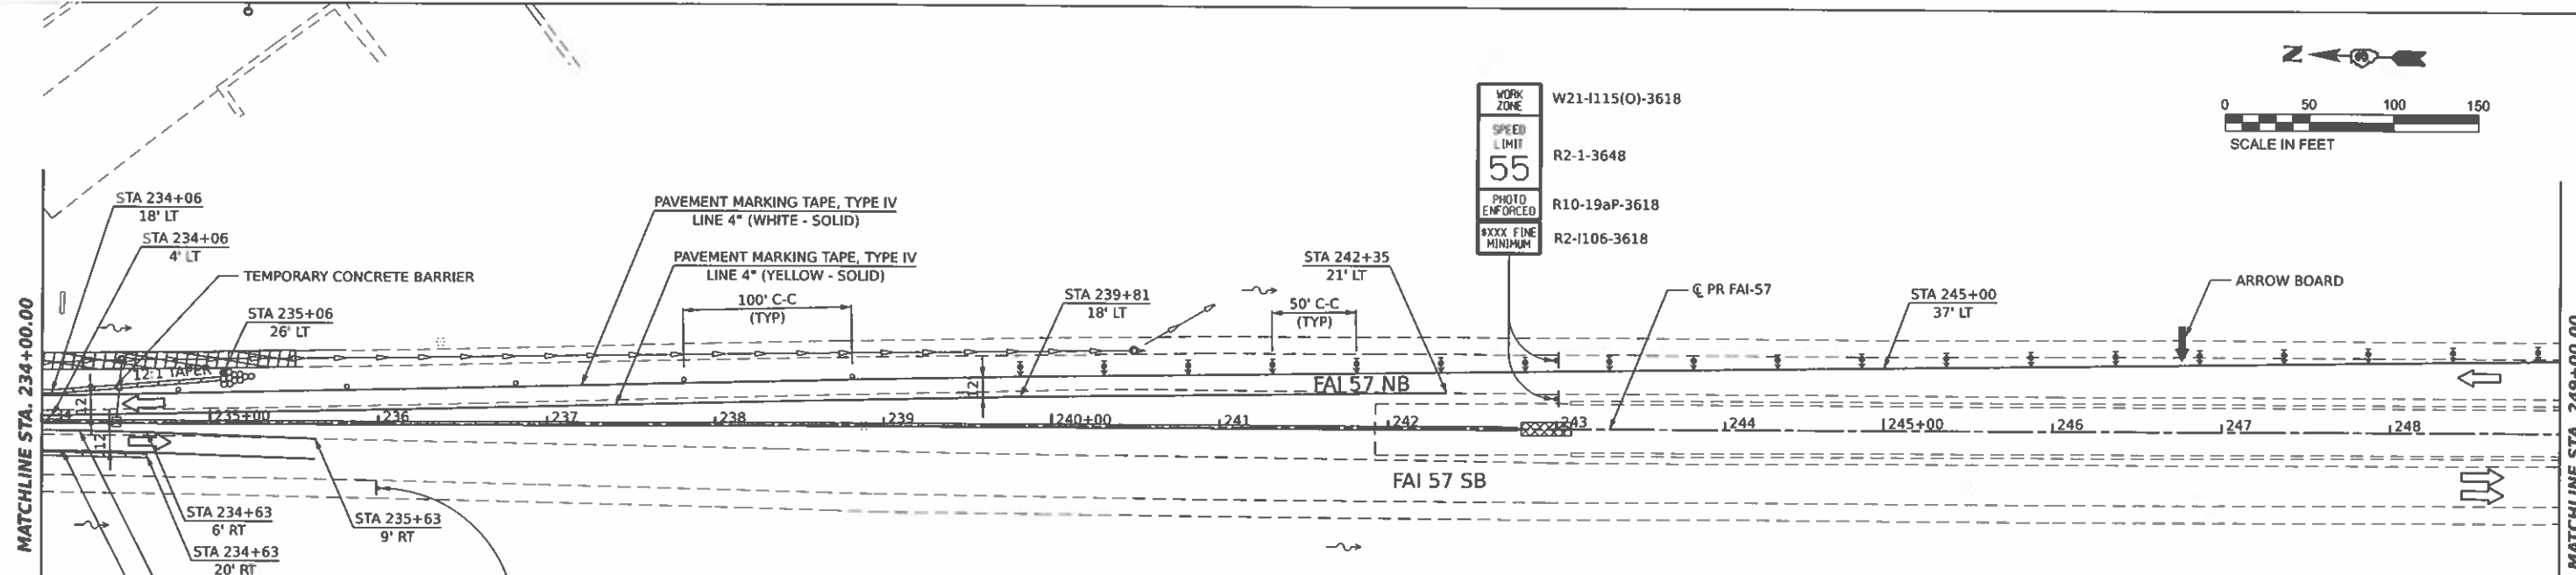


END
WORK ZONE
SPEED LIMIT
G20-I103-6036

LEGEND

- DIRECTION INDICATOR BARRICADE WITH STEADY BURN MONDIRECTIONAL LIGHT
- DRUM (WITH STEADY BURN BI-DIRECTIONAL LIGHT ON TAPERS ONLY)
- TYPE III BARRICADE WITH FLASHING LIGHT (2-EA.)
- DOUBLE VERTICAL PANEL
- WORK AREA
- ARROW BOARD
- CONSTRUCTION SIGN
- DIRECTION OF TRAFFIC
- TEMPORARY CONCRETE BARRIER
- IMPACT ATTENUATOR, TEMPORARY (NON-REDIRECTIVE) TEST LEVEL 3
- FLASHING MONO-DIRECTIONAL LIGHT

NOTE: ALL CONSTRUCTION SIGNS DESIGNATED WITH (O) SHALL BE FLUORESCENT ORANGE.

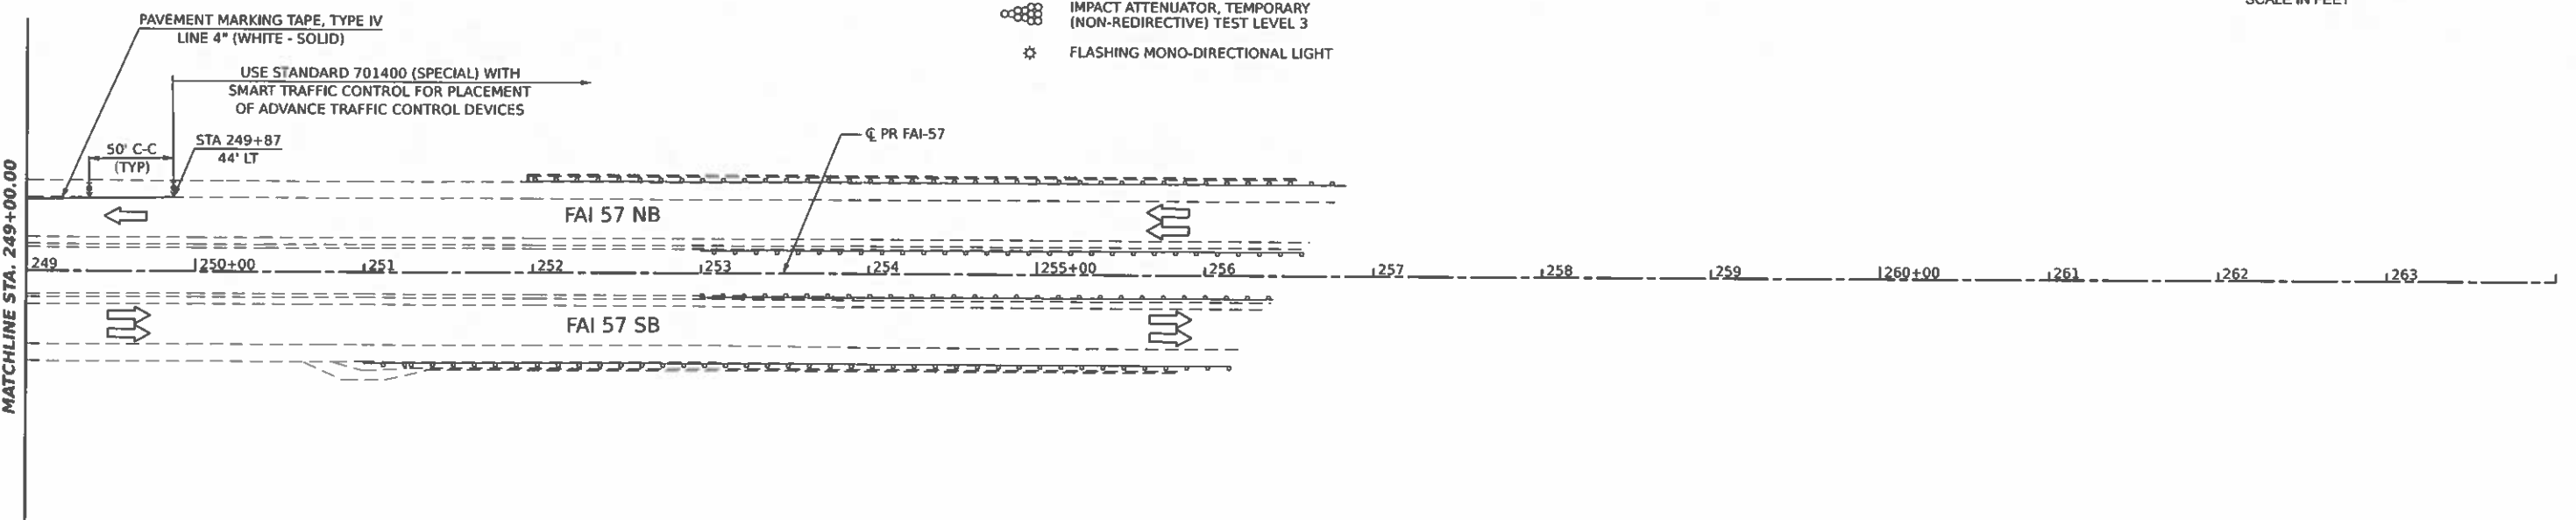

MODEL: Plan 3
FILE NAME: D:\95983-Sht-Stage 2.dgn



Hutchinson Engineering, Inc.
Jacksonville Moline Peoria Shorewood
Since 1945



USER NAME = msharlan	DESIGNED -	REVISED -
PLOT SCALE = 0.18658833" / ft.	DRAWN -	REVISED -
PLOT DATE = 3/29/2021	CHECKED -	REVISED -
	DATE -	REVISED -

**STATE OF ILLINOIS
DEPARTMENT OF TRANSPORTATION**


**FAI 57 & WALDRON ROAD
STAGE 2 FAI 57 OUTSIDE LANE CONSTRUCTION AND TRAFFIC CONTROL**
SCALE: 1"=50' SHEET 4 OF 7 SHEETS STA. 234+00 TO STA. 264+00

F.A.I. RTE.	SECTION	COUNTY	TOTAL SHEETS	SHEET NO.
57	139 HBR-6	KANKAKEE	202	56
CONTRACT NO. 66997				
ILLINOIS FED. AID PROJECT				

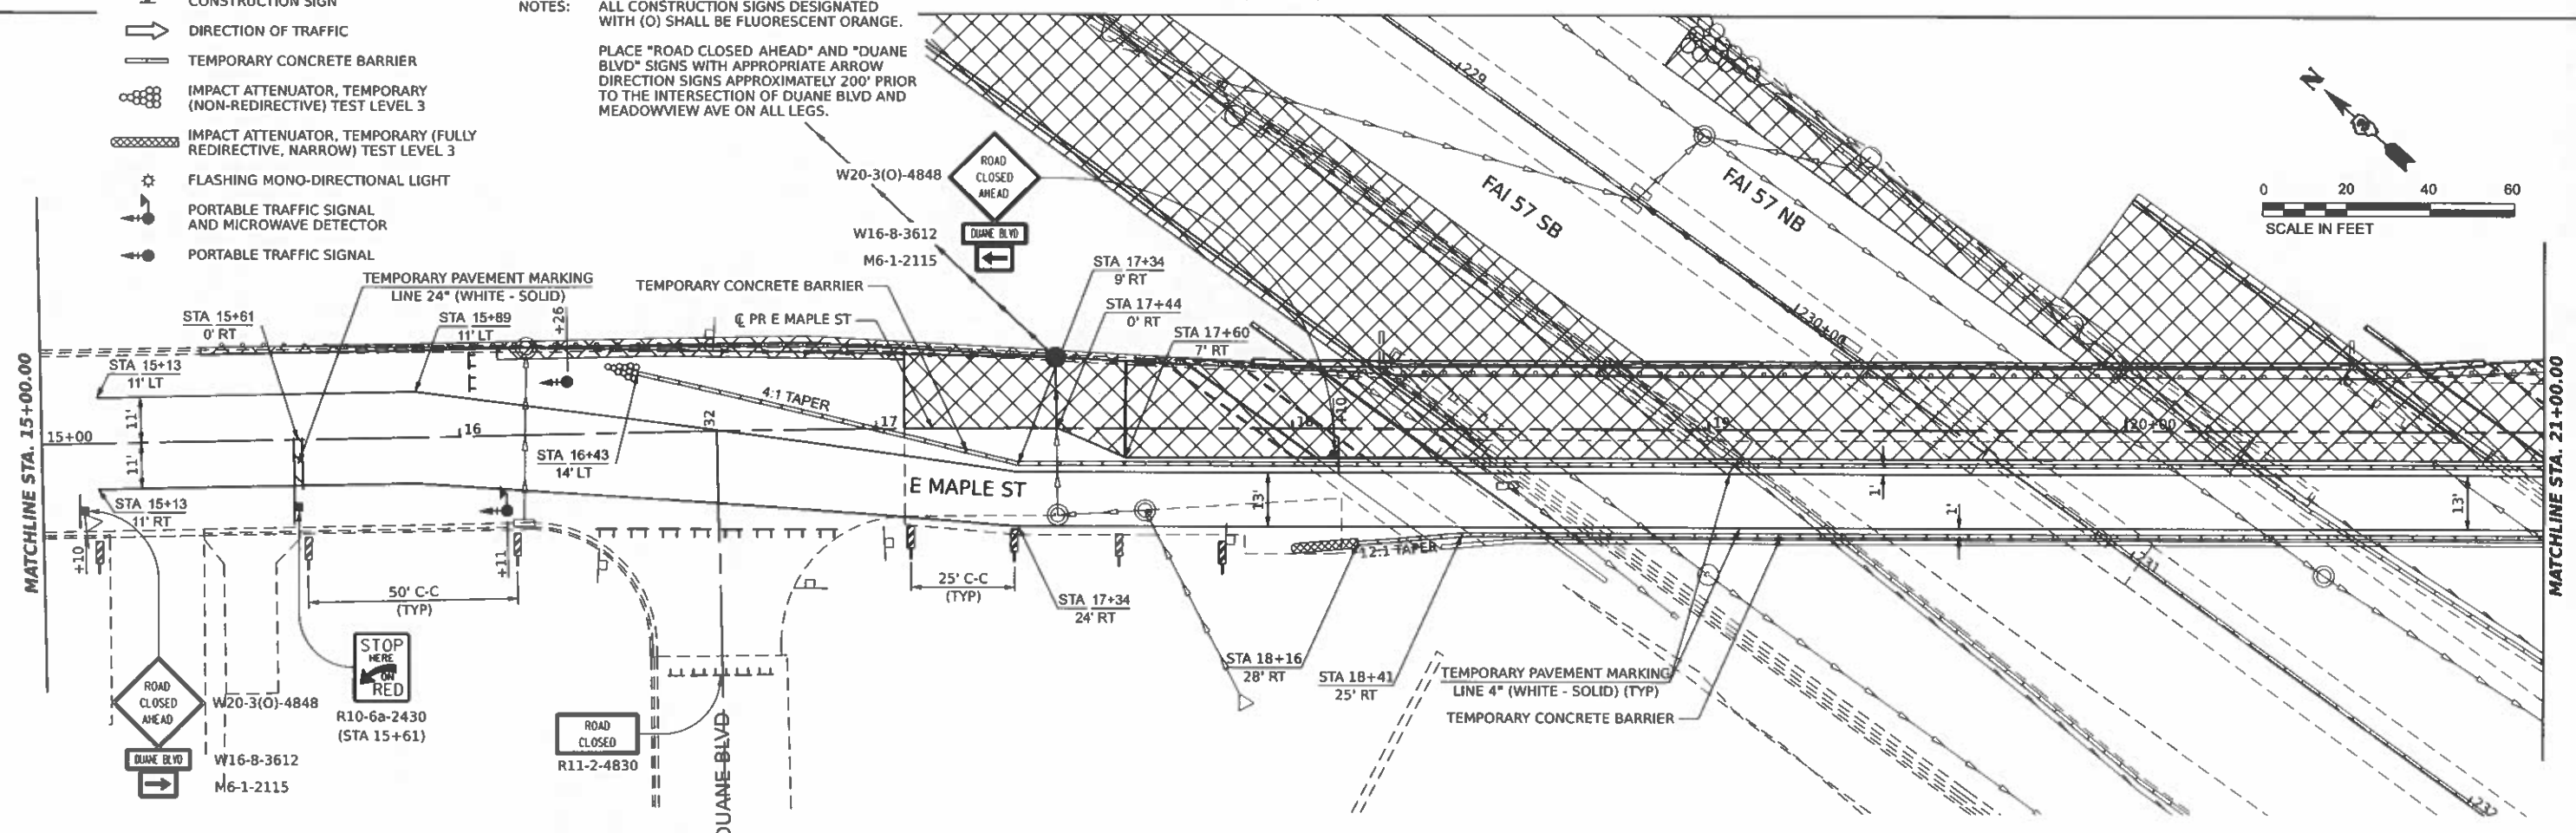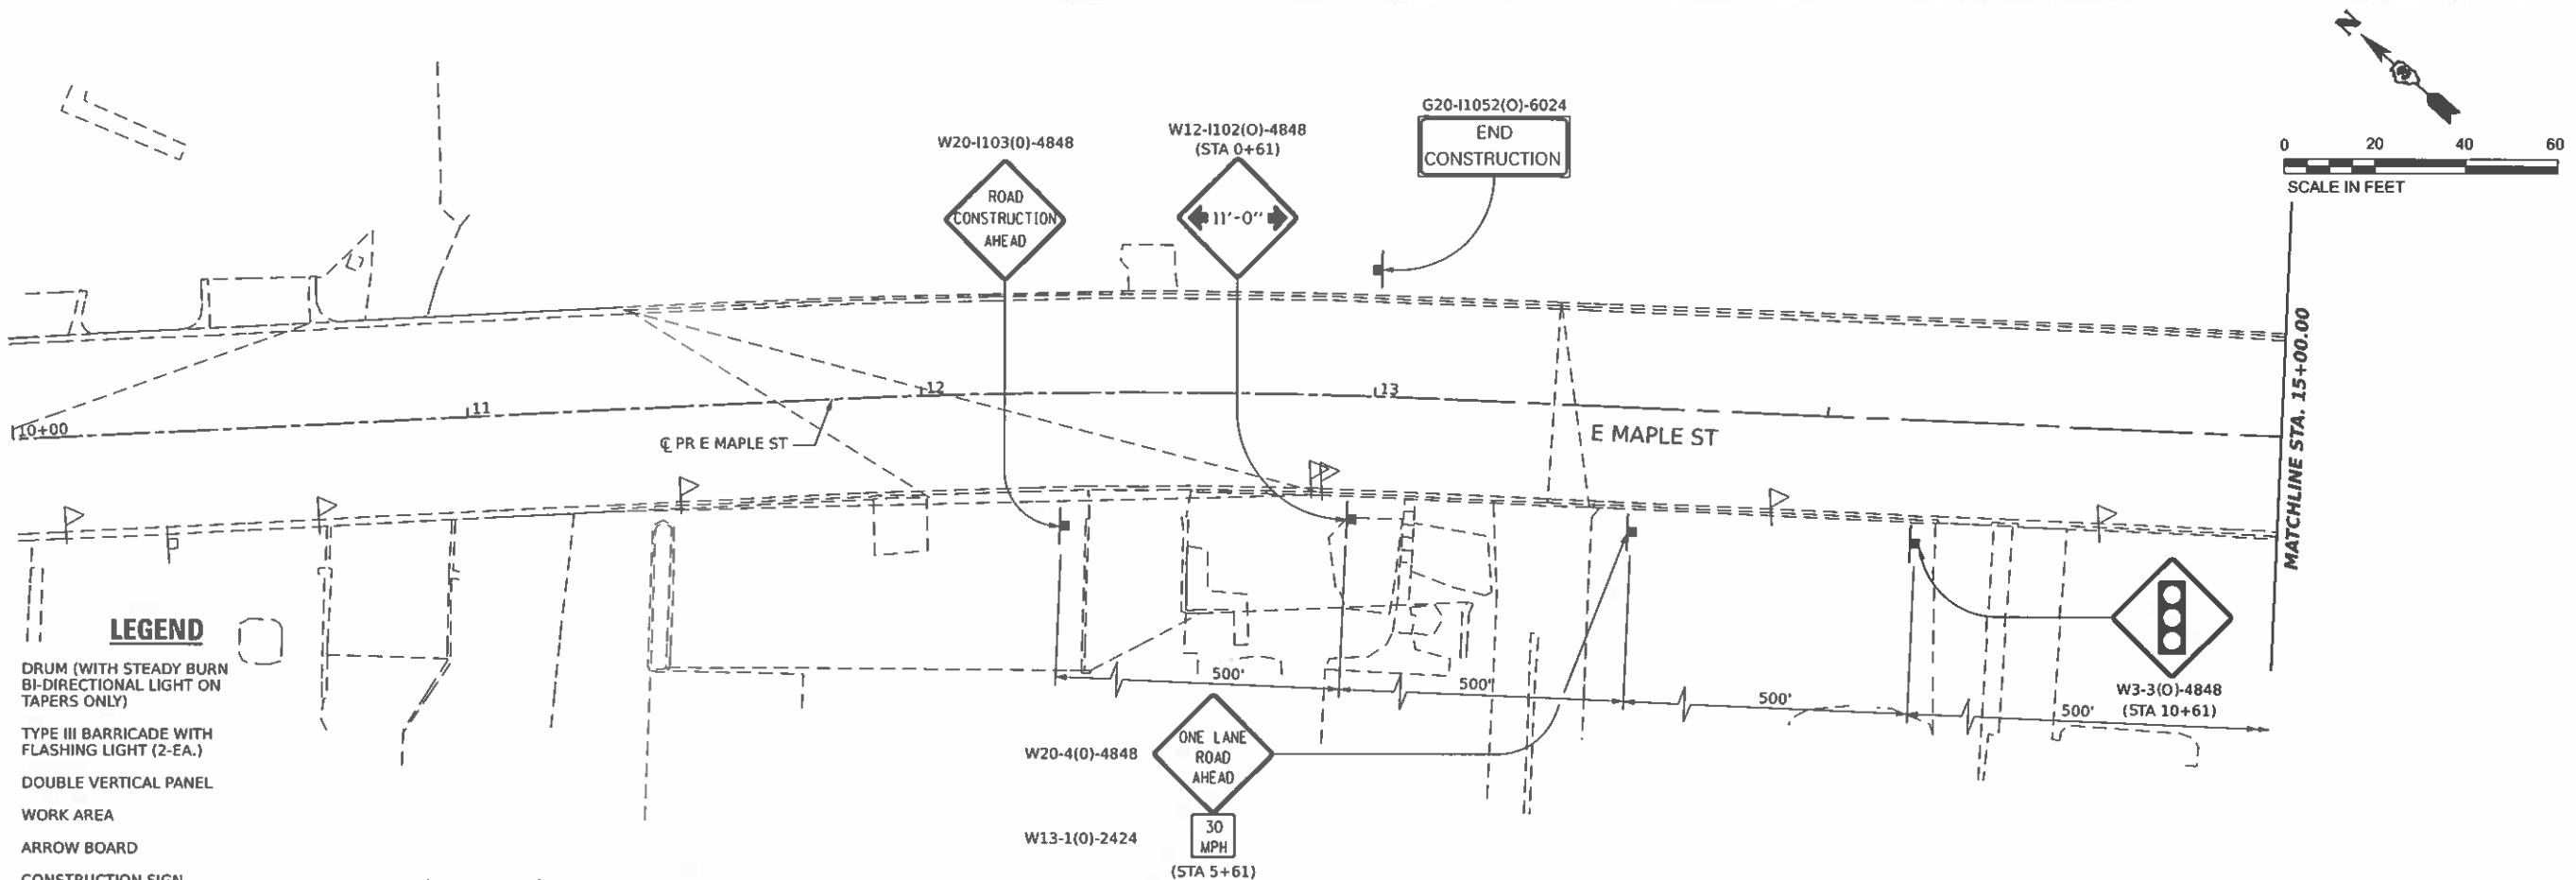

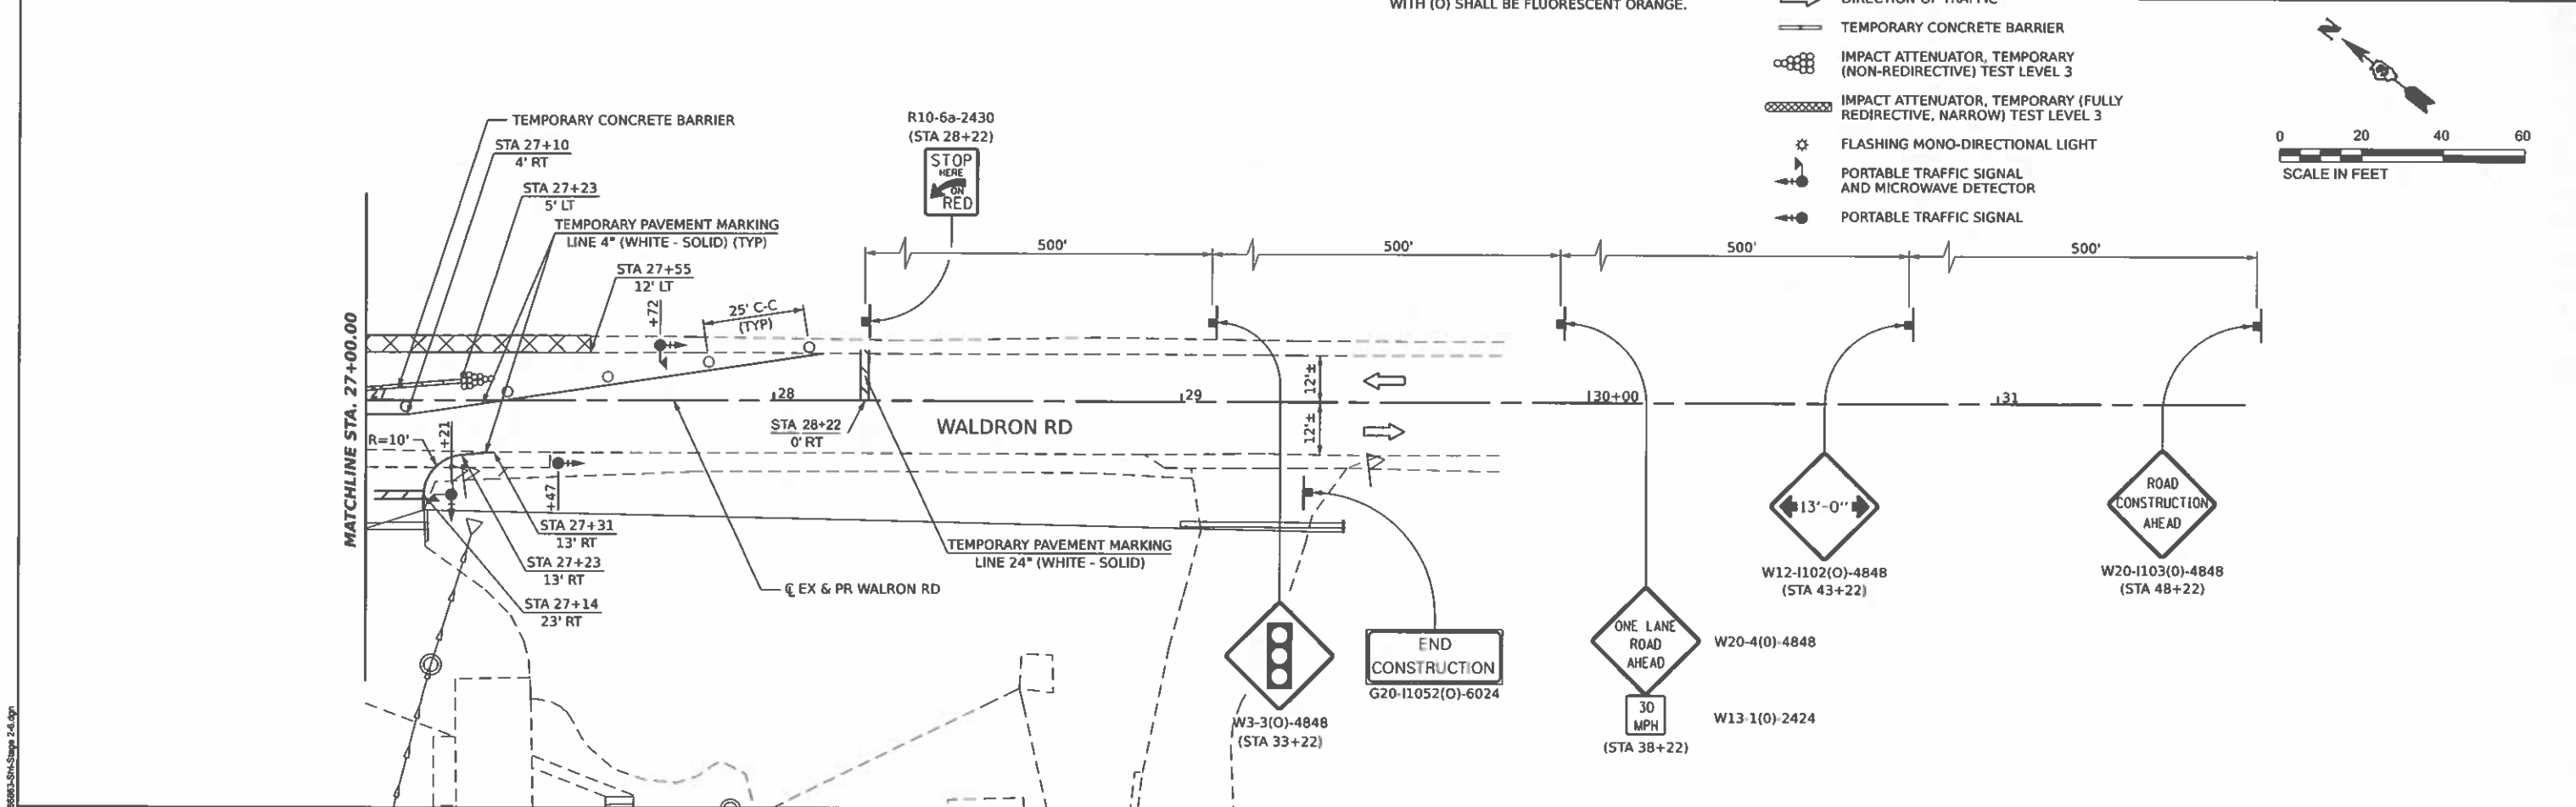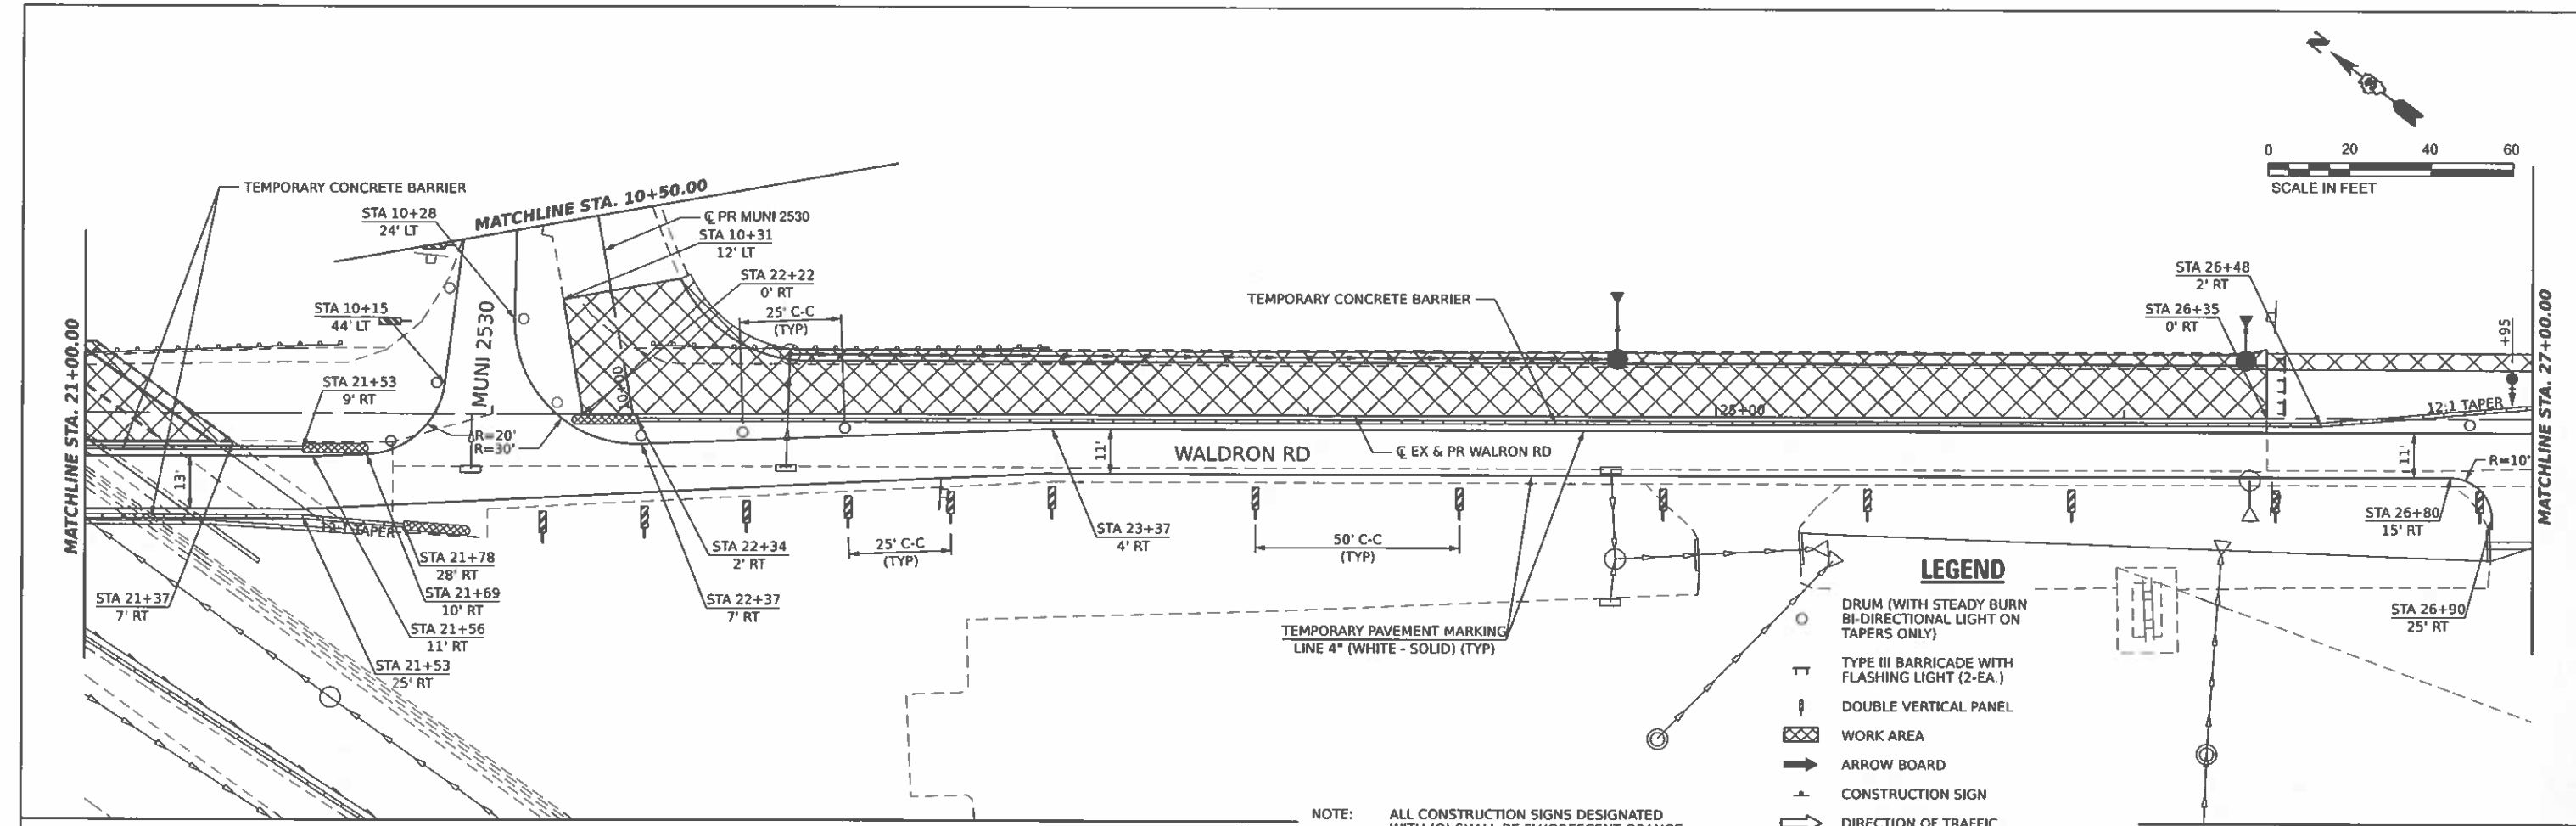


MODEL: Plan 7 FILE NAME: D:\06083-SHA-Stage 2.dgn Hutchinson Engineering, Inc. Jacksonville Moline Peoria Shorewood Since 1945	USER NAME = nealshen	DESIGNED -	REVISED -	STATE OF ILLINOIS DEPARTMENT OF TRANSPORTATION	FAI 57 & WALDRON ROAD STAGE 2 CONSTRUCTION AND TRAFFIC CONTROL	F.A.I. RTE.	SECTION	COUNTY	TOTAL SHEETS	SHEET NO.
	PLOT SCALE = 0.16666633" / ft.	DRAWN -	REVISED -		SCALE: 1"=20'	57	139 HBR-6	KANKAKEE	202	58
	PLOT DATE = 3/29/2021	CHECKED -	REVISED -		SHEET 6 OF 7 SHEETS STA. 21+00 TO STA. 31+50	CONTRACT NO. 66997				
		DATE -	REVISED -					ILLINOIS FED. AID PROJECT		

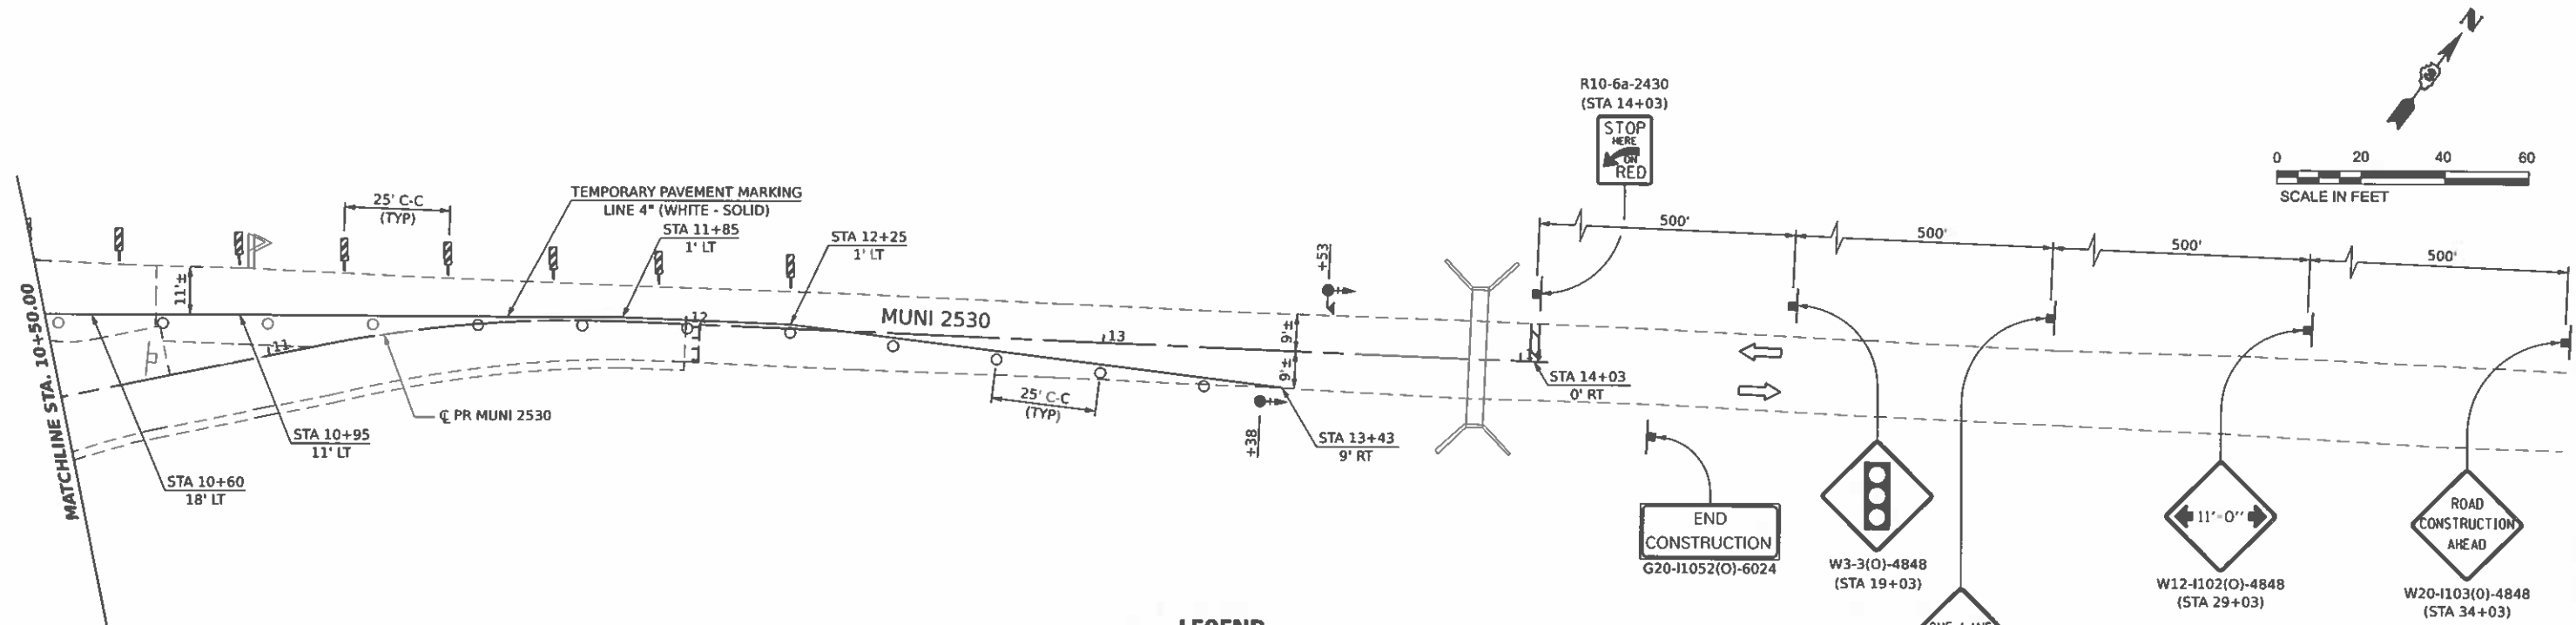

LEGEND

- DRUM (WITH STEADY BURN BI-DIRECTIONAL LIGHT ON TAPERS ONLY)
- TT TYPE III BARRICADE WITH FLASHING LIGHT (2-EA.)
- DOUBLE VERTICAL PANEL
- WORK AREA
- ARROW BOARD
- CONSTRUCTION SIGN
- DIRECTION OF TRAFFIC
- TEMPORARY CONCRETE BARRIER
- IMPACT ATTENUATOR, TEMPORARY (NON-REDIRECTIVE) TEST LEVEL 3
- FLASHING MONO-DIRECTIONAL LIGHT
- PORTABLE TRAFFIC SIGNAL AND MICROWAVE DETECTOR
- PORTABLE TRAFFIC SIGNAL

NOTE: ALL CONSTRUCTION SIGNS DESIGNATED WITH (O) SHALL BE FLUORESCENT ORANGE.

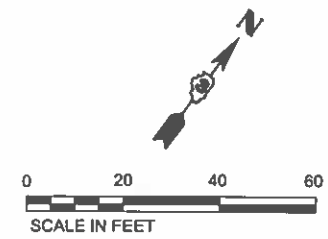

MODEL: Plan 9
FILE NAME: D066063-SHA-Sign 2-7.dgn

Hutchinson Engineering, Inc.
Jacksonville Maize Peoria Shorewood
Since 1945



USER NAME = realshian	DESIGNED -	REVISED -
PLOT SCALE = 0.188888833" = 1'	DRAWN -	REVISED -
PLOT DATE = 3/29/2021	CHECKED -	REVISED -
	DATE -	REVISED -

**STATE OF ILLINOIS
DEPARTMENT OF TRANSPORTATION**

**FAI 57 & WALDRON ROAD
STAGE 2 CONSTRUCTION AND TRAFFIC CONTROL**

SCALE: 1"=20' SHEET 7 OF 7 SHEETS STA. 10+50 TO STA. 14+06.67

F.A.I. RTE.	SECTION	COUNTY	TOTAL SHEETS	SHEET NO.
57	139 HBR-6	KANKAKEE	202	59
CONTRACT NO. 66997				
ILLINOIS FED. AID PROJECT				

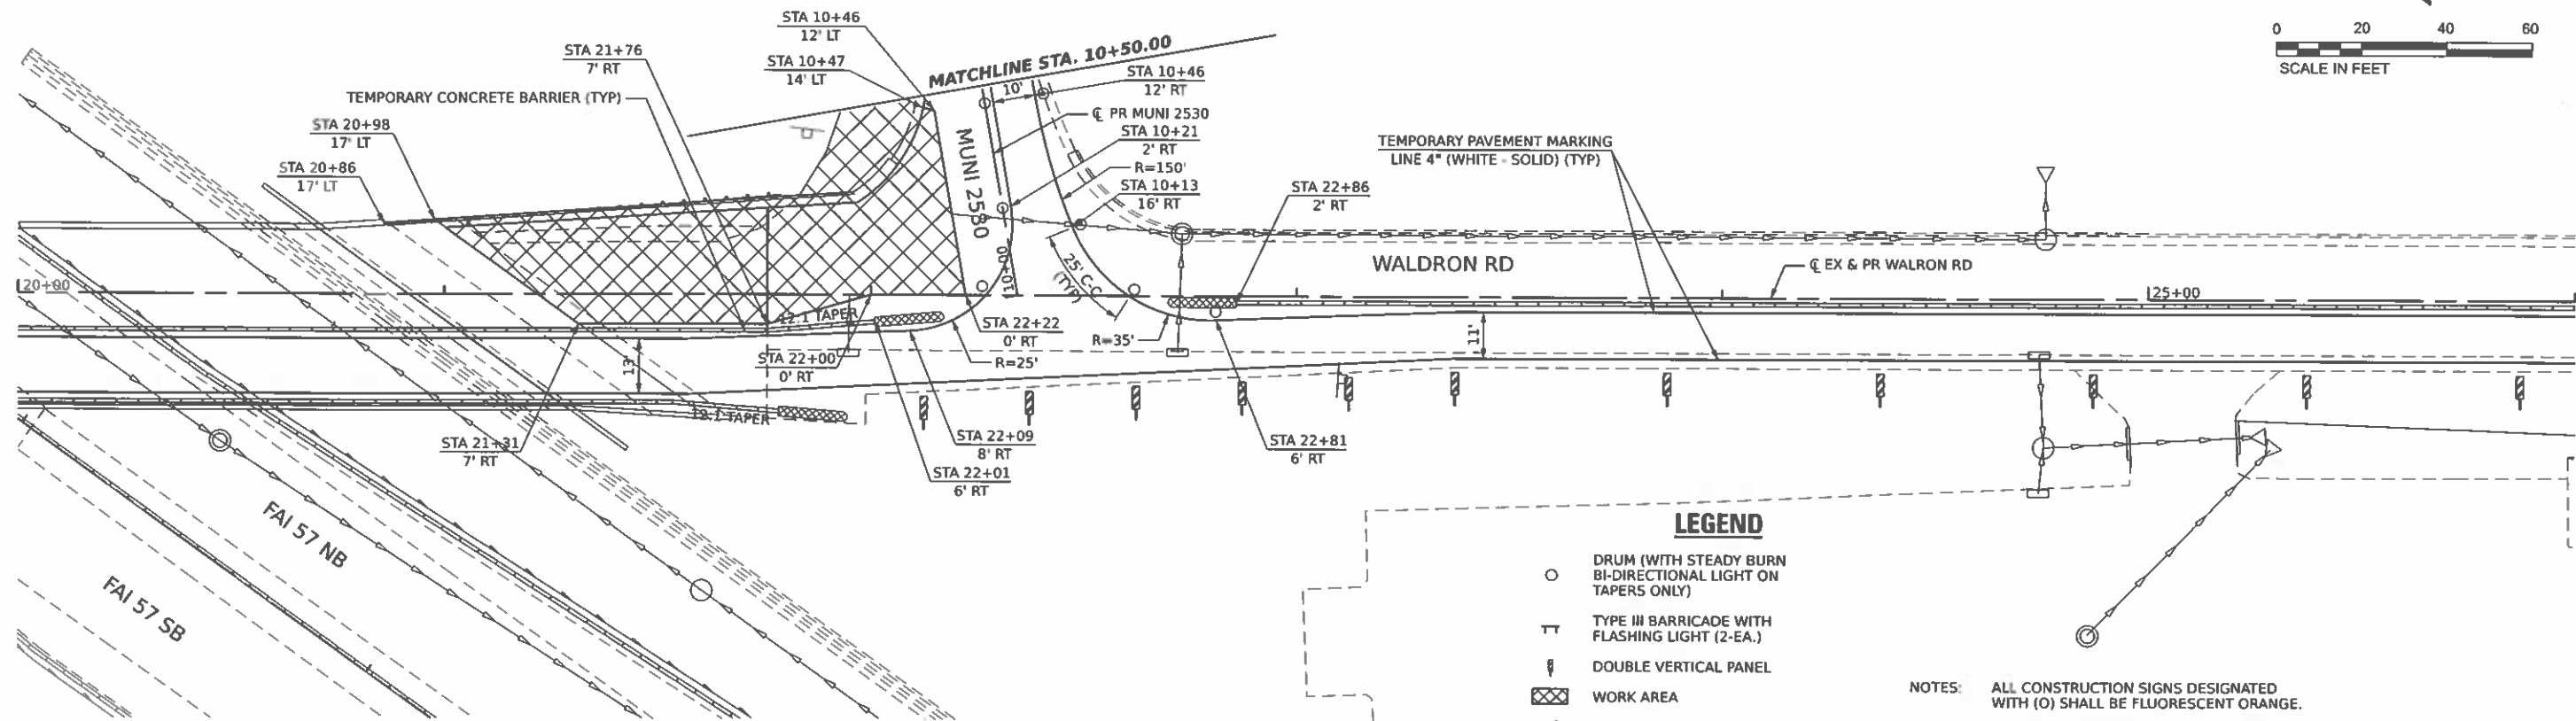
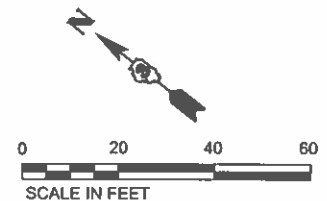


LEGEND

- DRUM (WITH STEADY BURN BI-DIRECTIONAL LIGHT ON TAPERS ONLY)
- ⌋ TYPE III BARRICADE WITH FLASHING LIGHT (2-EA.)
- ⌋ DOUBLE VERTICAL PANEL
- ⊠ WORK AREA
- ➔ ARROW BOARD
- ⌋ CONSTRUCTION SIGN
- ➔ DIRECTION OF TRAFFIC
- TEMPORARY CONCRETE BARRIER
- ⊠ IMPACT ATTENUATOR, TEMPORARY (FULLY REDIRECTIVE, NARROW) TEST LEVEL 3
- ⌋ FLASHING MONO-DIRECTIONAL LIGHT
- ⌋ PORTABLE TRAFFIC SIGNAL AND MICROWAVE DETECTOR
- ⌋ PORTABLE TRAFFIC SIGNAL

NOTES: ALL CONSTRUCTION SIGNS DESIGNATED WITH (O) SHALL BE FLUORESCENT ORANGE.

TRAFFIC CONTROL SIGNING AND TEMPORARY PAVEMENT MARKING FROM STAGE 2 TO REMAIN IN PLACE, UNLESS NOTED IN THE STAGE 2A PLANS.

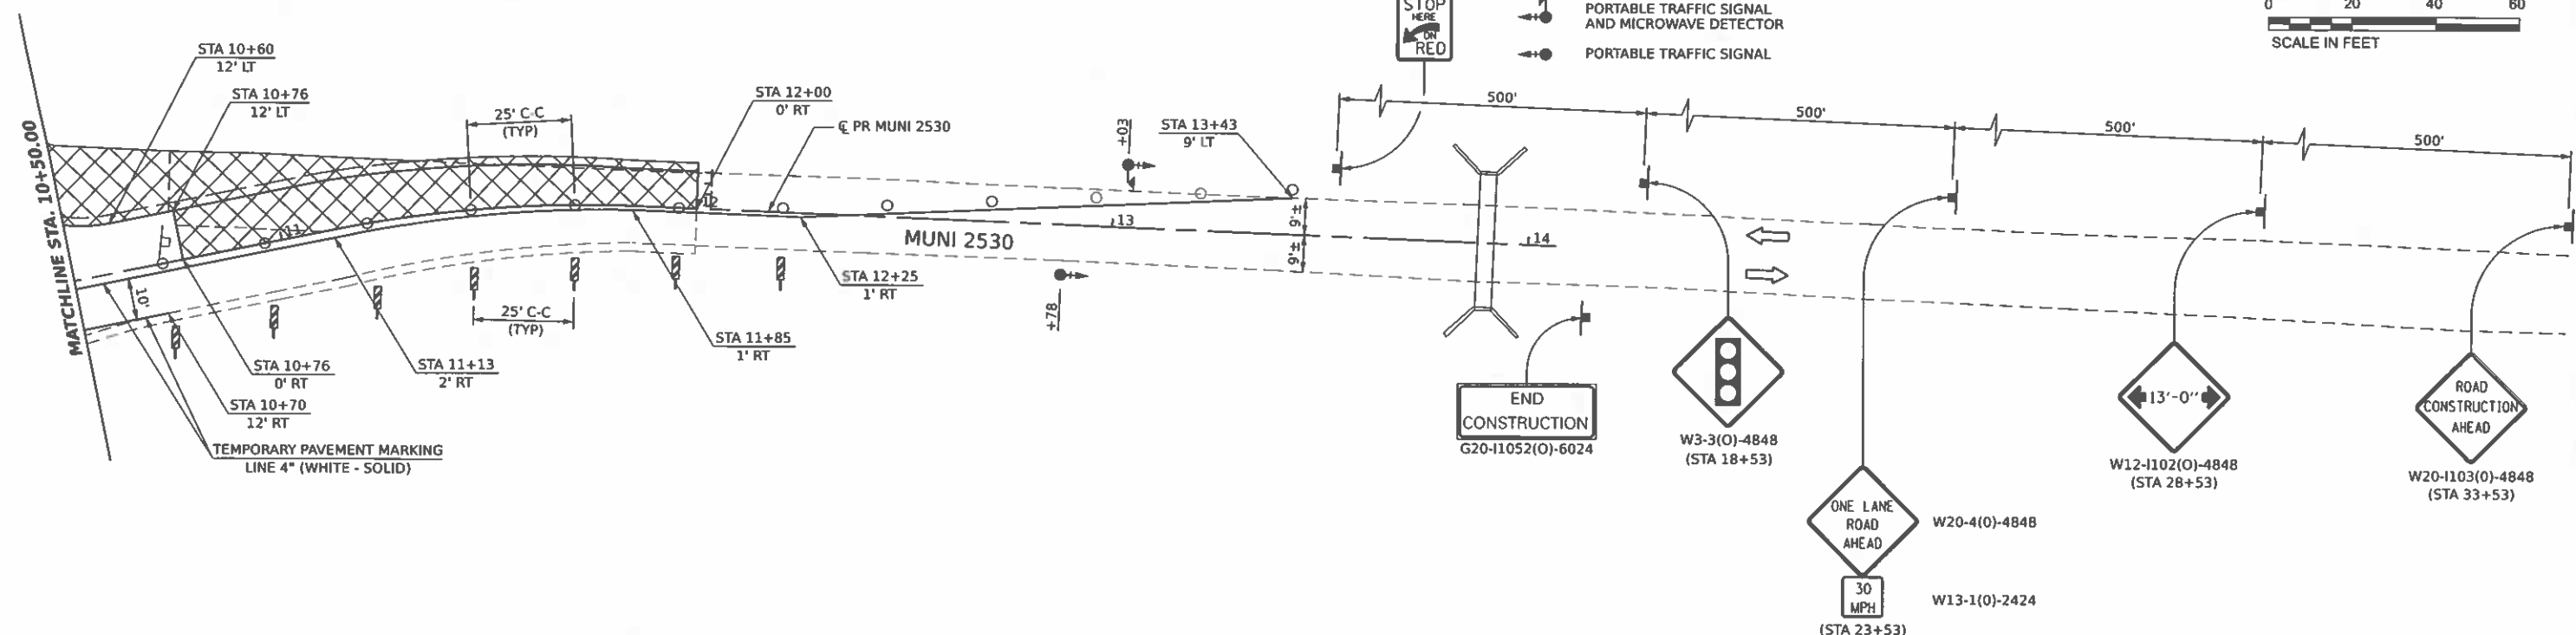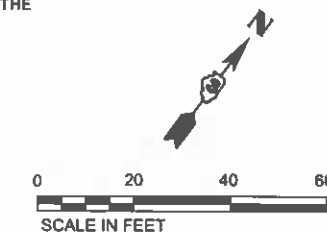

R10-6a-2430 (STA 13+53)

STOP HERE ON RED

END CONSTRUCTION
G20-11052(O)-6024

W3-3(O)-4848 (STA 18+53)

ONE LANE ROAD AHEAD
30 MPH
W13-1(O)-2424 (STA 23+53)

W20-4(O)-4848

W12-1102(O)-4848 (STA 28+53)

W20-1103(O)-4848 (STA 33+53)

MODEL: Plan 7
FILE NAME: D:\000003-SHA-Stage 2A.dgn

Hutchinson Engineering, Inc.
Jacksonville Moline Peoria Shorewood
Since 1945

USER NAME = nash/lan	DESIGNED -	REVISED -
PLOT SCALE = 0.16666633" / ft.	DRAWN -	REVISED -
PLOT DATE = 3/29/2021	CHECKED -	REVISED -
	DATE -	REVISED -

STATE OF ILLINOIS
DEPARTMENT OF TRANSPORTATION

FAI 57 & WALDRON ROAD
STAGE 2A CONSTRUCTION AND TRAFFIC CONTROL

SCALE: 1"=20' SHEET 1 OF 1 SHEETS STA. 20+00 TO STA. 26+00

FAI RTE.	SECTION	COUNTY	TOTAL SHEETS	SHEET NO.
57	139 HBR-6	KANKAKEE	202	60
CONTRACT NO. 66997				

ILLINOIS FED. AID PROJECT

STAGE 3 CONSTRUCTION

INSTALL TRAFFIC CONTROL SIGNING.

ADJUST TEMPORARY BRIDGE SIGNALS ACCORDING TO STAGE 3 PLANS.

CONSTRUCT CURB AND GUTTER AND SHARED USE PATH FROM STA 15+40 TO STA 17+96 AND FROM STA 21+22 TO STA 26+35.

MUN 2530 TO REMAIN OPEN DURING STAGE 3.

CONSTRUCT SHARED USE PATH PARAPET OF PROPOSED SN 046-0153 AS SHOWN IN THE STRUCTURE PLANS.

TRAFFIC CONTROL AND PROTECTION

TRAFFIC CONTROL AND PROTECTION SHALL BE PERFORMED IN ACCORDANCE WITH THE TRAFFIC CONTROL PLAN, SECTION 701 OF THE STANDARD SPECIFICATIONS AND THE SPECIAL PROVISIONS.

I-57

MAINTAIN EXISTING TRAFFIC.

WALDRON ROAD

MAINTAIN ONE LANE OF TRAFFIC AT ALL TIMES UTILIZING HIGHWAY STANDARD 701321. DUANE BLVD WILL BE CLOSED DURING STAGE 3.

EXISTING TRAFFIC CONTROL SIGNS AND DEVICES WILL BE REMOVED BY THE CONTRACTOR AFTER THE PROPOSED TRAFFIC CONTROL REQUIREMENTS ARE MET, OR AS AUTHORIZED BY THE ENGINEER. SIGNS OR DEVICES LEFT IN PLACE AT THIS TIME ARE TO BE PROTECTED FROM DAMAGE BY THE CONTRACTOR.


THE CONTRACTOR SHALL SCHEDULE OPERATIONS TO ENSURE THAT NO DROP-OFF OF GREATER THAN 12", WITHIN 3' OF THE TRAVEL LANE, IS PRESENT FOR 48 HOURS OR MORE.

NO DROP-OFF GREATER THAN 24" WITHIN 12' OF THE TRAVEL LANE WILL BE ALLOWED UNLESS A FLAGGER CONTROLLED LANE CLOSURE IS PROVIDED. SEGMENTS WHERE THESE CONDITIONS OCCUR DURING NON-WORKING HOURS MUST BE PROTECTED WITH TEMPORARY CONCRETE BARRIER. UNLESS AUTHORIZED BY THE ENGINEER, THE CONTRACTOR WILL ONLY BE PAID FOR TEMPORARY CONCRETE BARRIER ALONG SEGMENTS SHOWN IN THE PLANS.

DRUMS WITH STEADY-BURNING LIGHTS SHALL BE REQUIRED TO DELINEATE THE TRAVEL WAY. THE MAXIMUM SPACING SHALL BE 100 FEET, CENTER TO CENTER ALONG TANGENTS (50 FEET ALONG TAPERS); AND 25 FEET (CENTER TO CENTER) ALONG RADII TO SIDE ROADS AND ENTRANCES.

THE FOLLOWING TRAFFIC CONTROL STANDARDS ARE THE MINIMUM REQUIREMENTS FOR THE TRAFFIC FOR THIS PROJECT: 701001, 701006, 70101, 701201, 701301, 701326, 701400, 701401, 701406, 701901 AND 704001.


CHANGEABLE MESSAGE SIGNS ARE TO BE IN PLACE 2 WEEKS PRIOR TO THE BEGINNING OF CONSTRUCTION.

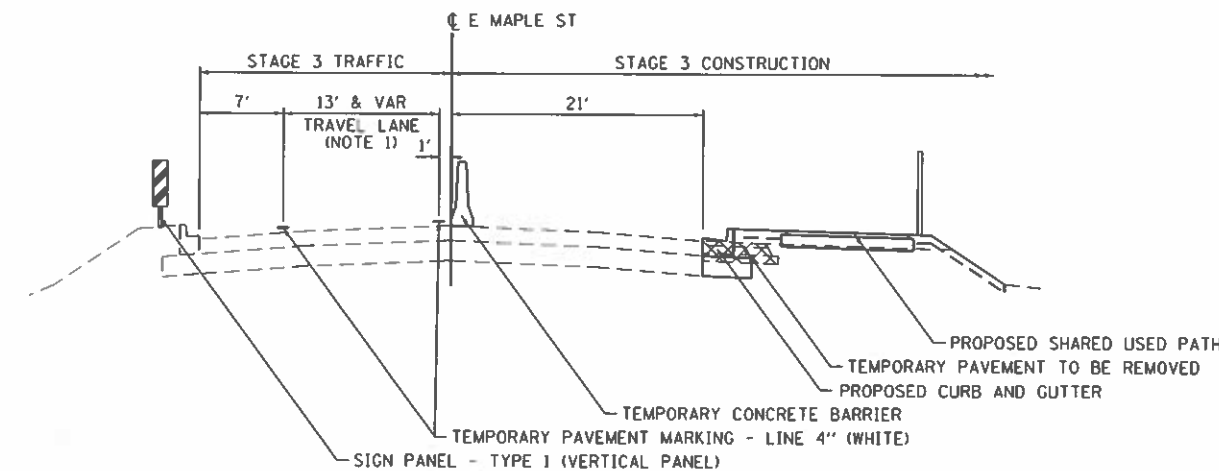

STAGE 3 TYPICAL SECTION

E MAPLE ST

STA 16+76.00 TO 17+96.21

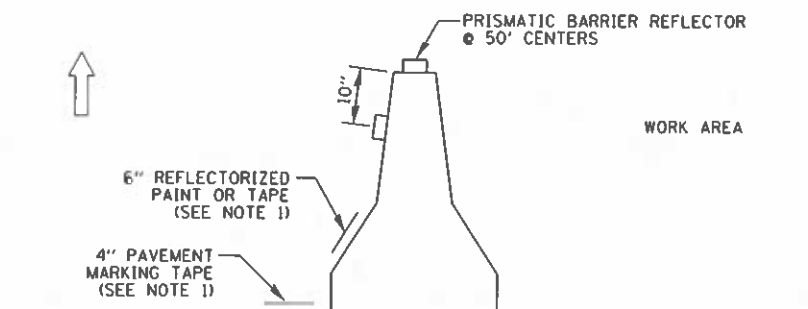


NOTES:

1. THE CONTRACTOR HAS THE OPTION OF USING EITHER THE LINE ON THE TEMPORARY CONCRETE BARRIER OR ON THE PAVEMENT.
2. THE COST OF THE REFLECTORS IS INCLUDED IN THE COST OF THE TEMPORARY CONCRETE BARRIER.

TEMPORARY CONCRETE BARRIER WALL DETAILS

NOTES:

1. VARIES FROM 11' AT STA 17+04 TO 13' AT STA 17+44.

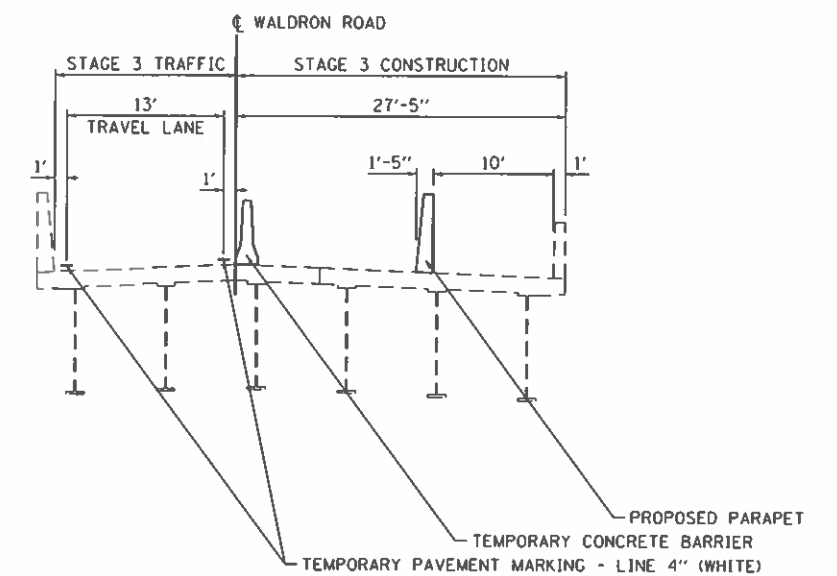


STAGE 3 BRIDGE TYPICAL SECTION

WALDRON ROAD

STA 17+96.21 TO 21+21.73

TEMPORARY PAVEMENT MARKING ON FINAL WEARING SURFACE SHALL BE PAVEMENT MARKING TAPE, TYPE IV

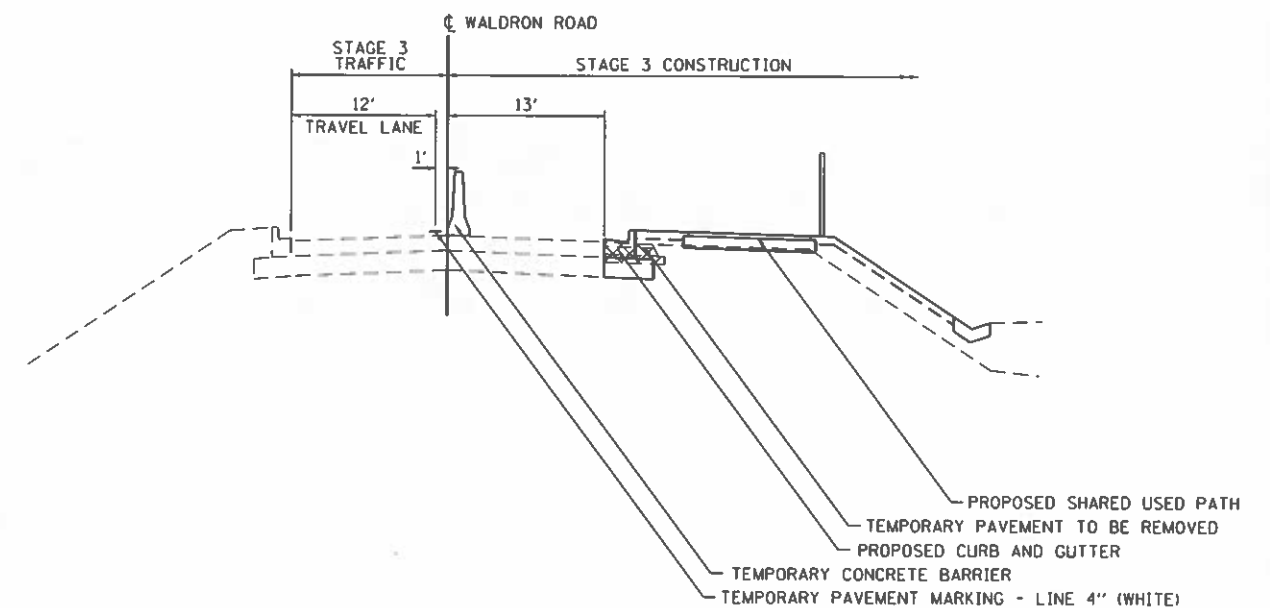

STAGE 3 TYPICAL SECTION

WALDRON ROAD

STA 21+21.73 TO 26+35.00

MODEL: Plan 1
FILE NAME: C:\06003-SN-Stage 3 Typical Section.dgn

Hutchinson Engineering, Inc.
Jacksonville Moline Peoria Shorewood
Since 1945



USER NAME = rneal@hinc	DESIGNED =	REVISED =
PLOT SCALE = 0.1887" = 1'	DRAWN =	REVISED =
PLOT DATE = 3/29/2021	CHECKED =	REVISED =
	DATE = 2021/03/26	REVISED =

STATE OF ILLINOIS
DEPARTMENT OF TRANSPORTATION



FAI 57 & WALDRON ROAD
STAGE 3 TYPICAL SECTIONS

SCALE: N.T.S. SHEET 1 OF 1 SHEETS STA. TO STA.

F.A.I. RTE.	SECTION	COUNTY	TOTAL SHEETS	SHEET NO.
57	139 HBR-6	KANKAKEE	202	61
CONTRACT NO. 66997				
ILLINOIS FED. AID PROJECT				

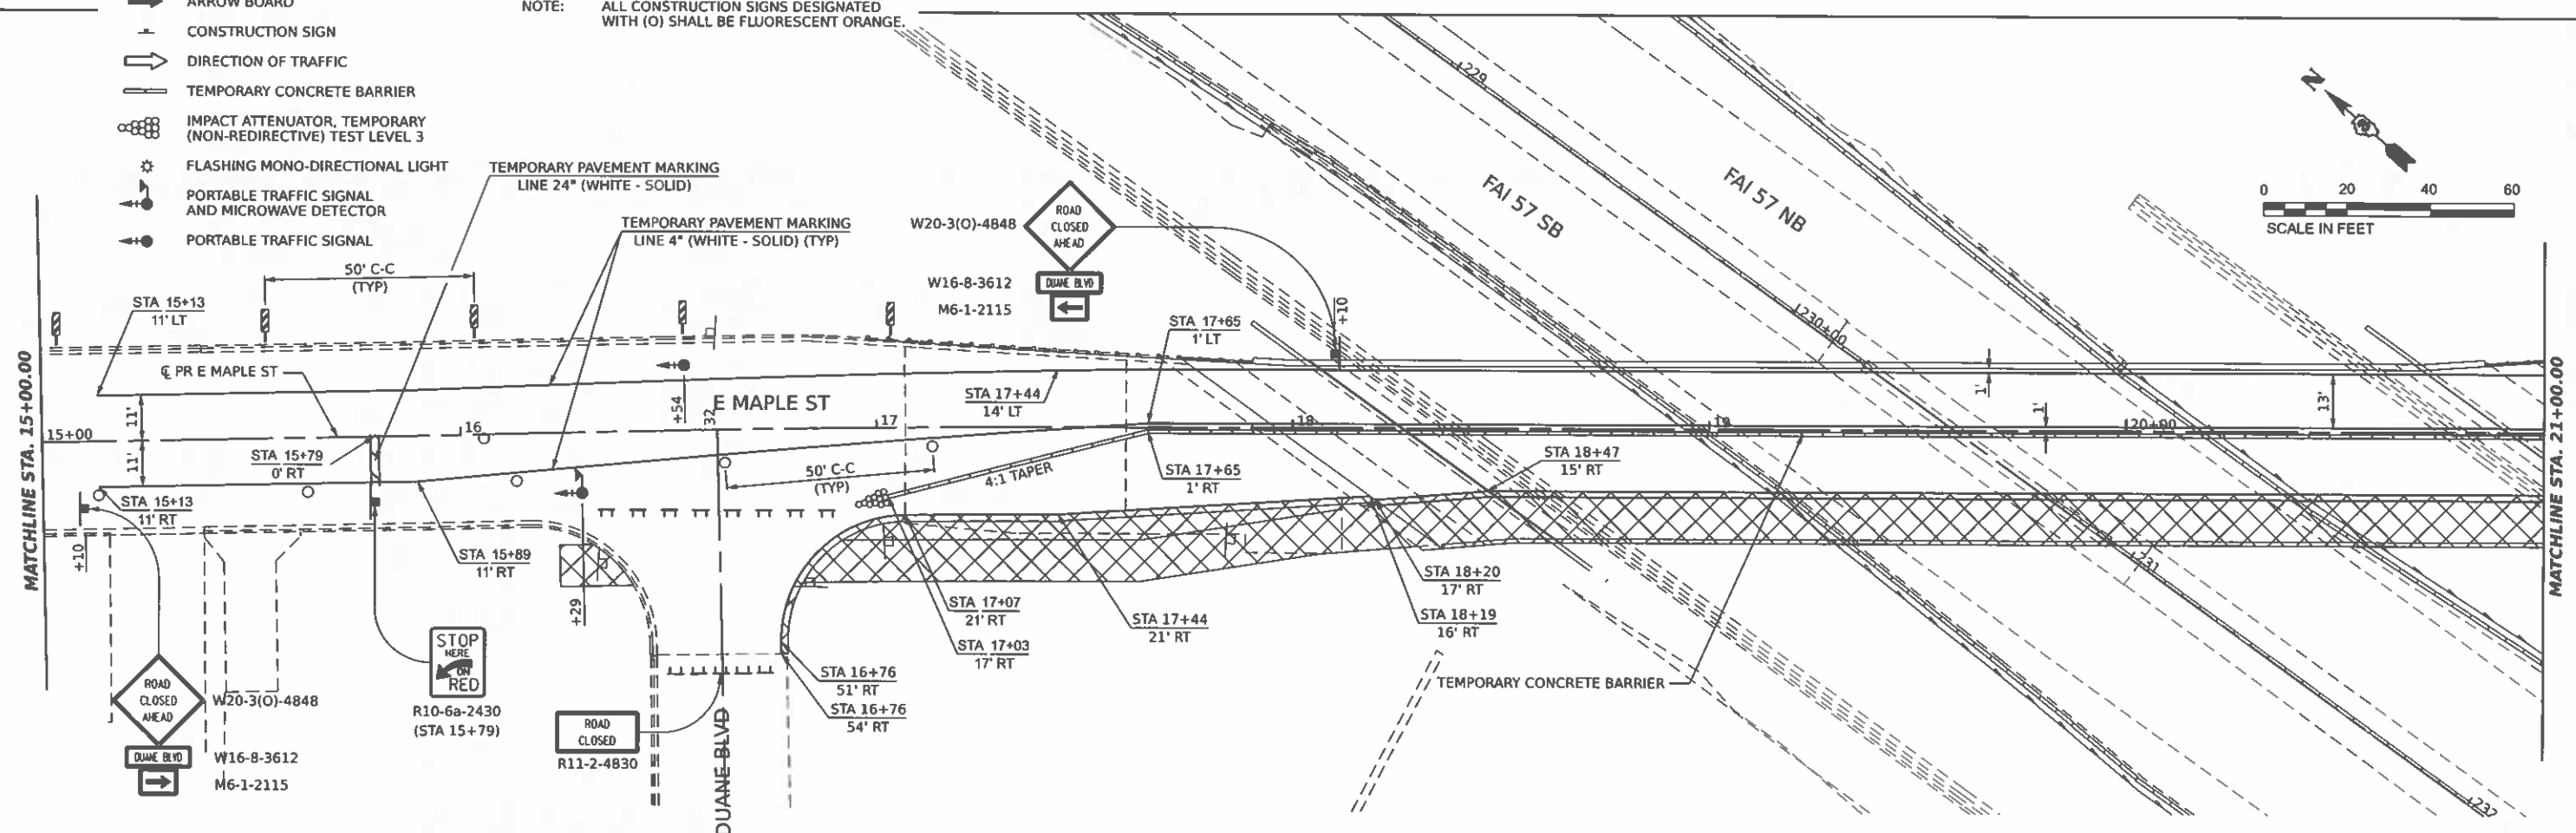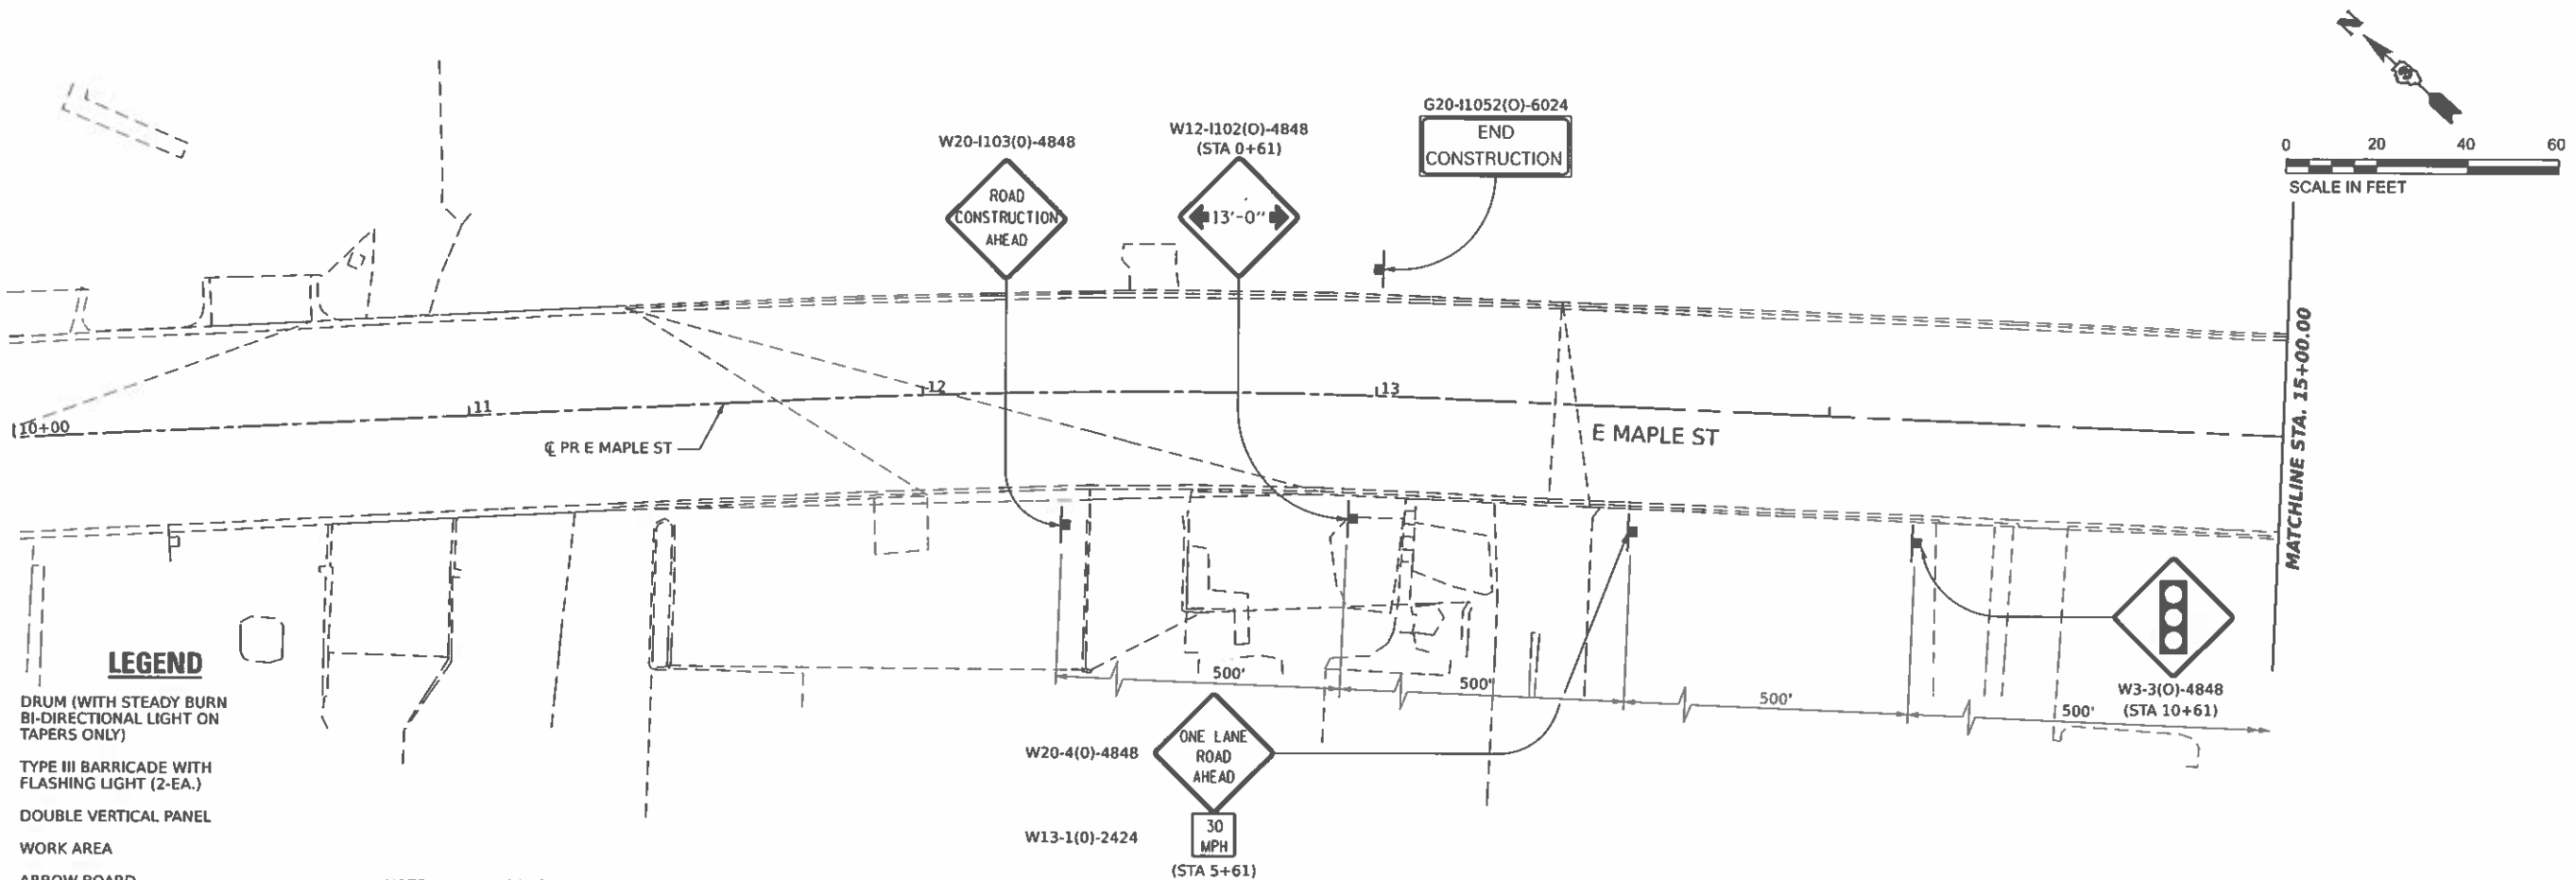

MODEL: Plan 5 FILE NAME: D:\060813-SHA-Stage 3-1.dgn Hutchinson Engineering, Inc. Jacksonville Moline Peoria Shorewood Since 1945	USER NAME = nrales@hpin	DESIGNED -	REVISED -	STATE OF ILLINOIS DEPARTMENT OF TRANSPORTATION				FAI 57 & WALDRON ROAD STAGE 3 CONSTRUCTION AND TRAFFIC CONTROL				FAI RTE.	SECTION	COUNTY	TOTAL SHEETS	SHEET NO.
	PLOT SCALE = 0.16666633" / ft.	DRAWN -	REVISED -									57	139 HBR-6	KANKAKEE	202	62
	PLOT DATE = 3/29/2021	CHECKED -	REVISED -									CONTRACT NO. 66997				
		DATE -	REVISED -									ILLINOIS FED. AID PROJECT				

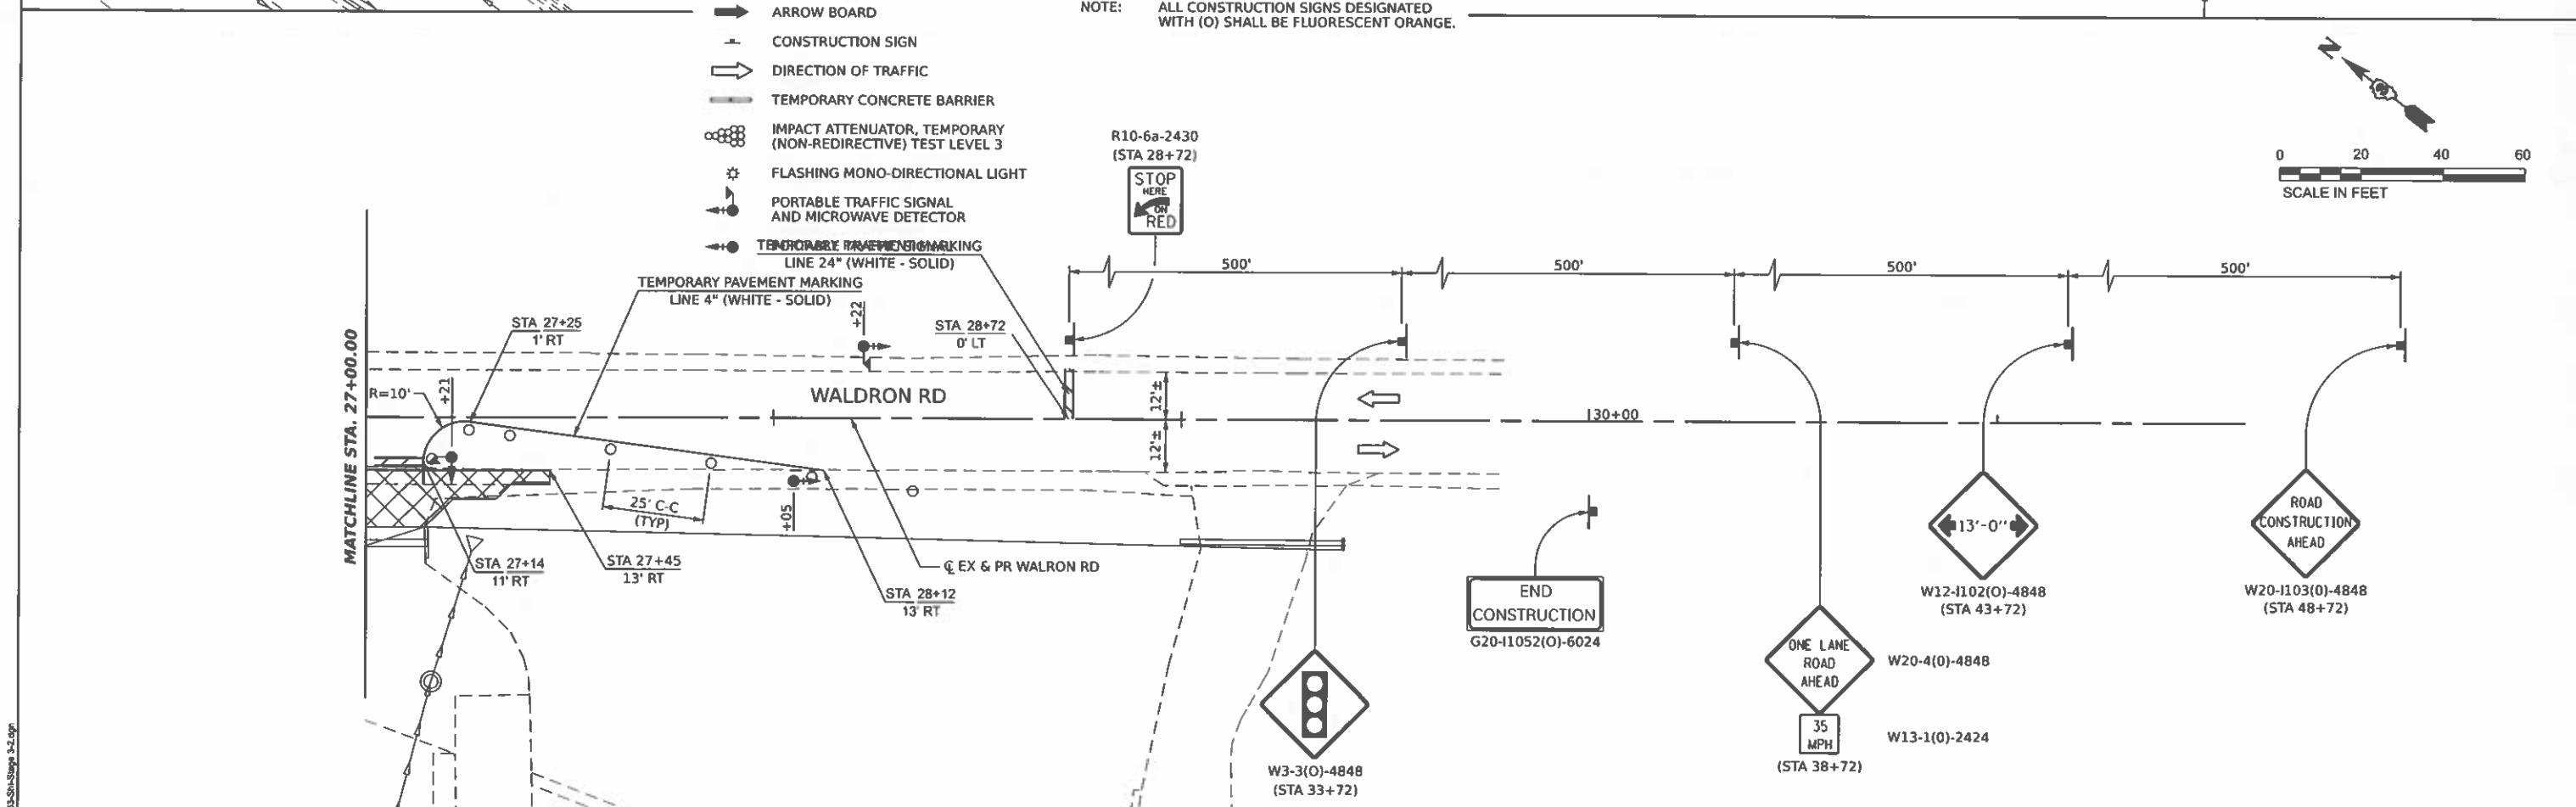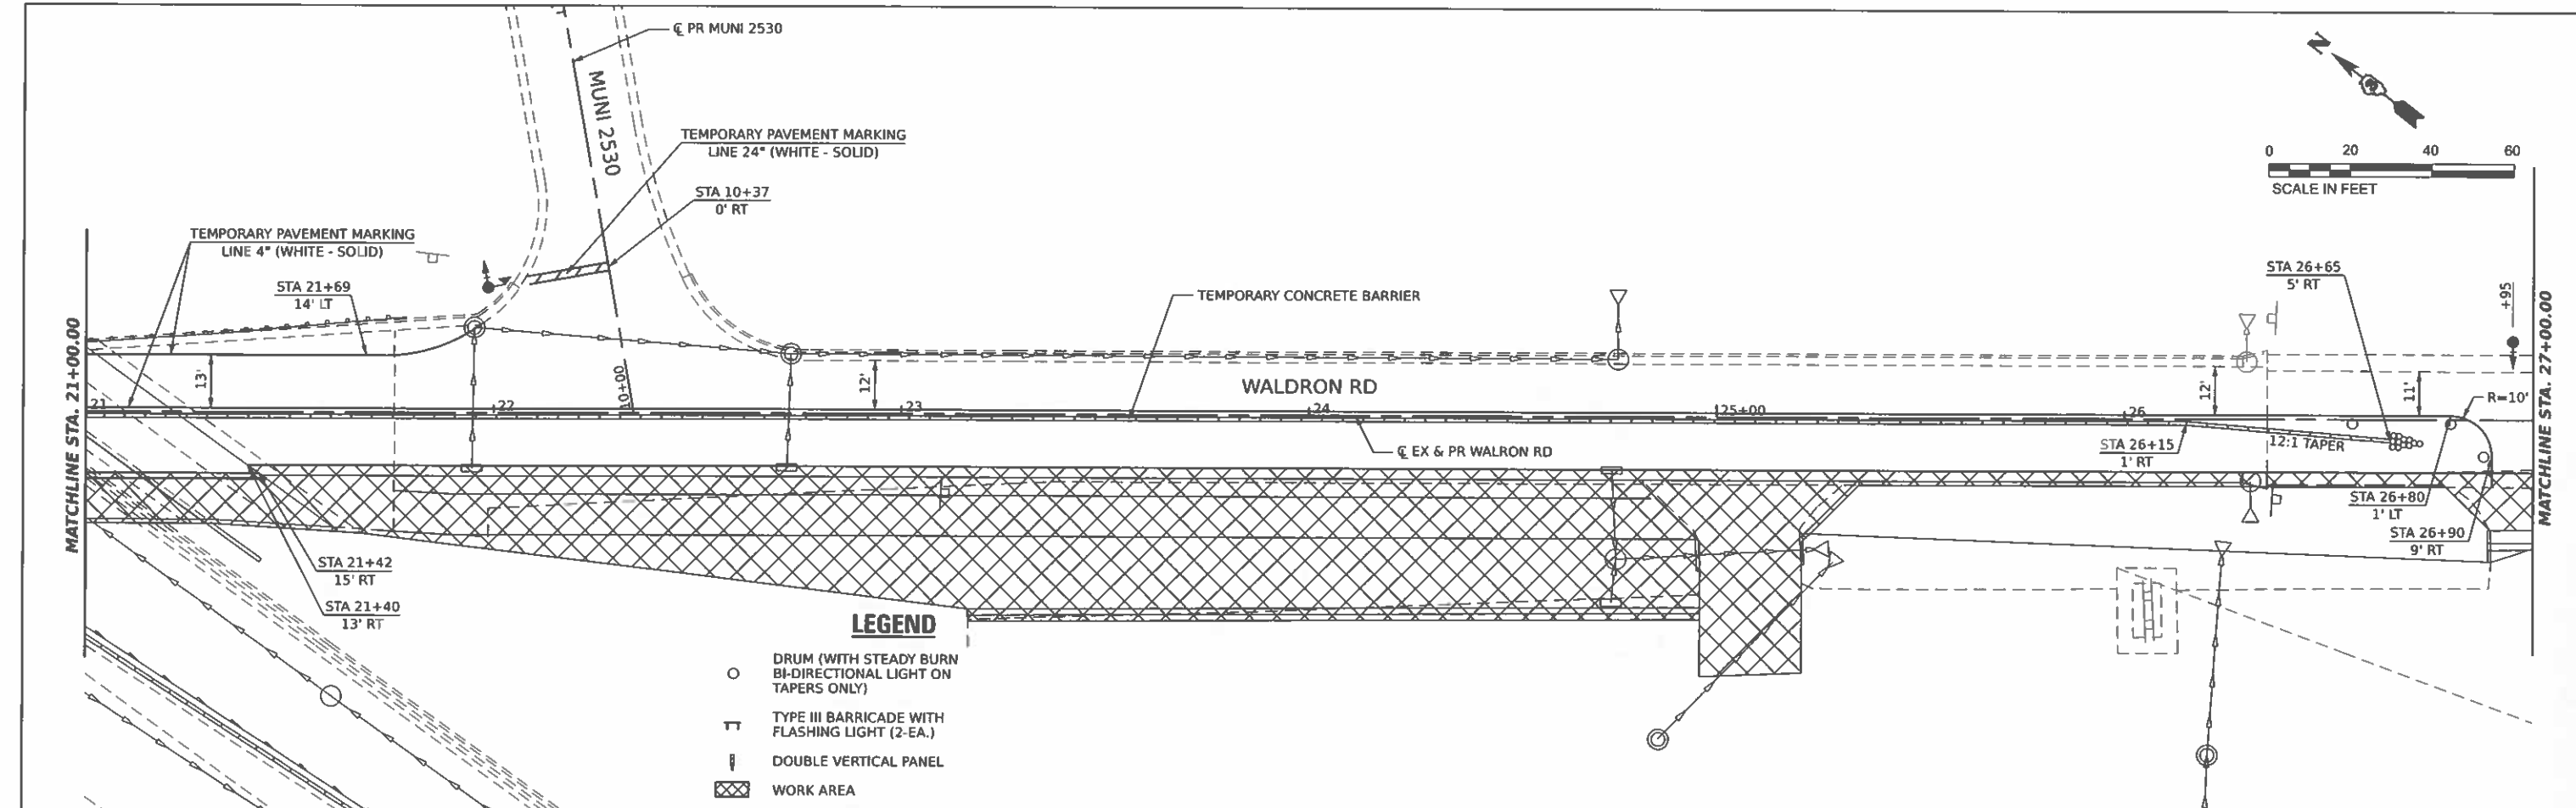

MODEL: Plan 7
FILE NAME: D:\06083-Shl-Stage 3-2.dgn

Hutchinson Engineering, Inc. Jacksonville Moline Peoria Shorewood Since 1945				STATE OF ILLINOIS DEPARTMENT OF TRANSPORTATION				FAI 57 & WALDRON ROAD STAGE 3 CONSTRUCTION AND TRAFFIC CONTROL				F.A.I. RTE. 57 SECTION 139 HBR-6 COUNTY KANKAKEE TOTAL SHEETS 202 SHEET NO. 63 CONTRACT NO. 66997			
USER NAME = maderlan PLOT SCALE = 0.16666633' / in. PLOT DATE = 3/29/2021				DESIGNED - DRAWN - CHECKED - DATE = 2021/03/26				REVISED - REVISED - REVISED - REVISED -				SCALE: 1"=20' SHEET 2 OF 2 SHEETS STA. 21+00 TO STA. 31+50			

LEGEND

DRUMS OR VERTICAL BARRICADES WITH STEADY BURNING WARNING LIGHTS AT 100' CENTERS. (50' CENTERS AT TAPERS) UNLESS OTHERWISE NOTED ON PLANS

TT

TYPE III BARRICADE WITH FLASHING LIGHT (2-EA.)

XXXX

INTERSTATE CLOSURE AREA

→

FLASHING ARROW BOARD

+

CONSTRUCTION SIGN

→

DIRECTION OF TRAFFIC



W20-2(O)-48



W3-4(O)-48



CHANGEABLE MESSAGE SIGN
MESSAGE:
"DETOUR AHEAD" /
"ALL TRAFFIC MUST EXIT"
RIGHT SHOULDER



W20-2(O)-48



W3-4(O)-48



W20-2(O)-48




W20-5L(O)-48



W4-2L(O)-48


WORK ZONE	W21-1115(O)-3618
SPEED LIMIT 55	R2-1-3648
PHOTO ENFORCED	W2-1114(O)-3612
XXXX FINE MINIMUM	R2-1106-3618

0.5 MILES UPSTREAM OF EXIT RAMP (NB/SB)

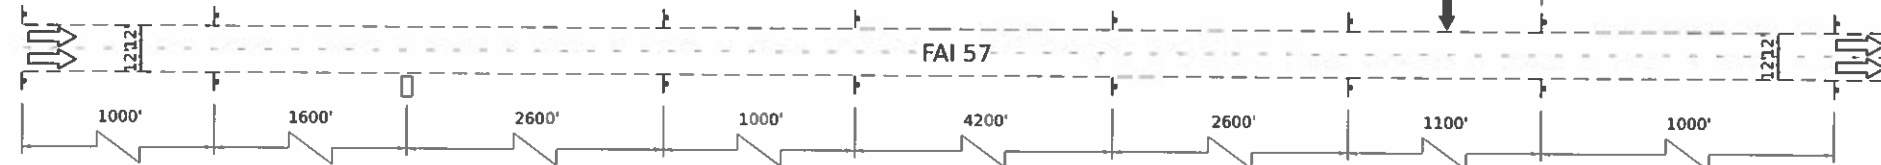

FAI 57 ADVANCED SIGNING DETAIL (NOT TO SCALE)

NOTE: TRAFFIC WILL UTILIZE DETOUR SHOWN IN THE "ALTERNATE ROUTE" DETAIL DURING EXISTING SUPERSTRUCTURE DEMOLITION AND BEAM PLACEMENT.

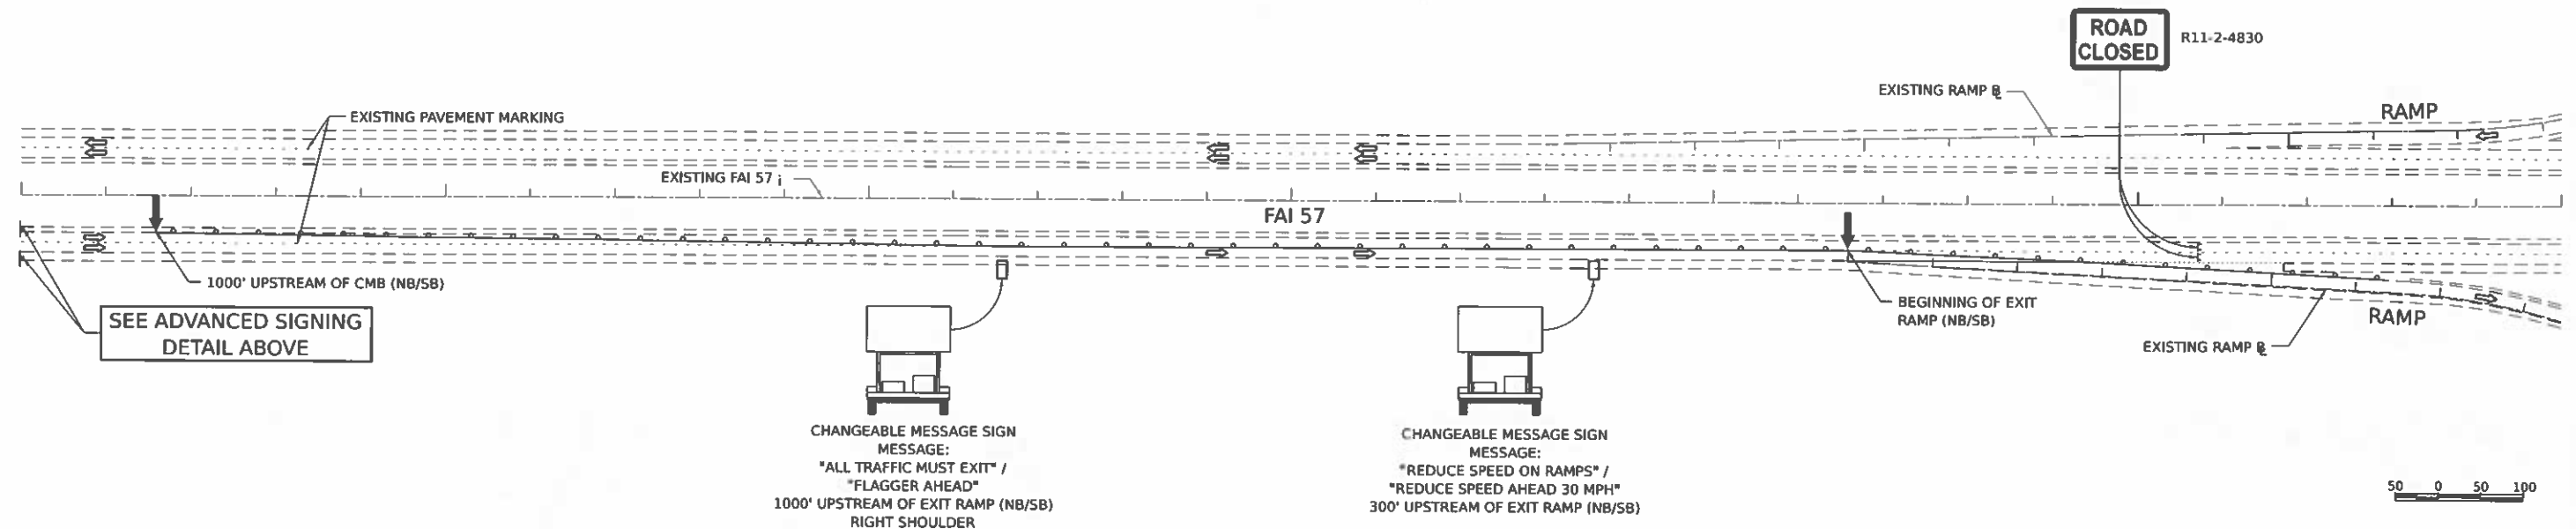

W20-1(O)-48




W20-1101(O)-48




W20-1101(O)-48

SEE ABOVE FOR INTERSTATE CLOSURE DETAILS

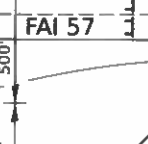

W20-1(O)-48

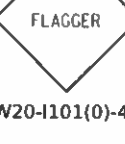

W20-1101(O)-48

LEGEND



LIGHTED FLAGGER STATIONS

NOTE: TRAFFIC WILL UTILIZE DETOUR SHOWN IN THE "ALTERNATE ROUTE" DETAIL DURING EXISTING SUPERSTRUCTURE DEMOLITION AND BEAM REPLACEMENT.

STATE OF ILLINOIS
DEPARTMENT OF TRANSPORTATION

FAI 57
TOTAL INTERSTATE CLOSURE AT NIGHT DETAIL

SCALE: 1"=100'

SHEET 1 OF 1 SHEETS STA. N/A TO STA. N/A


F.A.I. RTE.	SECTION	COUNTY	TOTAL SHEETS	SHEET NO.
57	139 HBR-6	KANKAKEE	202	64

CONTRACT NO. 66997

Hutchinson Engineering, Inc.
Jacksonville Moline Peoria Shorewood
Since 1945

USER NAME = raaahshan	DESIGNED -	REVISED -
PLOT SCALE = 0.18666633" / ft.	DRAWN -	REVISED -
PLOT DATE = 3/29/2021	CHECKED -	REVISED -
	DATE -	REVISED -

MODEL: Titleblock
FILE NAME: C:\Users\raaahshan\Documents\Shirley\Shirley Detail 1.dgn

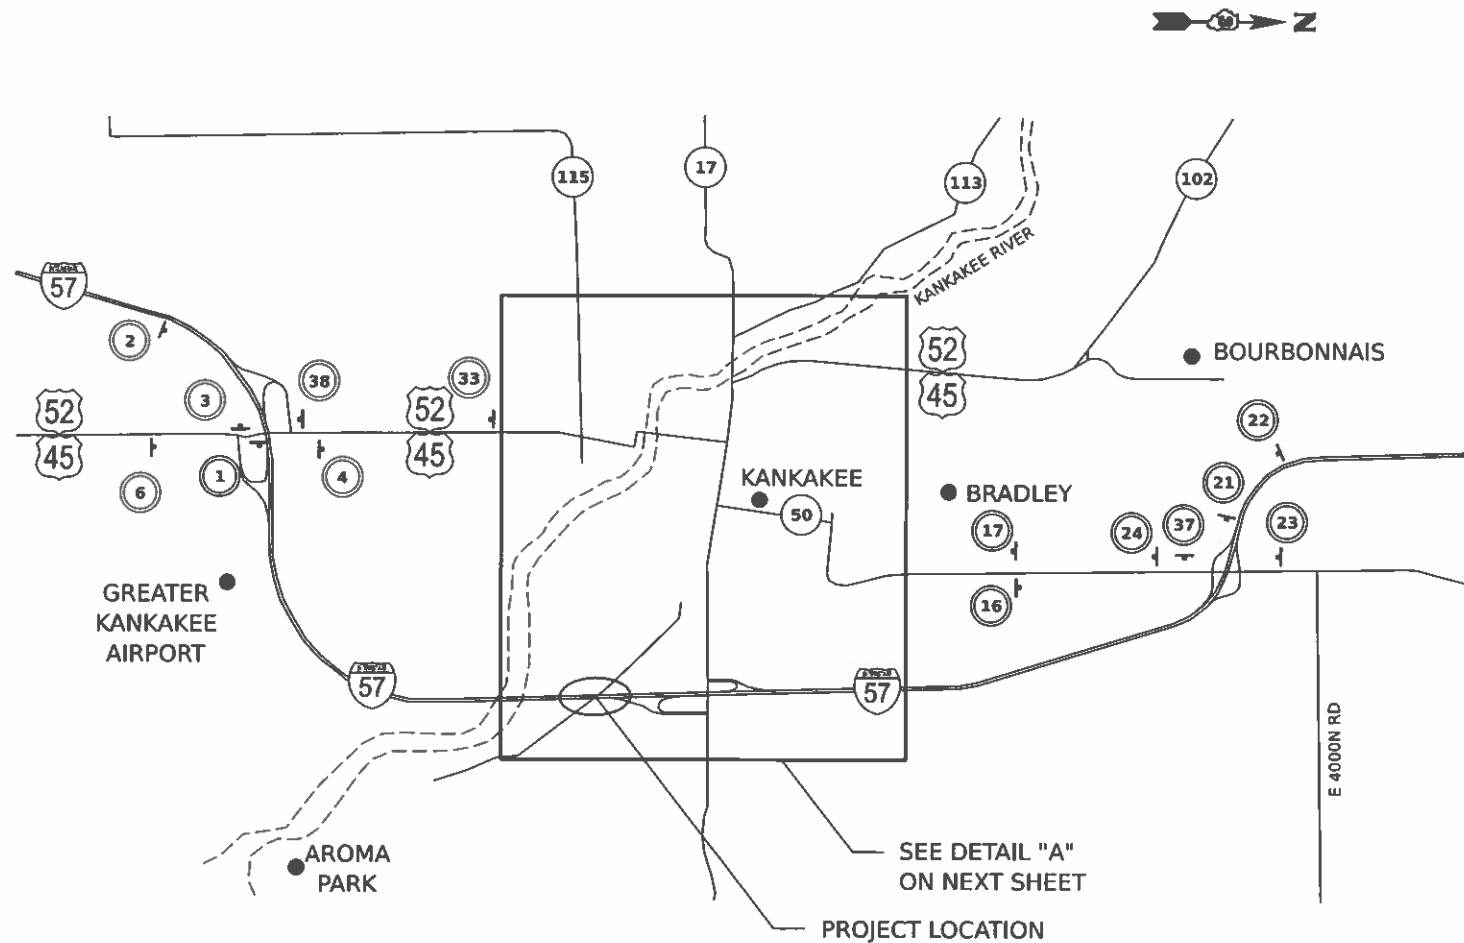

ALTERNATE ROUTE SIGNS
ALTERNATE ROUTE FOR I-57 DURING CONSTRUCTION
UTILIZES US 45/52, IL 17 AND IL 50.

THE CONTRACTOR SHALL FURNISH, INSTALL, MAINTAIN
AND REMOVE THE SIGNING FOR THE ALTERNATE ROUTE.

TWO EXTRA MESSAGE BOARDS ON I-57 AS OUTLINED IN
THE SPECIAL PROVISIONS SHALL DISPLAY THE
FOLLOWING MESSAGE:

I-57 CONSTRUCTION AHEAD
EXPECT DELAYS
ALT ROUTE AVAILABLE


SIGNS A1, B1, C, D, E, F, G, H, I: FLUORESCENT ORANGE
WITH BLACK SYMBOLS.

SIGNS A2, A3, B2, B3: BLUE WITH WHITE LETTERS.

ALTERNATE ROUTE

↓ SIGN SIGN NUMBER

SIGN ASSEMBLY

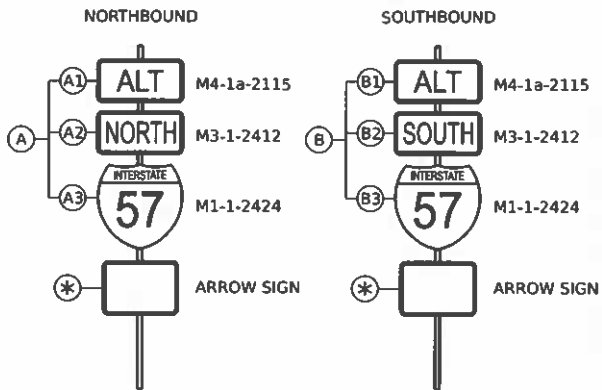

* SEE BELOW

ARROW SIGNS

- (C) M5-1(R)-2115
- (D) M5-1(L)-2115
- (E) M5-2(R)-2115
- (F) M6-1(L)-2115
- (G) M6-1(R)-2115
- (H) M6-2(R)-2115
- (I) M6-3-2115

SIGN NUMBER	LOCATION	PANELS
1	I-57 (NB) AT START OF RAMP	AH
2	I-57 (NB) 1/2 MILE PRIOR TO SIGN 1	AE
3	TOP OF RAMP FOR I-57 (NB) TRAFFIC HEADING NORTH ONTO US 45/52	AG
4	US 45/52 (NB) 500' NORTH OF I-57	AI
5	US 45/52 (NB) AT IL 50 JCT	AH
6	US 45/52 (NB), 100' PRIOR TO RAMP	AI
7	IL 50 (NB), SOUTH END OF BRIDGE	AC
8	IL 50 (NB) AT RIVER STREET	AG
9	IL 50 (NB) (RIVER STREET) AT HARRISON AVE	AF
10	IL 50 (NB) HARRISON AVE), 1500' SOUTH OF IL 17	AI
11	IL 50 (NB) (HARRISON AVE), AT IL 17	AI
12	IL 17 (WB), AT IL 50	BF
13	IL 50 (NB) NORTH OF IL 17	AI
14	IL 50 (NB) AND FAIR STREET	AG
15	IL 50 (NB FAIR STREET) BEFORE CURVE	AI
16	IL 50 (NB KINZIE AVE) 100' NORTH OF NORTH STREET	AI
17	IL 50 (SB KINZIE AVE) 100' NORTH OF NORTH STREET	BI
18	IL 50 (SB FAIR STREET) AT INDIANA AVE	BF
19	IL 50 (SB INDIANA AVE) 200' NORTH OF IL 17	BI
20	IL 17 (EB) AT INDIANA AVE	BG

SIGN NUMBER	LOCATION	PANELS
21	I-57 (SB) AT START OF RAMP	BH
22	I-57 (SB) 1/2 MILE PRIOR TO SIGN 21	BE
23	IL 50 (SB) 100' PRIOR TO RAMP	BI
24	IL 50 (SB) 500' SOUTH OF I-57	BI
25	IL 17 (WB) 100' PRIOR TO THE RAMP	BI
26	IL 17 (WB) 100' PRIOR TO THE RAMP	BI
27	IL 17 (WB) 1500' WEST OF I-57	BI
30	IL 17 (EB) AT HARRISON STREET	AF
33	US 45/52 (SB) 100' SOUTH OF SE AVE	BI
34	IL 50 (SB INDIANA AVE) AT RIVER STREET	BG
35	RIVER STREET, AT IL 50	BF
36	IL 50 (SB) AT E JEFFERY ST	BI
37	I-57 (SB) BOTTOM OF EXIT RAMP	BG
38	US 45/52 (SB) AT START OF RAMP	BH

DETAIL "A"



MODEL: T10plot
FILE NAME: D:\66973-SHA-Alternate Route 2.dgn

Hutchinson Engineering, Inc.
Jacksonville Moline Peoria Shorewood
Since 1945

USER NAME = rnsalehan
PLOT SCALE = 0.16666633 1/in.
PLOT DATE = 3/28/2021

DESIGNED -
DRAWN -
CHECKED -
DATE -

REVISED -
REVISED -
REVISED -
REVISED -


STATE OF ILLINOIS
DEPARTMENT OF TRANSPORTATION

FAI 57
ALTERNATE ROUTE

SCALE: N.T.S. SHEET 2 OF 2 SHEETS STA. N/A TO STA. N/A

F.A.I. RTE.	SECTION	COUNTY	TOTAL SHEETS	SHEET NO.
57	139 HBR-6	KANKAKEE	202	66
CONTRACT NO. 66997				

ILLINOIS FED. AID PROJECT

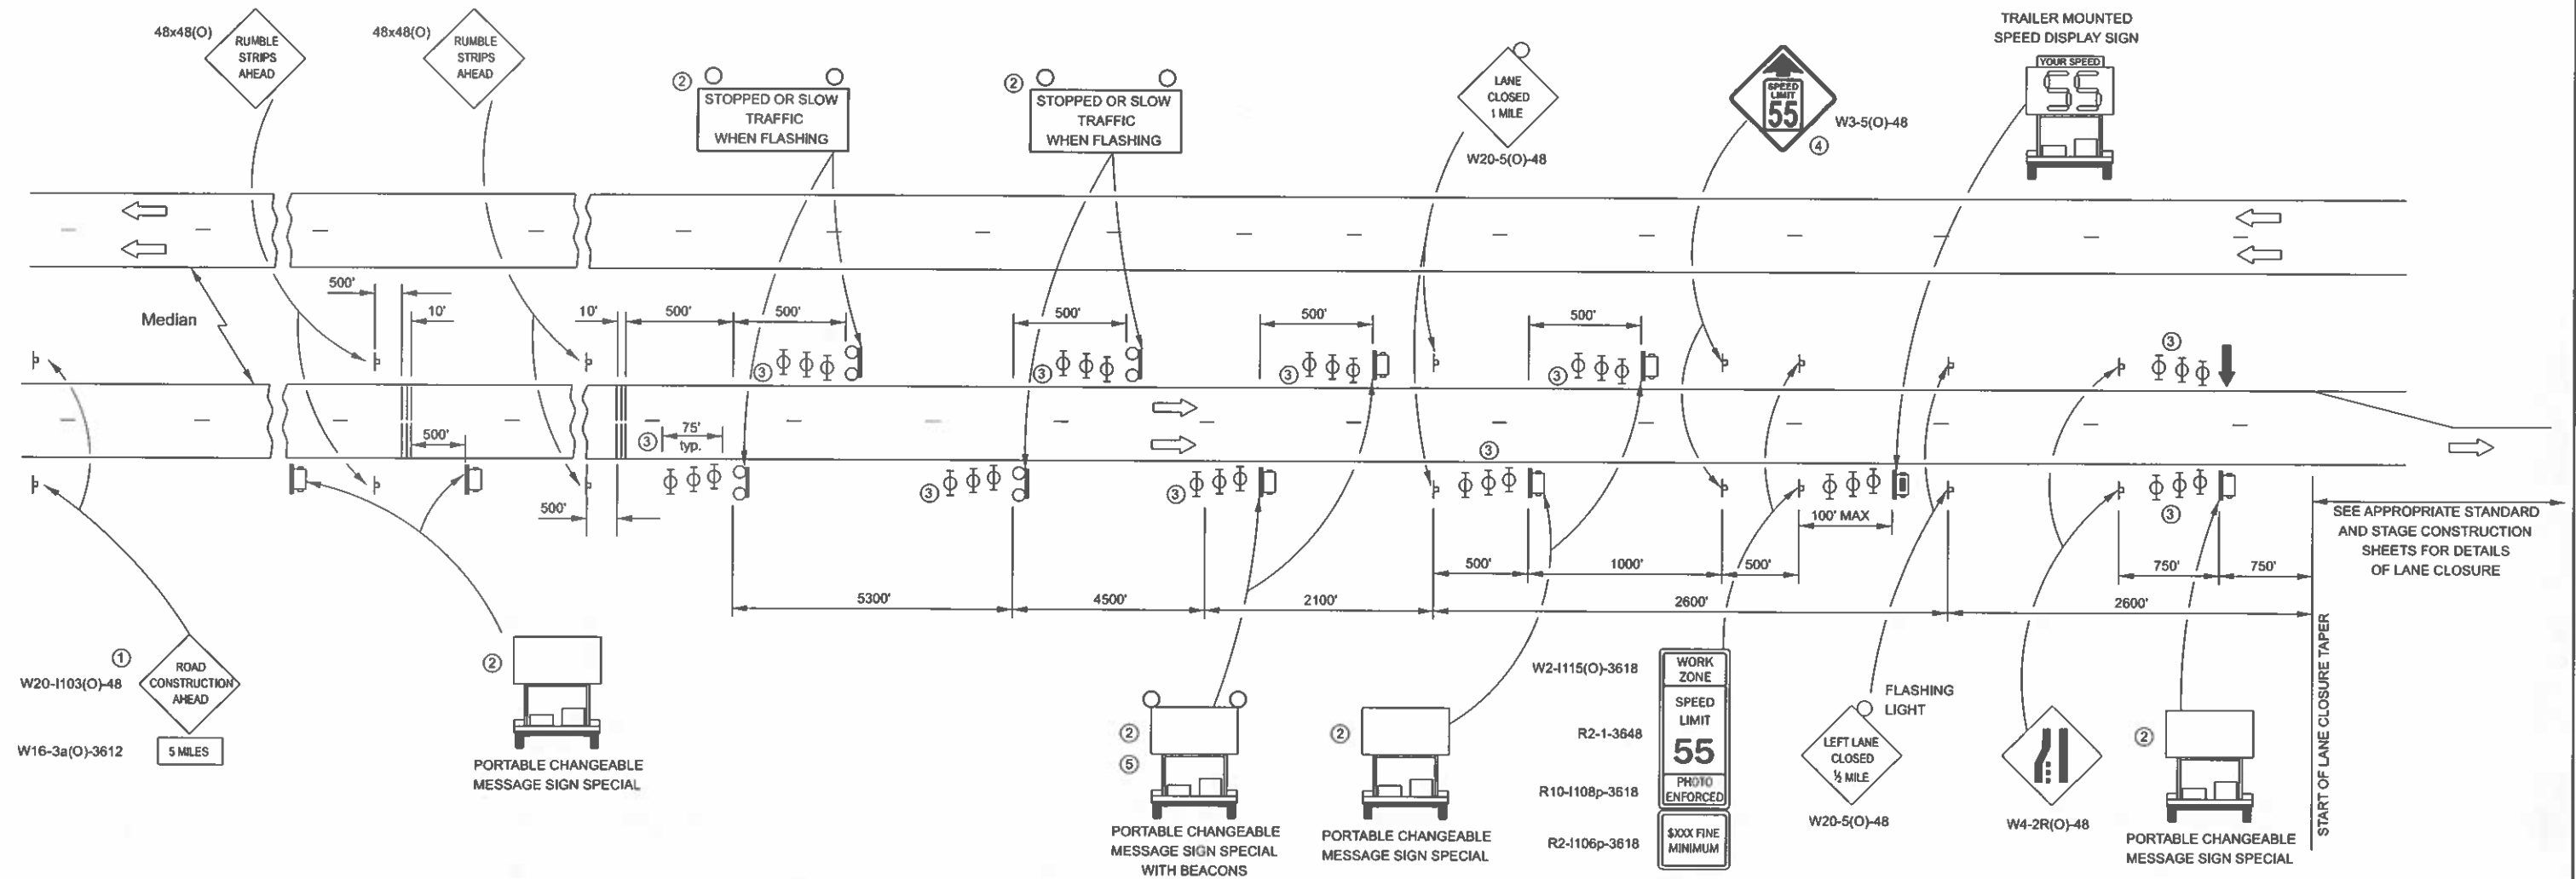


NOTES:

- THE ROAD CONSTRUCTION AHEAD SIGN SHALL BE LOCATED 5 MILES IN ADVANCE OF THE PROJECT LIMITS.
- UNIT TO BE PAID FOR SEPARATELY. TO BE PLACED OUTSIDE OF EXISTING PAVED SHOULDER. ANY REQUIRED EARTHWORK INCLUDED IN THE COST OF THE UNIT.
- THREE, TYPE II BARRICADES, DRUMS, OR VERTICAL BARRICADES AT 25' CENTERS.
- THIS SIGN SHALL ONLY BE USED IF THE EXISTING SPEED LIMIT IS GREATER THAN 65 MPH.
- WHEN SHOWN, PORTABLE CHANGEABLE MESSAGE SIGN SPECIAL SHALL HAVE EQUIVALENT FLASHING BEACONS AS REAL TIME TRAFFIC CONTROL SIGNING. COST INCLUDED IN PORTABLE CHANGEABLE MESSAGE SIGN SPECIAL.

LEGEND:

- ARROW BOARD
- PORTABLE CHANGEABLE MESSAGE SIGN
- SIGN
- REAL-TIME TRAFFIC CONTROL SIGNING
- TYPE II BARRICADE, DRUM, OR VERTICAL BARRICADE WITH MONODIRECTIONAL FLASHING LIGHT
- TEMPORARY RUMBLE STRIPS (SPECIAL) SEE DETAIL & SPECIAL PROVISION
- SPEED DISPLAY TRAILER

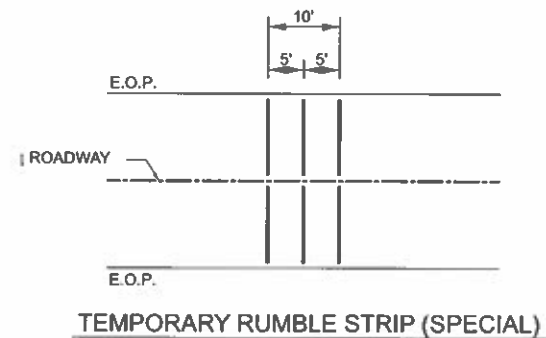

GENERAL NOTE:

THIS STANDARD IS USED WHERE A LANE CLOSURE IS IN PLACE LONGER THAN ONE CONSECUTIVE WEEK OR INCLUDING A WEEKEND OR HOLIDAY AS DESCRIBED IN KEEPING ROADS OPEN TO TRAFFIC.

THE FIRST TWO SIGNS ARE STATIONARY. THE OTHER SIGNS, ARROWBOARDS AND MESSAGE BOARDS SHALL BE MOVED AS NECESSARY TO MAINTAIN THE REQUIRED DISTANCE FROM THE START OF THE LANE CLOSURE TAPER(S).

SEE SPECIAL PROVISIONS FOR SMART TRAFFIC MONITORING SYSTEM, PORTABLE CHANGEABLE MESSAGE SIGN SPECIAL AND CONTROL OF WORK.

WHEN THE RIGHT LANE IS CLOSED, RIGHT LANE CLOSED SIGNS SHALL BE SUBSTITUTED FOR THE LEFT LANE CLOSED SIGNS.

WHEN EXISTING SIGNS, POLES, AND OTHER ITEMS CONFLICT WITH LOCATING THE EQUIPMENT SHOWN, THE CONTRACTOR SHALL COORDINATE WITH THE ENGINEER TO DECONFLICT EQUIPMENT PLACEMENT.

MODEL: T88000
FILE NAME: D:\000003-SHA\CP 701400 Smart Zone SpeedLimit.dgn

Hutchison Engineering, Inc.
Jacksonville Maline Peoria Shorewood
Since 1945


USER NAME = rsalobian	DESIGNED -	REVISED -
PLOT SCALE = 0.18666633' / in.	DRAWN -	REVISED -
PLOT DATE = 3/29/2021	CHECKED -	REVISED -
	DATE -	REVISED -

STATE OF ILLINOIS
DEPARTMENT OF TRANSPORTATION

TC&P STANDARD 701400 (SPECIAL) WITH SMART TRAFFIC CONTROL

SCALE: N.T.S. SHEET 1 OF 1 SHEETS STA. N/A TO STA. N/A

F.A.I. RTE	SECTION	COUNTY	TOTAL SHEETS	SHEET NO.
57	139 HBR-6	KANKAKEE	202	67
CONTRACT NO. 66997				
ILLINOIS FED. AID PROJECT				

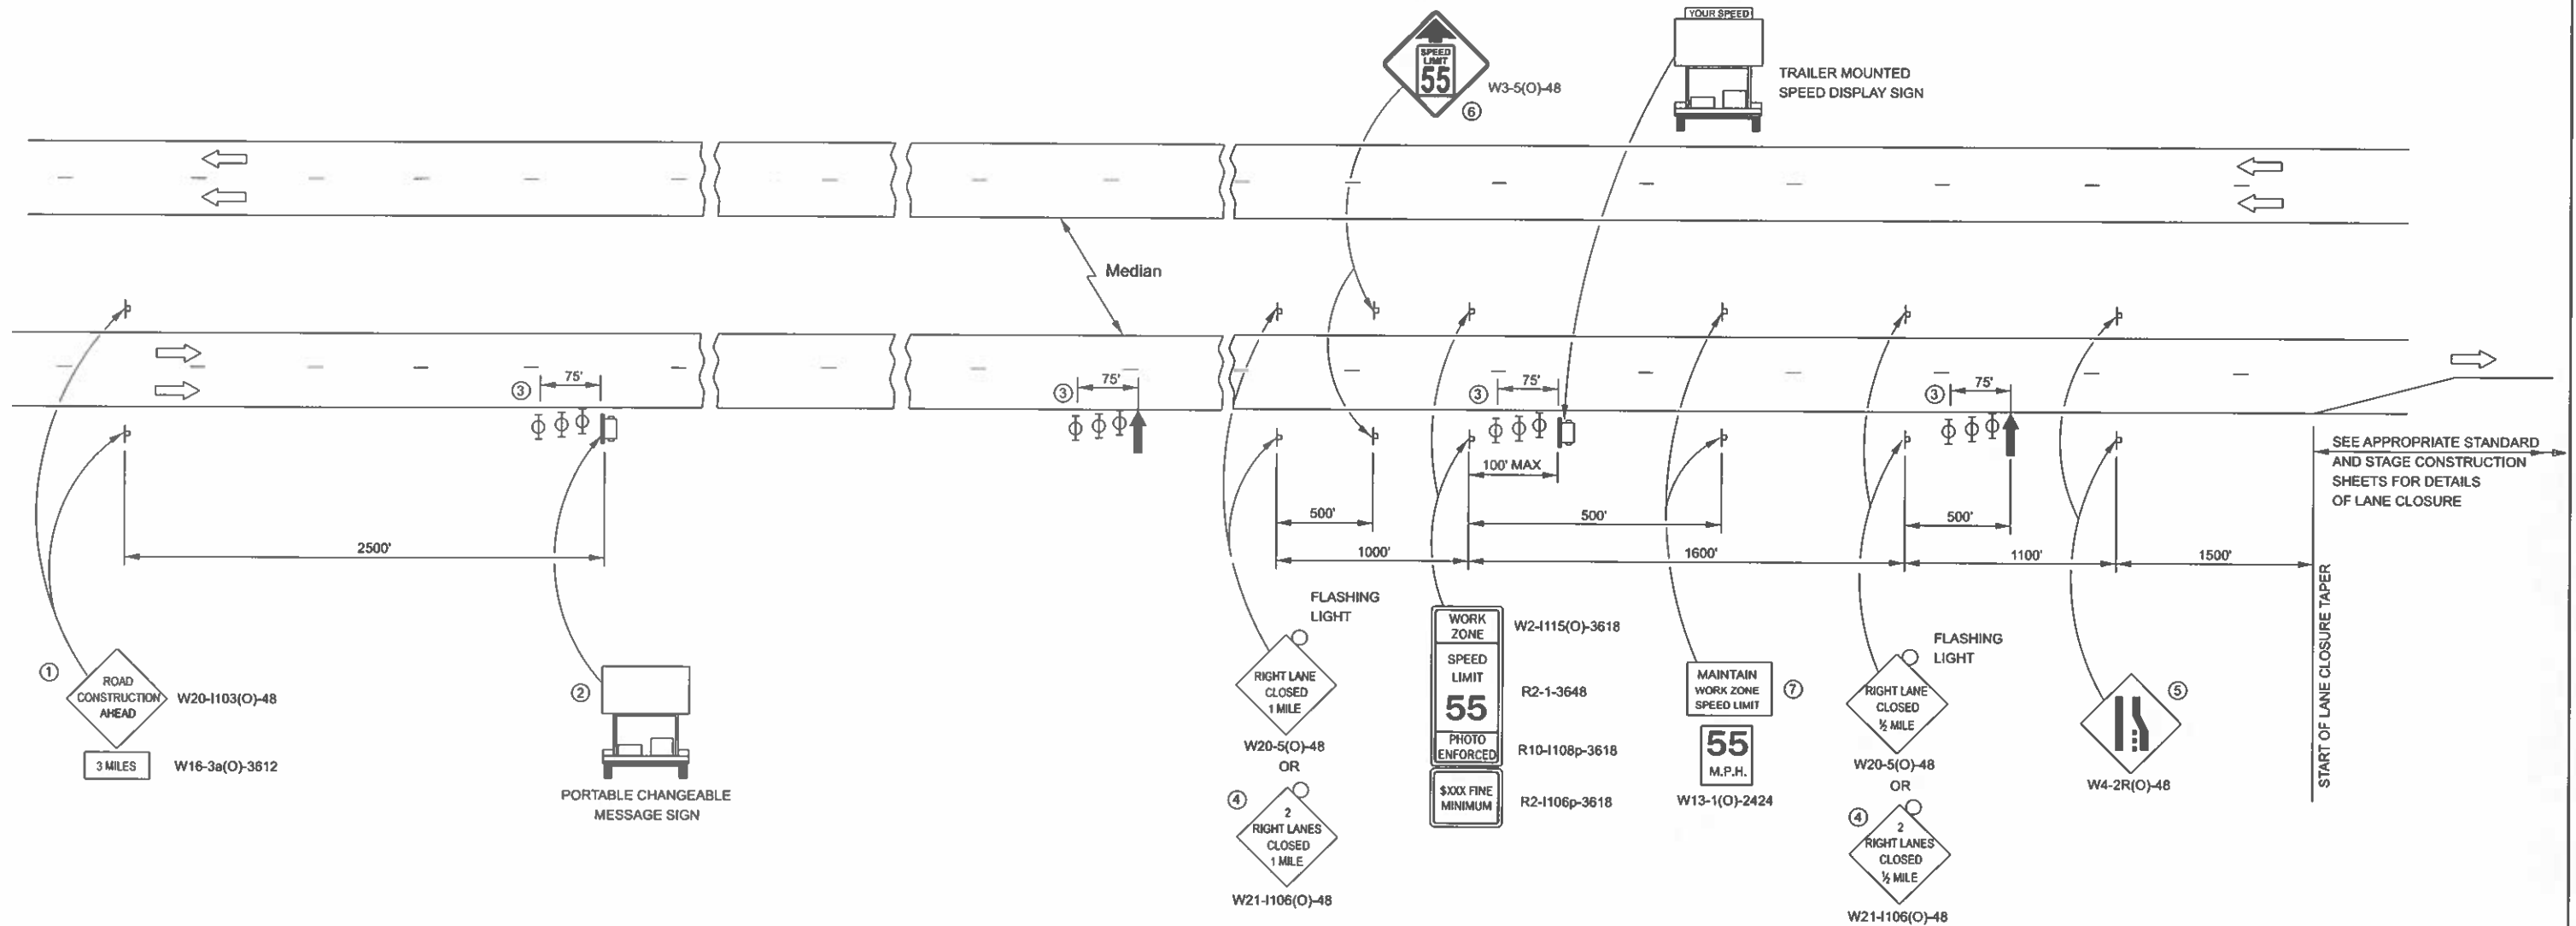

- ① THE ROAD CONSTRUCTION AHEAD SIGN SHALL BE LOCATED 3 MILES IN ADVANCE OF THE PROJECT LIMITS.
- ② TO BE PLACED IN THE MEDIAN WHEN FEASIBLE. THE MESSAGE BOARD SHALL BE USED TO DISPLAY STATUS OF LANES WITHIN THE PROJECT. THE PRIMARY MESSAGES SHALL BE:
"RIGHT LANE CLOSED" / "x MILES AHEAD"
"LEFT LANE CLOSED" / "x MILES AHEAD"
"ALL LANES OPEN"
- ③ THREE, TYPE II BARRICADES, DRUMS, OR VERTICAL BARRICADES AT 25' CENTERS.
- ④ THIS SIGN SHALL BE USED WHEN 2 LANES ARE CLOSED.
- ⑤ WHEN THE LEFT LANE IS CLOSED, SWITCH THESE TWO SIGNS AND THE DIRECTION OF THE MERGE ARROW.
- ⑥ THIS SIGN SHALL ONLY BE USED IF THE EXISTING SPEED LIMIT IS GREATER THAN 65 MPH.
- ⑦ 48"x36" FLUORESCENT ORANGE SIGN WITH BLACK LETTERS.

48"
36"
MAINTAIN
WORK ZONE
SPEED LIMIT

- ↑ ARROW BOARD
- ▮ PORTABLE CHANGEABLE MESSAGE SIGN
- ⊥ SIGN
- ⊕ TYPE II BARRICADE, DRUM, OR VERTICAL BARRICADE WITH MONODIRECTIONAL FLASHING LIGHT

GENERAL NOTE:

THIS STANDARD IS USED WHERE AT ANY TIME A LANE IS CLOSED ON A FREEWAY/EXPRESSWAY.

TO BE USED WHEN NO OVERNIGHT / LONG TERM LANE CLOSURE IS REQUIRED.

WHEN THE LEFT LANE IS CLOSED, LEFT LANE CLOSED SIGNS SHALL BE SUBSTITUTED FOR THE RIGHT LANE CLOSED SIGNS.


THE FIRST TWO SIGNS AND THE MESSAGE BOARD ARE STATIONARY. THE OTHER SIGNS AND ARROWBOARDS SHALL BE MOVED AS NECESSARY TO MAINTAIN THE REQUIRED DISTANCE FROM THE START OF THE LANE CLOSURE TAPER(S).

SEE SPECIAL PROVISIONS.

ALL DIMENSIONS ARE IN INCHES
UNLESS OTHERWISE SHOWN.

MODEL: T14000
FILE NAME: D:\BIBB\3-SHA-TCP 701400 Special.dgn


Hutchison Engineering, Inc. Jacksonville Moline Peoria Shorewood Since 1945				USER NAME = ncaahpian DESIGNED - DRAWN - CHECKED - PLOT DATE = 3/29/2021 DATE -				DESIGNED - DRAWN - CHECKED - DATE -				PLOT SCALE = 0.100000033" / ft. DATE -				STATE OF ILLINOIS DEPARTMENT OF TRANSPORTATION				TC&P STANDARD 701400 (SPECIAL)				SCALE: N.T.S. SHEET 1 OF 1 SHEETS STA. N/A TO STA. N/A				F.A.I. RTE. 57 SECTION 139 HBR-5 COUNTY KANKAKEE TOTAL SHEETS 202 SHEET NO. 68 CONTRACT NO. 66997 ILLINOIS FED. AID PROJECT			
--	--	--	--	--	--	--	--	--	--	--	--	---	--	--	--	---	--	--	--	--------------------------------	--	--	--	--	--	--	--	---	--	--	--

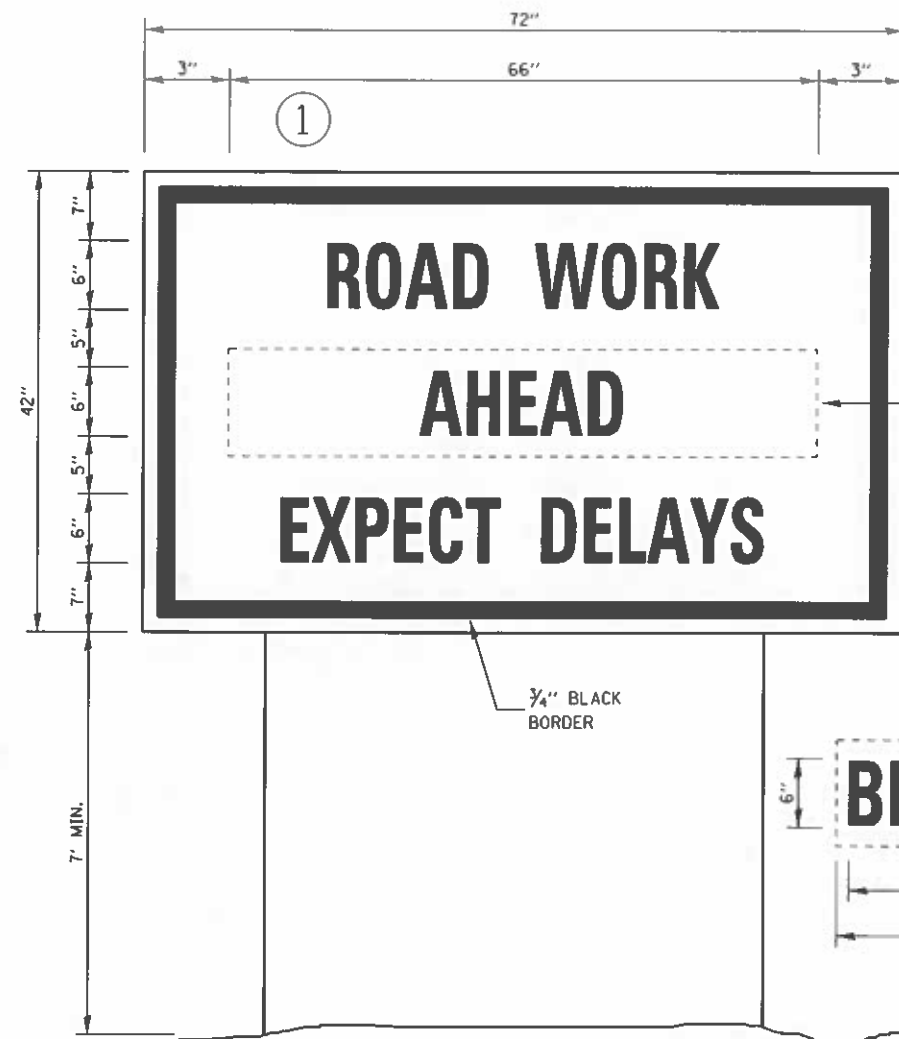



TEMPORARY INFORMATION SIGNING

NOTES:

1. USE 6" D BLACK LETTERING ON FLOURESENT ORANGE BACKGROUND.
2. ERECT SIGNS AT LOCATIONS IN ADVANCE OF THE "ROAD CONSTRUCTION AHEAD" SIGNS AS DIRECTED BY THE ENGINEER.
3. ERECT SIGN ① WITH INSTALLED PANEL ② A MINIMUM OF ONE WEEK PRIOR TO THE START OF THE LANE CLOSURE.
4. REMOVE PANEL ② ON THAT DATE.
5. SEE SPECIAL PROVISION "TEMPORARY INFORMATION SIGNING" FOR ADDITIONAL INFORMATION.
6. WILL BE PAID FOR PER SO FT AS "TEMPORARY INFORMATION SIGNING". EACH SIGN = 21 SO FT AND THE DATE PANEL ② WILL NOT BE MEASURED SEPARATELY FOR PAYMENT.

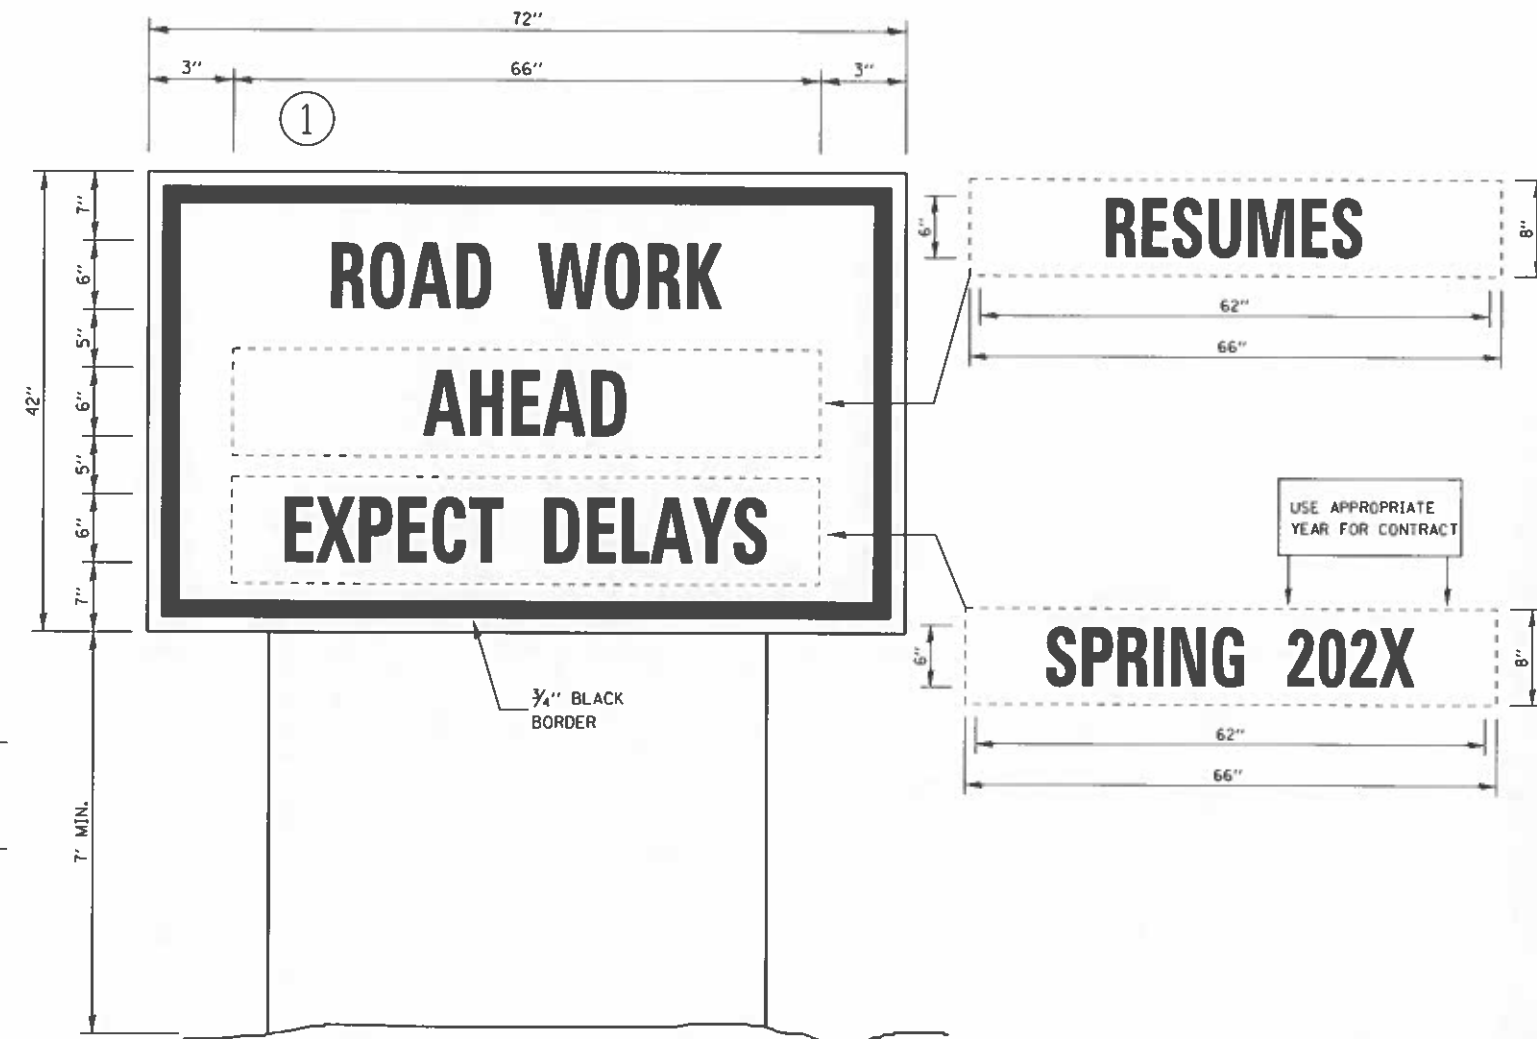

WINTER CLOSURE SIGNING

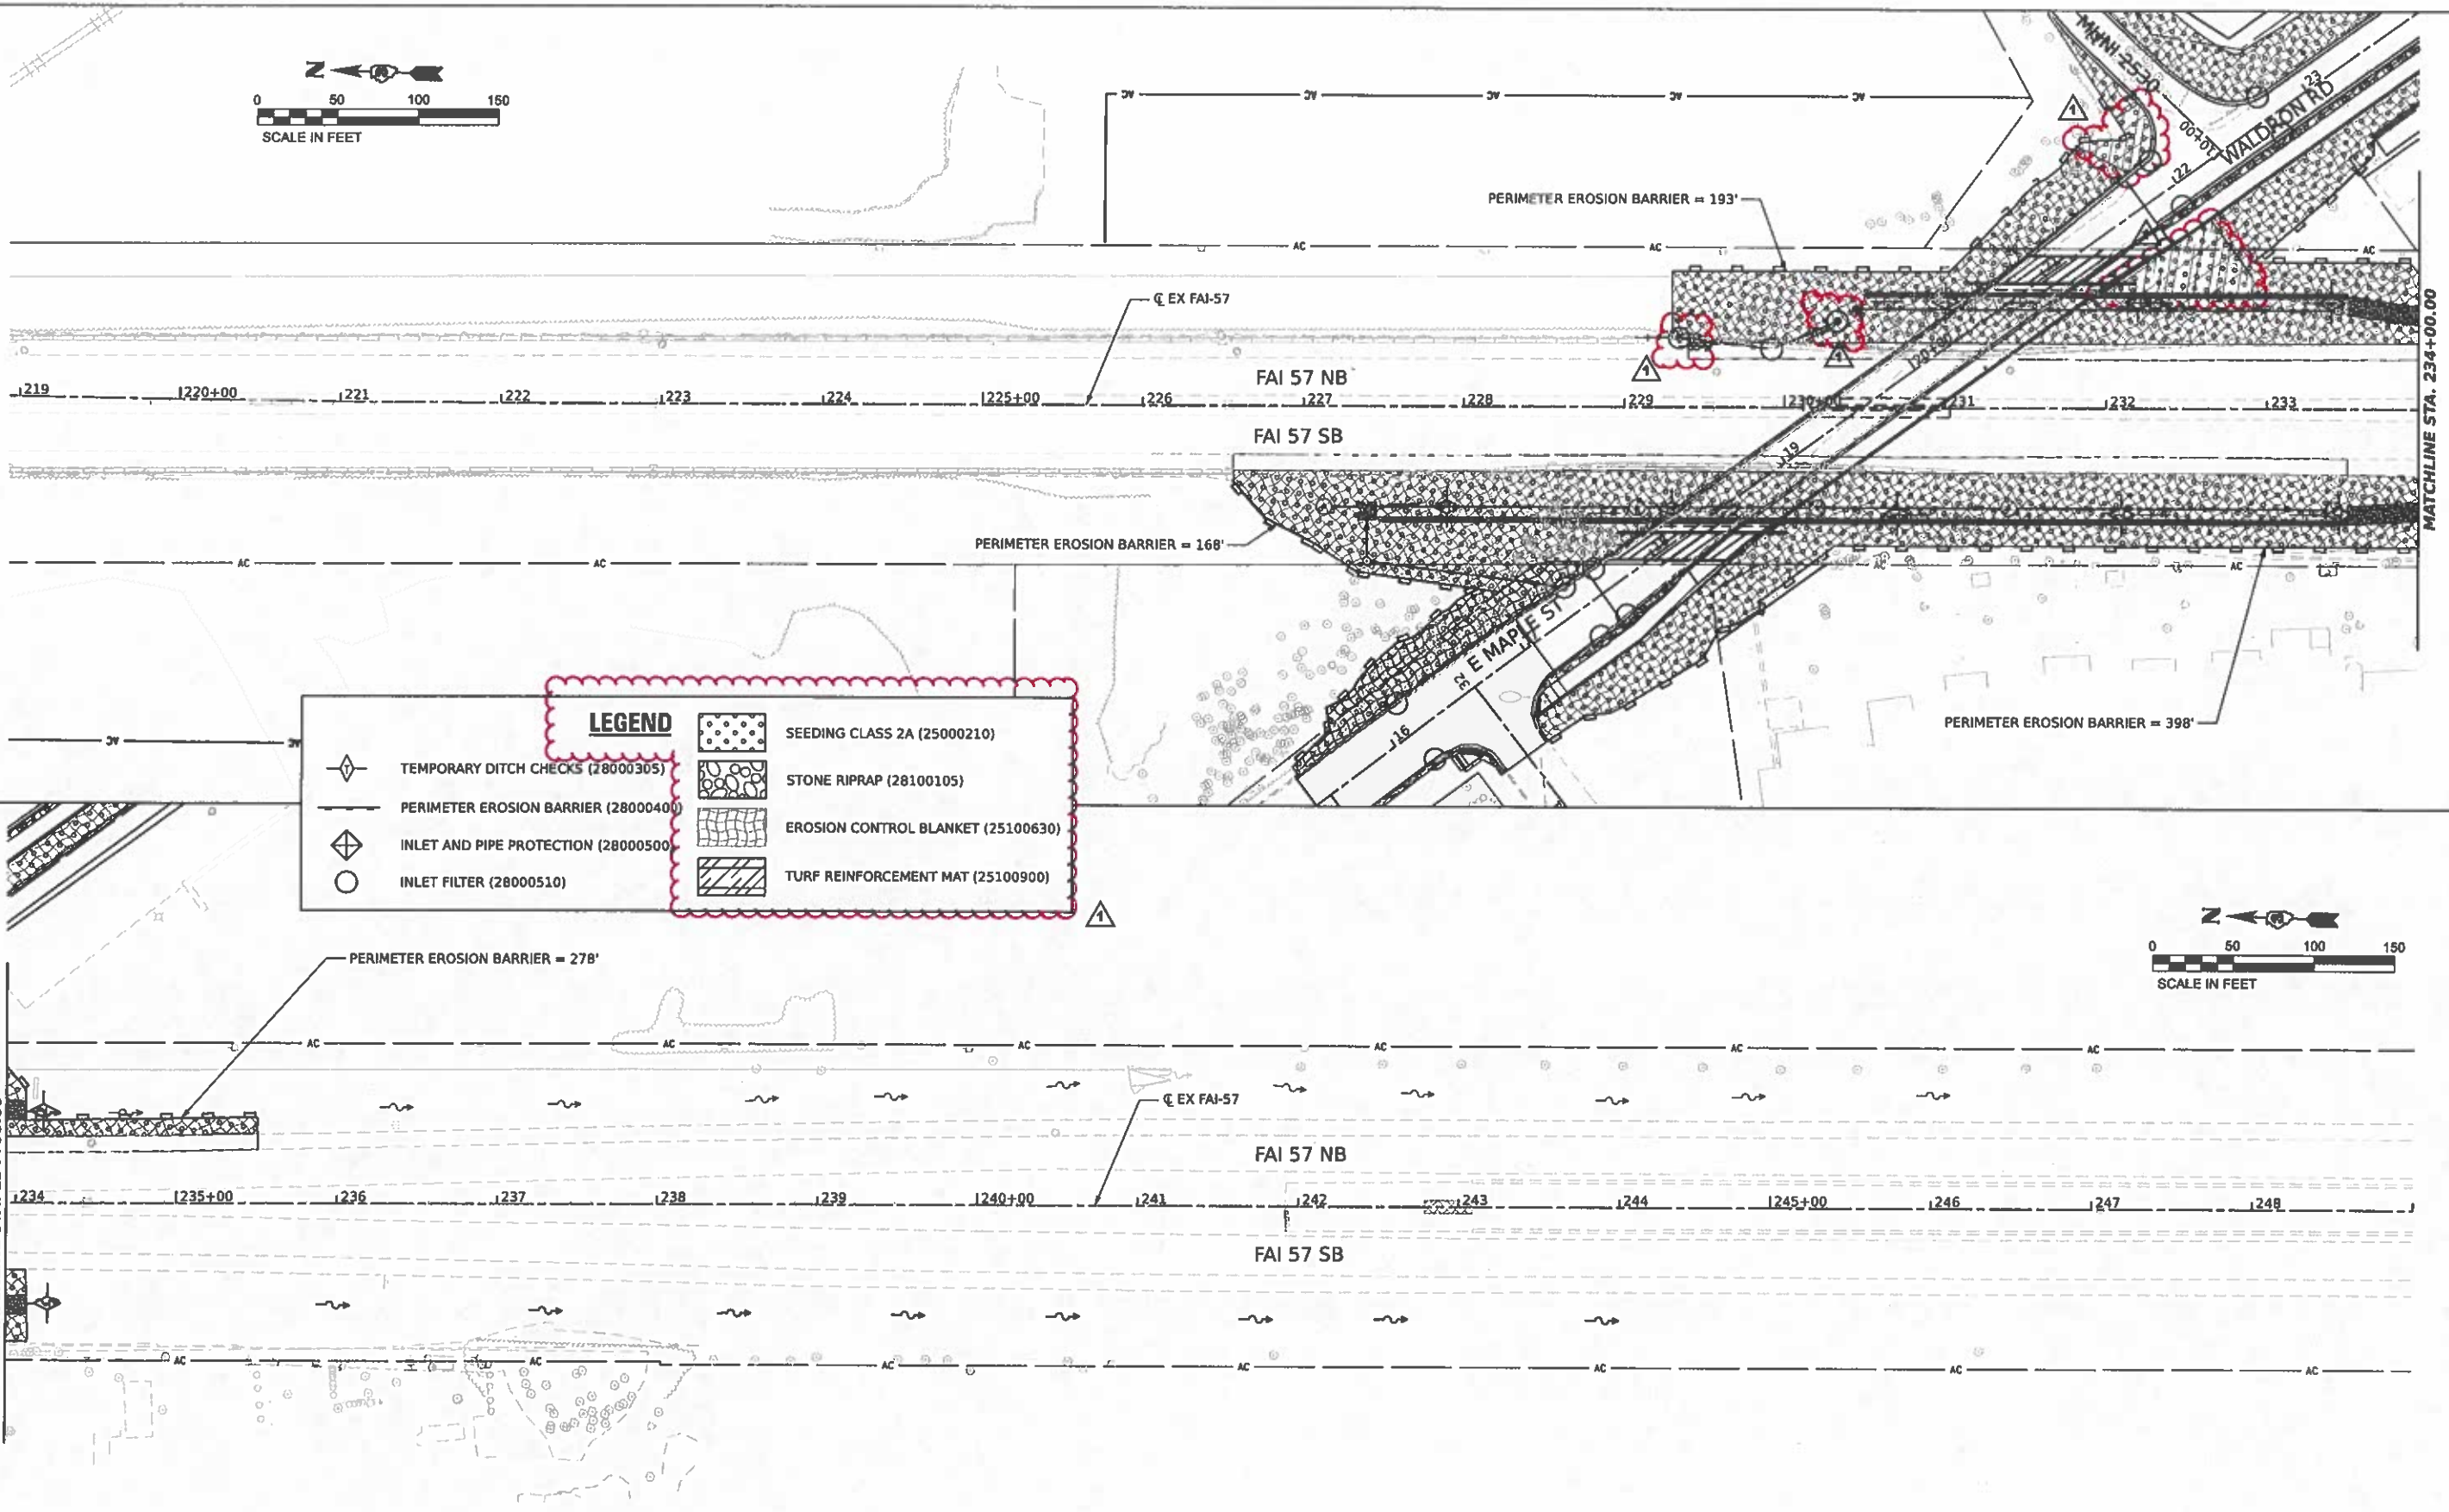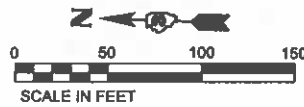

LEGEND

	TEMPORARY DITCH CHECKS (28000305)		SEEDING CLASS 2A (25000210)
	PERIMETER EROSION BARRIER (28000400)		STONE RIPRAP (28100105)
	INLET AND PIPE PROTECTION (28000500)		EROSION CONTROL BLANKET (25100630)
	INLET FILTER (28000510)		TURF REINFORCEMENT MAT (25100900)

MOORE, P. 1
FILE NAME: 120807-004-Erosion Control 1.dgn

Hutchinson Engineering, Inc.
Jacksonville Moline Peoria Shawnee
Since 1945


USER NAME = nashion	DESIGNED -	REVISED -
PLOT SCALE = 0.16666633' / in.	DRAWN -	REVISED -
PLOT DATE = 7/8/2021	CHECKED -	REVISED -
	DATE = 2021/03/26	REVISED -

**STATE OF ILLINOIS
DEPARTMENT OF TRANSPORTATION**

**FAI 57 & WALDRON ROAD
EROSION CONTROL PLAN**

SCALE: 1"=50' SHEET 1 OF 3 SHEETS STA. 219+00 TO STA. 249+00

F.A.I. RTE.	SECTION	COUNTY	TOTAL SHEETS	SHEET NO.
57	138 HBR-6	KANKAKEE	202	70
CONTRACT NO. 66997				
ILLINOIS FED. AID PROJECT				

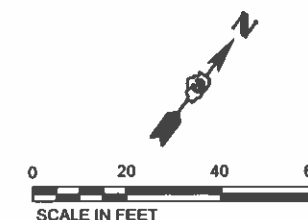

LEGEND

SYMBOLS	EXISTING	PROPOSED
REFERENCE LINE/CENTERLINE AND STATIONING		
RIGHT OF WAY LINE		
INTERPRETED DRAINAGE AREA		
SWALE		
DITCH		
OUTLET		
STORM SEWER		
FLARED END SECTION		
CATCH BASIN		
INLET		
MANHOLE		
NICOR GAS MAIN		
AERIAL LINES		
WATERMAIN		
STRUCTURE NO.		1-01
PIPE NO.		1-01

MODEL: Plan 1
FILE NAME: D:\20207_DRAINAGE_LEGENO_SHEET.dgn

TranSmart
411 South Wells Street Suite 1000
Chicago, Illinois 60607

USER NAME	= msalehian
PLOT SCALE	= 0.1000000033 1/16
PLOT DATE	= 3/28/2021

DESIGNED	= AKC
DRAWN	= AKC
CHECKED	= PKT
DATE	= 2021/03/26



REVISED	=
REVISED	=
REVISED	=
REVISED	=

STATE OF ILLINOIS
DEPARTMENT OF TRANSPORTATION

DRAINAGE LEGEND


SCALE: NTS SHEET 1 OF 1 SHEETS STA. TO STA.

F.A.L RTE	SECTION	COUNTY	TOTAL SHEETS	SHEET NO.
57	J39 HBR-6	KANKAKEE	202	73
CONTRACT NO. 66863				
ILLINOIS FED. AID PROJECT				

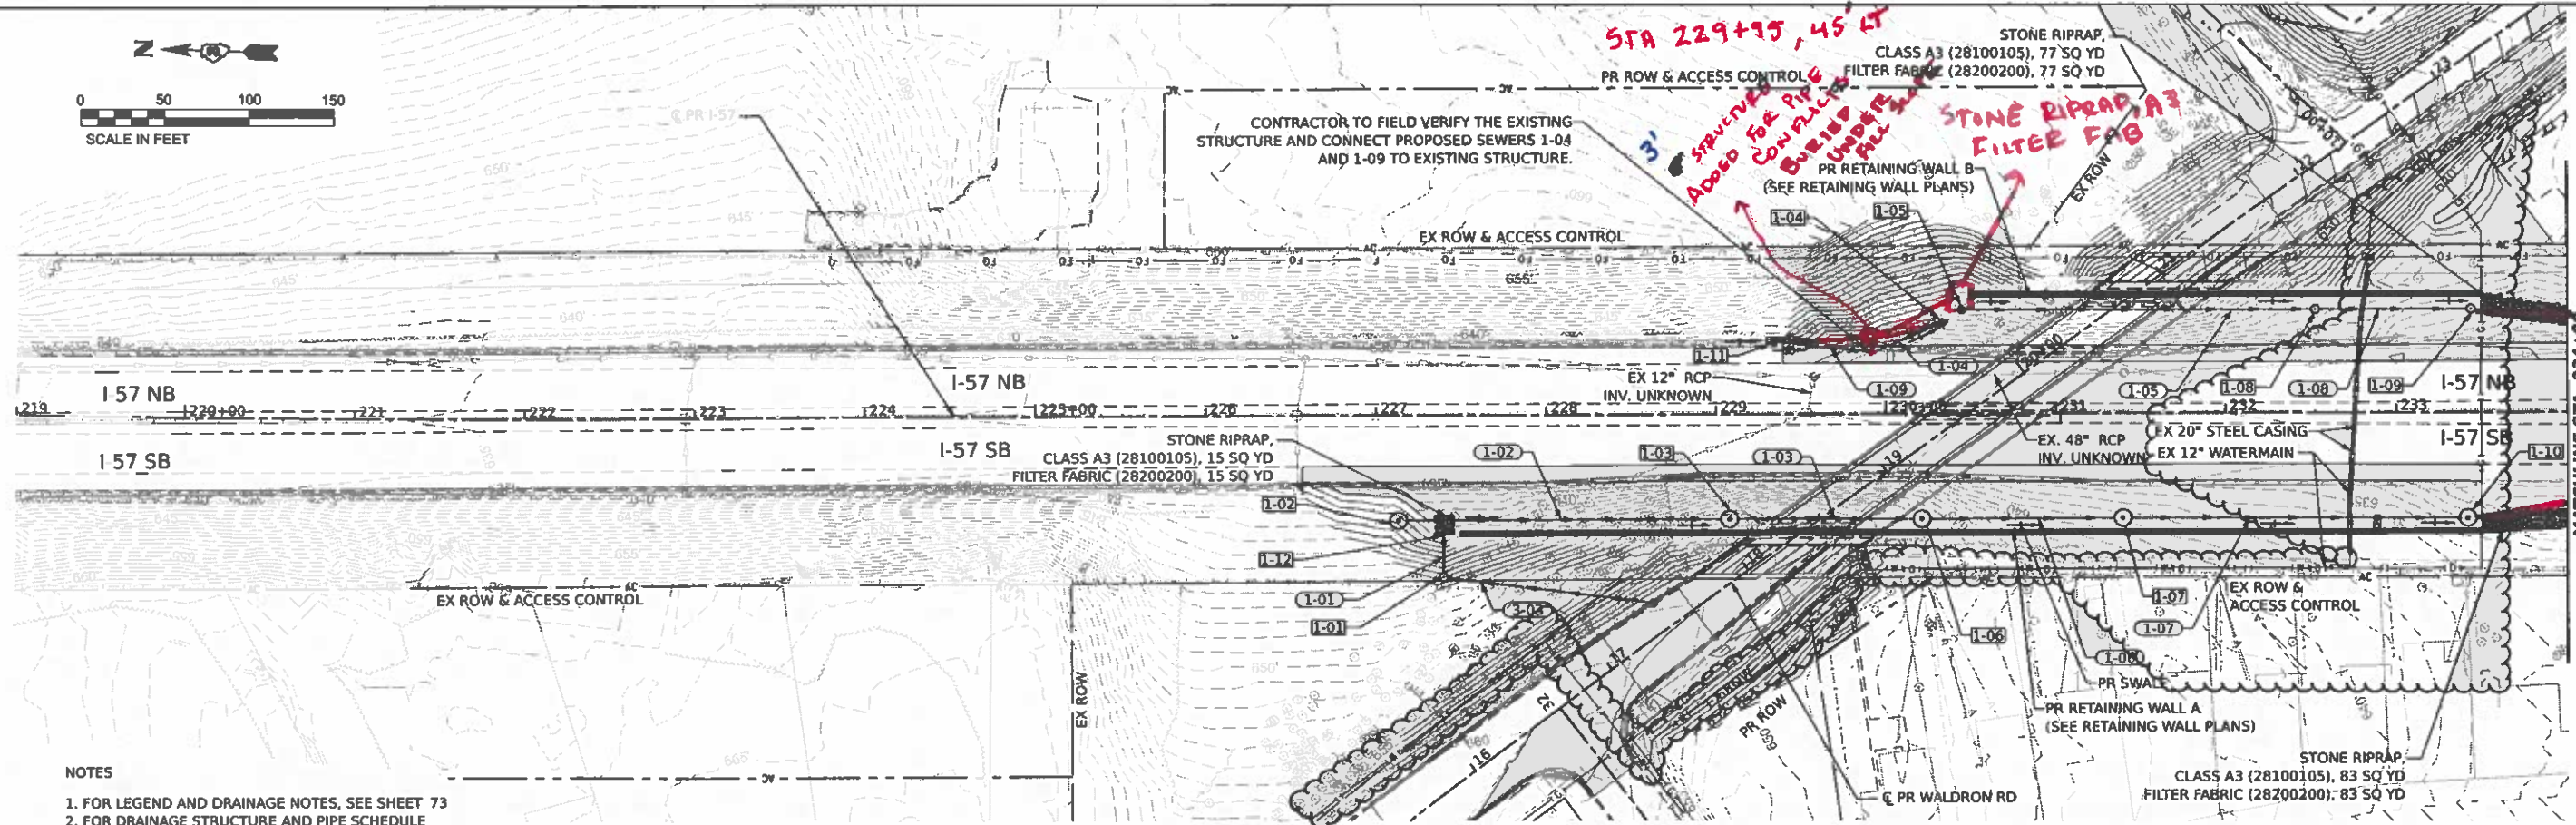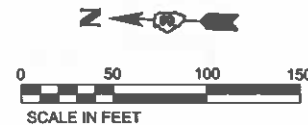

NOTES

1. FOR LEGEND AND DRAINAGE NOTES, SEE SHEET 73
2. FOR DRAINAGE STRUCTURE AND PIPE SCHEDULE SEE SHEETS 27 and 28
3. EXISTING UNDERDRAIN LOCATIONS ARE BASED ON THE BEST INFORMATION AVAILABLE. CONTRACTOR SHALL MAINTAIN EXISTING UNDERDRAIN SYSTEM IN WORKING CONDITION. ANY DAMAGE TO THE EXISTING UNDERDRAINS TO REMAIN AS A RESULT OF HIS/HER OPERATIONS SHALL BE REPAIRED TO THE ENGINEER'S SATISFACTION AT THE CONTRACTOR'S EXPENSE
4. THE EXISTING WATER MAIN LOCATION AND DEPTH ARE APPROXIMATE AS PER BEST INFORMATION AVAILABLE AND TO BE FIELD VERIFIED. CONTRACTOR TO CONFIRM THAT THE PROPOSED STORM SEWER AND WATER MAIN HORIZONTAL AND VERTICAL CLEARANCE REQUIREMENTS ARE MET AS PER IEPA. CONTRACTOR TO AVOID DAMAGE TO EXISTING WATER MAIN LINE.

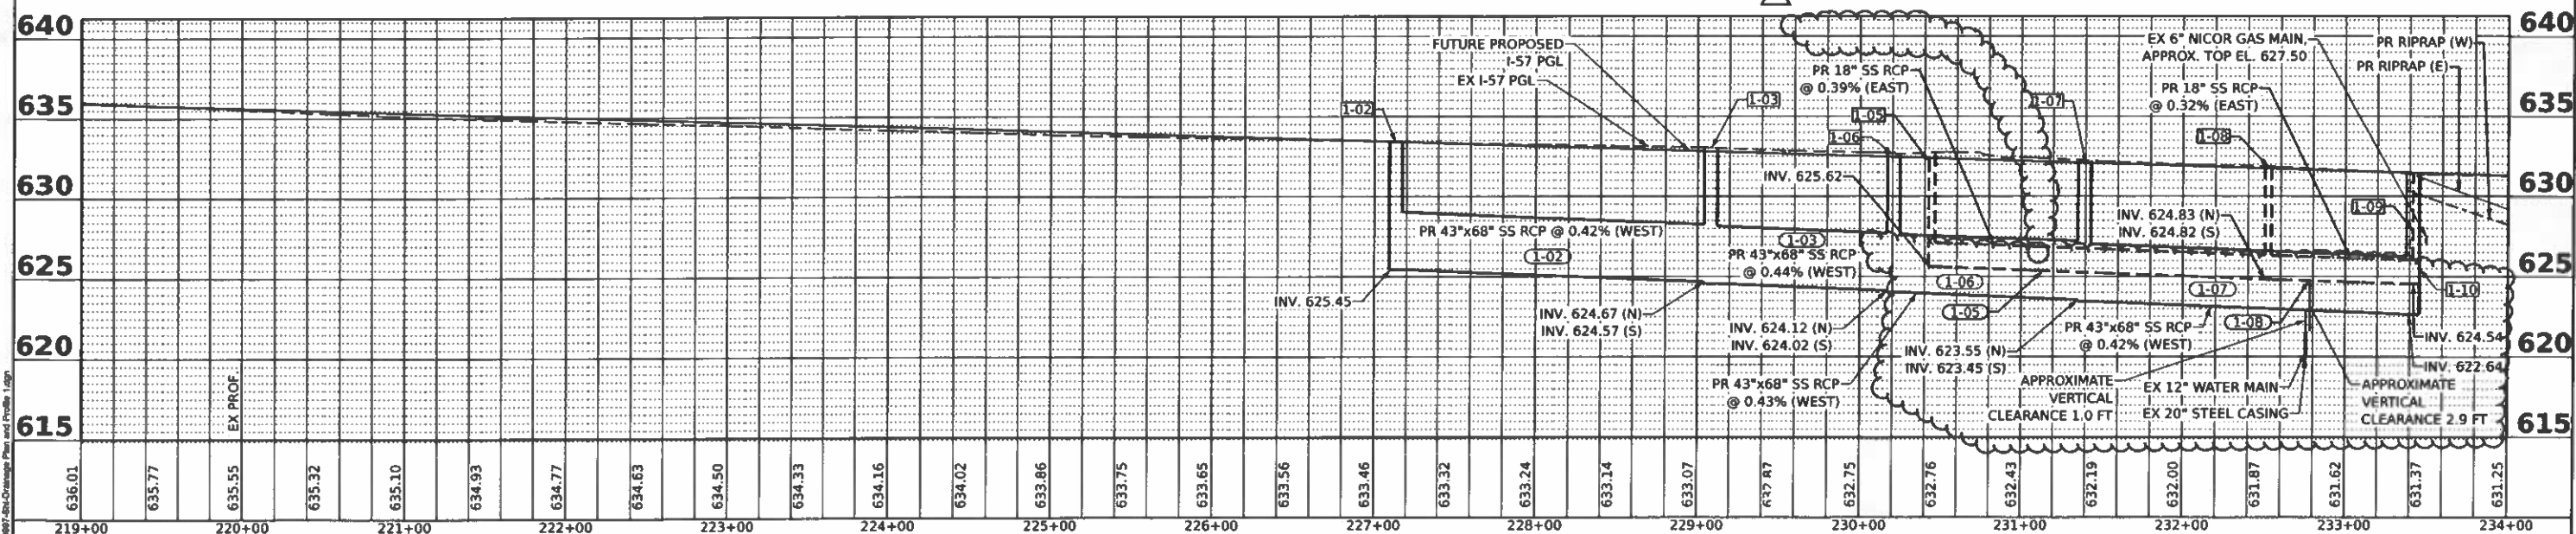

MODEL: Plan 1
FILE NAME: D000007-Box Drainage Plan and Profile 1.dgn

TranSmart
411 South Wells Street Suite 1000
Chicago, Illinois 60607

USER NAME = jmk
PLOT SCALE = 0.10000033 1/in.
PLOT DATE = 7/8/2021

DESIGNED - AKC
DRAWN - AKC
CHECKED - PKT
DATE - 2021/03/26


REVISED -
REVISED -
REVISED -
REVISED -

STATE OF ILLINOIS
DEPARTMENT OF TRANSPORTATION


DRAINAGE PLAN AND PROFILE
ILLINOIS ROUTE 57

SCALE: 1" = 50' SHEET 1 OF 5 SHEETS STA. TO STA.


F.A.I. RTE.	SECTION	COUNTY	TOTAL SHEETS	SHEET NO.
57	139 HBR-6	KANKAKEE	202	74
CONTRACT NO. 66997				
ILLINOIS FED. AID PROJECT				

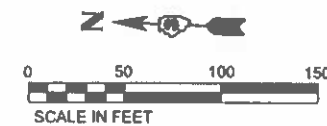

MATCHLINE STA. 234+00

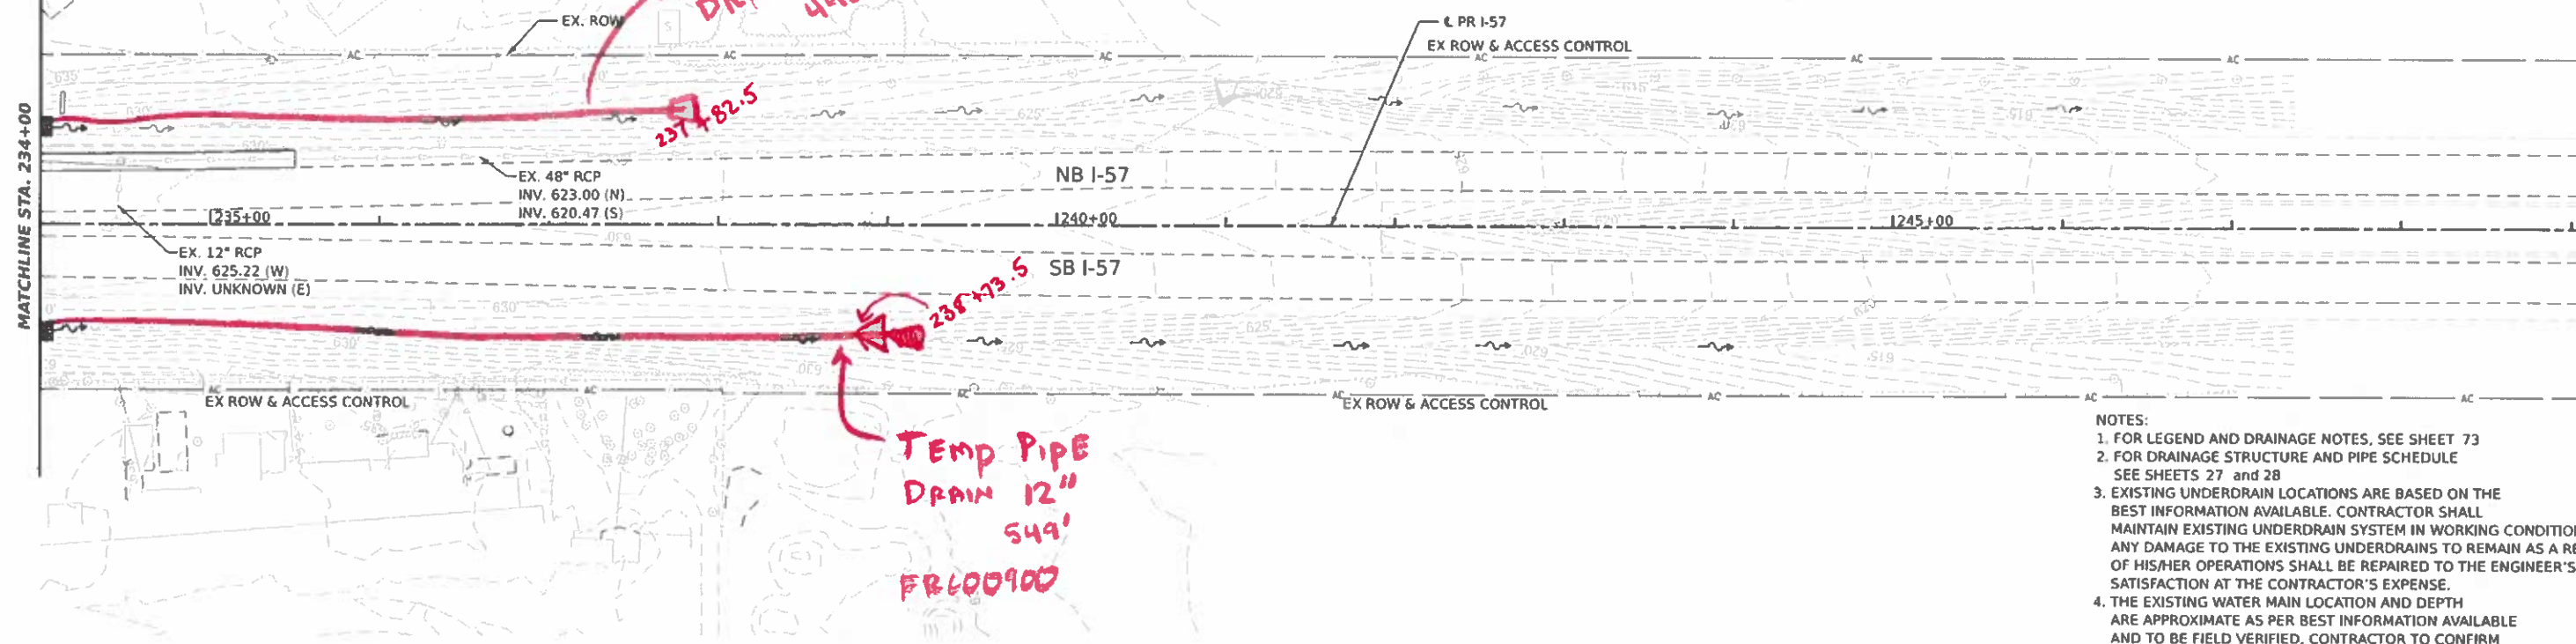

- NOTES:
1. FOR LEGEND AND DRAINAGE NOTES, SEE SHEET 73
 2. FOR DRAINAGE STRUCTURE AND PIPE SCHEDULE SEE SHEETS 27 and 28
 3. EXISTING UNDERDRAIN LOCATIONS ARE BASED ON THE BEST INFORMATION AVAILABLE. CONTRACTOR SHALL MAINTAIN EXISTING UNDERDRAIN SYSTEM IN WORKING CONDITION. ANY DAMAGE TO THE EXISTING UNDERDRAINS TO REMAIN AS A RESULT OF HIS/HER OPERATIONS SHALL BE REPAIRED TO THE ENGINEER'S SATISFACTION AT THE CONTRACTOR'S EXPENSE.
 4. THE EXISTING WATER MAIN LOCATION AND DEPTH ARE APPROXIMATE AS PER BEST INFORMATION AVAILABLE AND TO BE FIELD VERIFIED. CONTRACTOR TO CONFIRM THAT THE PROPOSED STORM SEWER AND WATER MAIN HORIZONTAL AND VERTICAL CLEARANCE REQUIREMENTS ARE MET AS PER IEPA.

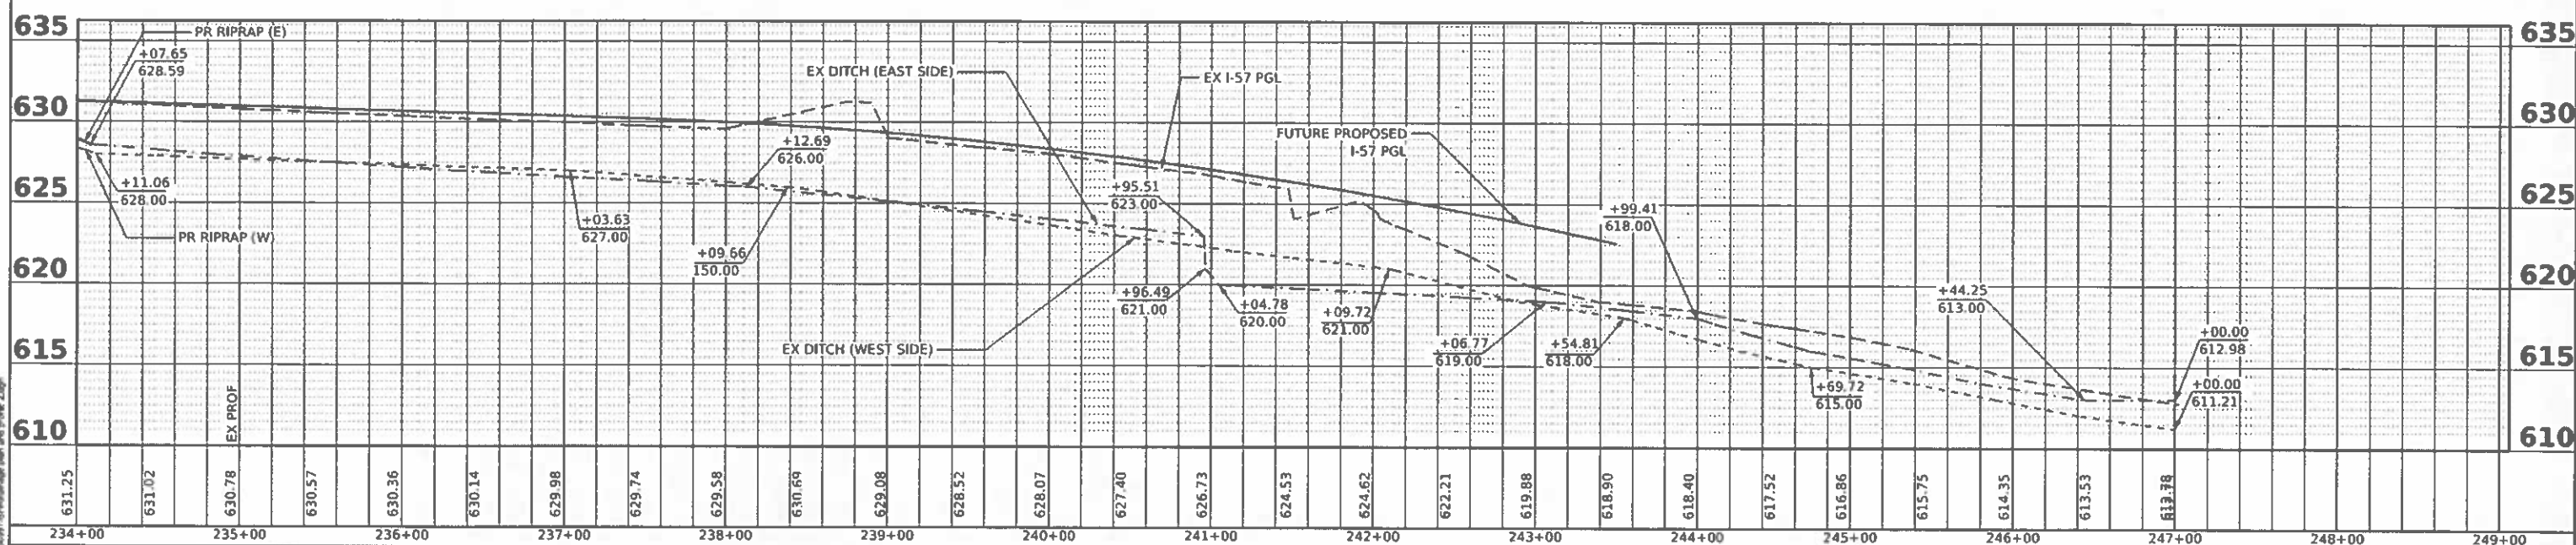

MODEL: Plan 2
FILE NAME: D:\2021\Illinois Route 57\Drawings\Sheet 2.dwg

TranSmart
411 South Wells Street Suite 1000
Chicago, Illinois 60607

USER NAME	AKC
DESIGNED	AKC
DRAWN	AKC
CHECKED	PKT
DATE	2021/03/26




REVISION	
REVISION	
REVISION	
REVISION	

STATE OF ILLINOIS
DEPARTMENT OF TRANSPORTATION

DRAINAGE PLAN AND PROFILE
ILLINOIS ROUTE 57

SCALE: 1" = 50' SHEET 2 OF 5 SHEETS STA. TO STA.

F.A.I. RTE.	SECTION	COUNTY	TOTAL SHEETS	SHEET NO.
57	139 HBR-6	KANKAKEE	202	75
CONTRACT NO. 66997				

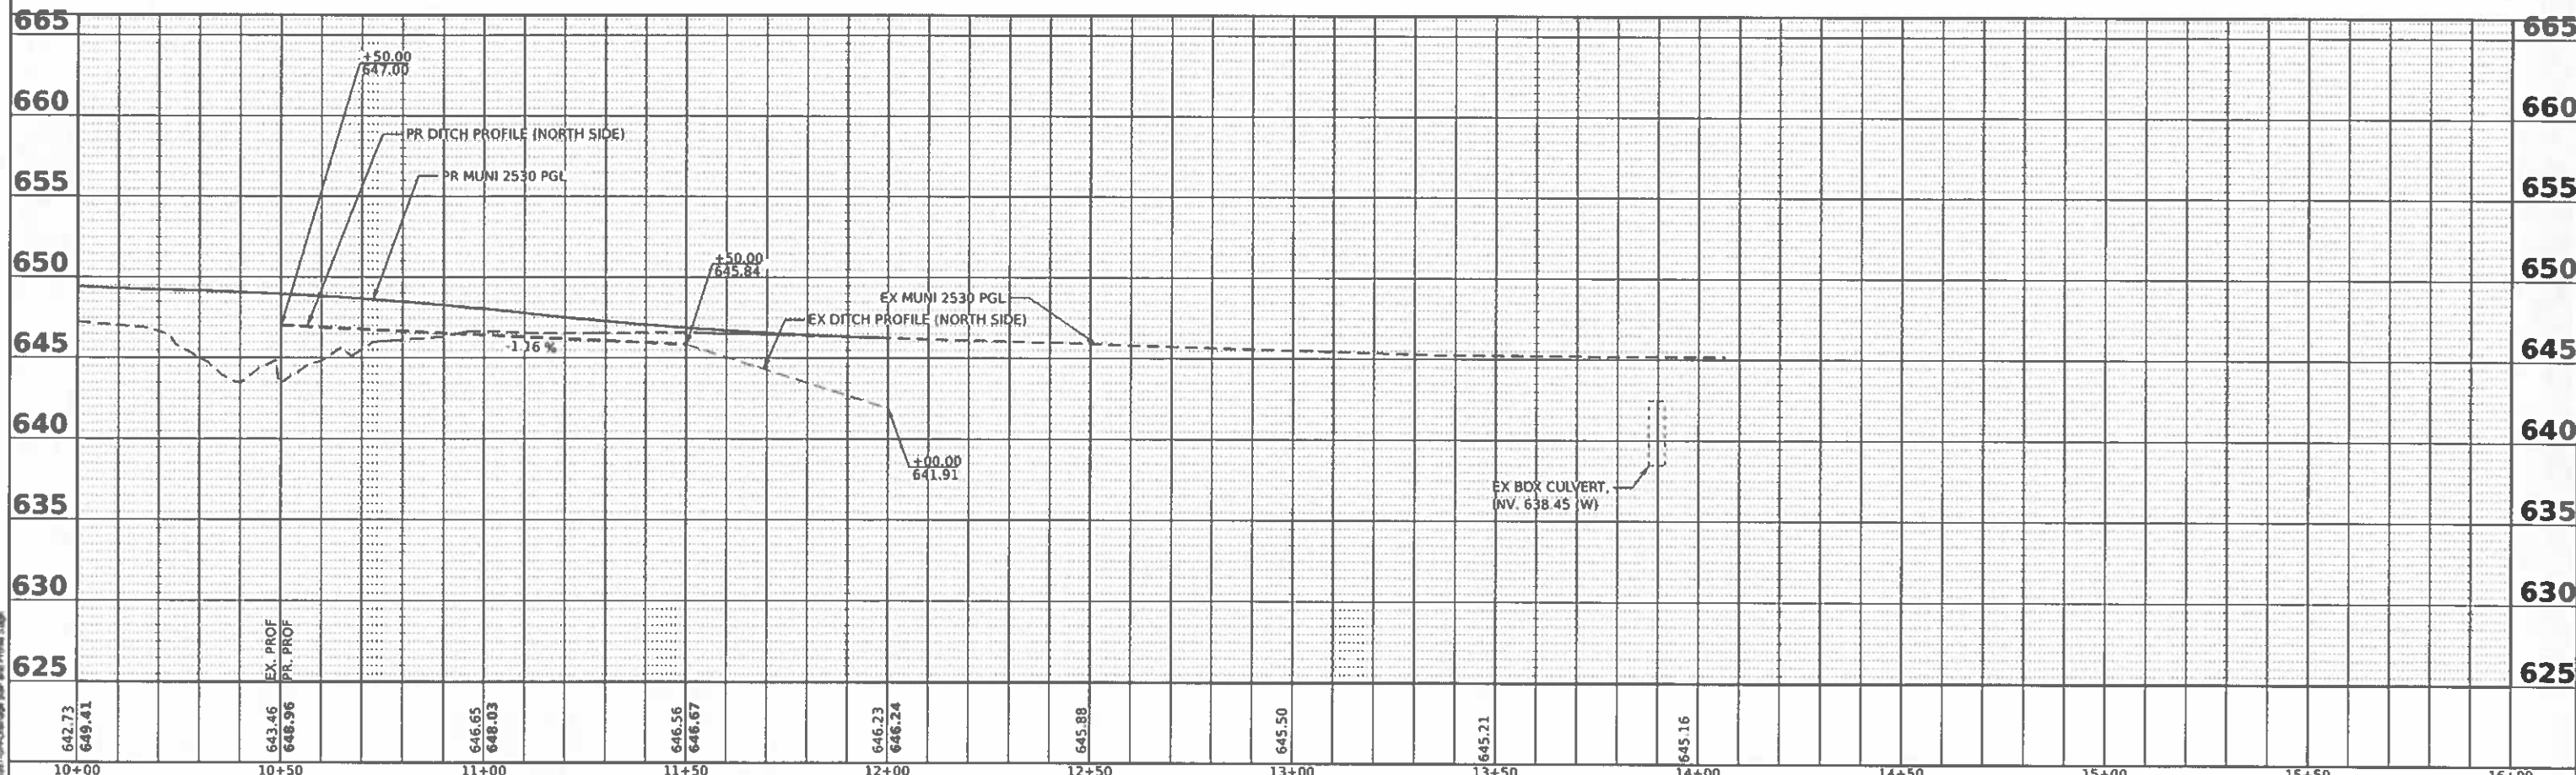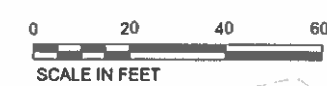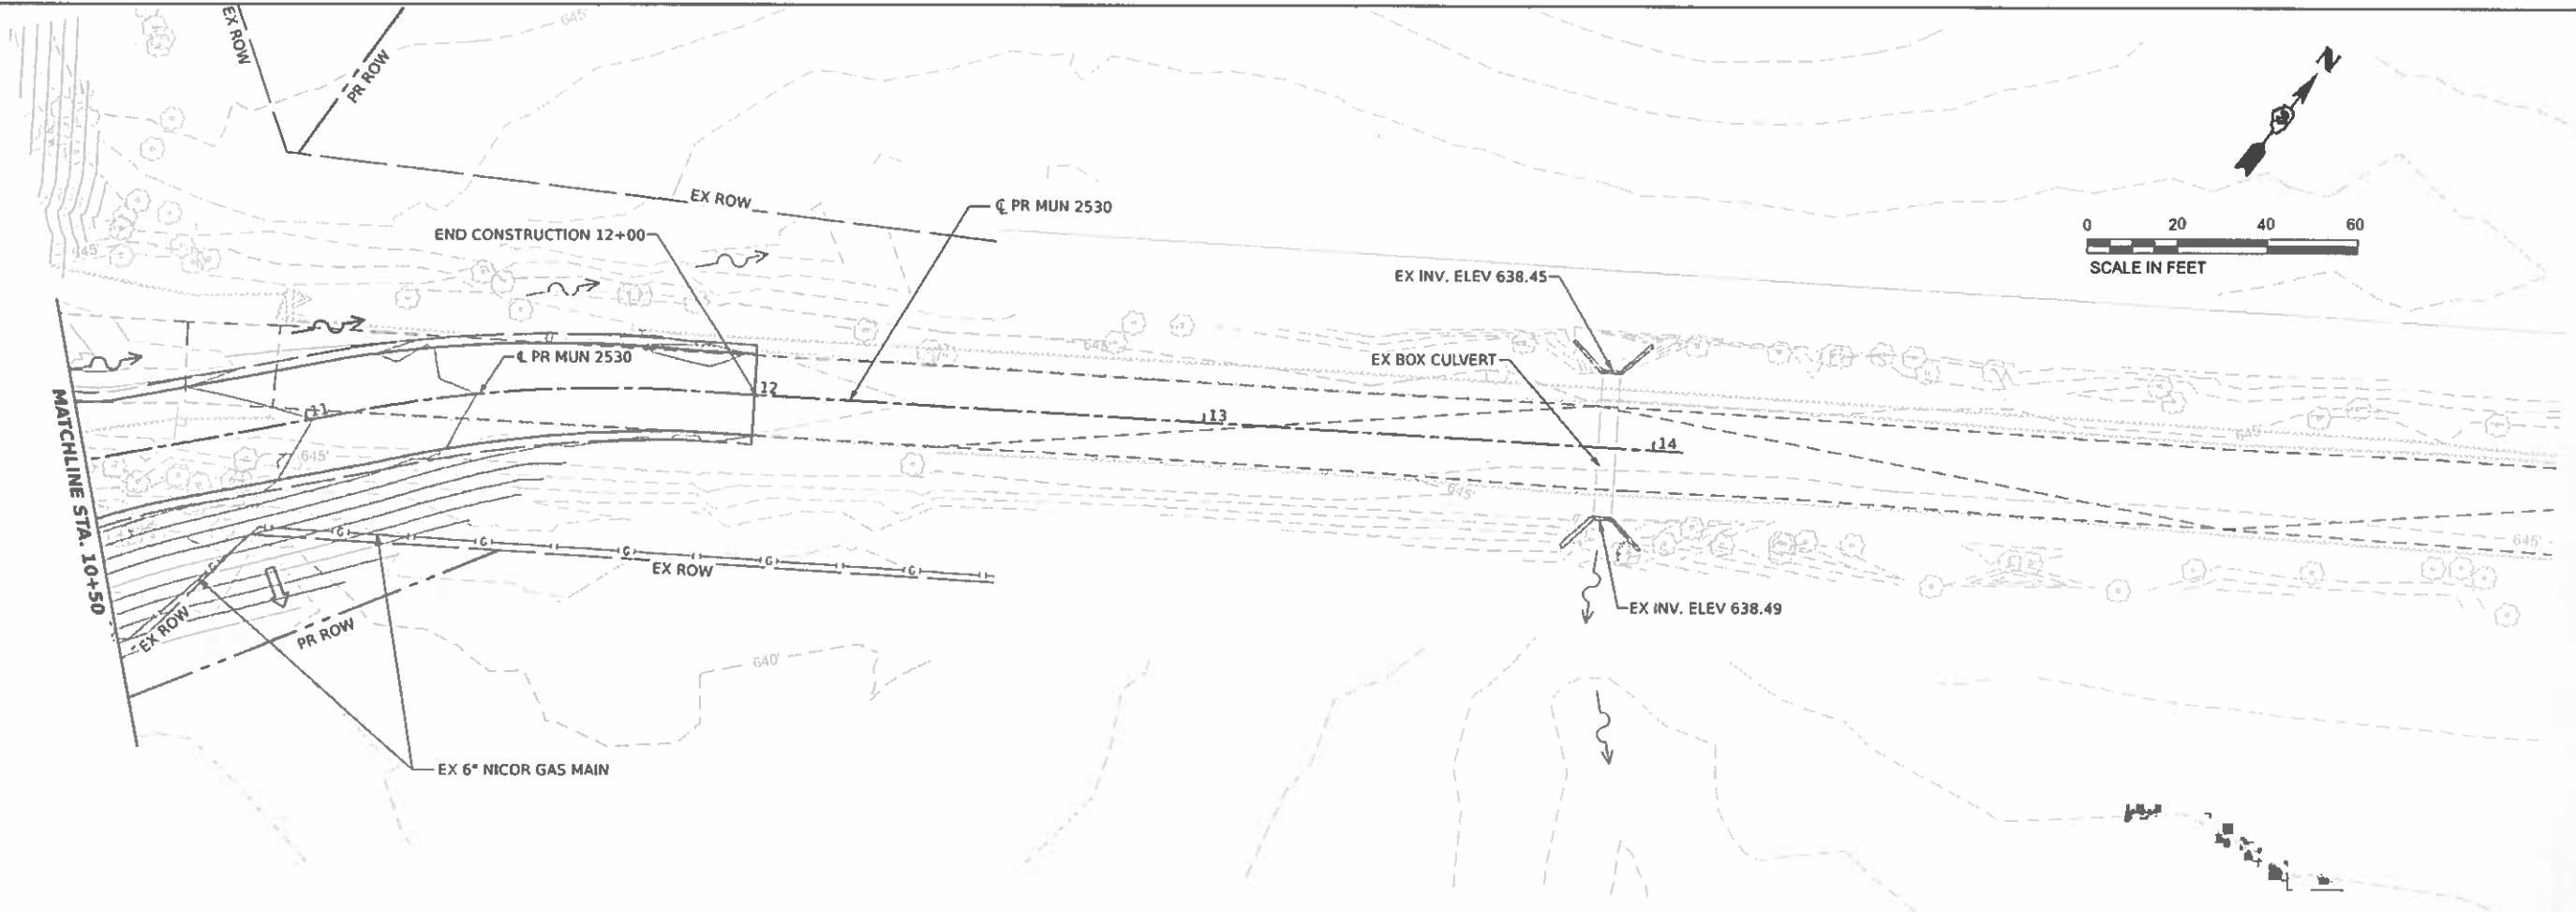

MODEL: Plan 5
FILE NAME: D:\PROJECTS\2021\103\26\10326.dwg


TronSmart
411 South Wells Street Suite 1000
Chicago, Illinois 60607

USER NAME	AKC	DESIGNED	AKC	REVISED	
PLOT SCALE	0.10000000 / in.	DRAWN	AKC	REVISED	
PLOT DATE	3/28/2021	CHECKED	PKT	REVISED	
		DATE	2021/03/26	REVISED	

STATE OF ILLINOIS
DEPARTMENT OF TRANSPORTATION

DRAINAGE PLAN AND PROFILE MUNICIPAL ROAD 2530			
SCALE: 1" = 20'	SHEET 5	OF 5 SHEETS	STA. TO STA.

F.A.I. RTE	SECTION	COUNTY	TOTAL SHEETS	SHEET NO.
57	139 HBR-6	KANKAKEE	202	78
CONTRACT NO. 66997				
ILLINOIS FED. AID PROJECT				

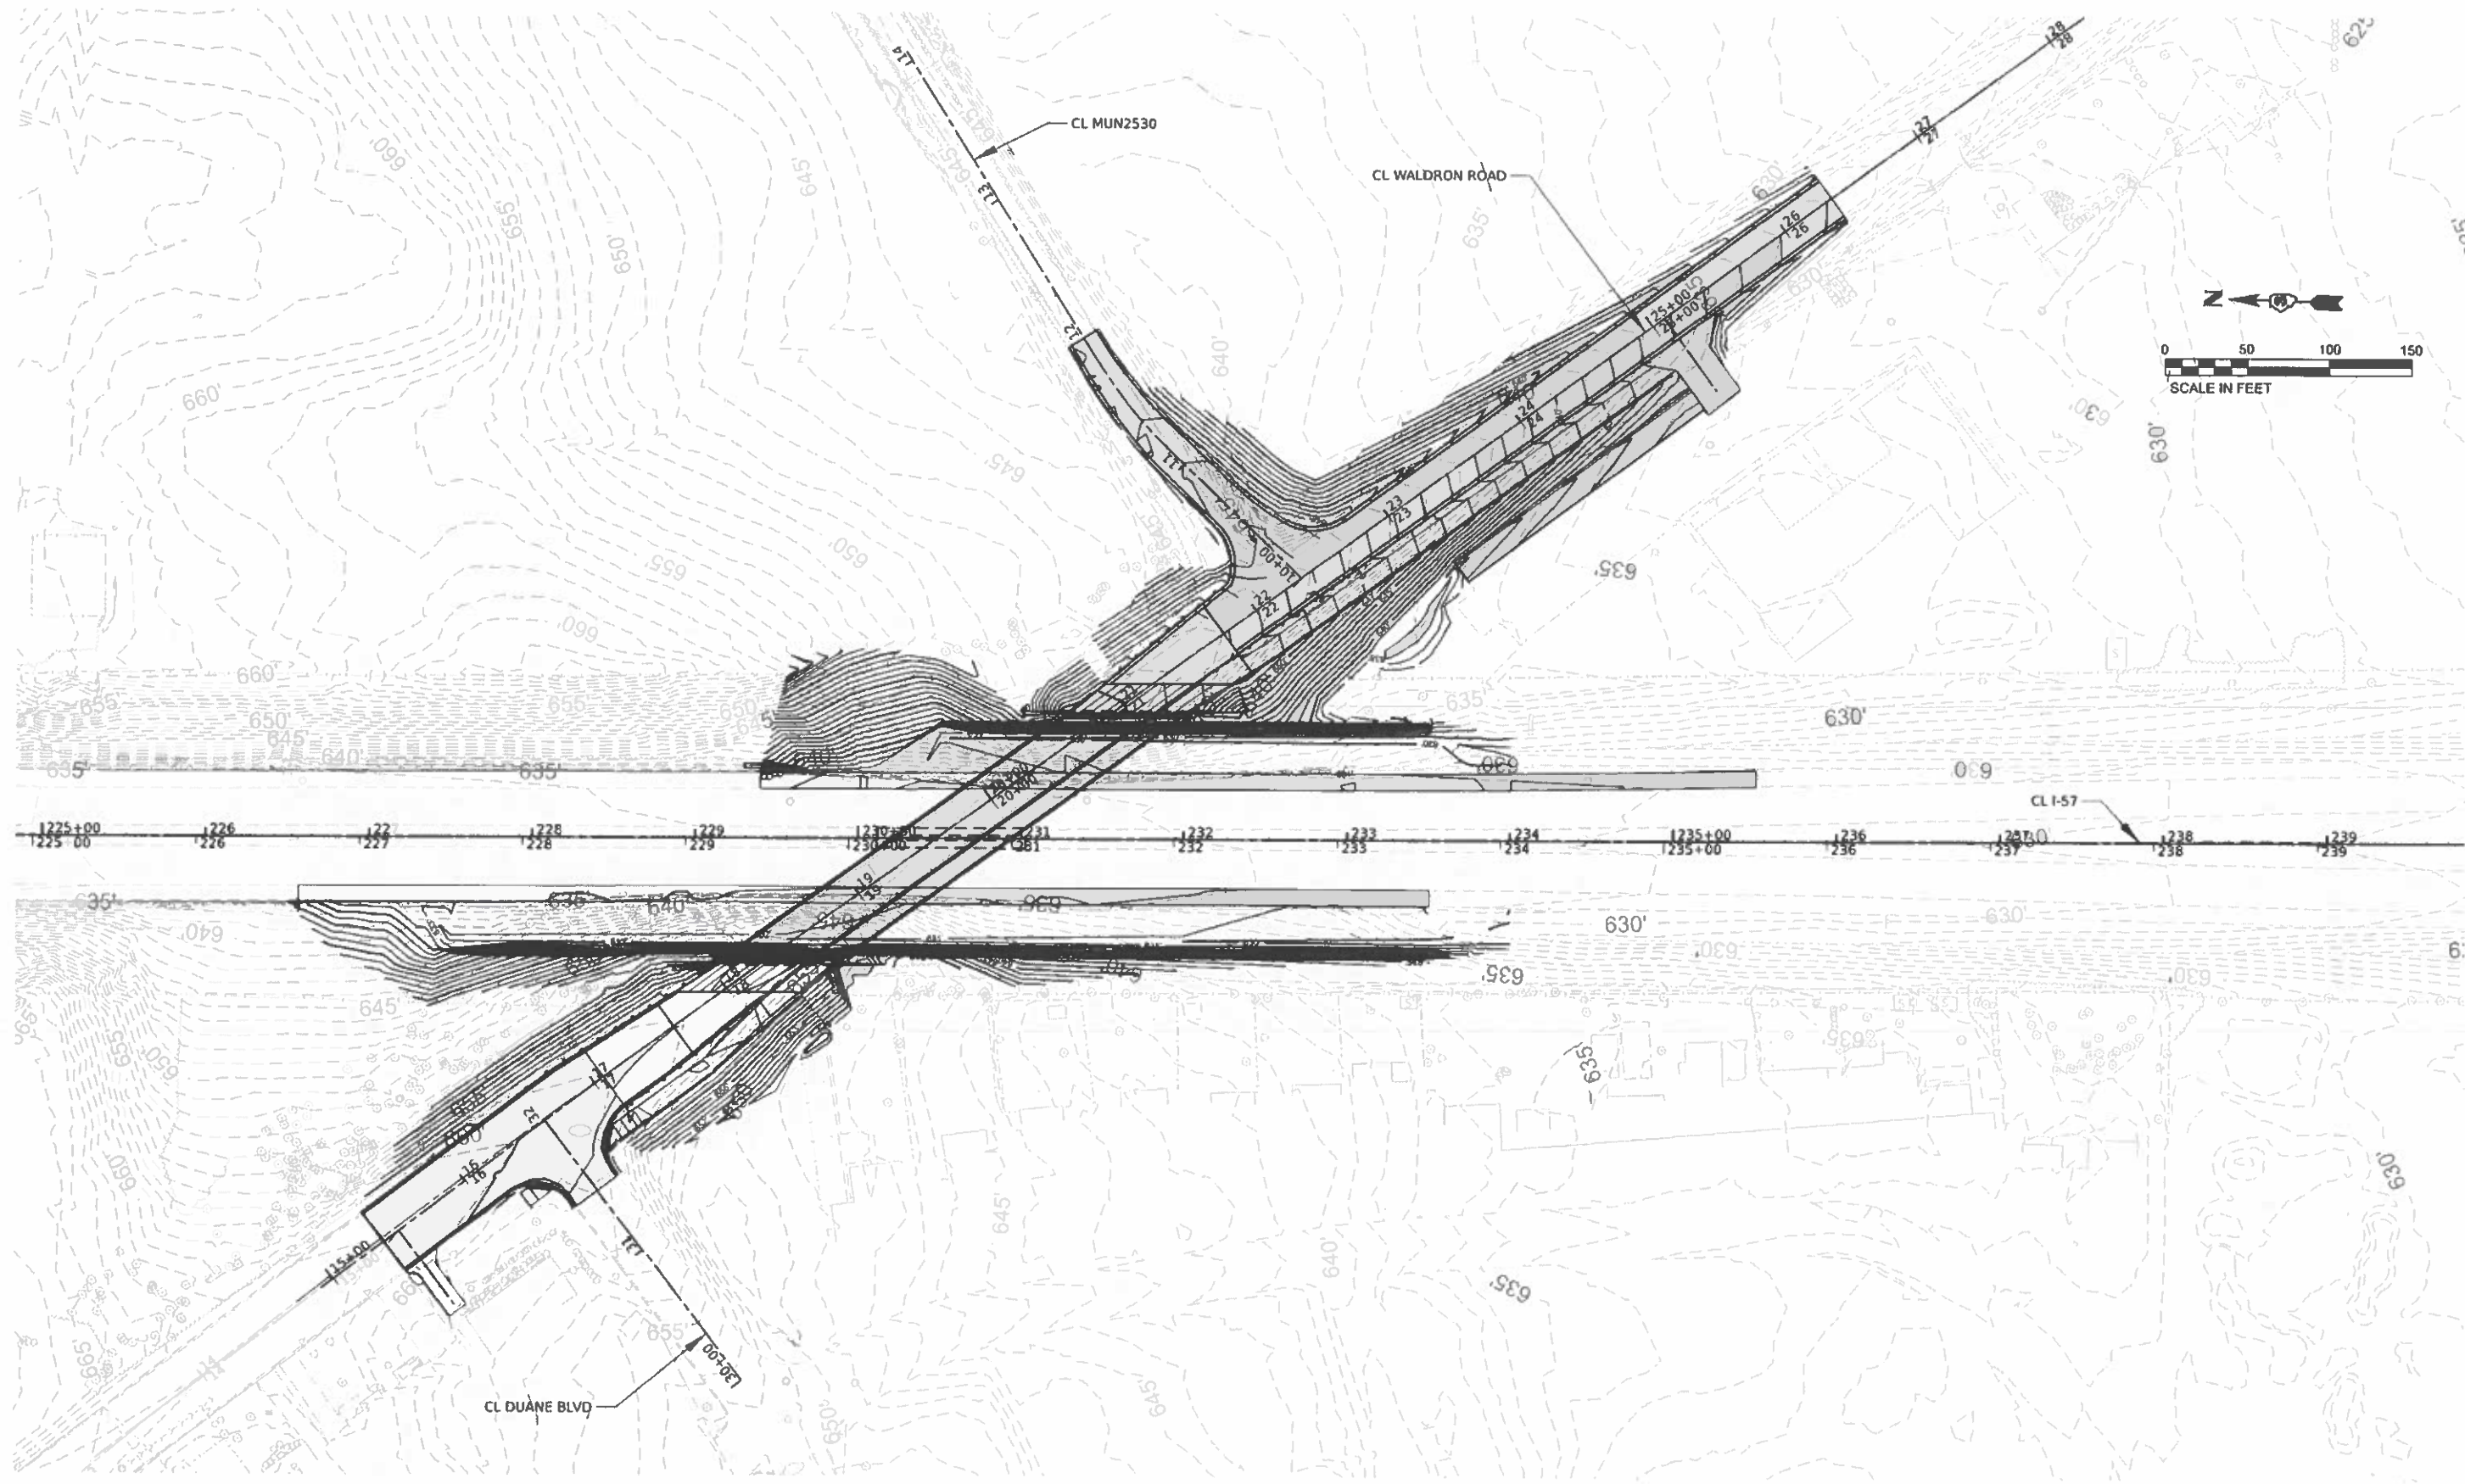

MODEL: Plan 1
FILE NAME: 66997-314-Grading.dgn

TransSmart
411 South Wells Street Suite 1000
Chicago, Illinois 60607

USER NAME	Waldron	DESIGNED	BJD	REVISED	5/5/2021
PLOT SCALE	0.1888833" = 1'	DRAWN	BJD	REVISED	-
PLOT DATE	3/29/2021	CHECKED	TW	REVISED	-
		DATE	2021/03/26	REVISED	-

STATE OF ILLINOIS
DEPARTMENT OF TRANSPORTATION

I-57 & WALDRON ROAD
GRADING PLAN

SCALE 1" = 50' SHEET 1 OF 1 SHEETS STA. TO STA.


F.A.I. RTE.	SECTION	COUNTY	TOTAL SHEETS	SHEET NO.
57	139 HBR-6	KANKAKEE	202	79
CONTRACT NO. 66997				
ILLINOIS FED. AID PROJECT				

STATE OF ILLINOIS
DEPARTMENT OF TRANSPORTATION
DIVISION OF HIGHWAYS

PLAT OF HIGHWAYS

F.A.I. 57 (I-57) AT WALDRON ROAD
SECTION: 139HBR-6
KANKAKEE COUNTY
JOB NO. : R-93-005-20

PARCEL NUMBER	PARCEL INDEX NUMBER	OWNER	SHEET NUMBER	PROPERTY ACQUIRED BY
		COVER SHEET	1	
		ALIGNMENT SHEET	2	
3AAL001	16-17-04-411-004	SAAD L. LABAN AND MONA N. LABAN, AS JOINT TENANTS	3	
3AAL002	16-07-04-413-005	SAAD L. LABAN AND MONA N. LABAN, AS JOINT TENANTS	4	
3AAL003TE	16-17-04-412-002	FAITH REFORMED CHURCH	4	
3AAL004	16-17-04-409-002	KATIE J. GLASS, A DIVORCED PERSON NOT SINCE REMARRIED	3	
3AAL005	16-17-04-409-001	MP PROPERTIES OF KANKAKEE, LLC, AN ILLINOIS LIMITED LIABILITY COMPANY	3	
3AAL006	16-17-04-403-047	NICHOLAS R. DUSENBURY	3	

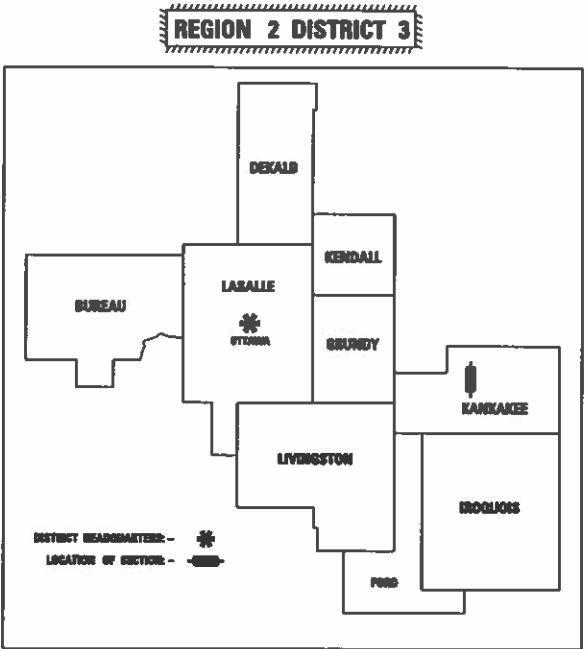


LEGEND

U.S. GOVERNMENT SECTION LINE
U.S. GOVERNMENT QUARTER SECTION LINE
PROPERTY (DEED) LINE
EXISTING CENTERLINE
EXISTING RIGHT OF WAY LINE
PROPOSED RIGHT OF WAY LINE
TEMPORARY EASEMENT

SECTION CORNER

IRON PIPE OR ROD FOUND
BRASS PLAQUE FOUND
FIRE HYDRANT
SIGN
UTILITY PEDESTAL
INLET
CENTERLINE
SET 5/8" RB


RIGHT-OF-WAY MARKER FOUND
SURVEY NAIL FOUND
GUY WIRE
WATER VALVE
UTILITY POLE
MANHOLE
PROPERTY LINE

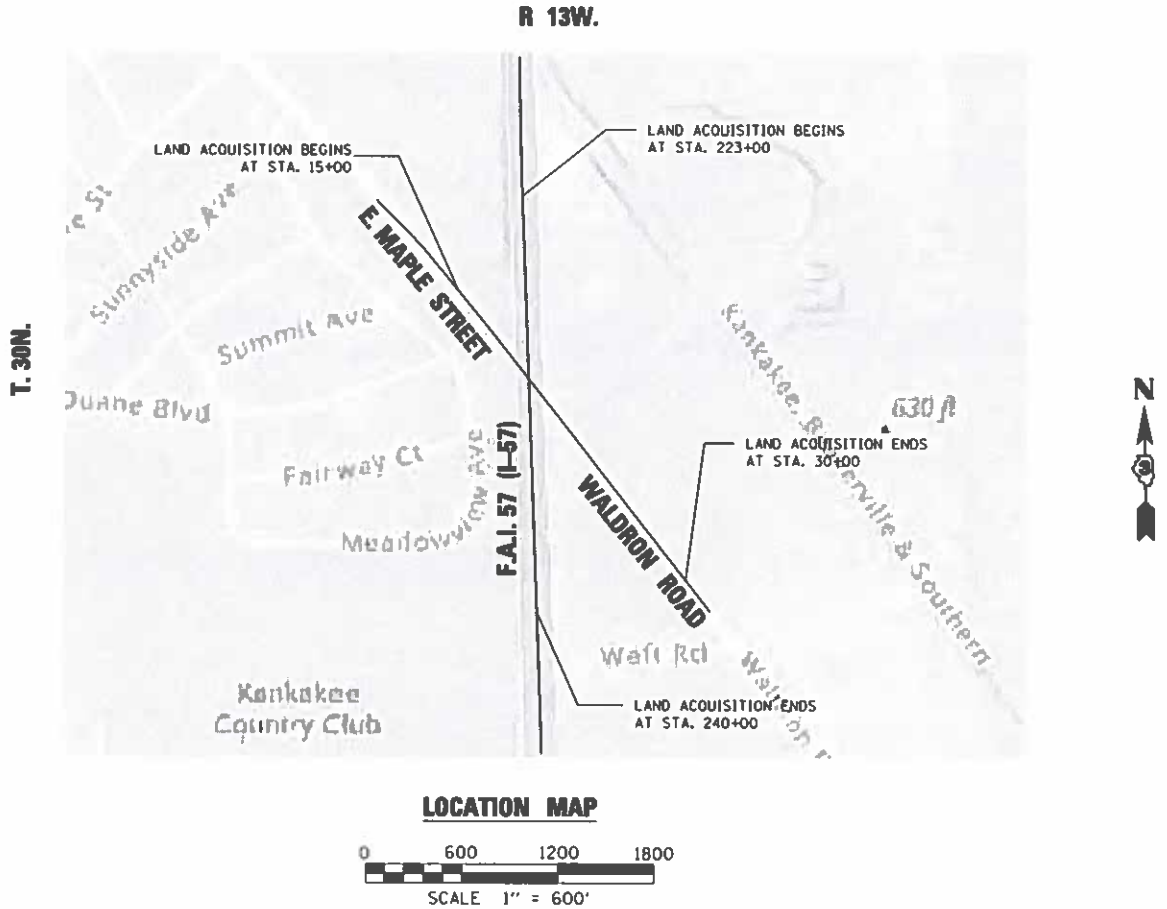

MODEL: SH00ELMAMKES FILE NAME: STPLS	USER NAME - MATTHEW MITCHELL		DESIGNED -	REVISED -	STATE OF ILLINOIS DEPARTMENT OF TRANSPORTATION	PLAT OF HIGHWAYS		F.A.I. RTE.	SECTION	COUNTY	TOTAL SHEETS	SHEET NO.
	PLOT SCALE - 1" = 50'		DRAWN - M.M. (RENWICK)	REVISED -		57	139 HBR-6	KANKAKEE	202	80		
	PLOT DATE - 06/03/2020		CHECKED -	REVISED -		1 57 @ WALDRON ROAD		CONTRACT NO. 66997				
	DATE -		REVISED -	SCALE: 1"=50'		SHEET 1 OF 4 SHEETS	STA. 223+00 TO STA. 234+00		ILLINOIS FED. AID PROJECT			

Renwick & Associates, Inc.
Professional Engineers & Land Surveyors
1204 Quail Circle, Suite 4, Channahon, IL 61509


SE ¼ OF SECTION 4, R. 30 N., R. 13 W., OF THE 2ND P.M.

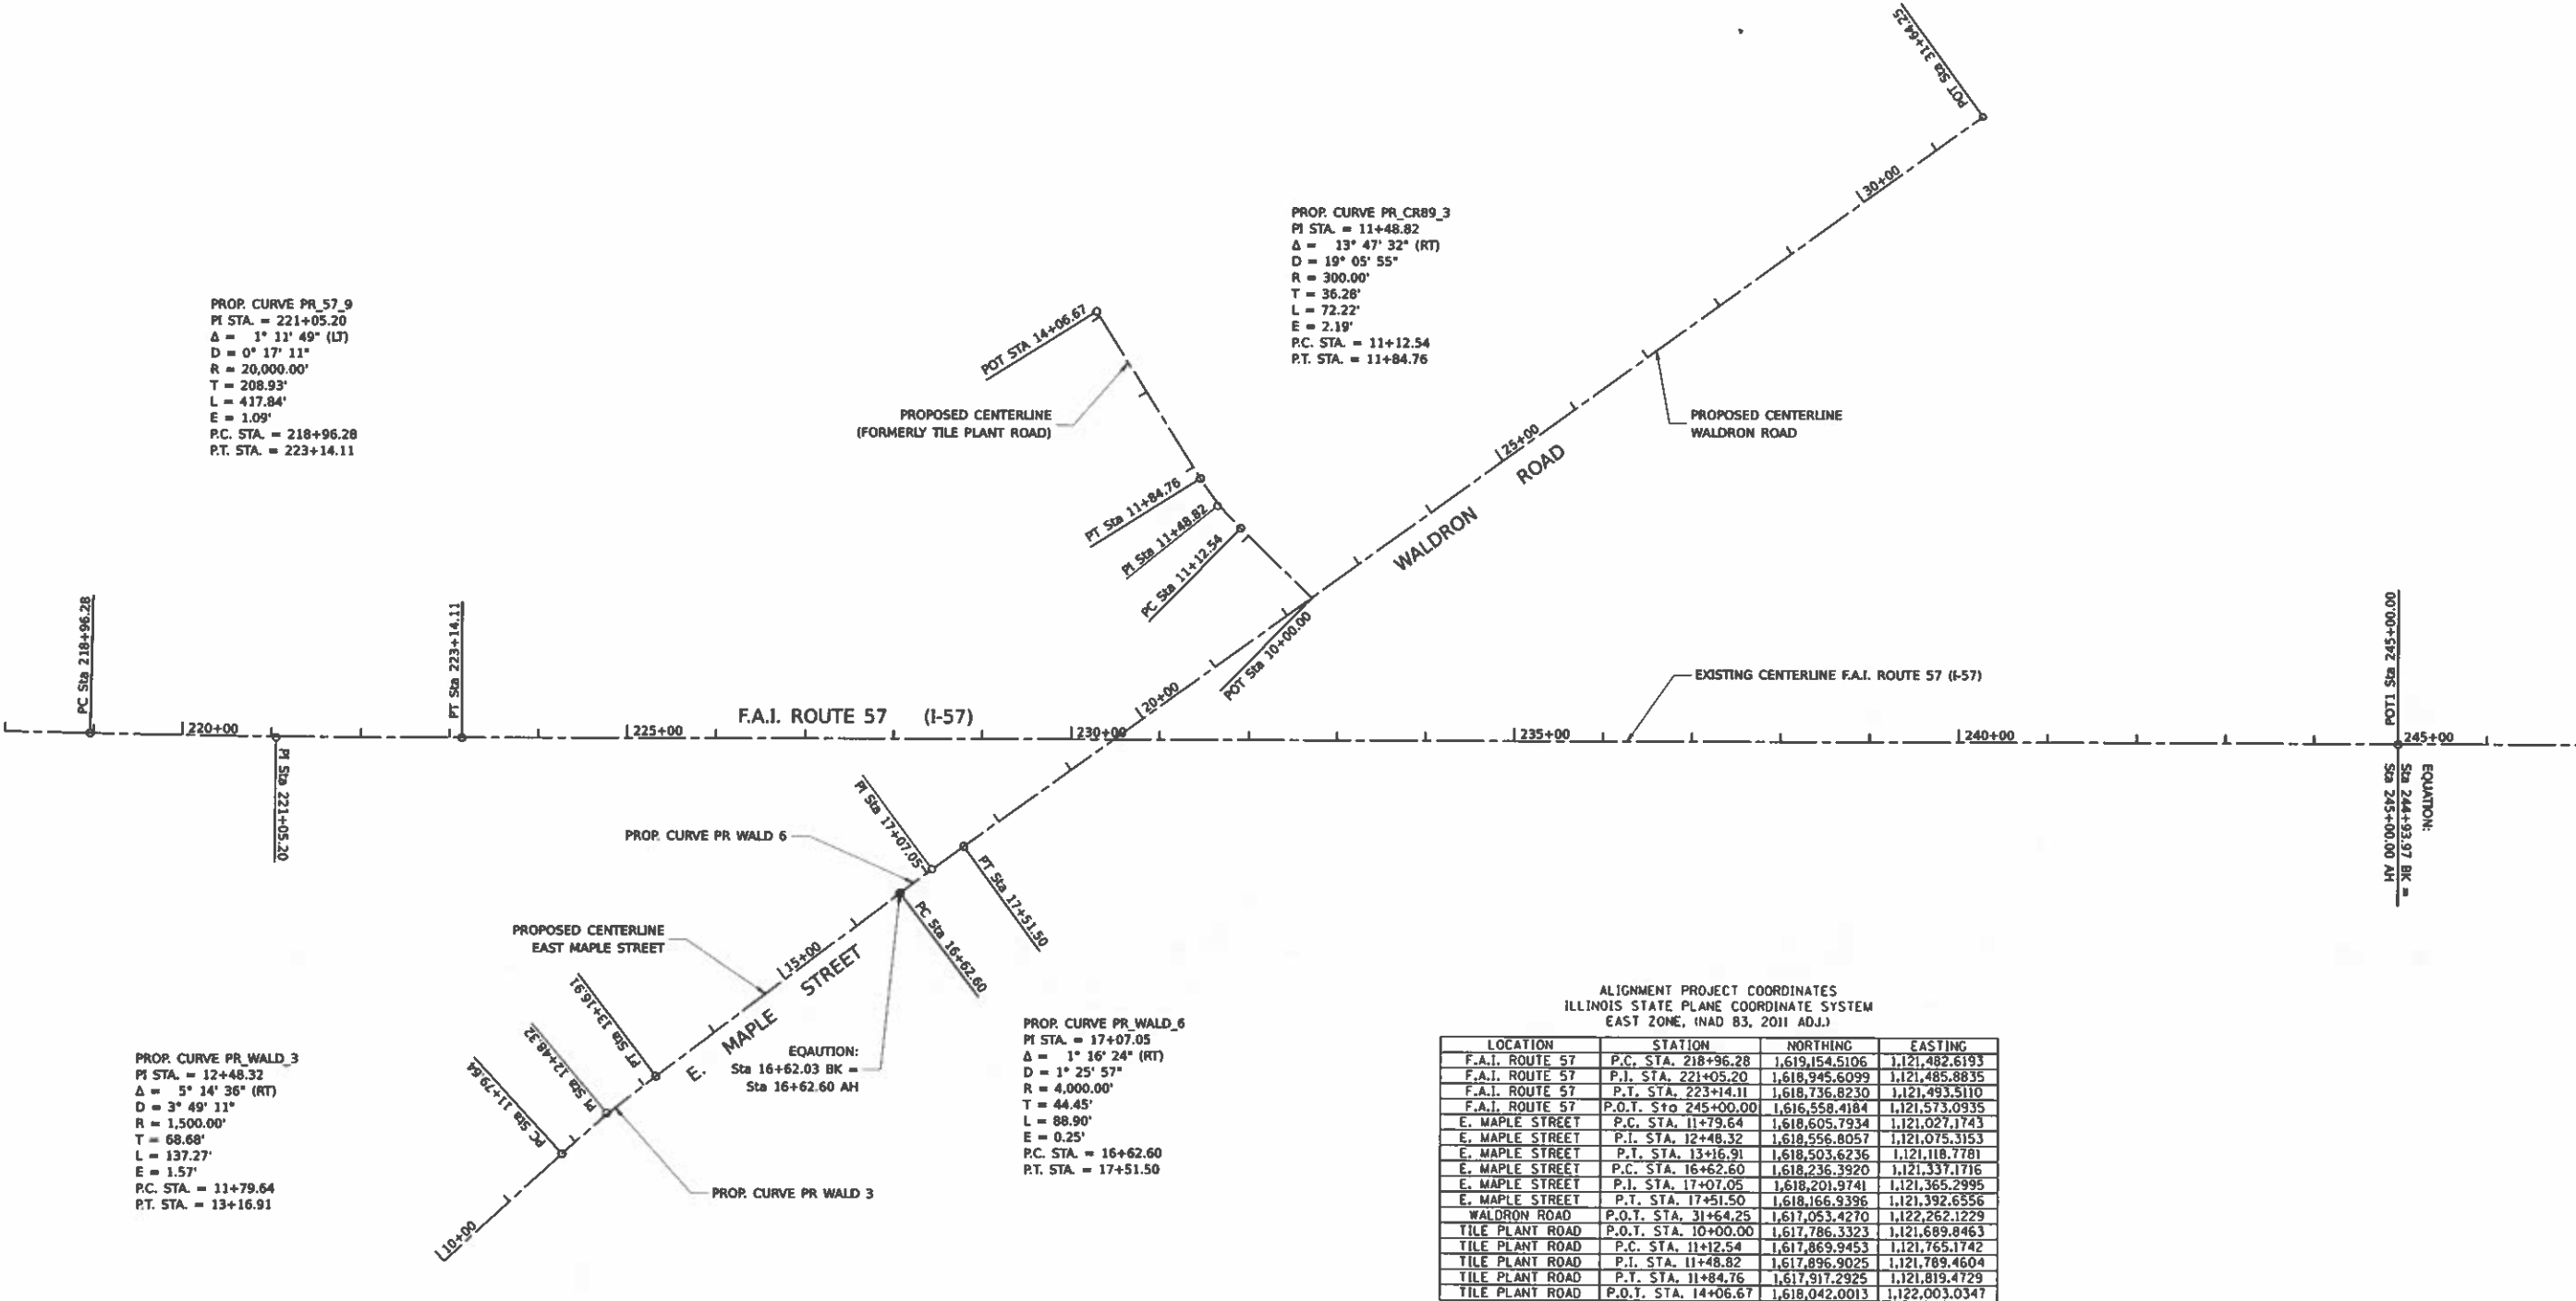

ALIGNMENT PROJECT COORDINATES ILLINOIS STATE PLANE COORDINATE SYSTEM EAST ZONE, (NAD 83, 2011 ADJ.)			
LOCATION	STATION	NORTHING	EASTING
F.A.I. ROUTE 57	P.C. STA. 218+96.28	1,619,154.5106	1,121,482.6193
F.A.I. ROUTE 57	P.I. STA. 221+05.20	1,618,945.6099	1,121,485.8835
F.A.I. ROUTE 57	P.T. STA. 223+14.11	1,618,736.8230	1,121,493.5110
F.A.I. ROUTE 57	P.O.T. STA. 245+00.00	1,616,558.4184	1,121,573.0935
E. MAPLE STREET	P.C. STA. 11+79.64	1,618,605.7934	1,121,027.1743
E. MAPLE STREET	P.I. STA. 12+48.32	1,618,556.8057	1,121,075.3153
E. MAPLE STREET	P.T. STA. 13+16.91	1,618,503.6236	1,121,118.7781
E. MAPLE STREET	P.C. STA. 16+62.60	1,618,236.3920	1,121,337.1716
E. MAPLE STREET	P.I. STA. 17+07.05	1,618,201.9741	1,121,365.2995
E. MAPLE STREET	P.T. STA. 17+51.50	1,618,166.9396	1,121,392.6556
WALDRON ROAD	P.O.T. STA. 31+64.25	1,617,053.4270	1,122,262.1229
TILE PLANT ROAD	P.O.T. STA. 10+00.00	1,617,786.3323	1,121,689.8463
TILE PLANT ROAD	P.C. STA. 11+12.54	1,617,869.9453	1,121,765.1742
TILE PLANT ROAD	P.I. STA. 11+48.82	1,617,896.9025	1,121,789.4604
TILE PLANT ROAD	P.T. STA. 11+84.76	1,617,917.2925	1,121,819.4729
TILE PLANT ROAD	P.O.T. STA. 14+06.67	1,618,042.0013	1,122,003.0347

I, KEITH W. STODDARD, HEREBY CERTIFY THAT I AM A PROFESSIONAL LAND SURVEYOR OF THE STATE OF ILLINOIS, THAT THE SURVEY OF PROPOSED WALDRON ROAD OVER F.A.I. 57 (I-57) WAS MADE BY KEITH W. STODDARD UNDER MY DIRECTION, AND THAT THE SURVEY IS TRUE AND COMPLETE AS SHOWN TO THE BEST OF MY KNOWLEDGE AND BELIEF, THAT ALL MONUMENTS AND MARKS ARE OF THE CHARACTER AND OCCUPY THE POSITION SHOWN THEREON, AND ARE SUFFICIENT TO ENABLE THE SURVEY TO BE RETRACED. THIS PROFESSIONAL SERVICE CONFORMS TO THE CURRENT ILLINOIS MINIMUM STANDARDS FOR A BOUNDARY SURVEY.

DATE: _____
ILLINOIS PROFESSIONAL LAND SURVEYOR
NO. 35-3122
11-30-2020
EXPIRATION DATE

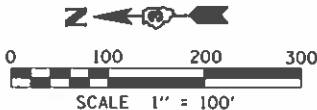

NOTE: GRID BEARINGS AND DISTANCES SHOWN HEREON ARE REFERENCED TO THE ILLINOIS STATE PLANE COORDINATE SYSTEM, EAST ZONE, (NAD 83, 2011 ADJ.). ALL AREAS BASED ON GROUND DISTANCES. GRID TO GROUND COMBINED FACTOR = 1.0000346

Renwick & Associates, Inc.
Professional Engineers & Land Surveyors
1204 Grand Circle, Suite 4 • Ottawa, IL 61350

	USER NAME = MATTHEW MITCHELL	DESIGNED -	REVISED -	STATE OF ILLINOIS DEPARTMENT OF TRANSPORTATION	PLAT OF HIGHWAYS			F&I RTE.	SECTION	COUNTY	TOTAL SHEETS	SHEET NO.
		DRAWN = MM (RENWICK)	REVISED -					57	139 HBR-6	KANKAKEE	202	81
	PLOT SCALE = 1"=100'	CHECKED -	REVISED -		PROJECT		JOB NO. R-93-005-20	157 @ WALDRON ROAD		CONTRACT NO. 66997		
	PLOT DATE = 06/03/2020	DATE -	REVISED -		SCALE: 1"=100'	SHEET 2 OF 4 SHEETS	STA. 223+00 TO STA. 234+00	ILLINOIS FED. AID PROJECT				

1/4 OF SEC. 4, T. 30N., R. 13W. OF THE 2ND P.M.

F.A.I. RTE.	SECTION	COUNTY	TOTAL SHEETS	SHEET NO.
57	139 HBR-6	KANKAKEE	202	82
I 57 @ WALDRON ROAD			CONTRACT NO. 66997	
BLUMKS		EED AND PROJECT		


PARCEL 3AAL002

TOTAL HOLDING	=	29.126 AC.±
TOTAL R.O.W. REQUIRED	=	0.274 AC.± (11,943 S.F.)
AREA IN EXISTING R.O.W.	=	0.225 AC.± (9,794 S.F.)
NET R.O.W. REQUIRED	=	0.049 AC.± (2,149 S.F.)
REMAINDER	=	28.852 AC.±

PROP. CURVE PR_CR89_3
PI STA. = 11+48.82
Δ = 13° 47' 32" (RT)
D = 19° 05' 55"
R = 300.00'
T = 36.28'
L = 72.22'
E = 2.19'
P.C. STA. = 11+12.54
P.T. STA. = 11+84.76

NORTH LINE OF LOT 4 IN THE PLAT OF
SUBDIVISION OF THE ESTATE OF A.J. BAKER,
CIRCUIT COURT RECORD DATE APRIL 30, 1894

P.O.C. PARCEL 3AAL002

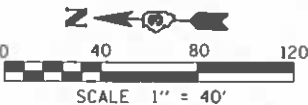

I, KEITH W. STODDARD, HEREBY CERTIFY THAT I AM A PROFESSIONAL LAND SURVEYOR OF THE STATE OF ILLINOIS, THAT THE SURVEY OF PROPOSED WALDRON ROAD OVER F.A.I. 57 (I-57) WAS MADE BY KEITH W. STODDARD UNDER MY DIRECTION, AND THAT THE SURVEY IS TRUE AND COMPLETE AS SHOWN TO THE BEST OF MY KNOWLEDGE AND BELIEF, THAT ALL MONUMENTS AND MARKS ARE OF THE CHARACTER AND OCCUPY THE POSITION SHOWN THEREON, AND ARE SUFFICIENT TO ENABLE THE SURVEY TO BE RETRACED. THIS PROFESSIONAL SERVICE CONFORMS TO THE CURRENT ILLINOIS MINIMUM STANDARDS FOR A BOUNDARY SURVEY.

DATE:

ILLINOIS PROFESSIONAL LAND SURVEYOR
NO. 35-3122

11-30-2020
EXPIRATION DATE



USER NAME = RYAN THOMPSON
PLOT SCALE = 1"=40'
PLOT DATE = 06/03/2020

DESIGNED -
DRAWN - RMT (RENWICK)
CHECKED -
DATE -

REVISED -
REVISED -
REVISED -
REVISED -

STATE OF ILLINOIS
DEPARTMENT OF TRANSPORTATION

PLAT OF HIGHWAYS

PROJECT: SHEET 4 OF 4 SHEETS
JOB NO. R-93-005-20
STA. 223+00 TO STA. 234+00
SCALE: 1"=40'

TOTAL HOLDING = 3.314 AC.±
TEMPORARY EASEMENT = 0.107 AC.± (4,652 S.F.)
PURPOSE: ENTRANCE CONSTRUCTION

PARCEL	POINT TO POINT	BEARING	DISTANCE
3AAL003	1 TO 2	N 51°46'59" E	15.29'
	3 TO 4	S 52°00'58" W	18.12'


NOTE: GRID BEARINGS AND DISTANCES SHOWN HEREON ARE REFERENCED TO THE ILLINOIS STATE PLANE COORDINATE SYSTEM, EAST ZONE, (NAD 83, 2011 ADJ.). ALL AREAS BASED ON GROUND DISTANCES. GRID TO GROUND COMBINED FACTOR = 1.0000346.

Renwick & Associates, Inc.
Professional Engineers & Land Surveyors
1204 Grand Circle, Suite 4 V. Ottawa, IL 61320

F.A.I. RTE.	SECTION	COUNTY	TOTAL SHEETS	SHEET NO.
57	139 HBR-6	KANKAKEE	202	83
I 57 @ WALDRON ROAD		CONTRACT NO. 66997		
ILLINOIS		FED. AID PROJECT		


SIGN NUMBERING CODE

DIRECTION OF TRAFFIC	SIGN PANEL NUMBER
EB - EASTBOUND	WB - WESTBOUND
NB - NORTHBOUND	SB - SOUTHBOUND
MOUNTING TYPE	
BS - BREAKAWAY STEEL POSTS	WP - WOOD POSTS
TS - TELESCOPING STEEL POSTS	PM - POLE MOUNTED

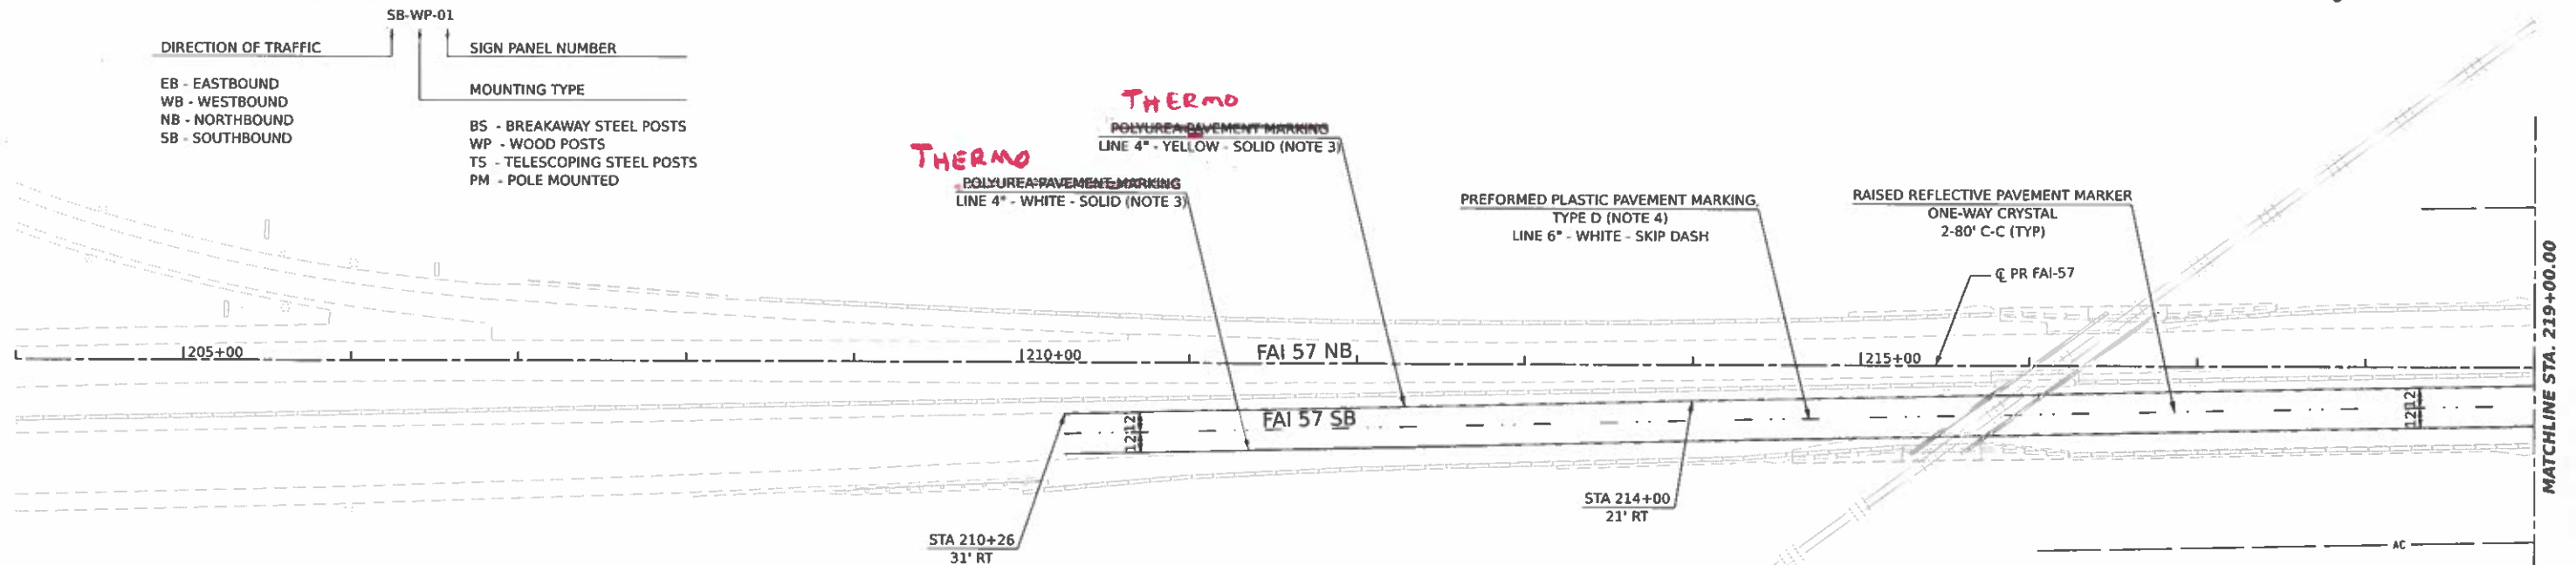

NOTES:

- PAVEMENT MARKING AND RAISED REFLECTIVE PAVEMENT MARKERS ARE TO PLACED ACCORDING TO HIGHWAY STANDARDS 780001 AND 781001 AND DISTRICT 3 STANDARD 780.
- ALL SIGNS SHOULD BE ERECTED IN ACCORDANCE WITH HIGHWAY STANDARD 720006 AND AS DIRECTED BY THE ENGINEER, ON WOOD SIGN SUPPORTS UNLESS OTHERWISE NOTED.
- GROOVING FOR RECESSED PAVEMENT MARKING, 5"
- GROOVING FOR RECESSED PAVEMENT MARKING, 7"
- SHOULDER RUMBLE STRIPS, 16 INC
SB - STA 218+82 TO STA 235+61
NB - STA 228+05 TO STA 242+35

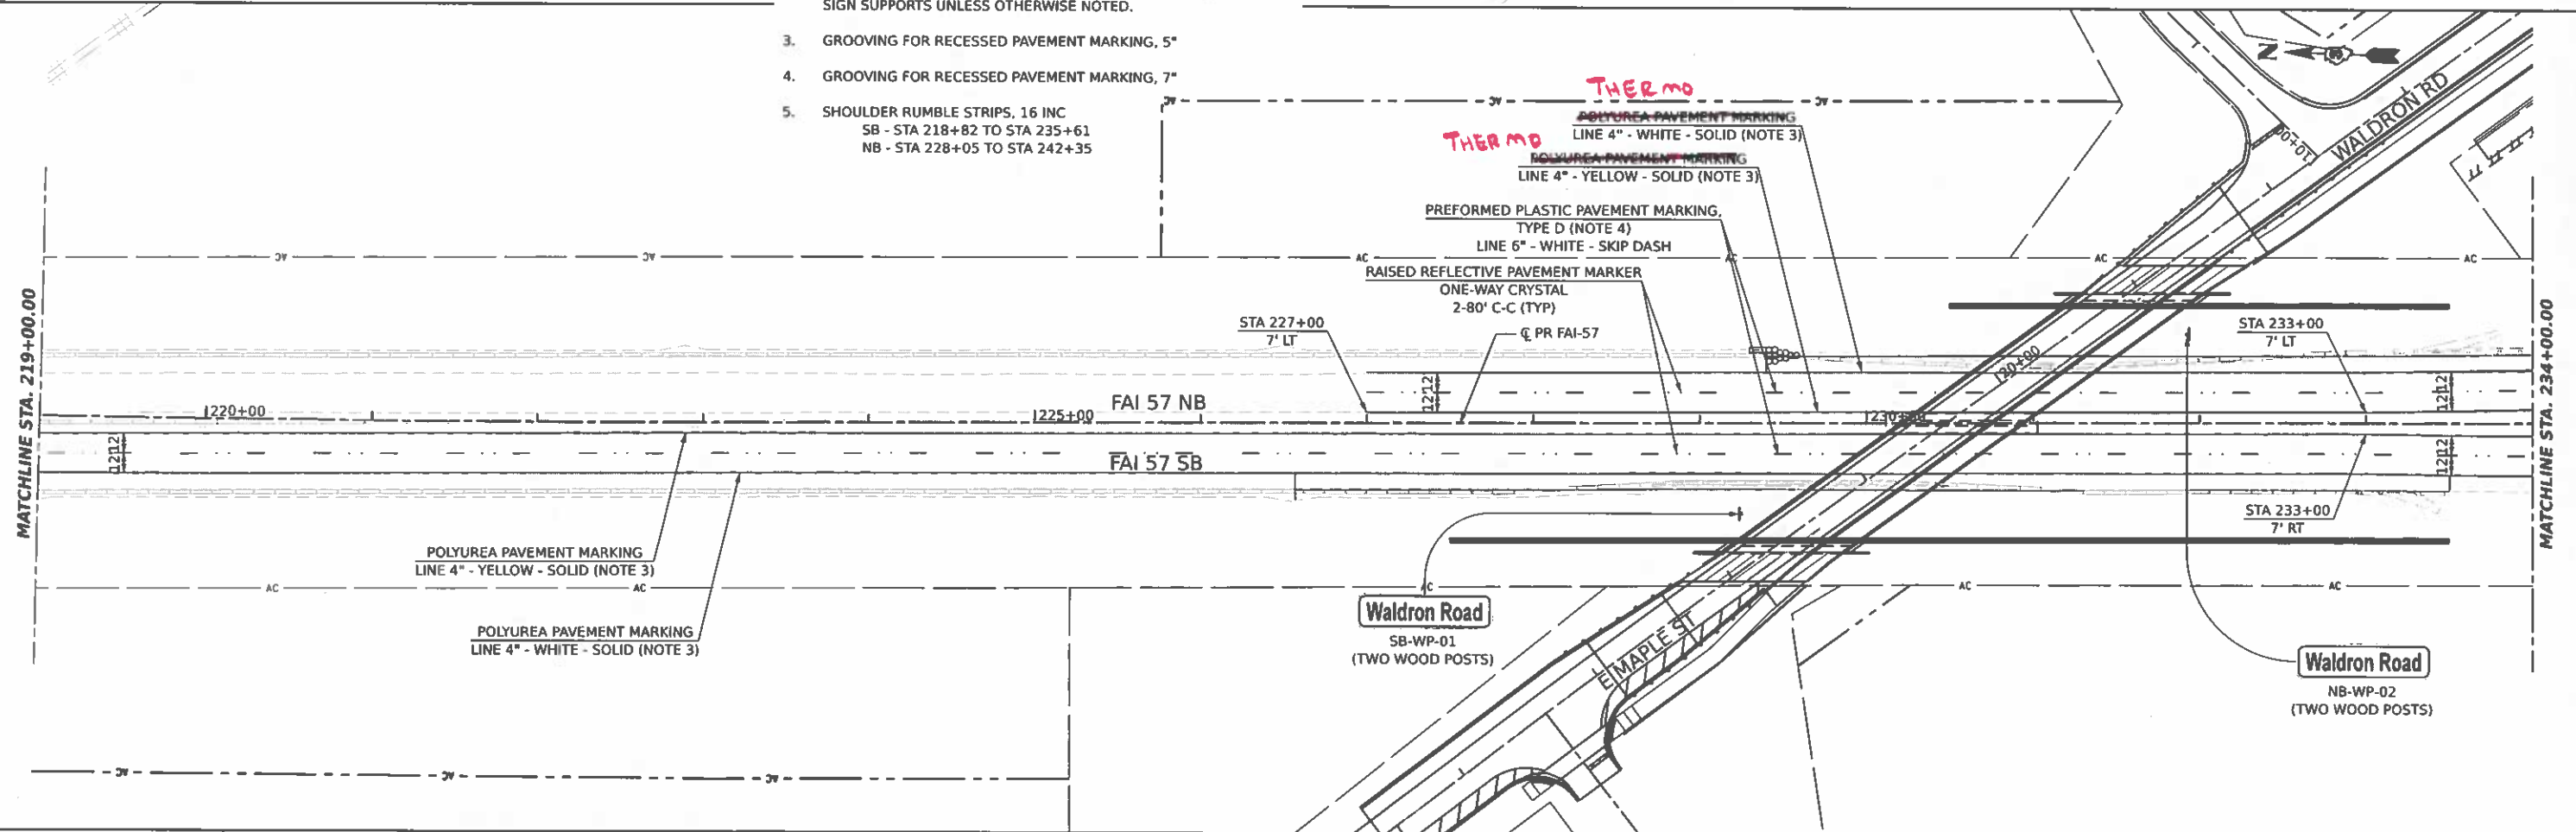

MODEL: Plan 5
FILE NAME: D:\66853\Sheet 1.dgn

Hutchinson Engineering, Inc.
Jacksonville Moline Peoria Shorewood
Since 1945

USER NAME = nsalehan
PLOT SCALE = 0.16666633" / in.
PLOT DATE = 3/29/2021

DESIGNED - Designed By
DRAWN - Drawn By
CHECKED - Checked By
DATE - Checked Date


REVISED - Revised By1
REVISED - Revised By2
REVISED - Revised By3
REVISED - Revised By4

STATE OF ILLINOIS
DEPARTMENT OF TRANSPORTATION


FAI 57 & WALDRON ROAD
PAVEMENT MARKING AND SIGNING PLAN


SCALE: 1"=50' SHEET 1 OF 4 SHEETS STA. 204+00 TO STA. 234+00

F.A.I. RTE.	SECTION	COUNTY	TOTAL SHEETS	SHEET NO.
57	139 HBR-6	KANKAKEE	202	84
CONTRACT NO. 66997				
ILLINOIS FED. AID PROJECT				

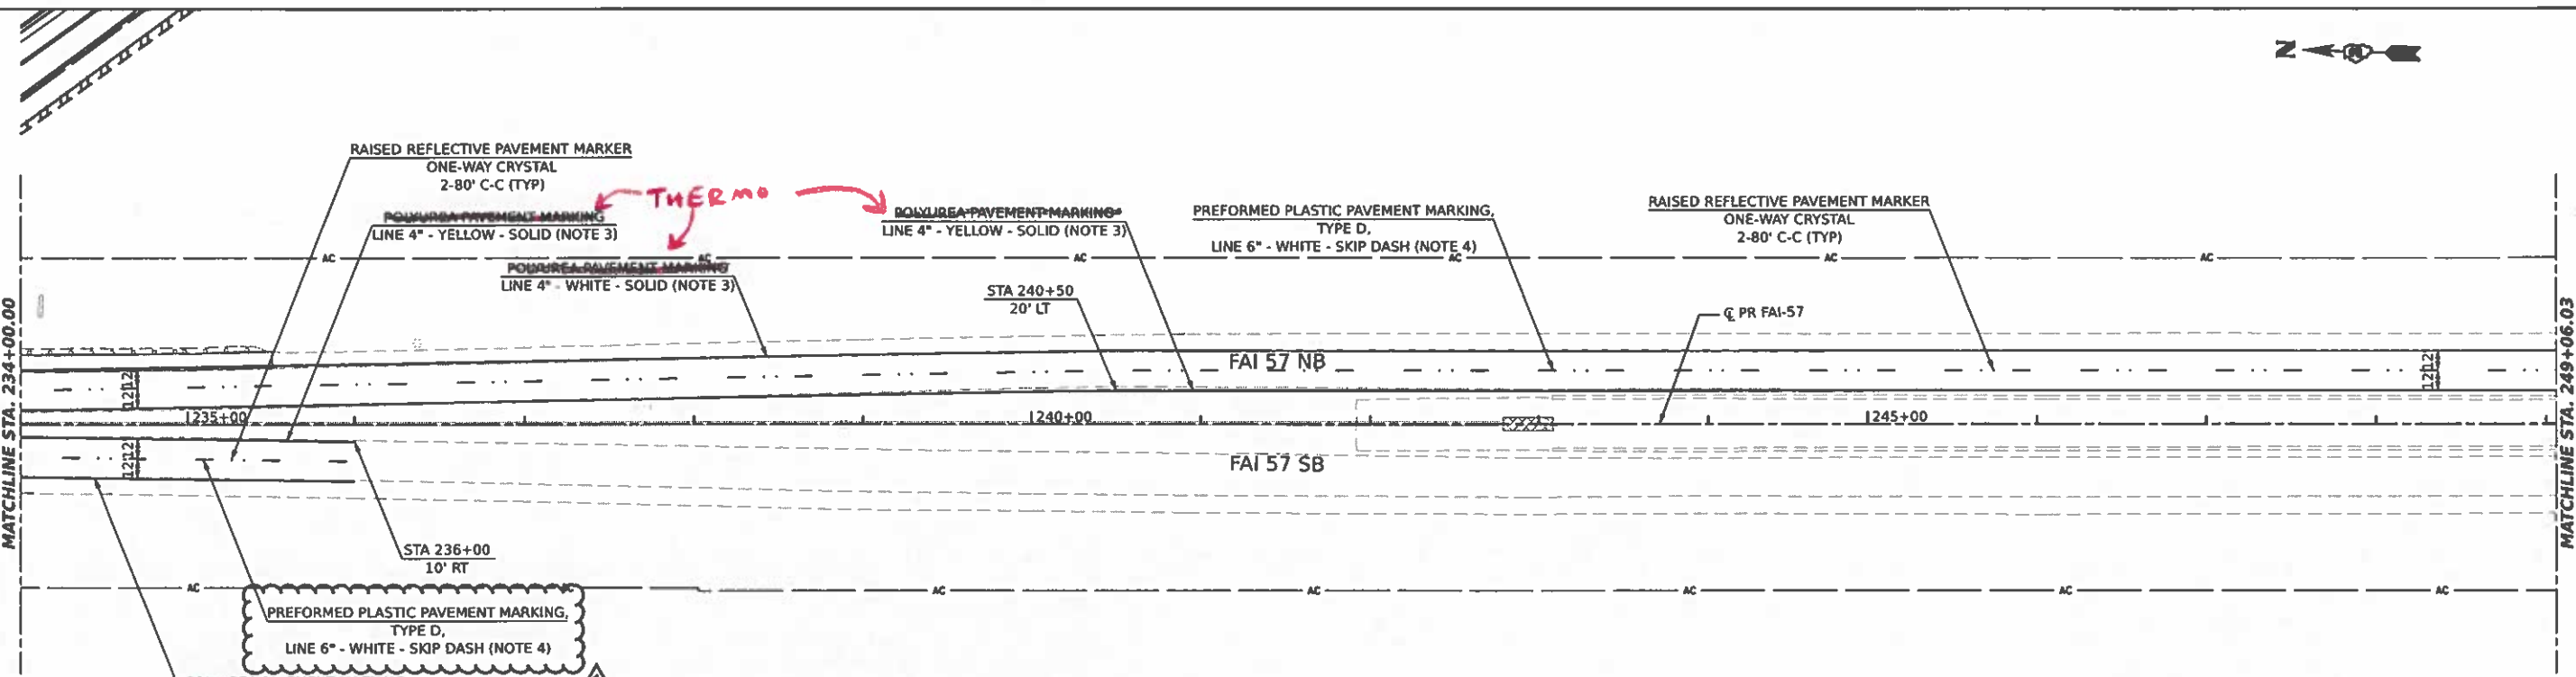


- NOTES:
- PAVEMENT MARKING AND RAISED REFLECTIVE PAVEMENT MARKERS ARE TO PLACED ACCORDING TO HIGHWAY STANDARDS 780001 AND 781001 AND DISTRICT 3 STANDARD 780.
 - ALL SIGNS SHOULD BE ERECTED IN ACCORDANCE WITH HIGHWAY STANDARD 720006 AND AS DIRECTED BY THE ENGINEER, ON WOOD SIGN SUPPORTS UNLESS OTHERWISE NOTED.
 - GROOVING FOR RECESSED PAVEMENT MARKING, 5"
 - GROOVING FOR RECESSED PAVEMENT MARKING, 7"
 - SHOULDER RUMBLE STRIPS, 16 INC
 SB - STA 218+82 TO STA 235+61
 NB - STA 228+05 TO STA 242+35

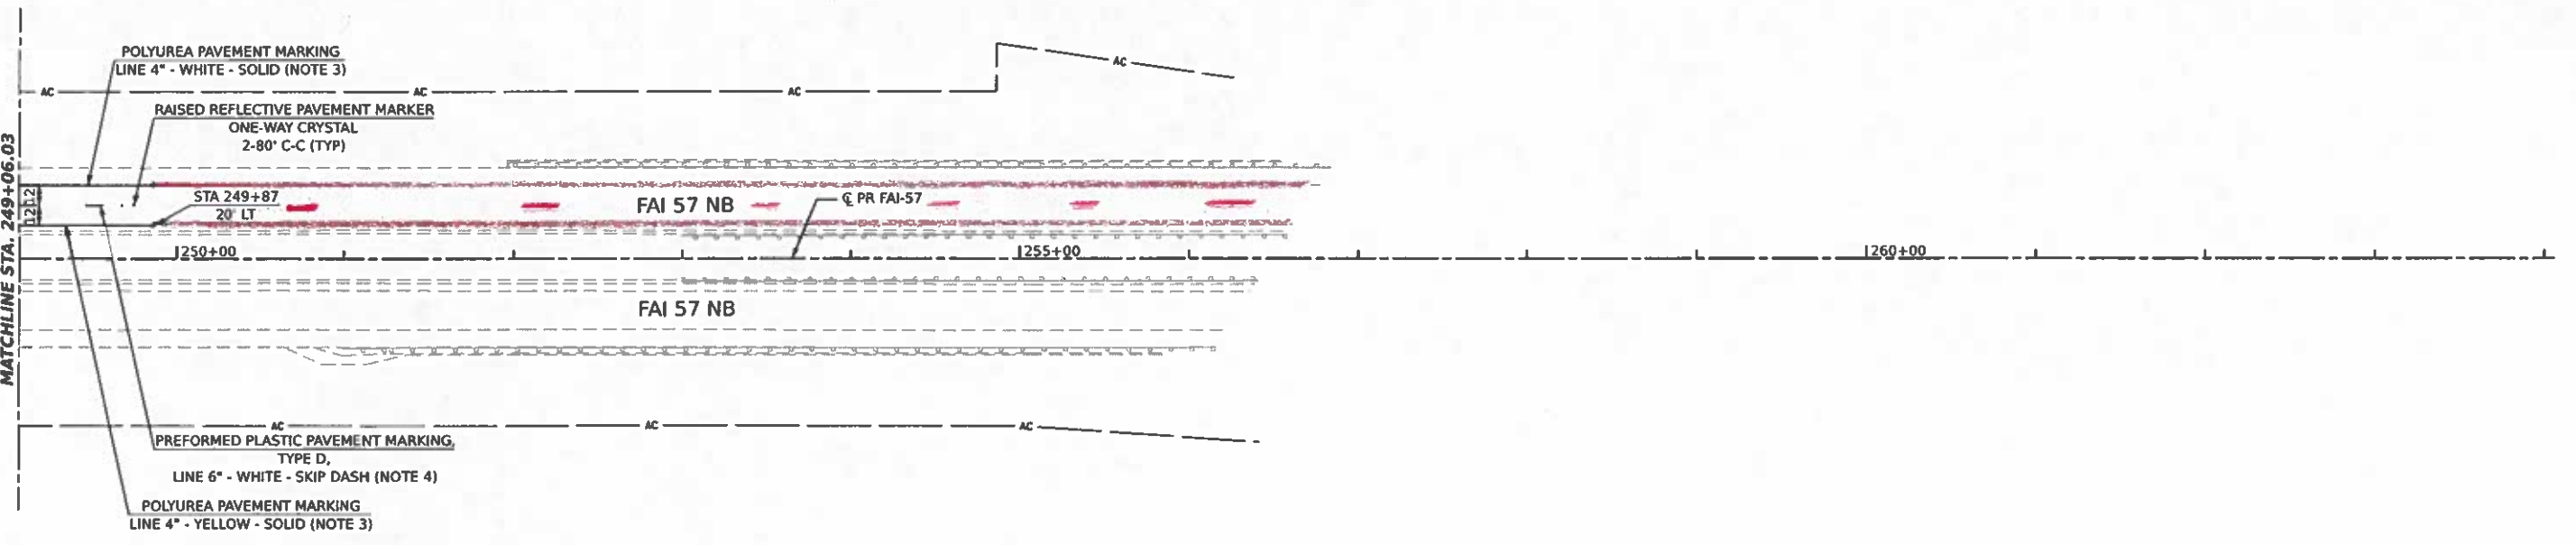

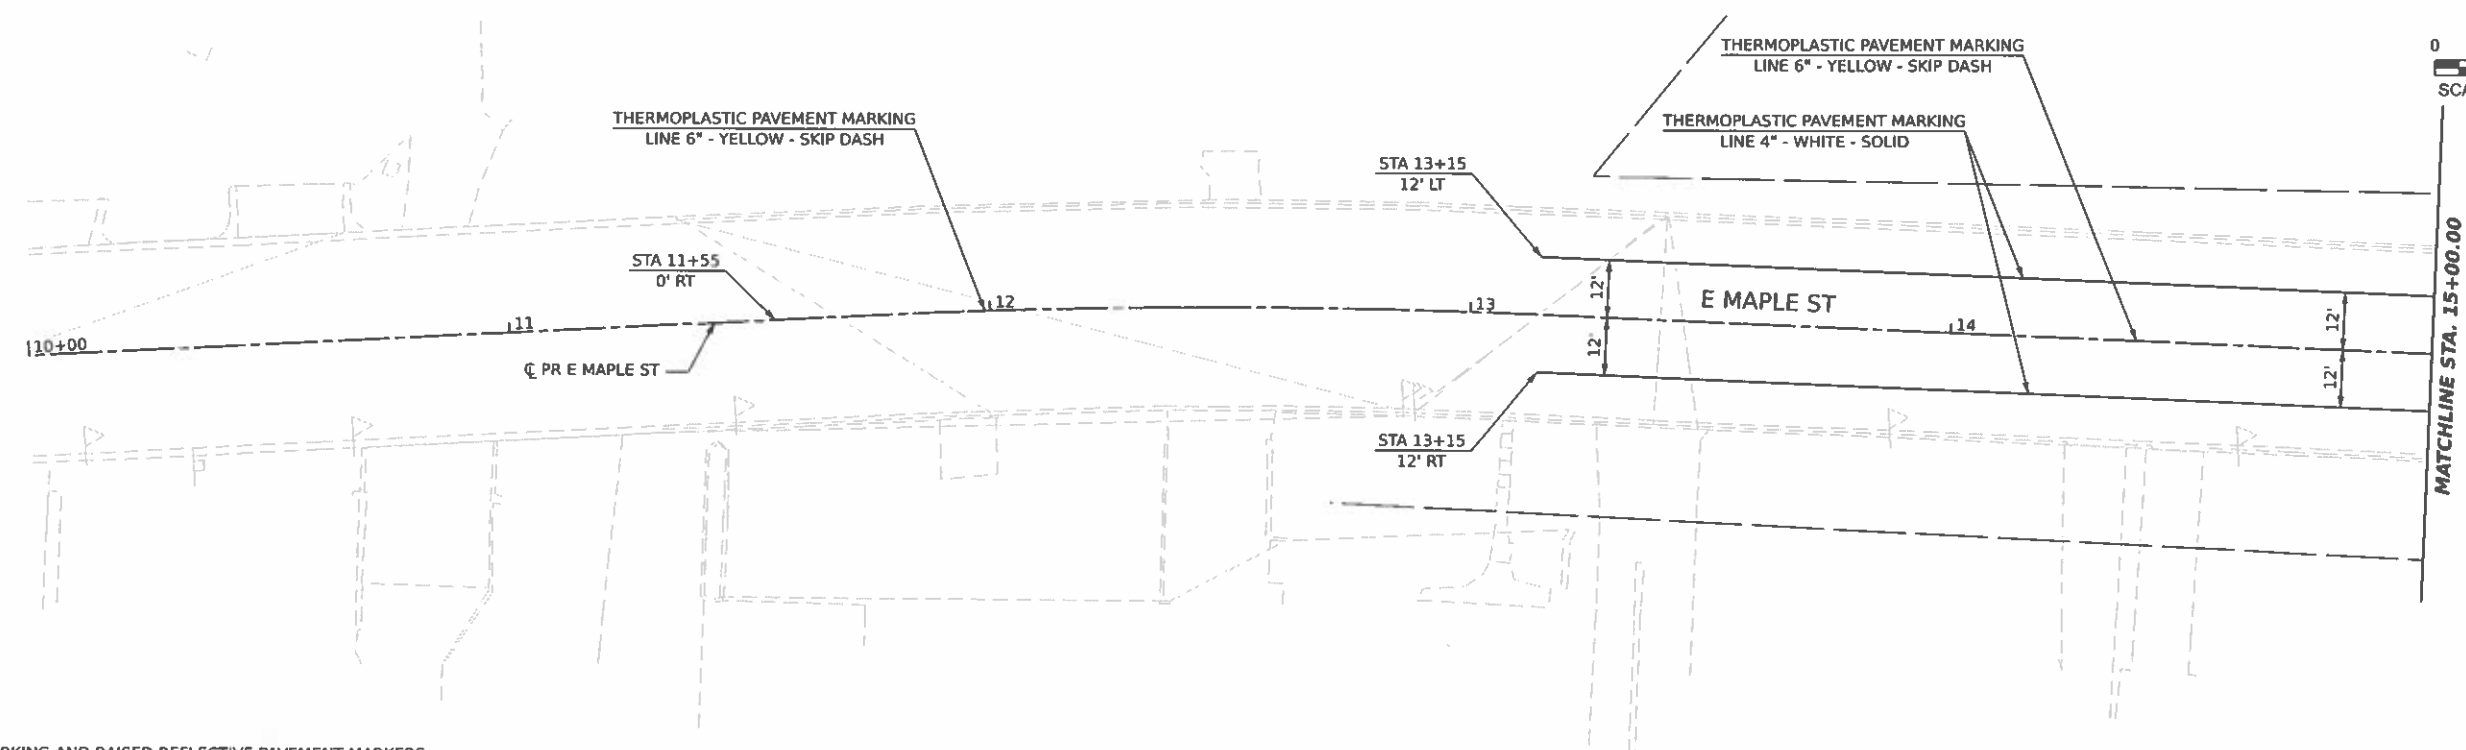

NOTES:

1. PAVEMENT MARKING AND RAISED REFLECTIVE PAVEMENT MARKERS ARE TO BE PLACED ACCORDING TO HIGHWAY STANDARDS 780001 AND 781001 AND DISTRICT 3 STANDARD 780.
2. ALL SIGNS SHOULD BE ERECTED IN ACCORDANCE WITH HIGHWAY STANDARD 720006 AND AS DIRECTED BY THE ENGINEER, ON WOOD SIGN SUPPORTS UNLESS OTHERWISE NOTED.
3. GROOVING FOR RECESSED PAVEMENT MARKING, 5"
4. GROOVING FOR RECESSED PAVEMENT MARKING, 7"

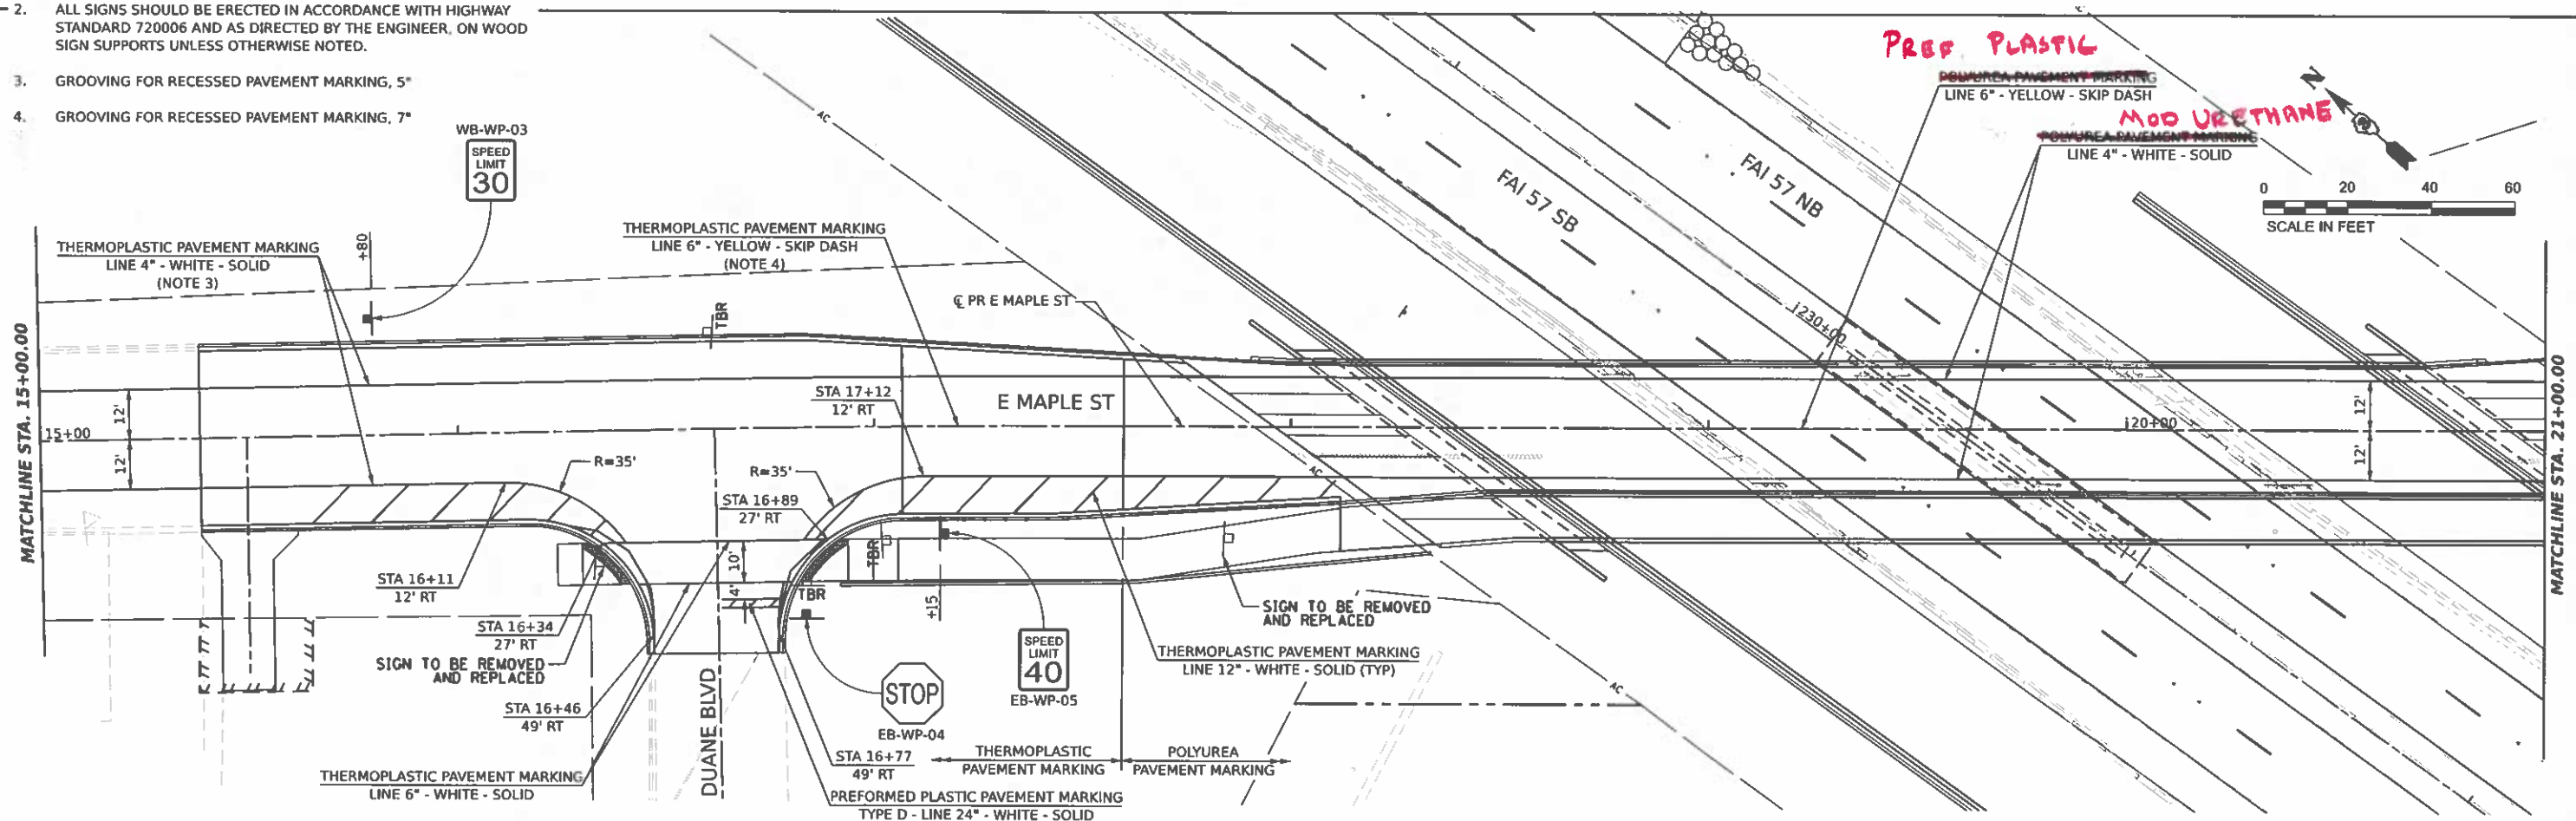

MODEL: Plan 5
FILE NAME: D:\66997\66997-1\66997-1.dgn

Hutchinson Engineering, Inc.
Jacksonville Moline Peoria Shorewood
Since 1945

USER NAME: mason
PLOT SCALE: 1"=20'
PLOT DATE: 3/29/2021

DESIGNED: -
DRAWN: -
CHECKED: -
DATE: -


REVISED: -
REVISED: -
REVISED: -
REVISED: -

STATE OF ILLINOIS
DEPARTMENT OF TRANSPORTATION


FAI 57 & WALDRON ROAD
PAVEMENT MARKING & SIGNING PLAN

SCALE: 1"=20' SHEET 3 OF 4 SHEETS STA. 10+00 TO STA. 21+00

F.A.I. RTE.	SECTION	COUNTY	TOTAL SHEETS	SHEET NO.
57	139 HBR-6	KANKAKEE	202	86
CONTRACT NO. 66997				
ILLINOIS FED. AID PROJECT				

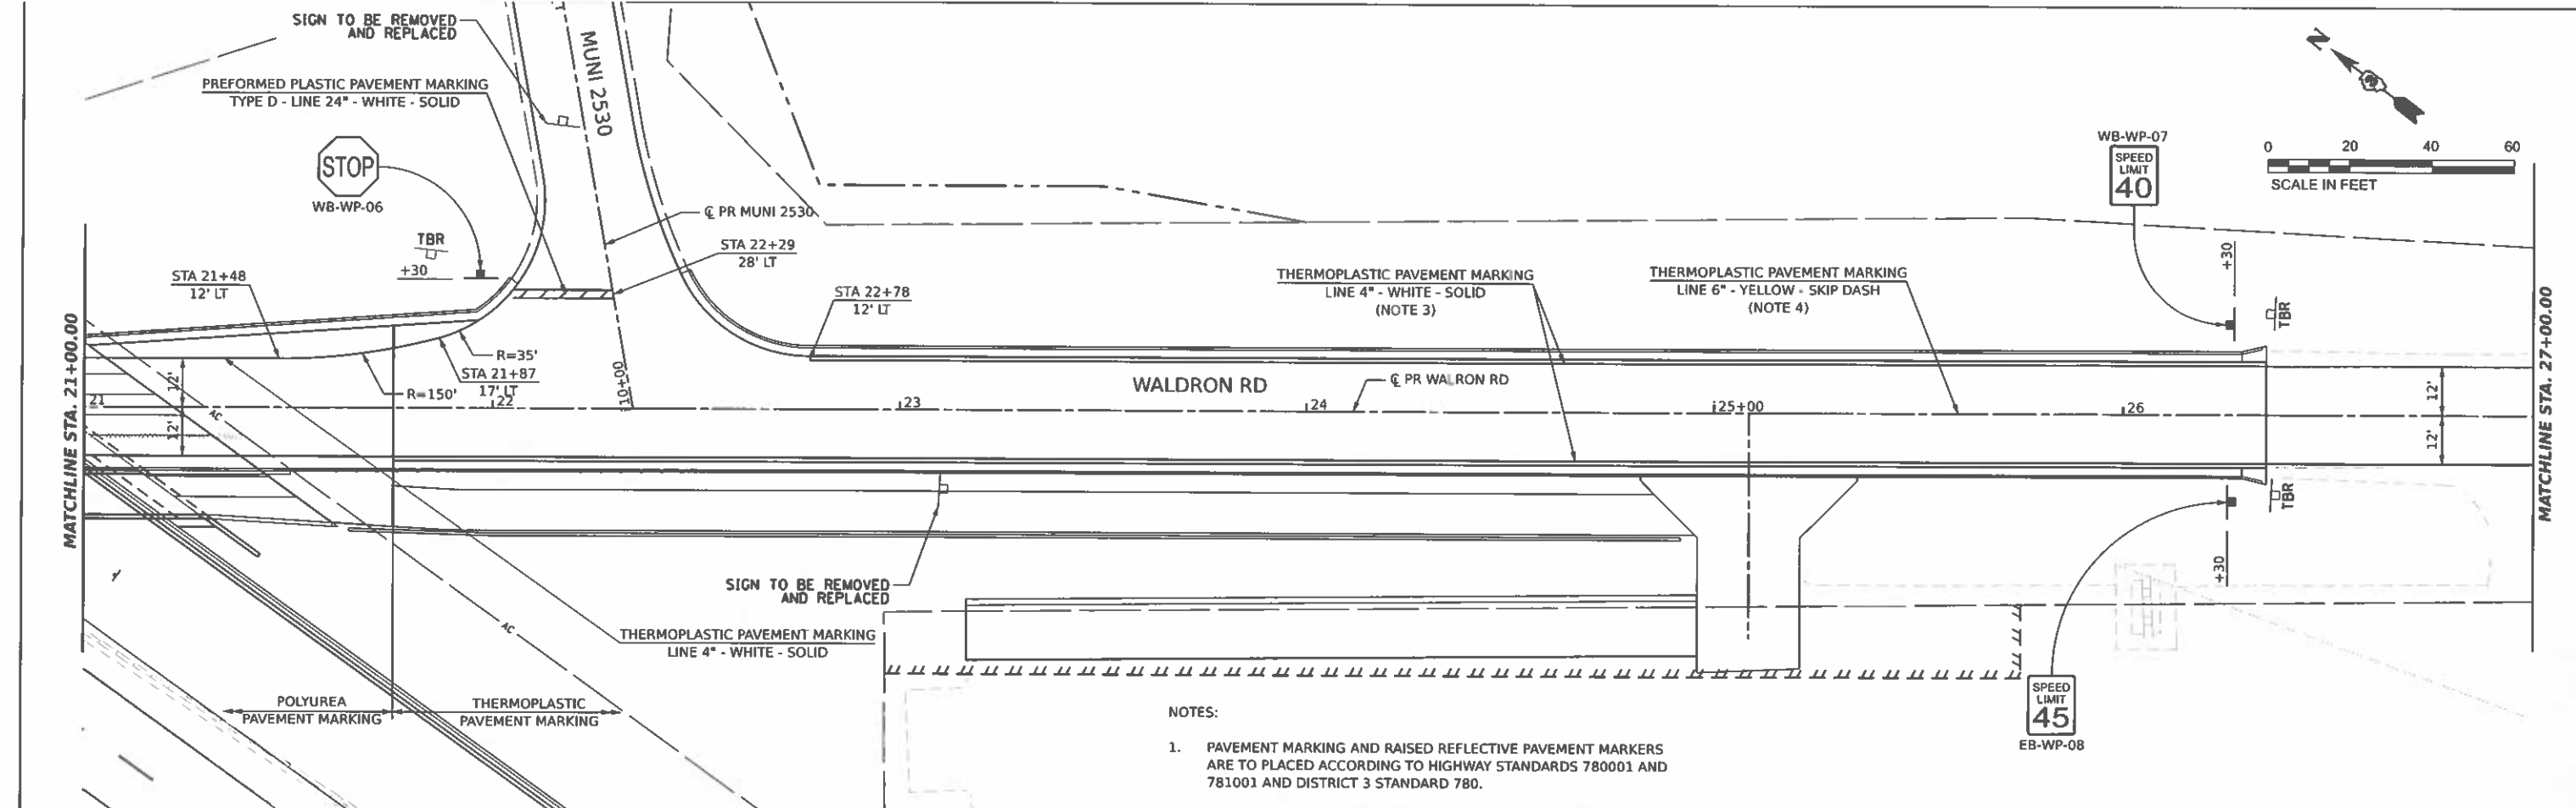


- NOTES:
1. PAVEMENT MARKING AND RAISED REFLECTIVE PAVEMENT MARKERS ARE TO BE PLACED ACCORDING TO HIGHWAY STANDARDS 780001 AND 781001 AND DISTRICT 3 STANDARD 780.
 2. ALL SIGNS SHOULD BE ERECTED IN ACCORDANCE WITH HIGHWAY STANDARD 720006 AND AS DIRECTED BY THE ENGINEER, ON WOOD SIGN SUPPORTS UNLESS OTHERWISE NOTED.
 3. GROOVING FOR RECESSED PAVEMENT MARKING, 5"
 4. GROOVING FOR RECESSED PAVEMENT MARKING, 7"

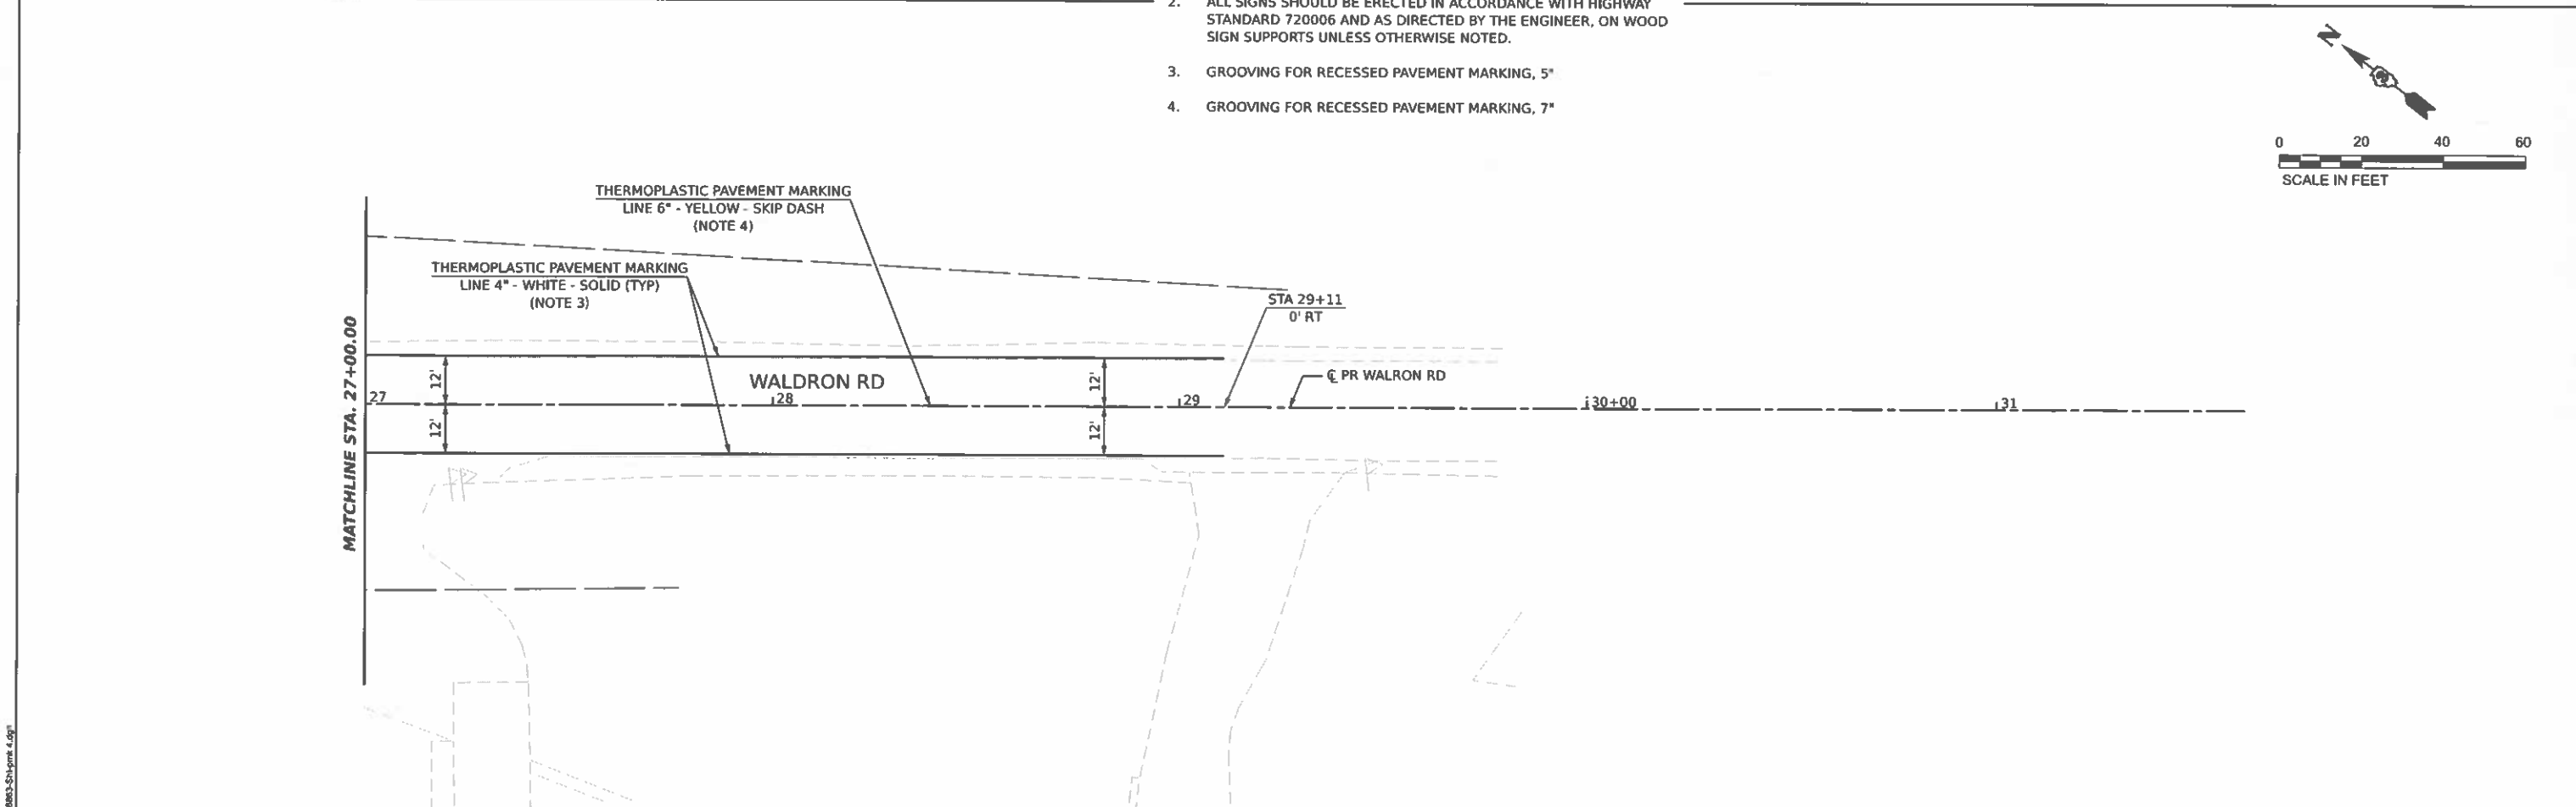

MODEL: Plan 7
FILE NAME: D:\000003-Station 4.dgn

Hutchlson Engineering, Inc. Jacksonville Moline Peoria Shorewood Since 1945	USER NAME = nashan	DESIGNED -	REVISED -	STATE OF ILLINOIS DEPARTMENT OF TRANSPORTATION	FAI 57 & WALDRON ROAD PAVEMENT MARKING & SIGNING PLAN	F.A.I. RTE.	SECTION	COUNTY	TOTAL SHEETS	SHEET NO.
		DRAWN -	REVISED -			57	139 HBR-6	KANKAKEE	202	87
	PLOT SCALE = 0.18888833' / in.	CHECKED -	REVISED -			CONTRACT NO. 66997				
	PLOT DATE = 3/29/2021	DATE -	REVISED -			SCALE: 1"=20'	SHEET 4 OF 4 SHEETS	STA. 21+00 TO STA. 31+50	ILLINOIS FED. AID PROJECT	

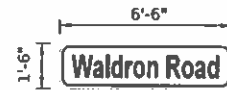

**R1-1
TYPE ZZ SHEETING**

R2-1
TYPE AP SHEETING


R2-1
TYPE AP SHEETING

R2-1
TYPE AP SHEETING


TYPE 22 SHEETING
WHITE/GREEN BACKGROUND
3/4" BORDER
8" SERIES D LETTERS

[illegible]


NOTE: TYPE AP SHEETING ON ALL SIGNS UNLESS OTHERWISE NOTED.

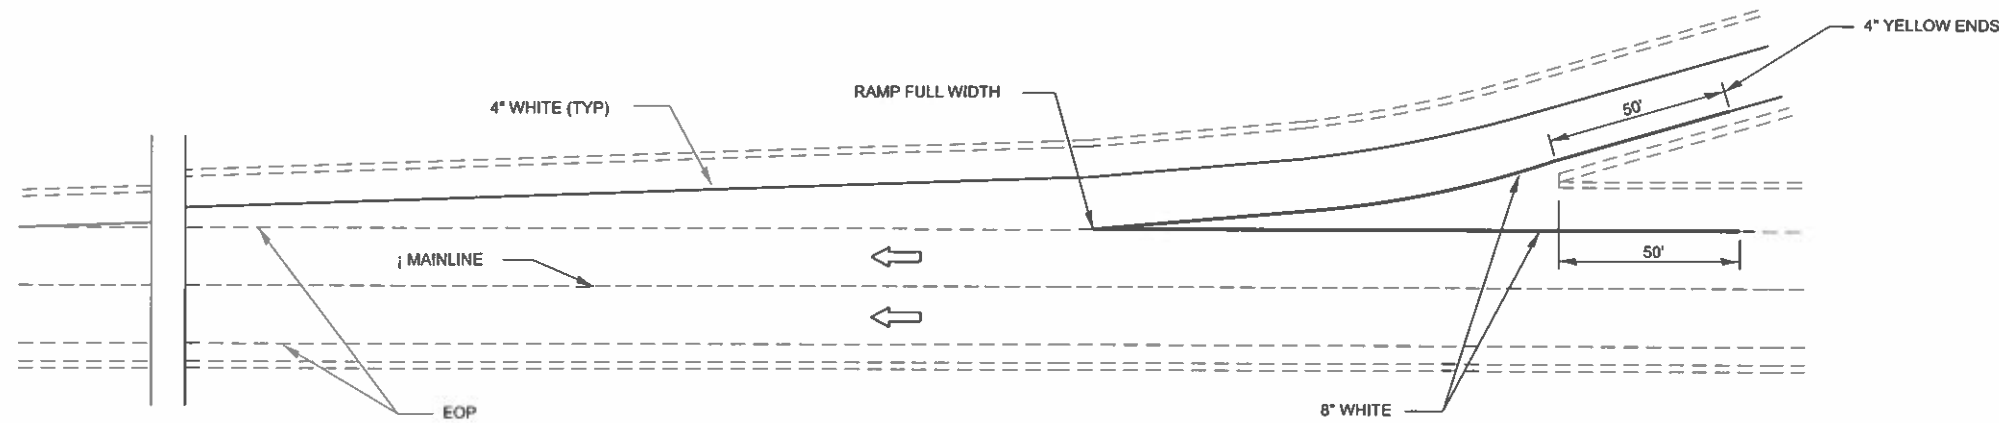

TYPICAL PAVEMENT MARKING FOR ENTRANCE RAMP TERMINALS

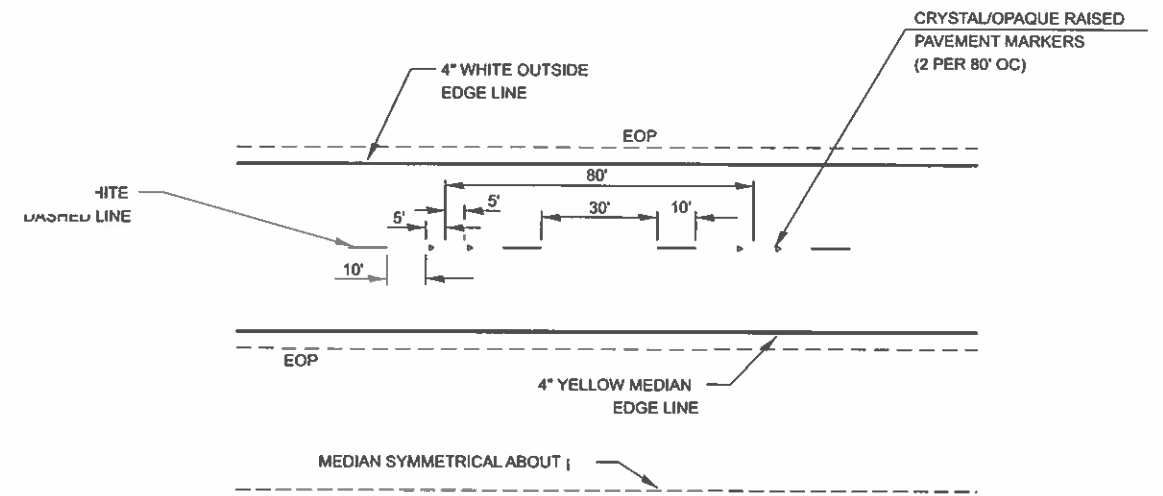

TYPICAL PAVEMENT MARKINGS

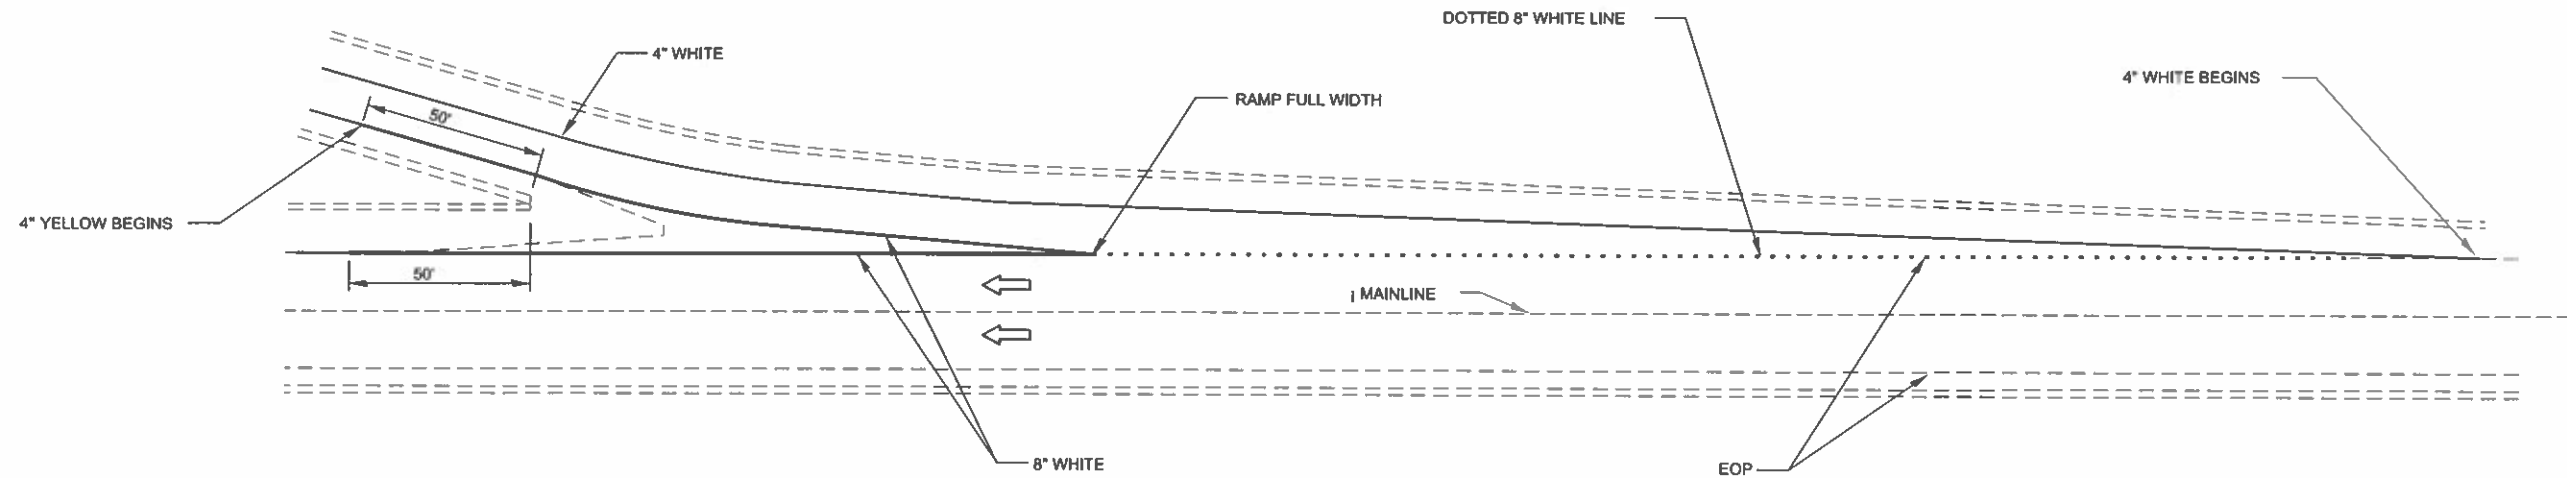

TYPICAL PAVEMENT MARKINGS FOR EXIT RAMP TERMINALS

MODEL: TheRoad
FILE NAME: C:\000003-SHA-PAK-Detail 1.dgn

Hutchinson Engineering, Inc.
Jacksonville Moline Peoria Shorewood
Since 1945

USER NAME = mshahin	DESIGNED -	REVISED -
PLOT SCALE = 0.18698633" / in.	DRAWN -	REVISED -
PLOT DATE = 3/29/2021	CHECKED -	REVISED -
	DATE -	REVISED -

**STATE OF ILLINOIS
DEPARTMENT OF TRANSPORTATION**

**FAI 57 & WALDRON ROAD
PAVEMENT MARKING DETAIL**

SCALE: 1"=100' SHEET 1 OF 1 SHEETS STA. N/A TO STA. N/A

F.A.I. RTE.	SECTION	COUNTY	TOTAL SHEETS	SHEET NO.
57	139 HBR-6	KANKAKEE	202	89
CONTRACT NO. 66997				
ILLINOIS FED. AID PROJECT				

3/12/2021 2:48:08 PM

TOTAL BILL OF MATERIAL

ITEM	UNIT	SUPER	SUB	TOTAL
Granular Backfill for Structures	Cu. Yd.	--	439	439
Removal of Existing Structures	Each	--	--	1
Protective Shield	Sq. Yd.	443	--	443
Structure Excavation	Cu. Yd.	--	775	775
Concrete Structures	Cu. Yd.	--	366.4	366.4
Concrete Superstructure	Cu. Yd.	508.1	--	508.1
Bridge Deck Grooving	Sq. Yd.	1324	--	1324
Protective Coat	Sq. Yd.	1961	--	1961
Furnishing and Erecting Structural Steel	L. Sum	1	--	1
Stud Shear Connectors	Each	9342	47	9389
Reinforcement Bars, Epoxy Coated	Pound	134640	73900	208540
Bar Splicers	Each	1065	102	1167
Bridge Fence Railing	Foot	324	--	324
Parapet Railing	Foot	334	--	334
Slope Wall 4 Inch	Sq. Yd.	--	43	43
Name Plates	Each	1	--	1
Drilled Shaft in Soil	Cu. Yd.	--	87.3	87.3
Drilled Shaft in Rock	Cu. Yd.	--	51.2	51.2
Elastomeric Bearing Assembly, Type I	Each	12	--	12
Anchor Bolts, 1 1/4"	Each	--	24	24
Anchor Bolts, 1 1/2"	Each	--	12	12
Temporary Soil Retention System	Sq. Ft.	--	640	640
Geocomposite Wall Drain	Sq. Yd.	--	230	230
Pipe Underdrains for Structures 4"	Foot	--	352	352
Concrete Wearing Surface, 5"	Sq. Yd.	299	--	299
Precast Bridge Approach Slab	Sq. Ft.	2604	--	2604
Preformed Joint Strip Seal	Foot	158	--	158
Concrete Sealer	Sq. Ft.	--	2780	2780
Furnishing Soldier Piles (W Section)	Foot	--	266	266
Drilling and Setting Soldier Piles (In Soil)	Cu. Ft.	--	984	984
Drilling and Setting Soldier Piles (In Rock)	Cu. Ft.	--	351	351
Removal of Existing Protective Shield	Sq. Yd.	391	--	391
Thermal Integrity Profile Data Collection	Foot	--	313	313
Thermal Integrity Profile Testing	Each	--	12	12
Rock Excavation For Structures	Cu. Yd.	--	102	102


INDEX OF SHEETS

1	General Plan & Elevation
2	General Data
3-6	Stage Construction Details
7-8	Top of Slab Elevations
9-10	Top of Approach Slab Elevations
11	Superstructure
12-14	Superstructure Details
15-16	Diaphragm Details
17-25	North Precast Bridge Approach Slab
26-34	South Precast Bridge Approach Slab
35-36	Preformed Joint Strip Seal
37	Parapet Railing
38	Bridge Fence Railing
39-42	Girder and Framing Details
43	Bearing Details
44	North Abutment
45	South Abutment
46	Wingwall Extension Elevations
47	Wingwall Extension Sections and Details
48	Pier
49	Bar Splicer Assembly Details
50	Temporary Concrete Barrier
51-54	Boring Logs

STATION 230+47.96
BUILT BY
STATE OF ILLINOIS
F.A.I. RT. 57 SEC. 139HBR-6
LOADING HL-93
STRUCTURE NO. 046-0153

NAME PLATE
See Std. 515001

F.A.I. RTE	SECTION	COUNTY	TOTAL SHEETS	SHEET NO.
57	139HBR-6	KANKAKEE	202	91
CONTRACT NO. 66997				
ILLINOIS FED. AID PROJECT				

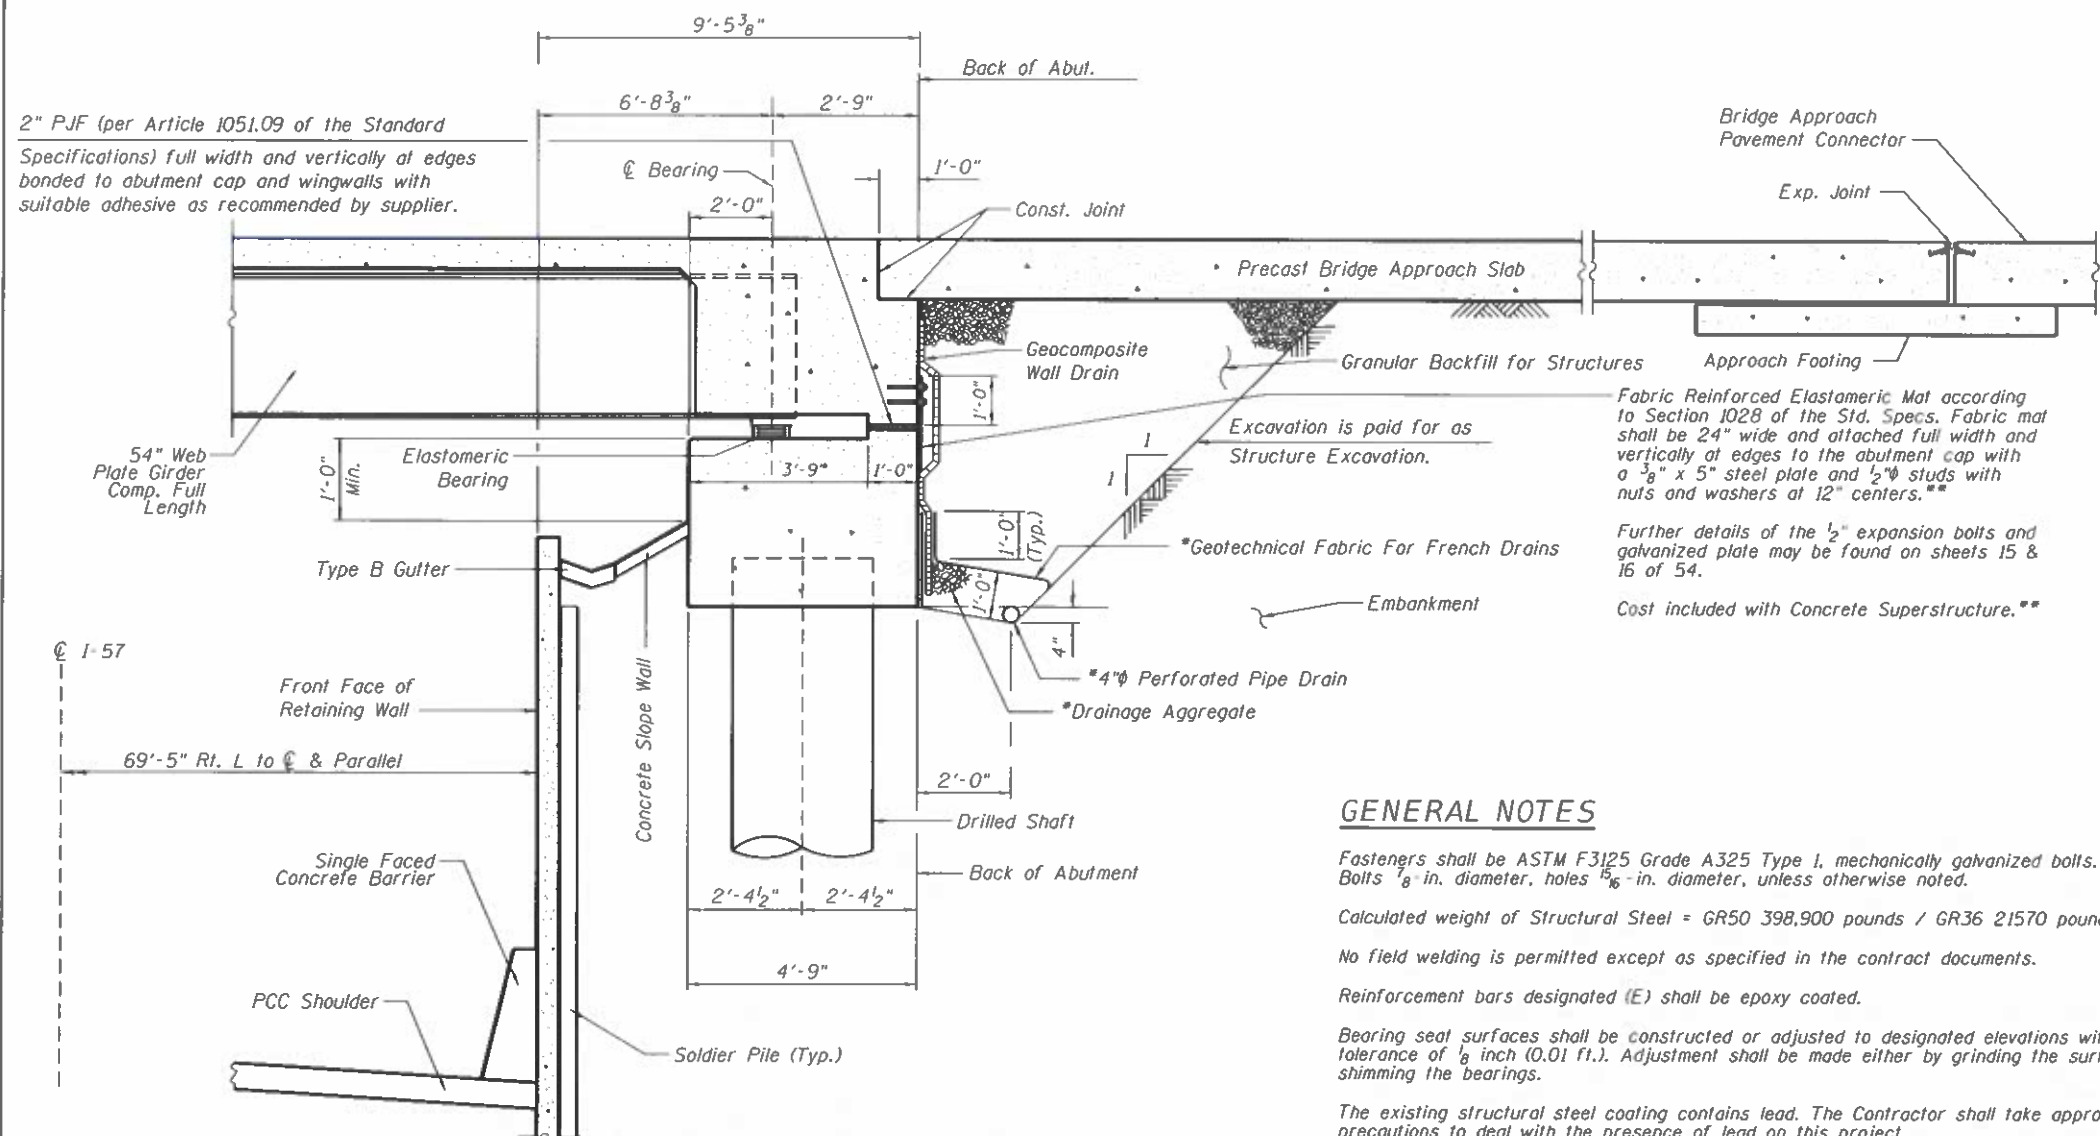


SECTION THRU SEMI INTEGRAL ABUTMENT

(Horiz. dim. $\bullet$ Rt. L's)*Included in the cost of Pipe Underdrains for Structures.
(See Special Provisions)


Note:

All drainage system components shall extend to 2'-0" from the end of each wingwall except an outlet pipe shall extend until intersecting with the side slopes. The pipes shall drain into concrete headwalls. (See Article 601.05 of the Standard Specifications and Highway Standard 601101).

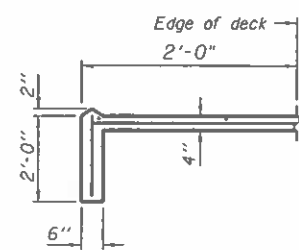

SECTION A-A

Horizontal Dimensions are at Right Angles

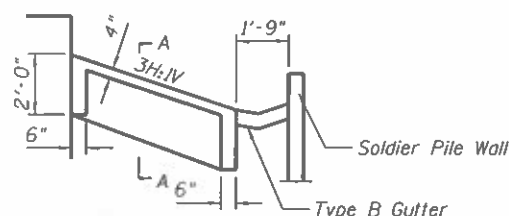

SECTION B-B

Horizontal Dimensions are at Right Angles

GENERAL NOTES

Fasteners shall be ASTM F3125 Grade A325 Type 1, mechanically galvanized bolts. Bolts 1/8" in. diameter, holes 15/16" in. diameter, unless otherwise noted.

Calculated weight of Structural Steel = GR50 398,900 pounds / GR36 21570 pounds

No field welding is permitted except as specified in the contract documents.

Reinforcement bars designated (E) shall be epoxy coated.

Bearing seat surfaces shall be constructed or adjusted to designated elevations within a tolerance of 1/8 inch (0.01 ft.). Adjustment shall be made either by grinding the surface or by shimming the bearings.

The existing structural steel coating contains lead. The Contractor shall take appropriate precautions to deal with the presence of lead on this project.

The Organic Zinc Rich Primer / Epoxy / Urethane Paint System shall be used for painting new structural steel except where otherwise noted. The entire system shall be shop applied with the exception of the exterior surface and the bottom of the bottom flange of the fascia beams, masked off connection surfaces, field installed fasteners and damaged areas shall be touched up in the field. The color of the final finish coat for all interior steel surfaces shall be Gray, Munsell No. 5B 7/1. The color of the final finish coat for the exterior and bottom flange of the fascia beams shall be Interstate Green, Munsell No. 7.5G 4/8.

The embankment configuration shown shall be the minimum that must be placed and compacted prior to construction of the abutments.

The concrete for bridge decks finished according to Article 503.16(a) of the Standard Specifications shall be placed and compacted parallel to the skew on uniform increments along centerline of bridge. The machine used for finishing shall be set parallel to the skew for striking off and screeding the concrete.

Sloped wall shall be reinforced with welded wire fabric, 6"x 6" W4.0 x W4.0 weighing 58 lbs. per 100 sq. ft.

Concrete Sealer shall be applied to the designated areas of the Pier.

Parapet Slipforming will not be allowed.

The Contractor shall retain the services of an engineering firm, prequalified in the IDOT consultant selection category of Highway Bridges (Advanced Typical), for preparation of the Structural Assessment Report(s). Contractor's pre-approval shall not be applicable for this project. See Special Provision.

Current Ratings on File for Existing Structure

Inventory: 1.140
Operating: 1.900
Live Load Restrictions: No

Inventory and Operating Ratings and Live Load Restrictions are provided for information only. Inventory and Operating Ratings are based on HS loading and configuration. Live Load Restrictions are based on Illinois legal loads and configurations. The Ratings and Live Load Restrictions are not necessarily representative of capacities to support the Contractor's equipment.


STATE OF ILLINOIS
DEPARTMENT OF TRANSPORTATION

GENERAL DATA
STRUCTURE NO. 046-0153


SHEET 2 OF 54 SHEETS



USER NAME	DESIGNED	JKC	REVISED	
PLOT SCALE	CHECKED	AJO	REVISED	
PLOT DATE	DRAWN	LAG	REVISED	
	CHECKED	JKC	REVISED	

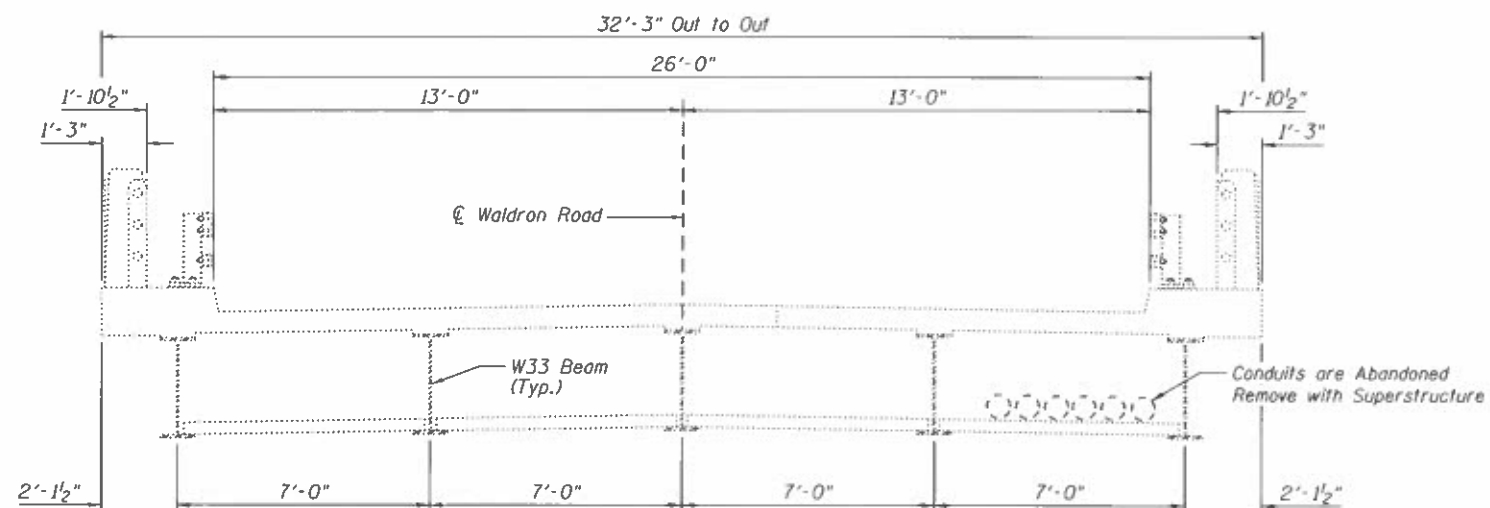

EXISTING STRUCTURE
Looking South East

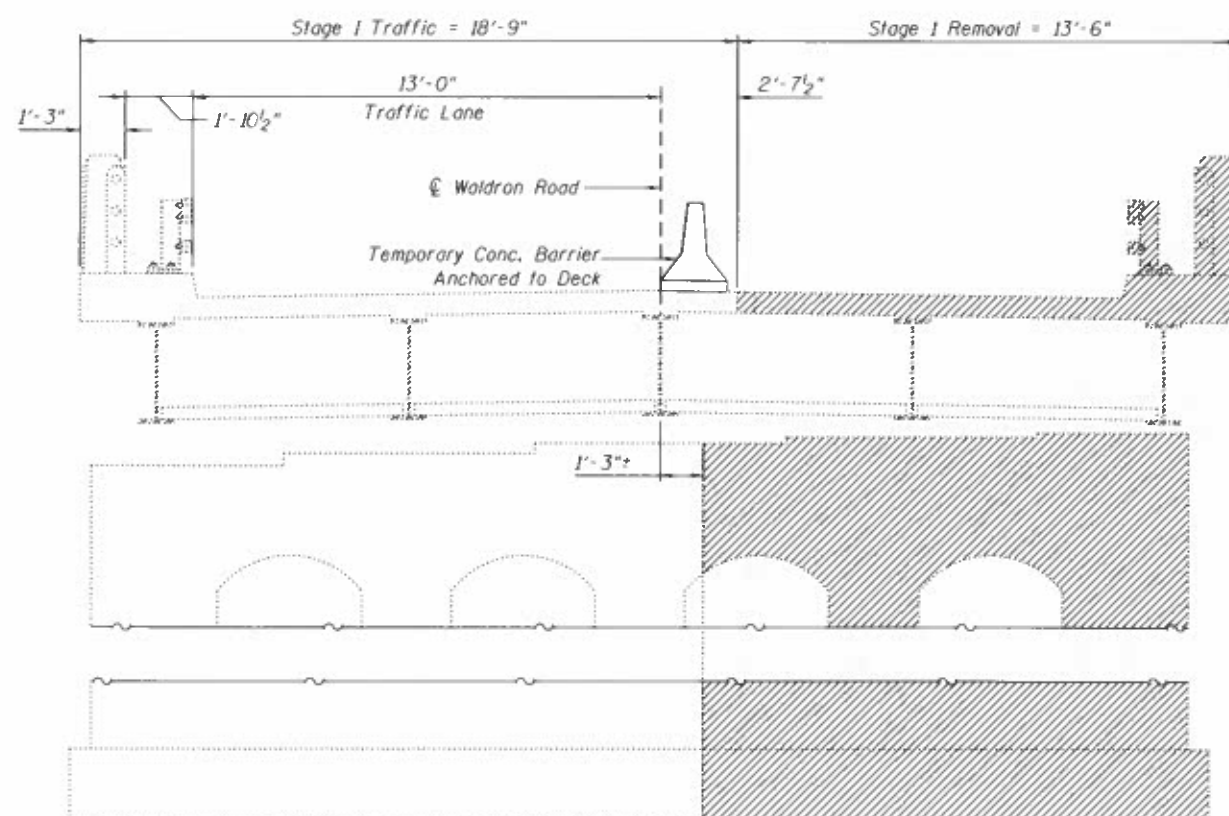

STAGE I DEMOLITION
Looking South East

LEGEND



Removal of Existing Structures

SN 046-0153 SEQUENCE OF WORK

Stage I

1. Erect Waldron Road Stage I traffic control, install temporary soil retention systems behind existing abutments, and remove stage I superstructure and roadway.
2. Erect I57 Stage I traffic control, remove Stage I of existing middle pier, and construct Stage I of new median pier.
3. Set Stage I soldier piles for Walls A & B.
4. Remove top block of existing abutments down to top of buttresses while installing timber lagging for the soldier pile walls. (The bottom of the "existing block" at the north abutment will be 2" +/- higher than the bottom of the proposed north abutment. The bottom of the "existing block" at the south abutment will be 4" +/- lower than the bottom of the proposed south abutment.)
5. Construct Stage I work for new abutments.
6. Construct Stage I superstructure and approach pavements. (The bottom of the proposed girders will be above the top of pier elevation of the existing outside piers.)

Stage II

1. Erect Waldron Road Stage II traffic control and remove stage II superstructure and roadway.
2. Maintain Erect I57 Stage I traffic control, remove Stage II of existing middle pier, and construct Stage II of new median pier.
3. Set Stage II soldier piles for Walls A & B.
4. Remove top block of existing abutments down to top of buttresses while installing timber lagging for the soldier pile walls.
5. Construct Stage II work for new abutments.
6. Erect I57 Stage II traffic control and remove existing outside piers.
7. Remove remainder of existing abutments while installing timber lagging for the soldier pile walls and removing soil between the new soldier pile wall and the existing outside piers.
8. Pour facing for soldier pile walls.
9. Construct Stage II superstructure and approach pavements.

Stage III

1. Erect Waldron Road Stage III traffic control.
2. Construct barrier wall between roadway and shared use path.
3. Install Bridge Fence Railing on outside parapet.
4. Open Waldron Road to normal traffic and continue I57 work below the bridge. (i.e., storm sewers parallel to soldier pile walls.)

NOTES

For quantity of Temporary Concrete Barrier, see Roadway Plans.

For details of Temporary Concrete Barrier, see sheet 50 of 54.

MODEL: STAGE CONST DETS 3
FILE NAME: G:\Users\1111111335-01-Waldron-Road-over-I57-Superstructure\Survey D366997\Consultant_Data\Chamlin_2020\CAD_Sheets\0460153-66997-003-004-005-STAGE_DETAILS.dgn
3/3/2021 3:33:52 PM




USER NAME	DESIGNED - JKC	REVISIONS
PLOT SCALE	CHECKED - AJO	REVISIONS
PLOT DATE	DRAWN - LAG	REVISIONS
	CHECKED - JKC	REVISIONS

STATE OF ILLINOIS
DEPARTMENT OF TRANSPORTATION


STAGE CONSTRUCTION DETAILS
STRUCTURE NO. 046-0153

SHEET 3 OF 54 SHEETS

F.A.I. RTE.	SECTION	COUNTY	TOTAL SHEETS	SHEET NO.
57	139HBR-6	KANKAKEE	202	92
CONTRACT NO. 66997				
ILLINOIS FED. AID PROJECT				

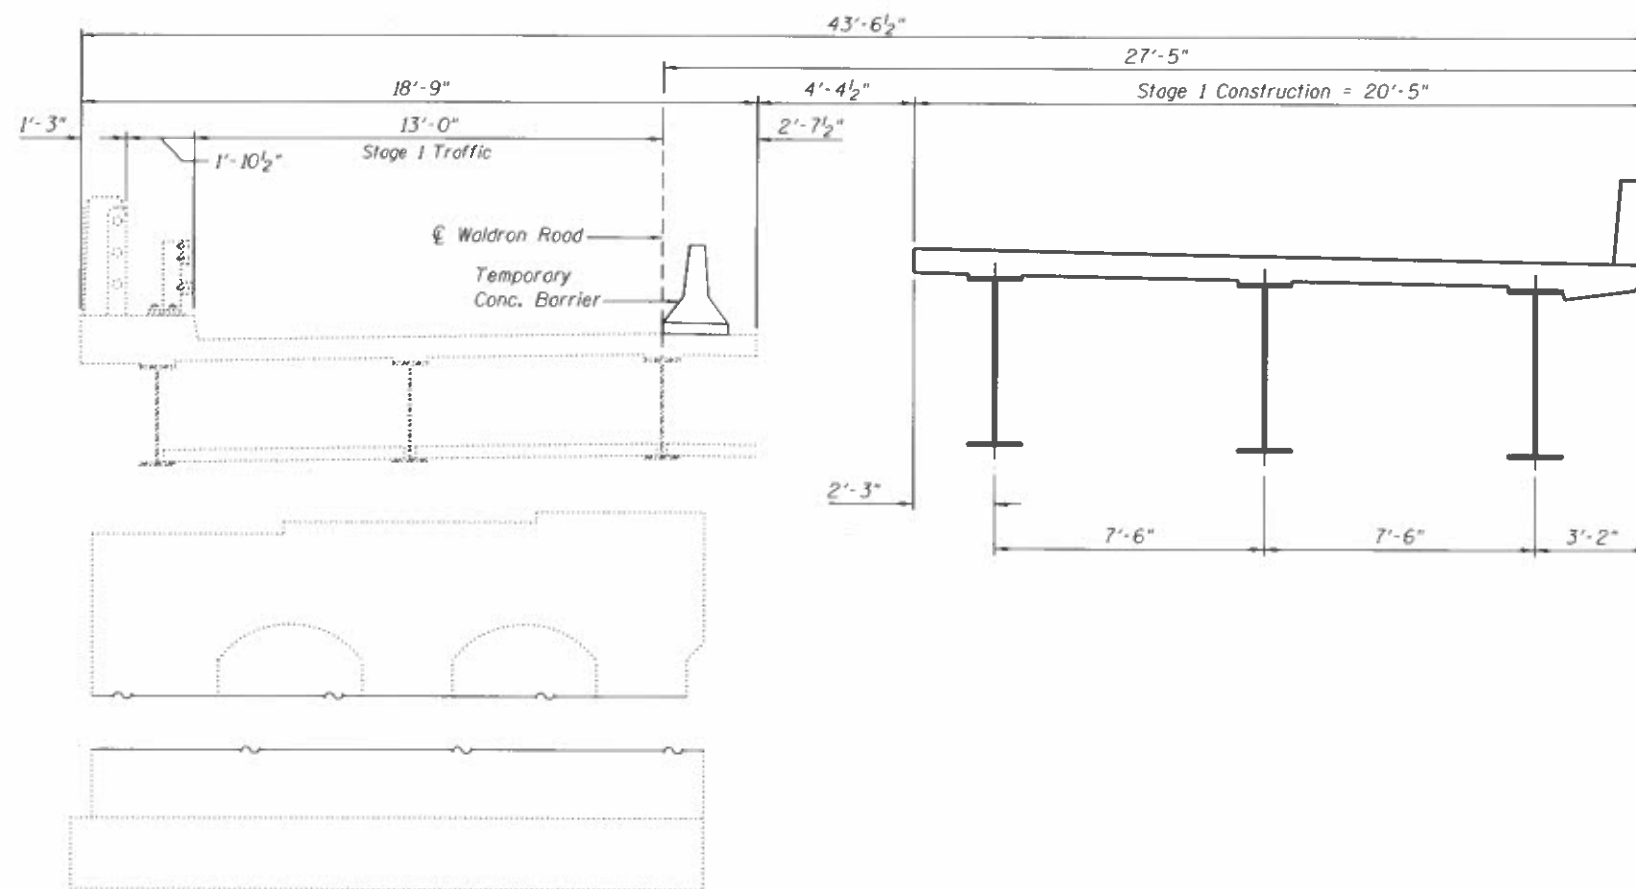

STAGE 1 CONSTRUCTION
Looking South East

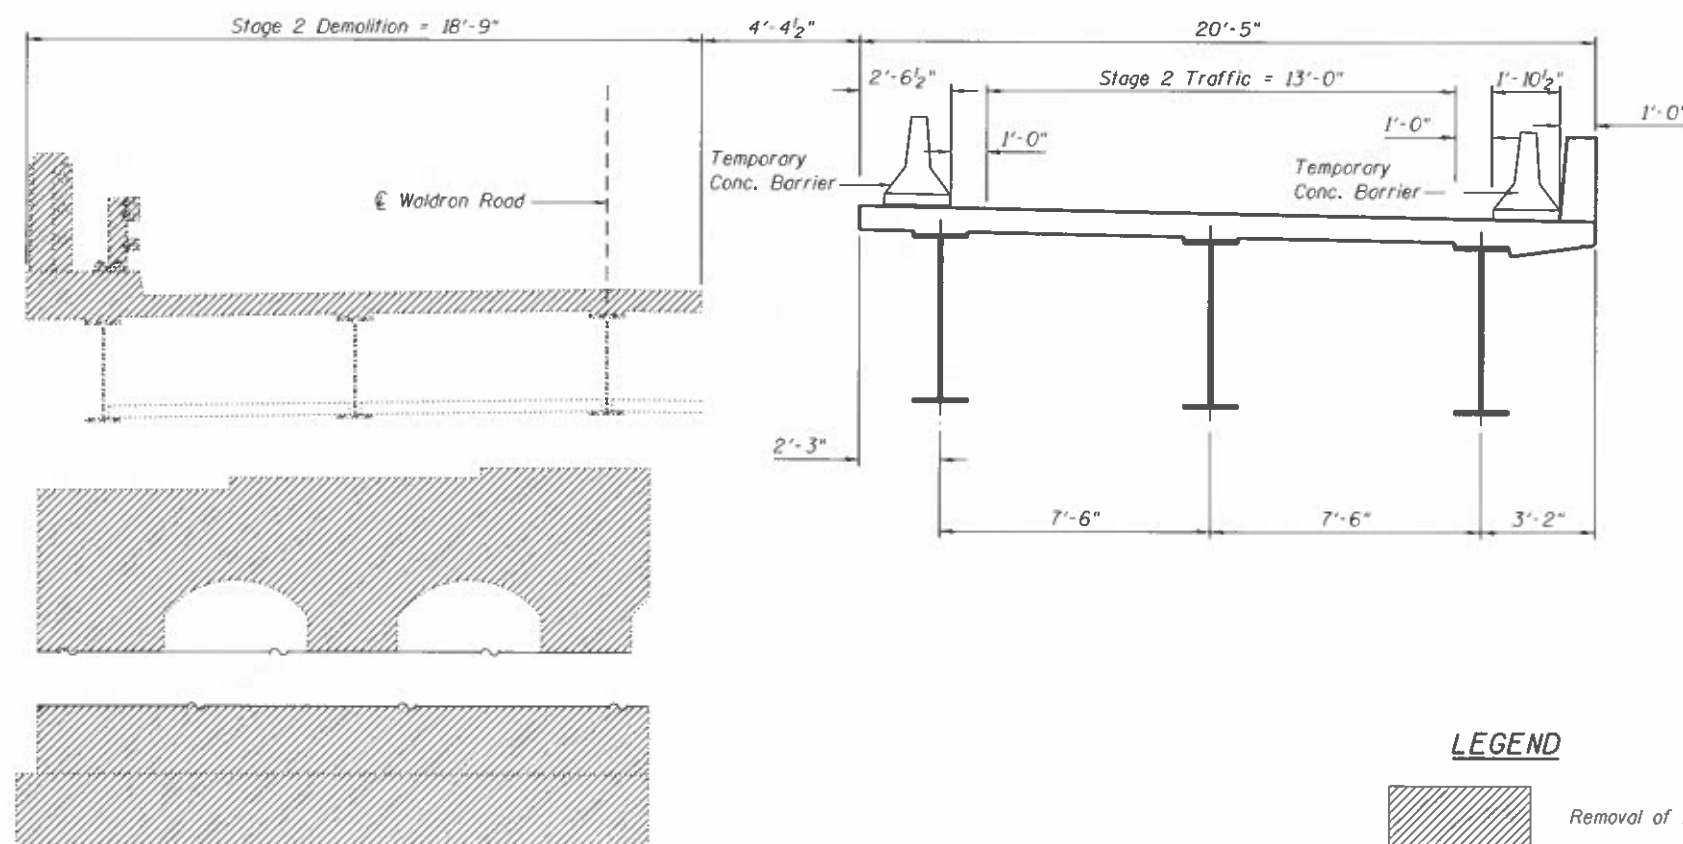

STAGE 2 DEMOLITION
Looking South East


NOTES

For quantity of Temporary Concrete Barrier,
see Roadway Plans.


For details of Temporary Concrete Barrier,
see sheet 50 of 54.

See sheet 3 of 54 for Sequence of work.


LEGEND

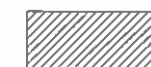

MODEL: STAGE CONST DETS 5
FILE NAME: C:\Users\j11111111\OneDrive\Documents\Survey Data\Chamlin_2020\CAD Sheets\0460153-66997-003-004-005-STAGE DETAILS.dgn
3/3/2021 10:27:11 AM

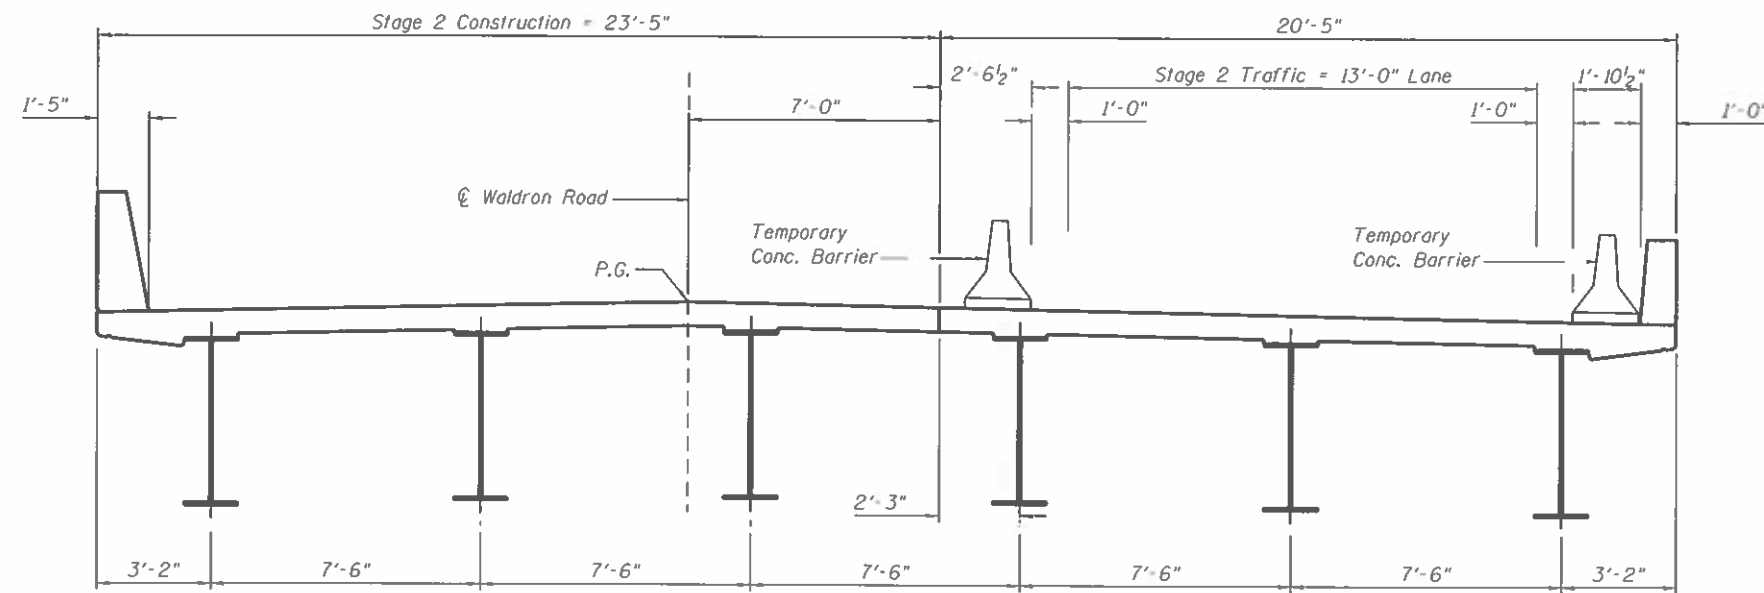

STAGE 2 CONSTRUCTION
Looking South East

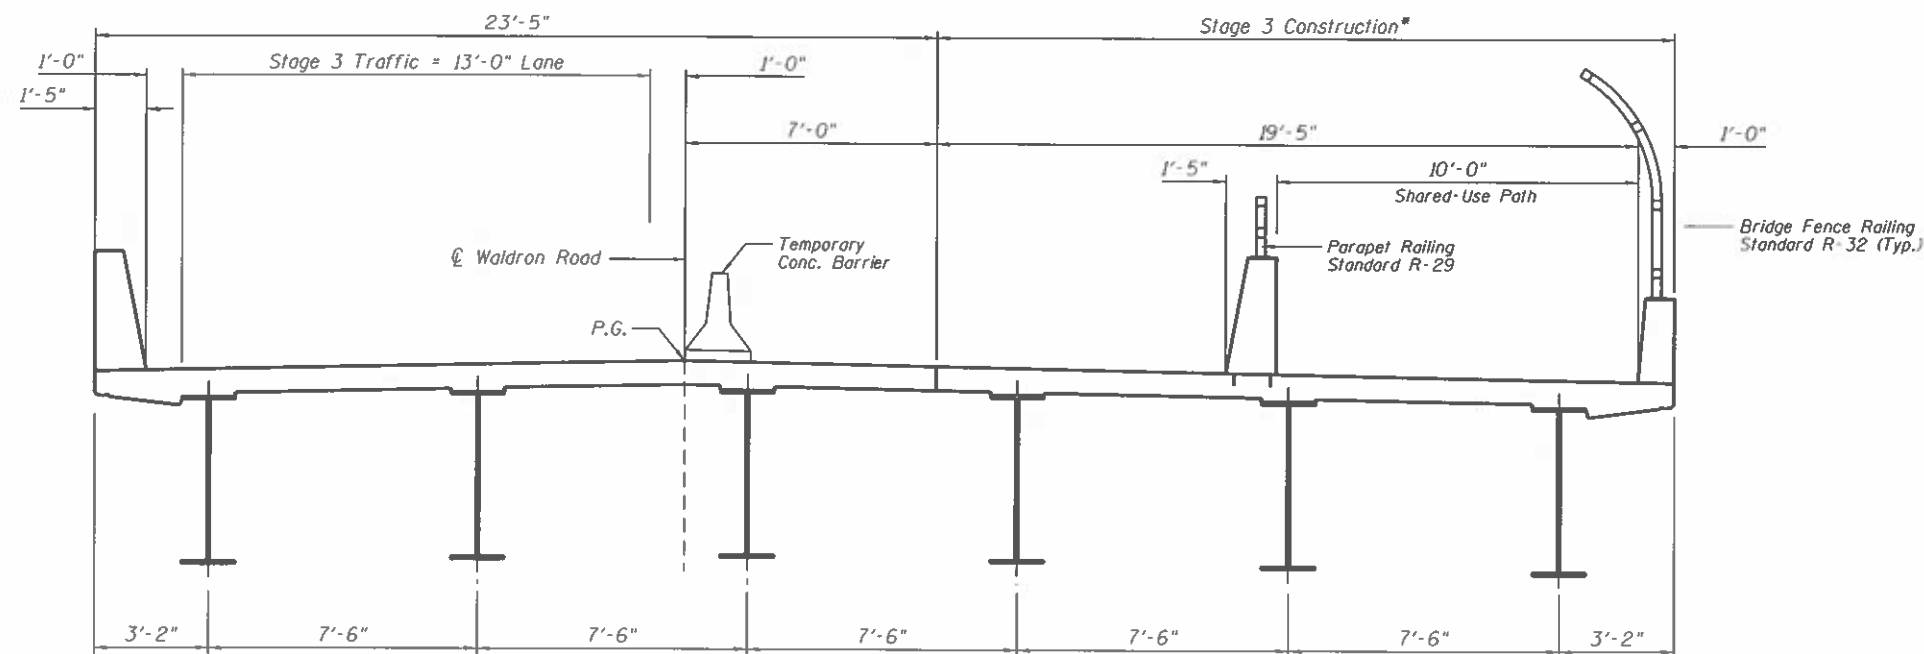

STAGE 3 CONSTRUCTION
Looking South East

* Stage 3 Construction is the addition of the Parapet separating the roadway from the shared-use path and the addition of the Parapet Railing and Bridge Fence Railing.

NOTES

Stage Construction Line differs for the superstructure and the substructure.

For quantity of Temporary Concrete Barrier, See Roadway Plans.

For details of Temporary Concrete Barrier see Sheet 50 of 54.

See sheet 3 of 54 for Sequence of Work.



USER NAME	DESIGNED - JKC	REVISED -
CHECKED - AJO	REVISED -	
DRAWN - LAG	REVISED -	
PLOT DATE	CHECKED - JKC	REVISED -


STATE OF ILLINOIS
DEPARTMENT OF TRANSPORTATION

STAGE CONSTRUCTION DETAILS
STRUCTURE NO. 046-0153

SHEET 5 OF 54 SHEETS

FAI RTE.	SECTION	COUNTY	TOTAL SHEETS	SHEET NO.
57	139HBR-6	KANKAKEE	202	94
CONTRACT NO. 66997				

ILLINOIS FED. AID PROJECT

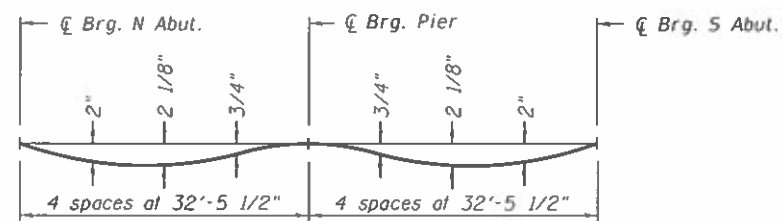


DEAD LOAD DEFLECTION DIAGRAM

(Includes weight of concrete only.)


Note:

The above deflections are not to be used in the field if the engineer is working from the grade elevations adjusted for dead load deflections as shown below and on sheet 8 of 54.

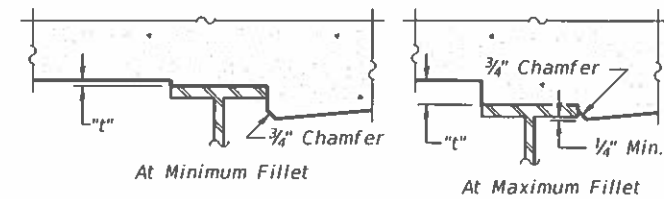

To determine "t": After all structural steel has been erected, elevations of the top flanges of the girders shall be taken at intervals shown below. These elevations subtracted from the "Theoretical Grade Elevations Adjusted for Dead Load Deflection" shown below and on sheet 8 of 54, minus slab thickness, equals the fillet heights "t" above top flange of girders.

FILLET HEIGHTS

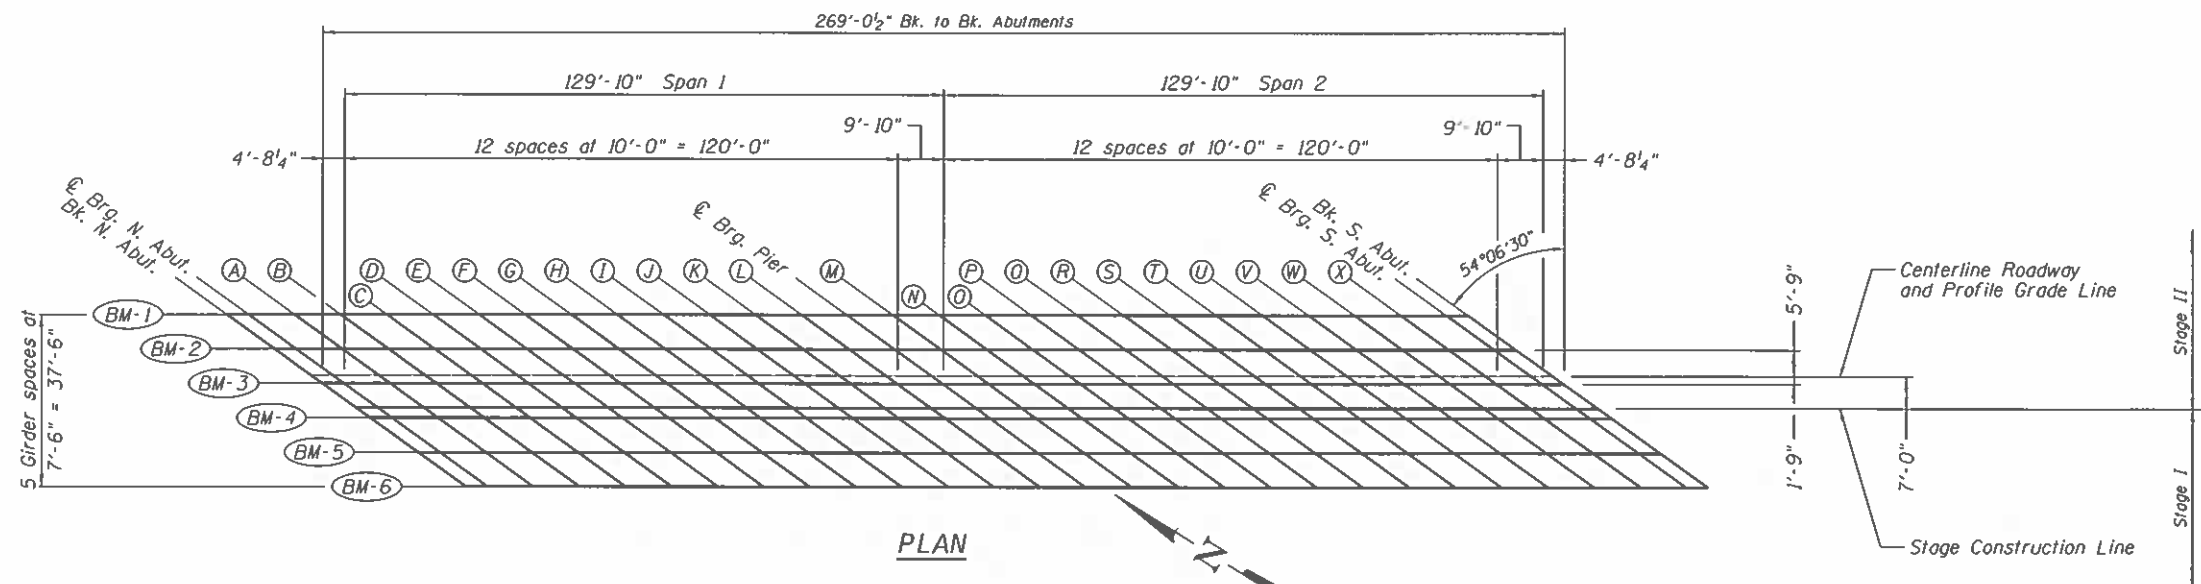

GIRDER 1				
Location	Station	Offset	Theoretical Grade Elevations	Theoretical Grade Elevations Adjusted for Dead Load Deflections
BK. N. ABUT	18+06.07	-13.25	658.89	658.89
CL. BRG N. ABUT	18+10.76	-13.25	658.91	658.91
	A 18+20.76	-13.25	658.96	659.01
	B 18+30.76	-13.25	658.99	659.09
	C 18+40.76	-13.25	659.00	659.15
	D 18+50.76	-13.25	659.00	659.18
	E 18+60.76	-13.25	658.99	659.17
	F 18+70.76	-13.25	658.97	659.14
	G 18+80.76	-13.25	658.93	659.08
	H 18+90.76	-13.25	658.88	659.00
	I 19+00.76	-13.25	658.82	658.90
	J 19+10.76	-13.25	658.74	658.80
	K 19+20.76	-13.25	658.65	658.68
	L 19+30.76	-13.25	658.55	658.56
CL. BRG. PIER	19+40.59	-13.25	658.44	658.44
	M 19+50.59	-13.25	658.31	658.32
	N 19+60.59	-13.25	658.16	658.19
	O 19+70.59	-13.25	658.01	658.06
	P 19+80.59	-13.25	657.84	657.93
	Q 19+90.59	-13.25	657.66	657.78
	R 20+00.59	-13.25	657.46	657.61
	S 20+10.59	-13.25	657.26	657.43
	T 20+20.59	-13.25	657.03	657.21
	U 20+30.59	-13.25	656.80	656.97
	V 20+40.59	-13.25	656.55	656.70
	W 20+50.59	-13.25	656.29	656.40
	X 20+60.59	-13.25	656.02	656.07
CL. BRG S. ABUT	20+70.42	-13.25	655.73	655.73
BK. S. ABUT	20+75.11	-13.25	655.59	655.59

GIRDER 2				
Location	Station	Offset	Theoretical Grade Elevations	Theoretical Grade Elevations Adjusted for Dead Load Deflections
BK. N. ABUT	18+16.43	-5.75	659.09	659.09
CL. BRG N. ABUT	18+21.12	-5.75	659.11	659.11
	A 18+31.12	-5.75	659.14	659.19
	B 18+41.12	-5.75	659.15	659.26
	C 18+51.12	-5.75	659.15	659.30
	D 18+61.12	-5.75	659.14	659.32
	E 18+71.12	-5.75	659.12	659.30
	F 18+81.12	-5.75	659.08	659.25
	G 18+91.12	-5.75	659.03	659.18
	H 19+01.12	-5.75	658.97	659.09
	I 19+11.12	-5.75	658.89	658.98
	J 19+21.12	-5.75	658.80	658.85
	K 19+31.12	-5.75	658.70	658.72
	L 19+41.12	-5.75	658.58	658.59
CL. BRG. PIER	19+50.95	-5.75	658.45	658.45
	M 19+60.95	-5.75	658.31	658.32
	N 19+70.95	-5.75	658.15	658.18
	O 19+80.95	-5.75	657.98	658.04
	P 19+90.95	-5.75	657.80	657.89
	Q 20+00.95	-5.75	657.61	657.73
	R 20+10.95	-5.75	657.40	657.55
	S 20+20.95	-5.75	657.18	657.35
	T 20+30.95	-5.75	656.94	657.12
	U 20+40.95	-5.75	656.69	656.86
	V 20+50.95	-5.75	656.43	656.58
	W 20+60.95	-5.75	656.16	656.26
	X 20+70.95	-5.75	655.87	655.92
CL. BRG S. ABUT	20+80.78	-5.75	655.57	655.57
BK. S. ABUT	20+85.48	-5.75	655.43	655.43

CENTERLINE ROADWAY AND PROFILE GRADE				
Location	Station	Offset	Theoretical Grade Elevations	Theoretical Grade Elevations Adjusted for Dead Load Deflections
BK. N. ABUT	18+24.38	0.00	659.23	659.23
CL. BRG N. ABUT	18+29.07	0.00	659.25	659.25
A	18+39.07	0.00	659.26	659.32
B	18+49.07	0.00	659.27	659.38
C	18+59.07	0.00	659.26	659.41
D	18+69.07	0.00	659.24	659.41
E	18+79.07	0.00	659.21	659.39
F	18+89.07	0.00	659.16	659.33
G	18+99.07	0.00	659.10	659.25
H	19+09.07	0.00	659.02	659.14
I	19+19.07	0.00	658.93	659.02
J	19+29.07	0.00	658.83	658.89
K	19+39.07	0.00	658.72	658.75
L	19+49.07	0.00	658.59	658.60
CL. BRG. PIER	19+58.90	0.00	658.45	658.45
M	19+68.90	0.00	658.30	658.31
N	19+78.90	0.00	658.13	658.16
O	19+88.90	0.00	657.96	658.01
P	19+98.90	0.00	657.76	657.85
Q	20+08.90	0.00	657.56	657.68
R	20+18.90	0.00	657.34	657.49
S	20+28.90	0.00	657.10	657.28
T	20+38.90	0.00	656.86	657.04
U	20+48.90	0.00	656.60	656.77
V	20+58.90	0.00	656.33	656.48
W	20+68.90	0.00	656.04	656.15
X	20+78.90	0.00	655.74	655.80
CL. BRG S. ABUT	20+88.73	0.00	655.44	655.44
BK. S. ABUT	20+93.42	0.00	655.29	655.29

E-S

2-17-2017



USER NAME =	DESIGNED - JKC	REVISED -
	CHECKED - AJO	REVISED -
PLOT SCALE =	DRAWN - LAG	REVISED -
PLOT DATE =	CHECKED - JKC	REVISED -

STATE OF ILLINOIS
DEPARTMENT OF TRANSPORTATION

TOP OF SLAB ELEVATIONS
STRUCTURE NO. 046-0153

SHEET 7 OF 54 SHEETS

F.A.I. RTE.	SECTION	COUNTY	TOTAL SHEETS	SHEET NO.
57	139HBR-6	KANKAKEE	202	96
CONTRACT NO. 66997				

MODEL: TOP SLAB ELEV 2
FILE NAME: G:\Users\1111111335-01-Waldron-Road-over-157-Superstructure\Survey D366997\Consultant_Data\Chamlin_2020\CAD_Sheets\0460153-66997-007-008-TOP-SLAB-ELEV.dgn
3/2/2021 2:37:42 PM

GIRDER 3				
Location	Station	Offset	Theoretical Grade Elevations	Theoretical Grade Elevations Adjusted for Dead Load Deflections
BK. N. ABUT	18+26.80	1.75	659.21	659.21
CL. BRG N. ABUT	18+31.49	1.75	659.22	659.22
A	18+41.49	1.75	659.23	659.29
B	18+51.49	1.75	659.23	659.34
C	18+61.49	1.75	659.22	659.37
D	18+71.49	1.75	659.20	659.37
E	18+81.49	1.75	659.16	659.34
F	18+91.49	1.75	659.11	659.28
G	19+01.49	1.75	659.04	659.20
H	19+11.49	1.75	658.97	659.09
I	19+21.49	1.75	658.88	658.96
J	19+31.49	1.75	658.77	658.83
K	19+41.49	1.75	658.66	658.68
L	19+51.49	1.75	658.52	658.53
CL. BRG. PIER	19+61.32	1.75	658.38	658.38
M	19+71.32	1.75	658.23	658.24
N	19+81.32	1.75	658.06	658.08
O	19+91.32	1.75	657.87	657.93
P	20+01.32	1.75	657.68	657.77
Q	20+11.32	1.75	657.47	657.59
R	20+21.32	1.75	657.25	657.40
S	20+31.32	1.75	657.01	657.18
T	20+41.32	1.75	656.76	656.94
U	20+51.32	1.75	656.50	656.67
V	20+61.32	1.75	656.23	656.37
W	20+71.32	1.75	655.94	656.05
X	20+81.32	1.75	655.64	655.69
CL. BRG S. ABUT	20+91.15	1.75	655.33	655.33
BK. S. ABUT	20+95.84	1.75	655.17	655.17

STAGE CONSTRUCTION LINE				
Location	Station	Offset	Theoretical Grade Elevations	Theoretical Grade Elevations Adjusted for Dead Load Deflections
BK. N. ABUT	18+34.05	7.00	659.12	659.12
CL. BRG N. ABUT	18+38.74	7.00	659.12	659.12
A	18+48.74	7.00	659.13	659.19
B	18+58.74	7.00	659.12	659.23
C	18+68.74	7.00	659.10	659.25
D	18+78.74	7.00	659.07	659.24
E	18+88.74	7.00	659.02	659.20
F	18+98.74	7.00	658.96	659.13
G	19+08.74	7.00	658.88	659.04
H	19+18.74	7.00	658.80	658.92
I	19+28.74	7.00	658.70	658.78
J	19+38.74	7.00	658.58	658.64
K	19+48.74	7.00	658.46	658.48
L	19+58.74	7.00	658.32	658.32
CL. BRG. PIER	19+68.57	7.00	658.17	658.17
M	19+78.57	7.00	658.00	658.01
N	19+88.57	7.00	657.82	657.85
O	19+98.57	7.00	657.63	657.68
P	20+08.57	7.00	657.42	657.51
Q	20+18.57	7.00	657.20	657.33
R	20+28.57	7.00	656.97	657.12
S	20+38.57	7.00	656.73	656.90
T	20+48.57	7.00	656.47	656.65
U	20+58.57	7.00	656.20	656.37
V	20+68.57	7.00	655.91	656.06
W	20+78.57	7.00	655.61	655.72
X	20+88.57	7.00	655.30	655.36
CL. BRG S. ABUT	20+98.40	7.00	654.98	654.98
BK. S. ABUT	21+03.09	7.00	654.83	654.83

GIRDER 4				
Location	Station	Offset	Theoretical Grade Elevations	Theoretical Grade Elevations Adjusted for Dead Load Deflections
BK. N. ABUT	18+37.16	9.25	659.08	659.08
CL. BRG N. ABUT	18+41.85	9.25	659.08	659.08
A	18+51.85	9.25	659.08	659.14
B	18+61.85	9.25	659.07	659.18
C	18+71.85	9.25	659.05	659.19
D	18+81.85	9.25	659.01	659.18
E	18+91.85	9.25	658.96	659.14
F	19+01.85	9.25	658.89	659.06
G	19+11.85	9.25	658.81	658.96
H	19+21.85	9.25	658.72	658.84
I	19+31.85	9.25	658.62	658.70
J	19+41.85	9.25	658.50	658.55
K	19+51.85	9.25	658.37	658.40
L	19+61.85	9.25	658.23	658.23
CL. BRG. PIER	19+71.68	9.25	658.07	658.07
M	19+81.68	9.25	657.90	657.91
N	19+91.68	9.25	657.72	657.74
O	20+01.68	9.25	657.52	657.58
P	20+11.68	9.25	657.31	657.40
Q	20+21.68	9.25	657.09	657.21
R	20+31.68	9.25	656.85	657.00
S	20+41.68	9.25	656.60	656.78
T	20+51.68	9.25	656.34	656.52
U	20+61.68	9.25	656.07	656.24
V	20+71.68	9.25	655.78	655.92
W	20+81.68	9.25	655.47	655.58
X	20+91.68	9.25	655.16	655.22
CL. BRG S. ABUT	21+01.51	9.25	654.84	654.84
BK. S. ABUT	21+06.20	9.25	654.68	654.68

GIRDER 5				
Location	Station	Offset	Theoretical Grade Elevations	Theoretical Grade Elevations Adjusted for Dead Load Deflections
BK. N. ABUT	18+47.53	16.75	658.93	658.93
CL. BRG N. ABUT	18+52.22	16.75	658.93	658.93
A	18+62.22	16.75	658.92	658.98
B	18+72.22	16.75	658.90	659.00
C	18+82.22	16.75	658.86	659.00
D	18+92.22	16.75	658.80	658.98
E	19+02.22	16.75	658.74	658.92
F	19+12.22	16.75	658.66	658.83
G	19+22.22	16.75	658.57	658.72
H	19+32.22	16.75	658.46	658.58
I	19+42.22	16.75	658.35	658.43
J	19+52.22	16.75	658.21	658.27
K	19+62.22	16.75	658.07	658.10
L	19+72.22	16.75	657.91	657.92
CL. BRG. PIER	19+82.05	16.75	657.74	657.74
M	19+92.05	16.75	657.56	657.57
N	20+02.05	16.75	657.36	657.39
O	20+12.05	16.75	657.15	657.21
P	20+22.05	16.75	656.93	657.02
Q	20+32.05	16.75	656.69	656.81
R	20+42.05	16.75	656.44	656.60
S	20+52.05	16.75	656.18	656.35
T	20+62.05	16.75	655.91	656.09
U	20+72.05	16.75	655.62	655.79
V	20+82.05	16.75	655.31	655.46
W	20+92.05	16.75	655.00	655.11
X	21+02.05	16.75	654.67	654.73
CL. BRG S. ABUT	21+11.88	16.75	654.33	654.33
BK. S. ABUT	21+16.57	16.75	654.17	654.17

GIRDER 6				
Location	Station	Offset	Theoretical Grade Elevations	Theoretical Grade Elevations Adjusted for Dead Load Deflections
BK. N. ABUT	18+57.89	24.25	658.78	658.78
CL. BRG N. ABUT	18+62.58	24.25	658.77	658.77
A	18+72.58	24.25	658.74	658.80
B	18+82.58	24.25	658.70	658.81
C	18+92.58	24.25	658.65	658.80
D	19+02.58	24.25	658.59	658.76
E	19+12.58	24.25	658.51	658.69
F	19+22.58	24.25	658.42	658.59
G	19+32.58	24.25	658.31	658.46
H	19+42.58	24.25	658.19	658.31
I	19+52.58	24.25	658.06	658.15
J	19+62.58	24.25	657.91	657.97
K	19+72.58	24.25	657.76	657.78
L	19+82.58	24.25	657.59	657.59
CL. BRG. PIER	19+92.41	24.25	657.40	657.40
M	20+02.41	24.25	657.21	657.21
N	20+12.41	24.25	657.00	657.02
O	20+22.41	24.25	656.77	656.83
P	20+32.41	24.25	656.54	656.62
Q	20+42.41	24.25	656.28	656.41
R	20+52.41	24.25	656.02	656.17
S	20+62.41	24.25	655.74	655.92
T	20+72.41	24.25	655.45	655.64
U	20+82.41	24.25	655.15	655.32
V	20+92.41	24.25	654.84	654.98
W	21+02.41	24.25	654.51	654.61
X	21+12.41	24.25	654.16	654.22
CL. BRG S. ABUT	21+22.24	24.25	653.81	653.81
BK. S. ABUT	21+26.93	24.25	653.64	653.64



USER NAME	DESIGNED - JKC	REVISED -
PLOT SCALE	CHECKED - AJO	REVISED -
PLOT DATE	DRAWN - LAG	REVISED -
	CHECKED - JKC	REVISED -

STATE OF ILLINOIS
DEPARTMENT OF TRANSPORTATION

TOP OF SLAB ELEVATIONS
STRUCTURE NO. 046-0153

SHEET 8 OF 54 SHEETS

F.A.I. RTE.	SECTION	COUNTY	TOTAL SHEETS	SHEET NO.
57	139HBR-5	KANKAKEE	202	97
CONTRACT NO. 66997				
ILLINOIS FED. AID PROJECT				

EAST EDGE OF SHOULDER			
Location	Station	Offset	Theoretical Grade
N. End South Appr. Pav't	20+70.98	-15.01	655.68
A1	20+80.11	-15.64	655.39
A2	20+89.25	-16.26	655.10
S. End South Appr. Pav't	20+98.38	-16.89	654.79


EAST EDGE OF PAVEMENT			
Location	Station	Offset	Theoretical Grade
N. End South Appr. Pav't	20+75.14	-12.00	655.62
A1	20+85.14	-12.00	655.31
A2	20+95.14	-12.00	654.99
S. End South Appr. Pav't	21+05.14	-12.00	654.66

CENTERLINE ROADWAY AND PROFILE GRADE			
Location	Station	Offset	Theoretical Grade
N. End South Appr. Pav't	20+91.72	0.00	655.34
A1	21+01.72	0.00	655.01
A2	21+11.72	0.00	654.67
S. End South Appr. Pav't	21+22.72	0.00	654.28

STAGE CONSTRUCTION LINE			
Location	Station	Offset	Theoretical Grade
N. End South Appr. Pav't	21+01.40	7.00	654.89
A1	21+11.40	7.00	654.54
A2	21+21.40	7.00	654.19
S. End South Appr. Pav't	21+31.40	7.00	653.82

WEST EDGE OF PAVEMENT			
Location	Station	Offset	Theoretical Grade
N. End South Appr. Pav't	21+08.31	12.00	654.55
A1	21+18.31	12.00	654.20
A2	21+28.31	12.00	653.84
S. End South Appr. Pav't	21+38.31	12.00	653.46

WEST EDGE OF SHOULDER			
Location	Station	Offset	Theoretical Grade
N. End South Appr. Pav't	21+28.23	26.42	653.55
A1	21+38.86	26.88	653.14
A2	21+49.78	27.54	652.70
S. End South Appr. Pav't	21+60.70	28.21	652.24

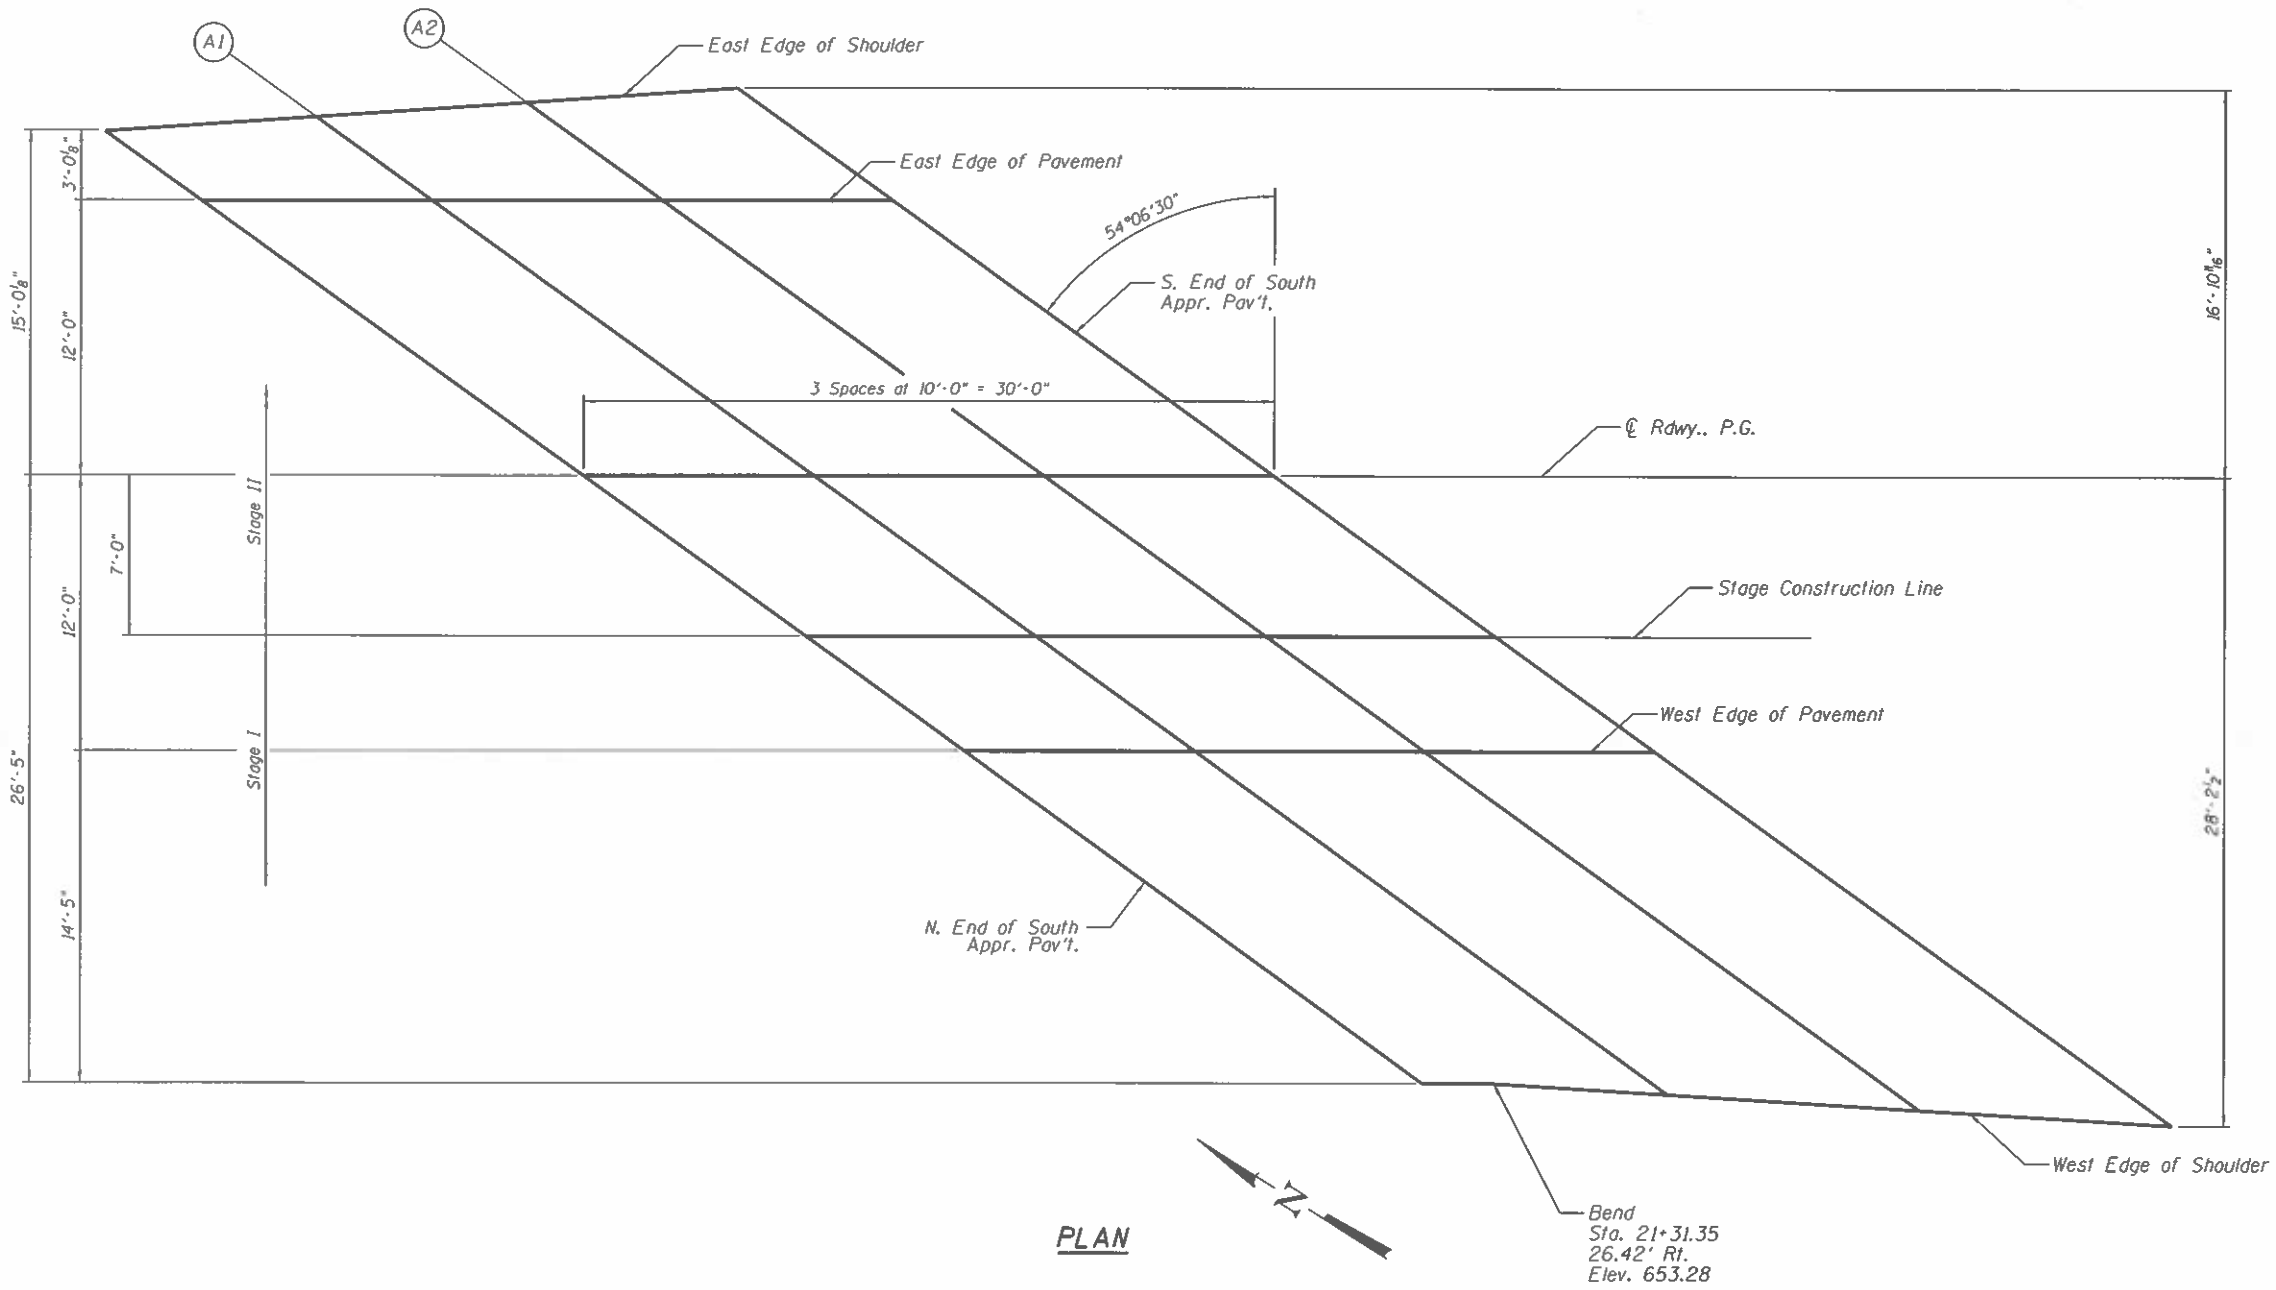

PLAN

E-AS

2-17-2017



USER NAME	DESIGNED - JKC	REVISION
PLOT SCALE	CHECKED - AJO	REVISION
PLOT DATE	DRAWN - LAG	REVISION
	CHECKED - JKC	REVISION


STATE OF ILLINOIS
DEPARTMENT OF TRANSPORTATION

TOP OF SOUTH APPROACH SLAB ELEVATIONS
STRUCTURE NO. 046-0153

SHEET 10 OF 54 SHEETS

F.A.I. RTE.	SECTION	COUNTY	TOTAL SHEETS	SHEET NO.
57	139HBR-6	KANKAKEE	202	99
CONTRACT NO. 66997				
ILLINOIS FED. AID PROJECT				

MODEL: SOUTH APP ELEV
FILE NAME: G:\Users\11111111335-01-Waldron-Road-over\Survey D366997\Consultant_Data\Chamlin_2020\CAD Sheets\0460153 66997-009-010-TOPAPP SLAB ELEV.dgn
3/2/2021 2:42:53 PM

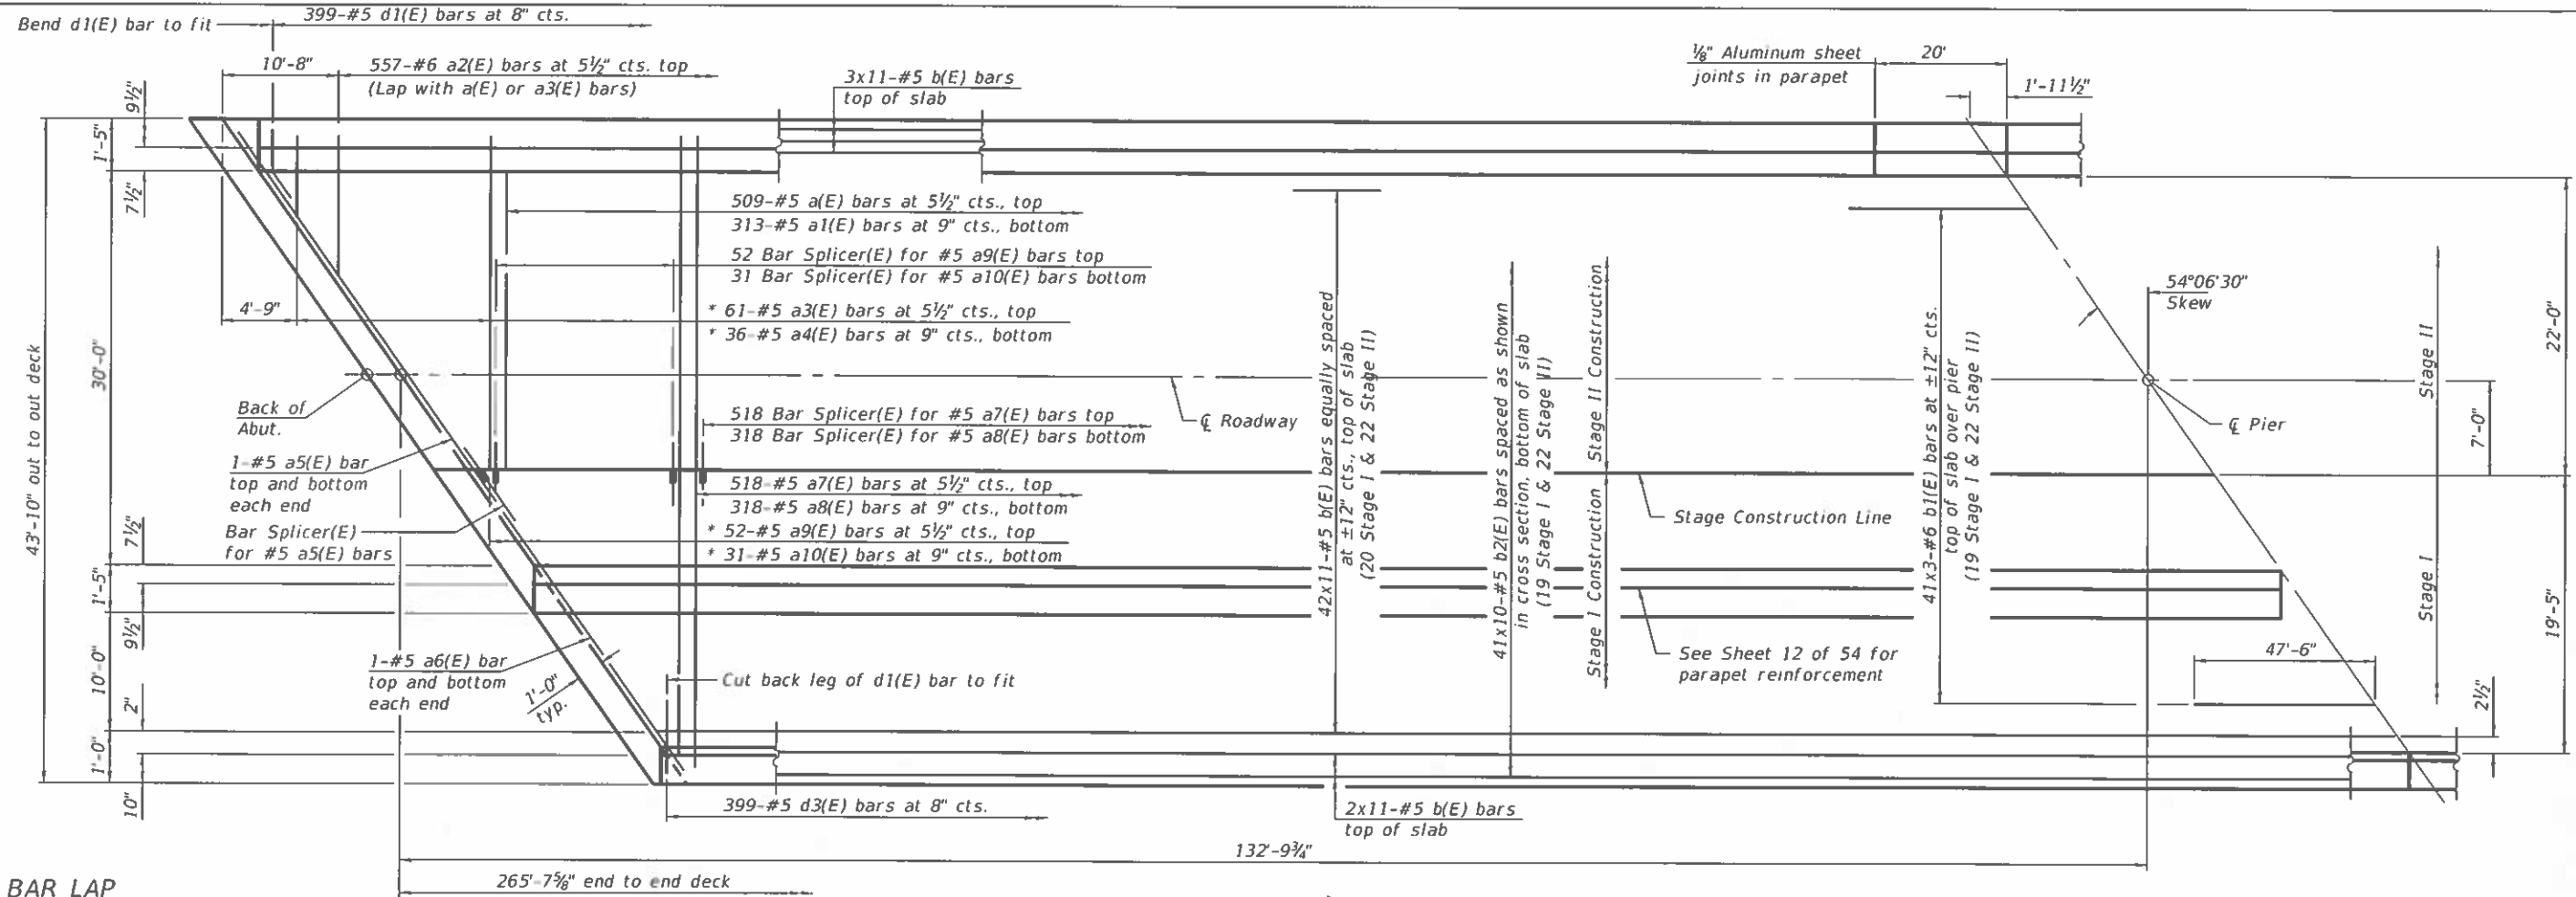


PARTIAL PLAN

MINIMUM BAR LAP

#5 bar = 3'-6"
#6 bar = 3'-7"

* See Field Cutting Diagram on sheet 12 of 54.

Notes:
See sheets 12-14 of 54 for superstructure details and Bill of Material.
Bars indicated thus 20 x 3-#5 etc. indicates 20 lines of bars with 3 lengths per line.
See sheet 49 of 54 for bar splicer details.

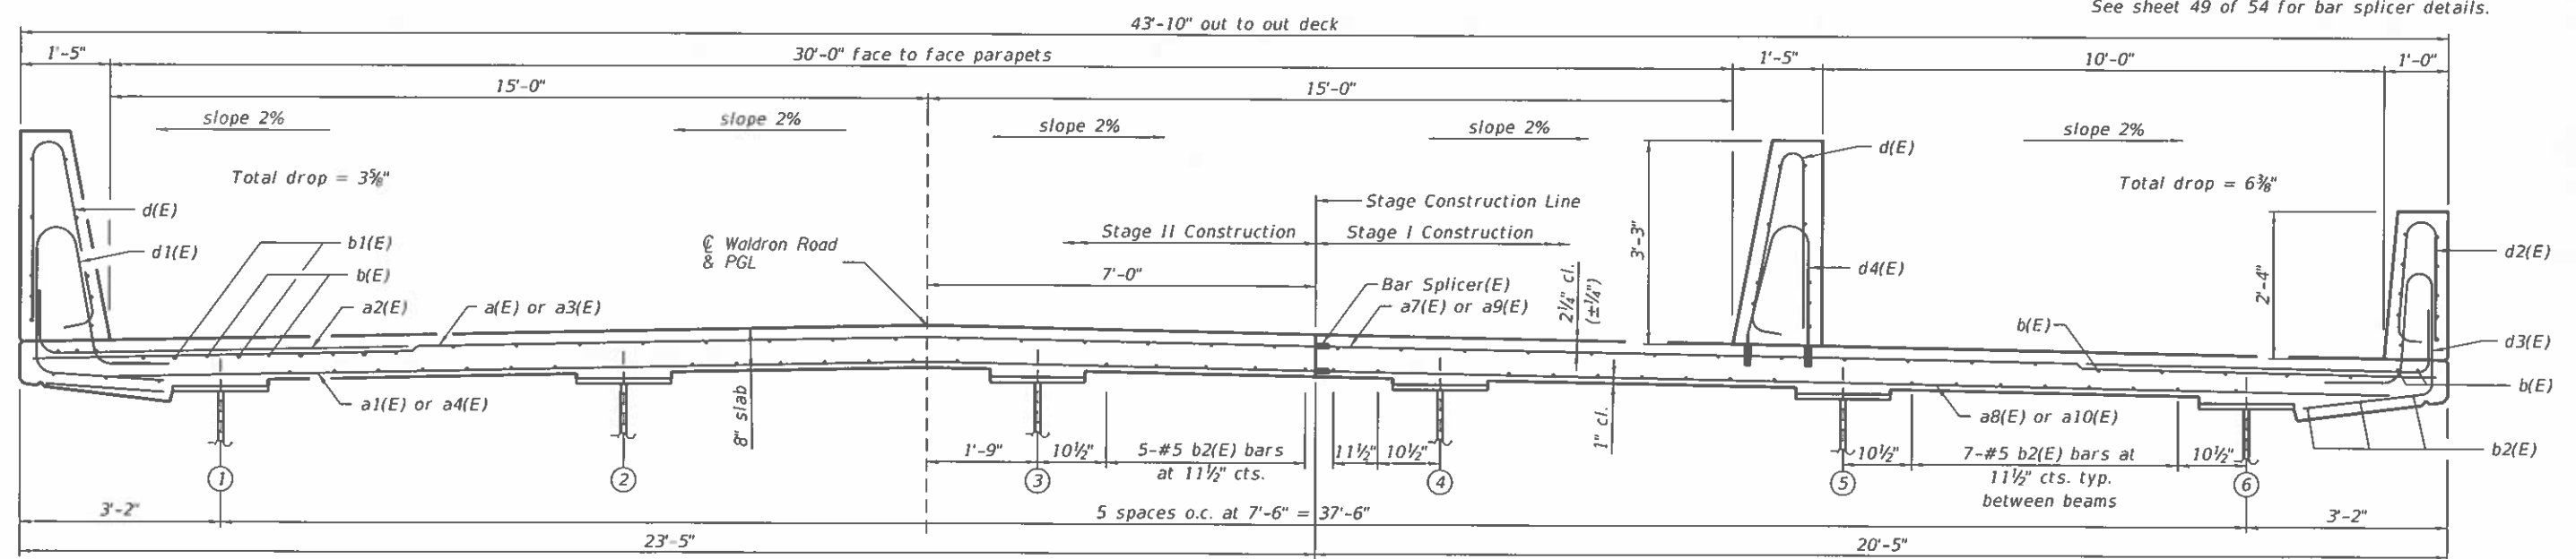

CROSS SECTION
(Looking South)



USER NAME *	DESIGNED - JKC	REVISED -
PLOT SCALE *	CHECKED - AJO	REVISED -
PLOT DATE *	DRAWN - LAG	REVISED -
	CHECKED - JKC	REVISED -

STATE OF ILLINOIS
DEPARTMENT OF TRANSPORTATION



SUPERSTRUCTURE
STRUCTURE NO. 046-0153

F.A.I. RTE.	SECTION	COUNTY	TOTAL SHEETS	SHEET NO.
57	139HBR-6	KANKAKEE	202	100
CONTRACT NO. 66997				



SHEET 11 OF 54 SHEETS

ILLINOIS FED. AID PROJECT


MODEL: TEMP CONC BARRIER
FILE NAME: G:\Users\N11111335-01\Waldron-Road-over-457-Superstructure\Survey D366997\Consultant_Data\Chamlin_2020\CAD_Sheets\0460153-66997-011-SUPERSTRUCTURE.dgn
3/2/2021 2:46:30 PM

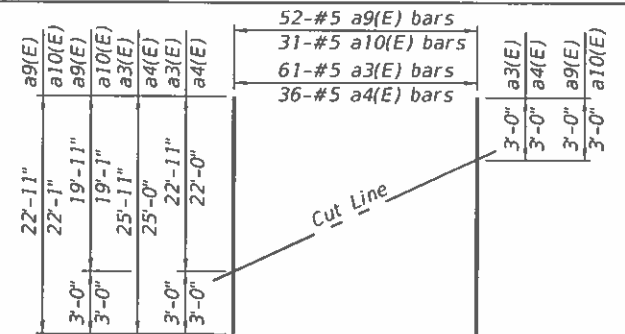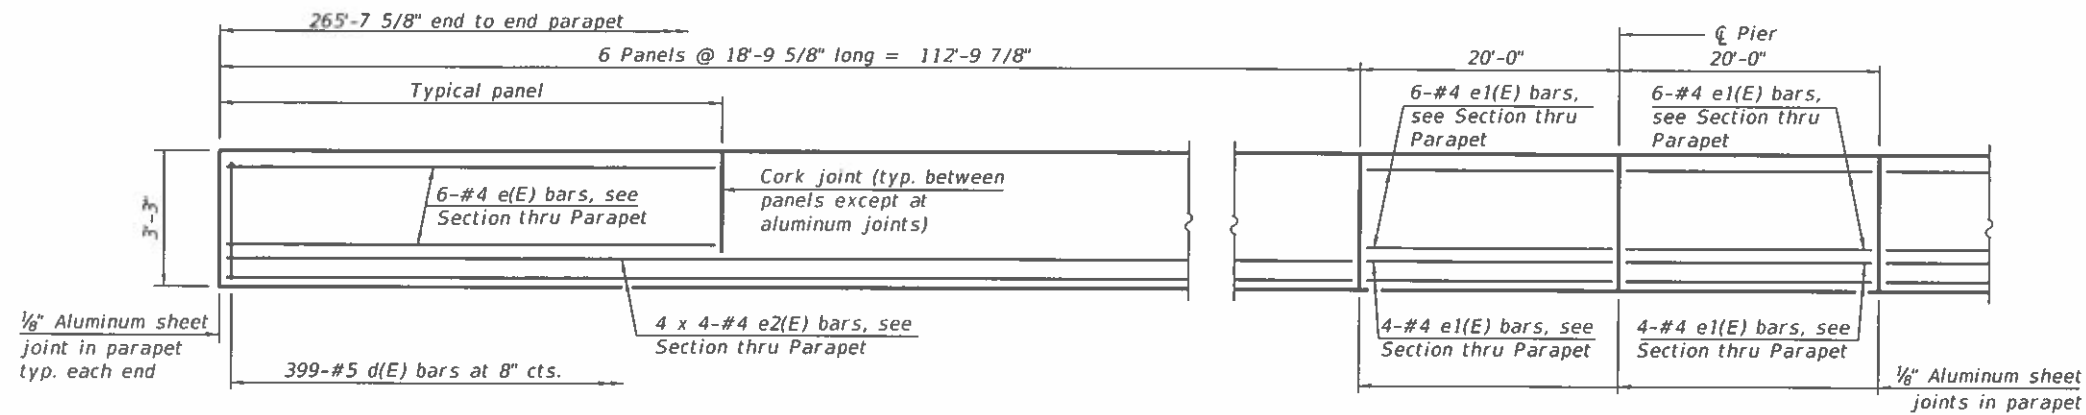

FIELD CUTTING DIAGRAM
Order a3(E), a4(E), a9(E) and a10(E) bars full length. Cut as shown and use remainder of bars in opposite end of deck.

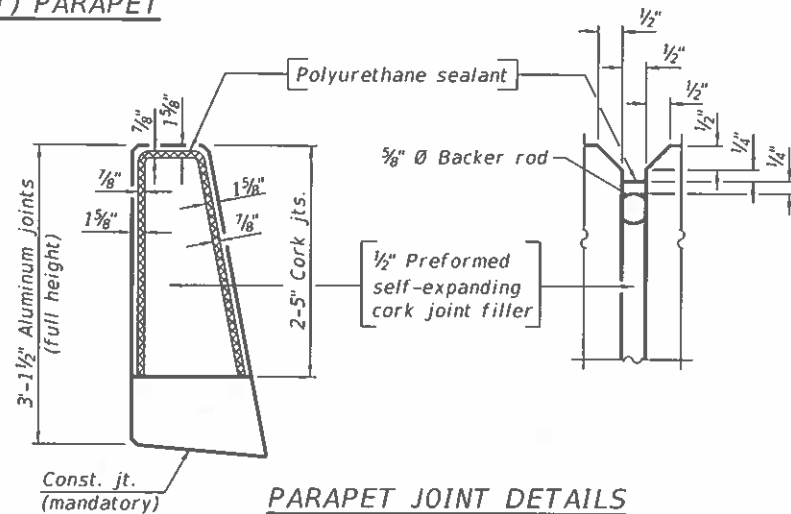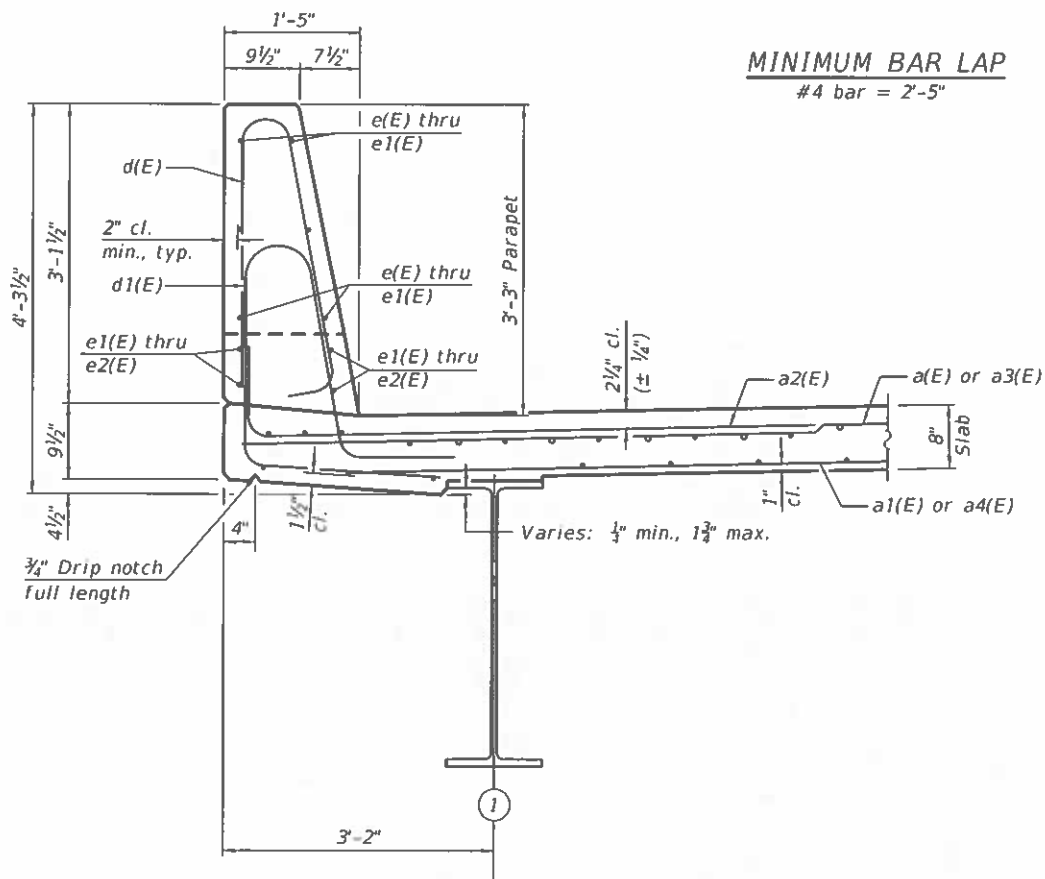


Notes:
The 1/8\" aluminum sheet shall be ASTM B 209 alloy 3003-H14 and coated to minimize reaction with wet concrete. Cost included with Concrete Superstructure.
The polyurethane sealant shall be according to Article 1050.04 of the Std. Spec. and the color shall be gray.
Headed bars shall conform to ASTM A970 with threaded attachment; Class HA; and reinforcement bars conforming to ASTM A706. Cost included with Reinforcement Bars, Epoxy Coated.

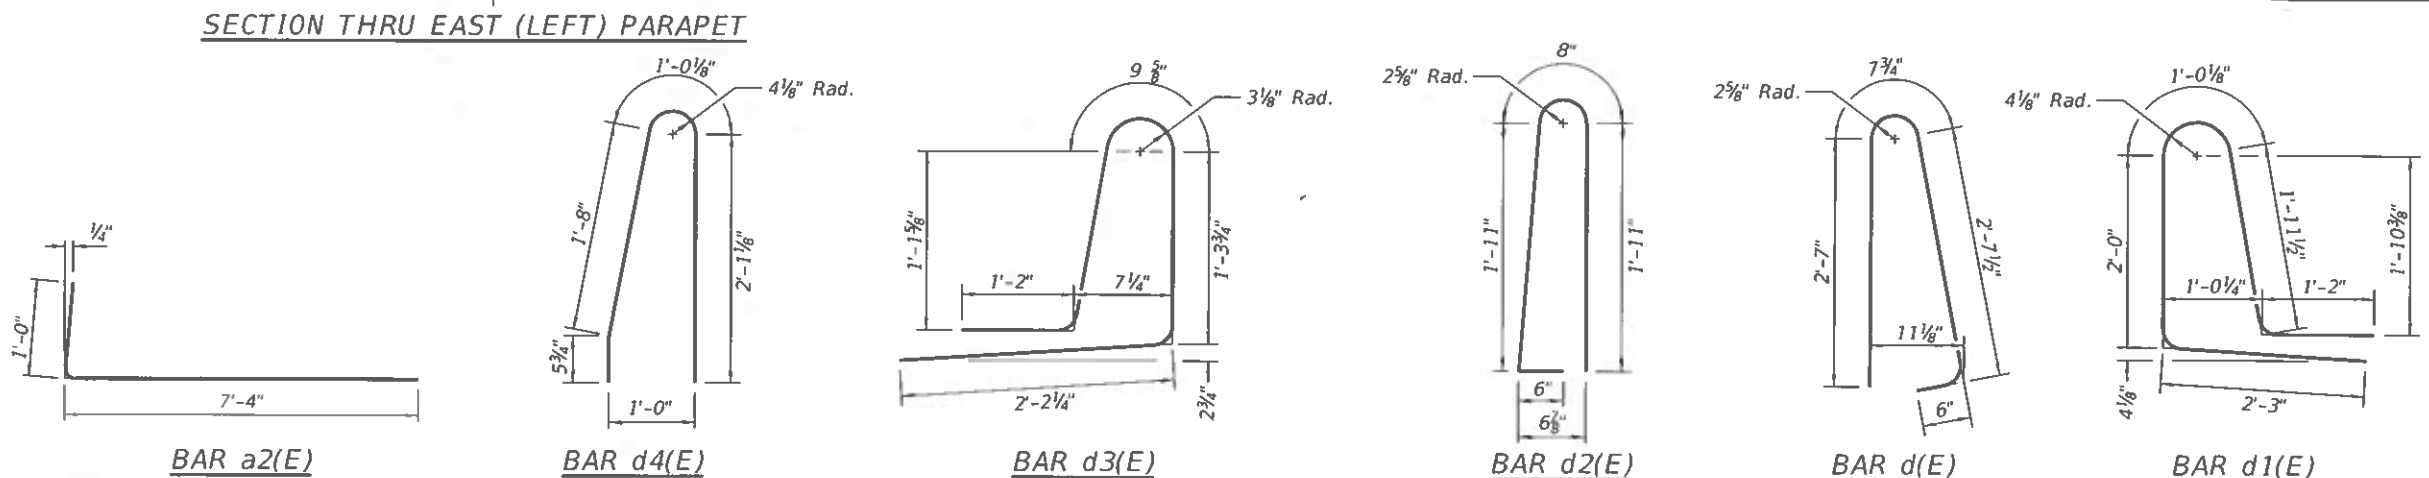


SUPERSTRUCTURE BILL OF MATERIAL

Bar	No.	Size	Length	Shape
a(E)	509	#5	23'-2"	—
a1(E)	313	#5	22'-2"	—
a2(E)	1114	#6	8'-4"	—
a3(E)	61	#5	25'-11"	—
a4(E)	36	#5	25'-0"	—
a5(E)	4	#5	39'-7"	—
a6(E)	4	#5	34'-6"	—
a7(E)	518	#5	20'-2"	—
a8(E)	318	#5	19'-2"	—
a9(E)	52	#5	22'-11"	—
a10(E)	31	#5	22'-1"	—
b(E)	517	#5	27'-5"	—
b1(E)	123	#6	34'-1"	—
b2(E)	410	#5	29'-8"	—
d(E)	798	#5	6'-5"	—
d1(E)	399	#5	8'-5"	—
d2(E)	399	#5	5'-0"	—
d3(E)	399	#5	6'-10"	—
d4(E)	399	#5	5'-3"	—
e(E)	216	#4	18'-6"	—
e1(E)	60	#4	19'-8"	—
e2(E)	96	#4	29'-11"	—
m10(E)	4	#6	34'-8"	—
m11(E)	16	#6	12'-6"	—
m12(E)	24	#6	12'-6"	—
m13(E)	8	#6	34'-8"	—
m14(E)	20	#6	5'-1"	—
m15(E)	4	#4	34'-8"	—
m20(E)	4	#6	39'-9"	—
m23(E)	8	#6	39'-9"	—
m25(E)	4	#4	39'-9"	—
s10(E)	82	#5	10'-10"	—
s11(E)	82	#5	14'-10"	—
u10(E)	82	#4	7'-2"	—
Reinforcement Bars, Epoxy Coated		Lbs.	115720	
Concrete Superstructure		Cu. Yds.	489.8	

Bars indicated thus 1 x 2-#4 etc. indicates 1 line of bars with 2 lengths per line.

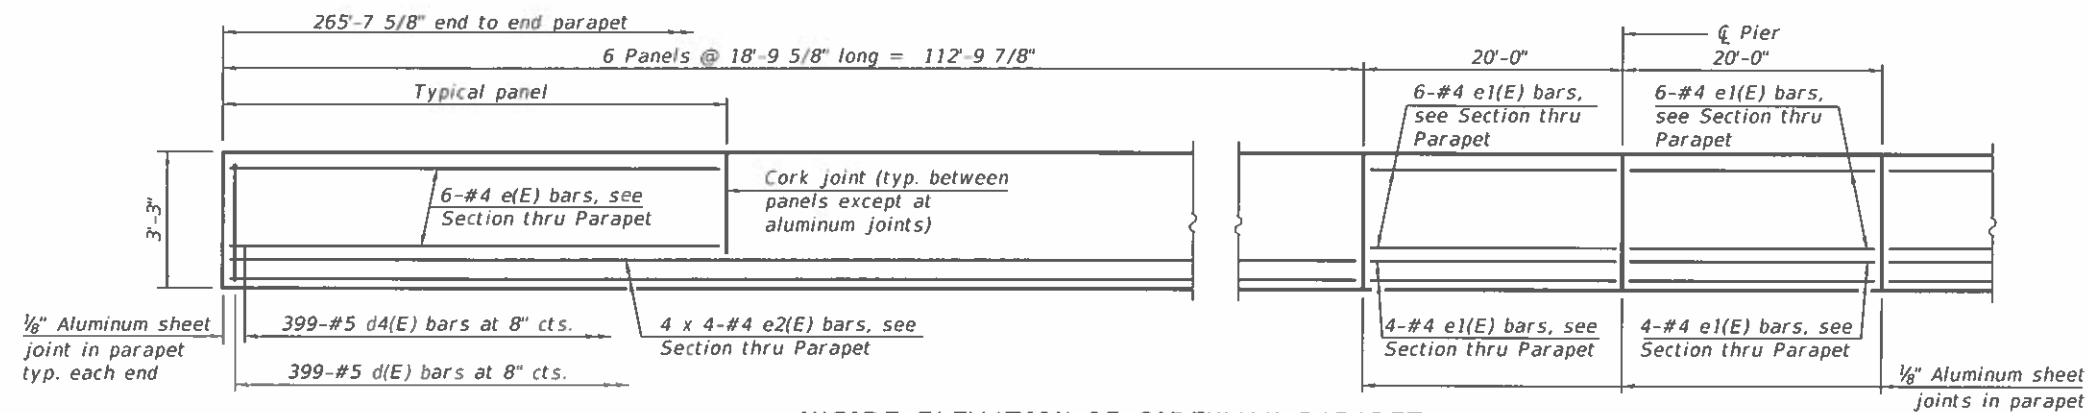


INSIDE ELEVATION OF SIDEWALK PARAPET
BETWEEN ROADWAY AND PATH

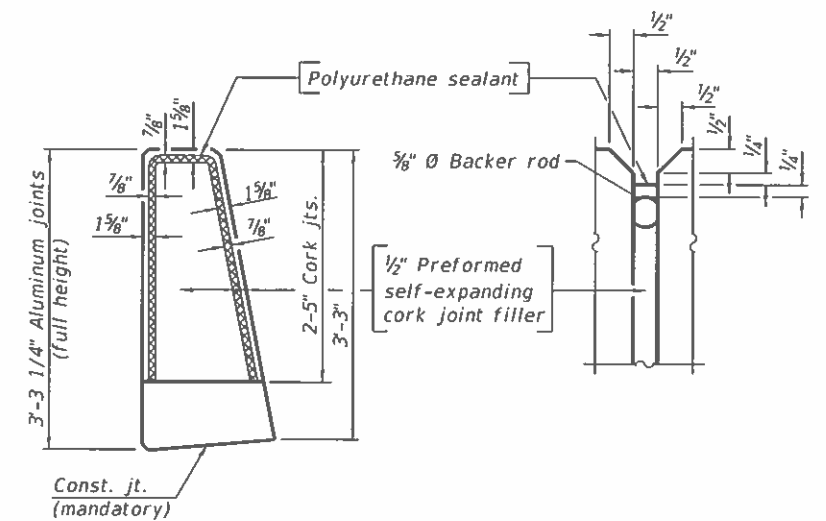


PARAPET JOINT DETAILS

Notes:
The 1/8\" aluminum sheet shall be ASTM B 209 alloy 3003-H14 and coated to minimize reaction with wet concrete. Cost included with Concrete Superstructure.
The polyurethane sealant shall be according to Article 1050.04 of the Std. Spec. and the color shall be gray.

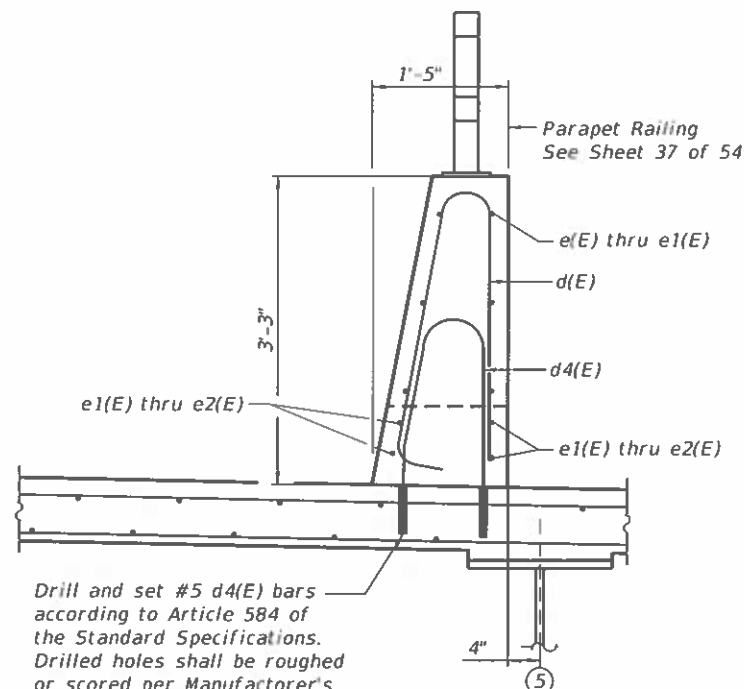

SECTION THRU SIDEWALK PARAPET

Drill and set #5 d4(E) bars according to Article 584 of the Standard Specifications. Drilled holes shall be roughed or scored per Manufacturer's recommendations. Maximum depth of hole shall not exceed 6\". Contractor shall take all necessary precautions to prevent drilled hole interference with deck reinforcement. Locate longitudinal bars to miss drilled locations. Locate drilled holes to miss transverse bars in deck.

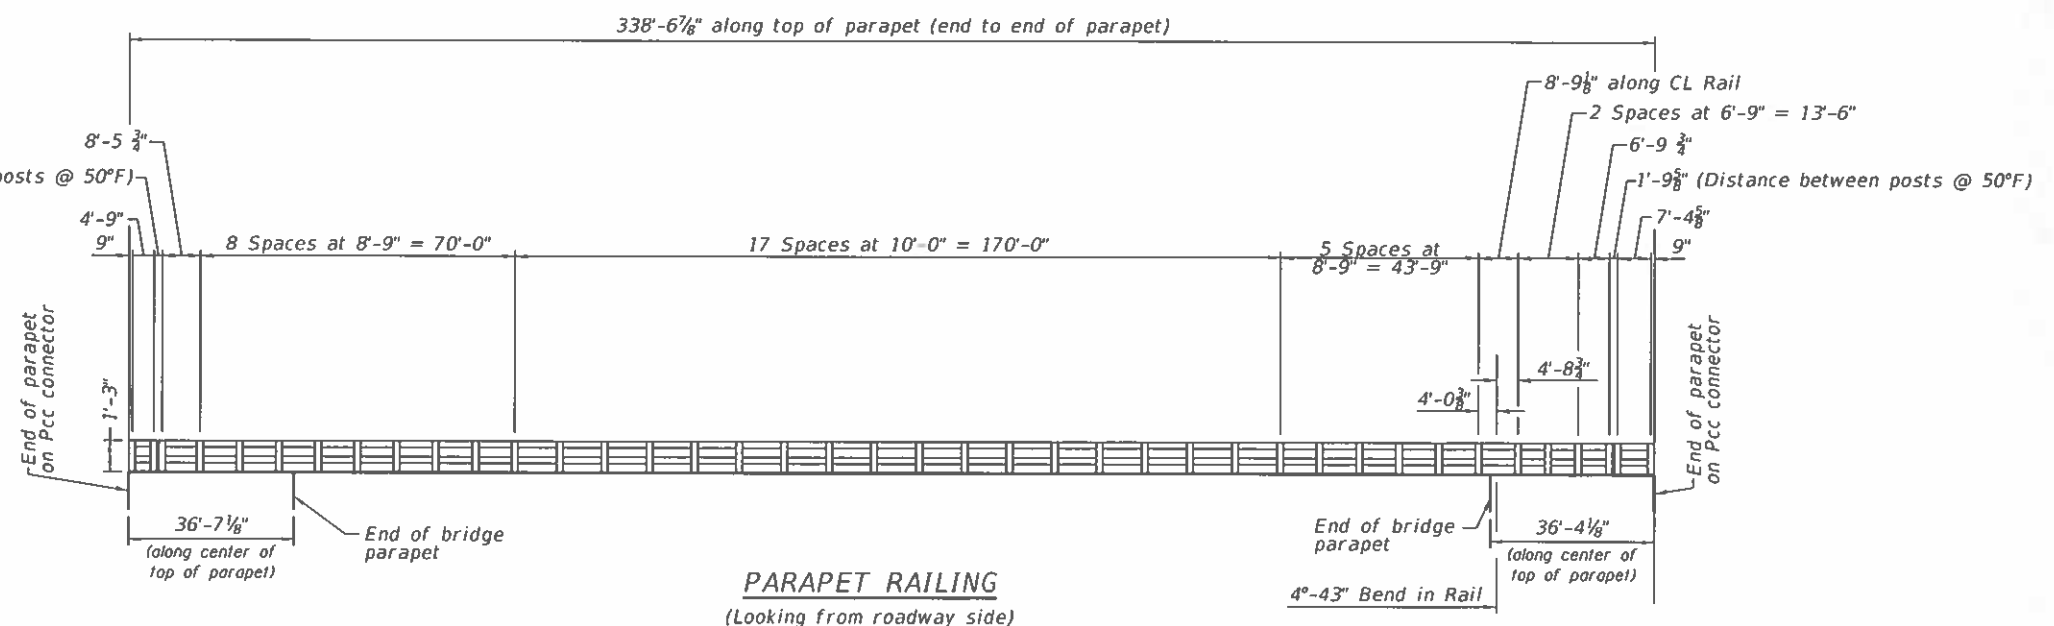

PARAPET RAILING
(Looking from roadway side)

MODEL: SUPDET-SWKPAPARPET
FILE NAME: G:\Users\111111335-01-Waldron-Road-over-I57-Superstructure\Survey D366997\Consultant Data\Chamlin_2020\CAD Sheets\0460153-66997-012-013-014-SUPERSTR_DETAILS.dgn
3/2/2021 2:48:51 PM




USER NAME *	DESIGNED - JKC	REVISED -
PLOT SCALE *	CHECKED - AJO	REVISED -
PLOT DATE *	DRAWN - LAG	REVISED -
	CHECKED - JKC	REVISED -

STATE OF ILLINOIS
DEPARTMENT OF TRANSPORTATION

SUPERSTRUCTURE DETAILS
STRUCTURE NO. 046-0153


SHEET 13 OF 54 SHEETS

FAI RTE.	SECTION	COUNTY	TOTAL SHEETS	SHEET NO.
57	139HBR-6	KANKAKEE	202	102
CONTRACT NO. 66997				
ILLINOIS FED. AID PROJECT				

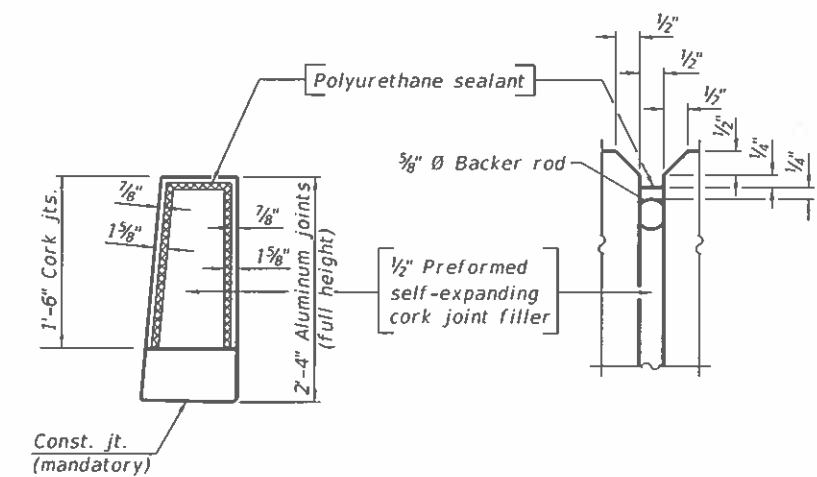


PARAPET JOINT DETAILS


#4 bar = 2'-5"

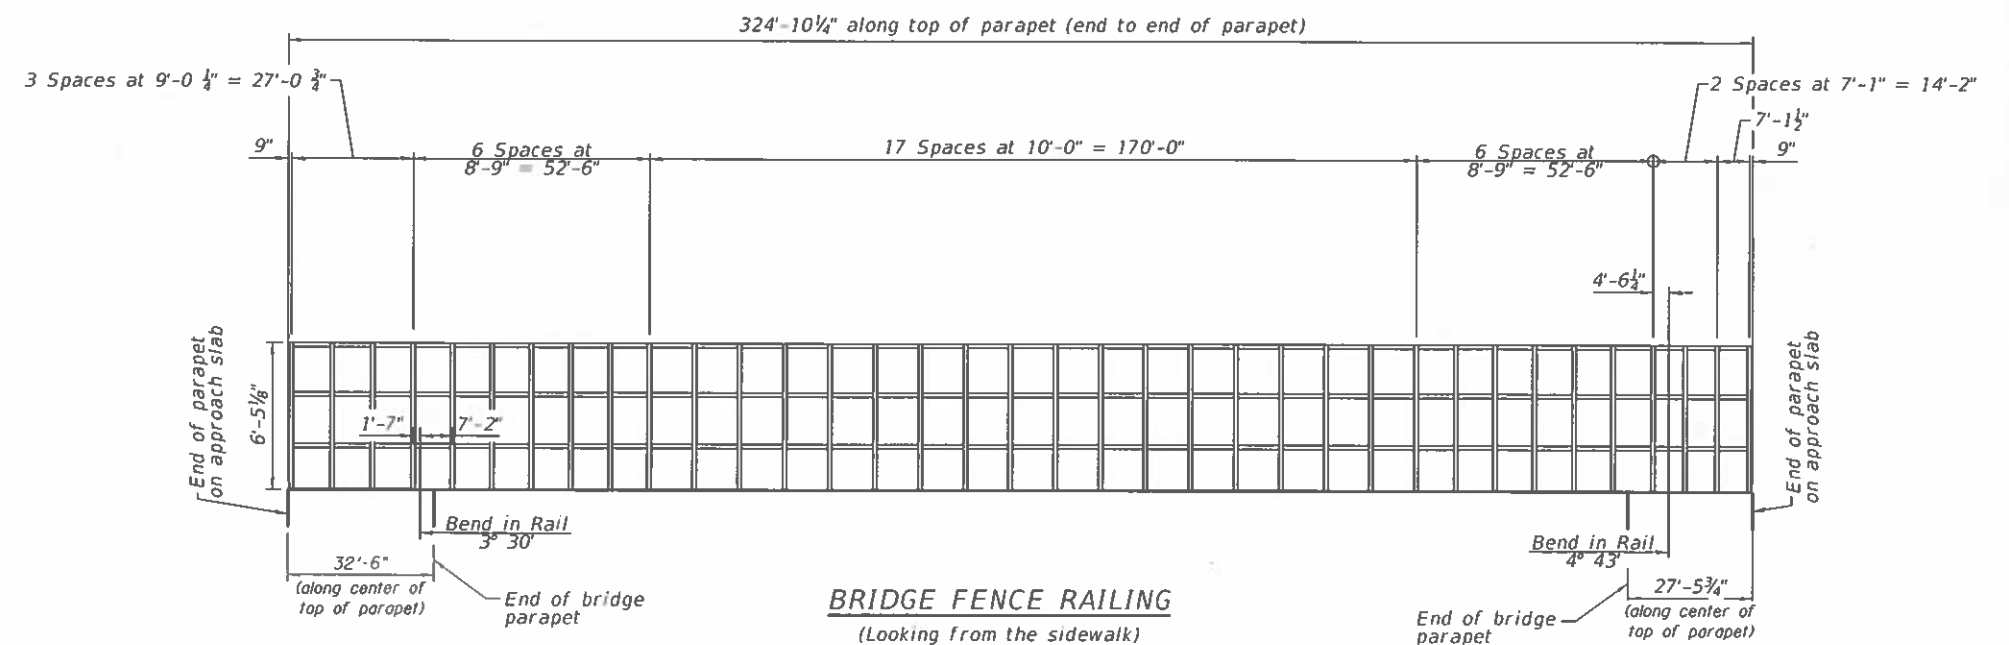


BRIDGE FENCE RAILING
(Looking from the sidewalk)

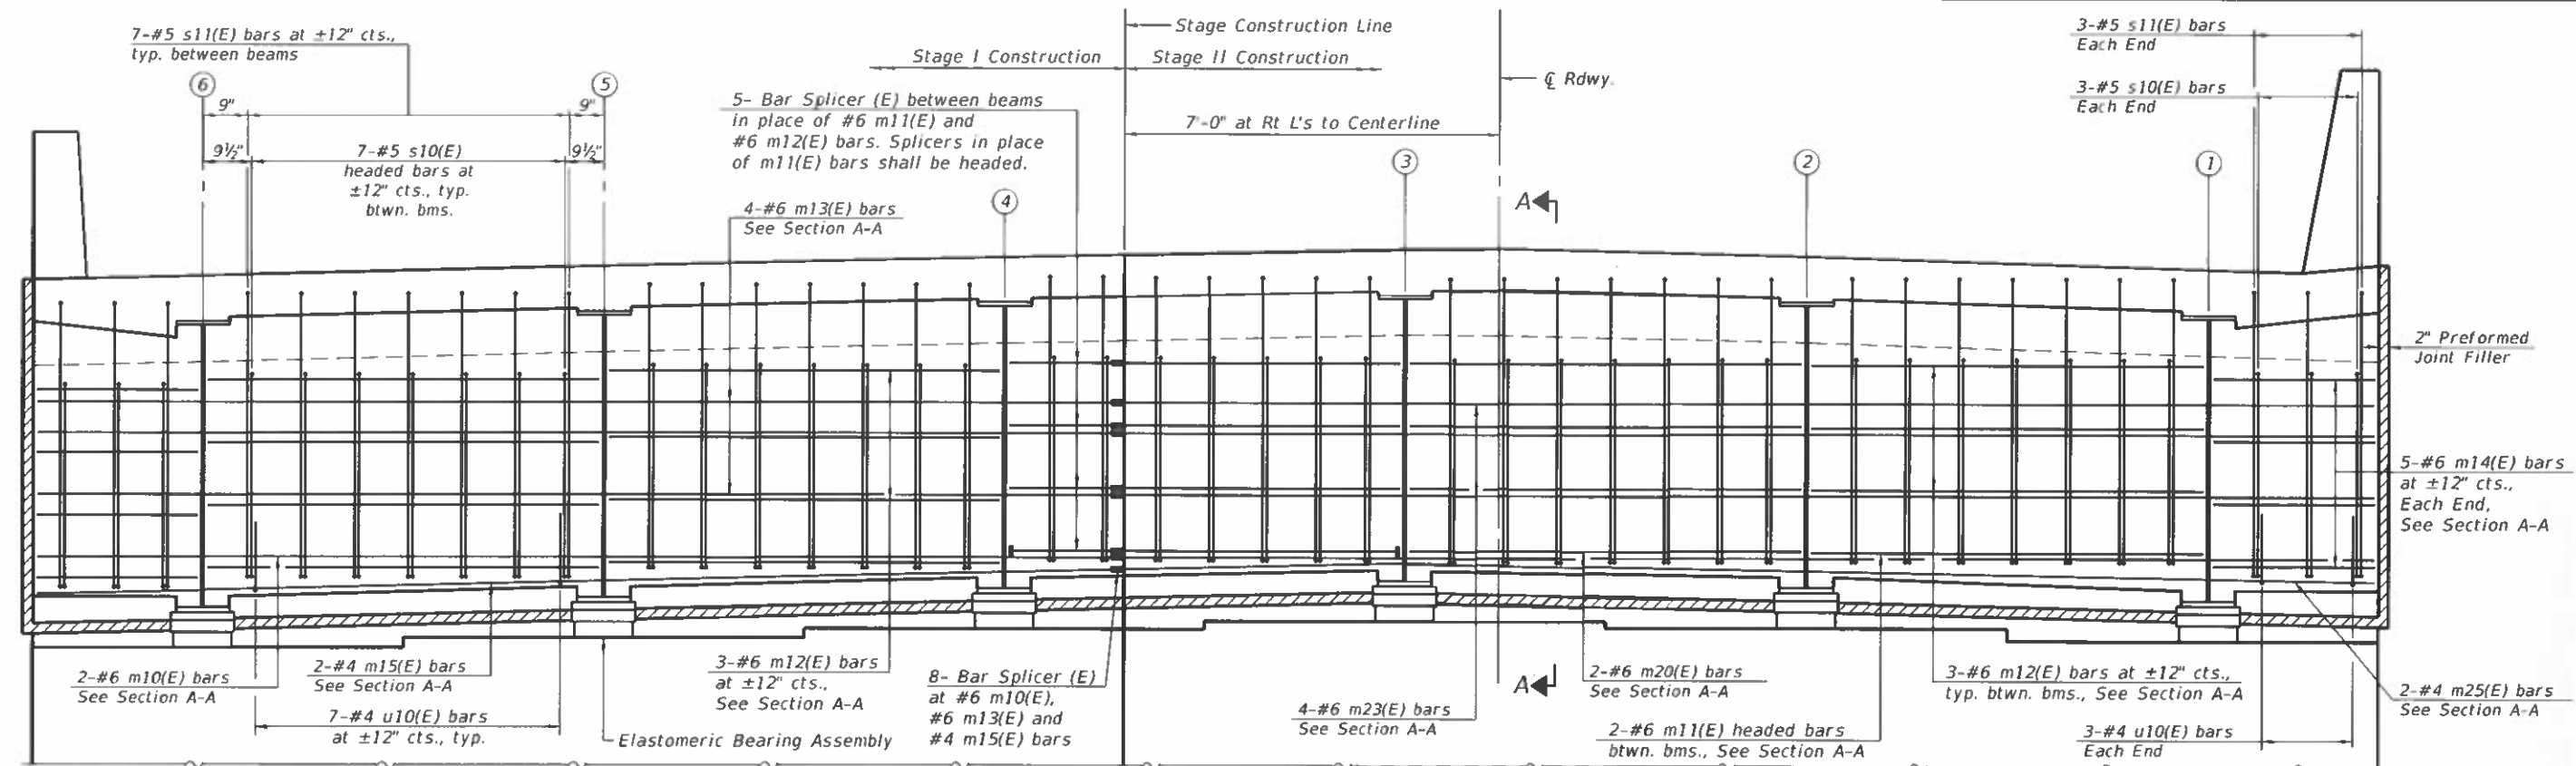

DIAPHRAGM AT NORTH ABUTMENT
(Looking North)

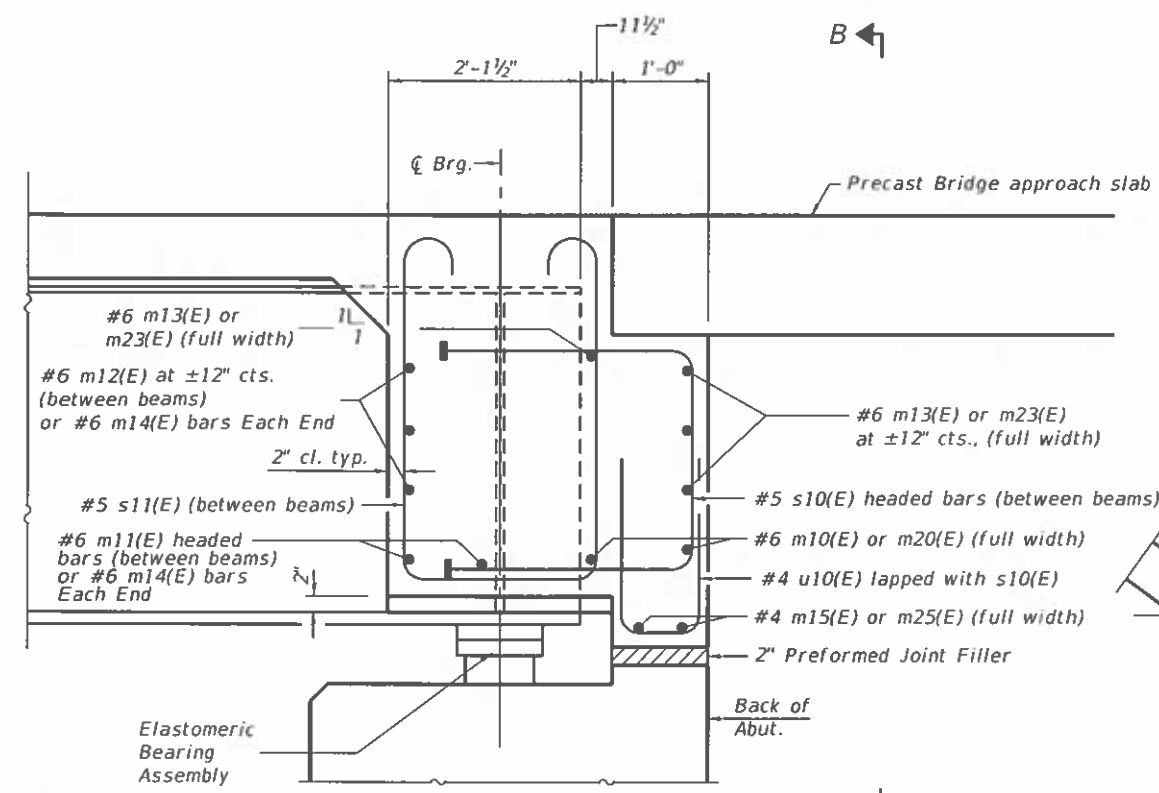


SECTION A-A
(at Rt. L's)

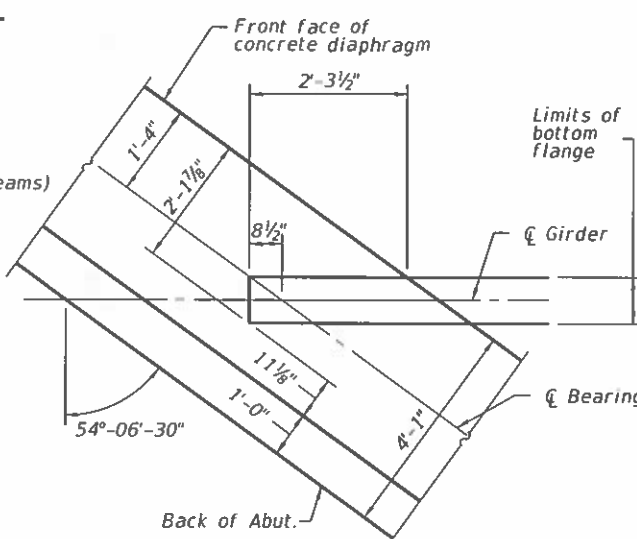

PLAN DETAIL

Headed bars shall conform to ASTM A970 with threaded attachment; Class HA; and reinforcement bars conforming to ASTM A706. Cost included with Reinforcement Bars, Epoxy Coated.

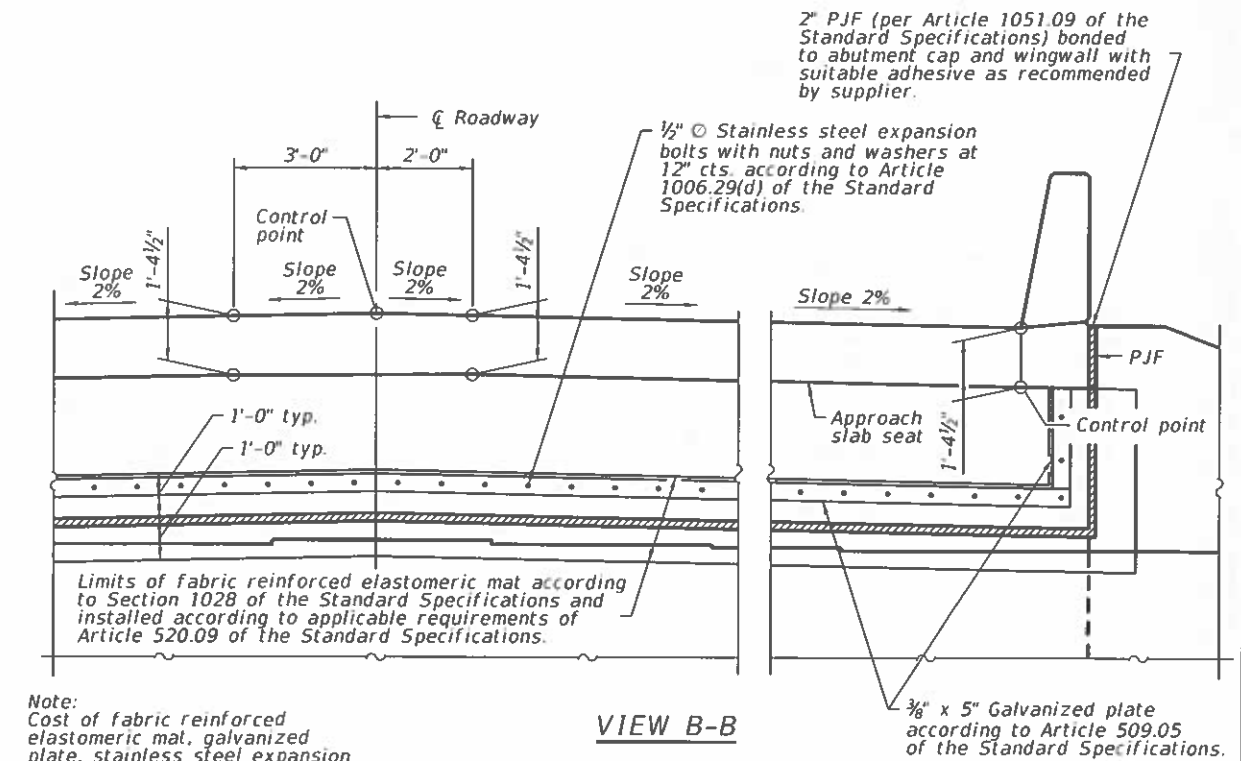

VIEW B-B

Note: Cost of fabric reinforced elastomeric mat, galvanized plate, stainless steel expansion bolts with nuts and washers and installation are included in the cost of Concrete Superstructure.

Notes:
See sheets 12 - 14 of 54 for superstructure details and Bill of Material.
The s10(E) and s11(E) bars shall be placed parallel to the beams.
Spacing for these bars shall be at right angles to the beams.
The approach slab seat shall have a constant slope determined from the control points shown.
See sheet 49 of 54 for bar splicer details.

Min. lap
#4 bar 2'-5"
#6 bar 3'-7"

STATE OF ILLINOIS
DEPARTMENT OF TRANSPORTATION

DIAPHRAGM DETAILS
STRUCTURE NO. 046-0153

SHEET 15 OF 54 SHEETS


F.A.I. RTE.	SECTION	COUNTY	TOTAL SHEETS	SHEET NO.
57	139HBR-6	KANKAKEE	202	104
CONTRACT NO. 66997				




USER NAME	DESIGNED - JKC	REVISIONS
PLOT SCALE	CHECKED - AJO	REVISIONS
PLOT DATE	DRAWN - LAG	REVISIONS
	CHECKED - JKC	REVISIONS

MODEL: NORTH DIAPHRAGM
FILE NAME: G:\Users\11111111\315-01-Walton Road-over-157-Superstructure\Survey D366997\Consultant Data\Chornin_2020\CAD Sheets\0460153-66997-015-016-DIAPHRAGM DETAILS.dgn
3/2/2021 2:50:47 PM


MODEL: SOUTH DIADETS
FILE NAME: C:\Users\11111\Documents\Survey\36697\Consultant_Data\Chamlin_2020\CAD_Sheets\046\153-66997-015-016-DIAPHRAGM_DETAILS.dgn
3/2/2021 2:51:15 PM

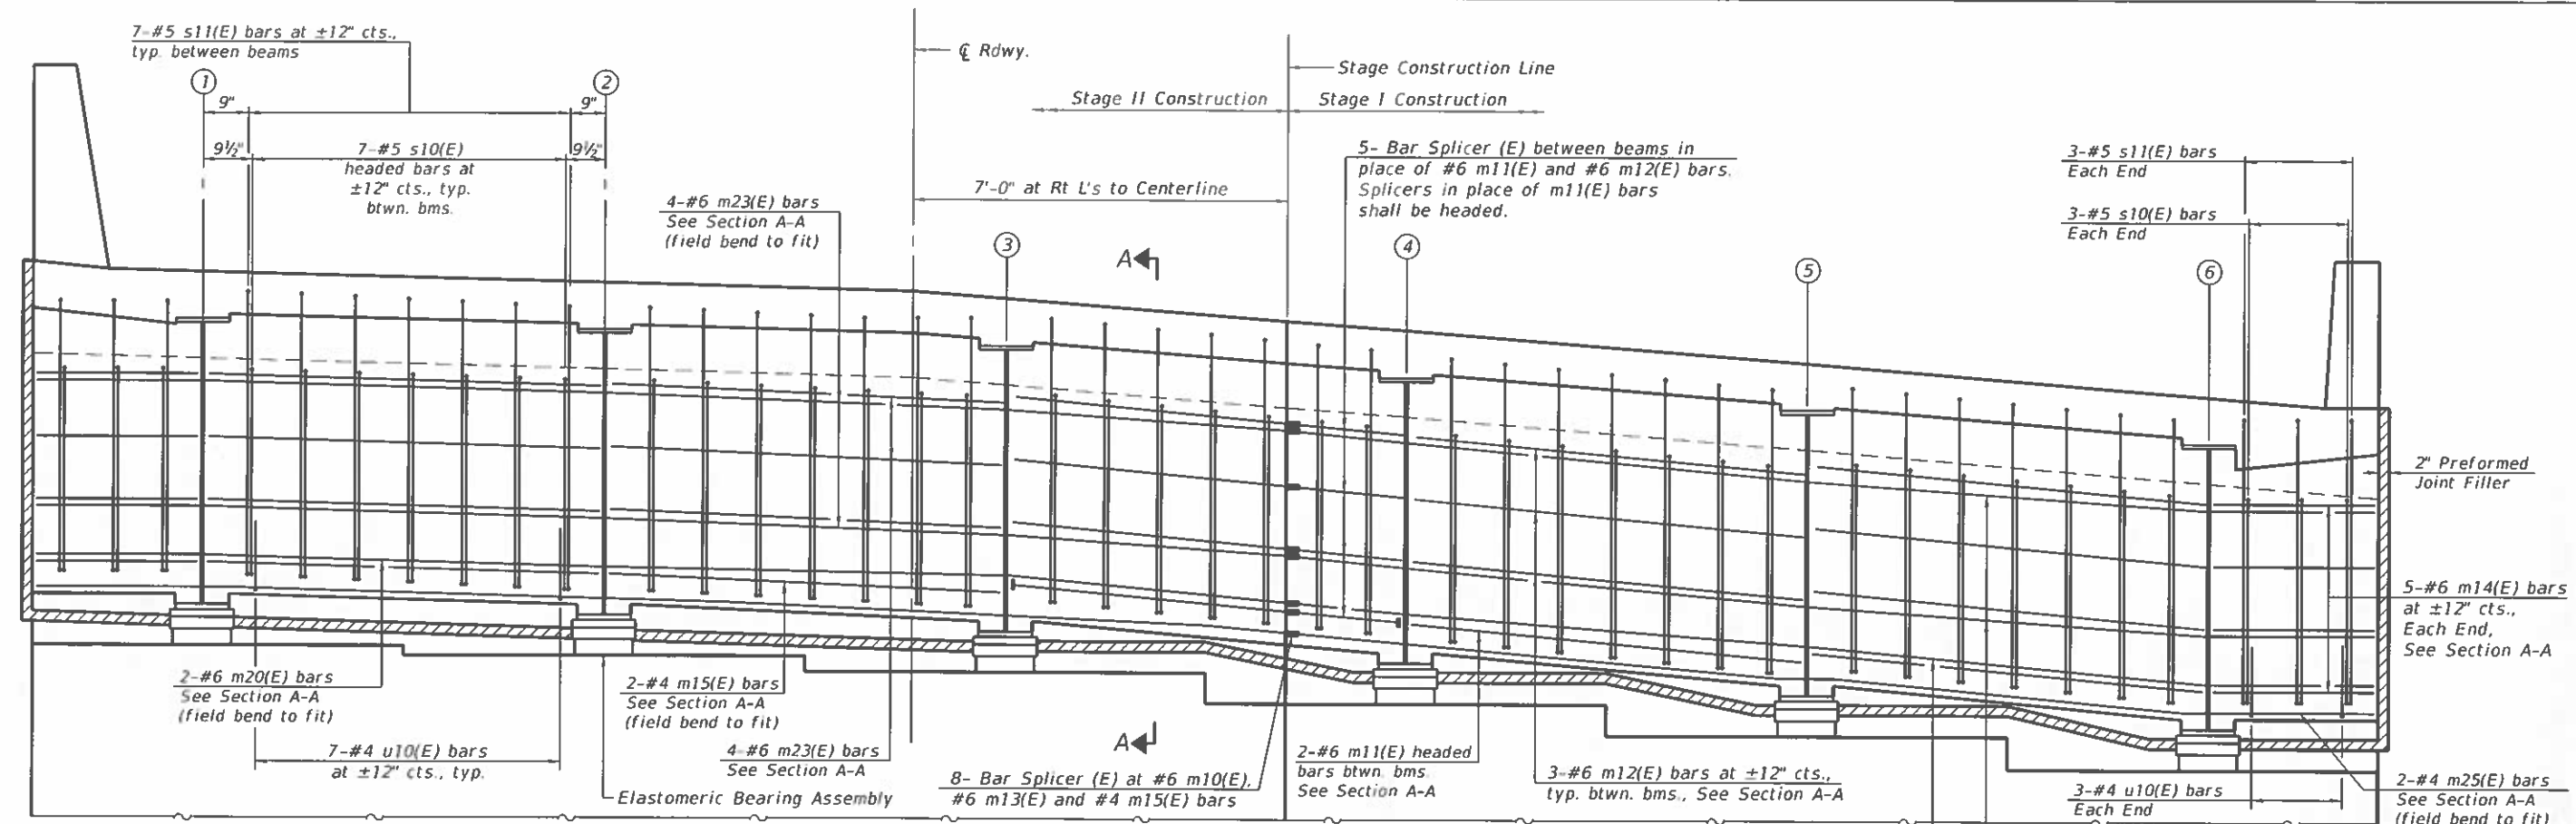


DIAPHRAGM AT SOUTH ABUTMENT
(Looking South)

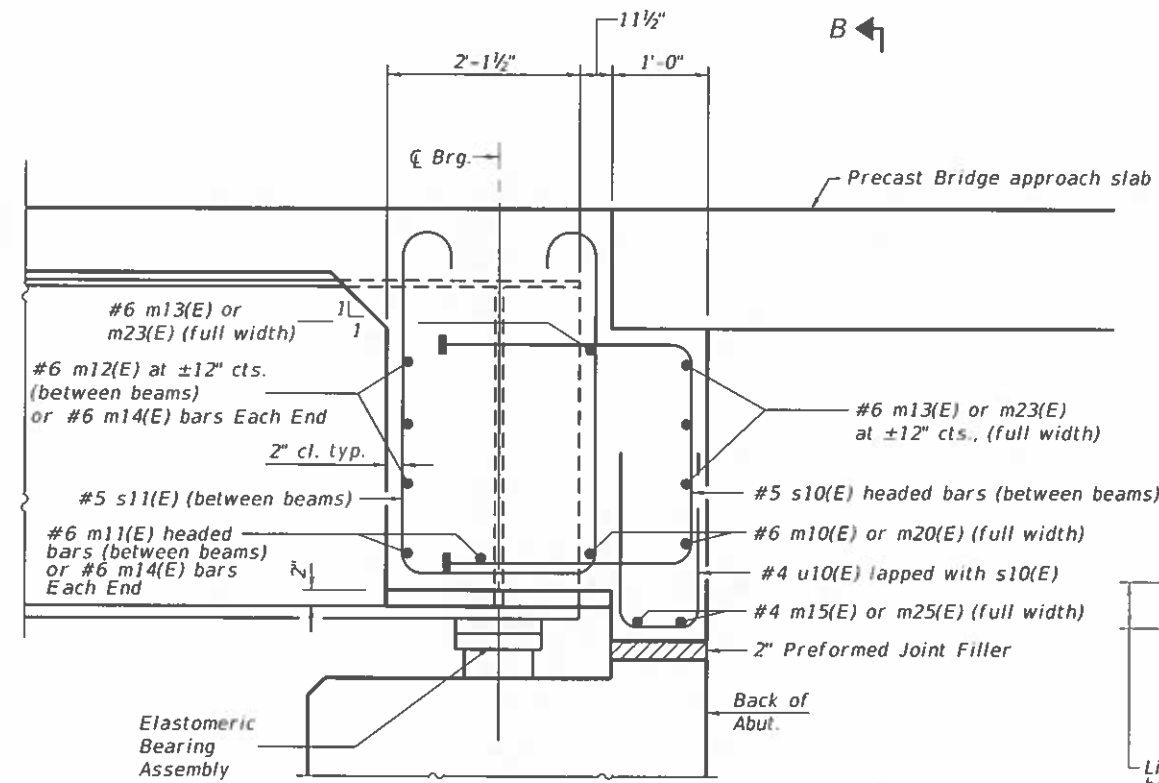

SECTION A-A
(at Rt. L's)

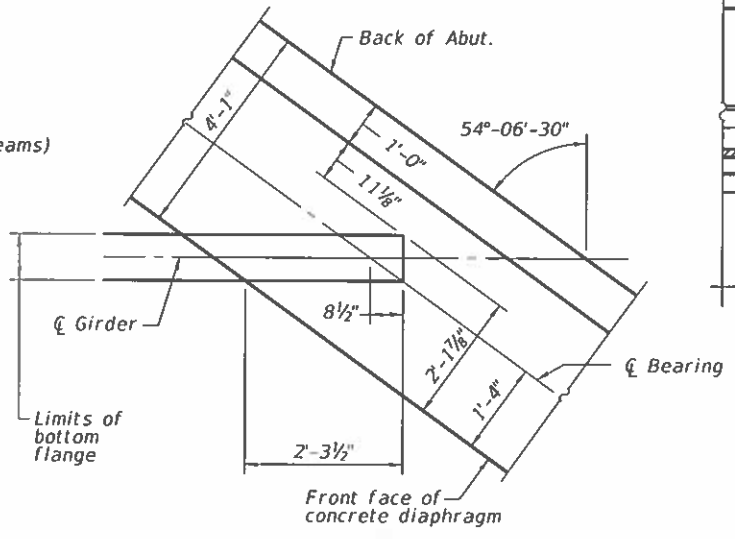

PLAN DETAIL

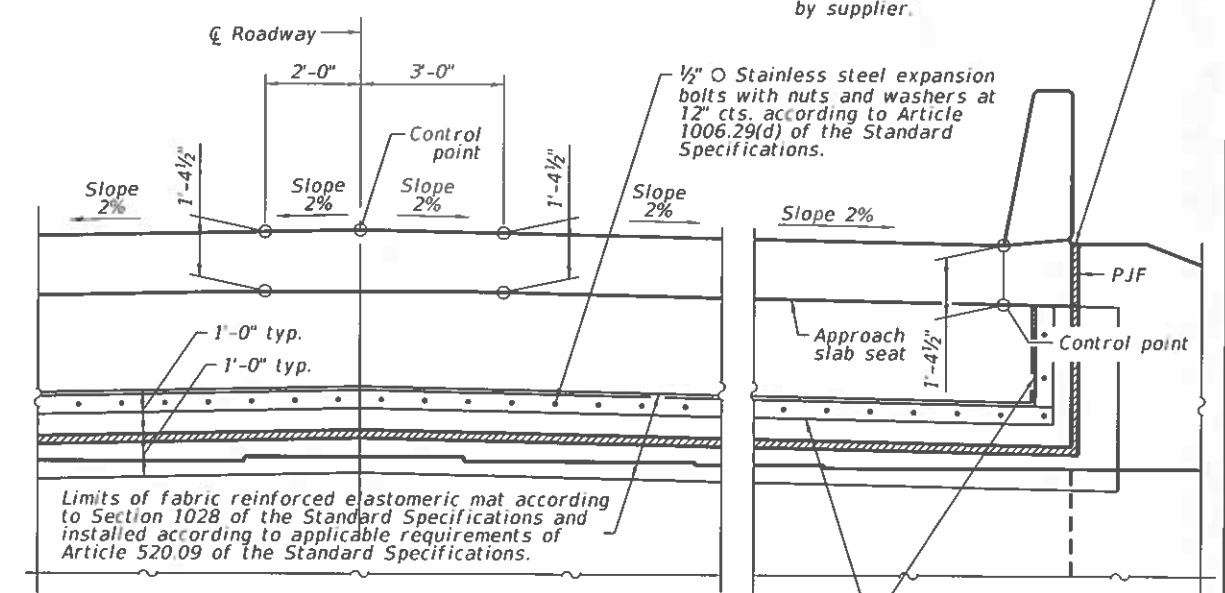

Notes:
See sheets 12 - 14 of 54 for superstructure details and Bill of Material.
The s10(E) and s11(E) bars shall be placed parallel to the beams.
Spacing for these bars shall be at right angles to the beams.
The approach slab seat shall have a constant slope determined from the control points shown.
See sheet 49 of 54 for bar splicer details.



USER NAME	DESIGNED - JKC	REVISIONS
PLOT SCALE	CHECKED - AJO	REVISIONS
PLOT DATE	DRAWN - LAG	REVISIONS
	CHECKED - JKC	REVISIONS

STATE OF ILLINOIS
DEPARTMENT OF TRANSPORTATION

DIAPHRAGM DETAILS
STRUCTURE NO. 046-0153
SHEET 16 OF 54 SHEETS

F.A.I. R.T.E.	SECTION	COUNTY	TOTAL SHEETS	SHEET NO.
57	139HBR-6	KANKAKEE	202	105
CONTRACT NO. 66997				



A cross-sectional diagram of a beam-to-column joint. The diagram shows a concrete column with a shear key cast with concrete, featuring a wearing surface. The shear key is supported by an interior fabric bearing pad and a styrofoam block. Dimensions are indicated: a width of $3\frac{1}{4}"$ ($\pm\frac{1}{4}"$) for the top section, a height of $2"$ ($\pm\frac{1}{4}"$) for the shear key, and a full length of beam for the styrofoam block.

$3\frac{1}{4}"$
($\pm\frac{1}{4}"$)


$2"$
($\pm\frac{1}{4}"$)

Shear key cast with concrete wearing surface, typ.

Interior fabric bearing pad

Styrofoam block full length of beam

DETAIL 'A'

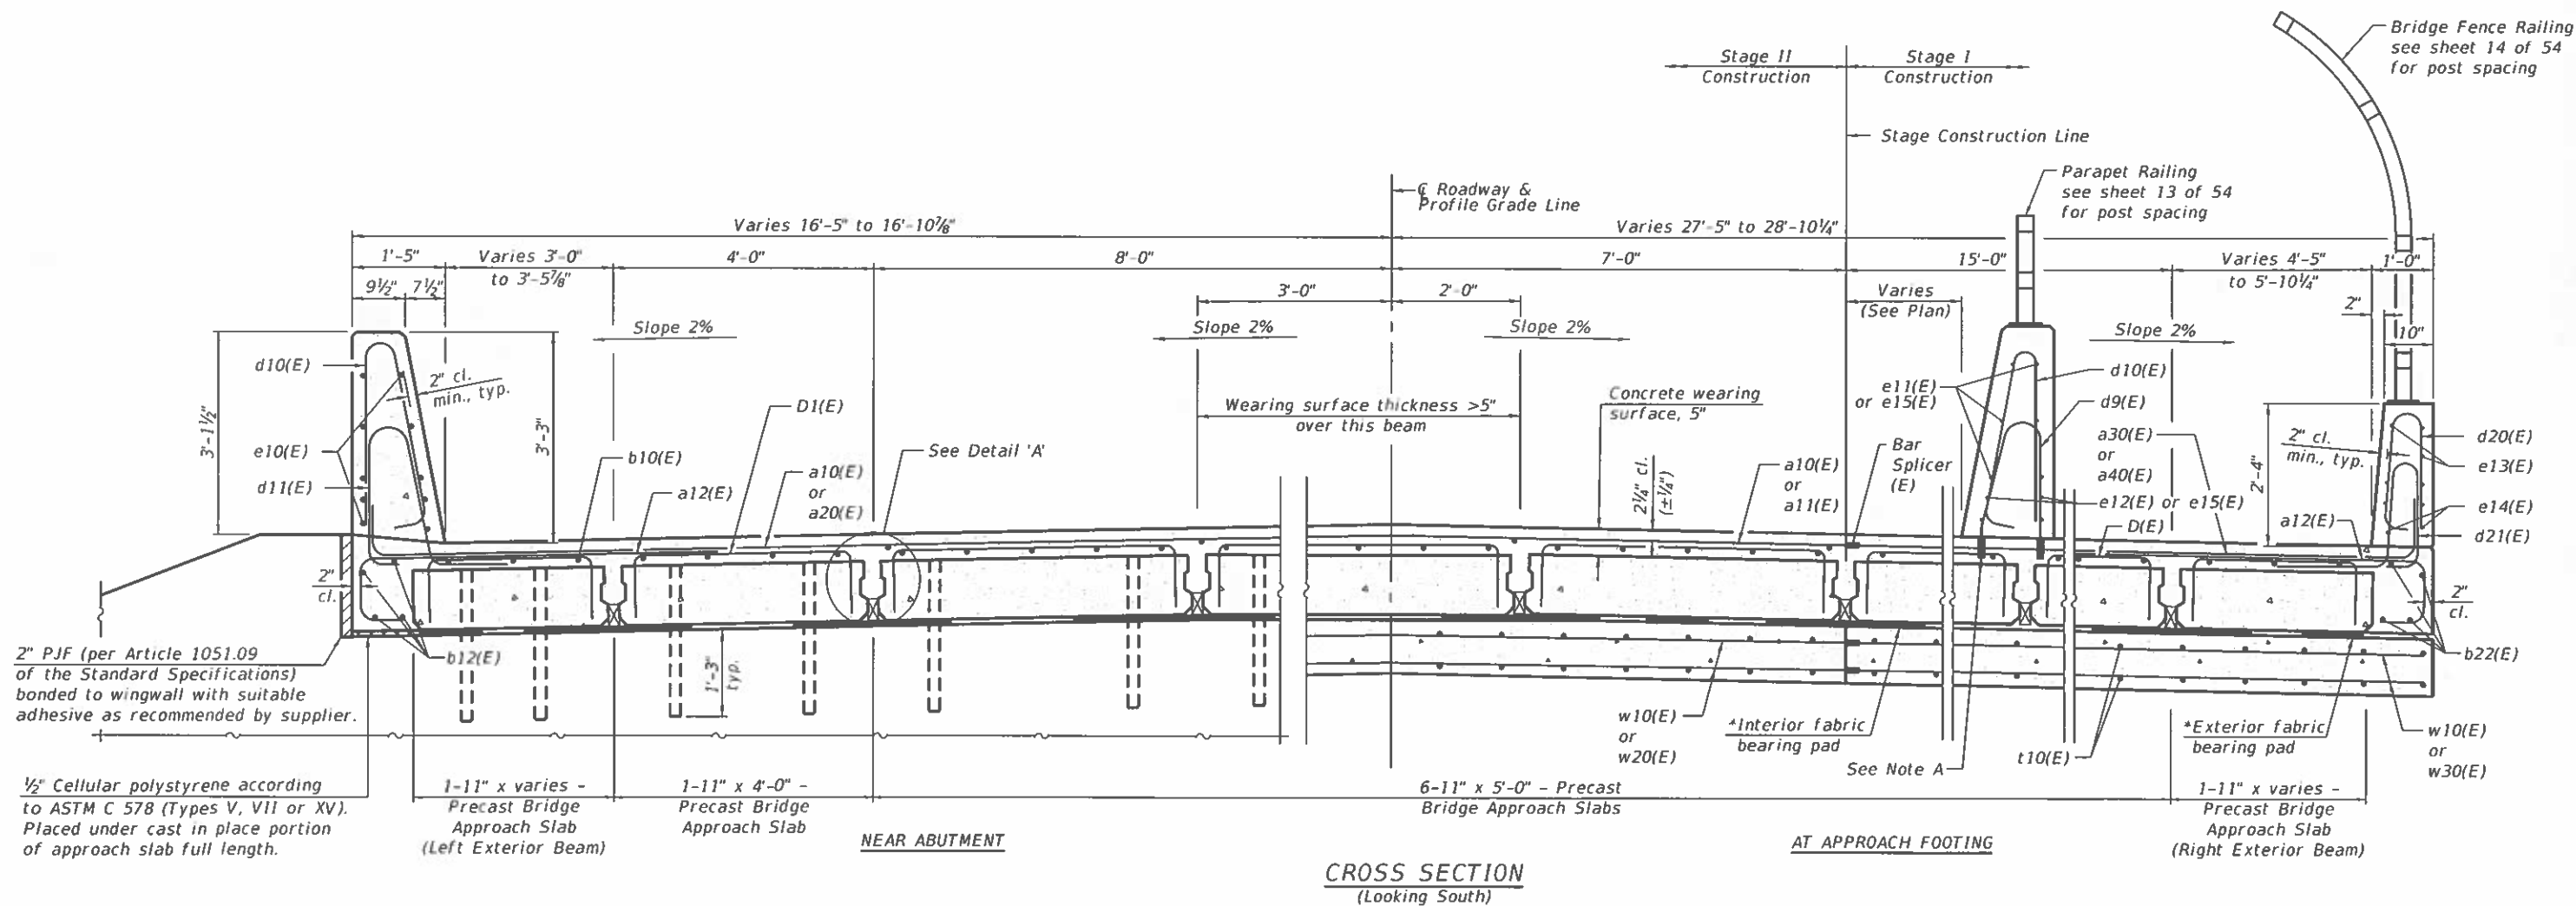

(Sheet 2 of 9)

USER NAME =	DESIGNED = JKC	REVISED =
	CHECKED = AJO	REVISED =
PLOT SCALE =	DRAWN = LAG	REVISED =
PLOT DATE =	CHECKED = JKC	REVISED =

**STATE OF ILLINOIS
DEPARTMENT OF TRANSPORTATION**

**NORTH PRECAST BRIDGE APPROACH SLAB
STRUCTURE NO. 046-0153**

SHEET 18 OF 54 SHEETS

F.A.I. RTE.	SECTION	COUNTY	TOTAL SHEETS	SHEET NO.
57	139HBR-6	KANKAKEE	202	107
CONTRACT NO. 66997				
ILLINOIS		FED. AID PROJECT		

MODEL: 019-NORTH BEAMDET 4ft 3ft
FILE NAME: G:\Users\111111111\OneDrive\Engineering\Survey\0366997\Consultant_Data\Chamlin_2020\CAD_Sheets\0460153-66997-017-024_026-033-PCASTAPPS\LAB.dgn
3/2/2021 2:55:44 PM











USER NAME	DESIGNED - JKC	REVISED -
PLOT SCALE	CHECKED - AJO	REVISED -
PLOT DATE	DRAWN - LAG	REVISED -
	CHECKED - JKC	REVISED -

STATE OF ILLINOIS
DEPARTMENT OF TRANSPORTATION

NORTH PRECAST BRIDGE APPROACH SLABS
STRUCTURE NO. 046-0153

SHEET 19 OF 54 SHEETS

F.A.I. RTE.	SECTION	COUNTY	TOTAL SHEETS	SHEET NO.
57	139HBR-6	KANKAKEE	202	108
CONTRACT NO. 66997				
ILLINOIS FED. AID PROJECT				

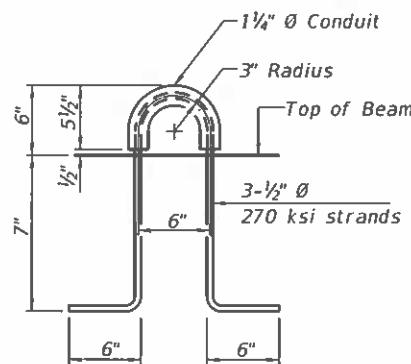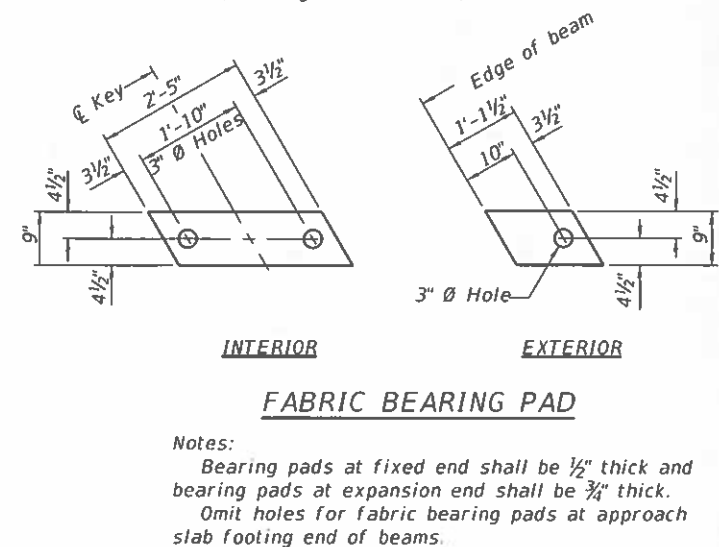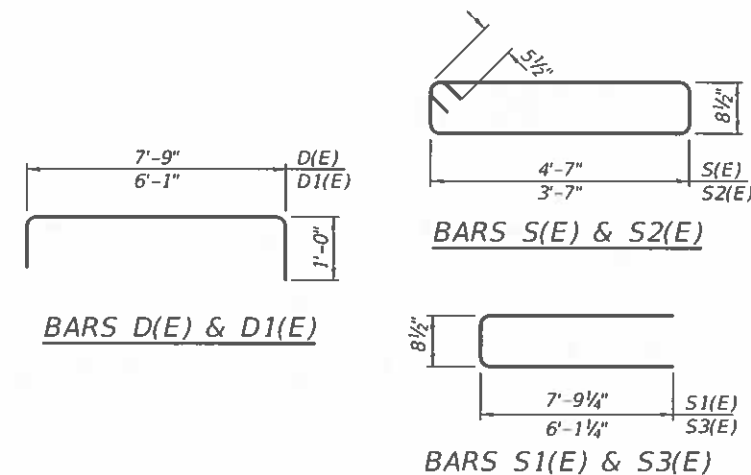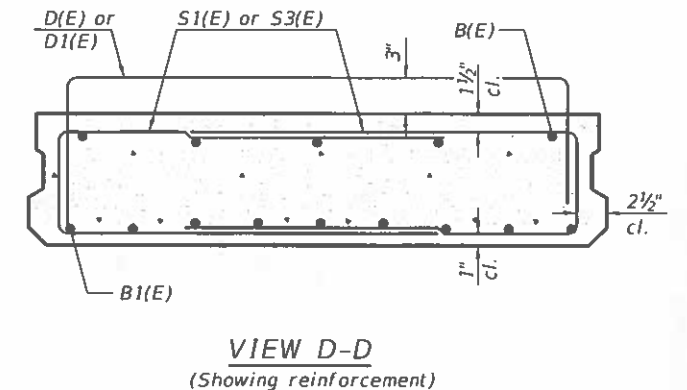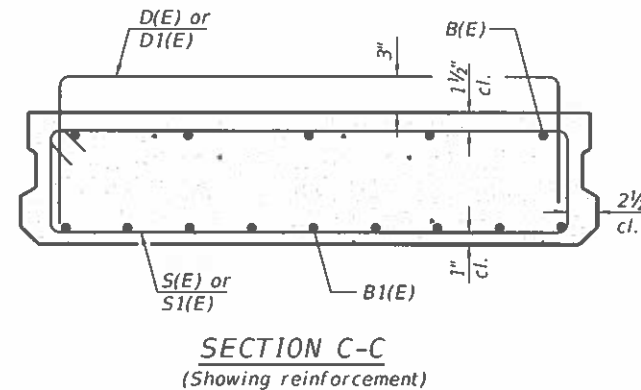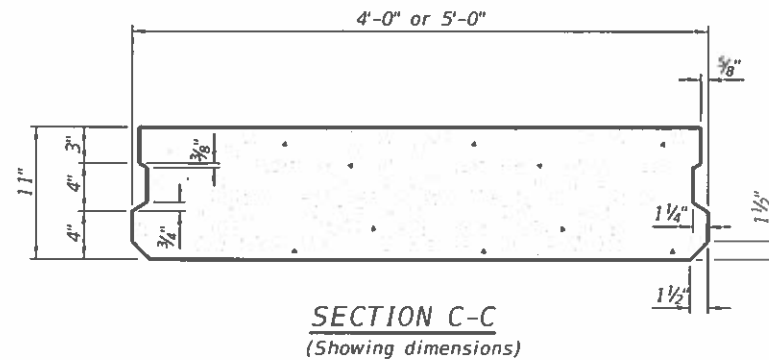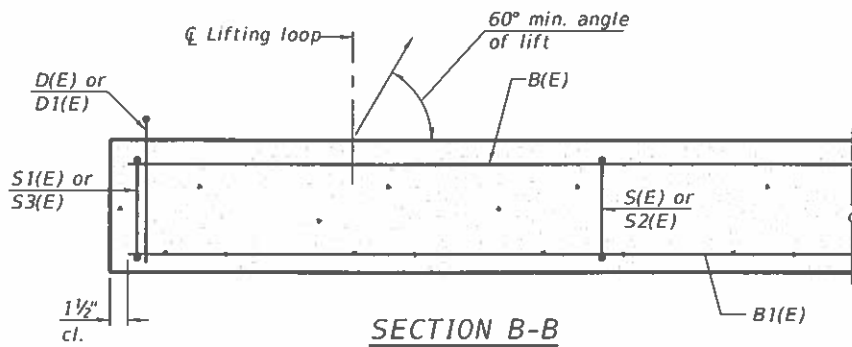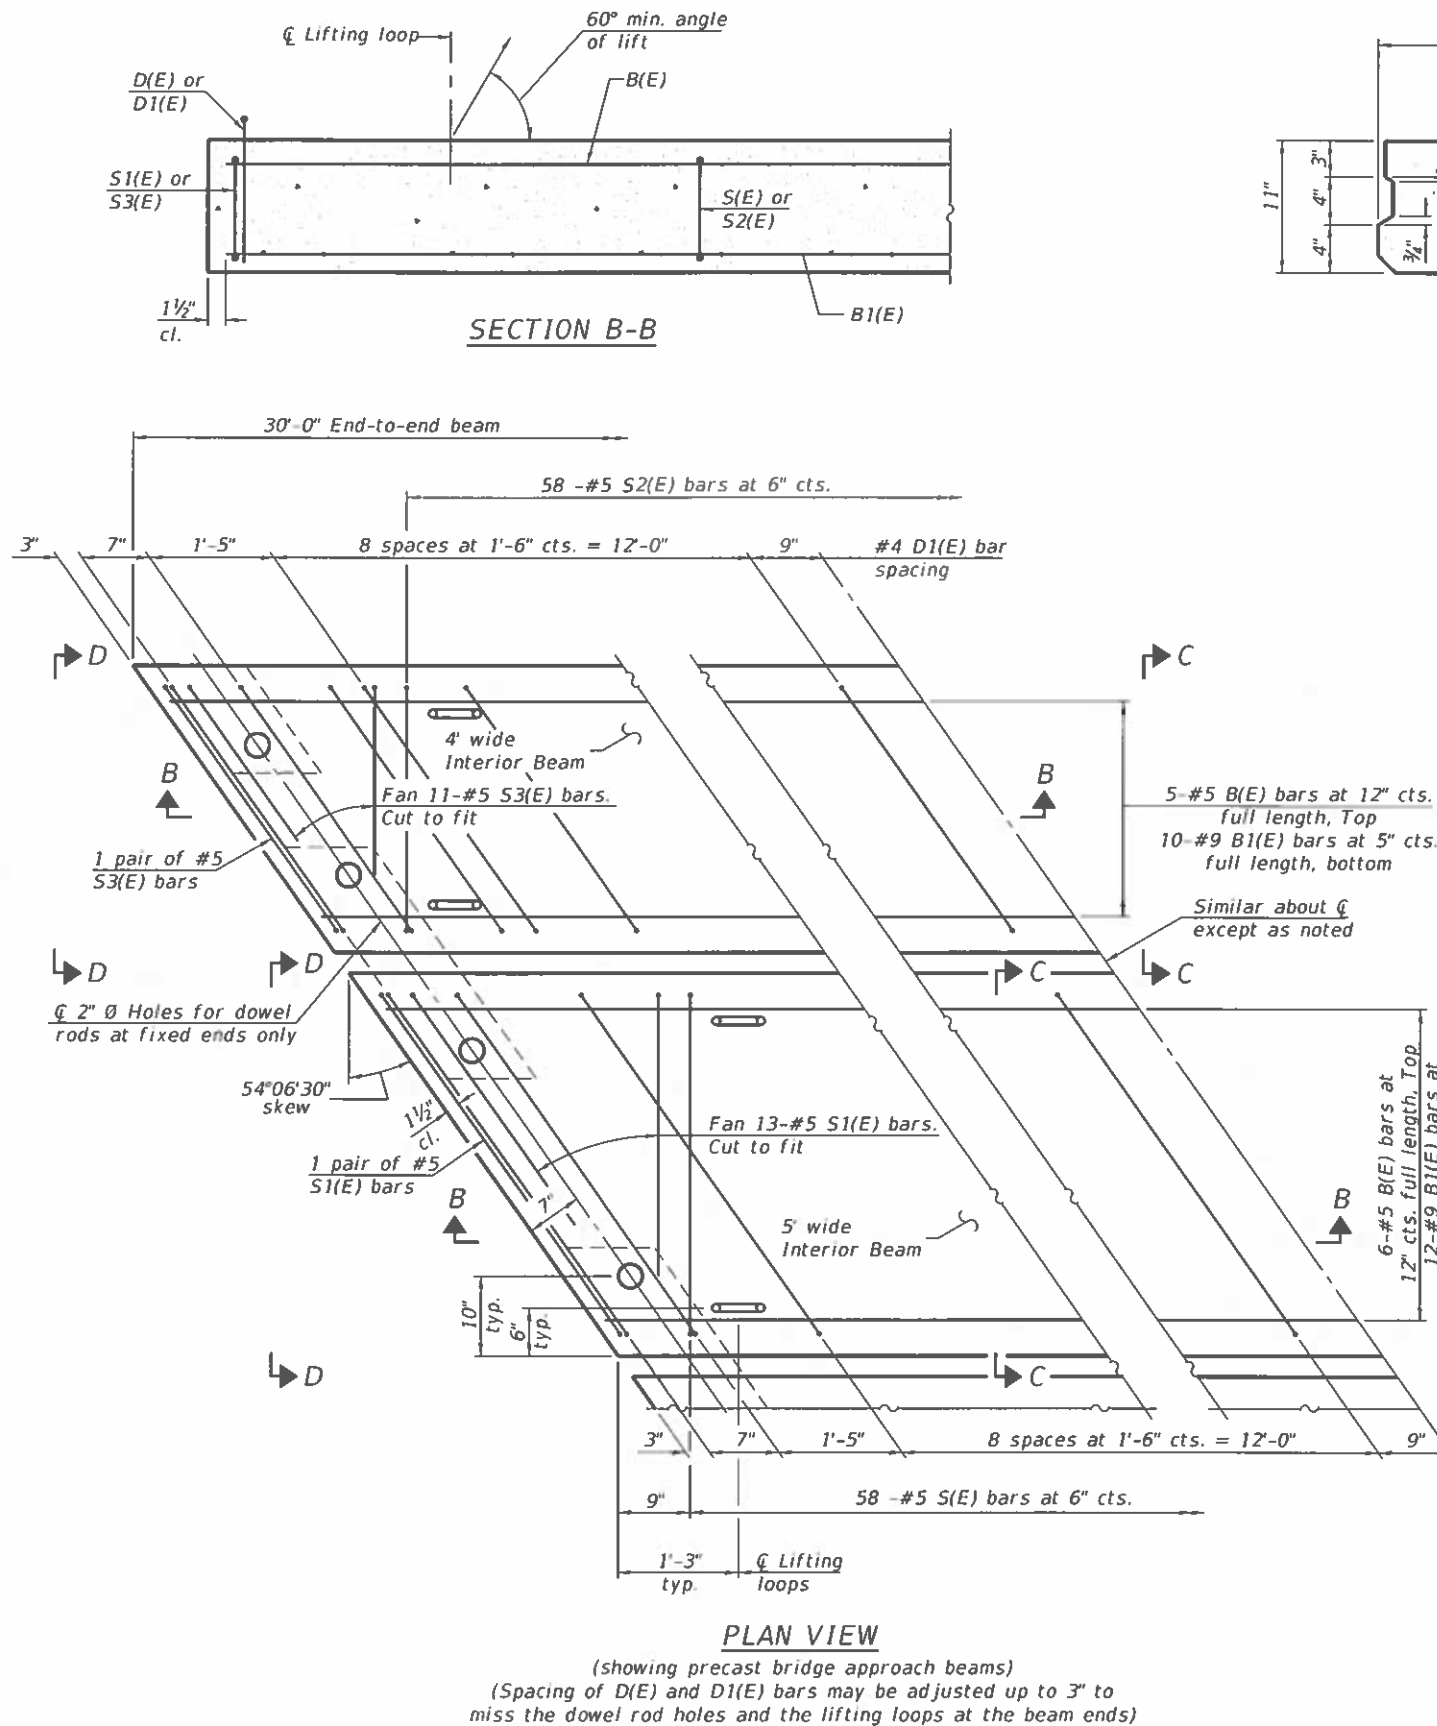


BAR LIST
EACH 5' WIDE INTERIOR BEAM
(For information only)

Bar	No.	Size	Length	Shape
B(E)	6	#5	29'-8"	—
B1(E)	12	#9	29'-8"	—
D(E)	22	#4	9'-9"	┐
S(E)	58	#5	11'-6"	▮
S1(E)	30	#5	16'-3"	▮

BAR LIST
EACH 4' WIDE INTERIOR BEAM
(For information only)

Bar	No.	Size	Length	Shape
B(E)	5	#5	29'-8"	—
B1(E)	10	#9	29'-8"	—
D1(E)	32	#4	8'-1"	┐
S2(E)	58	#5	9'-6"	▮
S3(E)	26	#5	12'-3"	▮

MODEL: 020-BEAMDET EXTNL
FILE NAME: C:\Users\111111335-01-Waldron-Road-over-457-Superstructure\Survey D366997\Consultant Data\Chamlin_2020\CAD Sheets\0460153-66997-017-024-026-033-PCASTAPPS\LAB.dgn
3/2/2021 2:56:23 PM

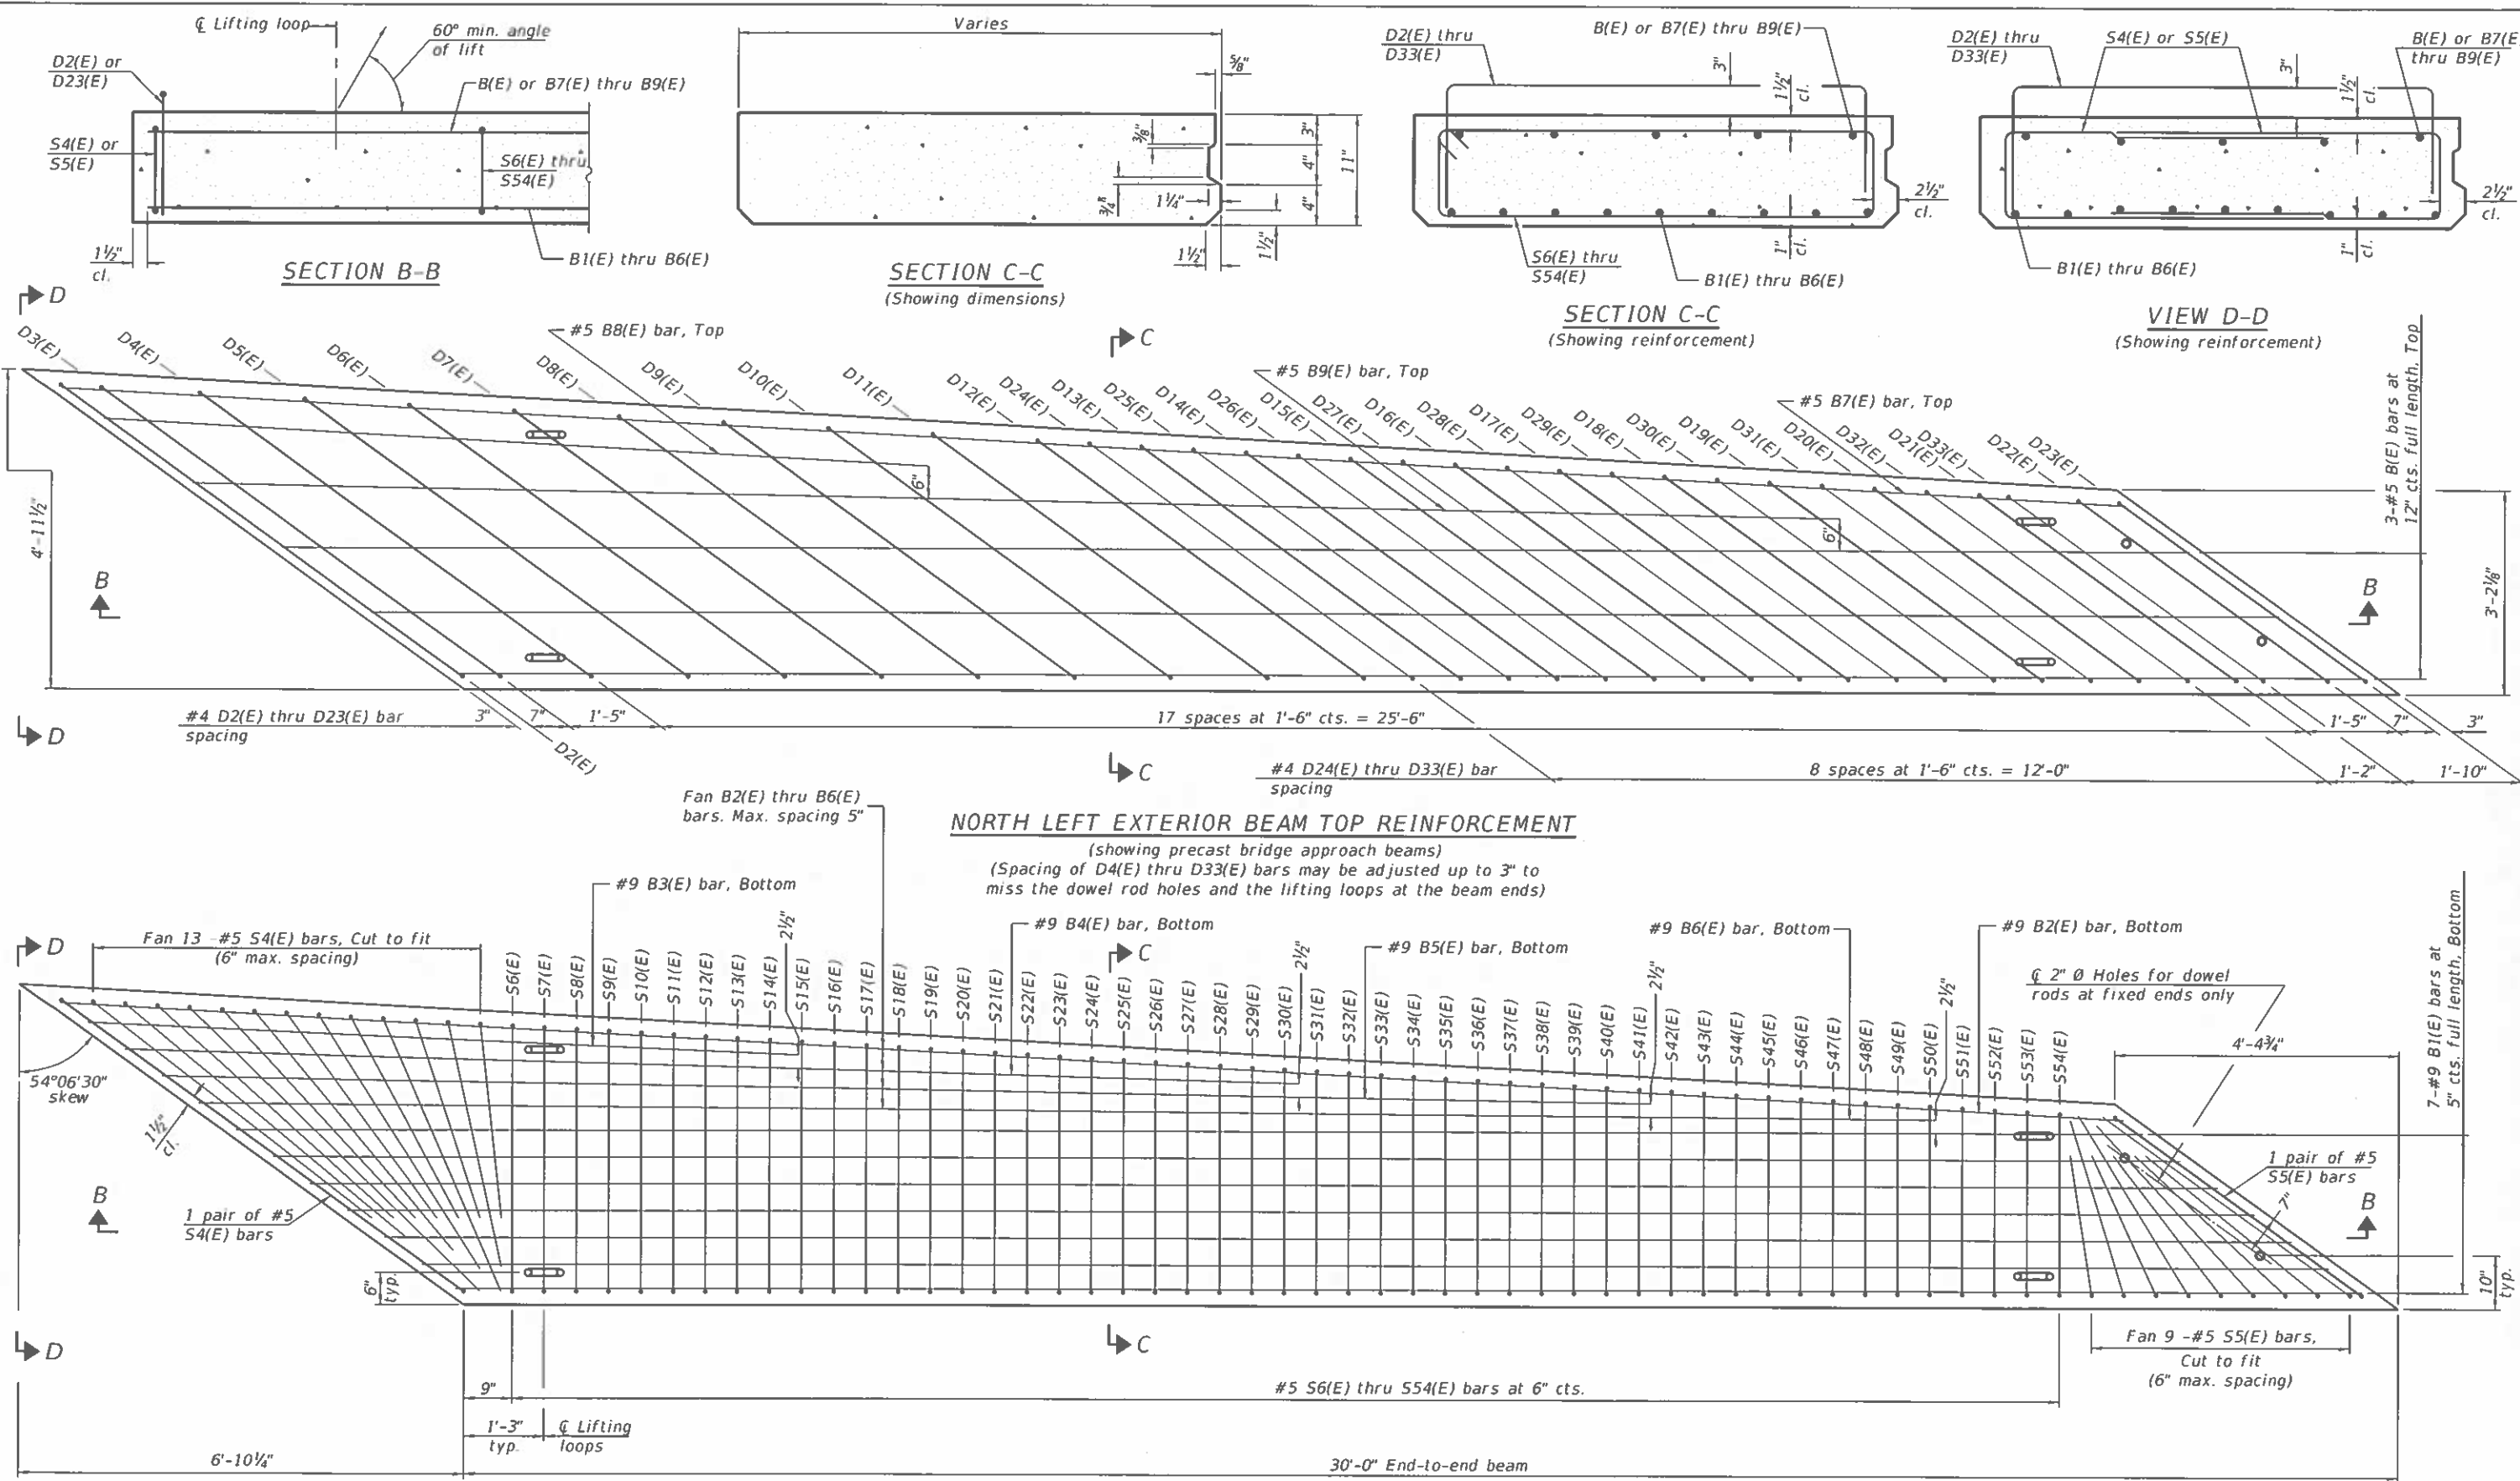

NORTH LEFT EXTERIOR BEAM BOTTOM REINFORCEMENT

(Sheet 4 of 9)



USER NAME	DESIGNED - JKC	REVIS
PLOT SCALE	CHECKED - AJO	REVIS
PLOT DATE	DRAWN - LAG	REVIS
	CHECKED - JKC	REVIS

STATE OF ILLINOIS
DEPARTMENT OF TRANSPORTATION

NORTH PRECAST BRIDGE APPROACH SLAB
STRUCTURE NO. 046-0153


SHEET 20 OF 54 SHEETS

FAI. RTE.	SECTION	COUNTY	TOTAL SHEETS	SHEET NO.
57	139HBR-6	KANKAKEE	202	109
CONTRACT NO. 66997				


ILLINOIS FED. AID PROJECT

MODEL: 021-BEAMDET EXTNL2
FILE NAME: G:\Users\11111335-01-Walton-Road-over-457-Superstructure\Survey D366997\Consultant Data\Chamlin_2020\CAD Sheets\0460153-66997-017-024_026-033-PCASTAPP\SLAB.dgn
3/2/2021 2:57:34 PM

7'-8" D2(E)
7'-7" D3(E)
7'-6" D4(E)
7'-4" D5(E)
7'-2" D6(E)
7'-0" D7(E)
6'-10" D8(E)
6'-8" D9(E)
6'-7" D10(E)
6'-5" D11(E)
6'-3" D12(E)
6'-1" D13(E)
5'-11" D14(E)
5'-10" D15(E)
5'-8" D16(E)
5'-6" D17(E)
5'-4" D18(E)
5'-2" D19(E)
5'-0" D20(E)
4'-11" D21(E)
4'-9" D22(E)
4'-8" D23(E)
6'-2" D24(E)
6'-0" D25(E)
5'-10" D26(E)
5'-9" D27(E)
5'-7" D28(E)
5'-5" D29(E)
5'-3" D30(E)
5'-1" D31(E)
4'-11" D32(E)
4'-10" D33(E)

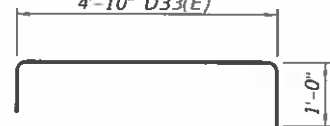


BARS D2(E) thru D33(E)

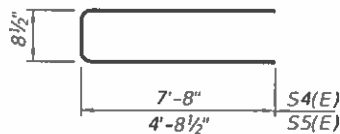


BARS S4(E) & S5(E)

4'-1 1/2" S6(E)
4'-1" S7(E)
4'-0 1/2" S8(E)
4'-0 1/2" S9(E)
4'-0" S10(E)
3'-11 1/2" S11(E)
3'-11 1/2" S12(E)
3'-11" S13(E)
3'-10 1/2" S14(E)
3'-10 1/2" S15(E)
3'-10" S16(E)
3'-9 1/2" S17(E)
3'-9 1/2" S18(E)
3'-9" S19(E)
3'-8 1/2" S20(E)
3'-8 1/2" S21(E)
3'-8" S22(E)
3'-7 1/2" S23(E)
3'-7 1/2" S24(E)
3'-7" S25(E)
3'-7" S26(E)
3'-6 1/2" S27(E)
3'-6" S28(E)
3'-6" S29(E)
3'-5 1/2" S30(E)
3'-5" S31(E)
3'-5" S32(E)
3'-4 1/2" S33(E)
3'-4" S34(E)
3'-4" S35(E)
3'-3 1/2" S36(E)
3'-3" S37(E)
3'-3" S38(E)
3'-2 1/2" S39(E)
3'-2" S40(E)
3'-2" S41(E)
3'-1 1/2" S42(E)
3'-1" S43(E)
3'-1" S44(E)
3'-0 1/2" S45(E)
3'-0" S46(E)
3'-0" S47(E)
2'-11 1/2" S48(E)
2'-11" S49(E)
2'-11" S50(E)
2'-10 1/2" S51(E)
2'-10" S52(E)
2'-10" S53(E)
2'-9 1/2" S54(E)

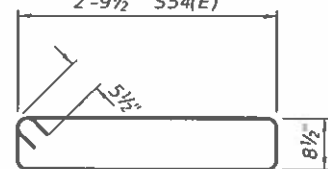

BARS S6(E) thru S54(E)

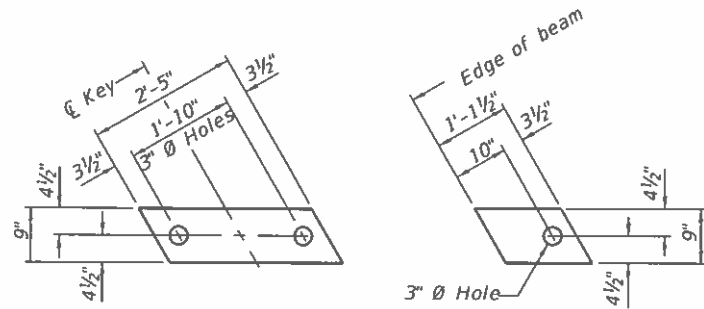


INTERIOR

EXTERIOR

FABRIC BEARING PAD

Notes:

Bearing pads at fixed end shall be 1/2" thick and bearing pads at expansion end shall be 3/4" thick. Omit holes for fabric bearing pads at approach slab footing end of beams.

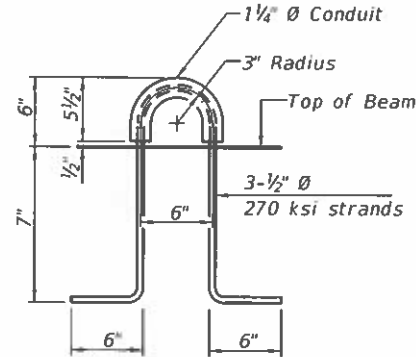

LIFTING LOOP DETAIL

(An alternate lifting loop with a proof load of 25,000 lbs. and utilized according to the manufacturer's recommendations may be used)

Notes:

The precast bridge approach slab shall be according to Section 504 of the Standard Specifications and shall be paid for at the contract unit price per square foot for Precast Bridge Approach Slab.

Cast-in-place substitution of Precast Bridge Approach Slab is not allowed. The top surface of precast bridge approach slabs shall be finished similar to precast prestressed deck beams with concrete wearing surface as specified in the IDOT "Manual for Fabrication of Precast Prestressed Concrete Products."

Two 1/8" fabric adjusting shims of the dimensions of the exterior bearing pad shall be provided for each bearing pad location. Cost included with Precast Bridge Approach Slab.

A minimum 2 1/2" diameter lifting pins shall be used to engage the lifting loops during handling.

Compressive strength of precast concrete, f'c shall be 6,000 psi.

Compressive strength of precast concrete during initial lifting, f'ci shall be 5,000 psi.

BAR LIST

NORTH LEFT EXTERIOR BEAM (For information only)

Bar	No.	Size	Length	Shape
B(E)	3	#5	29'-8"	—
B1(E)	7	#9	29'-8"	—
B2(E)	1	#9	32'-0"	—
B3(E)	1	#9	11'-0"	—
B4(E)	1	#9	18'-2"	—
B5(E)	1	#9	23'-1"	—
B6(E)	1	#9	26'-11"	—
B7(E)	1	#5	32'-0"	—
B8(E)	1	#5	12'-9"	—
B9(E)	1	#5	25'-6"	—
D2(E)	1	#4	9'-8"	U
D3(E)	1	#4	9'-7"	U
D4(E)	1	#4	9'-6"	U
D5(E)	1	#4	9'-4"	U
D6(E)	1	#4	9'-2"	U
D7(E)	1	#4	9'-0"	U
D8(E)	1	#4	8'-10"	U
D9(E)	1	#4	8'-8"	U
D10(E)	1	#4	8'-7"	U
D11(E)	1	#4	8'-5"	U
D12(E)	1	#4	8'-3"	U
D13(E)	1	#4	8'-1"	U
D14(E)	1	#4	7'-11"	U
D15(E)	1	#4	7'-10"	U
D16(E)	1	#4	7'-8"	U
D17(E)	1	#4	7'-6"	U
D18(E)	1	#4	7'-4"	U
D19(E)	1	#4	7'-2"	U
D20(E)	1	#4	7'-0"	U
D21(E)	1	#4	6'-11"	U
D22(E)	1	#4	6'-9"	U
D23(E)	1	#4	6'-8"	U
D24(E)	1	#4	8'-2"	U
D25(E)	1	#4	8'-0"	U
D26(E)	1	#4	7'-10"	U
D27(E)	1	#4	7'-9"	U
D28(E)	1	#4	7'-7"	U
D29(E)	1	#4	7'-5"	U
D30(E)	1	#4	7'-3"	U
D31(E)	1	#4	7'-1"	U
D32(E)	1	#4	6'-11"	U
D33(E)	1	#4	6'-10"	U

BAR LIST

NORTH LEFT EXTERIOR BEAM (For information only)

Bar	No.	Size	Length	Shape
S4(E)	15	#5	16'-1"	U
S5(E)	11	#5	10'-2"	U
S6(E)	1	#5	10'-7"	U
S7(E)	1	#5	10'-6"	U
S8(E)	1	#5	10'-5"	U
S9(E)	1	#5	10'-5"	U
S10(E)	1	#5	10'-4"	U
S11(E)	1	#5	10'-3"	U
S12(E)	1	#5	10'-3"	U
S13(E)	1	#5	10'-2"	U
S14(E)	1	#5	10'-1"	U
S15(E)	1	#5	10'-1"	U
S16(E)	1	#5	10'-0"	U
S17(E)	1	#5	9'-11"	U
S18(E)	1	#5	9'-11"	U
S19(E)	1	#5	9'-10"	U
S20(E)	1	#5	9'-9"	U
S21(E)	1	#5	9'-9"	U
S22(E)	1	#5	9'-8"	U
S23(E)	1	#5	9'-7"	U
S24(E)	1	#5	9'-7"	U
S25(E)	1	#5	9'-6"	U
S26(E)	1	#5	9'-6"	U
S27(E)	1	#5	9'-5"	U
S28(E)	1	#5	9'-4"	U
S29(E)	1	#5	9'-4"	U
S30(E)	1	#5	9'-3"	U
S31(E)	1	#5	9'-2"	U
S32(E)	1	#5	9'-2"	U
S33(E)	1	#5	9'-1"	U
S34(E)	1	#5	9'-0"	U
S35(E)	1	#5	9'-0"	U
S36(E)	1	#5	8'-11"	U
S37(E)	1	#5	8'-10"	U
S38(E)	1	#5	8'-10"	U
S39(E)	1	#5	8'-9"	U
S40(E)	1	#5	8'-8"	U
S41(E)	1	#5	8'-8"	U
S42(E)	1	#5	8'-7"	U
S43(E)	1	#5	8'-6"	U
S44(E)	1	#5	8'-6"	U
S45(E)	1	#5	8'-5"	U
S46(E)	1	#5	8'-4"	U
S47(E)	1	#5	8'-4"	U
S48(E)	1	#5	8'-3"	U
S49(E)	1	#5	8'-2"	U
S50(E)	1	#5	8'-2"	U
S51(E)	1	#5	8'-1"	U
S52(E)	1	#5	8'-0"	U
S53(E)	1	#5	8'-0"	U
S54(E)	1	#5	7'-11"	U

(Sheet 5 of 9)



USER NAME =
PLOT SCALE =
PLOT DATE =

DESIGNED - JKC
CHECKED - AJO
DRAWN - LAG
CHECKED - JKC

REVISED -
REVISED -
REVISED -
REVISED -

STATE OF ILLINOIS
DEPARTMENT OF TRANSPORTATION

NORTH PRECAST BRIDGE APPROACH SLAB
STRUCTURE NO. 046-0153

SHEET 21 OF 54 SHEETS

F.A.I. RTE. 57 SECTION 139HBR-6 COUNTY KANKAKEE TOTAL SHEETS 202 SHEET NO. 110 CONTRACT NO. 66997 ILLINOIS FED. AID PROJECT

MODEL: 023-BEAMDET EXTNR2
FILE NAME: G:\Users\11111335-01-Waltron-Road-over-57-SuperstructureSurvey D366997\Consultant_Data\Chamlin_2020\CAD_Sheets\0460153-66997-017-024_026-033-PCASTAPP5\LA8.dgn
3/2/2021 2:59:16 PM



USER NAME	*	DESIGNED	-	JKC	REVISED	-
PLOT SCALE	*	CHECKED	-	AJO	REVISED	-
PLOT DATE	*	DRAWN	-	LAG	REVISED	-
		CHECKED	-	JKC	REVISED	-


STATE OF ILLINOIS
DEPARTMENT OF TRANSPORTATION

NORTH PRECAST BRIDGE APPROACH SLAB
STRUCTURE NO. 046-0153


SHEET 23 OF 54 SHEETS

FAI RTE.	SECTION	COUNTY	TOTAL SHEETS	SHEET NO.
57	139HBR-6	KANKAKEE	202	112
CONTRACT NO. 66997				
ILLINOIS FED. AID PROJECT				

9'-7" D42(E)
9'-6" D43(E)
9'-4" D44(E)
9'-1" D45(E)
8'-11" D46(E)
8'-9" D47(E)
8'-6" D48(E)
8'-4" D49(E)
8'-2" D50(E)
8'-0" D51(E)
7'-9" D52(E)
7'-7" D53(E)
7'-5" D54(E)
7'-2" D55(E)
7'-0" D56(E)
6'-11" D57(E)
7'-8" D58(E)
7'-6" D59(E)
7'-4" D60(E)
7'-1" D61(E)

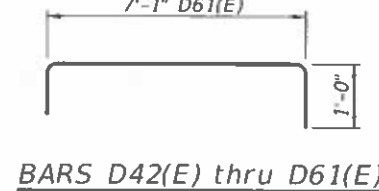


BARS D42(E) thru D61(E)

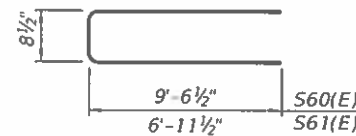


BARS S60(E) & S61(E)

5'-6 1/2" S62(E)
5'-6" S63(E)
5'-5 1/2" S64(E)
5'-5" S65(E)
5'-4 1/2" S66(E)
5'-4" S67(E)
5'-3 1/2" S68(E)
5'-3" S69(E)
5'-2 1/2" S70(E)
5'-2" S71(E)
5'-1 1/2" S72(E)
5'-1" S73(E)
5'-0 1/2" S74(E)
5'-0" S75(E)
4'-11 1/2" S76(E)
4'-11" S77(E)
4'-10 1/2" S78(E)
4'-10" S79(E)
4'-9 1/2" S80(E)
4'-9" S81(E)
4'-8 1/2" S82(E)
4'-8" S83(E)
4'-7 1/2" S84(E)
4'-7" S85(E)
4'-6 1/2" S86(E)
4'-6" S87(E)
4'-5 1/2" S88(E)
4'-5" S89(E)
4'-4 1/2" S90(E)
4'-4" S91(E)
4'-3 1/2" S92(E)
4'-3" S93(E)
4'-2 1/2" S94(E)
4'-2" S95(E)
4'-1 1/2" S96(E)
4'-1" S97(E)

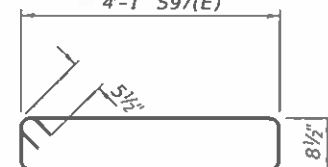


BARS S62(E) thru S97(E)

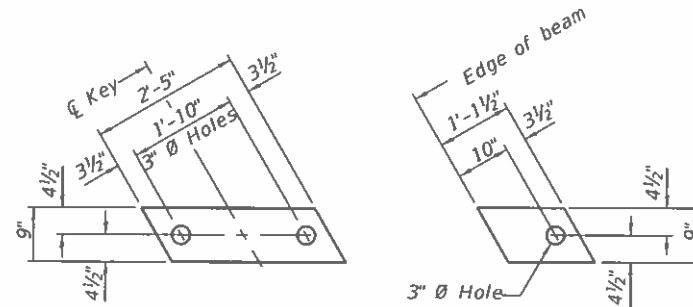

INTERIOR EXTERIOR

FABRIC BEARING PAD

Notes:
Bearing pads at fixed end shall be 1/2" thick and bearing pads at expansion end shall be 3/4" thick.
Omit holes for fabric bearing pads at approach slab footing end of beams.

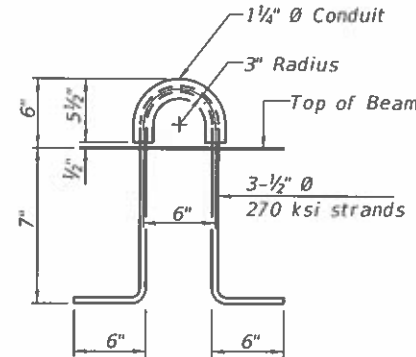

LIFTING LOOP DETAIL

(An alternate lifting loop with a proof load of 25,000 lbs. and utilized according to the manufacturer's recommendations may be used)

Notes:
The precast bridge approach slab shall be according to Section 504 of the Standard Specifications and shall be paid for at the contract unit price per square foot for Precast Bridge Approach Slab.
Cast-in-place substitution of Precast Bridge Approach Slab is not allowed.
The top surface of precast bridge approach slabs shall be finished similar to precast prestressed deck beams with concrete wearing surface as specified in the IDOT "Manual for Fabrication of Precast Prestressed Concrete Products."
Two 1/8" fabric adjusting shims of the dimensions of the exterior bearing pad shall be provided for each bearing pad location. Cost included with Precast Bridge Approach Slab.
A minimum 2 1/2" diameter lifting pins shall be used to engage the lifting loops during handling.
Compressive strength of precast concrete, f'c shall be 6,000 psi.
Compressive strength of precast concrete during initial lifting, f'ci shall be 5,000 psi.

BAR LIST


NORTH RIGHT EXTERIOR BEAM (For information only)

Bar	No.	Size	Length	Shape
B(E)	5	#5	29'-8"	—
B1(E)	10	#9	29'-8"	—
B12(E)	1	#9	27'-6"	—
B13(E)	1	#9	6'-5"	—
B14(E)	1	#9	12'-0"	—
B15(E)	1	#9	16'-1"	—
B16(E)	1	#9	19'-7"	—
B17(E)	1	#5	17'-2"	—
B18(E)	1	#5	8'-4"	—
D42(E)	1	#4	11'-7"	—
D43(E)	1	#4	11'-6"	—
D44(E)	1	#4	11'-4"	—
D45(E)	1	#4	11'-1"	—
D46(E)	1	#4	10'-11"	—
D47(E)	1	#4	10'-9"	—
D48(E)	1	#4	10'-6"	—
D49(E)	1	#4	10'-4"	—
D50(E)	1	#4	10'-2"	—
D51(E)	1	#4	10'-0"	—
D52(E)	1	#4	9'-9"	—
D53(E)	1	#4	9'-7"	—
D54(E)	1	#4	9'-5"	—
D55(E)	1	#4	9'-2"	—
D56(E)	1	#4	9'-0"	—
D57(E)	13	#4	8'-11"	—
D58(E)	1	#4	9'-8"	—
D59(E)	1	#4	9'-6"	—
D60(E)	1	#4	9'-4"	—
D61(E)	1	#4	9'-1"	—


BAR LIST

NORTH RIGHT EXTERIOR BEAM (For information only)

Bar	No.	Size	Length	Shape
S60(E)	19	#5	19'-10"	—
S61(E)	14	#5	14'-8"	—
S62(E)	1	#5	13'-5"	—
S63(E)	1	#5	13'-4"	—
S64(E)	1	#5	13'-3"	—
S65(E)	1	#5	13'-2"	—
S66(E)	1	#5	13'-1"	—
S67(E)	1	#5	13'-0"	—
S68(E)	1	#5	12'-11"	—
S69(E)	1	#5	12'-10"	—
S70(E)	1	#5	12'-9"	—
S71(E)	1	#5	12'-8"	—
S72(E)	1	#5	12'-7"	—
S73(E)	1	#5	12'-6"	—
S74(E)	1	#5	12'-5"	—
S75(E)	1	#5	12'-4"	—
S76(E)	1	#5	12'-3"	—
S77(E)	1	#5	12'-2"	—
S78(E)	1	#5	12'-1"	—
S79(E)	1	#5	12'-0"	—
S80(E)	1	#5	11'-11"	—
S81(E)	1	#5	11'-10"	—
S82(E)	1	#5	11'-9"	—
S83(E)	1	#5	11'-8"	—
S84(E)	1	#5	11'-7"	—
S85(E)	1	#5	11'-6"	—
S86(E)	1	#5	11'-5"	—
S87(E)	1	#5	11'-4"	—
S88(E)	1	#5	11'-3"	—
S89(E)	1	#5	11'-2"	—
S90(E)	1	#5	11'-1"	—
S91(E)	1	#5	11'-0"	—
S92(E)	1	#5	10'-11"	—
S93(E)	1	#5	10'-10"	—
S94(E)	1	#5	10'-9"	—
S95(E)	1	#5	10'-8"	—
S96(E)	1	#5	10'-7"	—
S97(E)	6	#5	10'-6"	—

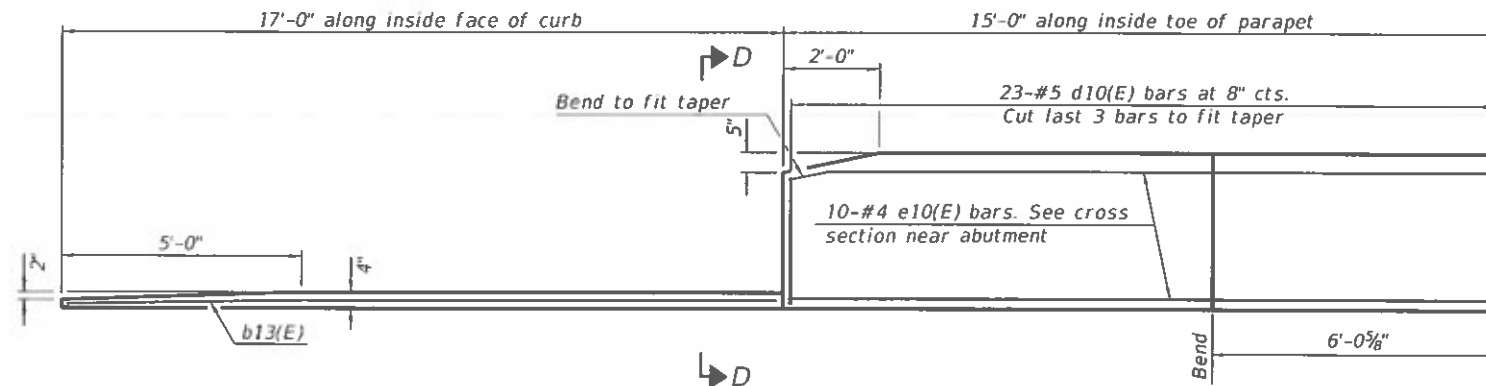

INSIDE ELEVATION OF EAST (LEFT) PARAPET AND CURB

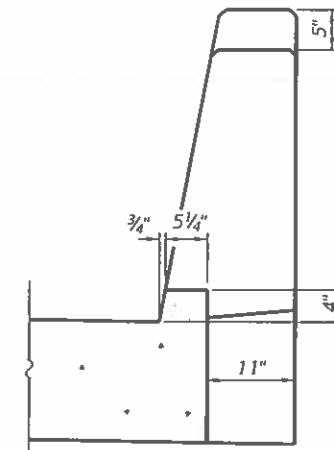

VIEW D-D


Notes:

The joint opening shall be adjusted for temperature per Article 520.04 of the Standard Specifications. However, since this detail is for jointless structures, the length of bridge used to calculate the adjustment shall be equal to half the total bridge length plus the length of the bridge approach slab.

After precast bridge approach slabs have been erected, holes shall be drilled into abutment and anchor dowels placed. Dowel holes shall be filled with non-shrink grout to top of precast slab and cured according to Article 1020.13(a)(3) or 1020.13(a)(5) of the Standard Specifications for a minimum of 24 hours before casting the shear keys and wearing surface.

Any concrete poured monolithically with the wearing surface, such as curbs, shall not be paid for separately, but will be included in the cost of Concrete Wearing Surface, 5". The strip seal shall extend 6" beyond the edge of the approach slab on each end. Parapet concrete shall be paid for as Concrete Superstructure.

Approach footing concrete shall be paid for as Concrete Structures. The approach footing maximum applied service bearing pressure (Q_{max}) = 2.0 ksf. Cost of excavation for approach footing included with Concrete Structures. For Granular Backfill for Structures and drainage treatment details, see sheet 2 of 54. Cost of cellular polystyrene is included with Concrete Superstructure.

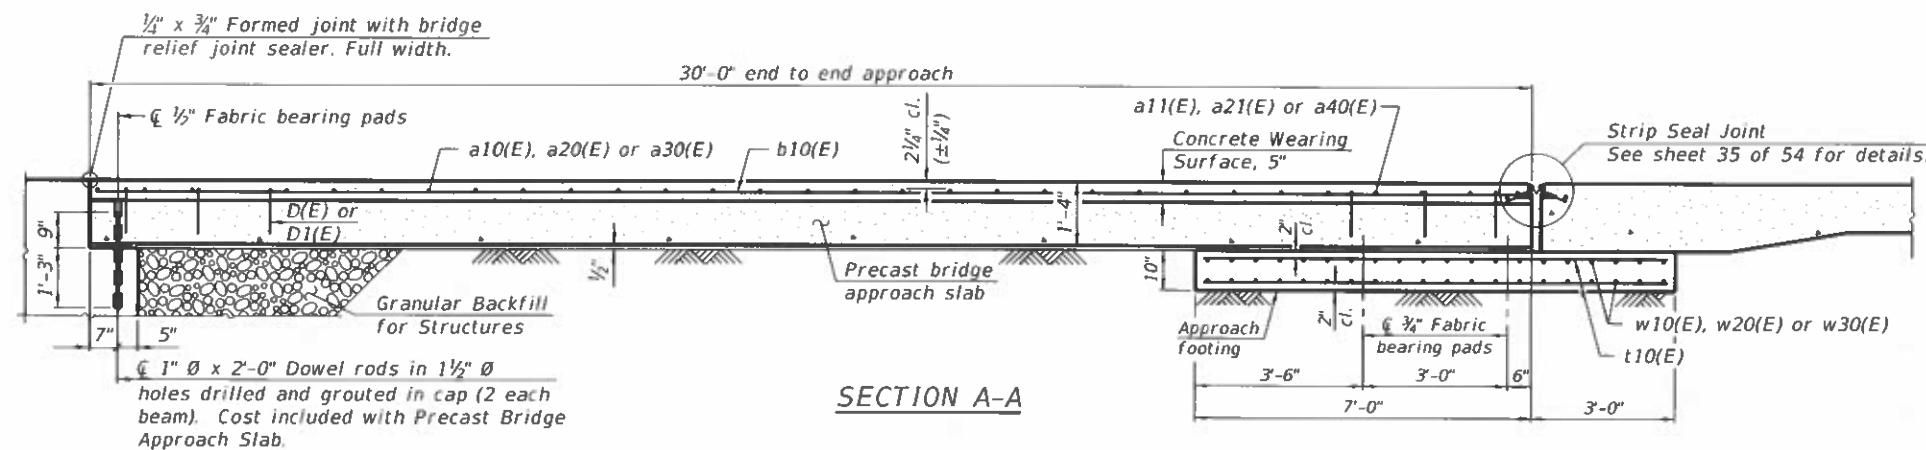


SECTION A-A


BILL OF MATERIAL

Bar	No.	Size	Length	Shape
a10(E)	16	#5	25'-0"	
a11(E)	20	#4	25'-0"	
a12(E)	26	#5	8'-2"	
a20(E)	8	#5	19'-10"	
a21(E)	10	#4	18'-5"	
a30(E)	8	#5	14'-2"	
a40(E)	10	#5	15'-3"	
b10(E)	43	#5	29'-5"	
b12(E)	4	#5	14'-7"	
b13(E)	1	#4	16'-9"	
b22(E)	4	#5	27'-5"	
d9(E)	53	#5	5'-3"	
d10(E)	76	#5	6'-5"	
d11(E)	23	#5	6'-5"	
d20(E)	41	#5	5'-0"	
d21(E)	41	#5	4'-9"	
e10(E)	10	#4	14'-9"	
e11(E)	12	#4	13'-3"	
e12(E)	4	#4	26'-9"	
e13(E)	12	#4	13'-1"	
e14(E)	4	#4	26'-6"	
e15(E)	10	#4	9'-0"	
t10(E)	96	#4	16'-6"	
w10(E)	80	#5	30'-0"	
w20(E)	40	#5	14'-6"	
w30(E)	40	#5	11'-1"	
Concrete Superstructure			Cu. Yd.	8.7
Concrete Structures			Cu. Yd.	23.9
Reinforcement Bars, Epoxy Coated			Pound	9550
Precast Bridge Approach Slab			Sq. Ft.	1293
Concrete Wearing Surface, 5"			Sq. Yd.	148



BAR a20(E), a30(E) or a40(E)

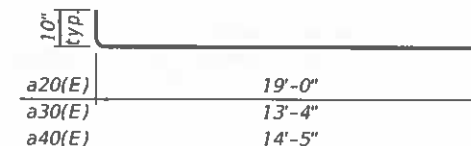


BAR a21(E)

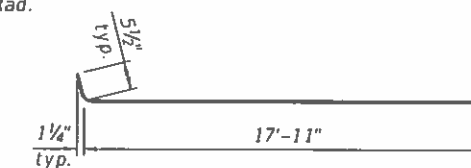


BAR a12(E)

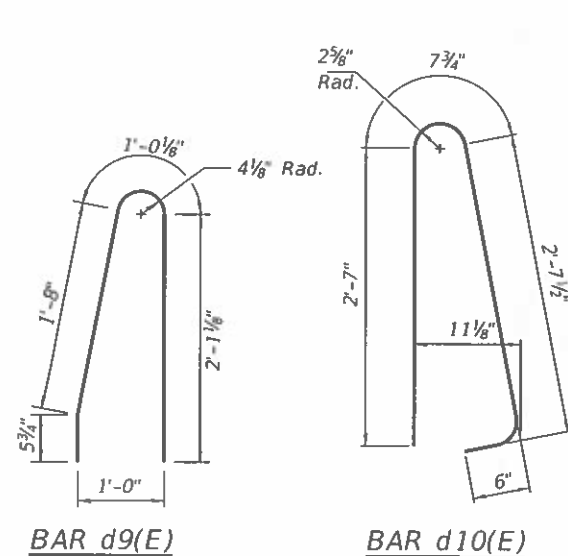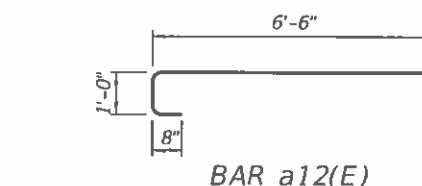


BAR d10(E)

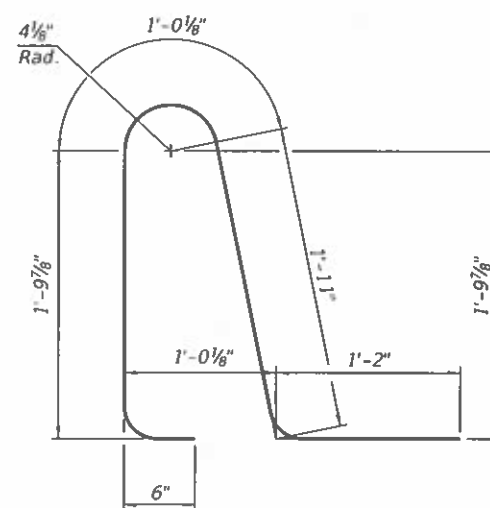


BAR d11(E)

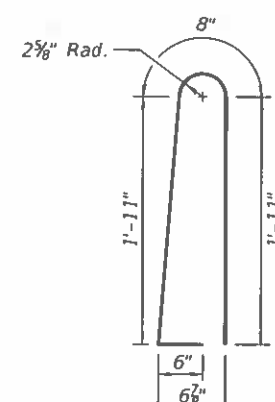


BAR d20(E)

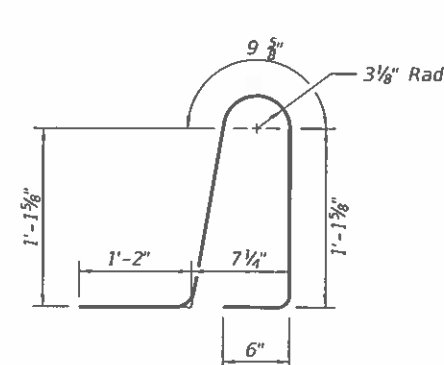

BAR d21(E)

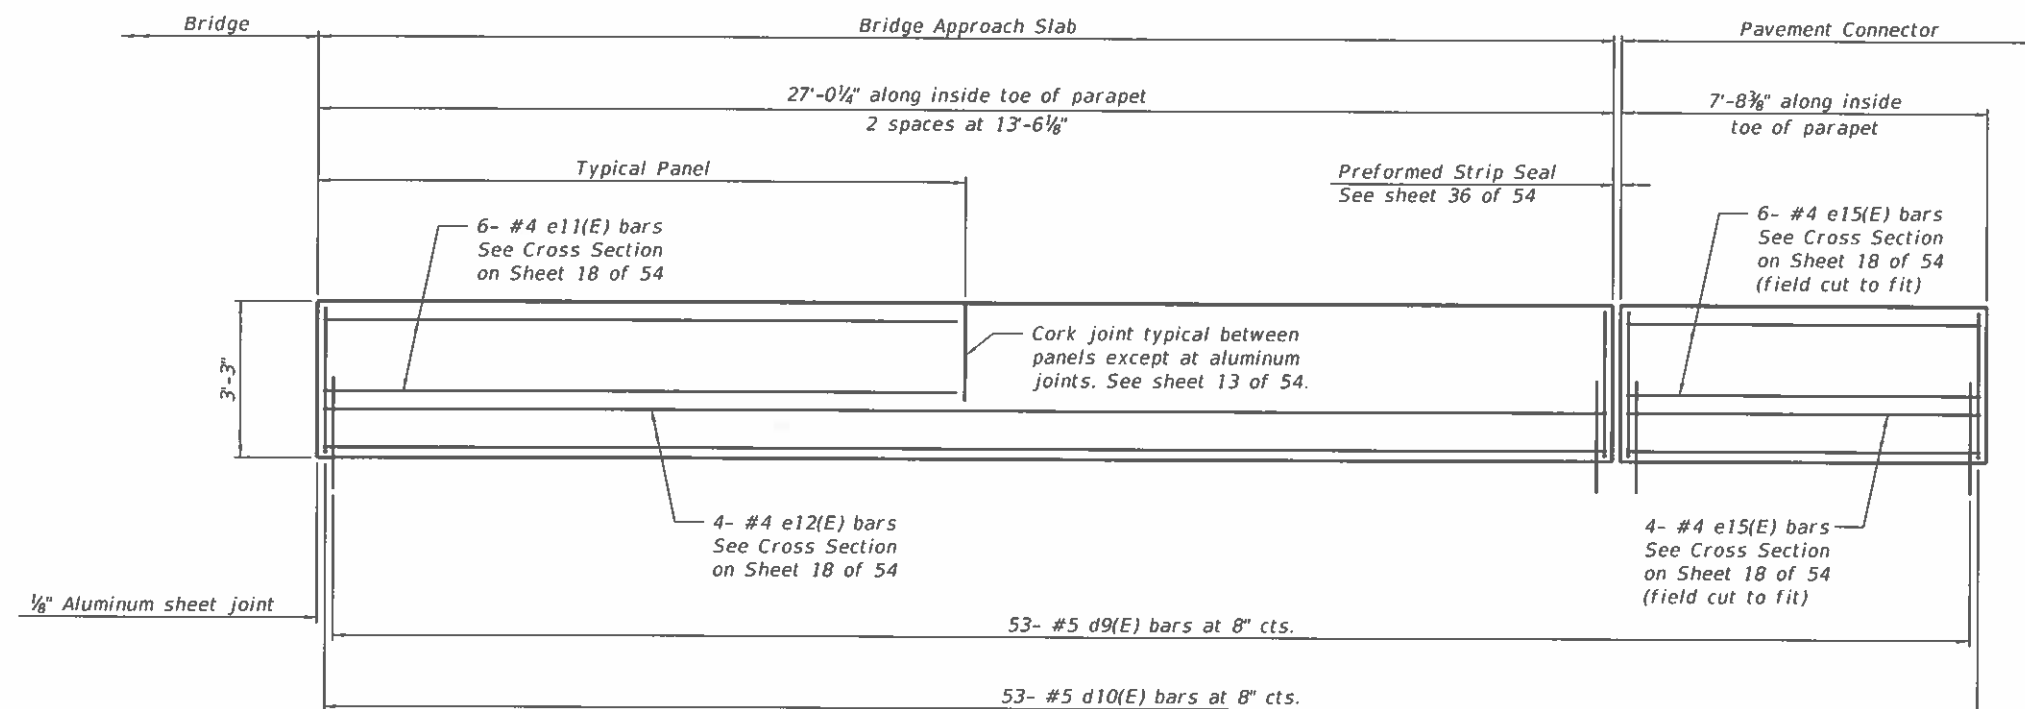

INSIDE ELEVATION OF WEST (RIGHT) PARAPET

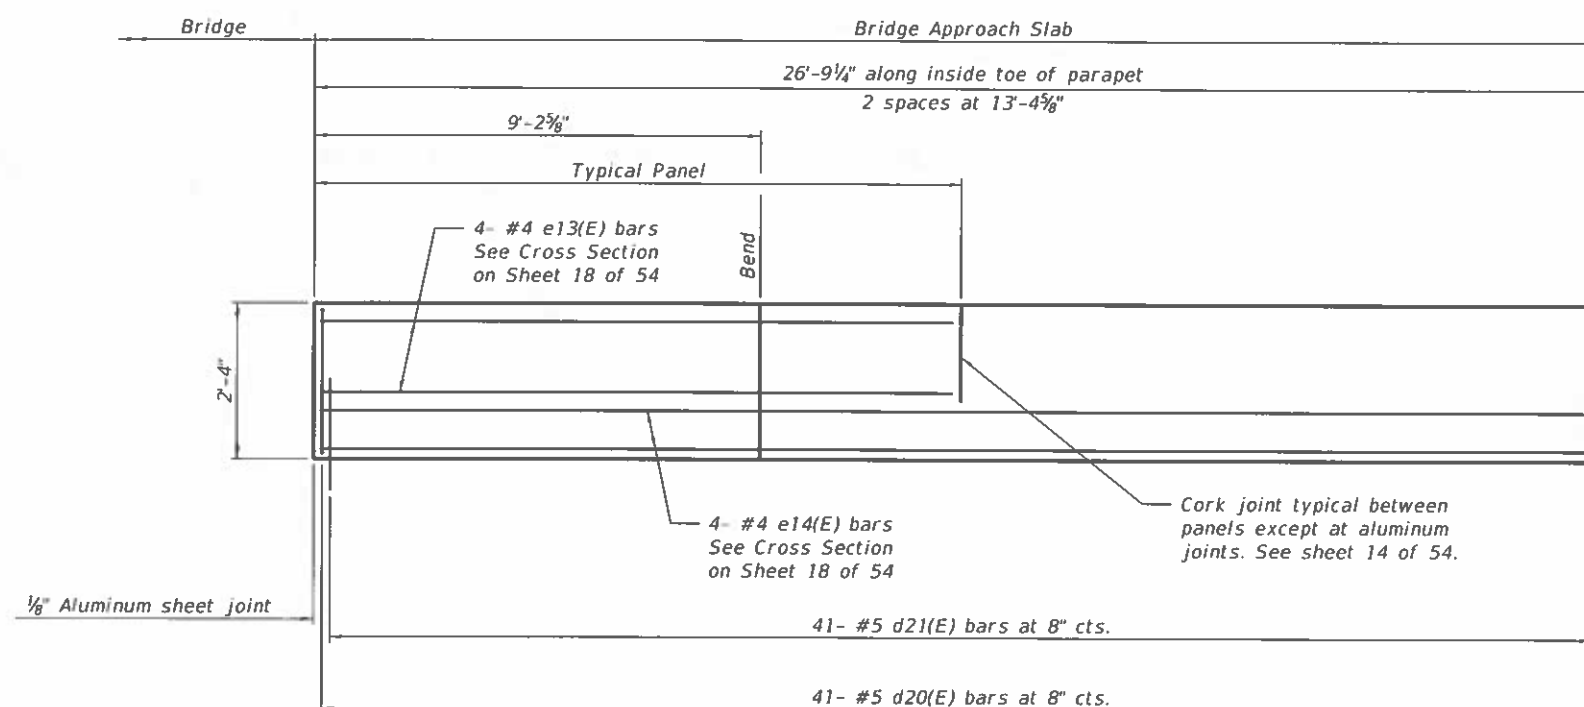

INSIDE ELEVATION OF SIDEWALK PARAPET

(Sheet 9 of 9)



USER NAME	DESIGNED - JKC	REVISIONS
PLOT SCALE	CHECKED - AJO	REVISIONS
PLOT DATE	DRAWN - LAG	REVISIONS
	CHECKED - JKC	REVISIONS

STATE OF ILLINOIS
DEPARTMENT OF TRANSPORTATION

NORTH PRECAST BRIDGE APPROACH SLAB
STRUCTURE NO. 046-0153

FAI RTE.	SECTION	COUNTY	TOTAL SHEETS	SHEET NO.
57	139HBR-6	KANKAKEE	202	114
CONTRACT NO. 66997				

SHEET 25 OF 54 SHEETS

ILLINOIS FED. AID PROJECT



3 1/4"
(± 1/4")

2"
(± 1/4")

Shear key cast with concrete wearing surface, typ.

Interior fabric bearing pad

Styrofoam block full length of beam

DETAIL 'A'



MODEL: 028-SOUTH BEAMDET 4ft. 5ft.
FILE NAME: G:\Users\11111111335-01-Waldron-Road-over-157-SuperstructureSurvey D366997\Consultant_Data\Chamlin_2020\CAO_Sheets\0460153-66997-017-024_026-033-PCASTAPPS\LAB.dgn
3/2/2021 3:06:51 PM




USER NAME	DESIGNED - JKC	REVISED -
PLOT SCALE	CHECKED - AJO	REVISED -
PLOT DATE	DRAWN - LAG	REVISED -
	CHECKED - JKC	REVISED -

STATE OF ILLINOIS
DEPARTMENT OF TRANSPORTATION

SOUTH PRECAST BRIDGE APPROACH SLABS
STRUCTURE NO. 046-0153


SHEET 28 OF 54 SHEETS

F.A.I. RTE.	SECTION	COUNTY	TOTAL SHEETS	SHEET NO.
57	139HBR-6	KANKAKEE	202	117
CONTRACT NO. 66997				
ILLINOIS FED. AID PROJECT				

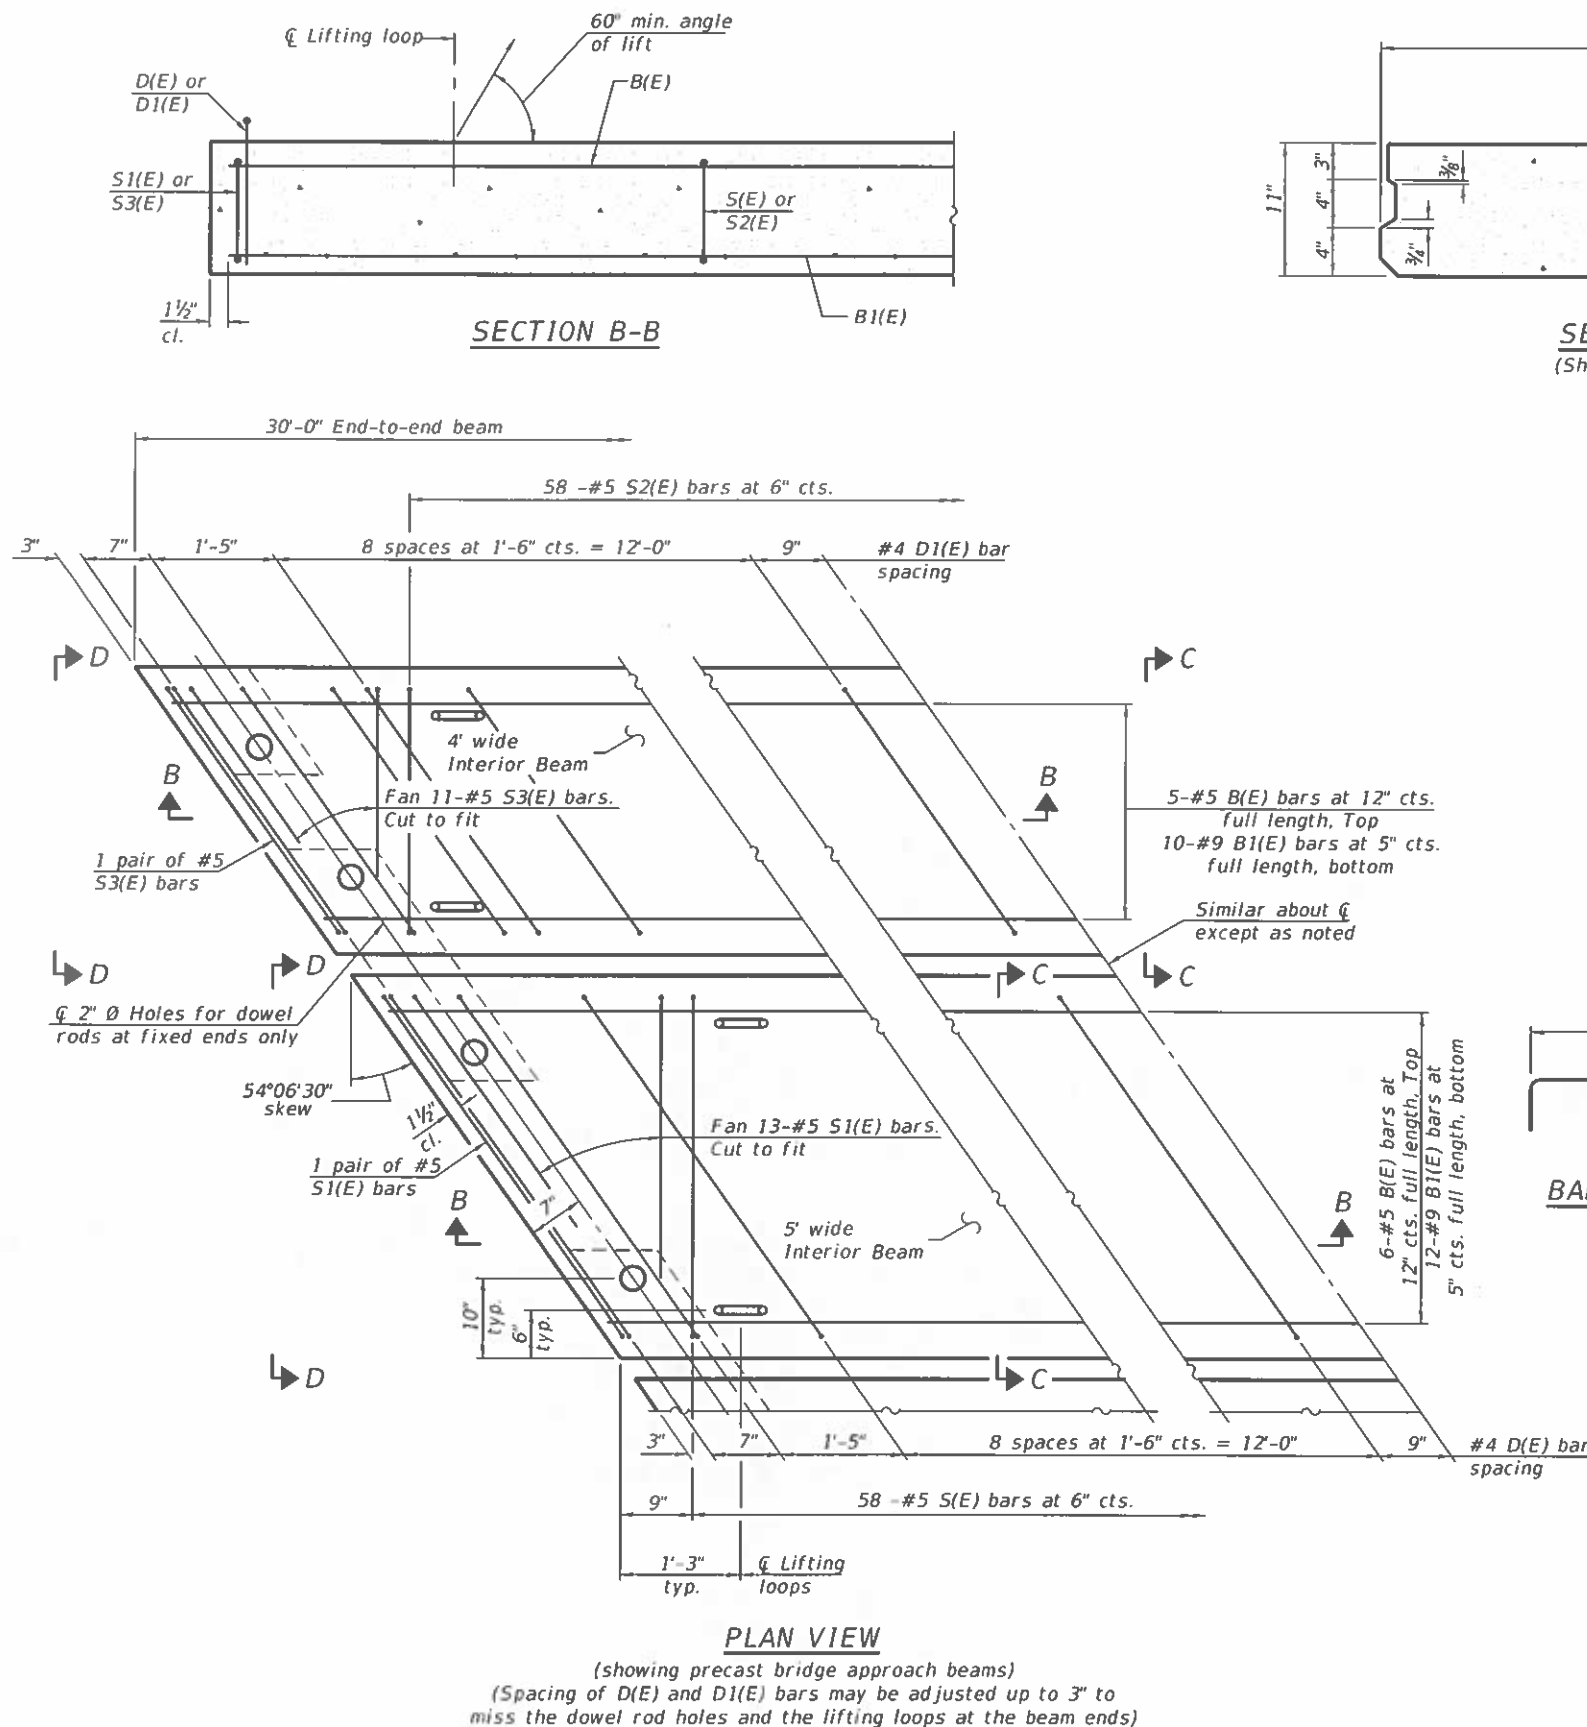


PLAN VIEW


(showing precast bridge approach beams)
(Spacing of D(E) and D1(E) bars may be adjusted up to 3" to miss the dowel rod holes and the lifting loops at the beam ends)

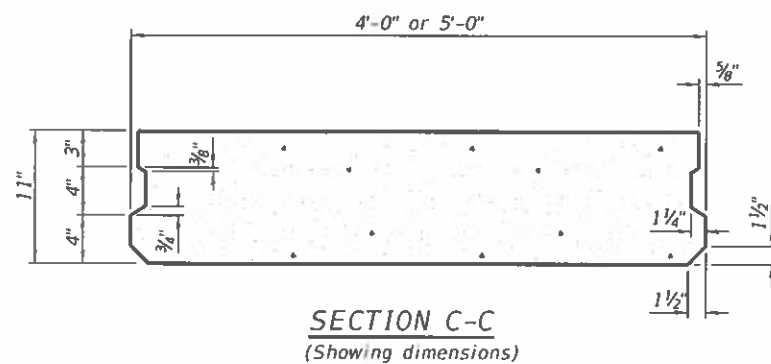


SECTION C-C
(Showing dimensions)

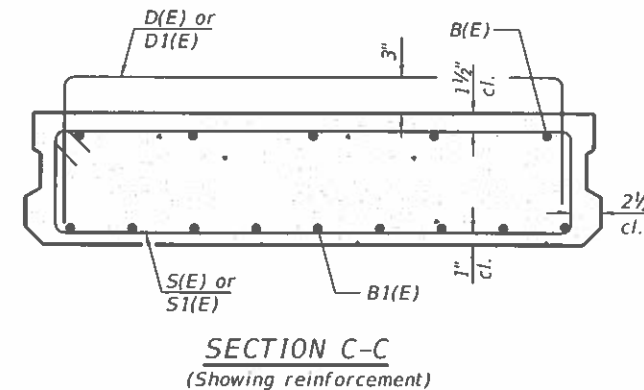

SECTION C-C
(Showing reinforcement)

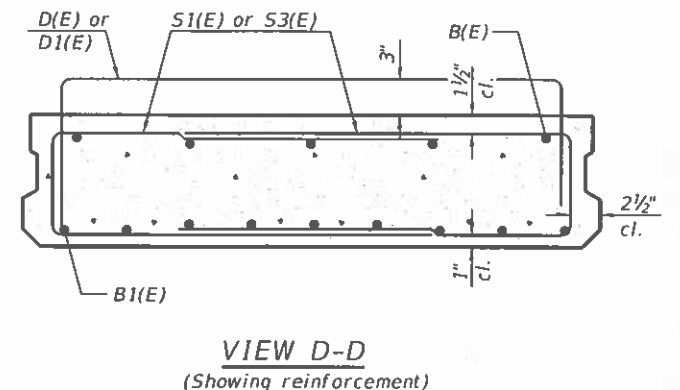


VIEW D-D
(Showing reinforcement)

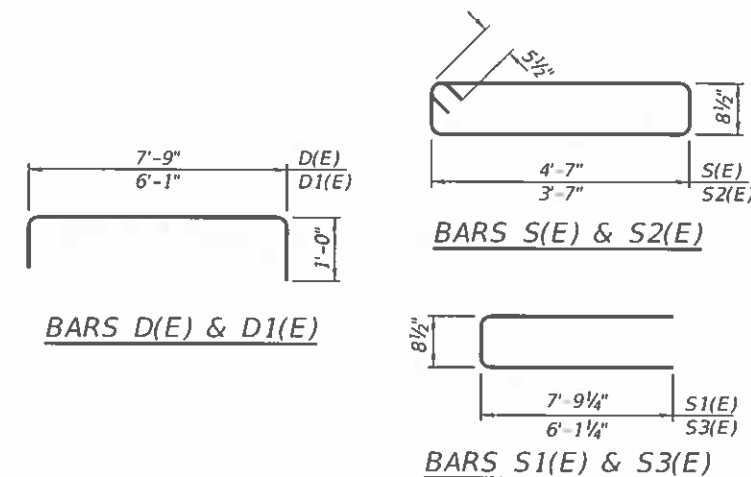

BARS D(E) & D1(E)


BARS S(E) & S2(E)

BARS S1(E) & S3(E)

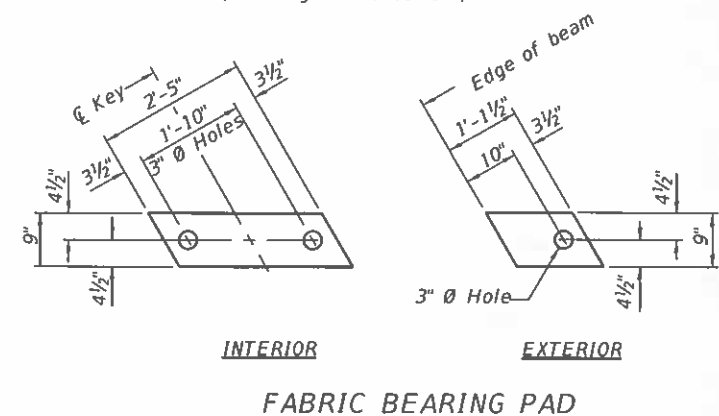

FABRIC BEARING PAD

Notes:
Bearing pads at fixed end shall be 1/2" thick and bearing pads at expansion end shall be 3/4" thick.
Omit holes for fabric bearing pads at approach slab footing end of beams.

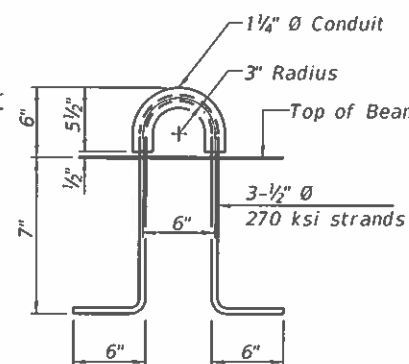

LIFTING LOOP DETAIL

(An alternate lifting loop with a proof load of 25,000 lbs. and utilized according to the manufacturer's recommendations may be used)



(Sheet 3 of 9)

BAR LIST
EACH 5' WIDE INTERIOR BEAM
(For information only)


Bar	No.	Size	Length	Shape
B(E)	6	#5	29'-8"	—
B1(E)	12	#9	29'-8"	—
D(E)	22	#4	9'-9"	┐
S(E)	58	#5	11'-6"	▮
S1(E)	30	#5	16'-3"	▮

BAR LIST
EACH 4' WIDE INTERIOR BEAM
(For information only)


Bar	No.	Size	Length	Shape
B(E)	5	#5	29'-8"	—
B1(E)	10	#9	29'-8"	—
D1(E)	32	#4	8'-1"	┐
S2(E)	58	#5	9'-6"	▮
S3(E)	26	#5	12'-3"	▮

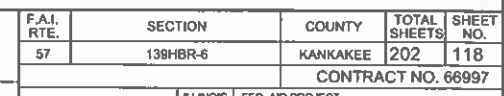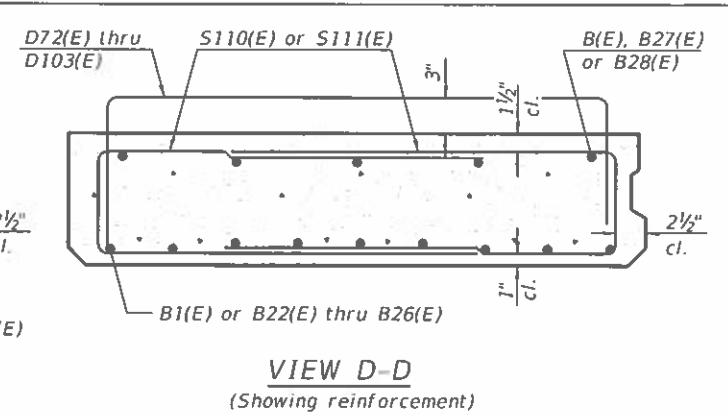


5'-3" D72(E)	3'-5" S112(E)
5'-4" D73(E)	3'-5 1/2" S113(E)
5'-5" D74(E)	3'-6" S114(E)
5'-7" D75(E)	3'-6 1/2" S115(E)
5'-9" D76(E)	3'-6 1/2" S116(E)
5'-11" D77(E)	3'-7" S117(E)
6'-1" D78(E)	3'-7 1/2" S118(E)
6'-3" D79(E)	3'-8" S119(E)
6'-5" D80(E)	3'-8 1/2" S120(E)
6'-7" D81(E)	3'-8 1/2" S121(E)
6'-9" D82(E)	3'-9" S122(E)
6'-11" D83(E)	3'-9 1/2" S123(E)
7'-1" D84(E)	3'-10" S124(E)
7'-2" D85(E)	3'-10 1/2" S125(E)
7'-4" D86(E)	3'-11" S126(E)
7'-6" D87(E)	3'-11" S127(E)
7'-8" D88(E)	3'-11 1/2" S128(E)
7'-10" D89(E)	4'-0" S129(E)
8'-0" D90(E)	4'-0 1/2" S130(E)
8'-2" D91(E)	4'-1" S131(E)
8'-4" D92(E)	4'-1 1/2" S132(E)
8'-5" D93(E)	4'-1 1/2" S133(E)
5'-5" D94(E)	4'-2" S134(E)
5'-6" D95(E)	4'-2 1/2" S135(E)
5'-8" D96(E)	4'-3" S136(E)
5'-10" D97(E)	4'-3 1/2" S137(E)
6'-0" D98(E)	4'-3 1/2" S138(E)
6'-2" D99(E)	4'-4" S139(E)
6'-4" D100(E)	4'-4 1/2" S140(E)
6'-6" D101(E)	4'-5" S141(E)
6'-8" D102(E)	4'-5 1/2" S142(E)
6'-10" D103(E)	4'-6" S143(E)

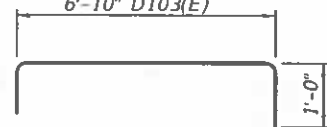


BARS D72(E) thru D103(E)

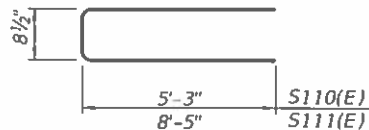

BARS S110(E) & S111(E)

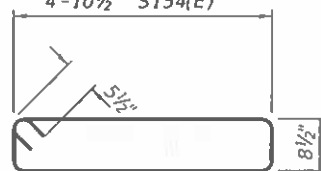


BARS S112(E) thru S154(E)

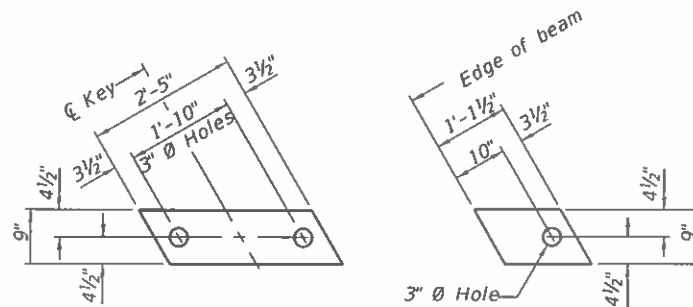

FABRIC BEARING PAD

Notes:
Bearing pads at fixed end shall be 1/2" thick and bearing pads at expansion end shall be 3/4" thick.
Omit holes for fabric bearing pads at approach slab footing end of beams.

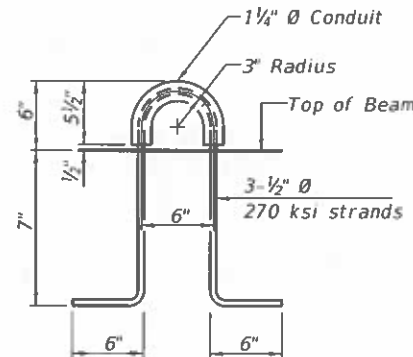

LIFTING LOOP DETAIL

(An alternate lifting loop with a proof load of 25,000 lbs. and utilized according to the manufacturer's recommendations may be used)

Notes:
The precast bridge approach slab shall be according to Section 504 of the Standard Specifications and shall be paid for at the contract unit price per square foot for Precast Bridge Approach Slab.
Cast-in-place substitution of Precast Bridge Approach Slab is not allowed.
The top surface of precast bridge approach slabs shall be finished similar to precast prestressed deck beams with concrete wearing surface as specified in the IDOT "Manual for Fabrication of Precast Prestressed Concrete Products."
Two 1/8" fabric adjusting shims of the dimensions of the exterior bearing pad shall be provided for each bearing pad location. Cost included with Precast Bridge Approach Slab.
A minimum 2 1/2" Ø lifting pins shall be used to engage the lifting loops during handling.
Compressive strength of precast concrete, f'c shall be 6,000 psi.
Compressive strength of precast concrete during initial lifting, f'ci shall be 5,000 psi.

BAR LIST SOUTH LEFT EXTERIOR BEAM (For information only)

Bar	No.	Size	Length	Shape
B(E)	4	#5	29'-8"	—
B1(E)	8	#9	29'-8"	—
B22(E)	1	#9	27'-1"	—
B23(E)	1	#9	25'-7"	—
B24(E)	1	#9	21'-7"	—
B25(E)	1	#9	16'-10"	—
B26(E)	1	#9	10'-11"	—
B27(E)	1	#5	27'-1"	—
B28(E)	1	#5	14'-11"	—
D72(E)	1	#4	7'-3"	—
D73(E)	1	#4	7'-4"	—
D74(E)	1	#4	7'-5"	—
D75(E)	1	#4	7'-7"	—
D76(E)	1	#4	7'-9"	—
D77(E)	1	#4	7'-11"	—
D78(E)	1	#4	8'-1"	—
D79(E)	1	#4	8'-3"	—
D80(E)	1	#4	8'-5"	—
D81(E)	1	#4	8'-7"	—
D82(E)	1	#4	8'-9"	—
D83(E)	1	#4	8'-11"	—
D84(E)	1	#4	9'-1"	—
D85(E)	1	#4	9'-2"	—
D86(E)	1	#4	9'-4"	—
D87(E)	1	#4	9'-6"	—
D88(E)	1	#4	9'-8"	—
D89(E)	1	#4	9'-10"	—
D90(E)	1	#4	10'-0"	—
D91(E)	1	#4	10'-2"	—
D92(E)	1	#4	10'-4"	—
D93(E)	1	#4	10'-5"	—
D94(E)	1	#4	7'-5"	—
D95(E)	1	#4	7'-6"	—
D96(E)	1	#4	7'-8"	—
D97(E)	1	#4	7'-10"	—
D98(E)	1	#4	8'-0"	—
D99(E)	1	#4	8'-2"	—
D100(E)	1	#4	8'-4"	—
D101(E)	1	#4	8'-6"	—
D102(E)	1	#4	8'-8"	—
D103(E)	1	#4	8'-10"	—

BAR LIST SOUTH LEFT EXTERIOR BEAM (For information only)

Bar	No.	Size	Length	Shape
S110(E)	11	#5	11'-3"	—
S111(E)	17	#5	17'-7"	—
S112(E)	1	#5	9'-2"	—
S113(E)	1	#5	9'-3"	—
S114(E)	1	#5	9'-4"	—
S115(E)	1	#5	9'-5"	—
S116(E)	1	#5	9'-5"	—
S117(E)	1	#5	9'-6"	—
S118(E)	1	#5	9'-7"	—
S119(E)	1	#5	9'-8"	—
S120(E)	1	#5	9'-9"	—
S121(E)	1	#5	9'-9"	—
S122(E)	1	#5	9'-10"	—
S123(E)	1	#5	9'-11"	—
S124(E)	1	#5	10'-0"	—
S125(E)	1	#5	10'-1"	—
S126(E)	1	#5	10'-2"	—
S127(E)	1	#5	10'-2"	—
S128(E)	1	#5	10'-3"	—
S129(E)	1	#5	10'-4"	—
S130(E)	1	#5	10'-5"	—
S131(E)	1	#5	10'-6"	—
S132(E)	1	#5	10'-7"	—
S133(E)	1	#5	10'-7"	—
S134(E)	1	#5	10'-8"	—
S135(E)	1	#5	10'-9"	—
S136(E)	1	#5	10'-10"	—
S137(E)	1	#5	10'-11"	—
S138(E)	1	#5	10'-11"	—
S139(E)	1	#5	11'-0"	—
S140(E)	1	#5	11'-1"	—
S141(E)	1	#5	11'-2"	—
S142(E)	1	#5	11'-3"	—
S143(E)	1	#5	11'-4"	—
S144(E)	1	#5	11'-4"	—
S145(E)	1	#5	11'-5"	—
S146(E)	1	#5	11'-6"	—
S147(E)	1	#5	11'-7"	—
S148(E)	1	#5	11'-8"	—
S149(E)	1	#5	11'-9"	—
S150(E)	1	#5	11'-9"	—
S151(E)	1	#5	11'-10"	—
S152(E)	1	#5	11'-11"	—
S153(E)	1	#5	12'-0"	—
S154(E)	1	#5	12'-1"	—

(Sheet 5 of 9)

STATE OF ILLINOIS
DEPARTMENT OF TRANSPORTATION

SOUTH PRECAST BRIDGE APPROACH SLAB
STRUCTURE NO. 046-0153


SHEET 30 OF 54 SHEETS

F.A.I. RTE.	SECTION	COUNTY	TOTAL SHEETS	SHEET NO.
57	139HBR-6	KANKAKEE	202	119
CONTRACT NO. 66997				



USER NAME	DESIGNED	JKC	REVISED	
PLOT SCALE	CHECKED	AJO	REVISED	
PLOT DATE	DRAWN	LAG	REVISED	
	CHECKED	JKC	REVISED	

MODEL: 031-BEAMDET EXTER
FILE NAME: C:\Users\11111335-01-Walton-Road-over-157-SuperstructureSurvey-D366997\Consultant_Data\Chamlin_2020\CAD_Sheets\0460153-66997-017-024-026-033-PCASTAPPS\LAB.dgn
3/2/2021 3:05:44 PM

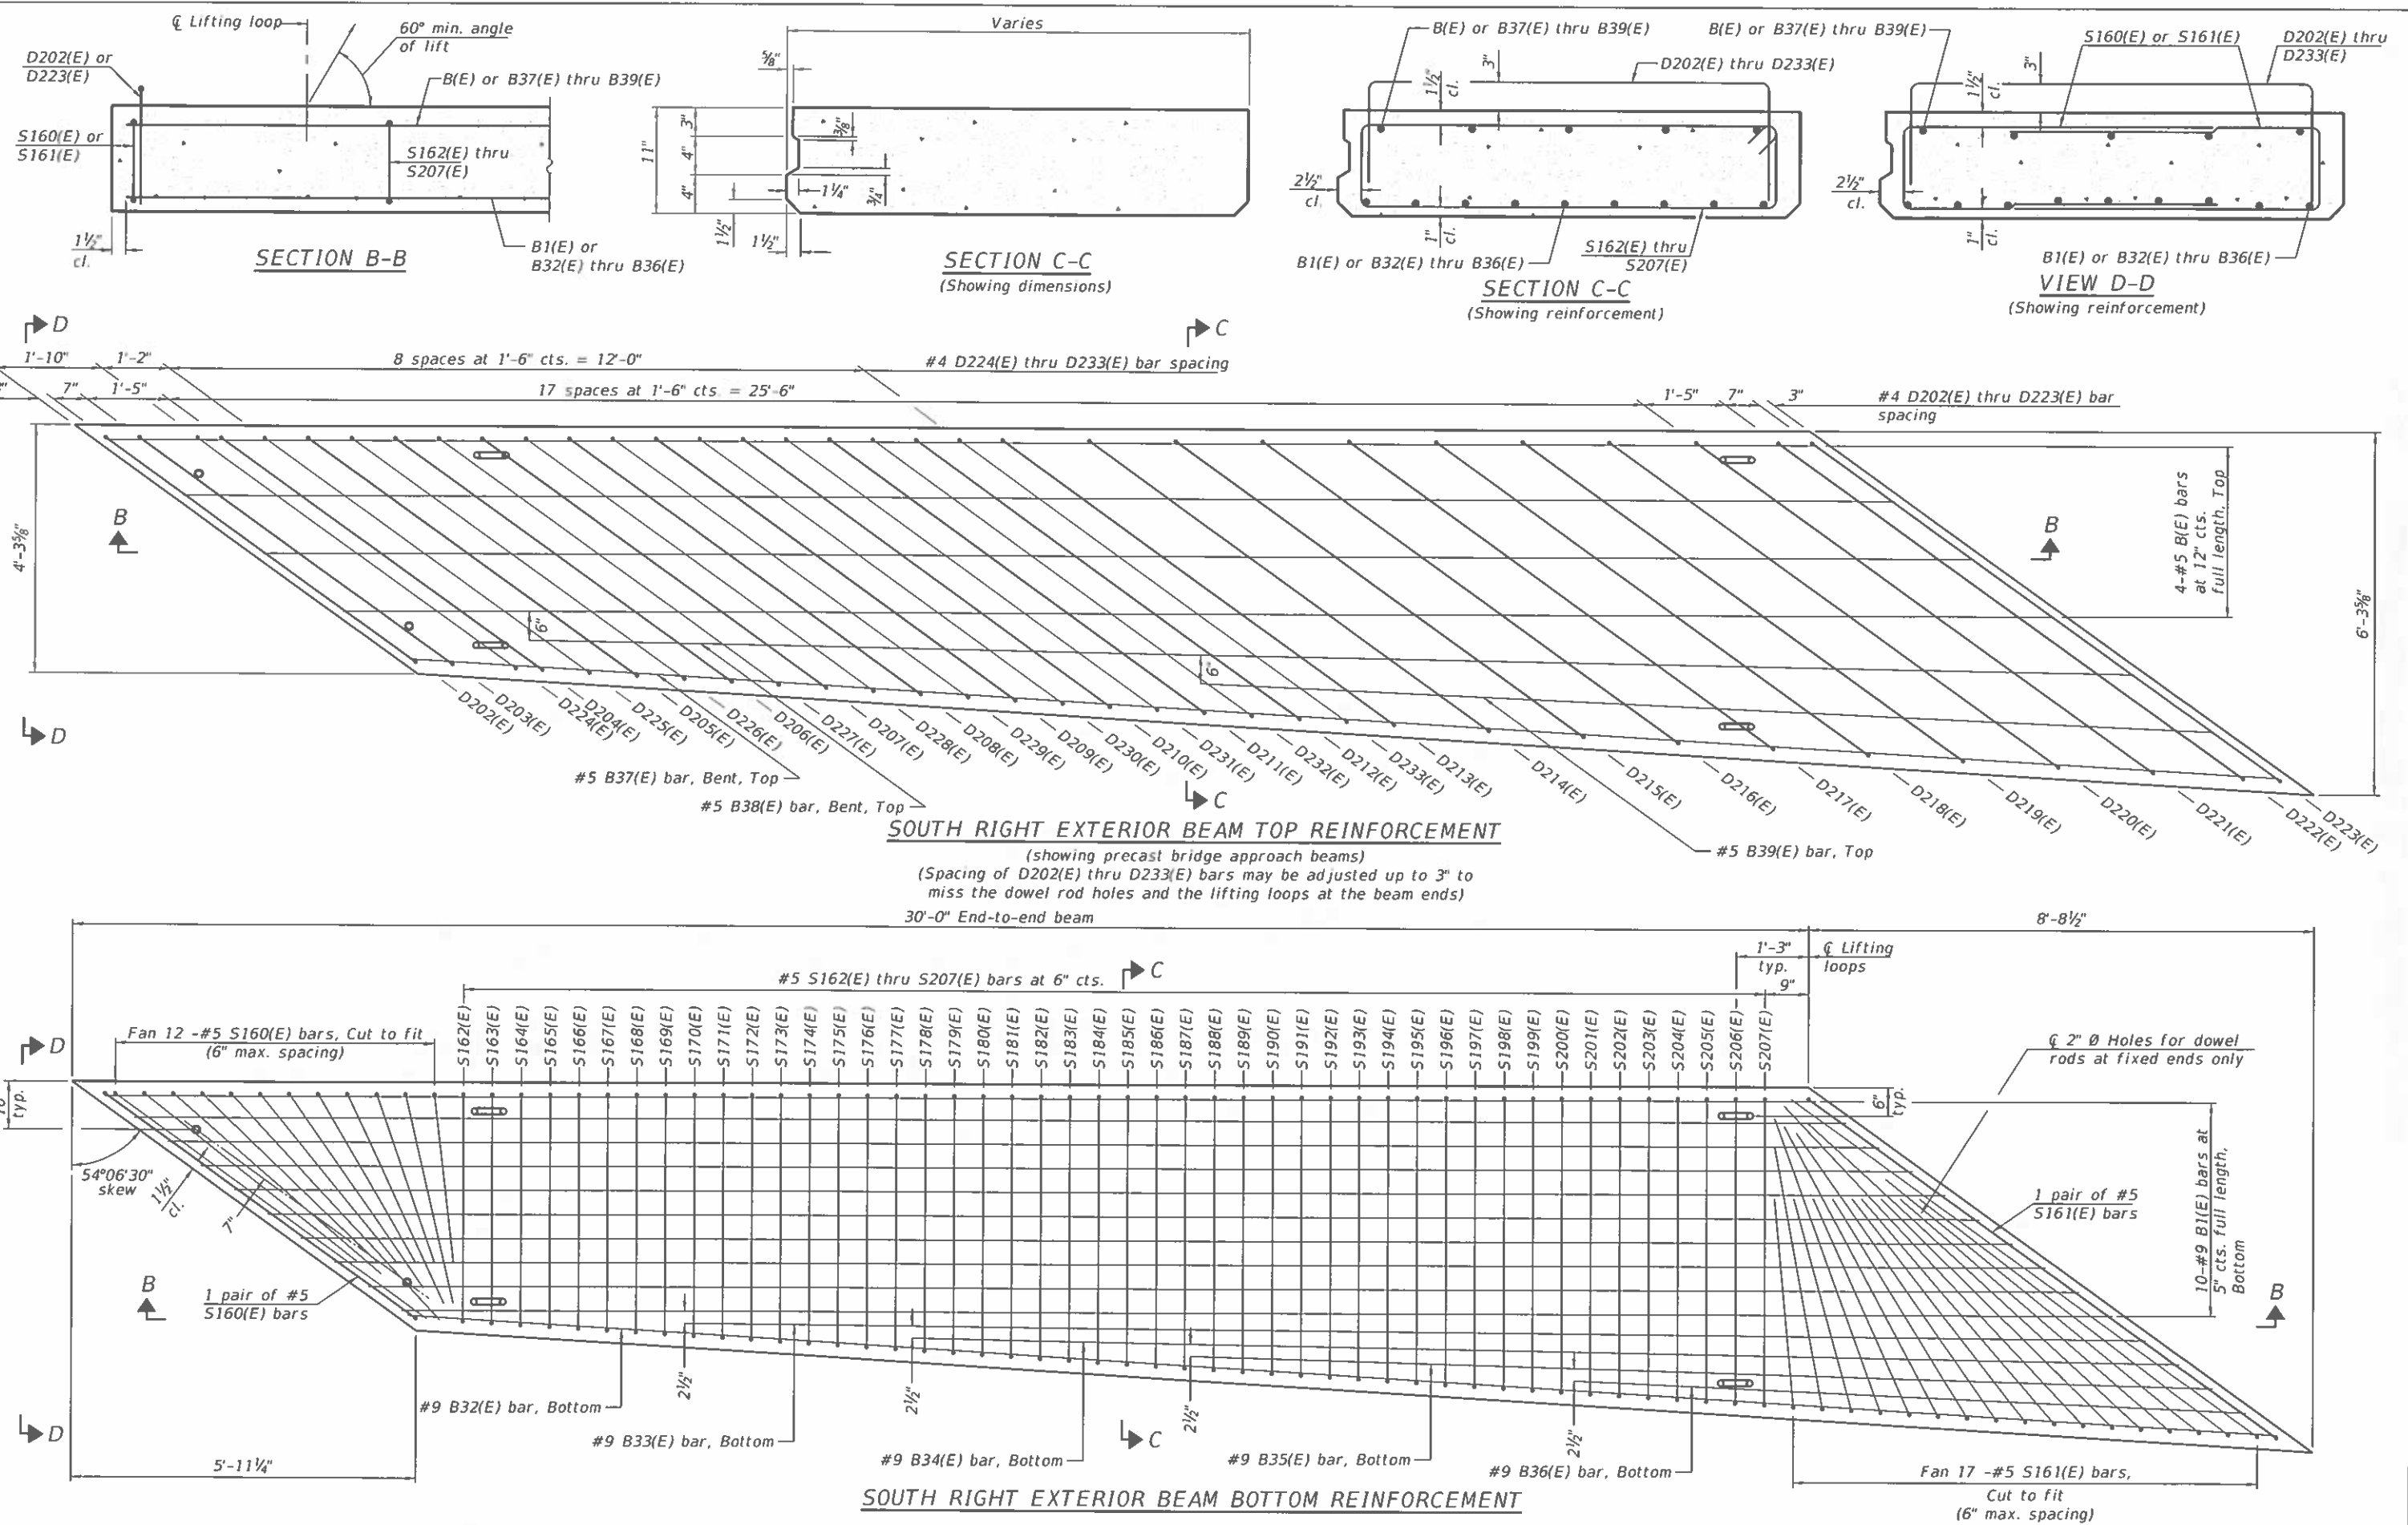

(Sheet 6 of 9)



USER NAME	DESIGNED - JKC	REVISED -
PLOT SCALE	CHECKED - AJO	REVISED -
PLOT DATE	DRAWN - LAG	REVISED -
	CHECKED - JKC	REVISED -

STATE OF ILLINOIS
DEPARTMENT OF TRANSPORTATION


SOUTH PRECAST BRIDGE APPROACH SLAB
STRUCTURE NO. 046-0153

SHEET 31 OF 54 SHEETS


F.A.I. RTE.	SECTION	COUNTY	TOTAL SHEETS	SHEET NO.
57	139HBR-6	KANKAKEE	202	120
CONTRACT NO. 66997				
ILLINOIS FED. AID PROJECT				

MODEL: 032-BEAMDET EXTSR2
FILE NAME: G:\Users\11111111\OneDrive\Survey\1366997\Consultant_Data\Chamlin_2020\CAD_Sheets\0460153-66997-017-024_026-033-PCASTAPPSLAB.dgn
3/2/2021 3:06:21 PM

- 6'-7" D202(E)
- 6'-8" D203(E)
- 6'-10" D204(E)
- 7'-0" D205(E)
- 7'-2" D206(E)
- 7'-4" D207(E)
- 7'-6" D208(E)
- 7'-8" D209(E)
- 7'-10" D210(E)
- 8'-0" D211(E)
- 8'-2" D212(E)
- 8'-4" D213(E)
- 8'-6" D214(E)
- 8'-8" D215(E)
- 8'-10" D216(E)
- 9'-0" D217(E)
- 9'-2" D218(E)
- 9'-4" D219(E)
- 9'-6" D220(E)
- 9'-8" D221(E)
- 9'-10" D222(E)
- 9'-11" D223(E)
- 6'-9" D224(E)
- 6'-11" D225(E)
- 7'-1" D226(E)
- 7'-3" D227(E)
- 7'-5" D228(E)
- 7'-7" D229(E)
- 7'-9" D230(E)
- 7'-11" D231(E)
- 8'-1" D232(E)
- 8'-3" D233(E)

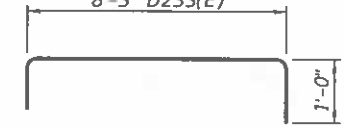


BARS D202(E) thru D233(E)

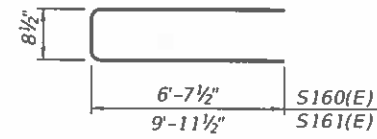


BARS S160(E) & S161(E)

- 3'-11" S162(E)
- 3'-11 1/2" S163(E)
- 4'-0" S164(E)
- 4'-0" S165(E)
- 4'-0 1/2" S166(E)
- 4'-1" S167(E)
- 4'-1" S168(E)
- 4'-1 1/2" S169(E)
- 4'-2" S170(E)
- 4'-2 1/2" S171(E)
- 4'-2 1/2" S172(E)
- 4'-3" S173(E)
- 4'-3 1/2" S174(E)
- 4'-4" S175(E)
- 4'-4" S176(E)
- 4'-4 1/2" S177(E)
- 4'-5" S178(E)
- 4'-5 1/2" S179(E)
- 4'-5 1/2" S180(E)
- 4'-6" S181(E)
- 4'-6 1/2" S182(E)
- 4'-6 1/2" S183(E)
- 4'-7" S184(E)
- 4'-7 1/2" S185(E)
- 4'-8" S186(E)
- 4'-8" S187(E)
- 4'-8 1/2" S188(E)
- 4'-9" S189(E)
- 4'-9 1/2" S190(E)
- 4'-9 1/2" S191(E)
- 4'-10" S192(E)
- 4'-10 1/2" S193(E)
- 4'-11" S194(E)
- 4'-11" S195(E)
- 4'-11 1/2" S196(E)
- 5'-0" S197(E)
- 5'-0" S198(E)
- 5'-0 1/2" S199(E)
- 5'-1" S200(E)
- 5'-1 1/2" S201(E)
- 5'-1 1/2" S202(E)
- 5'-2" S203(E)
- 5'-2 1/2" S204(E)
- 5'-3" S205(E)
- 5'-3" S206(E)
- 5'-3 1/2" S207(E)

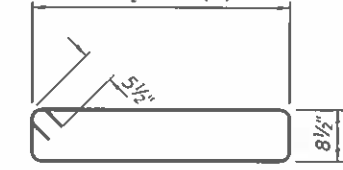


BARS S162(E) thru S207(E)

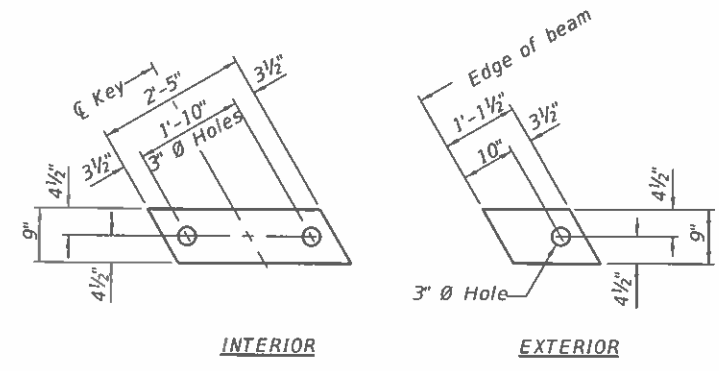

FABRIC BEARING PAD

Notes:
Bearing pads at fixed end shall be 1/2" thick and bearing pads at expansion end shall be 3/4" thick.
Omit holes for fabric bearing pads at approach slab footing end of beams.

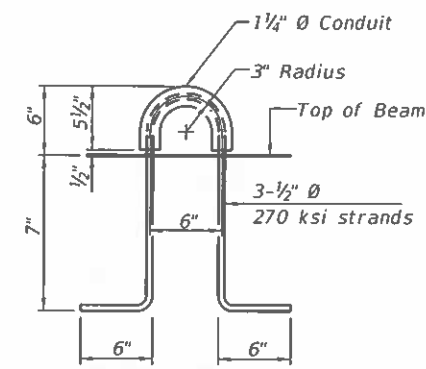

LIFTING LOOP DETAIL

(An alternate lifting loop with a proof load of 25,000 lbs. and utilized according to the manufacturer's recommendations may be used)

Notes:
The precast bridge approach slab shall be according to Section 504 of the Standard Specifications and shall be paid for at the contract unit price per square foot for Precast Bridge Approach Slab.
Cast-in-place substitution of Precast Bridge Approach Slab is not allowed.
The top surface of precast bridge approach slabs shall be finished similar to precast prestressed deck beams with concrete wearing surface as specified in the IDOT "Manual for Fabrication of Precast Prestressed Concrete Products."
Two 1/8" fabric adjusting shims of the dimensions of the exterior bearing pad shall be provided for each bearing pad location. Cost included with Precast Bridge Approach Slab.
A minimum 2 1/2" Ø lifting pins shall be used to engage the lifting loops during handling.
Compressive strength of precast concrete, f'c shall be 6,000 psi.
Compressive strength of precast concrete during initial lifting, f'ci shall be 5,000 psi.

BAR LIST
SOUTH RIGHT EXTERIOR BEAM
(For information only)

Bar	No.	Size	Length	Shape
B(E)	4	#5	29'-8"	—
B1(E)	10	#9	29'-8"	—
B32(E)	1	#9	32'-4"	—
B33(E)	1	#9	25'-3"	—
B34(E)	1	#9	21'-10"	—
B35(E)	1	#9	17'-7"	—
B36(E)	1	#9	11'-7"	—
B37(E)	1	#5	32'-4"	—
B38(E)	1	#5	27'-9"	—
B39(E)	1	#5	17'-6"	—
D202(E)	1	#4	8'-7"	□
D203(E)	1	#4	8'-8"	□
D204(E)	1	#4	8'-10"	□
D205(E)	1	#4	9'-0"	□
D206(E)	1	#4	9'-2"	□
D207(E)	1	#4	9'-4"	□
D208(E)	1	#4	9'-6"	□
D209(E)	1	#4	9'-8"	□
D210(E)	1	#4	9'-10"	□
D211(E)	1	#4	10'-0"	□
D212(E)	1	#4	10'-2"	□
D213(E)	1	#4	10'-4"	□
D214(E)	1	#4	10'-6"	□
D215(E)	1	#4	10'-8"	□
D216(E)	1	#4	10'-10"	□
D217(E)	1	#4	11'-0"	□
D218(E)	1	#4	11'-2"	□
D219(E)	1	#4	11'-4"	□
D220(E)	1	#4	11'-6"	□
D221(E)	1	#4	11'-8"	□
D222(E)	1	#4	11'-10"	□
D223(E)	1	#4	11'-11"	□
D224(E)	1	#4	8'-9"	□
D225(E)	1	#4	8'-11"	□
D226(E)	1	#4	9'-1"	□
D227(E)	1	#4	9'-3"	□
D228(E)	1	#4	9'-5"	□
D229(E)	1	#4	9'-7"	□
D230(E)	1	#4	9'-9"	□
D231(E)	1	#4	9'-11"	□
D232(E)	1	#4	10'-1"	□
D233(E)	1	#4	10'-3"	□

BAR LIST
SOUTH RIGHT EXTERIOR BEAM
(For information only)

Bar	No.	Size	Length	Shape
S160(E)	14	#5	14'-0"	□
S161(E)	19	#5	20'-8"	□
S162(E)	1	#5	10'-2"	□
S163(E)	1	#5	10'-3"	□
S164(E)	1	#5	10'-4"	□
S165(E)	1	#5	10'-4"	□
S166(E)	1	#5	10'-5"	□
S167(E)	1	#5	10'-6"	□
S168(E)	1	#5	10'-6"	□
S169(E)	1	#5	10'-7"	□
S170(E)	1	#5	10'-8"	□
S171(E)	1	#5	10'-9"	□
S172(E)	1	#5	10'-9"	□
S173(E)	1	#5	10'-10"	□
S174(E)	1	#5	10'-11"	□
S175(E)	1	#5	11'-0"	□
S176(E)	1	#5	11'-0"	□
S177(E)	1	#5	11'-1"	□
S178(E)	1	#5	11'-2"	□
S179(E)	1	#5	11'-3"	□
S180(E)	1	#5	11'-3"	□
S181(E)	1	#5	11'-4"	□
S182(E)	1	#5	11'-5"	□
S183(E)	1	#5	11'-5"	□
S184(E)	1	#5	11'-6"	□
S185(E)	1	#5	11'-7"	□
S186(E)	1	#5	11'-8"	□
S187(E)	1	#5	11'-8"	□
S188(E)	1	#5	11'-9"	□
S189(E)	1	#5	11'-10"	□
S190(E)	1	#5	11'-11"	□
S191(E)	1	#5	11'-11"	□
S192(E)	1	#5	12'-0"	□
S193(E)	1	#5	12'-1"	□
S194(E)	1	#5	12'-2"	□
S195(E)	1	#5	12'-2"	□
S196(E)	1	#5	12'-3"	□
S197(E)	1	#5	12'-4"	□
S198(E)	1	#5	12'-4"	□
S199(E)	1	#5	12'-5"	□
S200(E)	1	#5	12'-6"	□
S201(E)	1	#5	12'-7"	□
S202(E)	1	#5	12'-7"	□
S203(E)	1	#5	12'-8"	□
S204(E)	1	#5	12'-9"	□
S205(E)	1	#5	12'-10"	□
S206(E)	1	#5	12'-10"	□
S207(E)	1	#5	12'-11"	□

(Sheet 7 of 9)




USER NAME *	DESIGNED - JKC	REVISED -
PLOT SCALE *	CHECKED - AJO	REVISED -
PLOT DATE *	DRAWN - LAG	REVISED -
	CHECKED - JKC	REVISED -

STATE OF ILLINOIS
DEPARTMENT OF TRANSPORTATION


SOUTH PRECAST BRIDGE APPROACH SLAB
STRUCTURE NO. 046-0153

SHEET 32 OF 54 SHEETS


F.A.I. RTE.	SECTION	COUNTY	TOTAL SHEETS	SHEET NO.
57	139HBR-6	KANKAKEE	202	121
CONTRACT NO. 66997				
ILLINOIS FED. AID PROJECT				

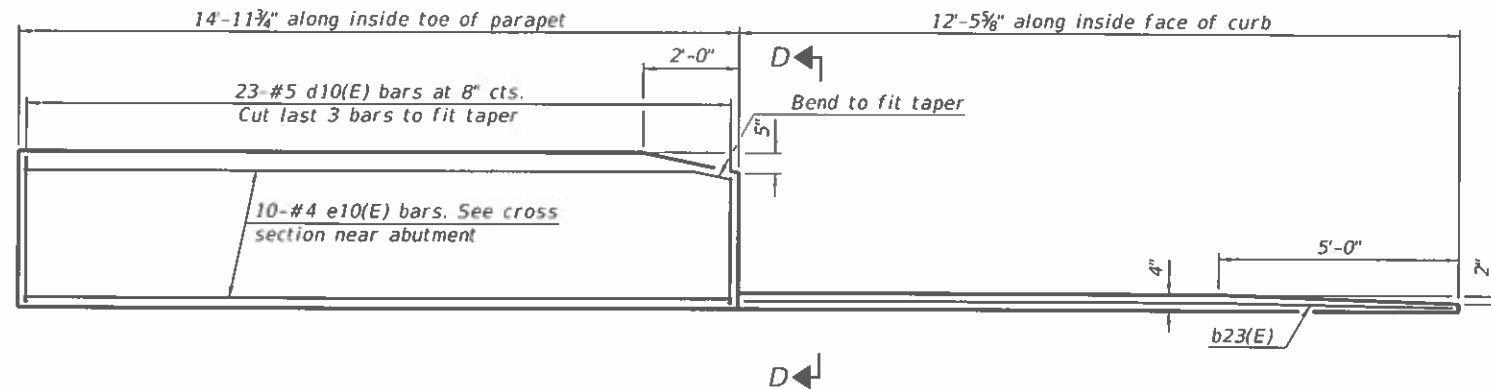

INSIDE ELEVATION OF EAST (LEFT) PARAPET AND CURB

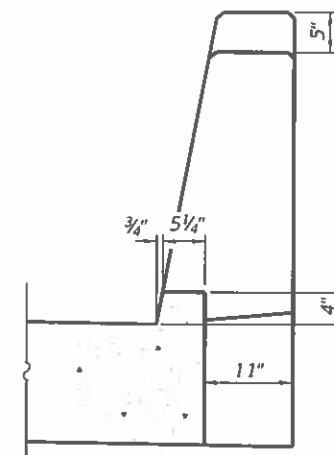

VIEW D-D

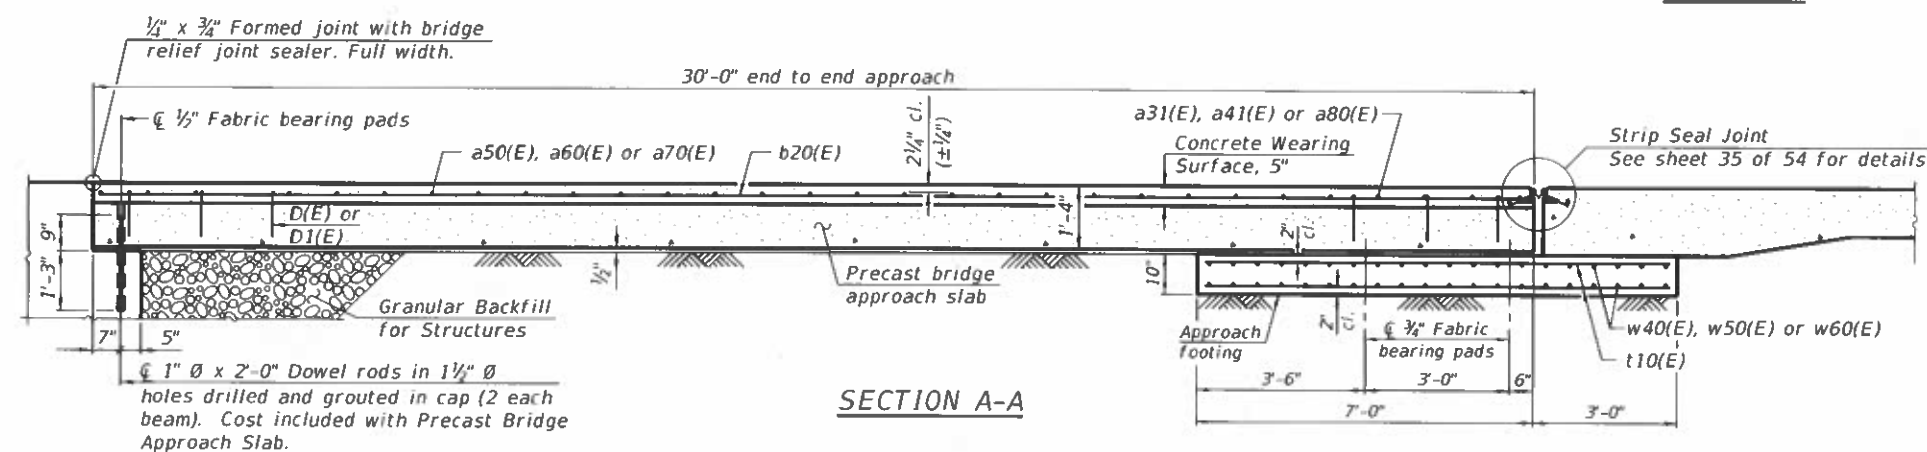

SECTION A-A

Notes:

The joint opening shall be adjusted for temperature per Article 520.04 of the Standard Specifications. However, since this detail is for jointless structures, the length of bridge used to calculate the adjustment shall be equal to half the total bridge length plus the length of the bridge approach slab.

After precast bridge approach slabs have been erected, holes shall be drilled into abutment and anchor dowels placed. Dowel holes shall be filled with non-shrink grout to top of precast slab and cured according to Article 1020.13(a)(3) or 1020.13(a)(5) of the Standard Specifications for a minimum of 24 hours before casting the shear keys and wearing surface.

Any concrete poured monolithically with the wearing surface, such as curbs, shall not be paid for separately, but will be included in the cost of Concrete Wearing Surface, 5". The strip seal shall extend 6" beyond the edge of the approach slab on each end. Parapet concrete shall be paid for as Concrete Superstructure.


Approach footing concrete shall be paid for as Concrete Structures. The approach footing maximum applied service bearing pressure (Q_{max}) = 2.0 ksf. Cost of excavation for approach footing included with Concrete Structures.

For Granular Backfill for Structures and drainage treatment details, see sheet 2 of Cost of cellular polystyrene is included with Concrete Superstructure.


BILL OF MATERIAL

Bar	No.	Size	Length	Shape
a12(E)	28	#5	8'-2"	
a31(E)	16	#4	25'-0"	
a41(E)	8	#4	17'-9"	
a50(E)	20	#5	25'-0"	
a60(E)	10	#5	18'-10"	
a70(E)	10	#5	15'-5"	
a80(E)	8	#5	15'-11"	
b20(E)	44	#4	29'-5"	
b23(E)	1	#4	11'-10"	
b30(E)	1	#4	26'-11"	
b32(E)	4	#5	15'-11"	
b40(E)	1	#4	32'-2"	
b42(E)	4	#5	31'-10"	
d9(E)	49	#5	5'-3"	
d10(E)	72	#5	6'-5"	
d11(E)	23	#5	6'-5"	
d20(E)	49	#5	5'-0"	
d21(E)	49	#5	4'-9"	
e10(E)	22	#4	14'-9"	
e16(E)	4	#4	29'-9"	
e17(E)	12	#4	16'-0"	
e18(E)	4	#4	32'-0"	
e19(E)	10	#4	7'-4"	
t10(E)	92	#4	16'-6"	
t20(E)	2	#4	15'-1"	
t30(E)	2	#4	18'-0"	
w40(E)	80	#5	30'-0"	
w50(E)	40	#5	15'-3"	
w60(E)	40	#5	11'-7"	
Concrete Superstructure			Cu. Yd.	96
Concrete Structures			Cu. Yd.	24.3
Reinforcement Bars, Epoxy Coated			Pound	9370
Precast Bridge Approach Slab			Sq. Ft.	1311
Concrete Wearing Surface, 5"			Sq. Yd.	151


BAR a60(E), a70(E) or a80(E)

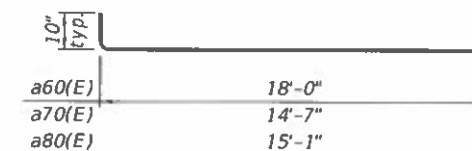


BAR a41(E)

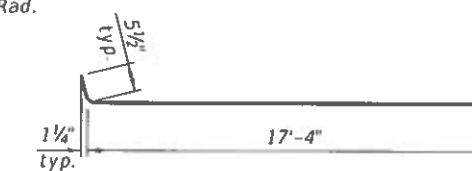


BAR a12(E)

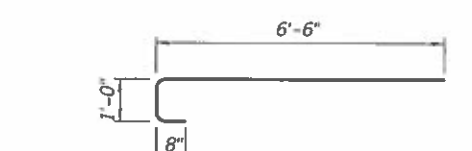


(Sheet 8 of 9)

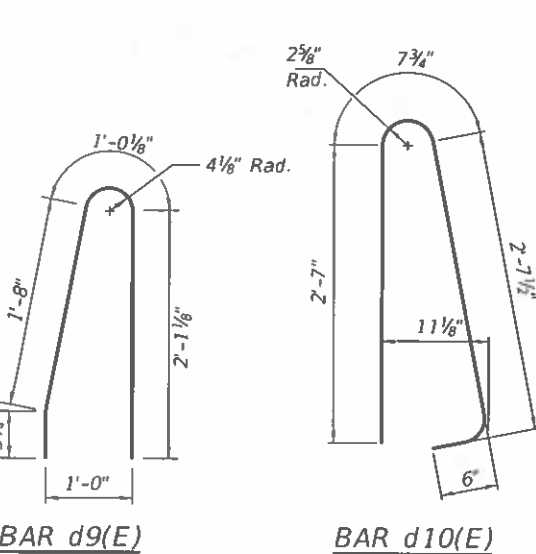


BAR d10(E)

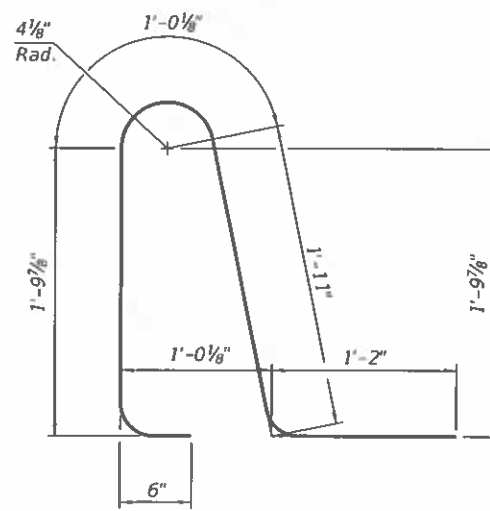

BAR d11(E)

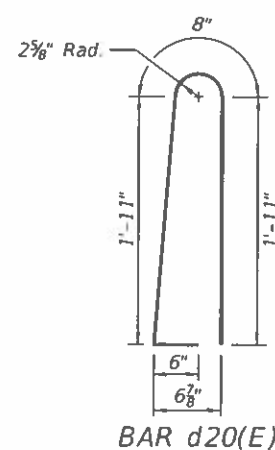

BAR d20(E)

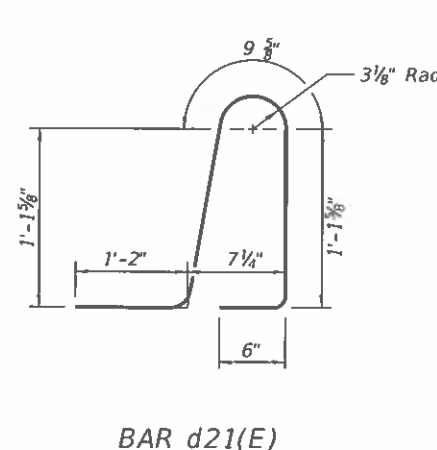

BAR d21(E)



USER NAME *	DESIGNED - JKC	REVISIONS
PLOT SCALE *	CHECKED - AJO	REVISIONS
PLOT DATE *	DRAWN - LAG	REVISIONS
	CHECKED - JKC	REVISIONS


STATE OF ILLINOIS
DEPARTMENT OF TRANSPORTATION

SOUTH PRECAST BRIDGE APPROACH SLAB
STRUCTURE NO. 046-0153


SHEET 33 OF 54 SHEETS

F.A.I. RTE.	SECTION	COUNTY	TOTAL SHEETS	SHEET NO.
57	139HBR-6	KANKAKEE	202	122
CONTRACT NO. 68897				

ILLINOIS FED. AID PROJECT

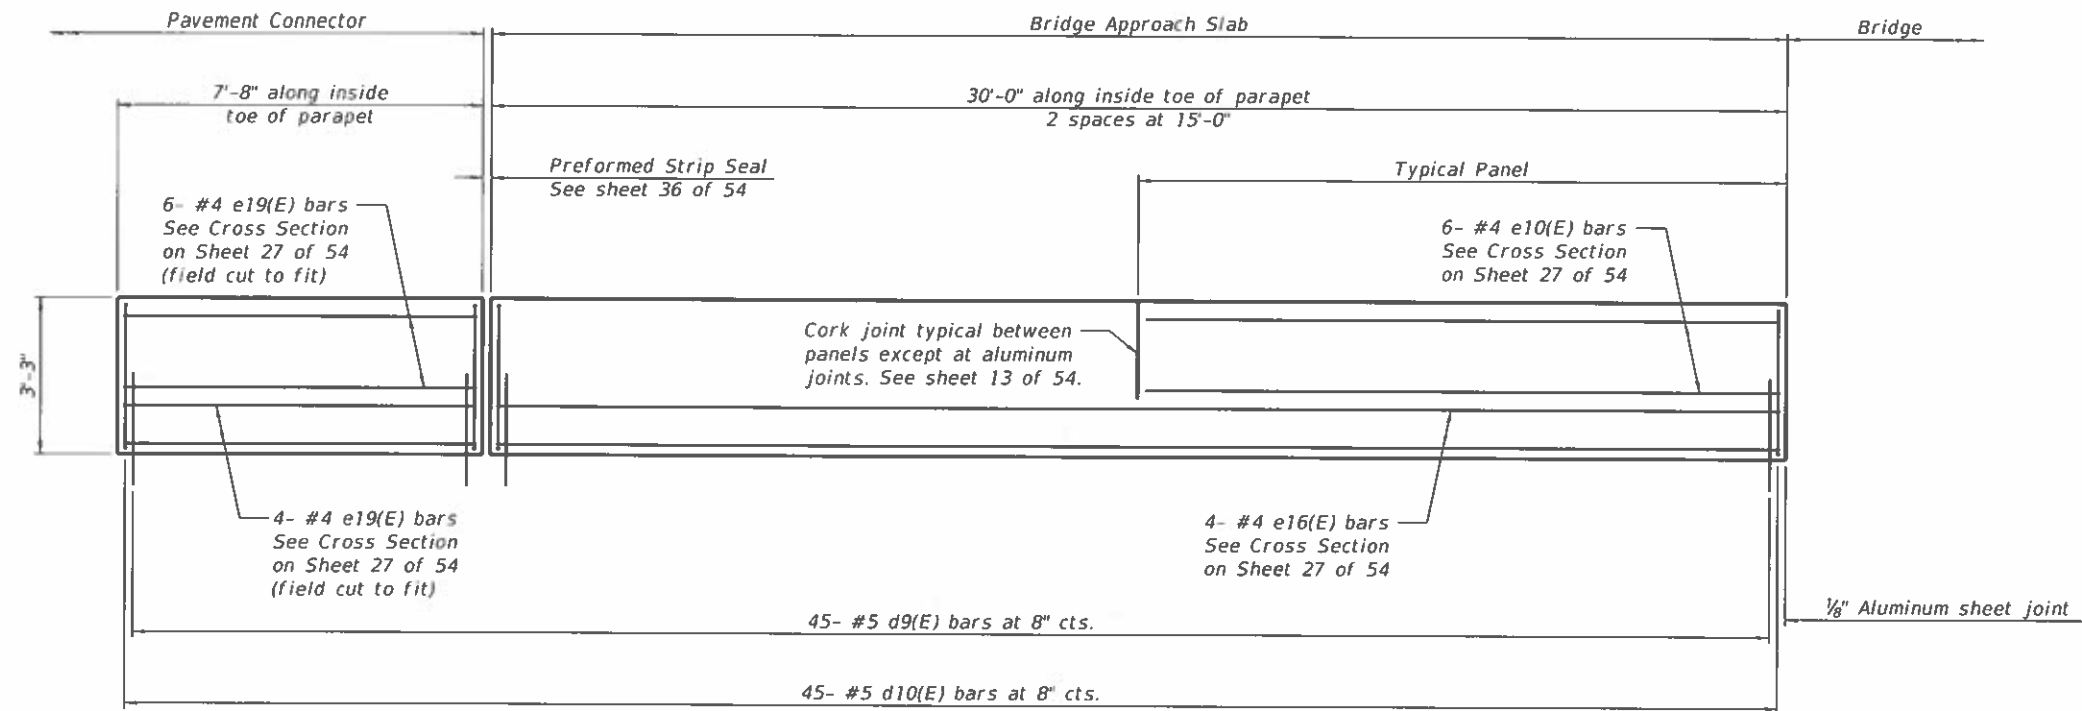

INSIDE ELEVATION OF WEST (RIGHT) PARAPET

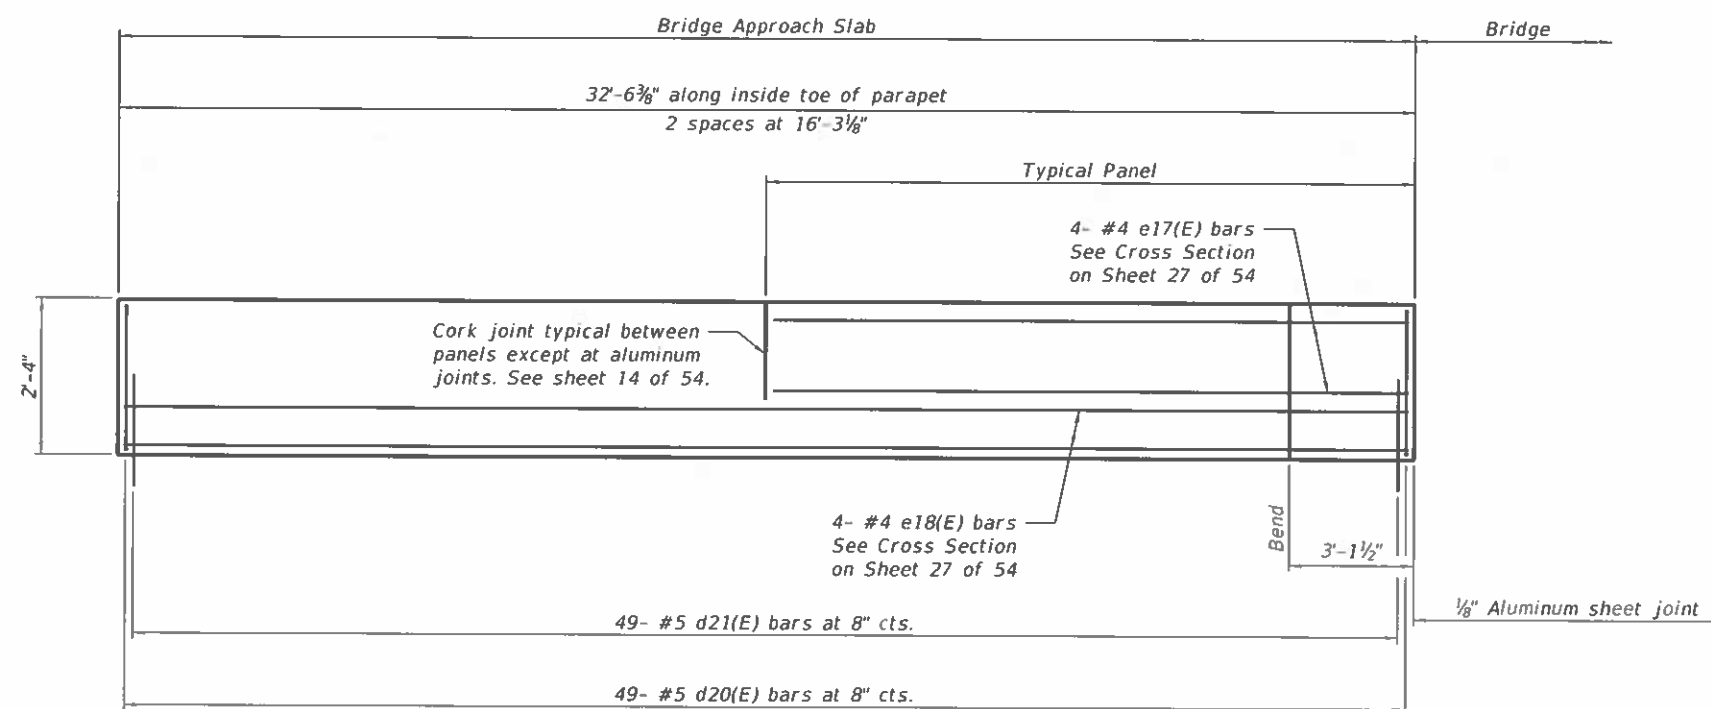

INSIDE ELEVATION OF SIDEWALK PARAPET

(Sheet 9 of 9)



USER NAME	DESIGNED - JKC	REVISED -
PLOT SCALE	CHECKED - AJO	REVISED -
PLOT DATE	DRAWN - LAG	REVISED -
	CHECKED - JKC	REVISED -

STATE OF ILLINOIS
DEPARTMENT OF TRANSPORTATION


SOUTH PRECAST BRIDGE APPROACH SLAB
STRUCTURE NO. 046-0153

SHEET 34 OF 54 SHEETS

F.A.I. RTE.	SECTION	COUNTY	TOTAL SHEETS	SHEET NO.
57	139HBR-6	KANKAKEE	202	123
CONTRACT NO. 66997				

ILLINOIS FED. AID PROJECT

MODEL: TEMP CONC BARRIER
FILE NAME: G:\Users\111111111\Documents\Survey\0366997\Consultant Data\Chamlin_2020\CAD_Sheets\0460153-66997-035-036-STRIP SEAL JOINT.dgn
3/2/2021 3:09:33 PM

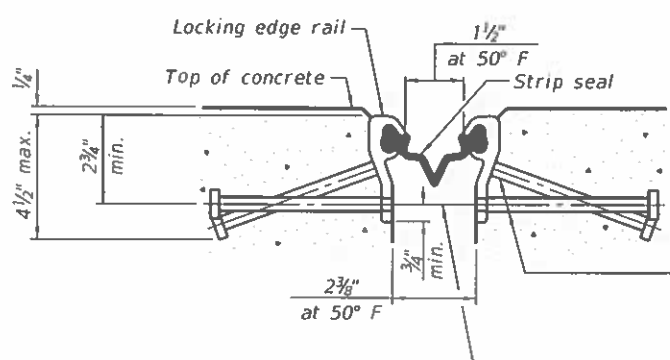


SHOWING ROLLED RAIL JOINT


+ 5/8" Ø x 6" studs @ 6" cts. (alternate angled/bent studs with horizontal studs)
3/8" Ø threaded rods in 1/8" Ø holes at ±4'-0" cts. for holding the proper joint opening based on the temperature during the deck pour. Place to miss studs. All rods shall be burned, or sawed off flush with the plates after concrete is set.

SECTION A-A

* Granular or solid flux filled headed studs conforming to Article 1006.32 of the Std. Specs., automatically end welded.

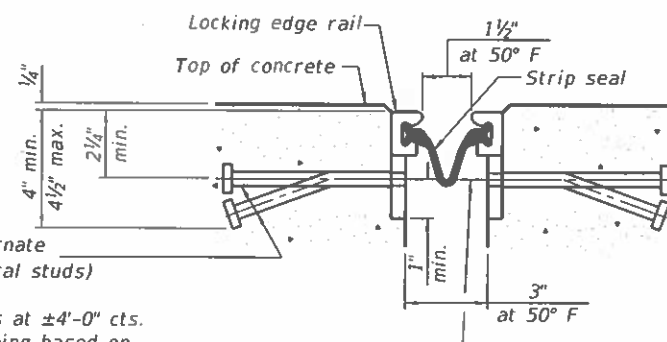


SHOWING WELDED RAIL JOINT

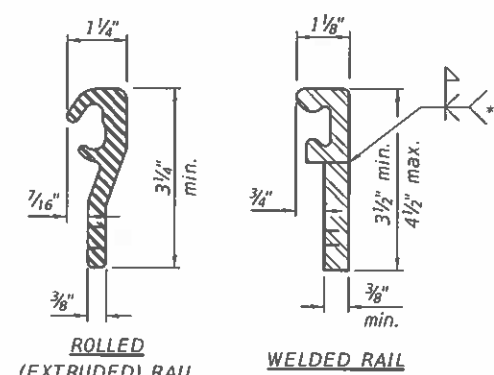

LOCKING EDGE RAILS

** Back gouge not required if complete joint penetration is verified by mock-up.

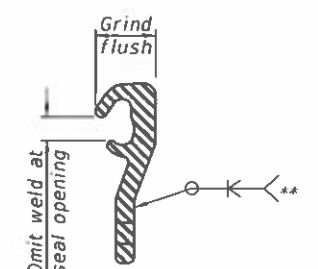

LOCKING EDGE RAIL SPLICE

The inside of the locking edge rail groove shall be free of weld residue. Rolled rail shown, welded rail similar.

BILL OF MATERIAL

Item	Unit	Total
Preformed Joint Strip Seal	Foot	158

(Sheet 1 of 2)




USER NAME	DESIGNED	JKC	REVISED	-
PLOT SCALE	CHECKED	AJO	REVISED	-
PLOT DATE	DRAWN	LAG	REVISED	-
	CHECKED	JKC	REVISED	-

STATE OF ILLINOIS
DEPARTMENT OF TRANSPORTATION

PREFORMED JOINT STRIP SEAL - SIDEWALK
STRUCTURE NO. 046-0153

SHEET 35 OF 54 SHEETS

F.A.I. RTE.	SECTION	COUNTY	TOTAL SHEETS	SHEET NO.
57	139HBR-6	KANKAKEE	202	124
CONTRACT NO. 66997				
ILLINOIS FED. AID PROJECT				


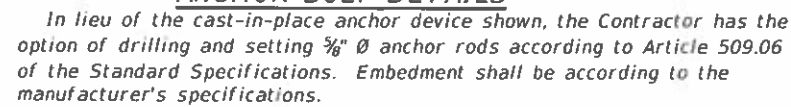


**STATE OF ILLINOIS
DEPARTMENT OF TRANSPORTATION**


SHEET 38 OF 54 SHEETS

F.A.I RTE	SECTION	COUNTY	TOTAL SHEETS	SHEET NO.
57	139HBR-6	KANKAKEE	202	127
CONTRACT NO. 66997				
BLINDS, FPD AND PROJECT				

MODEL: FRAMING PLAN
FILE NAME: G:\Users\11111335-01\Waldron-Road-over-157-Superstructure\Survey D366997\Consultant Data\Chamlin 2020\CAD Sheets\0460153-66997-039-040-FRAMING.dgn
3/3/2021 9:16:03 AM

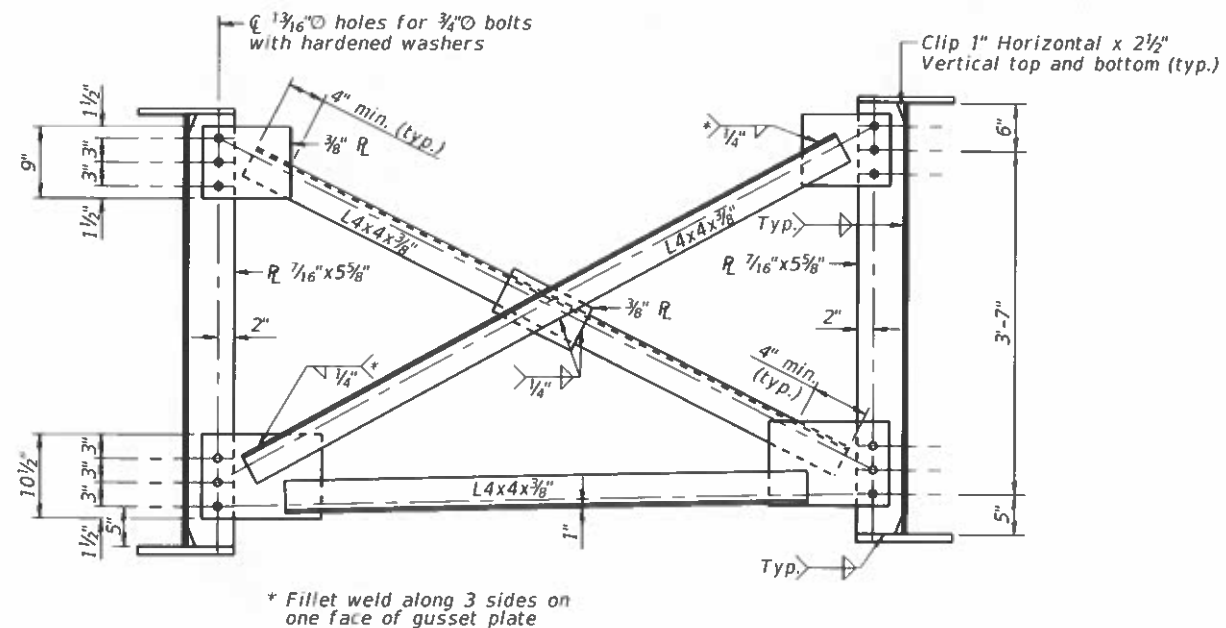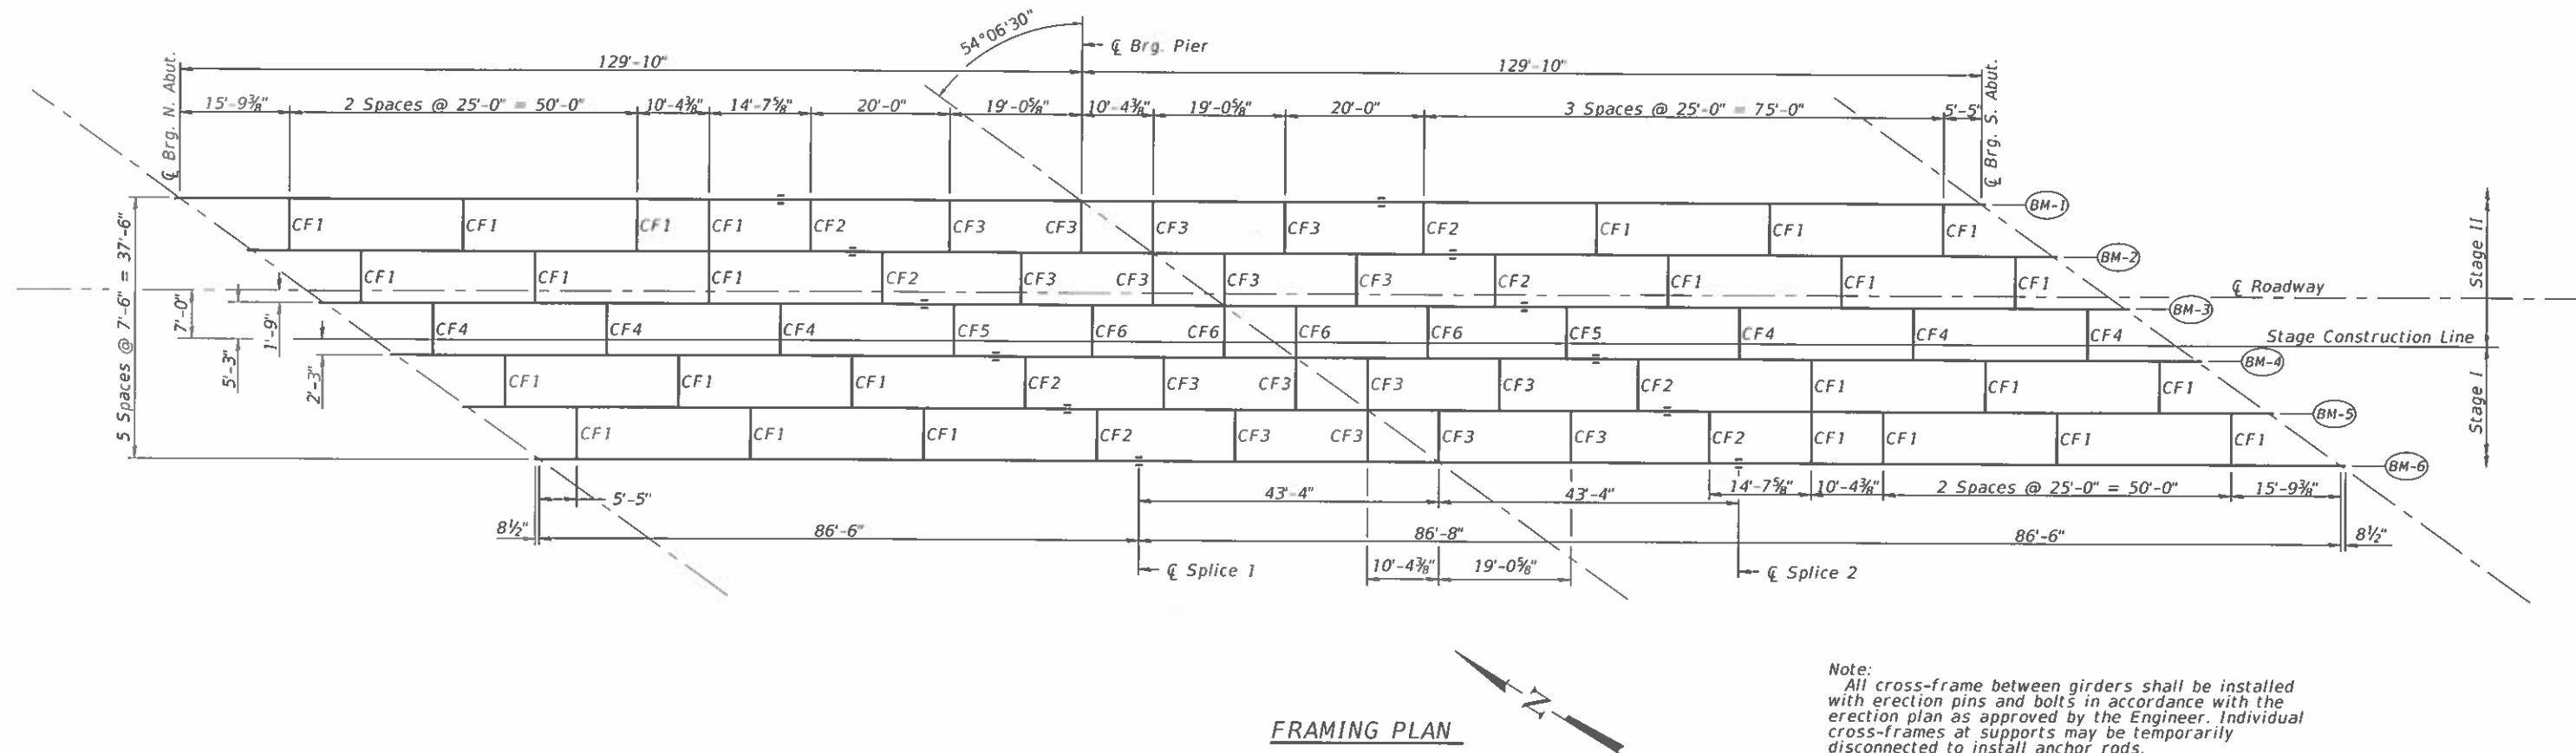

CROSS FRAME CF1
(26 REQUIRED)

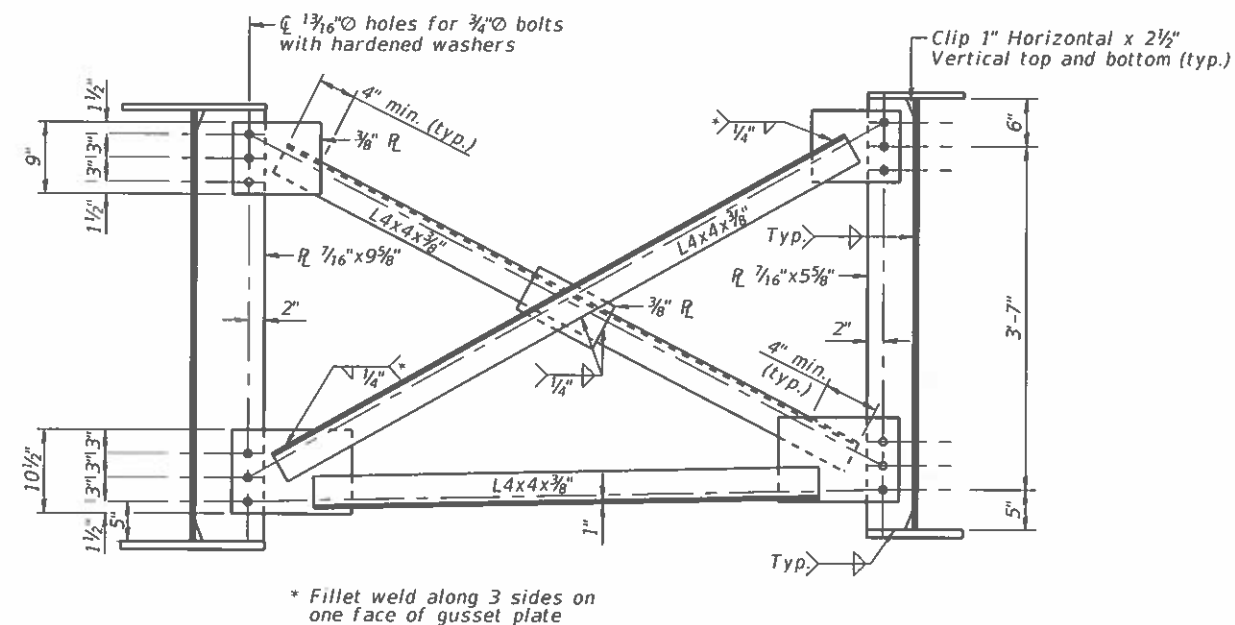

CROSS FRAME CF2
(8 REQUIRED)




USER NAME	CHAMLIN	DESIGNED	JKC	REVISED	
PLOT SCALE		CHECKED	AJO	REVISED	
PLOT DATE		DRAWN	ARR	REVISED	
		CHECKED	JKC	REVISED	

STATE OF ILLINOIS
DEPARTMENT OF TRANSPORTATION


FRAMING PLAN AND DETAILS
STRUCTURE NO. 046-0153

SHEET 39 OF 54 SHEETS


F.A.I. RTE.	SECTION	COUNTY	TOTAL SHEETS	SHEET NO.
57	139HBR-6	KANKAKEE	202	128
CONTRACT NO. 66997				
ILLINOIS FED. AID PROJECT				

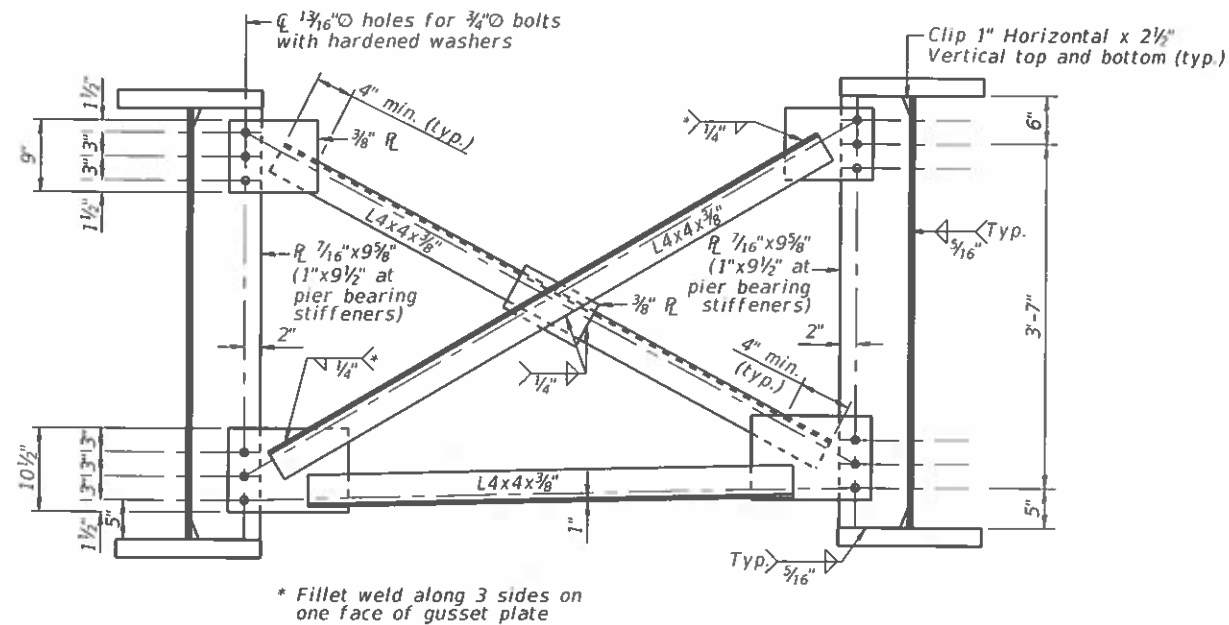


CROSS FRAME CF3
(16 REQUIRED)

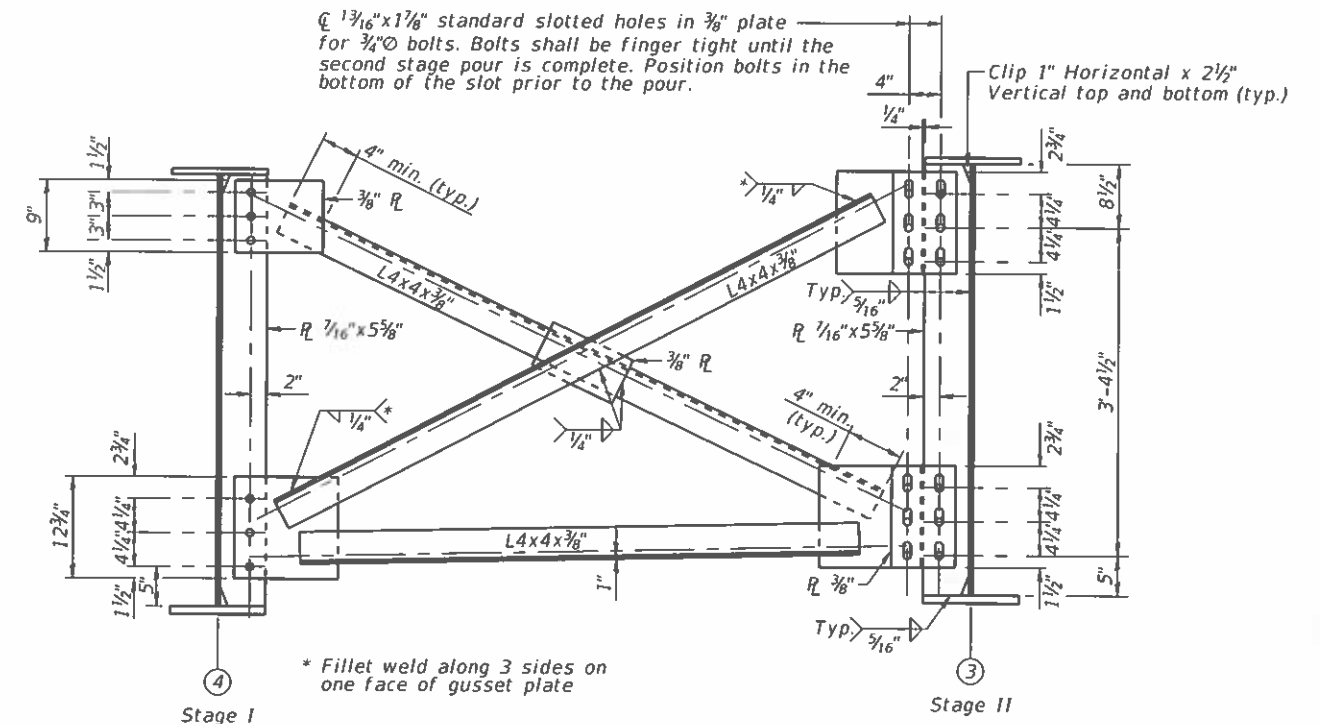

CROSS FRAME CF4
(6 REQUIRED)

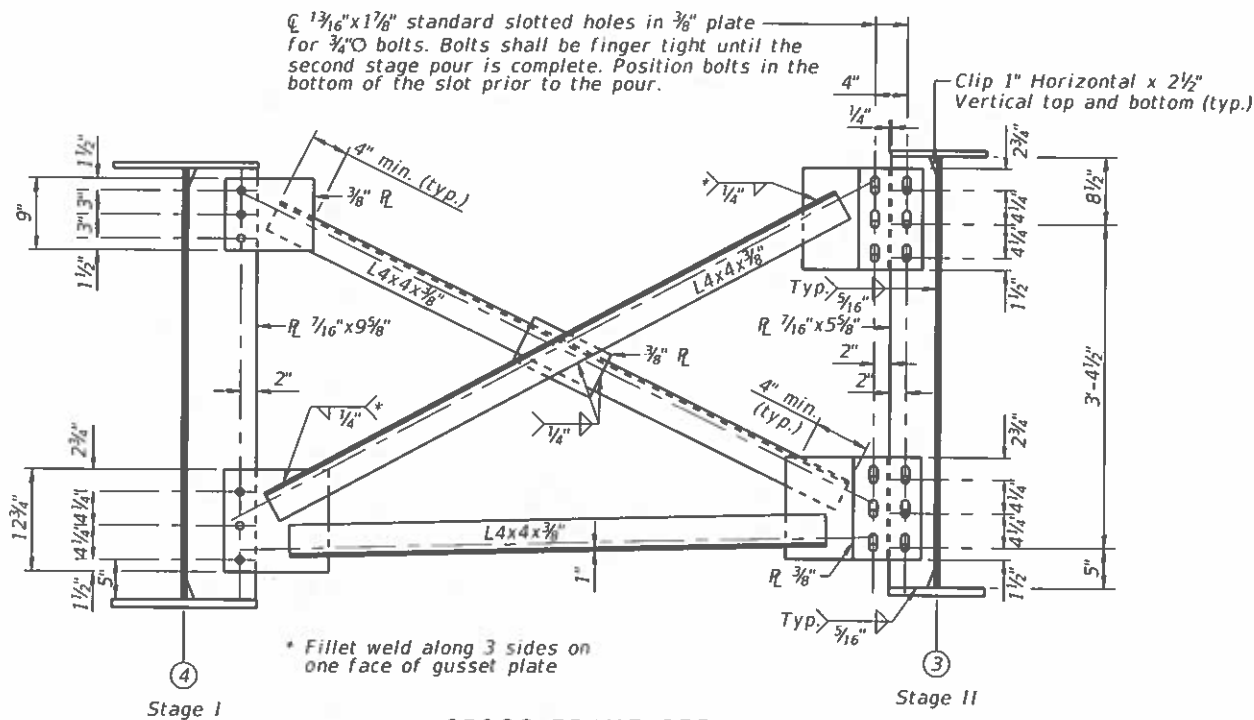

CROSS FRAME CF5
(2 REQUIRED)

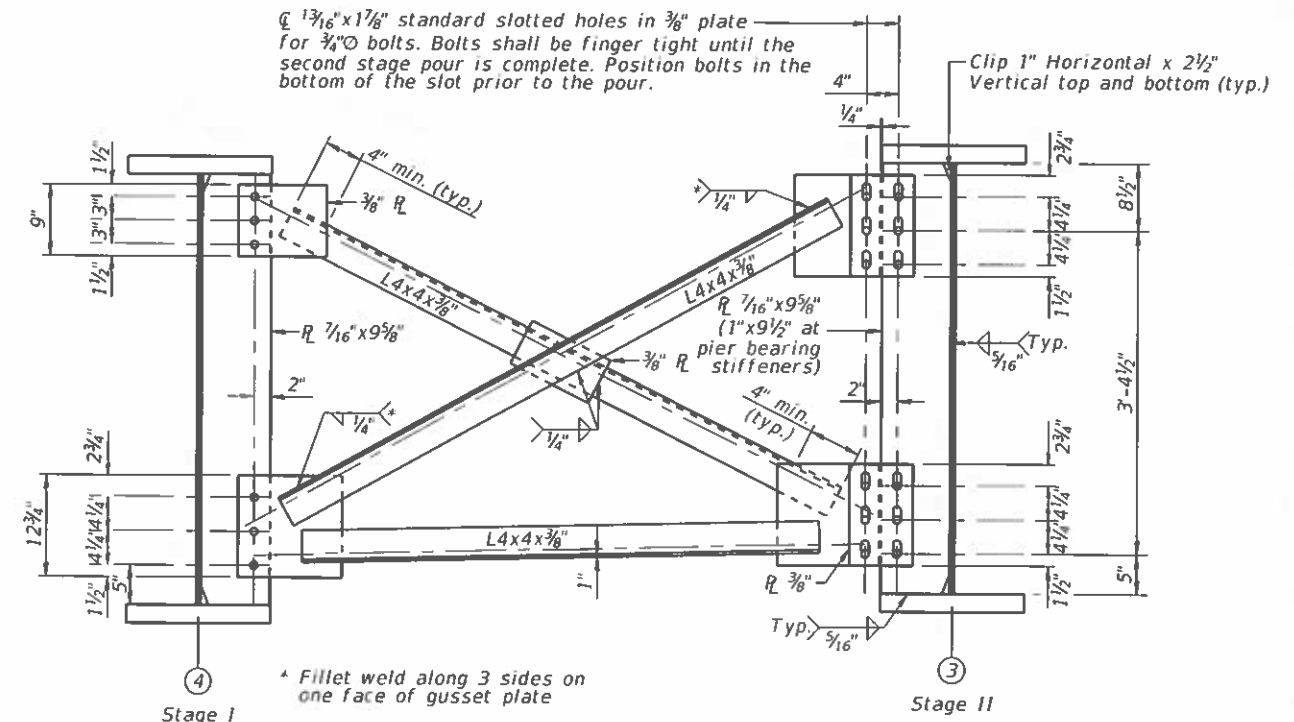

CROSS FRAME CF6
(4 REQUIRED)



STATE OF ILLINOIS
DEPARTMENT OF TRANSPORTATION

FRAMING PLAN AND DETAILS
STRUCTURE NO. 046-0153


SHEET 40 OF 54 SHEETS

F.A.L. RTE.	SECTION	COUNTY	TOTAL SHEETS	SHEET NO.
57	139HBR-6	KANKAKEE	202	129
CONTRACT NO. 66997				
ILLINOIS FED. AID PROJECT				



TOP OF WEB ELEVATIONS (FOR FABRICATION ONLY)						
LOCATION / BEAM	BM-1	BM-2	BM-3	BM-4	BM-5	BM-6
Centerline Brg. n. Abut.	658.12	658.32	658.43	658.29	658.14	657.98
Centerline Splice #1	658.12	658.20	658.19	657.93	657.67	657.38
Centerline Brg. Pier	657.59	657.61	657.54	657.22	656.90	656.56
Centerline Splice #2	657.06	657.02	656.89	656.52	656.13	655.73
Centerline Brg. S. Abut.	654.94	654.78	654.53	654.04	653.54	653.02

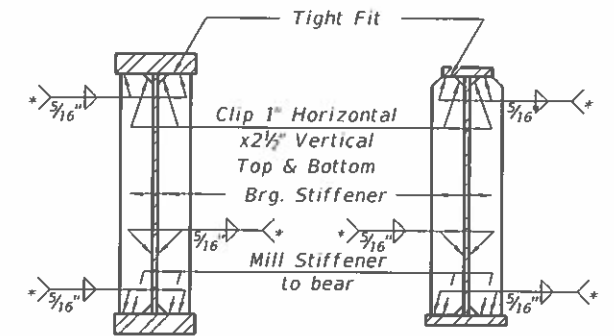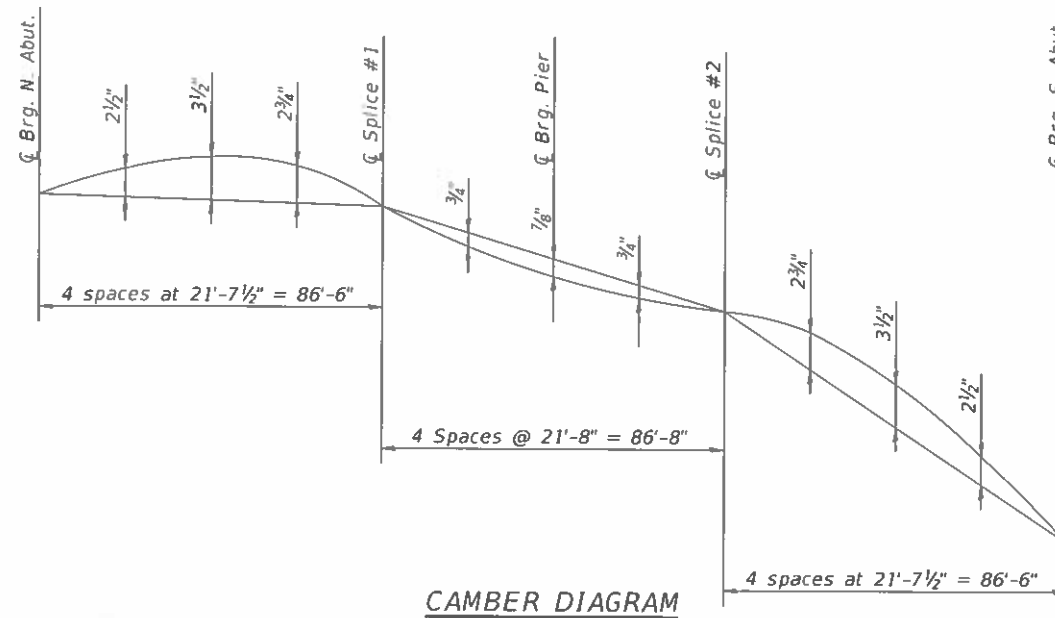

SECTION AT PIER SECTION AT ABUTMENT
* Terminate 1/4" (±1/8") from the end of plate intersects.

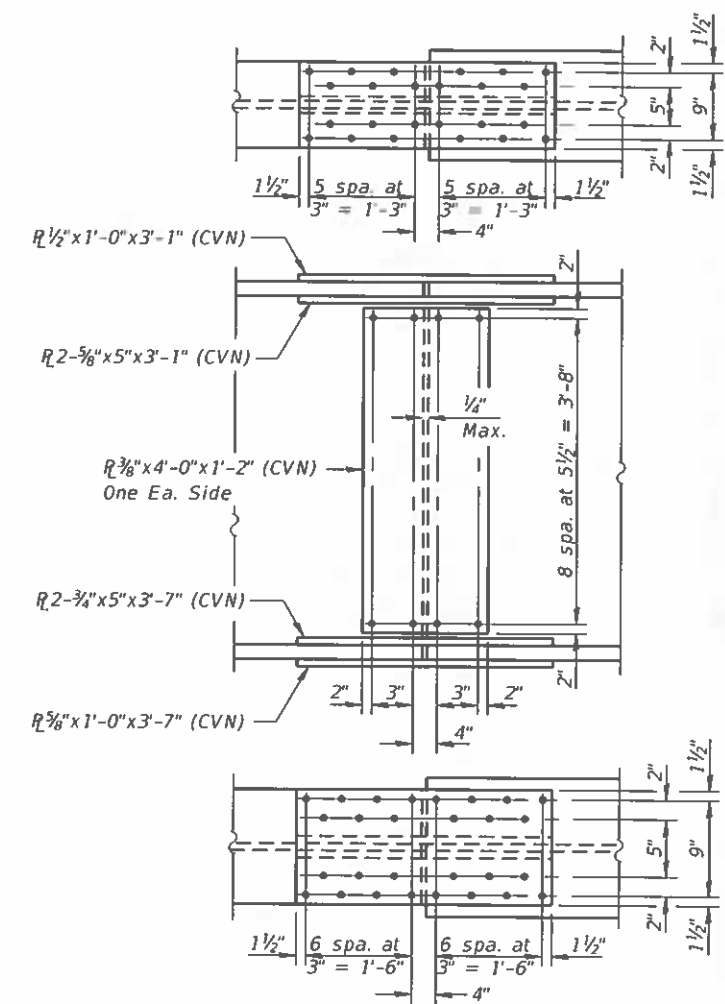

Note:
All flange plates, web plates, splice plates, and bearing stiffeners shall be AASHTO M270 Gr 50 Steel.

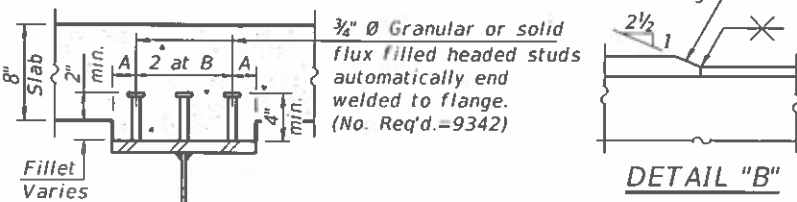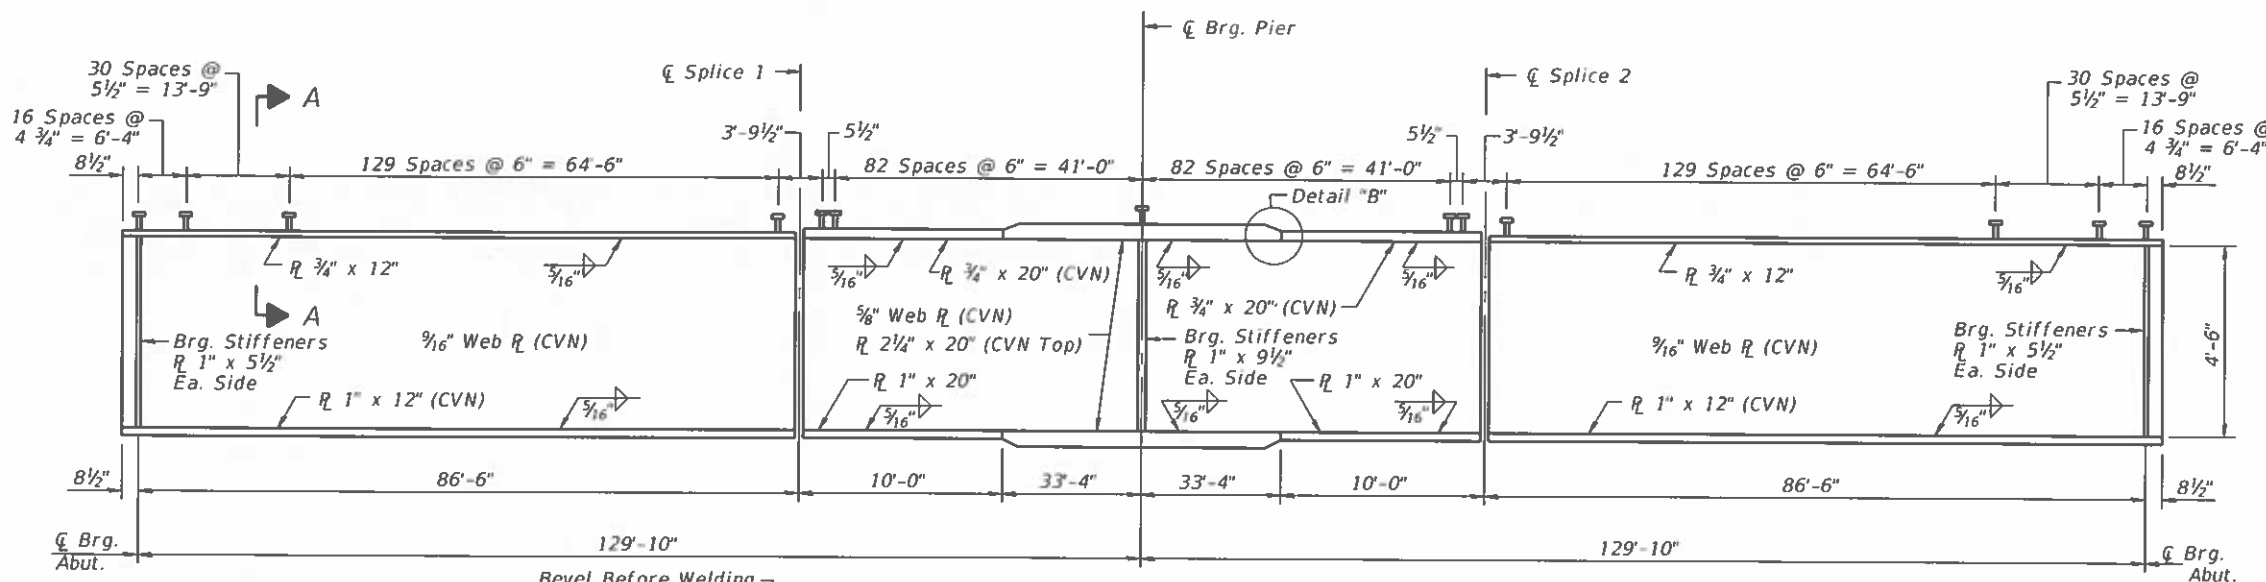

SECTION A-A

A = 2" at 12" flange or 4" at 20" flange
B = 4" at 12" flange or 6" at 20" flange

GIRDER ELEVATION
"CVN" denotes Charpy-V-Notch impact energy requirements, zone 2.



USER NAME	DESIGNED - JKC	REVISED -
PLOT SCALE	CHECKED - AJO	REVISED -
PLOT DATE	DRAWN - LAG	REVISED -
	CHECKED - JKC	REVISED -

STATE OF ILLINOIS
DEPARTMENT OF TRANSPORTATION

GIRDER AND FRAMING DETAILS
STRUCTURE NO. 046-0153

SHEET 41 OF 54 SHEETS

F.A.I. RTE.	SECTION	COUNTY	TOTAL SHEETS	SHEET NO.
57	139HBR-6	KANKAKEE	202	130
CONTRACT NO. 66997				

ILLINOIS FED. AID PROJECT

MODEL: TEMP CONC BARRIER
FILE NAME: C:\Users\11111111\Documents\Survey D366997\Consultant_Data\Chamlin_2020\CAD_Sheets\0460153-66997-042 INTERIOR GIRDER TABLES.dgn
3/3/2021 9:17:26 AM

INTERIOR GIRDER MOMENT TABLE			
		0.4 Sp. 1 or 0.6 Sp. 2	Pier
Is	(in ⁴)	23065.9	79430.6
Ic(n)	(in ⁴)	63658.0	--
Ic(3n)	(in ⁴)	47141.9	--
Ic(cr)	(in ⁴)	--	87286.2
Ss	(in ³)	874.6	2715.6
Sc(n)	(in ³)	1296.9	--
Sc(3n)	(in ³)	1180.7	--
Sc(cr)	(in ³)	--	2798.5
Sxc	(in ³)	1180.7	--
DC1	(k/')	1.008	1.008
MDC1	(k)	849.4	2974.4
DC2	(k/')	0.233	0.233
MDC2	(k)	222.6	623.3
DW	(k/')	0.340	0.340
MDW	(k)	326.0	912.7
LLDF	(k)	0.553	0.599
M _t + IM	(k)	1683.3	2519.5
ft (Strength I)	(k)	10.0	10.0
Mu + 1/3 ft Sxc	(k)	5102.7	--
Øf Mn	(k)	6259.0	--
fs DC1	(ksi)	11.65	13.14
fs DC2	(ksi)	2.26	2.67
fs DW	(ksi)	3.31	3.91
fs (t+IM)	(ksi)	15.58	10.80
ft (Service II)	(ksi)	10.00	10.00
fs + 1/2 (Service II)	(ksi)	42.48	38.77
0.95Rh Fyf	(ksi)	47.50	47.50
fs + 1/3 (Total Strength I)	(ksi)	--	47.88
Øf Fn	(ksi)	--	50.00
Vf	(k)	95.8	--

GIRDER REACTION TABLE				
	Abut.		Pier	
	Interior	Exterior	Interior	Exterior
LLDF	0.779	0.903	0.779	0.695
OCF	--	1.300	--	1.000
RDC1 (k)	42.5	40.1	176.8	166.8
RDC2 (k)	10.3	10.3	39.8	40.0
RDW (k)	15.1	15.1	58.4	58.4
R _t (k)	78.02	90.44	167.95	149.78
R _{IM} (k)	16.74	19.40	30.17	26.91
RTotal (k)	162.66	175.34	473.12	441.89

Is, Ss: Non-composite moment of inertia and section modulus of the steel section used for computing fs(Total-Strength I, and Service II) due to non-composite dead loads (in.⁴ and in.³).

Ic(n), Sc(n): Composite moment of inertia and section modulus of the steel and deck based upon the modular ratio, "n", used for computing fs(Total-Strength I, and Service II) in uncracked sections due to short-term composite live loads (in.⁴ and in.³).

Ic(3n), Sc(3n): Composite moment of inertia and section modulus of the steel and deck based upon 3 times the modular ratio, "3n", used for computing fs(Total-Strength I, and Service II) in uncracked sections, due to long-term composite (superimposed) dead loads (in.⁴ and in.³).

Ic(cr), Sc(cr): Composite moment of inertia and section modulus of the steel and longitudinal deck reinforcement, used for computing fs (Total-Strength I and Service II) in cracked sections, due to both short-term composite live loads and long-term composite (superimposed) dead loads (in.⁴ and in.³).

DC1: Un-factored non-composite dead load (kips/ft.).

MDC1: Un-factored moment due to non-composite dead load (kip-ft.).

DC2: Un-factored long-term composite (superimposed excluding future wearing surface) dead load (kips/ft.).

MDC2: Un-factored moment due to long-term composite (superimposed excluding future wearing surface) dead load (kip-ft.).

DW: Un-factored long-term composite (superimposed future wearing surface only) dead load (kips/ft.).

MDW: Un-factored moment due to long-term composite (superimposed future wearing surface only) dead load (kip-ft.).

M_t + IM: Un-factored live load moment plus dynamic load allowance (impact) (kip-ft.).

Mu (Strength I): Factored design moment (kip-ft.).

1.25 (MDC1 + MDC2) + 1.5 MDW + 1.75 M_t + IM

Øf Mn: Compact composite positive moment capacity computed according to Article 6.10.7.1 or non-slender negative moment capacity according to Article A6.1.1 or A6.1.2 (kip-ft.).

fs DC1: Un-factored stress at edge of flange for controlling steel flange due to vertical non-composite dead loads as calculated below (ksi).

MDC1/ Snc

fs DC2: Un-factored stress at edge of flange for controlling steel flange due to vertical composite dead loads as calculated below (ksi).

MDC2/ Sc(3n) or MDC2/ Sc(cr) as applicable.

fs DW: Un-factored stress at edge of flange for controlling steel flange due to vertical composite future wearing surface loads as calculated below (ksi).

MDW/ Sc(3n) or MDW/ Sc(cr) as applicable.

fs (t+IM): Un-factored stress at edge of flange for controlling steel flange due to vertical composite live load plus impact loads as calculated below (ksi).

M_t + IM / Sc(n) or M_t + IM / Sc(cr) as applicable.

fs + 1/2 (Service II): Sum of stresses as computed below (ksi).

fsDC1 + fsDC2 + fsDW + 1.3 fs(t+IM) + 1/2

0.95RhFyf: Composite stress capacity for Service II loading according to Article 6.10.4.2 (ksi).

fs + 1/3 (Total Strength I): Sum of stresses as computed below on non-compact section (ksi).

1.25 (fsDC1 + fsDC2) + 1.5 fsDW + 1.75 fs(t+IM) + 1/3

Øf Fn: Non-Compact composite positive or negative stress capacity for Strength I loading according to Article 6.10.7 or 6.10.8 (ksi).

Vf: Maximum factored shear range in span computed according to Article 6.10.10.

Note:

M_t and R_t include the effects of centrifugal force and superelevation.

OCF: Obtuse Correction factor

LLDF: Live Load Distribution Factor (Includes OCF)

Sxc: Section modulus about the major axis of section to the controlling flange, tension or compression, taken as yield moment with respect to the controlling flange over the yield strength of the controlling flange (in.³)





USER NAME	DESIGNED - JKC	REVISED -
PLOT SCALE	CHECKED - AJO	REVISED -
PLOT DATE	DRAWN - LAG	REVISED -
	CHECKED - JKC	REVISED -

STATE OF ILLINOIS
DEPARTMENT OF TRANSPORTATION

GIRDER AND FRAMING DETAILS
STRUCTURE NO. 046-0153

SHEET 42 OF 54 SHEETS

F.A.I. RTE.	SECTION	COUNTY	TOTAL SHEETS	SHEET NO.
57	136HBR-6	KANKAKEE	202	131
CONTRACT NO. 66997				
ILLINOIS FED. AID PROJECT				

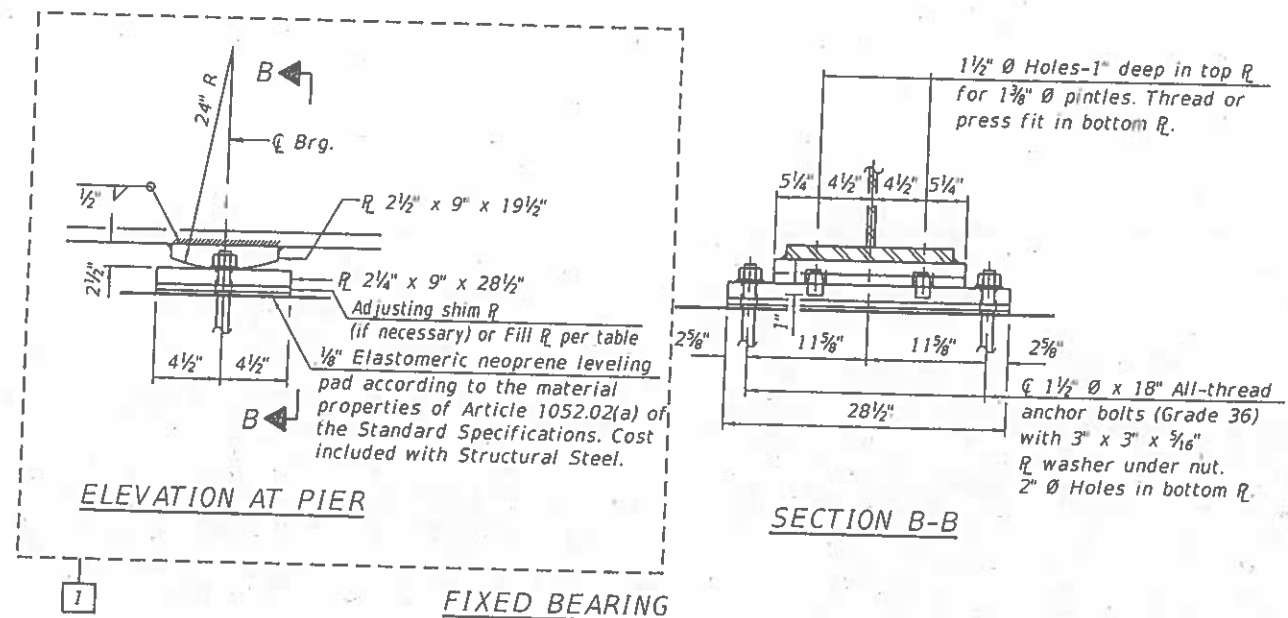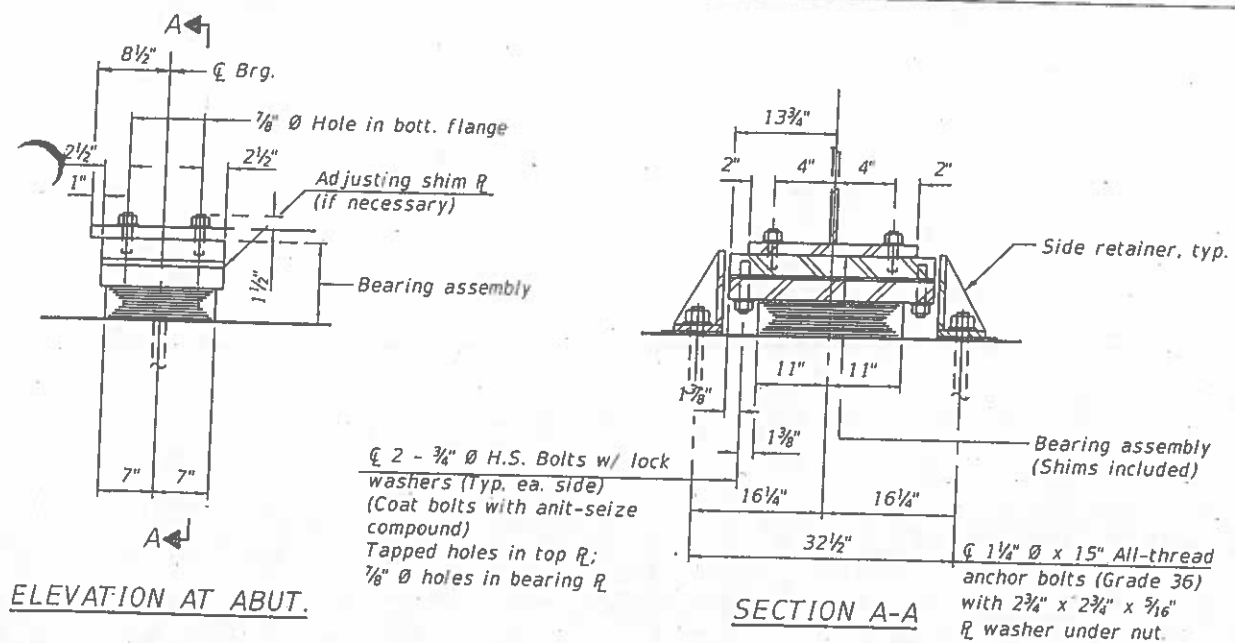



Notes:

Side retainers and stainless steel plates shall be included in the cost of Elastomeric Bearing Assembly, Type I.

Anchor bolts and side retainers at all supports shall be installed as each member is erected unless an equivalent temporary means of lateral restraint is used.

The Structural Steel Plates of the Fixed bearing and Elastomeric Bearing Assembly shall conform to the requirements of AASHTO M270 Grade 50.

Two 1/8 in. adjusting shims shall be provided for each bearing in addition to all other plates or shims and placed as shown on the bearing details.

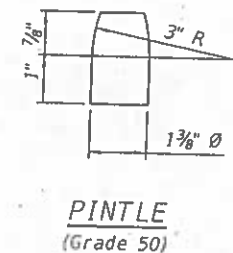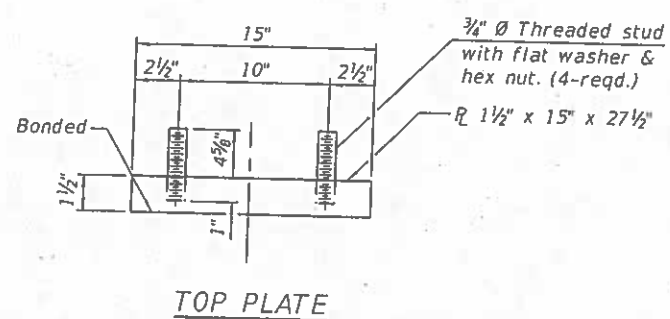



PIER FILL PLATE TABLE

Beam 1	3/8" x 9" x 28 1/2"
Beam 2	3/8" x 9" x 28 1/2"
Beams 3-6	

BILL OF MATERIAL



Item	Unit	Total
Elastomeric Bearing Assembly Type I	Each	12
Anchor Bolts 1 1/4"	Each	24
Anchor Bolts 1 1/2"	Each	12

8/12/2021 9:03:17 AM

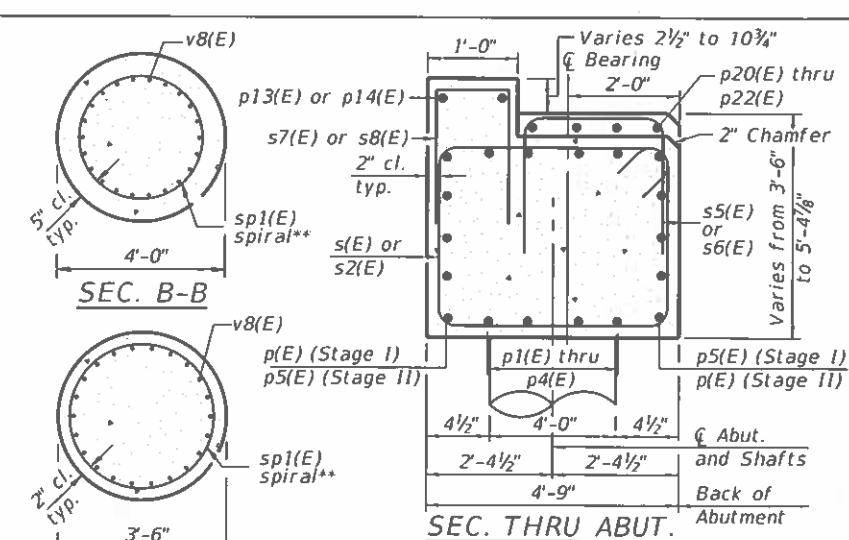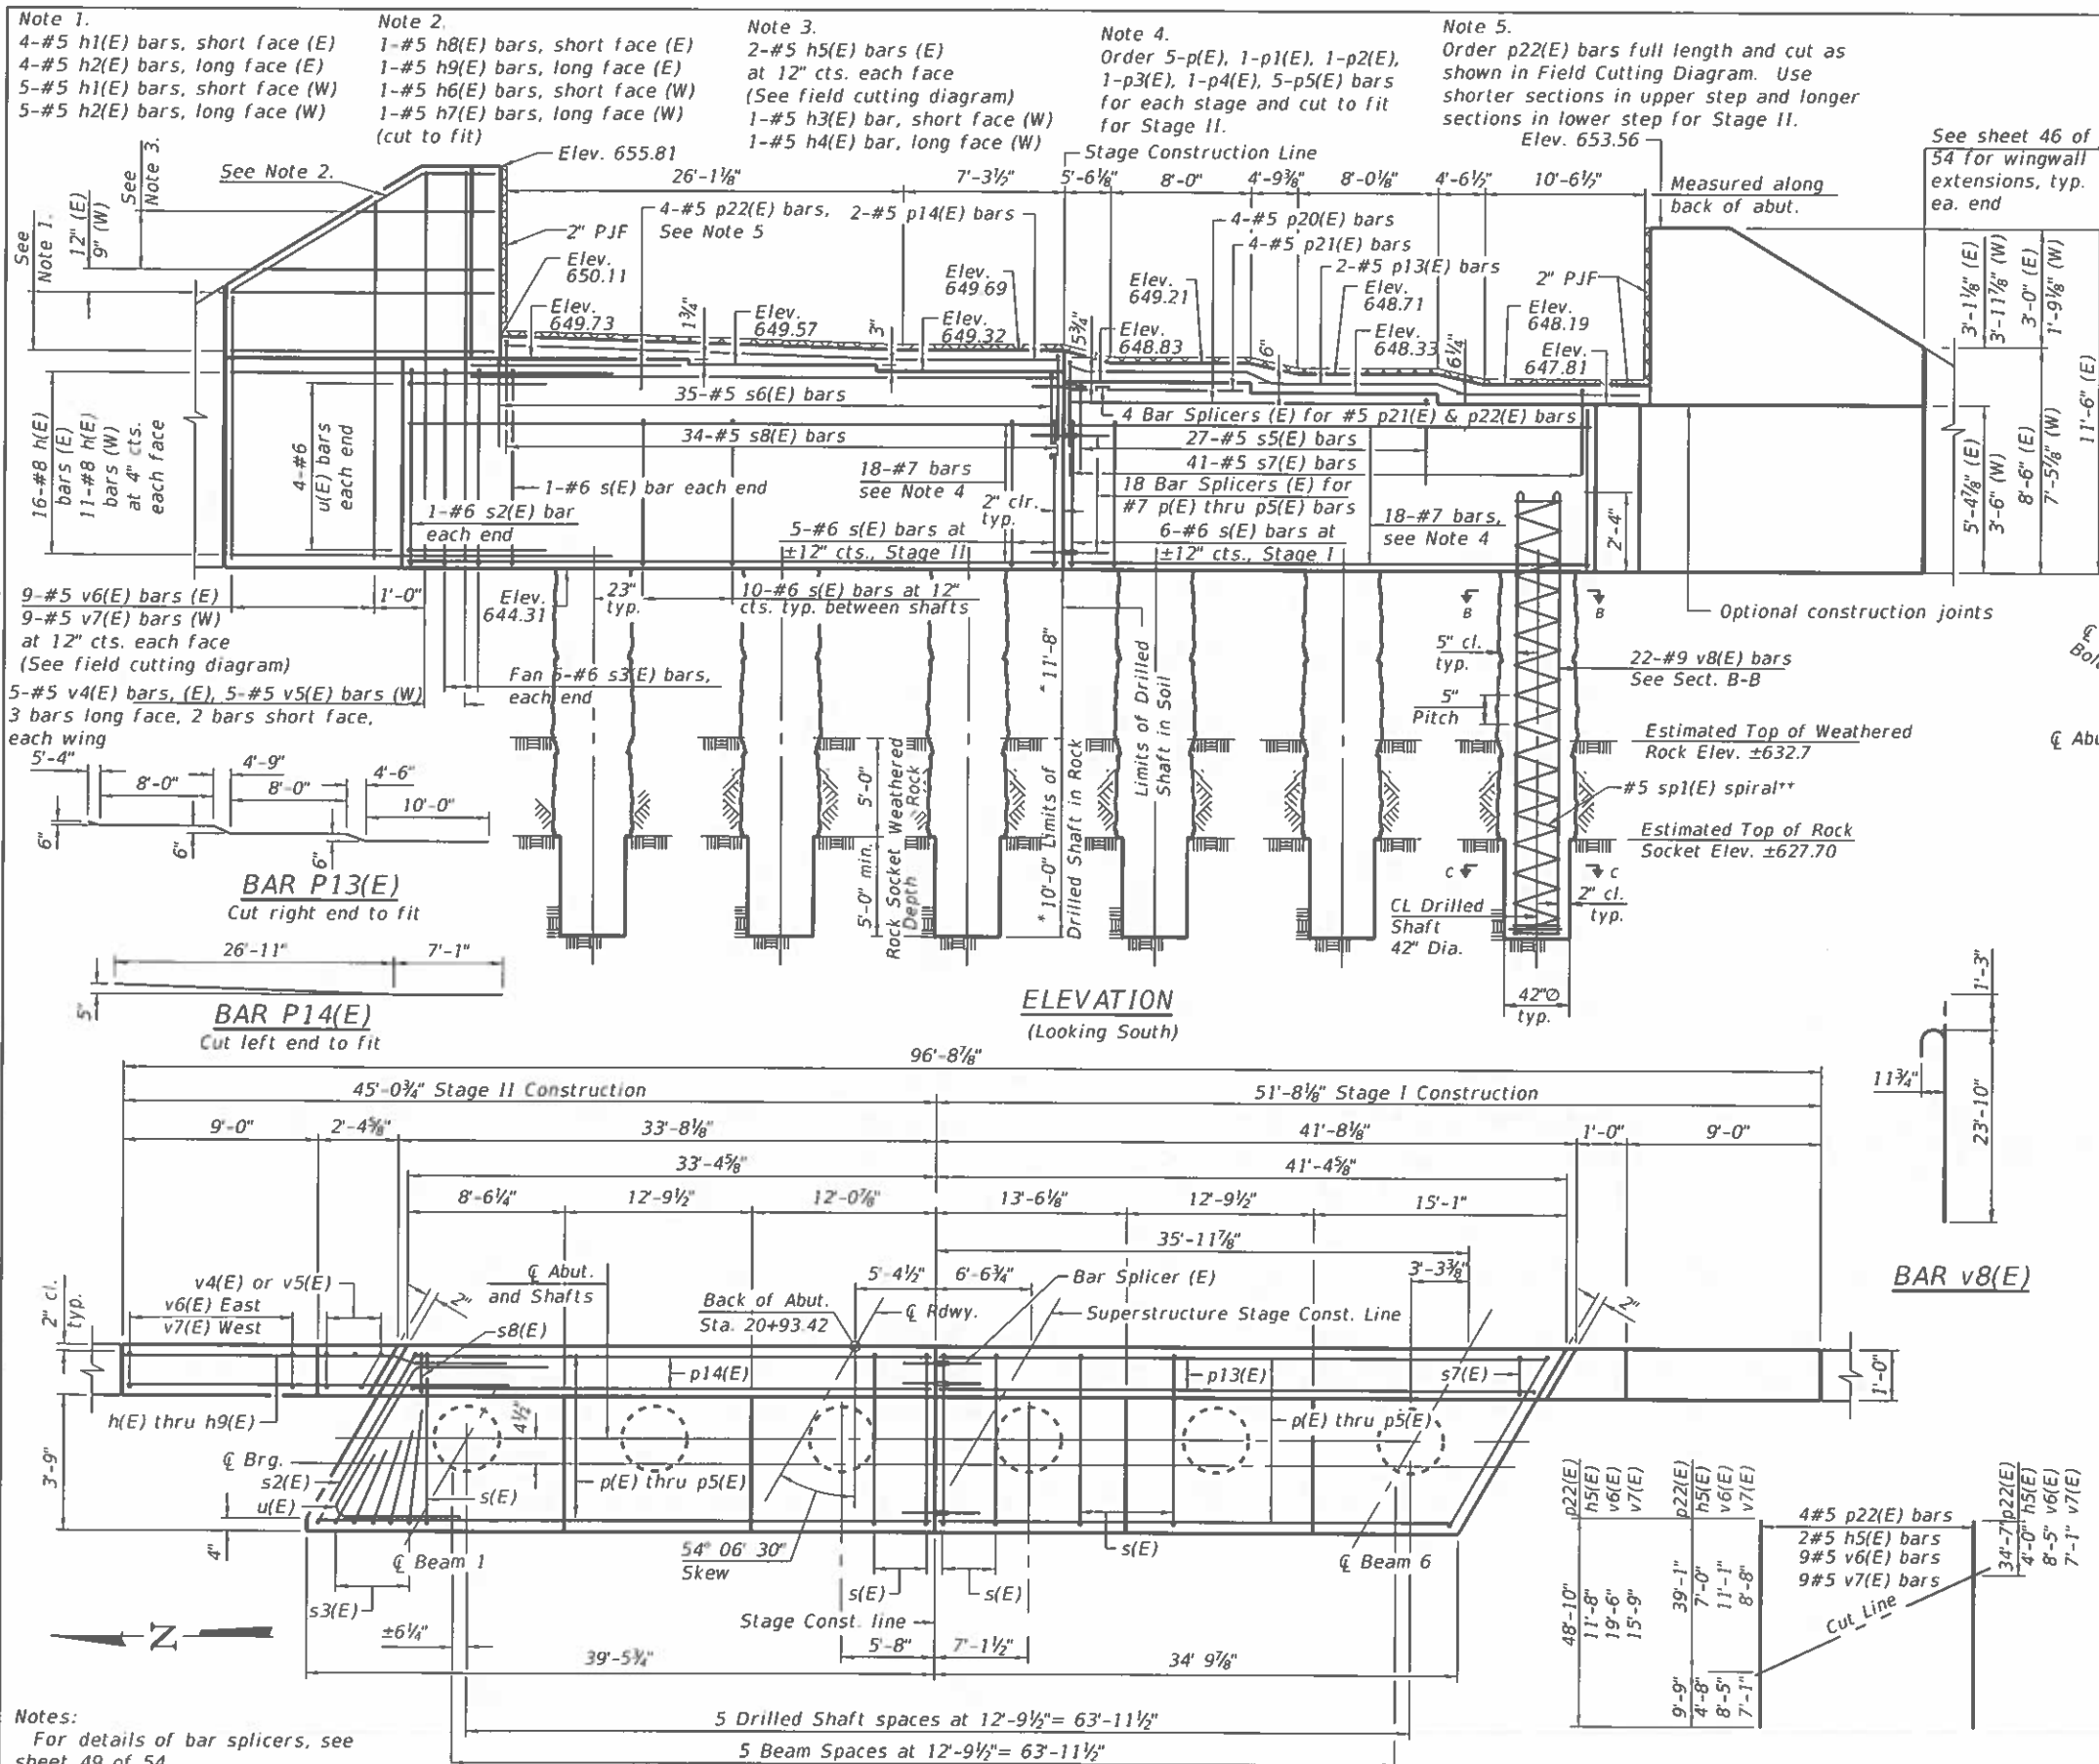

BILL OF MATERIAL

Bar	No.	Size	Length	Shape
h(E)	27	#8	16'-11"	
h1(E)	9	#5	9'-10"	
h2(E)	9	#5	10'-6"	
h3(E)	1	#5	6'-2"	
h4(E)	1	#5	6'-10"	
h5(E)	2	#5	11'-8"	
h6(E)	1	#5	10'-0"	
h7(E)	1	#5	10'-8"	
h8(E)	1	#5	10'-4"	
h9(E)	1	#5	11'-0"	
p(E)	10	#7	40'-7"	
p1(E)	4	#7	39'-6"	
p2(E)	4	#7	38'-3"	
p3(E)	4	#7	37'-1"	
p4(E)	4	#7	35'-11"	
p5(E)	10	#7	34'-7"	
p13(E)	2	#5	40'-10"	
p14(E)	2	#5	34'-0"	
p20(E)	4	#5	25'-11"	
p21(E)	4	#5	13'-2"	
p22(E)	4	#5	48'-10"	
s(E)	53	#6	16'-6"	
s2(E)	2	#6	22'-8"	
s3(E)	10	#6	11'-2"	
s5(E)	27	#5	10'-3"	
s6(E)	35	#5	12'-1"	
s7(E)	41	#5	7'-6"	
s8(E)	34	#5	9'-4"	
sp1(E)	6	#5	23'-8"	WWWW
u(E)	8	#6	15'-11"	
v4(E)	5	#5	11'-1"	
v5(E)	5	#5	8'-10"	
v6(E)	9	#5	19'-6"	
v7(E)	9	#5	15'-9"	
v8(E)	132	#9	25'-1"	
Structure Excavation			Cu. Yd.	269
Concrete Structures			Cu. Yd.	69.2
Reinforcement Bars, Epoxy Coated			Pound	23,260
Drilled shaft in soil			Cu. Yd.	32.6
Drilled shaft in rock			Cu. Yd.	24.6
Granular backfill for Structures			Cu. Yd.	242
Thermal Integrity Profile Testing			Each	6
Thermal Integrity Profile Data Collection			Foot	130
Pipe Underdrain for Structures 4"			Foot	97
Geocomp. Wall Drain			Sq. Yd.	98

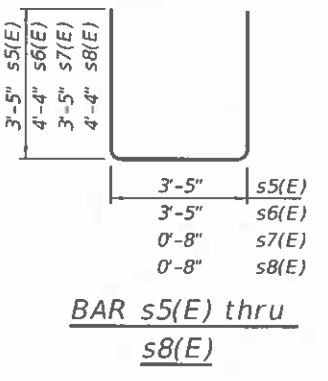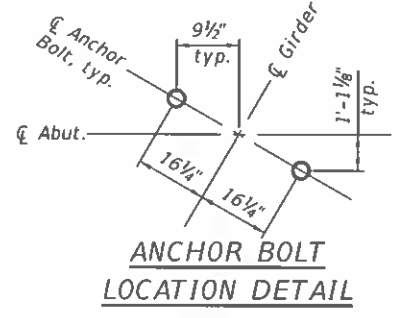

Space reinforcement in cap to miss anchor bolts.
 Pour steps monolithically with cap.
 See bar diagrams on sheet 44 of 54 for bars s(E) thru s3(E), u(E) and h6(E) thru h9(E).
 Minimum lap for spirals = 3'-9"
 * The quantities and detailing are based on the estimated elevations shown on the plans. The actual elevations may differ at each shaft and corresponding adjustments shall be made to the drilled shaft and reinforcement quantities and payment limits.
 **Provide 1 1/2 extra turns top and bottom of each drilled shaft. Extend spiral 2'-0" into abutment cap. Provide min. 4-#4 spacers or equivalent.
 ***Length is height of spiral.

Notes:
 For details of bar splicers, see sheet 49 of 54.
 Headed bars shall conform to ASTM A970 with threaded attachment; Class HA; and reinforcement bars conforming to ASTM A706. Cost included with Reinforcement Bars, Epoxy Coated.


Prairie Engineers, P.C.
 www.prairieengineers.com
 professional design firm no. 184-005965
 Copyright Prairie Engineers, P.C. 2016

USER NAME	DESIGNED	SMA	REVISED	
PLOT SCALE	CHECKED	CMF/TC	REVISED	
PLOT DATE	DRAWN	JLM	REVISED	
	CHECKED	SMA	REVISED	


STATE OF ILLINOIS
DEPARTMENT OF TRANSPORTATION

SOUTH ABUTMENT
STRUCTURE NO. 046-0153


F.A.I. RTE.	SECTION	COUNTY	TOTAL SHEETS	SHEET NO.
57	139HBR-6	KANKAKEE	202	134

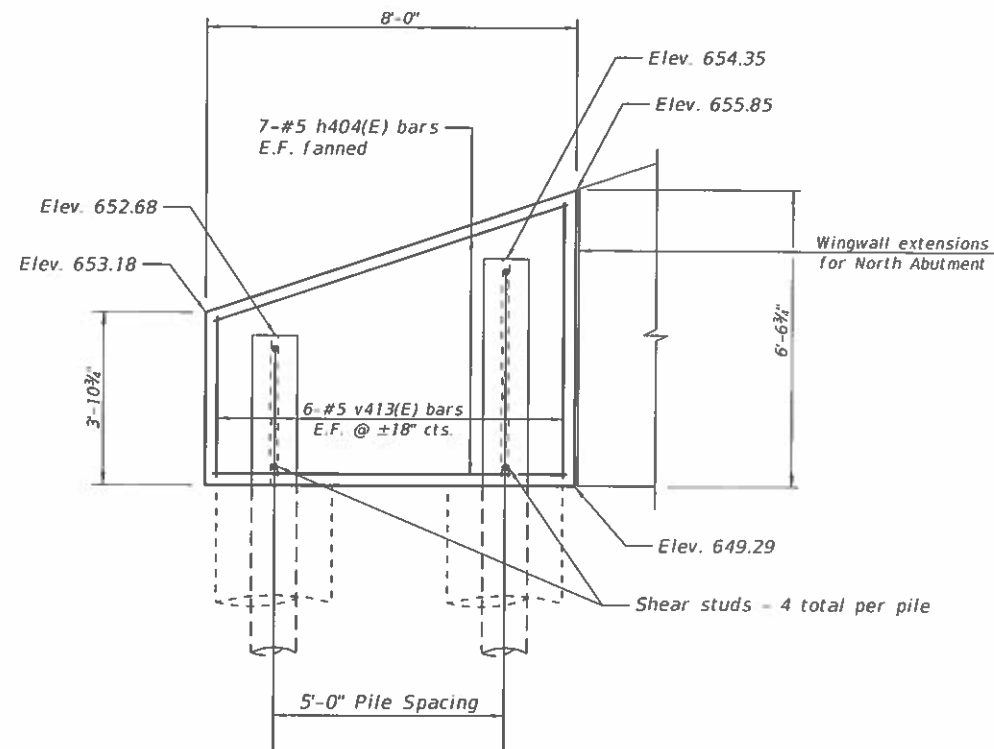


NW WINGWALL EXTENSION

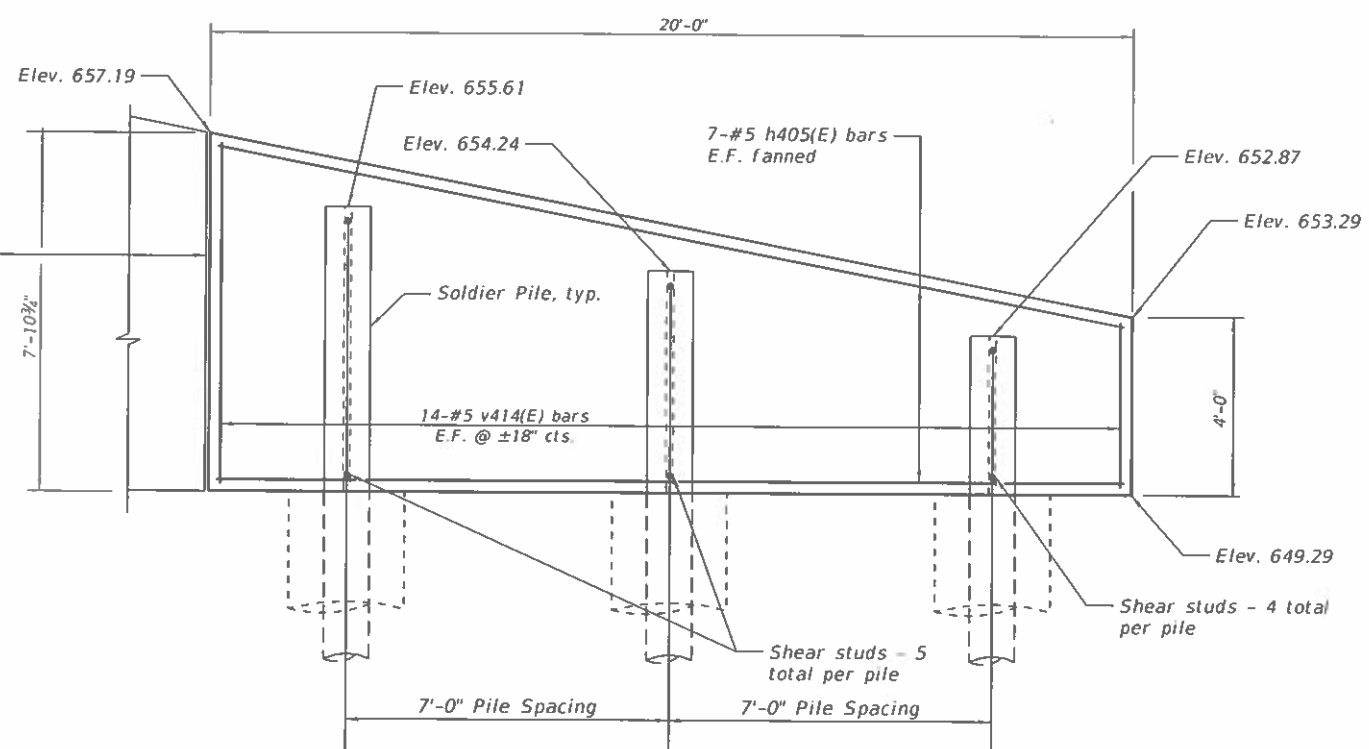

NE WINGWALL EXTENSION

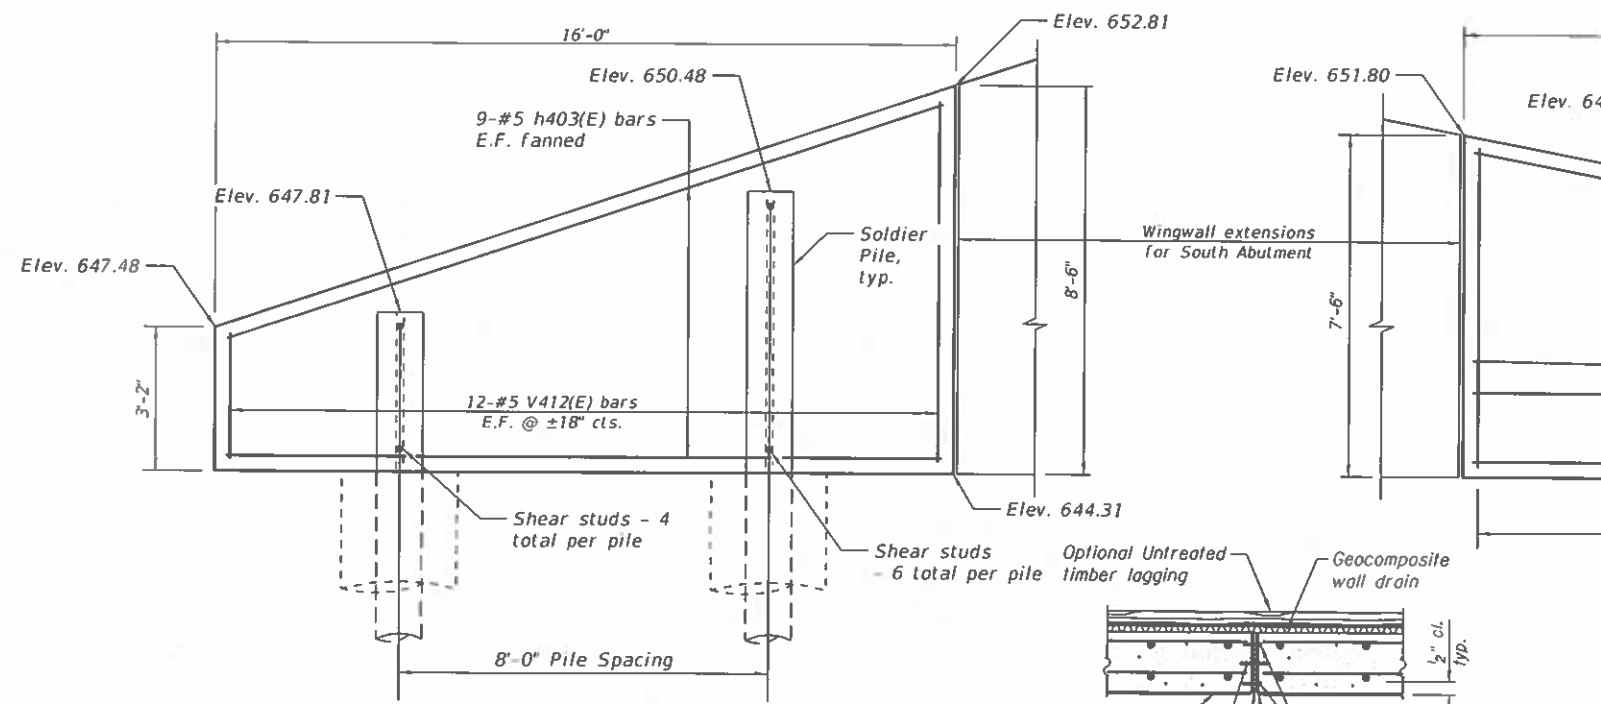

SE WINGWALL EXTENSION

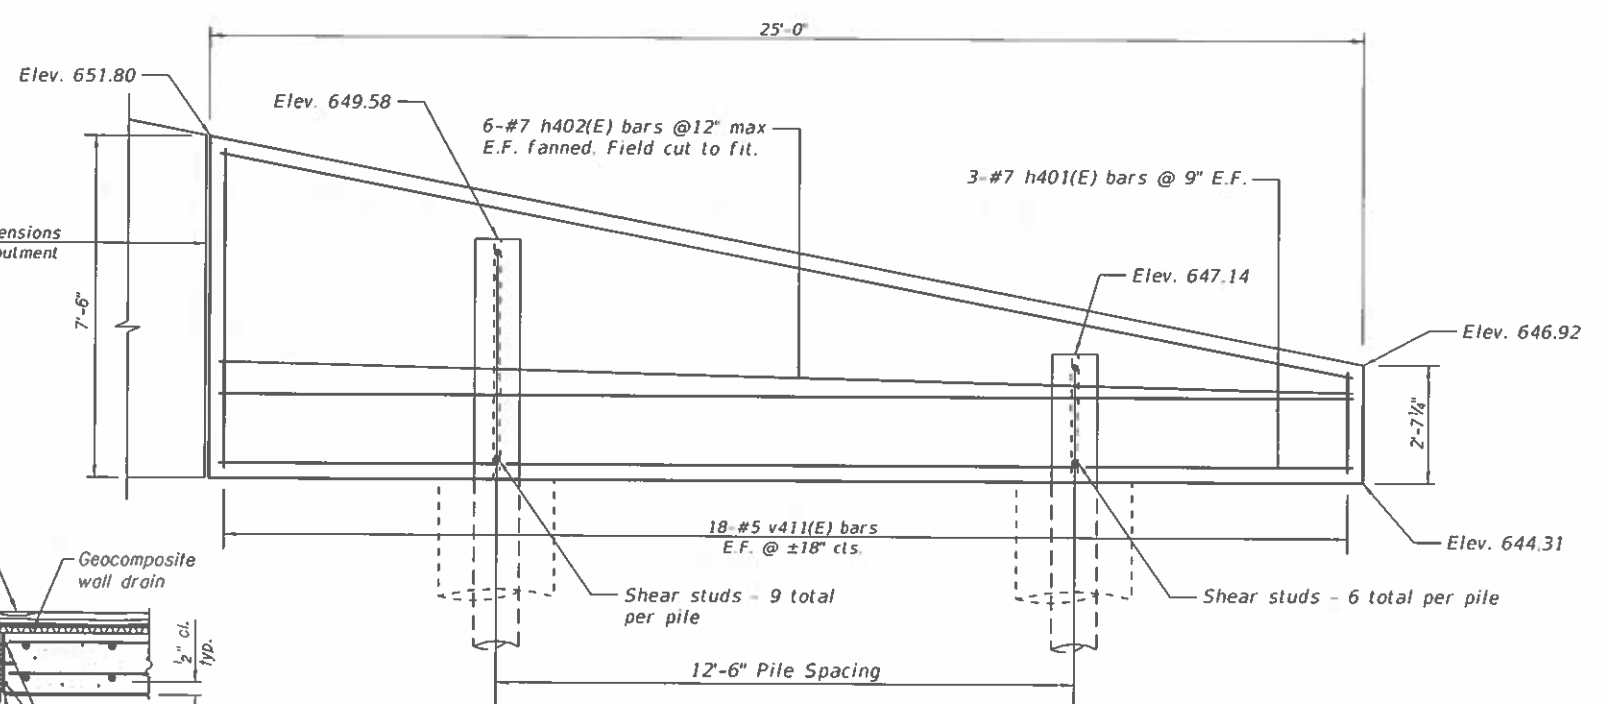

SW WINGWALL EXTENSION

6" Hollow Bulb Dumbbell Type Non-Metallic Water Seal (6" from top of wall to bottom) Cost included with Concrete Structures

Optional Untreated timber lagging

Geocomposite wall drain

Face of exposed concrete facing

Concrete Nails (flat head C.S.) 1" long at 12" cts. vertical

1" Chamfer

1/2" Preformed Joint Filler (Premolded)

EXPANSION JOINT

Notes:
F.F. = Front Face
B.F. = Back Face
See Bill of Materials and reinforcement field cutting diagram on sheet 47 of 54.

Prairie Engineers, P.C.
www.prairieengineers.com
Professional design firm no. 184-005965
© Copyright Prairie Engineers, P.C. 2020

USER NAME	DESIGNED - RC	REVISED -
PLOT SCALE	CHECKED - CMF	REVISED -
PLOT DATE	DRAWN - RNH	REVISED -
	CHECKED - RC	REVISED -


STATE OF ILLINOIS
DEPARTMENT OF TRANSPORTATION

WINGWALL EXTENSION ELEVATIONS
STRUCTURE NO. 046-0153

SHEET 46 OF 54 SHEETS


F.A.L. RTE.	SECTION	COUNTY	TOTAL SHEETS	SHEET NO.
57	139HBR-6	KANKAKEE	202	135
CONTRACT NO. 66997				

ILLINOIS FED. AID PROJECT

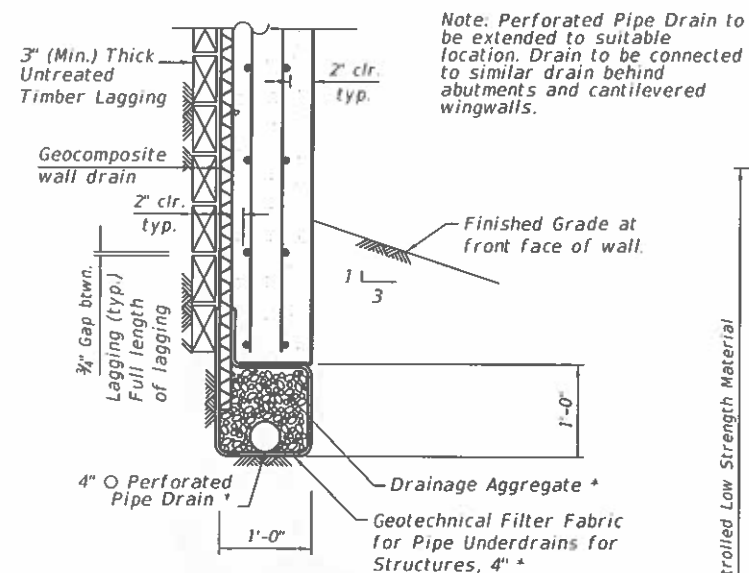


Note 1: Minimum socket depth is 4 feet below competent rock.

WINGWALL EXTENSION
BILL OF MATERIAL

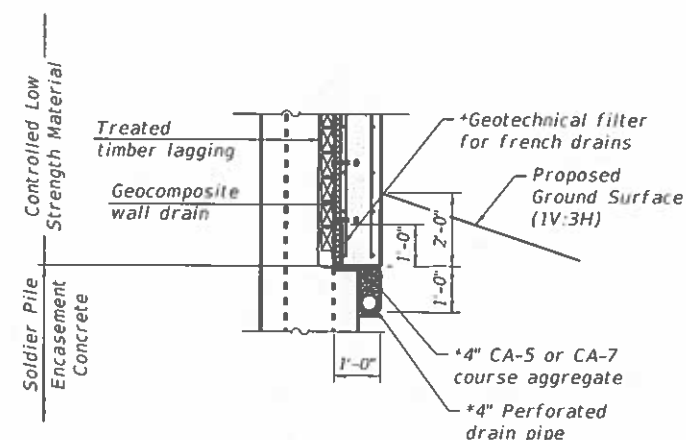

PIPE UNDERDRAIN DETAIL AT
SOLDIER PILES


^aIncluded in the cost of Pipe Underdrains for Structures

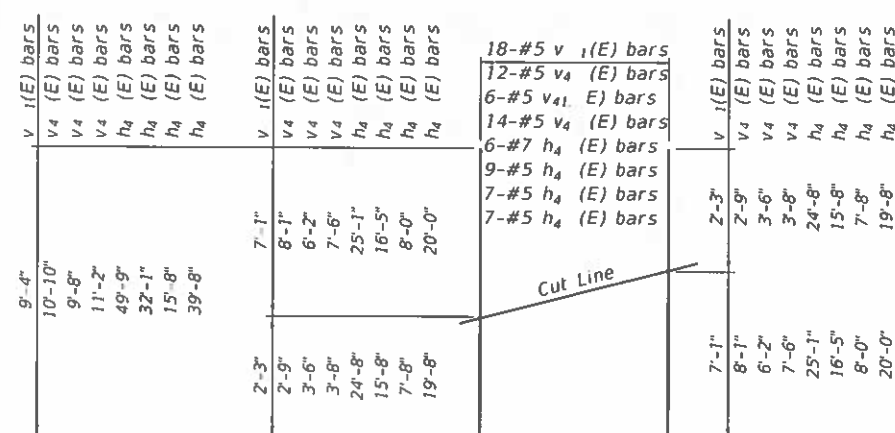


FIELD CUTTING DIAGRAM

Order bars full length. Cut as shown and use remainder of bars in opposite face.

See Sheet 3 of 54 for Sequence of Construction.

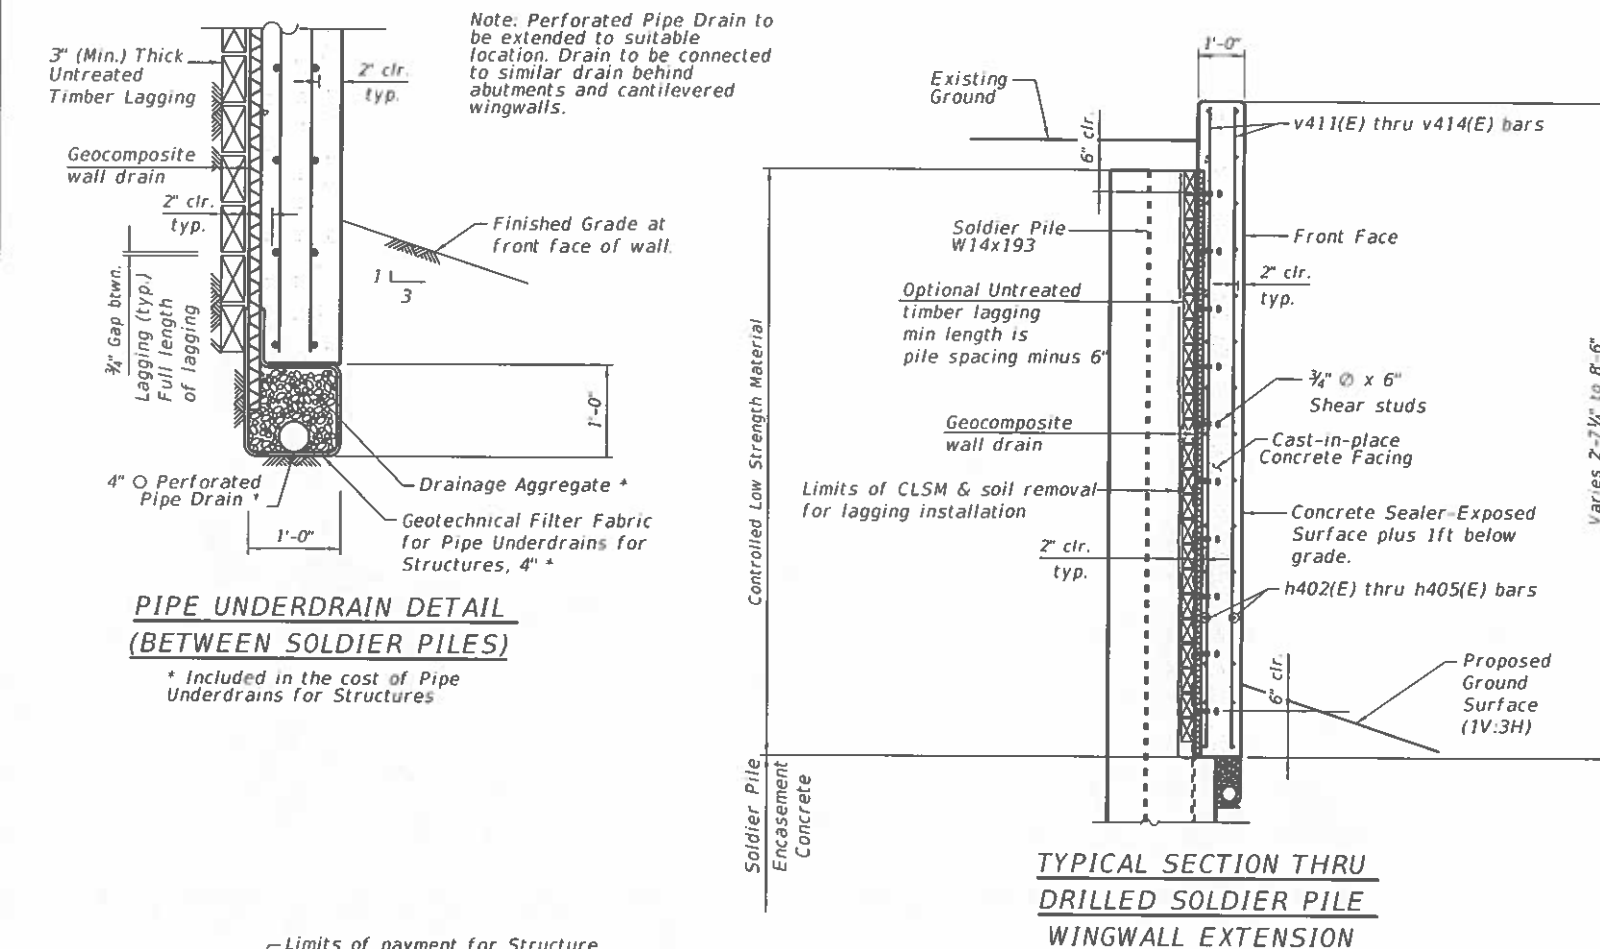


TYPICAL SECTION THRU
DRILLED SOLDIER PILE
WINGWALL EXTENSION

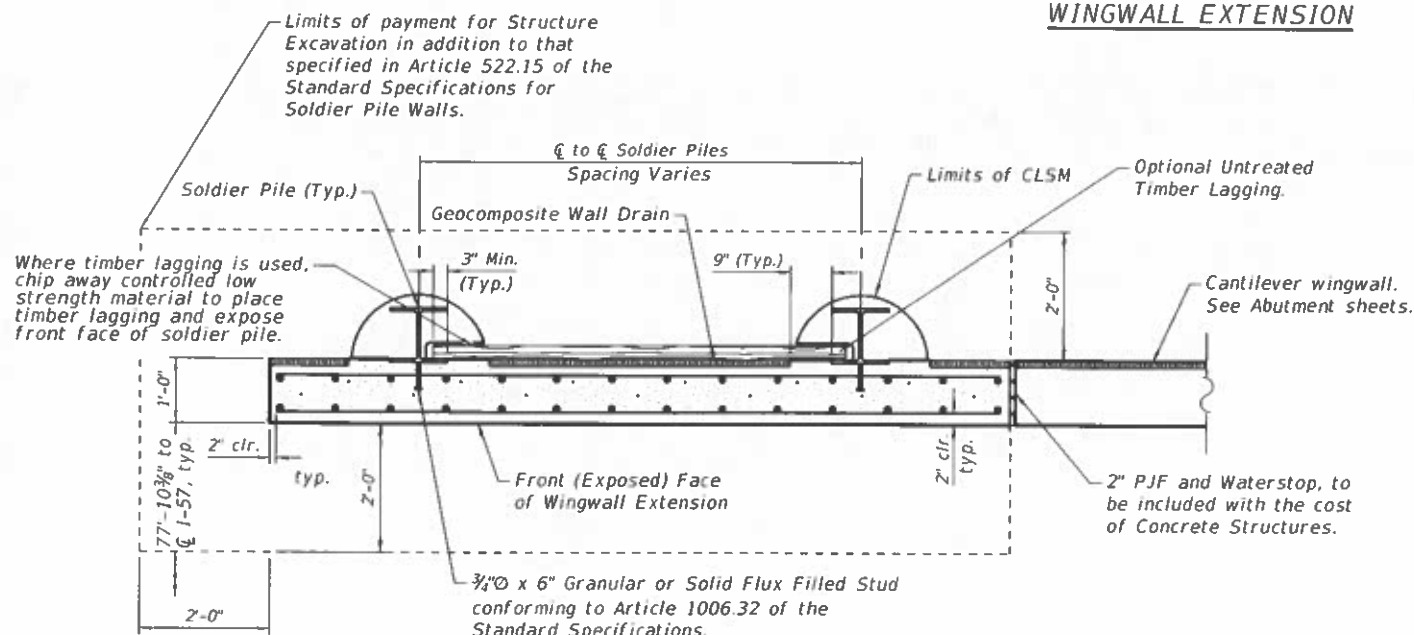


HORIZONTAL SECTION THRU SOLDIER PILE WINGWALL EXTENSION

The Contractor may optionally choose to use timber lagging rather than excavating behind the wall between piles and using traditional formwork. The Contractor is responsible for the design and performance of the lagging using no less than a 3 in. nominal rough-sawn thickness and timber with a minimum allowable bending stress of 1000 psi. This lagging will not be paid for separately but will be included in the cost of Concrete Structures.

Notes:
Space reinforcement in cap to miss anchor bolts.
Pour steps monolithically with cap.
Concrete Sealer shall be applied to all exposed areas of the pier.
See sheet 49 of 54 for bar splicer details.

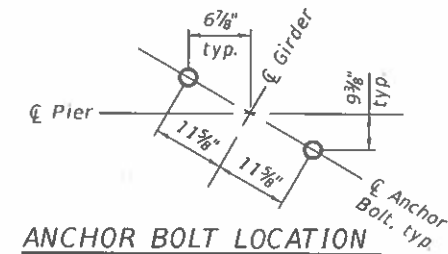


ANCHOR BOLT LOCATION DETAIL

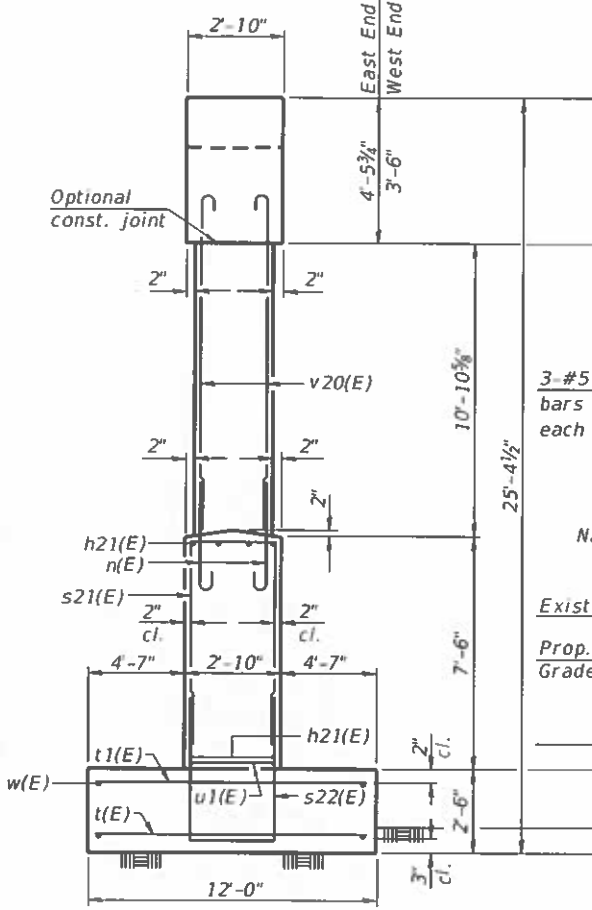

END VIEW

The bottom of footing elevation(s) shall be adjusted to ensure a minimum embedment of 6 inches in non-weathered rock. The rock excavation shall be made with near-vertical sides at the plan dimensions to allow the sides and base of the embedded portion of the footing to be cast against undisturbed rock surfaces.
Maximum applied service bearing pressure = $Q_{max} = 5.3$ ksf.

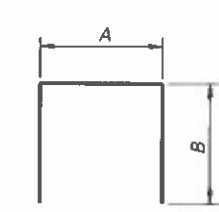


BARS

A & B DIMENSIONS


Bar	A	B
s21(E)	2'-6"	7'-2"
s22(E)	2'-6"	6'-3"
s23(E)	2'-6"	3'-1"
s24(E)	2'-6"	3'-5"

MINIMUM BAR LAP

#5 bar = 3'-7"
#7 bar = 5'-0"

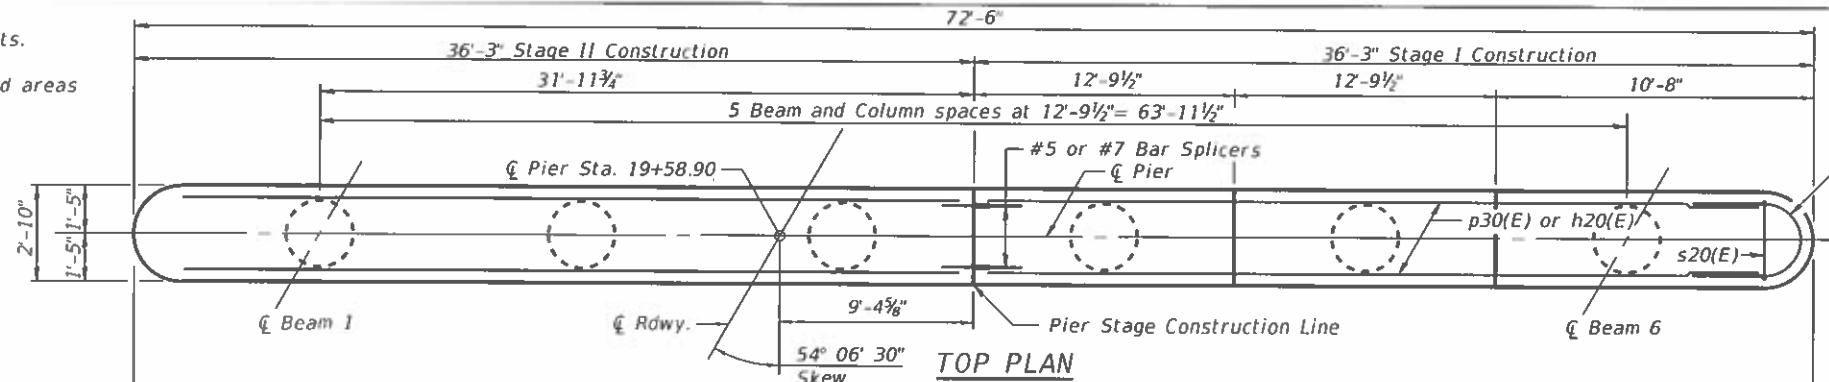


TOP PLAN

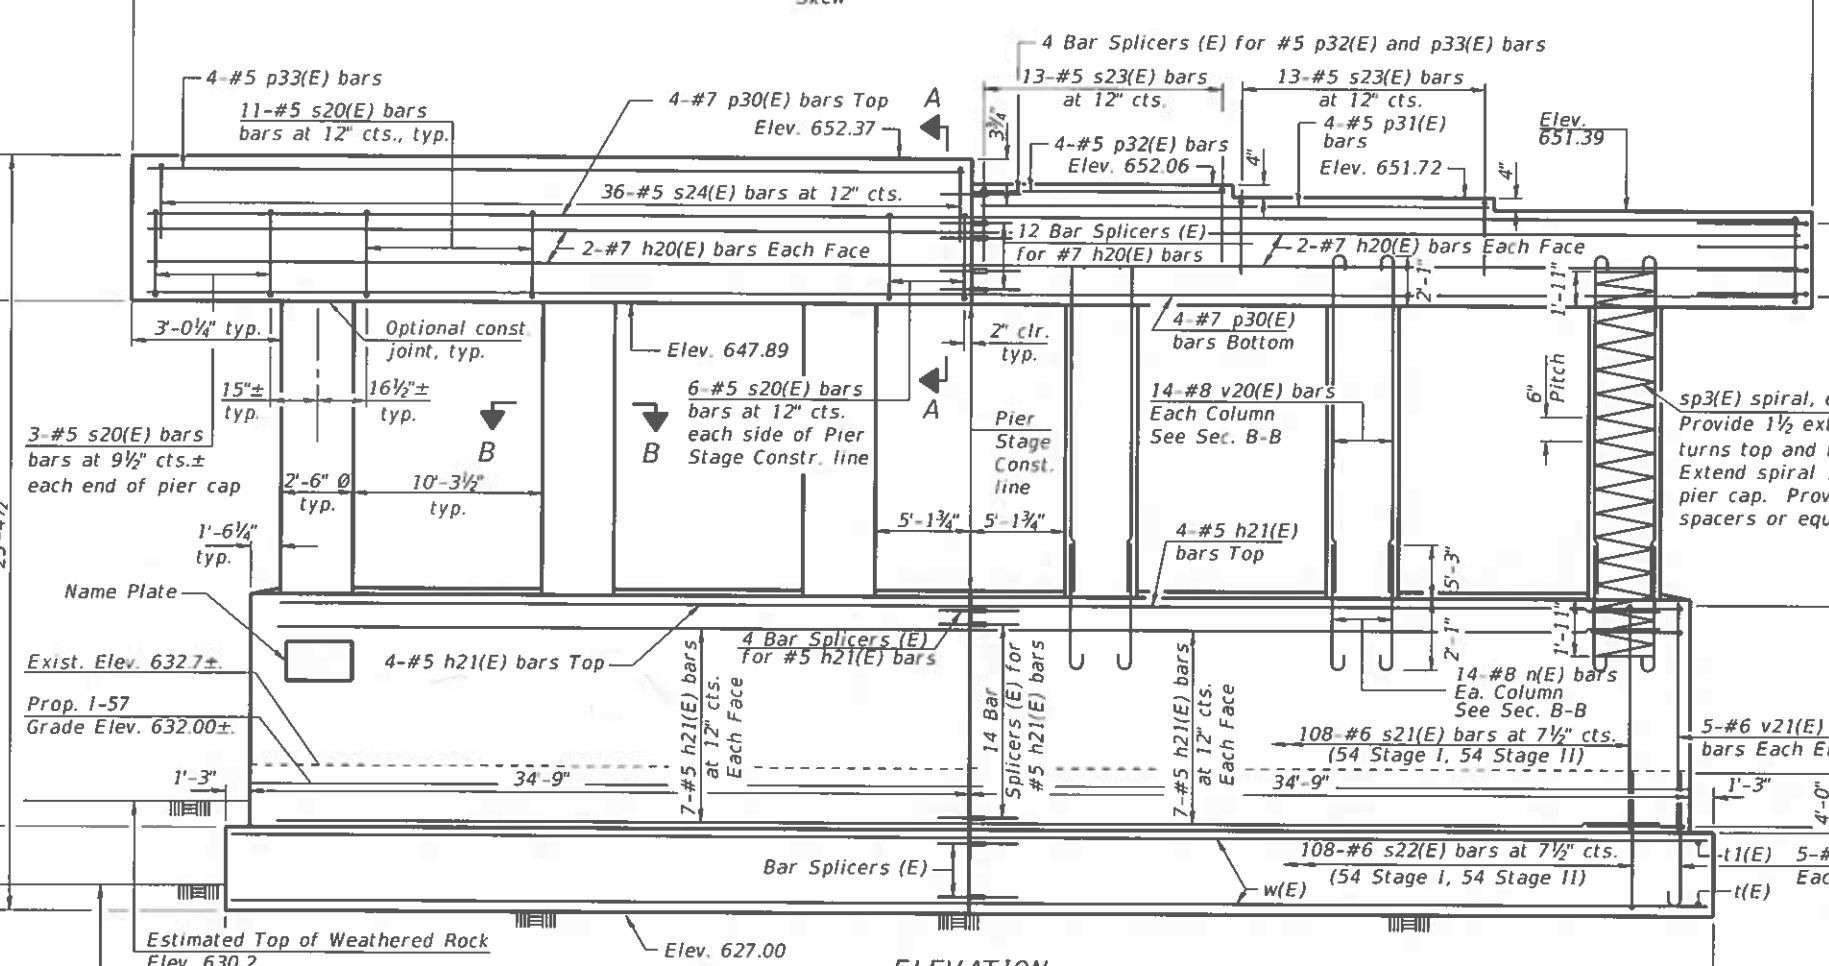


ELEVATION

(Looking South - Upstation Waldron Road)

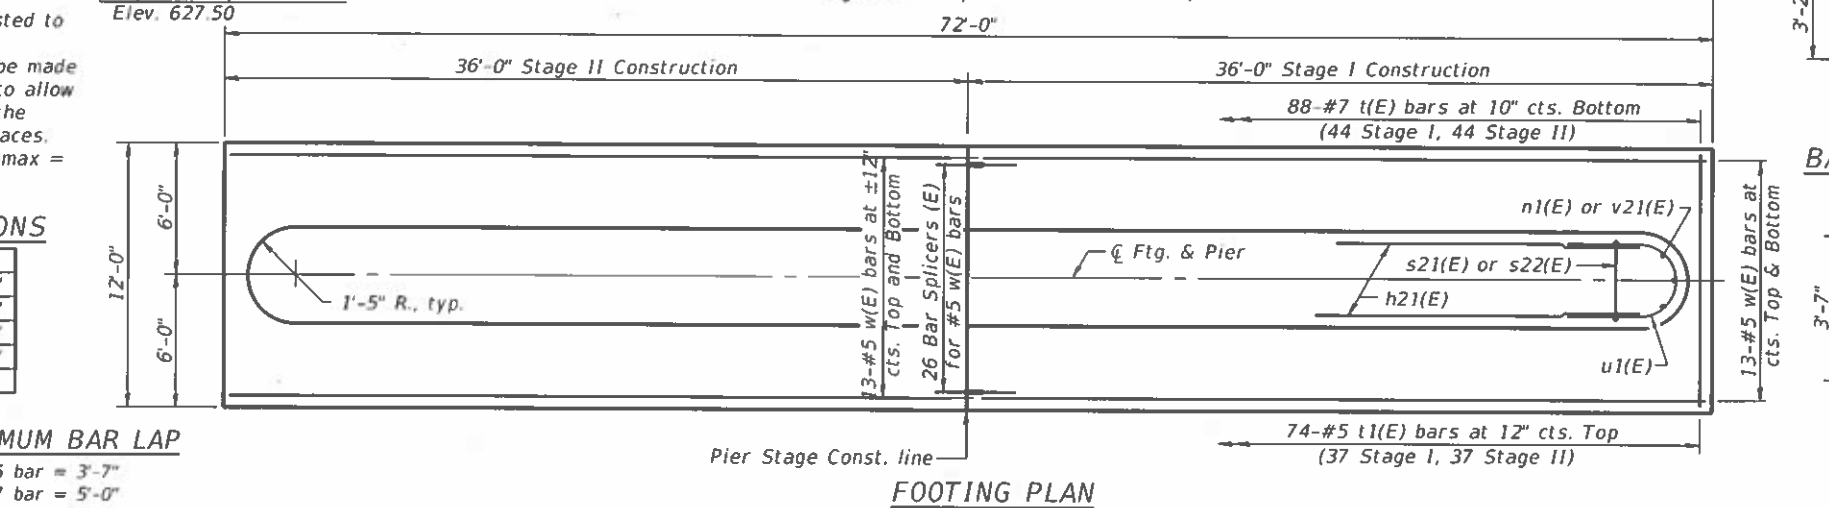


FOOTING PLAN

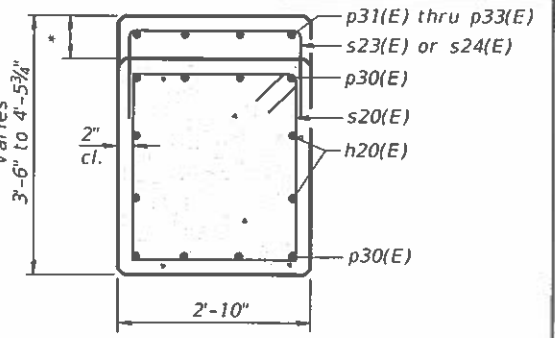

SEC. A-A

*Step heights vary, see Elevation

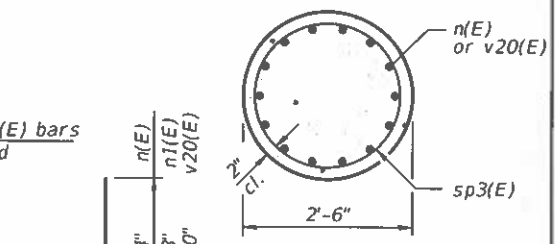

SEC. B-B

BAR n(E), n1(E), & v20(E)

BILL OF MATERIAL

Bar	No.	Size	Length	Shape
h20(E)	8	#7	34'-8"	—
h21(E)	36	#5	33'-2"	—
n(E)	84	#8	8'-3"	—
n1(E)	10	#6	6'-11"	—
p30(E)	16	#7	34'-8"	—
p31(E)	4	#5	25'-3"	—
p32(E)	4	#5	12'-5"	—
p33(E)	4	#5	34'-8"	—
s20(E)	62	#5	12'-3"	—
s21(E)	108	#6	16'-10"	—
s22(E)	108	#6	15'-0"	—
s23(E)	26	#5	8'-8"	—
s24(E)	36	#5	9'-4"	—
sp3(E)	6	#4	14'-9"	—
t(E)	88	#7	11'-6"	—
t1(E)	74	#5	11'-6"	—
u1(E)	24	#5	10'-10"	—
v20(E)	84	#8	13'-11"	—
v21(E)	10	#6	7'-2"	—
w(E)	52	#5	35'-7"	—
Structure Excavation		Cu. Yd.	113	
Rock Excavation for Structures		Cu. Yd.	102	
Concrete Structures		Cu. Yd.	178.1	
Reinforcement Bars, Epoxy Coated		Pound	21,160	
Concrete Sealer		Sq. Ft.	2,234	

** Length is height of spiral.

P-26

2-17-2017

Prairie Engineers, P.C.
www.prairieengineers.com
Professional design firm no. 164-005965
© Copyright Prairie Engineers, P.C. 2018

USER NAME
DESIGNED - SMA
CHECKED - CMF/TCO
PLOT SCALE
DRAWN - JLM
PLOT DATE
CHECKED - SMA

REVISIONS
REVISED -
REVISED -
REVISED -
REVISED -


STATE OF ILLINOIS
DEPARTMENT OF TRANSPORTATION

PIER DETAILS
STRUCTURE NO. 046-0153

SHEET 48 OF 54 SHEETS

F.A.I. RTE. SECTION COUNTY TOTAL SHEETS SHEET NO.
57 139HBR-6 KANKAKEE 202 137
CONTRACT NO. 66997

8/12/2021 9:05:54 AM

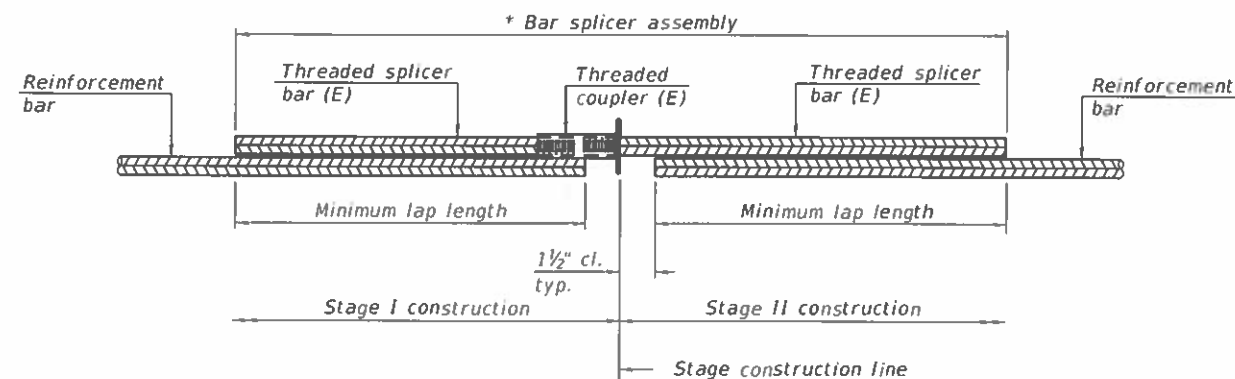


STANDARD BAR SPLICER ASSEMBLY PLAN
(All components shall be provided from one supplier)

Threaded splicer bar length = min. lap length + 1 1/2" + thread length

* Epoxy not required on Bar Splicer Assembly components used in conjunction with black bars.

Location	Bar size	No. assemblies required	Minimum lap length
Deck (top)	#5	572	3'-0"
Deck (bottom)	#5	351	3'-6"
Abutments	#5	6	3'-7"
Abutments	#7	36	5'-0"
Pier	#5	48	3'-7"
Pier	#7	12	5'-0"
Approach Slab	#5	18	3'-0"
Approach Slab	#4	18	2'-5"
Approach Slab Footing	#5	80	3'-0"
Back Face of Diaphragms	#6	22	3'-7"
Bottom of Diaphragms	#4	4	2'-5"

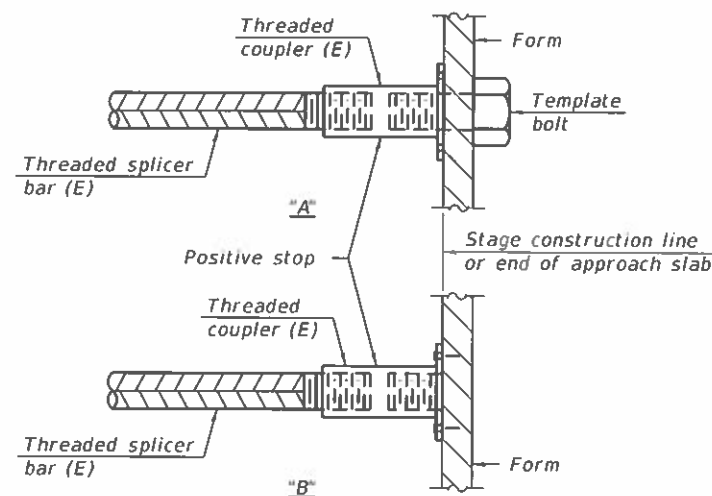


INSTALLATION AND SETTING METHODS

"A" : Set bar splicer assembly by means of a template bolt.


"B" : Set bar splicer assembly by nailing to wood forms or cementing to steel forms.

(E) : Indicates epoxy coating.

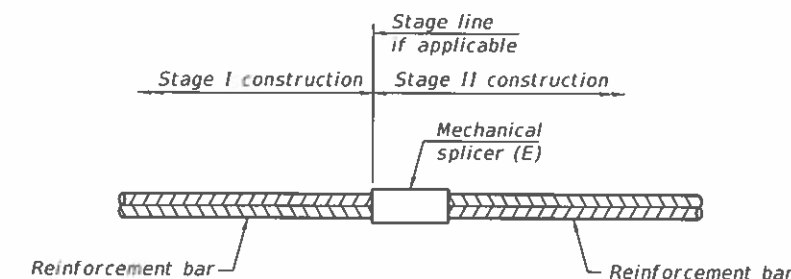

STANDARD MECHANICAL SPLICER

Location	Bar size	No. assemblies required

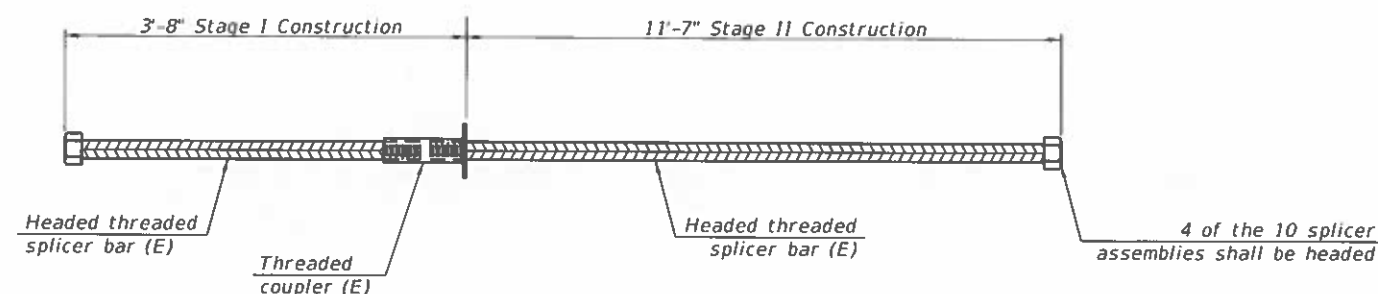

BAR SPLICER BETWEEN BEAMS (10 Required)

Notes:

Splicer bars shall be deformed with threaded ends and have a minimum 60 ksi yield strength.

All reinforcement shall be lapped and tied to the splicer bars.

Bar splicer assemblies shall be epoxy coated according to the requirements for reinforcement bars. See Section 508 of the Standard Specifications.

See approved list of bar splicer assemblies and mechanical splicers for alternatives.

MODEL: TEMP CONC BARRIER
FILE NAME: G:\Users\111111355-01-Waldron-Road-over-I57-SuperstructureSurvey-D366997\Consultant_Data\Chamlin_2020\CAD_Sheets\0460153-66997-049-BAR_SPLICER.dgn



USER NAME *	DESIGNED - JKC	REVISD -
PLOT SCALE *	CHECKED - AJO	REVISD -
PLOT DATE *	DRAWN - LAG	REVISD -
	CHECKED - JKC	REVISD -

STATE OF ILLINOIS
DEPARTMENT OF TRANSPORTATION


BAR SPLICER ASSEMBLY AND MECHANICAL SPLICER DETAILS
STRUCTURE NO. 046-0153

SHEET 49 OF 54 SHEETS

F.A.I. RTE.	SECTION	COUNTY	TOTAL SHEETS	SHEET NO.
57	139HBR-6	KANKAKEE	202	138
CONTRACT NO. 66997				


ILLINOIS | FED. AID PROJECT

3/11/2021 3:35:23 PM

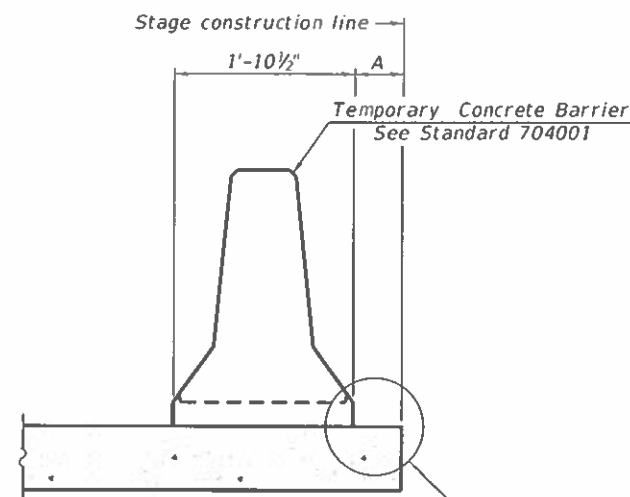


When "A" is 3'-1" or less, the temporary concrete barrier shall be restrained to the new slab according to Detail I, II or III. No restraint is required when "A" is greater than 3'-1". See Detail I, II or III

NEW SLAB OR NEW DECK BEAM

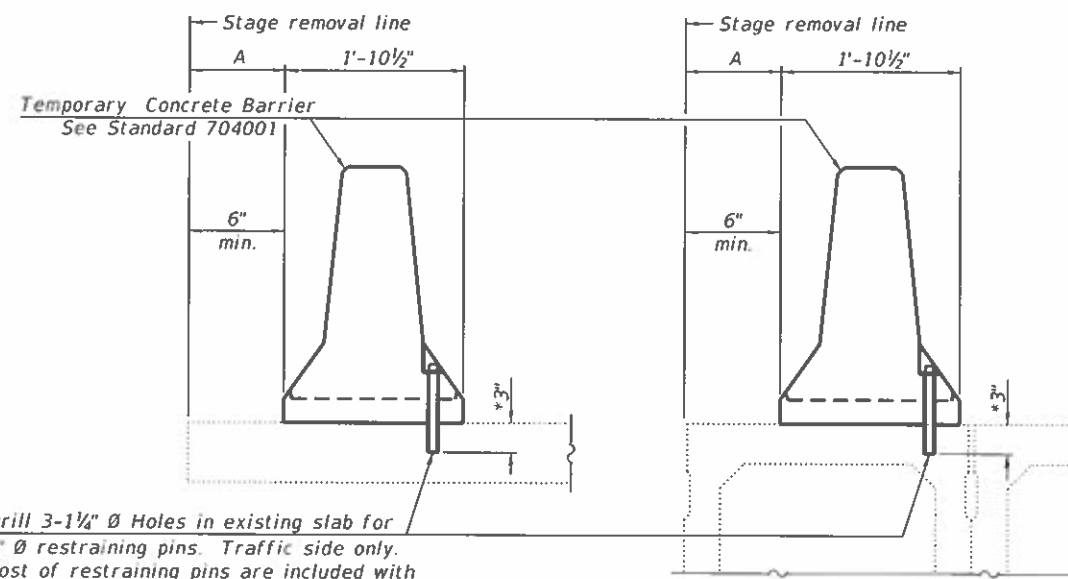


Drill 3-1 1/4" Ø Holes in existing slab for 1" Ø restraining pins. Traffic side only. Cost of restraining pins are included with Temporary Concrete Barrier. No restraint is required when "A" is greater than 3'-1".

EXISTING SLAB

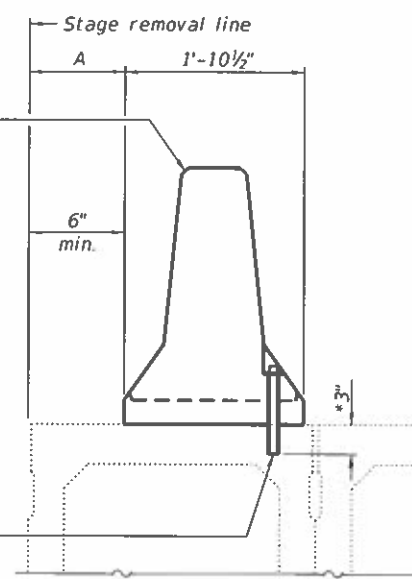


* When hot-mix asphalt wearing surface is present, embedment shall be 3" plus the wearing surface depth.


EXISTING DECK BEAM

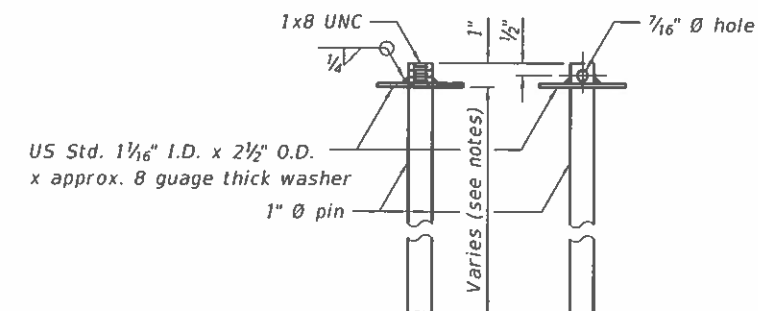


RESTRAINING PIN

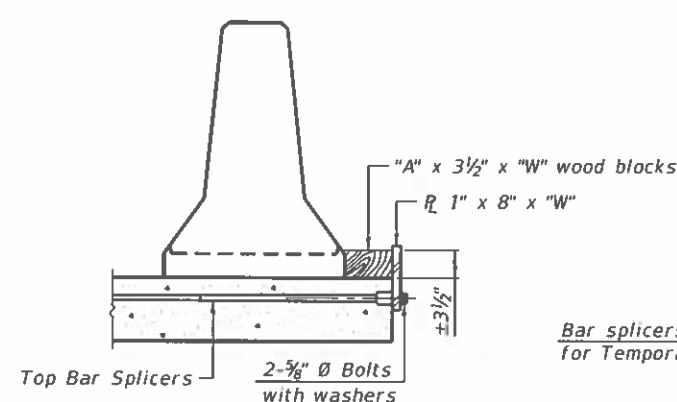


DETAIL 1

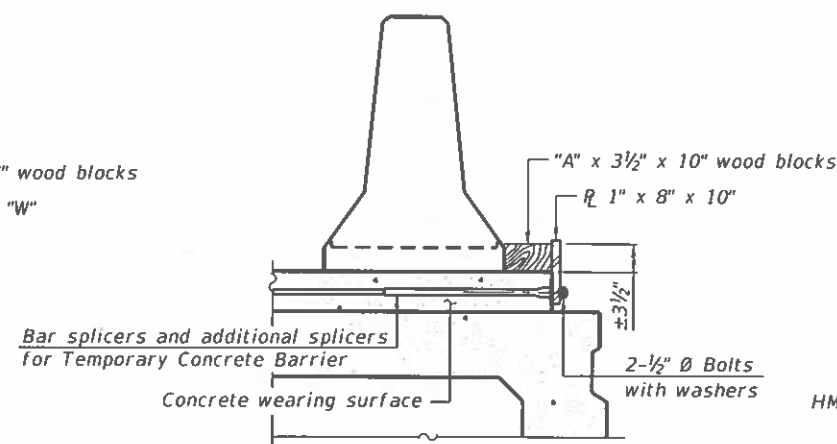


DETAIL II

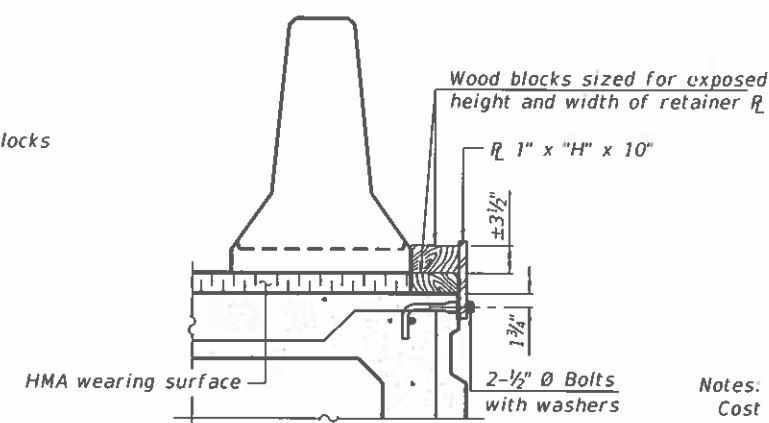


DETAIL III

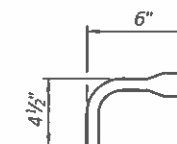

BAR SPLICER FOR #4 BAR - DETAIL III

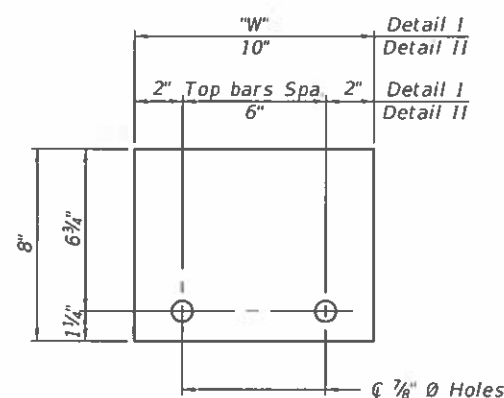

STEEL RETAINER R 1" x 8" x "W"
(Detail I and II)

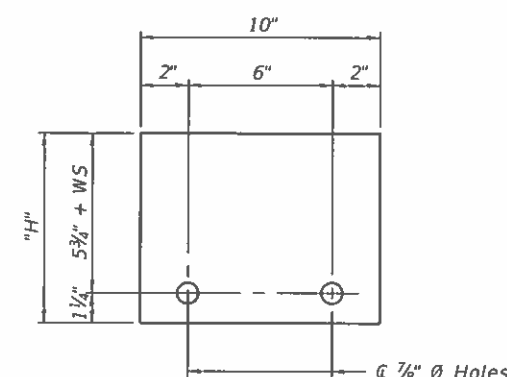

STEEL RETAINER R 1" x "H" x 10"
(Detail III)

Notes:

Cost of retainer assembly is included with Temporary Concrete Barrier.
A retainer assembly shall be located at the approximate $\frac{1}{4}$ of each temporary concrete barrier.

The retainer plate shall not be removed until the concrete on the adjacent stage is ready to be poured. For Detail III applications the retainer plate shall not be removed until just prior to placing the adjacent beam.

When the 'A' dimension is less than $1\frac{1}{2}$ ", the wood block shall be omitted and the barrier shall be placed in direct contact with the steel retainer plate. For deck beam applications the minimum required 'A' distance is 6" to accommodate the shear key clamping device.

Detail I - Installation for a new bridge deck or bridge slab.

Detail II – Installation for a new deck beam with an initial concrete wearing surface. Additional bar splicers shall be provided at 6'-0" centers and paired with the bar splicers of the concrete wearing surface reinforcement to accommodate the installation of the retainer assemblies. The cost of the additional bar splicers is included with the concrete wearing surface.

Detail III – Installation for a new deck beam with no initial wearing surface or with an initial hot-mix asphalt (HMA) wearing surface present. The deck beam directly beneath the temporary concrete barrier shall be fabricated with bar splicer inserts in the side of the beam, as detailed, to accommodate the installation of the retainer assemblies. A pair of bar splicers, 6" apart, shall be placed at 6'-0" centers along the length of the beam. The cost of the bar splicers is included with the deck beam.



ROCK CORE LOG

Date 9/7/17

ROUTE	I-57 (EAL57)	DESCRIPTION	15152	LOCATION ON MAP
		Waldron Road over I-57, 3.4 miles North of US		

SECTION (46-3)R, HBK, 5HBR, 6HBR LOCATION SE 1/4, SEC. 4, TWP. 30N, RNG. 13W, 2nd PM,
Latitude 41.108486, Longitude -87.835544

COUNTY	Kauai	CORING METHOD	Self-Regulating Air Line	B		CORE	S
--------	-------	---------------	--------------------------	---	--	------	---

STRUCT. NO.	046-0080 (EX)	CORING BARREL TYPE & SIZE	N.W.A. 2	D E P T H (ft)	C O R E (in)	C O V E R Y (%)	R Q D (%)	T I M E (min/hr)	T R E N G T H (tsf)	
Station	230+53.99 (EX)	Core Diameter	1.9							in
BORING NO.	B 219 (N. Abut.)	Top of Rock Elev.	624.80							ft
Station	229+18.36	Begin Core Elev.	624.80							ft
Offset	87.5 ft RI									
Ground Surface Elev.	657.30									

Ground Surface Elev.	857.30	ft	(ft)	(ft)	(%)	(%)	(min/ft)	(bbl)
Dense Gray Limestone with Generally Tight Horizontal Fractures, Interbedded Thin Shale Seams in top 6"	624.80		1	87	28	2.2		
Minor Calcite Crystal Vug Fill								895.1
								822.2
	619.80							732.4
Dense Gray Limestone with Tight Horizontal Fracturing			2	100	55	1.6		1359.7
Minor Calcite Crystal Vug Fill								1354.8
								1156.4
	614.80							
Dense Gray Limestone with Tight Horizontal Fractures			3	100	83	3.2		1005.9
Minor Calcite Crystal Vug Fill								1198.5
								598.8
	609.80							809.0
End of Boring								

The Unconfined Compressive Strength (UCS) Failure Mode is indicated by (B-Bulge, S-Shear, P-Penetrometer)
The SPT (N value) is the sum of the last two blow values in each sampling zone (AASHTO T208)

Color pictures of the cores Yes
 Cores will be stored for examination until Construction Complete
 The "Strength" column represents the uniaxial compressive strength of the core sample (ASTM D-2938)
 BBS, form 136 (Rev. 8-99)

Prairie Engineers, P.C.
www.prairieengineers.com
professional design firm no. 184-005965
© Copyright Prairie Engineers, P.C. 2018

USER NAME =	DESIGNED = SMA	REVISED =
	CHECKED = CMF/ICD	REVISED =
PLOT SCALE =	DRAWN = JLM	REVISED =
PLOT DATE =	CHECKED = SMA	REVISED =

**STATE OF ILLINOIS
DEPARTMENT OF TRANSPORTATION**

SOIL BORINGS
STRUCTURE NO. 046-0153

F.A.I. RTE.	SECTION	COUNTY	TOTAL SHEETS	SHEET NO.
57	139HBR-6	KANKAKEE	202	140
		CONTRACT NO. 66997		

Page 1 of 1

Date 9/4/13

ROUTE	DESCRIPTION	LOGGED BY
I-57 (FAI 57)	Waldron Road over I-57, 3.4 miles North of US 45/52	Larry Myers

SECTION (46-3)R, HBK, 5HBR, 6HBR LOCATION SE 1/4, SEC. 4, TWP. 30N, RNG. 13W, 2ND PM,

COUNTY Kankakee DRILLING METHOD Hollow Stem Auger HAMMER TYPE CME Automatic

STRUCT. NO. <u>046-0080 (Exst.)</u>	D	B	U	M	Surface Water Elev. _____ ft
Station <u>230+53.99 (Exist.)</u>	E	L	C	O	Stream Bed Elev. _____ ft
	P	O	S	I	
BORING NO. <u>BH 68 (Pier)</u>	T	W	Q	T	Groundwater Elev.: _____ ft
Station <u>230+00.99</u>	H	S	u		First Encounter _____ Dry
Offset <u>9.2 ft Li.</u>					Upon Completion _____ Dry
Ground Surface Elev. <u>632.86</u> ft (ft) (ft) (ft) (ft)					After _____ Hrs. _____ ft

Augered Bituminous Shoulder & Brown Fill Sand/Gravel

630.36
640.18

Dense Weathered Dolomite

End of Boring

100/2

0
-5
-10
-15
-20

15J & 15.17 ATTENDANCE DP2 6 001 001 11/2/14

The Unconfined Compressive Strength (UCS) Failure Mode is indicated by (B-Bulge, S-Shear, P-Penetrometer)
The SPT (N value) is the sum of the last two blow values in each sampling zone (AASHTO T206)

BBS, form 137 (Rev. 8-99)

Page 1 of 1

Date 9/4/13

ROUTE	DESCRIPTION	LOGGED BY
1-57 (FAI 57)	Waldron Road over I-57, 3.4 miles North of US 45/52	Larry Myers

SECTION (46-3)R, HBR, 5HBR, 6HBR LOCATION SE 1/4, SEC. 4, TWP. 30N, RNG. 13W, 2nd PM.

COUNTY Kankakee DRILLING METHOD Hollow Stem Auger HAMMER TYPE CME Automatic

STRUCT. NO.	046-0080 (Exist.)	D	B	U	M	Surface Water Elev.	_____ ft
Station	230+53.99 (Exist.)	E	L	C	O	Stream Bed Elev.	_____ ft
		P	L	S	I		
BORING NO.	BH 69 (Pier)	T	O		S	Groundwater Elev.	_____ ft
Station	231+04.30	H	S	Qu	T	First Encounter	_____ Dry ft
Offset	2.2 ft Li.					Upon Completion	_____ Dry ft
Ground Surface Elev.	632.74 ft	(ft)	(ft)	(tsf)	(%)	After	_____ Hrs. ft

Augered Bituminous Shoulder & Tan Weathered & Reworked Dolomite			
630.24			
Dense Tan Weathered Dolomite	100/4	7	
629.24			
Auger Refusal @ 3.5' End of Boring			
-5			
-10			
-15			
-20			

The Unconfined Compressive Strength (UCS) Failure Mode is indicated by (B-Bulge, S-Shear, P-Penetrometer)
The SPT (N value) is the sum of the last two blow values in each sampling zone (AASHTO T206)

BBS, form 137 (Rev. 8-89)

Prairie Engineers, P.C.
www.prairieengineers.com
professional design firm no. 184-005965
© Copyright Prairie Engineers, P.C. 2018

USER NAME	=	DESIGNED	=	SMA	REVISED	=
		CHECKED	=	CMF/TCD	REVISED	=
PLOT SCALE	=	DRAWN	=	JLM	REVISED	=
PLOT DATE	=	CHECKED	=	SMA	REVISED	=

**STATE OF ILLINOIS
DEPARTMENT OF TRANSPORTATION**

SOIL BORINGS
STRUCTURE NO. 046-0153

SHEET 52 OF 54 SHEETS

F.A.I. RTE.	SECTION	COUNTY	TOTAL SHEETS	SHEET NO.
57	139HBR-6	KANKAKEE	202	141
		CONTRACT NO. 66997		
ILLINOIS		FED. AND PROTECT.		

ILLINOIS	FED. AND PROJECT
----------	------------------

MODEL: 0460153-66997-051-054
FILE NAME: h:\jobs\2019\193.1901 PTB 192-011 District 3 Various Phase III Structure Projects\WQ 2 - Waldron Road over I-57\Drawings\bridge substructure\Sheet\0460153-66997-051-054-BORINGS.dgn

3/11/2021 4:56:15 PM



ROCK CORE LOG

Page 1 of 1

Date 10/4/17

ROUTE <u>1-57 (FAI 57)</u>		DESCRIPTION <u>Waldron Road over I-57, 3.4 miles North of US 45/52</u>	LOGGED BY <u>Larry Myers</u>
----------------------------	--	--	------------------------------

SECTION (46-3)R, HBK, 5HBR, 6HBR LOCATION SE 1/4, SEC. 4, TWP. 30N, RNG. 13W, 2ND PM.

COUNTY Kankakee CORING METHOD Split Barrel Wire Line R CORE S

STRUCT. NO.	046-0080 (EX)	CORING BARREL TYPE & SIZE	N W/L 2	D E P T H	C O R E	C O V E R Y	Q U A L I T Y	T I M E	R E N G T H
Station	230+53.99 (EX)	Core Diameter	1.8 in						
BORING NO.	B 218 (Pier)	Top of Rock Elev.	830.07 ft						
Station	231+25.20	Begin Core Elev.	827.57 ft						
Offset	8.0 ft LI								
Ground Surface Elev.	832.57	ft		(ft)	(#)	(%)	(%)	(min/ft)	(tsf)

LOG CODE	LOG NO.	LOG DATE	LOG TIME	LOG LOCATION	LOG DESCRIPTION	LOG SCALE	LOG UNIT	LOG TYPE	LOG STATUS	LOG COMMENTS
Dense Gray & Tan Limestone, Horizontal Fractures with Loose Joints	627.57	1	95	26	2.4					535.5 691.7
Some Vertical Fracturing @ 8.5'	622.57	-10								
Dense Gray Limestone with Tight Joints, Oxidized Tan Color, Horizontal Fractures with some Vertical Fracturing	517.57	2	100	45	3.2					839.7 770.5 696.5
Dense Gray Limestone, some Horizontal Fractures with Tight Joints	612.57	3	100	87	2.8					817.2 1453.7 1077.7 1022.4 866.7 1086.6
End of Boring	612.57	-20								

Color pictures of the cores Yes
 Cores will be stored for examination until Construction Complete
 The "Strength" column represents the uniaxial compressive strength of the core sample (ASTM D-2938)
 BBS, form 138 (Rev. 8-89)

MODEL: 0460153-66997-051-054
FILE NAME: I:\Jobs\2019\193\1901 PTB 192-011 District 3 Various Phase III Structure Projects\WO 2 - Waldron Road over I-57\Drawings\Bldg substructure\Sheet\0460153-66997-051-054-BORINGS.dgn
3/11/2021 4:57:19 PM

(Waldron rd.)
21+78.11
24.4' LT

(Waldron rd.)
21+70.80
11.3' LT

(Waldron rd.)
21+70.80
11.3' LT



Illinois Department
of Transportation
Division of Highways
IDOT

SOIL BORING LOG

Page 1 of 1

Date 9/12/13

ROUTE I-57 (FAI 57) DESCRIPTION Waldron Road over I-57, 3.4 miles North of US 45/52 LOGGED BY Larry Myers

SECTION (46-3)R, HBR, 5HBR, 6HBR LOCATION SE 1/4, SEC. 4, TWP. 30N, RNG. 13W, 2nd PM, Latitude 41.107886, Longitude -87.834855

COUNTY Kankakee DRILLING METHOD Hollow Stem Auger HAMMER TYPE CME Automatic

STRUCT. NO.	046-0080 (Exist.)	DEPT	BLOW	UCS	MOIST	Surface Water Elev.
Station	230+53.99 (Exist.)	H	S	Qu	T	Stream Bed Elev.
BORING NO.	BH 71 (E. Abut.)	(ft)	(ft)	(tsf)	(%)	Groundwater Elev.:
Station	232+11.23					First Encounter
Offset	148.3 ft LI					Upon Completion
Ground Surface Elev.	647.42 ft					After Hrs.
Augered Shoulder Stone, Brown Silty Clay Loam Fill						
644.92						
Hard Brown Silty Clay Loam Till Fill						
3						
4						
5						
-5						
3						
2						
3						
639.92						
Stiff to Very Stiff Brown Silty Clay/Silty Clay Loam						
2						
2						
637.92						
Stiff to Very Stiff Brown Silty Clay Loam Till						
2						
2						
634.92						
Weathered & Reworked Dolomite Surface						
30						
15						
12						
632.42						
Dense Tan/Orange Dolomite						
632.12						
Auger Refusal						
End of Boring						
-20						

The Unconfined Compressive Strength (UCS) Failure Mode is indicated by (B-Bulge, S-Shear, P-Penetrometer)
The SPT (N value) is the sum of the last two blow values in each sampling zone (AASHTO T206)

BBS, form 137 (Rev. 8-99)



Illinois Department
of Transportation
Division of Highways
IDOT

SOIL BORING LOG

Page 1 of 1

Date 9/8/17

ROUTE I-57 (FAI 57) DESCRIPTION Waldron Road over I-57, 3.4 miles North of US 45/52 LOGGED BY Larry Myers

SECTION (46-3)R, HBR, 5HBR, 6HBR LOCATION SE 1/4, SEC. 4, TWP. 30N, RNG. 13W, 2nd PM, Latitude 41.107886, Longitude -87.83471

COUNTY Kankakee DRILLING METHOD Hollow Stem Auger HAMMER TYPE CME Automatic

STRUCT. NO.	046-0080 (EX)	DEPT	BLOW	UCS	MOIST	Surface Water Elev.
Station	230+53.99 (EX)	H	S	Qu	T	Stream Bed Elev.
BORING NO.	B 217 (S. Abut.)	(ft)	(ft)	(tsf)	(%)	Groundwater Elev.:
Station	232+12.99					First Encounter
Offset	133.4 ft LI					Upon Completion
Ground Surface Elev.	648.76 ft					After Hrs.
Augered Material - Not Documented						
-5						
-10						
-15						
632.76						
Borehole continued with rock coring.						
-20						

The Unconfined Compressive Strength (UCS) Failure Mode is indicated by (B-Bulge, S-Shear, P-Penetrometer)
The SPT (N value) is the sum of the last two blow values in each sampling zone (AASHTO T206)

BBS, form 137 (Rev. 8-99)



Illinois Department
of Transportation
Division of Highways
IDOT

ROCK CORE LOG

Page 1 of 1

Date 9/8/17

ROUTE I-57 (FAI 57) DESCRIPTION Waldron Road over I-57, 3.4 miles North of US 45/52 LOGGED BY Larry Myers

SECTION (46-3)R, HBR, 5HBR, 6HBR LOCATION SE 1/4, SEC. 4, TWP. 30N, RNG. 13W, 2nd PM, Latitude 41.107886, Longitude -87.83471

COUNTY Kankakee CORING METHOD Split Barrel Wire Line

STRUCT. NO.	046-0080 (EX)	CORING BARREL TYPE & SIZE	N W/L 2	DEPT	CORE	RECOVER	R.Q.D.	CORE	STRENGTH
Station	230+53.99 (EX)			(ft)	(ft)	(%)	(%)	(min/ft)	(tsf)
BORING NO.	B 217 (S. Abut.)	Core Diameter	1.9 in						
Station	232+12.99	Top of Rock Elev.	632.76 ft						
Offset	133.4 ft LI	Begin Core Elev.	632.76 ft						
Ground Surface Elev.	648.76 ft								
Tan Dolomite Highly Horizontally Fractured with most Seams Filled with Weathered Shale, Loose Joints									
632.76									
Tan to Gray Dolomite - Horizontally Fractured with Loose Joints, some Vertical Fractures									
627.76									
Gray Limestone with some Loose Horizontal Fracturing and Heavy Vertical Fracturing, Horizontal Joints are Oxidized Tan Color									
622.76									
End of Boring									
617.76									
-30									
-35									

Color pictures of the cores Yes
Cores will be stored for examination until Construction Complete
The "Strength" column represents the uniaxial compressive strength of the core sample (ASTM D-2938)
BBS, form 138 (Rev. 8-99)

Prairie Engineers, P.C.
www.prairieengineers.com
professional design firm no. 184-005965
© Copyright Prairie Engineers, P.C. 2011

USER NAME	DESIGNED - SMA	REVISED -
PLOT SCALE	CHECKED - CMF/TCD	REVISED -
PLOT DATE	DRAWN - JLM	REVISED -
	CHECKED - SMA	REVISED -

STATE OF ILLINOIS
DEPARTMENT OF TRANSPORTATION

SOIL BORINGS
STRUCTURE NO. 046-0153

FAI RTE.	SECTION	COUNTY	TOTAL SHEETS	SHEET NO.
57	139HBR-6	KANKAKEE	202	143
CONTRACT NO. 66997				
ILLINOIS FED. AID PROJECT				

3/18/2021 7:03:53 PM

Bench Mark: BM4 Cut square on North Headwall at entrance to Faith Reformed Church located at 2400 Waldron Road. El. 634.41 Traffic to be maintained utilizing staged construction coordinated with bridge construction.



DESIGN SPECIFICATIONS

2017 AASHTO LRFD Bridge Design Specifications, 8th Edition


DESIGN STRESSES

FIELD UNITS

$f'_c = 3,500$ psi (Cast-In-Place Facing & Soldier Pile Encasement)
 $f_y = 60,000$ psi (Reinforcement)
 $f_y = 50,000$ psi (AASHTO M270 Gr. 50) (Soldier Pile)

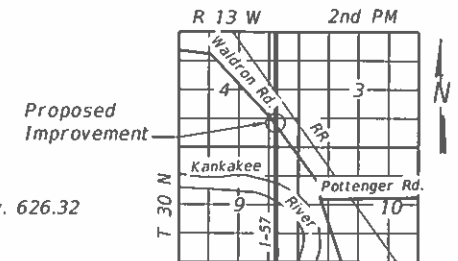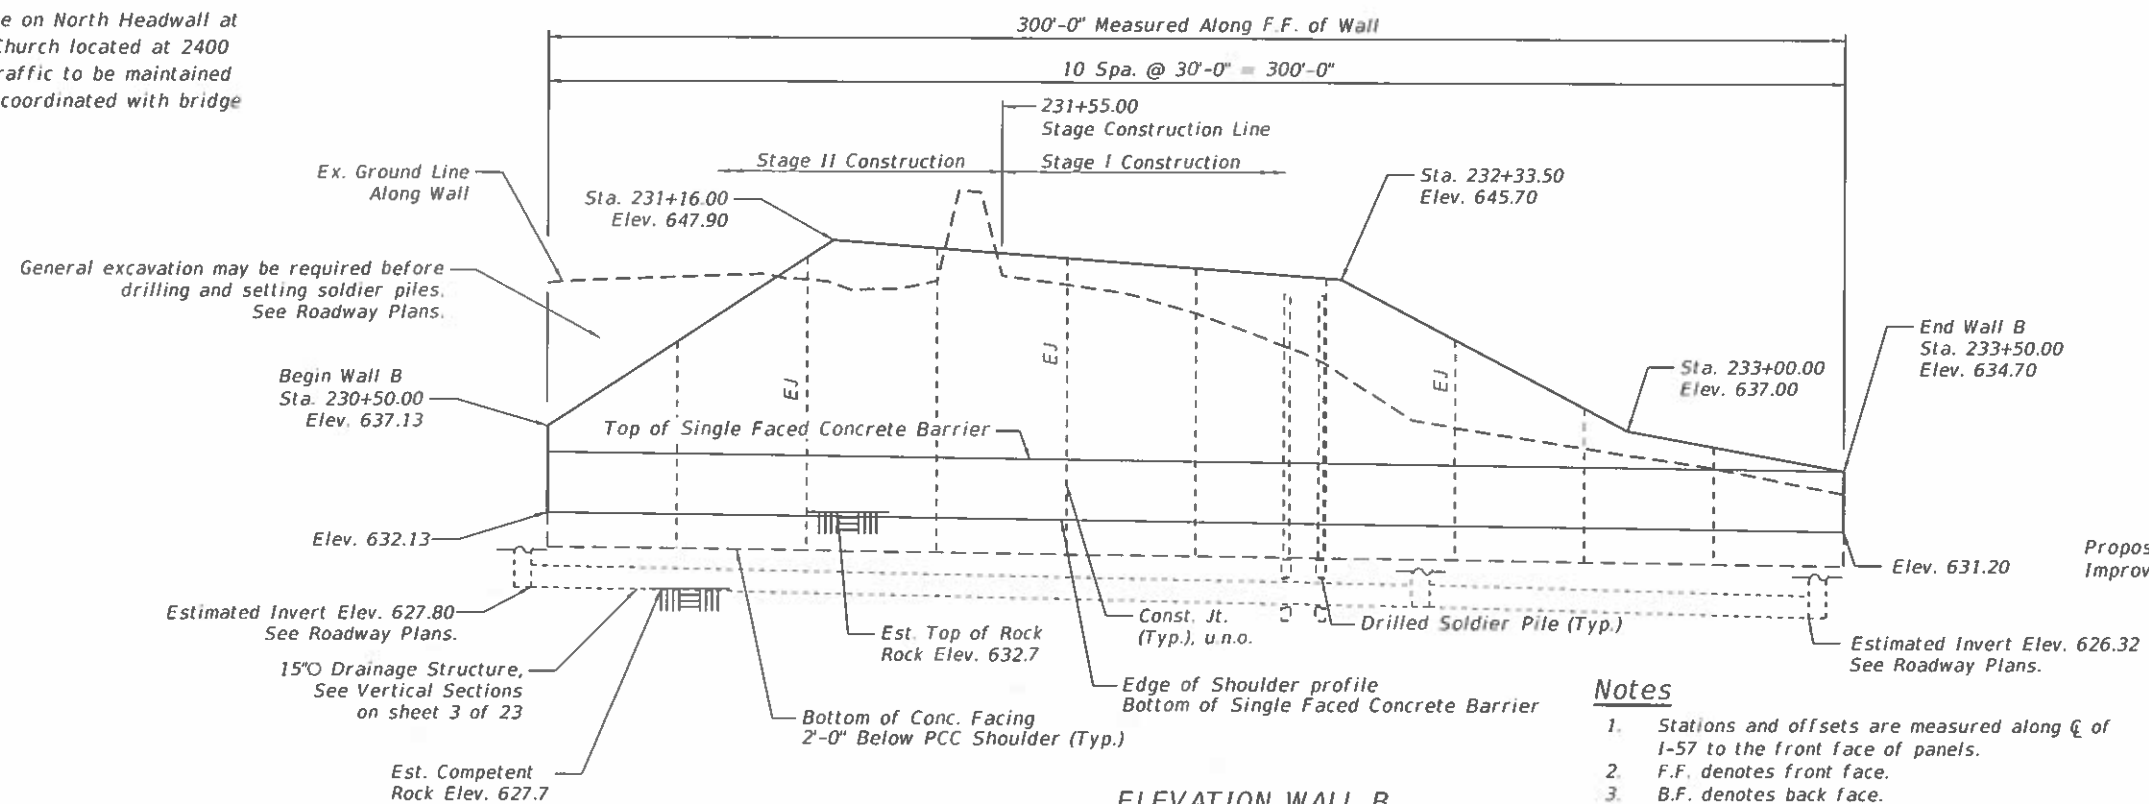

LOCATION SKETCH

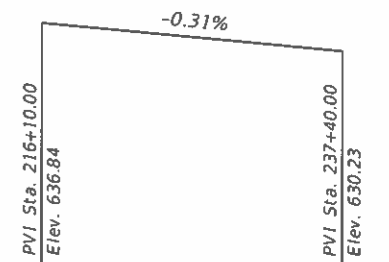


PROFILE GRADE I-57

Notes

- Stations and offsets are measured along ϕ of I-57 to the front face of panels.
- F.F. denotes front face.
- B.F. denotes back face.
- See Highway plans for Concrete Barrier, Guardrail, and Transitions.

ELEVATION WALL B

(Looking East at Front Face of Wall)

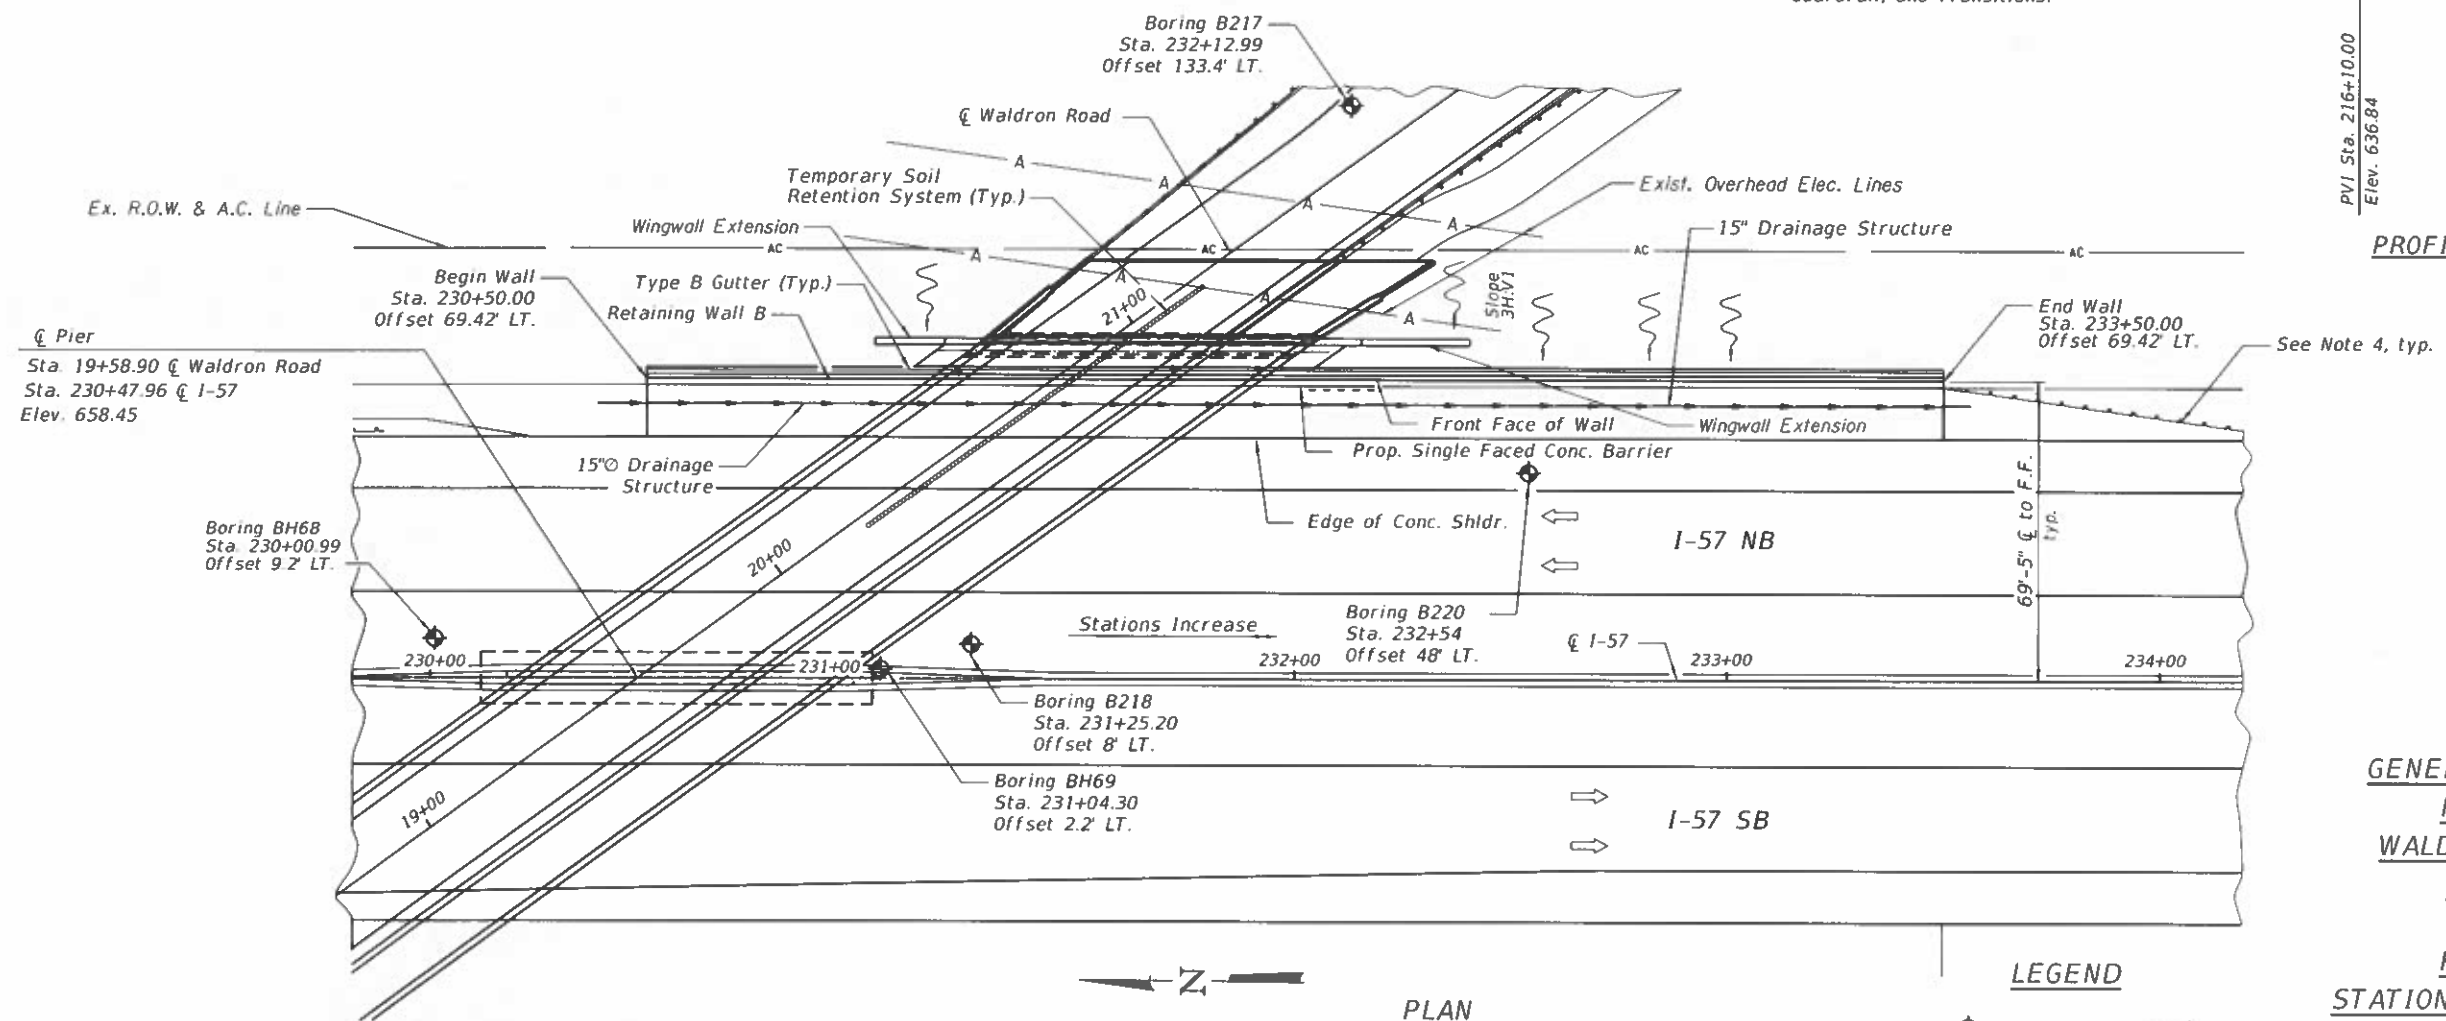

LEGEND

Soil Boring Location

GENERAL PLAN & ELEVATION

RETAINING WALL B

WALDRON ROAD F.A.U. 6184

OVER I-57 FAI-57

SEC. 139HBR-6

KANKAKEE COUNTY

STATION 230+50.00 TO 233+50.00

STRUCTURE NO. 046-0153

Prairie Engineers, P.C.
 www.prairieengineers.com
 professional design firm no. 184-005965
 Copyright Prairie Engineers, P.C. 2020

USER NAME	DESIGNED - RHC	REVISED -
CHECKED - CMF	REVISED -	
DRAWN - JLM	REVISED -	
CHECKED - SMA	REVISED -	

STATE OF ILLINOIS
 DEPARTMENT OF TRANSPORTATION

GENERAL PLAN & ELEVATION RETAINING WALL B
 STRUCTURE NO. 046-0153

SHEET 2 OF 23 SHEETS

SECTION	COUNTY	TOTAL SHEETS	SHEET NO.
139HBR-6	KANKAKEE	202	145
CONTRACT NO. 66997			

ILLINOIS FED. AID PROJECT

MODEL: 0460153-66997-002
 FILE NAME: I:\Jobs\2019\1931901 PTB 192-011 District 3 Various Phase III Structure Projects\W0 2 - Waldron Road over I-57\Drawings\wall B\Sheet\0460153-66997-002-wall B QPE.dgn
 3/18/2021 3:58:08 PM

SN 046-0153 SEQUENCE OF WORK

Stage I

- Erect Waldron Road Stage I traffic control, install temporary soil retention systems behind existing abutments, and remove stage I superstructure and roadway.
- Erect I-57 Stage I traffic control, remove Stage I of existing middle pier, and construct Stage I of new median pier.
- Set Stage I soldier piles for Walls A & B.
- Remove top block of existing abutments down to top of buttresses while installing timber lagging for the soldier pile walls. (The bottom of the "existing block" at the north abutment will be 2" +/- higher than the bottom of the proposed north abutment. The bottom of the "existing block" at the south abutment will be 4" +/- lower than the bottom of the proposed south abutment.)
- Construct Stage I work for new abutments.
- Construct Stage I superstructure and approach pavements. (The bottom of the proposed girders will be above the top of pier elevation of the existing outside piers.)

Stage II


- Erect Waldron Road Stage II traffic control and remove stage II superstructure and roadway.
- Maintain I-57 Stage I traffic control, remove Stage II of existing middle pier, and construct Stage II of new median pier.
- Set Stage II soldier piles for Walls A & B.
- Remove top block of existing abutments down to top of buttresses while installing timber lagging for the soldier pile walls.
- Construct Stage II work for new abutments.
- Erect I-57 Stage II traffic control and remove existing outside piers.
- Remove remainder of existing abutments while installing timber lagging for the soldier pile walls and removing soil between the new soldier pile wall and the existing outside piers.
- Pour facing for soldier pile walls.
- Construct Stage II superstructure and approach pavements.

Stage III

- Erect Waldron Road Stage III traffic control.
- Construct barrier wall between roadway and shared use path.
- Install Bridge Fence Railing on outside parapet.
- Open Waldron Road to normal traffic and continue I-57 work below the bridge. (i.e., storm sewers parallel to soldier pile walls.)


TOTAL BILL OF MATERIAL

ITEM	UNIT	Wall A	Wall B	TOTAL
Structure Excavation	Cu. Yd.	833	438	1,271
Stud Shear Connectors	Each	1,615	706	2,321
Reinforcement Bars, Epoxy Coated	Pound	52,950	29,370	82,320
Furnishing Soldier Piles (W Section)	Foot	2,390	856	3,246
Drilling and Setting Soldier Piles (In Soil)	Cu. Ft.	8,739	1,987	10,726
Drilling and Setting Soldier Piles (In Rock)	Cu. Ft.	3,593	2,488	6,081
Untreated Timber Lagging	Sq. Ft.	6,234	3,345	9,579
Concrete Structures	Cu. Yd.	277.6	146.2	423.8
Concrete Sealer	Sq. Ft.	8,395	4,398	12,793
Geocomposite Wall Drain	Sq. Yd.	473	266	739
Pipe Underdrains for Structures 4 inch	Foot	660	360	1,020

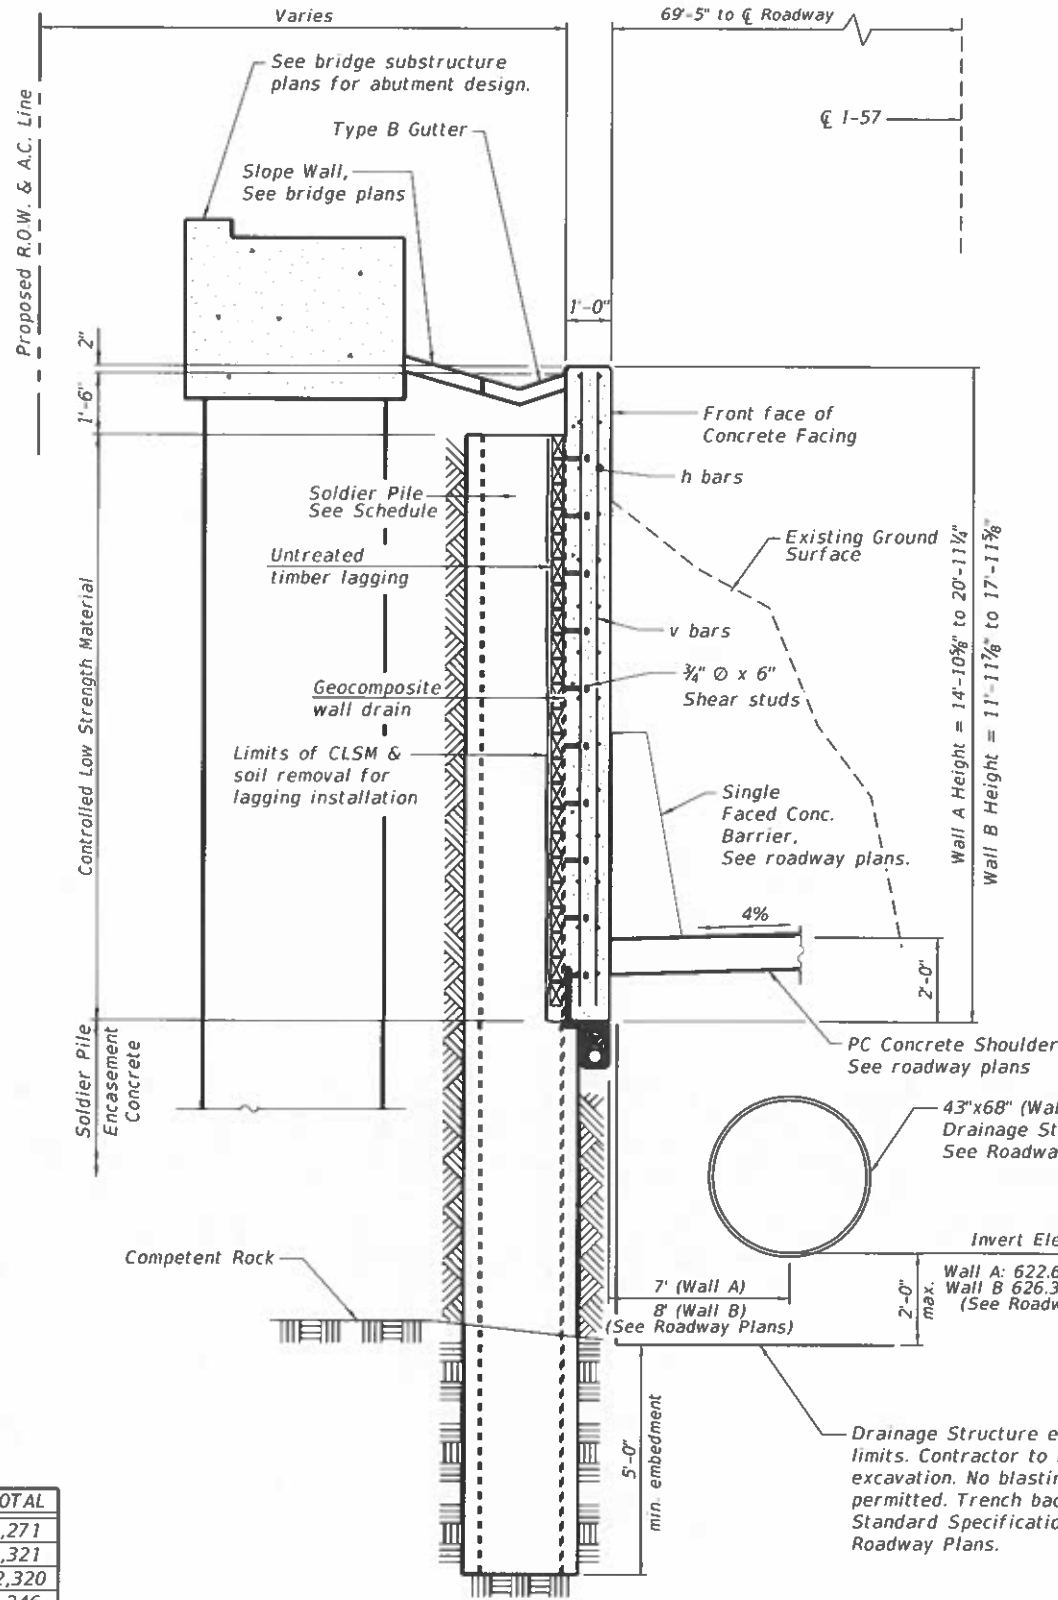

VERTICAL SECTION THRU
DRILLED SOLDIER PILE WALL
WITH TYPE "B" GUTTER

Wall A Sta. 228+40 to 230+50
Wall B Sta. 230+80 to 232+60

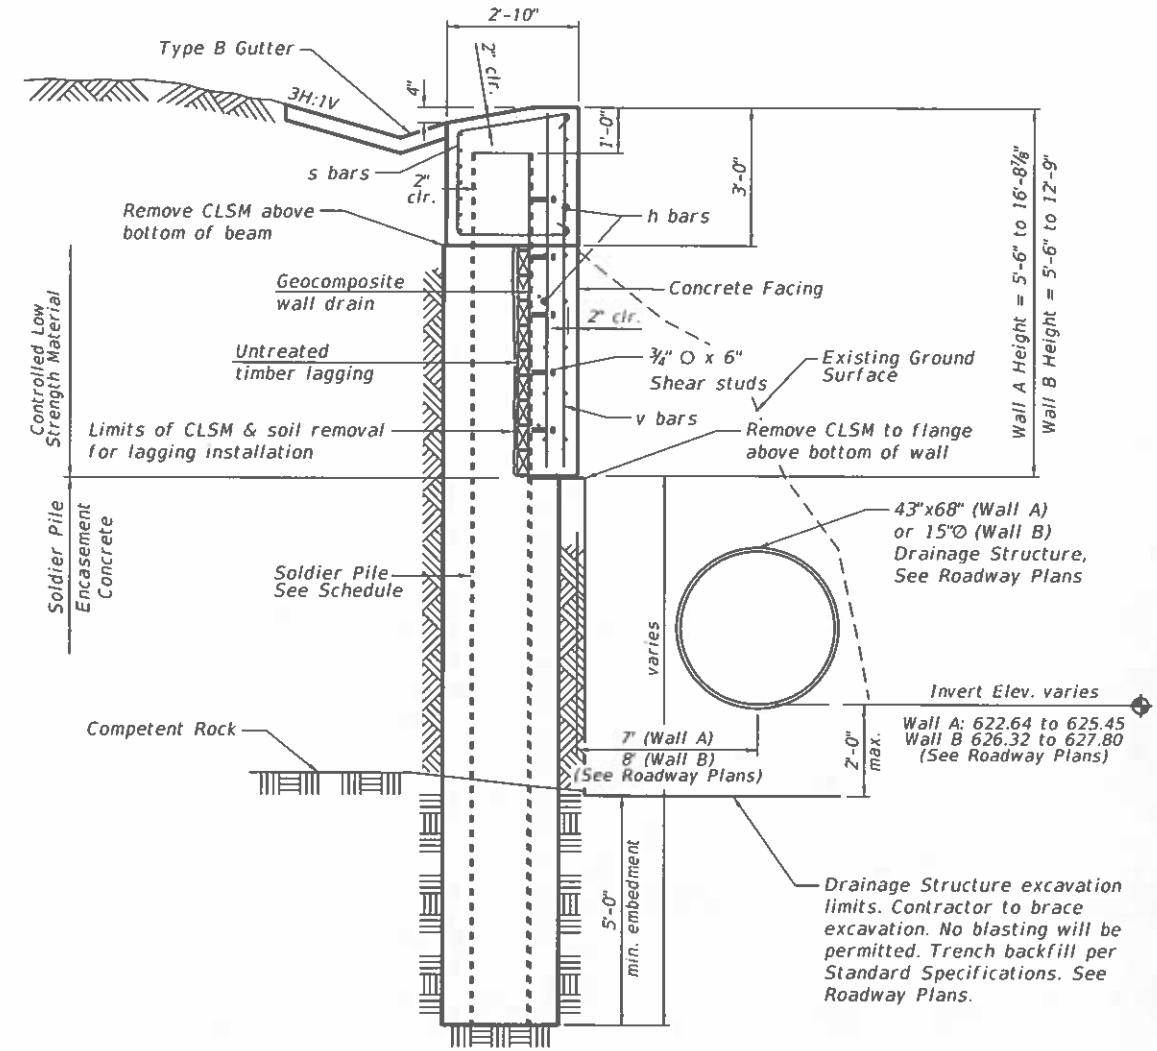

VERTICAL SECTION THRU
DRILLED SOLDIER PILE WALL
WITH BEAM

Wall A Sta. 227+50 to 228+40 & Sta. 230+50 to 233+50
Wall B Sta. 230+50 to 230+80 & Sta. 232+60 to 233+50

GENERAL NOTES

- No field welding is permitted except as specified in the contract documents.
- Reinforcement bars designated (E) shall be epoxy coated.
- Concrete Sealer shall be applied to all exposed surfaces of the wall, including front face, top and exposed back face, and shall extend 1'-0" minimum below finished grade.
- Chamfers on vertical surfaces shall be continued a minimum of 2'-0" below finished ground level.
- The Contractor is responsible for the design and performance of the lagging using no less than 3" nominal rough sawn thickness and timber with an allowable bending stress of 1000 psi.
- A cantilevered sheet piling design does not appear feasible and additional members or other retention systems may be necessary. The Contractor shall submit a temporary soil retention system design including plan details and calculations for review and acceptance by the Engineer. See bridge plans for S.N. 046-0153 for additional details regarding Temporary Soil Retention Systems including quantity. A single design shall be used for construction of the Bridge and Walls A and B. Connection of retention system to the soldier pile walls if required shall be coordinated in the design.

STATE OF ILLINOIS
DEPARTMENT OF TRANSPORTATION


GENERAL NOTES, SEQUENCE OF CONSTRUCTION,
& TOTAL BILL OF MATERIAL
STRUCTURE NO. 046-0153

FAI RTE.	SECTION	COUNTY	TOTAL SHEETS	SHEET NO.
57	139HBR-6	KANKAKEE	202	146
CONTRACT NO. 66997				

Prairie Engineers, P.C.
www.prairieengineers.com
professional design firm no. 184-005965
© Copyright Prairie Engineers, P.C. 2020

USER NAME	DESIGNED - RHC	REVISED -
PLOT SCALE	CHECKED - CMF	REVISED -
PLOT DATE	DRAWN - JLM	REVISED -
	CHECKED - SMA	REVISED -

MODEL: 0460153-66997-004
FILE NAME: I:\0460153\193\1931.PTB 192-011 District 3 Various Phase III Structure Projects\SWO 2 - Waldron Road over I-57\Drawings\Wall A\Sheet\0460153-66997-004-Wall A Plan-Sheets.dgn
3/18/2021 3:31:13 PM

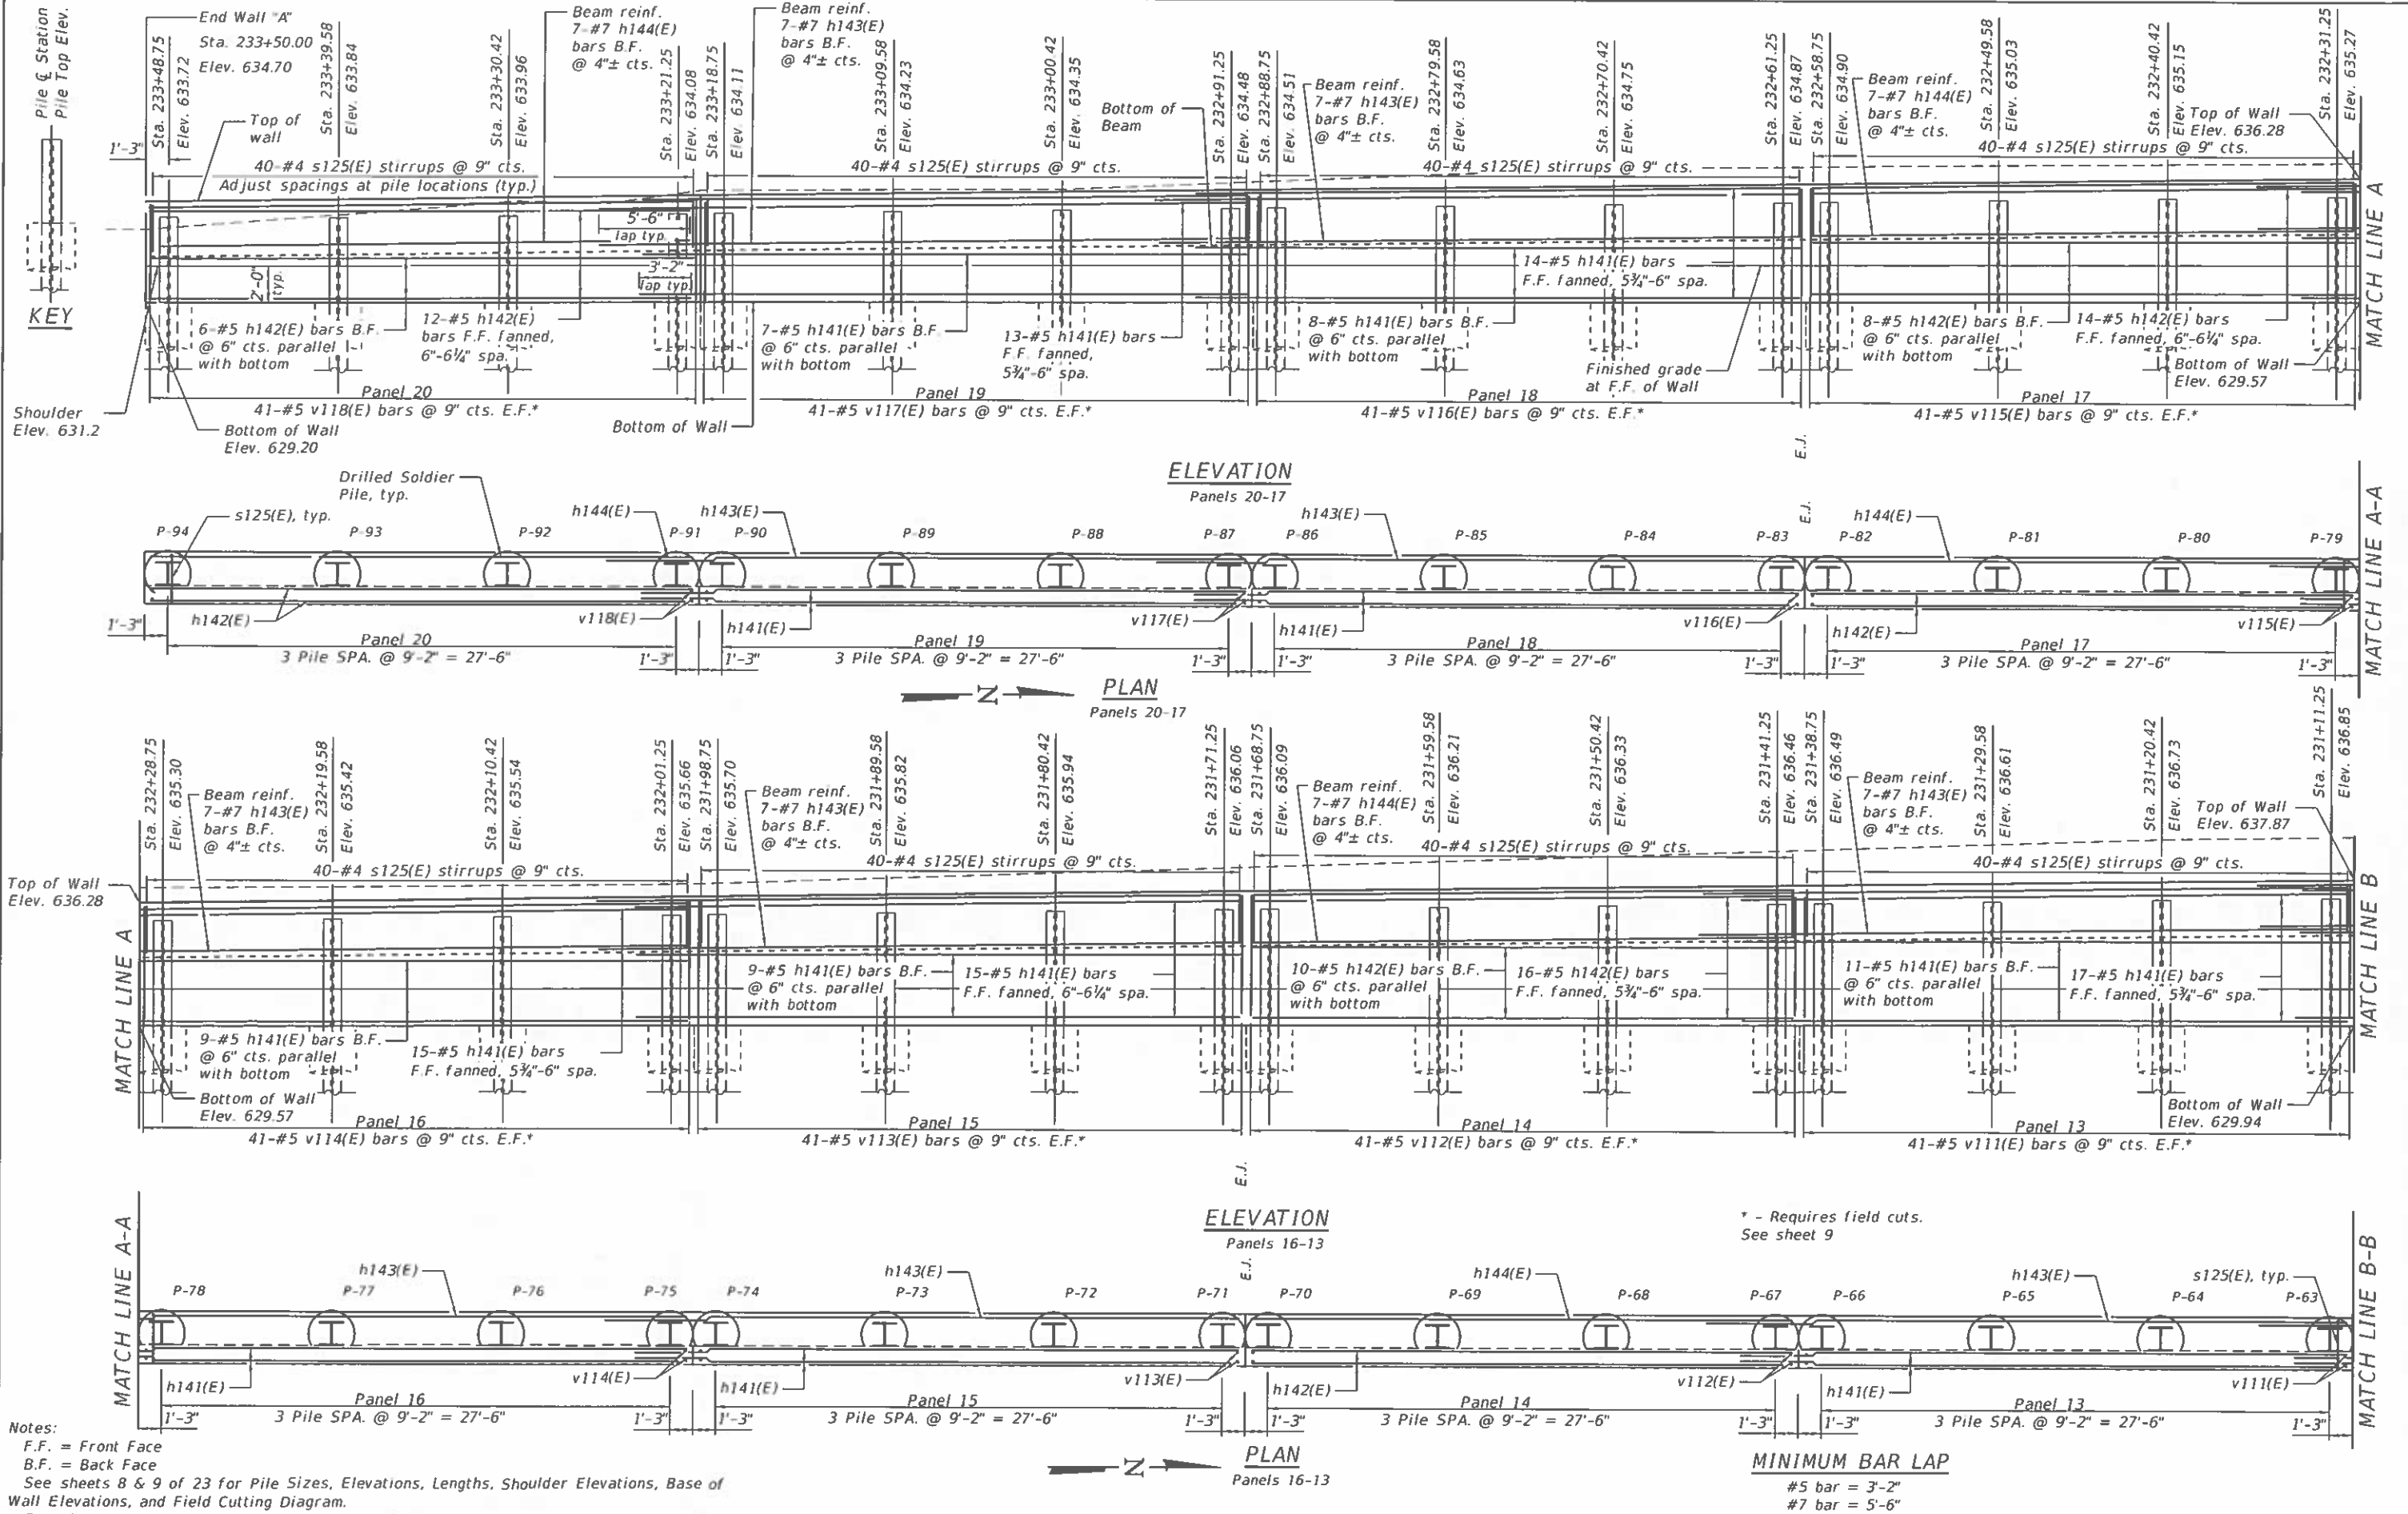

Notes:
F.F. = Front Face
B.F. = Back Face
See sheets 8 & 9 of 23 for Pile Sizes, Elevations, Lengths, Shoulder Elevations, Base of Wall Elevations, and Field Cutting Diagram.
See sheets 14-15 of 23 for Sections and Details. See sheet 5 of 23 for S bar details.

Prairie Engineers, P.C.
www.prairieengineers.com
professional design firm no. 184-005965
© Copyright Prairie Engineers, P.C. 2020

USER NAME	DESIGNED - RHC	REVISED -
PLOT SCALE	CHECKED - CMF	REVISED -
PLOT DATE	DRAWN - JLM	REVISED -
	CHECKED - SMA	REVISED -


STATE OF ILLINOIS
DEPARTMENT OF TRANSPORTATION

WALL A PLAN AND ENLARGED ELEVATIONS
STRUCTURE NO. 046-0153

SHEET 4 OF 23 SHEETS

SECTION	COUNTY	TOTAL SHEETS	SHEET NO.
139HBR-6	KANKAKEE	202	147
CONTRACT NO. 66997			


MODEL: 0460153-66997-005
FILE NAME: I:\Jobs\2019\133.1901.PTB 192-011 District 3 Various Phase III Structure Projects\W0 2 - Waldron Road over I57\Drawing\Wall A\Sheet\0460153-66997-004-007-wall A Plan-sheets.dgn
3/18/2021 3:39:47 PM

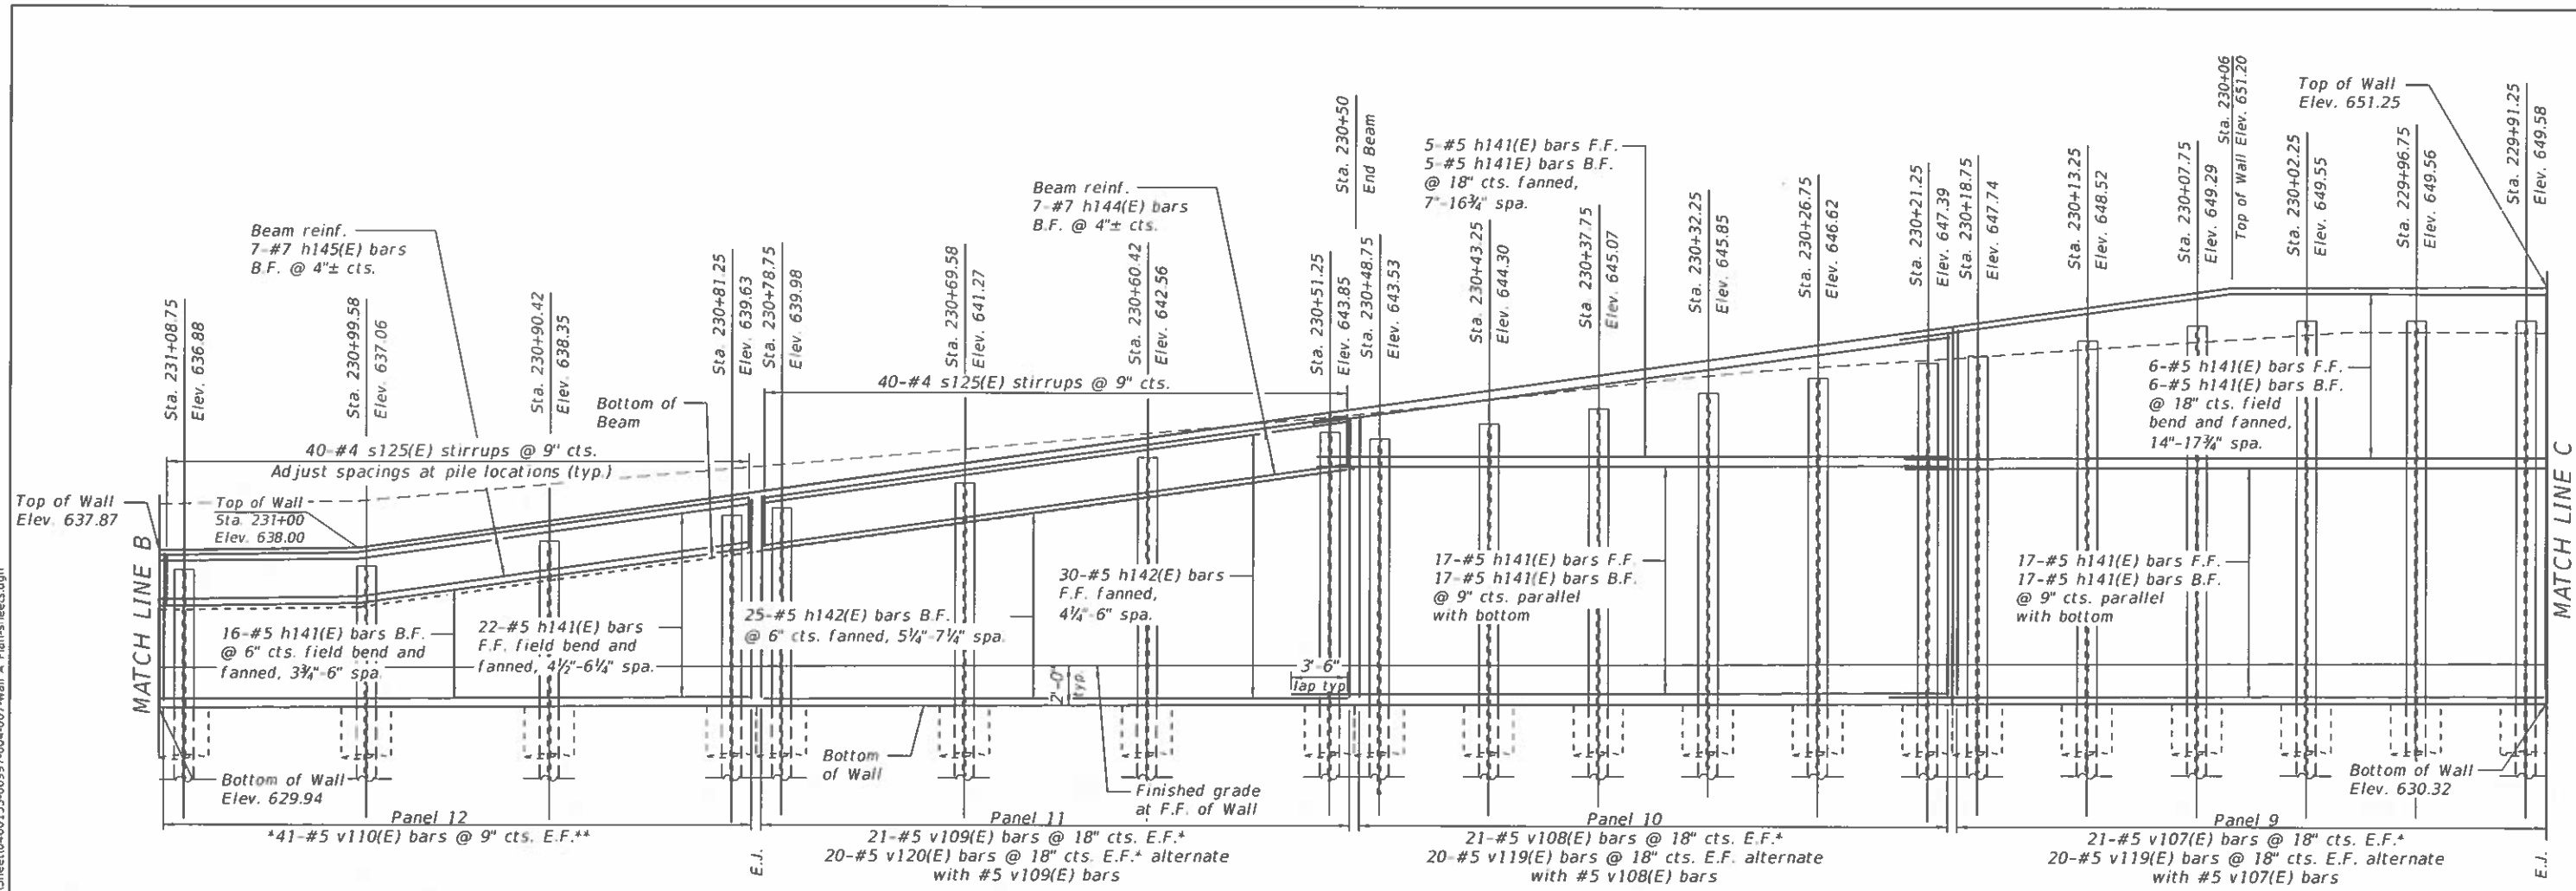

ELEVATION
Panels 12-9

** - After cutting bars to length per the cutting diagram, trim to fit as needed.

* - Requires field cuts. See sheet 9

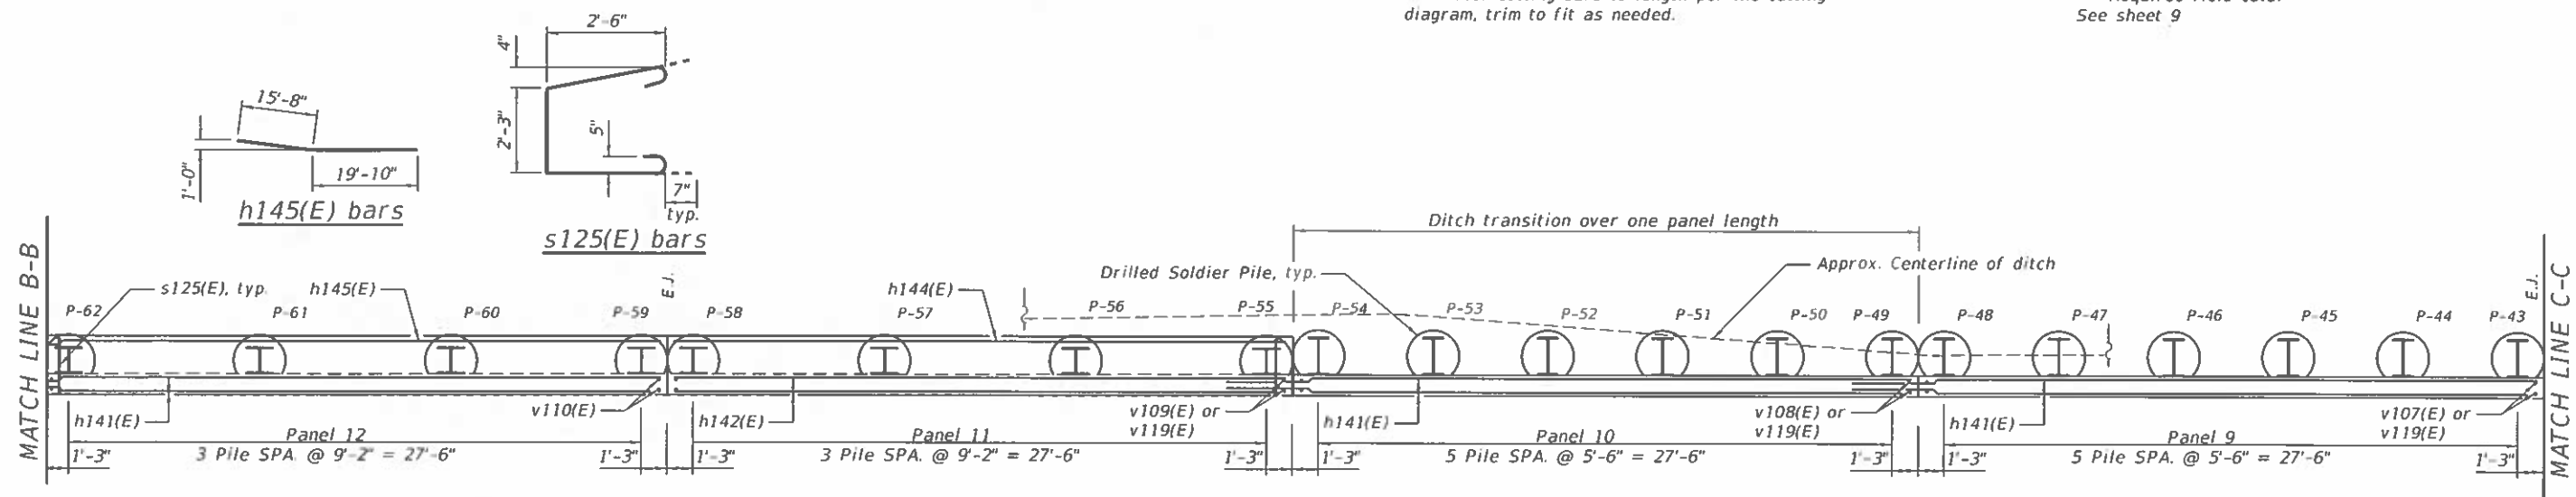

Notes:
F.F. = Front Face
B.F. = Back Face
See sheets 8 & 9 of 23 for Pile Sizes, Elevations, Lengths, Shoulder Elevations, Base of Wall Elevations, and Field Cutting Diagram.
See sheets 14-15 of 23 for Sections and Details. See sheet 5 of 23 for S bar details.

PLAN
Panels 12-9

MINIMUM BAR LAP
#5 bar = 3'-2"
#7 bar = 5'-6"

Prairie Engineers, P.C.
www.prairieengineers.com
Professional design firm no. 184-005965
© Copyright Prairie Engineers, P.C. 2020

USER NAME	DESIGNED	RHC	REVISED
PLOT SCALE	CHECKED	CMF	REVISED
PLOT DATE	DRAWN	JLM	REVISED
	CHECKED	SMA	REVISED


STATE OF ILLINOIS
DEPARTMENT OF TRANSPORTATION

WALL A PLAN AND ENLARGED ELEVATIONS
STRUCTURE NO. 046-0153


SHEET 5 OF 23 SHEETS

F.A.I. RTE.	SECTION	COUNTY	TOTAL SHEETS	SHEET NO.
57	139HBR-6	KANKAKEE	202	148
CONTRACT NO. 66997				
ILLINOIS FED. AID PROJECT				

MODEL: 0460153-66997-006
FILE NAME: I:\Jobs\2019\153.1901 PTB 192-011 District 3 Various Phase III Structure Projects\W0 2 - Waldron Road over I-57\Drawings\Wall A\Sheet\0460153-66997-004-007-wall A Plan-sheets.dgn

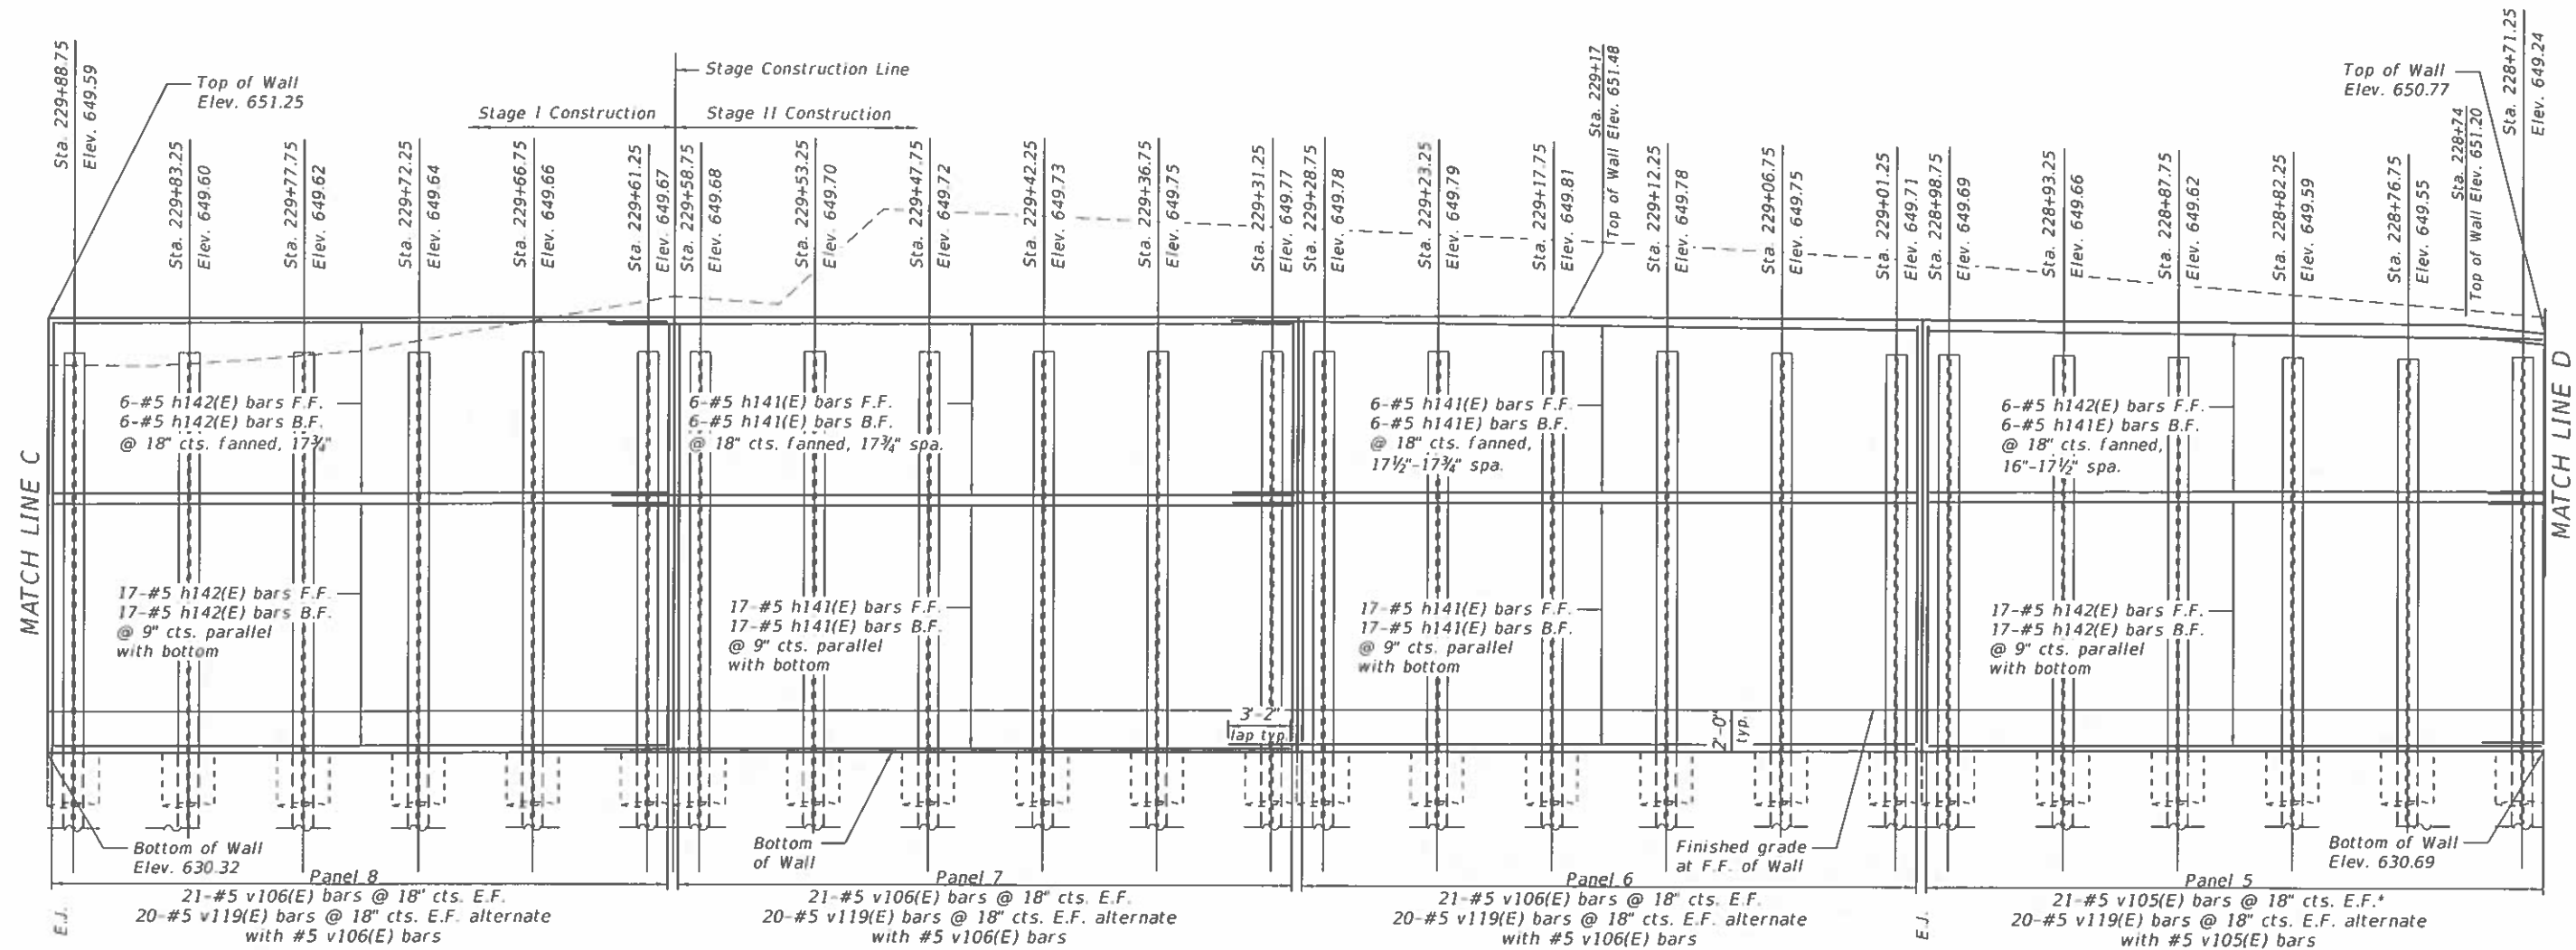

ELEVATION
Panels 8-5

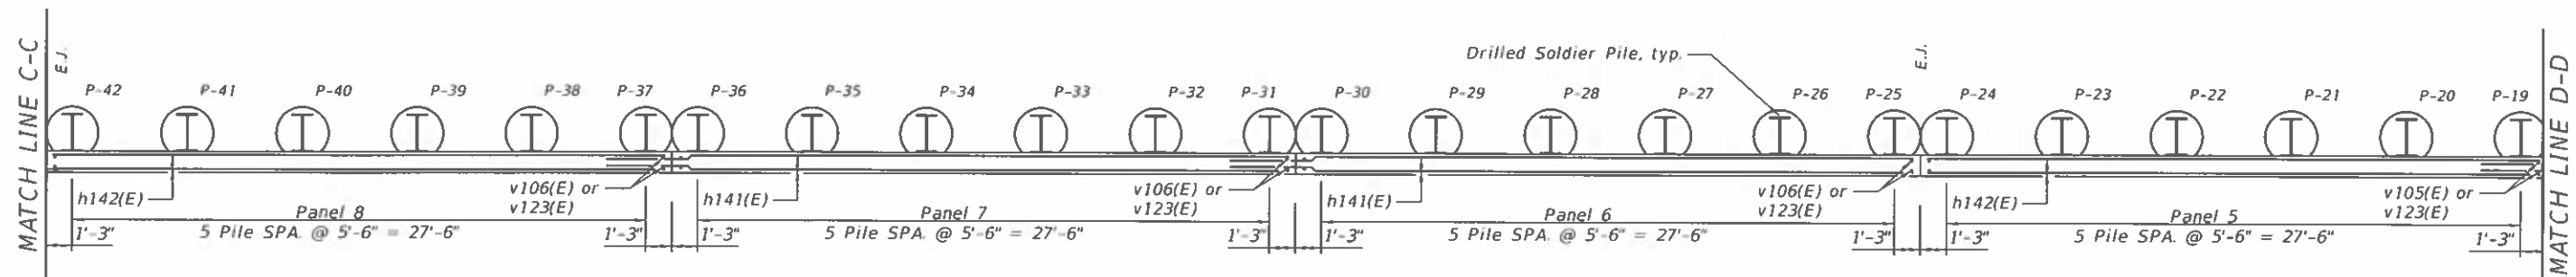

MINIMUM BAR LAP
#5 bar = 3'-2"

Notes:
F.F. = Front Face
B.F. = Back Face
See sheets 8 & 9 of 23 for Pile Sizes, Elevations, Lengths, Shoulder Elevations, Base of Wall Elevations, and Field Cutting Diagram.
See sheets 14-15 of 23 for Sections and Details. See sheet 5 of 23 for S bar details.

Prairie Engineers, P.C.
www.prairieengineers.com
professional design firm no. 184-005965
© Copyright Prairie Engineers, P.C. 2020

USER NAME	*	DESIGNED	RHC	REVISED	-
PLOT SCALE	*	CHECKED	CMF	REVISED	-
PLOT DATE	*	DRAWN	JLM	REVISED	-
		CHECKED	SMA	REVISED	-

STATE OF ILLINOIS
DEPARTMENT OF TRANSPORTATION


WALL A PLAN AND ENLARGED ELEVATIONS
STRUCTURE NO. 046-0153

SHEET 6 OF 23 SHEETS

F.A.I. RTE.	SECTION	COUNTY	TOTAL SHEETS	SHEET NO.
57	139HBR-6	KANKAKEE	202	149
CONTRACT NO. 66997				


ILLINOIS FED. AID PROJECT

MODEL: 0460153-66997-007
FILE NAME: I:\Jobs\2019\193-1901 PTB 192-011 Dist'ct 3 Various Phase III Structure Projects\W0 2 - Waldron Road over I-57\Drawings\wall A\Sheet\0460153-66997-004-007-wall A Plan-sheets.dgn
3/18/2021 3:37:54 PM

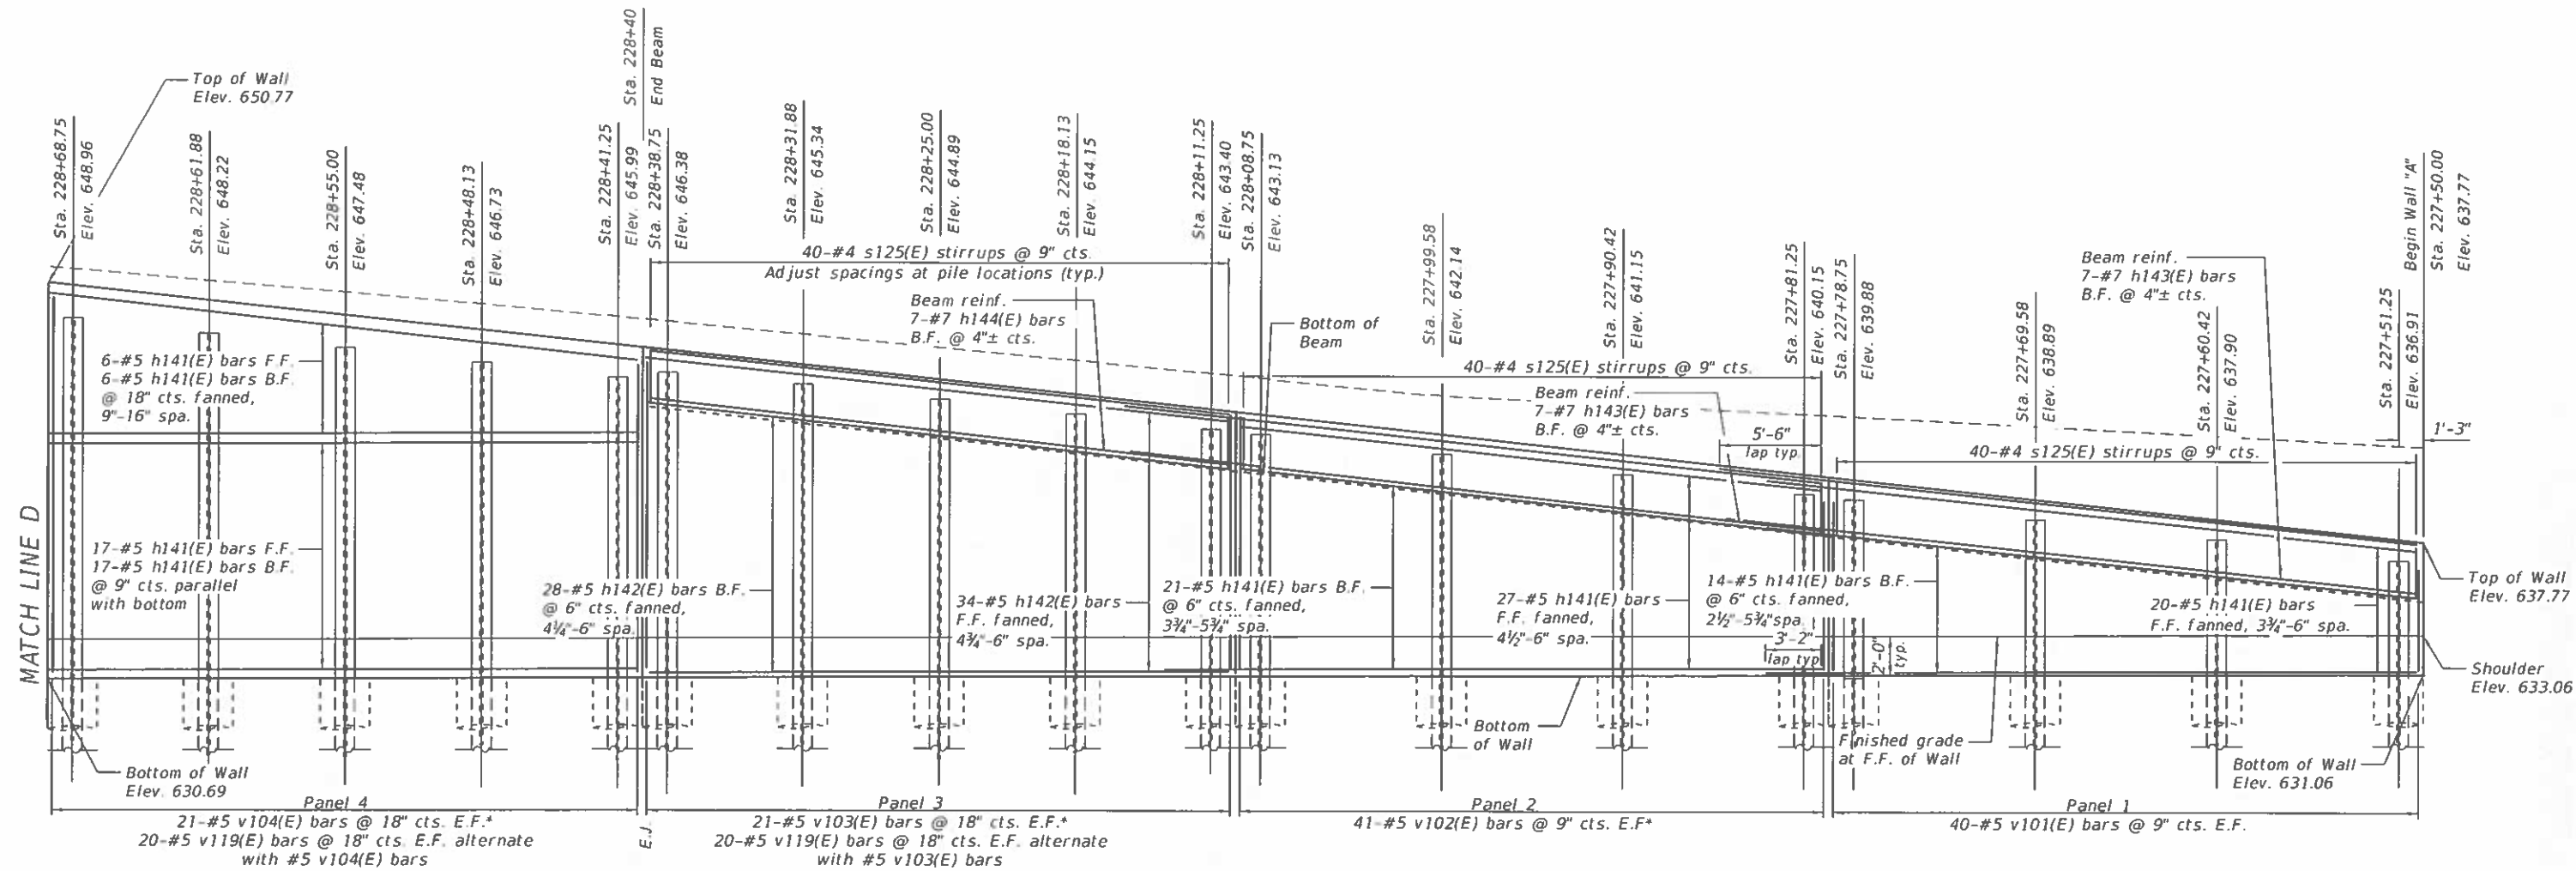

ELEVATION
Panels 4-1

* - Requires field cuts.
See sheet 9

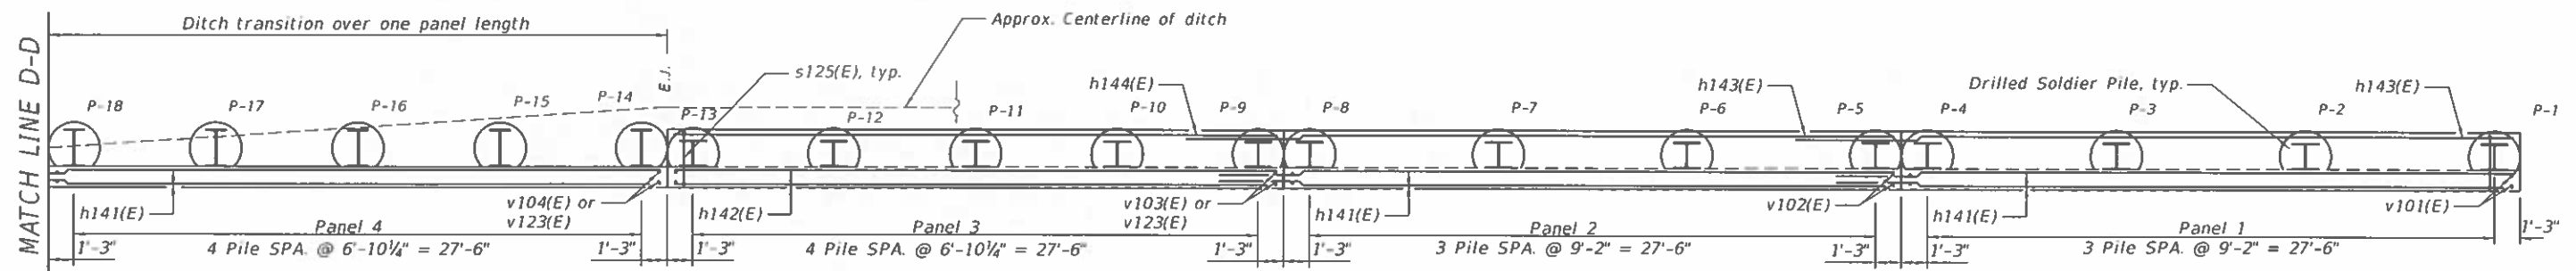

Notes:
F.F. = Front Face
B.F. = Back Face
See sheets 8 & 9 of 23 for Pile Sizes, Elevations, Lengths, Shoulder Elevations, Base of Wall Elevations, and Field Cutting Diagram.
See sheets 14-15 of 23 for Sections and Details. See sheet 5 of 23 for S bar details.

PLAN
Panels 4-1

MINIMUM BAR LAP
#5 bar = 3'-2"
#7 bar = 5'-6"

Prairie Engineers, P.C.
www.prairieengineers.com
Professional design firm no. 184-005965
© Copyright Prairie Engineers, P.C. 2020

USER NAME	DESIGNED	RMC	REVISED	
	CHECKED	CMF	REVISED	
PLOT SCALE	DRAWN	JLM	REVISED	
PLOT DATE	CHECKED	SMA	REVISED	

STATE OF ILLINOIS
DEPARTMENT OF TRANSPORTATION

WALL A PLAN AND ENLARGED ELEVATIONS
STRUCTURE NO. 046-0153

SHEET 7 OF 23 SHEETS

FILE	SECTION	COUNTY	TOTAL SHEETS	SHEET NO.
57	139HBR-6	KANKAKEE	202	150
CONTRACT NO. 66997				

ILLINOIS FED. AID PROJECT

MODEL: 0460153-66997-008
FILE NAME: I:\jobs\2019\193.1901 PTB 192-011 District 3 Various Phase III Structure Projects\WO 2 - Waldron Road over I-57\Drawings\wall A\SHEET\0460153-66997-008-wall A schedule sheet.dgn
3/18/2021 3:40:58 PM

SOLDIER PILE NUMBER	SOLDIER PILE STATION	OFFSET	EDGE OF SHOULDER ELEVATION	TOP OF PILE ELEVATION	TOP OF WALL ELEVATION	BOTTOM OF WALL ELEVATION	SECTION	HOLE DIAMETER	ESTIMATED ROCK ELEVATION	BOTTOM OF TRENCH	ESTIMATED PILE TIP ELEVATION	ESTIMATED SOLDIER PILE LENGTH
		(FEET)	(FEET)	(FEET)	(FEET)	(FEET)			(FEET)	(FEET)	(FEET)	(FEET)
P-1	227+51.25	71.07 RT	633.06	636.91	637.91	631.06	W14X193	2'-6"	624.8	623.29	618.29	18.62
P-2	227+60.42	71.07 RT	633.03	637.90	638.90	631.03	W14X193	2'-6"	624.8	623.25	618.25	19.65
P-3	227+69.58	71.07 RT	633.00	638.89	639.89	631.00	W14X193	2'-6"	624.8	623.21	618.21	20.68
P-4	227+78.75	71.07 RT	632.97	639.88	640.88	630.97	W14X193	2'-6"	624.8	623.18	618.18	21.71
P-5	227+81.25	71.07 RT	632.96	640.15	641.15	630.96	W14X193	2'-6"	624.8	623.17	618.17	21.99
P-6	227+90.42	71.07 RT	632.93	641.15	642.15	630.93	W14X193	2'-6"	624.8	623.13	618.13	23.02
P-7	227+99.58	71.07 RT	632.91	642.14	643.14	630.91	W14X193	2'-6"	624.8	623.09	618.09	24.05
P-8	228+08.75	71.07 RT	632.88	643.13	644.13	630.88	W14X193	2'-6"	624.8	623.06	618.06	25.08
P-9	228+11.25	71.07 RT	632.87	643.40	644.40	630.87	W14X193	2'-6"	624.8	623.05	618.05	25.36
P-10	228+18.13	71.07 RT	632.85	644.15	645.15	630.85	W14X193	2'-6"	624.8	623.02	618.02	26.13
P-11	228+25.00	71.07 RT	632.83	644.89	645.89	630.83	W14X193	2'-6"	624.8	622.99	617.99	26.90
P-12	228+31.88	71.07 RT	632.81	645.64	646.64	630.81	W14X193	2'-6"	624.8	622.96	617.96	27.68
P-13	228+38.75	71.07 RT	632.78	646.38	647.38	630.78	W14X193	2'-6"	624.8	622.94	617.94	28.45
P-14	228+41.25	71.33 RT	632.78	645.99	647.65	630.78	W18X283	2'-6"	624.8	622.93	617.93	28.06
P-15	228+48.13	71.33 RT	632.76	646.73	648.40	630.76	W18X283	2'-6"	624.8	622.90	617.90	28.83
P-16	228+55.00	71.33 RT	632.73	647.48	649.14	630.73	W18X283	2'-6"	624.8	622.87	617.87	29.61
P-17	228+61.88	71.33 RT	632.71	648.22	649.89	630.71	W18X283	2'-6"	624.8	622.84	617.84	30.38
P-18	228+68.75	71.33 RT	632.69	648.96	650.63	630.69	W18X283	2'-6"	624.8	622.82	617.82	31.15
P-19	228+71.25	71.33 RT	632.68	649.24	650.90	630.68	W18X283	2'-6"	624.8	622.81	617.81	31.43
P-20	228+76.75	71.33 RT	632.67	649.55	651.22	630.67	W18X283	2'-6"	624.8	622.78	617.78	31.77
P-21	228+82.25	71.33 RT	632.65	649.59	651.25	630.65	W18X283	2'-6"	624.8	622.76	617.76	31.83
P-22	228+87.75	71.33 RT	632.63	649.62	651.29	630.63	W18X283	2'-6"	624.8	622.74	617.74	31.88
P-23	228+93.25	71.33 RT	632.62	649.66	651.33	630.62	W18X283	2'-6"	624.8	622.72	617.72	31.94
P-24	228+98.75	71.33 RT	632.60	649.69	651.36	630.60	W18X283	2'-6"	624.8	622.70	617.70	32.00
P-25	229+01.25	71.33 RT	632.59	649.71	651.38	630.59	W18X283	2'-6"	624.8	622.68	617.68	32.03
P-26	229+06.75	71.33 RT	632.57	649.75	651.41	630.57	W18X283	2'-6"	624.8	622.64	617.64	32.11
P-27	229+12.25	71.33 RT	632.56	649.78	651.45	630.56	W18X283	2'-6"	624.8	622.60	617.60	32.18
P-28	229+17.75	71.33 RT	632.54	649.81	651.48	630.54	W18X283	2'-6"	624.8	622.56	617.56	32.25
P-29	229+23.25	71.33 RT	632.52	649.79	651.46	630.52	W18X283	2'-6"	624.8	622.52	617.52	32.27
P-30	229+28.75	71.33 RT	632.51	649.78	651.44	630.51	W18X283	2'-6"	624.8	622.48	617.48	32.30
P-31	229+31.25	71.33 RT	632.50	649.77	651.44	630.50	W18X283	2'-6"	624.8	622.47	617.47	32.30
P-32	229+36.75	71.33 RT	632.48	649.75	651.42	630.48	W18X283	2'-6"	624.8	622.44	617.44	32.31
P-33	229+42.25	71.33 RT	632.46	649.73	651.40	630.46	W18X283	2'-6"	624.8	622.42	617.42	32.31
P-34	229+47.75	71.33 RT	632.45	649.72	651.38	630.45	W18X283	2'-6"	624.8	622.40	617.40	32.32
P-35	229+53.25	71.33 RT	632.43	649.70	651.37	630.43	W18X283	2'-6"	624.8	622.38	617.38	32.32
P-36	229+58.75	71.33 RT	632.41	649.68	651.35	630.41	W18X283	2'-6"	624.8	622.36	617.36	32.32
P-37	229+61.25	71.33 RT	632.41	649.67	651.34	630.41	W18X283	2'-6"	624.8	622.35	617.35	32.33

See details on sheet 3 of 23 for minimum pile embedment in competent rock.

Prairie Engineers, P.C.
www.prairieengineers.com
professional design firm no. 184-005965
© Copyright Prairie Engineers, P.C. 2020

USER NAME *
PLOT SCALE *
PLOT DATE *

DESIGNED - RHC
CHECKED - CMF
DRAWN - JLM
CHECKED - SMA

REVISED -
REVISED -
REVISED -
REVISED -

STATE OF ILLINOIS
DEPARTMENT OF TRANSPORTATION

WALL A TABLE OF PILE LENGTHS AND ELEVATIONS
STRUCTURE NO. 046-0153


SHEET 8 OF 23 SHEETS

F.A.I. RTE.	SECTION	COUNTY	TOTAL SHEETS	SHEET NO.
S7	139HBR-6	KANKAKEE	202	151
CONTRACT NO. 66997				
ILLINOIS FED. AID PROJECT				

SOLDIER PILE NUMBER	SOLDIER PILE STATION	OFFSET	EDGE OF SHOULDER ELEVATION	TOP OF PILE ELEVATION	TOP OF WALL ELEVATION	BOTTOM OF WALL ELEVATION	SECTION	HOLE DIAMETER	ESTIMATED ROCK ELEVATION	BOTTOM OF TRENCH	ESTIMATED PILE TIP ELEVATION	ESTIMATED SOLDIER PILE LENGTH
		(FEET)	(FEET)	(FEET)	(FEET)	(FEET)			(FEET)	(FEET)	(FEET)	(FEET)
P38	229+66.75	71.33 RT	632.39	649.66	651.32	630.39	W18X283	2'-6"	624.8	622.33	617.33	32.33
P39	229+72.25	71.33 RT	632.37	649.64	651.31	630.37	W18X283	2'-6"	624.8	622.30	617.30	32.33
P40	229+77.75	71.33 RT	632.35	649.62	651.29	630.35	W18X283	2'-6"	624.8	622.28	617.28	32.34
P41	229+83.25	71.33 RT	632.34	649.60	651.27	630.34	W18X283	2'-6"	624.8	622.26	617.26	32.34
P42	229+88.75	71.33 RT	632.32	649.59	651.25	630.32	W18X283	2'-6"	624.8	622.24	617.24	32.35
P43	229+91.25	71.33 RT	632.31	649.58	651.25	630.31	W18X283	2'-6"	624.8	622.23	617.23	32.35
P44	229+96.75	71.33 RT	632.30	649.56	651.23	630.30	W18X283	2'-6"	624.8	622.21	617.21	32.35
P45	230+02.25	71.33 RT	632.28	649.55	651.21	630.28	W18X283	2'-6"	624.8	622.19	617.19	32.36
P46	230+07.75	71.33 RT	632.26	649.29	650.95	630.26	W18X283	2'-6"	624.8	622.15	617.15	32.14
P47	230+13.25	71.33 RT	632.24	648.52	650.18	630.24	W18X283	2'-6"	624.8	622.09	617.09	31.42
P48	230+18.75	71.33 RT	632.23	647.74	649.41	630.23	W18X283	2'-6"	624.8	622.03	617.03	30.71
P49	230+21.25	71.33 RT	632.22	647.39	649.06	630.22	W18X283	2'-6"	624.8	622.01	617.01	30.38
P50	230+26.75	71.33 RT	632.20	646.62	648.29	630.20	W18X283	2'-6"	624.8	622.00	617.00	29.62
P51	230+32.25	71.33 RT	632.19	645.85	647.51	630.19	W18X283	2'-6"	624.8	621.98	616.98	28.87
P52	230+37.75	71.33 RT	632.17	645.07	646.74	630.17	W18X283	2'-6"	624.8	621.96	616.96	28.11
P52	230+43.25	71.33 RT	632.15	644.30	645.97	630.15	W18X283	2'-6"	624.8	621.94	616.94	27.36
P54	230+48.75	71.33 RT	632.13	643.53	645.20	630.13	W18X283	2'-6"	624.8	621.93	616.93	26.61
P55	230+51.25	71.07 RT	632.13	643.85	644.85	630.13	W14X193	2'-6"	624.8	621.92	616.92	26.93
P56	230+60.42	71.07 RT	632.10	642.56	643.56	630.10	W14X193	2'-6"	624.8	621.89	616.89	25.67
P57	230+69.58	71.07 RT	632.07	641.27	642.27	630.07	W14X193	2'-6"	624.8	621.86	616.86	24.41
P58	230+78.75	71.07 RT	632.04	639.98	640.98	630.04	W14X193	2'-6"	624.8	621.83	616.83	23.15
P59	230+81.25	71.07 RT	632.03	639.63	640.63	630.03	W14X193	2'-6"	624.8	621.82	616.82	22.81
P60	230+90.42	71.07 RT	632.00	638.35	639.35	630.00	W14X193	2'-6"	624.8	621.79	616.79	21.55
P61	230+99.58	71.07 RT	631.98	637.06	638.06	629.98	W14X193	2'-6"	624.8	621.76	616.76	20.30
P62	231+08.75	71.07 RT	631.95	636.88	637.88	629.95	W14X193	2'-6"	624.8	621.73	616.73	20.15
P63	231+11.25	71.07 RT	631.94	636.85	637.85	629.94	W14X193	2'-6"	624.8	621.72	616.72	20.13
P64	231+20.42	71.07 RT	631.91	636.73	637.73	629.91	W14X193	2'-6"	624.8	621.63	616.63	20.10
P65	231+29.58	71.07 RT	631.88	636.61	637.61	629.88	W14X193	2'-6"	624.8	621.53	616.53	20.07
P66	231+38.75	71.07 RT	631.85	636.49	637.49	629.85	W14X193	2'-6"	624.8	621.44	616.44	20.04
P67	231+41.25	71.07 RT	631.85	636.46	637.46	629.85	W14X193	2'-6"	624.8	621.43	616.43	20.03
P68	231+50.42	71.07 RT	631.82	636.33	637.33	629.82	W14X193	2'-6"	624.8	621.39	616.39	19.94
P69	231+59.58	71.07 RT	631.79	636.21	637.21	629.79	W14X193	2'-6"	624.8	621.36	616.36	19.86
P70	231+68.75	71.07 RT	631.76	636.09	637.09	629.76	W14X193	2'-6"	624.8	621.32	616.32	19.77
P71	231+71.25	71.07 RT	631.75	636.06	637.06	629.75	W14X193	2'-6"	624.8	621.31	616.31	19.75
P72	231+80.42	71.07 RT	631.73	635.94	636.94	629.73	W14X193	2'-6"	624.8	621.28	616.28	19.66
P73	231+89.58	71.07 RT	631.70	635.82	636.82	629.70	W14X193	2'-6"	624.8	621.24	616.24	19.57
P74	231+98.75	71.07 RT	631.67	635.70	636.70	629.67	W14X193	2'-6"	624.8	621.21	616.21	19.49
P75	232+01.25	71.07 RT	631.66	635.66	636.66	629.66	W14X193	2'-6"	624.8	621.20	616.20	19.46
P76	232+10.42	71.07 RT	631.63	635.54	636.54	629.63	W14X193	2'-6"	624.8	621.17	616.17	19.38
P77	232+19.58	71.07 RT	631.60	635.42	636.42	629.60	W14X193	2'-6"	624.8	621.13	616.13	19.29
P78	232+28.75	71.07 RT	631.58	635.30	636.30	629.58	W14X193	2'-6"	624.8	621.10	616.10	19.20
P79	232+31.25	71.07 RT	631.57	635.27	636.27	629.57	W14X193	2'-6"	624.8	621.09	616.09	19.18
P80	232+40.42	71.07 RT	631.54	635.15	636.15	629.54	W14X193	2'-6"	624.8	621.05	616.05	19.09
P81	232+49.58	71.07 RT	631.51	635.03	636.03	629.51	W14X193	2'-6"	624.8	621.02	616.02	19.01
P82	232+58.75	71.07 RT	631.48	634.90	635.90	629.48	W14X193	2'-6"	624.8	620.98	615.98	18.92
P83	232+61.25	71.07 RT	631.48	634.87	635.87	629.48	W14X193	2'-6"	624.8	620.97	615.97	18.90
P84	232+70.42	71.07 RT	631.45	634.75	635.75	629.45	W14X193	2'-6"	624.8	620.94	615.94	18.81
P85	232+79.58	71.07 RT	631.42	634.63	635.63	629.42	W14X193	2'-6"	624.8	620.91	615.91	18.72
P86	232+88.75	71.07 RT	631.39	634.51	635.51	629.39	W14X193	2'-6"	624.8	620.87	615.87	18.64
P87	232+91.25	71.07 RT	631.38	634.48	635.48	629.38	W14X193	2'-6"	624.8	620.86	615.86	18.61
P88	233+00.42	71.07 RT	631.35	634.35	635.35	629.35	W14X193	2'-6"	624.8	620.83	615.83	18.53
P89	233+09.58	71.07 RT	631.33	634.23	635.23	629.33	W14X193	2'-6"	624.8	620.79	615.79	18.44
P90	233+18.75	71.07 RT	631.30	634.11	635.11	629.30	W14X193	2'-6"	624.8	620.76	615.76	18.35
P91	233+21.25	71.07 RT	631.29	634.08	635.08	629.29	W14X193	2'-6"	624.8	620.75	615.75	18.33
P92	233+30.42	71.07 RT	631.26	633.96	634.96	629.26	W14X193	2'-6"	624.8	620.71	615.71	18.24
P93	233+39.58	71.07 RT	631.23	633.84	634.84	629.23	W14X193	2'-6"	624.8	620.68	615.68	18.16
P94	233+48.75	71.07 RT	631.20	633.72	634.72	629.20	W14X193	2'-6"	624.8	620.64	615.64	18.07

WALL A BAR DIMENSIONS

Bar	No.	A	B
v101(E)	40	9'-9"	6'-4"
v102(E)	41	13'-1"	9'-9"
v103(E)	21	16'-5"	13'-1"
v104(E)	21	19'-9"	16'-5"
v105(E)	21	20'-5"	19'-9"
v107(E)	21	20'-7"	18'-8"
v108(E)	21	18'-8"	14'-7"
v109(E)	21	14'-7"	10'-5"
v110(E)	41	10'-5"	7'-7"
v111(E)	41	7'-7"	7'-3"
v112(E)	41	7'-3"	7'-0"
v113(E)	41	7'-0"	6'-8"
v114(E)	41	6'-8"	6'-5"
v115(E)	41	6'-5"	6'-1"
v116(E)	41	6'-1"	5'-9"
v117(E)	41	5'-9"	5'-6"
v118(E)	41	5'-6"	5'-2"
v120(E)	20	14'-3"	10'-5"

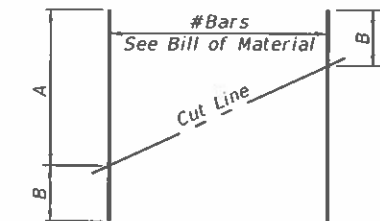

FIELD CUTTING DIAGRAM

Order bars full length. Cut as shown and use remainder of bars in opposite face. See table for lengths.

WALL A BILL OF MATERIAL

Bar	No.	Size	Length	Shape
h141(E)	466	#5	33'-2"	=====
h142(E)	275	#5	29'-10"	=====
h143(E)	49	#7	35'-10"	=====
h144(E)	35	#7	29'-10"	=====
h145(E)	7	#7	35'-6"	=====
s125(E)	520	#4	8'-6"	⌌
* v101(E)	40	#5	16'-1"	=====
* v102(E)	41	#5	22'-10"	=====
* v103(E)	21	#5	29'-6"	=====
* v104(E)	21	#5	36'-2"	=====
* v105(E)	21	#5	40'-2"	=====
* v106(E)	126	#5	20'-7"	=====
* v107(E)	21	#5	39'-3"	=====
* v108(E)	21	#5	33'-3"	=====
* v109(E)	21	#5	25'-0"	=====
* v110(E)	41	#5	18'-0"	=====
* v111(E)	41	#5	14'-10"	=====
* v112(E)	41	#5	14'-4"	=====
* v113(E)	41	#5	13'-8"	=====
* v114(E)	41	#5	13'-1"	=====
* v115(E)	41	#5	12'-6"	=====
* v116(E)	41	#5	11'-10"	=====
* v117(E)	41	#5	11'-3"	=====
* v118(E)	41	#5	10'-8"	=====
* v119(E)	320	#5	14'-3"	=====
* v120(E)	20	#5	24'-8"	=====
Structure Excavation			Cu. Yd.	833
Stud Shear Connectors			Each	1,615
Reinforcement Bars, Epoxy Coated			Pound	52,950
Furnishing Soldier Piles (W Section)			Foot	2,390
Drilling and Setting Soldier Piles (in Soil)			Cu. Ft.	8,739
Drilling and Setting Soldier Piles (in Rock)			Cu. Ft.	3,593
Untreated Timber Lagging			Sq. Ft.	6,234
Concrete Structures			Cu. Yd.	277.6
Concrete Sealer			Sq. Ft.	8,395
Geocomposite Wall Drain			Sq. Yd.	473
Pipe Underdrains for Structures 4 inch			Foot	660


* Bars to be field cut

See details on sheet 3 of 23 for minimum pile embedment in competent rock.


Prairie Engineers, P.C. www.prairieengineers.com professional design firm no. 184-005965 © Copyright Prairie Engineers, P.C. 2020	USER NAME =	DESIGNED - RHC	REVISED -	STATE OF ILLINOIS DEPARTMENT OF TRANSPORTATION	WALL A TABLE OF PILE LENGTHS AND ELEVATIONS, BILL OF MATERIAL STRUCTURE NO. 046-0153	F.A.I. RTE.	SECTION	COUNTY	TOTAL SHEETS	SHEET NO.
		CHECKED - CMF	REVISED -			57	139HBR-6	KANKAKEE	202	152
	PLOT SCALE =	DRAWN - JLM	REVISED -			CONTRACT NO. 66997				
	PLOT DATE =	CHECKED - SMA	REVISED -			SHEET 9 OF 23 SHEETS				

MODEL: 0460153-66997-010
FILE NAME: I:\jobs\2019\193_1901 P7B 192-011 District 3 Various Phase III Structure Projects\WO 2 - Waldron Road over I-57\Drawings\wall B\Sheet\0460153-66997-010-012-wall B Plan-sheets.dgn
3/18/2021 3:58:46 PM

Notes:
F.F. = Front Face
B.F. = Back Face
See sheets 13 of 23 for Pile Sizes, Elevations, Lengths, Shoulder Elevations, Base of Wall Elevations, and Field Cutting Diagram.
See sheets 14-15 of 23 for Sections and Details. See sheet 5 of 23 for S bar details.

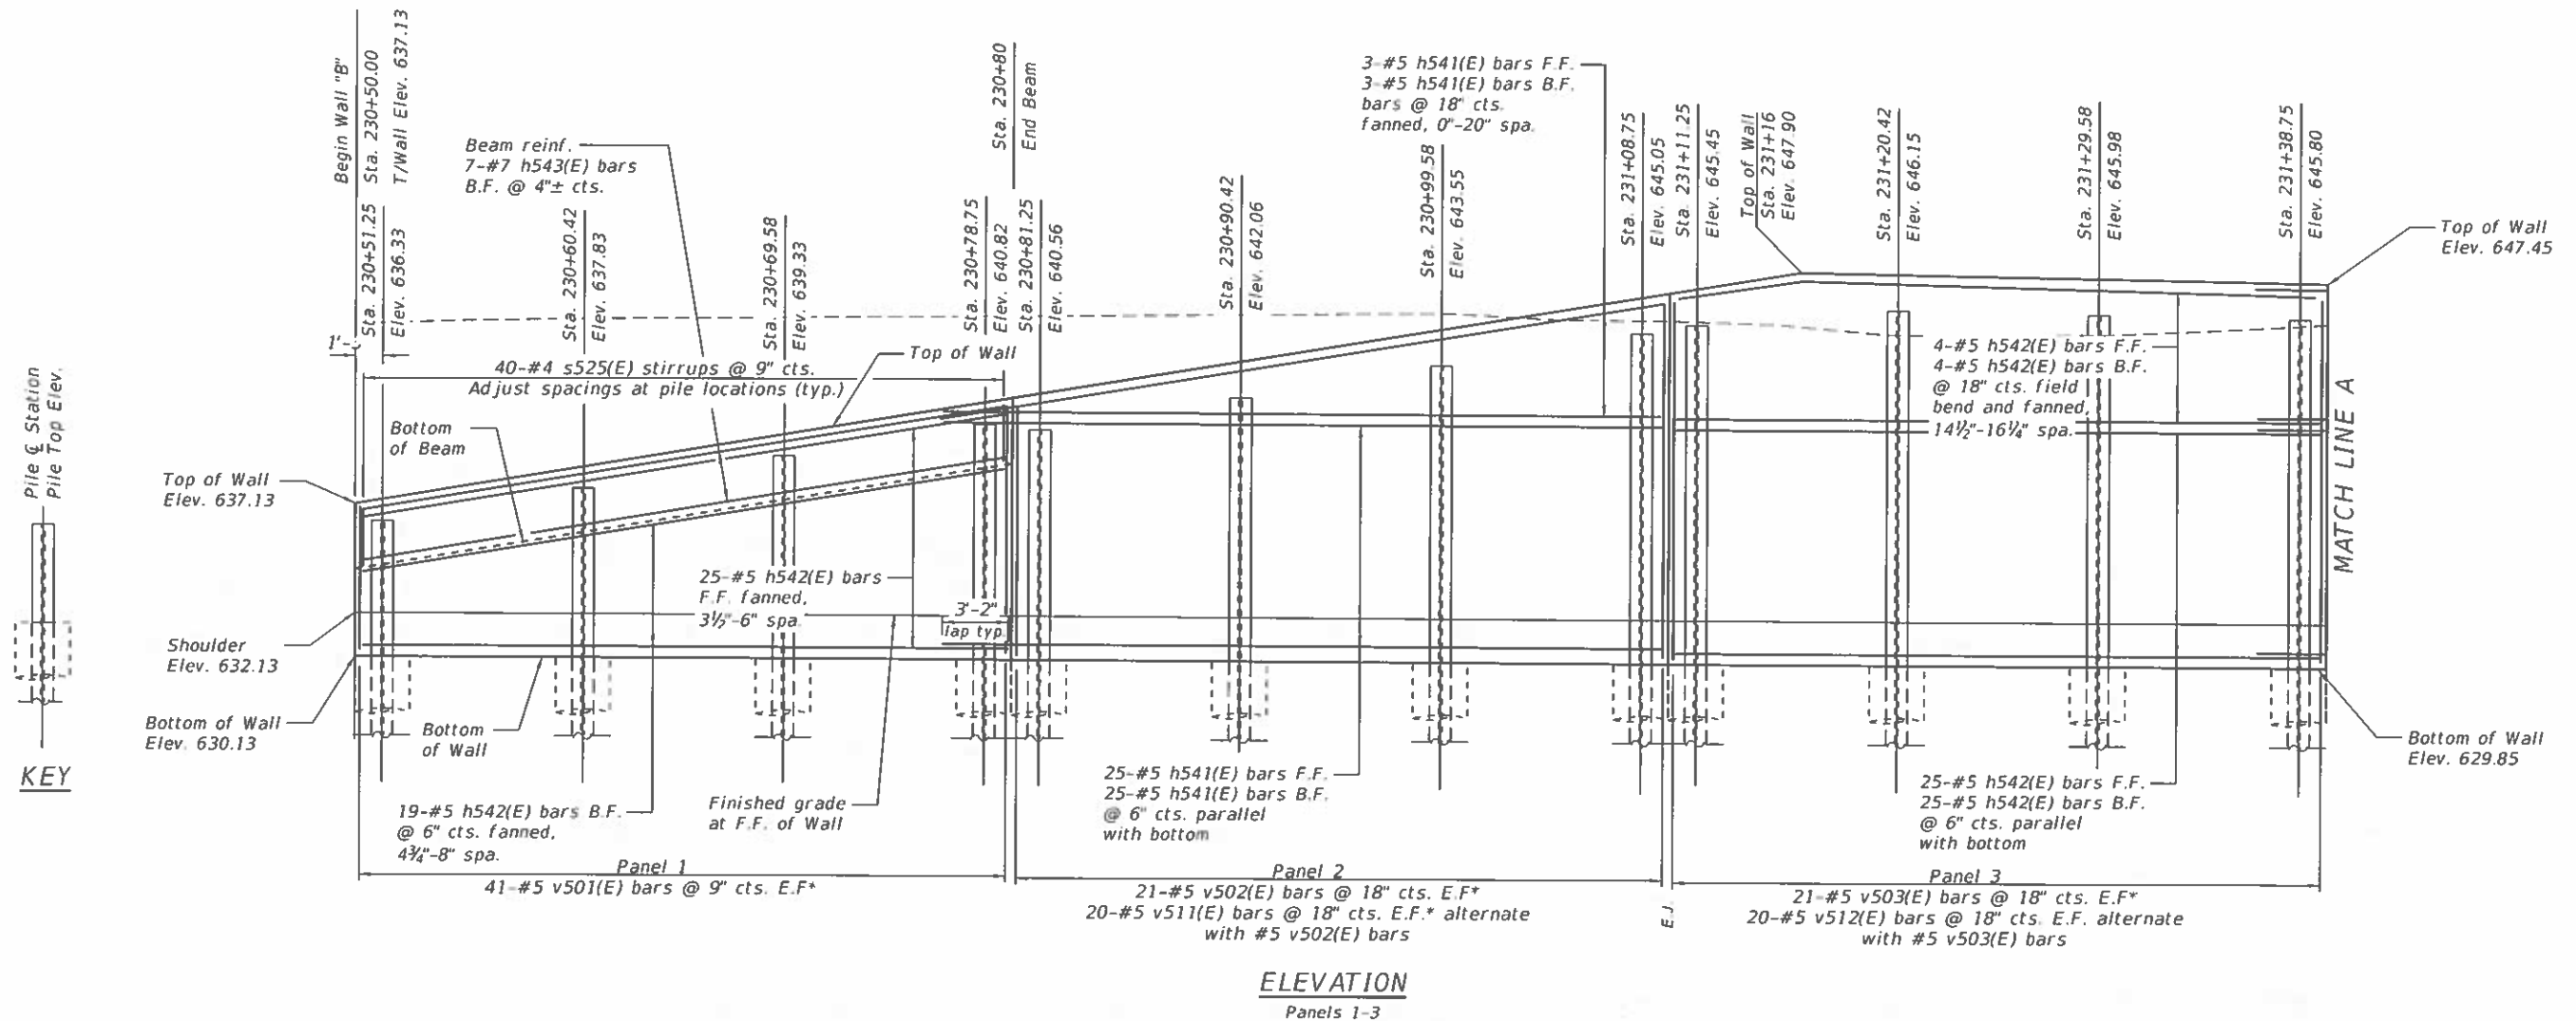

* - Requires field cuts.
See sheet 13

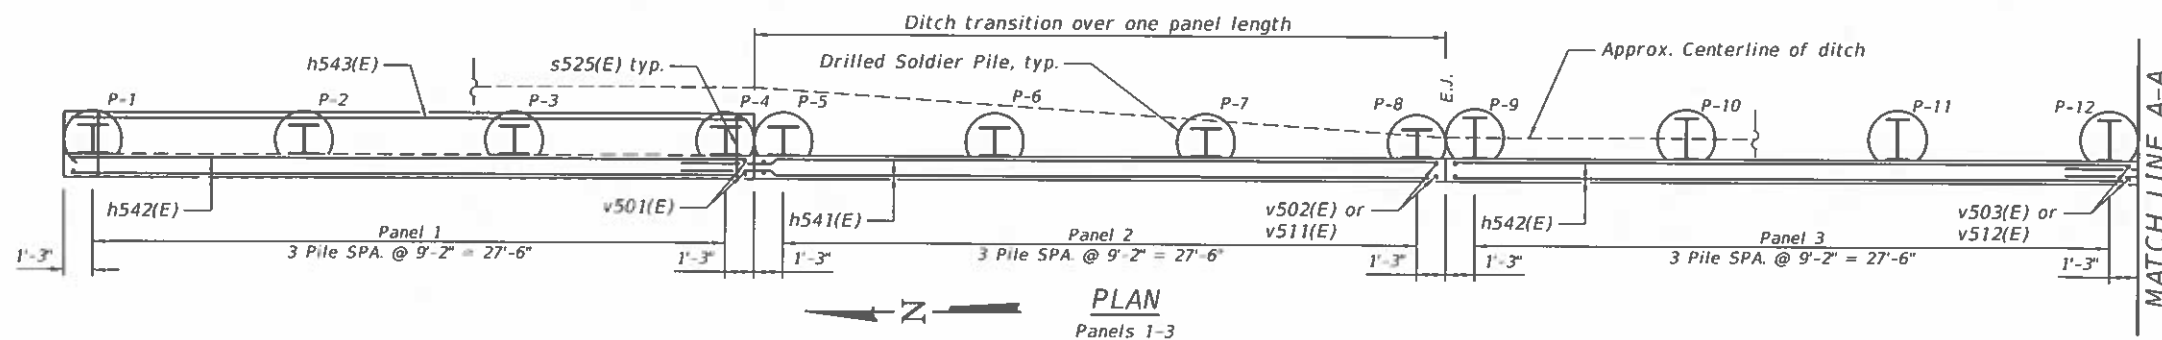

MINIMUM BAR LAP
#5 bar = 3'-2"
#7 bar = 5'-6"

Prairie Engineers, P.C.
www.prairieengineers.com
professional design firm no. 184-005965
© Copyright Prairie Engineers, P.C. 2020

USER NAME	DESIGNED	RHC	REVISED	
PLOT SCALE	CHECKED	CMF	REVISED	
PLOT DATE	DRAWN	JLM	REVISED	
	CHECKED	SMA	REVISED	



STATE OF ILLINOIS
DEPARTMENT OF TRANSPORTATION

WALL B PLAN AND ENLARGED ELEVATION
STRUCTURE NO. 046-0153

SHEET 10 OF 23 SHEETS

FAI. RTE.	SECTION	COUNTY	TOTAL SHEETS	SHEET NO.
S7	139HBR-6	KANKAKEE	202	153
CONTRACT NO. 66997				
ILLINOIS FED. AID PROJECT				

MODEL: 0460153-66997-011
FILE NAME: I:\000\2019\193\1901 PTB 192-011 District 3 Various Phase III Structure Projects\WO 2 - Waldron Road over I-57\Drawings\wall B\Sheet\0460153-66997-010-012-wall B Plan-sheets.dgn

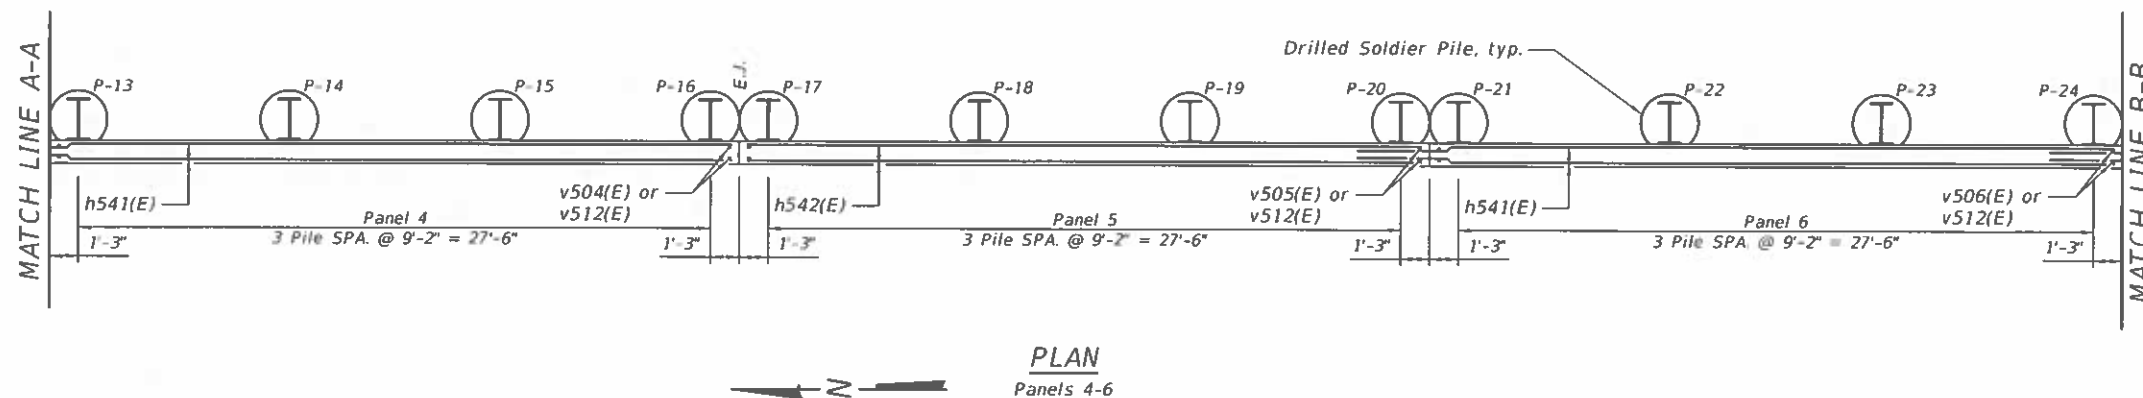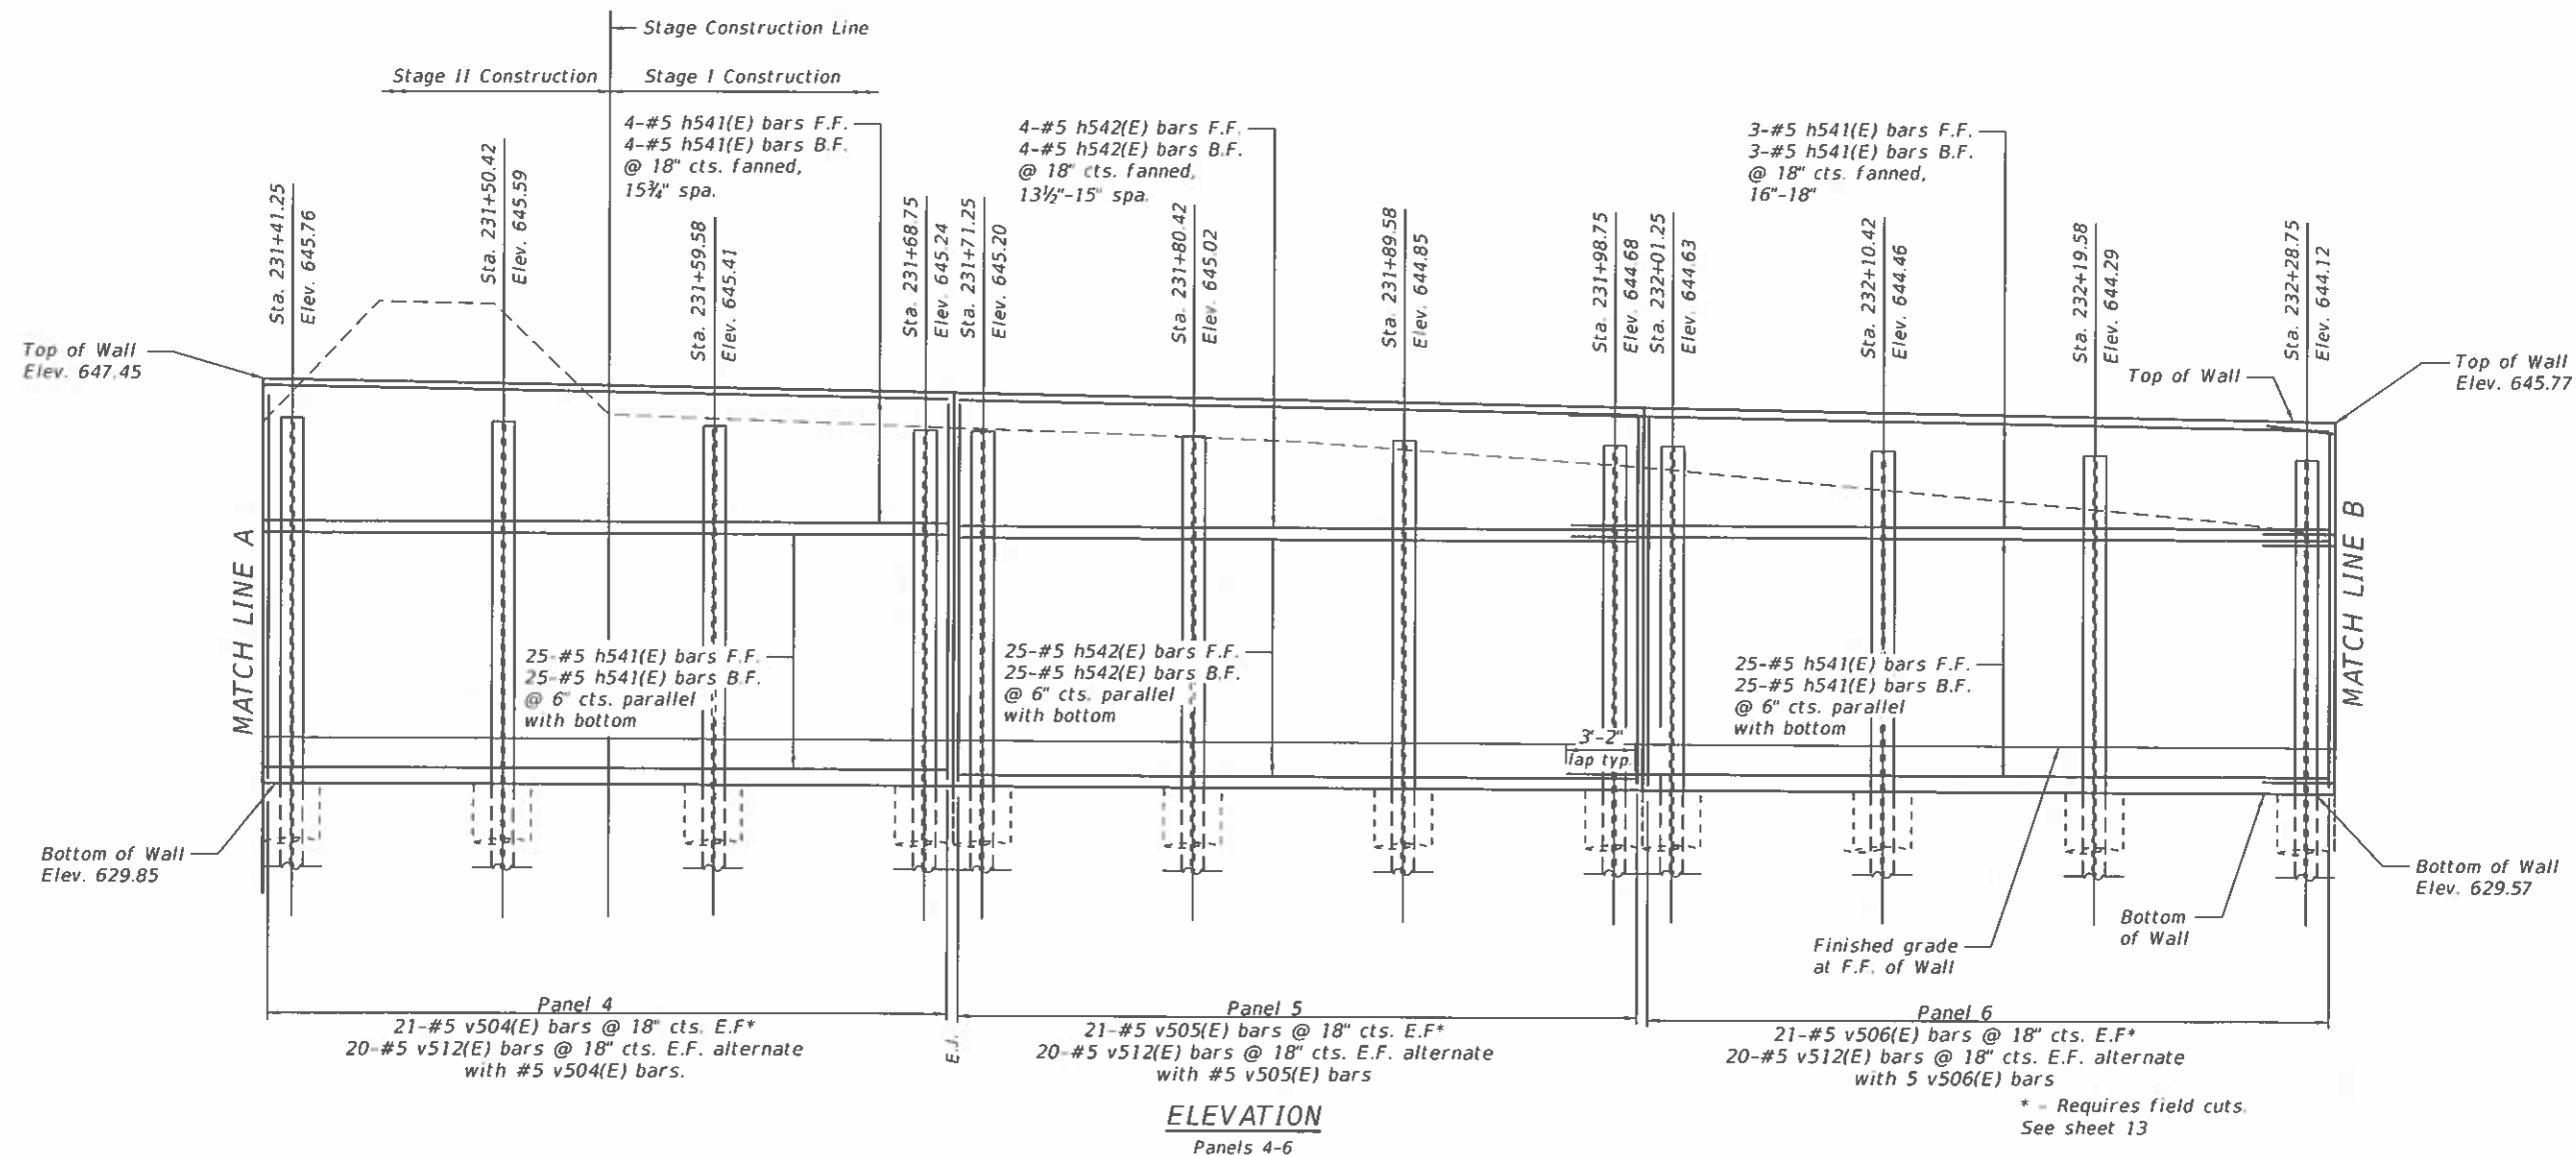

Notes:
F.F. = Front Face
B.F. = Back Face
See sheets 13 of 23 for Pile Sizes, Elevations, Lengths, Shoulder Elevations, Base of Wall Elevations, and Field Cutting Diagram.
See sheets 14-15 of 23 for Sections and Details. See sheet 5 of 23 for S bar details.

MINIMUM BAR LAP
#5 bar = 3'-2"

Prairie Engineers, P.C.
www.prairieengineers.com
professional design firm no. 184-005965
© Copyright Prairie Engineers, P.C. 2020

USER NAME	DESIGNED - RHC	REVISED -
PLOT SCALE	CHECKED - CMF	REVISED -
PLOT DATE	DRAWN - JLM	REVISED -
	CHECKED - SMA	REVISED -

STATE OF ILLINOIS
DEPARTMENT OF TRANSPORTATION


WALL B PLAN AND ENLARGED ELEVATION
STRUCTURE NO. 046-0153

SHEET 11 OF 23 SHEETS

P.A.L. RTE.	SECTION	COUNTY	TOTAL SHEETS	SHEET NO.
57	139HBR-6	KANKAKEE	202	154
CONTRACT NO. 66997				

ILLINOIS FED. AID PROJECT


MODEL: 0460153-66997-012
FILE NAME: I:\0460153-66997-012\PTB 192-011 District 3 Various Phase III Structure Projects\WO 2 - Waldron Road over I-57\Drawing\wall B1Sheet\0460153-66997-012-012-wall B Plan-sheets.dgn
3/18/2021 3:59:50 PM

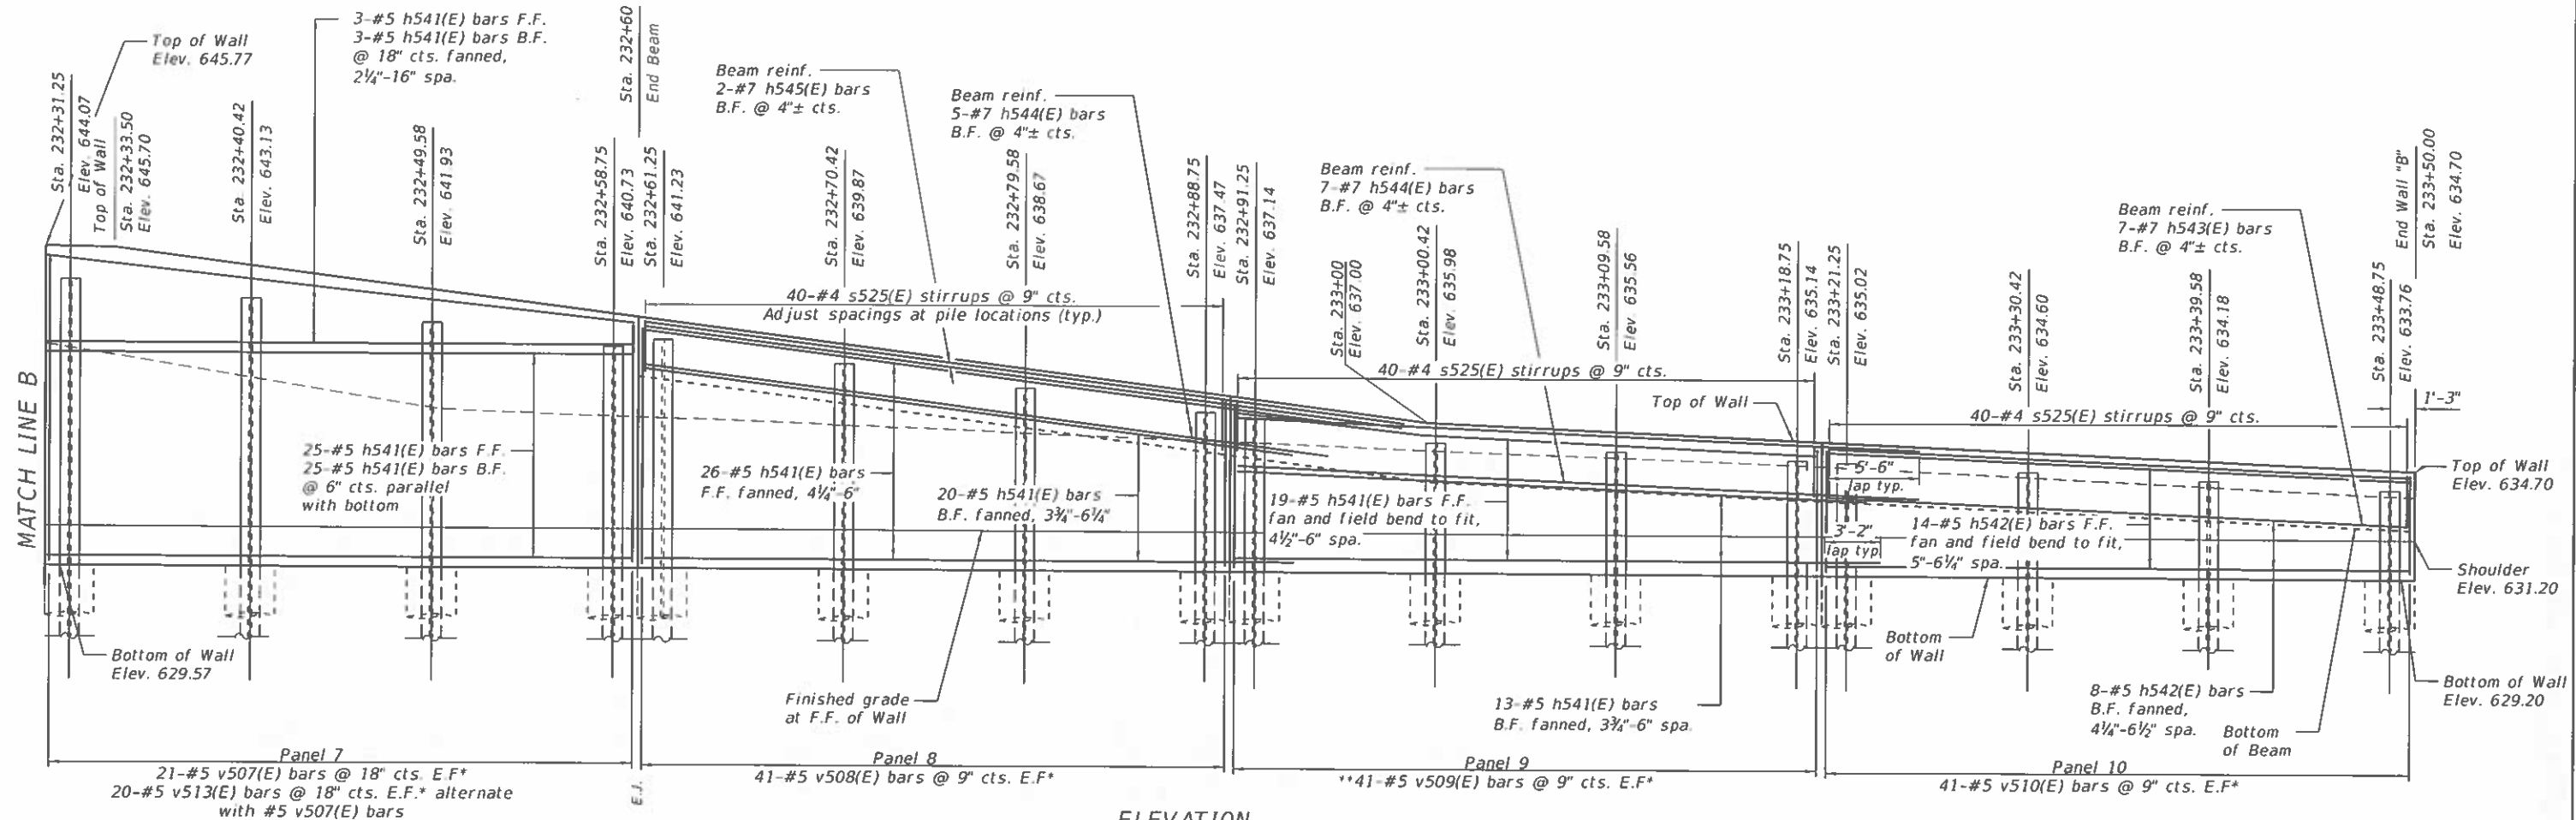

ELEVATION
Panels 7-10

** - After cutting bars to length per the cutting diagram, trim to fit as needed.

* - Requires field cuts. See sheet 13

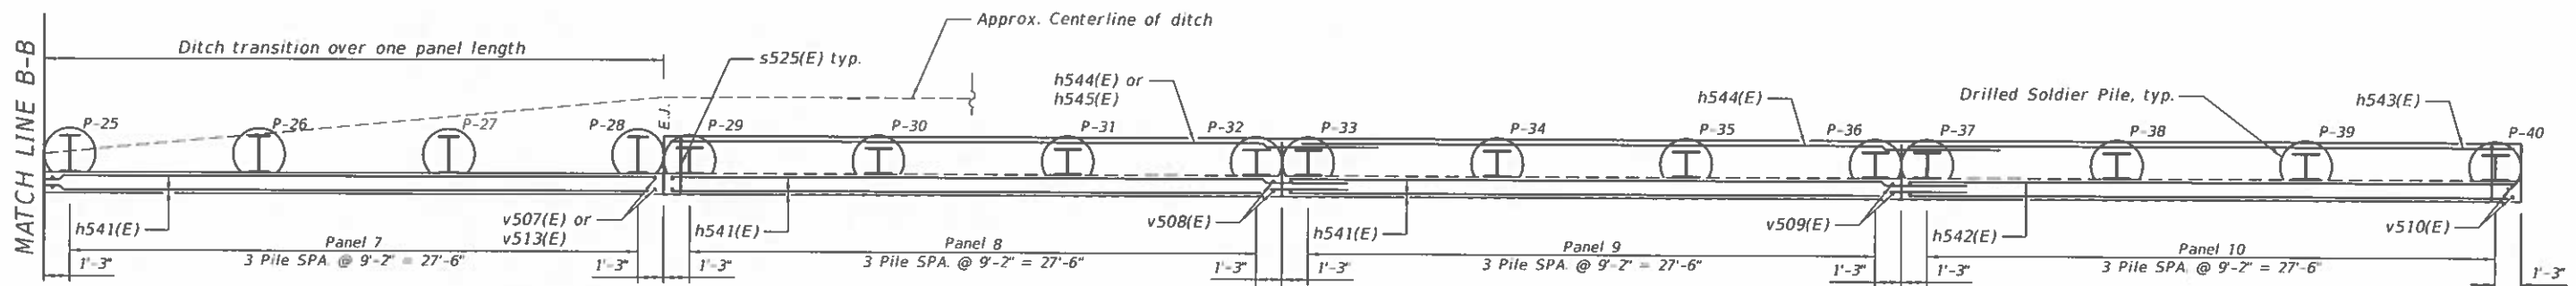

PLAN
Panels 7-10

Notes:
F.F. = Front Face
B.F. = Back Face
See sheets 13 of 23 for Pile Sizes, Elevations, Lengths, Shoulder Elevations, Base of Wall Elevations, and Field Cutting Diagram.
See sheets 14-15 of 23 for Sections and Details. See sheet 5 of 23 for S bar details.

MINIMUM BAR LAP

#5 bar = 3'-2"
#7 bar = 5'-6"

Prairie Engineers, P.C.
www.prairieengineers.com
professional design firm no. 164-005965
Copyright Prairie Engineers, P.C. 2020

USER NAME	DESIGNED - RHC	REVISED -
PLOT SCALE	CHECKED - CMF	REVISED -
PLOT DATE	DRAWN - JLM	REVISED -
	CHECKED - SMA	REVISED -

STATE OF ILLINOIS
DEPARTMENT OF TRANSPORTATION

WALL B PLAN AND ENLARGED ELEVATION
STRUCTURE NO. 046-0153

SHEET 12 OF 23 SHEETS

F.A.I. RTE.	SECTION	COUNTY	TOTAL SHEETS	SHEET NO.
57	139HBR-6	KANKAKEE	202	155
CONTRACT NO. 66997				

ILLINOIS | FED. AID PROJECT


MODEL: 0460153-66997-013
FILE NAME: I:\jobs\2019\193.1901_PTB 192-011 District 3 Various Phase III Structure Projects\WO 2 - Waldron Road over I-57\Drawings\wall B\Sheet\0460153-66997-013-wall B schedule sheet.dgn
3/18/2021 4:00:43 PM

SOLDIER PILE NUMBER	SOLDIER PILE STATION	OFFSET	EDGE OF SHOULDER ELEVATION	TOP OF PILE ELEVATION	TOP OF WALL ELEVATION	BOTTOM OF WALL ELEVATION	SECTION	HOLE DIAMETER	ESTIMATED ROCK ELEVATION	BOTTOM OF TRENCH	ESTIMATED PILE TIP ELEVATION	ESTIMATED SOLDIER PILE LENGTH
		(FEET)	(FEET)	(FEET)	(FEET)	(FEET)			(FEET)	(FEET)	(FEET)	(FEET)
P1	230+51.25	71.07 LT	632.13	636.33	637.33	630.13	W14X193	2'-6"	632.70	625.75	620.75	15.58
P2	230+60.42	71.07 LT	632.10	637.83	638.83	630.10	W14X193	2'-6"	632.70	625.71	620.71	17.12
P3	230+69.58	71.07 LT	632.07	639.33	640.33	630.07	W14X193	2'-6"	632.70	625.67	620.67	18.66
P4	230+78.75	71.07 LT	632.04	640.82	641.82	630.04	W14X193	2'-6"	632.70	625.62	620.62	20.20
P5	230+81.25	71.07 LT	632.03	640.56	642.23	630.03	W14X193	2'-6"	632.70	625.61	620.61	19.95
P6	230+90.42	71.07 LT	632.00	642.06	643.73	630.00	W14X193	2'-6"	632.70	625.56	620.56	21.49
P7	230+99.58	71.07 LT	631.98	643.55	645.22	629.98	W14X193	2'-6"	632.70	625.52	620.52	23.03
P8	231+08.75	71.07 LT	631.95	645.05	646.72	629.95	W14X193	2'-6"	632.70	625.47	620.47	24.57
P9	231+11.25	71.33 LT	631.94	645.45	647.12	629.94	W18X283	2'-6"	632.70	625.46	620.46	24.99
P10	231+20.42	71.33 LT	631.91	646.15	647.82	629.91	W18X283	2'-6"	632.70	625.42	620.42	25.73
P11	231+29.58	71.33 LT	631.88	645.98	647.65	629.88	W18X283	2'-6"	632.70	625.37	620.37	25.60
P12	231+38.75	71.33 LT	631.85	645.80	647.47	629.85	W18X283	2'-6"	632.70	625.33	620.33	25.48
P13	231+41.25	71.33 LT	631.85	645.76	647.43	629.85	W18X283	2'-6"	632.70	625.32	620.32	25.44
P14	231+50.42	71.33 LT	631.82	645.59	647.26	629.82	W18X283	2'-6"	632.70	625.27	620.27	25.32
P15	231+59.58	71.33 LT	631.79	645.41	647.08	629.79	W18X283	2'-6"	632.70	625.23	620.23	25.19
P16	231+68.75	71.33 LT	631.76	645.24	646.91	629.76	W18X283	2'-6"	632.70	625.18	620.18	25.06
P17	231+71.25	71.33 LT	631.75	645.20	646.87	629.75	W18X283	2'-6"	632.70	625.17	620.17	25.03
P18	231+80.42	71.33 LT	631.73	645.02	646.69	629.73	W18X283	2'-6"	632.70	625.12	620.12	24.90
P19	231+89.58	71.33 LT	631.70	644.85	646.52	629.70	W18X283	2'-6"	632.70	625.08	620.08	24.77
P20	231+98.75	71.33 LT	631.67	644.68	646.35	629.67	W18X283	2'-6"	632.70	625.03	620.03	24.65
P21	232+01.25	71.33 LT	631.66	644.63	646.30	629.66	W18X283	2'-6"	632.70	625.02	620.02	24.61
P22	232+10.42	71.33 LT	631.63	644.46	646.13	629.63	W18X283	2'-6"	632.70	624.98	619.98	24.48
P23	232+19.58	71.33 LT	631.60	644.29	645.96	629.60	W18X283	2'-6"	632.70	624.93	619.93	24.36
P24	232+28.75	71.33 LT	631.58	644.12	645.79	629.58	W18X283	2'-6"	632.70	624.89	619.89	24.23
P25	232+31.25	71.33 LT	631.57	644.07	645.74	629.57	W18X283	2'-6"	632.70	624.88	619.88	24.20
P26	232+40.42	71.33 LT	631.54	643.13	644.80	629.54	W18X283	2'-6"	632.70	624.83	619.83	23.29
P27	232+49.58	71.33 LT	631.51	641.93	643.60	629.51	W18X283	2'-6"	632.70	624.79	619.79	22.14
P28	232+58.75	71.33 LT	631.48	640.73	642.40	629.48	W18X283	2'-6"	632.70	624.74	619.74	20.99
P29	232+61.25	71.07 LT	631.48	641.23	642.07	629.48	W14X193	2'-6"	632.70	624.73	619.73	21.50
P30	232+70.42	71.07 LT	631.45	639.87	640.87	629.45	W14X193	2'-6"	632.70	624.68	619.68	20.19
P31	232+79.58	71.07 LT	631.42	638.67	639.67	629.42	W14X193	2'-6"	632.70	624.64	619.64	19.03
P32	232+88.75	71.07 LT	631.39	637.47	638.47	629.39	W14X193	2'-6"	632.70	624.59	619.59	17.88
P33	232+91.25	71.07 LT	631.38	637.14	638.14	629.38	W14X193	2'-6"	632.70	624.58	619.58	17.56
P34	233+00.42	71.07 LT	631.35	635.98	636.98	629.35	W14X193	2'-6"	632.70	624.54	619.54	16.44
P35	233+09.58	71.07 LT	631.33	635.56	636.56	629.33	W14X193	2'-6"	632.70	624.49	619.49	16.07
P36	233+18.75	71.07 LT	631.30	635.14	636.14	629.30	W14X193	2'-6"	632.70	624.45	619.45	15.69
P37	233+21.25	71.07 LT	631.29	635.02	636.02	629.29	W14X193	2'-6"	632.70	624.44	619.44	15.59
P38	233+30.42	71.07 LT	631.26	634.60	635.60	629.26	W14X193	2'-6"	632.70	624.39	619.39	15.21
P39	233+39.58	71.07 LT	631.23	634.18	635.18	629.23	W14X193	2'-6"	632.70	624.35	619.35	14.83
P40	233+48.75	71.07 LT	631.20	633.76	634.76	629.20	W14X193	2'-6"	632.70	624.30	619.30	14.46

See details on sheet 3 of 23 for minimum pile embedment in competent rock.

WALL B BAR DIMENSIONS

Bar	No.	A	B
v501(E)	41	11'-8"	6'-8"
v502(E)	21	16'-8"	11'-8"
v503(E)	21	17'-3"	16'-8"
v504(E)	21	17'-3"	16'-10"
v505(E)	21	16'-10"	16'-4"
v506(E)	21	16'-4"	15'-10"
v507(E)	21	15'-10"	12'-5"
v508(E)	41	12'-5"	8'-7"
v509(E)	41	8'-7"	6'-5"
v510(E)	41	6'-5"	5'-2"
v511(E)	20	14'-3"	11'-8"
v513(E)	20	14'-3"	12'-5"

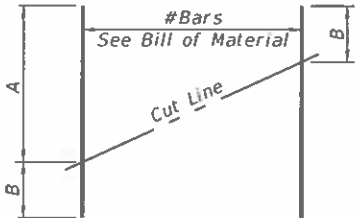

FIELD CUTTING DIAGRAM

Order bars full length. Cut as shown and use remainder of bars in opposite face. See table for lengths.

WALL B BILL OF MATERIAL

Bar	No.	Size	Length	Shape
h541(E)	304	#5	33'-2"	=====
h542(E)	182	#5	29'-10"	=====
h543(E)	14	#7	29'-10"	=====
h544(E)	12	#7	35'-10"	=====
h545(E)	2	#7	42'-0"	=====
s525(E)	160	#4	8'-6"	□
* v501(E)	41	#5	18'-4"	=====
* v502(E)	21	#5	28'-4"	=====
* v503(E)	21	#5	33'-11"	=====
* v504(E)	21	#5	34'-1"	=====
* v505(E)	21	#5	33'-2"	=====
* v506(E)	21	#5	32'-2"	=====
* v507(E)	21	#5	28'-3"	=====
* v508(E)	41	#5	21'-0"	=====
* v509(E)	41	#5	15'-0"	=====
* v510(E)	41	#5	11'-7"	=====
* v511(E)	20	#5	25'-11"	=====
* v512(E)	160	#5	14'-3"	=====
* v513(E)	20	#5	26'-8"	=====
Structure Excavation				Cu. Yd. 438
Stud Shear Connectors				Each 706
Reinforcement Bars, Epoxy Coated				Pound 29,370
Furnishing Soldier Piles (W Section)				Foot 856
Drilling and Setting Solder Piles (in Soil)				Cu. Ft. 1,987
Drilling and Setting Solder Piles (in Rock)				Cu. Ft. 2,488
Untreated Timber Lagging				Sq. Ft. 3,345
Concrete Structures				Cu. Yd. 146.2
Concrete Sealer				Sq. Ft. 4,398
Geocomposite Wall Drain				Sq. Yd. 266
Pipe Underdrains for Structures 4 inch				Foot 360

* Bars to be field cut

Pralie Engineers, P.C.
www.pralieengineers.com
professional design firm no. 184-005965
© Copyright Pralie Engineers, P.C. 2020

USER NAME -	DESIGNED - RHC	REVISED -
PLOT SCALE -	CHECKED - CMF	REVISED -
PLOT DATE -	DRAWN - JLM	REVISED -
	CHECKED - SMA	REVISED -


STATE OF ILLINOIS
DEPARTMENT OF TRANSPORTATION

WALL B TABLE OF PILE LENGTHS AND ELEVATIONS, BILL OF MATERIAL
STRUCTURE NO. 046-0153


SHEET 13 OF 23 SHEETS

F.A.I. RTE.	SECTION	COUNTY	TOTAL SHEETS	SHEET NO.
57	139HBR-6	KANKAKEE	202	156
CONTRACT NO. 66997				

MODEL: 0460153-66997-014
FILE NAME: I:\0460153-66997-014\1901 PTB 192-011 District 3 Various Phase III Structure Project\202 - Waldron Road over I-57\Drawings\wall A\SHEET\0460153-66997-014-wall A section.dgn
3/18/2021 3:45:10 PM

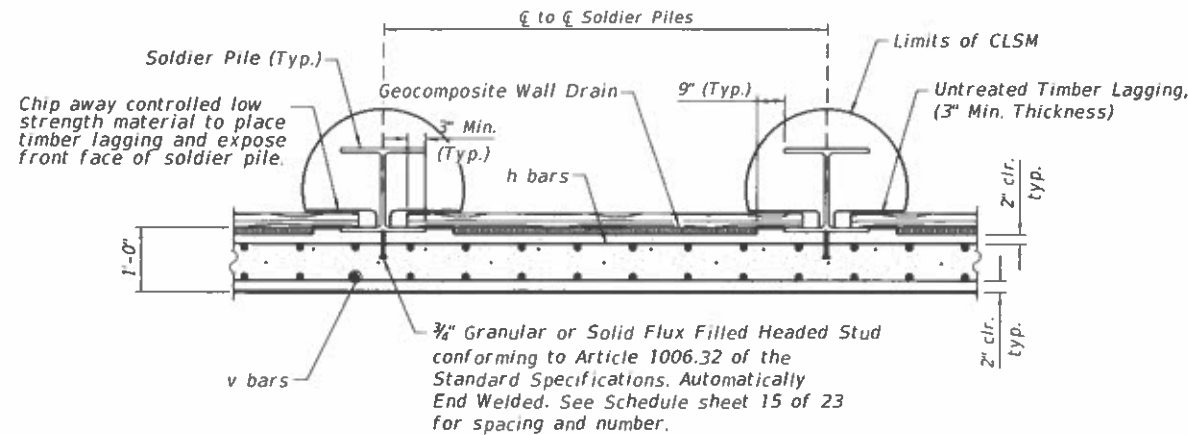


HORIZONTAL SECTION THRU SOLDIER PILE WALL

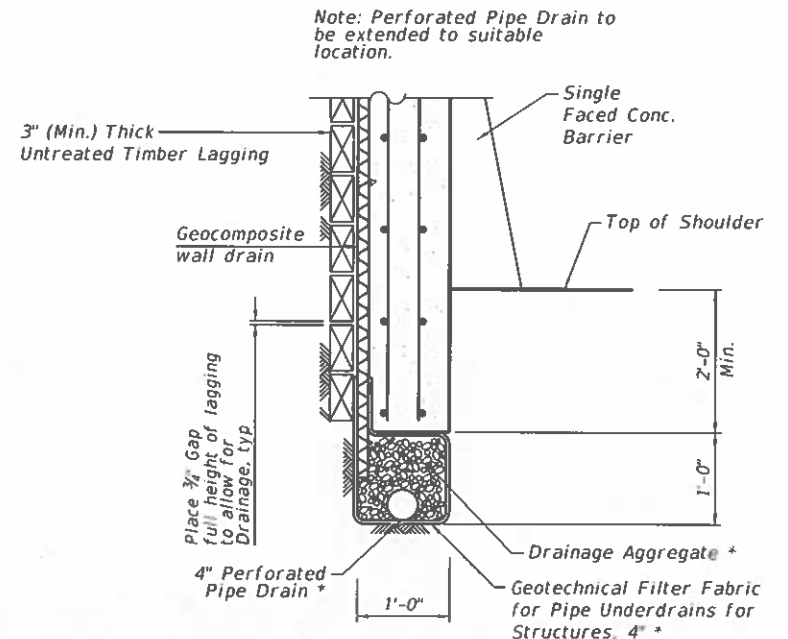


PIPE UNDERDRAIN DETAIL (BETWEEN SOLDIER PILES)

* Included in the cost of Pipe Underdrains for Structures, 4"

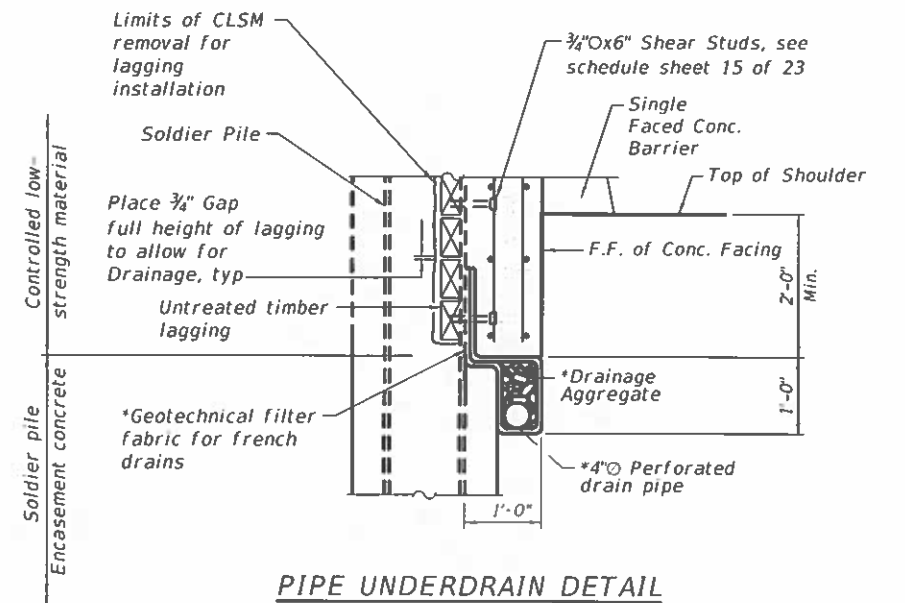

PIPE UNDERDRAIN DETAIL AT SOLDIER PILE


* Included in the cost of Pipe Underdrains for Structures

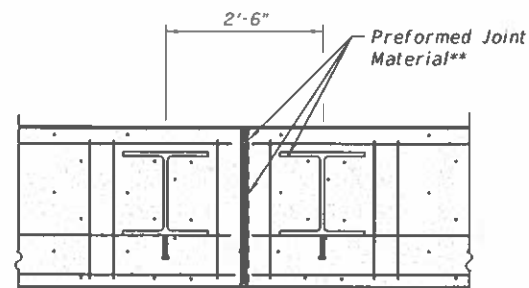

SECTION

(Expansion Joint at Beam)


**Included in the cost of Concrete Structures

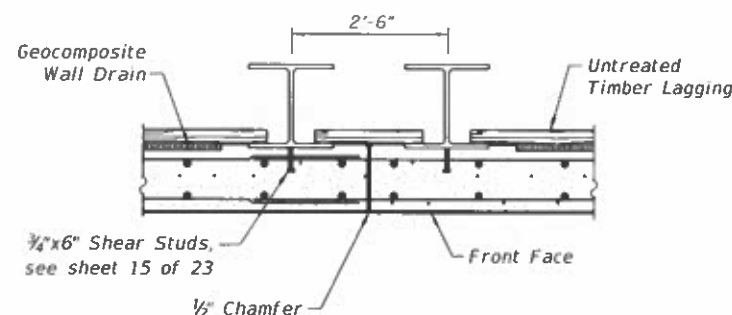

SECTION

(Construction Joint)

Limits of CSLM not shown.

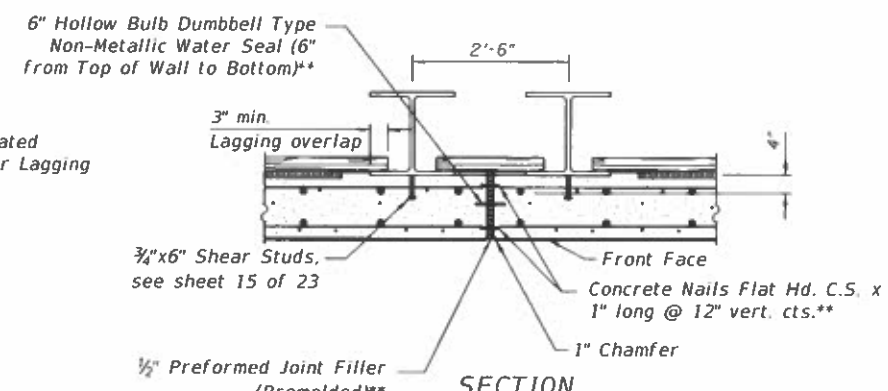

SECTION

(Expansion Joint)

Limits of CSLM not shown.

**Included in the cost of Concrete Structures

Notes:
See sheets 8, 9 and 13 of 23 for Soldier Pile Tables.
See sheet 15 of 23 for Shear Studs and Dowel Bars details and schedules.

Pralie Engineers, P.C.
www.pralieengineers.com
professional design firm no. 184-005965
© Copyright Pralie Engineers, P.C. 2020

USER NAME	DESIGNED	CMF	REVIS
PLOT SCALE	CHECKED	CMF	REVIS
PLOT DATE	DRAWN	CMF	REVIS
	CHECKED	SMA	REVIS


STATE OF ILLINOIS
DEPARTMENT OF TRANSPORTATION

SOLDIER PILE WALL SECTIONS
STRUCTURE NO. 046-0153

SHEET 14 OF 23 SHEETS

F.A.I. RTE.	SECTION	COUNTY	TOTAL SHEETS	SHEET NO.
57	139HBR-6	KANKAKEE	202	157
CONTRACT NO. 66997				
ILLINOIS FED. AID PROJECT				

* Number of studs at 8" cts. varies depending on height of wall. For short wall heights, 18" spacings at top of wall may not apply. See tables at right.

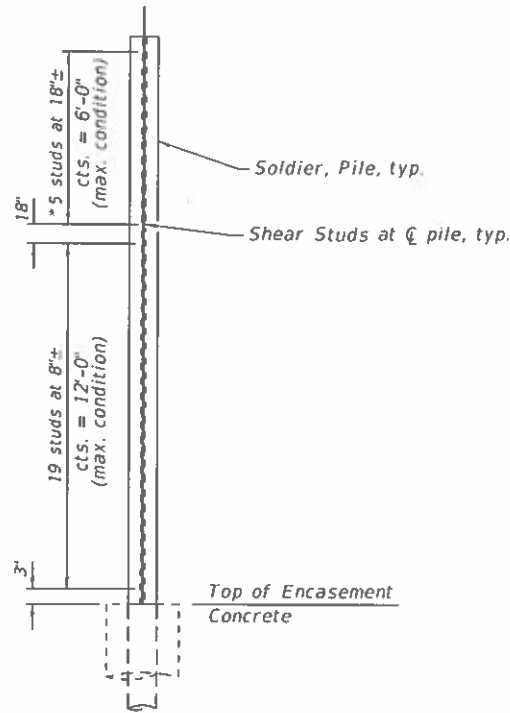

STUD SHEAR CONNECTOR LAYOUT

WALL A STUD SHEAR CONNECTOR TABLE

PILE	STATION	NUMBER OF CONNECTIONS BELOW 12'-3" @ 8"± SPA.	NUMBER OF CONNECTIONS ABOVE 12'-3" @ 18"± SPA.
P1	227+51.25	10	
P2	227+60.42	11	
P3	227+69.58	13	
P4	227+78.75	14	
P5	227+81.25	15	
P6	227+90.42	16	
P7	227+99.58	18	
P8	228+08.75	19	
P9	228+11.25	19	1
P10	228+18.13	19	1
P11	228+25.00	19	2
P12	228+31.88	19	2
P13	228+38.75	19	3
P14	228+41.25	19	3
P15	228+48.13	19	3
P16	228+55.00	19	4
P17	228+61.88	19	4
P18	228+68.75	19	5
P19	228+71.25	19	5
P20	228+76.75	19	5
P21	228+82.25	19	5
P22	228+87.75	19	5
P23	228+93.25	19	5
P24	228+98.75	19	5
P25	229+01.25	19	5
P26	229+06.75	19	5
P27	229+12.25	19	5
P28	229+17.75	19	5
P29	229+23.25	19	5
P30	229+28.75	19	5
P31	229+31.25	19	5
P32	229+36.75	19	5
P33	229+42.25	19	5
P34	229+47.75	19	5
P35	229+53.25	19	5
P36	229+58.75	19	5
P37	229+61.25	19	5
P38	229+66.75	19	5
P39	229+72.25	19	5
P40	229+77.75	19	5
P41	229+83.25	19	5
P42	229+88.75	19	5
P43	229+91.25	19	5
P44	229+96.75	19	5
P45	230+02.25	19	5
P46	230+07.75	19	5
P47	230+13.25	19	5
P48	230+18.75	19	4
P49	230+21.25	19	4
P50	230+26.75	19	3
P51	230+32.25	19	3
P52	230+37.75	19	2
P53	230+43.25	19	2
P54	230+48.75	19	1
P55	230+51.25	19	2
P56	230+60.42	19	1
P57	230+69.58	18	
P58	230+78.75	16	
P59	230+81.25	15	
P60	230+90.42	14	
P61	230+99.58	12	
P62	231+08.75	11	
P63	231+11.25	11	
P64	231+20.42	11	
P65	231+29.58	11	
P66	231+38.75	11	
P67	231+41.25	11	
P68	231+50.42	11	
P69	231+59.58	11	
P70	231+68.75	10	
P71	231+71.25	10	
P72	231+80.42	10	
P73	231+89.58	10	
P74	231+98.75	10	

WALL B STUD SHEAR CONNECTOR TABLE

PILE	STATION	NUMBER OF CONNECTIONS BELOW 12'-3" @ 8"± SPA.	NUMBER OF CONNECTIONS ABOVE 12'-3" @ 18"± SPA.
P75	232+01.25	10	
P76	232+10.42	10	
P77	232+19.58	10	
P78	232+28.75	10	
P79	232+31.25	10	
P80	232+40.42	9	
P81	232+49.58	9	
P82	232+58.75	9	
P83	232+61.25	9	
P84	232+70.42	9	
P85	232+79.58	9	
P86	232+88.75	9	
P87	232+91.25	9	
P88	233+00.42	9	
P89	233+09.58	8	
P90	233+18.75	8	
P91	233+21.25	8	
P92	233+30.42	8	
P93	233+39.58	8	
P94	233+48.75	8	

PILE	STATION	NUMBER OF CONNECTIONS BELOW 12'-3" @ 8"± SPA.	NUMBER OF CONNECTIONS ABOVE 12'-3" @ 18"± SPA.
P1	230+51.25	10	
P2	230+60.42	13	
P3	230+69.58	15	
P4	230+78.75	17	
P5	230+81.25	17	
P6	230+90.42	19	1
P7	230+99.58	19	2
P8	231+08.75	19	3
P9	231+11.25	19	3
P10	231+20.42	19	3
P11	231+29.58	19	3
P12	231+38.75	19	3
P13	231+41.25	19	3
P14	231+50.42	19	3
P15	231+59.58	19	3
P16	231+68.75	19	3
P17	231+71.25	19	3
P18	231+80.42	19	3
P19	231+89.58	19	3
P20	231+98.75	19	3
P21	232+01.25	19	2
P22	232+10.42	19	2
P23	232+19.58	19	2
P24	232+28.75	19	2
P25	232+31.25	19	2
P26	232+40.42	19	2
P27	232+49.58	19	1
P28	232+58.75	18	
P29	232+61.25	19	
P30	232+70.42	17	
P31	232+79.58	15	
P32	232+88.75	13	
P33	232+91.25	13	
P34	233+00.42	11	
P35	233+09.58	10	
P36	233+18.75	10	
P37	233+21.25	10	
P38	233+30.42	9	
P39	233+39.58	8	
P40	233+48.75	8	

Notes:
See sheet 14 of 23 for shear connector size and additional information.

MODEL: 0460153-66997-015
FILE NAME: I:\bbs2019\193-1901 PTB 192-011 District 3 Various Phase III Structure Projects\WO 2 - Waldron Road over I-57\Drawing\Wall A\Sheet\0460153-66997-015-wall A shear studs.dgn
3/18/2021 3:45:51 PM

Prairie Engineers, P.C.
www.prairieengineers.com
professional design firm no. 184-005965
© Copyright Prairie Engineers, P.C. 2020

USER NAME	DESIGNED - RHC	REVISED -
PLOT SCALE	CHECKED - CMF	REVISED -
PLOT DATE	DRAWN - RNH	REVISED -
	CHECKED - SMA	REVISED -

STATE OF ILLINOIS
DEPARTMENT OF TRANSPORTATION

SHEAR STUD CONNECTOR LAYOUT
STRUCTURE NO. 046-0153

SHEET 15 OF 23 SHEETS

F.A.I. RTE.	SECTION	COUNTY	TOTAL SHEETS	SHEET NO.
57	139HBR-6	KANKAKEE	202	158
CONTRACT NO. 66997				
ILLINOIS FED. AID PROJECT				

SOIL BORING LOG

Page 1 of 1

Date 8/25/17

ROUTE	<u>I-57 (FAI 57)</u>	DESCRIPTION	<u>on West side of I-57</u>	LOGGED BY	<u>Larry Myers</u>
-------	----------------------	-------------	-----------------------------	-----------	--------------------

SECTION (46-3)R, HBK, 5HBR, 6HBR LOCATION SE 1/4, SEC. 4, TWP. 30N, RNG. 13W, 2nd PM.

COUNTY Kankakee DRILLING METHOD Hollow Stem Auger HAMMER TYPE CME Automatic

STRUCT. NO. _____	D	B	U	M	Surface Water Elev. _____ ft
Station _____	E	L	O	O	Stream Bed Elev. _____ ft
	P	O	S	I	
BORING NO. _____	T	W			Groundwater Elev.: _____ ft
Station _____	H	S	Qu	T	First Encounter _____ ft
Offset _____					Upon Completion _____ ft
Ground Surface Elev. _____ ft	(ft)	(ft)	(ft)	(%)	After _____ ft
					After _____ ft

Augered Material - Not Documented	628 64			
Rock encountered @ approximately 2' and Augered to 4'	626 64			
Borehole continued with rock coring.				

The Unconfined Compressive Strength (UCS) Failure Mode is indicated by (B-Bulge, S-Shear, P-Penetrometer)
The SPT (N value) is the sum of the last two blow values in each sampling zone (AASHTO T206)



ROCK CORE LOG

Page 1 of 1

Date 9/25/17

ROUTE	DESCRIPTION	LOGGED BY
1-57 (FAI 57)	on West side of I-57	Larry Myers

SECTION (46-3)R, H8K, 5H8R, 6H8R LOCATION SE 1/4, SEC. 4, TWP. 30N, RNG. 13W, 2nd PM.

COUNTY	Kankakee	CORING METHOD	Solid Barrel Wire Line	R		CORE	S
--------	----------	---------------	------------------------	---	--	------	---

STRUCT. NO.	CORING BARREL TYPE & SIZE	N	W	L	2	D	C	C	Q	T	R
Station	Core Diameter					E	O	O	D	I	E
	Top of Rock Elev.					P	R	R		M	N
	Begin Core Elev.					T	E				

Depth (ft)	Penetration (ft)	Penetration (in)	Penetration (mm)	Penetration (cm)
0	1	97	13	2
626.64				770.3
621.64				749.7
0	2	100	75	2.8
				832.1
				734.6
616.64				765.4
End of Boring				

Color pictures of the cores Yes
 Cores will be stored for examination until Construction Complete
 The "Strength" column represents the uniaxial compressive strength of the core sample (ASTM D-2938)
 BBS, form 138 (Rev. 8-99)

MODEL: 0460153-6699-016-021
FILE NAME 1: jobs2019193.1901_PTB 192-011 District 3 Various Phase III Structure ProjectsWO 2 - Waldron Road over I-57DrawingWall A1Sheet0460153-6699-016-021-Wall A-soil borings.dgn

Prairie Engineers, P.C.
www.prairieengineers.com
professional design firm no. 184-005965
© Copyright Prairie Engineers, P.C. 2010

USER NAME *	DESIGNED - RHC	REVISED -
	CHECKED - CMF	REVISED -
PLOT SCALE *	DRAWN - JLM	REVISED -
PLOT DATE *	CHECKED - SMA	REVISED -

**STATE OF ILLINOIS
DEPARTMENT OF TRANSPORTATION**

WALL A SOIL BORINGS
STRUCTURE NO. 046-0153

SHEET 18 OF 23 SHEETS

F.A.I. RTE.	SECTION	COUNTY	TOTAL SHEETS	SHEET NO.
57	139HBR-6	KANKAKEE	202	161
CONTRACT NO. 66997				
BLINDS SED. AND PROJECT				

ILLINOIS	FED. AID PROJECT
----------	------------------

3/18/2021 3:51:34 PM

MODEL: 0460153-66997-016-021
FILE NAME: I:\bbs\2019\193 1901 PTB 192-011 District 3 Various Phase III Structure Projects\WO 2 - Waldron Road over I-57\Drawings\Wall A\Soil Borings.dgn



Illinois Department
of Transportation
Division of Highways
Illinois Department of Transportation

SOIL BORING LOG

Page 1 of 1

Date 9/13/17

ROUTE I-57 (FAI 57) DESCRIPTION Retaining Wall South of Waldron Road over I-57 on West side of I-57 LOGGED BY Larry Myers

SECTION (46-3)R, HBK, 5HBR, 6HBR LOCATION SE 1/4, SEC. 4, TWP. 30N, RNG. 13W, 2nd PM, Latitude 41.107697, Longitude -87.835316

COUNTY Kankakee DRILLING METHOD Hollow Stem Auger HAMMER TYPE CME Automatic

STRUCT. NO. Station B 223 232+07.62
BORING NO. Station 232+07.62
Offset 33.5 ft Rt.
Ground Surface Elev. 632.47 ft

Surface Water Elev. ft
Stream Bed Elev. ft
Groundwater Elev. ft
First Encounter Upon Completion After Hrs. ft

Augered Material - Not Documented	DEPTH (ft)	BLOW COUNT (bls)	UCS (tsf)	MOISTURE (%)	Notes
	0				
	629.47				Borehole continued with rock coring.
	-5				
	-10				
	-15				
	-20				

The Unconfined Compressive Strength (UCS) Failure Mode is indicated by (B-Bulge, S-Shear, P-Penetrometer)
The SPT (N value) is the sum of the last two blow values in each sampling zone (AASHTO T206)
BBS, form 137 (Rev. 8-99)



Illinois Department
of Transportation
Division of Highways
Illinois Department of Transportation

ROCK CORE LOG

Page 1 of 1

Date 9/13/17

ROUTE I-57 (FAI 57) DESCRIPTION Retaining Wall South of Waldron Road over I-57 on West side of I-57 LOGGED BY Larry Myers

SECTION (46-3)R, HBK, 5HBR, 6HBR LOCATION SE 1/4, SEC. 4, TWP. 30N, RNG. 13W, 2nd PM, Latitude 41.107697, Longitude -87.835316

COUNTY Kankakee CORING METHOD Split Barrel Wire Line

STRUCT. NO. Station B 223 232+07.62
BORING NO. Station 232+07.62
Offset 33.5 ft Rt.
Ground Surface Elev. 632.47 ft

CORING BARREL TYPE & SIZE N W/L 2
Core Diameter 1.9 in
Top of Rock Elev. 629.47 ft
Begin Core Elev. 629.47 ft

Core Description	DEPTH (ft)	CORRECTION (%)	RECOVERY (%)	ROQ (%)	TIME (min)	STRENGTH (tsf)
Tan to Gray Limestone with some Horizontal Fracturing, Joint Faces Oxidized Tan Color	629.47	1	83	37	2.6	744.9
	-5					585.6
	624.47					807.1
Gray Limestone with some Horizontal Fracturing, Joint Faces Oxidized Tan Color	624.47	2	100	37	2.8	872.1
	-10					803.2
	619.47					771.2
End of Boring						746.6
	-15					
	-20					

Color pictures of the cores Yes
Cores will be stored for examination until Construction Complete
The "Strength" column represents the uniaxial compressive strength of the core sample (ASTM D-2938)
BBS, form 138 (Rev. 8-99)

Pralrie Engineers, P.C.
www.pralrieengineers.com
professional design firm no. 184-005965
© Copyright Pralrie Engineers, P.C. 2018


USER NAME	DESIGNED - RHC	REVISED -
CHECKED - CMF	REVISED -	
PLOT SCALE	DRAWN - JLM	REVISED -
PLOT DATE	CHECKED - SMA	REVISED -

STATE OF ILLINOIS
DEPARTMENT OF TRANSPORTATION

WALL A SOIL BORINGS
STRUCTURE NO. 046-0153

SHEET 19 OF 23 SHEETS

FAI RTE.	SECTION	COUNTY	TOTAL SHEETS	SHEET NO.
57	139HBR-6	KANKAKEE	202	162
CONTRACT NO. 66997				
ILLINOIS FED. AID PROJECT				

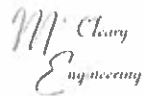

3705 Progress Blvd
Peru, IL 61354
815 780-8488

SOIL BORING LOG

Solutions You Can Build On
ROUTE FAI 57 DESCRIPTION Retaining wall west of I-57, south of K B & S Railroad Crossing LOGGED BY TLM

Date 12/18/17

SECTION (46-3)R.HBK.5HBR.6HBR LOCATION SE 1/4, SEC. 4, TWP. 30N, RNG. 13W, 2nd PM
COUNTY Kankakee DRILLING METHOD Hollow Stem Auger HAMMER TYPE CME Automatic

STRUCT. NO.	DEPT	BLOW	UCS	MOIST	Surface Water Elev.	DEPT	BLOW	UCS	MOIST
Station	H	S	Qu	T	ft	H	S	Qu	T
BORING NO. B-224					ft				
Station 227+30					ft				
Offset 148.0 ft RL					ft				
Ground Surface Elev. 650.69	(ft)	(ft)	(tsf)	(%)	ft	(ft)	(ft)	(tsf)	(%)
Brown Topsoil, Silty Loam Timber Soil, moist									
649.19	4	4.5	18		629.19	3	2.5	12	
Hard brown & gray Silty Clay, dry	10	14	P			8	B	4.5	P
	7					6			
	11	4.5	16		626.19	18	5.2	5	
645.19	18	P				94	B		
Hard brown Silty Clay, dry	9					85/1*			
	15	4.5	14					5	
642.69	20	P							
Hard brown & dark gray Silty Clay Till	7					50/25			
	12	4.5	15		620.69			4	
640.19	19	P							
Hard gray Clay, trace fine gravel	5								
	9	7.0	18						
	11	B							
	5								
	5	4.7	17						
635.19	9	B							
Very stiff gray Clay	3								
	5	3.1	19						
	8	B							
	3								
	5	2.9	21						
	7	B							

The Unconfined Compressive Strength (UCS) Failure Mode is indicated by (B-Bulge, S-Shear, P-Penetrometer)
The SPT (N value) is the sum of the last two blow values in each sampling zone (AASHTO T206)
BBS, form 137 (Rev. 8-99)



3705 Progress Blvd
Peru, IL 61354
815 780-8488

ROCK CORE LOG

Solutions You Can Build On
ROUTE FAI 57 DESCRIPTION Retaining wall west of I-57, south of K B & S Railroad Crossing LOGGED BY TLM

Date 12/18/17

SECTION (46-3)R.HBK.5HBR.6HBR LOCATION SE 1/4, SEC. 4, TWP. 30N, RNG. 13W, 2nd PM
COUNTY Kankakee CORING METHOD Wireline

STRUCT. NO.	CORING BARREL TYPE & SIZE	NO	DEPT	CORRE	RECOVER	R.Q.	TIME	STRENGTH
Station			H	E	Y	(%)	(min)	(tsf)
BORING NO. B-224	Core Diameter 2 in							
Station 227+30	Top of Rock Elev. 624.69 ft							
Offset 148.0 ft RL	Begin Core Elev. 620.69 ft							
Ground Surface Elev. 650.69	ft		(ft)	(ft)	(%)	(%)	(min)	(tsf)
Brown & gray fractured Dolostone with Shale partings				1	100	0	4	
620.69								
619.19				2	100	13	2	
Gray Dolostone with frequent & thin Shale partings. Crystal lined void approximately 2' wide x 0.5' tall & 1.5' deep. Some pyrite present in void. Void is 2.92' down from top of rock.								769.0
								796.0
								235.0
610.69								
End of Boring								

Color pictures of the cores Yes
Cores will be stored for examination until
The "Strength" column represents the uniaxial compressive strength of the core sample (ASTM D-2938)
BBS, form 136 (Rev. 8-99)

MODEL: 0460153-66997-016-021
FILE NAME: I:\0460153-66997-016-021\Drawing\Wall A-Soil Borings.dgn
PTB 192-011 District 3 Various Phase III Structure Projects\WO 2 - Waldron Road over I-57\Drawing\Wall A-Soil Borings.dgn

Prairie Engineers, P.C.
www.prairieengineers.com
professional design firm no. 184-005965
Copyright Prairie Engineers, P.C. 2018

USER NAME	DESIGNED	RHC	REVISED
CHECKED	CMF	REVISED	
PLOT SCALE	DRAWN	JLM	REVISED
PLOT DATE	CHECKED	SMA	REVISED

STATE OF ILLINOIS
DEPARTMENT OF TRANSPORTATION

WALL A SOIL BORINGS
STRUCTURE NO. 046-0153

SHEET 20 OF 23 SHEETS

F.A.I. RTE	SECTION	COUNTY	TOTAL SHEETS	SHEET NO.
57	139HBR-6	KANKAKEE	202	163
CONTRACT NO. 66997				
ILLINOIS FED. AID PROJECT				

SOIL BORING LOG

Page 1 of 1

Date 3/27/10

ROUTE	DESCRIPTION	LOGGED BY
1-57 (FAI 57)	Investigation	Larry Myers

SECTION (48-3)R, HBK, 5HBR, 6HBR LOCATION SE 1/4, SEC. 4, TWP. 30N, RNG. 13W,

COUNTY Kankakee DRILLING METHOD Hollow Stem Auger HAMMER TYPE CME Automatic

STRUCT. NO.	046-0080	D	B	U	M	Surface Water Elev.	ft	D	B	U	M
Station	230+53.99 (Exist.)	E	L	C	O	Stream Bed Elev.	ft	E	L	C	O

BORING NO. <u>8H 101 (NW Quad.)</u>	T	W		S	Groundwater Elev.:	T	W		S
Station <u>229+13.97</u>	H	S	Qu	T	First Encounter _____ ft	H	S	Qu	T
Offset <u>82.1 ft RL</u>					Upon Completion _____ ft				
Ground Surface Elev. <u>657.19</u> ft (ft) (/6") (tsf) (%)					After _____ Hrs. _____ ft (ft) (/6") (tsf) (%)				

Augered Bituminous, Sand & Gravel & Black, Gray, Silty Clay Loam Fill				Hard Brown to Gray Silty Clay/Silty Clay Loam Till (continued)		5			
						6	4.6	19	
						7	S		
654 69									
Very Stiff to Hard, Gray/Brown/Black, Silty Loam/Silty Clay Loam Till Fill with Rock & Concrete Debris		4				3			
		5	3.5	23		5	4.0	22	
		6	P			7	S		
					632 19				
		3		Hard Gray Silty Clay Loam Till with Large Gravel Pieces		4			
		4	3.5		18		8	4.0	12
		5	P				12	P	
					829 69				
648 69		3		Assumed Dolostone Surface, Auger Refusal End of Boring		100/1'	No		
		5					Recovery		
		8	4.3		22				
Hard Gray & Brown Silty Clay/Silty Clay Loam									
647 19		8				30			
Hard, Brown, Silty Clay Loam Till									
		12	8.2	17					
		14	S						
		9							
		10	8.2	19					
		11	S						
642 19									
Very Stiff Brown Silty Loam Till with Silt Layers		3							
		4	3.0	20					
		5	P						
		3							
		4	3.0	18					
		5	P						
637 69									

The Unconfined Compressive Strength (UCS) Failure Mode is indicated by (B-Bulge, S-Shear, P-Penetrometer)
The SPT (N value) is the sum of the last two blow values in each sampling zone (AASHTO T206)

BBS, form 137 (Rev. 8-99)



SOIL BORING LOG

Page 1 of 1

Date 9/7/17

ROUTE	1-57 (FAI 57)	DESCRIPTION	45/52	LOGGED BY	Larry Meyer
-------	---------------	-------------	-------	-----------	-------------

SECTION (46-3)R, HBK, 5HBR, 6HBR LOCATION SE 1/4, SEC. 4, TWP. 30N, RNG. 13W, 2ND PM

COUNTY Kankakee DRILLING METHOD Hollow Stem Auger HAMMER TYPE CME Automatic

STRUCT. NO.	046-0080 (EX)	D	B	U	M	Surface Water Elev.	_____ ft	D	B	U	M
Station	230+53.99 (EX)	E	L	C	O	Stream Bed Elev.	_____ ft	E	L	C	O

BORING NO. <u>B 219 (N. Abut.)</u>	T	W		S	Groundwater Elev.:	T	W		S
Station <u>229+18.36</u>	H	S	Qu	T	First Encounter _____ ft	H	S	Qu	T
Offset <u>87.5 ft RL</u>					Upon Completion _____ ft				
Ground Surface Elev. <u>657.30</u> ft	(ft)	(ft)	(tsf)	(%)	After _____ Hrs. _____ ft	(ft)	(ft)	(tsf)	(%)

	Augered Material - Not Documented	Augered Material - Not Documented (<i>continued</i>)
	-8	-25
	-10	-30
		624.80
	-15	-35
		Borehole continued with rock coring.
	-20	-40

The Unconfined Compressive Strength (UCS) Failure Mode is indicated by (B-Bulge, S-Shear, P-Penetrometer)
The SPT (N value) is the sum of the last two blow values in each sampling zone (AASHTO T206)

BBS, form 137 (Rev. 8-99)



ROCK CORE LOG

Page 1 of 1

Date 9/7/17

ROUTE	1-57 (FAI 57)	DESCRIPTION	45/52	LOGGED BY	Larry Myers
-------	---------------	-------------	-------	-----------	-------------

SECTION (46-3)R, HBK, 5HBR, 6HBR LOCATION SE 1/4, SEC. 4, TWP. 30N, RNG. 13W, 2nd PM.

COUNTY Kankakee CORING METHOD Split Barrel Wire Line

STRUCT. NO.	046-0080 (EX)	CORING BARREL TYPE & SIZE	N W/L 2	D	C	C	Q	T	R
Station	230+53.99 (EX)			E	O	O		M	E

BORING NO.	B 218 (N Abut)	Top of Rock Elev.	624.80	ft	P	R	E	D	E	G
Station	229+18.36	Begin Core Elev.	624.80	ft	T	E	R	.		H
Offset	87.5 ft RI				H		R			
Ground Surface Elev.	657.30	ft			(ft)	(#)	(%)	(%)	(min/ft)	(tsf)

	624.80	1	97	28	2.2	
Dense Gray Limestone with Generally Tight Horizontal Fractures. Interbedded Thin Shale Seams in top 6"						
Minor Calcite Crystal Vug Fill						895.1
	-35					
						822.2
						732.4
	619.80					
Dense Gray Limestone with Tight Horizontal Fracturing		2	100	55	1.6	1359.7
Minor Calcite Crystal Vug Fill						1354.8
	-40					
						1156.4
	614.80					
Dense Gray Limestone with Tight Horizontal Fractures		3	100	83	3.2	
Minor Calcite Crystal Vug Fill						1005.9
	-45					
						1198.5
						598.8
	609.80					809.0
End of Boring						
	-50					

Color pictures of the cores Yes
Cores will be stored for examination until construction complete

The "Strength" column represents the uniaxial compressive strength of the core sample (ASTM D-2938)

BBS, form 138 (Rev. 8-99)

Prairie Engineers, P.C.
www.prairieengineers.com
professional design firm no. 184-005965
© Copyright Prairie Engineers, P.C. 2018

USER NAME	DESIGNED	RHC	REVISED
	CHECKED	CMF	REVISED
PLOT SCALE	DRAWN	JLM	REVISED
PROJECT NAME	CHECKED	CALL	REVISED

**STATE OF ILLINOIS
DEPARTMENT OF TRANSPORTATION**


WALL A SOIL BORINGS
STRUCTURE NO. 046-0153

SHEET 21 OF 23 SHEETS

F.A.I. RTE.	SECTION	COUNTY	TOTAL SHEETS	SHEET NO.
57	139HBR-6	KANKAKEE	202	164
			CONTRACT NO. 66997	
ILLINOIS FED. AND PROVCT				



MODEL: 0460153-66997-016-021
FILE NAME \\bobs\2019\193 1901 PTB 192-011 District 3 Various Phase III Structure Projects\WO 2 - Waldron Road over I-57\Drawing\wall A\Sheet\0460153-66997-016-021-Wall A-sol borings.dgn

3/18/2021 3:55:53 PM

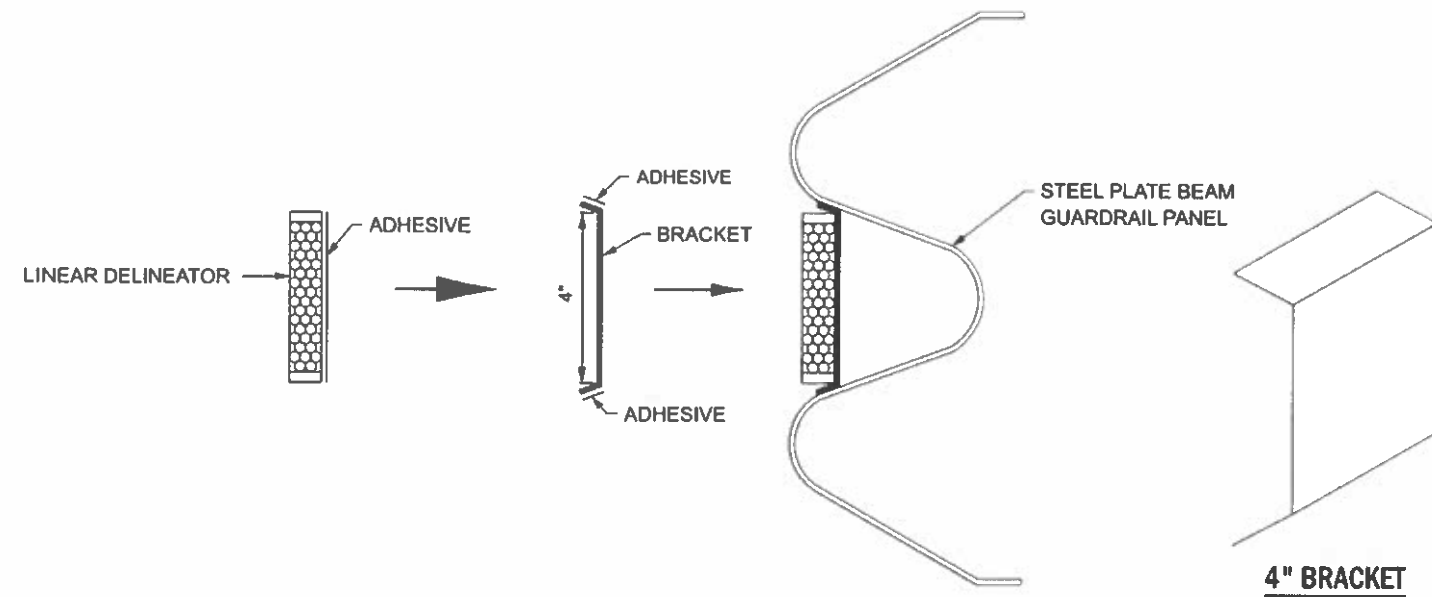

LINEATOR DELINEATOR APPLICATION TO STANDARD GALVANIZED GUARDRAIL

LINEATOR DELINEATOR SHALL BE APPLIED ACCORDING TO THE MANUFACTURER'S RECOMMENDATIONS

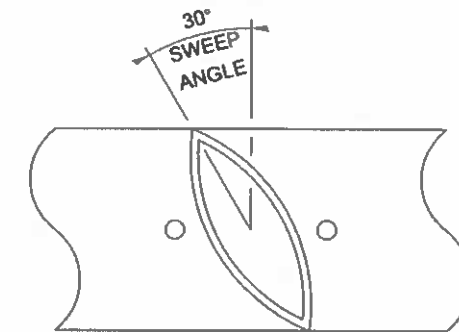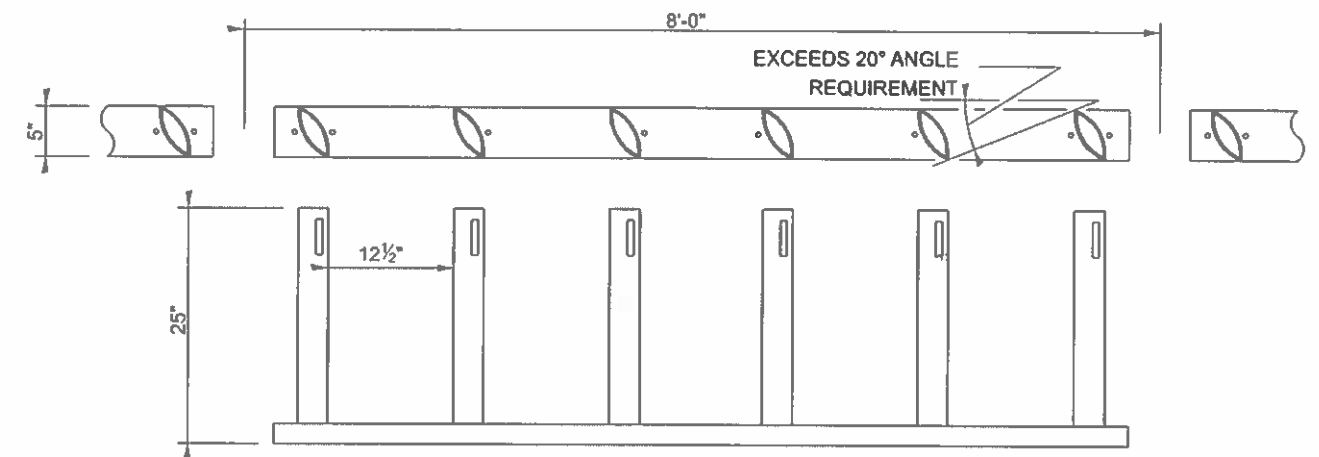

DETAIL DRAWING

MODULAR GLARE SCREEN BLADES

MODEL: Plan-1
FILE NAME: D:\6697-3\1-Drawings.dgn

TranSmart
411 South Wells Street Suite 1000
Chicago, Illinois 60607



USER NAME	rsalazar	DESIGNED	NS	REVISED	-
DRAWN	NS	REVIS	-		
PLOT SCALE	0.10000033" = 1"	CHECKED	TW	REVIS	-
PLOT DATE	3/29/2021	DATE	2021/03/26	REVISED	-

STATE OF ILLINOIS
DEPARTMENT OF TRANSPORTATION

ROADWAY DETAILS
LINEAR DELINEATOR, 4" & MODULAR GLARE SCREEN

SCALE: NTS SHEET OF SHEETS STA TO STA


F.A.L. RTE.	SECTION	COUNTY	TOTAL SHEETS	SHEET NO.
57	139 HBR-6	KANKAKEE	8TOT	168
CONTRACT NO. 66997				
RAI/MS FED. AID PROJECT				

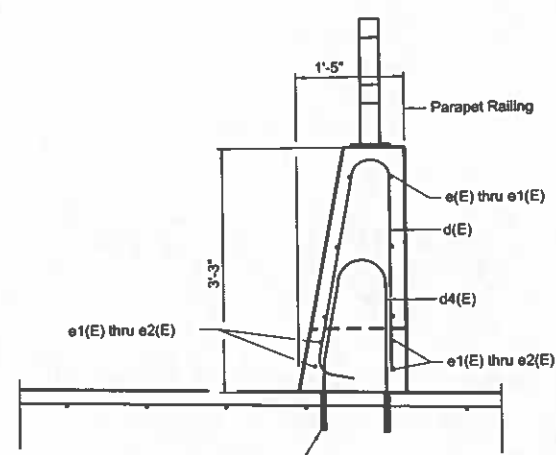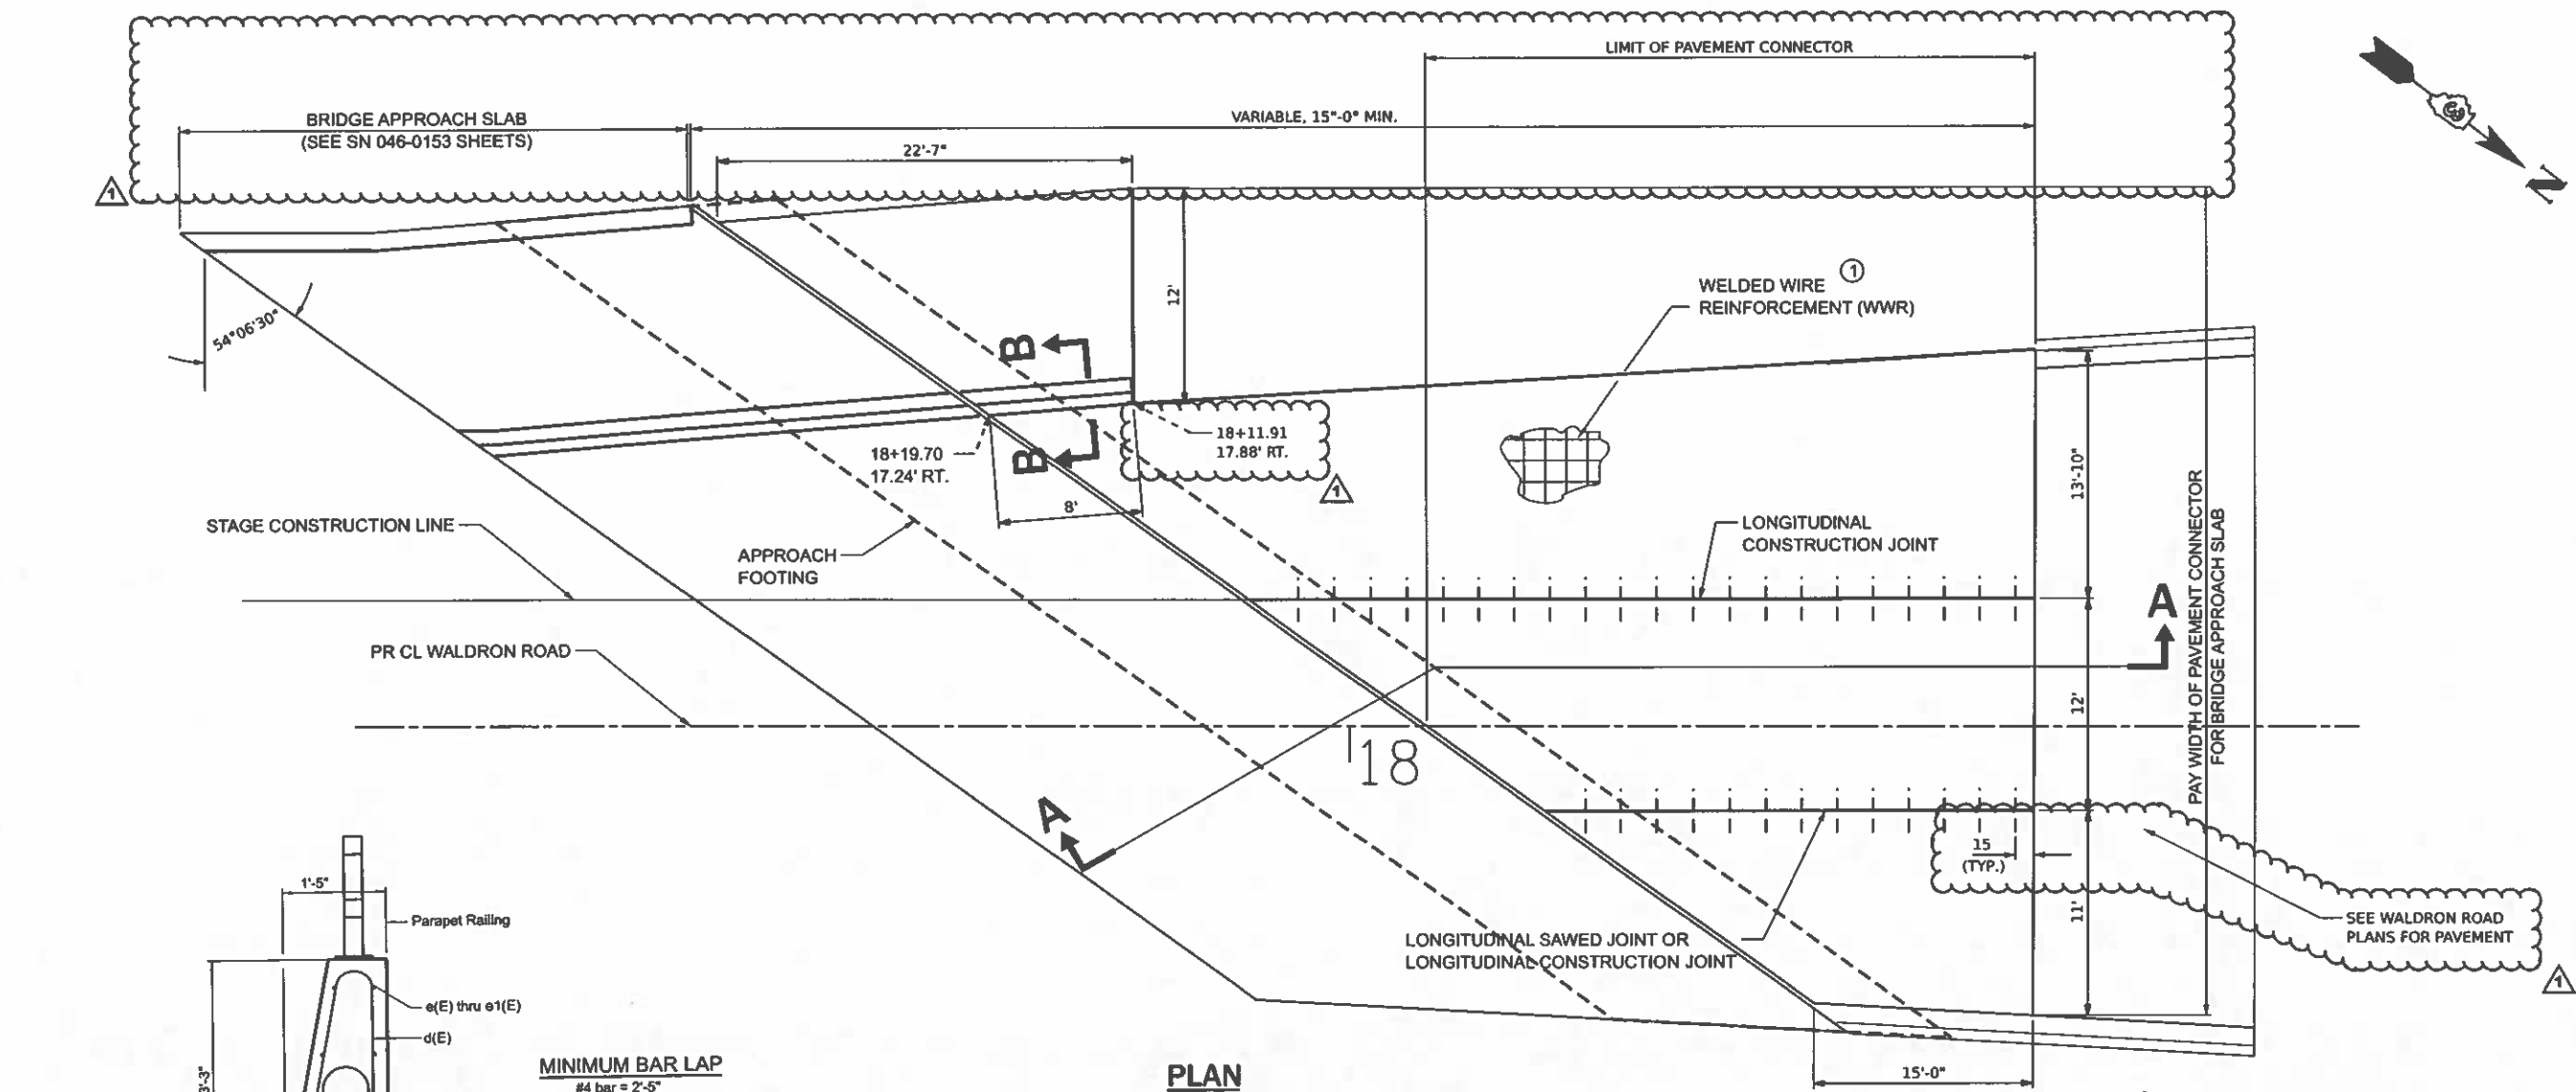

Drill and set #5 d4(E) bars according to Article 584 of the Standard Specifications. Drilled holes shall be roughed or scored per Manufacturer's recommendations. Maximum depth of hole shall not exceed 6". Contractor shall take all necessary precautions to prevent drilled hole interference with welded wire reinforcement.

SECTION B-B

**PLAN
NORTH PAVEMENT CONNECTOR**
STA 17+60 TO STA 18+26

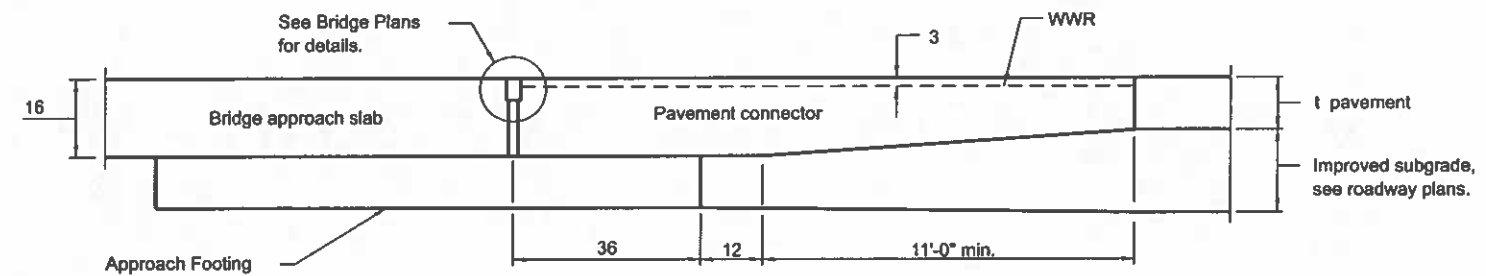

SECTION A-A

① WWR shall be 0.11 sq. in./ft. in both directions. Maximum wire spacing shall be 6". Minimum lap distance shall be two cross wires.

GENERAL NOTES

- THICKNESS-"t"=Thickness of Pavement.
- Concrete barrier, reinforcement bars and parapet railing will be included in the cost of PAVEMENT CONNECTOR FOR BRIDGE APPROACH SLAB.
- See Standard 420001 for pavement joint details not shown.
- See Standard 610001 for shoulder inlet with curb when required.
- See plans for details of bridge approach slab, approach footing and joint treatment.
- All dimensions are in inches unless otherwise shown.

MODEL: Plan 1
FILE NAME: D:\08097-Sm-Creek-03.dgn

TranSmart
411 South Wells Street Suite 1000
Chicago, Illinois 60607



USER NAME = ashic	DESIGNED = NS	REVISED =
DRAWN = NS	REVISOR =	
CHECKED = TW	REVISOR =	
DATE = 2021/03/26	REVISOR =	

**STATE OF ILLINOIS
DEPARTMENT OF TRANSPORTATION**


PAVEMENT CONNECTOR (PCC) FOR BRIDGE APPROACH SLAB			
SCALE: NTS	SHEET 1	OF 2 SHEETS	STA. TO STA.

F.A.I. RTE.	SECTION	COUNTY	TOTAL SHEETS	SHEET NO.
57	139 HBR-6	KANKAKEE	202	169
CONTRACT NO. 66997				
ILLINOIS FED. AID PROJECT				

REV. 08/25/21

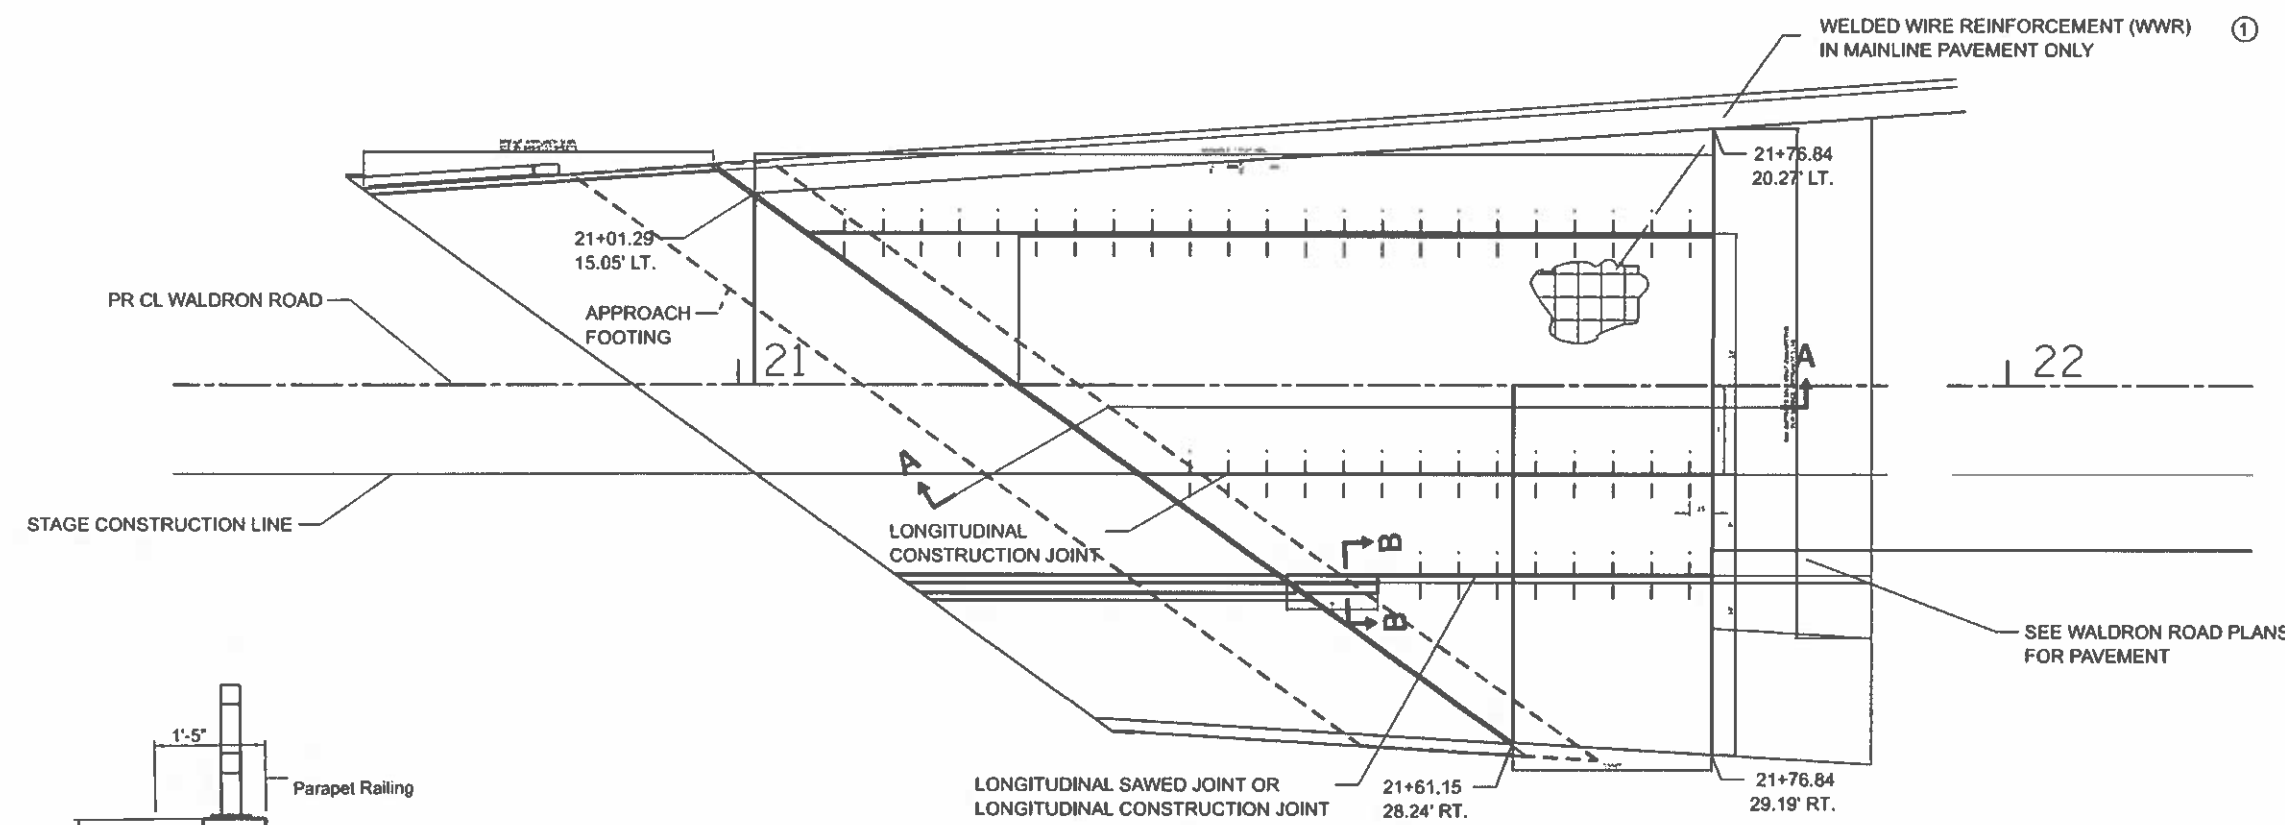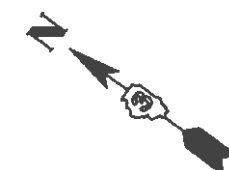


PLAN
SOUTH PAVEMENT CONNECTOR

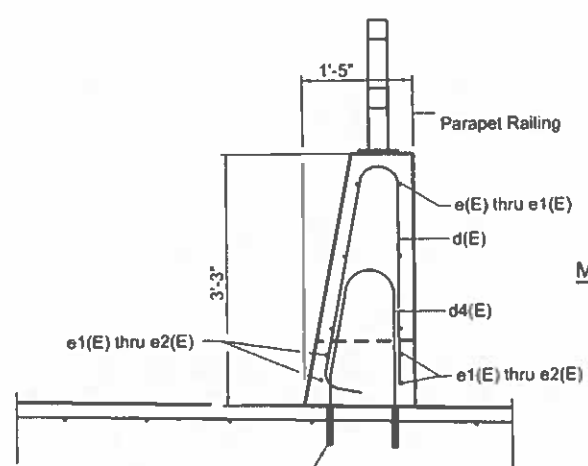

Drill and set #5 d4(E) bars according to Article 584 of the Standard Specifications. Drilled holes shall be roughed or scored per Manufacturer's recommendations. Maximum depth of hole shall not exceed 6". Contractor shall take all necessary precautions to prevent drilled hole interference with welded wire reinforcement.

MINIMUM BAR LAP
#4 bar = 2'-5"

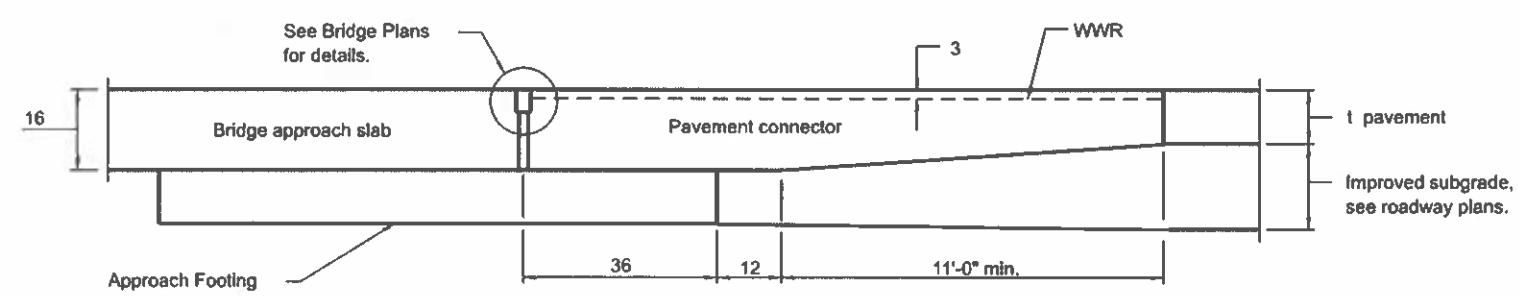

SECTION A-A

SECTION B-B

- ① WWR shall be 0.11 sq. in./ft. in both directions. Maximum wire spacing shall be 6". Minimum lap distance shall be two cross wires.

GENERAL NOTES

THICKNESS-"t"=Thickness of Pavement.

Concrete barrier, reinforcement bars and parapet railing will be included in the cost of PAVEMENT CONNECTOR FOR BRIDGE APPROACH SLAB.

See Standard 420001 for pavement joint details not shown.

See Standard 610001 for shoulder inlet with curb when required.

See plans for details of bridge approach slab, approach footing and joint treatment.

All dimensions are in inches unless otherwise shown.

MOORE, Plan 1
FILE NAME: D:\Users\Shirley\Desktop\sign




TransSmart
411 South Wells Street Suite 1000
Chicago, Illinois 60607

USER NAME	DESIGNED - NS	REVISED -
PLOT SCALE - 0.1866833 / in.	DRAWN - NS	REVISED -
PLOT DATE - 3/29/2021	CHECKED - TW	REVISED -
	DATE - 2021/03/26	REVISED -

STATE OF ILLINOIS
DEPARTMENT OF TRANSPORTATION

PAVEMENT CONNECTOR (PCC) FOR BRIDGE APPROACH SLAB			
SCALE: NTS	SHEET 2	OF 2	SHEETS
STA.	TO STA.		

F.A.L. RTE.	SECTION	COUNTY	TOTAL SHEETS	SHEET NO.
57	139 HBR-6	KANKAKEE	202	170
CONTRACT NO. 66997				
ILLINOIS FED. AID PROJECT				

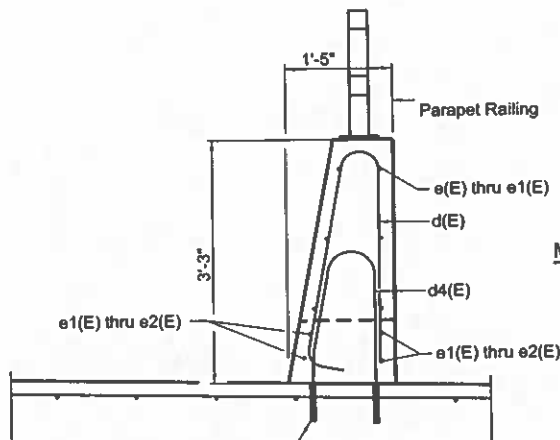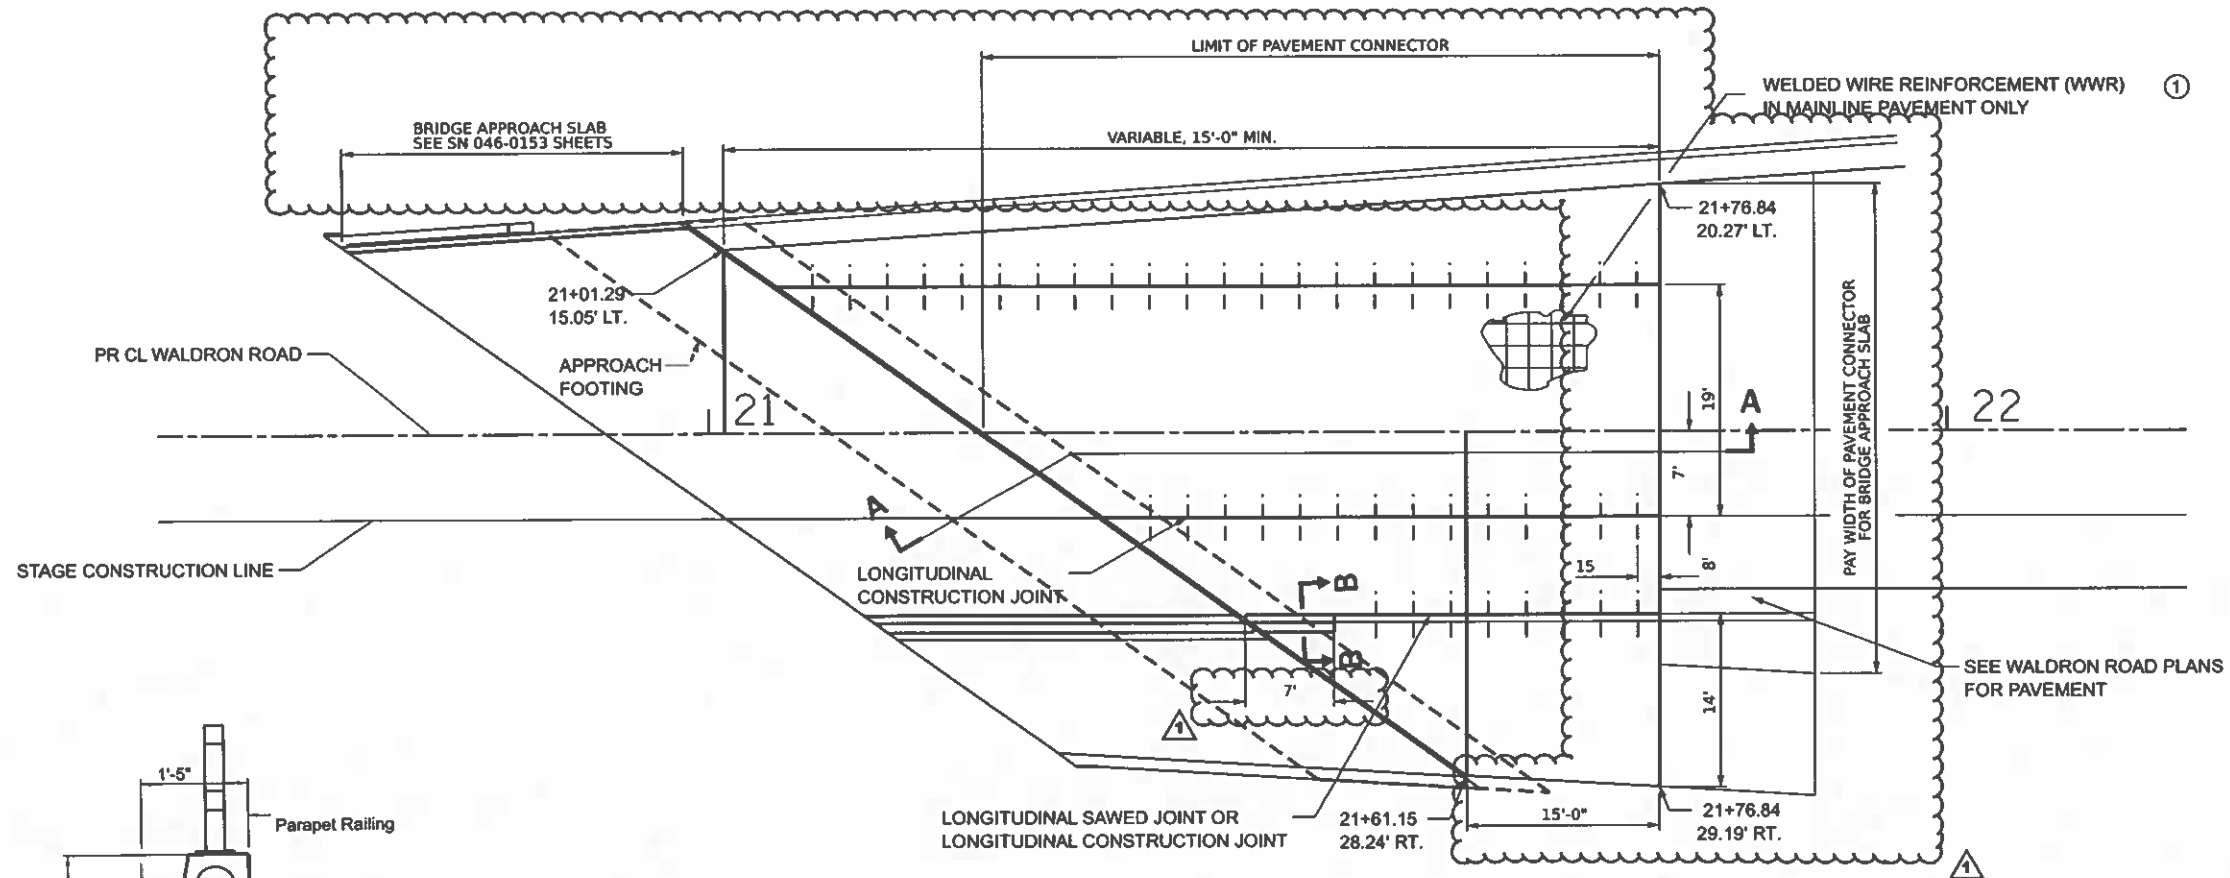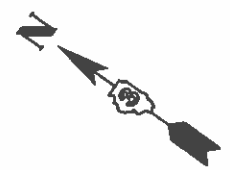


Drill and set #5 d4(E) bars according to Article 584 of the Standard Specifications. Drilled holes shall be roughed or scored per Manufacturer's recommendations. Maximum depth of hole shall not exceed 6". Contractor shall take all necessary precautions to prevent drilled hole interference with welded wire reinforcement.

MINIMUM BAR LAP
#4 bar = 2'-5"

PLAN SOUTH PAVEMENT CONNECTOR

STA. 21+22 TO STA 21+76

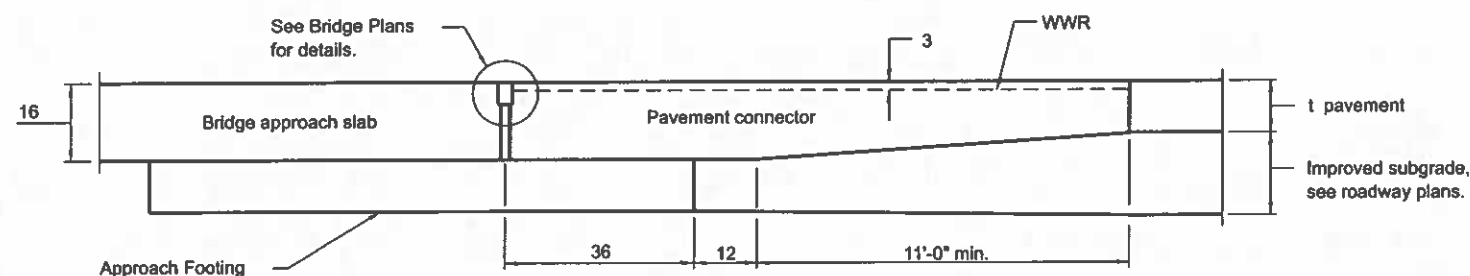

SECTION B-B

SECTION A-A

- ① WWR shall be 0.11 sq. in./ft. in both directions. Maximum wire spacing shall be 6". Minimum lap distance shall be two cross wires.

GENERAL NOTES

THICKNESS-"t"=Thickness of Pavement.

Concrete barrier, reinforcement bars and parapet railing will be included in the cost of PAVEMENT CONNECTOR FOR BRIDGE APPROACH SLAB.

See Standard 420001 for pavement joint details not shown.

See Standard 610001 for shoulder inlet with curb when required.

See plans for details of bridge approach slab, approach footing and joint treatment.

All dimensions are in inches unless otherwise shown.

MODEL: Plan 1
FILE NAME: D:\Bentley\Bentley-04.dgn

TranSmart
411 South Wells Street Suite 1000
Chicago, Illinois 60607

USER NAME = asbhc	DESIGNED - NS	REVISED -
	DRAWN - NS	REVISED -
PLOT SCALE = 0.19899533' / in.	CHECKED - TW	REVISED -
PLOT DATE = 7/9/2021	DATE - 2021/03/26	REVISED -

STATE OF ILLINOIS
DEPARTMENT OF TRANSPORTATION






PAVEMENT CONNECTOR (PCC)
FOR BRIDGE APPROACH SLAB

SCALE: NTS SHEET 2 OF 2 SHEETS STA. TO STA.

F.A.I. RTE.	SECTION	COUNTY	TOTAL SHEETS	SHEET NO.
57	139 HBR-6	KANKAKEE	202	170A
CONTRACT NO. 66997				

ILLINOIS FED. AID PROJECT


REV. 08/25/21

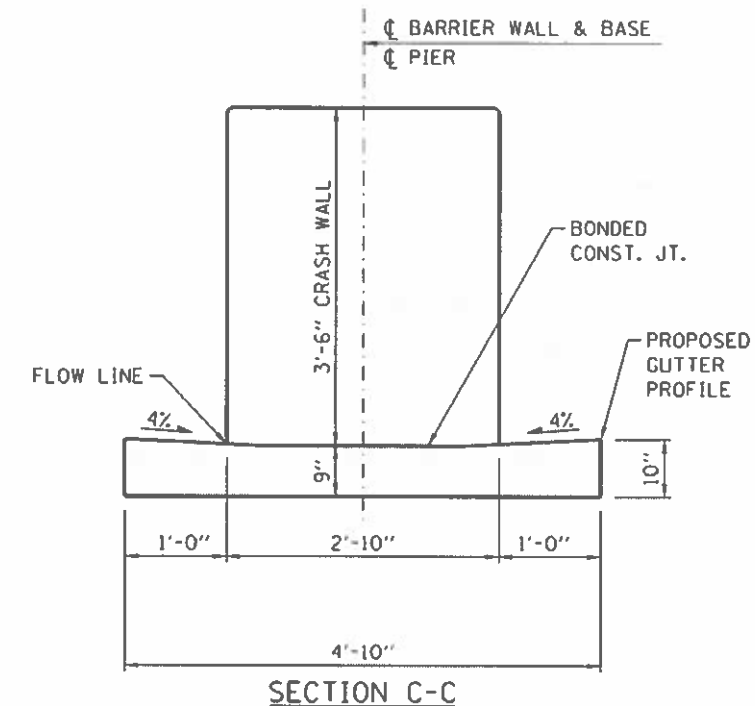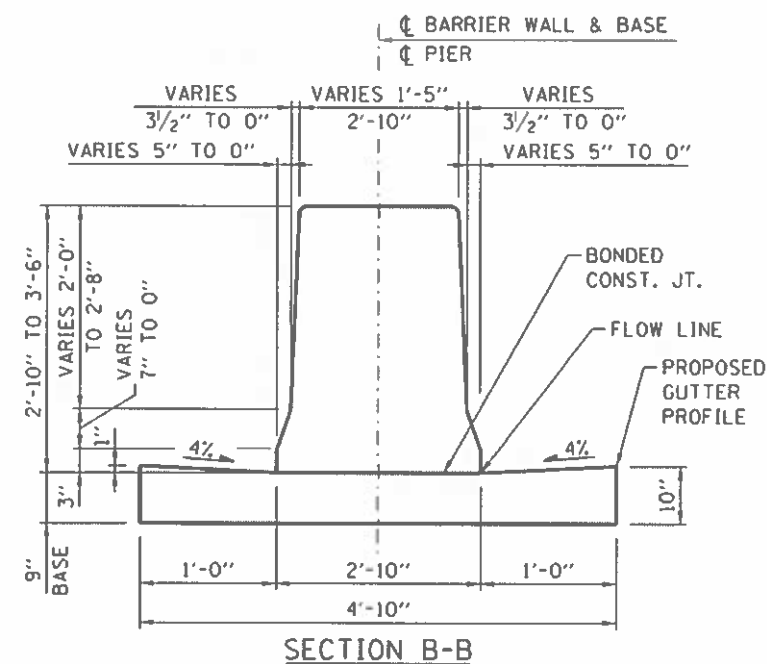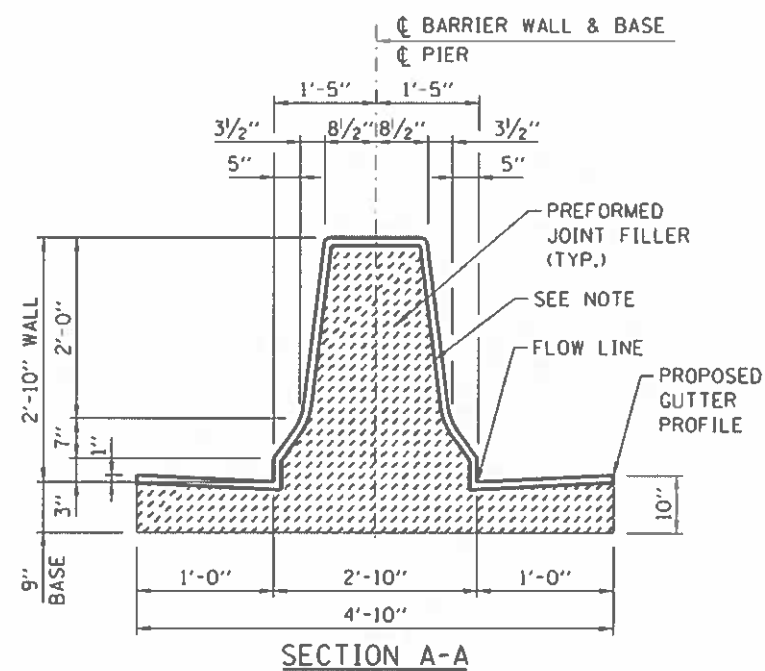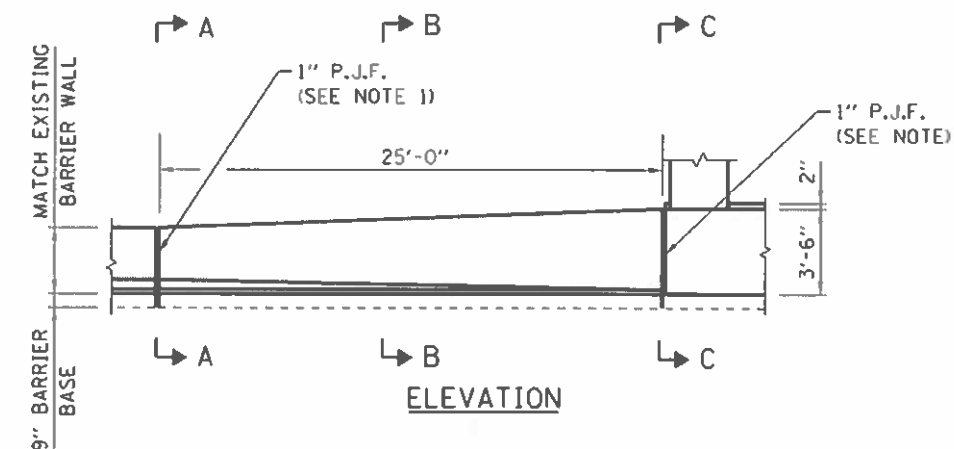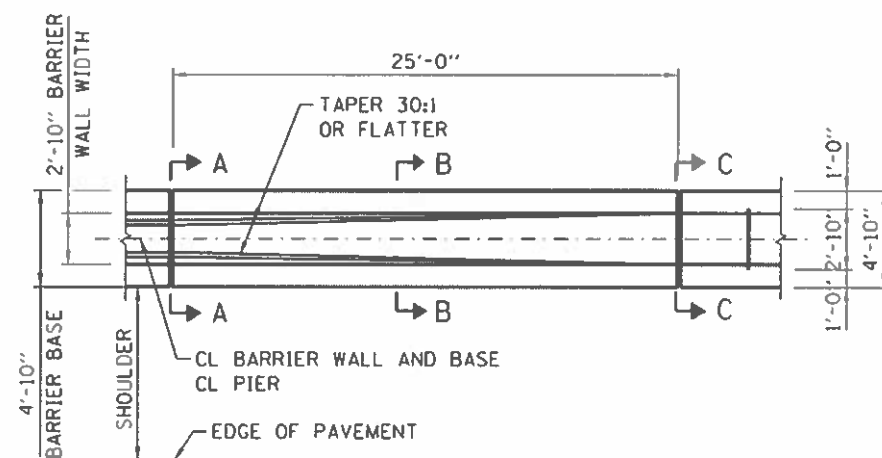

NOTE:

1. NON-STAINING GRAY ONE COMPONENT NON-SAG ELASTOMERIC GUN GRADE POLYURETHANE SEALANT MEETING THE REQUIREMENTS OF ASTM C-920, TYPE S, GRADE NS, CLASS 25, USE T WITH A BACKER ROD.
2. COST OF MATERIAL AND INSTALLATION OF PERFORMED JOINT FILLER TO BE INCLUDED IN CONCRETE BARRIER TRANSITION.

CONCRETE BARRIER TRANSITION

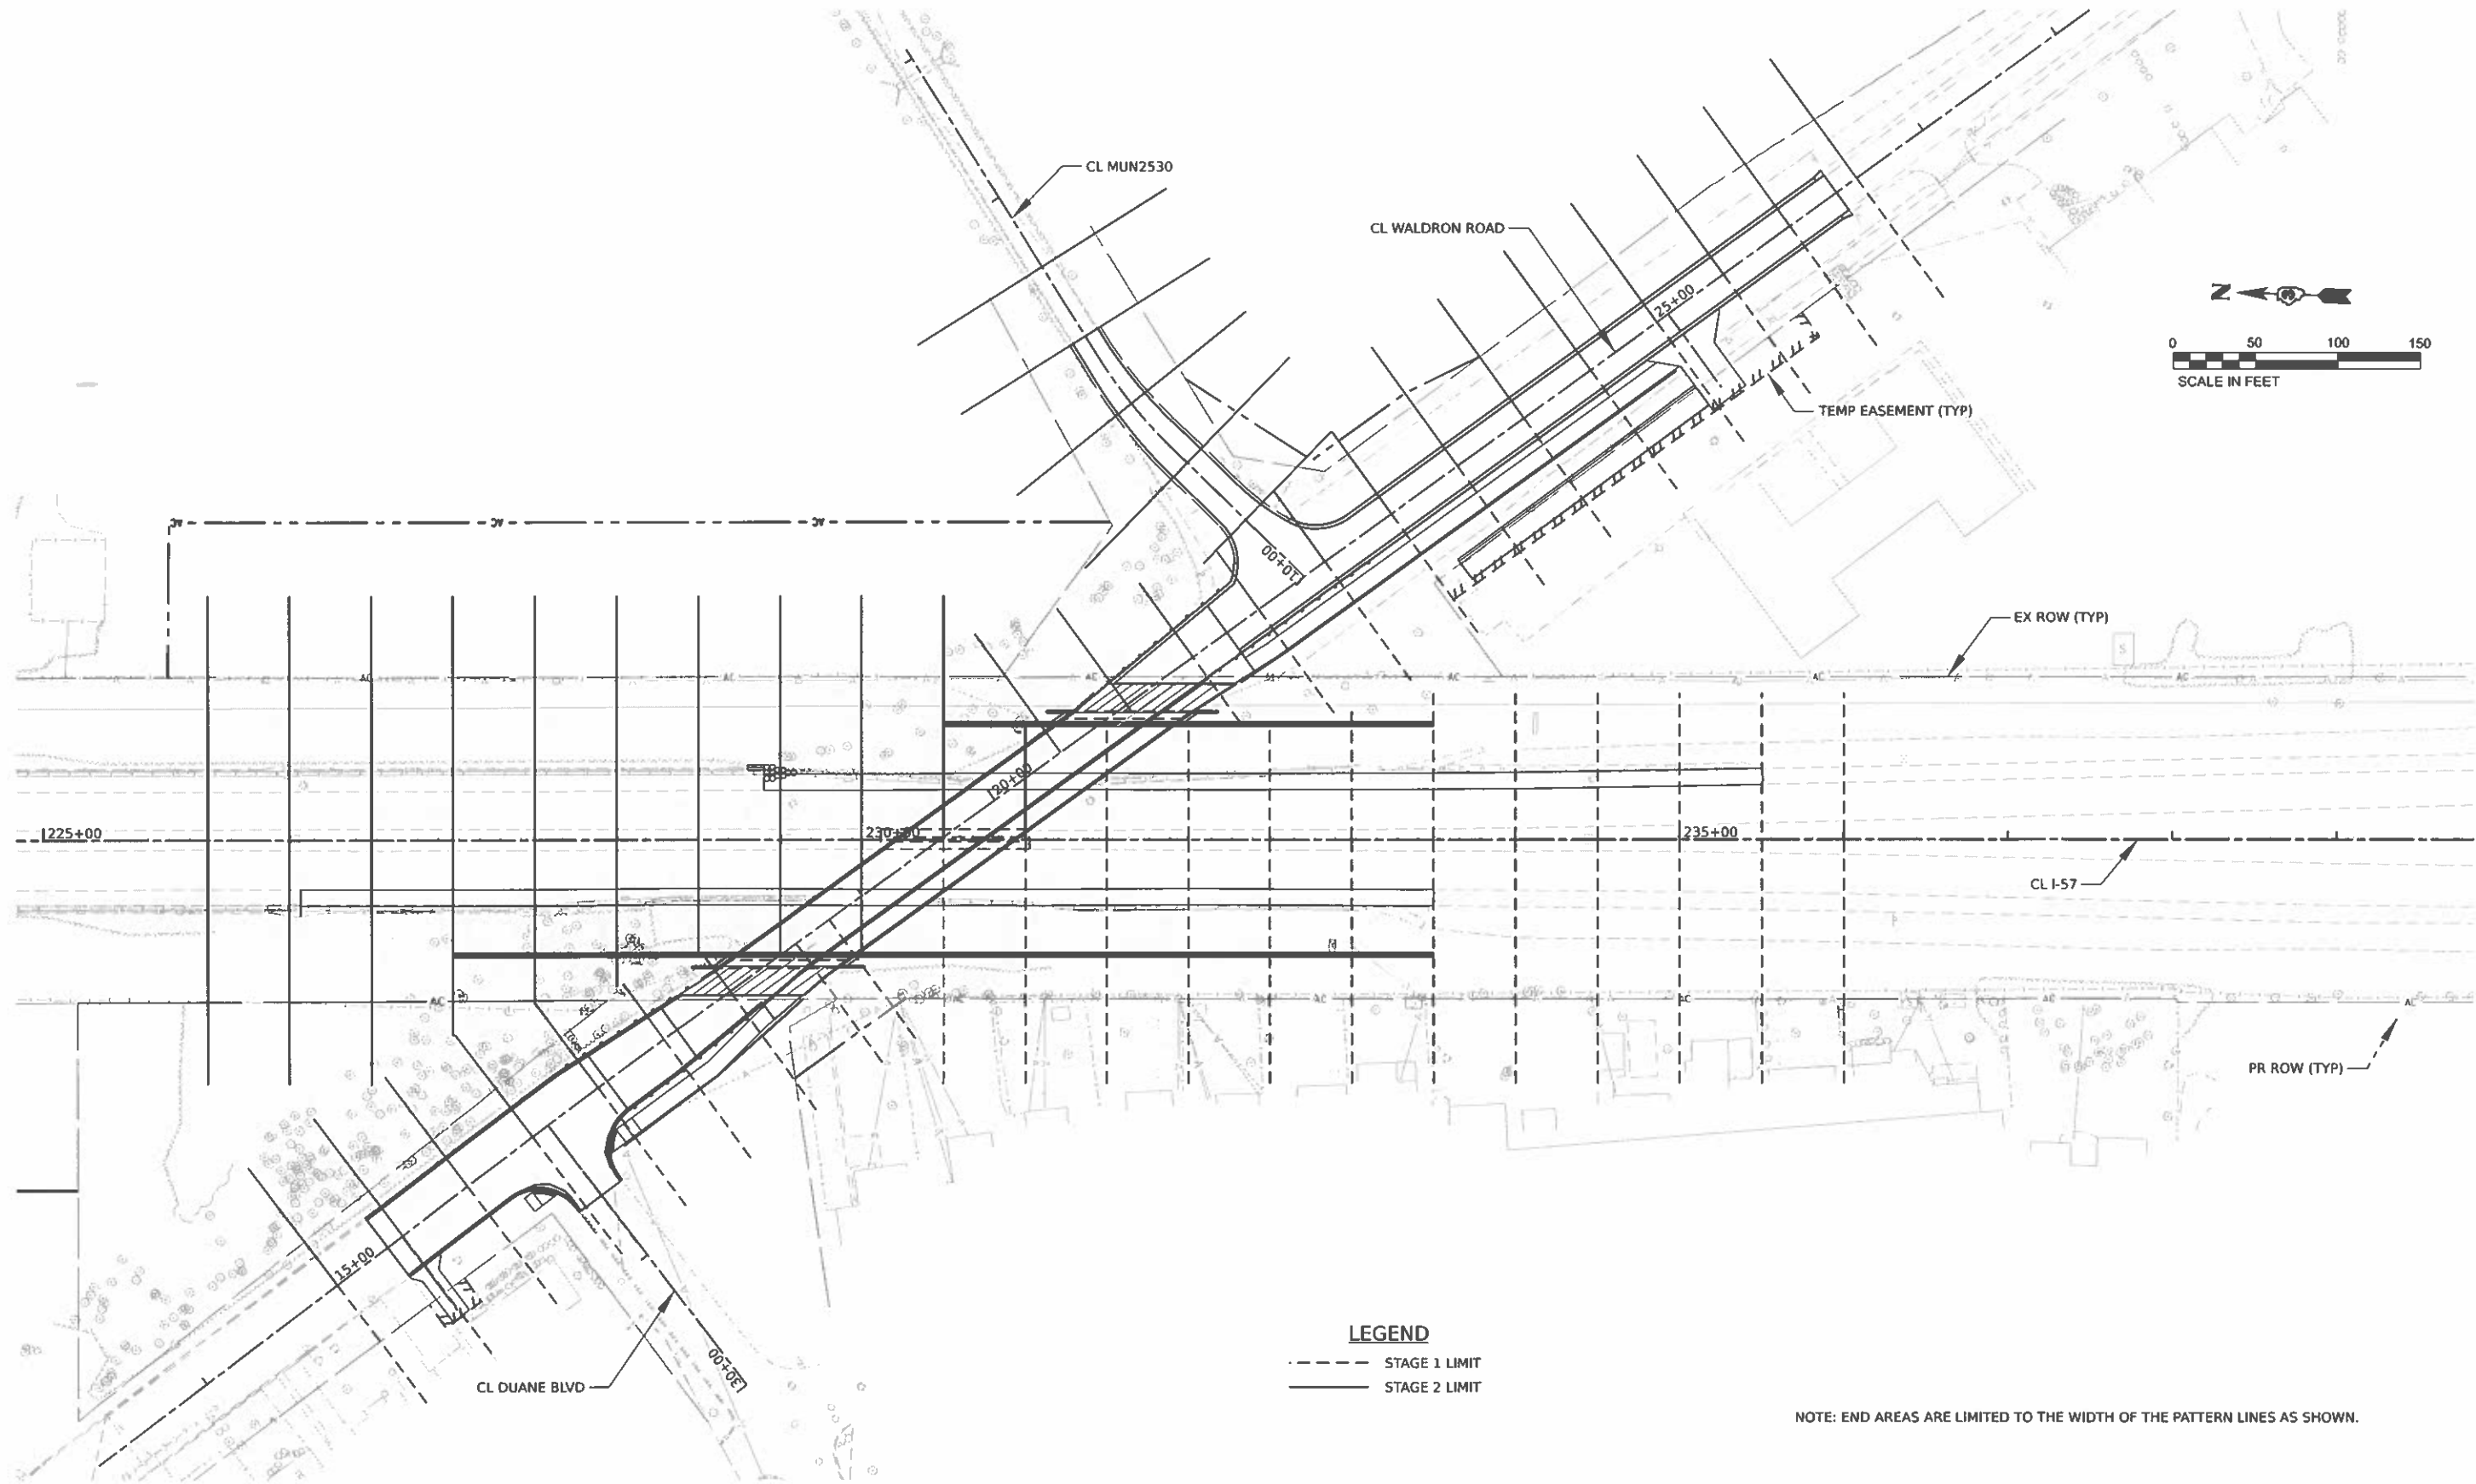

LEGEND
--- STAGE 1 LIMIT
--- STAGE 2 LIMIT

NOTE: END AREAS ARE LIMITED TO THE WIDTH OF THE PATTERN LINES AS SHOWN.


MODEL: Plan 1
FILE NAME: D:\060603\SH-Plan.mxd


USER NAME	* mshelton	DESIGNED	- BJD	REVISED	-
		DRAWN	- BJD	REVISED	-
PLOT SCALE	* 0.16666633" / ft.	CHECKED	- TW	REVISED	-
PLOT DATE	* 3/29/2021	DATE	-	REVISED	-

STATE OF ILLINOIS
DEPARTMENT OF TRANSPORTATION

I-57 & WALDRON ROAD CROSS SECTION PATTERNS			
SCALE: 1" = 50'	SHEET 1	OF 1	SHEETS
STA.	TO STA.		

F.A.I. RTE. 57	SECTION 139 HBR-6	COUNTY KANKAKEE	TOTAL SHEETS 202	SHEET NO. 171
CONTRACT NO. 66997				
ILLINOIS FED. AID PROJECT				

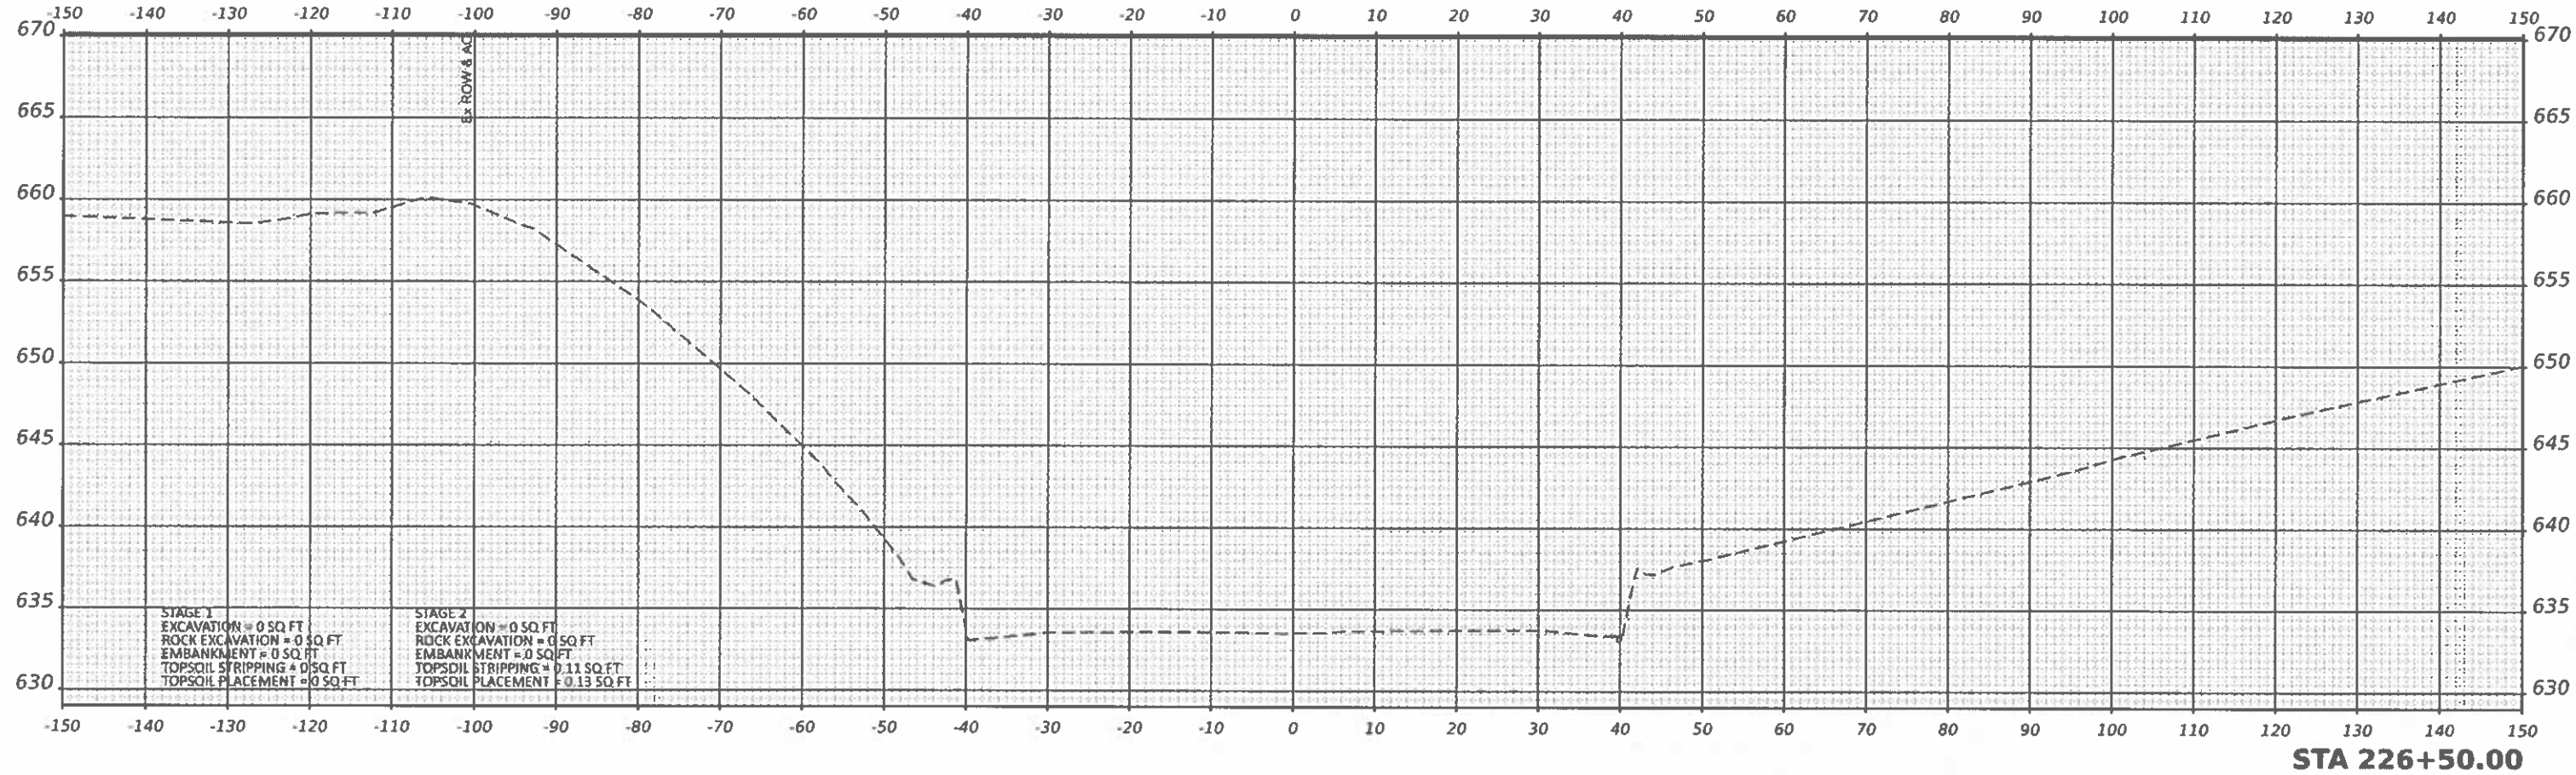

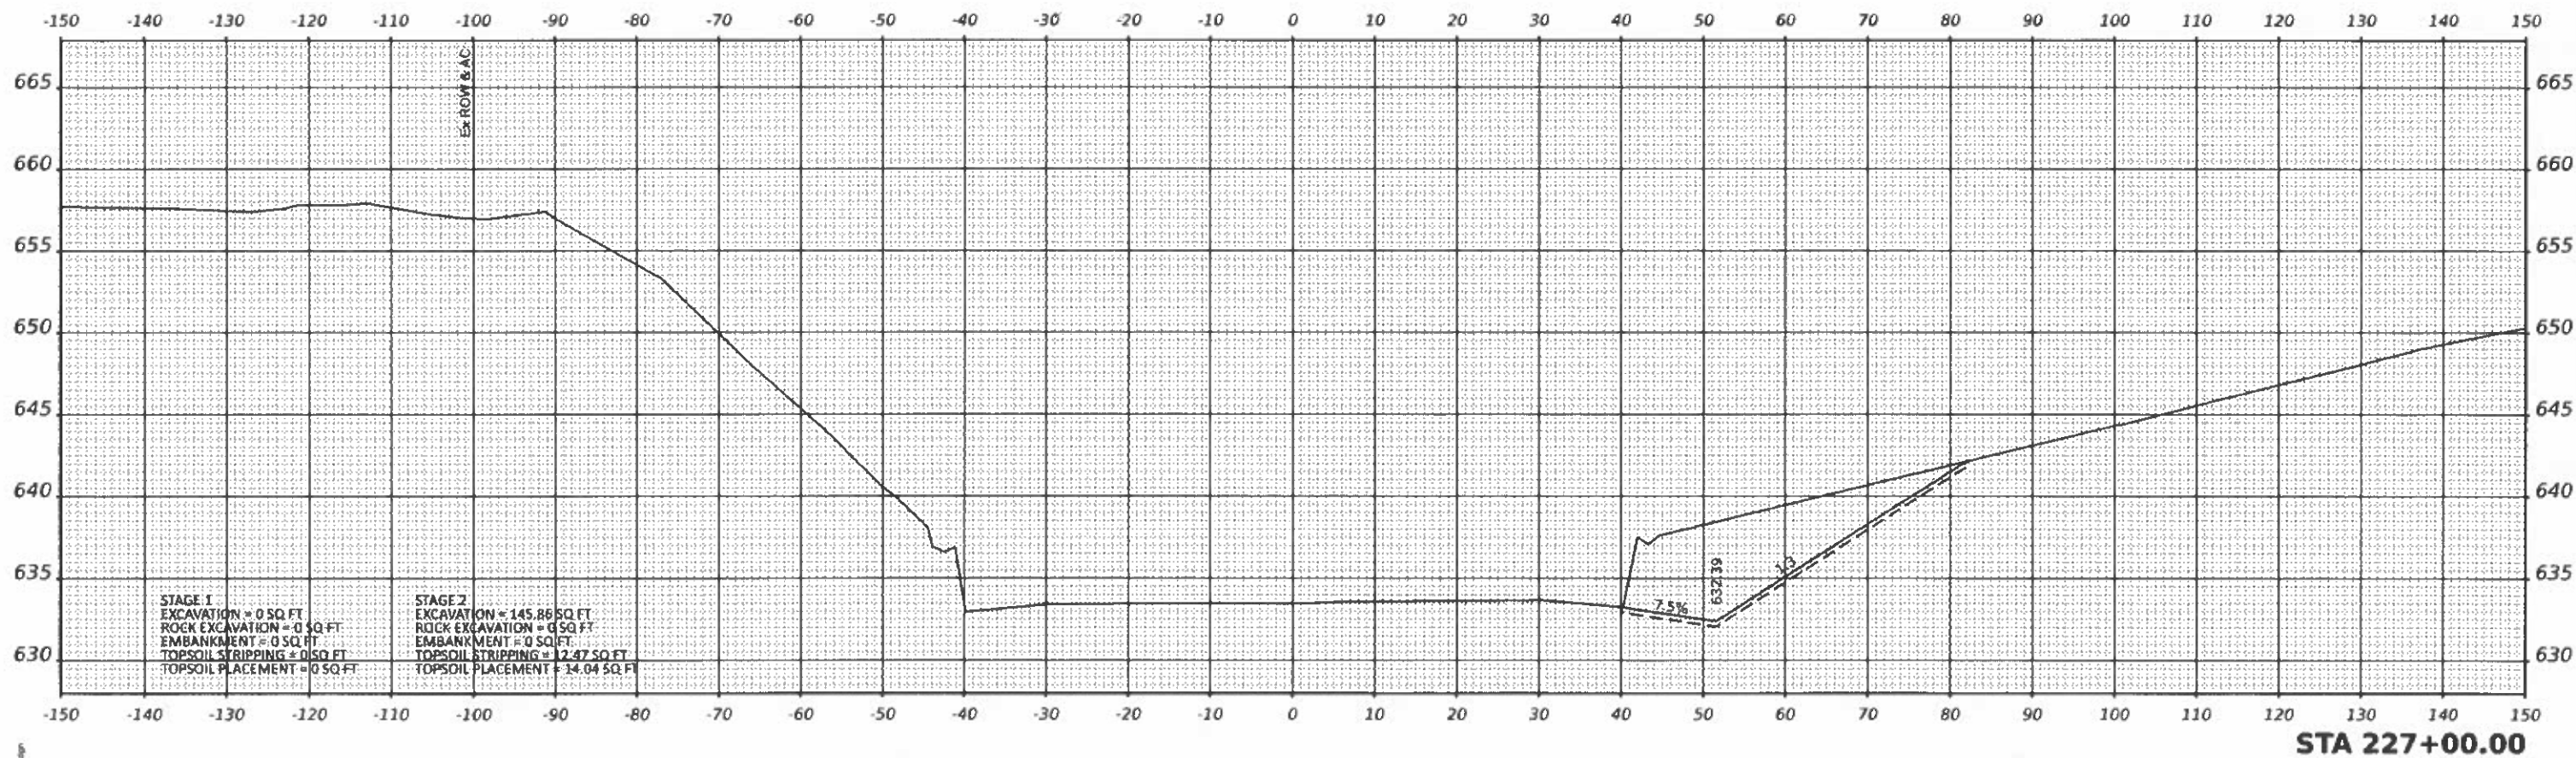

MODEL: PQ 17 ISS
 FILE NAME: PROJ_1000.dgn

TranSmart
 411 South Wells Street Suite 1000
 Chicago, Illinois 60607


USER NAME = mshahin	DESIGNED = BJD	REVISED =
PLOT SCALE = 0.16666633 / ft.	DRAWN = BJD	REVISED =
PLOT DATE = 3/28/2021	CHECKED = TW	REVISED =
	DATE = 2021/03/26	REVISED =

**STATE OF ILLINOIS
 DEPARTMENT OF TRANSPORTATION**

**INTERSTATE 57
 CROSS SECTIONS**

SCALE: 1" = 10' SHEET 2 OF 13 SHEETS STA. 227+00 TO STA. 227+00

FA I RTE.	SECTION	COUNTY	TOTAL SHEETS	SHEET NO.
57	139 HBR-6	KANKAKEE	202	173
CONTRACT NO. 66997				
ILLINOIS FEDERAL PROJECT				

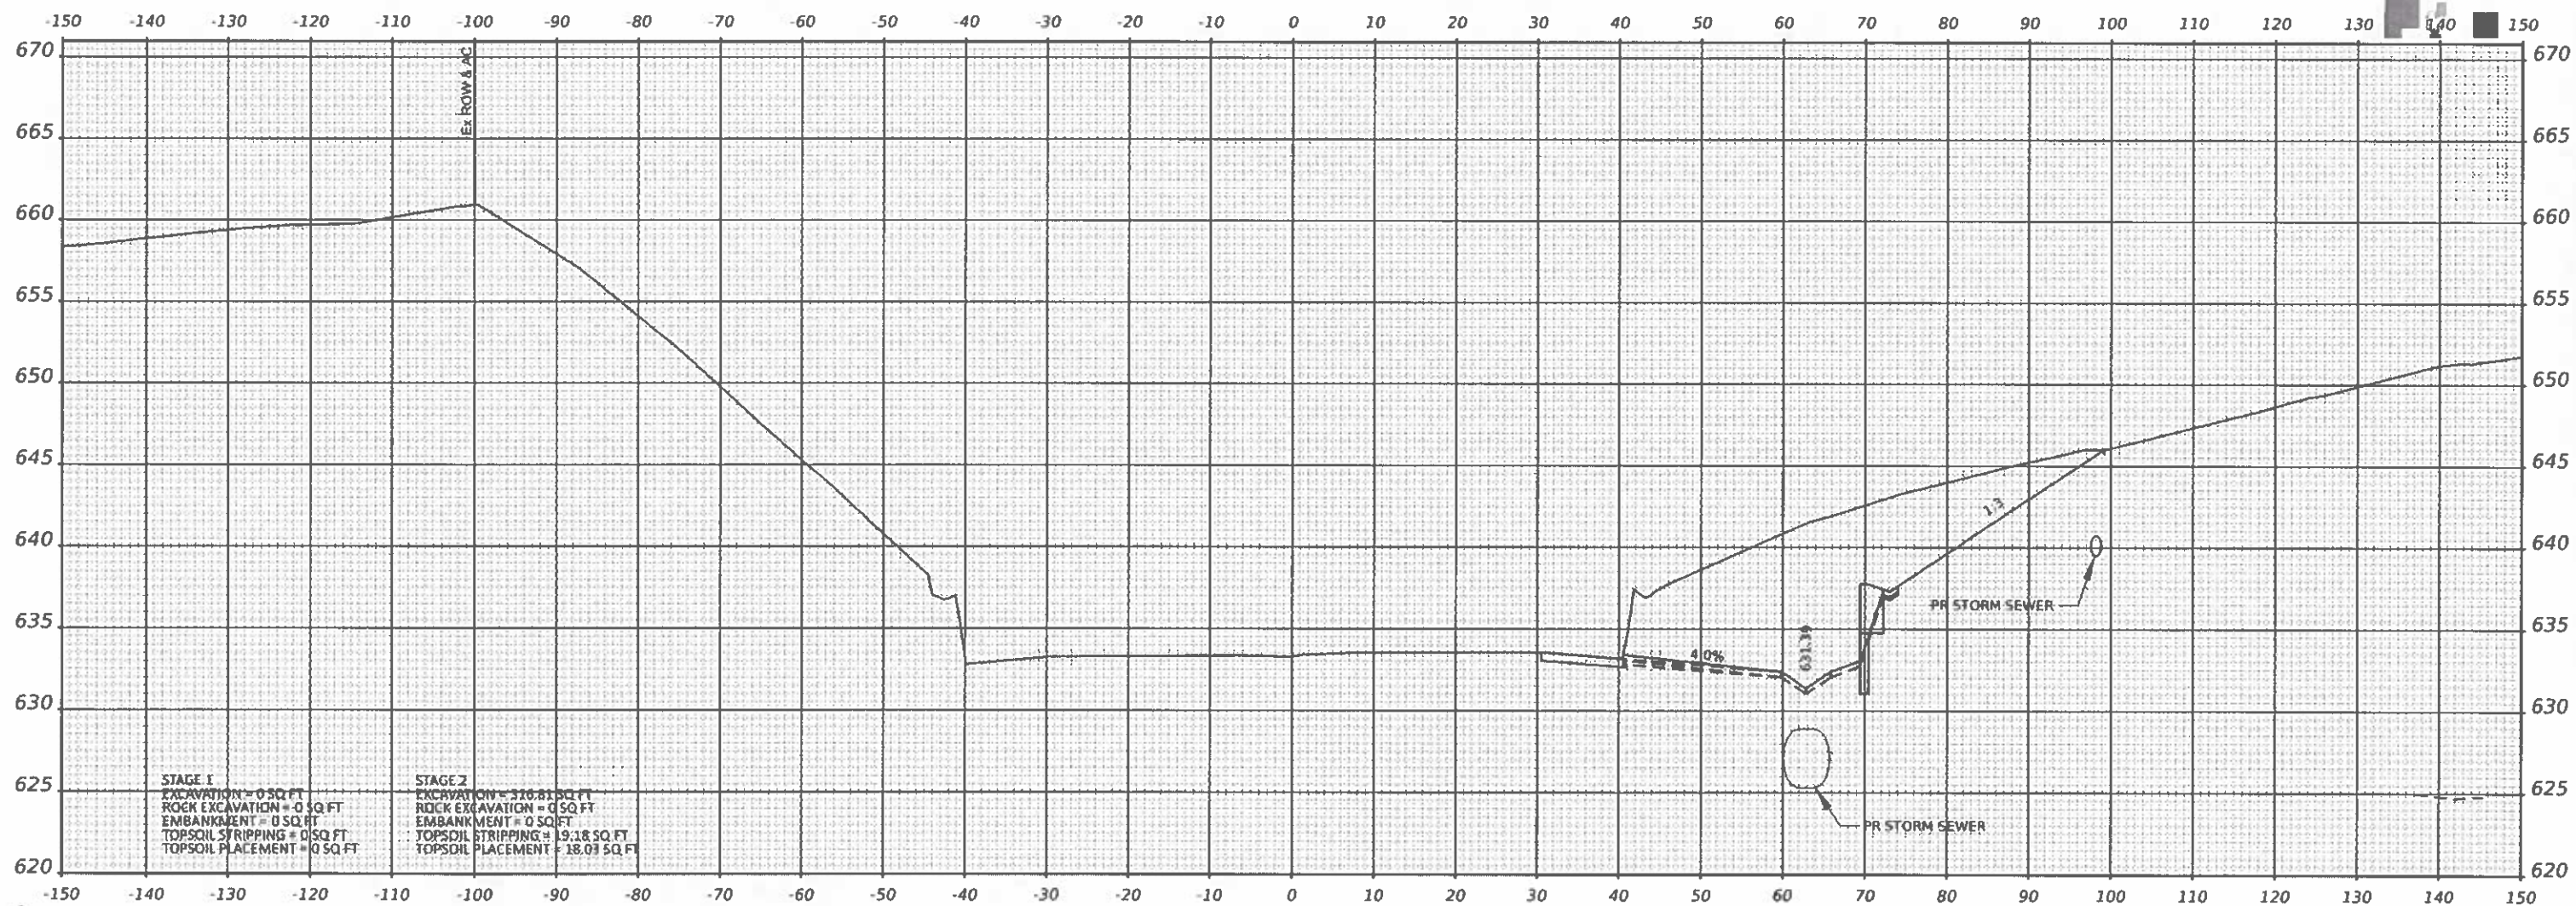

STA 227+50.00

MODEL: PL 8715-4
FILE NAME: PR57_254.dgn

TransSmart
411 South Wells Street Suite 1000
Chicago, Illinois 60607

USER NAME: *realation
PLOT SCALE: * 0.16666633' / IN.
PLOT DATE: * 3/28/2021

DESIGNED: * BJD
DRAWN: * BJD
CHECKED: * TW
DATE: * 2021/03/26

REVISED: -
REVISED: -
REVISED: -
REVISED: -

STATE OF ILLINOIS
DEPARTMENT OF TRANSPORTATION

INTERSTATE 57
CROSS SECTIONS

SCALE: 1" = 10'

SHEET 3

OF 13


SHEETS

STA. 227+50

TO STA. 227+50

FILE	SECTION	COUNTY	TOTAL SHEETS	SHEET NO.
57	139 HBR-6	KANKAKEE	202	174
CONTRACT NO. 66997				

ILLINOIS FED. AID PROJECT

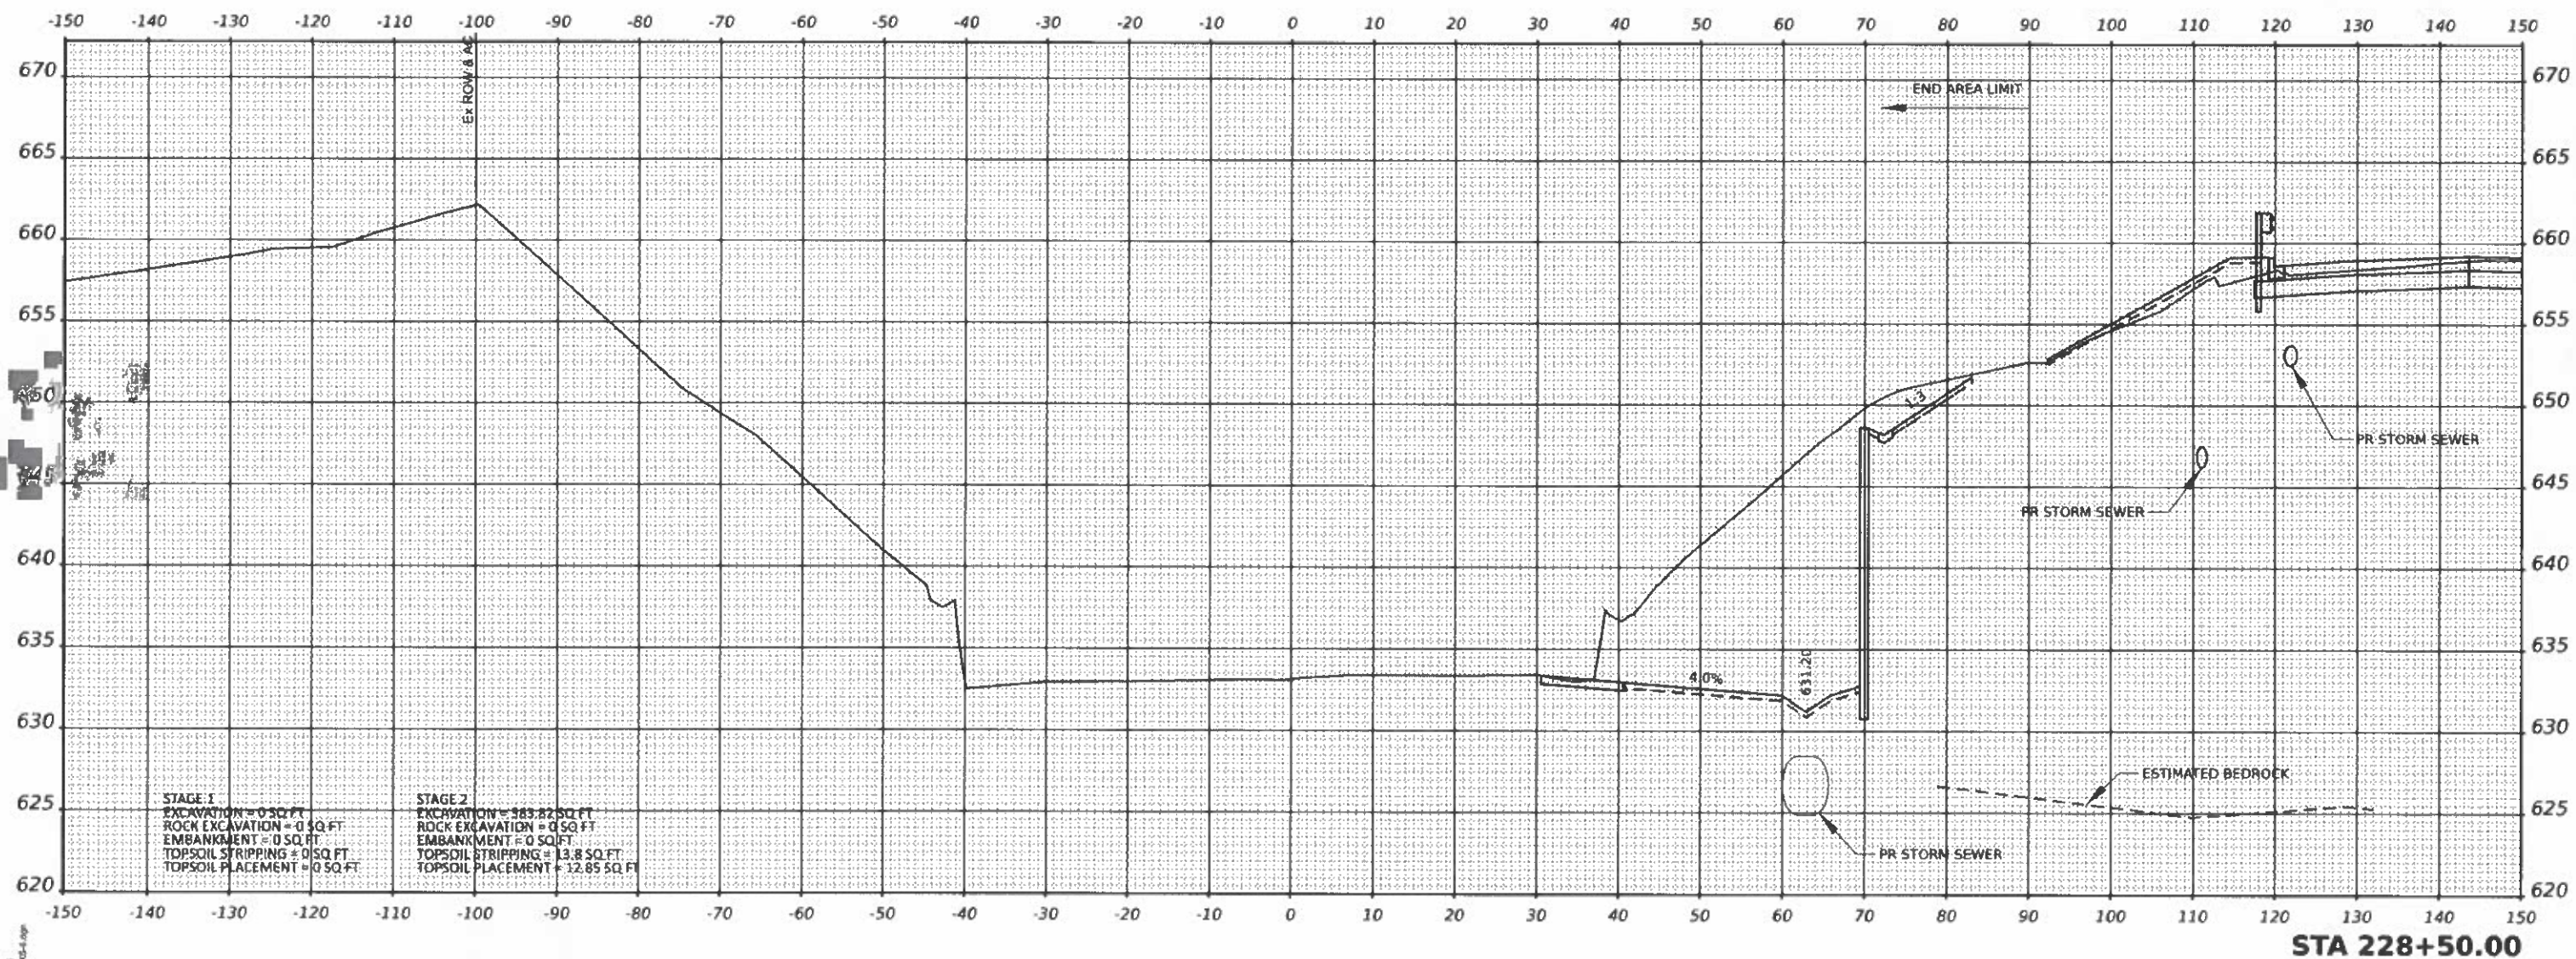

MODEL: PL 5716-6
 FILE NAME: 0617_004.dwg

TranSmart
 411 South Wells Street Suite 1000
 Chicago, Illinois 60607


USER NAME = resolution	DESIGNED - BJD	REVISED -
PLOT SCALE = 0.16666633 / in.	DRAWN - BJD	REVISED -
PLOT DATE = 3/28/2021	CHECKED - TW	REVISED -
	DATE - 2021/03/26	REVISED -

**STATE OF ILLINOIS
 DEPARTMENT OF TRANSPORTATION**

**INTERSTATE 57
 CROSS SECTIONS**

SCALE: 1" = 10' SHEET 5 OF 13 SHEETS STA. 228+50 TO STA. 228+50

F.A.I. RTE.	SECTION	COUNTY	TOTAL SHEETS	SHEET NO.
57	139 H&R-6	KANKAKEE	202	176
CONTRACT NO. 66997				
ILLINOIS FED. AID PROJECT				

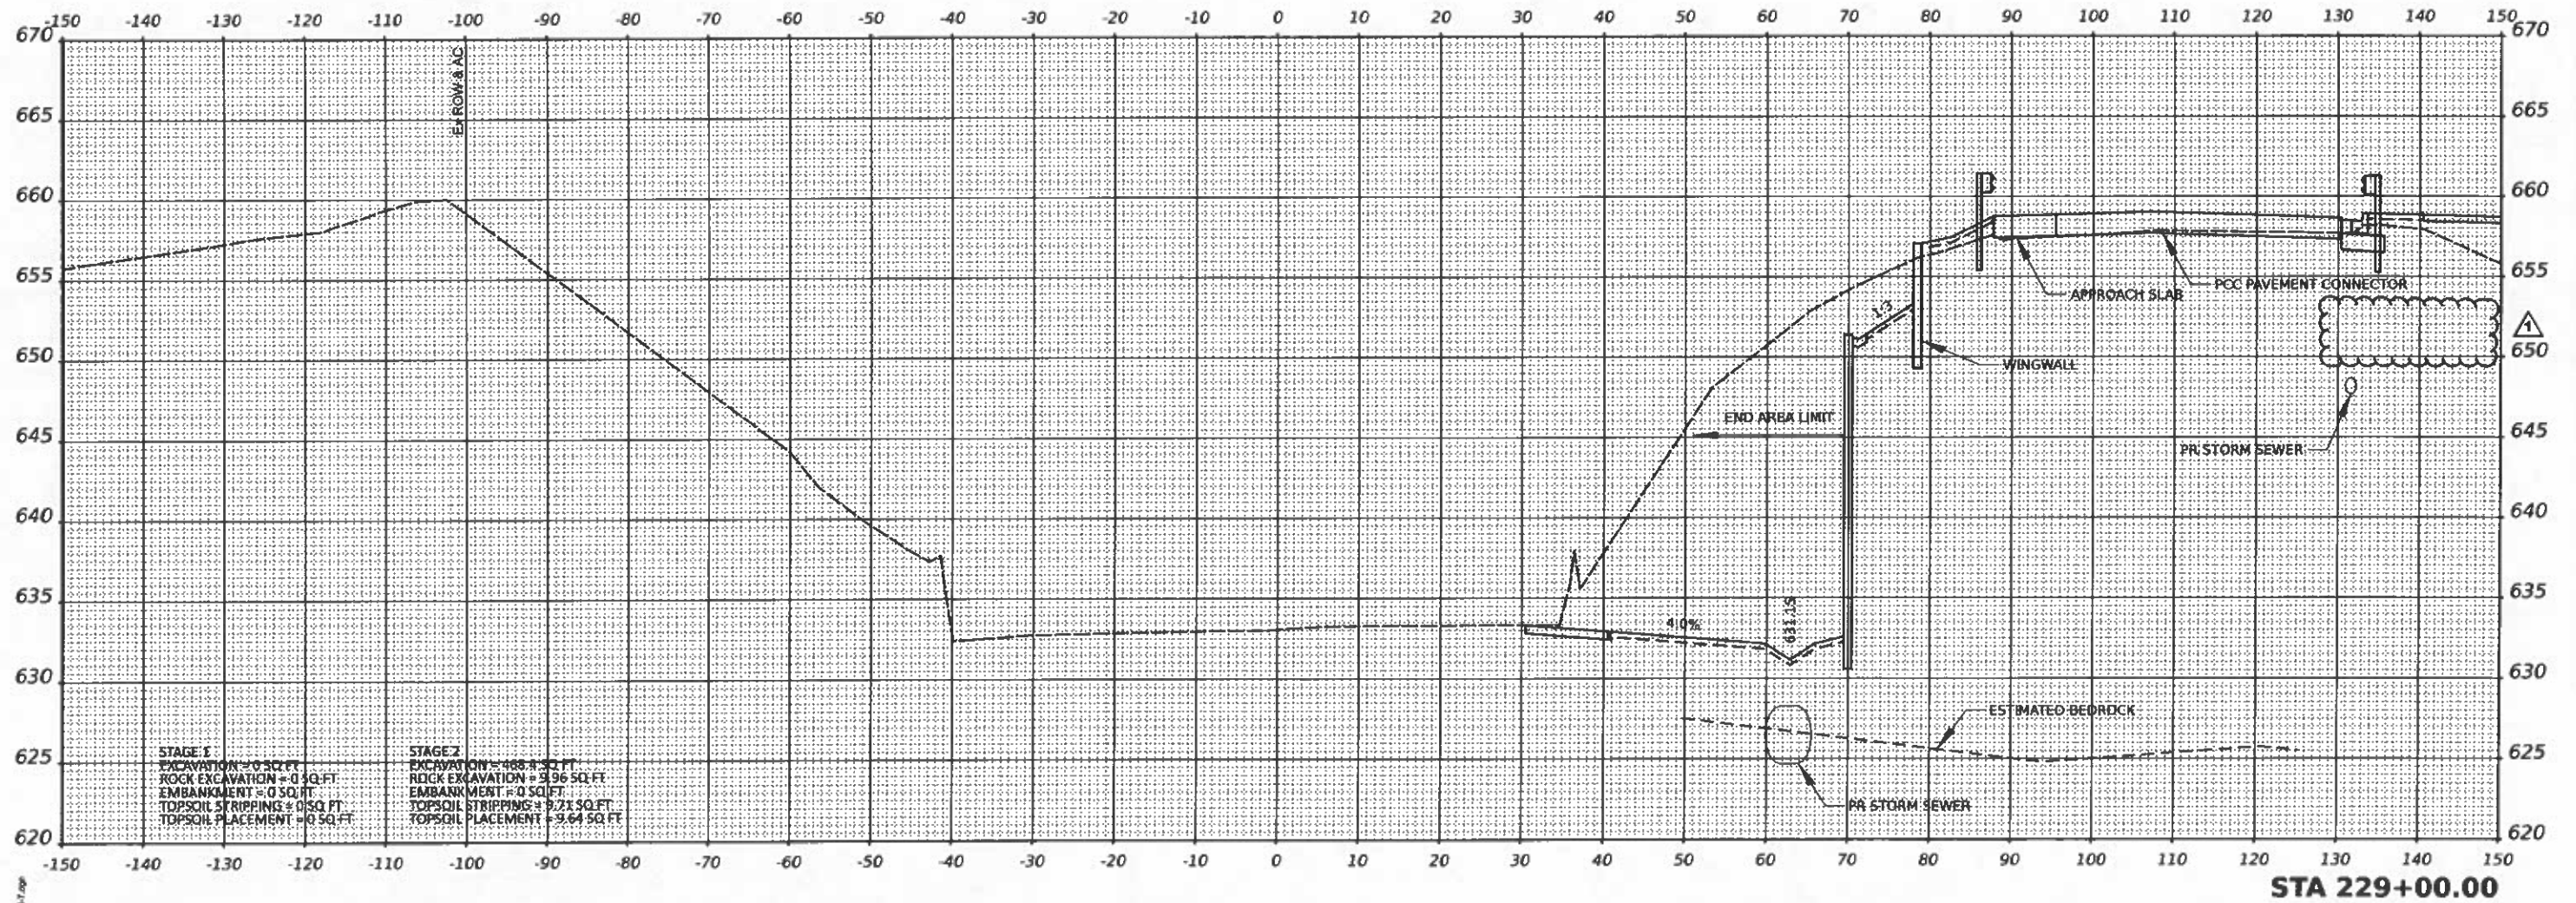

MODEL: PR_07_001
FILE NAME: PR_07_001.dwg

TranSmart
411 South Wells Street Suite 1000
Chicago, Illinois 60607

USER NAME = ashlc	DESIGNED - BJD	REVISED -
PLOT SCALE = 0.10000000 / in.	DRAWN - BJD	REVISED -
PLOT DATE = 7/9/2021	CHECKED - TW	REVISED -
	DATE - 2021/03/28	REVISED -

STATE OF ILLINOIS
DEPARTMENT OF TRANSPORTATION


INTERSTATE 57
CROSS SECTIONS

SCALE: 1" = 10' SHEET 6 OF 13 SHEETS STA. 229+00 TO STA. 229+00

F.A.I. RTE.	SECTION	COUNTY	TOTAL SHEETS	SHEET NO.
57	130 HBR-6	KANKAKEE	202	177
CONTRACT NO. 66997				

ILLINOIS FED. AID PROJECT

REV. 08/25/21

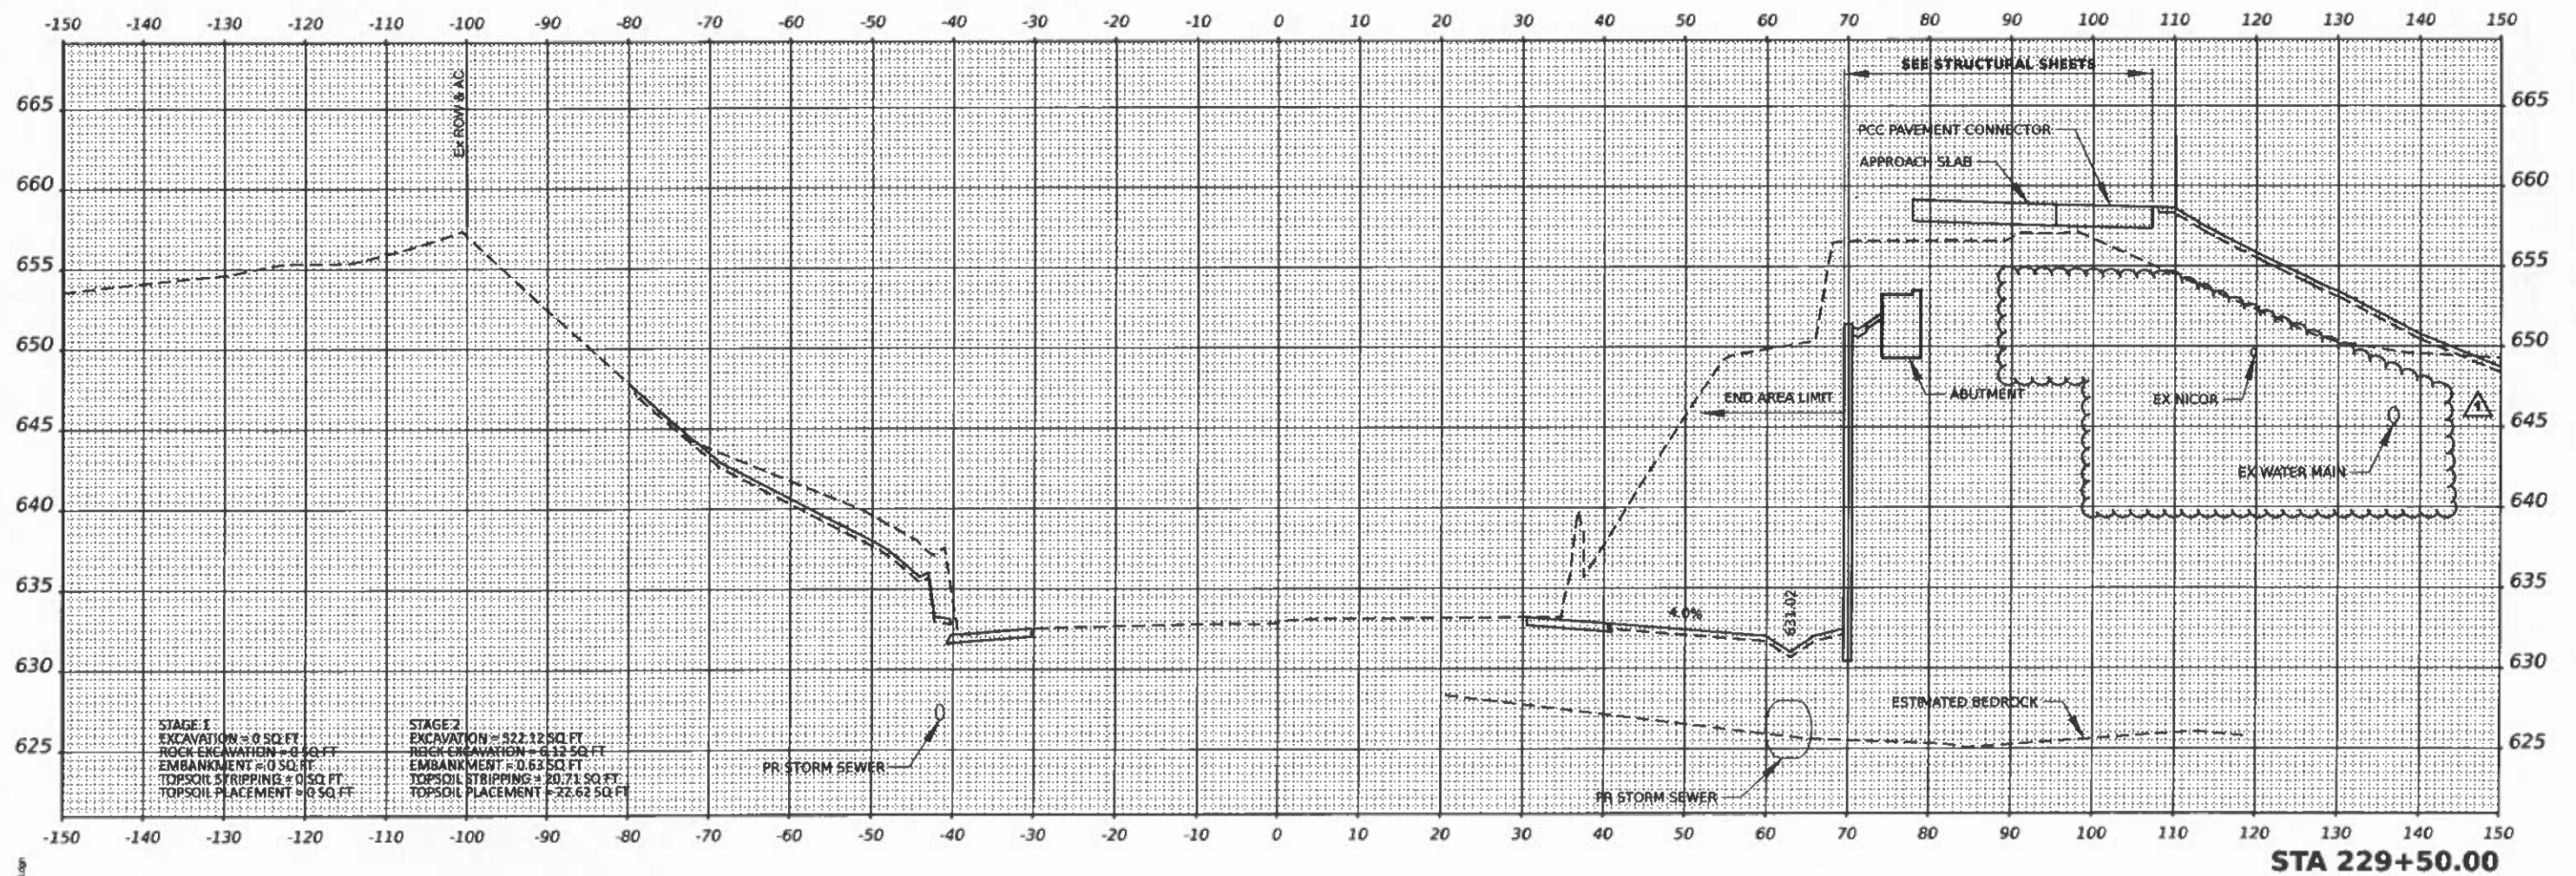

MODEL: IIS-37-014
FILE NAME: PLOT_014.dgn

TransSmart
411 South Wells Street Suite 1000
Chicago, Illinois 60607



USER NAME = asbhc	DESIGNED - BJD	REVISED -
PLOT SCALE = 0.10000033' / in.	DRAWN - BJD	REVISED -
PLOT DATE = 7/9/2021	CHECKED - TW	REVISED -
	DATE - 2021/03/28	REVISED -



STATE OF ILLINOIS
DEPARTMENT OF TRANSPORTATION

INTERSTATE 57
CROSS SECTIONS
SCALE: 1" = 10'
SHEET 7 OF 13 SHEETS
STA. 229+50 TO STA. 229+50

F.A.I. RTE.	SECTION	COUNTY	TOTAL SHEETS	SHEET NO.
57	139 HBR-6	KANKAKEE	202	178
CONTRACT NO. 66997				
ILLINOIS FED. AID PROJECT				

REV. 08/25/21

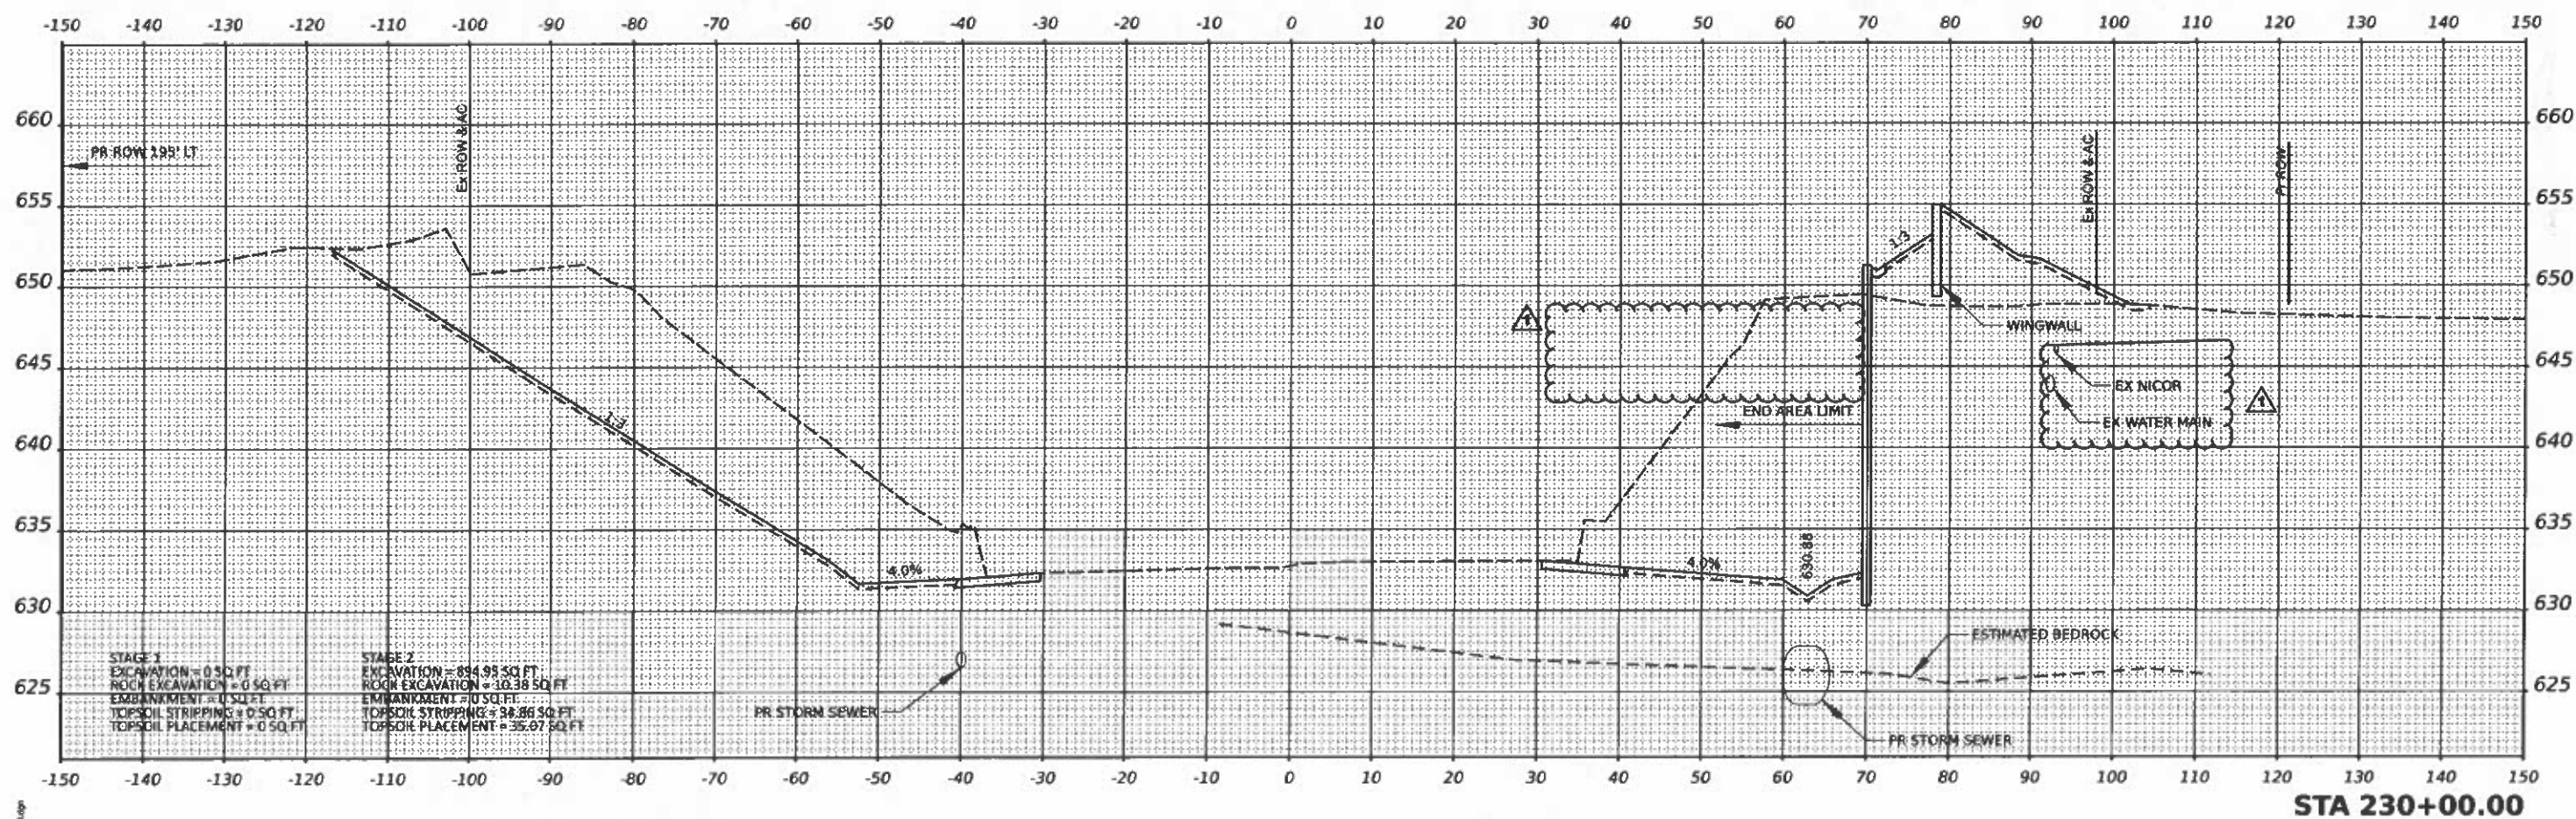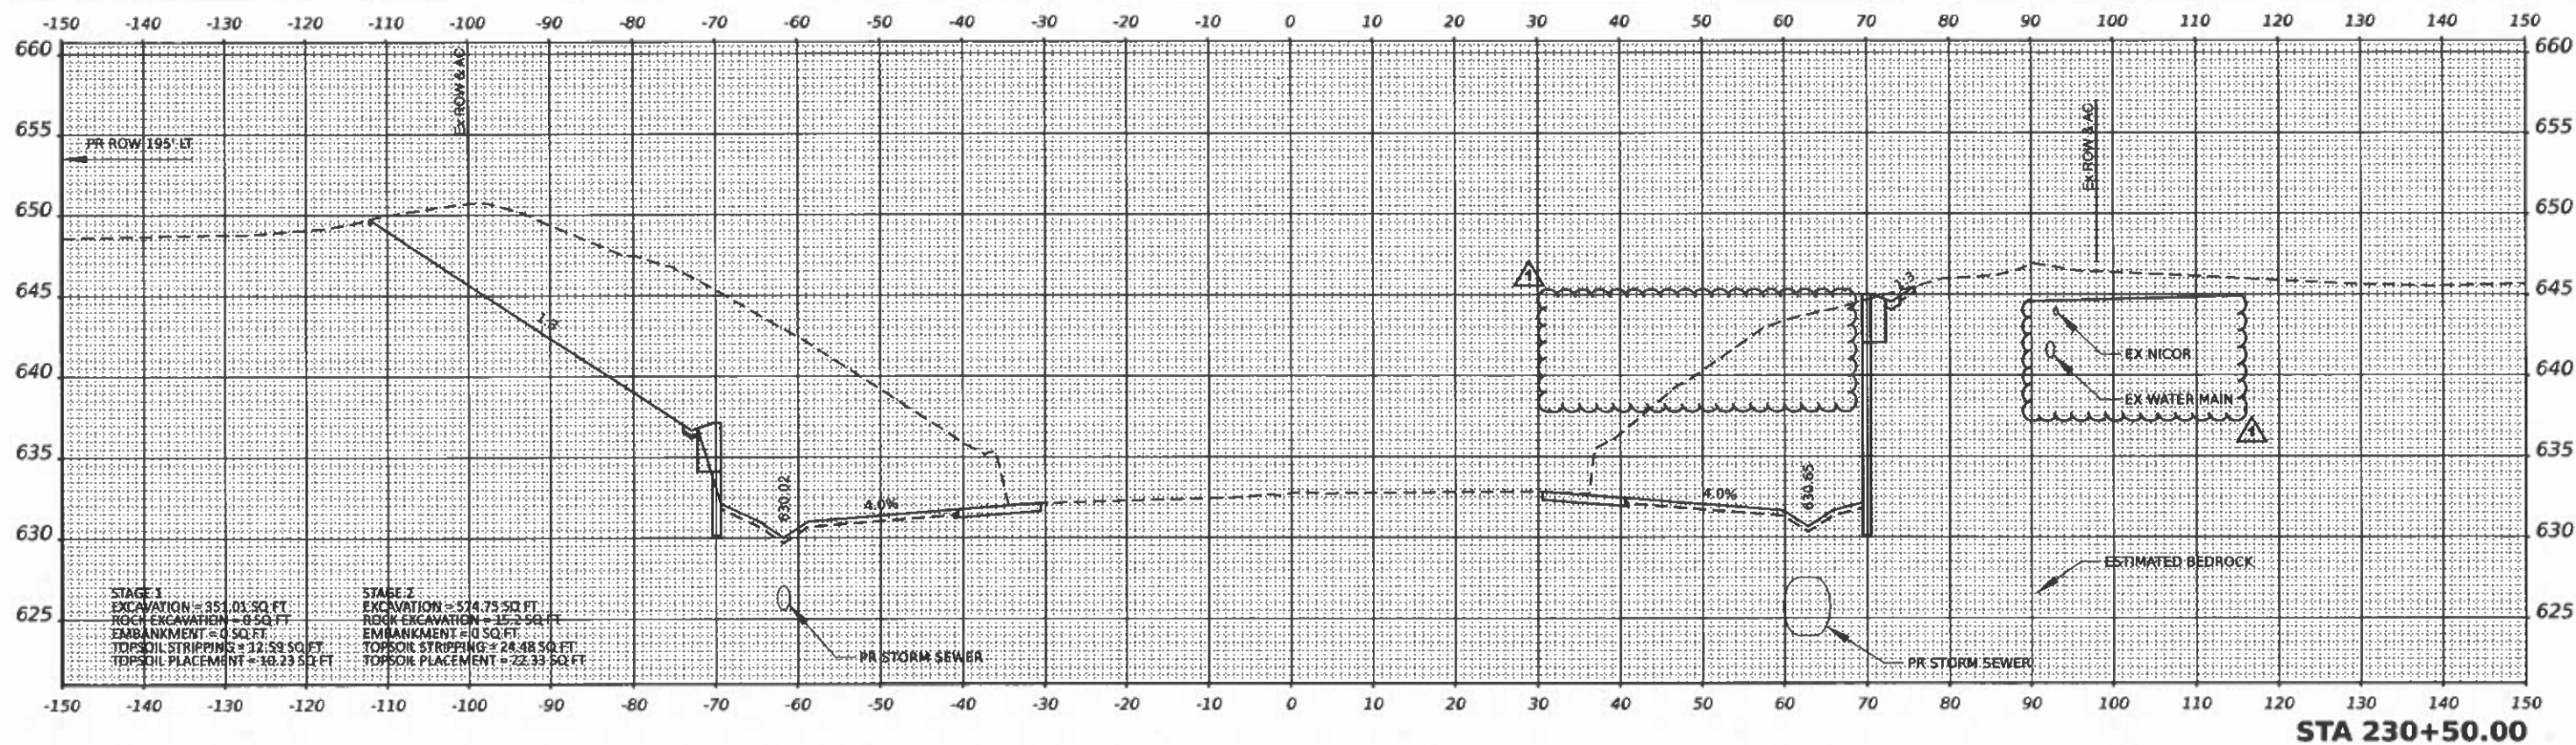

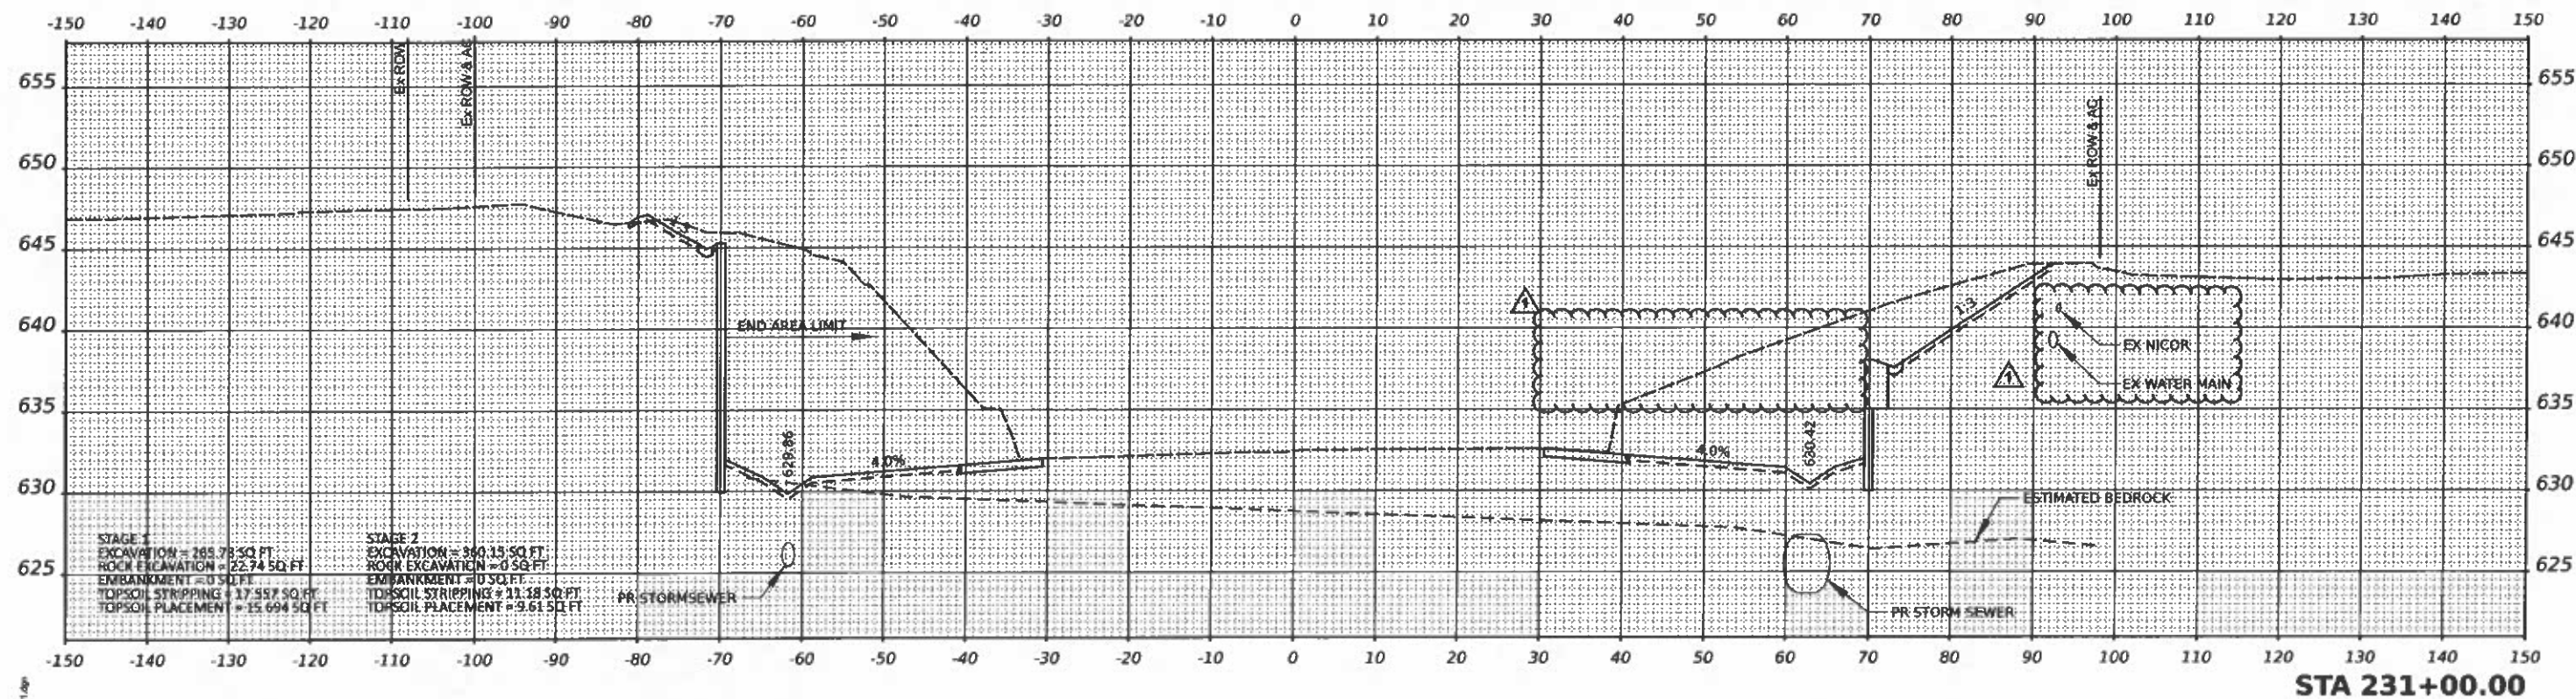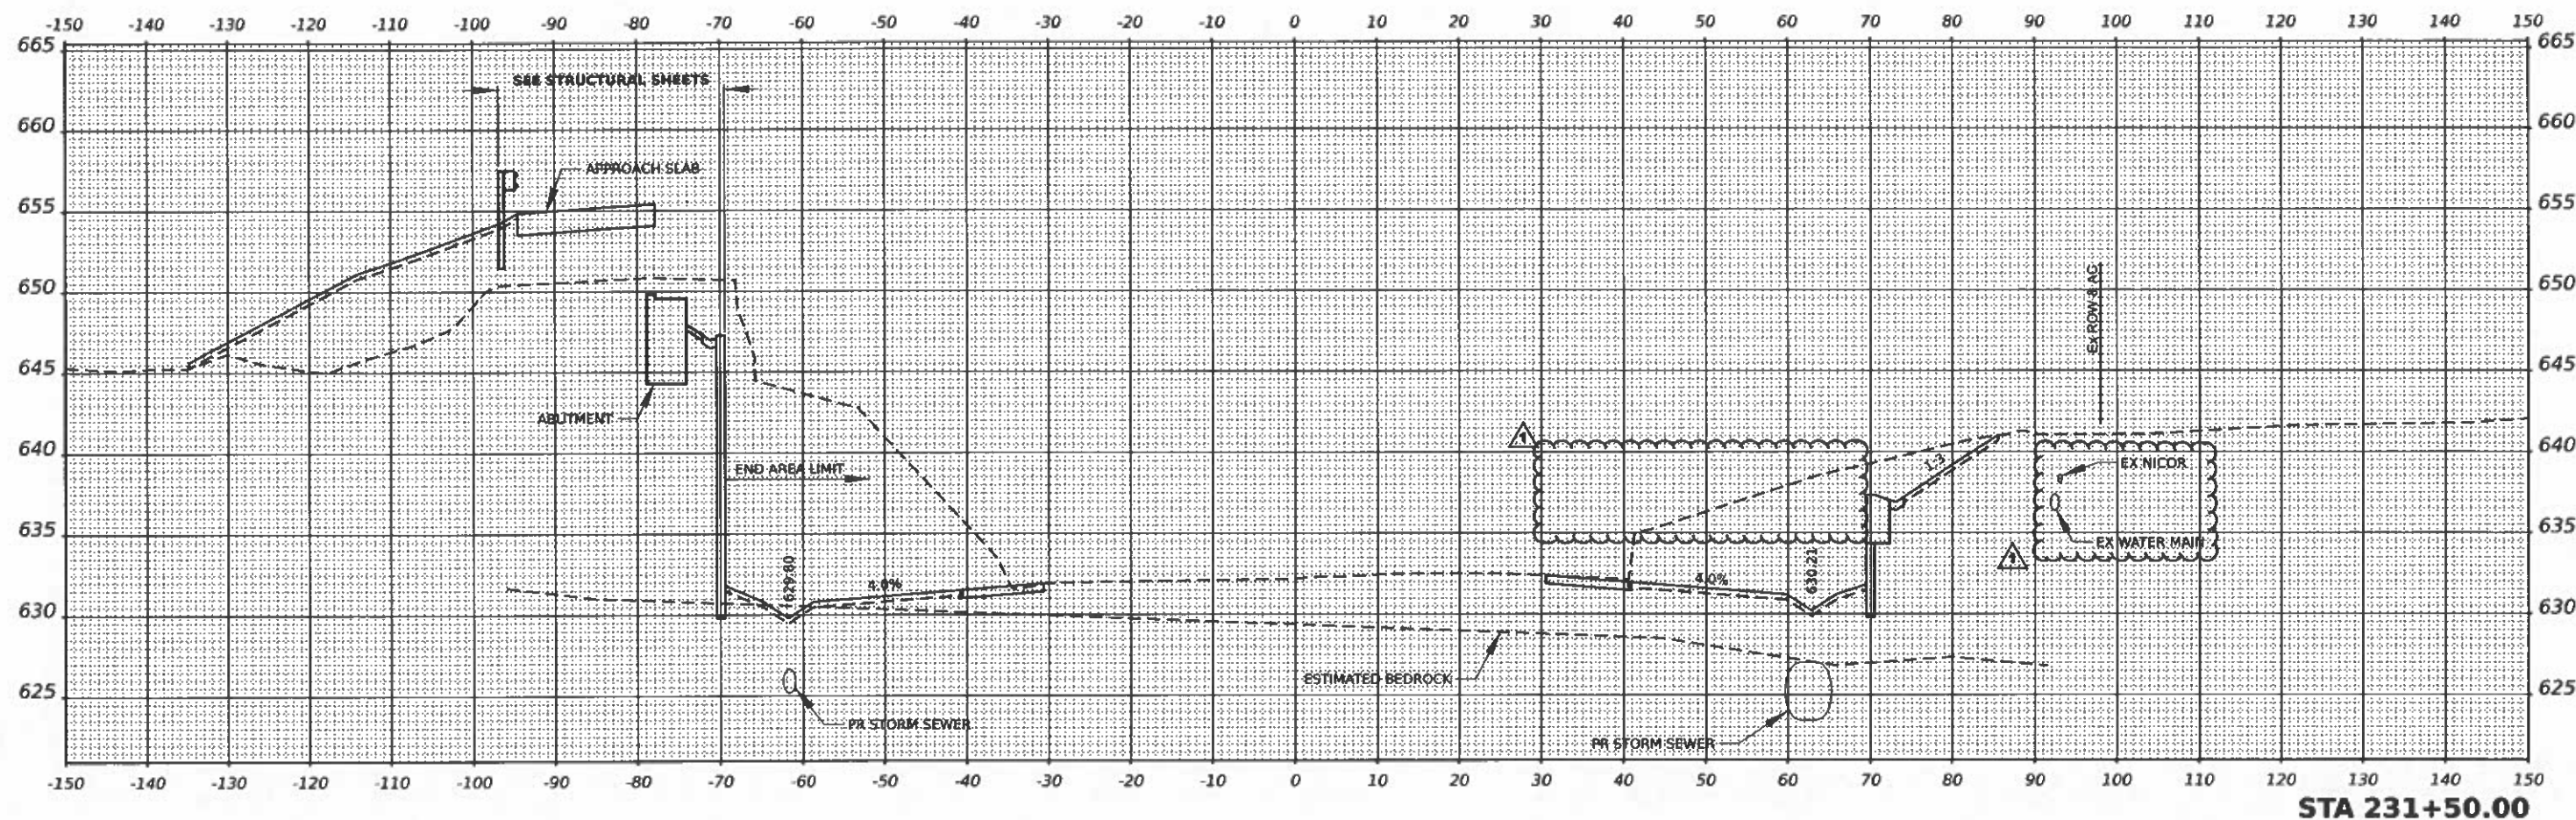

MODEL: PLS 37-05-11
FILE NAME: PLS_37_05-11.dgn

TranSmart
411 South Wells Street Suite 1000
Chicago, Illinois 60607

USER NAME = a22nc
PLOT SCALE = 0.10000037 / in.
PLOT DATE = 7/6/2021

DESIGNED - BJD
DRAWN - BJD
CHECKED - TW
DATE - 2021/03/26

REVISED - 5/7/2021
REVISED -
REVISED -
REVISED -

**STATE OF ILLINOIS
DEPARTMENT OF TRANSPORTATION**



**INTERSTATE 57
CROSS SECTIONS**

SCALE: 1" = 10' SHEET 9 OF 13 SHEETS STA. 231+00 TO STA. 231+50



F.A.I. RTE.	SECTION	COUNTY	TOTAL SHEETS	SHEET NO.
57	130 HBR-6	KANKAKEE	202	180
CONTRACT NO. 66997				

ILLINOIS FED. AID PROJECT

REV. 08/25/21

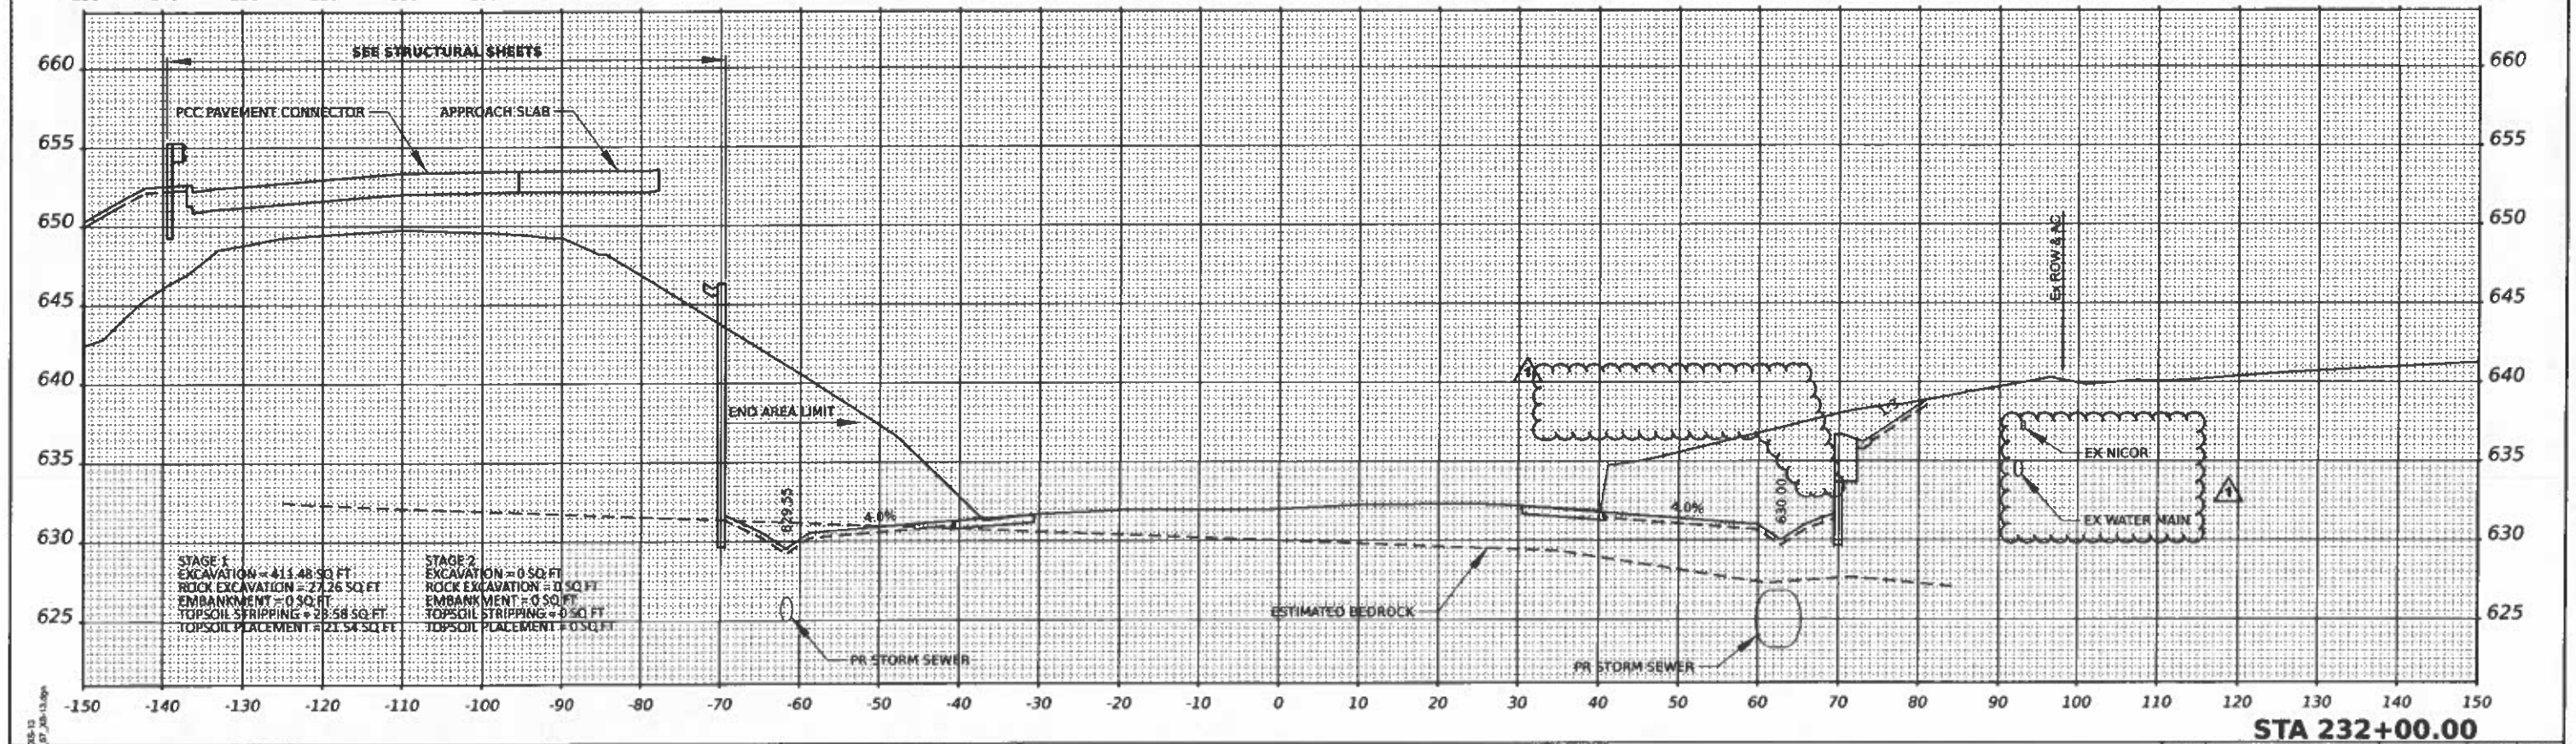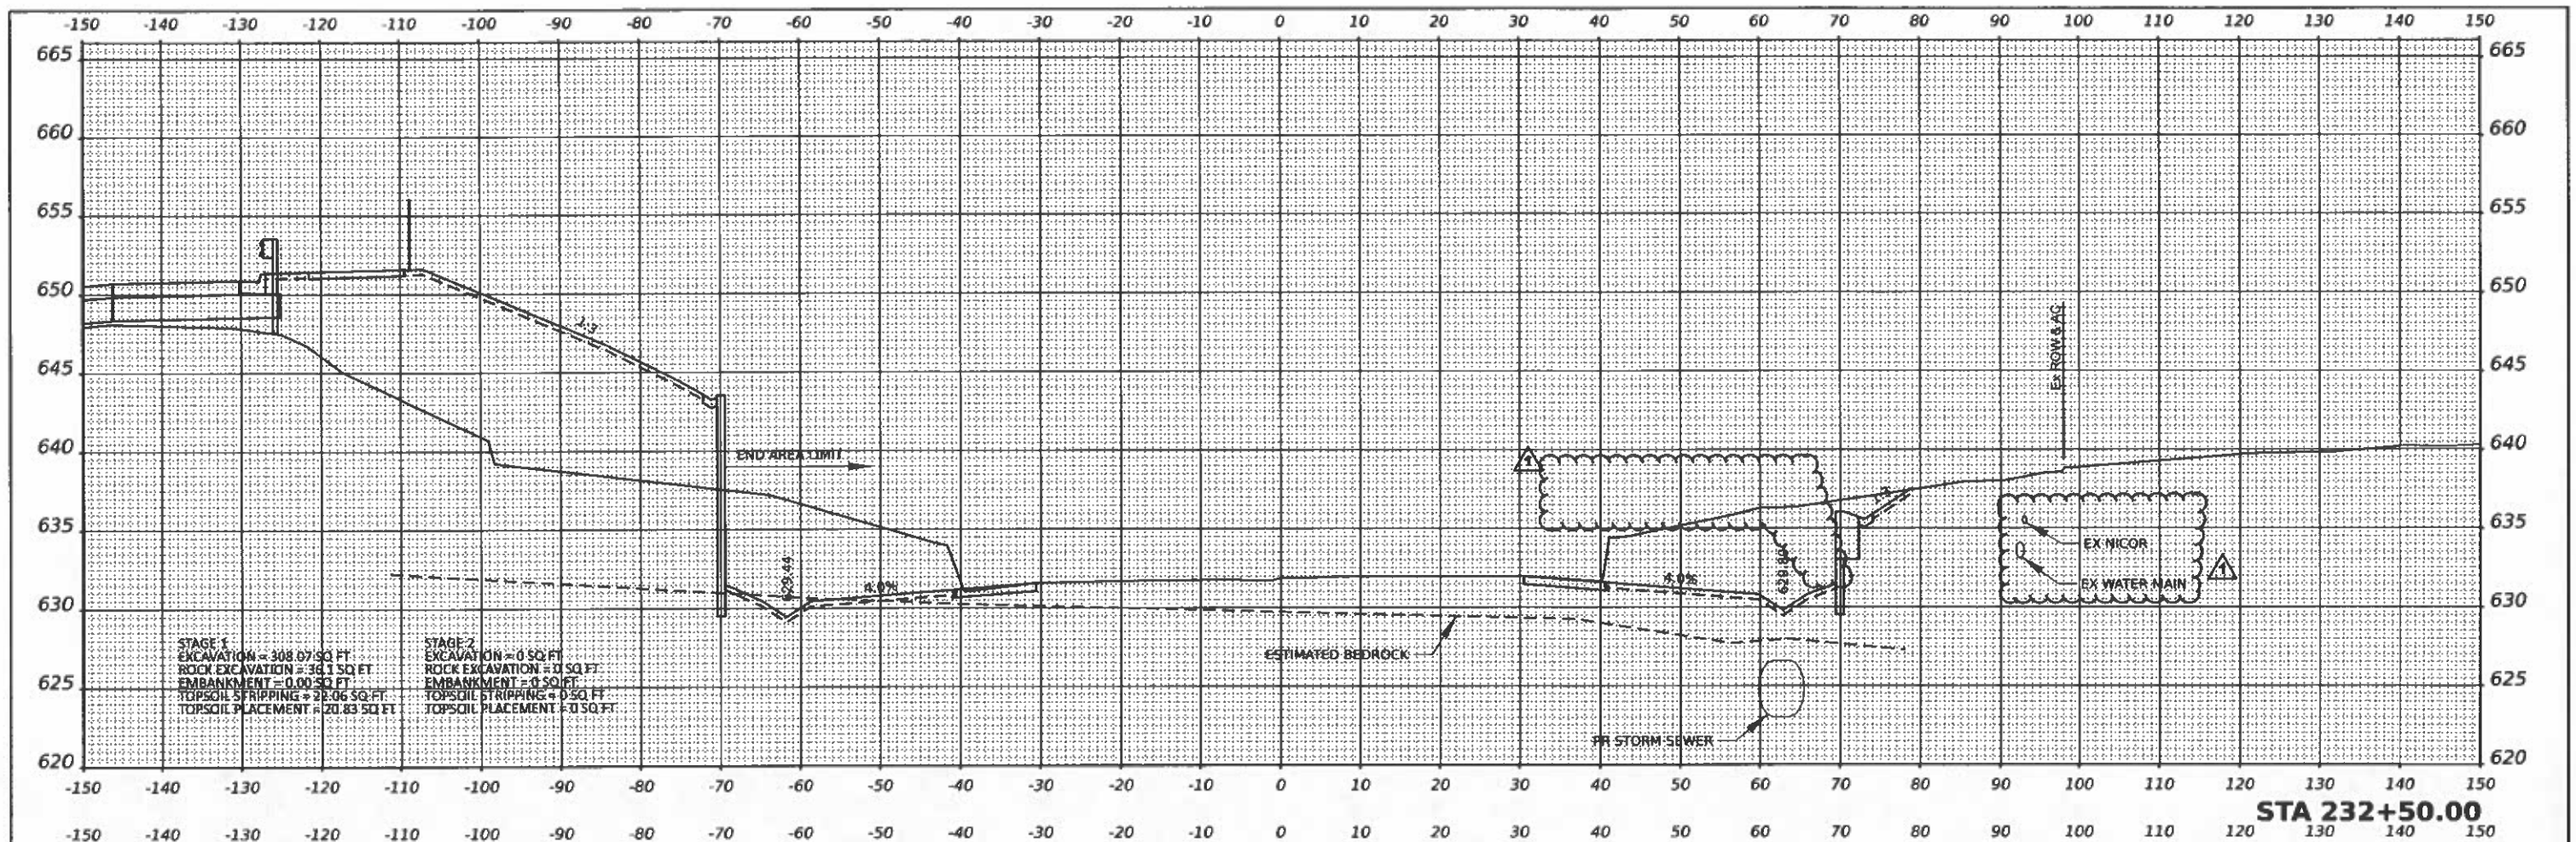

MODEL: PLS. 27 FILE NAME: PLS. TransSmart 411 South Wells Street Suite 1000 Chicago, Illinois 60607	USER NAME = jsmc	DESIGNED = BJD	REVISED = 5/7/2021	STATE OF ILLINOIS DEPARTMENT OF TRANSPORTATION	INTERSTATE 57 CROSS SECTIONS				F.A.I. RTE.	SECTION	COUNTY	TOTAL SHEETS	SHEET NO.
	PLOT SCALE = 0.18888833 1/in.	DRAWN = BJD	REVISED =		57	139 HBR-8	KANKAKEE	202	161				
	PLOT DATE = 7/9/2021	CHECKED = TW	REVISED =		CONTRACT NO. 66997								
	DATE = 2021/03/26	REVISED =	SCALE: 1" = 10'		SHEET 10	OF 13 SHEETS	STA. 232+00	TO STA. 232+50	ILLINOIS	FED. AID PROJECT			

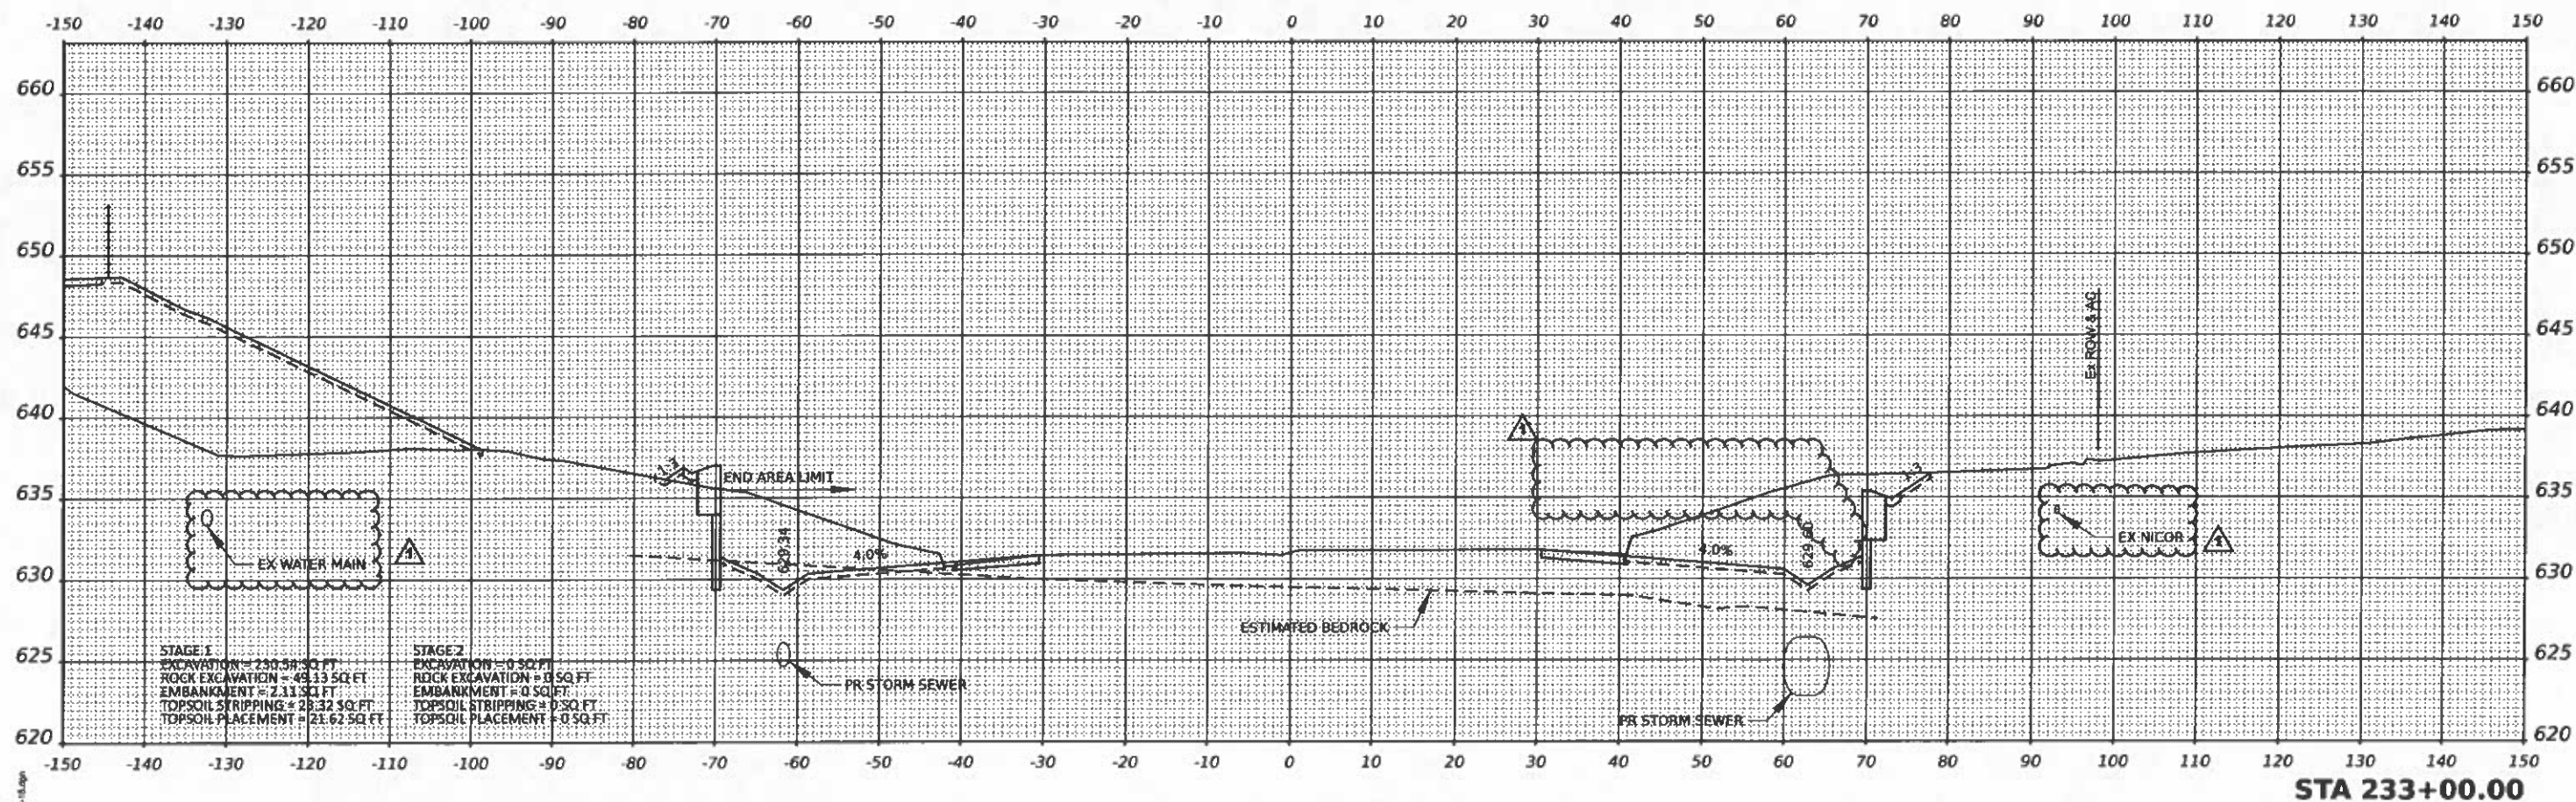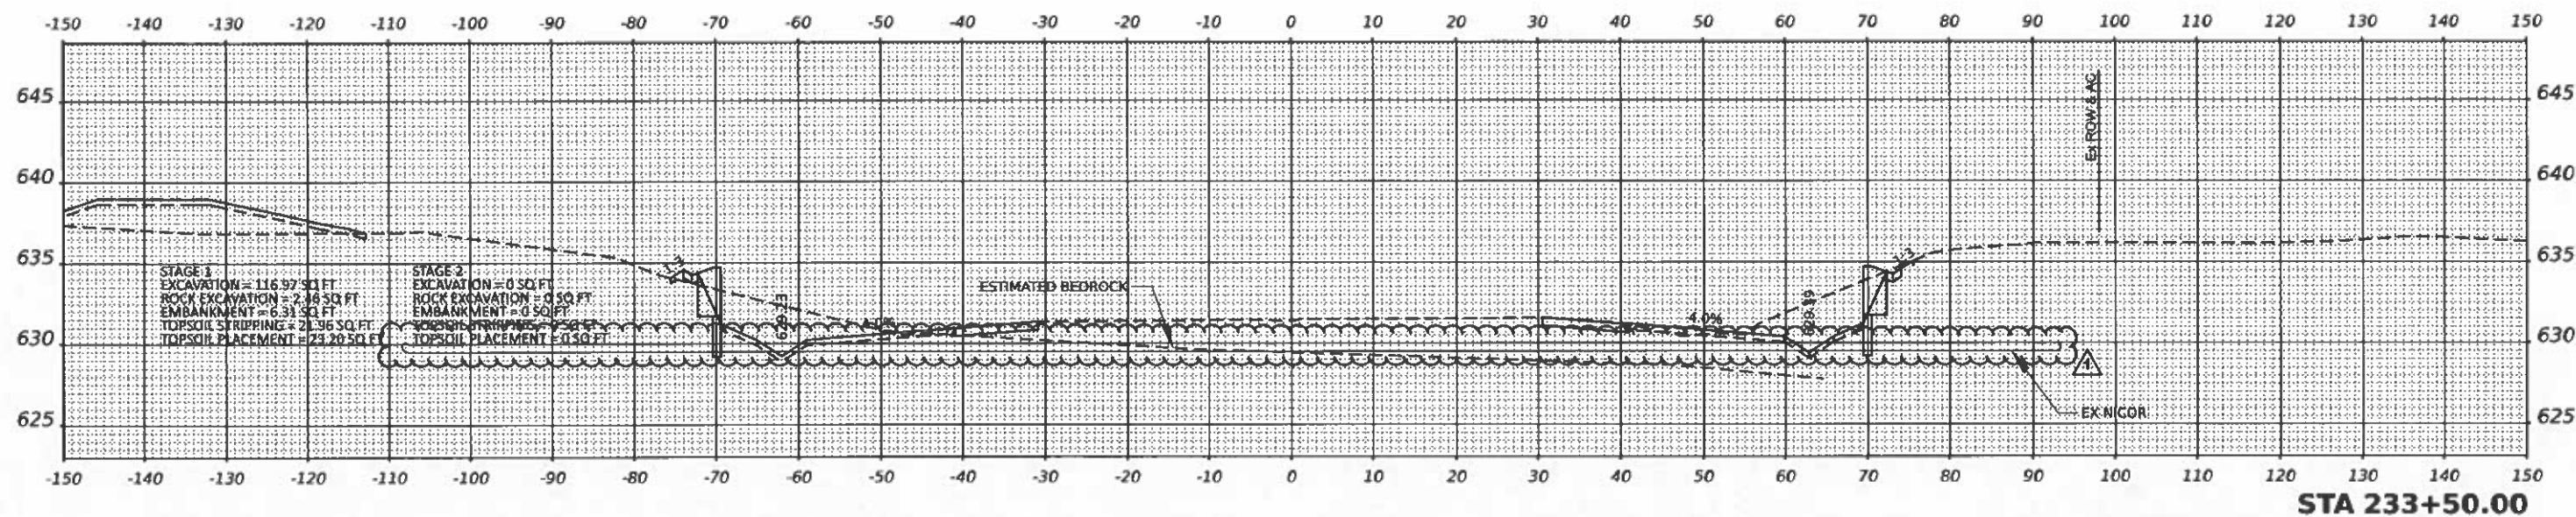

MODEL: PR_57_105-15
FILE NAME: PR_57_105-15.dgn

TransSmart
411 South Wells Street Suite 1000
Chicago, Illinois 60607

USER NAME = asahc
PLOT SCALE = 0.10000033" / ft.
PLOT DATE = 7/9/2021

DESIGNED - BJD
DRAWN - BJD
CHECKED - TW
DATE - 2021/03/26

REVISED - 5/7/2021
REVISED -
REVISED -
REVISED -




STATE OF ILLINOIS
DEPARTMENT OF TRANSPORTATION

INTERSTATE 57
CROSS SECTIONS

SCALE: 1" = 10' SHEET 11 OF 13 SHEETS STA. 233+00 TO STA. 233+50

F.A.I. RTE.	SECTION	COUNTY	TOTAL SHEETS	SHEET NO.
57	139 HBR-6	KANKAKEE	202	182
CONTRACT NO. 68997				
ILLINOIS FED. AID PROJECT				

REV. 08/25/21

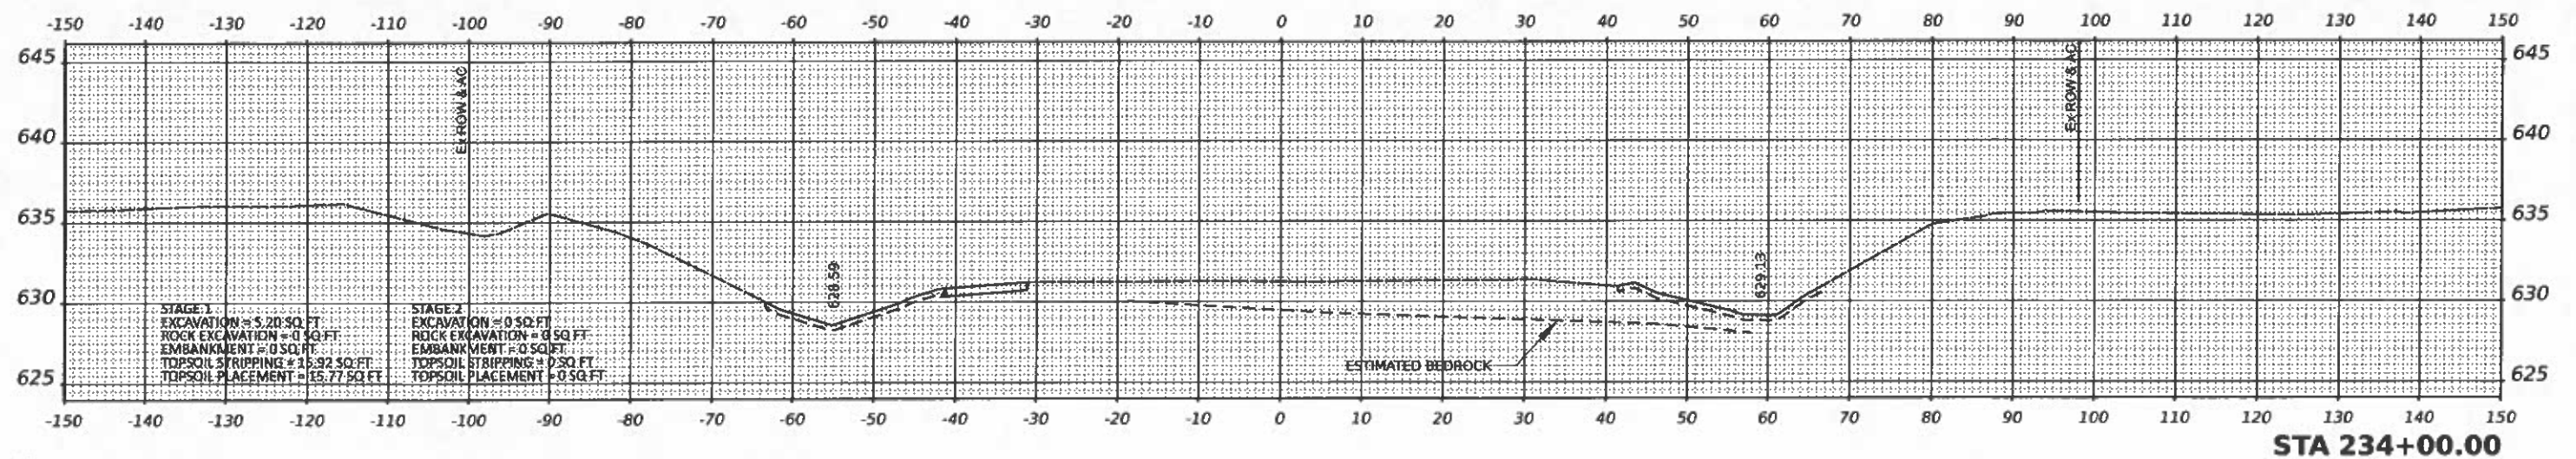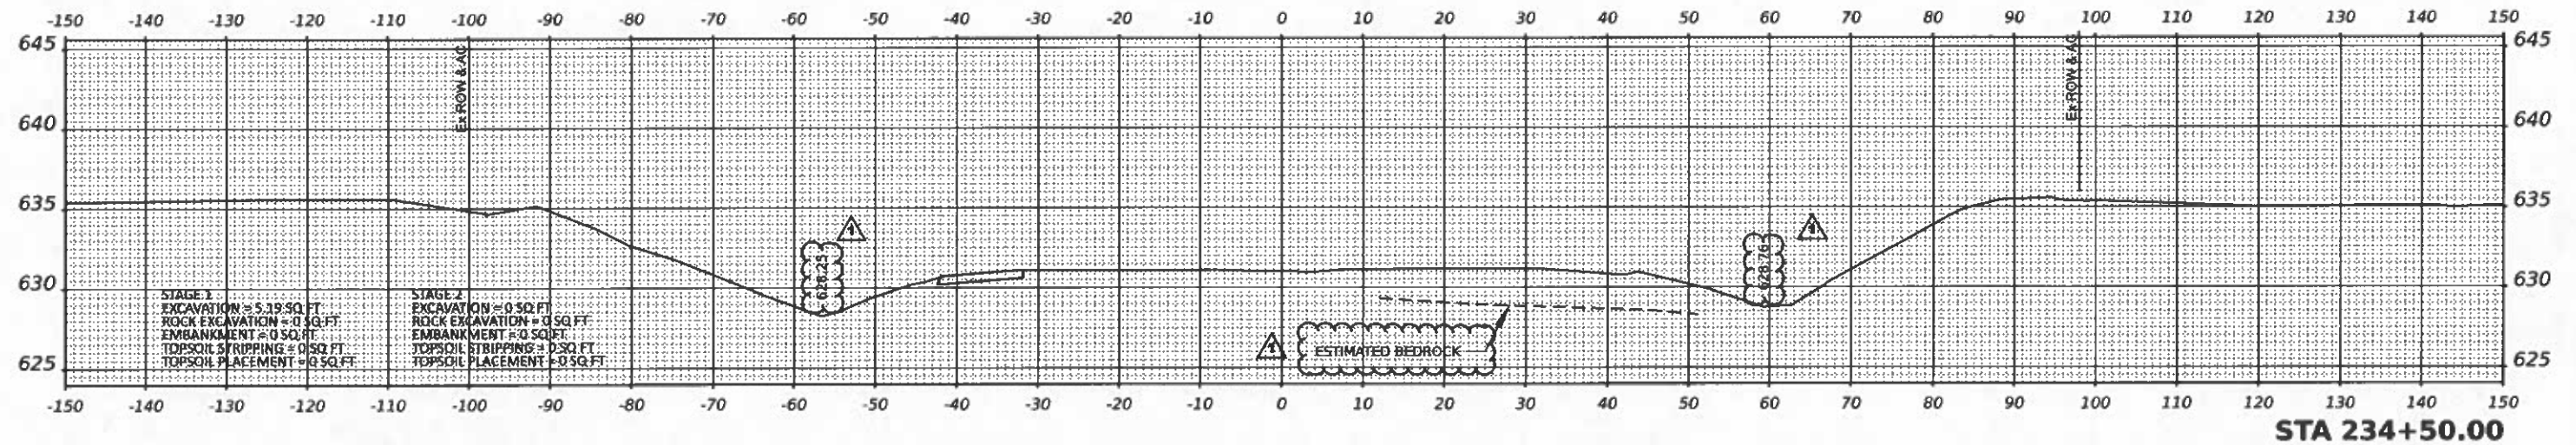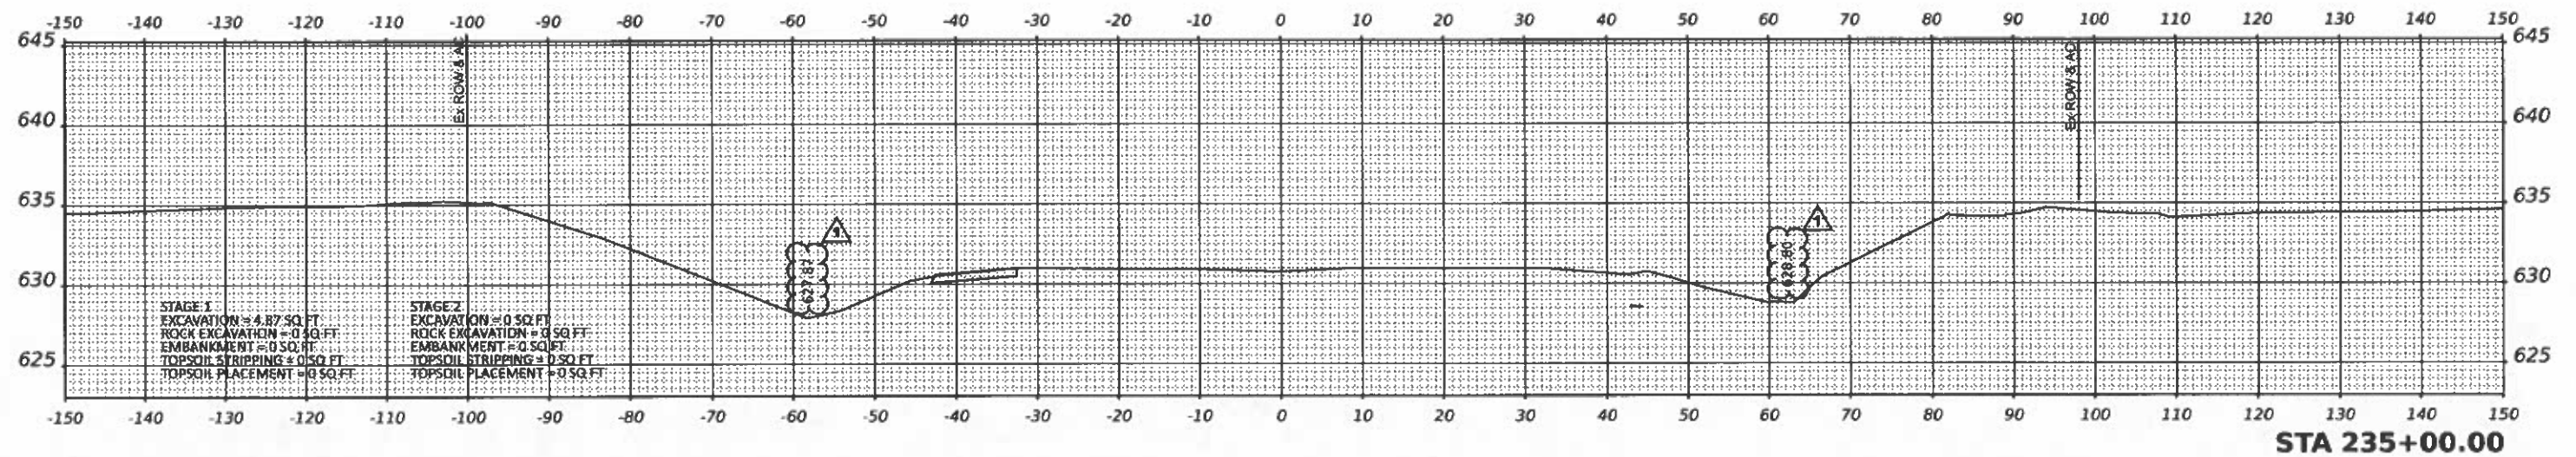

MODEL: PRJ_57
FILE NAME: PRJ_57_234+00.00.dgn

TransSmart
411 South Wells Street Suite 1000
Chicago, Illinois 60607

USER NAME = aswac
PLOT SCALE = 0.10000033' / in.
PLOT DATE = 7/9/2021

DESIGNED - BJD
DRAWN - BJD
CHECKED - TW
DATE - 2021/03/26

REVISED -
REVISED -
REVISED -
REVISED -

STATE OF ILLINOIS
DEPARTMENT OF TRANSPORTATION



INTERSTATE 57
CROSS SECTIONS

SCALE: 1" = 10' SHEET 12 OF 13 SHEETS STA. 234+00 TO STA. 235+00

F.A.I. RTE.	SECTION	COUNTY	TOTAL SHEETS	SHEET NO.
57	139 HBR-6	KANKAKEE	202	183
CONTRACT NO. 68997				

ILLINOIS FED. AID PROJECT

REV. 08/25/21

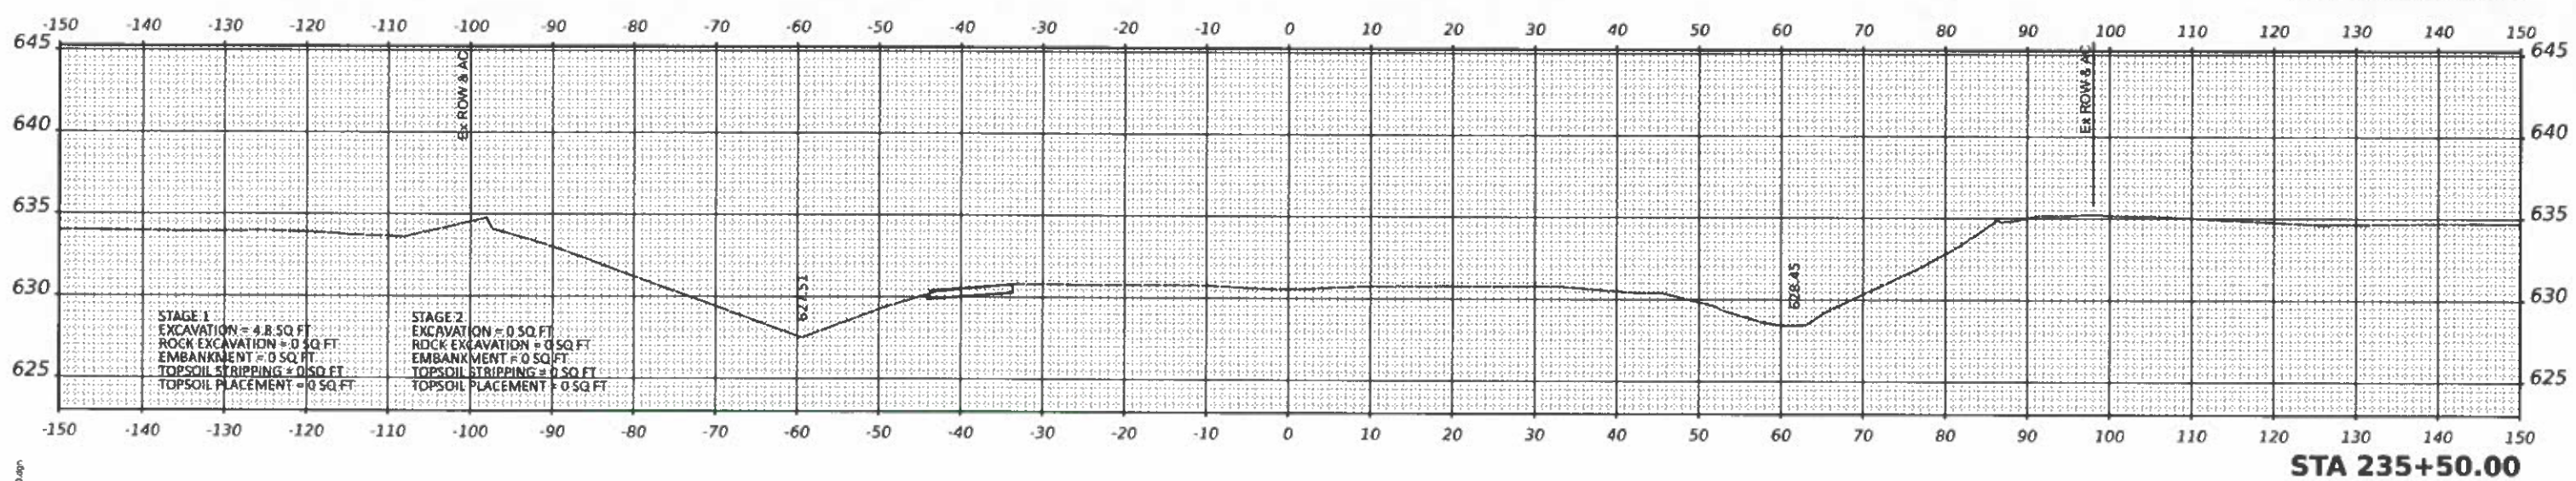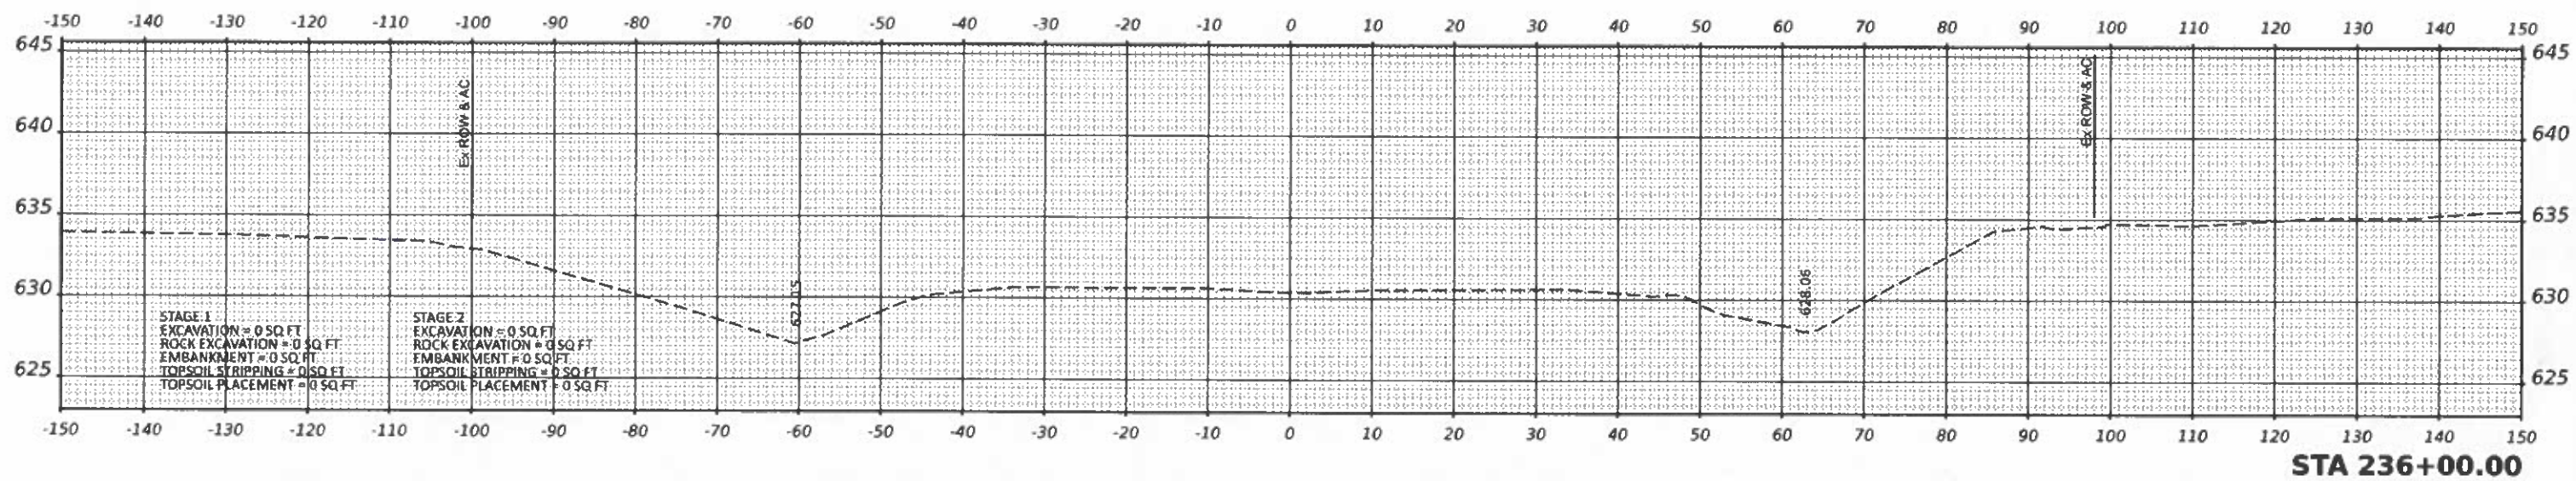

MODEL: PL_17/15-30
FILE NAME: 190117_15-30.dgn

TronSmart
411 South Wells Street Suite 1000
Chicago, Illinois 60607



USER NAME	msdian	DESIGNED	BJD	REVISED	-
PLOT SCALE	0.18888833 1/in.	DRAWN	BJD	REVISED	-
PLOT DATE	3/29/2021	CHECKED	TW	REVISED	-
		DATE	2021/03/26	REVISED	-

STATE OF ILLINOIS
DEPARTMENT OF TRANSPORTATION



INTERSTATE 57
CROSS SECTIONS

SCALE: 1" = 10' SHEET 13 OF 13 SHEETS STA. 235+50 TO STA. 236+00

F.A.I. RTE	SECTION	COUNTY	TOTAL SHEETS	SHEET NO.
57	139 HBR-6	KANKAKEE	202	184
CONTRACT NO. 66997				
ILLINOIS FED. AID PROJECT				

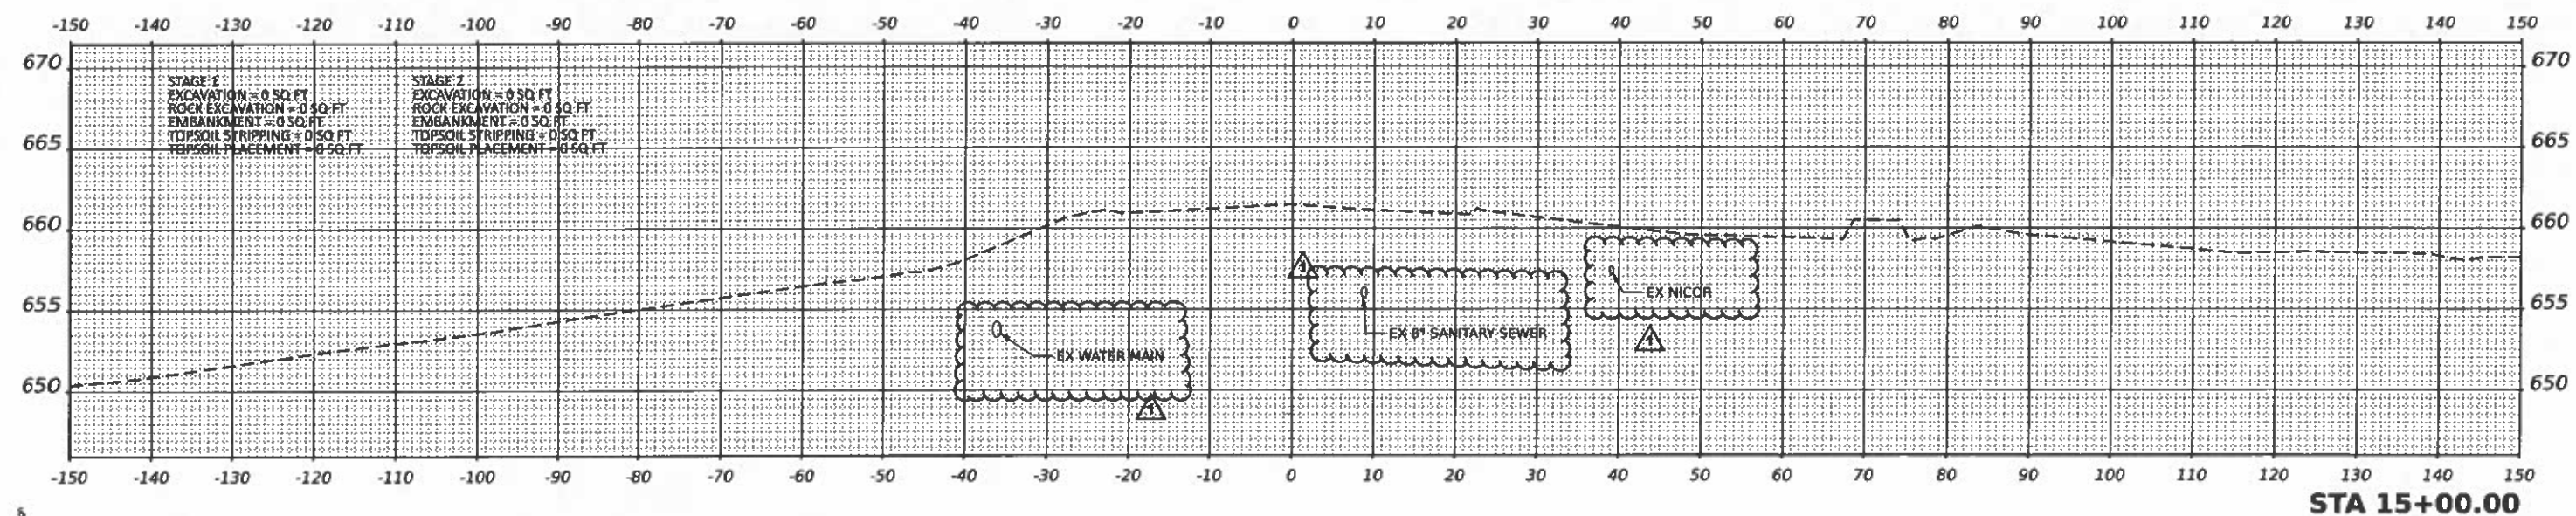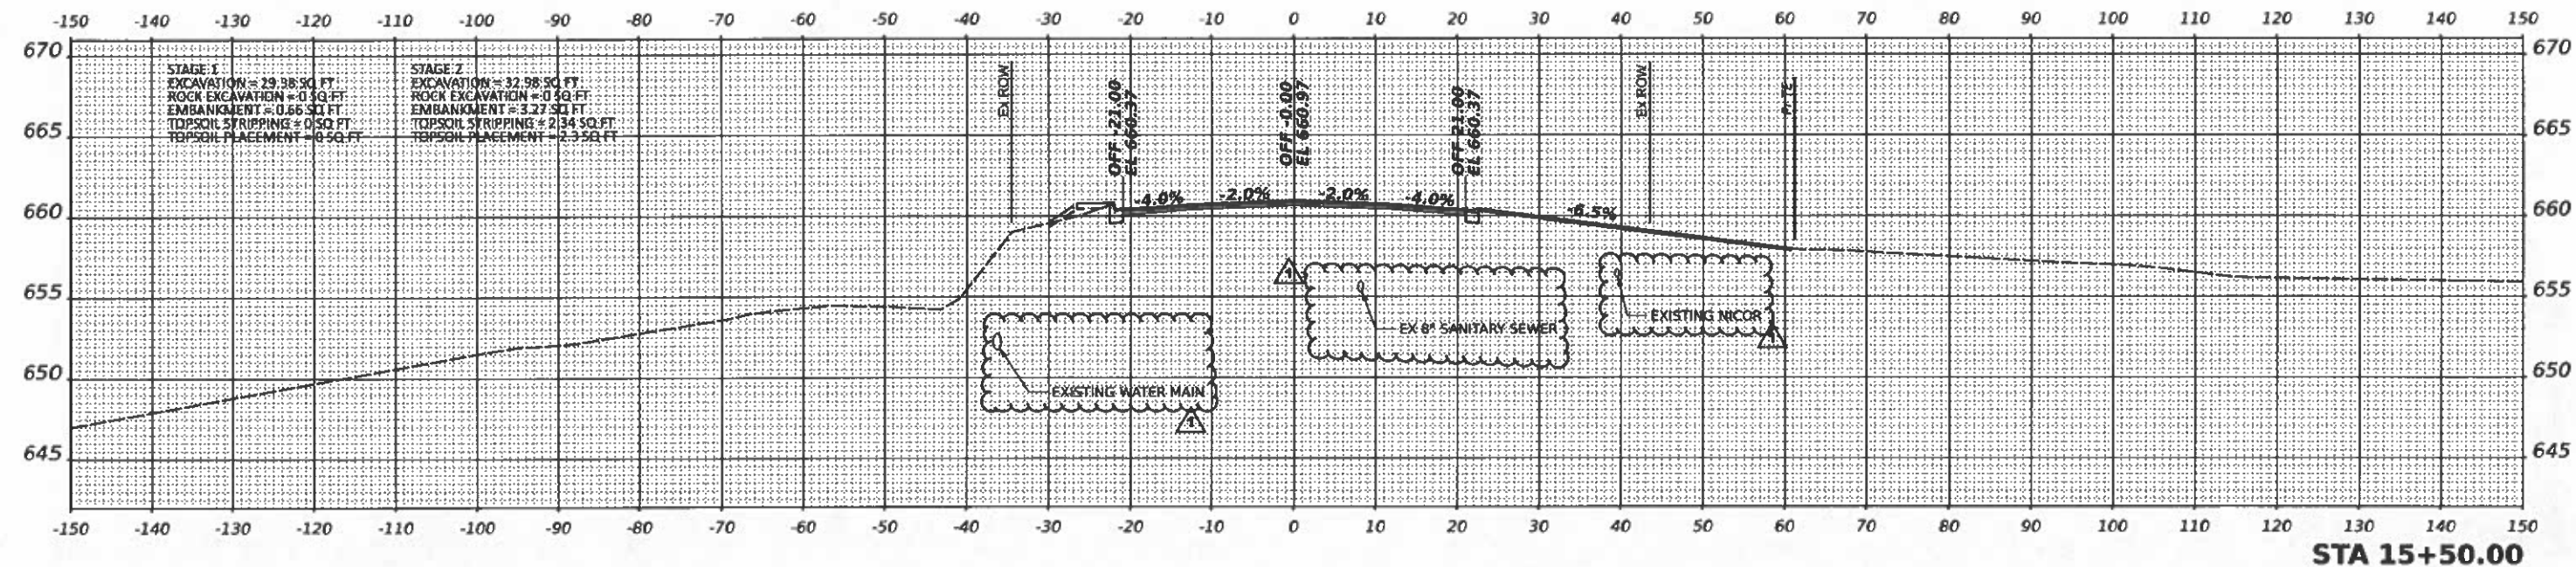

TranSmart 411 South Wells Street Suite 1000 Chicago, Illinois 60607	USER NAME = asphc	DESIGNED - NS	REVISED -	STATE OF ILLINOIS DEPARTMENT OF TRANSPORTATION	WALDRON ROAD CROSS SECTIONS	SCALE: SHEET 1 OF 15 SHEETS STA. 15+00 TO STA. 15+50	F.A.I. RTE. 57 SECTION 139 HBR-6 COUNTY KANKAKEE TOTAL SHEETS 202 SHEET NO. 185 CONTRACT NO. 66997 ILLINOIS FED. AID PROJECT
	PLOT SCALE = 0.10000033" / in.	DRAWN - NS	REVISED -				
	CHECKED - TW	REVISOR -	REVISOR -				
	PLOT DATE = 7/8/2021	DATE - 2021/07/09	REVISED -				

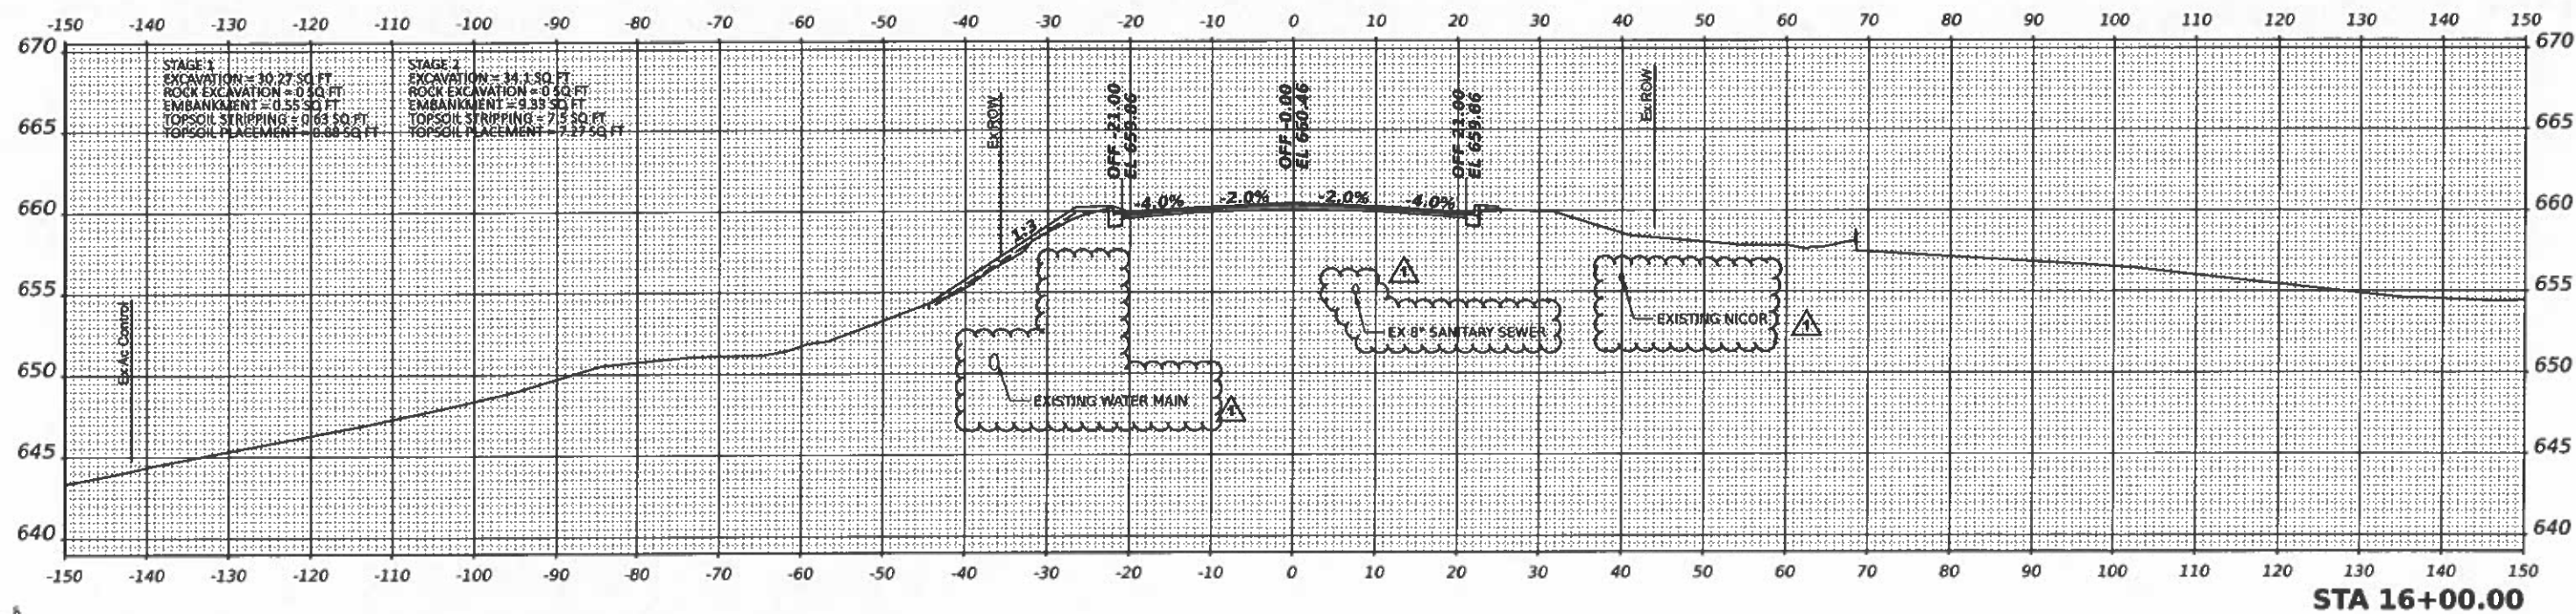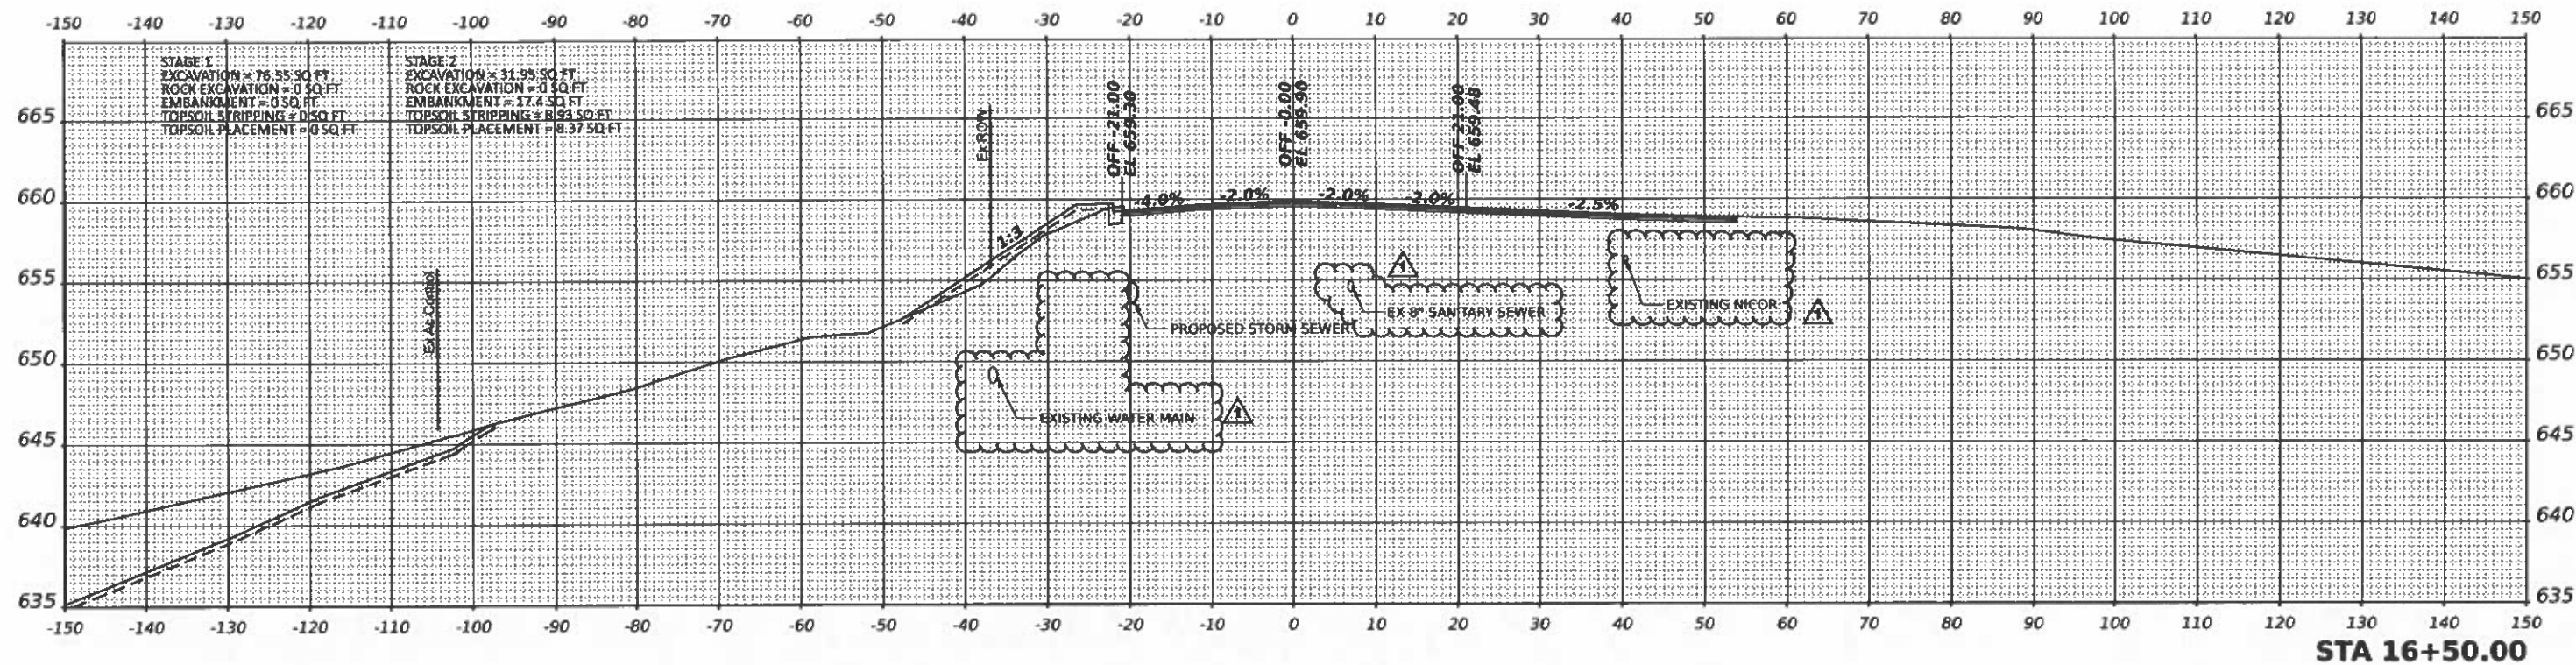

MODEL: 16+00.00
FILE NAME: 16+00.00.dgn

TranSmart
411 South Wells Street Suite 1000
Chicago, Illinois 60607

USER NAME = ash/c	DESIGNED - NS	REVISED -
DRAWN - NS	REVISOR -	
PLOT SCALE = 0.1060833" / ft.	CHECKED - TW	REVISED -
PLOT DATE = 7/9/2021	DATE - 2021/07/09	REVISED -

STATE OF ILLINOIS
DEPARTMENT OF TRANSPORTATION


WALDRON ROAD
CROSS SECTIONS

SCALE: SHEET 2 OF 15 SHEETS STA. 16+00 TO STA. 16+50


F.A.I. RTE	SECTION	COUNTY	TOTAL SHEETS	SHEET NO.
57	139 HBR-6	KANKAKEE	202	186
CONTRACT NO. 66997				

ILLINOIS FED. AID PROJECT

REV. 08/25/21

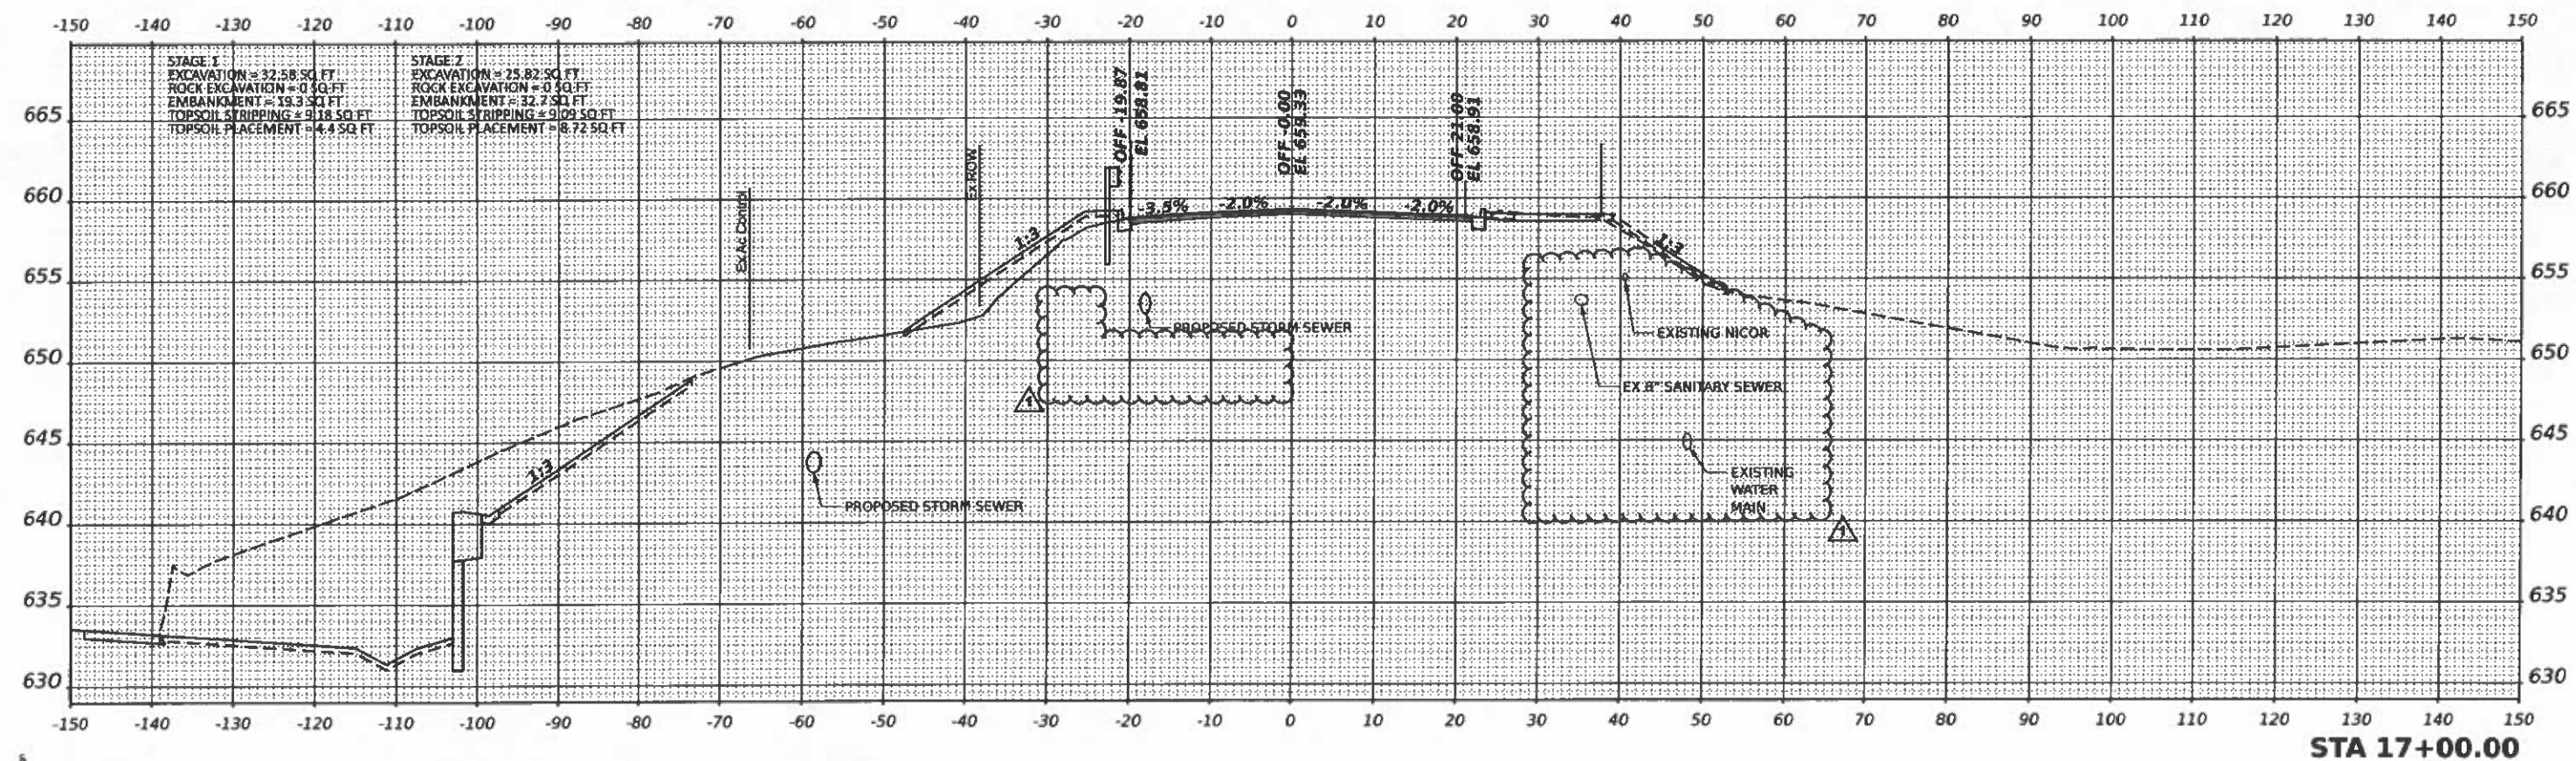

TranSmart 411 South Wells Street Suite 1000 Chicago, Illinois 60607	USER NAME = jsh/c	DESIGNED - NS	REVISED -	STATE OF ILLINOIS DEPARTMENT OF TRANSPORTATION		WALDRON ROAD CROSS SECTIONS		F.A.I. RTE.	SECTION	COUNTY	TOTAL SHEETS	SHEET NO.
	PLOT SCALE = 0.18888833" / ft.	DRAWN - NS	REVISED -					57	130 HBR-6	KANKAKEE	202	187
	PLOT DATE = 7/8/2021	CHECKED - TW	REVISED -					CONTRACT NO. 66997				
		DATE - 2021/07/09	REVISED -					ILLINOIS FED. AID PROJECT				

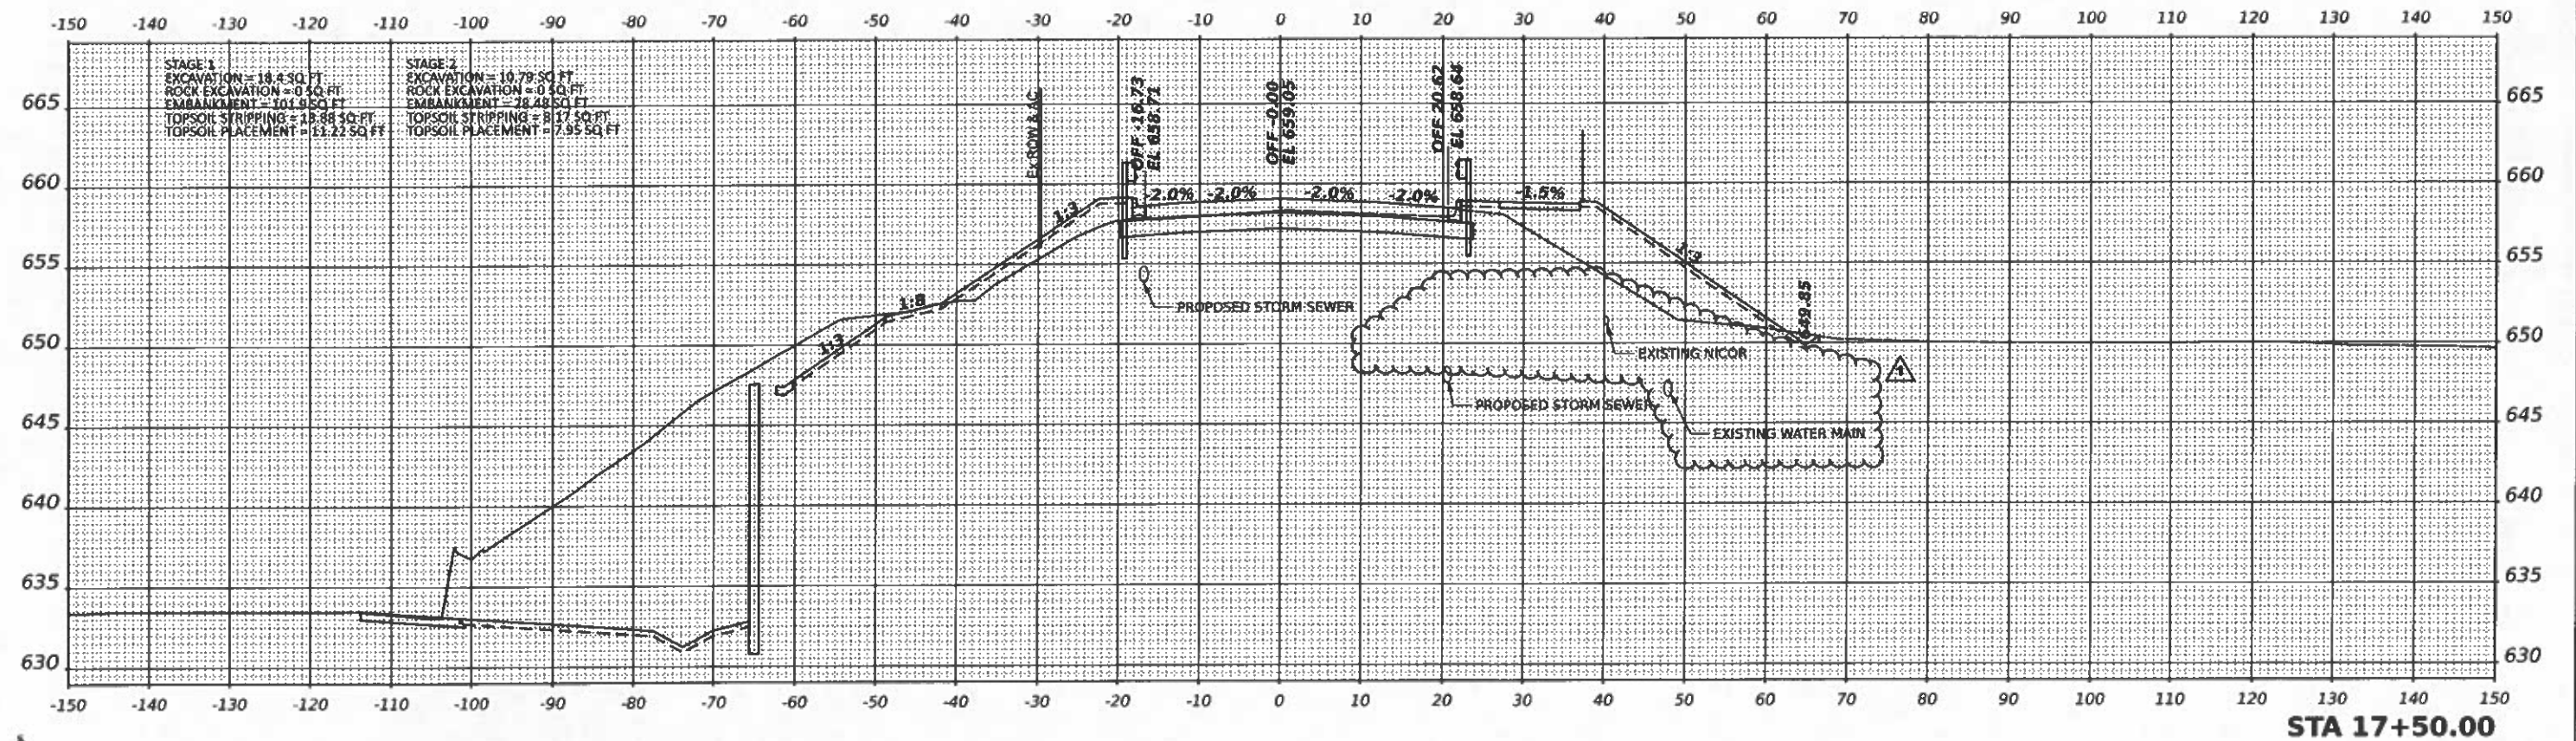

MODEL: 17-50.00
FILE NAME: 17-50.00.dgn

TranSmart
411 South Wells Street Suite 1000
Chicago, Illinois 60607

USER NAME = ashac	DESIGNED - NS	REVISED -
PLOT SCALE = 0.10000000 1/16"	DRAWN - NS	REVISED -
PLOT DATE = 7/9/2021	CHECKED - TW	REVISED -
	DATE - 2021/03/26	REVISED -

STATE OF ILLINOIS
DEPARTMENT OF TRANSPORTATION

WALDRON ROAD
CROSS SECTIONS


SCALE: SHEET 4 OF 15 SHEETS STA. 17+50 TO STA. 17+50

F.A.L. RTE.	SECTION	COUNTY	TOTAL SHEETS	SHEET NO.
57	139 HBR-6	KANKAKEE	202	188
CONTRACT NO. 66997				

ILLINOIS FED. AID PROJECT

REV. 08/25/21

NOTE : SEE STRUCTURAL SHEETS FOR BRIDGE DETAIL

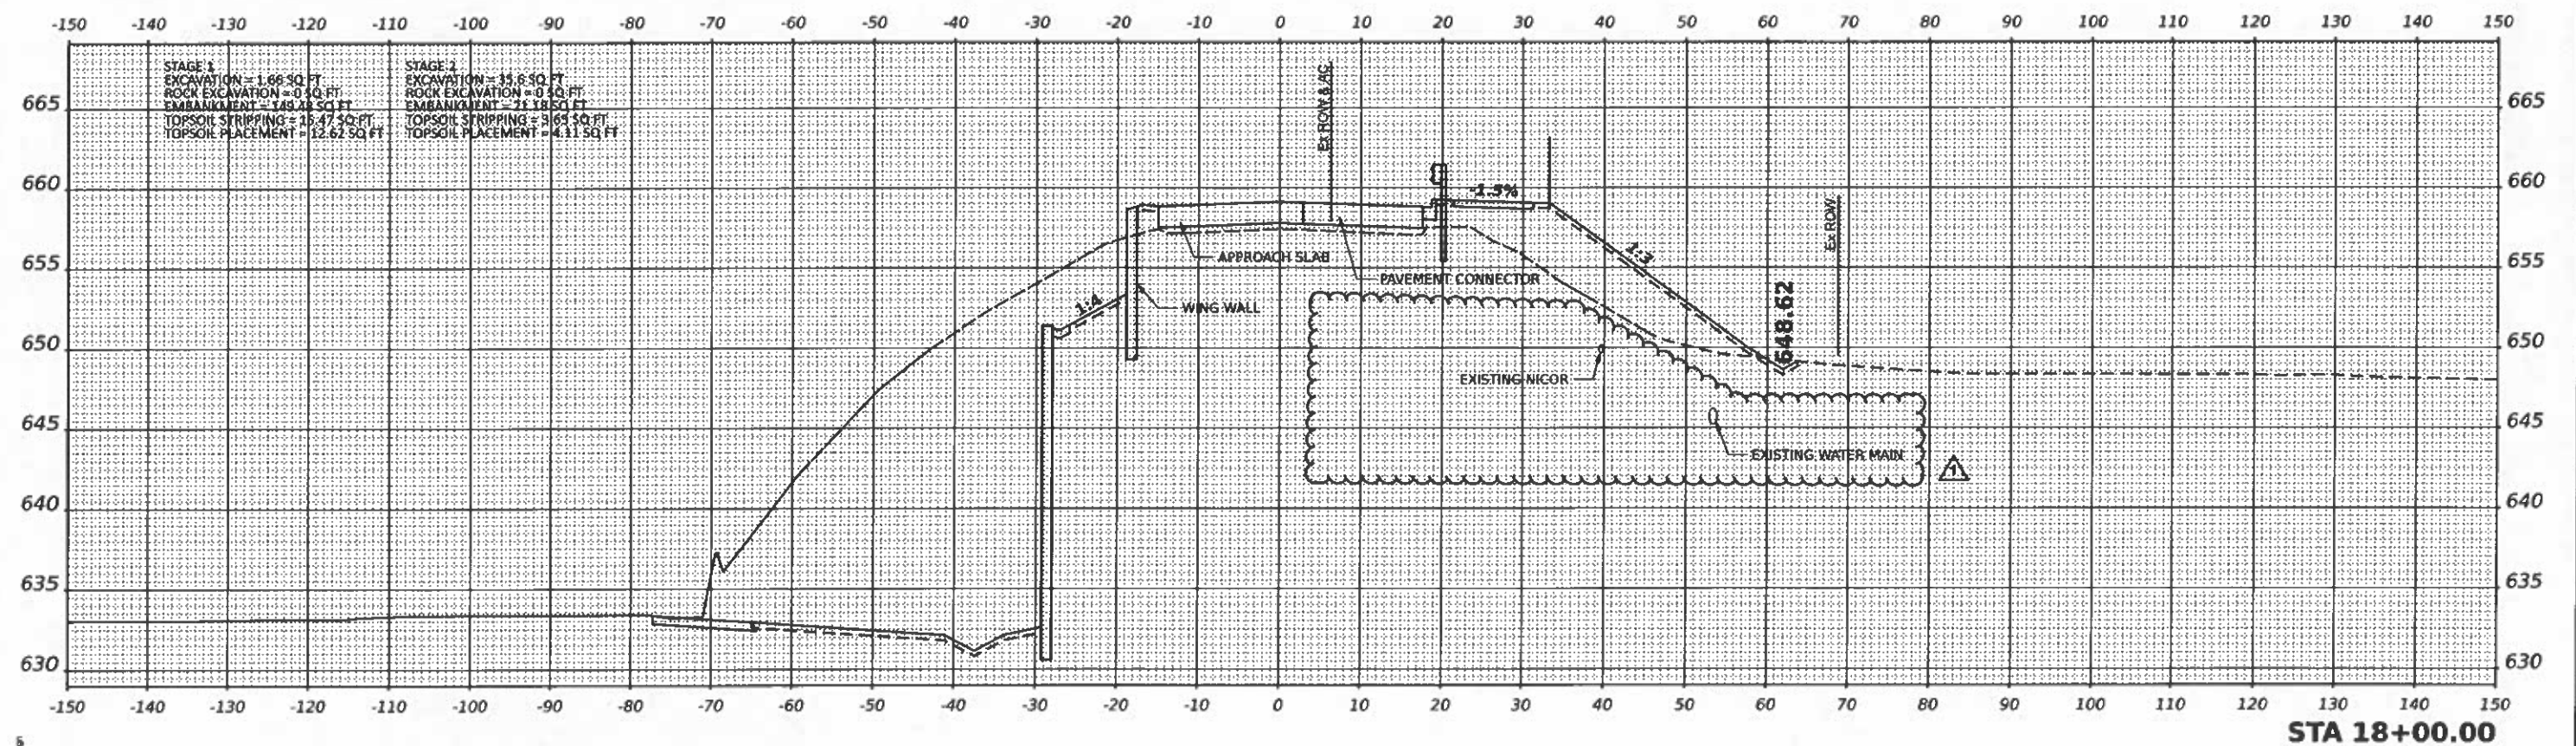

MODEL: 18-00-00
FILE NAME: 18-00-00.dgn

TranSmart
411 South Wells Street Suite 1000
Chicago, Illinois 60607

USER NAME = asw	DESIGNED = NS	REVISED =
PLOT SCALE = 0.10000033 / in.	DRAWN = NS	REVISED =
PLOT DATE = 7/9/2021	CHECKED = TW	REVISED =
	DATE = 2021/03/26	REVISED =

STATE OF ILLINOIS
DEPARTMENT OF TRANSPORTATION


WALDRON ROAD
CROSS SECTIONS

SCALE: SHEET 5 OF 15 SHEETS STA. 18+00 TO STA. 18+00

F.A.I. RTE.	SECTION	COUNTY	TOTAL SHEETS	SHEET NO.
57	139 HBR-6	KANKAKEE	202	189
CONTRACT NO. 68997				
ILLINOIS FED. AID PROJECT				

REV. 08/25/21

NOTE :SECTION THROUGH WALDRON BRIDGE NOT SHOWN.
SEE STRUCTURAL SHEETS FOR BRIDGE DETAIL

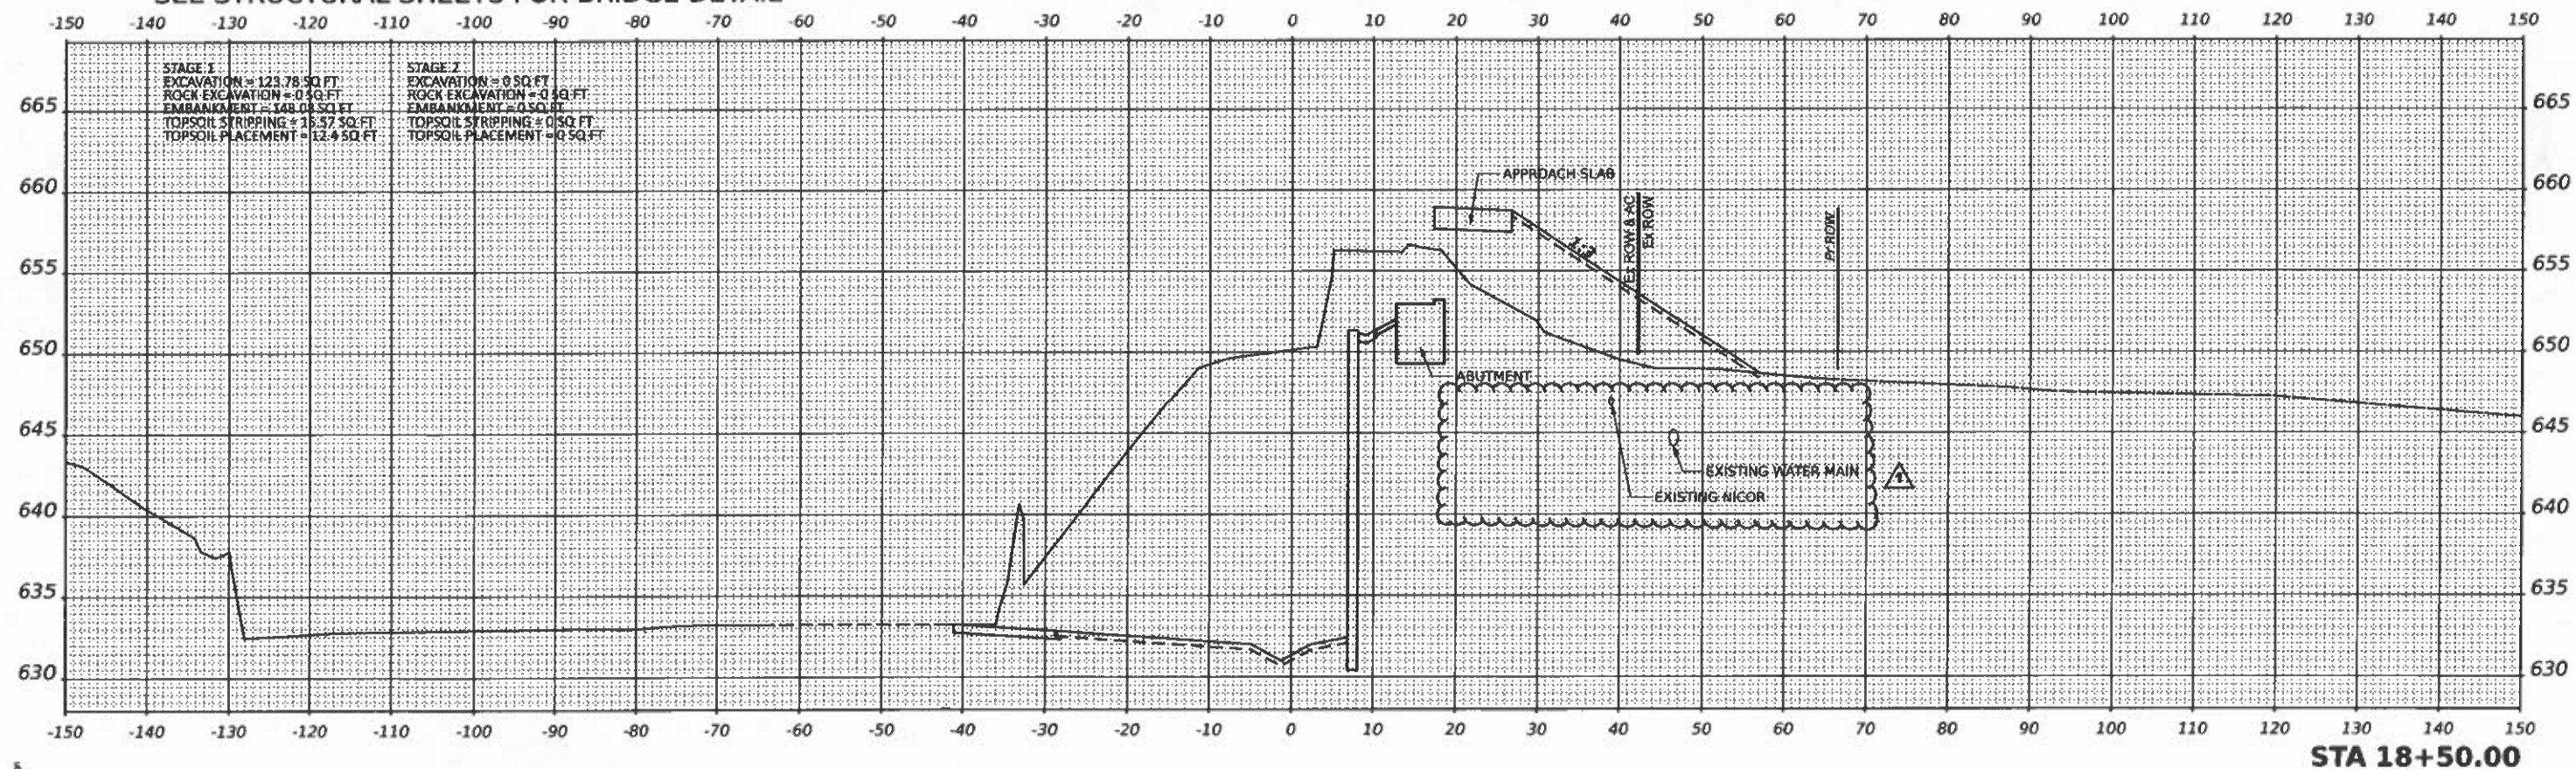

MODEL: 18-50.00
FILE NAME: 18-50.00.dgn

TranSmart
411 South Wells Street Suite 1000
Chicago, Illinois 60607

USER NAME = asfmc
PLOT SCALE = 0.18888833 / in.
PLOT DATE = 7/8/2021

DESIGNED - NS
DRAWN - NS
CHECKED - TW
DATE - 2021/03/28

REVISED -
REVISED -
REVISED -
REVISED -

STATE OF ILLINOIS
DEPARTMENT OF TRANSPORTATION


WALDRON ROAD
CROSS SECTIONS

SCALE: SHEET 6 OF 15 SHEETS STA. 18+50 TO STA. 18+50

F.A.I. RTE.	SECTION	COUNTY	TOTAL SHEETS	SHEET NO.
57	139 HBR-6	KANKAKEE	202	190
CONTRACT NO. 66997				
ILLINOIS FED. AID PROJECT				

REV. 08/25/21

NOTE :SECTION THROUGH WALDRON BRIDGE NOT SHOWN.
SEE STRUCTURAL SHEETS FOR BRIDGE DETAIL

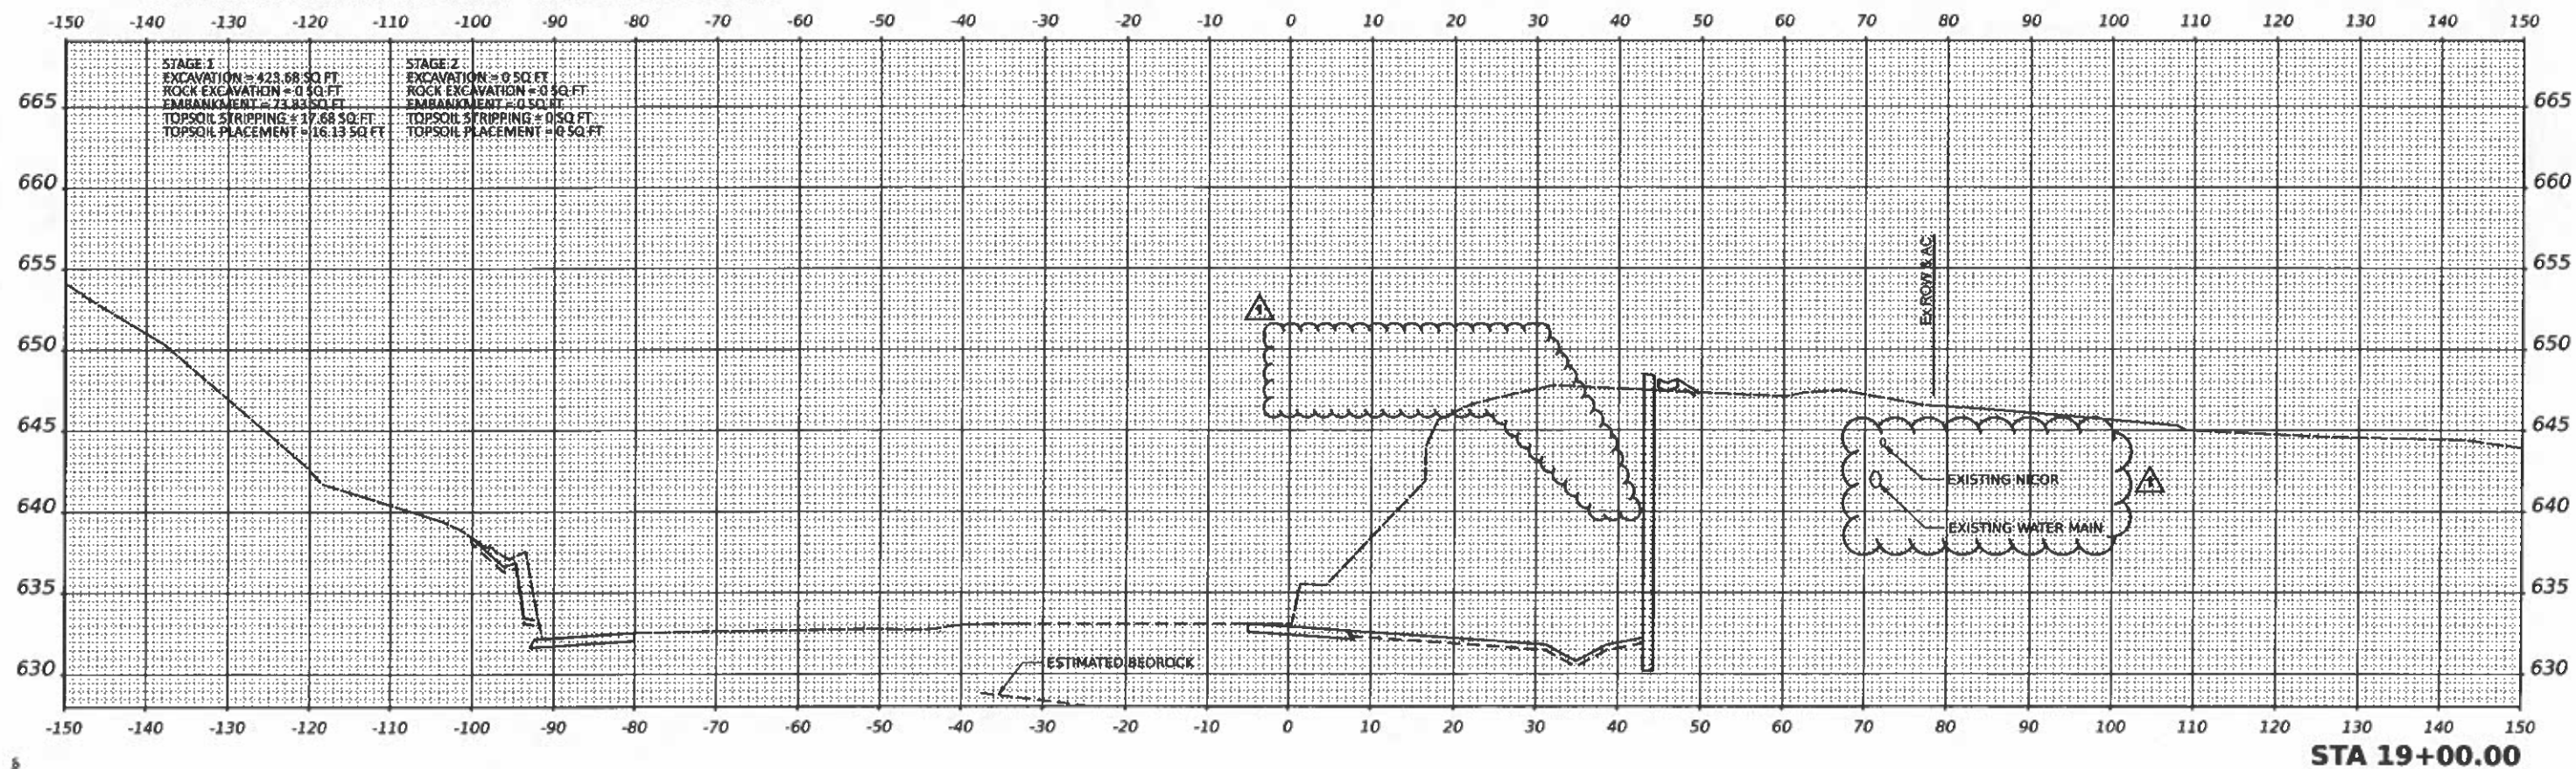

MODEL: 18-006
FILE NAME: 18-006.dgn

TranSmart
411 South Wells Street Suite 1000
Chicago, Illinois 60607

USER NAME = jshhc	DESIGNED - NS	REVISED -
PLOT SCALE = 0.10000033 1/in.	DRAWN - NS	REVISED -
PLOT DATE = 7/9/2021	CHECKED - TW	REVISED -
	DATE - 2021/03/26	REVISED -

STATE OF ILLINOIS
DEPARTMENT OF TRANSPORTATION


WALDRON ROAD
CROSS SECTIONS

SCALE: SHEET 7 OF 15 SHEETS STA. 19+00 TO STA. 19+00

F.A.I. RTE.	SECTION	COUNTY	TOTAL SHEETS	SHEET NO.
67	138 HBR-6	KANKAKEE	202	191
CONTRACT NO. 68997				
ILLINOIS FED. AID PROJECT				

REV. 08/25/21

NOTE :SECTION THROUGH WALDRON BRIDGE NOT SHOWN.
SEE STRUCTURAL SHEETS FOR BRIDGE DETAIL

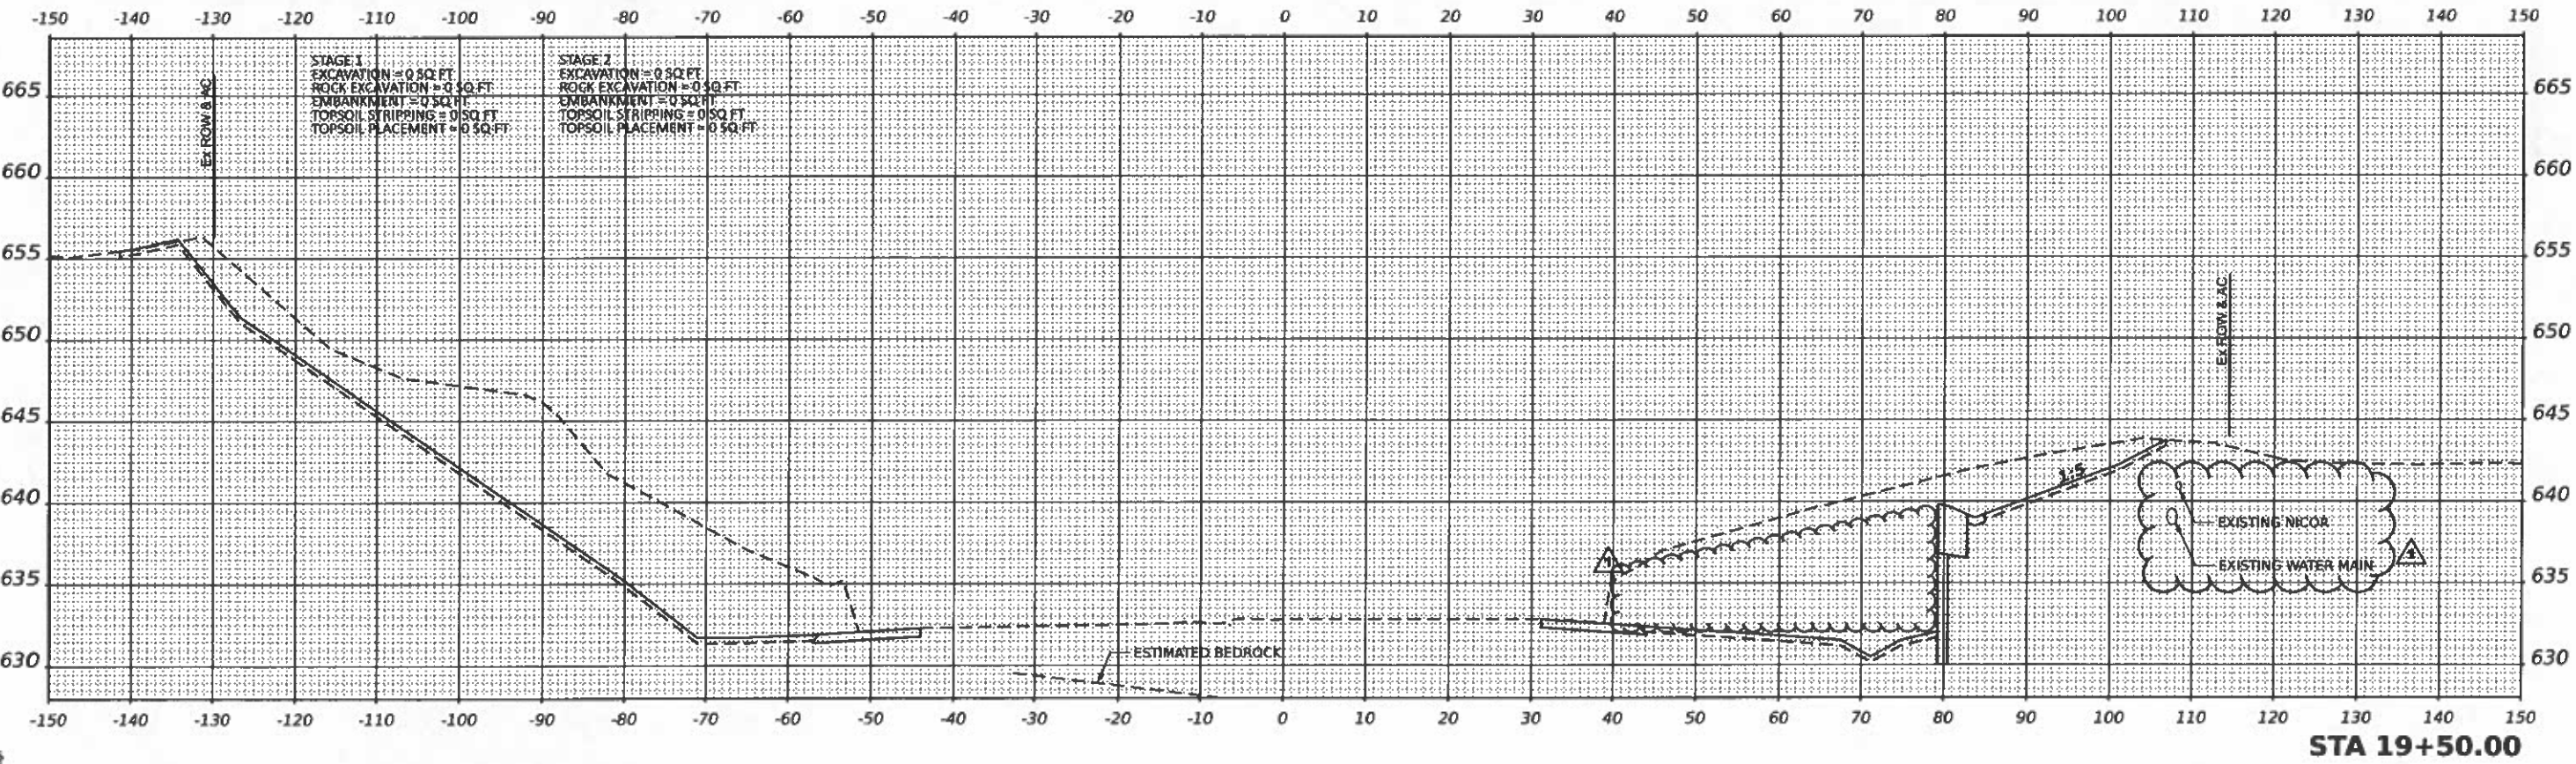

MODEL: 19-50-00

FILE NAME: 19-50-00.dwg

TranSmart

411 South Wells Street Suite 1000

Chicago, Illinois 60607

USER NAME = asfAc	DESIGNED = NS	REVISED =
	DRAWN = NS	REVISED =
PLOT SCALE = 0.10000033 / in.	CHECKED = TW	REVISED =
PLOT DATE = 7/6/2021	DATE = 2021/03/26	REVISED =

STATE OF ILLINOIS

DEPARTMENT OF TRANSPORTATION


WALDRON ROAD

CROSS SECTIONS

SCALE:	SHEET 8 OF 15 SHEETS	STA. 19+50 TO STA. 19+50
--------	----------------------	--------------------------

F.A.I. RTE. 57	SECTION 139 HBR-6	COUNTY KANKAKEE	TOTAL SHEETS 202	SHEET NO. 192
CONTRACT NO. 68997			ILLINOIS FED. AID PROJECT	

NOTE: SECTION THROUGH WALDRON BRIDGE NOT SHOWN.
SEE STRUCTURAL SHEETS FOR BRIDGE DETAIL

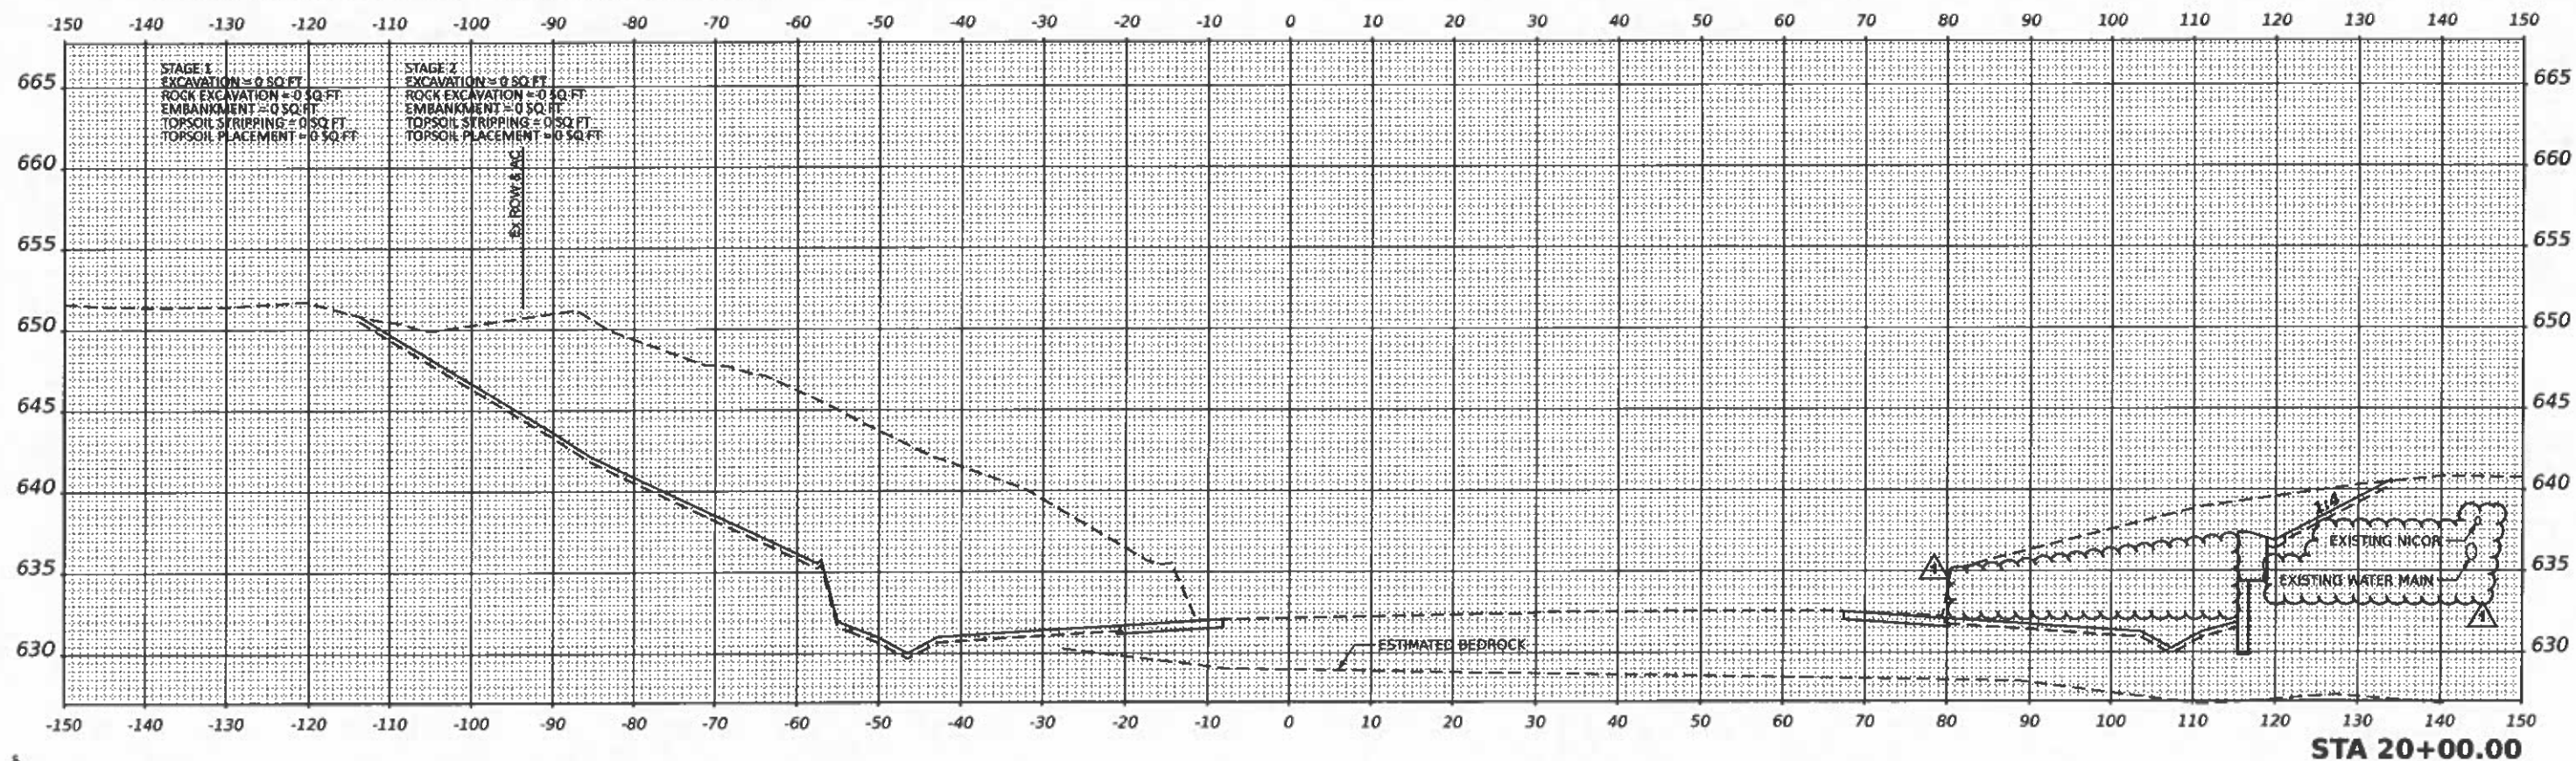

MODEL: 204010
FILE NAME: 204010.dgn

TranSmart
411 South Wells Street Suite 1000
Chicago, Illinois 60607

USER NAME = ashac	DESIGNED = NS	REVISED =
PLOT SCALE = 0.18000033 / in.	DRAWN = NS	REVISED =
PLOT DATE = 7/9/2021	CHECKED = TW	REVISED =
	DATE = 2021/03/26	REVISED =

STATE OF ILLINOIS
DEPARTMENT OF TRANSPORTATION


WALDRON ROAD
CROSS SECTIONS

SCALE: SHEET 9 OF 15 SHEETS STA. 20+00 TO STA. 20+00

F.A.I. RTE.	SECTION	COUNTY	TOTAL SHEETS	SHEET NO.
57	139 HBR-6	KANKAKEE	202	193
CONTRACT NO. 66997				
ILLINOIS FED. AID PROJECT				


REV. 08/25/21

NOTE: SECTION THROUGH WALDRON BRIDGE NOT SHOWN.
SEE STRUCTURAL SHEETS FOR BRIDGE DETAIL

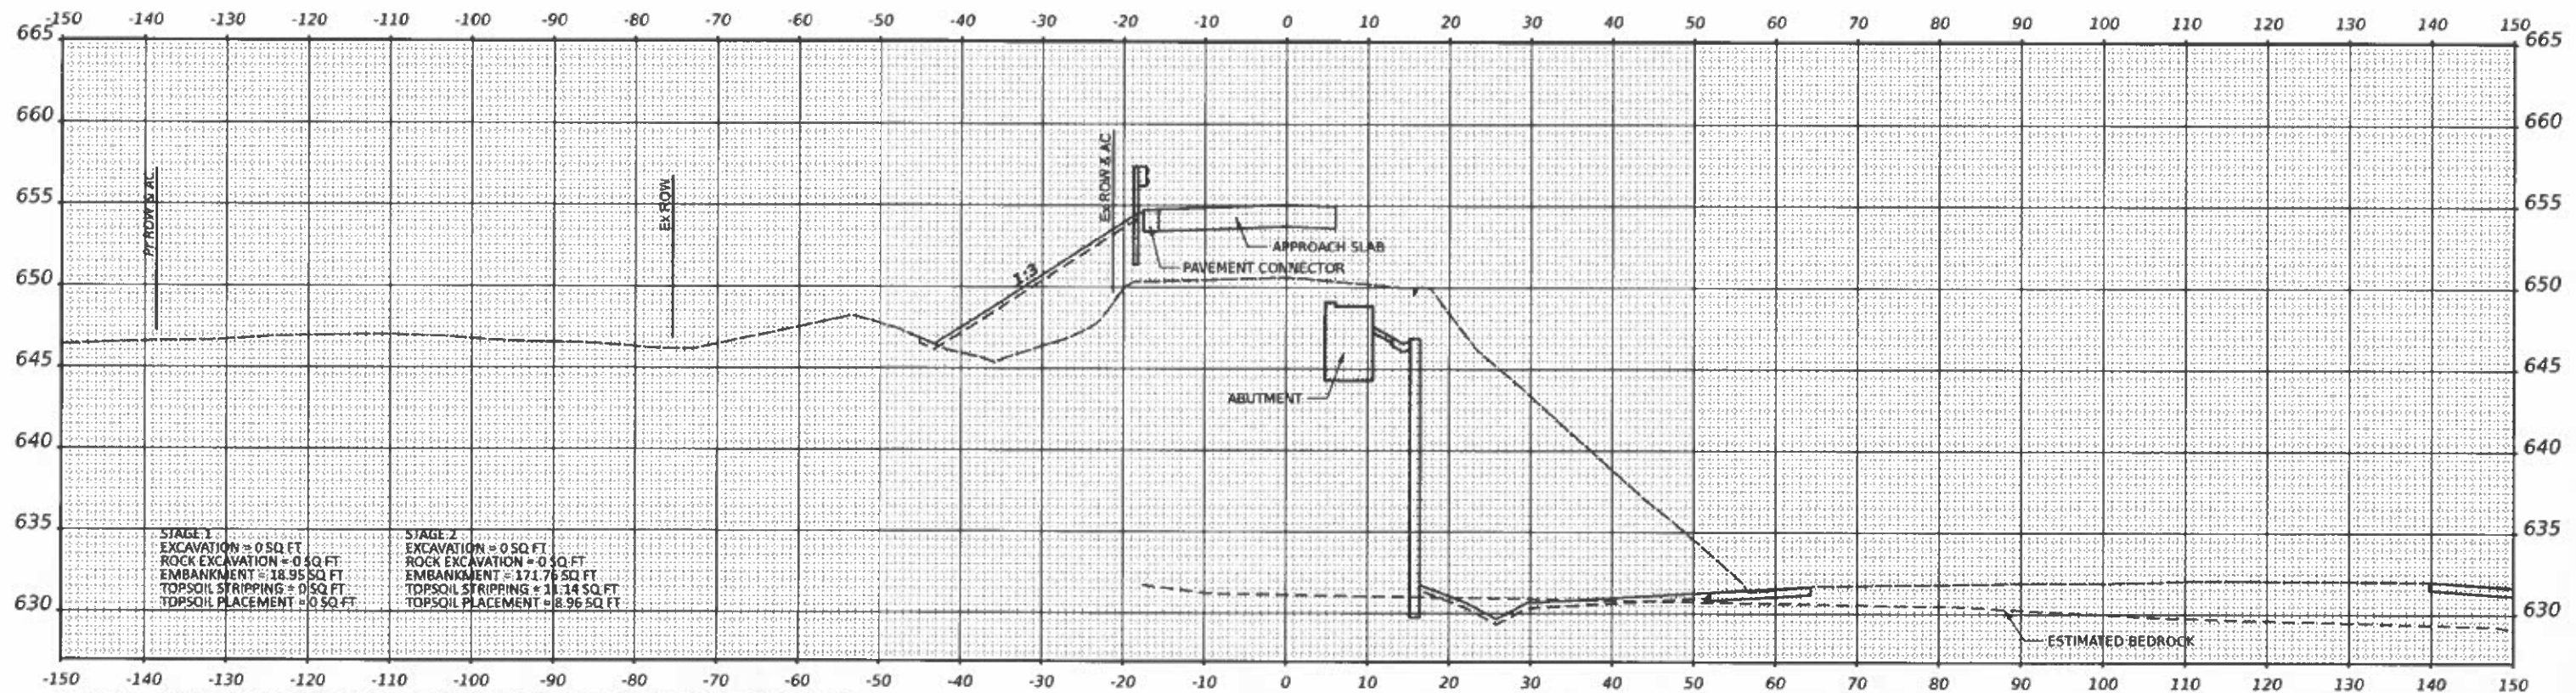

NOTE: SECTION THROUGH WALDRON BRIDGE NOT SHOWN.
SEE STRUCTURAL SHEETS FOR BRIDGE DETAIL

STA 21+00.00

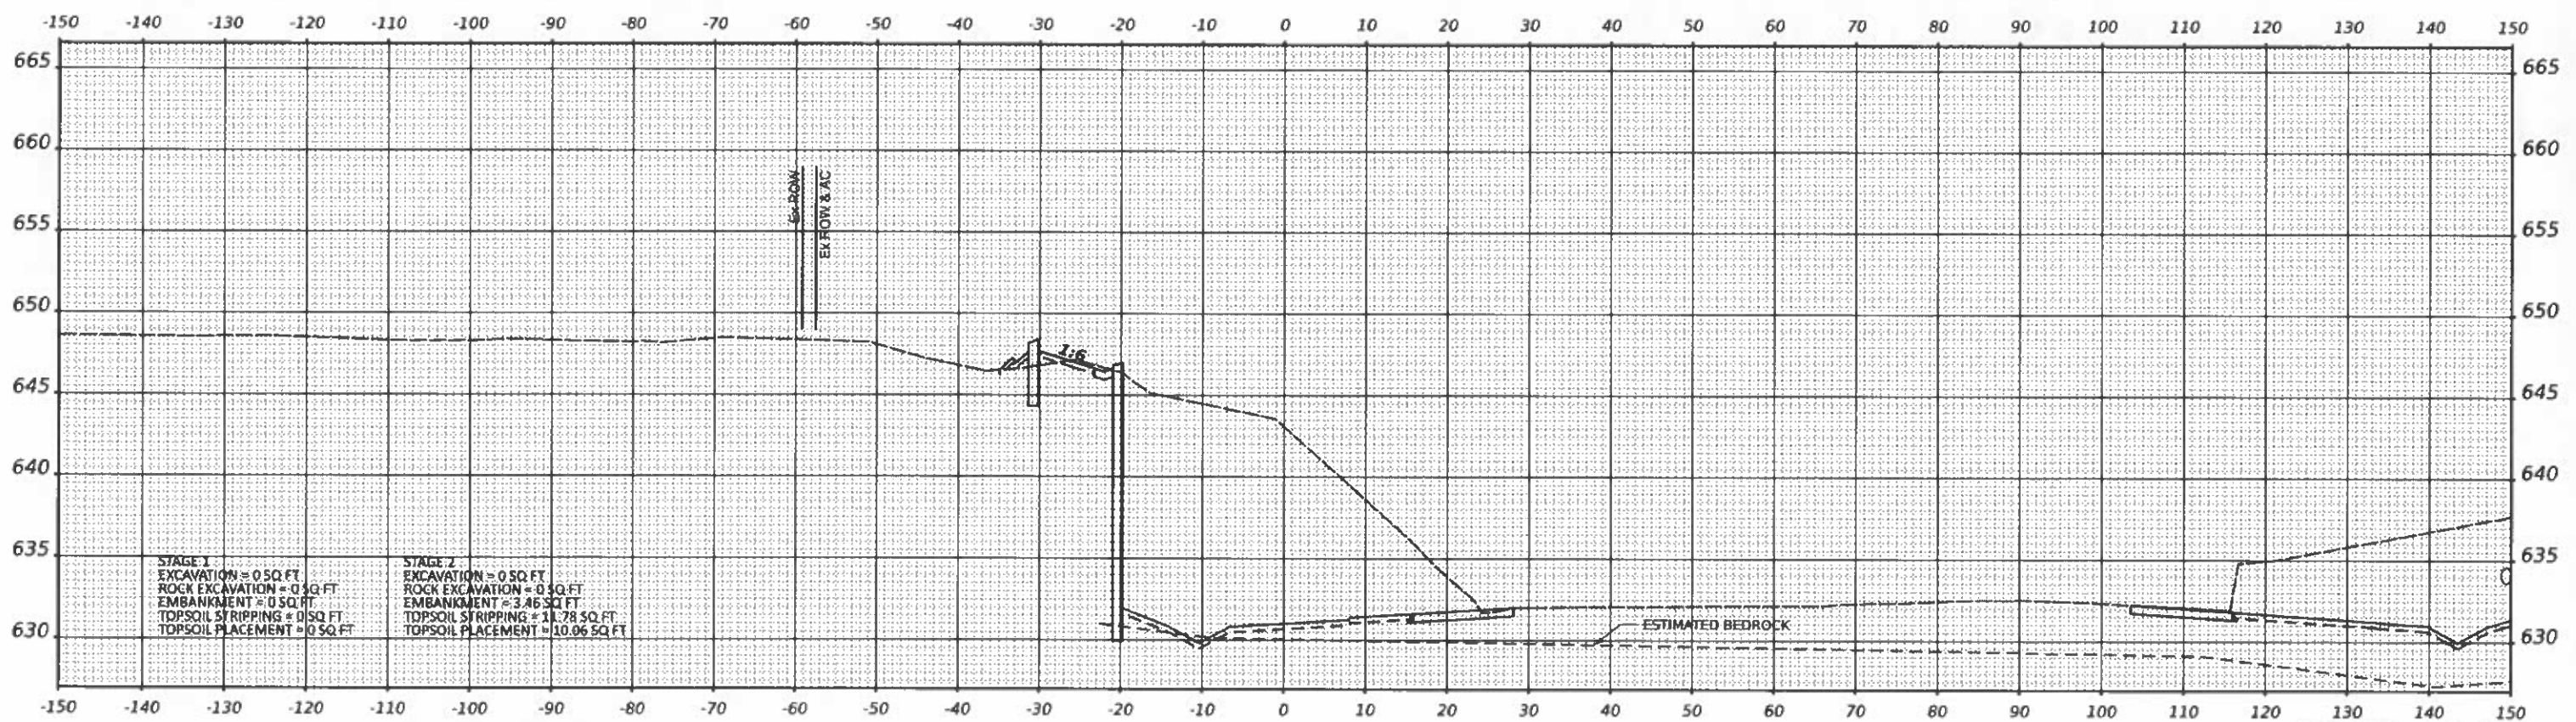

STA 20+50.00

MODEL: 20-20-00
FILE NAME: 20-20-00.dgn

Transmart
411 South Wells Street Suite 1000
Chicago, Illinois 60607

USER NAME = realerham	DESIGNED = NS	REVISED =
PLOT SCALE = 0.1866833' / in.	DRAWN = NS	REVISED =
PLOT DATE = 3/28/2021	CHECKED = TW	REVISED =
	DATE = 2021/03/26	REVISED =



STATE OF ILLINOIS
DEPARTMENT OF TRANSPORTATION

WALDRON ROAD
CROSS SECTIONS

SCALE: SHEET 10 OF 15 SHEETS STA. 20+50 TO STA. 21+00

F.A.I. RTE	SECTION	COUNTY	TOTAL SHEETS	SHEET NO.
57	139 HBR-6	KANKAKEE	202	194
CONTRACT NO. 66997				

ILLINOIS FED. AID PROJECT

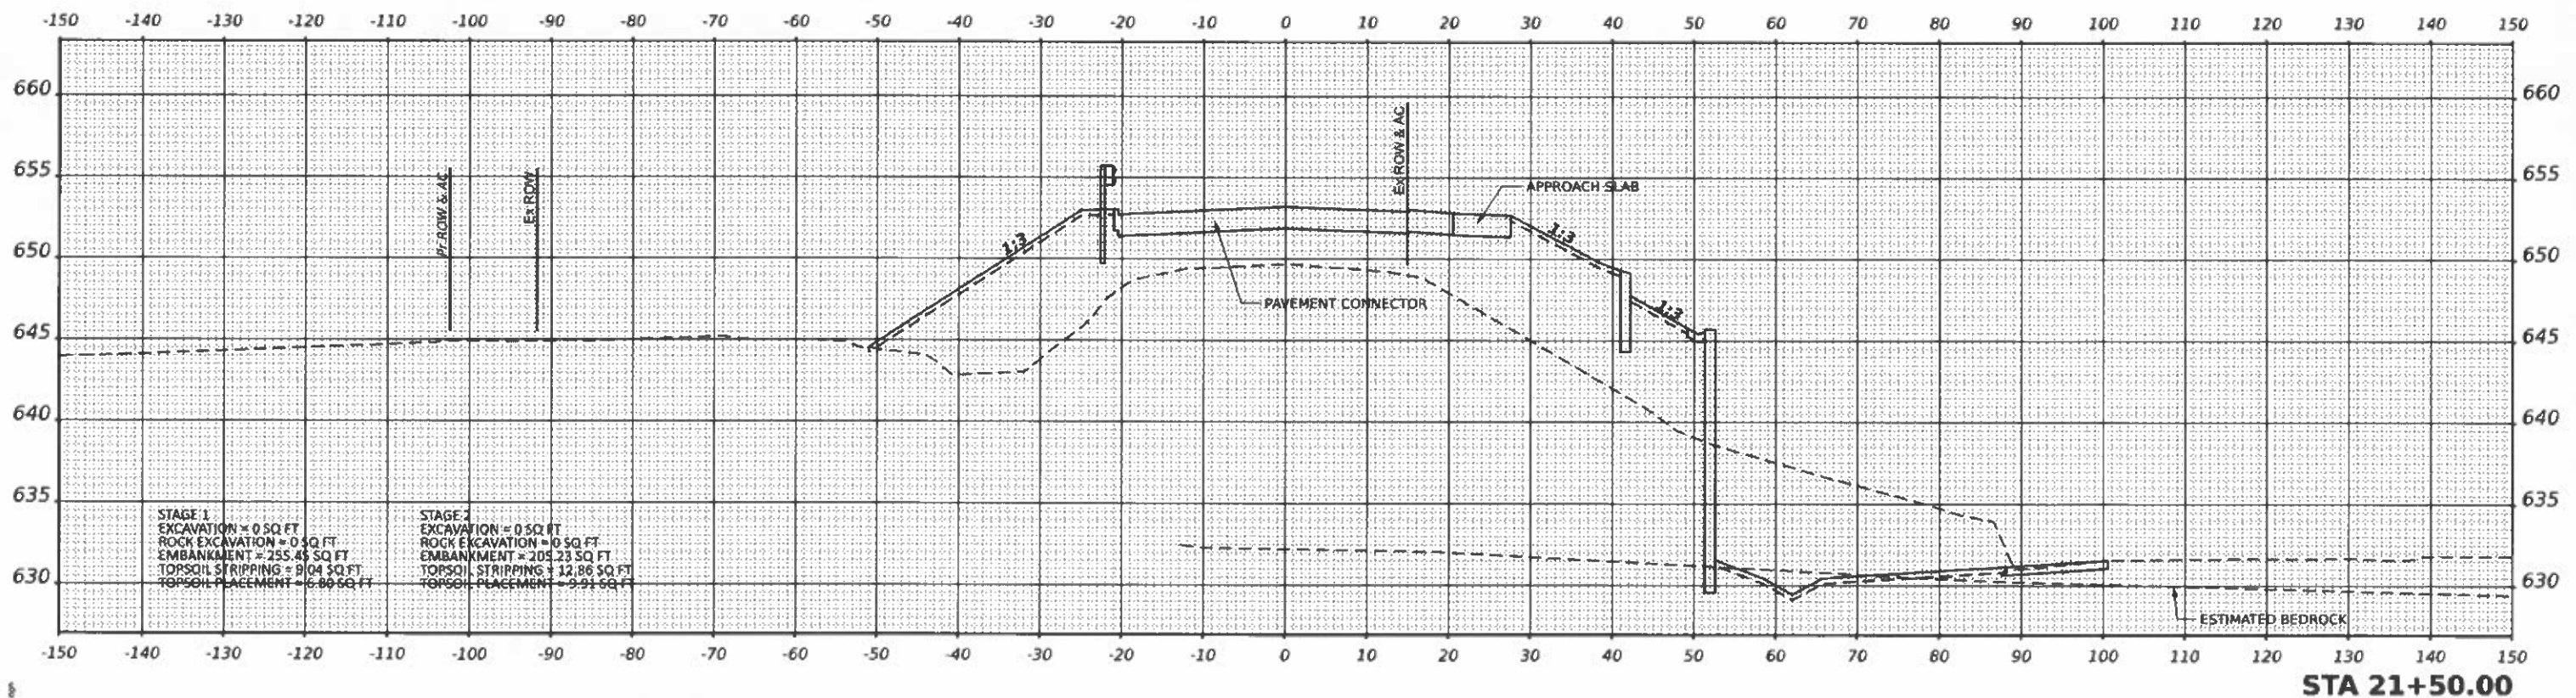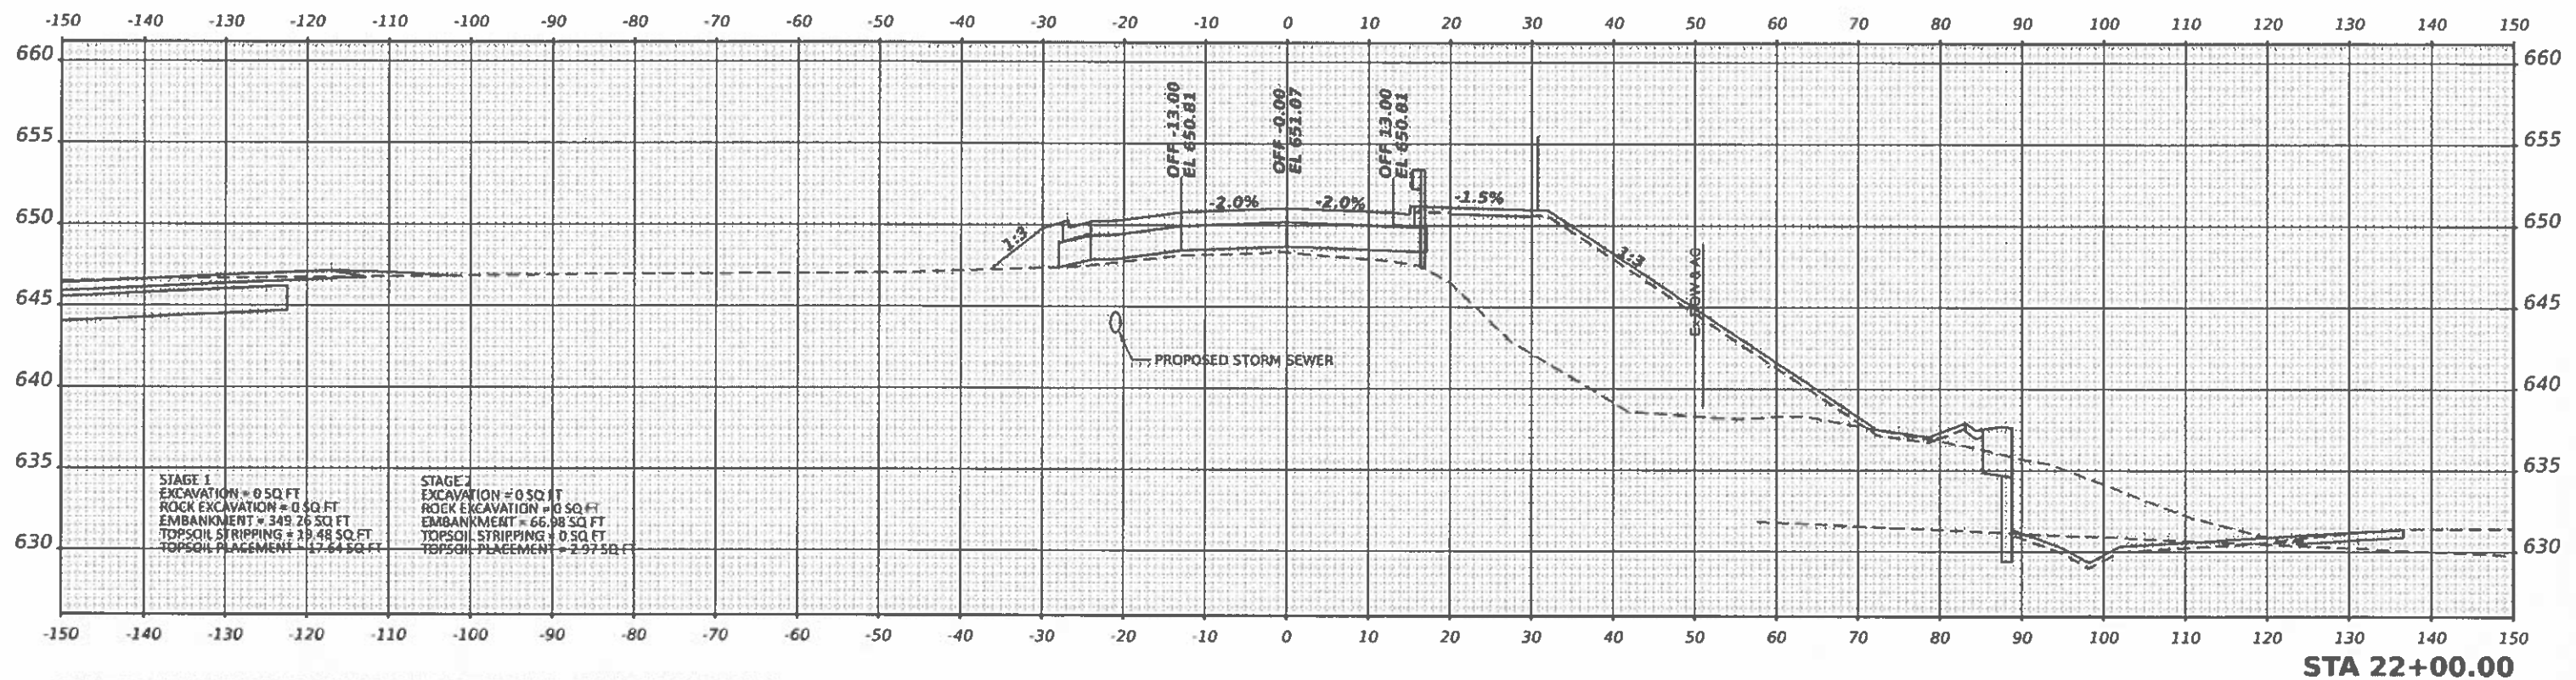

MODEL: 21-50-00
FILE NAME: 21-50-00.dgn

TransSmart
411 South Wells Street Suite 1000
Chicago, Illinois 60607

USER NAME = rjordan
PLOT SCALE = 0.16666633' / in.
PLOT DATE = 3/28/2021

DESIGNED - NS
DRAWN - NS
CHECKED - TW
DATE - 2021/03/26

REVISED - 5/7/2021
REVISED -
REVISED -
REVISED -



STATE OF ILLINOIS
DEPARTMENT OF TRANSPORTATION

WALDRON ROAD
CROSS SECTIONS




SCALE: SHEET 11 OF 15 SHEETS STA. 21+50 TO STA. 22+00

F.A.L. RTE	SECTION	COUNTY	TOTAL SHEETS	SHEET NO.
57	139 HBR-6	KANKAKEE	202	195

CONTRACT NO. 66997
ILLINOIS FED. AID PROJECT

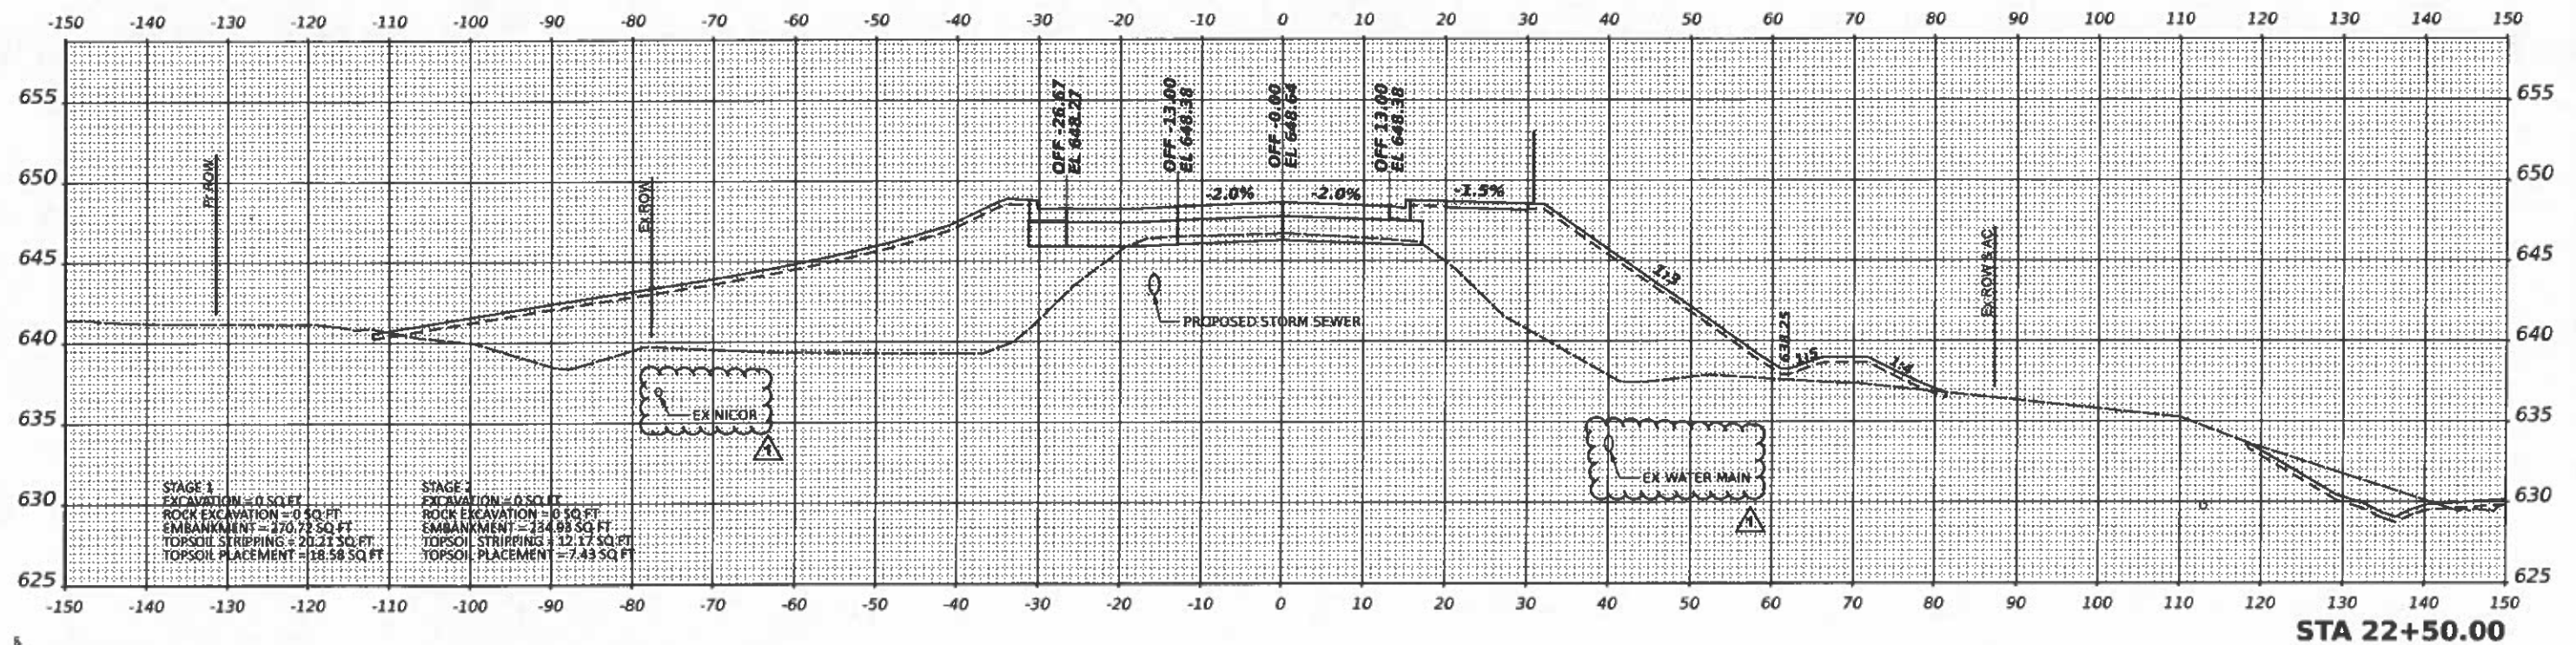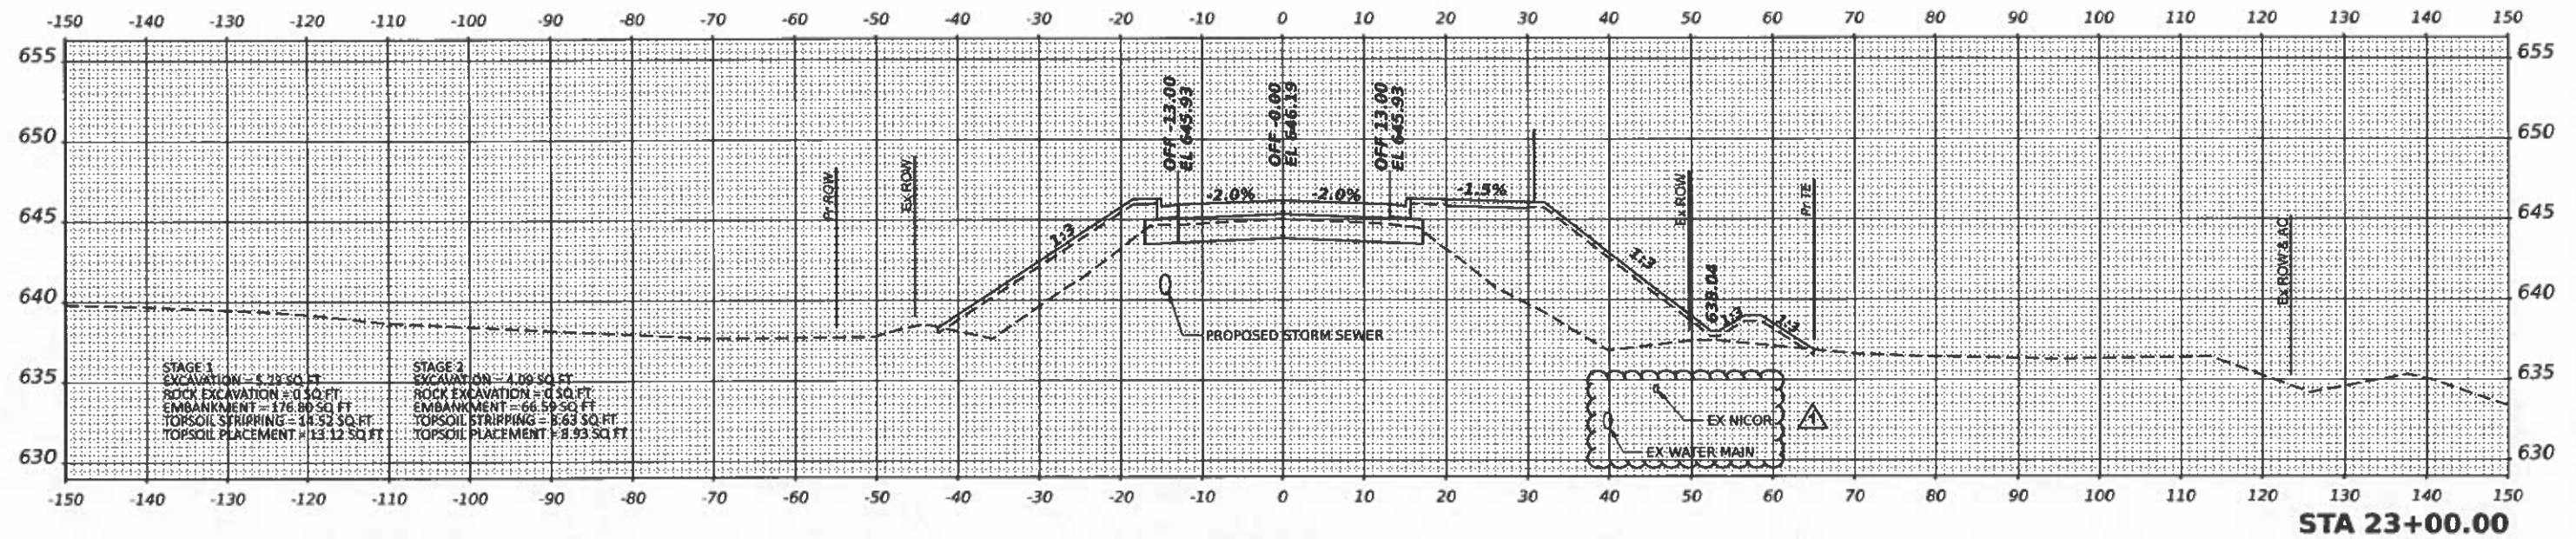

TranSmart 411 South Wells Street Suite 1000 Chicago, Illinois 60607	USER NAME = jshk		DESIGNED - NS	REVISED -	STATE OF ILLINOIS DEPARTMENT OF TRANSPORTATION	WALDRON ROAD CROSS SECTIONS		F.A.I. RTE. 57	SECTION 139 HBR-6	COUNTY KANKAKEE	TOTAL SHEETS 202	SHEET NO. 198
	PLOT SCALE = 0.10000033 / 1 in.		DRAWN - NS	REVISED -		SCALE: SHEET 12 OF 15 SHEETS STA. 22+50 TO STA. 23+00		CONTRACT NO. 66997				
	PLOT DATE = 7/6/2021		CHECKED - TW	REVISED -				ILLINOIS FED. AID PROJECT				
			DATE - 2021/03/26	REVISED -				REV. 08/25/21				

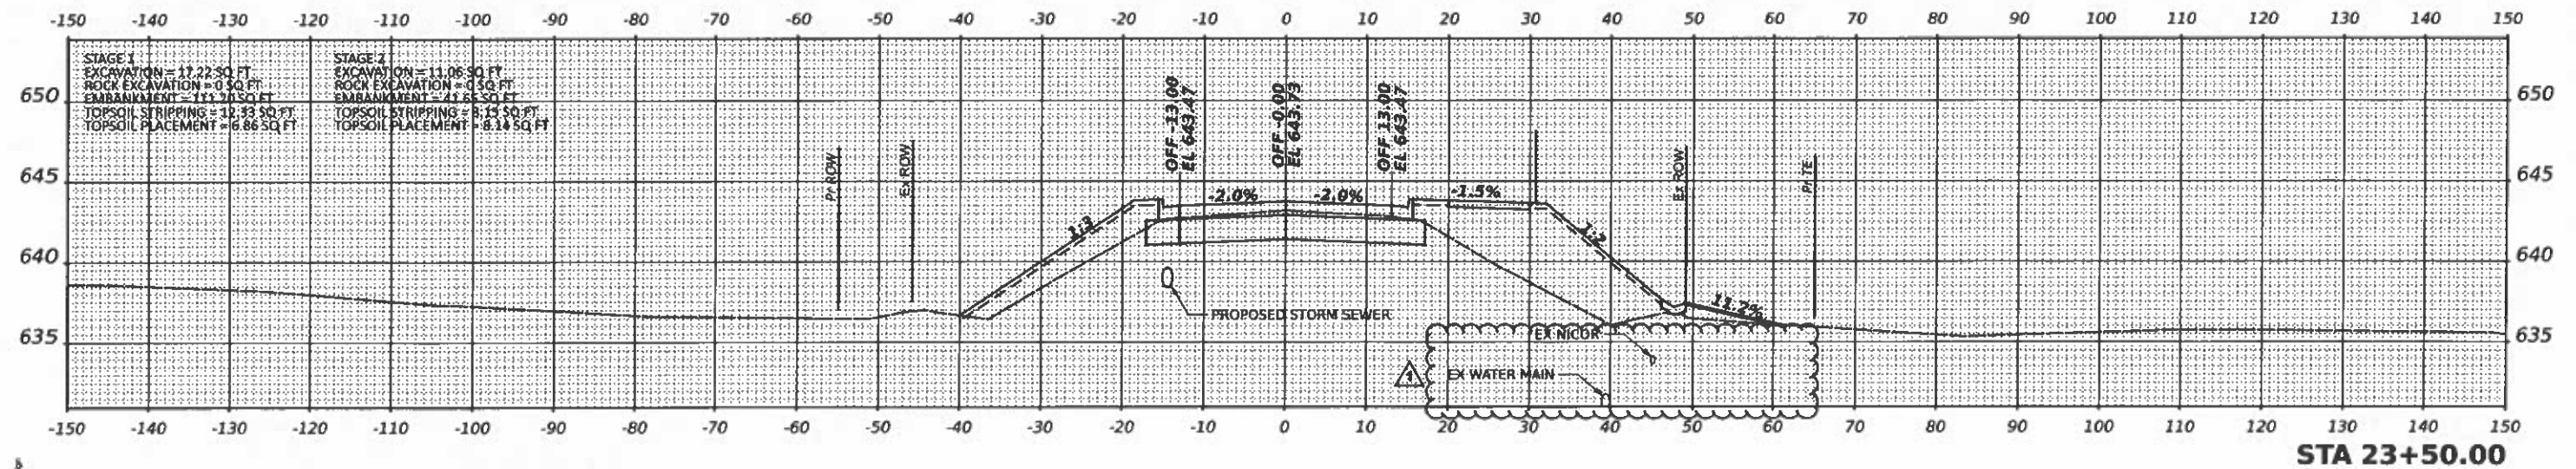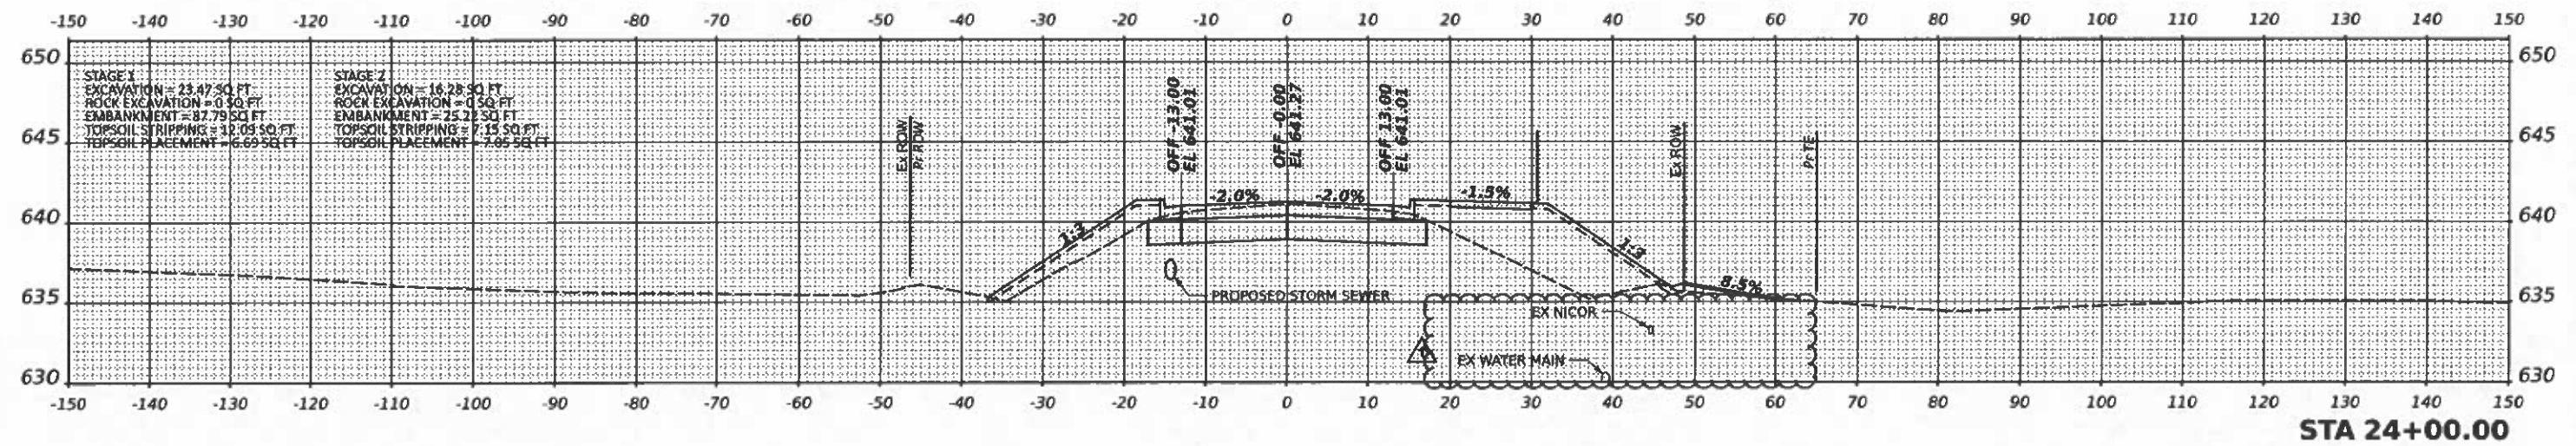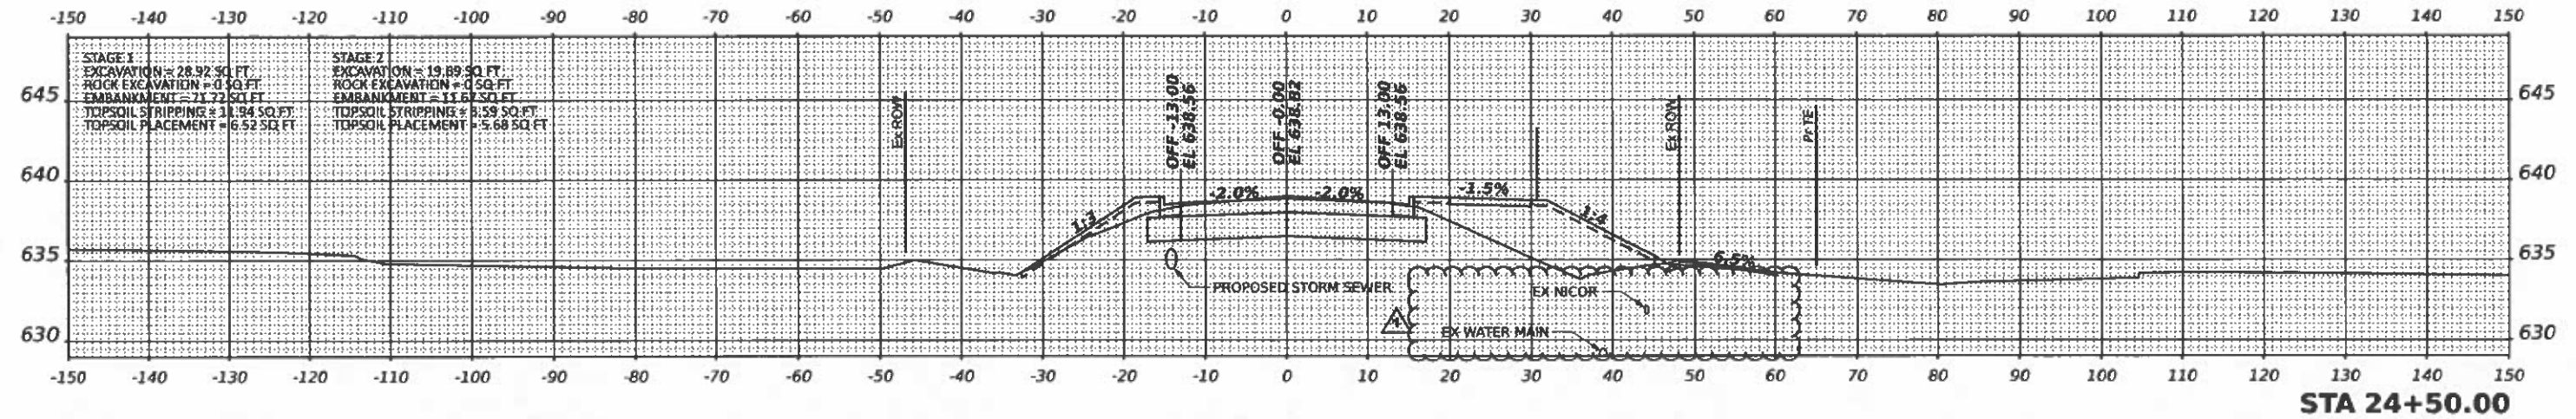

MODEL: 23+50.00
FILE NAME: 23+50.00.dwg

TranSmart
411 South Wells Street Suite 1000
Chicago, Illinois 60607

USER NAME = zshk
PLOT SCALE = 0.10000033 / in.
PLOT DATE = 7/9/2021

DESIGNED - NS
DRAWN - NS
CHECKED - TW
DATE - 2021/03/28

REVISED -
REVISED -
REVISED -
REVISED -




STATE OF ILLINOIS
DEPARTMENT OF TRANSPORTATION


WALDRON ROAD
CROSS SECTIONS

SCALE: SHEET 13 OF 15 SHEETS STA. 23+50 TO STA. 24+50



F.A.I. RTE.	SECTION	COUNTY	TOTAL SHEETS	SHEET NO.
57	138 HBR-6	KANKAKEE	202	197
CONTRACT NO. 66997				
ILLINOIS FED. AID PROJECT				

REV. 08/25/21

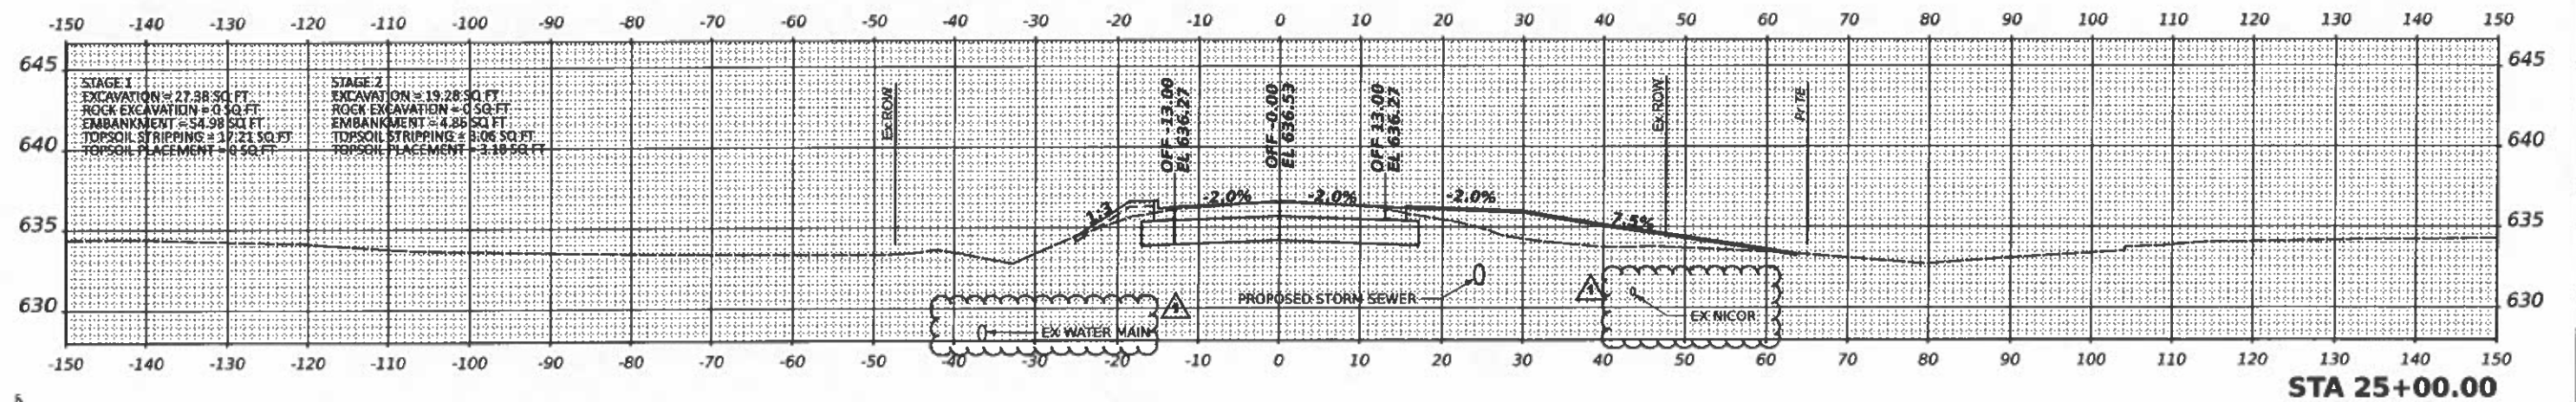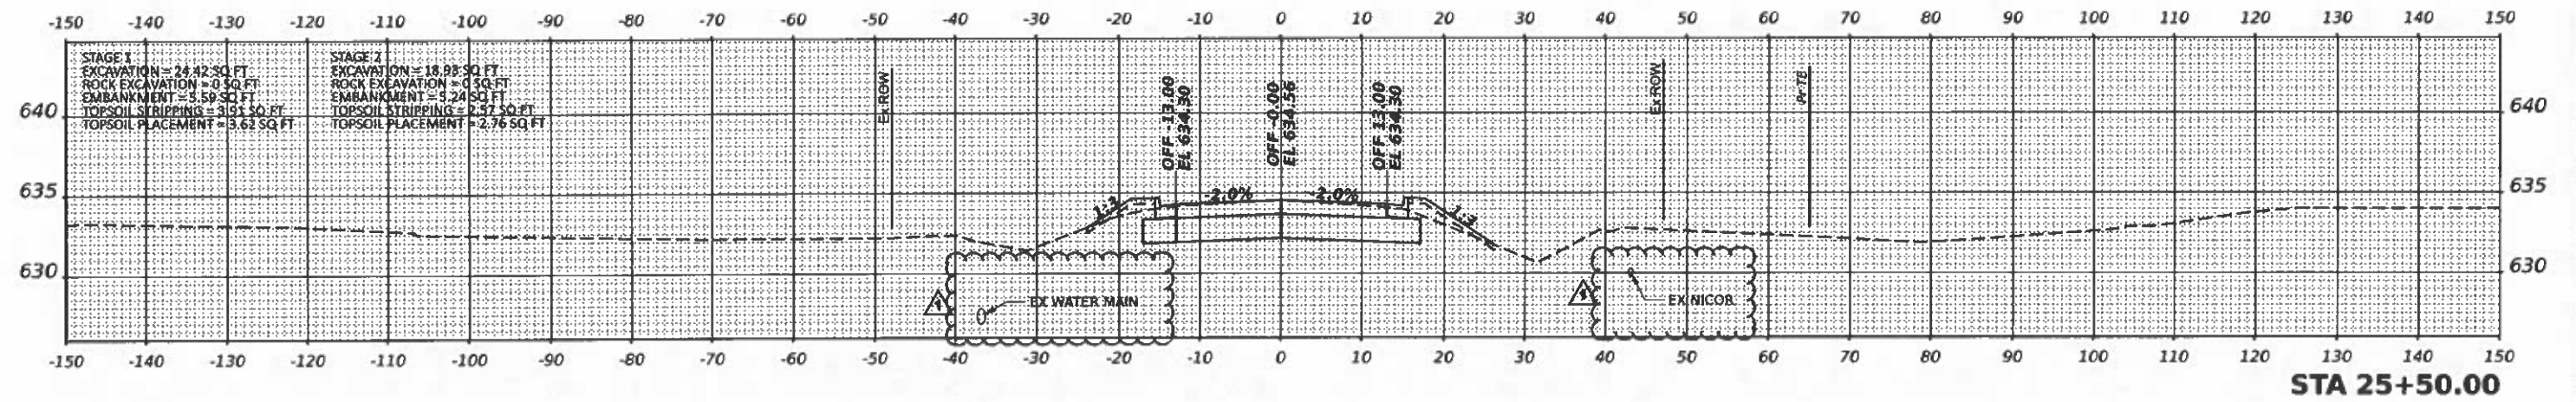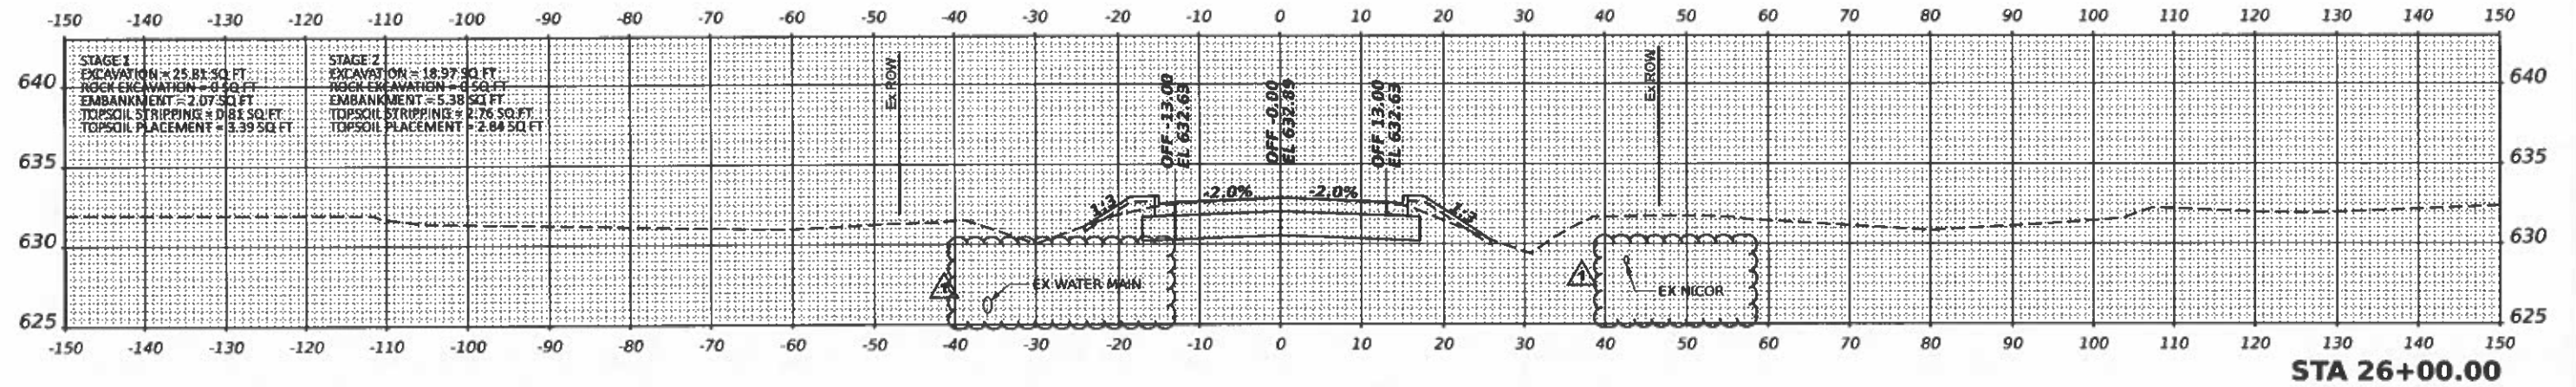

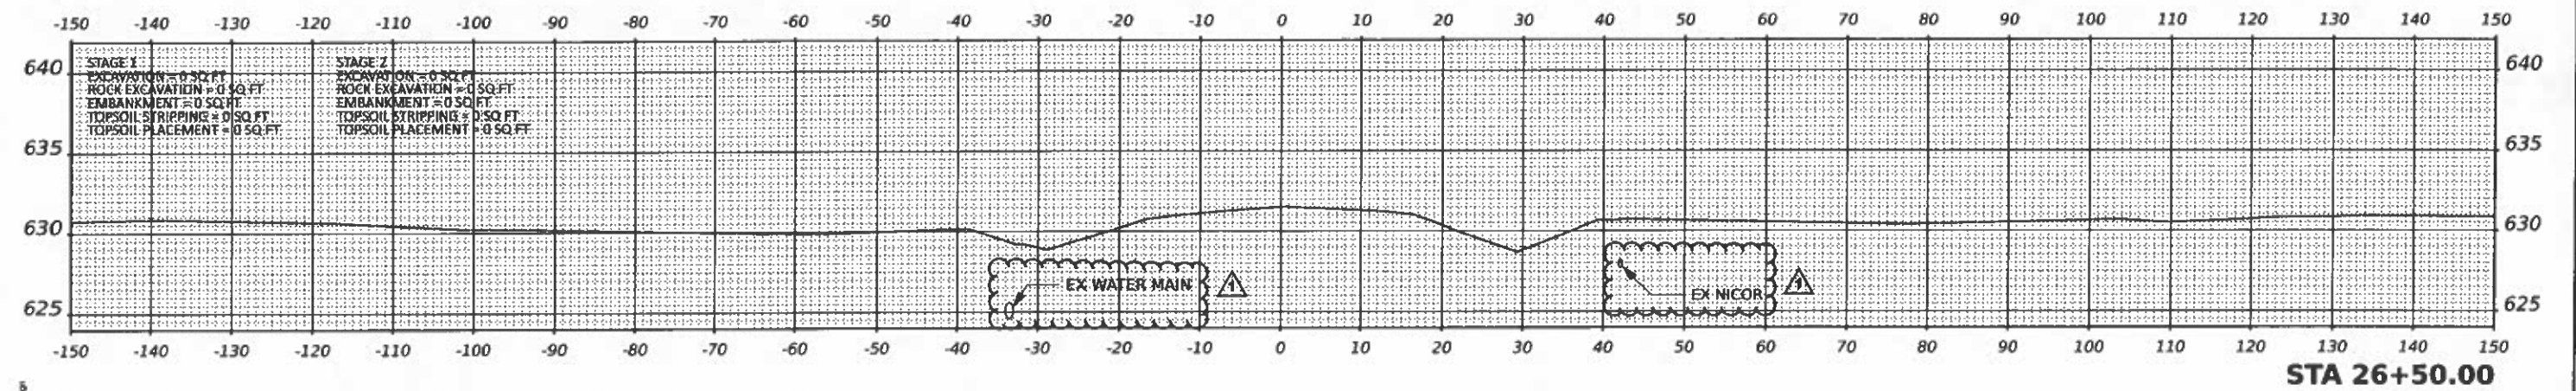

MODEL: 20-50-00 FILE NAME: 20-50-00.dgn TranSmart 411 South Wells Street Suite 1000 Chicago, Illinois 60607	USER NAME = ashac		DESIGNED - NS	REVISED -	STATE OF ILLINOIS DEPARTMENT OF TRANSPORTATION	WALDRON ROAD CROSS SECTIONS		F.A.I. RTE. 57	SECTION 139 HBR-6	COUNTY KANKAKEE	TOTAL SHEETS 202	SHEET NO. 198
	PLOT SCALE = 0.18888833' / in.		DRAWN - NS	REVISED -		SCALE:		SHEET 15 OF 15 SHEETS		STA. 26+50 TO STA. 26+50		
	PLOT DATE = 7/9/2021		CHECKED - TW	REVISED -						ILLINOIS FED. AID PROJECT		
	DATE = 2021/03/26		REVIS	REVISED -						CONTRACT NO. 68997		

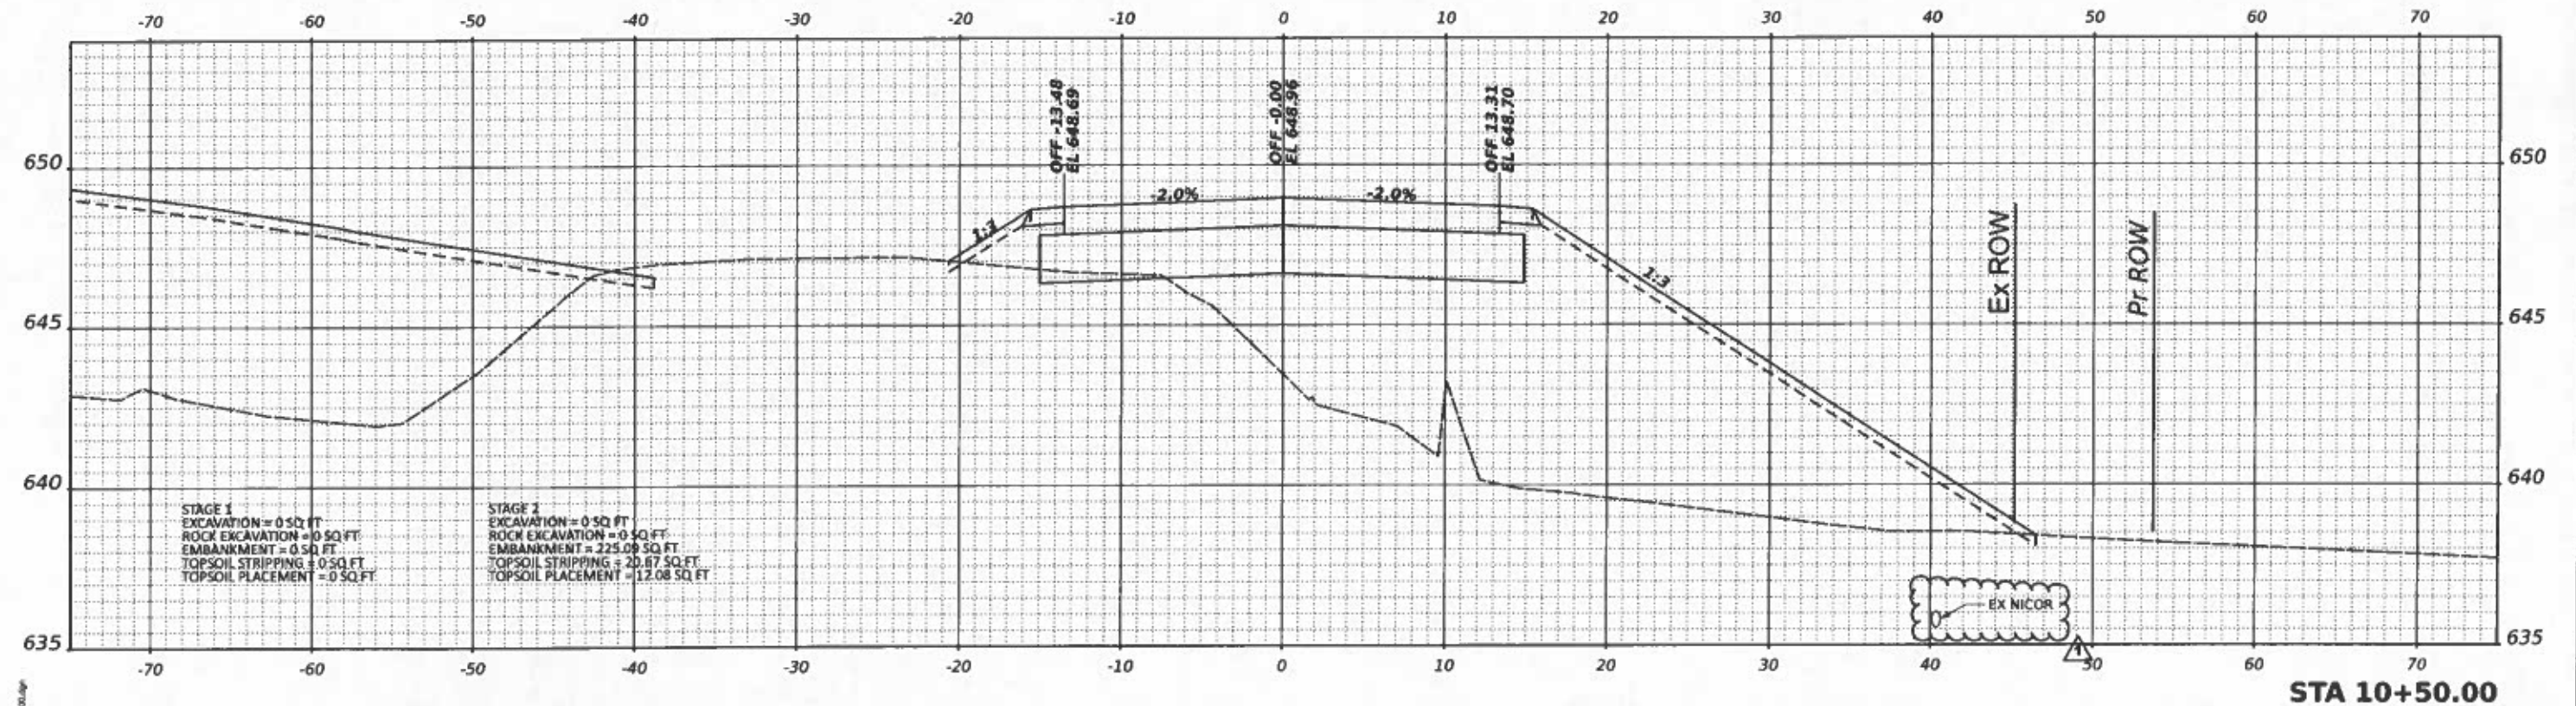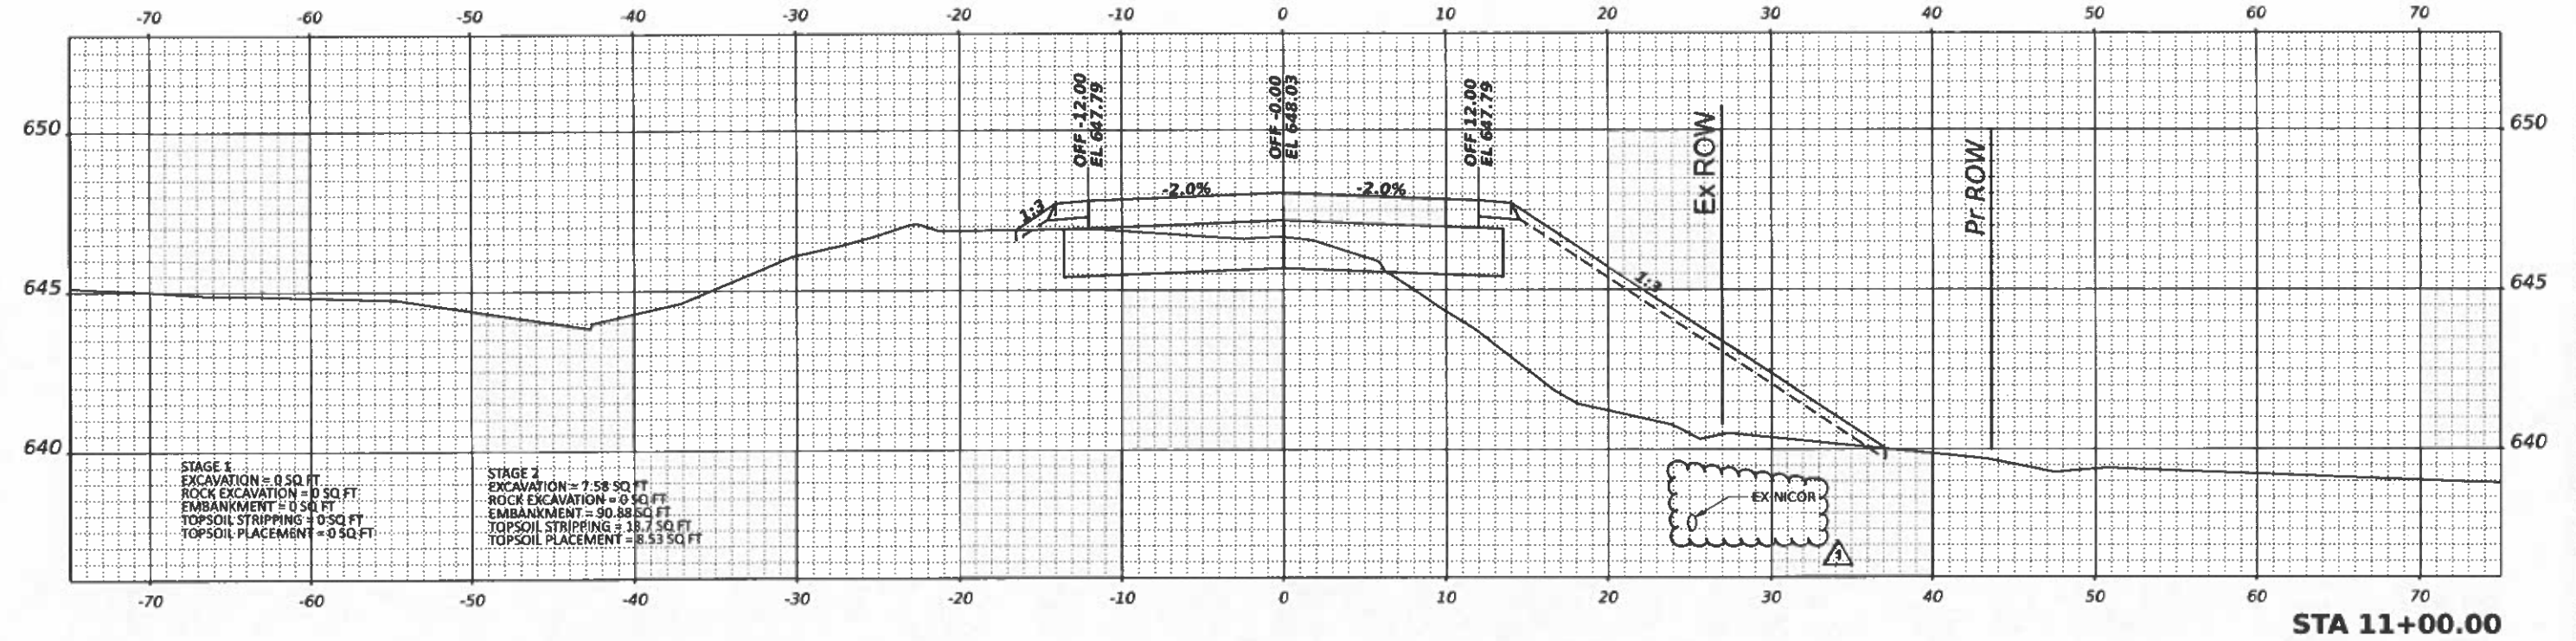

MODEL: 10-10-10
FILE NAME: 10-10-10.dwg

TransSmart
411 South Wells Street Suite 1000
Chicago, Illinois 60607

USER NAME = mshc	DESIGNED = NS	REVISED =
PLOT SCALE = 0.10000033 1/in.	DRAWN = NS	REVISED =
PLOT DATE = 7/8/2021	CHECKED = TW	REVISED =
	DATE = 2021/03/26	REVISED =

STATE OF ILLINOIS
DEPARTMENT OF TRANSPORTATION



MUN 2530
CROSS SECTIONS

SCALE: SHEET 1 OF 3 SHEETS STA. 10+50 TO STA. 11+00

F.A.I. RTE.	SECTION	COUNTY	TOTAL SHEETS	SHEET NO.
57	139 HBR-6	KANKAKEE	202	200
CONTRACT NO. 68997				

ILLINOIS FED. AID PROJECT

REV. 08/25/21

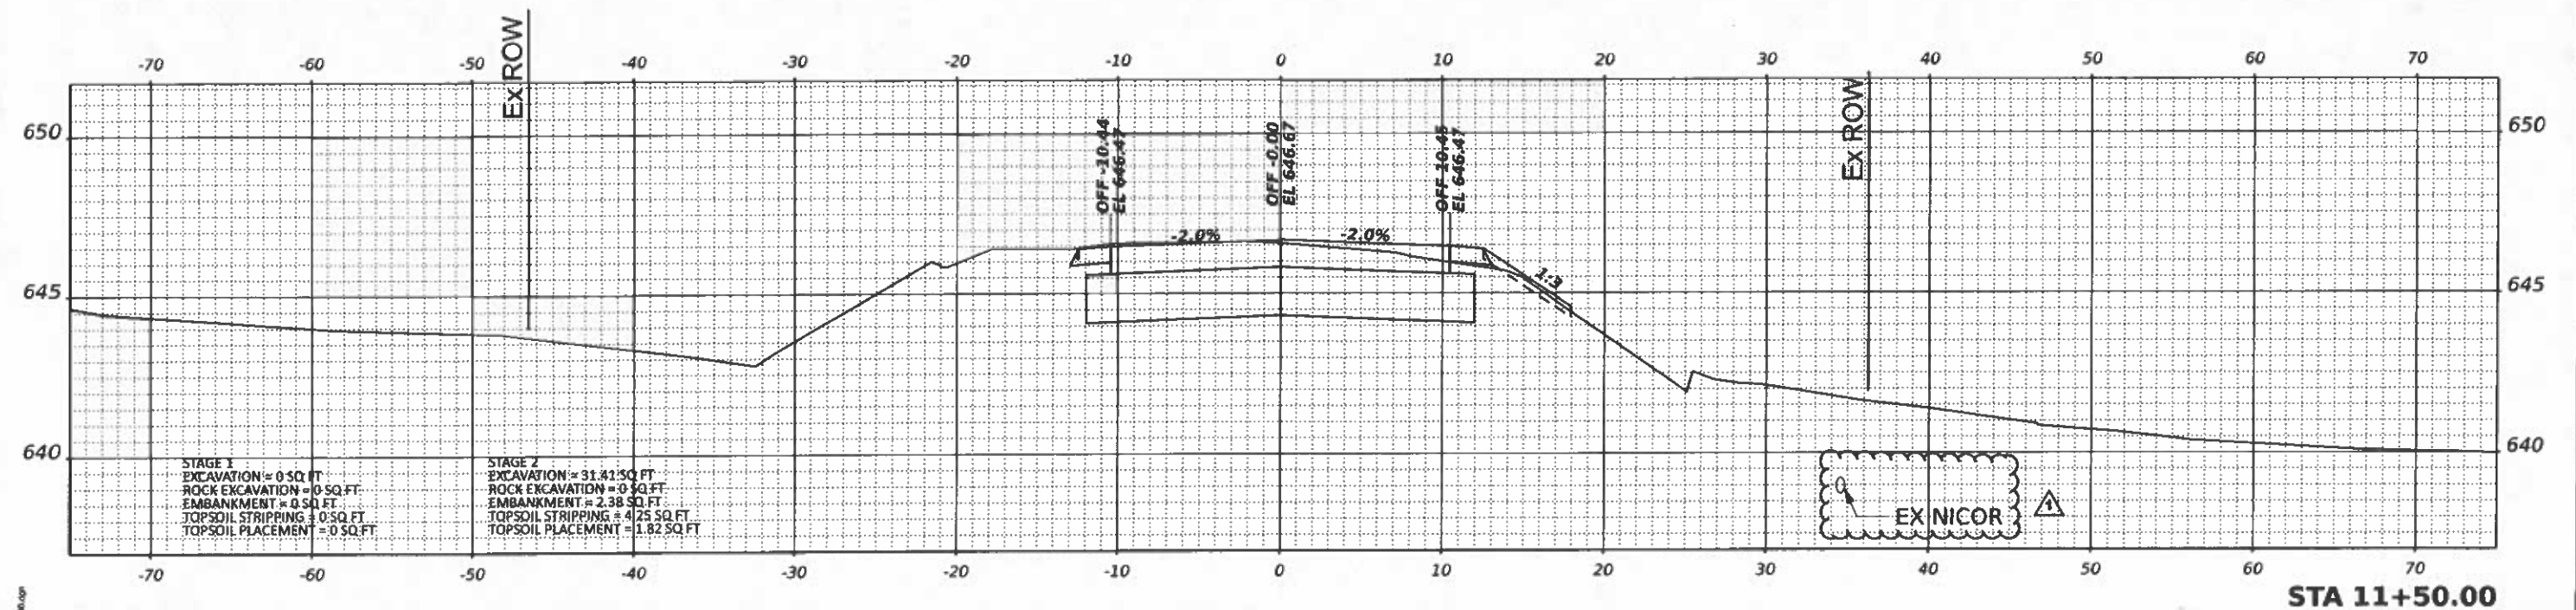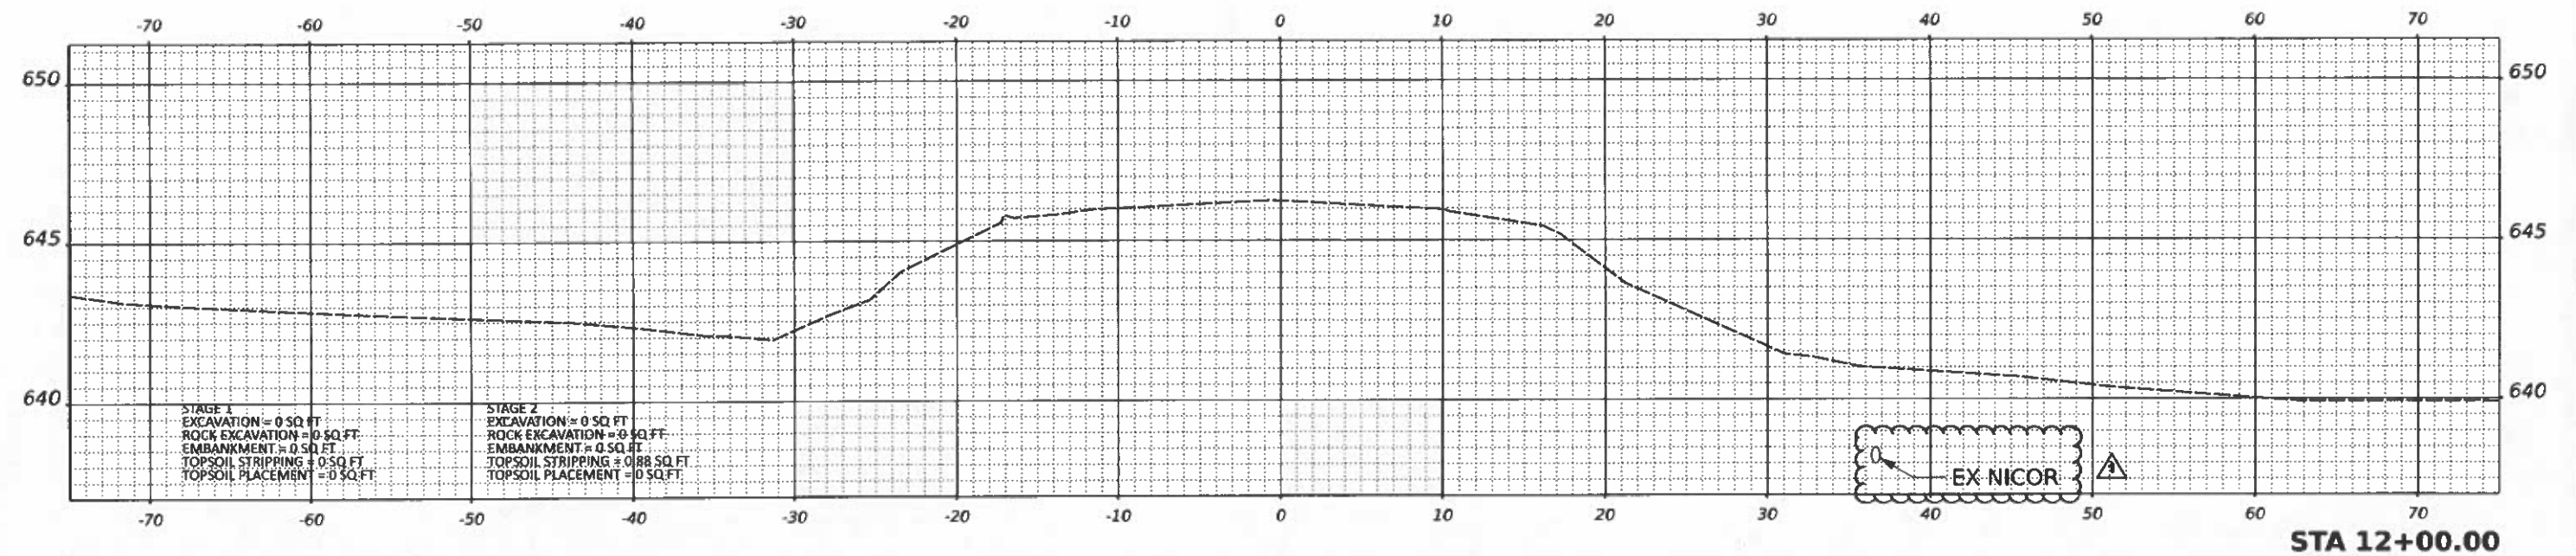

MODEL: 11-500
FILE NAME: 1150.00.dgn

TransSmart
411 South Wells Street Suite 1000
Chicago, Illinois 60607

USER NAME = bsnac	DESIGNED = NS	REVISED =
	DRAWN = NS	REVISED =
PLOT SCALE = 0.18889633' / in.	CHECKED = TW	REVISED =
PLOT DATE = 7/9/2021	DATE = 2021/03/28	REVISED =

**STATE OF ILLINOIS
DEPARTMENT OF TRANSPORTATION**


**MUN 2530
CROSS SECTIONS**

SCALE: SHEET 2 OF 3 SHEETS STA. 11+50 TO STA. 12+00

F.A.I. RTE.	SECTION	COUNTY	TOTAL SHEETS	SHEET NO.
57	138 HBR-6	KANKAKEE	202	201
CONTRACT NO. 66997				

ILLINOIS FED. AID PROJECT

REV. 08/25/21

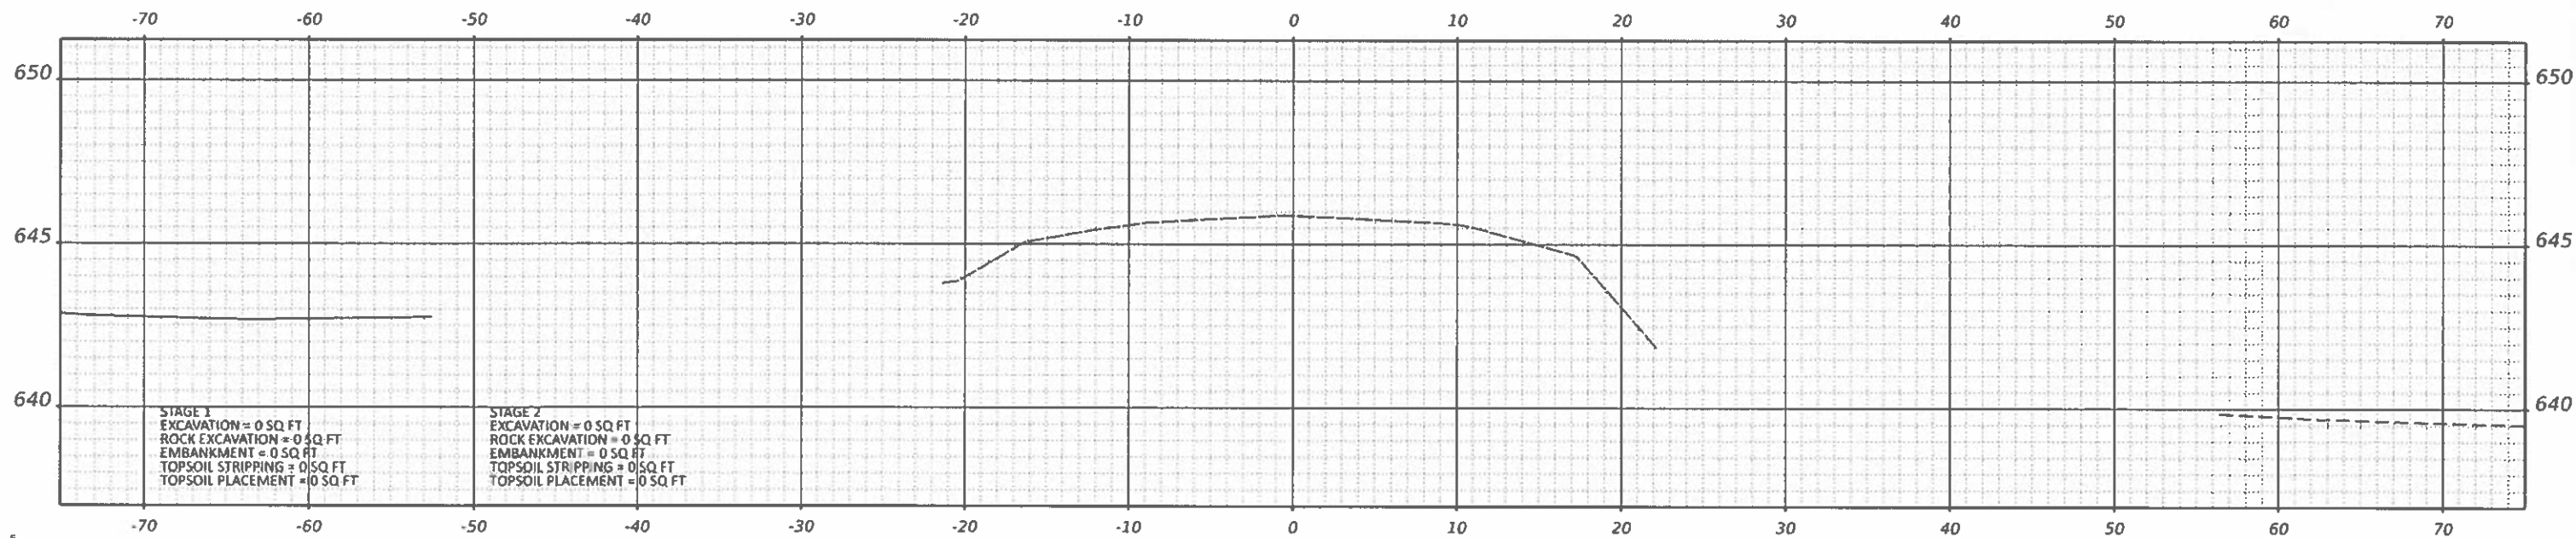

STA 12+50.00

MODEL: 12-50-00
FILE NAME: 12500000.dgn

TranSmart
411 South Wells Street Suite 1000
Chicago, Illinois 60607

USER NAME	msullivan	DESIGNED	NS	REVISED	-
		DRAWN	NS	REVISED	-
PLOT SCALE	0.100000000000000000	CHECKED	TW	REVISED	-
PLOT DATE	3/29/2021	DATE	-	REVISED	-

STATE OF ILLINOIS
DEPARTMENT OF TRANSPORTATION

MUN 2530
CROSS SECTIONS

SCALE: SHEET 3 OF 3 SHEETS STA. 12+50 TO STA. 12+50

F.A.I. RTE.	SECTION	COUNTY	TOTAL SHEETS	SHEET NO.
57	139 HBR-6	KANKAKEE	202	202
CONTRACT NO. 66997				
ILLINOIS FED. AID PROJECT				