
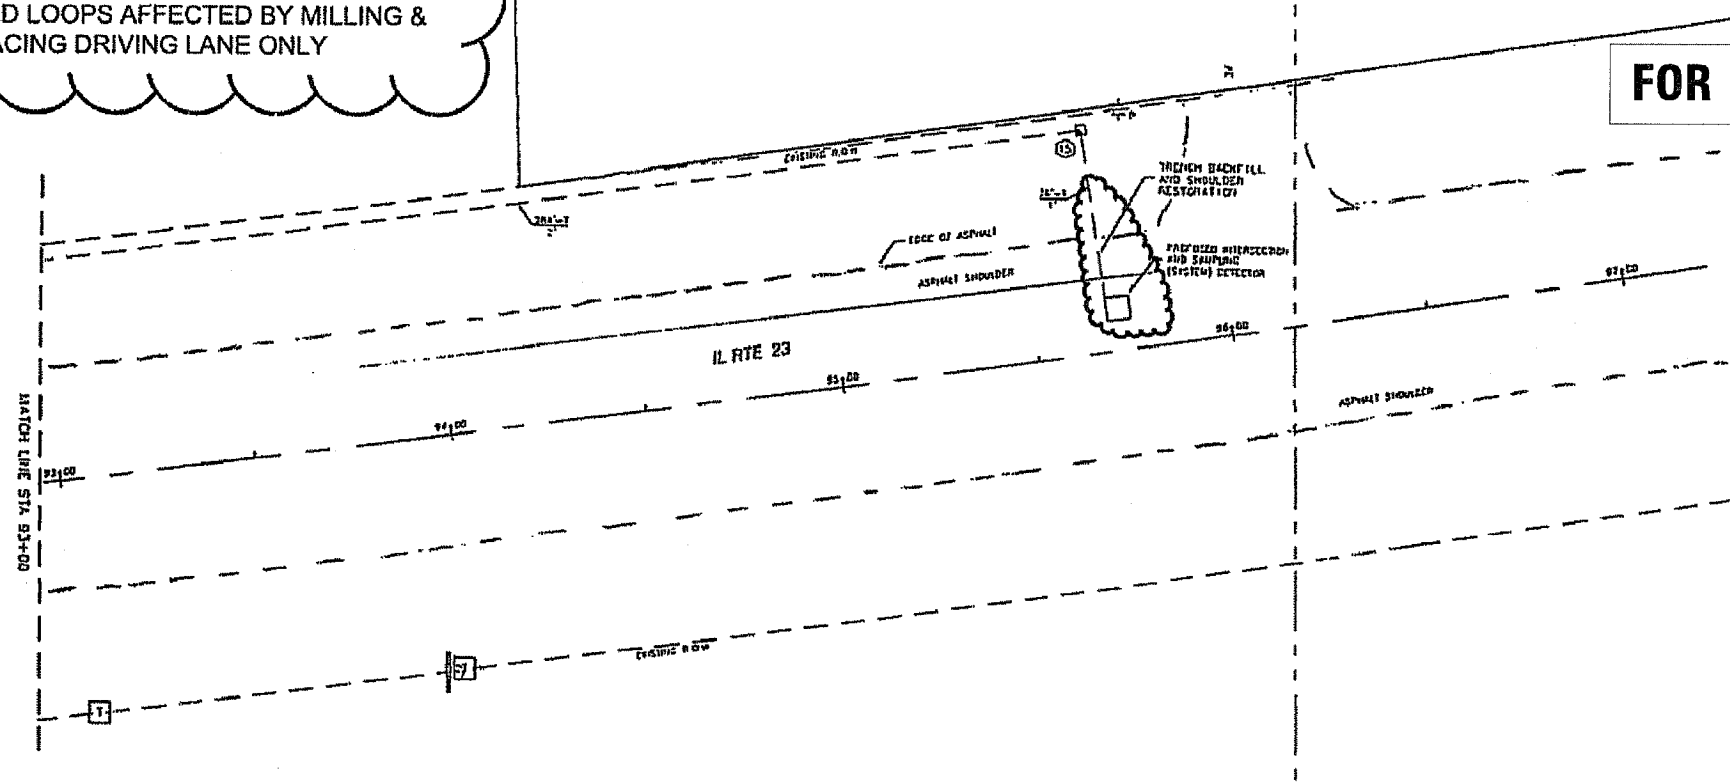


INDICATED LOOPS AFFECTED BY MILLING & RESURFACING DRIVING LANE ONLY


FOR INFORMATION ONLY

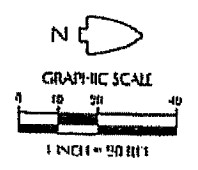

**TRAFFIC SIGNAL LEGEND**

EXISTING	PROPOSED	DESCRIPTION
[Symbol]	[Symbol]	CONTROLLER
[Symbol]	[Symbol]	SIGNAL POST
[Symbol]	[Symbol]	SIGNAL HEAD
[Symbol]	[Symbol]	SIGNAL HEAD WITH BACKPLATE
[Symbol]	[Symbol]	MAST ARM ASSEMBLY AND FOLE
[Symbol]	[Symbol]	LUMINAIRE
[Symbol]	[Symbol]	HANDHOLE
[Symbol]	[Symbol]	HEAVY DUTY HANDHOLE
[Symbol]	[Symbol]	DOUBLE HANDHOLE
[Symbol]	[Symbol]	HEAVY DUTY HANDHOLE
[Symbol]	[Symbol]	GALVANIZED STEEL CONDUIT
[Symbol]	[Symbol]	UNDERGROUND CABLE
[Symbol]	[Symbol]	DETECTOR LOOP
[Symbol]	[Symbol]	POWER POLE SERVICE
[Symbol]	[Symbol]	PRIORITY VEHICLE DETECTOR // CONTRA BEACON
[Symbol]	[Symbol]	CONFIRMATION BEACON
[Symbol]	[Symbol]	WOOD POLE
[Symbol]	[Symbol]	EQUIPMENT NUMBER

RESTORATION OF WORK AREA RESTORATION OF THE TRAFFIC SIGNAL MAST AREA SHALL BE IDENTICAL TO THE RELATED PAY ITEM SUCH AS FOUNDATION CONCRETE, HANDHOLE TRENCH AND BACKFILL, ETC. AND NO EXTRA COMPENSATION SHALL BE ALLOWED. ALL ROADWAY SURFACES SUCH AS SHOULDERS, MEDIANS, SIDEWALKS, PARKING, ETC. SHALL BE REPLACED IN KIND. ALL DAMAGE TO UNPAVED FIELDS SHALL BE REPLACED WITH AN APPROVED SOIL AND ALL DAMAGE TO UNPAVED FIELDS SHALL BE REPAIRED IN ACCORDANCE WITH STANDARD SPECIFICATIONS 252 AND 250 RESPECTIVELY.

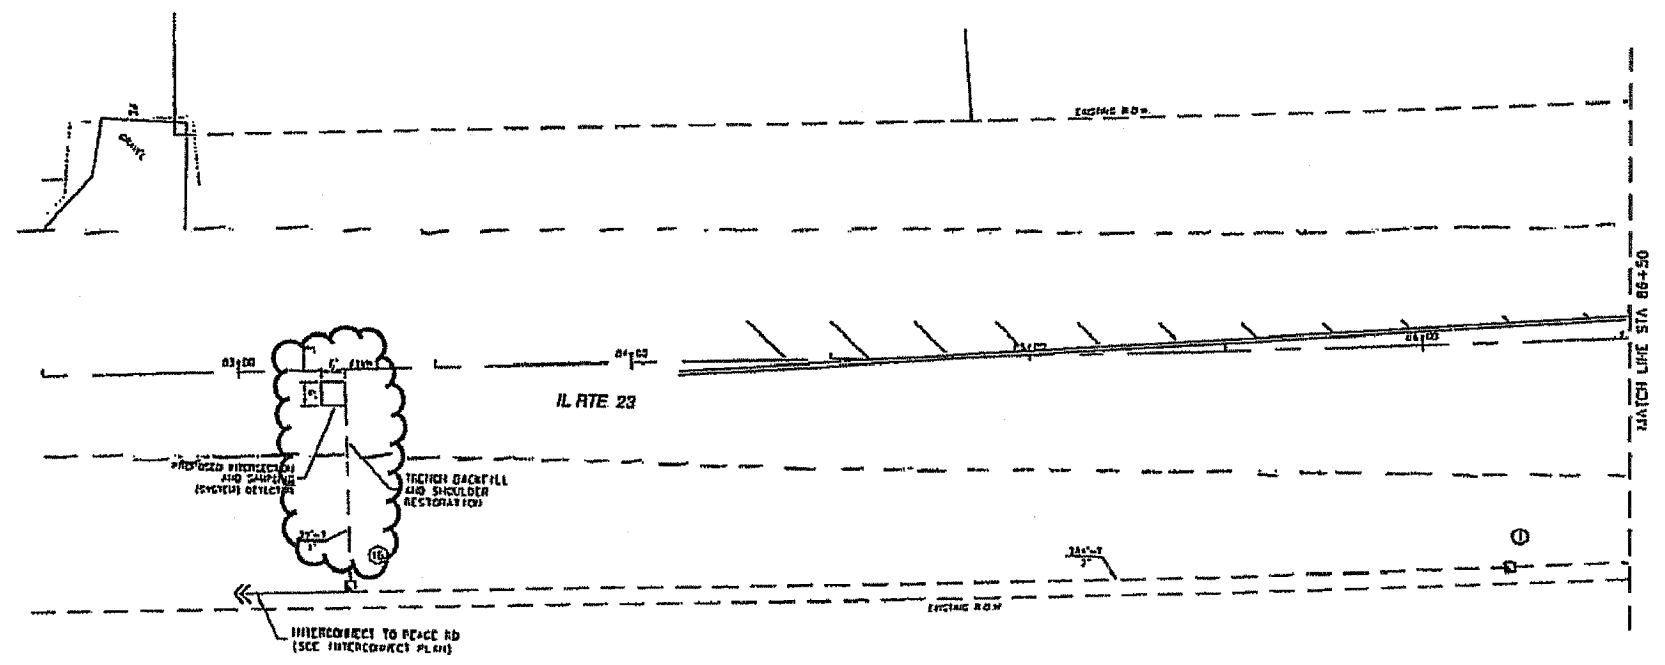

PREPARED FOR:  
**WENDLER ENGINEERING SERVICES, INC.**  
404 N. WINDY CREEK ROAD  
FARMINGTON, IL 62421

PREPARED BY:  
**WESTERN SURVEYING & ENGINEERING, P.C.**  
771 N. WINDY CREEK ROAD  
FARMINGTON, IL 62421  
TEL: 618-242-1111  
WWW.WSE-IL.COM

NO.	DATE	DESCRIPTION	BY	DATE	DESCRIPTION
1	07/20/07	REVISED PER SENIOR COUNTY AND CITY OF DEKALB REVIEW COMMENTS			
2	10/27/07	REVISED PER IDOT REVIEW COMMENTS			
3	11/27/07	REVISED PER IDOT REVIEW COMMENTS			
4	12/26/07	REVISED PER IDOT REVIEW COMMENTS			

**IL ROUTE 23 & NORTHGATE DRIVE IMPROVEMENTS - TRAFFIC SIGNAL LAYOUT**  
DEKALB COUNTY, ILLINOIS  
FILE NAME: 031244.DWG  
DESIGN BY: DWG  
DATE: 12/21/07  
SCALE: 1" = 50'