

60028

COOK & WILL

JAR

#1 139

F.A.I. RTE.	SECTION	COUNTY	TOTAL SHEETS	SHEET NO.
VAR	2007-0401	COOK / WILL	19	1
FED. ROAD DIST. NO.	ILLINOIS	CONTRACT NO. 60028		

STATE OF ILLINOIS

3-7-08 Letting, Item 139

DEPARTMENT OF TRANSPORTATION  
DIVISION OF HIGHWAYS

# PROPOSED HIGHWAY PLANS

VARIOUS ROUTES  
VARIOUS LOCATIONS  
SECTION: 2007-040 I  
PERMANENT PROTECTIVE SHIELDING  
COOK & WILL COUNTIES  
C-91-372-07

FOR INDEX OF SHEETS, SEE SHEET NO. 5


IMPROVEMENTS ARE LOCATED IN THE CITY OF CHICAGO, AND IN THE VILLAGES OF BURR RIDGE, MONEE, RICHTON PARK, SKOKIE, & TINLEY PARK

98%  
8-2-2008

016-0927

- LOC 1 SN 016-0823
- LOC 2 SN 016-2070, -2071
- LOC 3 SN 016-0587
- LOC 4 SN 016-0927
- LOC 5 SN 016-0575
- LOC 6 SN 099-0192
- LOC 7 SN 099-0159
- LOC 8 SN 099-0177

FOR LOCATION MAPS SEE SHEETS 2 - 4

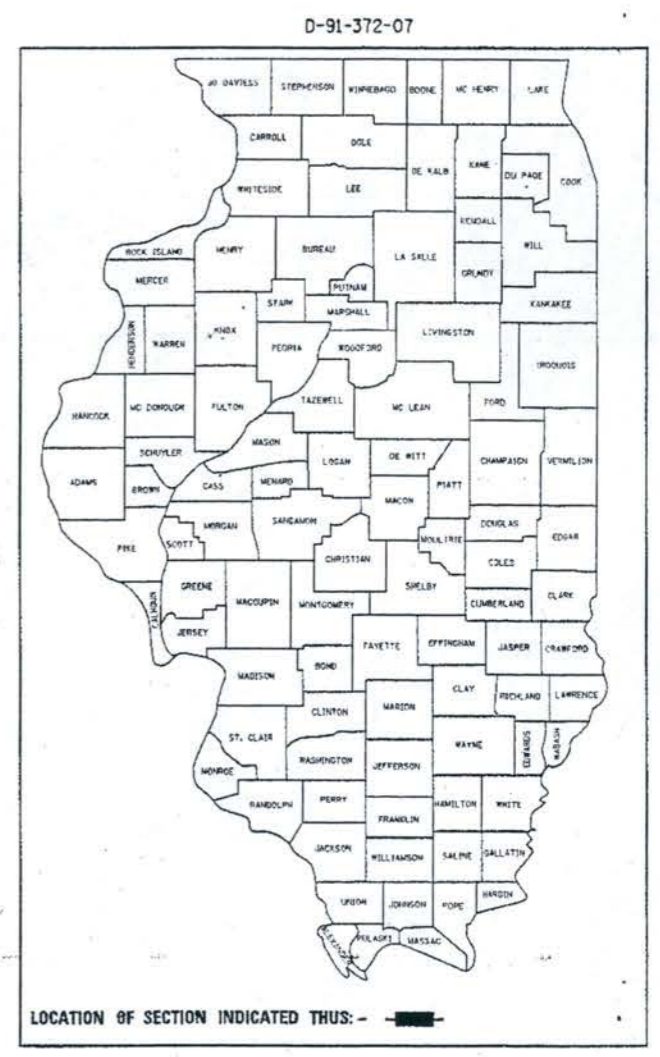

J.U.L.I.E.  
JOINT UTILITY LOCATION INFORMATION FOR EXCAVATION  
1-800-892-0123 OR 811  
C.U.A.N.  
CHICAGO UTILITY ALERT NETWORK  
1-312-744-7000

PROJECT ENGINEER ROBERT BORO (847) 705-4178  
PROJECT MANAGER KEN ENG  
CONTRACT NO. 60D28

016-0927

STATE OF ILLINOIS  
DEPARTMENT OF TRANSPORTATION  
DIVISION OF HIGHWAYS

SUBMITTED Dec 24 20 07  
[Signature]  
DEPUTY DIRECTOR OF HIGHWAYS, REGION ENGINEER

February 1, 20 08  
[Signature]  
ENGINEER OF DESIGN AND ENVIRONMENT

February 1, 20 08  
[Signature]  
DIRECTOR OF HIGHWAYS, CHIEF ENGINEER

PRINTED BY THE AUTHORITY  
OF THE STATE OF ILLINOIS

SUMMARY OF QUANTITIES			URBAN TOTAL QUANTITIES	CONSTRUCTION TYPE CODE SFTY - 2A																	
CODE NO	ITEM	UNIT		COOK COUNTY					WILL COUNTY												
				LOC 1 016- 0823	LOC 2 016- 2070, 2071	LOC 3 016- 0587	LOC 4 016- 0927	LOC 5 016- 0575	LOC 6 099- 0159	LOC 7 099- 0192	LOC 8 099- 0177										
67000400	ENGINEER'S FIELD OFFICE, TYPE A	CAL MO	3	0.40	0.83	0.73	0.16	0.50	0.13	0.13	0.12										
67100100	MOBILIZATION	L SUM	1	0.13	0.13	0.13	0.12	0.13	0.12	0.12	0.12										
50157300	PROTECTIVE SHIELD	SQ YD	5052	676	1404	1238	264	832	211	225	202										
X7011015	TRAFFIC CONTROL AND PROTECTION (EXPRESSWAYS)	L SUM	1	0.14	0.18	0.14	0.14	0.1	0.1	0.1	0.1										
Z0048665	RAILROAD PROTECTIVE LIABILITY INSURANCE	L SUM	1	0	1	0	0	0	0	0	0										

REVISIONS	
NAME	DATE


ILLINOIS DEPARTMENT OF TRANSPORTATION  
SUMMARY OF QUANTITIES




STATE OF ILLINOIS  
DEPARTMENT OF TRANSPORTATION

PROJECT NO.	SECTION	COUNTY	TOTAL SHEETS	SHEET NO.
VAR 2007-0401		COOK/WILL	19	16
DATE REVISION MADE	BY ENGINEER	DATE	PROJECT NO.	


Contract Number: 60D28

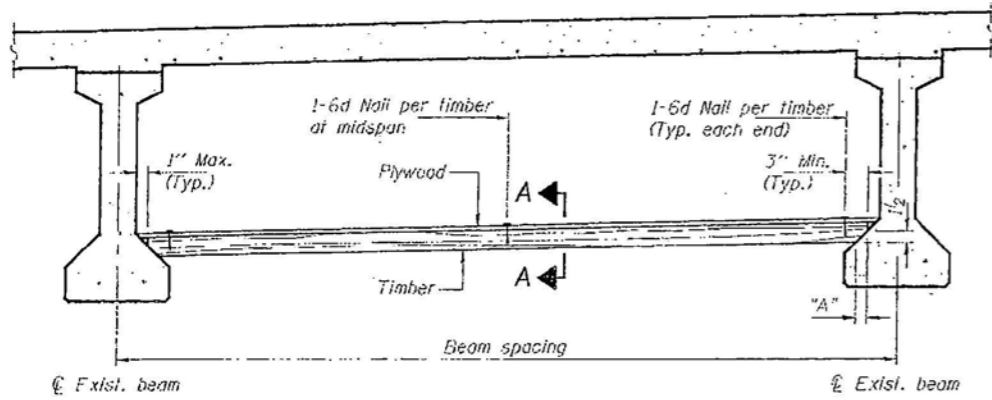

PPC I-BEAMS AND BULB-T'S

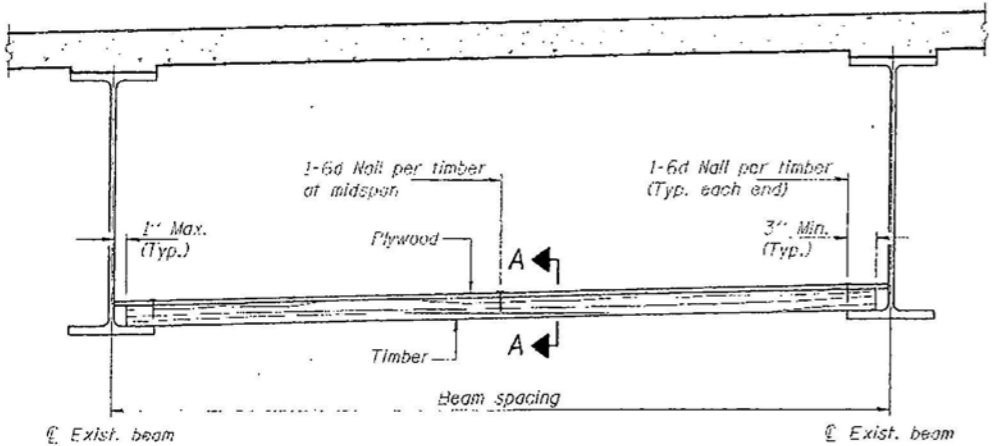

STEEL BEAMS

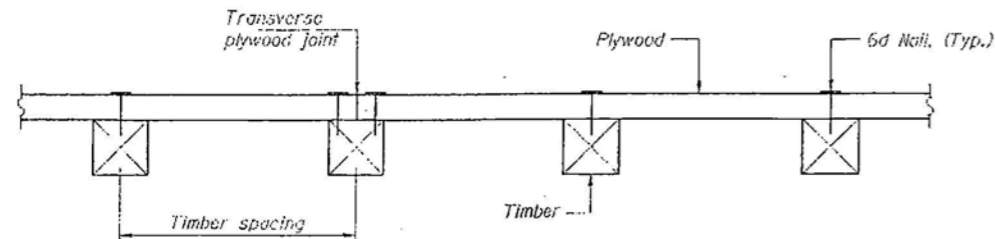

SECTION A-A

TIMBER SPACING

Beam Spacing (ft.)	Timber Sizes (in.)		
	4" x 4" with min. Fb=775 psi Fv=135 psi	4" x 6" with min. Fb=775 psi Fv=135 psi	6" x 6" with min. Fb=575 psi Fv=125 psi
	Maximum Timber Spacing (in.)		
4.5	16	16	16
4.75	16	16	16
5.0	16	16	16
5.25	16	16	16
5.5	16	16	16
5.75	16	16	16
6.0	16	16	16
6.25	12	16	16
6.5	12	16	16
6.75	12	16	16
7.0	8	16	16
7.25	8	16	16
7.5	8	16	16
7.75	8	16	16
8.0	8	12	16
8.25	8	12	16
8.5	6	12	12
8.75	6	12	12
9.0	6	8	12

PPC I-BEAMS AND BULB-T'S

BFAM	"A"
36" I-Beam	1 1/2"
42" I-Beam	1 1/2"
48" I-Beam	1 1/2"
54" I-Beam	1 5/8"
63" Bulb-T	3 3/8"
72" Bulb-T	3 3/8"

Notes: See special provision for Permanent Protective Shield System.  
Timber sizes shown are nominal sizes. Rough sawn timber of the dimensions shown will also be considered acceptable.  
The minimum Fb and Fv values shown are the tabulated design values given in the National Design Specification for Wood Construction for No. 2 Spruce-Pine-Fir without adjustment factors applied. Better grades or other species with equal or higher allowable stresses will also be considered acceptable.  
The timber spacings shown have been determined using allowable stresses with all adjustment factors necessary for the anticipated service conditions.  
All timber shall be treated.  
Plywood shall be 5/8" Exterior type plywood.  
Plywood shall be placed such that the face grain is perpendicular to the timber supports. When less than a full sheet (4' width) of plywood is used, the width of the strip used shall not be less than 2'.  
Transverse plywood joints shall be supported by timbers.  
When 4" x 6" timbers are used, they shall be placed such that the wide face is horizontal and the narrow face is vertical.  
Design load = 200 psf.

BILL OF MATERIAL




Item	Unit	Total
Protective Shield (Permanent)	Sq. Yd.	5052

PERMANENT PROTECTIVE SHIELD



SECTION	COUNTY	TOTAL SHEETS	SHEET NO.
80	COOK	359	75
STA. TO STA.		FED. ROAD DIST. NO. 7	
		ILLINOIS	
		FED. AID PROJECT	

11213-825HBK, 1315-821, 1516-822, 1216-823, 1819-824RS-1 & 1516-804HB, 1516-805HB, 1718-807R

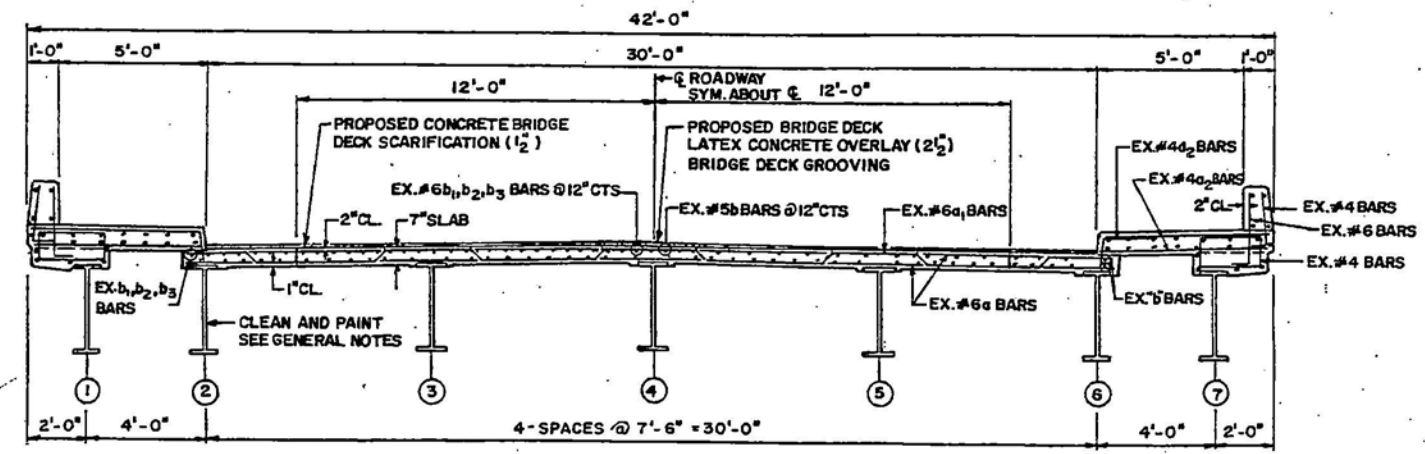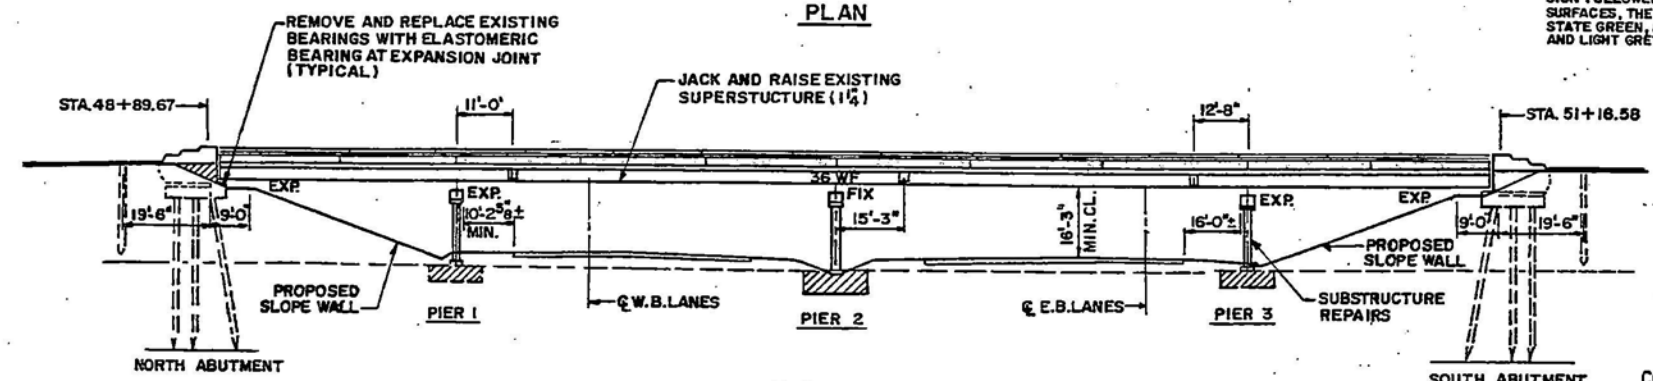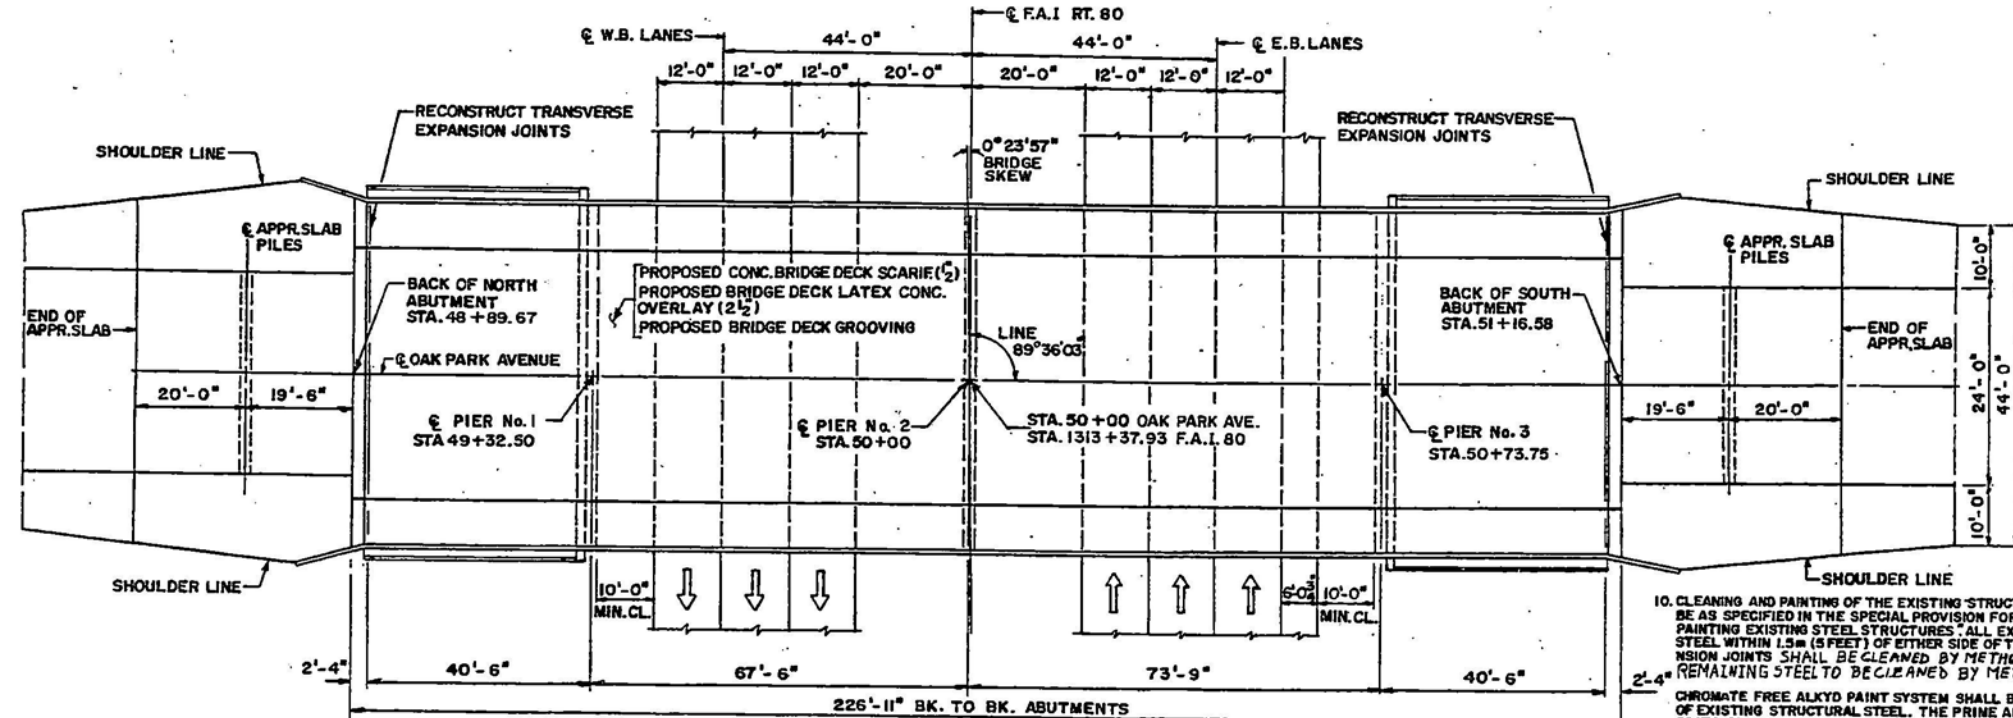

10. CLEANING AND PAINTING OF THE EXISTING STRUCTURAL STEEL SHALL BE AS SPECIFIED IN THE SPECIAL PROVISION FOR "CLEANING AND PAINTING EXISTING STEEL STRUCTURES". ALL EXISTING STRUCTURAL STEEL WITHIN 1.5m (5 FEET) OF EITHER SIDE OF TRANSVERSE EXPANSION JOINTS SHALL BE CLEANED BY METHOD 1. ALL OF THE REMAINING STEEL TO BE CLEANED BY METHOD 2. THE LEAD AND CHROMATE FREE ALKYLID PAINT SYSTEM SHALL BE USED FOR PAINTING OF EXISTING STRUCTURAL STEEL. THE PRIME AND INTERMEDIATE COATS SHALL BE APPLIED AS SPECIFIED IN THE SPECIAL PROVISION FOLLOWED BY ONE COMPLETE FINAL COAT OVER ALL STEEL SURFACES. THE COLOR OF THE FINAL FINISH COAT SHALL BE INTERSTATE GREEN, MUNSELL No. 7.5B 4/8 ON THE EXTERIOR GIRDERS AND LIGHT GREY, MUNSELL No. 10Y 7/1 ON INTERIOR GIRDERS.

- GENERAL NOTES:**
- PLAN DIMENSIONS AND DETAILS RELATIVE TO THE EXISTING STRUCTURE HAVE BEEN TAKEN FROM EXISTING PLANS AND ARE SUBJECT TO NOMINAL CONSTRUCTION VARIATIONS. IT SHALL BE THE CONTRACTOR'S RESPONSIBILITY TO VERIFY SUCH DIMENSION AND DETAILS IN THE FIELD AND MAKE NECESSARY APPROVED ADJUSTMENTS PRIOR TO CONSTRUCTION OR ORDERING OF MATERIALS. SUCH VARIATION SHALL NOT BE CAUSE FOR ADDITIONAL COMPENSATION FOR A CHANGE IN THE SCOPE OF WORK, HOWEVER, THE CONTRACTOR WILL BE PAID FOR THE ACTUAL QUANTITY FURNISHED AT THE UNIT BID PRICE FOR THE WORK.
  - THE CONTRACTOR MUST USE EXTREME CARE DURING CONCRETE REMOVALS AS NOT TO NICK, CUT, OR DAMAGE ANY OF THE STRUCTURAL STEEL AND NOT TO DAMAGE OR CUT ANY EXISTING REINFORCEMENT BARS THAT ARE TO BE INCORPORATED INTO THE NEW CONSTRUCTION. ANY DAMAGE SHALL BE REPAIRED AT CONTRACTORS EXPENSE.
  - ANY REINFORCEMENT BARS THAT ARE DAMAGED DURING CONSTRUCTION SHALL BE REPAIRED WITH AN APPROVED BAR SPLICER OR ANCHORAGE SYSTEM. COST INCIDENTAL TO "CONCRETE REMOVAL".
  - REINFORCEMENT BARS SHALL CONFORM TO THE REQUIREMENTS OF AASHTO M-31, M-42, OR M-53 GRADE 60.
  - ALL NEW STRUCTURAL STEEL SHALL CONFORM TO AASHTO M-270, GR.36 UNLESS OTHERWISE SPECIFIED.
  - ALL NEW FASTENERS SHALL BE HIGH STRENGTH BOLTS. HOLES SHALL BE SUBPUNCHED OR SUBDRILLED 1/8" DIA. AND REAMED IN THE FIELD TO 1/4" DIA. FOR 1/2" DIA. HIGH STRENGTH BOLTS (EXCEPT AS NOTED ON THE PLANS) AFTER NEW STRUCTURAL STEEL SECTIONS ARE PROPERLY FITTED INTO POSITION.
  - PRIOR TO POURING THE NEW CONCRETE FOR THE DECK, ALL LOOSE RUST, LOOSE MILL SCALE, AND ALL OTHER FOREIGN MATERIAL SHALL BE REMOVED FROM THE EMBEDDED PORTIONS OF FLANGES OF BEAMS. THE SURFACE SHALL BE ACCOMPLISHED IN ACCORDANCE WITH THE REQUIREMENTS OF THE SSPC SURFACE PREPARATION SPECIFICATIONS SP3 FOR POWER TOOL CLEANING OR SP2 FOR HAND TOOL CLEANING. COST SHALL BE INCIDENTAL TO CONCRETE REMOVAL.
  - THE INORGANIC ZINC RICH PRIMER/ACRYLIC/ACRYLIC PAINT SYSTEM SHALL BE USED FOR SHOP AND FIELD PAINTING OF NEW STRUCTURAL STEEL EXCEPT WHERE OTHERWISE NOTED. THE COLOR OF THE ACRYLIC FINISH COAT SHALL BE "LIGHT GREY", MUNSELL No. 10Y 7/1. SEE SPECIAL PROVISIONS.
  - THE PAINT ON THE EXISTING STRUCTURAL STEEL CONTAINS LEAD. PRECAUTIONS SHALL BE TAKEN TO PROTECT WORKERS AND THE ENVIRONMENT AS REQUIRED BY LOCAL, STATE AND FEDERAL REGULATIONS.

**CONSTRUCTION SEQUENCE**

- TRAFFIC STAGING.
- BEAM REPLACEMENT.
- DECK SLAB REPAIRS.
- CONCRETE BRIDGE DECK SCARIFICATION.
- SUBSTRUCTURE REPAIRS / SLOPE WALL REPAIRS.
- JACK EXISTING SUPERSTRUCTURE 1 1/4" AND REPLACE BEARINGS AT ABUTMENT AND REPLACE TOP PLATE AT THE PIERS.
- RECONSTRUCT TRANSVERSE JOINTS.
- BRIDGE DECK LATEX CONCRETE OVERLAY (2 1/2").
- DECK DRAIN EXTENSION.
- BRIDGE CLEANING AND PAINTING.

**APPROVED**  
FOR STRUCTURAL ADEQUACY ONLY  
*Ralph E. Anderson*  
ENGINEER OF BRIDGES AND STRUCTURES

**TOTAL BILL OF MATERIALS - BRIDGE**

Item	Unit	Quantity
Concrete Superstructure	Cu. Yd.	15.6
Reinforcement Bars (Epoxy Coated)	Pound	4020
Deck Slab Repair (Partial)	Sq. Yd.	70
Deck Slab Repair (Full Depth - Type I)	Sq. Yd.	20
Deck Slab Repair (Full Depth - Type II)	Sq. Yd.	1.0
Preformed Joint Seal 4"	Foot	90
Concrete Structures	Cu. Yd.	7.3
Bar Splicers	Each	32
Concrete Bridge Deck Scarification (1/2")	Sq. Yd.	760
Bridge Deck Latex Concrete Overlay (2 1/2")	Sq. Yd.	760
Protective Shield	Sq. Yd.	660
Concrete Removal	Cu. Yd.	20.2
Formed Concrete Repair (1.5")	Sq. Ft.	45
Formed Concrete Repair (2.5")	Sq. Ft.	15
Epoxy Crack Sealing	Foot	5
Furnishing And Erecting Of Structural Steel	Pound	15180
Jack Existing Superstructure	L.S.	1
Elastomeric Bearing Assembly Type II	Each	14
SLOPE WALL REMOVAL	SQ.YD.	425
SLOPE WALL 4"	SQ.YD.	474
Cleaning and Painting Steel Bridge Structure I	L. Sum	1
Blasting Residue Containment Disposal	L. Sum	1
Power Tool Cleaning Residue Containment and Disp.	L. Sum	1
Floor Drain Extensions	Each	16
Temporary Slab Support System	L. Sum	1
Bridge Deck Grooving	Sq.Yd.	760

**REVISIONS**



NAME	DATE

ILLINOIS DEPARTMENT OF TRANSPORTATION  
**OAK PARK AVENUE  
OVER INTERSTATE ROUTE 80  
PLAN, ELEVATION AND CROSS SECTION  
S.N. 016-0927**

SCALE: VERT. HORIZ.  
DATE: DRAWN BY M.VT.  
CHECKED BY J.A.F.

STATE OF ILLINOIS  
DEPARTMENT OF TRANSPORTATION

ROUTE NO.	SECTION	COUNTY	POST MILES	POST	SHEET NO. SJ-A
FAI 80	8	COOK	35.9	75A	S17 SHEETS
FED. ROAD DIST. NO. 7		ILLINOIS	FED. AID PROGRAM		
SEC. 11213-82548X, 1315-8211516-822, 1216-8231819-82485-1A11516-8848, 1516-829481718-8878					

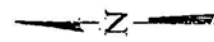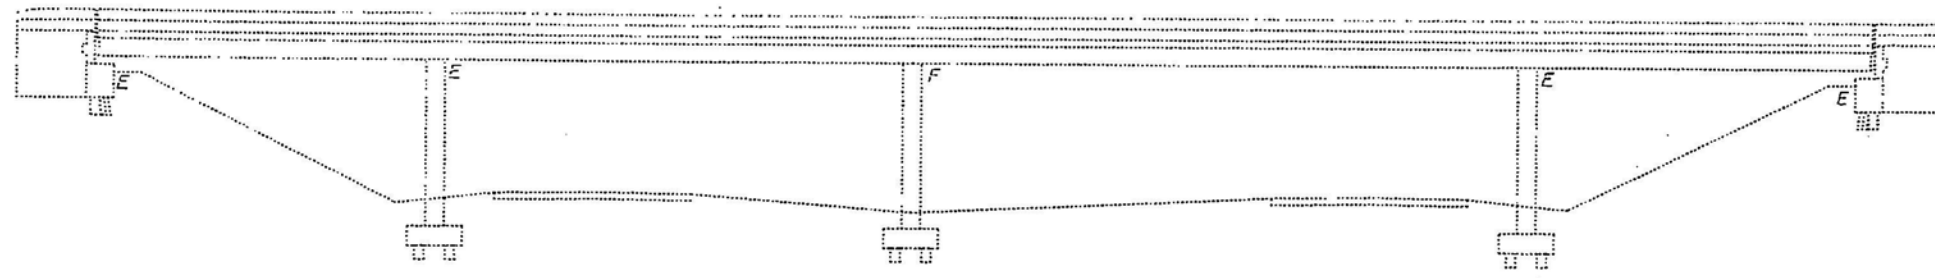

ELEVATION


NOTES

The Contractor shall provide support and/or shoring systems for the beam in the area of existing splice removal and at other locations as required in order to maintain the "as-built" deck profile. See Special Provisions for "Temporary Slab Support System".

Grind existing nicks, gouges and shallow cracks in the damaged beams as shown by the detail on sheet 2. Ground surfaces shall be inspected for cracks using magnetic particle testing prior to initiating any beam straightening operations. Any cracks that cannot be removed by grinding approximately 1/4" deep shall be identified and reported to the Bureau of Bridges and Structures for further disposition.

Removal of all damaged members necessary to complete the work as detailed on the plans and as specified in the Special Provisions shall be considered incidental to Furnishing and Erecting Structural Steel.

After the new beam is in its final position and/or beam straightening operations have been completed, the Engineer in the field shall check to see that the top flange is tight against the slab. If not, the Contractor shall inject epoxy between the existing concrete deck and the top flange of the beam. See Special Provision "Epoxy Injection".

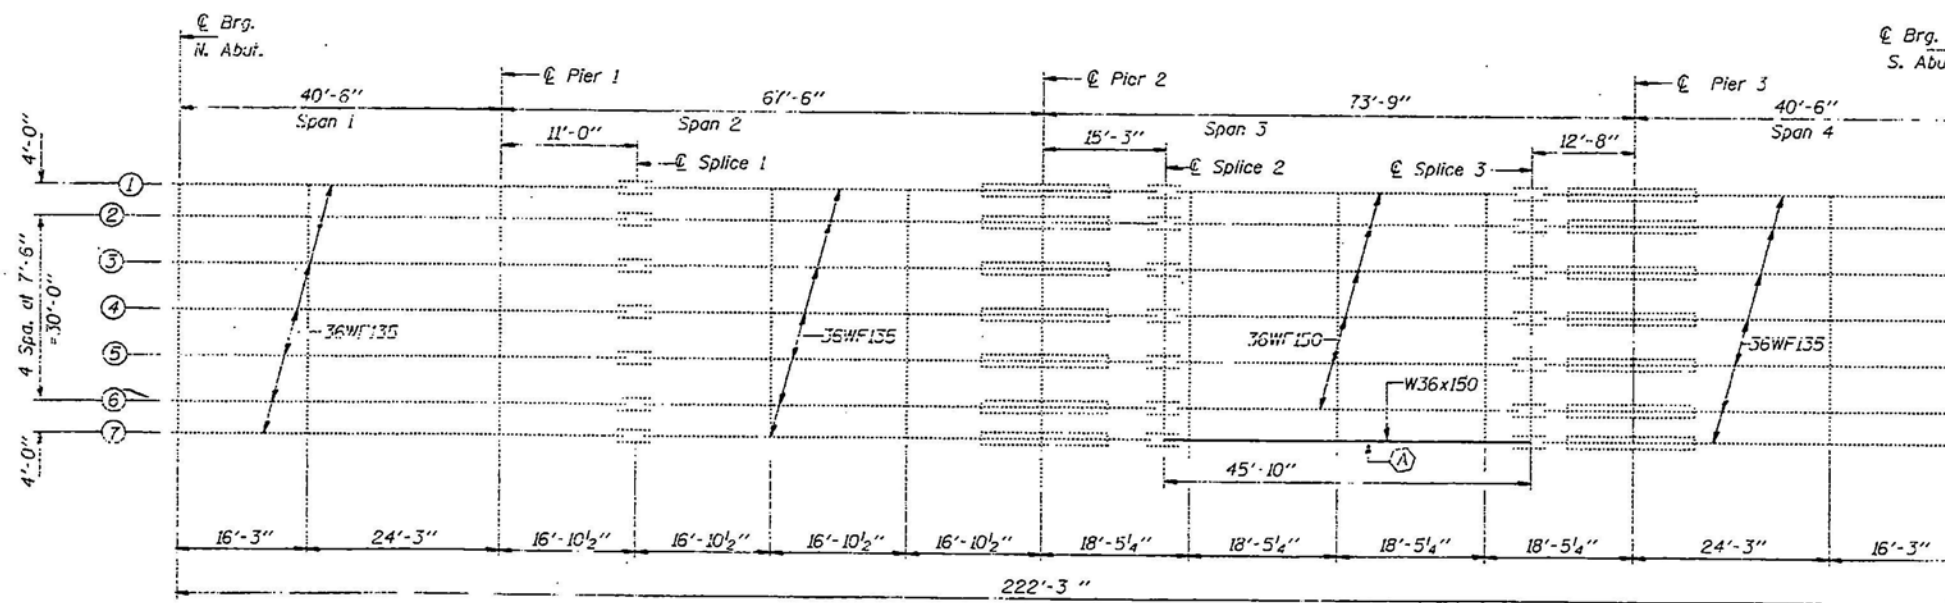

PLAN

(A) Existing Beam to be replaced.

BILL OF MATERIAL

ITEM	UNIT	QUANTITY
Furnishing and Erecting Structural Steel	Pound	7080
Temporary Slab Support System	L.S.	1
Concrete Removal	Cu. Yd.	2.9
Concrete Superstructure	Cu. Yd.	2.9

DESIGNED	<i>Alan T. Bell</i>
CHECKED	<i>Vernor H. Veltz</i>
DRAWN	<i>J. March</i>
CHECKED	<i>GTB VHV</i>

October 11, 1996
EXAMINED <i>Scott E. Adams</i>
PASSED
ENGINEER OF STRUCTURAL SERVICES
ENGINEER OF BRIDGES AND STRUCTURES


BEAM REPLACEMENT  
F.A.I. RT. 80 SEC. 1313-811 HB  
COOK COUNTY  
STA. 1313+37.93  
STR. No. 016-0927



STATE OF ILLINOIS  
DEPARTMENT OF TRANSPORTATION

ROUTE NO.	SECTION	COUNTY	POST MILES	POST	SHEET NO. SI-C
FAI 80	8	COOK	309	75C	SI7 SHEETS
BALANCE		FIELD NO. PROJECT			

SEC. 0213-020-01315-0211916-022.  
1215-02211914-02485-14121515-00446.  
1515-00504.1718-007R



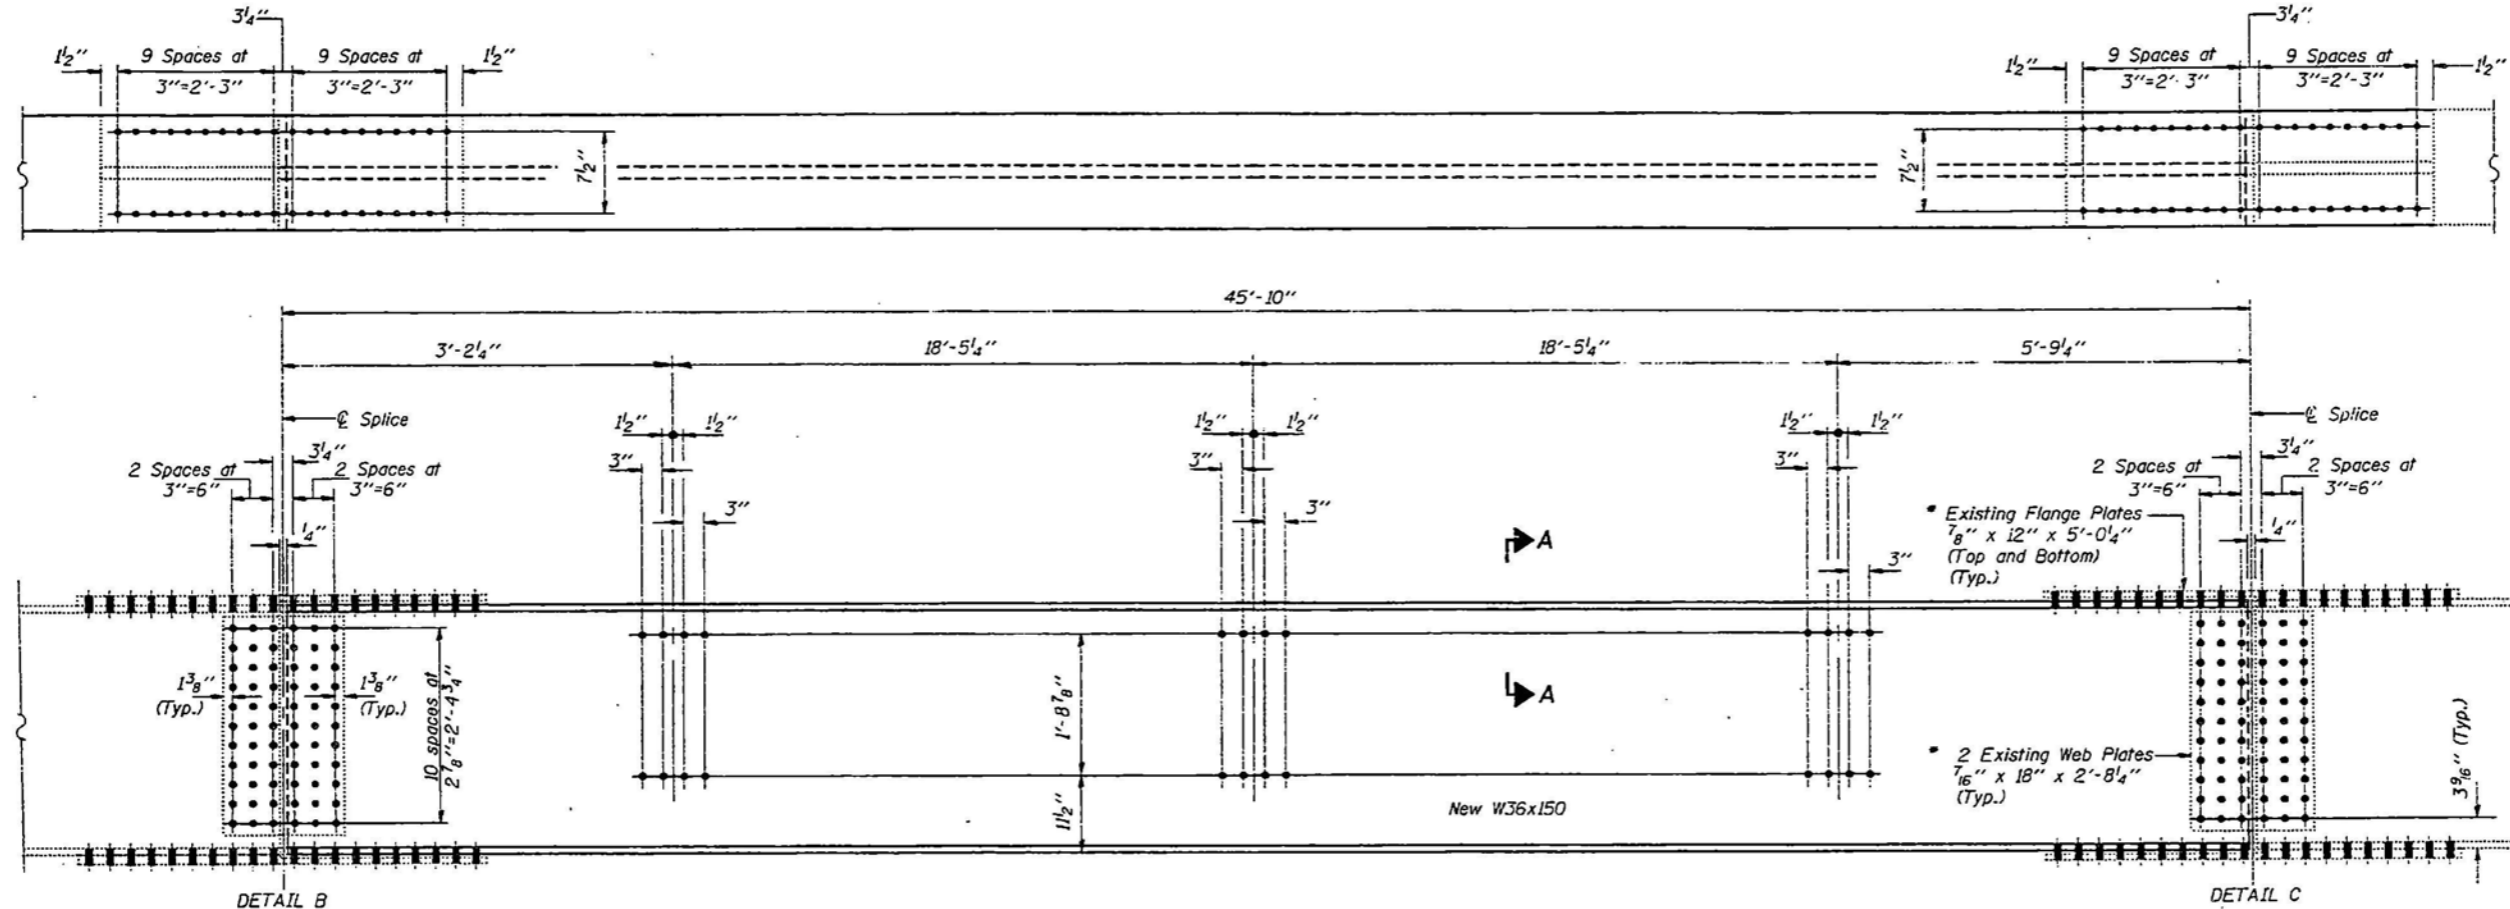


**ELEVATION BEAM 7**

Required: One (1) W36 x 150 x 45'-10"

Notes: Natural camber of new beam shall be placed upward for fabrication.  
All existing Splice Connection Bolts to be replaced with new H.S. Bolts.  
All 1 1/8" φ bolt hole for new 3/4" φ H.S. Bolts for web splices shall be drilled in the field using the existing web splice plates as templates after the new structural steel is fitted into position.  
All 5/16" φ bolt hole for new 3/4" φ H.S. Bolts for all diaphragm connections shall be drilled in the field using existing clip angles as templates after the new structure steel is fitted into position.  
Two hardened washers shall be required at diaphragm connections.  
All 5/16" φ bolt hole for new 7/8" φ H.S. Bolts for flange splices shall be drilled in the field using the existing flange splice plates as templates after the new structure steel is fitted into position.

\* Existing Plates to be matched, marked, removed and reused.

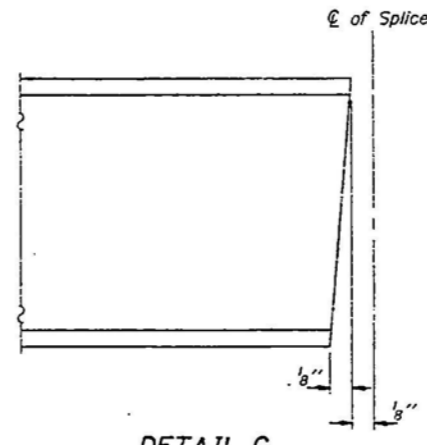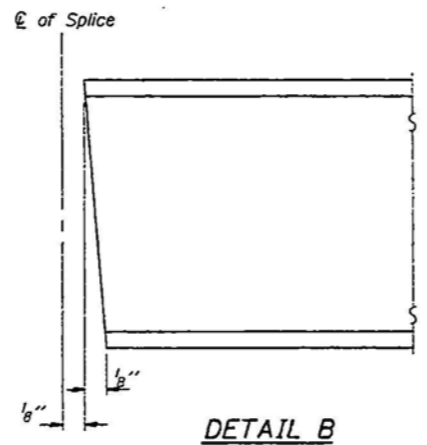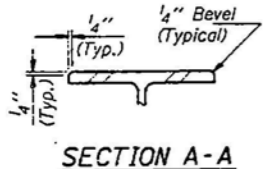

DESIGNED	G.T.B.
CHECKED	V.H.V.
DRAWN	J. March
CHECKED	G.T.B. V.H.V.


October 11, 1996  
EXAMINED *Todd E. Adams*  
PASSED  
ENGINEER OF STRUCTURAL SERVICES  
ENGINEER OF BRIDGES AND STRUCTURES

**BEAM REPLACEMENT**  
F.A.I. RT. 80 SEC. 1313-811 HB  
COOK COUNTY  
STA. 1313+37.93  
STR. No. 016-0927




SECTION	QUANTITY	TOTAL SHEETS	SHEET NO.
80	COOK	359	76


11213-825HBK, 1315-821, 1516-822, 1216-823, 1819-824RS-1 & (1516-804HB, 1516-805HB, 1718-807R)

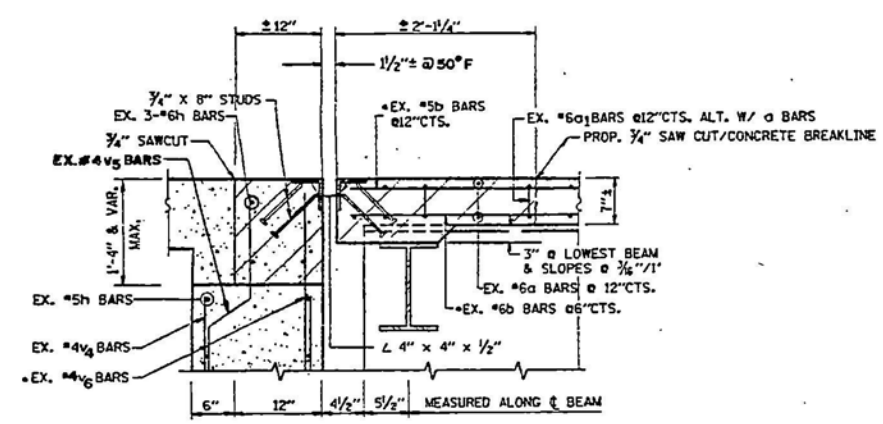


EXISTING EXPANSION JOINT

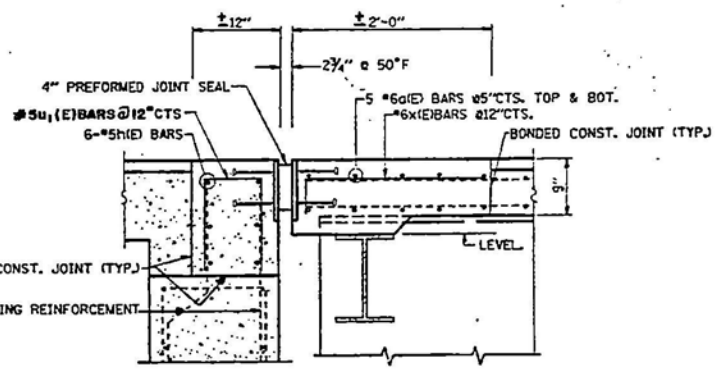


SECTION A-A PROPOSED EXPANSION JOINT

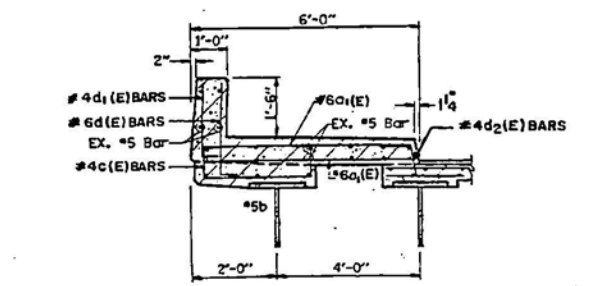

EXISTING/PROPOSED PARAPET AT EXPANSION JOINT

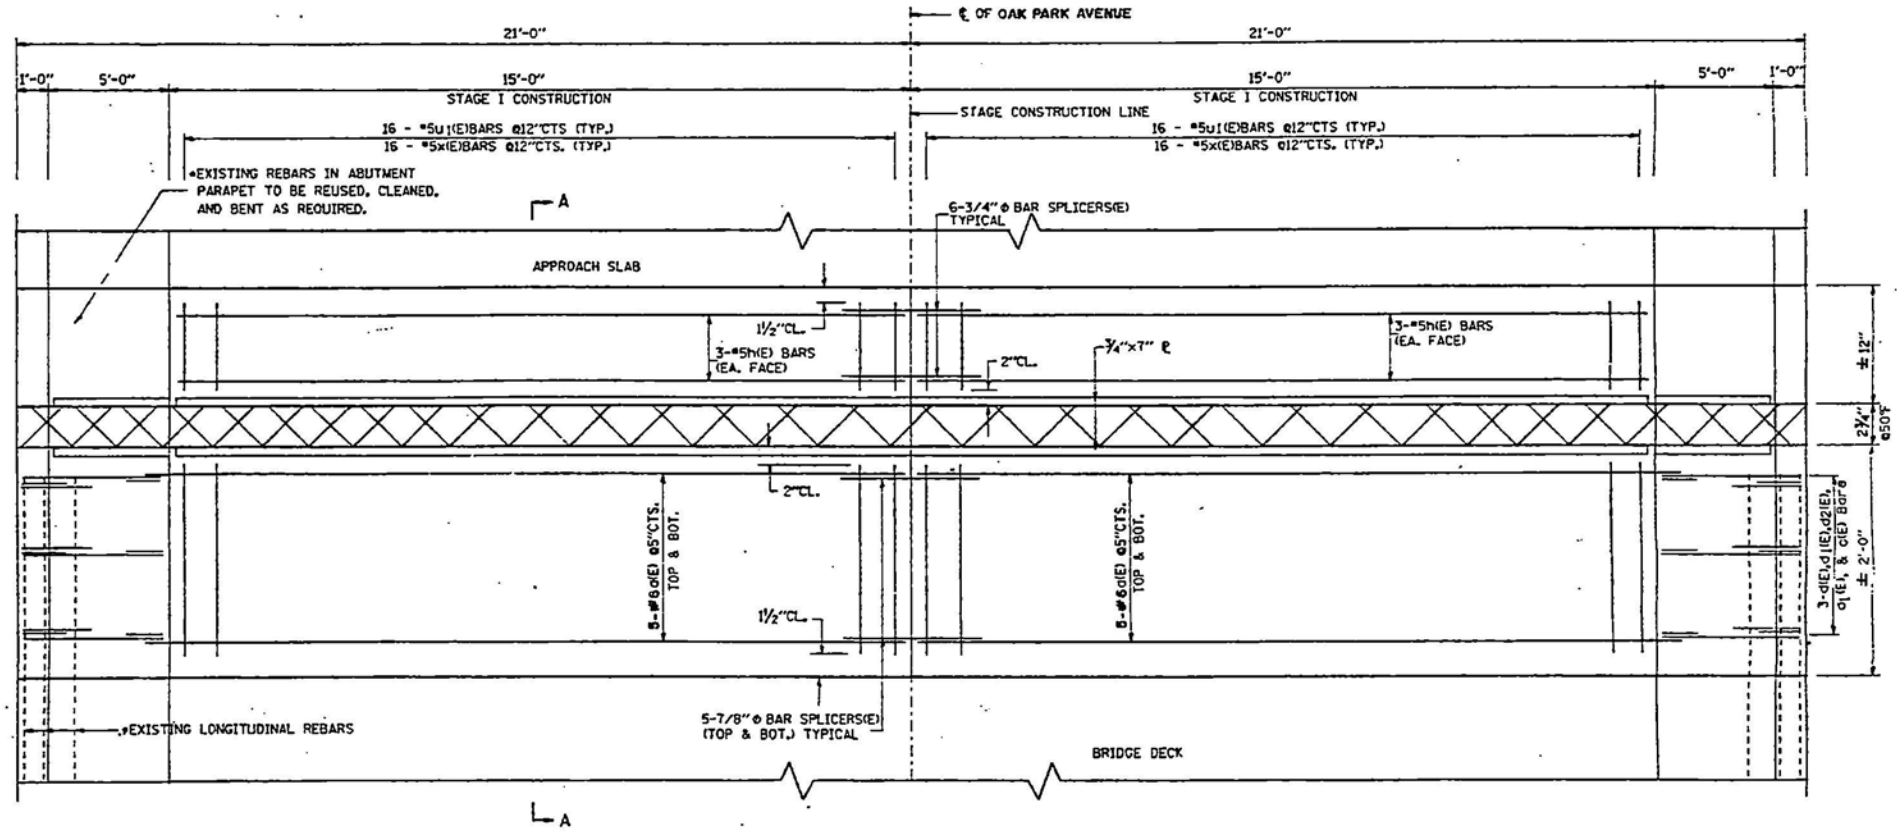

BRIDGE DECK EXPANSION JOINT @ ABUTMENT PLAN

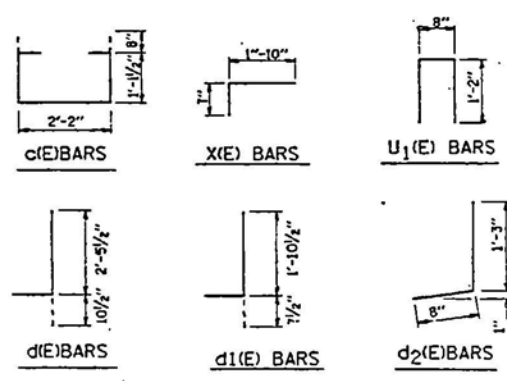

**LEGEND**  
 CONCRETE REMOVAL  
 4\"/>

**NOTES:**  
 \*EXISTING REINFORCEMENT BARS EXTENDING INTO NEW CONSTRUCTION SHALL BE CLEANED, STRAIGHTENED, AND INCORPORATED INTO THE NEW CONCRETE. THE CONTRACTOR SHALL EXERCISE CAUTION WHEN REMOVING EXISTING CONCRETE SO AS TO NOT DAMAGE EXISTING REINFORCEMENT.  
 FIELD CUTS OF PROPOSED REINFORCEMENT BARS TO FIT FIELD CONDITIONS SHALL BE CONSIDERED INCIDENTAL TO THE COST OF REINFORCEMENT BARS (EPOXY COATED).  
 BONDED CONSTRUCTION JOINT SHALL BE CONSTRUCTED IN ACCORDANCE WITH ARTICLE 503.09(a)(2) OF THE STANDARD SPECIFICATIONS. SEE SHEET FOR BAR SPLICER DETAILS.

BILL OF MATERIALS

Bar	No.	Size	Length	Shape
c(E)	40	#6	15'-8"	—
a1(E)	24	#6	5'-6"	—
d(E)	12	#6	3'-4"	—
d1(E)	12	#4	2'-6"	—
d2(E)	12	#4	1'-11"	—
c1(E)	12	#4	5'-9"	—
u1(E)	64	#5	3'-0"	—
n1(E)	24	#5	14'-10"	—
x1(E)	64	#6	2'-5"	—
Item	Unit	Quantity		
Reinforcement Bars (Epoxy Coated)	Pound	3050		
Concrete Removal	Cu. Yds.	14.6		
Concrete Superstructure	Cu. Yds.	12.7		
Preformed Joint Seal (4")	Foot	90		
Furn. And Erect. Structural Steel	Pound	3200		
Bar Splicers	Each	32		


REVISIONS	
NAME	DATE

ILLINOIS DEPARTMENT OF TRANSPORTATION  
 OAK PARK AVENUE  
 OVER INTERSTATE ROUTE 80  
 TRANSVERSE EXPANSION JOINT DETAIL  
 S.N.016-0927

SCALE: NONE  
 DATE: 11/17/95  
 DRAWN BY: JAF  
 CHECKED BY: MVT


P.A.A. NO.	SECTION	COUNTY	SHEET	TOTAL SHEETS
80		COOK	359	77
STA.	TO STA.			
FED. ROAD DIST. NO.	BLDG.	FED. AID PROJECT		

#11213-825HBK, 1315-821, 1516-822, 1216-823, 1819-824RS-1 & (1516-804HB, 1516-805HB, 1718-807R)

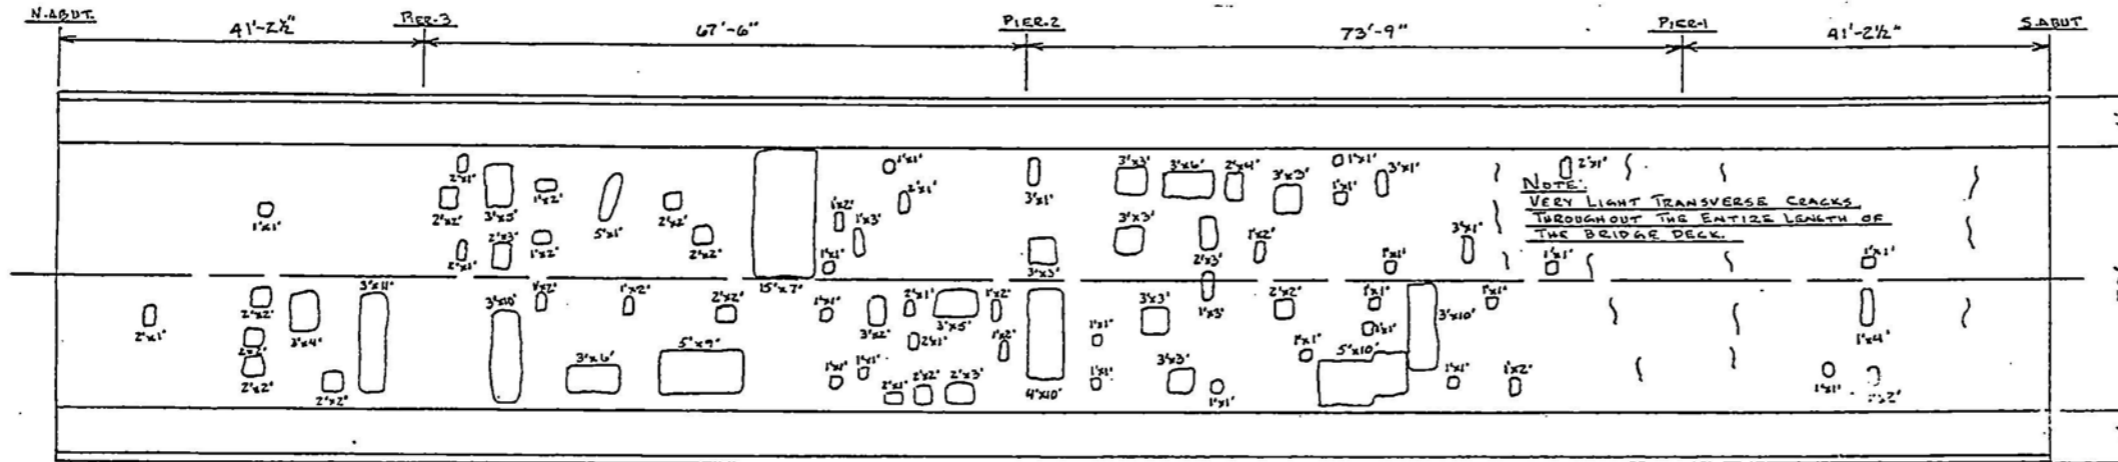

NOTE:  
 ○ ○ ○ - PARTIAL DEPTH AREAS = 617 SQ. FT. = 69 SQ. YDS.  
 ||| - TRANSVERSE CRACKS

TOP DECK SURVEY  
 OAK PARK AVE/I-80  
 BRIDGE NO. 016-0927  
 UPDATED ON 11/9/95  
 BY: LME

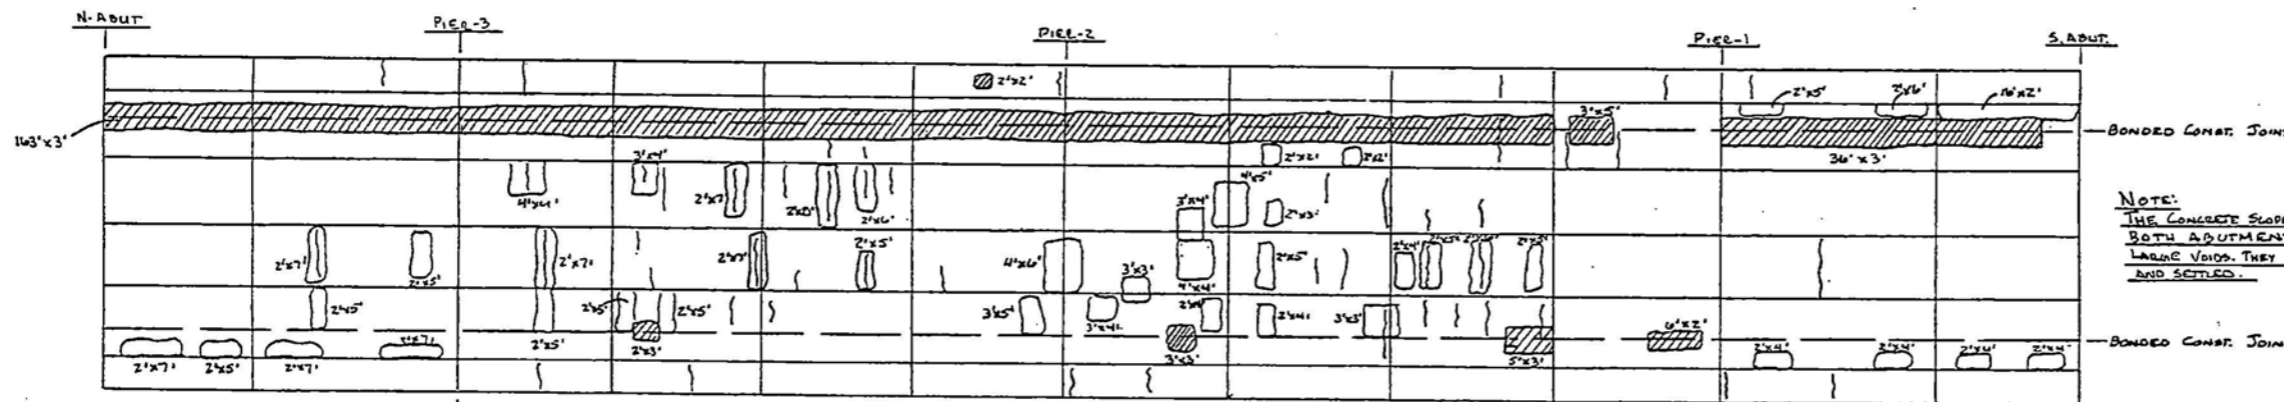

NOTE:  
 ○ ○ ○ - SPALL AREAS = 658 SQ. FT. = 73 SQ. YDS.  
 ○ ○ - LEACHING AREAS = 507 SQ. FT. = 56 SQ. YDS.  
 ||| - LEACHING CRACKS

NOTE:  
 IMPACT DAMAGE TO WEST FACIA BEAM OVER LANE #3

NOTE:  
 FILLETS ALONG FACIA BEAMS AND FIRST BEAM IN EACH SPAN ARE IN DANGER OF SPALLING. MOST OF THESE IN SPAN 1 AND 4, HAVE ALREADY FALLEN.

BOTTOM DECK SURVEY  
 OAK PARK AVE/I-80  
 BRIDGE NO. 016-0927  
 UPDATED ON 11/9/95  
 BY: LME

BILL OF MATERIALS

Item	Unit	Total
Deck Slab Repair (Partial)	Sq. Yds.	70
Deck Slab Repair (Full Depth, Type D)	Sq. Yds.	20
Deck Slab Repair (Full Depth, Type I)	Sq. Yds.	10

NOTE:  
 DECK SLAB REPAIRS SHALL BE DETERMINED IN THE FIELD AT THE RESIDENT ENGINEER'S DISCRETION.

REVISIONS	
NAME	DATE


ILLINOIS DEPARTMENT OF TRANSPORTATION  
 OAK PARK AVENUE OVER  
 INTERSTATE ROUTE 80  
 S.N.016-0927  
 DECK REPAIR PLAN

SCALE: NONE  
 DATE: 10-13-95  
 DRAWN BY: JAF  
 CHECKED BY: MVT


P.L.A. NO.	SECTION	COUNT	TOTAL SHEETS	SHEET NO.
80	COOK	359	70	
STA.	TO STA.			
P.L.A. NO. (SEE PLAN)		SHEET NO.		P.L.A. PROJECT

#1213-825HBK, 1315-821, 1516-822, 1216-823, 1819-824RS-1 & 1516-804HB, 1516-805HB, 1718-807R

IFRDS VER 3.1  
 BRIDGE N31 016-0927  
 DATE 10-17-95  
 OPERATOR RIL-FA  
 CORNER ST OAK PARK AV. I-80 S REUT N3 SKEU  
 TOTAL "C" = 00413 TOTAL DELAMINATIONS = 518 ST. = 0.2%  
 TOTAL PTS = 06660

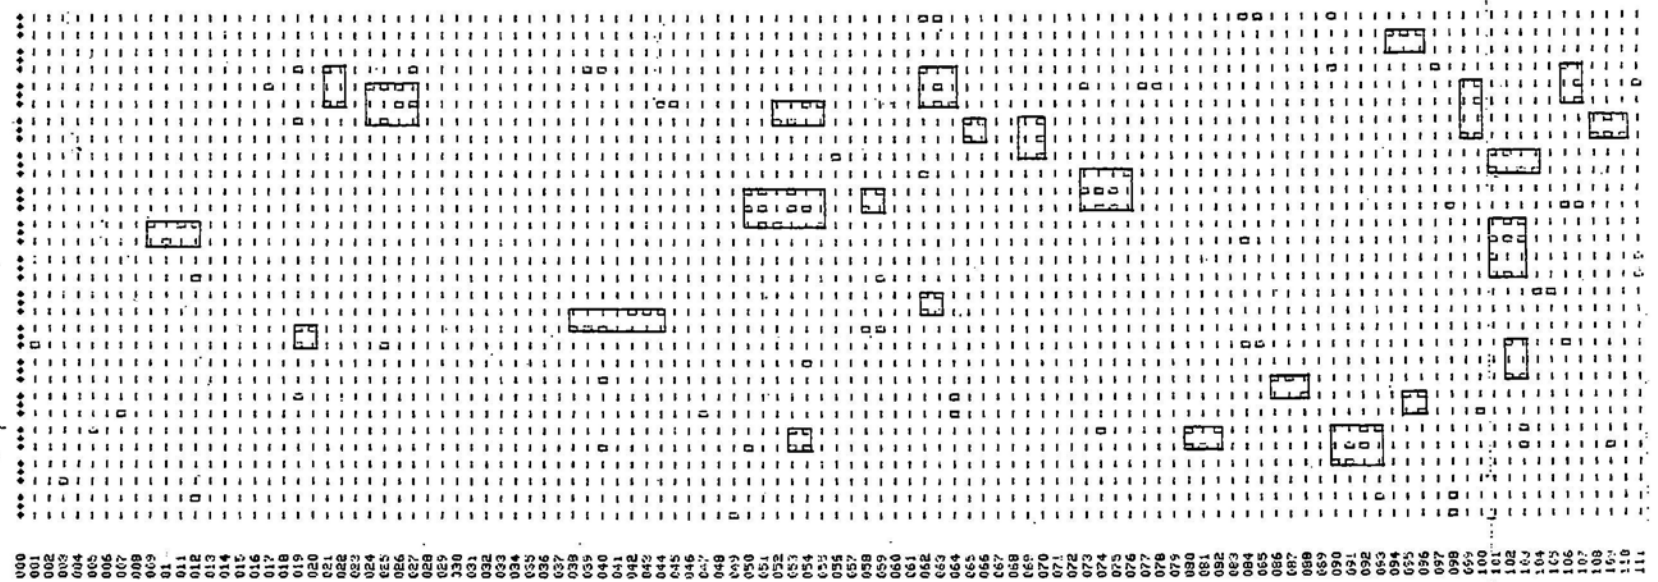

DELAMINATION PLAN

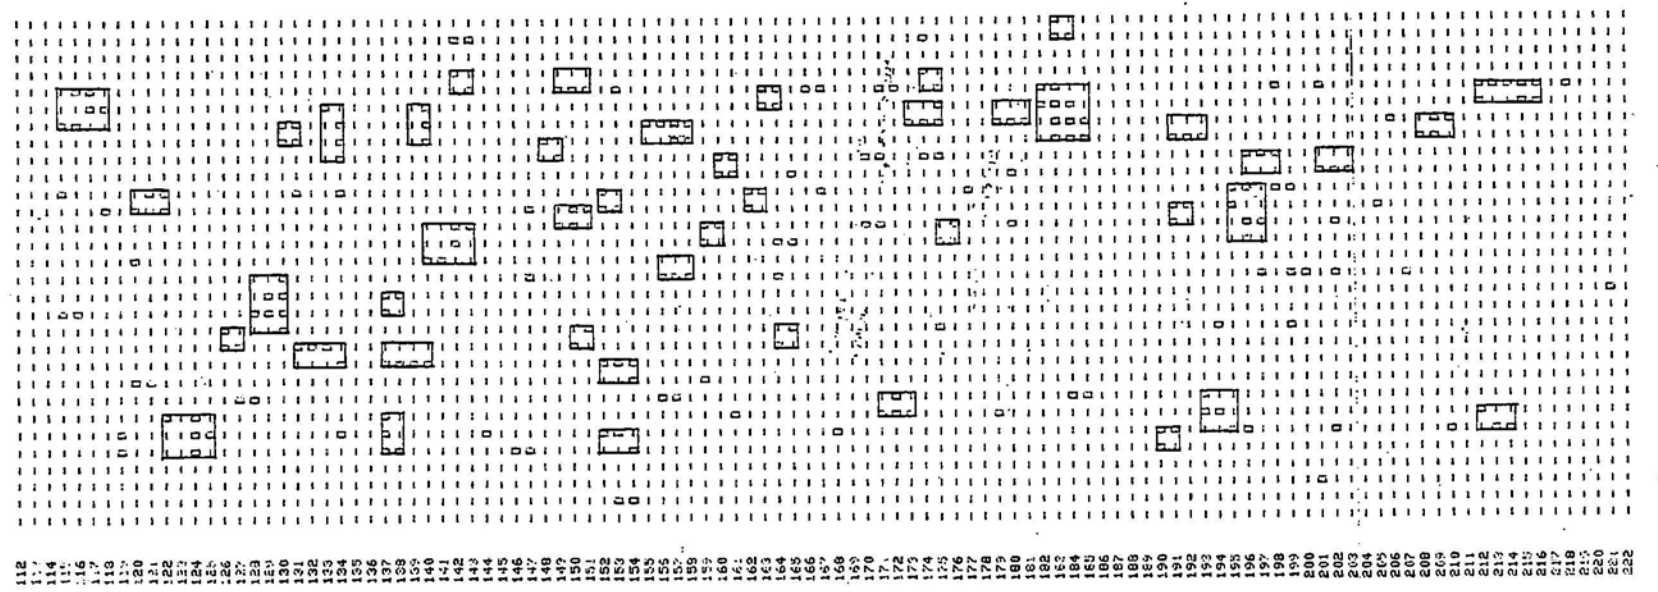

112 113 114 222

NOTE:  
 DELAMINATION PLAN HAS BEEN INCLUDED FOR  
 INFORMATION ONLY.

REVISIONS	
NAME	DATE


ILLINOIS DEPARTMENT OF TRANSPORTATION  
 OAK PARK AVENUE OVER  
 INTERSTATE ROUTE 80  
 S.N.016-0927  
 DELAMINATION PLAN

SCALE: NONE  
 DATE 10-13-95

DRAWN BY JAF  
 CHECKED BY MWT


P.L. NO.	SECTION	COUNTY	TRK. MILE	SHEET NO.
80	5	COOK	359	79
STA.	TO STA.			
FED. ROAD DIST. NO.	SLURRY	FED. AID PROJECT		

#1213-825HBK, 1315-821, 1516-822, 1216-823, 1819-824IRS-1 & 1516-804HB, 1516-805HB, 1718-807R

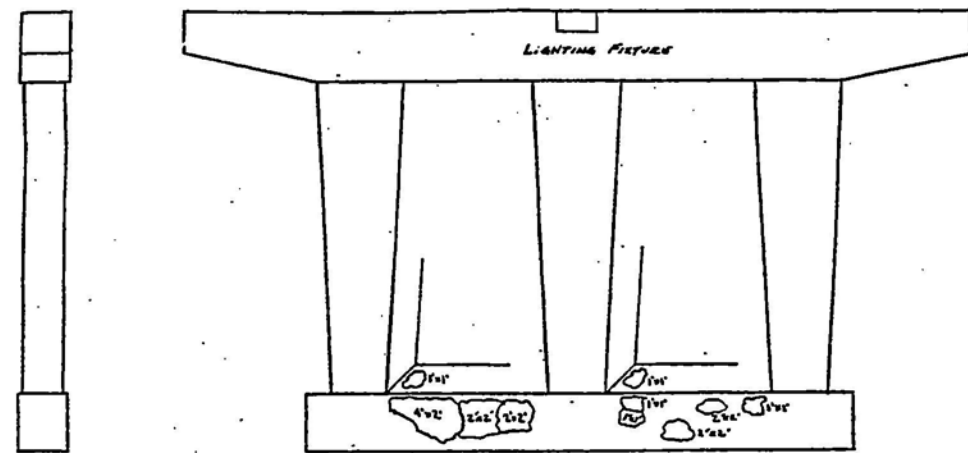


NOTE:  
 ○ - SPALL AREAS = 29 SQ. FT.

PIER #1 - NORTH SIDE

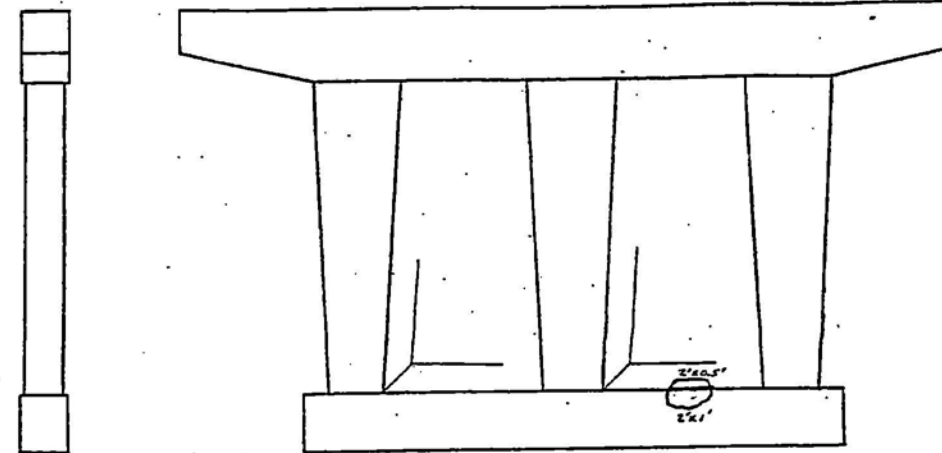

NOTE:  
 ○ - SPALL AREAS = 3 SQ. FT.

PIER #1 - SOUTH SIDE

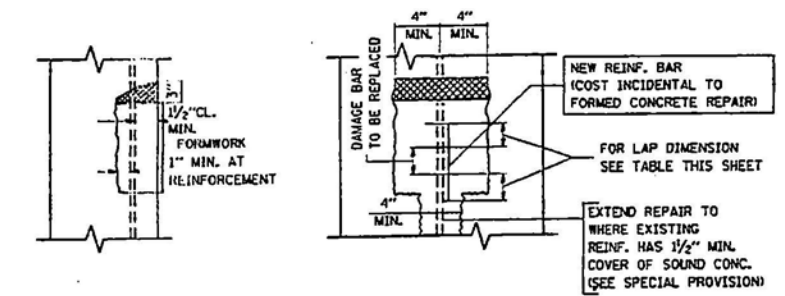

NOTE:  
 EXISTING REINFORCEMENT HAVING 10% OR MORE OF CROSS SECTIONAL AREA LOST DUE TO CORROSION OR DAMAGED DURING CONC. REMOVAL SHALL BE REPLACED BY NEW REINFORCEMENT LAPPED AS SHOWN OR NOTED.

LAP DIMENSIONS


BAR SIZE	LAP LENGTH
#4	1'-8"
#5	2'-2"
#6	2'-7"
#7	3'-5"
#8	4'-6"

FORMED CONCRETE REPAIR DETAIL WITH REINFORCEMENT

LEGEND


▨ INDICATES FORMED CONCRETE REPAIR

SUBSTRUCTURE SURVEY  
 OAK PARK AVE./I-80  
 BRIDGE NO. 016-0927

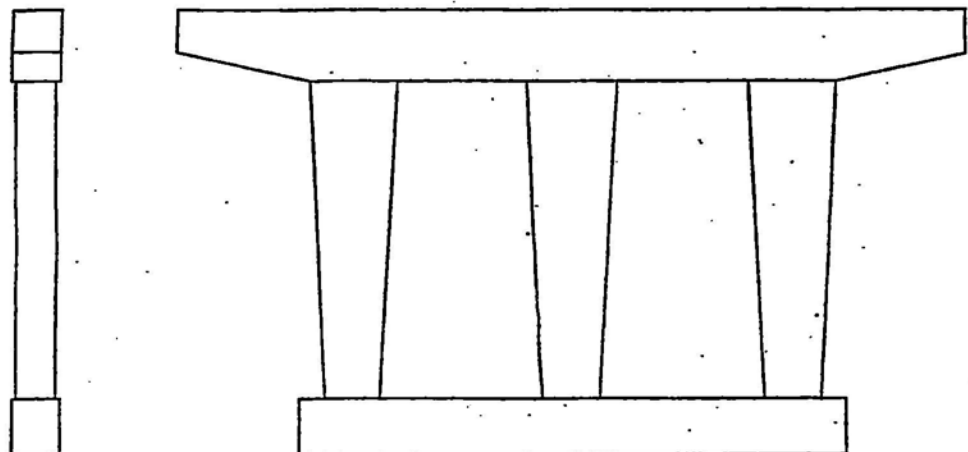

NOTE:  
 No visible SPALLS OR CRACKS.

PIER #2 - NORTH SIDE

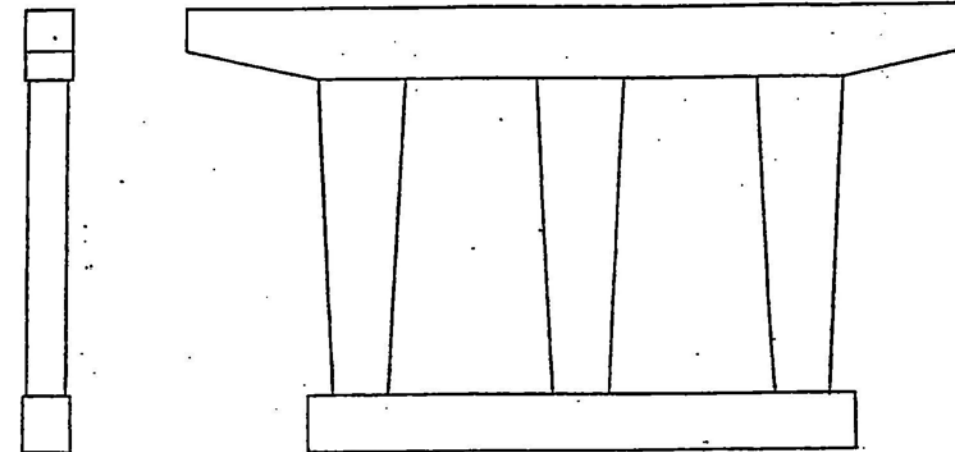


NOTE:  
 No visible SPALLS OR CRACKS.

PIER #2 - SOUTH SIDE

BILL OF MATERIALS


Item	Unit	Total
Formed Concrete Repair ≤ 5" Depth	Sq. Ft.	45
Formed Concrete Repair > 5" Depth	Sq. Ft.	15
Epoxy Crack Sealing	Foot	5

NOTE:  
 FORMED CONCRETE REPAIR < 5" OR > 5" IS TO BE DETERMINE IN THE FIELD AT THE RESIDENT ENGINEER'S DISCRETION. FIELD DATA BY M.J.J.

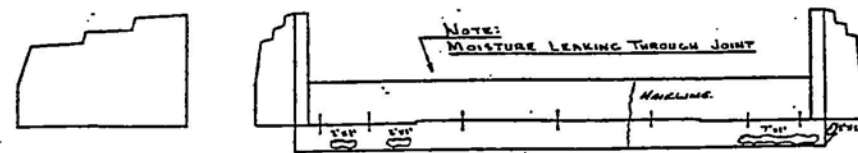


NOTE:  
 MOISTURE LEAKING THROUGH JOINT

NOTE:  
 VOIDS UNDER SLOPE PAVEMENT  
 ○ - SPALL AREA = 12 SQ. FT.

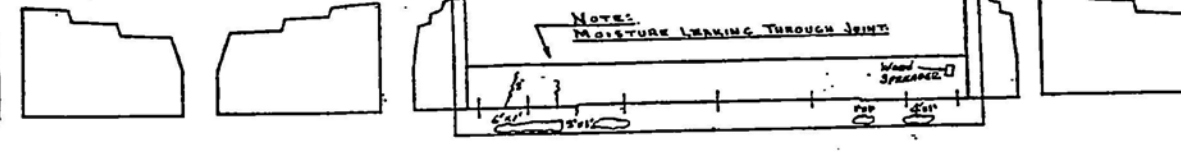


NOTE:  
 MOISTURE LEAKING THROUGH JOINT

NOTE:  
 VOIDS UNDER SLOPE PAVEMENT AND SETTLED  
 ○ - SPALL AREAS = 16 SQ. FT.  
 / - EPOXY INJECT CRACK = 5 LIN. FT.  
 / - WAVELINE CRACK

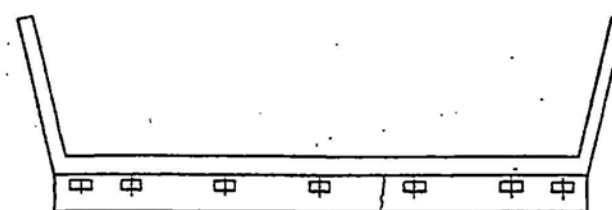

SOUTH ABUTMENT

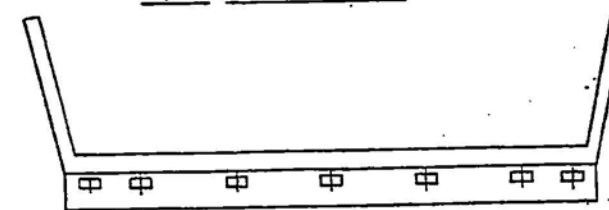

NORTH ABUTMENT


REVISIONS	
NAME	DATE

ILLINOIS DEPARTMENT OF TRANSPORTATION  
 OAK PARK AVE. OVER  
 INTERSTATE ROUTE 80  
 S.N.016-00927  
 SUBSTRUCTURE REPAIR PLANS


SCALE: VERT.      DRAWN BY CADD  
 HORIZ.              CHECKED BY JAF  
 DATE

P.A.A. No.	SECTION	COUNTY	TOTAL SHEETS	SHEET NO.
80		COOK	359	80
STA.		TO STA.		
FED. AID DIST. NO.		ALTERN.	FED. AID PROJECT	


#(1213-825HBK, 1315-821, 1516-822, 1216-823, 1819-824RS-1 & (1516-804HB, 1516-805HB, 1718-807R)

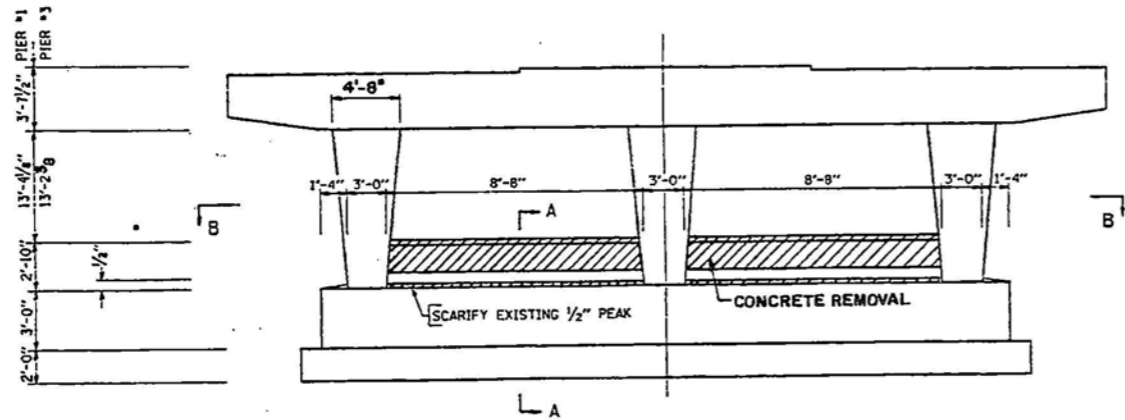


EXISTING PIER #1 ELEVATION (LOOKING NORTH)  
EXISTING PIER #3 ELEVATION (LOOKING SOUTH)  
(HATCHED AREA INDICATES CONCRETE REMOVAL.)

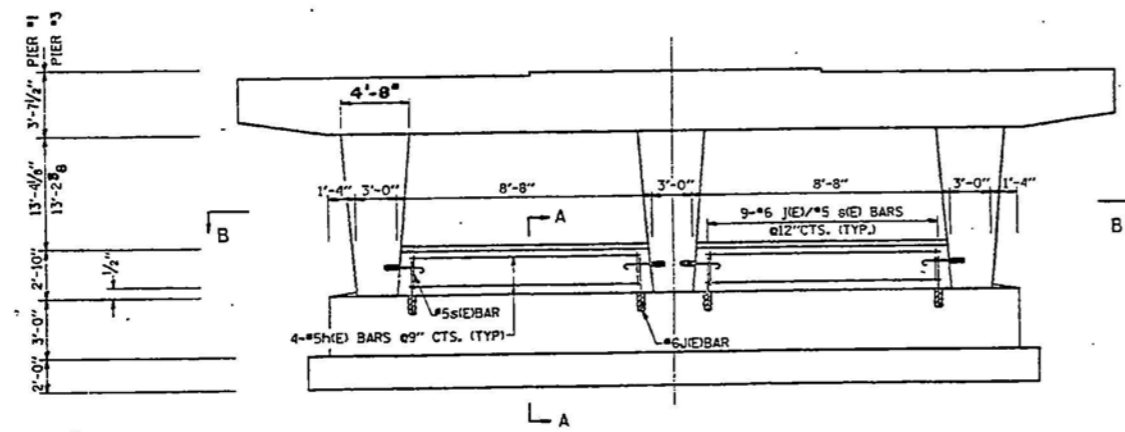

PROPOSED PIER #1 ELEVATION (LOOKING NORTH)  
PROPOSED PIER #3 ELEVATION (LOOKING SOUTH)

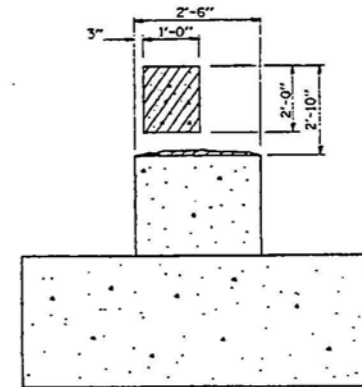

SECTION A-A  
(EXISTING)

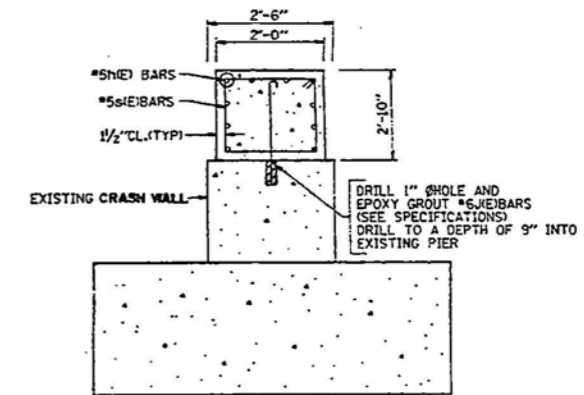


SECTION A-A  
(PROPOSED)



BILL OF MATERIALS

Bar	No.	Size	Length	Shape
J(E)	44	#6	4'-1"	C
H(E)	40	#5	8'-0"	
s(E)	36	#5	9'-7"	L
Item	Unit	Quantity		
Concrete Removal	Cu. Yds.	2.7		
Reinforcement Bars(Epoxy Coated)	Pound	970		
Concrete Structures	Cu. Yds.	7.3		

NOTES:  
DRILLING AND EPOXY GROUTING OF THE #6 J BARS IS TO BE CONSIDERED INCIDENTAL TO THE COST OF REINFORCEMENT BARS (EPOXY COATED).  
THE SCARIFICATION OF THE 1/2" PEAK ON THE EXISTING PIER BASE WALL SHALL BE PAID FOR AS CONCRETE REMOVAL.  
ALL EDGES SHALL HAVE 1/4" CHAMFER.

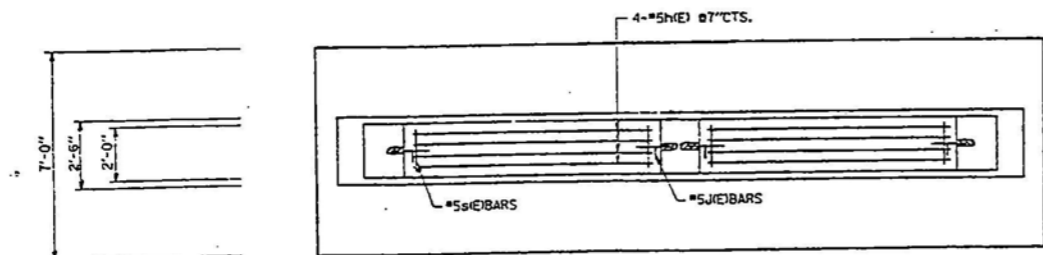

SECTION B-B

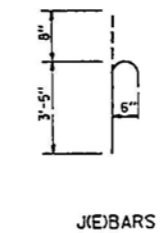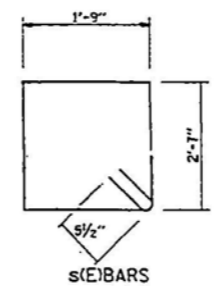


DESIGN STRESSES  
f'c = 3,500psi  
fy = 60,000psi

REVISIONS	
NAME	DATE


ILLINOIS DEPARTMENT OF TRANSPORTATION  
OAK PARK AVENUE OVER  
INTERSTATE ROUTE 80  
PIER #1 & #3-BASE WALL EXTENSION  
S.N. 016-0927  
SCALE: NONE  
DATE 11/28/95  
DRAWN BY CADD  
CHECKED BY JAF

SECTION	QUANTITY	TYPE	UNIT
80	COOK	359	81
STA. TO STA.			
FOR NO. PROJECT			


#1213-825HBK, 1315-821, 1516-822, 1216-823, 1819-824RS-1 & 1516-804HB, 1516-805HB, 1718-807R

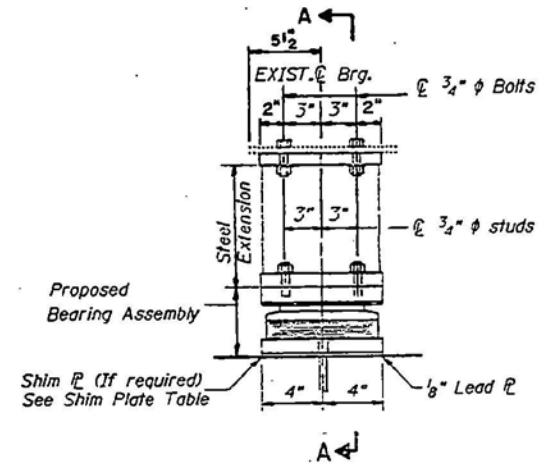


ELEVATION AT NORTH / SOUTH ABUTMENT  
(14 Required)

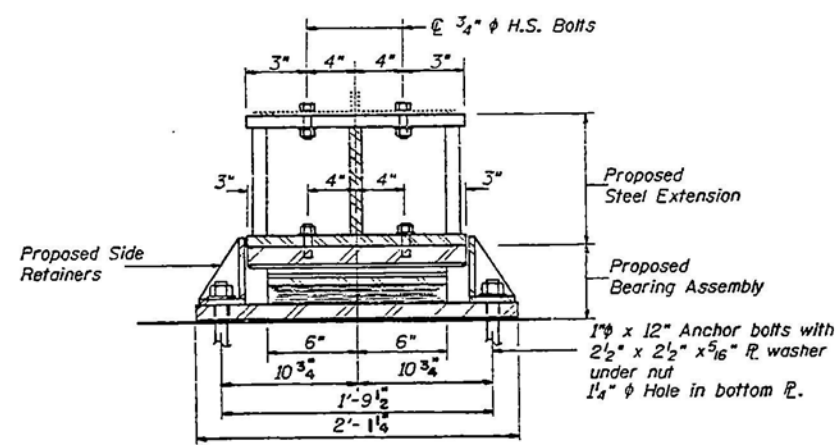


SECTION A-A

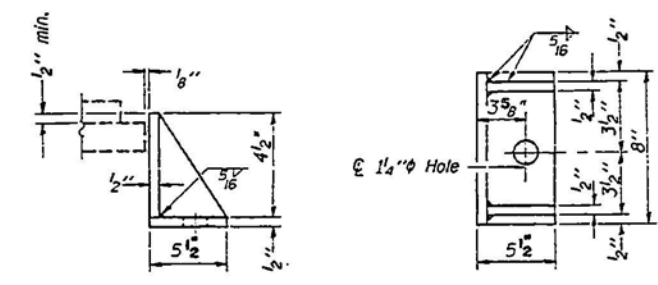


SIDE RETAINER

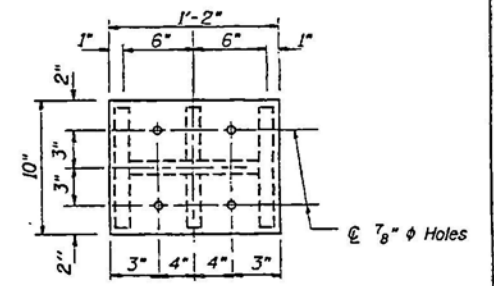


PLAN TOP PLATE

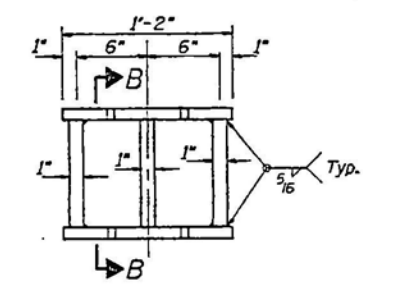


STEEL EXTENSION DETAIL

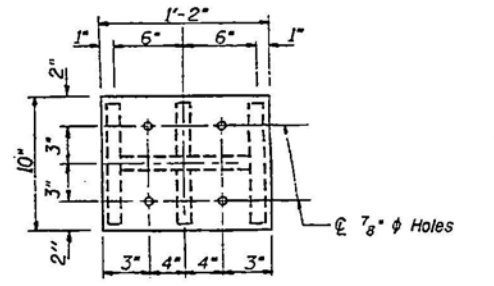


PLAN BOTTOM PLATE

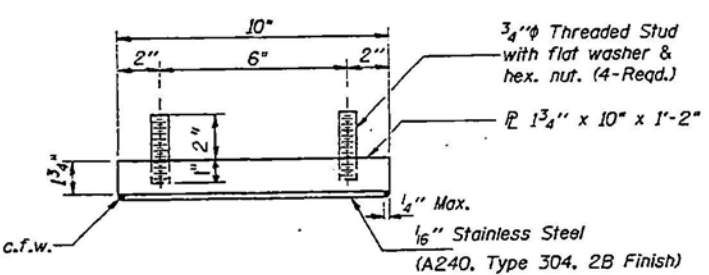

TOP BEARING ASSEMBLY

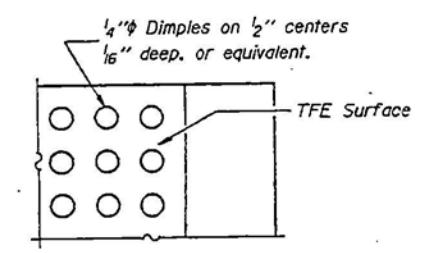

PLAN-TFE SURFACE

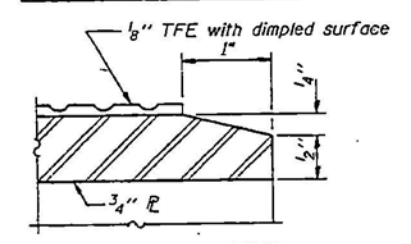

SECTION THRU TFE


GIRDER REACTIONS		
	NO. ABUT.	SO. ABUT.
R <sub>DL</sub> (K)	15.3	12.7
R <sub>LL</sub> (K)	36.0	35.8
R <sub>IMP</sub> (K)	10.8	10.8
R <sub>TOTAL</sub> (K)	62.1	59.3

NOTES:  
Before installing the new bearing, remove the top plate of the existing bearing assembly from the bottom flange using the air-arc method and grind smooth all weld material remaining on the existing bottom flange. Burn existing anchor bolts flush with existing concrete surface. Grind smooth and seal with epoxy. The cost is included with F&E Structural Steel. See Existing Bearing Removal Detail.  
New side retainers, shim plates, connection bolts, and anchor bolts are included in Furnishing and Erecting Structural Steel.

For the details of existing bearings see sheet S10 thru S12 Contractor shall submit jacking details for approval by the bridge office.  
For anchor bolt details see sheet S16.  
Prior to ordering any material, the contractor shall verify in the field all bearing heights and shim plate thickness dimensions  
Diaphragm removal and replacement may be required to facilitate drilling holes in the bottom flange for bearing attachment. Cost incidental to Furnishing and Erecting Structural Steel.


Table Of Dimension "n" For Shim Plates

Beam No.	1	2	3	4	5	6	7
So. Abutment	0	0	0	5/8"	0	0	0
No. Abutment	0	0	0	5/8"	0	0	0

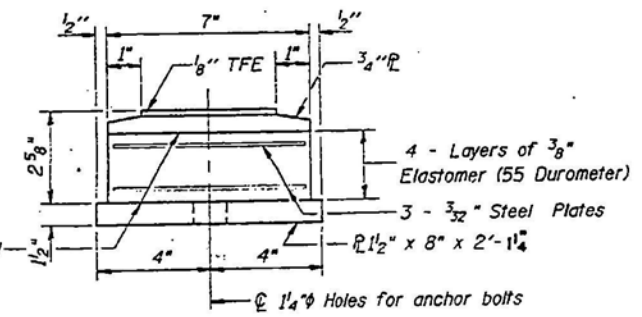


BOTTOM BEARING ASSEMBLY

Note: The 1/8" TFE sheet shall be bonded directly to the top steel plate with a two-component, medium viscosity epoxy resin, conforming to the requirements of the Federal Specification MMM-A-134, Type I. The bond agent shall be applied on the full area of the contact surfaces.  
Bonding of 1/8" TFE sheet during vulcanizing process will be permitted provided the process and method of adjusting assembly height is approved by the Engineer.

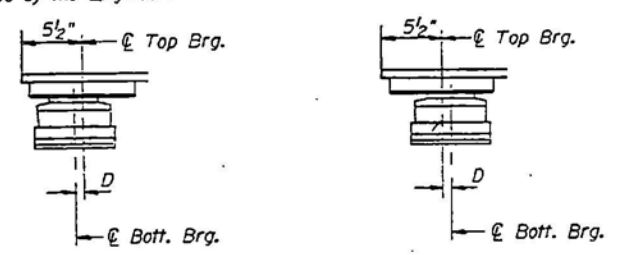

SETTING ANCHOR BOLTS AT EXP. BRG.

D = 1/8" per each 100' of expansion for every 15° temp. change from the normal temp. of 50° F.

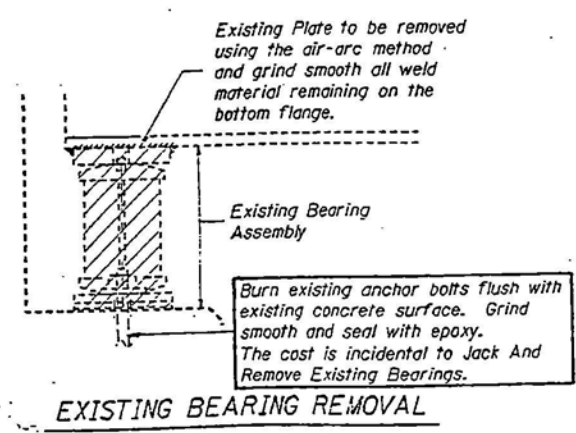

EXISTING BEARING REMOVAL

BILL OF MATERIAL

Item	Unit	Total
Elastomeric Bearing Assembly Type II	Each	14
Furnishing And Erecting Structural Steel	Pound	2960

REVISIONS	
NAME	DATE


ILLINOIS DEPARTMENT OF TRANSPORTATION  
OAK PARK AVENUE OVER INTERSTATE ROUTE 80  
NORTH / SOUTH ABUTMENTS  
ELASTOMERIC BEARING DETAIL  
S.N. 016-0927

SCALE: NONE  
DATE: 11/15/95  
DRAWN BY: CADD  
CHECKED BY: JAF


Wed Nov 15 10:50:19 AM 1995  
/usr/project/111193/d11193t1.5.m2 LVI-63

P.A.S. NO.	SECTION	QUANTITY	NO. SHEETS	SHEET NO.
80	#	COOK	359	82
STA.	TO STA.			
FED. ROAD DIST. NO.	BLDG. NO.	FED. AID PROJECT		


#1213-825HBX, 1315-821, 1516-822, 1216-823, 1819-824RS-1 & (1516-804HB, 1516-805HB, 1718-807R)

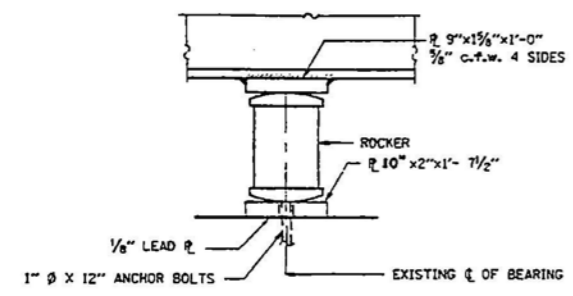


EXISTING SECTION AT PIER #3

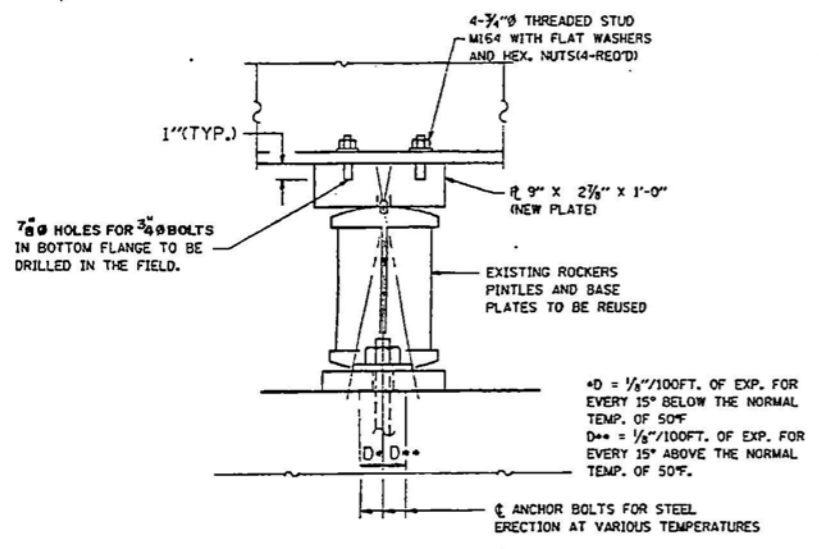

PROPOSED SECTION AT PIER #3

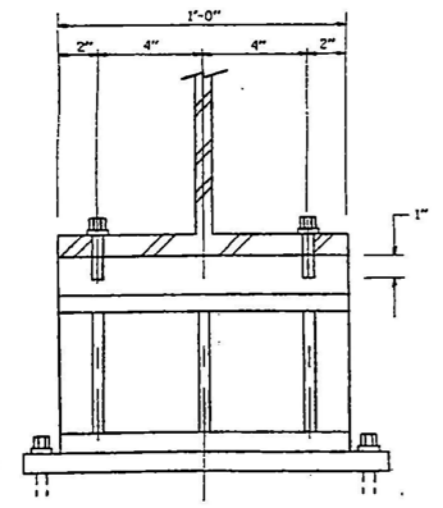

PROPOSED SECTION AT PIER #3

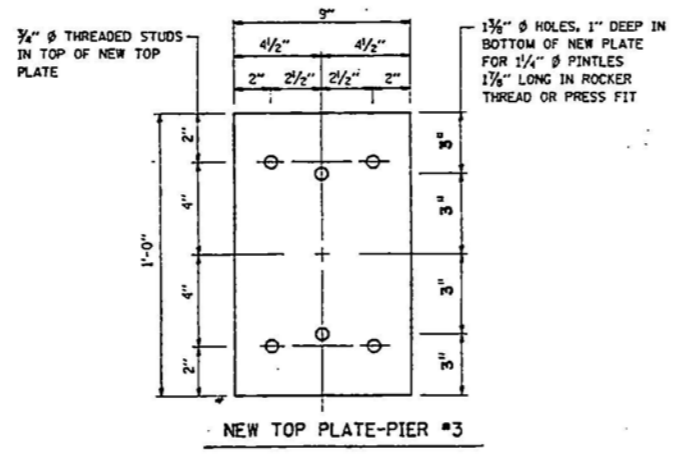

NEW TOP PLATE-PIER #3

GIRDER REACTIONS	
	PIER 3
R <sub>DL</sub> (K)	75.1
R <sub>LL</sub> (K)	49.3
R <sub>IMP</sub> (K)	13.5
R <sub>TOTAL</sub> (K)	138

BILL OF MATERIALS

Item	Unit	Total
Furnishing and Erecting Structural Steel	Pound	630

NOTES:  
 PROPOSED PLATES TO BE ALIGNED ABOVE EXISTING C OF BEARING. PROPOSED PLATE SHALL BE AASHTO, M-270, GR-36.  
 FOR JACKING INFORMATION, SEE SHEETS S10-S12  
 CONTRACTORS SHALL SUBMIT JACKING DETAILS FOR APPROVAL BY THE BRIDGE OFFICE.  
 BROKEN, RUSTED OUT OR MISALIGNED BOLTS, PINTLES AND ANCHOR BOLTS WHICH NEED TO BE REPLACED OR REALIGNED, THE COST SHALL BE CONSIDERED AND PAID FOR AS FURNISHING AND ERECTING STRUCTURAL STEEL.  
 EXISTING ROCKERS AND BASE PLATES TO BE CLEANED AND PAINTED AND REUSED. SEE SPECIAL PROVISIONS.


USE THE AIR-ARC METHOD TO CUT EXISTING SOLE PLATES FROM THE BOTTOM FLANGE. GRIND SMOOTH ALL WELD MATERIAL REMAINING ON THE BOTTOM FLANGE. COST INCIDENTAL TO FURNISHING & ERECTING STRUCTURAL STEEL.  
 DRILLING TO BE DONE IN THE FIELD IS INCIDENTAL TO THE COST OF FURNISHING AND ERECTING STRUCTURAL STEEL.

REVISIONS	
NAME	DATE


ILLINOIS DEPARTMENT OF TRANSPORTATION  
 OAK PARK AVENUE  
 OVER INTERSTATE ROUTE 80  
 BEARING DETAILS  
 S.N. 016-0927  
 SCALE: 50'-1"  
 DATE: 11/17/95  
 DRAWN BY: CADD  
 CHECKED BY: JAF

SECTION	COUNTY	TOTAL SHEETS	SHEET NO.
80	COOK	359	83
STA.	TO STA.		
111.000	111.000		

11213-825HBK, 1315-821, 1516-822, 1216-823, 1819-824RS-1 & (1516-804HB, 1516-805HB, 1718-807R)

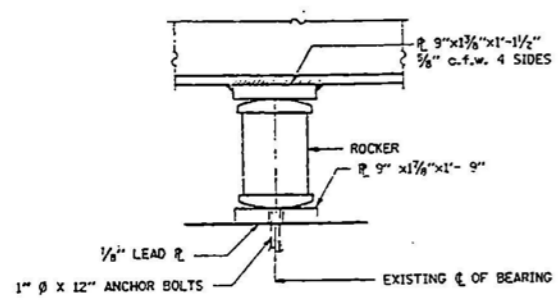


EXISTING SECTION AT PIER #1

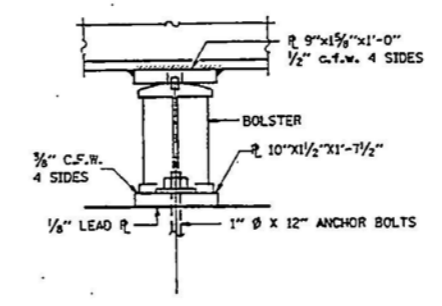

EXISTING SECTION AT PIER #2

BILL OF MATERIALS


Item	Unit	Total
Furnishing and Erecting Structural Steel	Pound	1280

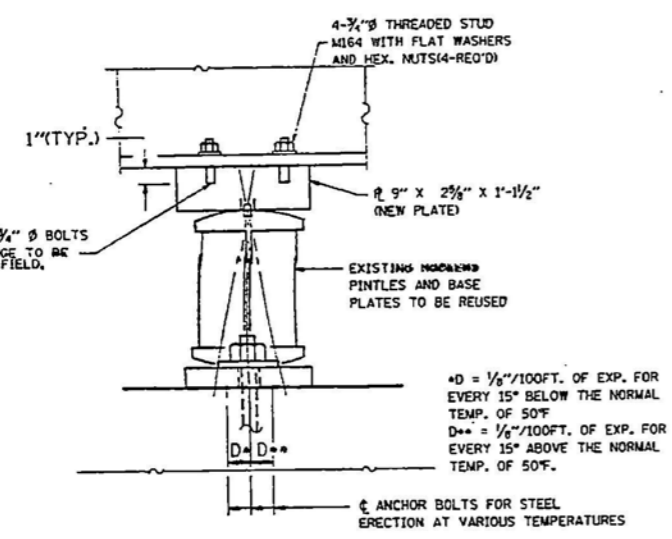

PROPOSED SECTION AT PIER #1

GIRDER REACTIONS


	PIER 1	PIER 2
R <sub>DL</sub> (K)	66.5	87.3
R <sub>LL</sub> (K)	47.5	52.4
R <sub>IMP</sub> (K)	13.3	13.4
R (K)	127.3	153.1

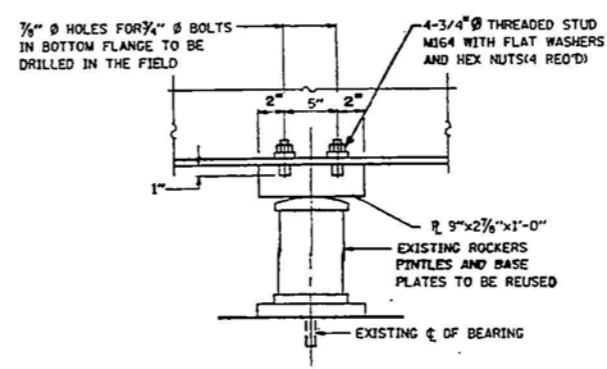


PROPOSED SECTION AT PIER #2

NOTES:  
 PROPOSED PLATES TO BE ALIGNED ABOVE EXISTING Ø OF BEARING. PROPOSED PLATE SHALL BE AASHTO, M-270, GR-36. FOR JACKING INFORMATION, SEE SHEETS S . CONTRACTORS SHALL SUBMIT JACKING DETAILS FOR APPROVAL BY THE BRIDGE OFFICE.  
 BROKEN, RUSTED OUT OR MISALIGNED BOLTS, PINTLES AND ANCHOR BOLTS WHICH NEED TO BE REPLACED OR REALIGNED, THE COST SHALL BE CONSIDERED AND PAID FOR AS FURNISHING AND ERECTING STRUCTURAL STEEL.  
 EXISTING ROCKERS AND BASE PLATES TO BE CLEANED AND PAINTED AND REUSED, SEE SPECIAL PROVISIONS.


USE THE AIR-ARC METHOD TO CUT EXISTING SOLE PLATES FROM THE BOTTOM FLANGE. GRIND SMOOTH ALL WELD MATERIAL REMAINING ON THE BOTTOM FLANGE. COST INCIDENTAL TO FURNISHING & ERECTING STRUCTURAL STEEL.  
 DRILLING TO BE DONE IN THE FIELD IS INCIDENTAL TO THE COST OF FURNISHING AND ERECTING STRUCTURAL STEEL.

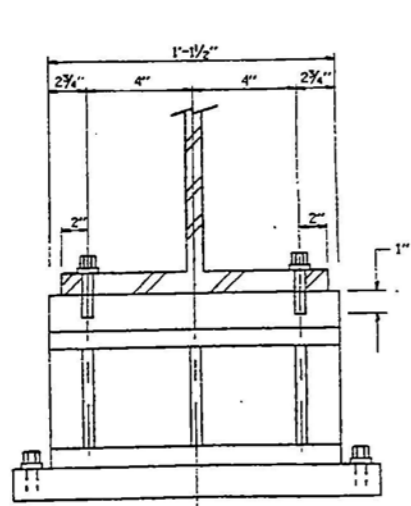


PROPOSED SECTION AT PIER #1

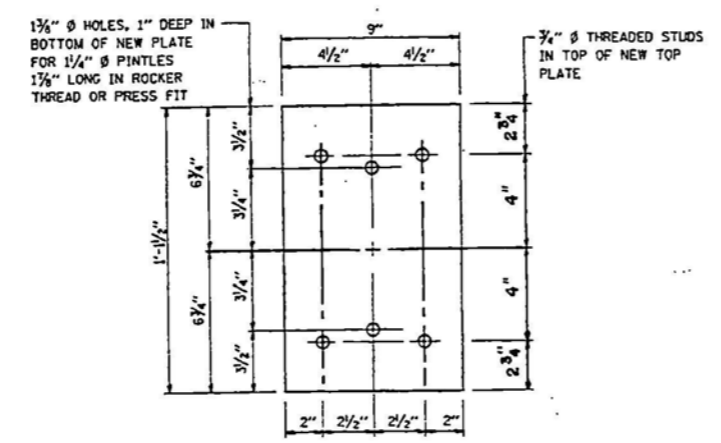

NEW TOP PLATE-PIER #1

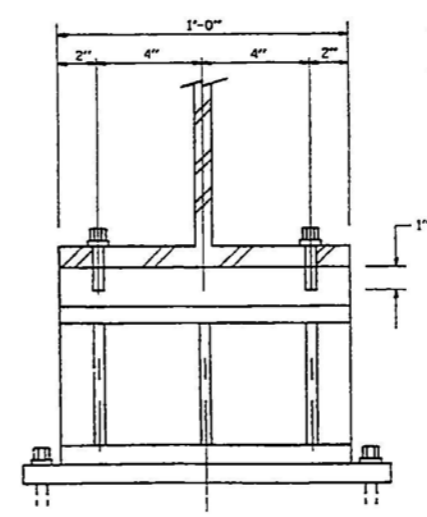

PROPOSED FRONT FACE AT PIER #2

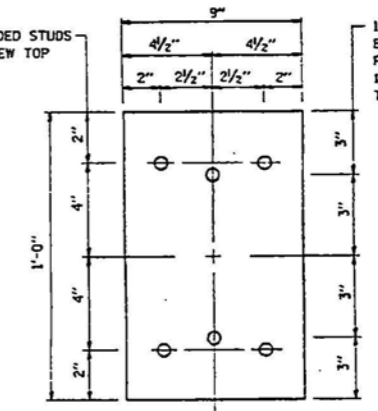

NEW TOP PLATE AT PIER #2


REVISIONS

NAME	DATE


ILLINOIS DEPARTMENT OF TRANSPORTATION  
 OAK PARK AVENUE  
 OVER INTERSTATE ROUTE 80  
 BEARING DETAILS  
 S.N. 016-0927  
 SCALE: 50'=1"  
 DATE: 11/17/95  
 DRAWN BY CADD  
 CHECKED BY JAF

SECTION	COUNTY	SHEET	SHEET NO.
80	COOK	359	87
STA.		TO STA.	
FED. ROAD DIST. NO.		BADDER	FED. RD PROJECT


11213-825HRK, 1315-821, 1516-822, 1216-823, 1819-824RS-1 & (1516-804HB, 1516-805HB, 1718-807R)

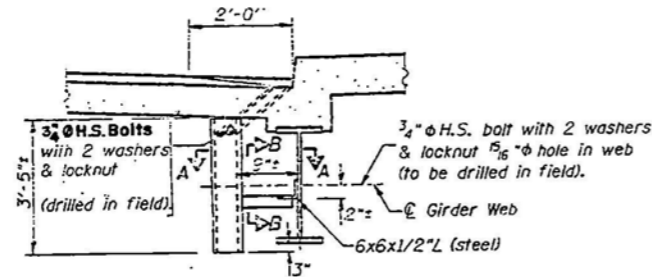


SECTION AT SIDEWALK

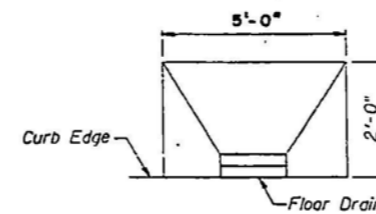

PLAN  
EXISTING FLOOR DRAIN TAPER

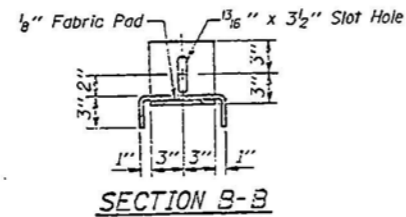

SECTION B-B

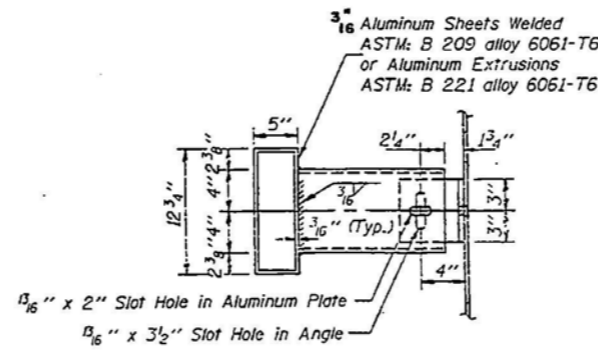

SECTION A-A

**NOTES:**

THE EXTERIOR SURFACES OF THE FLOOR DRAINS SHALL BE PAINTED WITH THE FINISH COAT AS SPECIFIED IN THE SPECIAL PROVISIONS FOR CLEANING AND PAINTING METAL STRUCTURES.


THE EXTERIOR SURFACES OF THE DRAIN SHALL BE CLEANED AND GIVEN A WASHCOAT PRETREATMENT IN ACCORDANCE WITH STEEL STRUCTURES PAINTING COUNCIL'S SPEC. SSPC-SPI AND SSPC PAINT 27 PRIOR TO PAINTING.

REVISIONS	
NAME	DATE

ILLINOIS DEPARTMENT OF TRANSPORTATION  
OAK PARK AVENUE  
OVER INTERSTATE ROUTE 80  
BRIDGE DECK DRAIN EXTENSION  
DETAIL  
S.N. 016-0927  
SCALE: 50'-1" DRAWN BY CADD  
DATE 11/28/95 CHECKED BY JAF


SECTION	COUNTY	TOTAL SHEETS	SHEET NO.
80	COOK	359	88
STA.	TO STA.		
FED. ROAD DIST. NO.	ALIGNED	FED. AID PROJECT	

11213-825HBK, 1315-821, 1516-822, 1216-823, 1819-824RS-1 & (1516-804HB, 1516-805HB, 1718-807R)

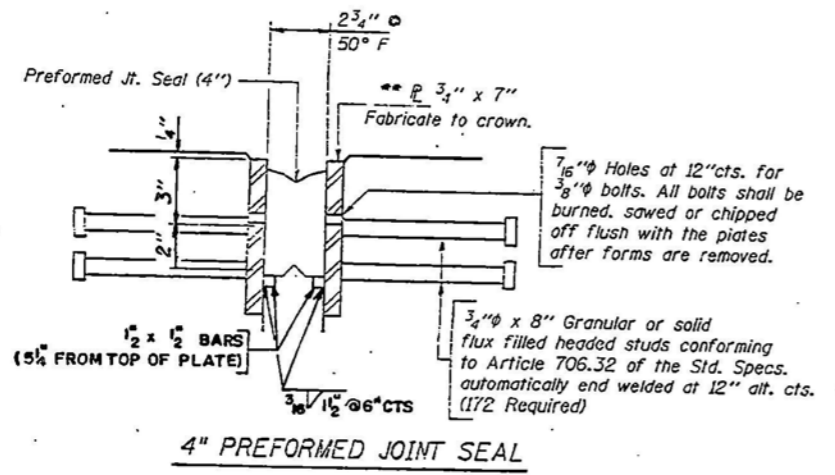


DETAIL "A"


**NOTES:**  
 • Furnish in segments of 20 ft. maximum length. Maximum space between installed segments shall be 3/16". Seal space with Silicone Sealant suitable for Structural Steel.  
 After fabrication all surface of the steel plates shall be given one shop coat of paint specified for structural steel. No field painting required.

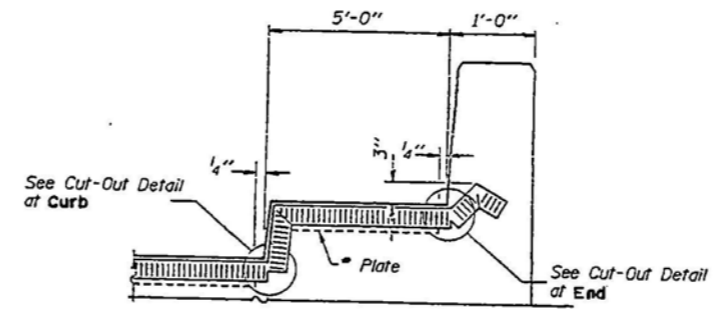


\*Cut retainer bars in sidewalk 6" short of curb face

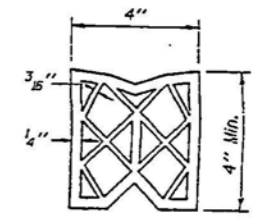

PREFORMED JOINT SEAL (4")

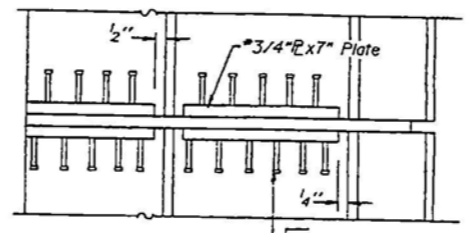

3/4" x 8" Granular or solid flux filled headed studs conforming to Article 706.32 of the Std. Specs. automatically end welded at 12" alt. cts.

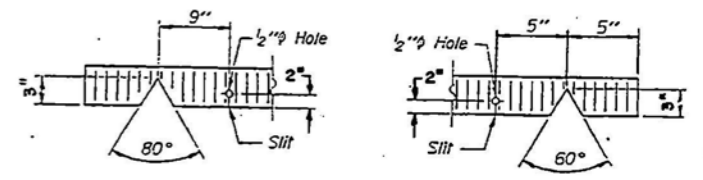


SEAL CUT-OUT DETAIL

REVISIONS	
NAME	DATE

ILLINOIS DEPARTMENT OF TRANSPORTATION  
 OAK PARK AVENUE  
 OVER INTERSTATE ROUTE 80  
 PREFORMED JOINT SEAL DETAIL  
 S.N. 016-0927  
 SCALE: 50'-1"  
 DATE 11/28/95  
 DRAWN BY CADD  
 CHECKED BY JAF

SECTION	COUNTY	TOTAL SHEETS	SHEET NO.
80	COOK	359	89
STA. TO STA.		FED. PROJ. NO.	

11213-825HBK, 1315-82L, 1516-822, 1216-823, 1819-824RS-1 & 1516-804HB, 1516-805HB, 1718-807R

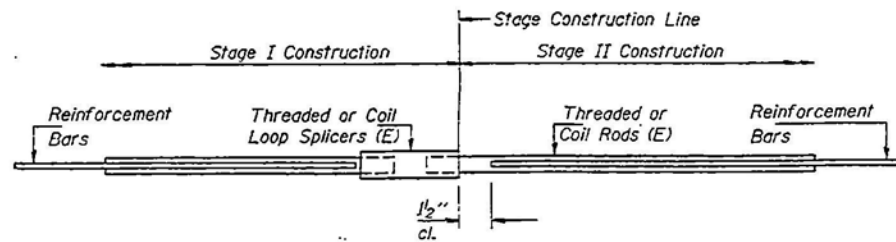

SPLICER DETAIL

Bar Size	No. Req'd. (Splicers)	Location
#6	10	N. Abut. Tr. Exp. Jt.
#5	6	N. Abut. Tr. Exp. Jt.
#6	10	S. Abut. Tr. Exp. Jt.
#5	6	S. Abut. Tr. Exp. Jt.


The diameter of this part of Splicer is the same as the diameter of the bar spliced.

ROLLED THREAD DOWEL BAR



ONE PIECE


Wire Connector

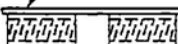

WELDED SECTIONS

SPLICER ALTERNATIVES

Heavy Hex Nuts conforming to ASTM A 563, Grade C, D or DH may be used.

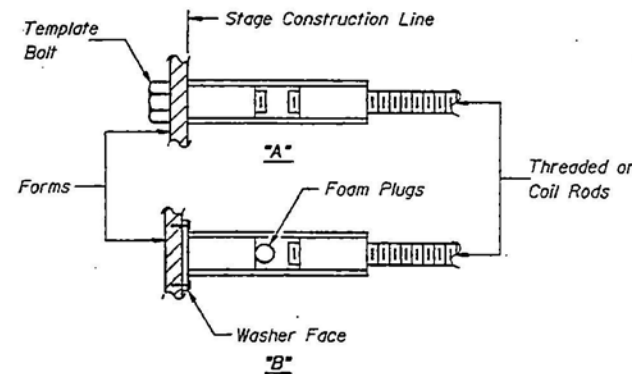

INSTALLATION AND SETTING METHODS

"A": Set splicer by means of a template bolt.  
 "B": Set splicer by nailing to wood forms or cementing to steel forms.  
 (E): Indicates epoxy coating.

NOTES

Steel Splicer (Coupler) assembly shall be of an approved type and shall develop in tension at least 125 percent of the yield strength of the lapped reinforcement bars.  
 Steel Splicer rods shall be of minimum 60 ksi yield strength, threaded or coiled full length. All reinforcement bars shall be lapped and tied to the splicer rods.  
 Splicer (coupler) assembly shall be epoxy coated in accordance with the requirements for reinforcement bars.  
 Other systems of similar design may be submitted to the Engineer for approval. Approval shall be based on certified test results from an approved testing laboratory that the proposed splicer (coupler) assembly satisfies the following requirements:

- Minimum Capacity (Tension in kips) =  $1.25 \times f_y \times A_t$
- Minimum Pull-out Strength (Tension in kips) =  $1.25 \times f_{s_{allow}} \times A_t$

Where  $f_y$  = Yield strength of lapped reinforcement bars in ksi.  
 $f_{s_{allow}}$  = Allowable tensile stress in lapped reinforcement bars in ksi (Service Load)  
 $A_t$  = Tensile stress area of lapped reinforcement bars.  
 \* = 28 day concrete

Typical Splicer (Coupler) Assembly Sizes:

#5 bar lap with 3/4" Splicer (Coupler) x 2'-0" Splicer Rods	Minimum Capacity = 23.0 kips-tension Minimum Pull-out Strength = 9.2 kips-tension
#6 bar lap with 7/8" Splicer (Coupler) x 2'-7" Splicer Rods	Minimum Capacity = 33.1 kips-tension Minimum Pull-out Strength = 13.3 kips-tension
#7 bar lap with 1" Splicer (Coupler) x 3'-5" Splicer Rods	Minimum Capacity = 45.1 kips-tension Minimum Pull-out Strength = 18.0 kips-tension
#8 bar lap with 1 1/4" Splicer (Coupler) x 4'-6" Splicer Rods	Minimum Capacity = 58.9 kips-tension Minimum Pull-out Strength = 23.6 kips-tension

Bar splicer assemblies shall be in accordance with Section 508 of the Standard Specifications, except as noted. The furnishing and installation of bar splicer assemblies will be measured and paid for at the contract unit price each for "BAR SPLICERS."

REVISIONS	
NAME	DATE


ILLINOIS DEPARTMENT OF TRANSPORTATION  
 OAK PARK AVENUE  
 OVER INTERSTATE ROUTE 80  
 BAR SPLICER (COUPLER) DETAILS

S.N. 016-0927

SCALE: NONE DRAWN BY CAD  
 DATE: 11/28/95 CHECKED BY JAF


DATE	DESIGNER	CHECKER	DATE	SCALE
80	COOK	359	90	
STA.		TO STA.		
FILE NO. & PROJ. NO.		FILE NO. & PROJ. NO.		

11213-825HBK, 1315-821, 1516-822, 1216-823, 1819-824RS-1 & (1516-804HB, 1516-805HB, 1718-807R)

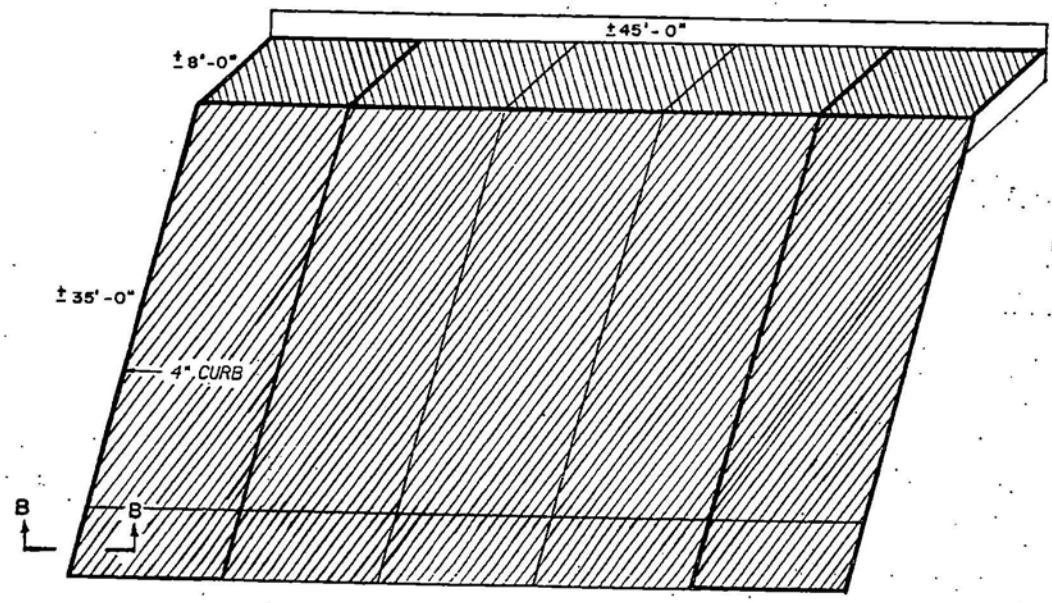

EXISTING EASTBOUND SLOPE WALL

AREA TO BE REMOVED

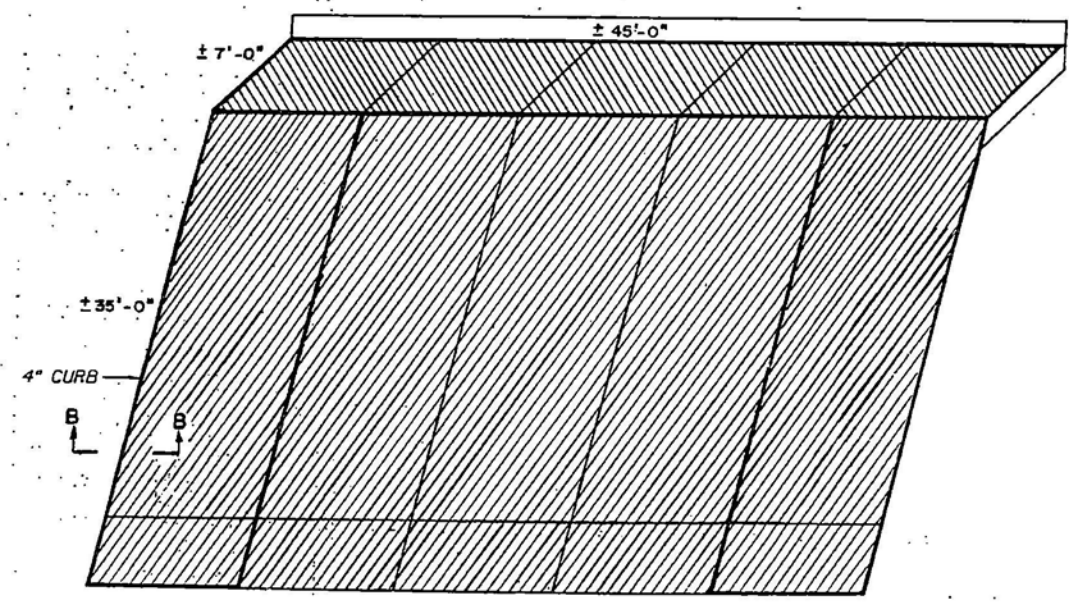


EXISTING WESTBOUND SLOPE WALL

AREA TO BE REMOVED

NOTES:


\* The space between the slope wall and pier shall be filled with Two inch bituminous joint filler. The preformed joint filler shall be in accordance with the requirements of article 751.03 of the Standard Specifications. Seal the top 1/4" with hot poured joint sealer as per article 750.02 of the Standard Specifications. This work shall be considered incidental to the pay item "Slope Wall 4".

SLOPE WALL SHALL BE REINFORCED WITH WELDED WIRE FABRIC 6"x6" - W4.0 x 4.0 WEIGHING 58 LBS PER 100 SQ. FT.

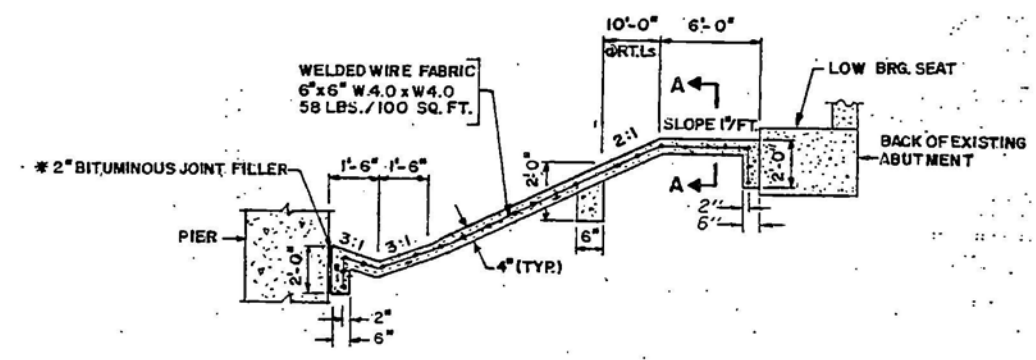


SECTION THRU PROPOSED SLOPE WALL

SEE SHEET S1 OF S17 FOR THE LOCATION AND LIMITS OF THE PROPOSED SLOPE WALL

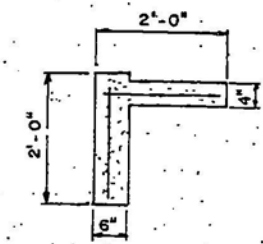

SECTION B-B  
EXISTING SLOPE WALL

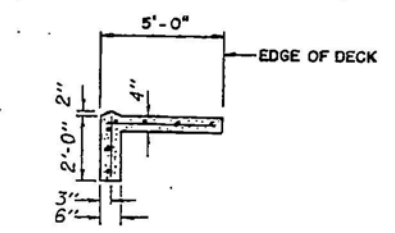

SECTION A-A

BILL OF MATERIAL

Item	Unit	Quantity
Slope Wall Removal	Sq. Yd.	425
Slope Wall 4"	Sq. Yd.	474

REVISIONS	
NAME	DATE

ILLINOIS DEPARTMENT OF TRANSPORTATION  
OAK PARK AVENUE  
OVER INTERSTATE ROUTE 80  
SLOPE WALL DETAIL  
S.N. 016-0927

SCALE: NONE  
DATE



DRAWN BY JAF  
CHECKED BY MVT

P. & S. NO.	SECTION	COUNTY	TOTAL SHEETS	SHEET NO.
80		COOK	359	91
STA.		TO STA.		
FED. ROAD DIST. NO.	BLKNO.	FED. AID PROJECT		

\*1213-825HBK, 1315-821, 1516-822, 1216-823, 1819-824IRS-1 & (1516-804HB, 1516-805HB, 1718-807IR

The Illinois Coil-Lock Anchor Bolt is a proprietary item which is the property of the Illinois Department of Transportation. Use, reproduction or disclosure without express written permission is prohibited and protected under Federal copyright laws. The production and the fabrication of this bolt for use on highway projects in the State of Illinois shall be permitted and there shall be no incurred charges or fees to the manufacturer or the fabricator for producing or fabricating this bolt.

D	E	H	K	"d"
1"	1 1/8"	1 1/16"	1 3/4"	1/4"
1 1/4"	1 3/8"	1 1/8"	2"	3/8"
1 1/2"	1 5/8"	1 5/16"	2 1/8"	1/2"
2"	2 1/8"	1 13/16"	2 7/8"	1/2"
2 1/2"	2 5/8"	2 5/16"	3 3/8"	1"

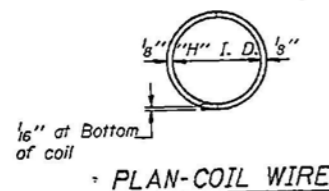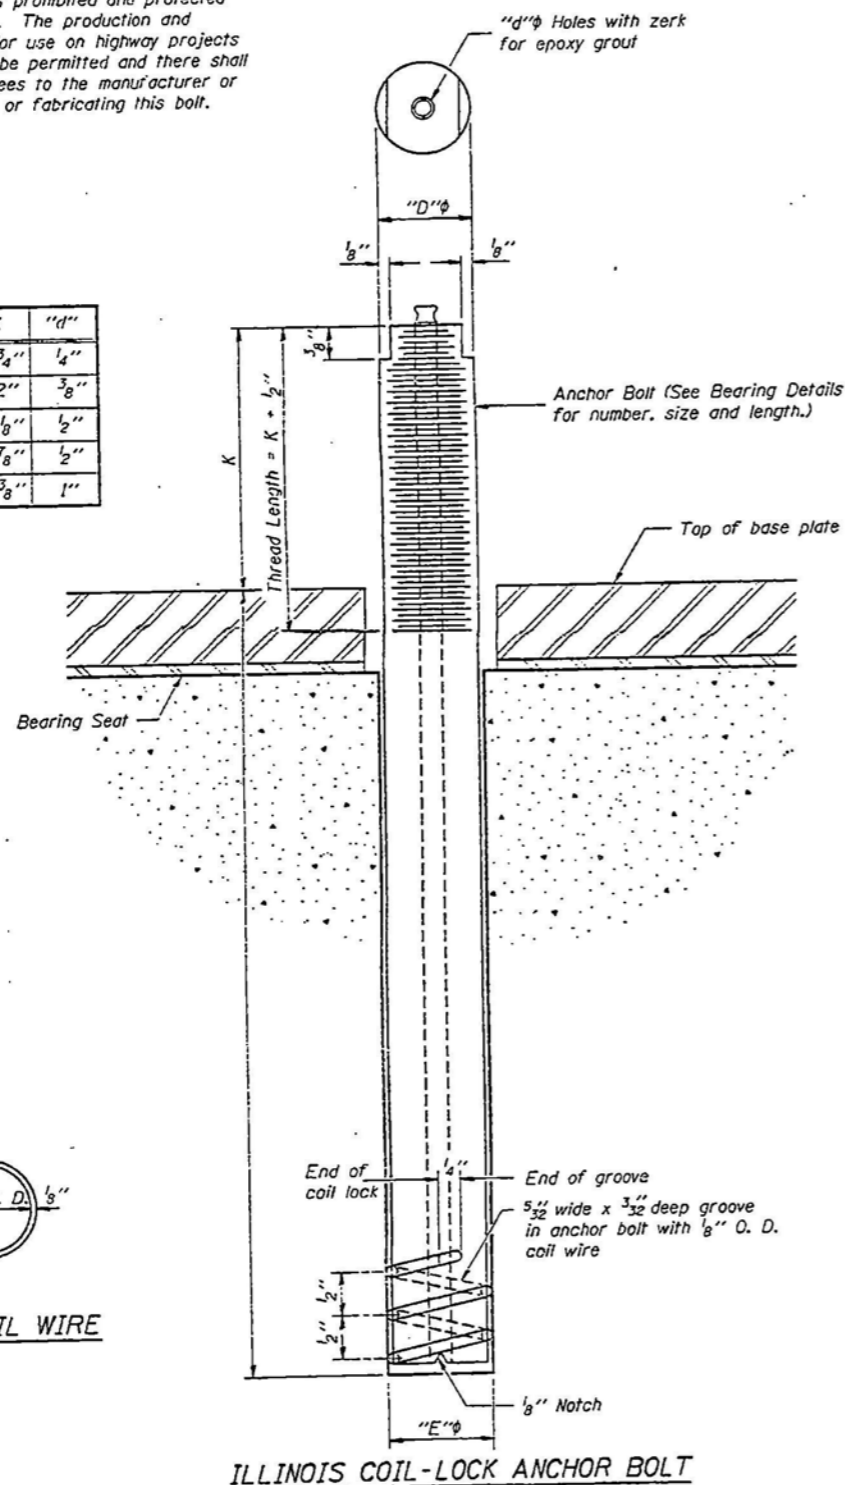

**MATERIALS FOR ILLINOIS COIL-LOCK ANCHOR BOLT**

The anchor bolt shall be fabricated from cold drawn or hot finished seamless carbon steel mechanical tubing conforming to ASTM A519, Grade 1026 and supplied with hexagonal nuts and cut washers.  
 The coil wire shall be made of any suitable soft steel wire.  
 The finished anchor bolt shall be cleaned of rust and other foreign materials and wrapped or packaged to prevent contamination until they are installed.  
 The epoxy grout shall be a two-component, epoxy resin bonding system conforming to ASTM C881, Type I, Grade I and of a Class suitable for the temperature at installation.

**INSTALLATION PROCEDURE for the ILLINOIS COIL-LOCK ANCHOR BOLT**

1. With the coil wire in place, the bolt shall be inserted into the hole and turned clockwise to a snug fit in the hole. Nut and washer shall be placed on the bolt. The nut shall be tensioned until the steel base plates are held securely to the concrete bearing seat.
2. Epoxy grout shall be pumped through the zerk fitting with a pressure gun. Pumping shall continue until the epoxy overflows the hole around the bolt shank. After pumping is discontinued, excess epoxy shall be immediately wiped off.

**ALTERNATE ANCHOR BOLTS**

The Contractor may use, at his option, the capsule or the adhesive cartridge type anchor rods that have been previously tested and given a prior approval by the Department. The Contractor shall install these anchor rods in pre-drilled holes in accordance with the manufacturer's recommendations and procedures.  
 The capsule or the adhesive cartridge type anchor rods shall be a two part system composed of:  
 1. A threaded rod stud with nut and washer conforming to ASTM A307.  
 2. A sealed glass capsule or a sealed glass adhesive cartridge containing premeasured amounts of the adhesive chemical.

**GENERAL NOTES**

Holes in the masonry for anchor bolts shall be drilled through the base plates to the diameter and depth shown or in accordance with the manufacturer's recommendation after beams or girders have been erected and adjusted.  
 Prior to setting the bolts, the holes shall be dry and all dust and loose particles shall be removed by the use of compressed air or vacuuming.  
 The anchor bolts, furnished and installed and including the epoxy grout or capsules shall not be paid for separately but shall be included in the unit bid price for "Furnishing and Erecting Structural Steel".

REVISIONS	
NAME	DATE

ILLINOIS DEPARTMENT OF TRANSPORTATION  
 OAK PARK AVENUE  
 OVER INTERSTATE ROUTE 80  
 ANCHOR BOLT DETAILS  
 FOR BEARINGS  
 S.N. 016-0927  
 SCALE: NONE  
 DATE: 11/28/95  
 DRAWN BY: CADD  
 CHECKED BY: JAF

Tue Nov 28 10:45:41 1995  
 /usr/25-cjoc1/struct1/dll7393b4.smp LV1-63

**STATE OF ILLINOIS**  
**DEPARTMENT OF PUBLIC WORKS AND BUILDINGS**  
**DIVISION OF HIGHWAYS**  
**PLANS FOR PROPOSED**  
**FEDERAL AID HIGHWAY**

FEDERAL AID	SEC.	COUNTY	TOTAL SHEETS	SHEET NO.
F.A.I. 80	1313-811 HB	COOK	44	1
FED. ROAD DIST. NO. 7 ILLINOIS		PROJECT 1-80-4(77)150		

P-91-110-00

**SCALES**  
 PLAN 1 INCH  
 PROFILE HOR. 1 INCH  
 PROFILE VERT. 1 INCH  
 CROSS-SECTIONS 1 INCH  
 CROSS-SECTIONS 1 INCH  
 VERT. HOR.

INDEX OF SHEETS ON SHEET No. 3


F.A.I. ROUTE 80 SECTION 1313-811 HB  
 COOK COUNTY PROJECT 1-80-4(77)150  
**OAK PARK AVENUE**  
 C-90-512-65



LOCATION OF SECTION INDICATED THUS: —

FILE COPY  
 # 38  
 7-1-66 ✓

HIGHWAY CLASSIFICATION  
 F.A.I. ROUTE 80 8100-T-60  
 OAK PARK AVE. 1000-T-45

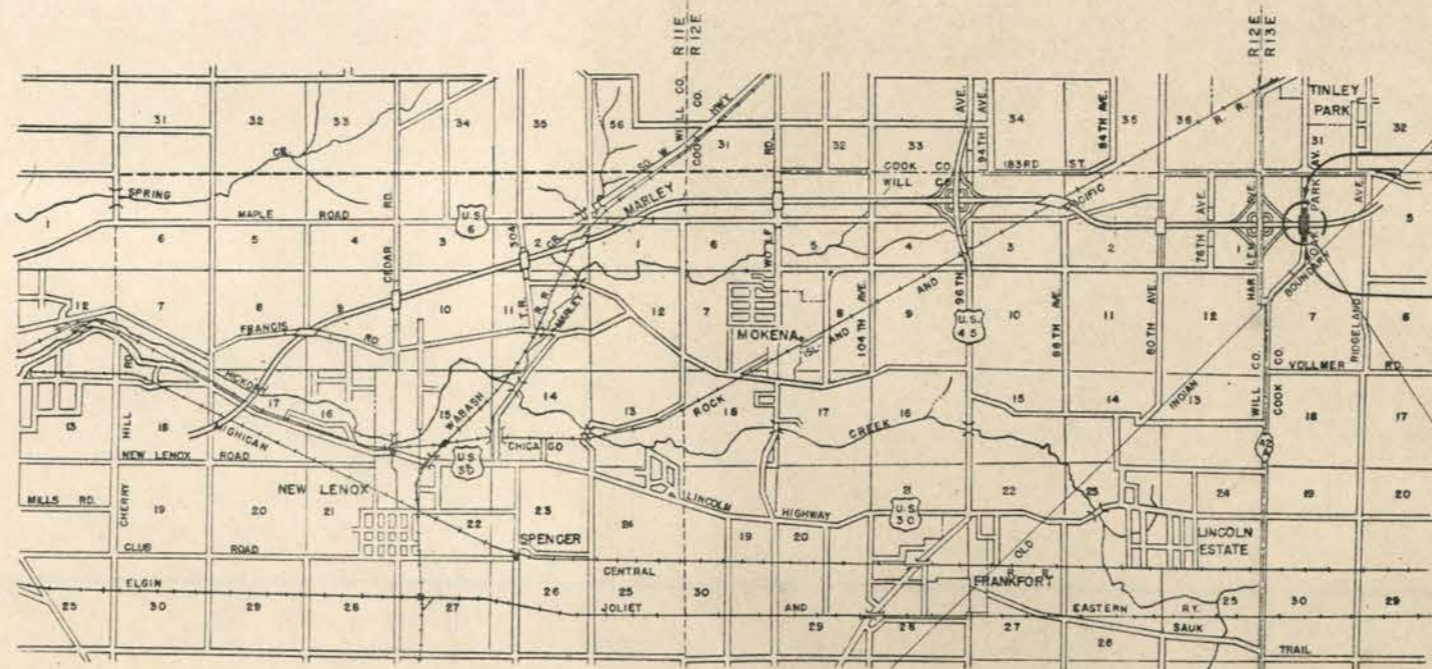

OAK PARK AVE.  
 BEGIN CONSTRUCTION  
 STA. 40 + 65

OAK PARK AVE.  
 END CONSTRUCTION  
 STA. 58 + 75

PROJECT 1-80-4(77)150, SECTION 1313-811 HB  
 INCLUDES A 4-SPAN WF-BEAM GRADE  
 SEPARATION STRUCTURE (CARRYING OAK PARK  
 AVENUE OVER F.A.I. ROUTE 80) SPANS 2 AT  
 40'-6", 1 AT 67'-6" AND 1 AT 73'-9" ON R.C. OPEN  
 PIERS AND CONCRETE PILE BENT ABUTMENTS  
 AT STATION 1313+37.93. ALSO INCLUDES  
 CONCRETE PAVED APPROACHES.

APPROVED  
 FOR STRUCTURAL APPROVAL ONLY

*Carl E. Hansen*  
 REGISTERED STRUCTURAL ENGINEER

STATE OF ILLINOIS  
 DEPARTMENT OF PUBLIC WORKS AND BUILDINGS  
 DIVISION OF HIGHWAYS

SUBMITTED APRIL 15, 1966  
*C.A. Bernow*  
 DISTRICT ENGINEER

EXAMINED May 6, 1966  
*C.W. Cole & Son*  
 ENGINEER OF ROAD PLANS & CONTRACTS

PASSED May 6, 1966  
*[Signature]*  
 ENGINEER OF DESIGN

APPROVED May 6, 1966  
*[Signature]*  
 CHIEF HIGHWAY ENGINEER

APPROVED May 6, 1966  
*Francis E. Hansen*  
 DIRECTOR

0-70

NET LENGTH OF IMPROVEMENT = 1810 L.F. = 0.343 Miles  
 NET LENGTH OF PROJECT = 000 L.F. = 0.000 Miles

SCALE: 1" = 5000'

PREPARED BY: *Henry M. Hamaker*  
 DISTRICT DESIGN ENGINEER  
 EXAMINED BY: *Francis E. Hansen*  
 ASS'T DIST. ENGR. ENGINEERING  
 ENTIRE SECTION INSPECTED  
 AND APPROVED AS TO POLICY  
 BY: *C.A. Bernow*  
 DISTRICT ENGINEER

CONTRACT NO. 24617

THESE PLANS PREPARED  
 BY  
**Chas. W. Cole & Son**  
 Engineers & Architects  
 South Bend, Indiana

DEPARTMENT OF COMMERCE  
 BUREAU OF PUBLIC ROADS

APPROVED \_\_\_\_\_  
 DIVISION ENGINEER




DATE \_\_\_\_\_

*Francis E. Hansen*  
 REGISTERED STRUCTURAL ENGINEER STATE OF ILLINOIS NO. 01-2547

STATE OF ILLINOIS  
DEPARTMENT OF PUBLIC WORKS & BUILDINGS  
DIVISION OF HIGHWAYS

Note: Hatched Area behind Abutment Parapet to be placed after Abutment is in place.

ROUTE NO.	SECTION	COUNTY	TOTAL SHEETS	SHEET NO.
F.A.I. 80	811-HB	COOK	44	10
FED. ROAD DIST. NO. 7			ILLINOIS	FED. AID PROJECT: 2-80-4(77)150

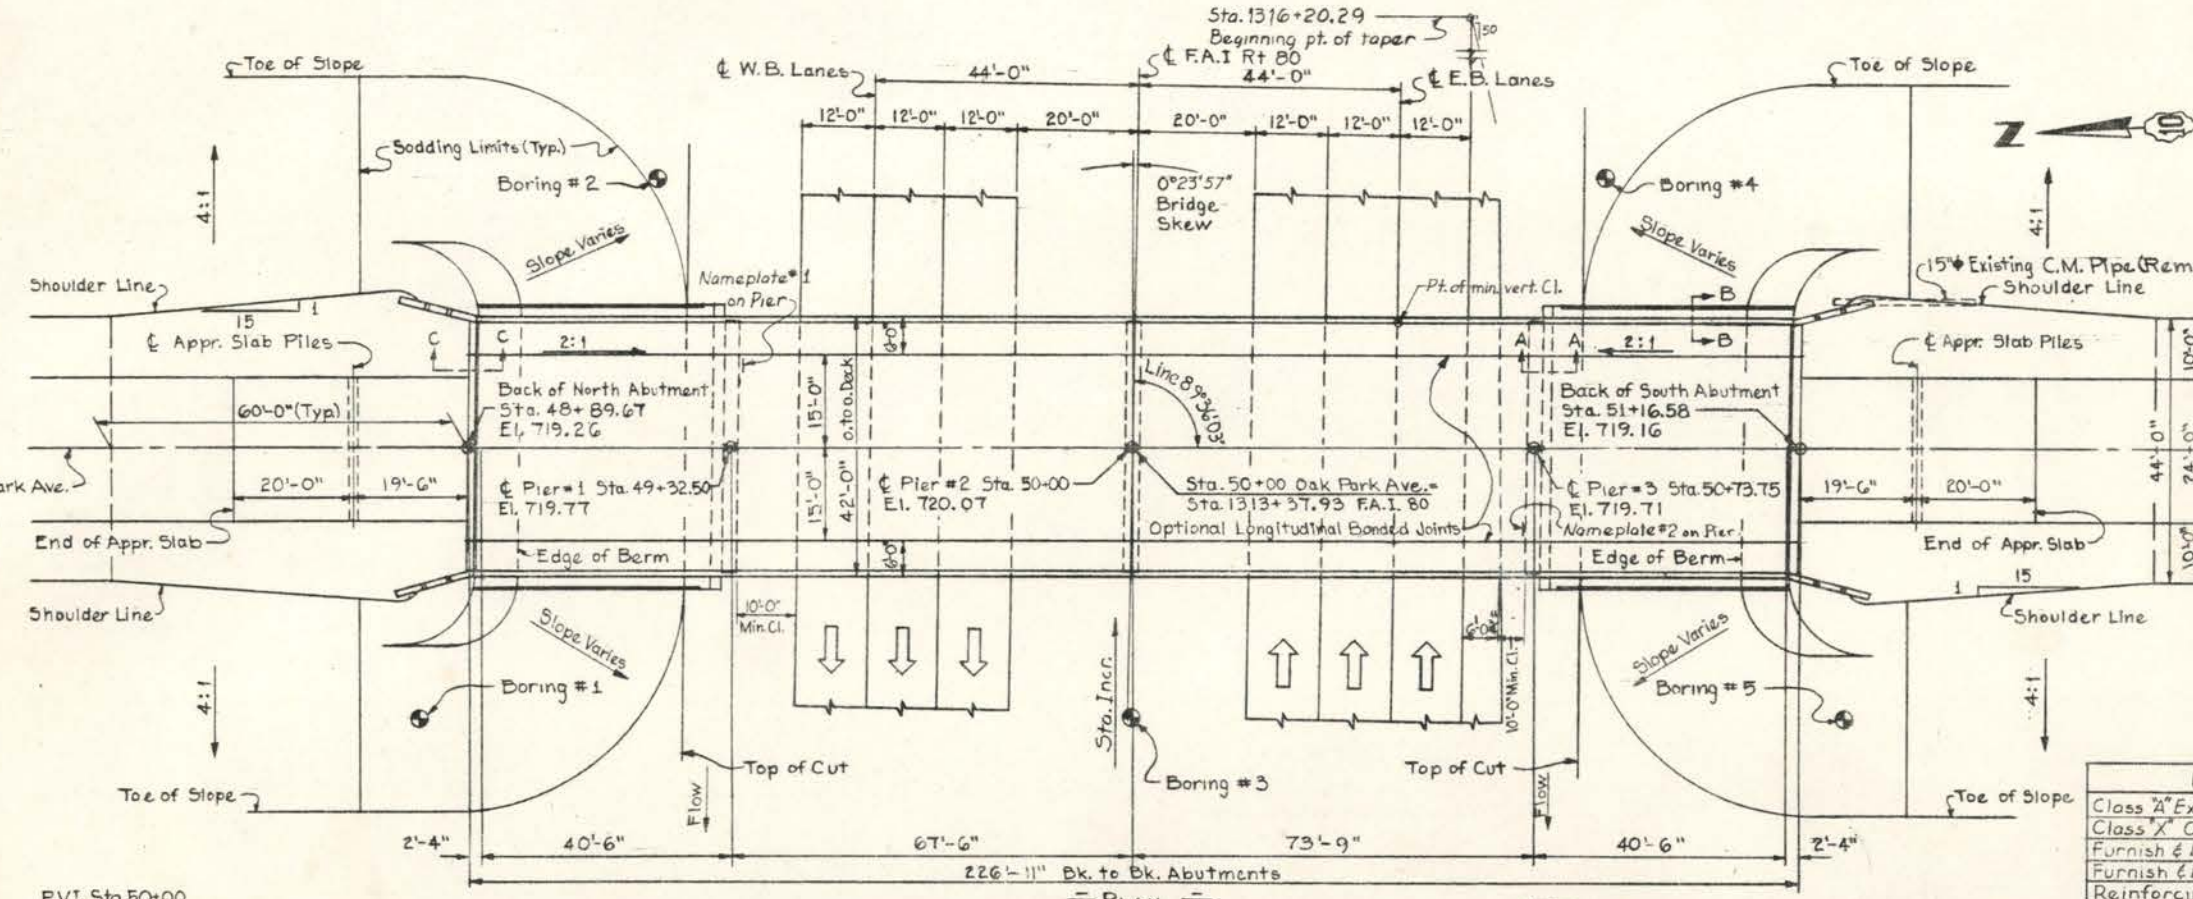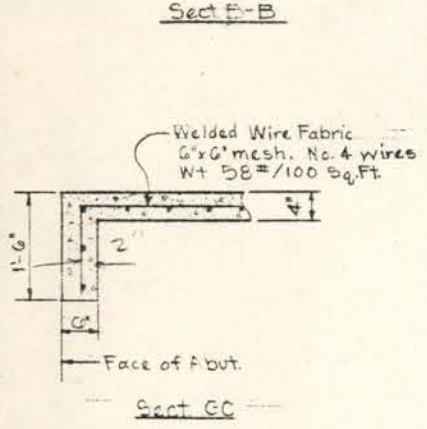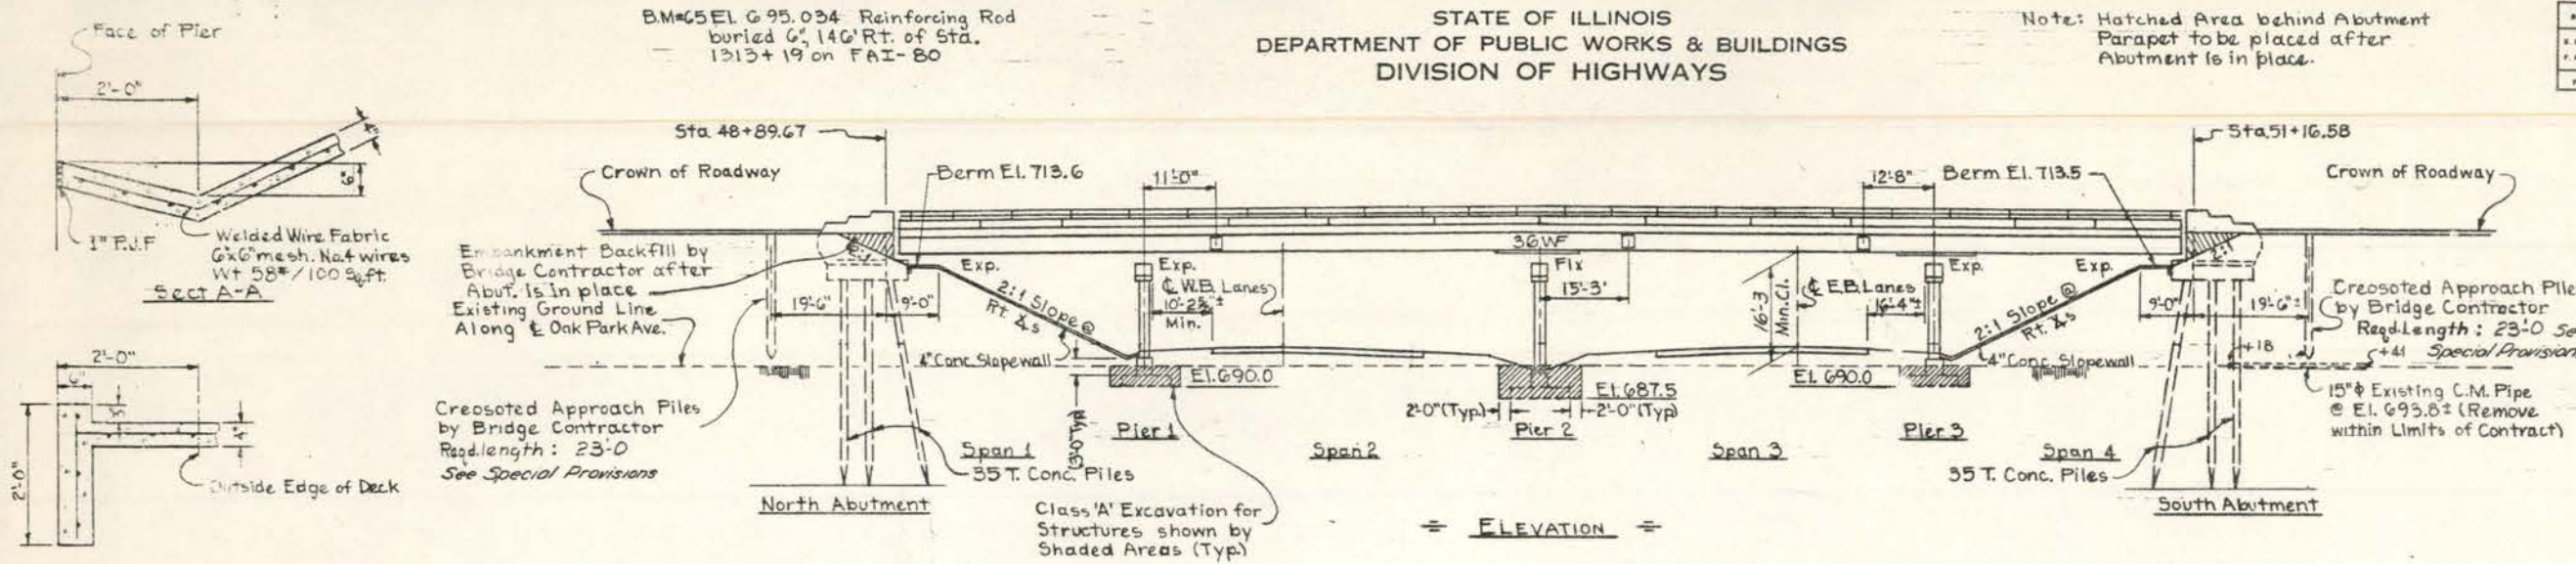

**Design Stresses**  
 $f_c = 1400$  psi.  
 $V_{f_{top}} = 75$  p.s.i.  
 $f_s = 20,000$  p.s.i. Reinforcing Steel  
 $f_s = 20,000$  p.s.i. Structural Steel (A56)  
 $n = 10$   
 Loading: A.A.S.H.O. HS 20-44  
 Allow. live load defl. =  $\frac{1}{1000}$  (non-composite)

**Foundation**  
 Abutments: 35 T. Conc. Piles  
 Piers: Max. Allowable Soil Pressure = 25T/5F  
 Approx. Length of Piles = 50' @ Abutments

**Approach Pile Data**  
 Creosoted Timber Piles  
 Capacity - 15 Tons  
 Estimated Lengths - 25 Feet  
 Number Req'd - 12


**SHEET INDEX TO BRIDGE PLANS**

SHEET NO.	ITEM
10	Gen. Plan & Elev.
11	Boring Data
12 & 13	Superstructure Details
14 & 15	Structural Steel Details
16	Screeed Data
17	Handrail Details
18	North & South Abutments
19	Piers 1 & 3
20	Pier 2
21	Pile Details
22 & 23	Handrail Details
24	Nameplate Details

**STRUCTURAL QUANTITIES**


ITEM	UNIT	SUPER	SUB.	TOTAL
Class 'A' Excavation for structures	Cu.yd.		300	300
Class 'X' Concrete	Cu.yd.	290.8	266.9	557.7
Furnish & Erect Str. steel	Lb.	250,700		250,700
Furnish & Erect Handrail	Lin. Ft.	447.33		447.33
Reinforcing Bars	Lb.	73,350	44,260	117,610
Furnish Conc. Piles	Lin. Ft.		850	850
Driving Conc. Piles	Lin. Ft.		850	850
Test Piles (conc.)	Each		1	1
Furnishing Creosoted Piles	Lin. Ft.			276
Driving Timber Piles	Lin. Ft.			276
Name Plates	Each		2	2
Slopewall	Sq. yd.			498
Sodding	Sq. yd.			1949
Protective Coat	Sq. Yd.	1054		1054
Bridge Seat Sealant *	L.S.		1	1

\* Abutments Only

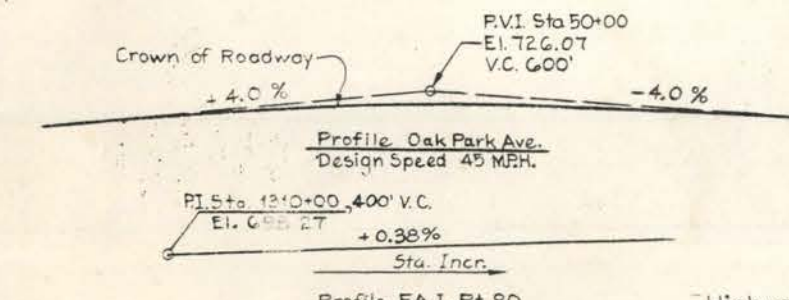

**Highway Classification**

Rtz	D.H.V.	A.D.T.	Class	M.P.H.
42A	1000	8000	B-3	45
	(1985)	(1985)		

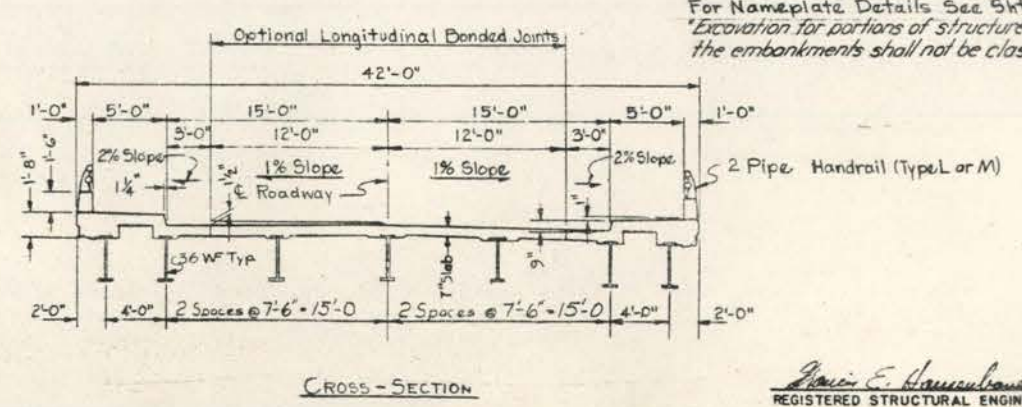

Note: Excavation for Slope Wall shall be considered incidental to the cost of the Slope Wall. For Nameplate Details See Sht. 24. Excavation for portions of structures in the embankments shall not be classified.


GENERAL PLAN & ELEVATION  
OAK PARK AVENUE OVER  
F.A.I. RT. 80 SEC. 1313-811 HB  
PROJECT I-80-4(77)150  
COOK COUNTY - STA. 1313+3793

REGISTERED STRUCTURAL ENGINEER STATE OF ILLINOIS NO. 81-2547


STATE OF ILLINOIS  
DEPARTMENT OF PUBLIC WORKS & BUILDINGS  
DIVISION OF HIGHWAYS

ROUTE NO.	SECTION	COUNTY	TOTAL SHEETS	SHEET NO.
80	113-HB	COOK	44	11
F.A.Z.		ILLINOIS		FED. AID PROJECT.


BORING No. 1

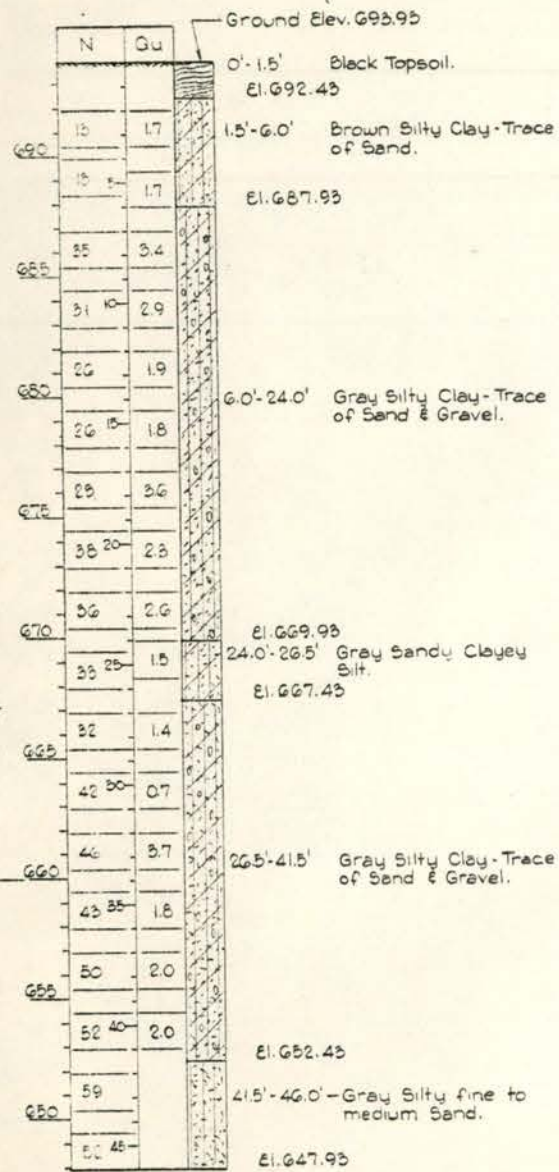


BORING No. 2

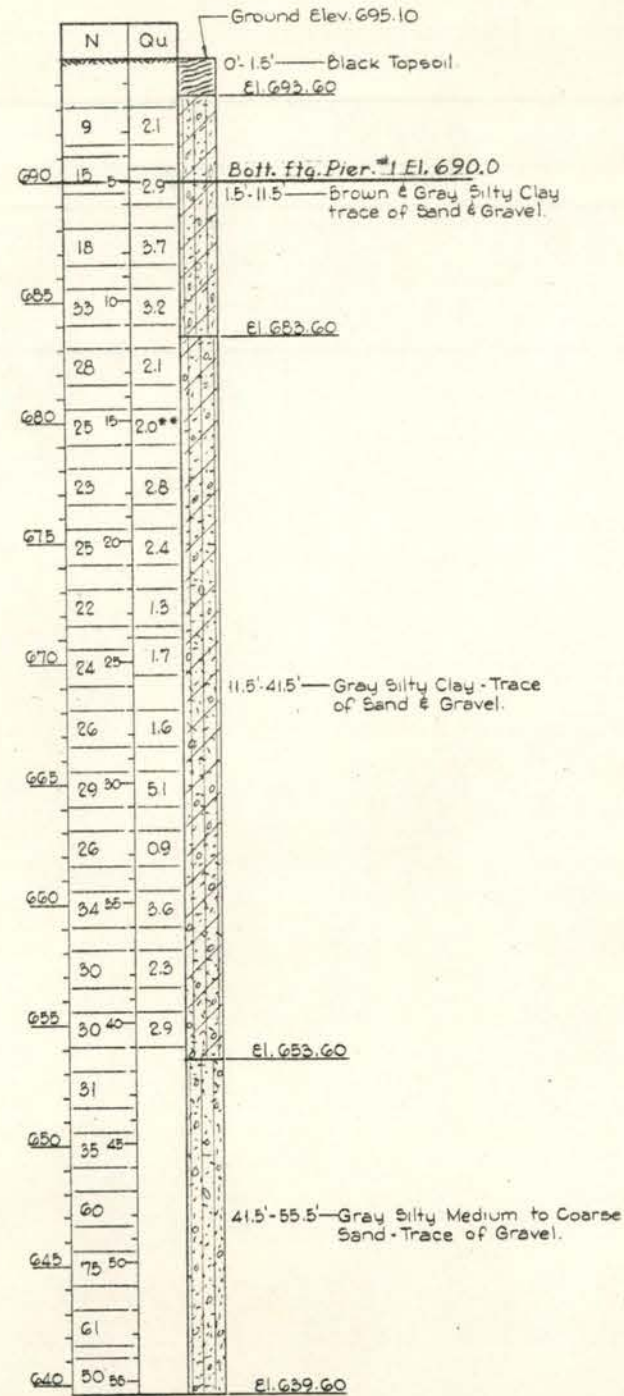


BORING No. 3

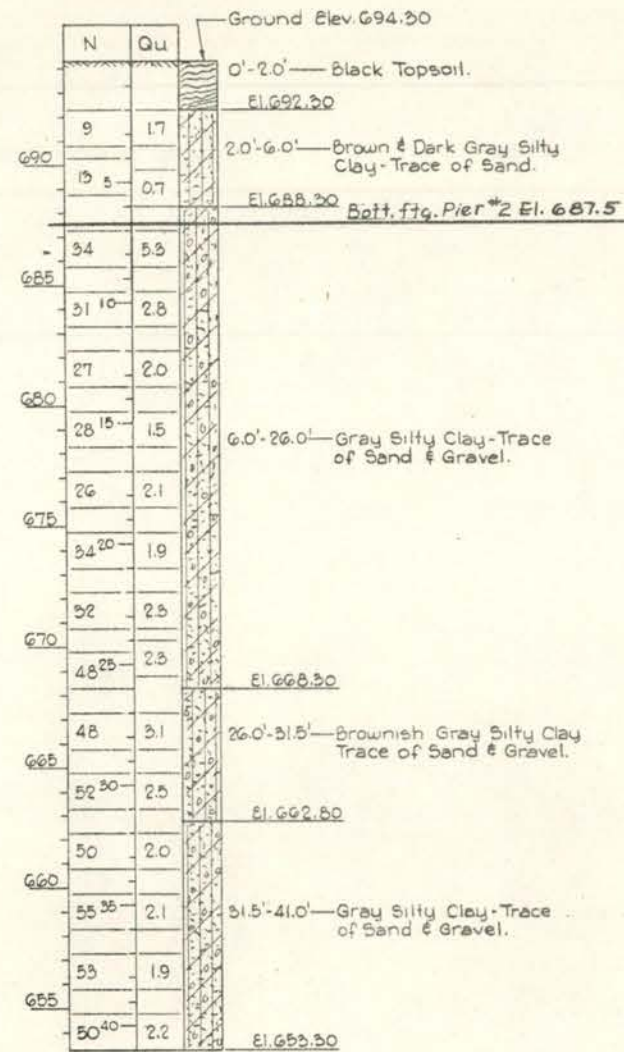

BORING No. 4

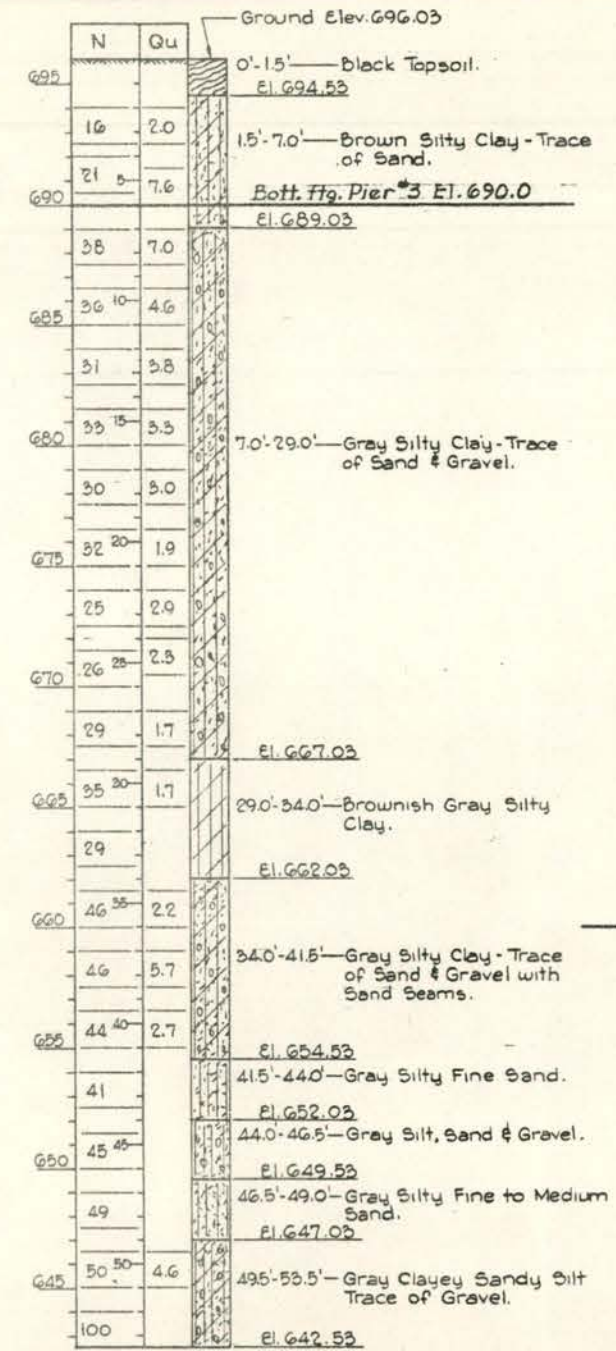

BORING No. 5

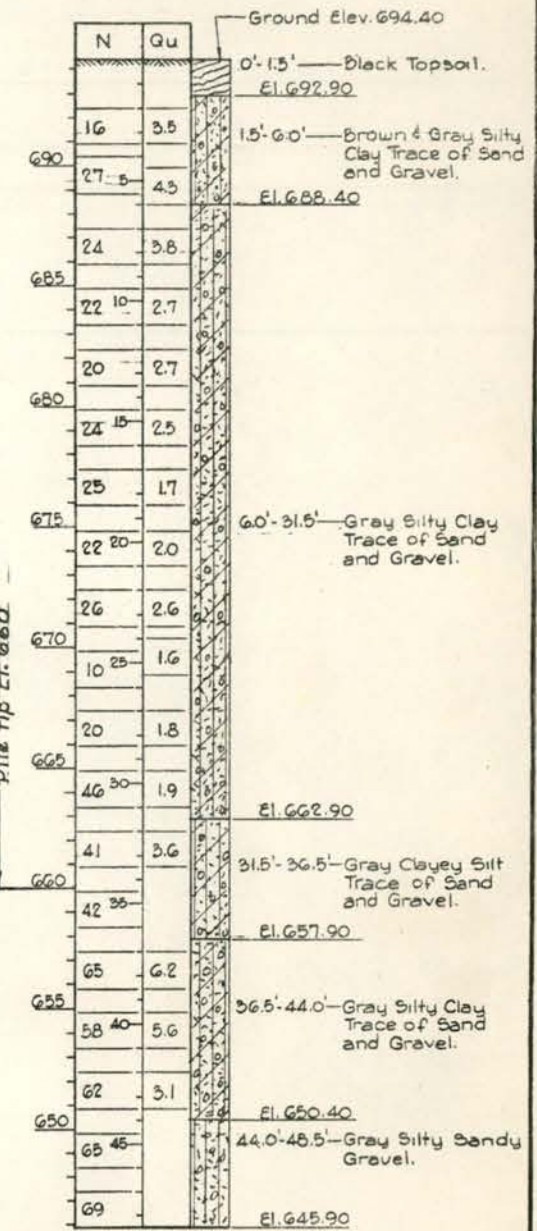






NOTE:-

N = Blows per foot of penetration of Sampling spoon.  
Hammer weight = 140 Lb., drop = 30 inches.  
Qu = Unconfined compressive strength in tons per square foot.  
See Art. 2.3 of Specifications regarding Test Pit Data.  
\*\* Based on pocket penetrometer measurements, maximum range of penetrometer = 4.5

BORING DATA

STATE OF ILLINOIS  
DEPARTMENT OF PUBLIC WORKS & BUILDINGS  
DIVISION OF HIGHWAYS

ROUTE NO.	SECTION	COUNTY	TOTAL SHEETS	SHEET NO.	SHEET NO.
S.A.Z. 80	B11-HB	COOK	44	12	
FED. ROAD DIST. NO. 7	ILLINOIS	FED. AID PROJECT			

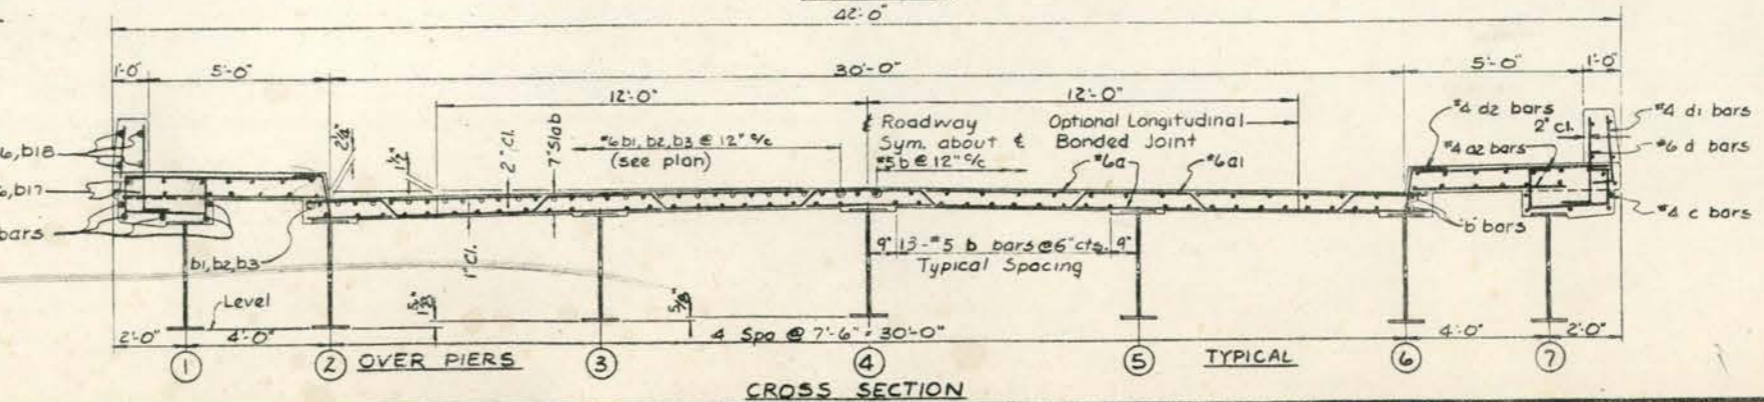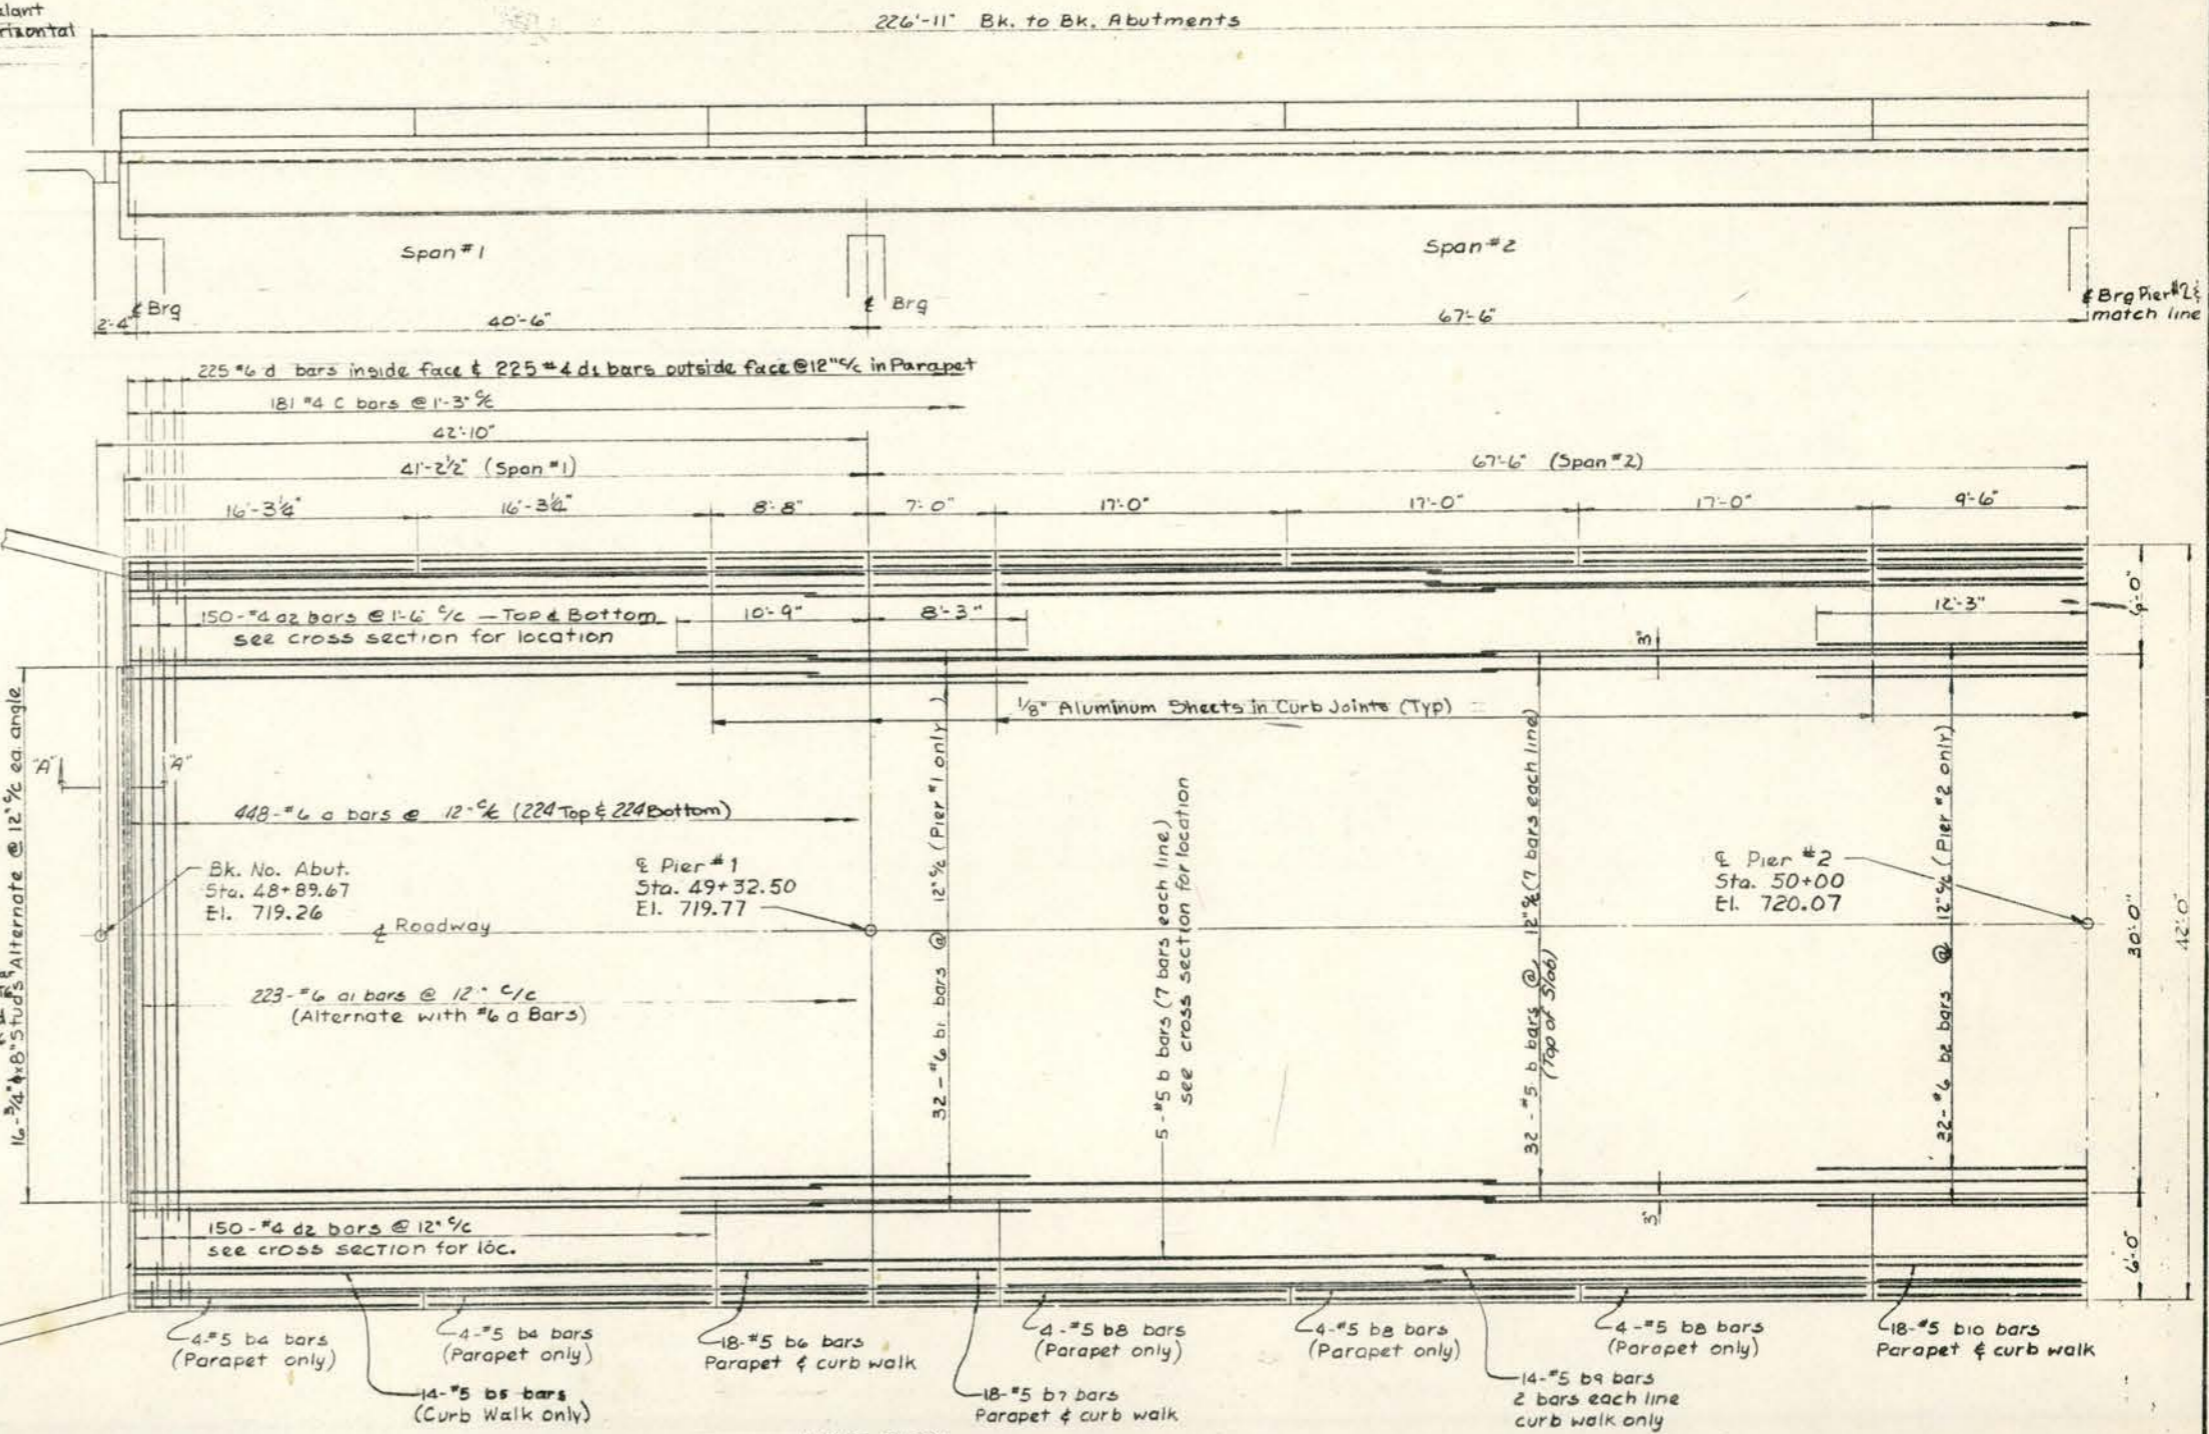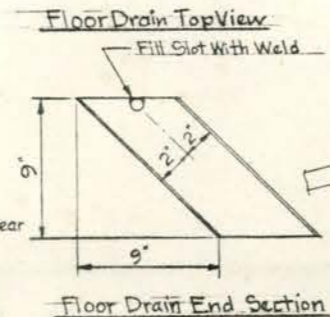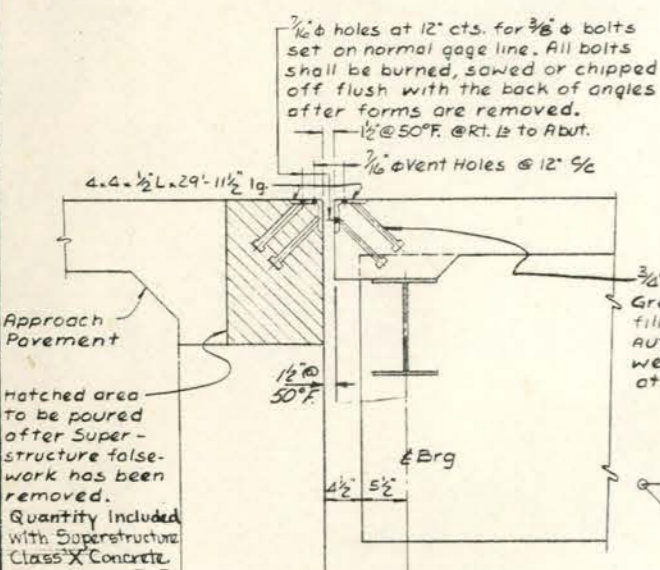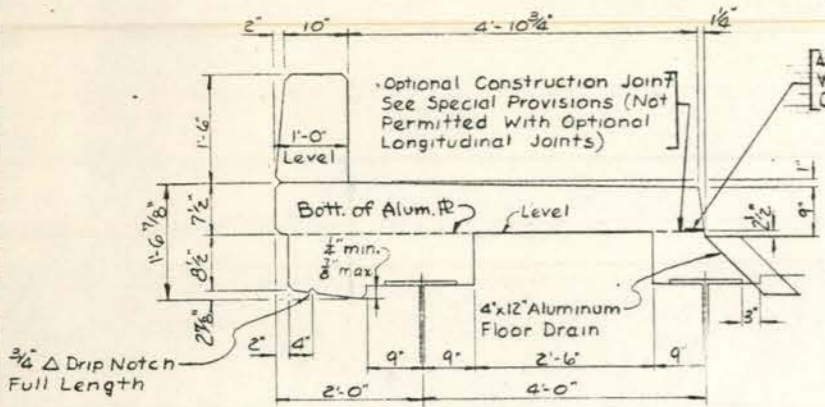


Note:  
Minimum lap for all reinforcement bars shall be 20 bar diameters

SUPERSTRUCTURE DETAILS  
OAK PARK AVENUE OVER  
FAI RT. 60 SEC. 1313-811HB  
COOK COUNTY - STA. 1313+37.93



STATE OF ILLINOIS  
DEPARTMENT OF PUBLIC WORKS & BUILDINGS  
DIVISION OF HIGHWAYS

ROUTE NO.	SECTION	COUNTY	TOTAL SHEETS	SHEET NO.	SHEET NO.
80	1313-HB	COOK	44	13	
FED. ROAD DIST. NO. 7	ILLINOIS	FED. AID PROJECT			

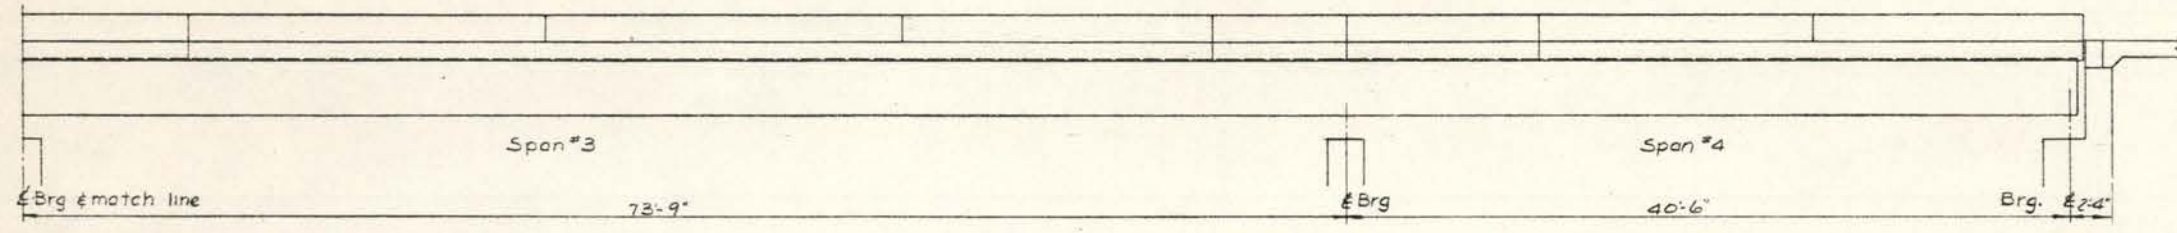


HALF ELEVATION

METHOD OF DETERMINING FILLET HEIGHT "f"  
After all structural steel has been erected, elevations of the top flanges of the beams shall be taken at the stations shown on sheet 16. These elevations subtracted from the "Theoretical Grade Elevations Adjusted for Dead Load Deflection" shown on sheet 15, minus floor thickness equals the fillet heights above top flange of beams.

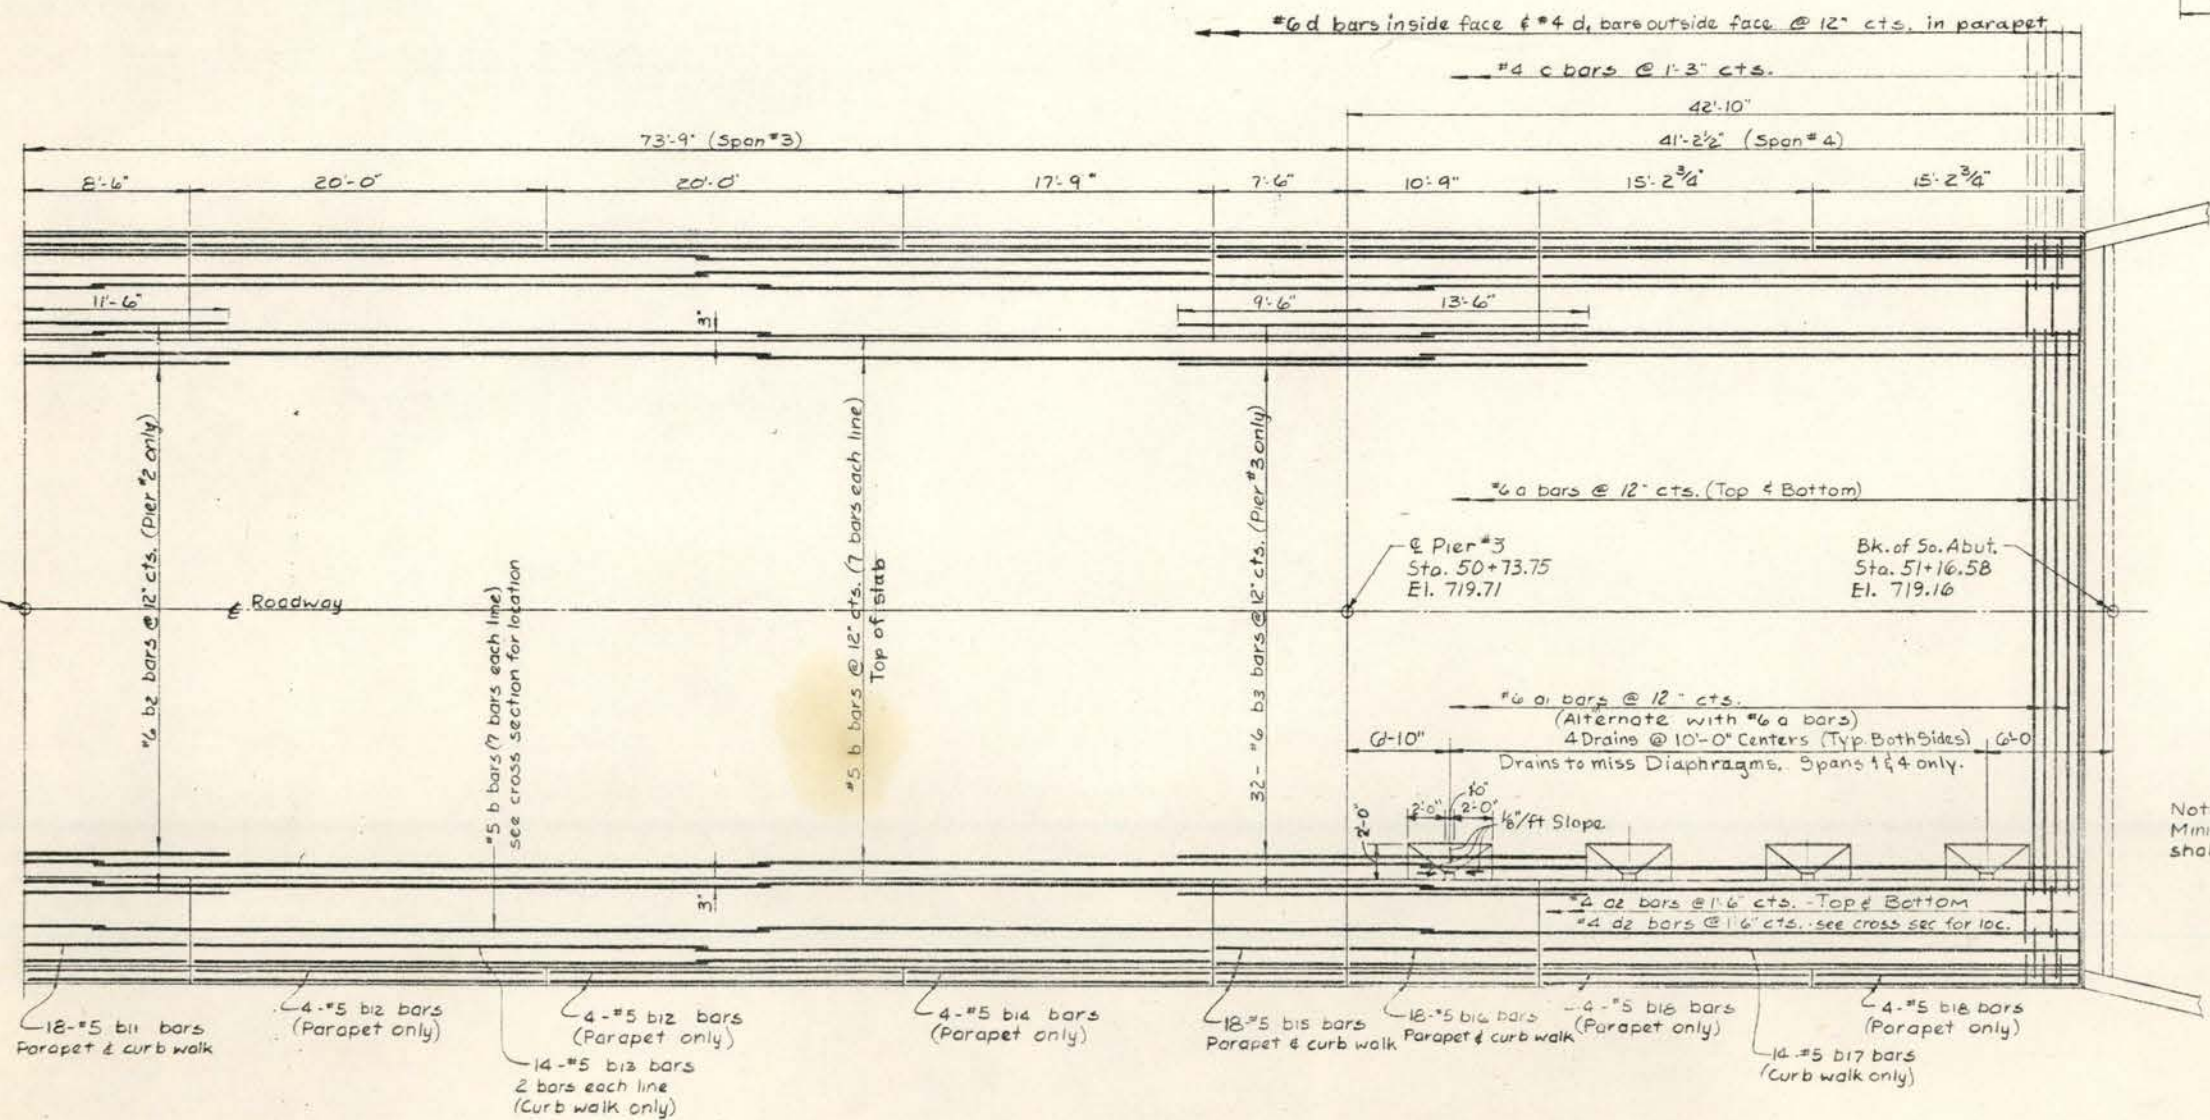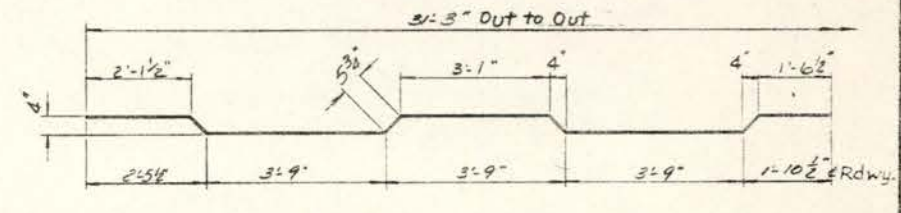

HALF PLAN

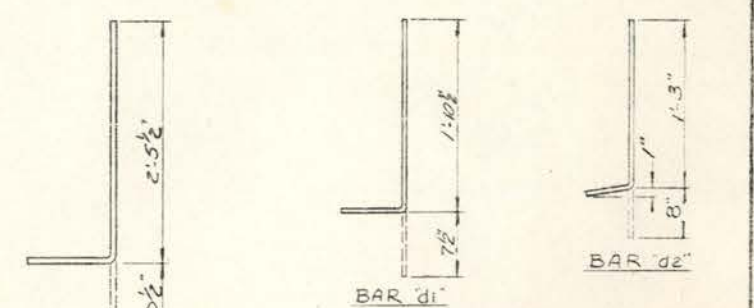

Bill of Material

Bar	No.	Size	Length	Shape
a	448	6	31'-3"	
a1	223	6	32'-4"	
a2	600	4	5'-6"	
b	672	5	32'-10"	
b1	32	6	19'-0"	
b2	32	6	23'-9"	
b3	32	6	23'-0"	
b4	16	5	16'-0"	
b5	28	5	32'-3"	
b6	36	5	8'-6"	
b7	36	5	6'-9"	
b8	24	5	16'-9"	
b9	56	5	26'-3"	
b10	36	5	9'-3"	
b11	36	5	8'-3"	
b12	16	5	19'-9"	
b13	56	5	28'-6"	
b14	8	5	17'-6"	
b15	36	5	7'-3"	
b16	36	5	10'-6"	
b17	28	5	31'-3"	
b18	16	5	15'-0"	
c	362	4	5'-8"	
d	450	6	3'-4"	
d1	450	4	2'-6"	
d2	300	4	1'-11"	


Note: Minimum lap for all reinforcing bars shall be 20 bar diameters

Summary of Quantities


Class "X" Concrete	790.8 cu yd
Reinforcement bars	73350 lbs.
Structural Steel	250,700 lbs.

\*Weight of Rockers, Bearing Plates, Lead Plates & Anchor Bolts included as Structural Steel


SUPERSTRUCTURE DETAILS  
CAK PARK AVENUE OVER  
FAI RT. 80 SEC. 1313-811HB  
COOK COUNTY - STA. 1313+37.93

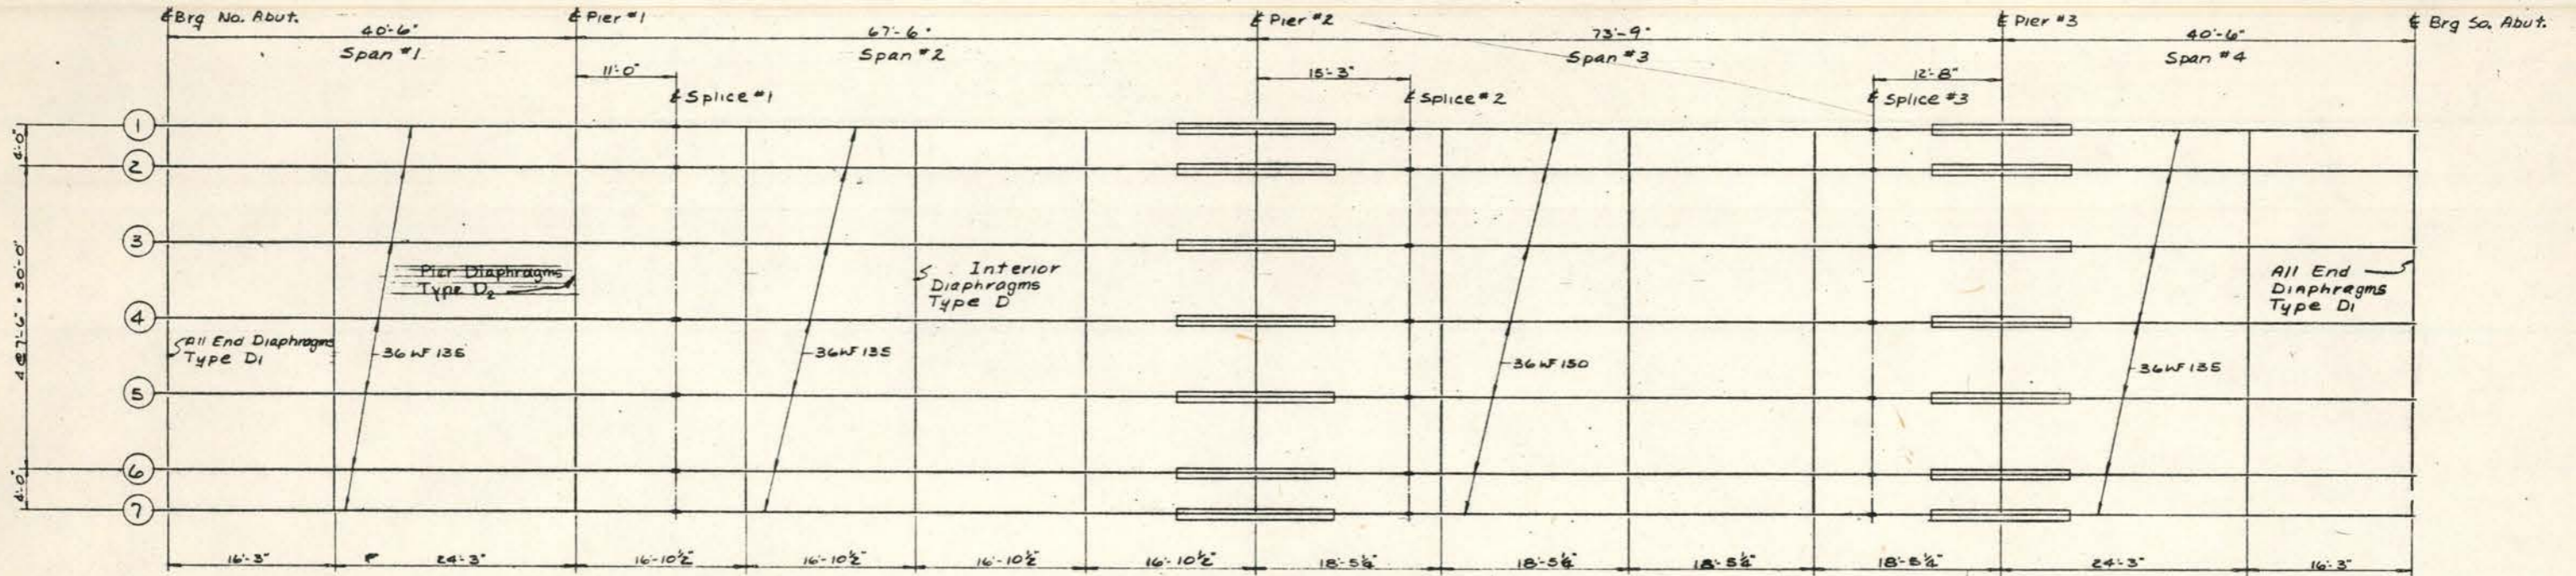


PLAN OF STRUCTURAL STEEL  
Scale  $\frac{1}{8}'' = 1'-0''$

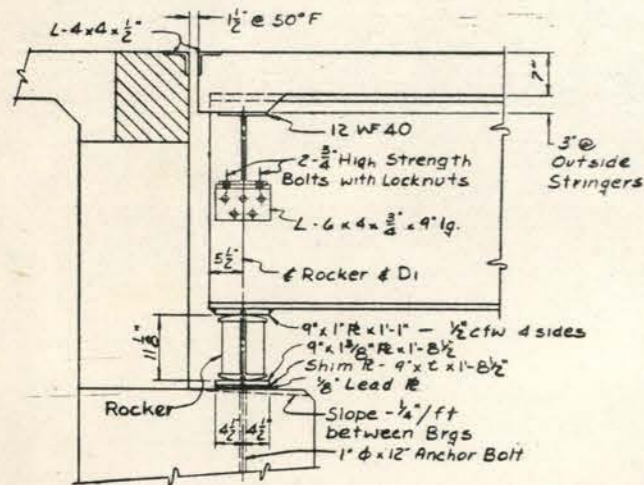


SECTION AT ABUTMENT  
Scale  $\frac{3}{4}'' = 1'-0''$

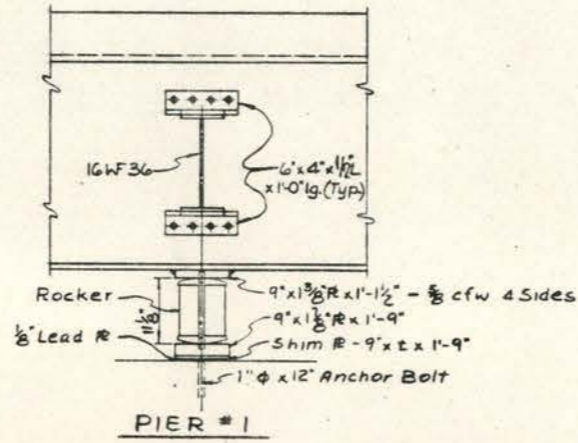


PIER #1

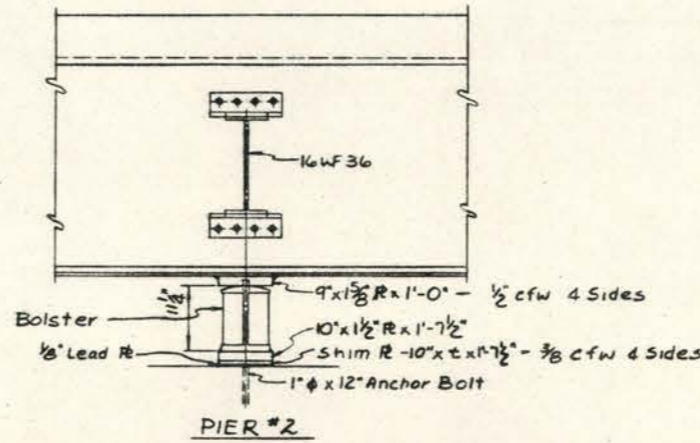


PIER #2

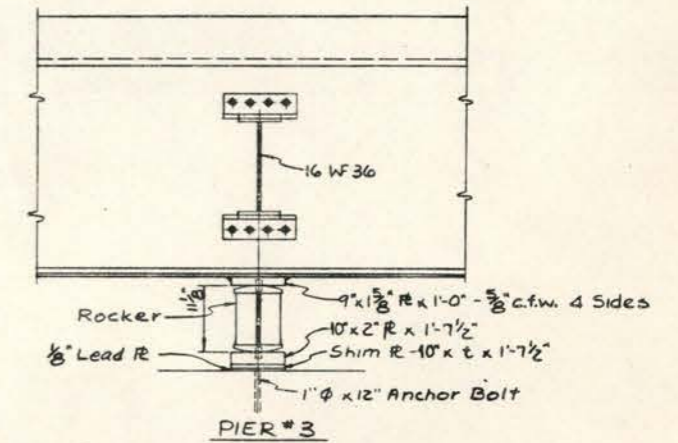


PIER #3

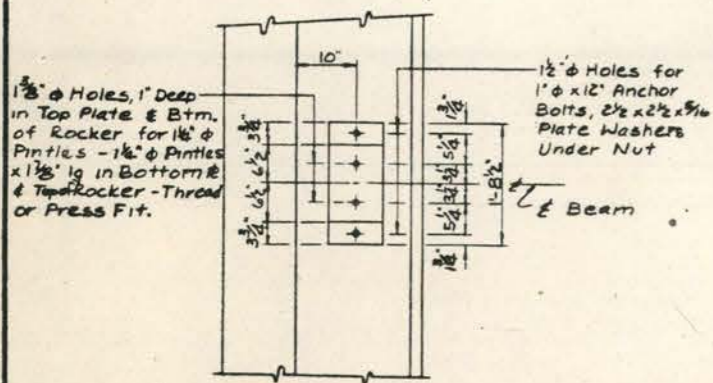


PLAN AT ABUTMENT

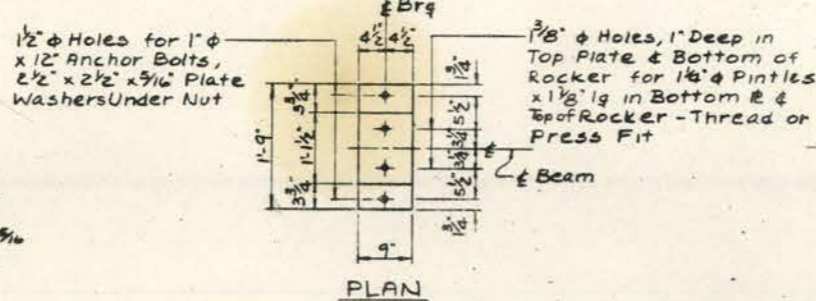

PLAN

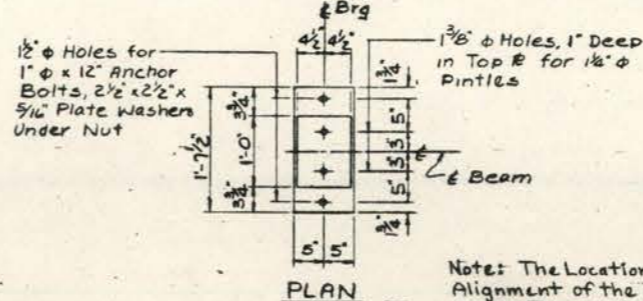

PLAN

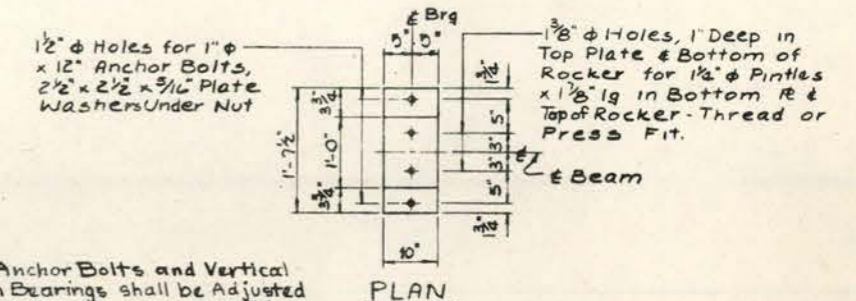

PLAN



Note: The Location of the Anchor Bolts and Vertical Alignment of the Expansion Bearings shall be Adjusted to the Temp. at the Time of Erection. See Art. 54.9 of Std. Specs.  
Anchor Bolts shall be Grouted into Drilled Holes after Beams are in place or Bolts at Fixed Pier may be Built into the Masonry.

TABLE OF "t" DIMENSIONS (SHIM THICK)

Beam Location	#1	#2	#3	#4	#5	#6	#7
North Abut	0	0	0	5/8"	0	0	0
Pier #1	0	0	0	3/8"	0	0	0
Pier #2	0	0	0	5/8"	0	0	0
Pier #3	0	0	0	5/8"	0	0	0
South Abut	0	0	0	5/8"	0	0	0

Structural Steel	
A36	250,770
Lead Plates	330
Total Struct. Steel	250,700

STRUCTURAL STEEL DETAILS  
OAK PARK AVENUE OVER  
FAI RT 80 SEC. 1313-811HB  
COOK COUNTY - STA. 1313+37.93

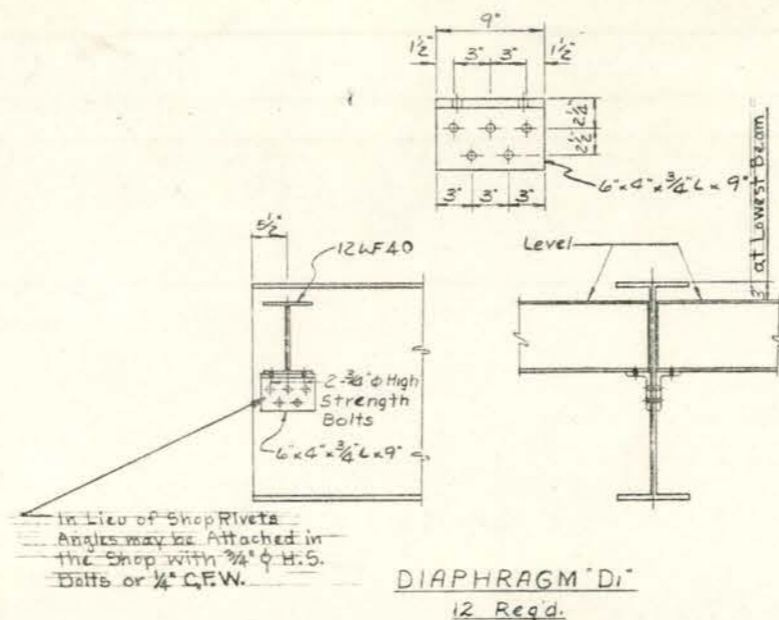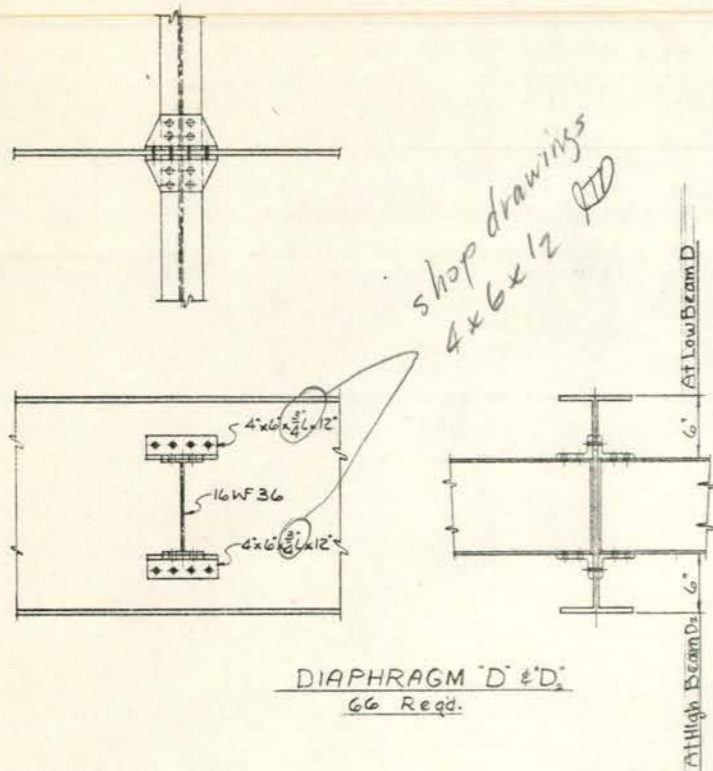

(For Fabrication)  
THEORETICAL ELEVATION TOP OF BEAMS

Beam Location	#1	#2	#3	#4	#5	#6	#7
Brig. No. Abut	718.522	718.522	718.657	718.709	718.657	718.522	718.522
Brig. Pier #1	718.966	718.966	719.101	719.153	719.101	718.966	718.966
Splice #1	719.086	719.086	719.222	719.274	719.222	719.086	719.086
Brig. Pier #2	719.234	719.234	719.369	719.421	719.369	719.234	719.234
Splice #2	719.284	719.284	719.419	719.471	719.419	719.284	719.284
Splice #3	719.050	719.050	719.186	719.238	719.186	719.050	719.050
Brig. Pier #3	718.895	718.895	719.030	719.082	719.030	718.895	718.895
Brig. So. Abut	718.429	718.429	718.564	718.617	718.564	718.429	718.429









Notes: Elevation Top of Beam is Always Top of Beam Flange, does not include Top Cover or Top Flange Splice Plates if any. Elevation Top of Beam does not include Dead Load Deflection due to the Weight of the Structural Steel or the Concrete Deck.

TABLE OF MOMENTS (INTERIOR BEAMS)

	Me. A Sp1	Me. Pier1	Me. S Sp2	Me. Pier2	Me. S Sp3	Me. Pier3	Me. S Sp4
Dead Load	74.7	-263.3	176.9	-424.0	238.0	-253.7	47.6
Live Load	260.4	-293.7	388.5	-365.0	425.4	-334.6	262.6
Impact	78.1	-76.4	101.0	-93.4	107.2	-84.3	78.8
Total Load	413.2	-632.4	666.4	-882.4	780.6	-749.6	387.0

TABLE OF REACTIONS




	R. No. Abut	R. Pier1	R. Pier2	R. Pier3	R. So. Abut
Dead Load	12.01	53.47	68.20	59.11	10.35
Live Load	40.86	52.39	55.88	55.42	40.94
Impact	12.26	13.62	14.31	13.97	12.28
Total Load	65.13	119.48	138.39	125.75	63.57

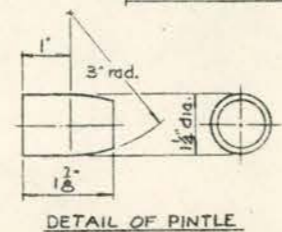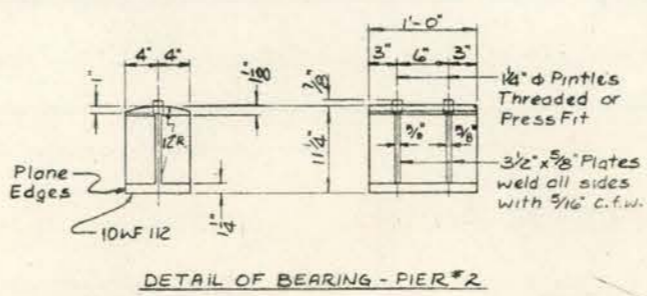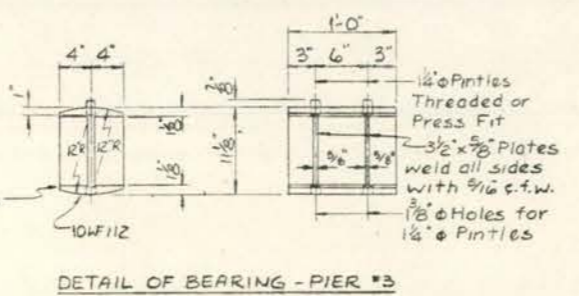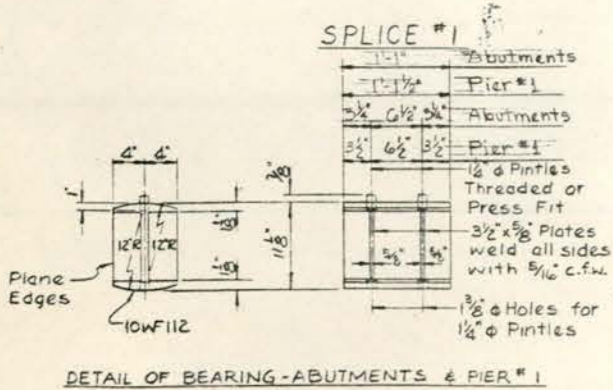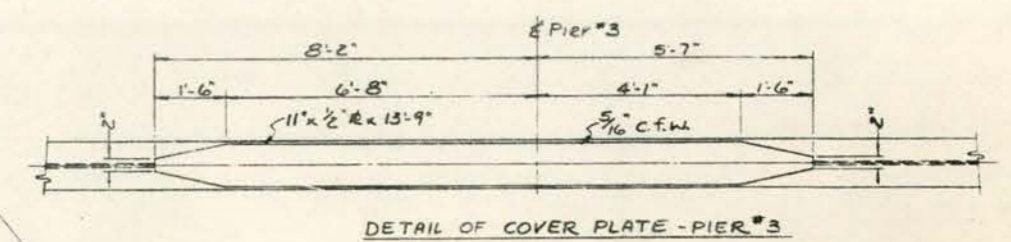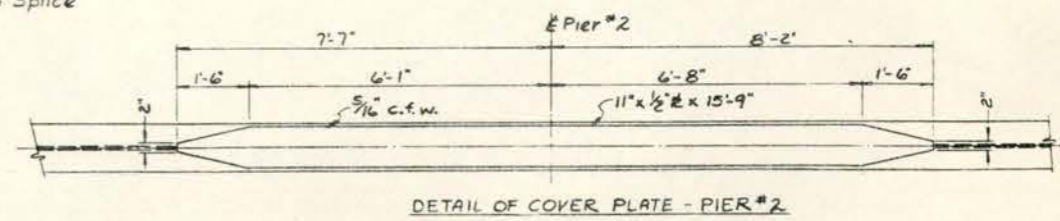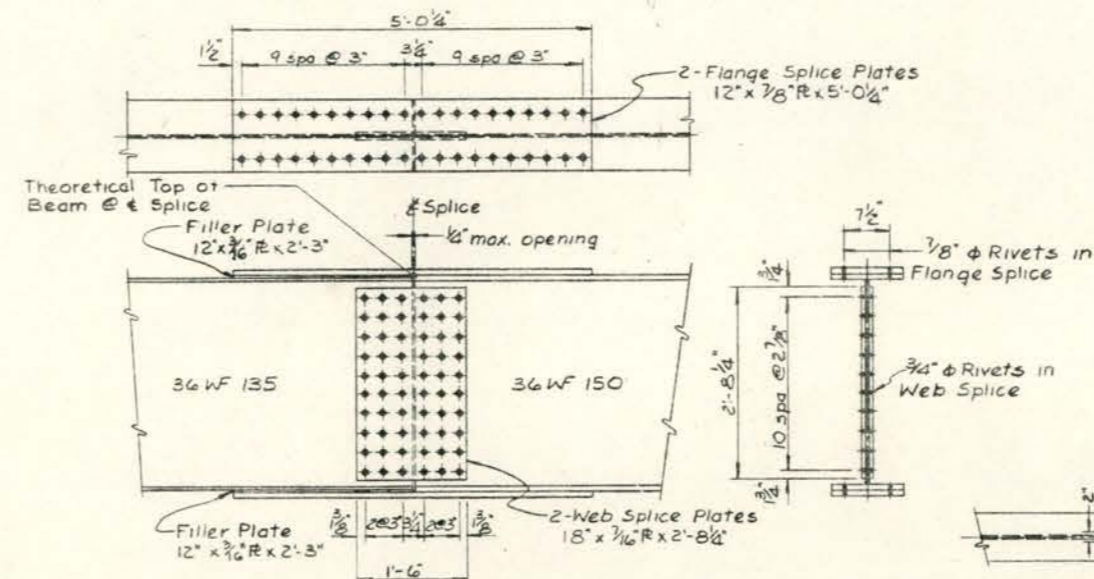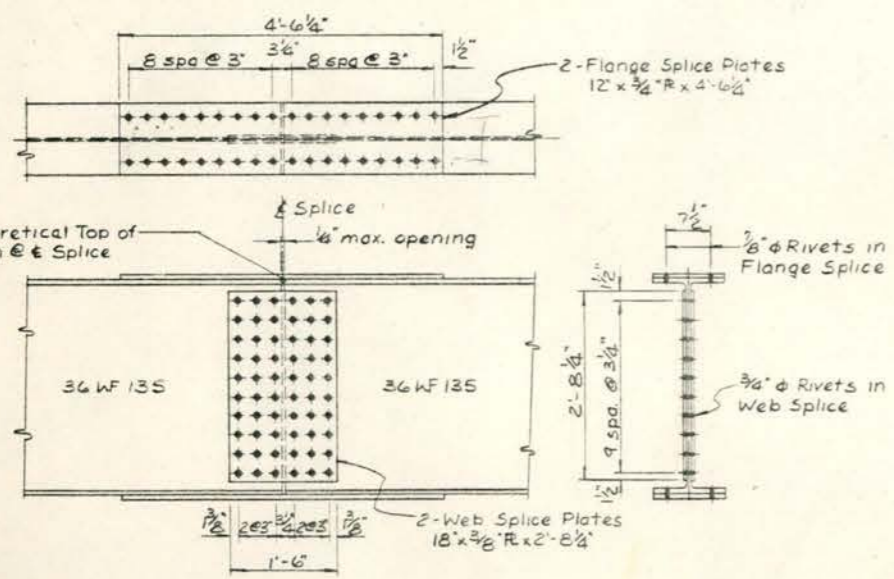

STRUCTURAL STEEL DETAILS  
OAK PARK AVENUE OVER  
FAI RT. 80 SEC 1313-811HB  
COOK COUNTY - STA. 1313+37.93

STATE OF ILLINOIS  
DEPARTMENT OF PUBLIC WORKS & BUILDINGS  
DIVISION OF HIGHWAYS

ROUTE NO.	SECTION	COUNTY	TOTAL SHEETS	SHEET NO.	SHEET NO.
F.A.I. 80	B11-HB	COOK	44	17	
FED. ROAD DIST. NO. 7	ILLINOIS	FED. AID PROJECT			

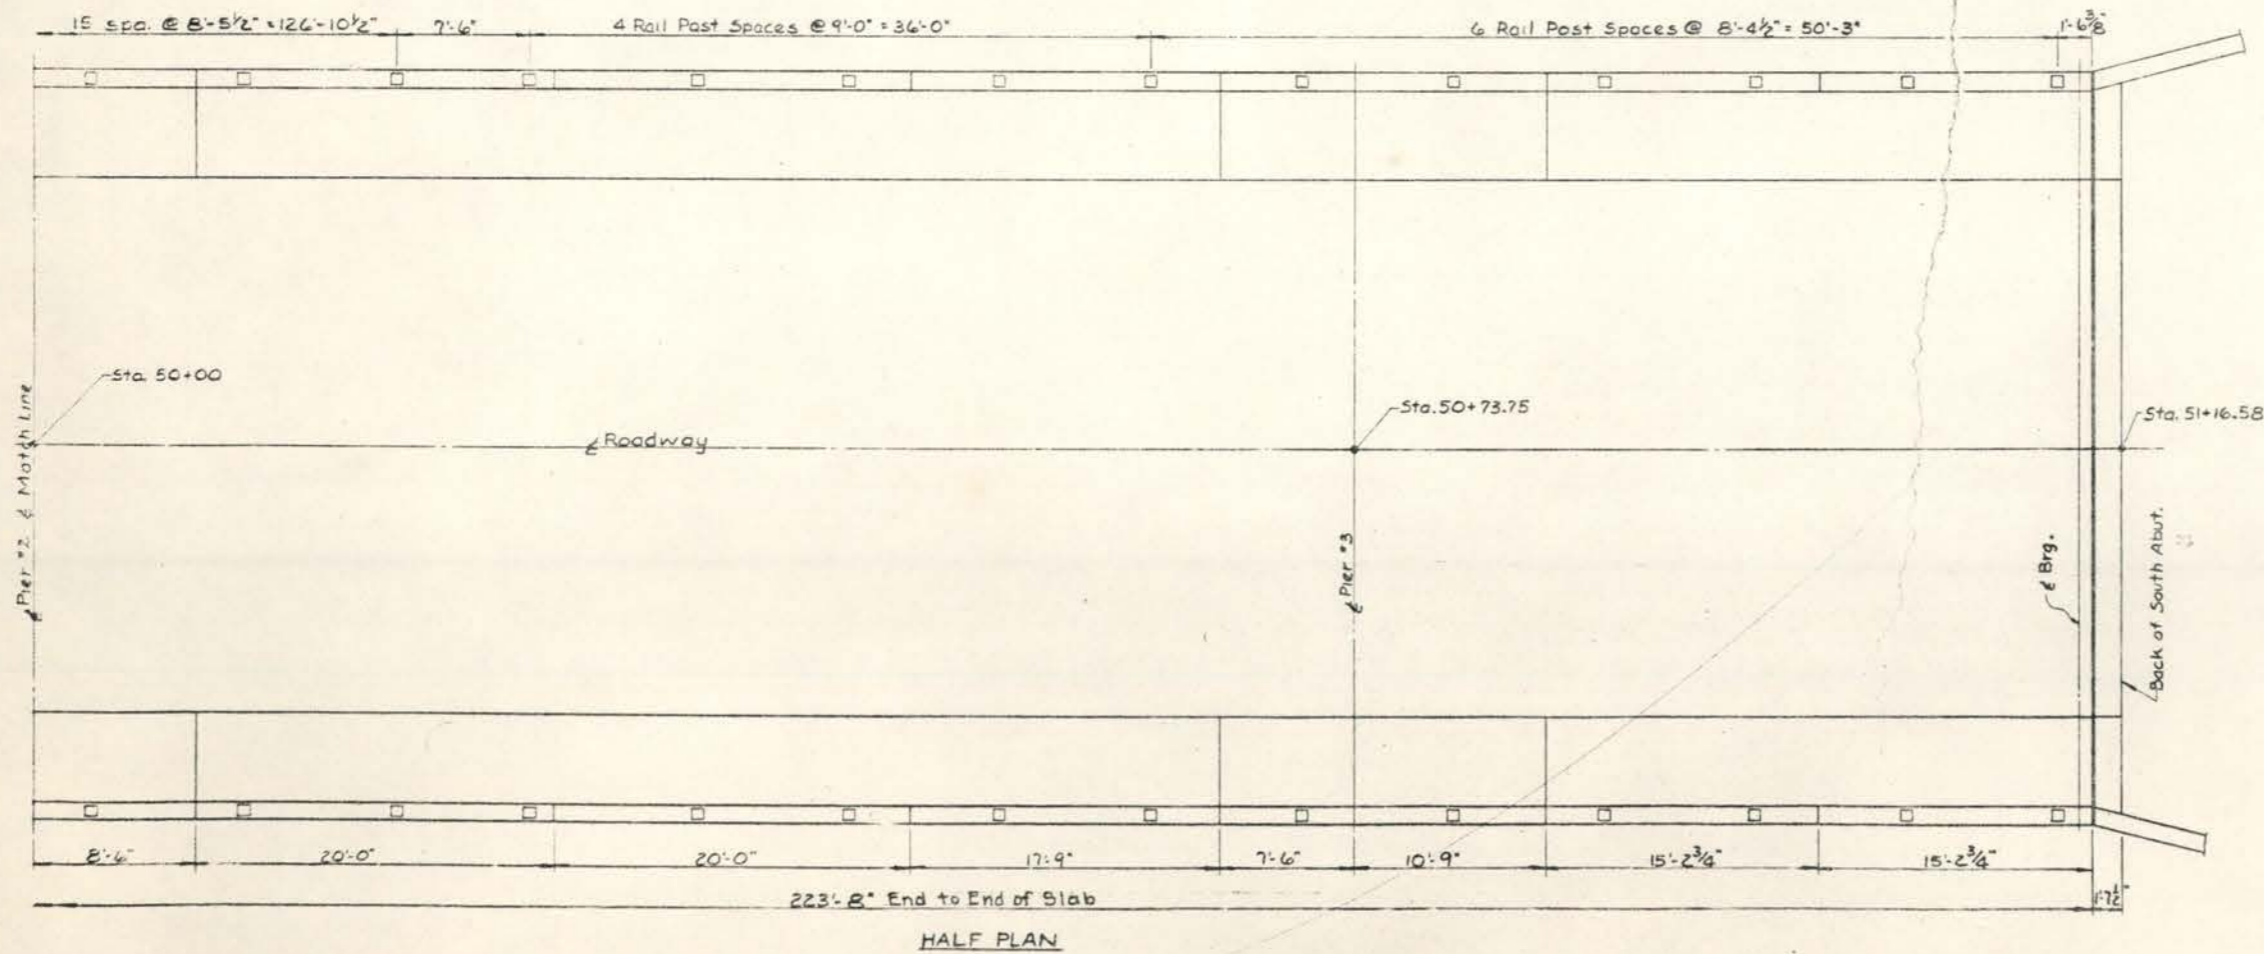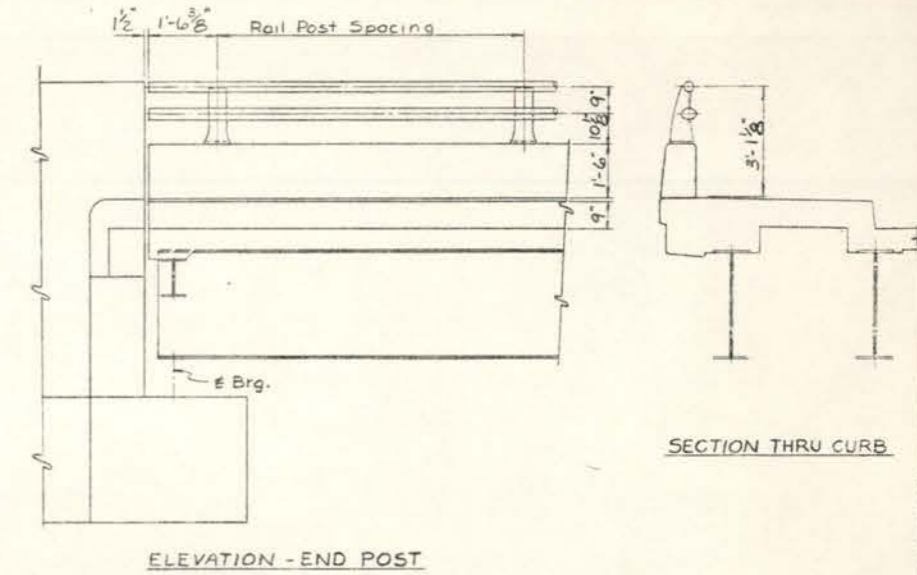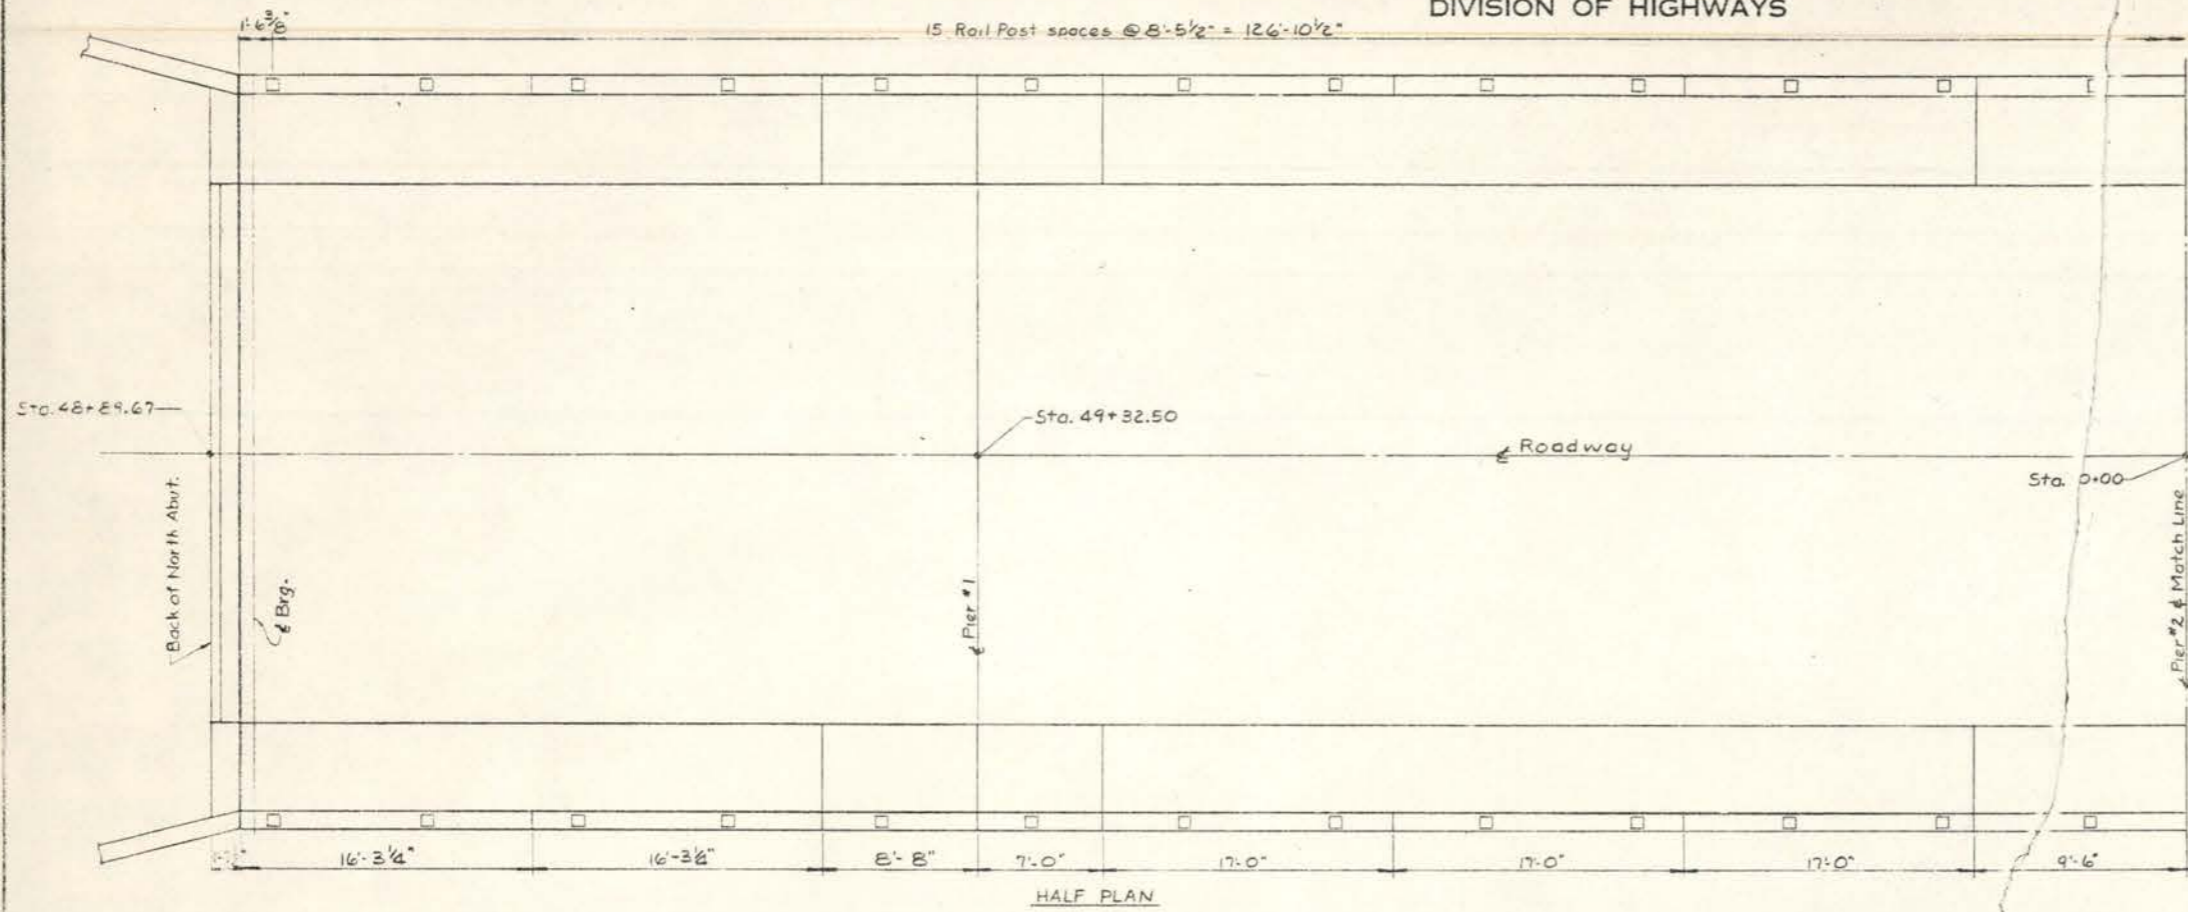

Note:  
Handrail to be two pipe (Type 'L' or 'M')  
See Sheets 22 & 23



TWO PIPE HANDRAIL  
OAK PARK AVENUE OVER  
FAI RT. 80 SEC 1313-611HB  
COOK COUNTY - STA. 1313+37.93



STATE OF ILLINOIS  
DEPARTMENT OF PUBLIC WORKS & BUILDINGS  
DIVISION OF HIGHWAYS

ROUTE NO.	SECTION	COUNTY	TOTAL SHEETS	SHEET NO.
F.A.I. 80	B11-HB	COOK	44	19
FED. ROAD DIST. NO. 7		ILLINOIS	PER. AND PROJECT	

SHEET NO.  
SHEETS

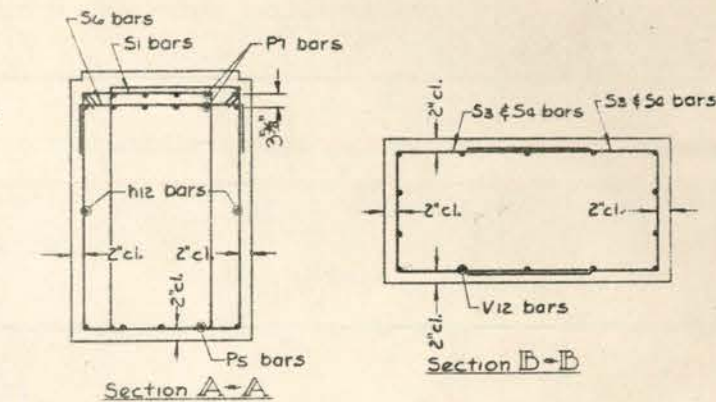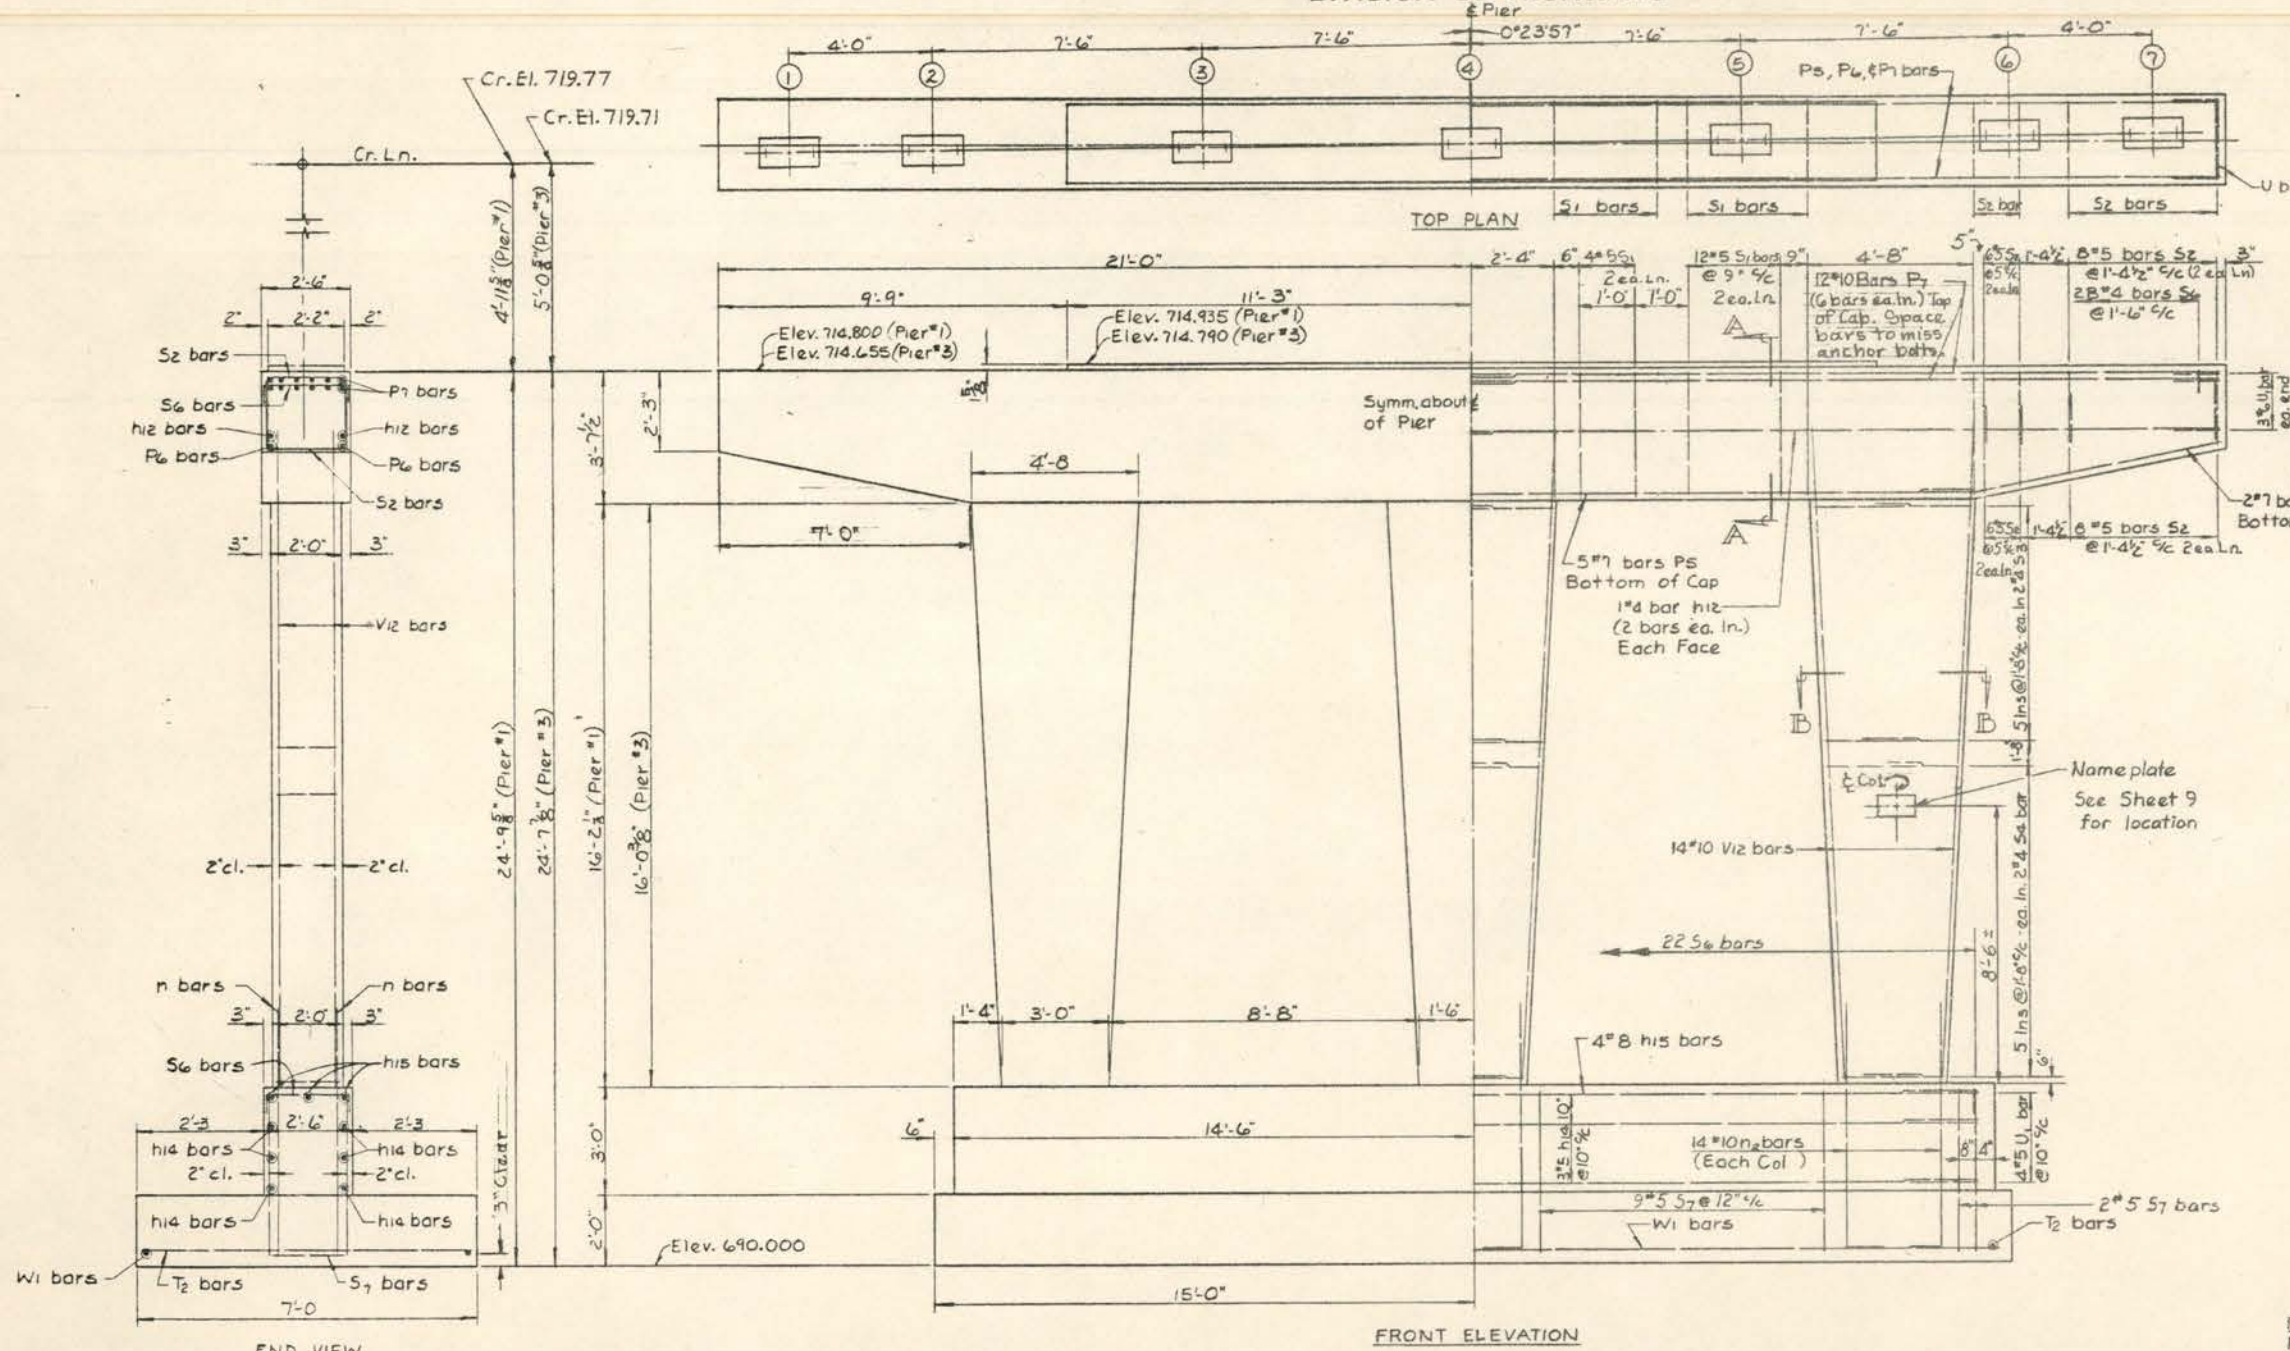

**BILL OF MATERIAL**  
TWO (2) PIERS



Bar	No.	Size	Length	Shape
h12	8	#4	21'-6"	
h14	12	#5	28'-6"	
h15	4	#8	28'-6"	
n2	84	#10	8'-3"	
P5	10	#7	28'-0"	
P6	8	#7	8'-3"	
P7	48	#10	22'-0"	
S1	64	#5	10'-0"	
S2	44	#5	5'-4"	
S3	60	#4	7'-0"	
S4	60	#4	6'-2"	
S6	92	#5	3'-2"	
S7	44	#5	11'-2"	
T2	60	#6	6'-6"	
U1	28	#6	8'-2"	
V12	84	#10	19'-0"	
W1	20	#6	29'-6"	
Class 'X' Concrete		Cu. yds.	100.8	
Reinforcement Bars		Lbs.	19,970	

Notes:  
Minimum lap or embedment of all reinforcement bars shall be 20 bar diameters

AS AWARDED

PIER #1 & #3  
OAK PARK AVENUE OVER  
F.A.I. RT. 80 SEC. 1313-B11 HB  
COOK COUNTY - STA. 1313+37.93


Br. No.	1	2	3	4	5	6	7
Dim. 'A'	0	0	0	0	0	0	0
Dim. 'B'	1 1/4	1 1/2	5/8	0	5/8	1 1/4	1 1/4

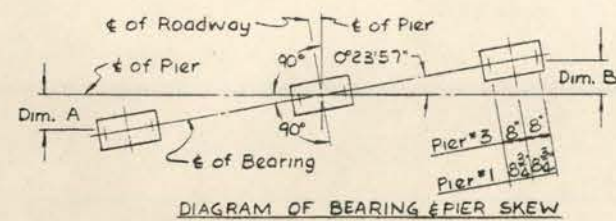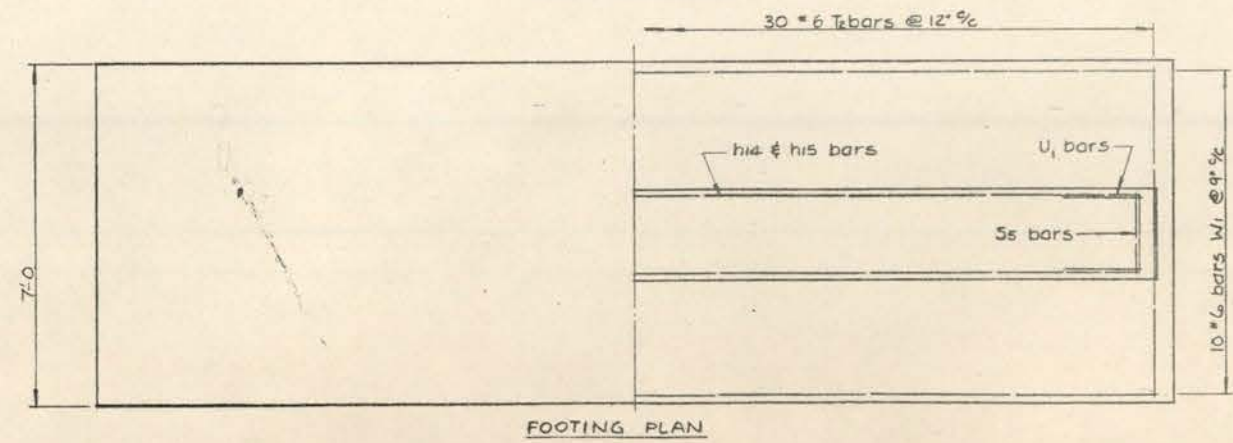


F.A.I. RT. 80  
 SEC. 1313-811HB  
 COOK COUNTY

Attach to  
 Sheet 19

PIERS 1 & 3

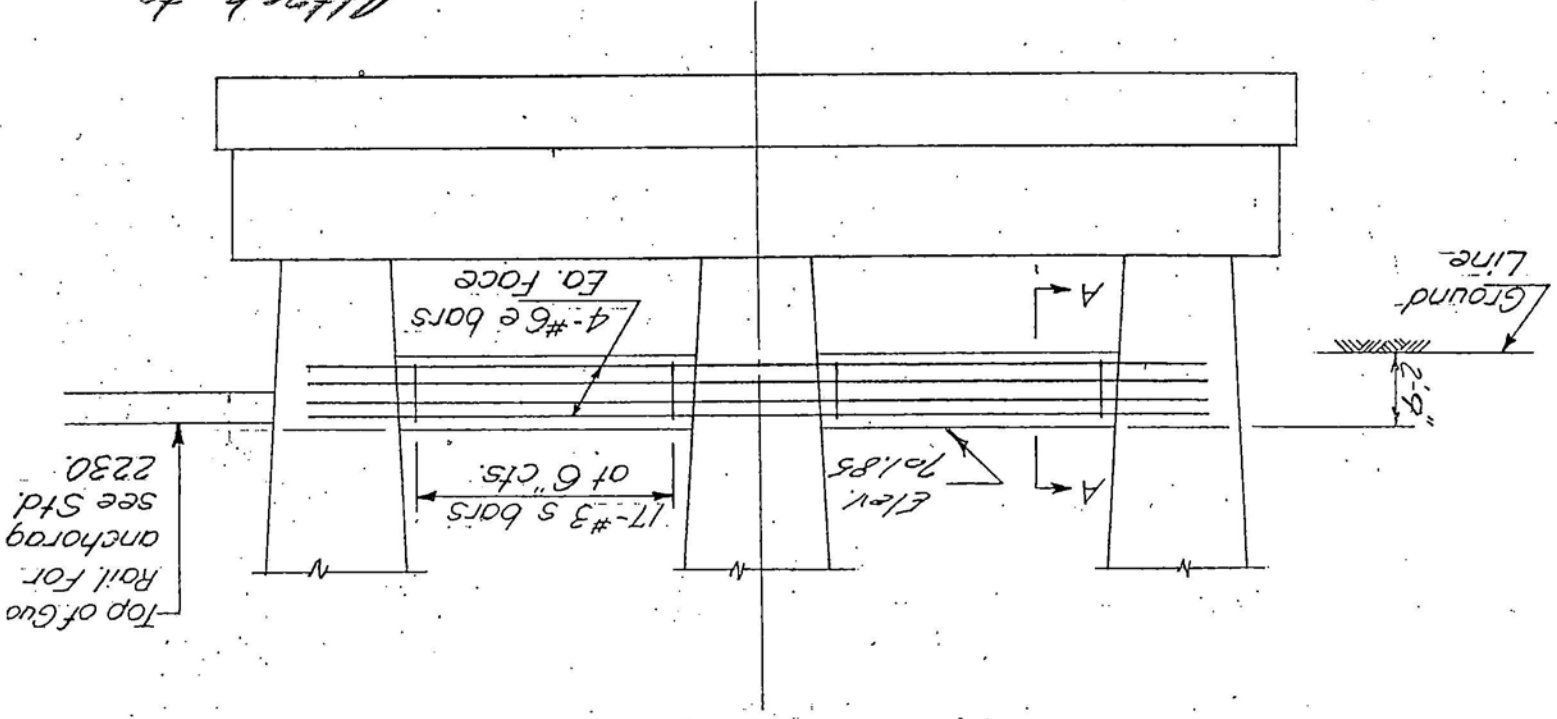

SEC. A-A


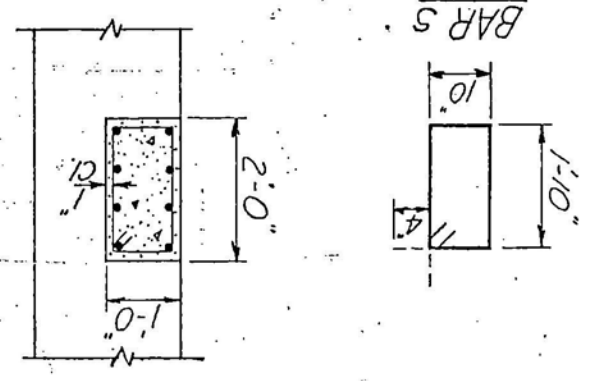


Bar No	Size	Length	Reinf. Bars	Lbs.	Class Conc.	Cu. Yds.
e	#6	24'-4"	16			
s	#3	6'-0"	68	740		2.6

BILL OF ADDITIONAL  
 MAT'L. (TWO PIERS)


PS bars  
Section A-A

SECTION 11

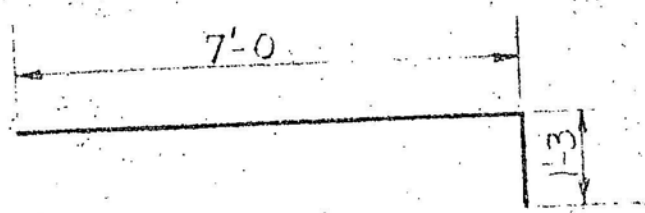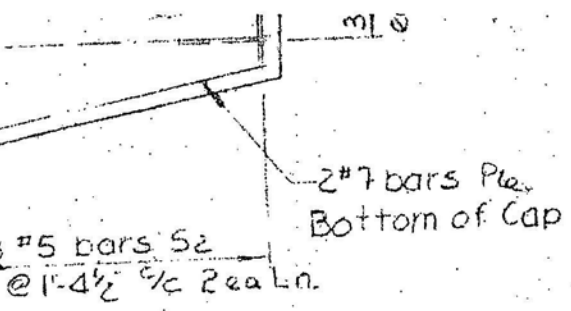


BAR n2

Nameplate  
See Sheet 9  
for location

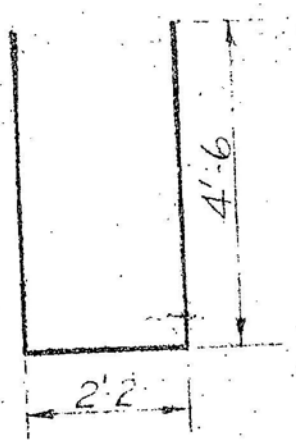

BAR S7

See Sheet 20 for additional  
bar details

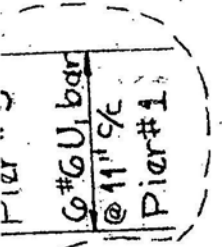

2#5 S7 bars

Notes:  
Minimum lap or embedment of  
all reinforcement bars shall  
be 20 bar diameters

The Following Splice Bars Shall Be  
Used For Pier #1:  
#5 n3 (Lap With #5 S7)  
#10 n4 (Lap With #10 n2)

BILL OF MATERIAL  
TWO (2) PIERS



Bar	No.	Size	Length	Shape
n12	8	#4	21'-6"	
n14	(16)	#5	28'-6"	
n15	4	#8	28'-6"	
n3	44	#5	3'-0"	
n2	84	#10	8'-3"	
n4	42	#10	4'-3"	
P5	10	#7	28'-0"	
P6	8	#7	8'-3"	
P7	48	#10	22'-0"	
e	16	#6	24'-4"	
s	68	#3	6'-0"	□
S1	64	#5	10'-0"	□
S2	44	#5	5'-4"	□
S3	60	#4	7'-0"	□
S4	60	#4	6'-2"	□
S6	92	#5	3'-2"	□
S7	44	#5	11'-2"	□
T2	60	#6	6'-6"	
U1	(32)	#6	8'-2"	□
V12	84	#10	19'-0"	
W1	20	#6	29'-6"	
Class 'X' Concrete			cu. yds.	108.8
Reinforcement Bars			Lbs.	21,780

10#6 bars W1 @ 9' c/c

PIER #1 E #3  
OAK PARK AVENUE OVER  
F.A.I. RT. 80 SEC. 1313-811 HB  
COOK COUNTY - STA. 1313+37.93


AS BUILT

21,040# to 21,780# (Added Crash Rail) 10-5-66 L.W.

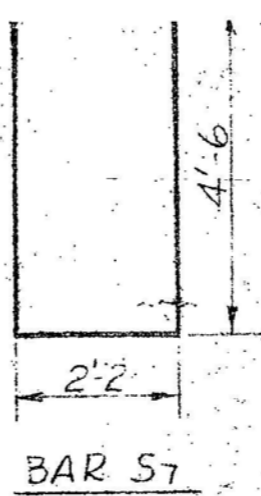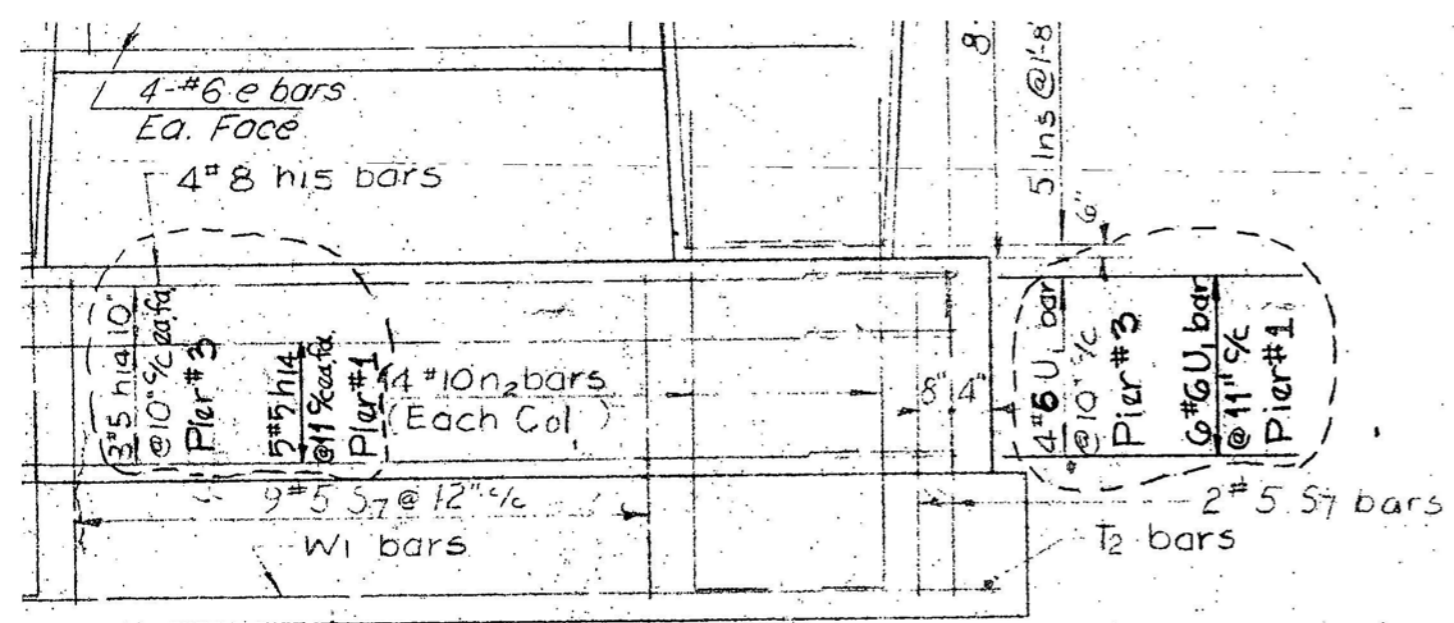


See Sheet 20 for additional bar details

S3	60	#4	7'-0"	
S4	60	#4	6'-2"	
S6	92	#5	3'-2"	
S7	44	#5	11'-2"	
T2	60	#6	6'-6"	
U1	(32)	#6	8'-2"	
V12	84	#10	19'-0"	
W1	20	#6	29'-6"	
Class "X" Concrete			Cu. yds.	108.8
Reinforcement Bars			Lbs.	21,780

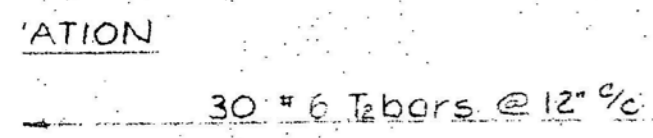

Notes:  
Minimum lap or embedment of all reinforcement bars shall be 20 bar diameters


The Following Splice Bars Shall Be Used For Pier #1:  
#5 n3 (Lap With #5 S7)  
#10 n4 (Lap With #10 n2)

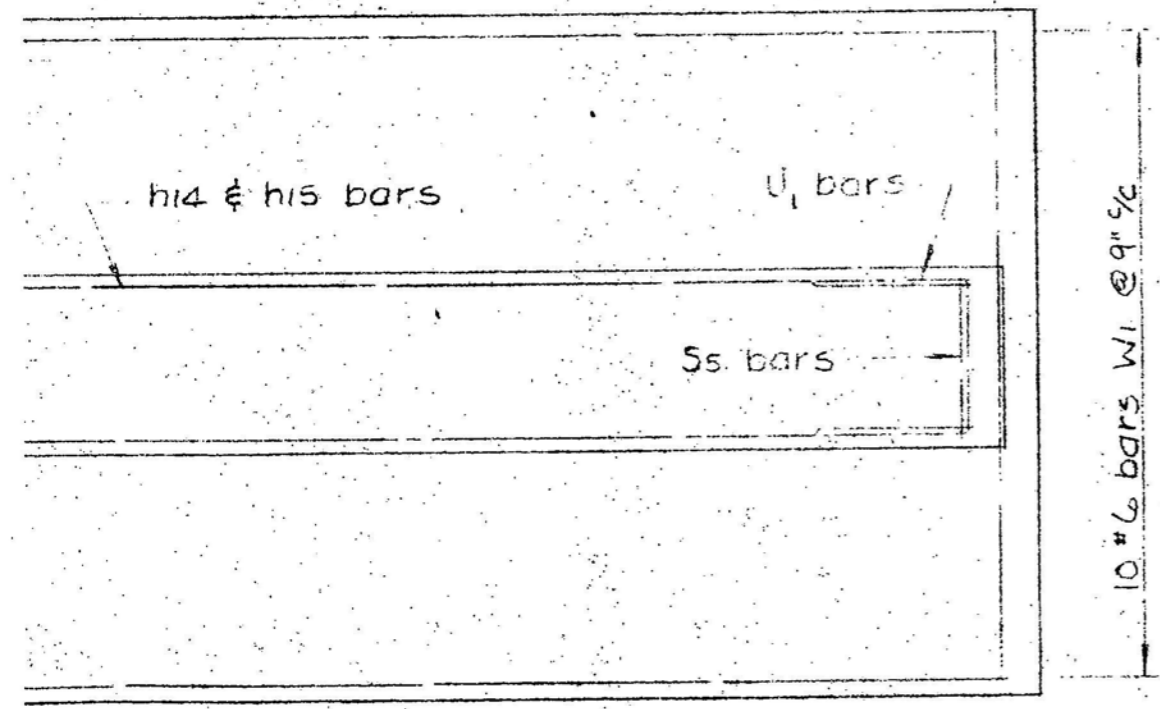



PIER #1 E #3  
OAK PARK AVENUE OVER  
F.A.I. RT. 80 SEC. 1313-811 MB  
COOK COUNTY - STA. 1313+37.93

**AS BUILT**

Conc. from 106.2 Cu. Yds. to 108.8 Cu. Yds. Rein. from 21,040# to 21,780# (Added Crash Rail) 10-5-66 L. W.

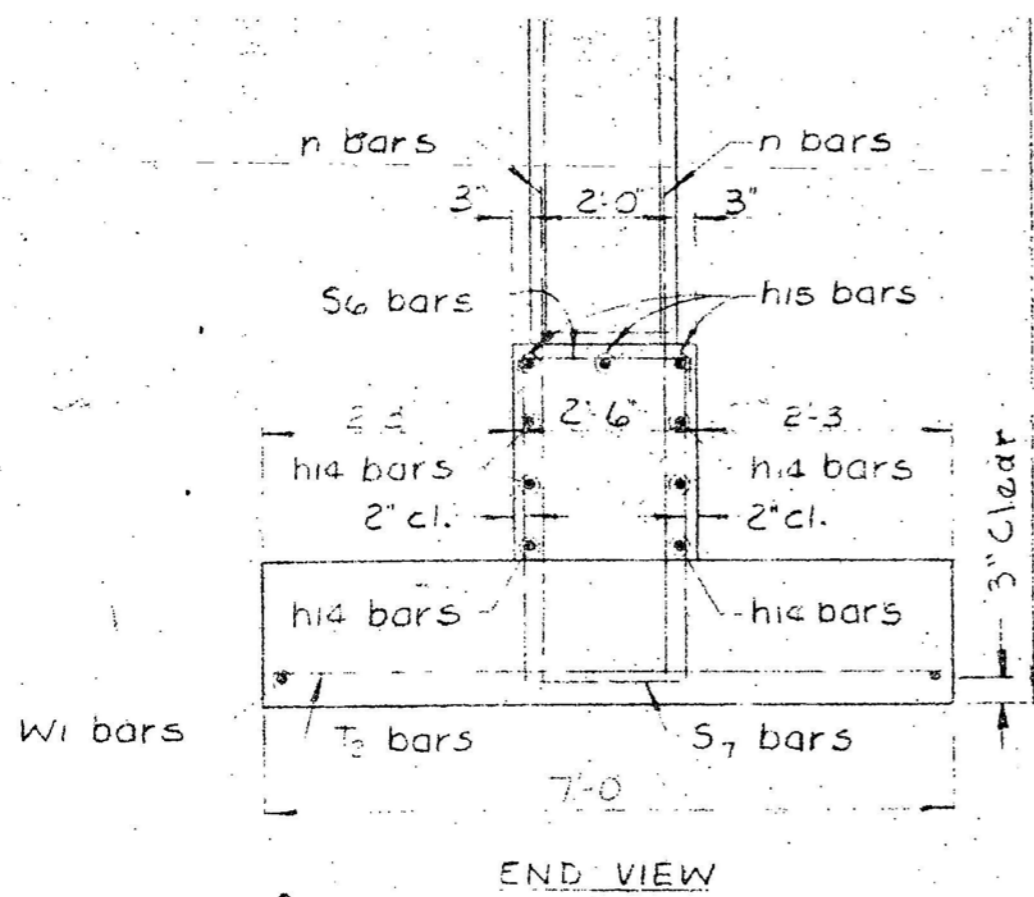

END VIEW

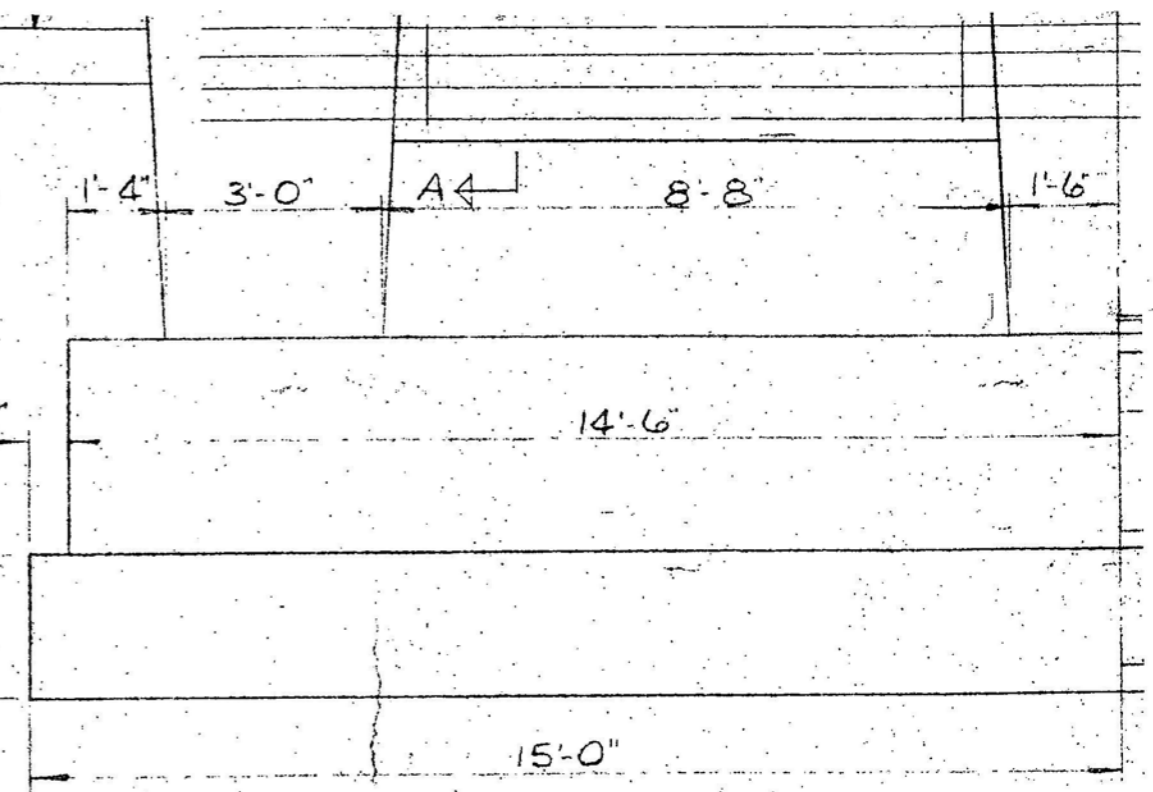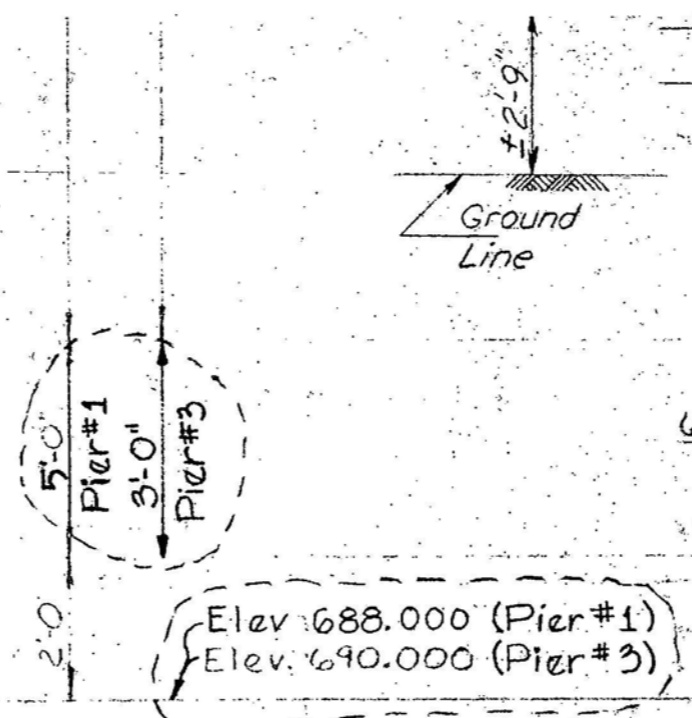

FRONT EL


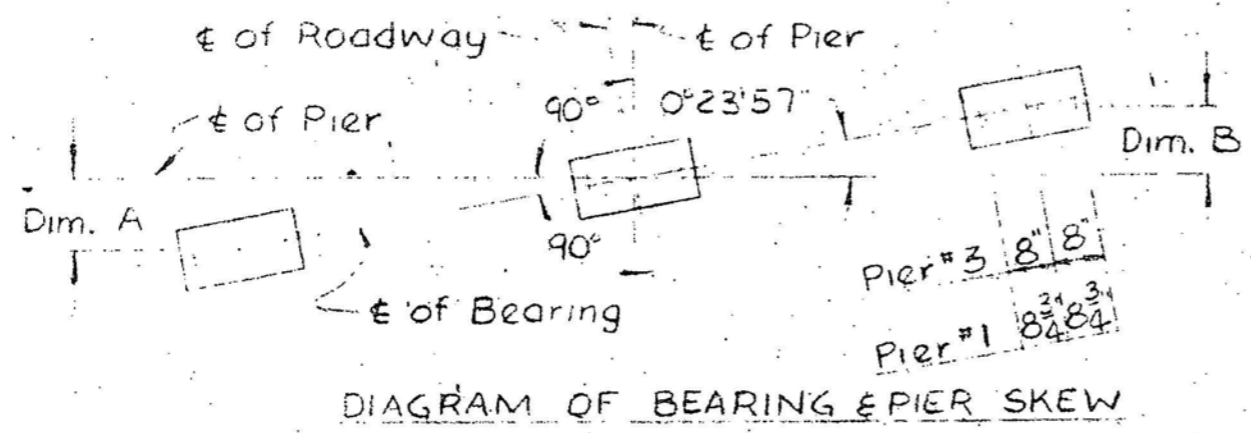


DIAGRAM OF BEARING & PIER SKEW







Brg. No.	1	2	3	4	5	6	7
Dim. A				0	5/8	1/4	1 9/16
Dim. B	1 9/16	1/2	5/8	0			

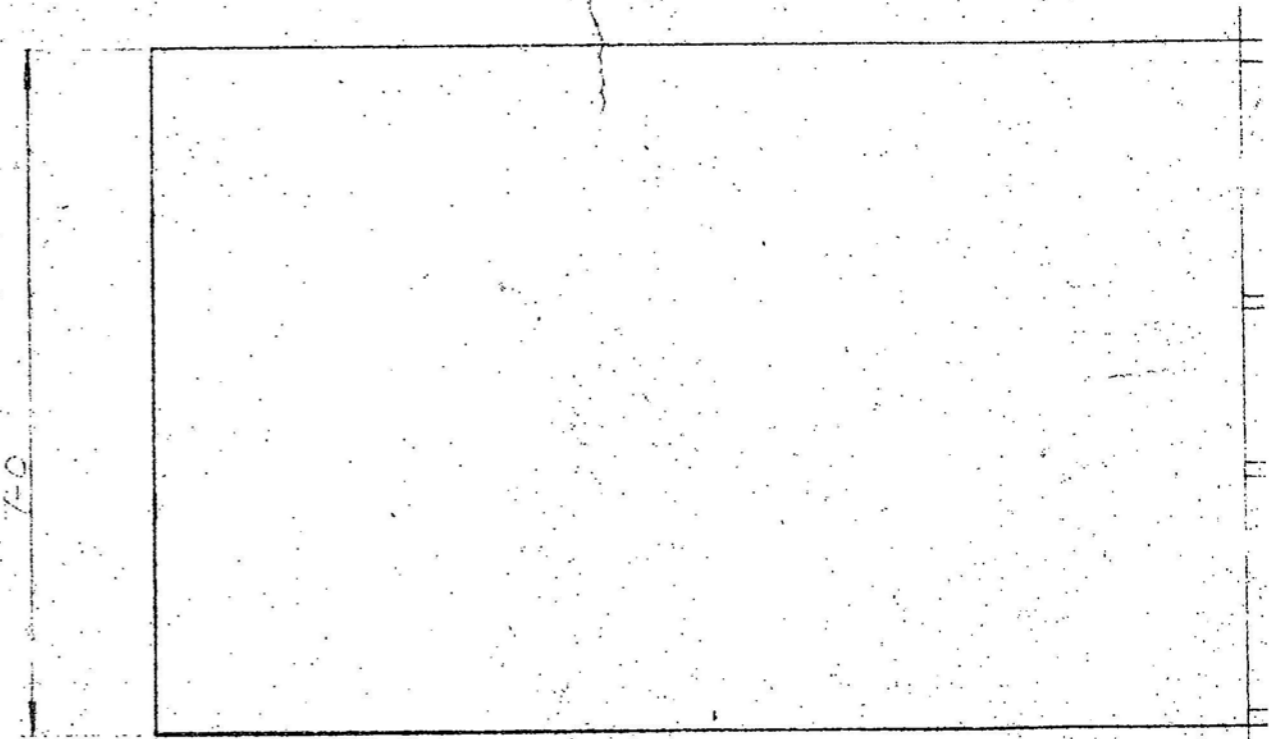

FOOTING

STATE OF ILLINOIS  
DEPARTMENT OF PUBLIC WORKS & BUILDINGS  
DIVISION OF HIGHWAYS

ROUTE NO.	SECTION	COUNTY	TOTAL SHEETS	SHEET NO.	SHEET NO.
1513-	80B11WB	COOK	44	20	
FED. ROAD DIST. NO. 7		ILLINOIS		FED. AID PROJECT	

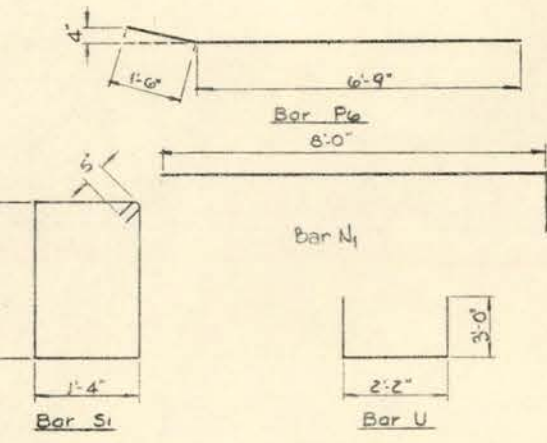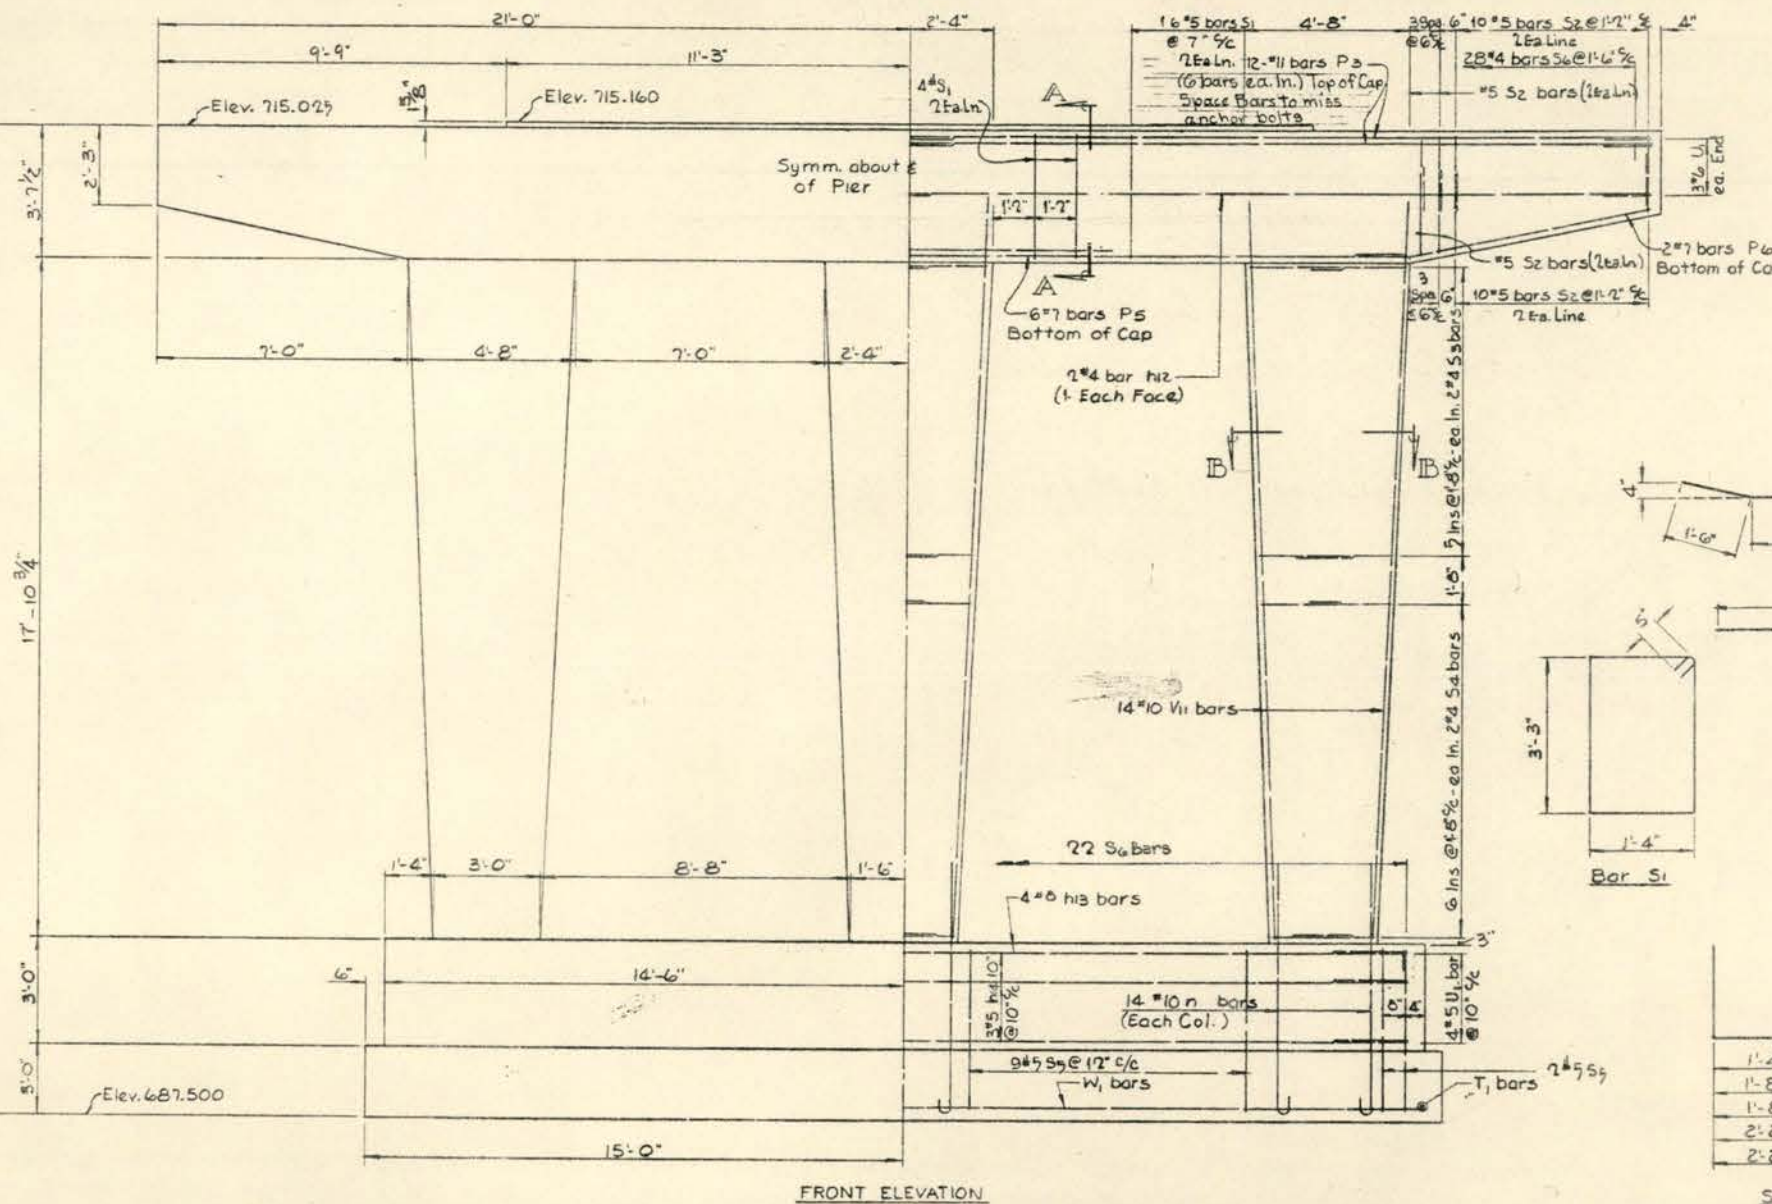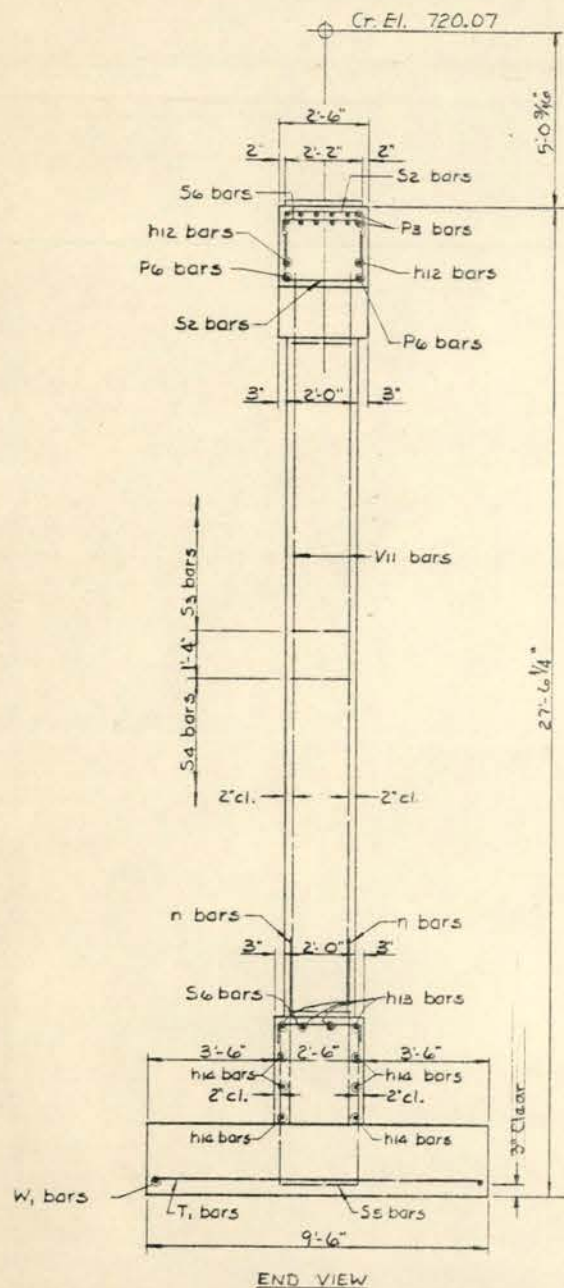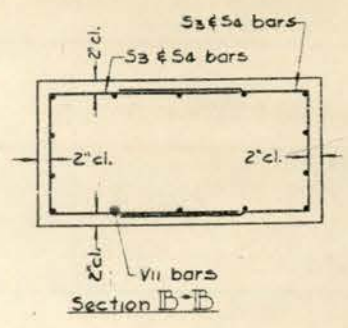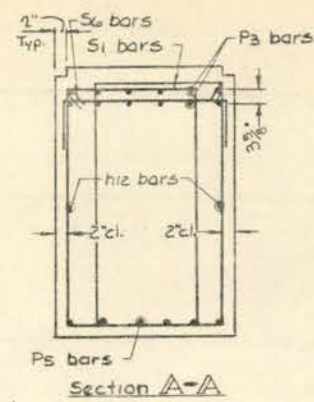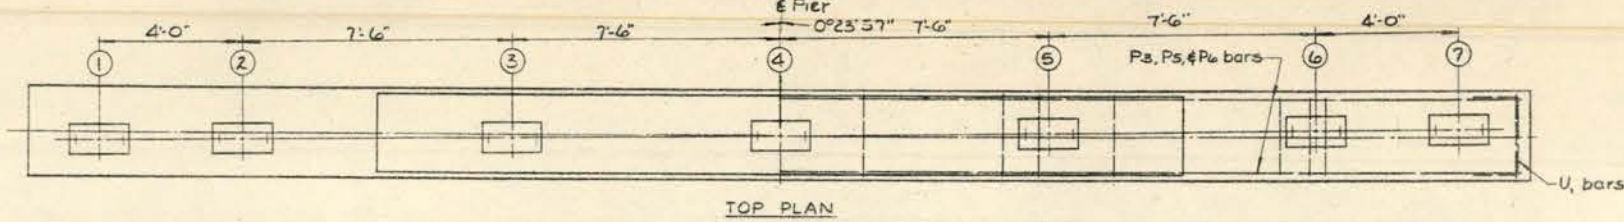


S Bars


3'-0"	S2
1'-8"	S3
1'-8"	S4
2'-2"	S5
2'-2"	S6

BILL OF MATERIAL

Bar	No.	Size	Length	Shape
h12	4	#4	21'-6"	—
h13	4	#8	28'-6"	—
h14	6	#5	28'-6"	—
n1	42	#10	9'-3"	—
P3	24	#11	22'-0"	—
P5	6	#7	28'-0"	—
P6	4	#7	8'-3"	—
S1	40	#5	10'-0"	□
S2	56	#5	5'-4"	□
S3	30	#4	7'-0"	□
S4	30	#4	6'-2"	□
S5	22	#5	15'-2"	□
S6	50	#5	3'-2"	□
T1	40	#6	9'-0"	—
U1	14	#6	8'-2"	□
V11	42	#10	21'-0"	—
W1	19	#6	29'-6"	—
Class X Concrete				Cu Yards 68.3
Reinforcement Bars				Lbs. 17,791

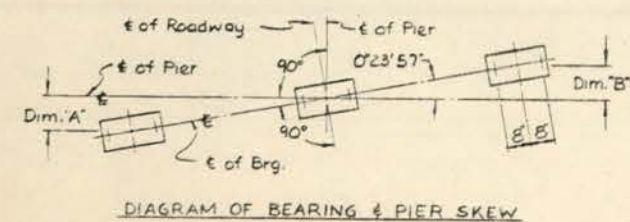


Brg No.	1	2	3	4	5	6	7
Dim. A'	0	0	0	0	0	0	0
Dim. B'	1 1/16"	1/8"	3/16"	0	5/16"	1/4"	1 1/16"

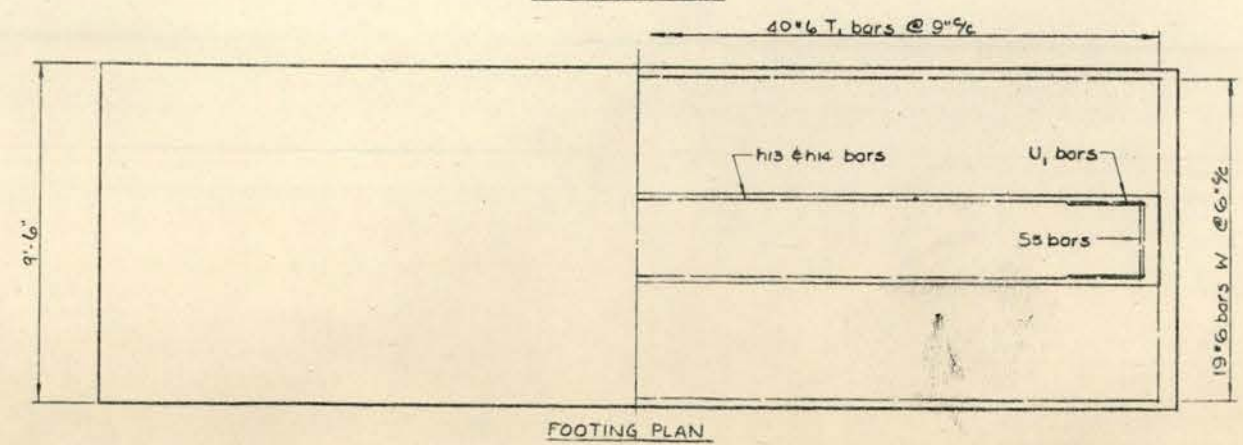

Notes:  
Minimum lap or embedment of all reinforcement bars shall be 20 bar diameters.

PIER #2  
OAK PARK AVENUE OVER  
F.A.T. RT. 80 SEC. 1313-811WB  
COOK COUNTY - STA. 1313+37.93





PROJECT NO.	1315
SECTION	COCK
DATE	4A
SHEET NO.	21

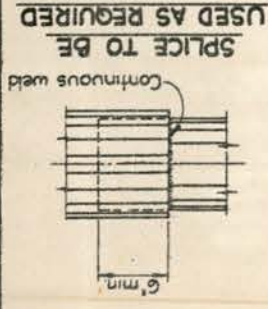



**ALLOWABLE TAPERS**

- 1 - Taper 1/2-6" for 10' ± 12" Cylindrical Section Extension.
- 2 - Taper 1/4-0" for 17' ± 12" Cylindrical Section Extension.
- 3 - Taper 1/7-0" for 30' ± 12" Cylindrical Section Extension.


Welded wire fabric 6"x6" Mesh  
#4 Wires - Wt 58#/100sq ft. plus  
4-#4 tie bars. The cost of  
Class X Concrete Encasement and  
Reinforcement is incidental to the  
cost of furnishing piles.  
The thickness of the shell shall be  
.1795 inches with a tolerance of 5%.

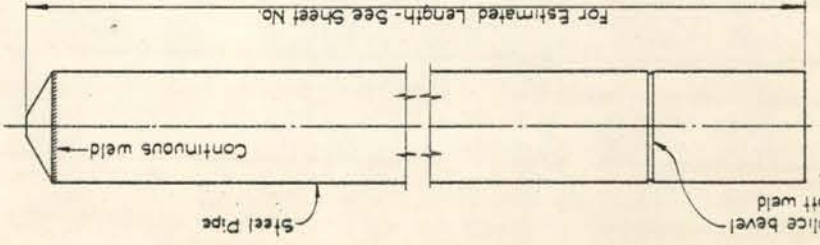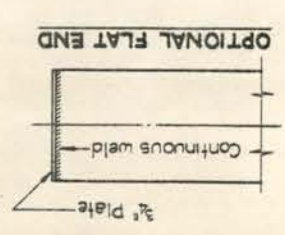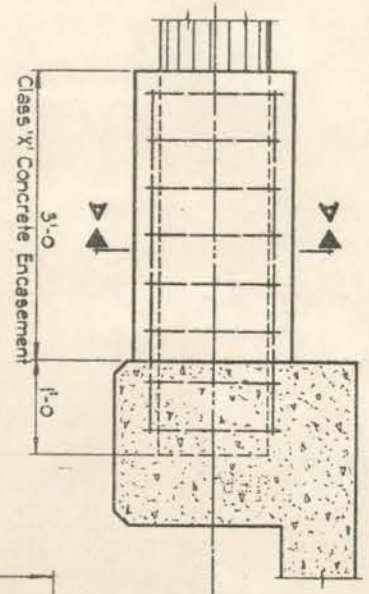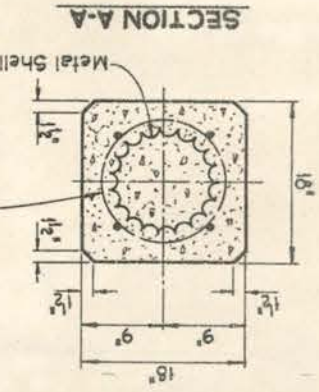


NOTE:- Driving and Bearing ends of pipe shall be cut square.  
Welded wire fabric 6"x6" Mesh  
#4 Wires - Wt 58#/100sq ft. plus  
4-#4 tie bars. The cost of  
Class X Concrete Encasement  
and Reinforcement is incidental  
to the cost of furnishing piles.  
The thickness of the shell shall be  
.1795 inches with a tolerance of 5%.

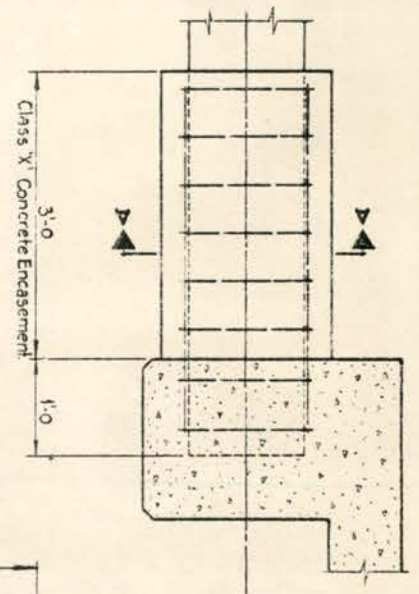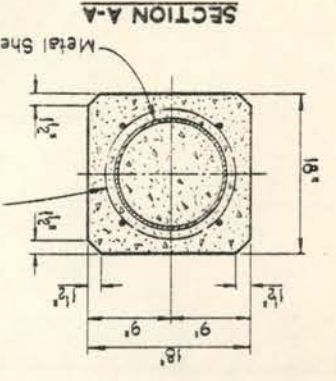


**DETAIL OF TAPERED METAL SHELL  
FOR CAST IN PLACE CONCRETE PILES**

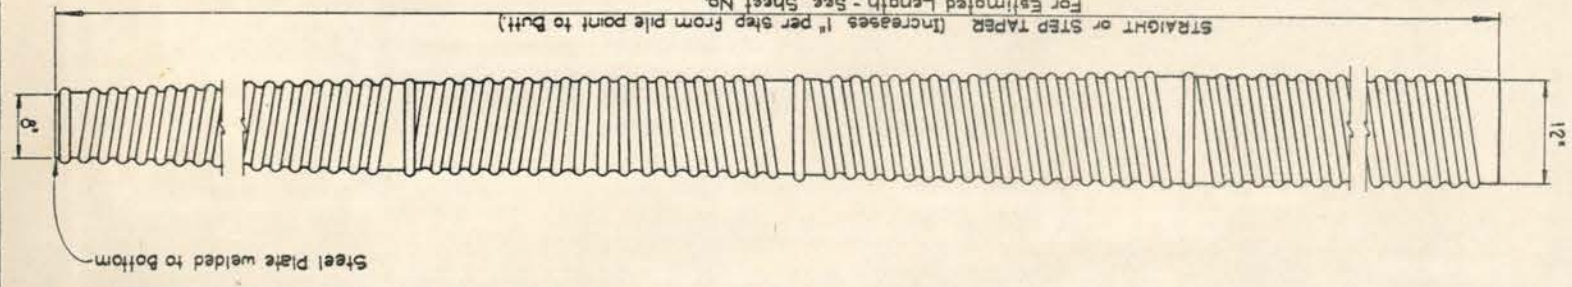

**DETAIL OF  
MANDREL DRIVEN STRAIGHT OR STEP-TAPER PILES  
FOR CAST IN PLACE CONCRETE PILES.**

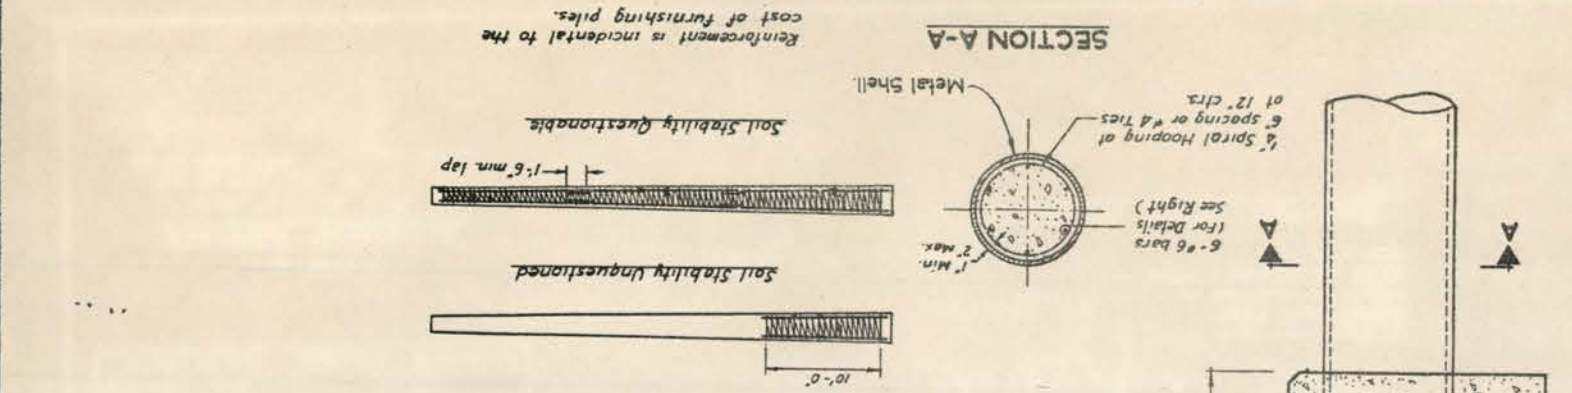

**DETAIL OF CYLINDRICAL STEEL SHELL  
FOR CAST IN PLACE CONCRETE PILES**

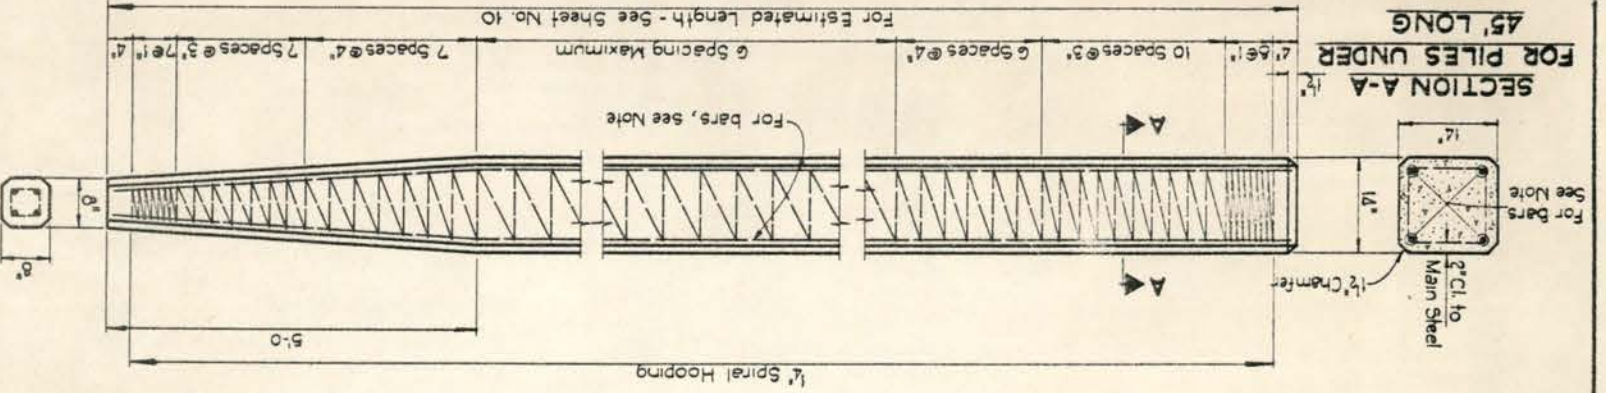



Note: For 14' piles 45' long or more use 6-#6 bars  
4 for the full length and 4 to the point of level.  
For 14' piles under 45' long use 4-#9 bars the full length.  
Handling: For pile lengths up to 45', use two slings placed at a distance of 0.21 L\* from each end.  
For piles longer than 45', use three slings placed at a distance of 0.12 L\* from each end and at mid-point of pile.  
\* L = Over all length of pile to be handled.

**DETAIL OF PRECAST CONCRETE PILES**


STATE OF ILLINOIS  
DEPARTMENT OF PUBLIC WORKS & BUILDINGS  
DIVISION OF HIGHWAYS

DESIGN NO.	SECTION	COUNTY	TOTAL SHEETS	SHEET NO.
R-20	1373	COOK	44	22
F. A. I. 80 811-48				
ILLINOIS				


SHEET NO.  
SHEETS

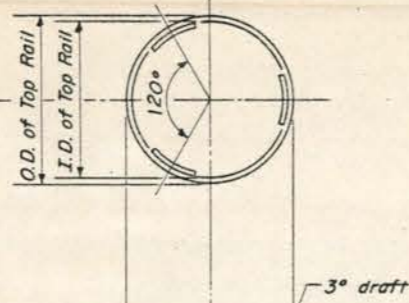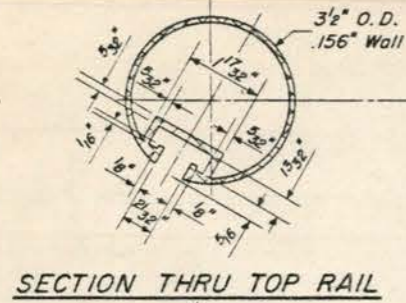

Drill & tap for 1/2\"/>

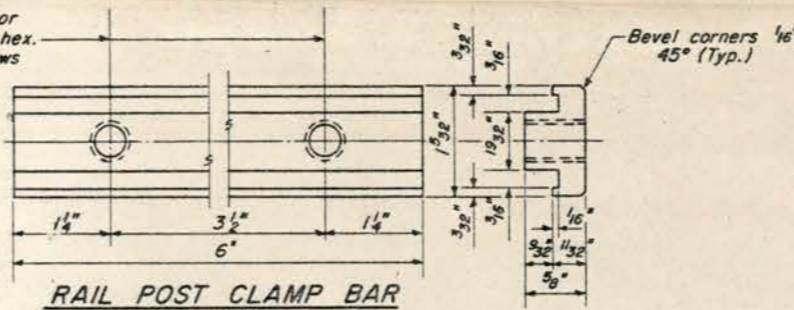

RAIL POST CLAMP BAR  
For Top Rail

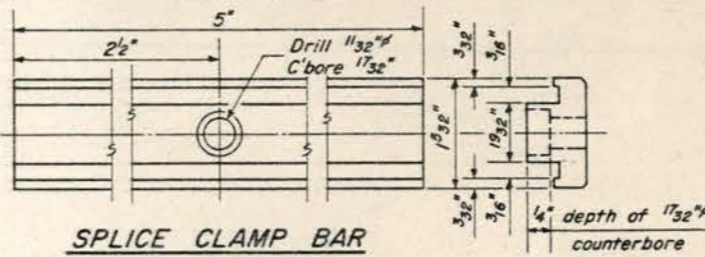


SPLICE CLAMP BAR  
For Top Rail

NOTES

All Posts shall be normal to parapet.  
All Aluminum Alloy Extruded Rail shall conform to ASTM specification B-221 alloy 6061-T6 and shall extend a minimum of 2 panel lengths (attached to a minimum of 3 posts) except at ends or at open joints where a minimum of 1 panel length is required. All joints in railing must be spliced per detail.  
See Special Provisions for following Material Specifications:  
Cast Aluminum Alloy Bridge Post - Alloy A344-T4.  
Stainless Steel Cap Screws, Washers and Bars.  
Fabric Bearing Pad


METHOD of MEASUREMENT: Aluminum handrail shall be measured in lineal feet. The length paid for shall be the over all length along the top longitudinal railing member thru all posts and gaps.  
BASIS of PAYMENT: Aluminum handrail shall be paid for at the contract unit price per lineal foot for ALUMINUM HANDRAIL, measured as specified, which price shall be payment in full for all materials, fabrication, transportation and erection.  
Cost of rail splice, end caps and hardware to be incidental to item ALUMINUM HANDRAIL.  
Provide 1-1/8\"/>

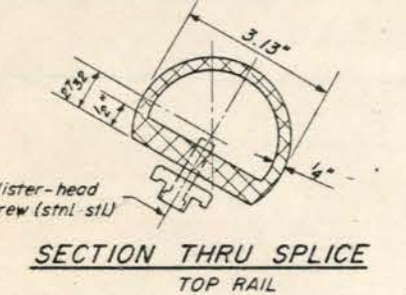

SECTION THRU SPLICE  
TOP RAIL

5/16\"/>


CAST END CAP  
For Top Rail  
Required

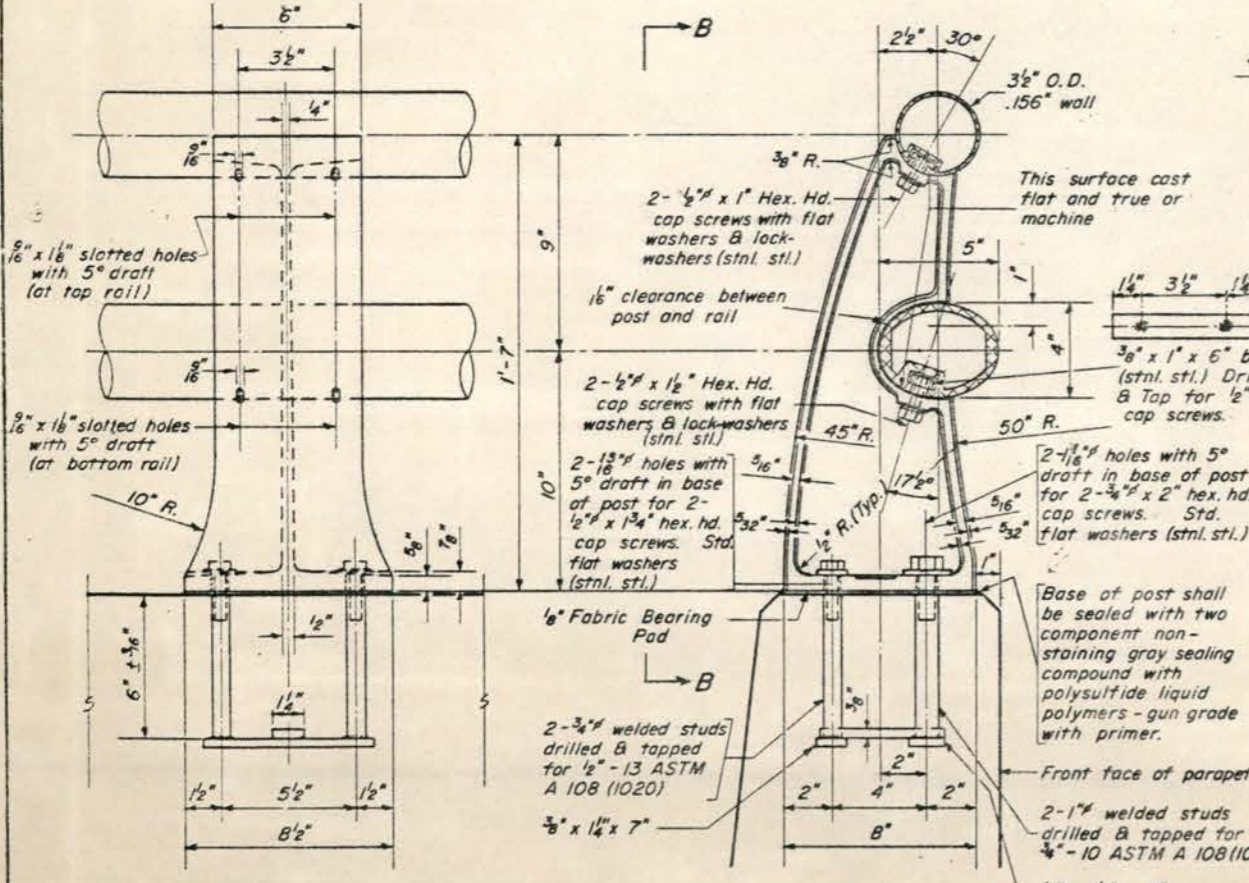


VIEW B-B

SECTION A-A


RAIL POST DETAILS

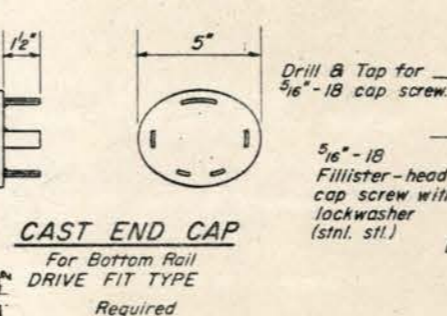


CAST END CAP  
For Bottom Rail  
DRIVE FIT TYPE  
Required

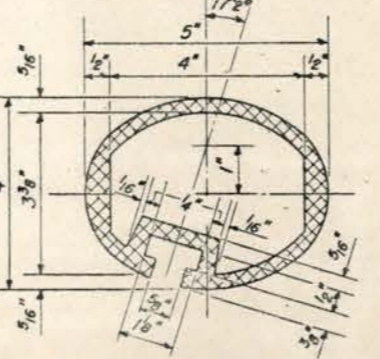


SEC. THRU ELLIPTICAL  
RAIL SECTION

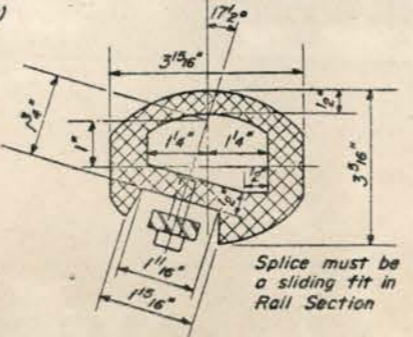


SEC. THRU SPLICE

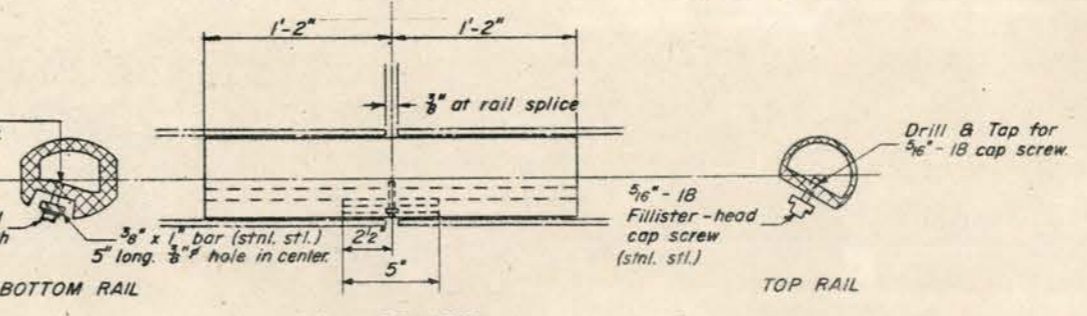


RAIL SPLICE  
Notch top of slot in rails to clear 1/8\"/>

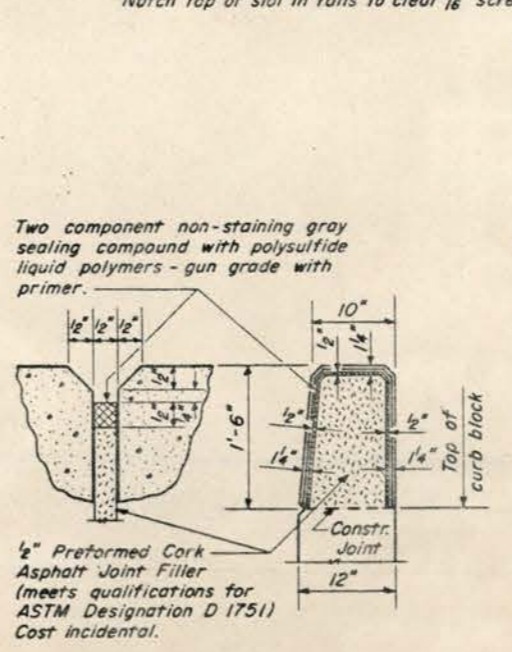

PARAPET JOINT DETAIL

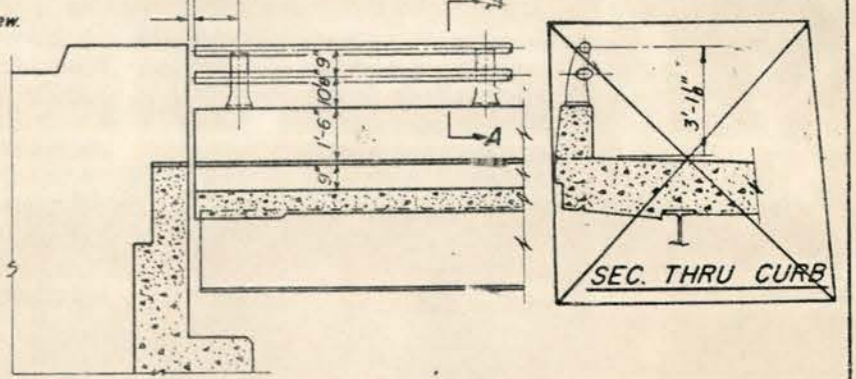

INSIDE VIEW AT ABUTMENT

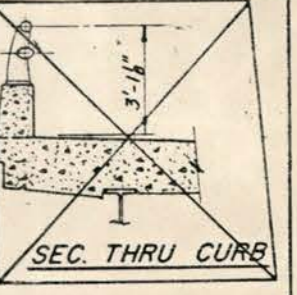


SEC. THRU CURB

BILL OF MATERIAL


Item	Unit	Quantity
ALUMINUM HANDRAIL	Lin. Ft.	4475

TYPE L  
ALUMINUM HANDRAIL  
OAK PARK AVENUE OVER  
F. A. I. RT 80 SEC 1313-81148  
COOK COUNTY STA 1313+37.93


DESIGNED	19
CHECKED	EXAMINED
DRAWN W. M. Best	PASSED
W. A. Sausaman Jr.	APPROVED
CHECKED	

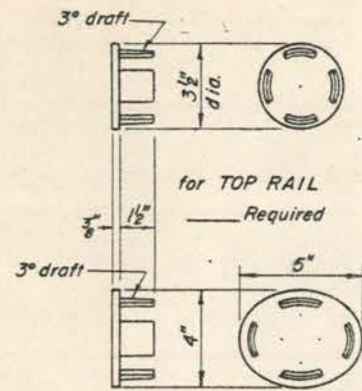

**CAST END CAPS**  
DRIVE FIT TYPE  
for BOTTOM RAIL  
Required

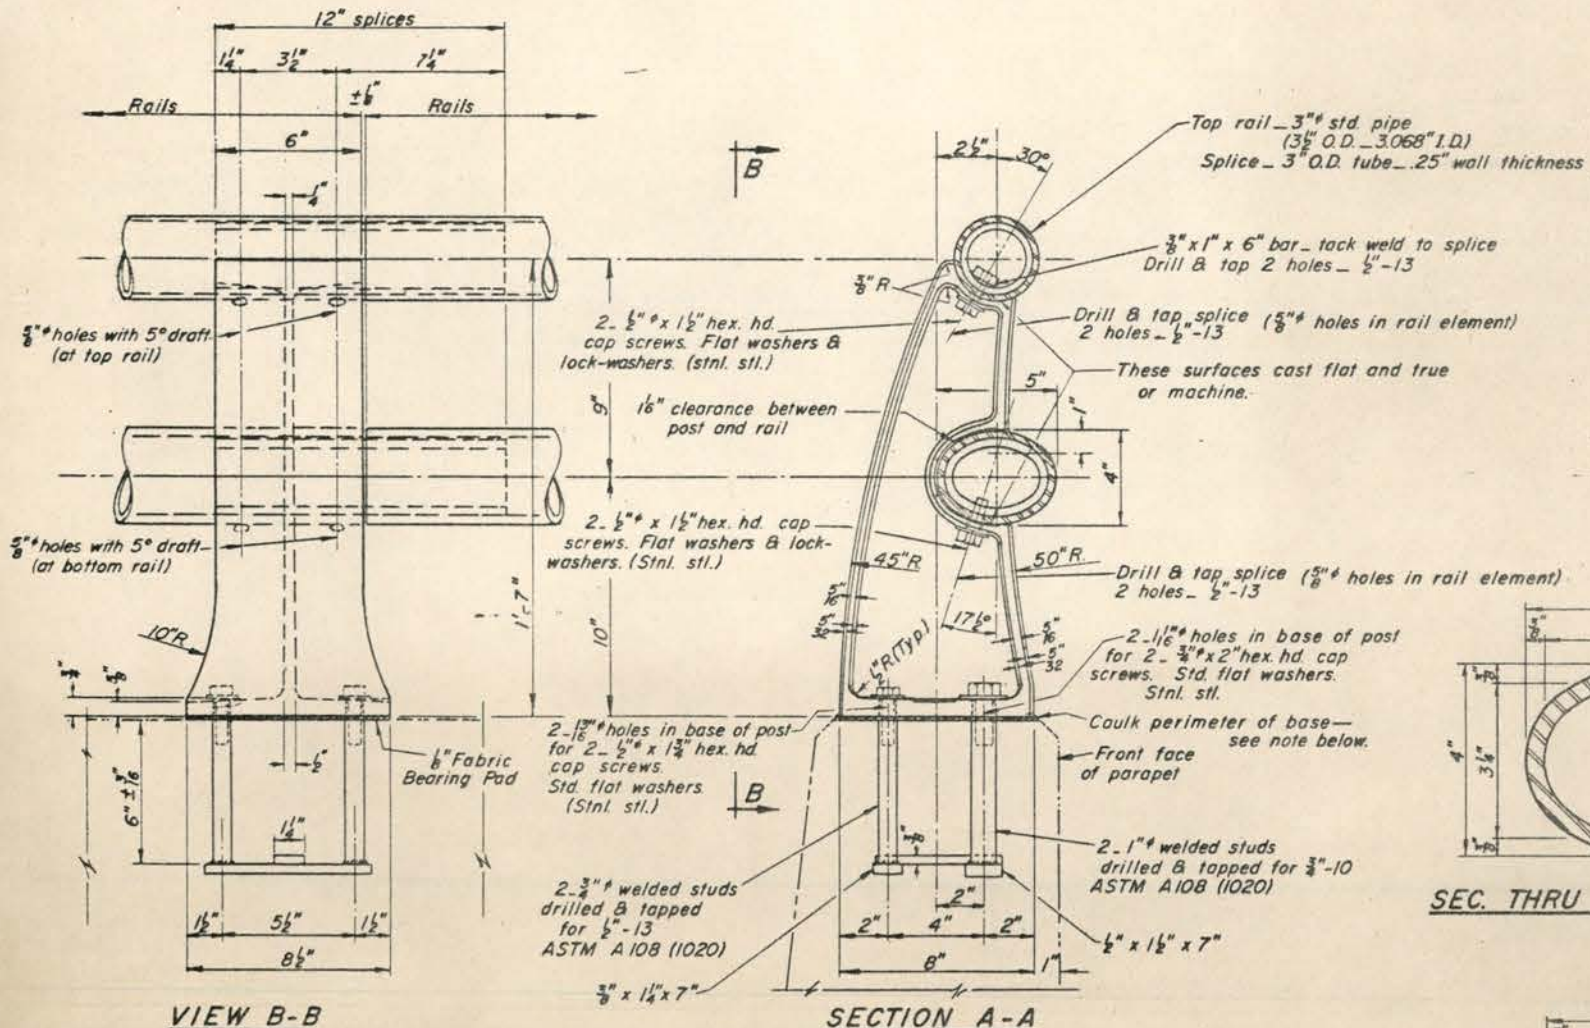

**RAIL POST DETAILS**

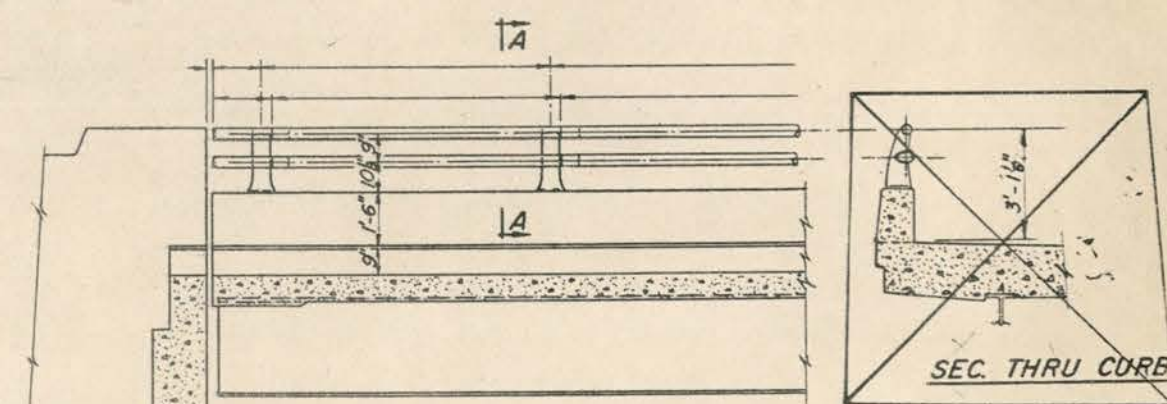


**INSIDE VIEW AT ABUTMENT**

**BILL of MATERIAL**


Item	Unit	Quantity
METAL HANDRAIL	Lin. Ft.	4473

Two component non-staining gray sealing compound with polysulfide liquid polymers—gun grade with primer.

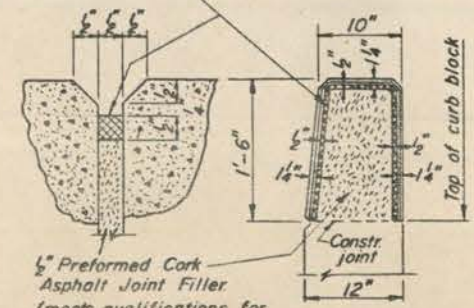


**PARAPET JOINT DETAIL**

**TYPE M METAL HANDRAIL**  
OAK PARK AVENUE OVER  
F.A.I. RT. 80 SEC. 13/3 R11/HB  
COOK COUNTY STA. 13/3+37.93

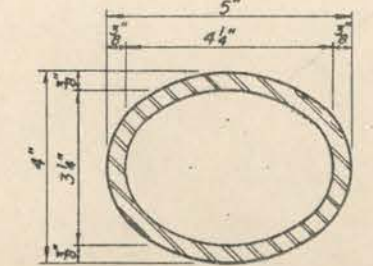

**SEC. THRU BOTTOM RAIL**

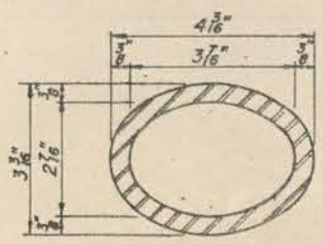

**SEC. THRU BOTTOM SPLICE**

DESIGNED	19
CHECKED	EXAMINED
DRAWN Wm. M. Best	PASSED
CHECKED	APPROVED

Note! Seal base of post to parapet with two component non-staining gray sealing compound with polysulfide liquid polymers—gun grade with primer.

Note! Splice must be sliding fit in Rail Section.