


RT. FA 68

SEC. (37, 101) BVB

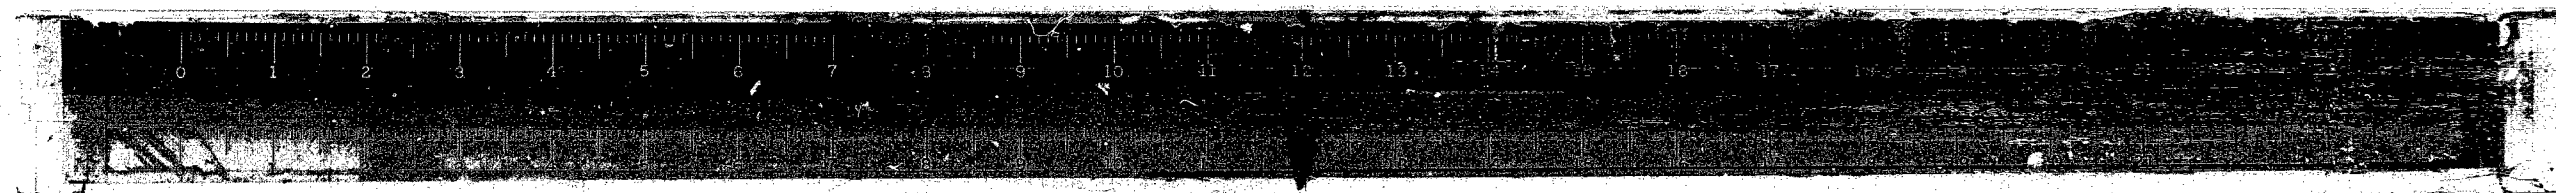

State

STATE OF ILLINOIS  
DEPARTMENT OF TRANSPORTATION


PLANS FOR PROPOSED  
FEDERAL AID HIGHWAY

Sheet No.	INDEX OF SHEETS
1	Cover Sheet
2-3	Typical Sections
4-5	Details
6	Summary of Quantities
7-11	Quantity Schedule
12-16	Plan & Profile - F.A. 24
17-18	Plan & Profile - S.R. Sta. 125 + 50
19-40	Bridge Plans
41-65	Cross Sections - F.A. 24
66-67	Cross Sections - S.R. Sta. 125 + 50

STANDARDS

- 1686-4 Standard Symbols and Abbreviations
- 1744-4 Right-of-Way Markers
- 2113-1 Name Plate for Bridges
- 2117-1 Bituminous Patching Details
- 2135 Permanent Survey Markers
- 2228-4 Metal End Section for Pipe Culvert
- 2237-10 Shoulder Detail \*
- 2249-4 Inlet Box
- 2258-3 Paved Ditch
- 2262-3 Precast R.C. Flared End Section
- 2298-4 Typical Application of Traffic Control Devices
- 2299-7 Design of Traffic Control Devices
- 2300-1 Flagman Traffic Control Sign
- 2301-3 Traffic Control Devices
- 2302-3 Traffic Control Devices
- 2303-4 Traffic Control Devices
- 2305-3 Traffic Control Devices
- 2307-4 Traffic Control Devices
- 2322-1 Bituminous Curb and Concrete Inlet For Stabilized Shoulders \*

\* For Information Only


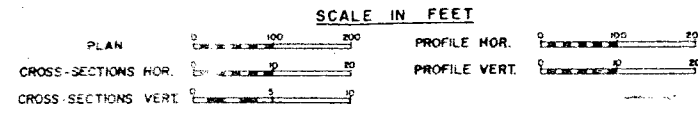


F.A. ROUTE 68  
SECTION (37,101)BVB  
PROJECT BR-F-F-68(24)  
LIVINGSTON COUNTY  
C-93-019-78

F.A. Route 68  
Formerly F.A. Route 24

ROUTE NO.	SECTION	COUNTY	PROJECT NO.
EA. 68	37, 101	LIVINGSTON	67 1
STA.	BVB		
PROJECT BR-F-F-68(24)			

P-93-031-66

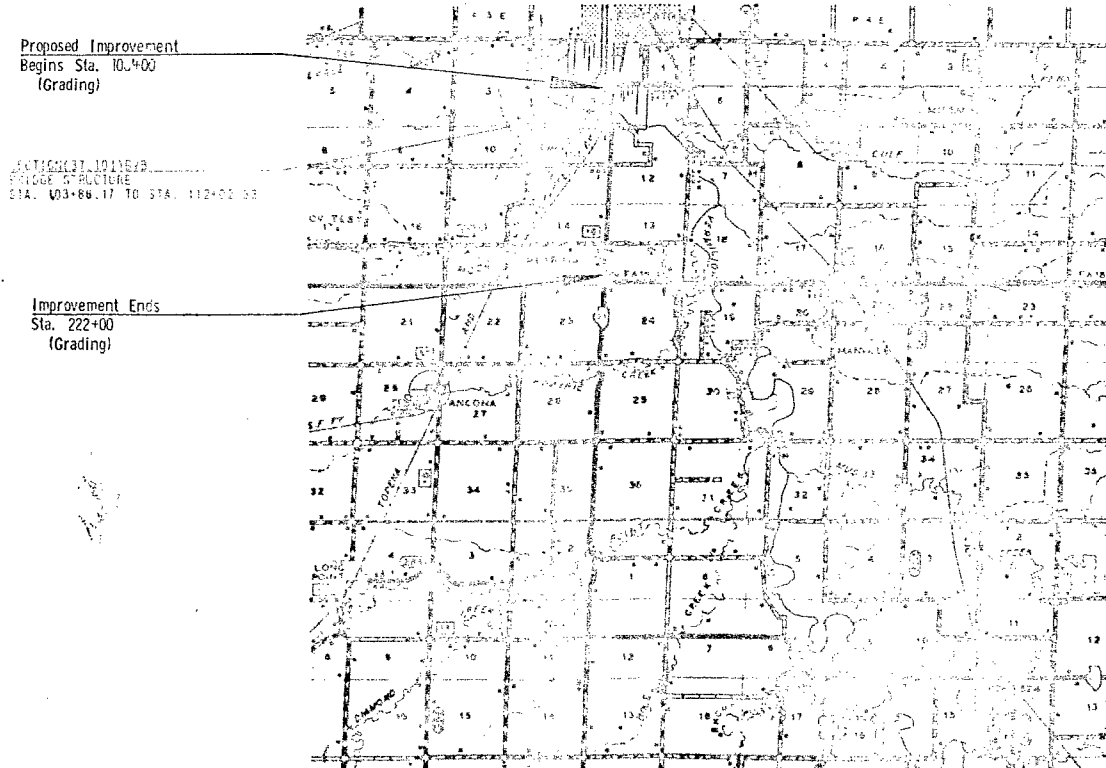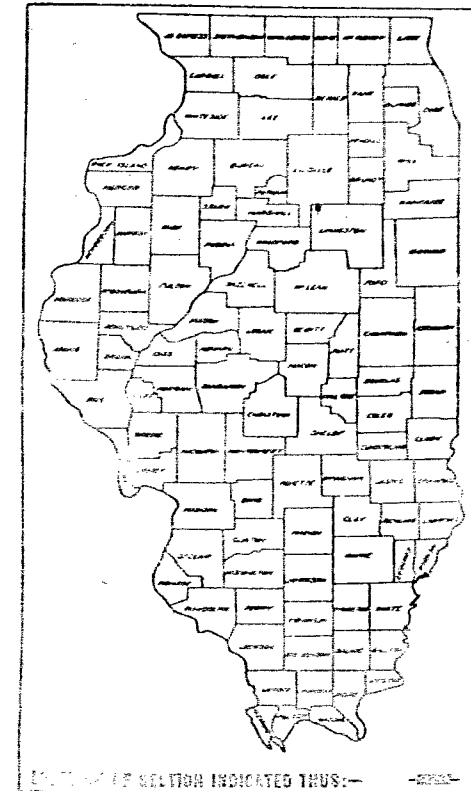

Net Length of Sections (37, 101)R, W & RS (Pregrade) = 11383.8 Ft. = 2.156 Miles  
 (37, 101) BVB = 816.16 Ft. = 0.155 Miles  
 Gross Length of Improvement 12200.00 Ft. = 2.311 Miles  
 Net Length of Improvement 12200.00 Ft. = 2.311 Miles

Design Designation:  
575(93) Major O. 661B-151

STATE OF ILLINOIS  
DEPARTMENT OF TRANSPORTATION

5/19/78  
8/25/78  
8/25/78  
8/25/78

THOMAS R. ENYET  
DIRECTOR OF HIGHWAY

DEPARTMENT OF TRANSPORTATION  
REGIONAL HIGHWAY ADMINISTRATION

APPROVED  
Jay W. Miller  
DIVISION ADMINISTRATOR

DATE  
4/23/78

STATE OF ILLINOIS  
DEPARTMENT OF TRANSPORTATION  
REGIONAL HIGHWAY ADMINISTRATION

CONTRACT NO. 88400

SCALE IN MILES

LIVINGSTON COUNTY SECTION (37, 101) BVB F.A. ROUTE 68

Rev. 9-12-78

STC


STATE OF ILLINOIS  
DEPARTMENT OF TRANSPORTATION

ROUTE NO.	SECTION	COUNTY	SHEET
EA. 68	37, 101	LIVINGSTON	67
BVB			1
STA.	PROJECT BR-F-F-68(24)		

P-93-031-66


Sheet No.	INDEX OF SHEETS
1	Cover Sheet
2-3	Typical Sections
4-5	Details
6	Summary of Quantities
7-11	Quantity Schedule
12-16	Plan & Profile - F.A. 24
17-18	Plan & Profile - S.R. Sta. 125 + 50
19-40	Bridge Plans
41-65	Cross Sections - F.A. 24
66-67	Cross Sections - S.R. Sta. 125 + 50

PLANS FOR PROPOSED  
FEDERAL AID HIGHWAY

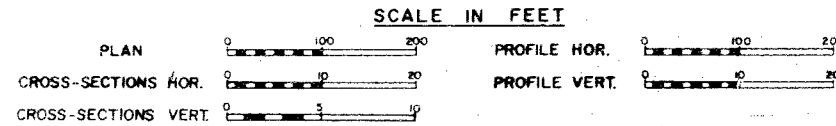

F.A. ROUTE 68  
SECTION (37, 101)BVB  
PROJECT BR-F-F-68(24)  
LIVINGSTON COUNTY  
C-93-019-78

F. A. Route 68  
Formerly F. A. Route 24

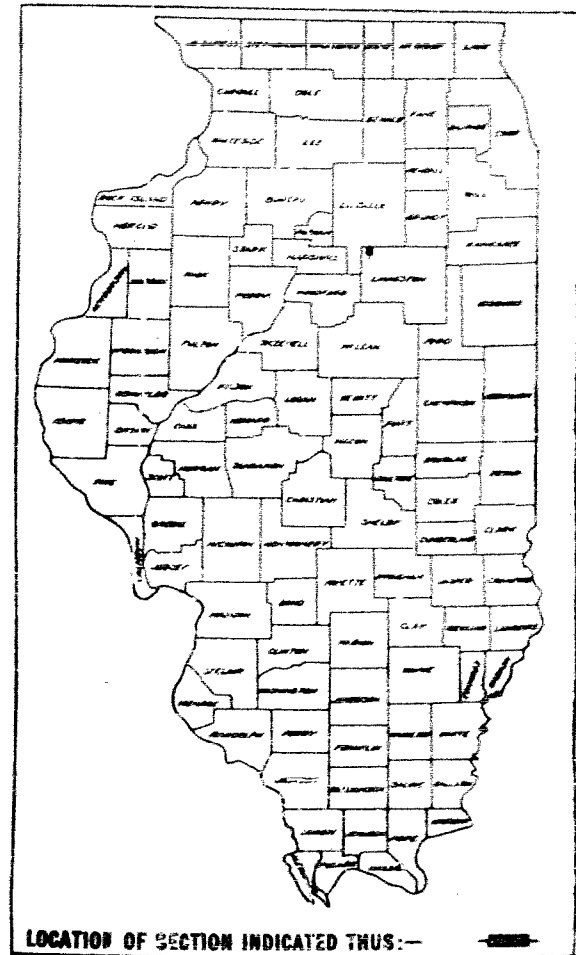

STANDARDS


1686-4	Standard Symbols and Abbreviations
1744-4	Right-of-Way Markers
2113-1	Name Plate for Bridges
2117-1	Bituminous Patching Details
2135	Permanent Survey Markers
2228-4	Metal End Section for Pipe Culvert
2237-10	Shoulder Detail
2249-4	Inlet Box
2258-3	Paved Ditch
2262-3	Precast R. C. Flared End Section
2298-4	Typical Application of Traffic Control Devices
2299-7	Design of Traffic Control Devices
2300-1	Flagman Traffic Control Sign
2301-3	Traffic Control Devices
2302-3	Traffic Control Devices
2303-4	Traffic Control Devices
2305-3	Traffic Control Devices
2307-4	Traffic Control Devices
2322-1	Bituminous Curb and Concrete Inlet For Stabilized Shoulders

\* For Information Only


Proposed Improvement  
Begins Sta. 100+00  
(Grading)

SECTION (37, 101)BVB  
BRIDGE STRUCTURE  
STA. 103+88.17 TO STA. 112+02.33

Improvement Ends  
Sta. 222+00  
(Grading)

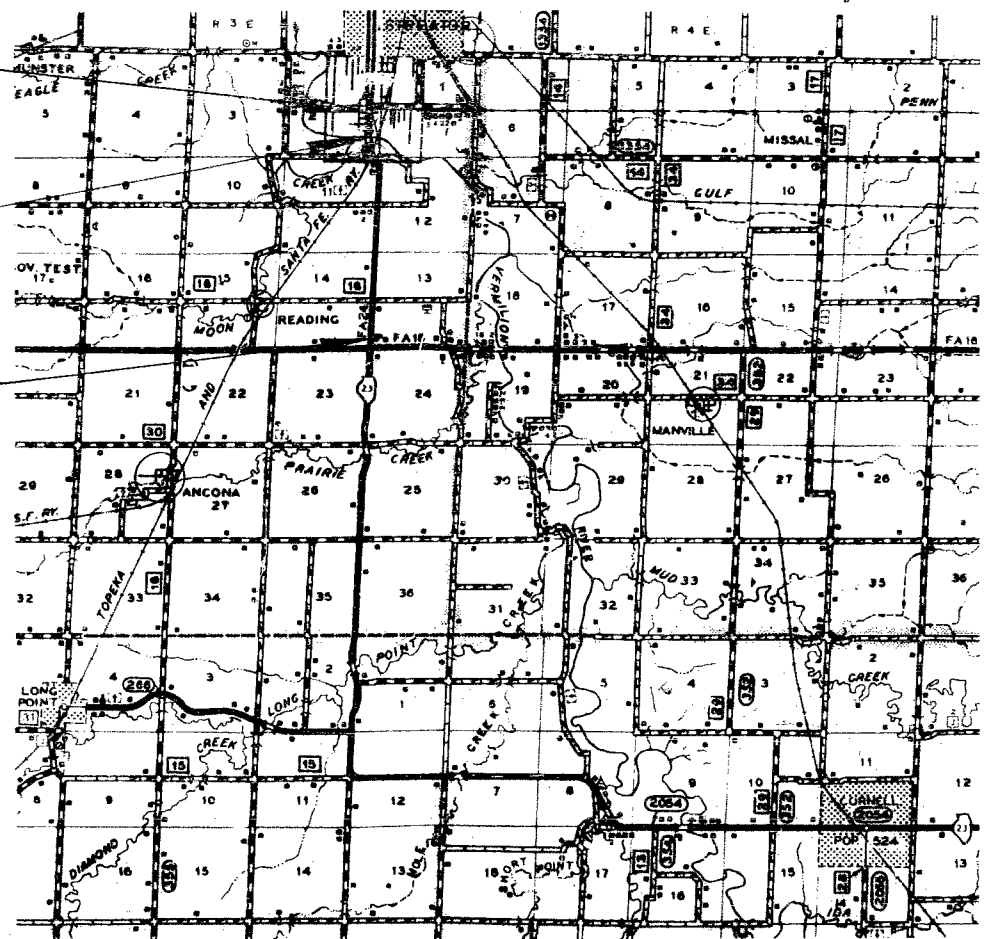

 Net Length of Sections (37, 101)R, W & RS (Pregrade) = 11383.8 Ft. = 2.156 Miles  
(37, 101) BVB = 816.16 Ft. = 0.155 Miles  
Gross Length of Improvement 12200.00 Ft. = 2.311 Miles  
Net Length of Improvement 12200.00 Ft. = 2.311 Miles



Design Designation:  
575(93) Major 0.66(B-15)

STATE OF ILLINOIS  
DEPARTMENT OF TRANSPORTATION

DATE: 5/19/78  
DRAWN BY: [Signature]  
CHECKED BY: [Signature]  
PREPARED BY: [Signature]  
APPROVED BY: [Signature]  
DIRECTOR OF HIGHWAY

DEPARTMENT OF TRANSPORTATION  
FEDERAL HIGHWAY ADMINISTRATION

APPROVED: [Signature] DATE: [ ]

DIVISION ADMINISTRATOR

STODROP & PARCEL AND ASSOCIATES, INC.  
ENGINEERS - ARCHITECTS  
ST. LOUIS, MISSOURI

[Signature]

CONTRACT NO. 93400


STATE OF ILLINOIS  
DEPARTMENT OF TRANSPORTATION

PROJECT NO. 13-1-72  
SHEET NO. 11-14-78  
F.A. 68 (37, 101) BVB LIVINGSTON 67 1A  
BR-F-F-68(24)

Sheet No. INDEX OF SHEETS

- 1, 1A Cover Sheet
- 2-3 Typical Sections
- 4-5 Details
- 6 Summary of Quantities
- 7-11 Quantity Schedule
- 12-16 Plan & Profile - F.A. 24
- 17-18 Plan & Profile - S.R. Sta. 125 + 50
- 19-40, 37A Bridge Plans
- 41-65 Cross Sections - F.A. 24
- 66-67 Cross. Sections - S.R. Sta. 125 + 50


PLANS FOR PROPOSED  
FEDERAL AID HIGHWAY

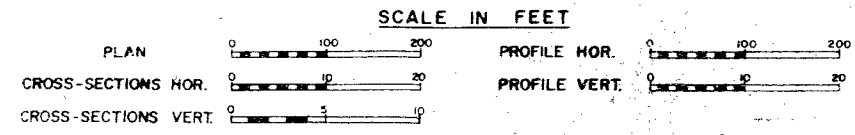

F.A. ROUTE 68  
SECTION (37, 101) BVB  
PROJECT BR-F-F-68(24)  
LIVINGSTON COUNTY


C-93-019-78

F. A. Route 68  
Formerly F. A. Route 24

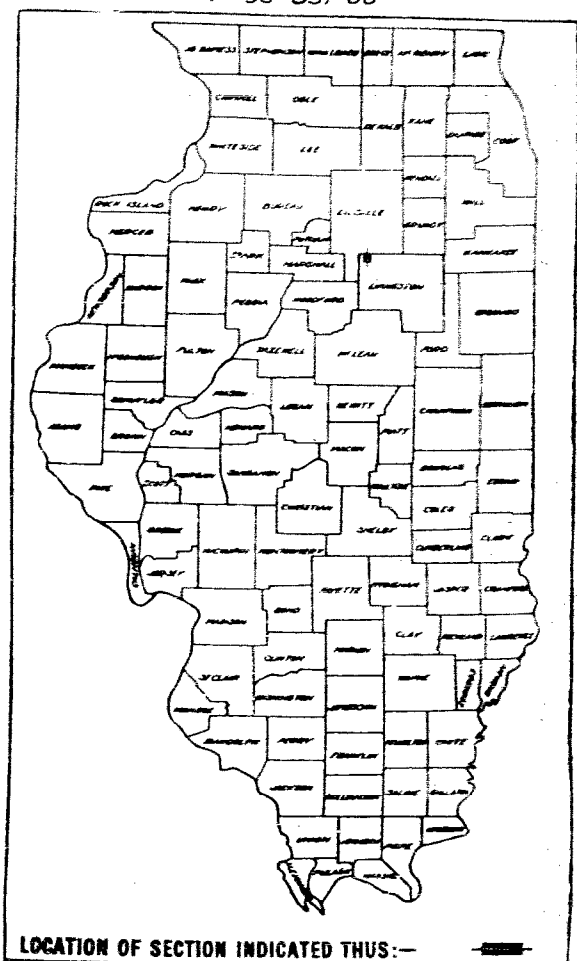


- STANDARDS
- 1686-4 Standard Symbols and Abbreviations
  - 1744-4 Right-of-Way Markers
  - 2113-1 Name Plate for Bridges
  - 2117-1 Bituminous Patching Details
  - 2135 Permanent Survey Markers
  - 2228-4 Metal End Section for Pipe Culvert
  - 2237-10 Shoulder Detail
  - 2249-4 Inlet Box
  - 2258-3 Paved Ditch
  - 2262-3 Precast R. C. Flared End Section
  - 2298-4 Typical Application of Traffic Control Devices
  - 2299-7 Design of Traffic Control Devices
  - 2300-1 Flagman Traffic Control Sign
  - 2301-3 Traffic Control Devices
  - 2302-3 Traffic Control Devices
  - 2303-4 Traffic Control Devices
  - 2305-3 Traffic Control Devices
  - 2307-4 Traffic Control Devices
  - 2322-1 Bituminous Curb and Concrete Inlet For Stabilized Shoulders \*

\* For Information Only

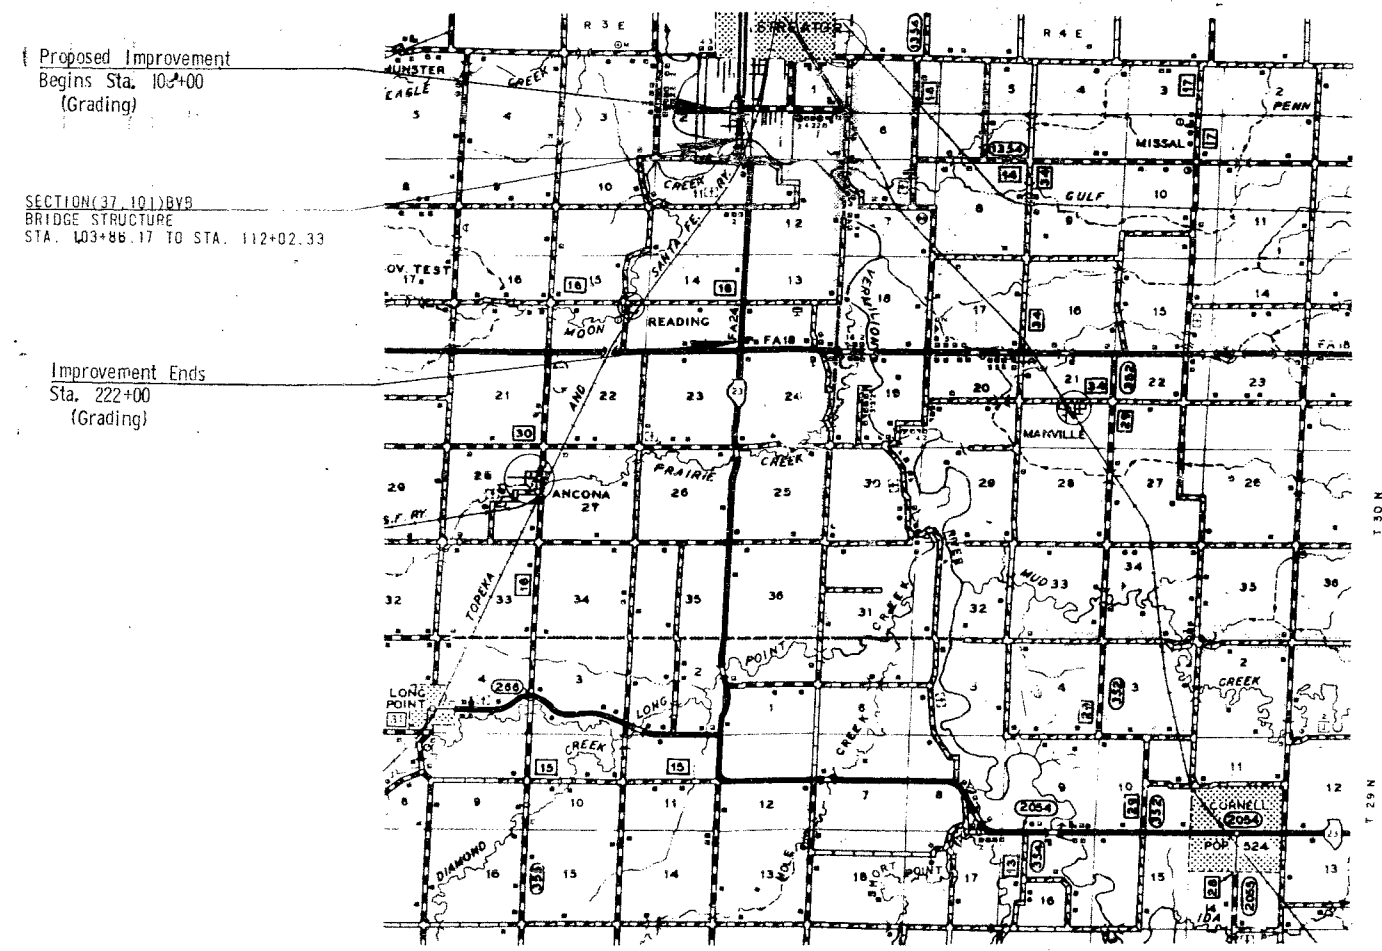

AS REVISED

Net Length of Sections (37, 101)R, W & RS (Prergrade) = 11383.8 Ft. = 2.156 Miles  
(37, 101) BVB = 816.16 Ft. = 0.155 Miles  
Gross Length of Improvement 12200.00 Ft. = 2.311 Miles  
Net Length of Improvement 12200.00 Ft. = 2.311 Miles

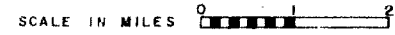

Design Designation:  
575(93) Major Q. 66(B-15)

STATE OF ILLINOIS  
DEPARTMENT OF TRANSPORTATION

SUBMITTED: 5/19/78  
EXAMINED: 8/25/78  
PASSED: 8/25/78  
APPROVED: 8/25/78

DIRECTOR OF HIGHWAY

DEPARTMENT OF TRANSPORTATION  
FEDERAL HIGHWAY ADMINISTRATION

APPROVED: [ ] DATE: [ ]



DIVISION ADMINISTRATOR

SYVERDRUP & PARCELAND ASSOCIATES, INC.  
ENGINEERS - ARCHITECTS  
ST. LOUIS, MISSOURI






Henry A. Boyford

CONTRACT NO. 33400

ROUTE NO.	SECTION	COUNTY	TOTAL SHEETS	SHEET NO.
S.B.1	(200)	LIVINGSTON	67	2
FA. 24	BVA			
FED. ROAD DIST. NO. 7	ILLINOIS	FED. AID PROJECT		

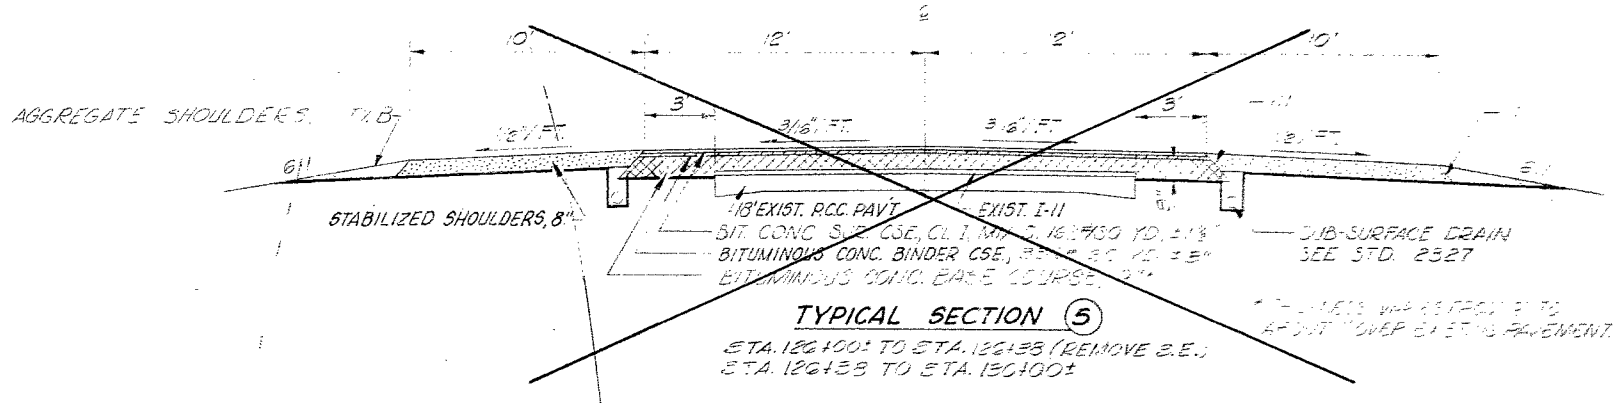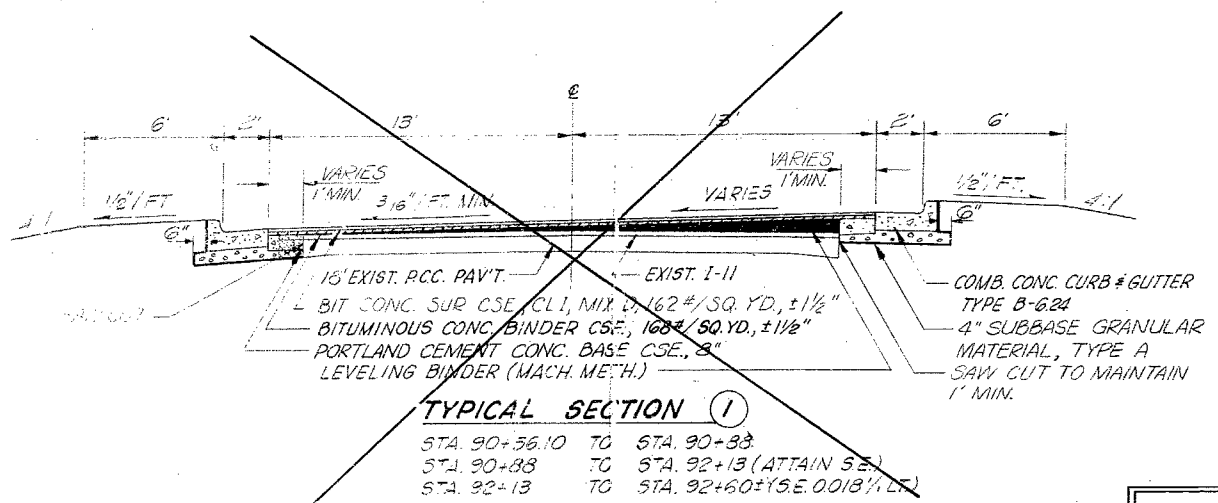

All references to "F.A. Route 24" throughout these Plans shall be construed to mean "F.A. Route 68."

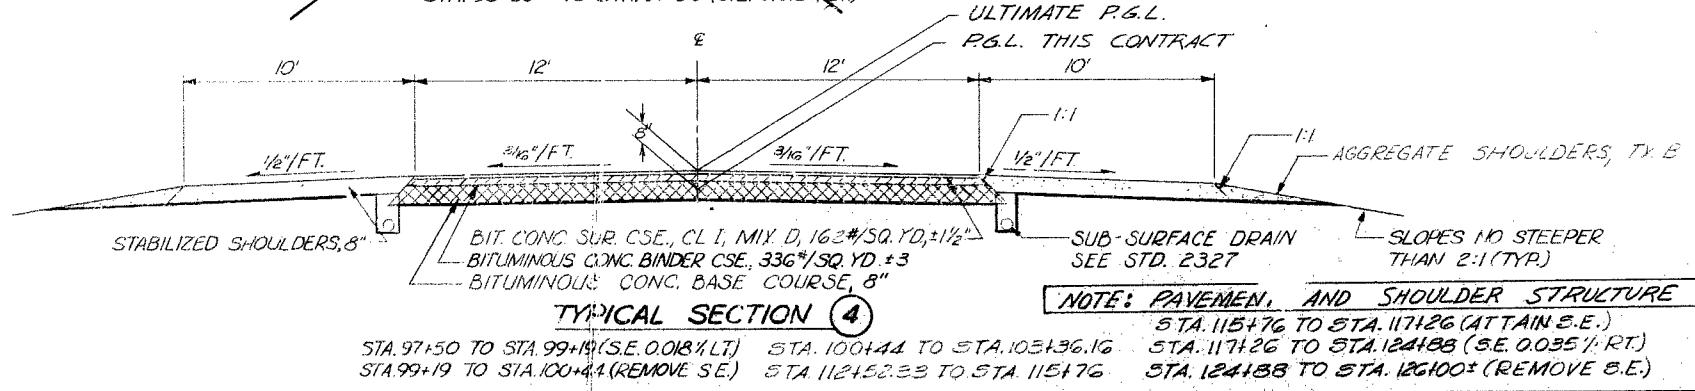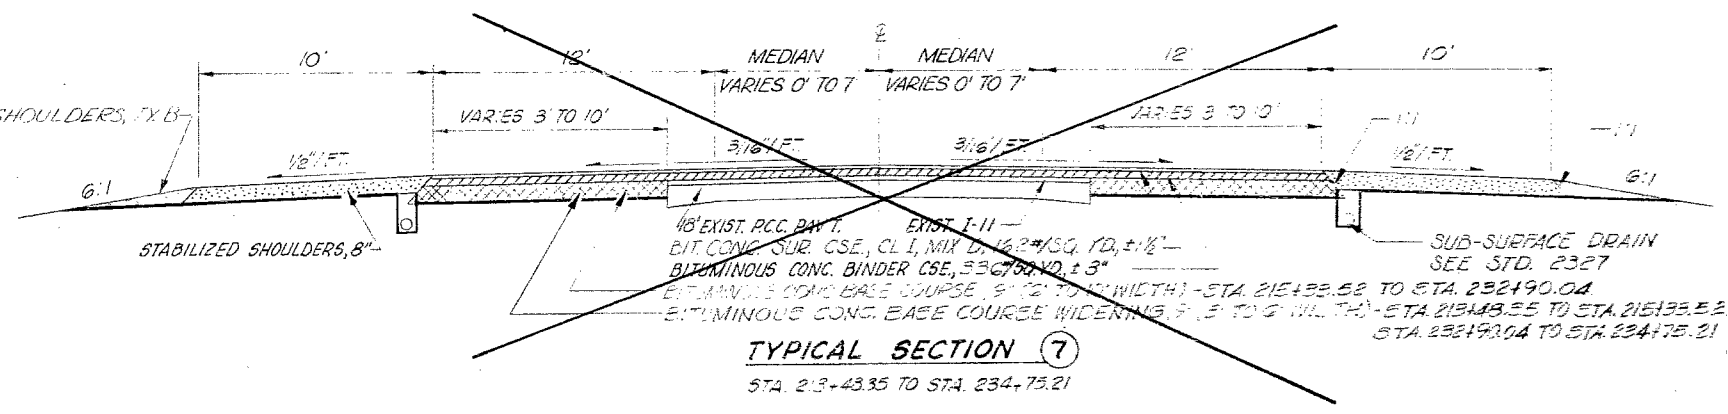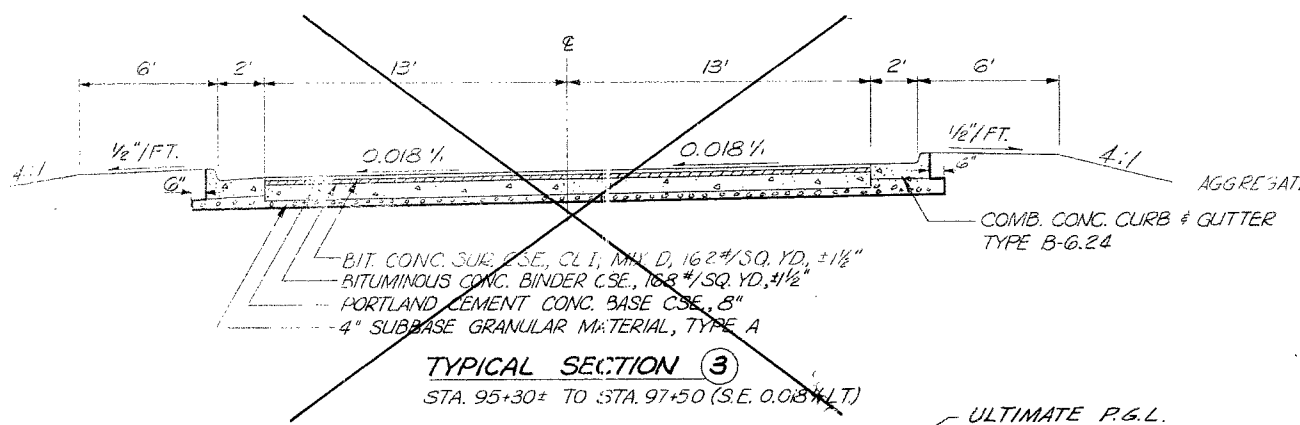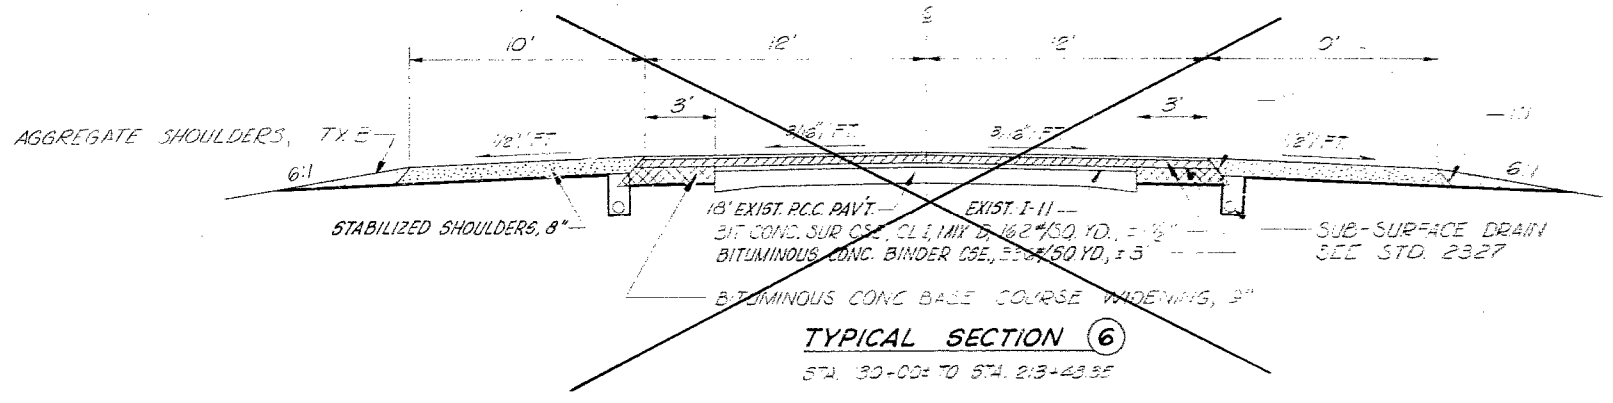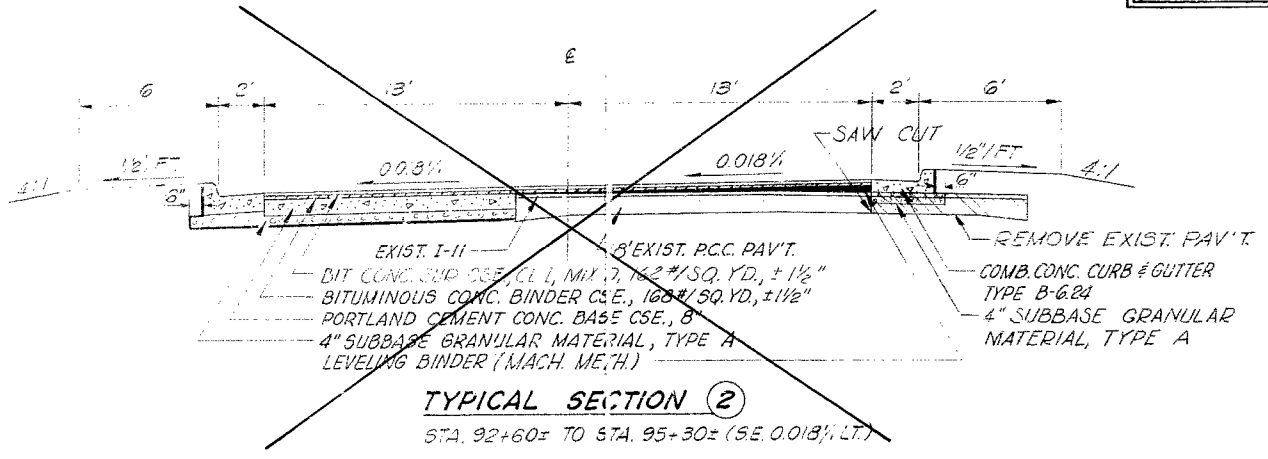


NOTE: PAVEMENT AND SHOULDER STRUCTURE FOR INFORMATION ONLY.

TYPICAL SECTIONS  
 F.A. ROUTE 24

3291


ROUTE NO.	SECTION	COUNTY	TOTAL SHEETS	SHEET NO.
24	BVB	LIVINGSTON	67	3
FED. ROAD DIST. NO. 7, ILLINOIS FED. AID PROJECT				

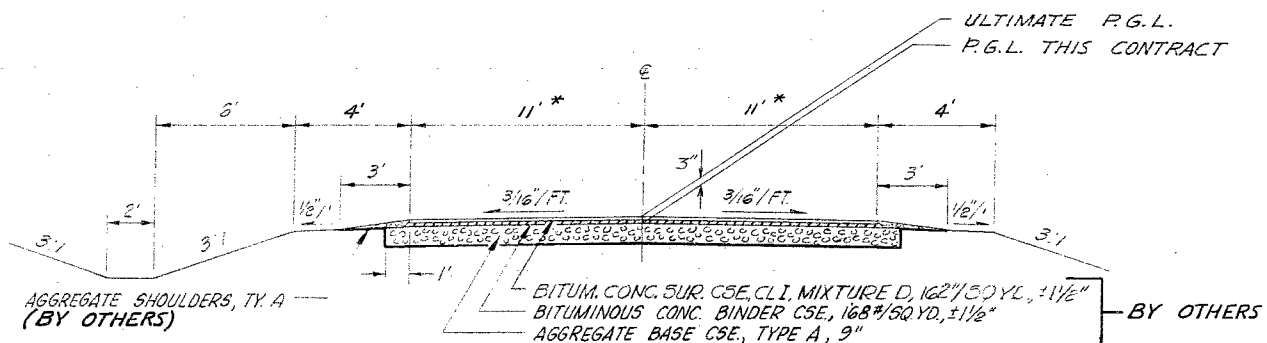

NOTE: PAVEMENT AND SHOULDER STRUCTURE FOR INFORMATION ONLY (BY OTHERS).


**TYPICAL SECTION ⑧ SIDE ROAD RIGHT STA. 125+50 AND DETOUR**

- STA. 2+57 TO STA. 6+08
- STA. 6+08 TO STA. 7+08 (ATTAIN S.E.)
- STA. 7+08 TO STA. 8+35 (S.E. 0.028% RT.)
- STA. 8+35 TO STA. 9+35 (REMOVE S.E.)
- STA. 9+35 TO STA. 9+50
- STA. 12+20± TO STA. 14+24 (S.E. 0.040% RT.)
- STA. 14+24 TO STA. 15+28 (REMOVE S.E.)
- STA. 15+28 TO STA. 16+31 (ATTAIN S.E.)
- STA. 16+31 TO STA. 18+68 (S.E. 0.040% LT.)
- STA. 18+68 TO STA. 19+68 (REMOVE S.E.)
- STA. 19+68 TO STA. 19+90±
- DETOUR - STA. 17+44 TO STA. 21+94.14
- SIDE ROAD - STA. 6+75 \* 10'

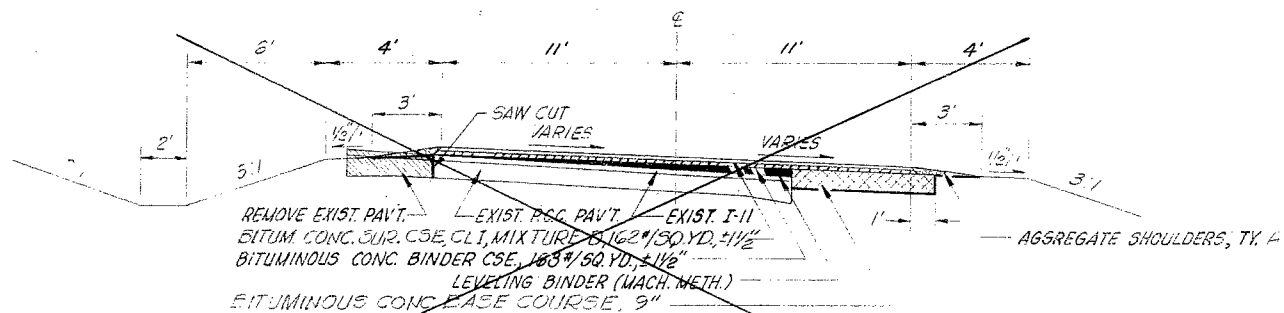


**TYPICAL SECTION ⑨ SIDE ROAD RIGHT STA. 125+50**

- STA. 10+32 TO STA. 11+32 (ATTAIN S.E.)
- STA. 11+32 TO STA. 12+20± (S.E. 0.040% RT.)

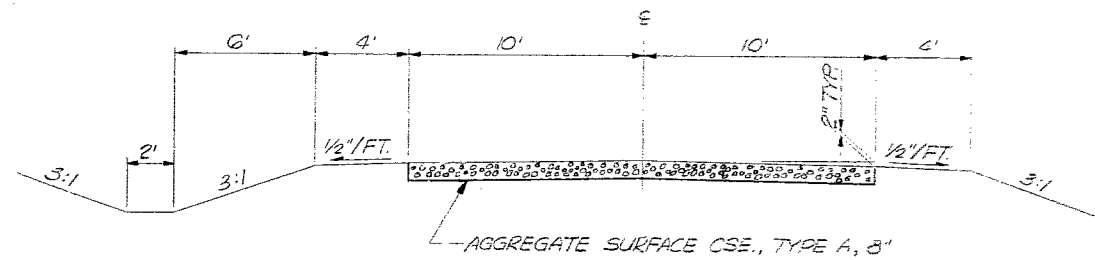


**TYPICAL SECTION ⑫ SIDE ROADS**

- STA. 144+11.6 LEFT & RIGHT
- STA. 197+44.5 LEFT
- STA. 197+48.8 RIGHT

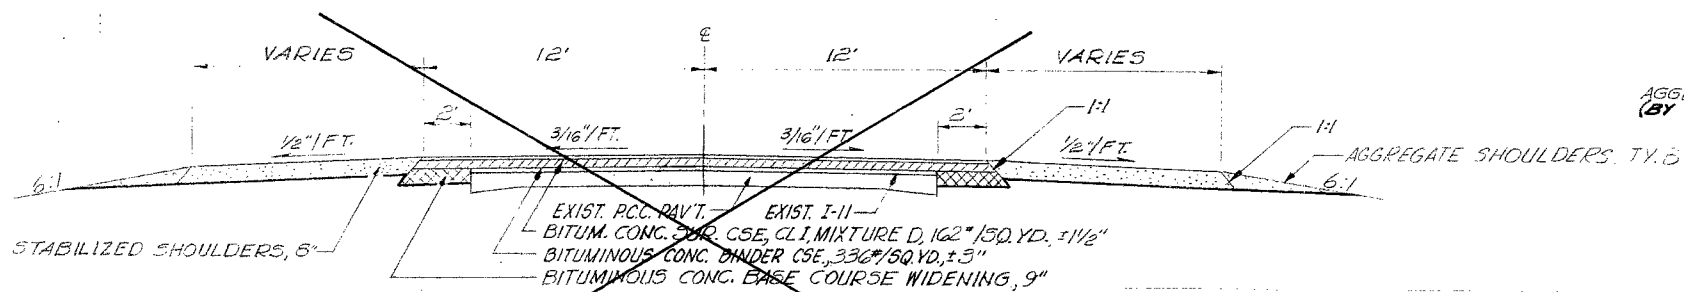


**TYPICAL SECTION ⑩ F.A. ROUTE 18**

- STA. 6+90.84 TO STA. 9+81
- STA. 10+19 TO STA. 12+59.10

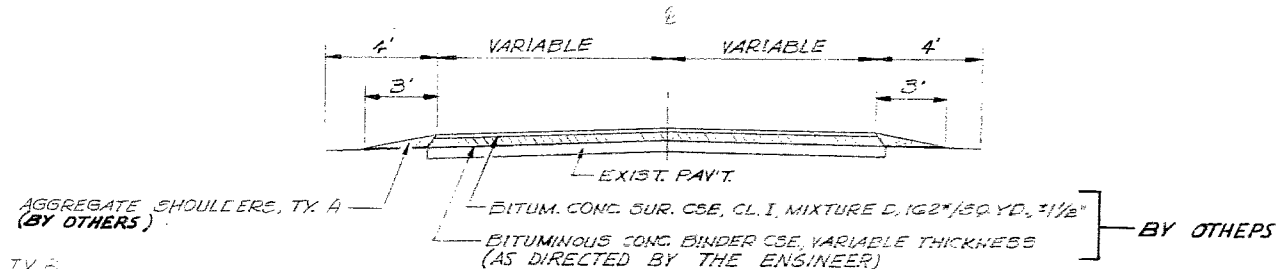

**TYPICAL SECTION ⑬ SIDE ROADS**

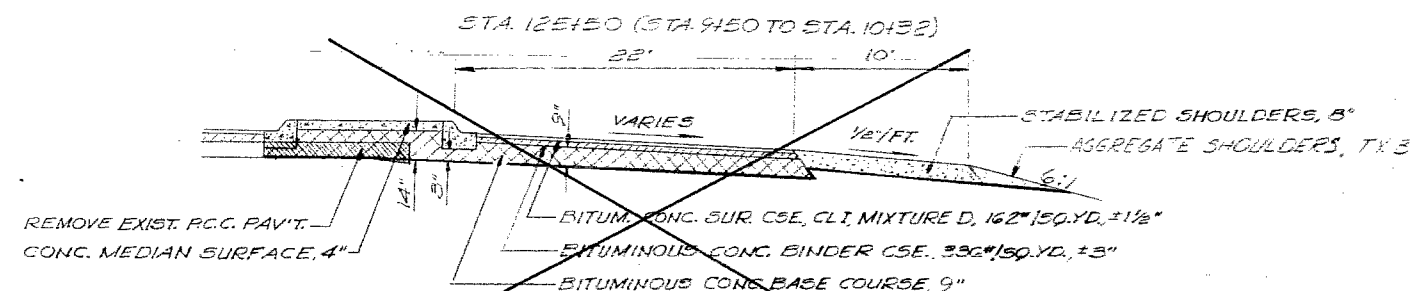

**TYPICAL SECTION ⑭**

TURNING ROADWAYS AT F.A. ROUTE 18

**TYPICAL SECTIONS**

State of Illinois  
Department of Transportation  
District Three

Reviewed By: Craig A. Chisholm  
District Engineer of Design

Date: 5-22-72

Examined By: Claude R. ...  
District Engineer of Construction


Alvin ...  
District Engineer of Maintenance

William N. ...  
District Engineer of Materials


Alvin Jensen  
District Engineer of Traffic

District Engineer of Planning


ROUTE NO.	SECTION	COUNTY	TOTAL SHEETS	SHEET NO.
S.B.L.	137.00	LIVINGSTON	67	4
F.A. 24	B1B			
FED. ROAD DIST. NO. 7 ILLINOIS FED. AID PROJECT				

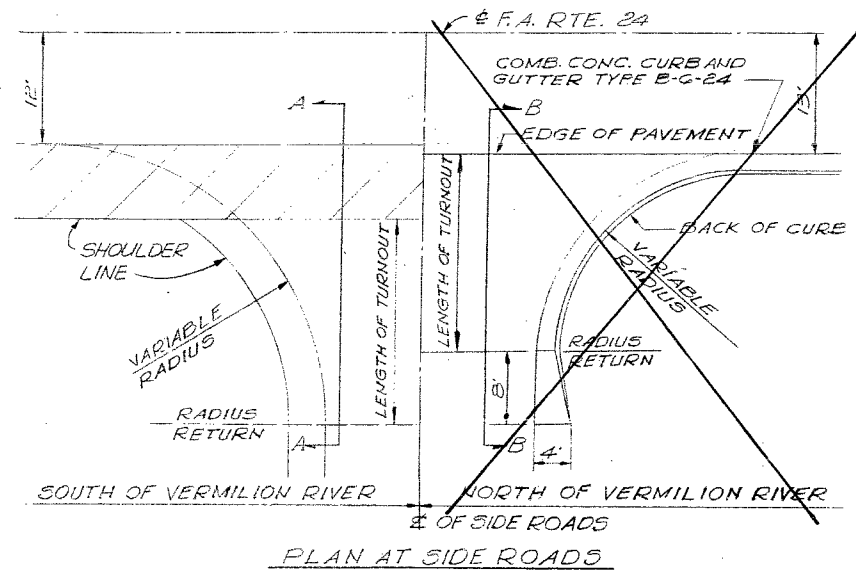


PLAN AT SIDE ROADS

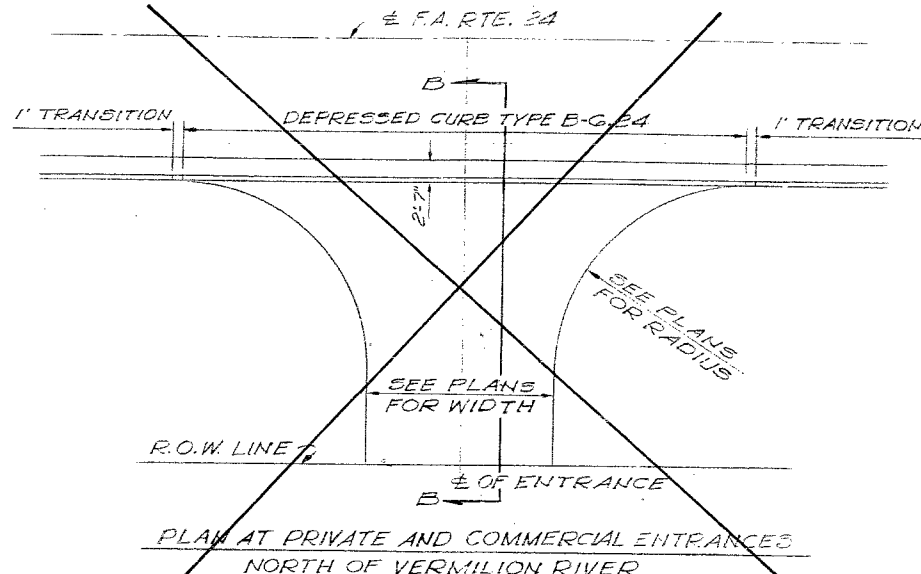

PLAN AT PRIVATE AND COMMERCIAL ENTRANCES NORTH OF VERMILION RIVER

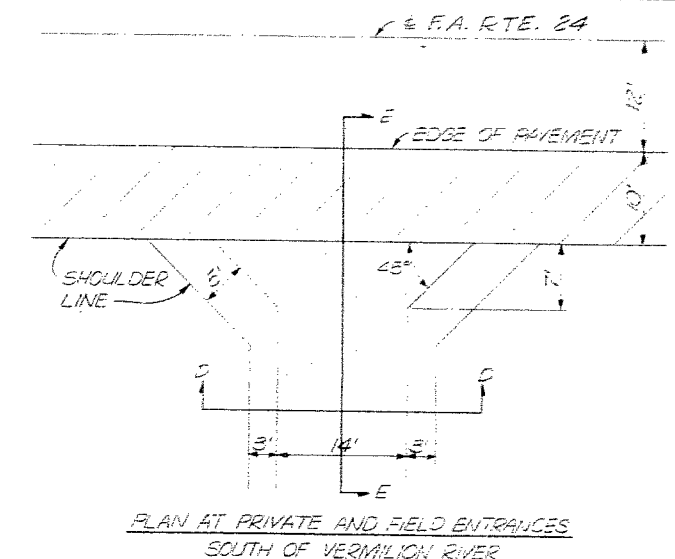


PLAN AT PRIVATE AND FIELD ENTRANCES SOUTH OF VERMILION RIVER

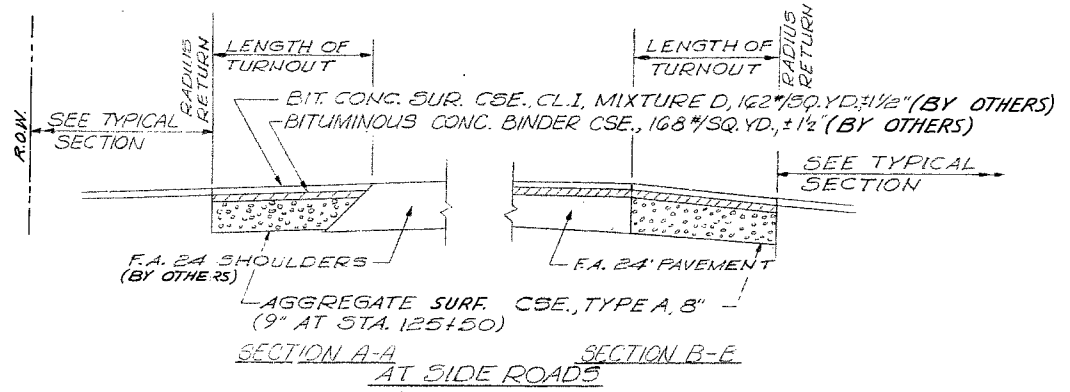


SECTION A-A AT SIDE ROADS


SECTION B-E AT SIDE ROADS

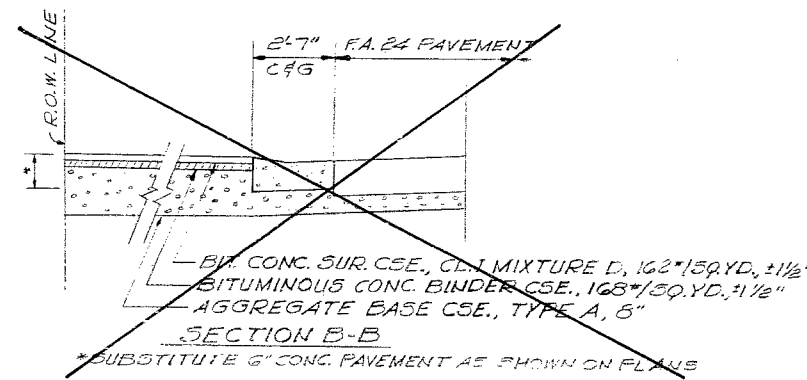


SECTION B-B

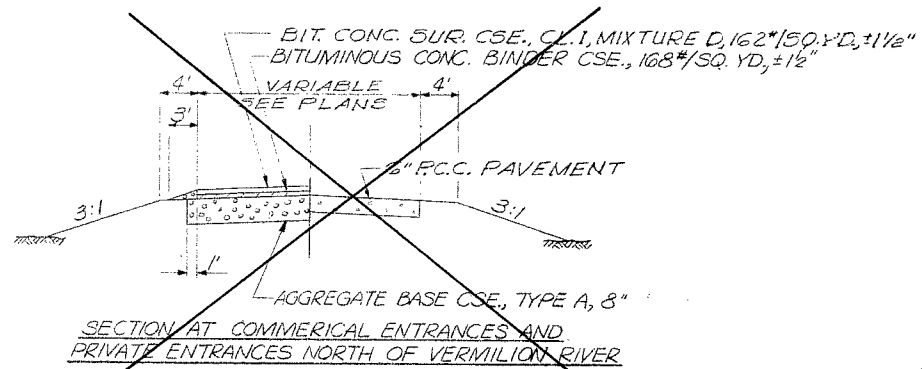

SECTION AT COMMERCIAL ENTRANCES AND PRIVATE ENTRANCES NORTH OF VERMILION RIVER

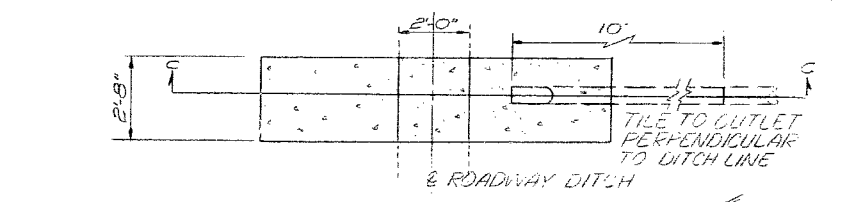


PLAN

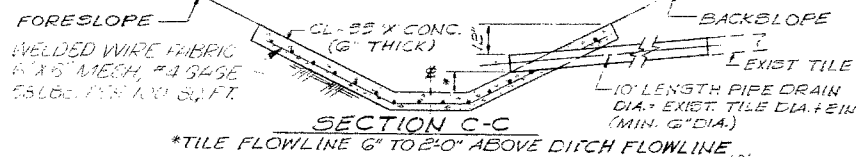


SECTION C-C


\*TILE FLOWLINE 6\"/>

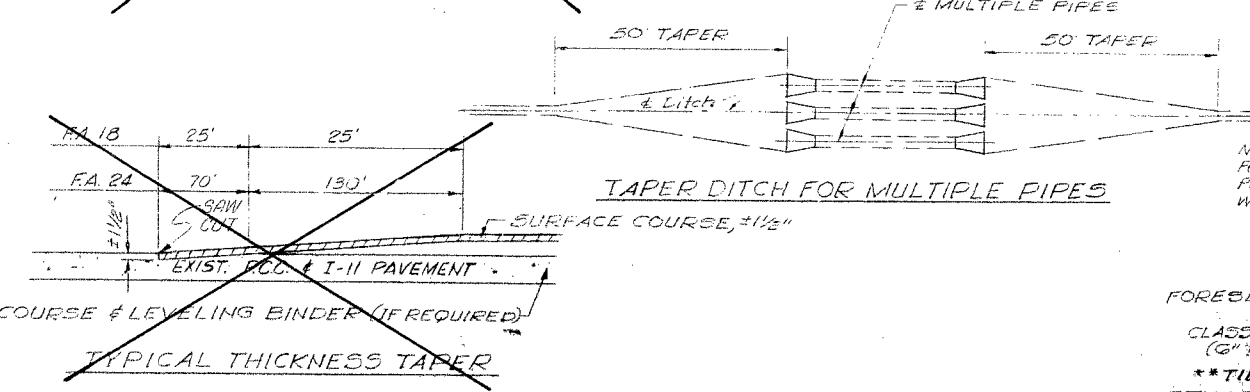

TAPER DITCH FOR MULTIPLE PIPES

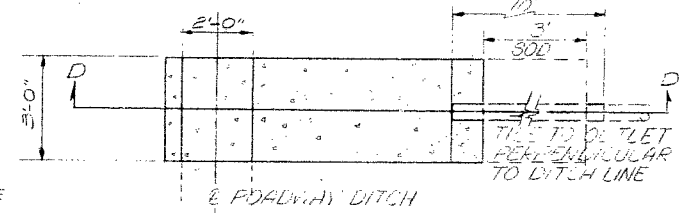


PLAN

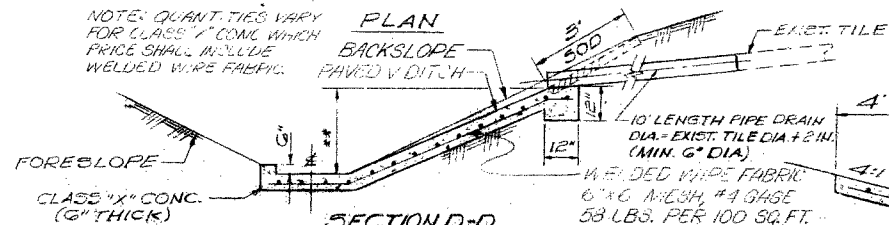


SECTION D-D


\*\*TILE FLOWLINE GREATER THAN 2\"/>

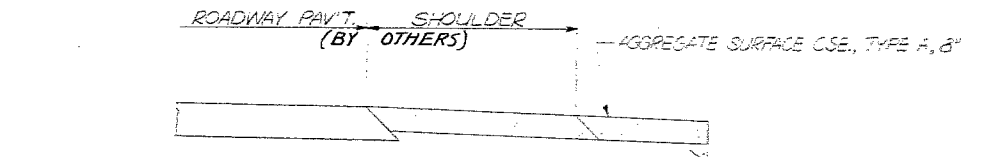

SECTION E-E

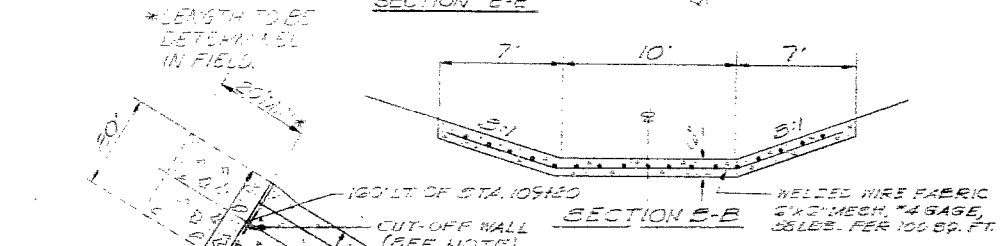

SECTION B-B

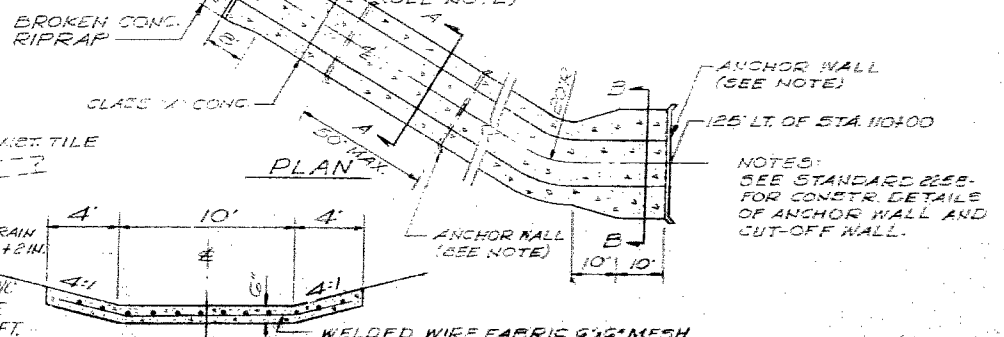


SECTION A-A (SPECIAL) PAVED DITCH (STA. 109420 TO STA. 110400)

NOTES: SEE STANDARD SPEC. FOR CONSTR. DETAILS OF ANCHOR WALL AND CUT-OFF WALL.

DETAILS

3391 750 2003

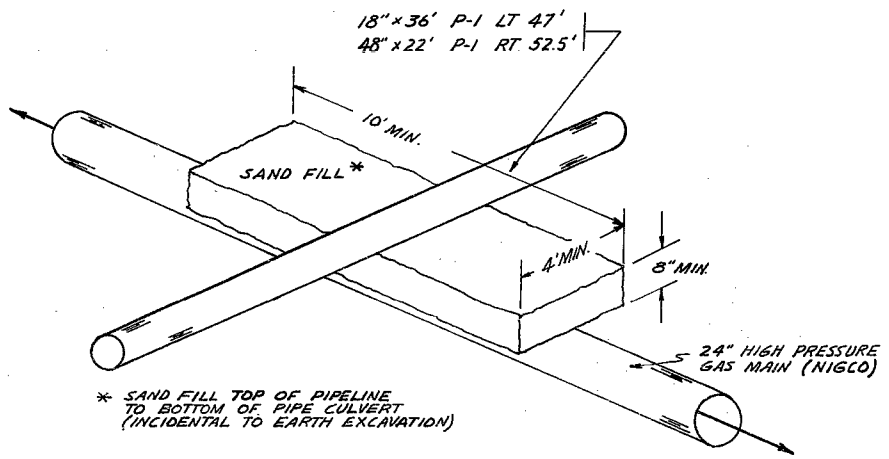

\* SAND FILL TOP OF PIPELINE TO BOTTOM OF PIPE CULVERT (INCIDENTAL TO EARTH EXCAVATION)

**PIPELINE PROTECTION \***

STA. 209+58 LT.  
STA. 210+00 RT.

\* SEE SPECIAL PROVISION

ADDITIONAL BE SUBJECT OF CONTRACT AND ENFORCEMENT BY THE ENGINEER. THE CONTRACTOR SHALL BE RESPONSIBLE FOR THE PROTECTION OF ALL UTILITIES AND STRUCTURES EXISTING ON THE PROJECT. THE CONTRACTOR SHALL BE RESPONSIBLE FOR THE PROTECTION OF ALL UTILITIES AND STRUCTURES EXISTING ON THE PROJECT. THE CONTRACTOR SHALL BE RESPONSIBLE FOR THE PROTECTION OF ALL UTILITIES AND STRUCTURES EXISTING ON THE PROJECT.

~~ADDITIONAL BE SUBJECT OF CONTRACT AND ENFORCEMENT BY THE ENGINEER. THE CONTRACTOR SHALL BE RESPONSIBLE FOR THE PROTECTION OF ALL UTILITIES AND STRUCTURES EXISTING ON THE PROJECT. THE CONTRACTOR SHALL BE RESPONSIBLE FOR THE PROTECTION OF ALL UTILITIES AND STRUCTURES EXISTING ON THE PROJECT. THE CONTRACTOR SHALL BE RESPONSIBLE FOR THE PROTECTION OF ALL UTILITIES AND STRUCTURES EXISTING ON THE PROJECT.~~

When along any edge of the right-of-way, the contractor shall be responsible for the protection of all utilities and structures existing on the project. The contractor shall be responsible for the protection of all utilities and structures existing on the project. The contractor shall be responsible for the protection of all utilities and structures existing on the project.

For the purpose of this contract, the contractor shall be responsible for the protection of all utilities and structures existing on the project. The contractor shall be responsible for the protection of all utilities and structures existing on the project. The contractor shall be responsible for the protection of all utilities and structures existing on the project.

**ONLY EARTHWORK SHOWN AS STAGE I ON THE CROSS-SECTIONS IS INCLUDED ON THIS CONTRACT.**

SEE SPECIAL PROVISIONS FOR PROTECTION OF UTILITIES AND STRUCTURES EXISTING ON THE PROJECT.

STATION	SIDE	PROPOSED GRADE	EXISTING GRADE	PROPOSED ELEVATION	EXISTING ELEVATION	REMARKS
124+65	LT	4.91	4.00	100	100	
127+90	RT	4.00	4.00	100	100	
135+85	LT	5.00	4.00	100	100	
144+11.6	RT	4.00	4.00	100	100	
155+74	LT	4.00	4.00	100	100	
170+00	RT	4.00	4.00	100	100	
183+00	LT	4.00	4.00	100	100	
187+48.8	RT	4.00	4.00	100	100	
200+20	LT	4.00	4.00	100	100	
210+00	RT	4.00	4.00	100	100	
210+00 (RUE, RT)		8.14	8.14	100	100	

SUMMARY OF QUANTITIES

ITEM NO.	ITEM	UNIT	TOTAL QUANT.	CONSTRUCTION TYPE CODE			BR-F		F	
				0010-540	X371-531	Y005	FUND TYPE CODE		F	
							SBRP	F. A. P.	SBRP	F. A. P.
201001	TREE REMOVAL (6 TO 15 INCH DIAMETER)	INCH DIA	207.	207.			207.			
201002	TREE REMOVAL (OVER 15 INCH DIAMETER)	INCH DIA	2,822.	2,822.			1351.	1471.		
201005 *	TREE REMOVAL, ACRES	ACRE	12.6	12.6			9.4	3.2		
202001 *	EARTH EXCAVATION	CU YD	192,305.	192,305.			192,305.			
204001 *	BORROW EXCAVATION	CU YD	14,050.	14,050.			14,050.			
209002	POROUS GRANULAR EMBANKMENT	CU YD	5,077.	5,077.			5,077.			
210001	TRENCH BACKFILL	CU YD	75	75				75.		
211001	POROUS GRANULAR BACKFILL	CU YD	570	570			570			
216001	TOP SOIL EXCAVATION	CU YD	10,630.	10,630.			3,210.	7,420.		
216003	TOP SOIL PLACEMENT 4"	SO YD	95,670.		95,670		28,890.	66,780.		
220001 *	EXPLORATION TRENCH 52" DEPTH	LIN FT	1,300.	1,300.			300.	1,000.		
402001	AGGREGATE SURFACE COURSE, TYPE A	TON	1,855.	1,855.			1,855.			
501003 *	REMOVAL OF EXISTING STRUCTURES NO. 1 (PIER)	EACH	1.		1.		1.			
502003	COFFERDAM EXCAVATION	CU YD	230.		230.		230.			
502004	ROCK EXCAVATION FOR STRUCTURES	CU YD	7.		7.		7.			
502005	COFFERDAMS	EACH	1.		1.		1.			
504003	CLASS X CONCRETE	CU YD	2,038.1	10.9	2,027.2		2,027.2	10.9		
507001	FURNISHING AND ERECTING STRUCTURAL STEEL	LUMP SUM	1.		1.		1.			
507005	STUD SHEAR CONNECTORS	EACH	7,311.		7,311.		7,311.			
508005	ALUMINUM RAILING	LIN FT	1,686.		1,686.		1,686.			
511025 *	PIPE CULVERTS, TYPE 1 15"	LIN FT	22.		22.			22.		
511026 *	PIPE CULVERTS, TYPE 1 18"	LIN FT	142.		142.			142.		
511028 *	PIPE CULVERTS, TYPE 1 24"	LIN FT	66.		66.			66.		
511032 *	PIPE CULVERTS, TYPE 1 48"	LIN FT	124.		124.			124.		
511047	PIPE CULVERTS, TYPE 1 RCCP 24"	LIN FT	270.		270.			270.		
511051	PIPE CULVERTS, TYPE 1 RCCP 48"	LIN FT	80.		80.			80.		
511102	PIPE CULVERTS, TYPE 2 24"	LIN FT	132.		132.			132.		
511103	PIPE CULVERTS, TYPE 2 30"	LIN FT	466.		466.			466.		
511106	PIPE CULVERTS, TYPE 2 48"	LIN FT	92.		92.			92.		
511759	END SECTIONS 12"	EACH	5.		5.			5.		
511760	END SECTIONS 15"	EACH	2.		2.			2.		
511761	END SECTIONS 18"	EACH	8.		8.			8.		
511763	END SECTIONS 24"	EACH	10.		10.			10.		
511765	END SECTIONS 30"	EACH	20.		20.			20.		
511769	END SECTIONS 48"	EACH	12.		12.			12.		
511780	PRECAST REINFORCED CONC. FLARED END SECTIONS, 24"	EACH	5.		5.			5.		
511786	PRECAST REINFORCED CONC. FLARED END SECTIONS, 48"	EACH	2.		2.			2.		
512001	REINFORCEMENT BARS	POUND	464,230.		464,230.		464,230.			
514001	NAME PLATES	EACH	1.		1.		1.			

SUMMARY OF QUANTITIES

FA 68 (5/7/01) BVB LIVINGSTON 67 2

ITEM NO.	ITEM	UNIT	TOTAL QUANT.	CONSTRUCTION TYPE CODE				BR-F		F	
				0010-540	X371-531	Y005	Y080	FUND TYPE CODE		F	
								SBRP	F. A. P.	SBRP	F. A. P.
601005 *	BROKEN CONCRETE RIPRAP	SQ YD	90.				90.				
603002 *	STORM SEWERS, TYPE 1 6"	LIN FT	130.	130.						130.	
603003 *	STORM SEWERS, TYPE 1 8"	LIN FT	300.	300.						300.	
603004 *	STORM SEWERS, TYPE 1 10"	LIN FT	70.	70.						70.	
607002 *	PIPE DRAINS 6"	LIN FT	80.	80.						80.	
607005	PIPE DRAINS 12"	LIN FT	300.	300.						300.	
607077 *	PIPE UNDERDRAINS, 6"	LIN FT	325.	325.						325.	
610002	WATER SERVICE LINE 3/4"	LIN FT	1,330.	1,330.						1,330.	
612458	INLET BOX, STANDARD 2249	EACH	1	1						1	
616146 *	PAVED DITCH (SPECIAL)	LIN FT	94.							94.	
616166	PAVED DITCH, TYPE B-12	LIN FT	20.							20.	
616174	PAVED DITCH, TYPE B-24	LIN FT	10.							10.	
618001	SLOPE WALL 4 INCH	SQ YD	664.			664.				664.	
618003	SLOPE WALL 6 INCH	SQ YD	1,251.			1,251.				1,251.	
620019	PAVEMENT REMOVAL AND BITUMINOUS REPLACEMENT, TYPE I, 10 INCH	SQ YD	116.	116.						116.	
620020	PAVEMENT REMOVAL AND BITUMINOUS REPLACEMENT, TYPE II, 10 INCH	SQ YD	134.	134.						134.	
639001	FURNISHING AND ERECTING RIGHT-OF-WAY MARKERS	EACH	71.	71.						71.	
642001	SEEDING, CLASS I	ACRE	35.2			35.2				4.4	
642003	SEEDING, CLASS III	ACRE	3.8			3.8				3.8	
642004	NITROGEN FERTILIZER NUTRIENT	POUND	3,228.			3,228.				658.	
642005	PHOSPHORUS FERTILIZER NUTRIENT	POUND	6,456.			6,456.				1,316.	
642006	POTASSIUM FERTILIZER NUTRIENT	POUND	3,228.			3,228.				658.	
X64308	MULCH METHOD II	TON	82.6			82.6				16.6	
643004	EXCELSIOR BLANKET	SQ YD	18,419.			18,419.				18,419.	
643005	EMULSIFIED ASPHALT	GALLON	8,260.			8,260.				1,660.	
644001 *	SODDING	SQ YD	6,589.			6,589.				6,589.	
644002	SUPPLEMENTAL WATERING	UNIT	66.			66.				66.	
646004	ENGINEER'S FIELD OFFICE, TYPE A	CAL MO	25.			25.				25.	
646006	ENGINEER'S FIELD LABORATORY	CAL MO	25.			25.				25.	
Z10044	BUILDING REMOVAL NO. 1	L SUM	1	1						1	
Z10045	BUILDING REMOVAL NO. 2	L SUM	1	1						1	
Z10145 *	CAISSON CONCRETE	CU YD	764.6			764.6				764.6	
Z10232 *	FILLING EXISTING WELLS - DUG	EACH	2.	2.						1.	
Z10282	NEOPRENE EXPANSION JOINT 6 1/2"	LIN FT	93.			93.				93.	
Z10301	PERMANENT SURVEY MARKERS, TYPE II	EACH	1.	1.						1.	
X04661 *	MINE FILL SAND	TON	300.	300.						300.	
Z10527	TRAINEES	HOURL	2,000				2,000	1,000		1,000	

\* SEE SPECIAL PROVISIONS or SPECIAL DRAWING

**SCHEDULE OF EARTHWORK QUANTITIES**

Shrinkage Factor = 1.25

BALANCE	ROADWAY	LOCATION	THEORETICAL		TOPSOIL REQUIRED		TOPSOIL SOURCE		ADJUSTED		BORROW CU. YD.	WASTE CU. YD.	4" TOPSOIL PLACEMENT SQ. YD.	HAUL EARTH EXCAVATION CU. YD.	HAUL TOPSOIL	POROUS GRANULAR EMBANKMENT CU. YD.
			CUT CU. YD.	FILL CU. YD.	IN. CUT CU. YD.	IN. FILL CU. YD.	IN. CUT CU. YD.	IN. FILL CU. YD.	CUT CU. YD.	FILL CU. YD.						
1	ML	100 + 00 TO 102 + 00	3,752.	16,665.	209.	251.	-----	-----	3,961.	16,414.			4,140.	Place 16,804 From S. R. Rt. 125 + 50	Place 460 Cu. Yd. From 120 + 00 To 150 + 00	
2	ML	102 + 00 TO 105 + 35	13,009.	42,531.	489.	368.	-----	-----	13,498.	42,163.			7,713.	Place 17,351 From S. R. Rt. 125 + 50 Place 20,016 From 120 + 00 To 150 + 00 Place 1839 From 150 + 00 To 180 + 00	Place 857 Cu. Yd. From 120 + 00 To 150 + 00	
3	ML	109 + 20 TO 115 + 00	8,325.	49,963.	289.	612.	-----	-----	8,614.	49,351.		2,481.	8,109.	Place 37,987 From 180 + 00 To 210 + 00 Place 17,569 From 150 + 00 To 180 + 00	Place 901 Cu. Yd. From 120 + 00 To 150 + 00	2481
4	ML	115 + 00 TO 120 + 00	8,507.	40,698.	315.	600.	-----	-----	8,822.	40,098.	14,050.	2,596.	8,235.	Place 8018 From 210 + 00 To 222 + 00 Place 21,829 From 150 + 00 To 180 + 00	Place 915 Cu. Yd. From 120 + 00 To 150 + 00	2596
5	ML	120 + 00 TO 150 + 00	32,646.	7,643.	1,627.	114.	4,874.	- 0 -	29,278.	7,529.			15,669.	Haul 20,016 To 102 + 00 To 105 + 35	Haul 460 Cu. Yd. To 100 + 00 To 102 + 00 Haul 857 Cu. Yd. To 102 + 00 To 105 + 35 Haul 901 Cu. Yd. To 109 + 20 To 115 + 00 Haul 915 Cu. Yd. To 115 + 00 To 120 + 00	
6	ML	150 + 00 TO 180 + 00	44,061.	1,470.	2,115.	- 0 -	3,101.	- 0 -	43,075.	1,470.			15,035.	Haul 1839 To 102 + 00 To 105 + 35 Haul 17,569 To 109 + 20 To 115 + 00 Haul 21,829 To 115 + 00 To 120 + 00	Haul 986 To S. R. Rt. 125 + 50	
7	ML	180 + 00 TO 210 + 00	40,055.	1,654.	2,227.	- 0 -	2,227.	- 0 -	40,055.	1,654.			20,043.	Haul 37,987 To 109 + 20 To 115 + 00		
8	ML	210 + 00 TO 222 + 00	8,194.	141.	428.	- 0 -	428.	- 0 -	8,194.	141.			3,852.	Haul 8018 To 115 + 00 To 120 + 00		
9	SIDE ROAD STA. 125 + 50	2 + 57 TO 19 + 00	35,822.	1,894.	986.	- 0 -	-----	-----	36,808.	1,894.			8,874.	Haul 16,806 To 100 + 00 To 102 + 00 Haul 17,351 To 102 + 00 To 105 + 35	Place 986 Cu. Yd. From 150 + 00 To 180 + 00	
10	SIDE ROAD STA. 224 + 11.9	6 + 90 TO 13 + 09	-----	-----	-----	-----	-----	-----	-----	-----						
11	DETOUR CONSTRUCTION	17 + 44 TO 21 + 94.14	-----	-----	-----	-----	-----	-----	-----	-----						
12	DETOUR REMOVAL	17 + 44 TO 21 + 94.14	-----	-----	-----	-----	-----	-----	-----	-----				OVERHAUL - APPROXIMATELY 6,600,000 CU. YD. - STA.	OVERHAUL - APPROXIMATELY 125,000 CU. YD. - STA.	
<b>TOTALS</b>			194,371.	162,659.	8,685.	1,945.	10,630.		192,305.	160,714.	14,050.	5,077.	95,670.			5077

**SCHEDULE OF SIDE ROAD AND ENTRANCE QUANTITIES**

STATION	SIDE	TYPE	WIDTH	LENGTH	RADIUS	AGG SURF CRSE TY A TON
127+96	LT	PE	14	123.1		874.8
128+20	RT	PE	14	40.		30.8
129+76	RT	PE	14	38.		29.4
144+11.6	LT	SR	20	78.	30.	89.3
144+11.6	RT	SR	20	90.	30.	101.5
145+47	RT	PE	14	43.		33.0
165+74	LT	FE	14	98.		72.3
170+17	RT	PE	14	38.		29.4
170+60	LT	FE	14	98.		72.3
179+44	RT	PE	14	38.		29.4
183+91	LT	FE	14	75.		55.9
188+27	LT	FE	14	70.		52.4
197+44.5	LT	SR	20	90.	30.	101.5
197+48.8	RT	SR	20	90.	30.	101.5
200+74	LT	PE	14	63.		47.4
202+54	LT	FE	14	61.		45.9
203+28	RT	FE	14	63.		47.4
210+00	RT	FE	14	53.		40.3
<b>TOTAL</b>						1854.5

**SCHEDULE OF SEEDING**

Station to Station	Seeding Class I Acres *	Seeding Class III Acres **	Nitrogen Fertilizer Pounds 80 lb/AC	Phosphate Fertilizer Pounds 160 lb/AC	Potassium Fertilizer Pounds 80 lb/AC	METHOD II Mulch Tons 2 Tons/AC	Emulsified Asphalt Gallons 100 Gal/Ton Mulch
99+30 to 101+00	0.58		46	92	46	1.2	120
101+00 to 119+00	2.88	3.80	534	1068	534	13.4	1340
119+00 to 120+50	0.98		78	156	78	2.0	200
119+00 to 222+00	27.11		2169	4338	2169	54.2	5420
S. R. @ 125+50	3.65		292	584	292	7.3	730
Sodded Areas			109	218	109		
<b>Totals</b>	<b>35.20</b>	<b>3.80</b>	<b>3228.</b>	<b>6456</b>	<b>3228</b>	<b>78.1</b>	<b>7810</b>

\* Between Stations 99+30 and 120+50 Seed only areas within the limits of construction or as determined by the Engineer

\*\* Seeding Class III shall be applied to all 2 to 1 slopes \*\* Station 126+00 and south, existing shoulders are not to be seeded.

**SCHEDULE OF EXCELSIOR BLANKET**

STATION TO STATION	SIDE	SQ. YD.
101+00 to N. Abut.	LT	2944.
101+00 to N. Abut.	RT	2709.
S. Abut. to 119+00	LT	6592.
S. Abut. to 119+00	RT	6174
<b>TOTAL</b>		<b>18,419 Sq. Yd.</b>

**SCHEDULE OF MULCH FOR EROSION CONTROL PROTECTION \***

Location	Area (AC)	Mulch 2 Ton/AC	Emulsified Asphalt 100 Gal/Ton
Mi.	1.50	3.0	300
SR RT 125+50	0.75	1.5	150
<b>Total</b>	<b>2.25AC</b>	<b>4.5 Ton</b>	<b>450 Gallons</b>

\* As Directed by the Engineer

**SCHEDULE OF DUG WELLS TO BE FILLED**

STATION	REPORTED DEPTH	WELL TO BE FILLED
63' RT STA 117+45.5	14'	1
35' RT STA 170+72	15'	1
<b>TOTAL</b>		<b>2</b>



SCHEDULE OF CURB AND GUTTER

STATION TO STATION	SIDE	TYPE B6.24 LIN. FT.	TYPE M6.05 LIN. FT.
<del>90+58</del>	<del>RT</del>	<del>309</del>	
<del>90+56</del>	<del>RT</del>	<del>310</del>	
<del>93+60</del>	<del>LT</del>	<del>404</del>	
<del>93+60</del>	<del>RT</del>	<del>417</del>	
<del>223+85±</del>	<del>RT</del>		<del>49</del>
<del>223+85±</del>	<del>LT</del>		<del>48</del>
<del>224+40±</del>	<del>RT</del>		<del>49</del>
<del>224+40±</del>	<del>LT</del>		<del>48</del>
TOTALS		1,440	194

SCHEDULE OF YELLOW THERMOPLASTIC PAVEMENT MARKING

STATION TO STATION	4" LIN. FT.	12" LIN. FT.
<del>213+48.35</del>	<del>223+75.21</del>	<del>4,000</del>
<del>224+75.21</del>	<del>234+75.21</del>	<del>4,000</del>
<del>213+48.35</del>	<del>220+18.35</del>	<del>304</del>
<del>227+75.21</del>	<del>234+75.21</del>	<del>304</del>
TOTALS		6,000

SCHEDULE OF PAVEMENT REMOVAL AND REPLACEMENT 10"

STATION	TYPE I SQ. YD.		TYPE II SQ. YD.		TOTAL SQ. YD.
	LT.	RT.	LT.	RT.	
<del>128+05</del>	<del>3</del>	<del>3</del>	<del>10</del>	<del>10</del>	
<del>133+00</del>					
<del>173+99.5</del>	<del>5</del>	<del>5</del>			
<del>183+00</del>			<del>7</del>	<del>7</del>	
CONTINGENCY		100	100		200
TOTAL		116	134		250

SCHEDULE OF EXPLORATION TRENCH

STATION	IN. FT.	REMARKS
<del>102+50</del>	<del>300</del>	<del>200' LT TO 100' FT</del>
<del>ESTIMATE FOR UNKNOWN LOCATIONS</del>	<del>1,000</del>	
TOTAL		1,300

SCHEDULE OF WATER SERVICE LINE, 3/4"

STATION TO STATION	SIDE	LIN. FT.	REMARKS
<del>116+90</del>	<del>LT &amp; RT</del>	<del>1,160</del>	
<del>128+05</del>	<del>LT &amp; RT</del>	<del>170</del>	<del>WITHIN R.O.W.</del>
TOTAL		1,330	

SCHEDULE OF PORTLAND CEMENT CONCRETE BASE COURSE (14") APPROACH SLABS

STATION TO STATION	SO. YDS.	
<del>103+36.70</del>	<del>105+86.70</del>	<del>133.0</del>
<del>112+01.93</del>	<del>124+51.85</del>	<del>133.0</del>
TOTAL		266.0

SCHEDULE OF DELINEATORS

STATION TO STATION	REMARKS	
<del>97+10</del>	<del>99+00 RT &amp; LT (150' SPACING)</del>	<del>4</del>
<del>100+50</del>	<del>116+50 RT &amp; LT (200' SPACING)</del>	<del>18</del>
<del>118+00</del>	<del>125+50 RT &amp; LT (150' SPACING)</del>	<del>12</del>
<del>127+50</del>	<del>233+50 RT &amp; LT (200' SPACING)</del>	<del>24</del>
TOTAL		58

SCHEDULE OF PAVEMENT MARKING TAPE

STATION TO STATION	ROADWAY	LIN. FT.
<del>90+56</del>	<del>F.A. 24</del>	<del>19</del>
<del>126+00</del>	<del>F.A. 24</del>	<del>870</del>
<del>2+50</del>	<del>S.R. @ 125+50</del>	<del>6</del>
<del>8+50</del>	<del>S.R. @ 125+50</del>	<del>14</del>
<del>6+00</del>	<del>RTE. 17</del>	<del>56</del>
TOTAL		965

SCHEDULE OF PAVEMENT REMOVAL

STATION TO STATION	ROADWAY	SO. YDS.
<del>92+60</del>	<del>97+00 RT F.A. 24</del>	<del>590</del>
<del>6+75 LT</del>	<del>S.R. @ 125+50</del>	<del>1,000</del>
<del>11+17</del>	<del>126+00 F.A. 24 S.R. @ 125+50</del>	<del>1,783</del>
TOTAL		3,373

SCHEDULE OF P.C.C. SIDEWALK

STATION TO STATION	SIDE	SO. YDS.
<del>93+35±</del>	<del>RT</del>	<del>28</del>
<del>93+72±</del>	<del>RT</del>	<del>32</del>
TOTAL		60

SCHEDULE OF STORM SEWERS, TYPE I

LOCATION	IN. FT.	REMARKS
<del>TO BE CONSTRUCTED AT LOCATIONS DETERMINED BY ENGINEER BY USE OF EXPLORATION TRENCH</del>	<del>6" 8" 10"</del>	<del>ESTIMATED</del>
<del>STA. 128+05</del>	<del>170</del>	
TOTAL		130 300 70

SCHEDULE OF PERMANENT SURVEY MARKERS, TYPE I

STATION	LOCATION	DESCRIPTION	EACH
<del>91+71.77</del>	<del>C</del>	<del>P.C.</del>	<del>1</del>
<del>99+51.08</del>	<del>C</del>	<del>P.T.</del>	<del>1</del>
<del>116+75.97</del>	<del>C</del>	<del>P.C.</del>	<del>1</del>
<del>125+37.64</del>	<del>C</del>	<del>P.T.</del>	<del>1</del>
<del>144+08.24</del>	<del>0.38' LT</del>	<del>SEC. COR.</del>	<del>1</del>
<del>170+75.94</del>	<del>0.07' RT</del>	<del>SEC. COR.</del>	<del>1</del>
<del>197+42.03</del>	<del>1.46' RT</del>	<del>SEC. COR.</del>	<del>1</del>
<del>224+08.18</del>	<del>3.05' RT</del>	<del>SEC. COR.</del>	<del>1</del>
TOTAL			8

SCHEDULE OF STEEL PLATE BEAM GUARD RAIL AND TERMINAL SECTION

STATION TO STATION	SIDE	GUARD RAIL LIN. FT.	TERMINAL SECTION EACH
<del>100+05</del>	<del>LT</del>	<del>350</del>	<del>1</del>
<del>100+14</del>	<del>RT</del>	<del>325</del>	<del>1</del>
<del>112+17</del>	<del>LT</del>	<del>750</del>	<del>1</del>
<del>112+17</del>	<del>RT</del>	<del>500</del>	<del>1</del>
TOTALS		2,325	4

SCHEDULE OF PROTECTIVE COAT

SURFACE	SO. YDS.	
<del>P.C.C. DRIVEWAY</del>	<del>97.3</del>	
<del>SIDEWALK</del>	<del>10.2</del>	
<del>CURB &amp; GUTTER B6.24</del>	<del>420.0</del>	
<del>CURB &amp; GUTTER M6.05</del>	<del>28.7</del>	
<del>CONC. MEDIAN SURFACE</del>	<del>4.2</del>	
TOTAL		660.4

SCHEDULE OF PERMANENT SURVEY MARKERS, TYPE II

STATION	LOCATION	DESCRIPTION	EACH
<del>117+95.37</del>	<del>107.93' LT.</del>	<del>SEC. COR.</del>	<del>1</del>
TOTAL			1

SCHEDULE OF SODDING

STATION TO STATION	SIDE	DESCRIPTION	SQ. YDS.	SUPPLEMENTAL WATERING
<del>90+56</del>	<del>FRANKLIN ST RT</del>	<del>URBAN</del>	<del>201</del>	
<del>91+00</del>	<del>FRANKLIN ST LT</del>	<del>URBAN</del>	<del>286</del>	
<del>FRANKLIN ST</del>	<del>97+62 RT</del>	<del>URBAN</del>	<del>1,848</del>	
<del>FRANKLIN ST</del>	<del>97+58 LT</del>	<del>URBAN</del>	<del>1,218</del>	
<del>119+80</del>	<del>122+05 LT</del>	<del>10' DITCH, 1.5' DEPTH</del>	<del>505</del>	
<del>136+00</del>	<del>138+00 LT</del>	<del>2' DITCH, 2' DEPTH</del>	<del>490</del>	
<del>131+00</del>	<del>183+00 RT</del>	<del>2' DITCH, 2' DEPTH</del>	<del>488</del>	
<del>3+50</del>	<del>7+00 SR @ 125+50 RT</del>	<del>2' DITCH, 1' DEPTH</del>	<del>324</del>	
96 END SECTIONS				188
1 INLET BOX				6
154 UNDERDRAIN OUTLETS				182
<del>128+30</del>	<del>131+35 RT</del>	<del>LAWN</del>	<del>744</del>	
<del>144+30</del>	<del>145+15 RT</del>	<del>LAWN</del>	<del>608</del>	
<del>168+15</del>	<del>170+85 RT</del>	<del>LAWN</del>	<del>654</del>	
<del>177+05</del>	<del>181+10 RT</del>	<del>LAWN</del>	<del>846</del>	
<del>199+25</del>	<del>202+70 LT</del>	<del>LAWN</del>	<del>1,912</del>	
TOTAL			6589	65.9

SCHEDULE OF PAVED DITCH

STATION TO STATION	SIDE	SPECIAL LIN. FT.	8-12 LIN. FT.	8-24 LIN. FT.
<del>109+20</del>	<del>LT</del>	<del>94</del>		
<del>136+05</del>	<del>RT</del>		<del>10</del>	
<del>137+95</del>	<del>LT</del>			<del>10</del>
<del>138+15</del>	<del>RT</del>		<del>10</del>	
TOTALS		94	20	10

SCHEDULE OF TRENCH BACKFILL

STATION	Cu. YDS.	
<del>102+00</del>	<del>105+25</del>	<del>570.0</del>
<del>120+05</del>		<del>4.7</del>
<del>133+00</del>		<del>14.9</del>
<del>144+11.6 LT</del>		<del>7.8</del>
<del>144+11.6 RT</del>		<del>5.8</del>
<del>175+99.5</del>		<del>5.6</del>
<del>183+00</del>		<del>8.2</del>
<del>197+44.5 LT</del>		<del>12.8</del>
<del>197+48.8 RT</del>		<del>14.8</del>
<del>5+88 RTE. 17</del>		<del>19.0</del>
TOTAL		746

SCHEDULE OF POROUS GRANULAR BACKFILL

± Station	Cu. Yds.	
<del>102+00 - 105+25</del>	<del>570*</del>	
Total		570

\* SBRP

SCHEDULE OF CONCRETE MEDIAN SURFACE, 4"

STATION	SIDE	SO. FT.
<del>223+85±</del>	<del>RT</del>	<del>100</del>
<del>223+85±</del>	<del>LT</del>	<del>99</del>
<del>224+40±</del>	<del>RT</del>	<del>99</del>
<del>224+40±</del>	<del>LT</del>	<del>100</del>
TOTAL		398

SCHEDULE OF BROKEN CONCRETE RIPRAP

STATION	SIDE	SO. YDS.
<del>109+20±</del>	<del>LT</del>	<del>90</del>

STATE OF ILLINOIS  
DEPARTMENT OF TRANSPORTATION  
BRIDGE, CULVERT AND STORM SEWER SCHEDULE

F.A. 24 68  
SECTION (37,101) 818  
LIVINGSTON COUNTY  
SHEET 1 OF 2

STATION NO.	TYPE	STANDARD AND DESIGN NUMBER	CLASS X CONCRETE CU.YDS	REINFORCEMENT BARS LBS.	PIPE CULVERTS				S.S.		RCCP		END SECTIONS						RCCP			INLET			
					TYPE 1				TYPE 2		TYPE 1		END SECTIONS						END SECTIONS			INLET			
					15"	18"	24"	48"	24"	30"	48"	8"	24"	48"	15"	18"	24"	30"	48"	12"	24"	48"	A-3	2249	
98+52 LT	A-3	1582																							
98+24 LT		2228																							
97+25 RT	18"x36" P-1	2228																							
103+36 70																									
103+86 76	APPROACH SLAB	2360		7,300																					
103+86 70	BRIDGE STRUCTURE		2,027.2	464,230																					
112+01.83																									
112+51.83	APPROACH SLAB	2360		7,100																					
119+80 LT	30"x34" P-2	2228							34									2							
124+65 LT	3-30"x46" P-2	2228							138									6							
128+05	8"x 170" P-1/RCCP	2262									170														
127+96 LT	3-30"x56" P-2	2228							168									6							
129+76 RT	15"x22" P-1	2228				22								2											
133+00	2-24"x96" P-1/RCCP	2262											192								4				
135+65 LT	3-30"x42" P-2	2228							126									6							
144+11.6 LT	48"x38" P-1	2228					38																	2	
144+11.6 RT	24"x40" P-1	2228				40													2						
145+47 RT	24"x26" P-1	2228				26													2						
165+74 LT	48"x50" P-2	2228								50															2
170+60 LT	48"x42" P-2	2228								42															2
175+99.5	24"x78" P-1/RCCP	2262 & 2249											78												1
183+00	48"x60" P-1/RCCP	2262												80							2				1
183+91 LT	24"x44" P-2	2228							44										2						
188+27 LT	24"x40" P-2	2228							40										2						
197+44.5 LT	24"x48" P-2	2228							48										2						
197+46.8 RT	48"x40" P-1	2228					40																	2	
206+74 LT	18"x36" P-1	2228				36													2						
202+52 LT	18"x36" P-1	2228				36													2						
203+26 RT	48"x24" P-1	2228					24																	2	
210+00 RT	48"x22" P-1	2228					22																	2	
209+58 LT	18"x36" P-1	2228				36													2						
S.R. @ 224+11.9																									
9+00	3-24"x90" P-1/RCCP	2262																							
S.R. @ 125+50																									
5+75 LT	18"x34" P-1	2228				34													2						
19+00 RT	15"x24" P-1	2228																							

MADE BY: RMJ DATE: 5-14-75  
CHECKED BY: RMR DATE: 5-19-75

TOTALS			2027.2	166,230	22	142	66	124		132	466	92	170	270	80	2	8	10	20	12		5	2		1
--------	--	--	--------	---------	----	-----	----	-----	--	-----	-----	----	-----	-----	----	---	---	----	----	----	--	---	---	--	---

STATE OF ILLINOIS  
 DEPARTMENT OF TRANSPORTATION  
 BRIDGE, CULVERT AND STORM SEWER SCHEDULE

F.A. 68  
 (37,101) BVB  
 LIVINGSTON UNIT  
 SHEET 2 OF 2

STATION NO.	TYPE	STANDARD AND DESIGN NUMBER	CLASS X CONCRETE CU. YDS	REINFORCEMENT BARS LBS.	PIPE					OUTLET ELEVATION OF PIPE UNDERDRAIN	STORM SEWER SS-2	END SECTIONS
					UNDERDRAINS 4"	6"	PIPE DRAINS 4"	6"	PIPE DRAINS 12"			
<del>96+52</del>	<del>SS-2</del>											
<del>96+24 LT</del>	<del>SS-2</del>											
<del>97+70</del>												
<del>103+90 LT</del>	<del>CONT. UNDERDRAIN</del>				620							
<del>97+70</del>												
<del>103+80 RT</del>	<del>CONT. UNDERDRAIN</del>				610							
<del>97+70 RT &amp; LT</del>	<del>OUTLET</del>	<del>2327 &amp; 2362</del>				30		2				
<del>102+00</del>	<del>CONT. UNDERDRAIN</del>											
<del>105+25</del>	<del>CONT. UNDERDRAIN</del>	<del>SPECIAL PROVISION</del>				325						
<del>100+50 RT &amp; LT</del>	<del>OUTLET</del>	<del>2327 &amp; 2362</del>					36	2				
<del>112+04</del>												
<del>120+00 RT &amp; LT</del>	<del>CONT. UNDERDRAIN</del>				1592							
<del>116+00 RT &amp; LT</del>	<del>OUTLET</del>	<del>2327 &amp; 2362</del>					34	2				
<del>120+00</del>												
<del>150+00 RT &amp; LT</del>	<del>CONT. UNDERDRAIN</del>				6000							
<del>121+00 RT &amp; LT</del>	<del>OUTLET</del>	<del>2327 &amp; 2362</del>					28	2				
<del>126+00 RT &amp; LT</del>	<del>OUTLET</del>	<del>2327 &amp; 2362</del>					36	2	609.29			
<del>138+00 RT &amp; LT</del>	<del>OUTLET</del>	<del>2327 &amp; 2362</del>					29	2	609.84			
<del>142+00 RT &amp; LT</del>	<del>OUTLET</del>	<del>2327 &amp; 2362</del>					29	2	610.63			
<del>147+00 RT &amp; LT</del>	<del>OUTLET</del>	<del>2327 &amp; 2362</del>					29	2	612.33			
<del>150+00</del>												
<del>180+00 RT &amp; LT</del>	<del>CONT. UNDERDRAIN</del>				6000							
<del>156+00 RT &amp; LT</del>	<del>OUTLET</del>	<del>2327 &amp; 2362</del>					35	2	612.07			
<del>161+00 RT &amp; LT</del>	<del>OUTLET</del>	<del>2327 &amp; 2362</del>					29	2	614.55			
<del>171+00 RT &amp; LT</del>	<del>OUTLET</del>	<del>2327 &amp; 2362</del>					29	2	615.57			
<del>180+00</del>												
<del>210+00 RT &amp; LT</del>	<del>CONT. UNDERDRAIN</del>				6000							
<del>193+00 RT &amp; LT</del>	<del>OUTLET</del>	<del>2327 &amp; 2362</del>					36	2	614.27			
<del>203+00 RT &amp; LT</del>	<del>OUTLET</del>	<del>2327 &amp; 2362</del>					36	2	614.27			
<del>210+00</del>												
<del>234+75 RT &amp; LT</del>	<del>CONT. UNDERDRAIN</del>				4950							
<del>212+00 RT &amp; LT</del>	<del>OUTLET</del>	<del>2327 &amp; 2362</del>					39	2	614.01			
<del>220+00 RT &amp; LT</del>	<del>OUTLET</del>	<del>2327 &amp; 2362</del>					40	2	613.47			
<del>227+00 RT &amp; LT</del>	<del>OUTLET</del>	<del>2327 &amp; 2362</del>					38	2	613.60			
<del>234+75 RT &amp; LT</del>	<del>OUTLET</del>	<del>2327 &amp; 2362</del>					35	2	610.62			
<del>FIELD TILE OUTLET</del>												
<del>105+25 RT</del>			.25									
<del>225+ - 235+ RT &amp; LT</del>	<del>8x OUTLETS</del>		10.68				80					
<del>100+50 RT</del>	<del>SLOPE DRAIN</del>	<del>2228 &amp; 2322</del>										
<del>115+50 LT</del>	<del>SLOPE DRAIN</del>	<del>2228 &amp; 2322</del>										
<del>118+25 RT</del>	<del>SLOPE DRAIN</del>	<del>2228 &amp; 2322</del>										
<del>119+95 LT</del>	<del>SLOPE DRAIN</del>	<del>2228 &amp; 2322</del>										
<del>119+95 RT</del>	<del>SLOPE DRAIN</del>	<del>2228 &amp; 2322</del>										
<b>TOTALS</b>			10.93		25772	325	560	80	34	300	5	

MADE BY: RWJ DATE: 11-18-76  
 CHECKED BY: BIP DATE: 12-8-76  
 REV: DLC 3-9-78


NOTES: TYPE 45° OUTLETS ARE TO BE INSTALLED WHEN THE PROFILE GRADE IS GREATER THAN 2.5%.  
 PIPE UNDERDRAIN OUTLETS TO BE PLACED AT THE DEPTH SHOWN ON STANDARD DRAWING NO. 2327 UNLESS OTHERWISE NOTED.  
 MINIMUM GRADE FOR PIPE UNDERDRAINS SHALL BE 0.1%.

3291  
 7107

PROJECT BEGINS STA. 90+56.10

P1 STA 95+68.94  
 $\Delta = 15^{\circ}47'10''$   
 $D = 2^{\circ}00'$   
 $T = 397.17'$   
 $R = 2864.79'$   
 $L = 789.31'$   
 $E = 27.40'$   
 $S.E. = 0.0184''$   
 ATTAIN S.E. 90+88 TO 92+13  
 REMOVE S.E. 99+19 TO 100+44

STA. 100+00  
 EMBANKMENT LIMIT  
 THIS CONTRACT

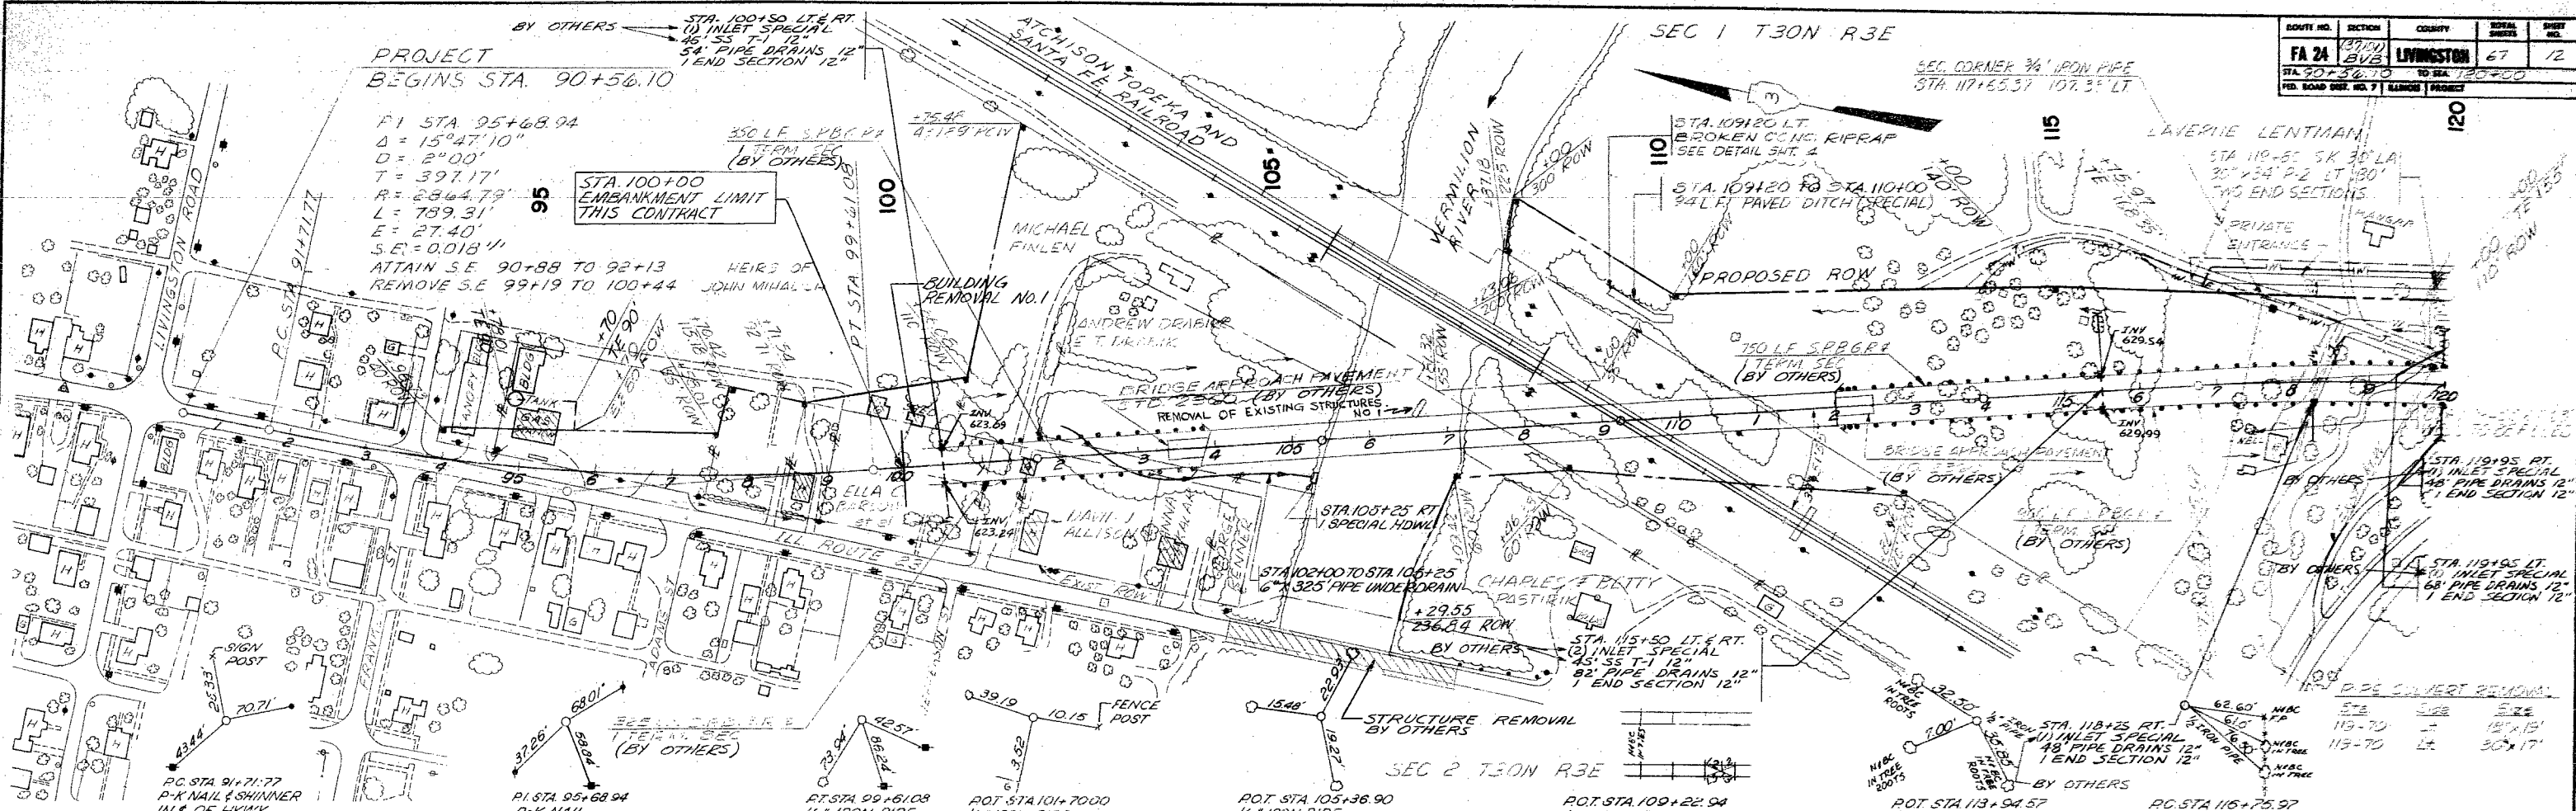

ROUTE NO.	SECTION	COUNTY	TOTAL SHEETS	SHEET NO.
FA 2A	(37,101) BVB	LIVINGSTON	67	12
STA. 90+56.10 TO STA. 120+00				
RD. ROAD DIST. NO. 7   RANGE   PROJECT				

DATE	BY	REVISION

DATE	BY	REVISION


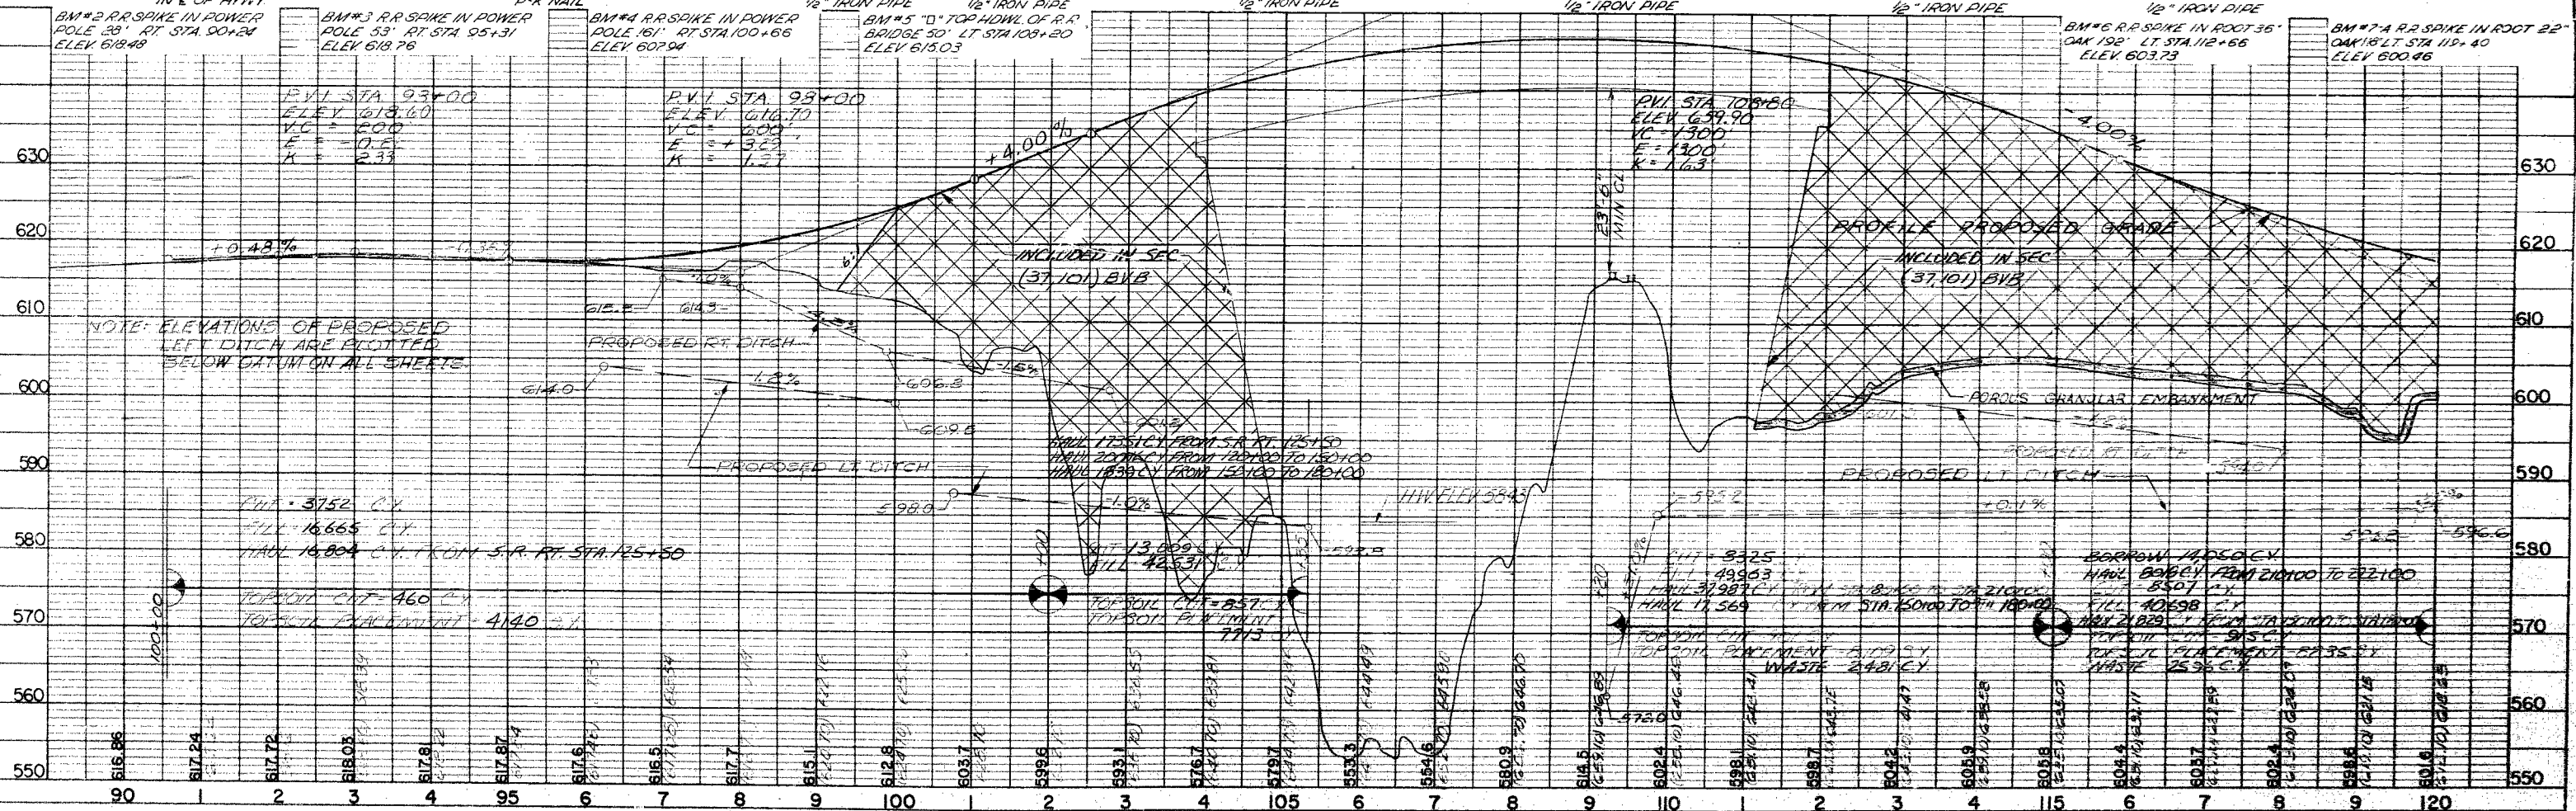


PLATE I - PLAN PROFILE & P. & S. STANDARD  
 THE FREDERICK POST CO., CHICAGO  
 Revised 9-1-78

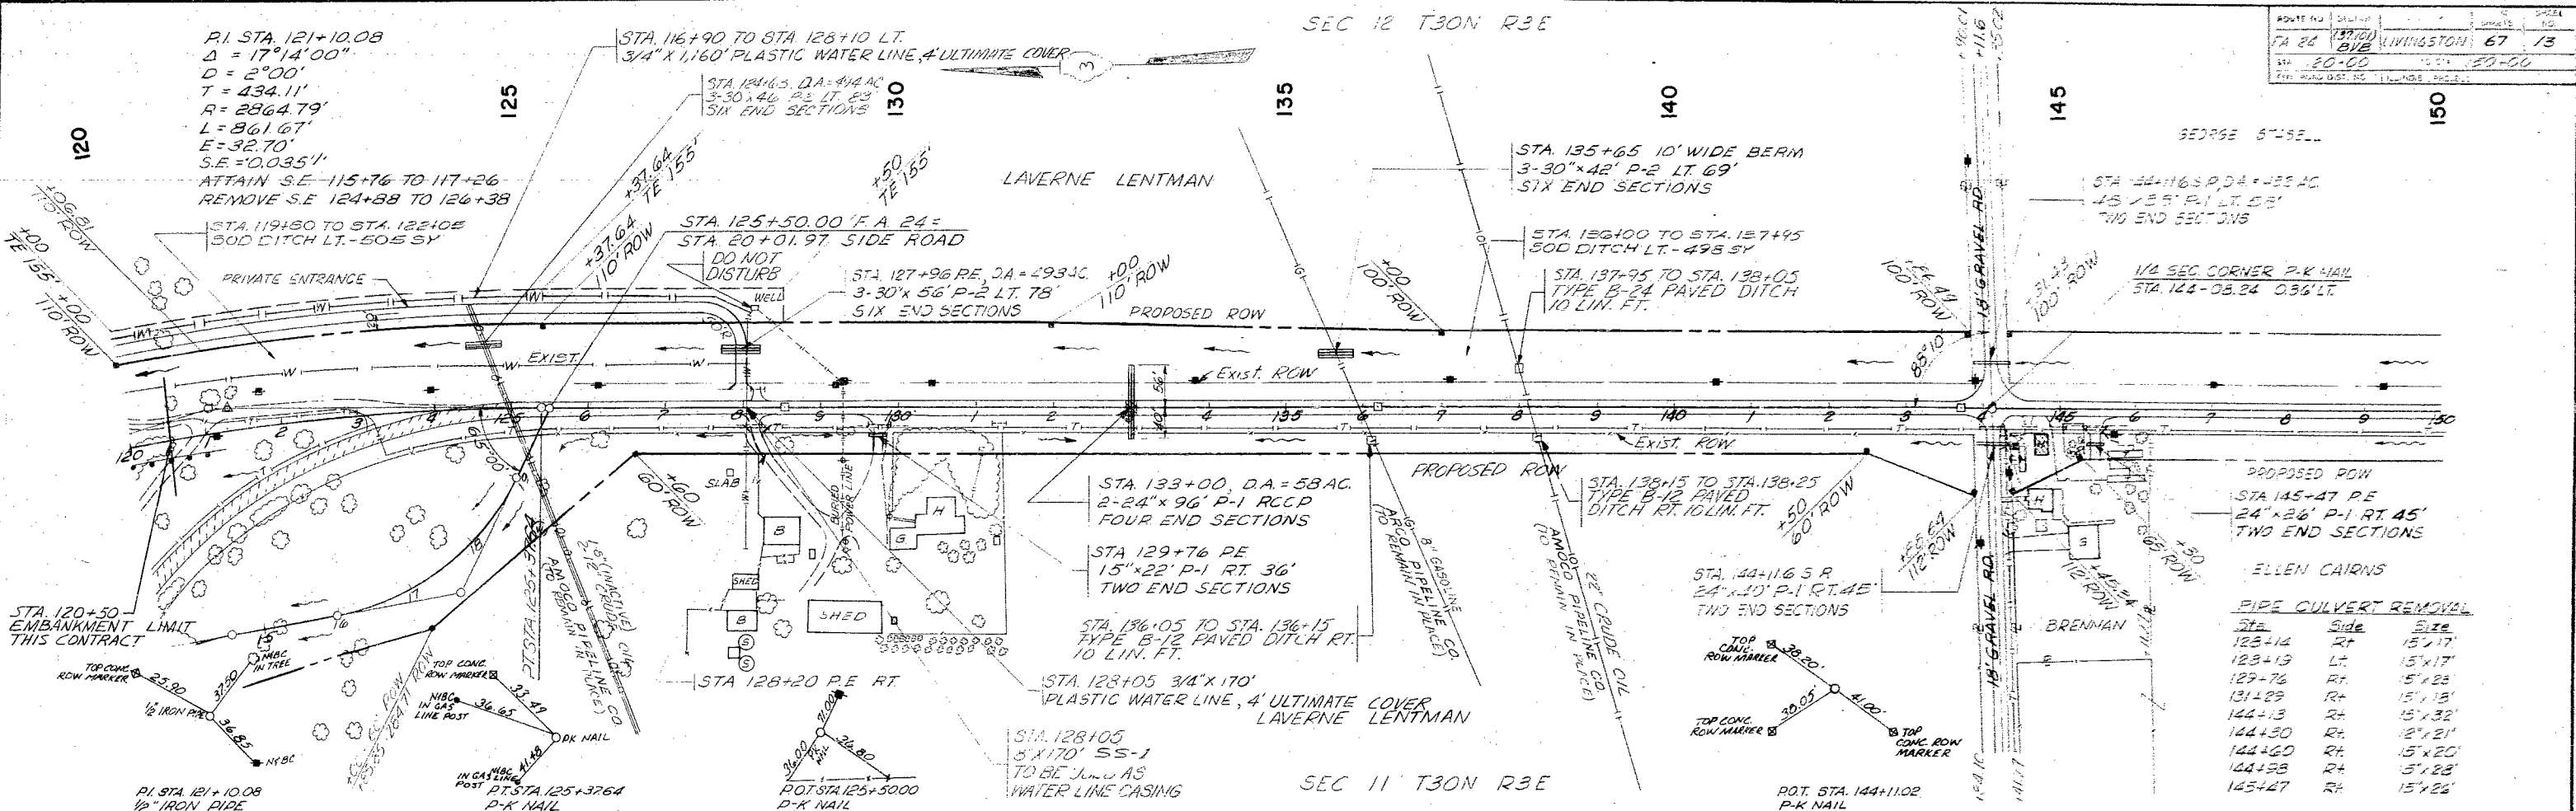

PROPOSED ROW  
 STA. 145+47 P.E.  
 24" X 26" P-1 RT. 45'  
 TWO END SECTIONS

ELLEN CAIRNS

Sta.	Side	Size
123+14	Rt	15' X 17'
123+19	Lt	15' X 17'
129+76	Rt	15' X 28'
131+29	Rt	15' X 15'
144+13	Rt	15' X 32'
144+30	Rt	12' X 21'
144+60	Rt	15' X 20'
144+98	Rt	15' X 28'
145+47	Rt	15' X 26'

PIPE CULVERT REMOVAL

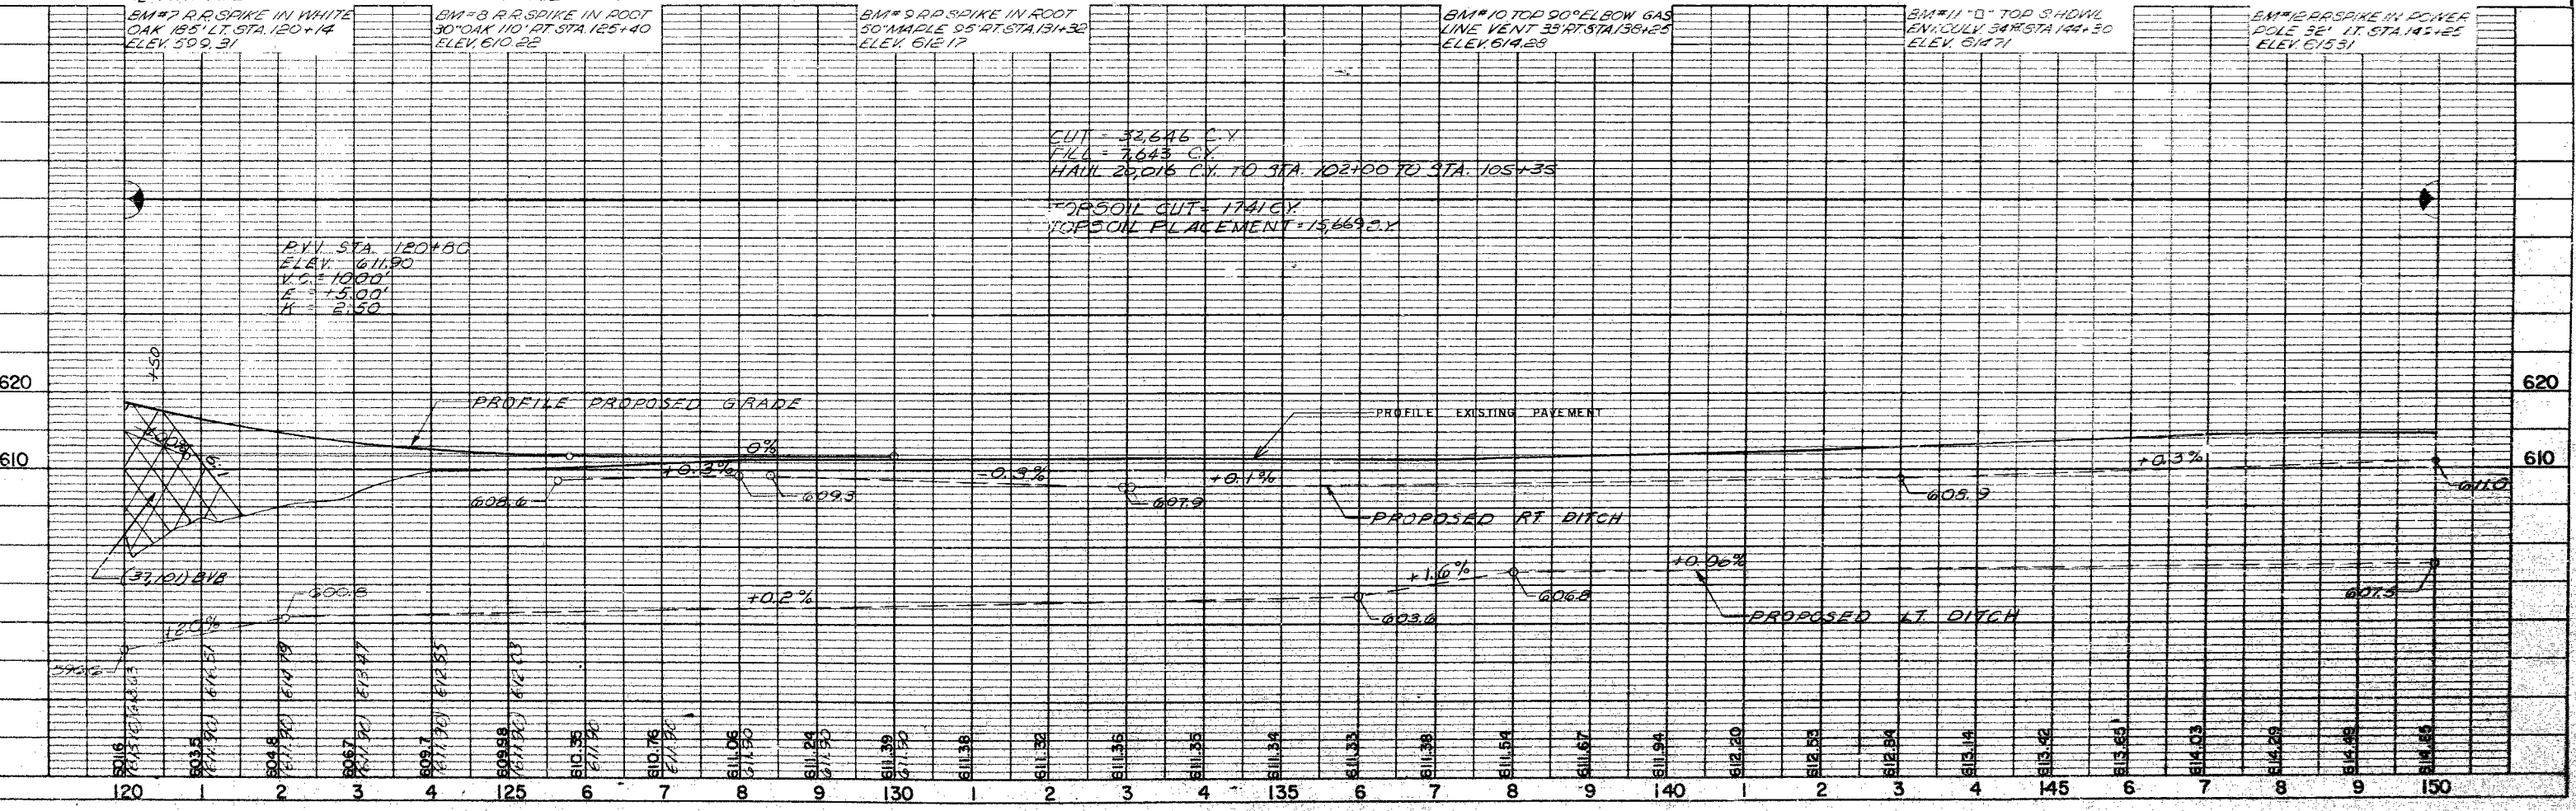


PLATE 1 - PLAN PROFILE & P. & S. STANDARD  
 THE PROFESSIONAL ENGINEER'S SEAL

SEC 12 T30N R3E

SEC 13 T30N R3E

ROUTE NO.	SECTION	COUNTY	TOTAL SHEETS	SHEET NO.
PA 25	3750	LIVINGSTON	67	14
STA 150+00	TO STA 180+00			
FED. ROAD DIST. NO. 71 ILLINOIS PROJECT				

150

155

160

165

170

175

180

GEORGE STASELL

HELEN CARONS


STA 165+74 F.E., D.A.=427 AC  
48"x50' P-2 LT 78'  
TWO END SECTIONS

STA 170+60 F.E., D.A.=426 AC  
48"x42' P-2 LT 73'  
TWO END SECTIONS

STA 175+99.5  
24"x78' P-1 RCCP  
ONE END SECTION  
ONE INLET BOX  
SEC. CORNER P-K NAIL  
STA 170+75.94 0.07 RT.

STA 175+99.5 LT 29'  
C/B TO BE REMOVED

STA 175+99.5  
EXISTING 8" VCR CULVERT  
TO BE REMOVED

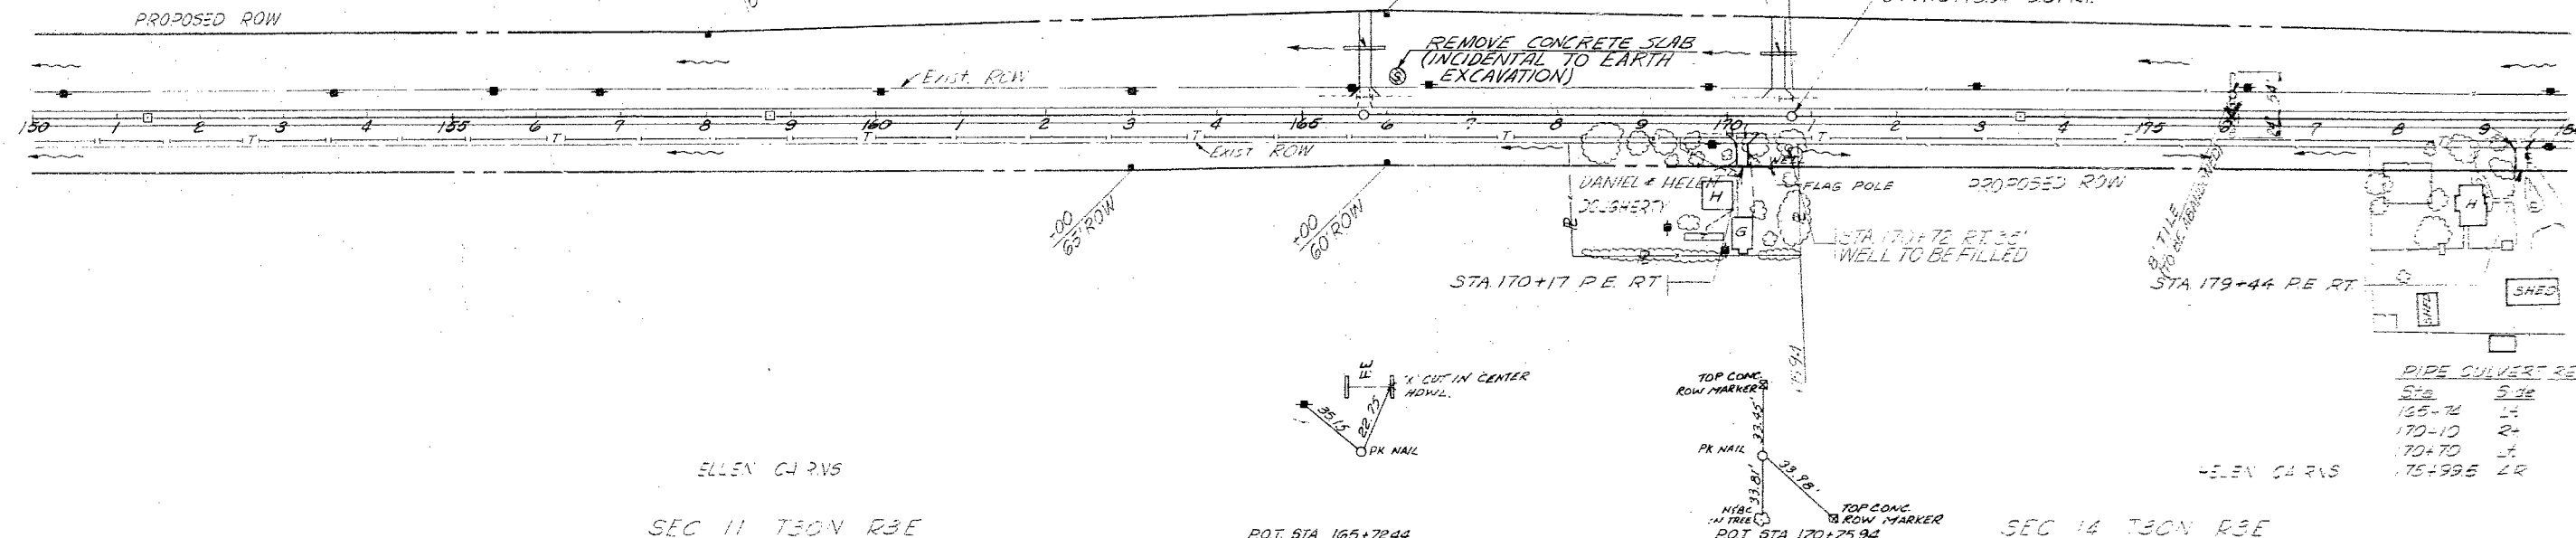

BM#13 RR SPIKE IN POWER POLE 32' LT STA 155+50 ELEV. 615.25

BM#14 RR SPIKE IN POWER POLE 38' LT STA 163+00 ELEV. 617.48

BM#15 RR SPIKE IN ROOT 15" MAPLE 75' RT STA 171+00 ELEV. 618.01

BM#16 RR SPIKE IN ROOT 20" ELM 85' RT STA 178+50 ELEV. 617.04

CUT = 44061 CY  
FILL = 1470 CY  
HAUL 7839 CY TO STA 162+00 TO STA 105+35  
HAUL 17589 CY TO STA 109+20 TO STA 115+00  
HAUL 21829 CY TO STA 115+00 TO STA 120+00  
TOP SOIL CUT = 2115 CY  
TOP SOIL PLACEMENT = 19035 CY


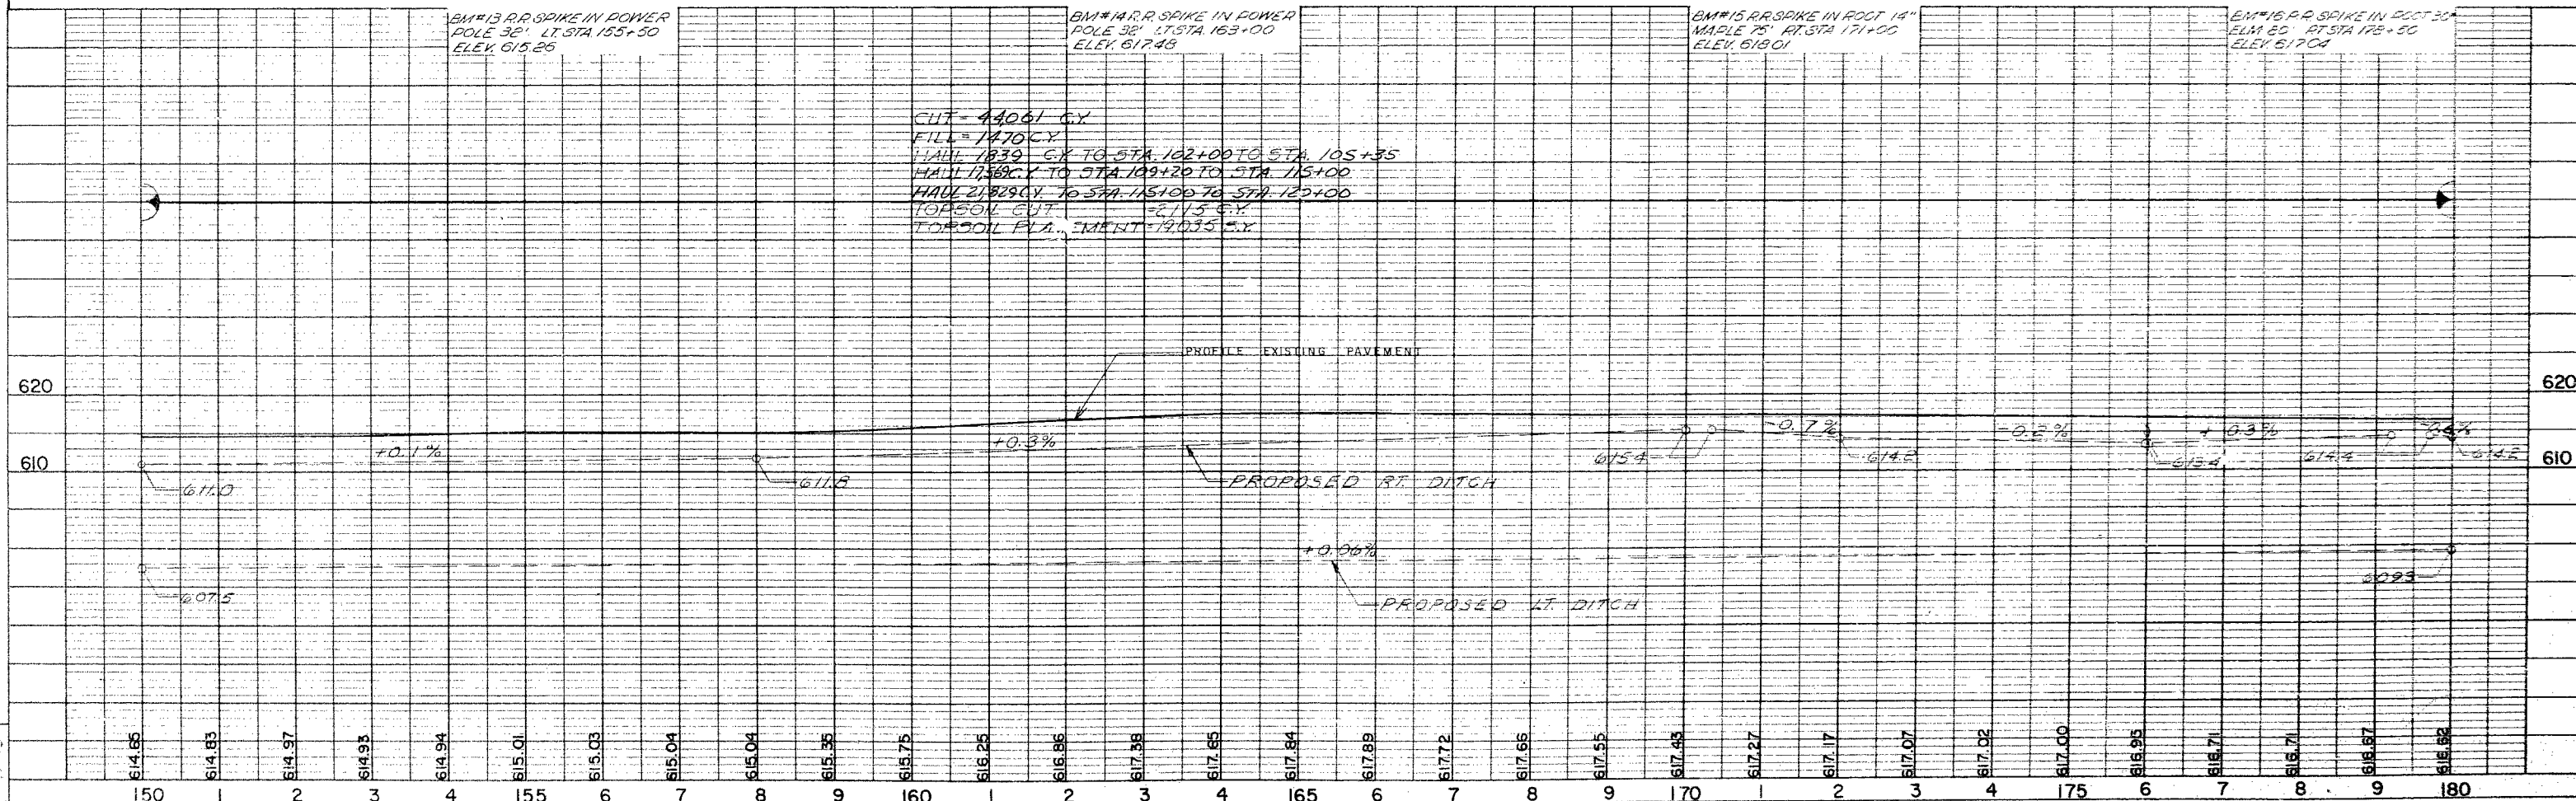


PLATE 1 - PLAN PROFILE & P. R. STANDARD  
THE FREDERICK POST CO., CHICAGO

STR.

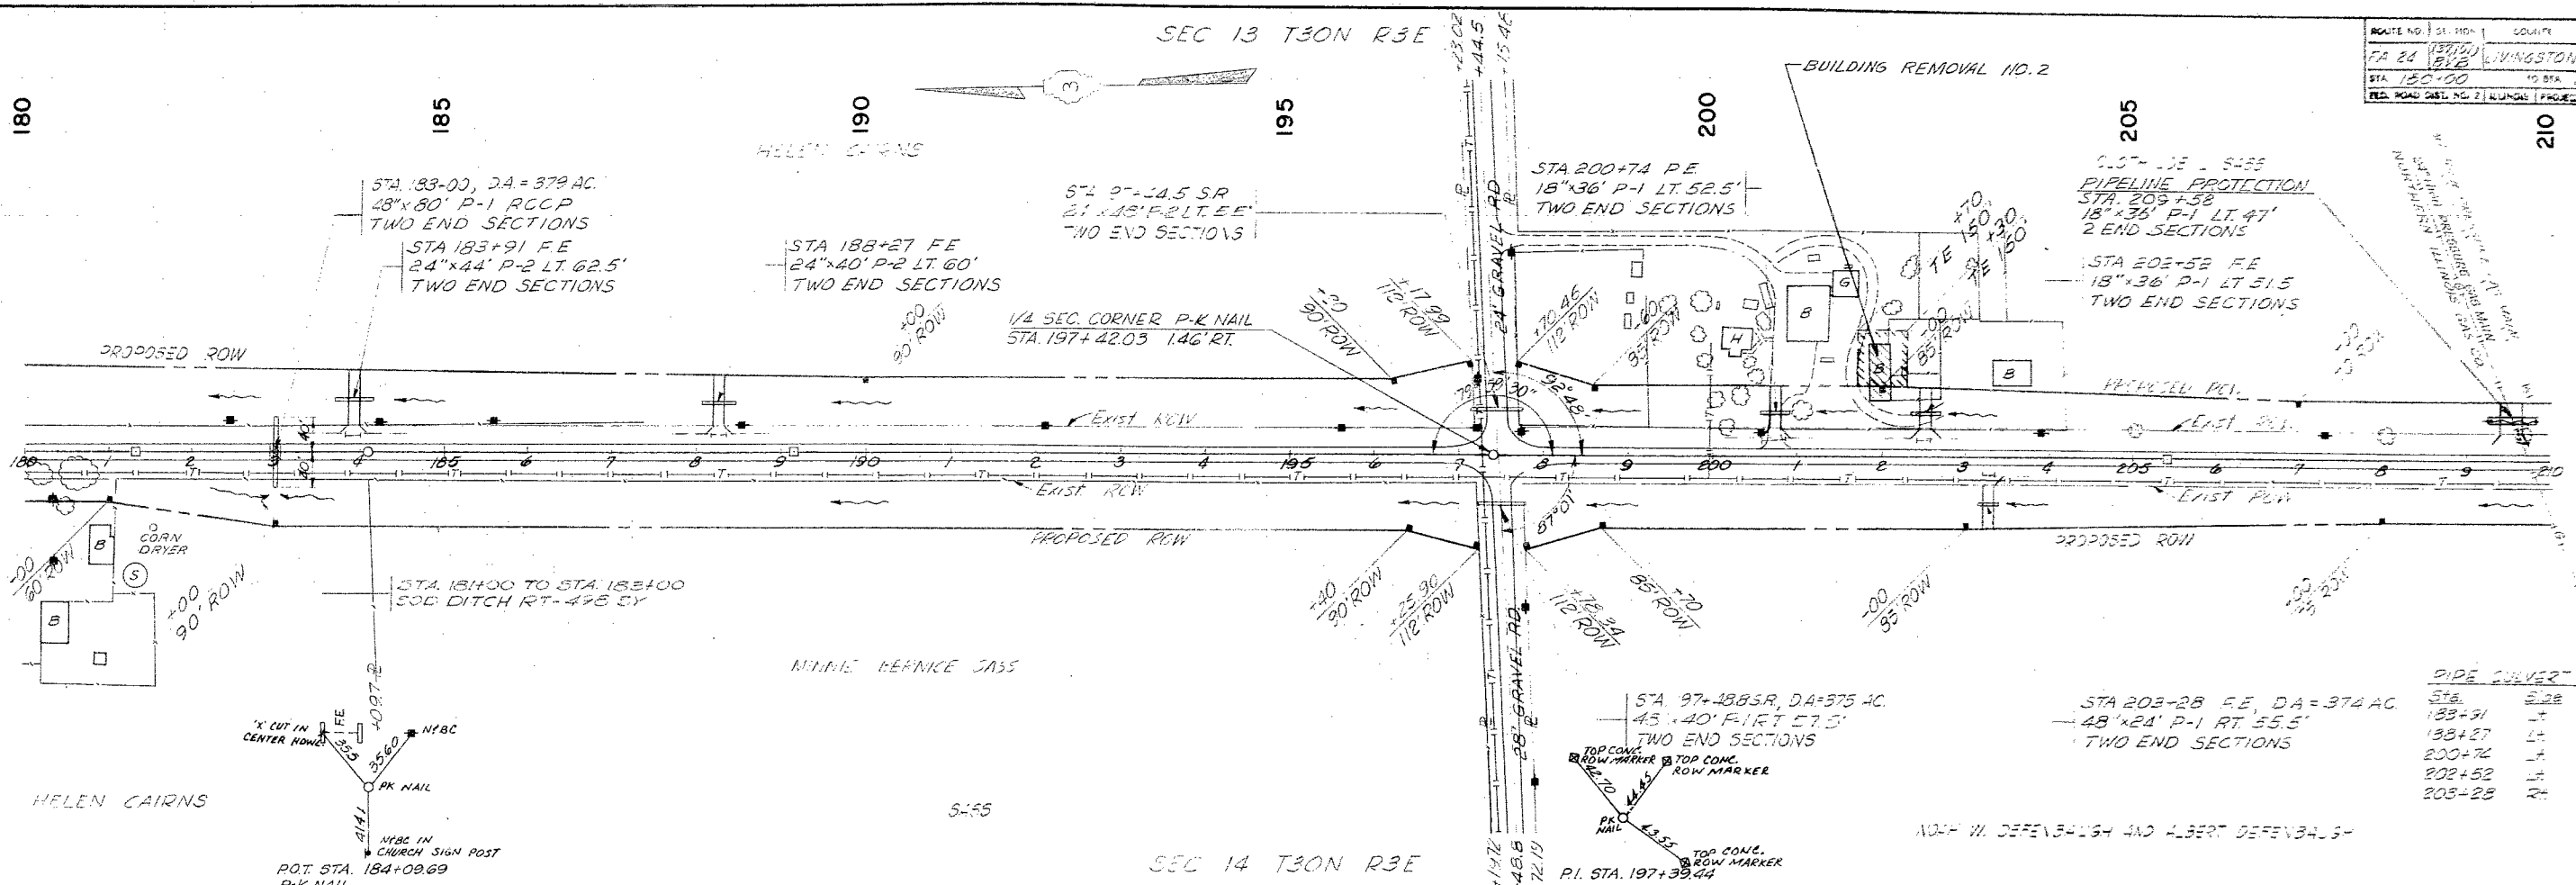

PIPE CULVERT REMOVAL

Sta.	Size	Size
183+21	15'x18'	
188+27	15'x18'	
200+74	15'x20'	
202+52	15'x18'	
203+28	15'x17'	

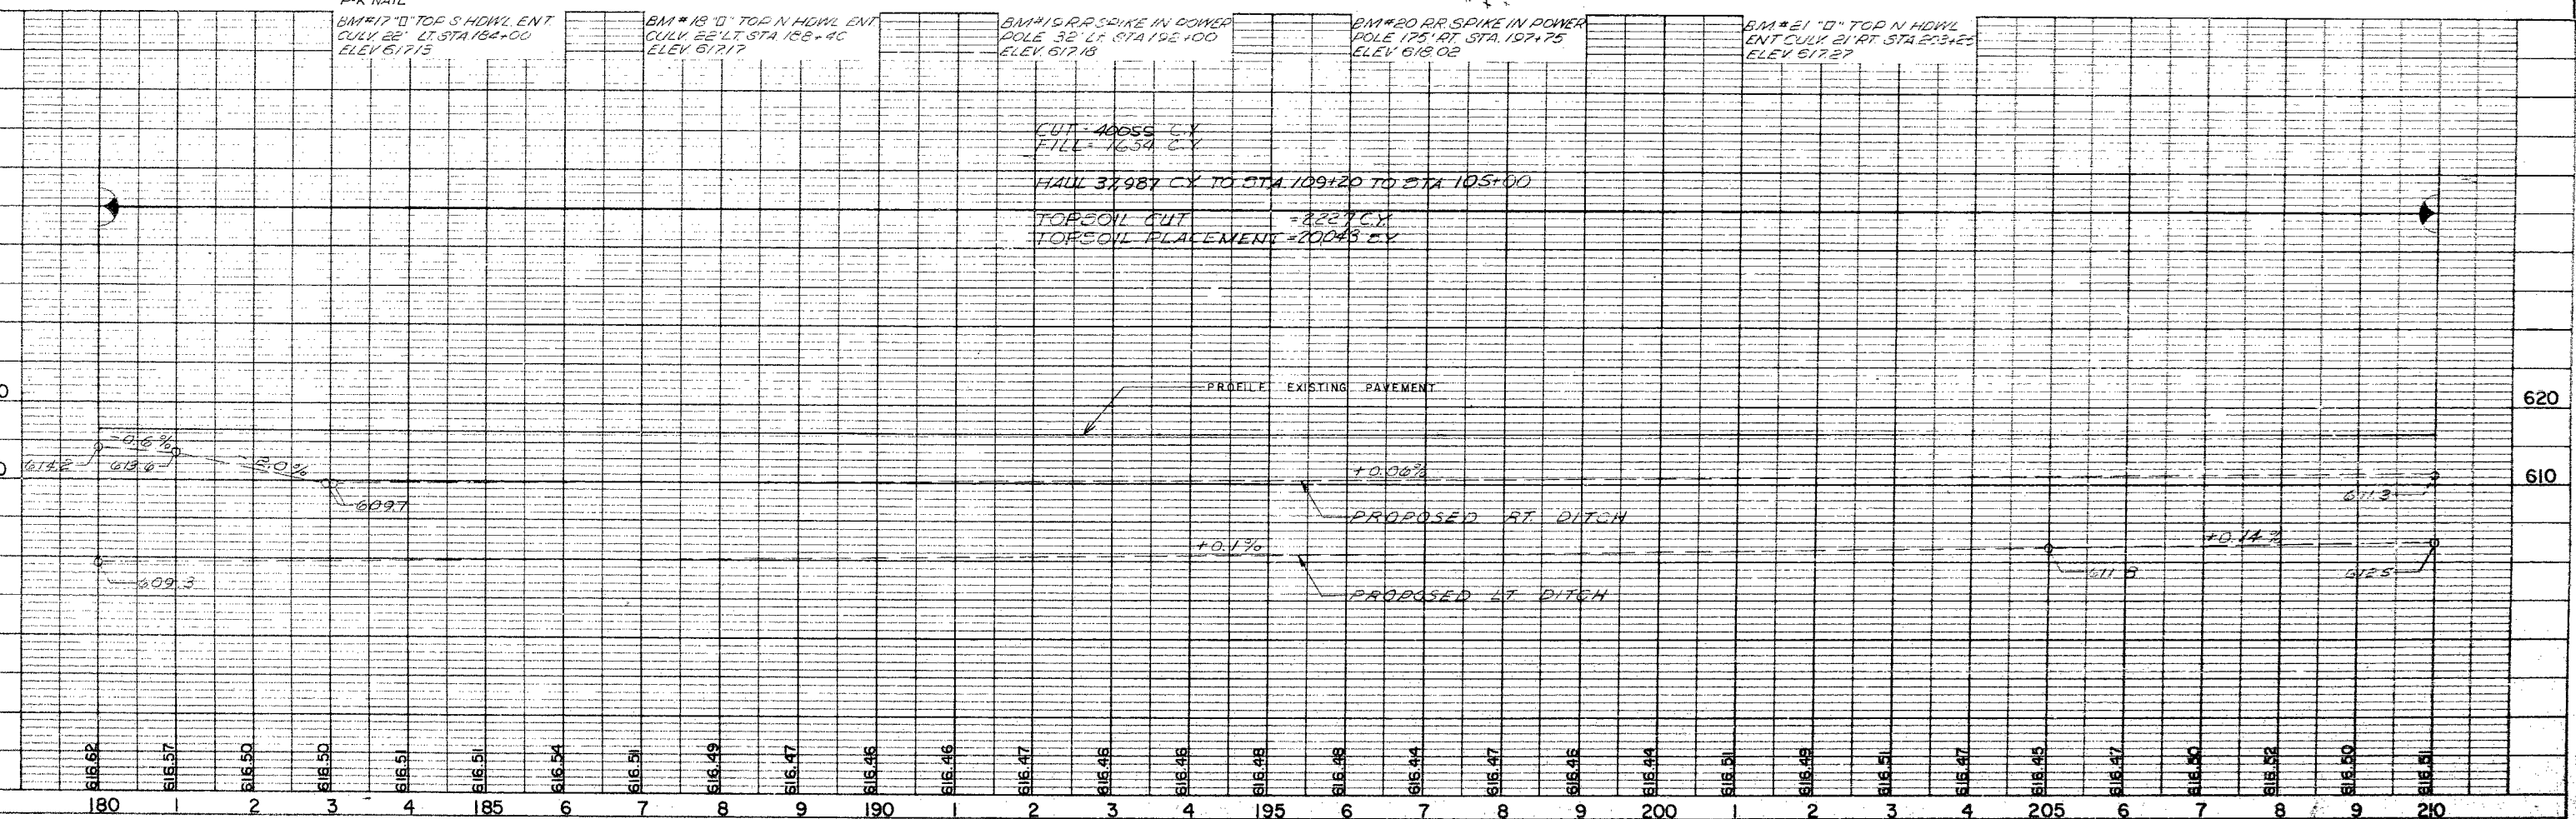


PLATE 1—PLAN PROFILE & P. B. STANDARD  
THE FREDERICK POST CO., CHICAGO

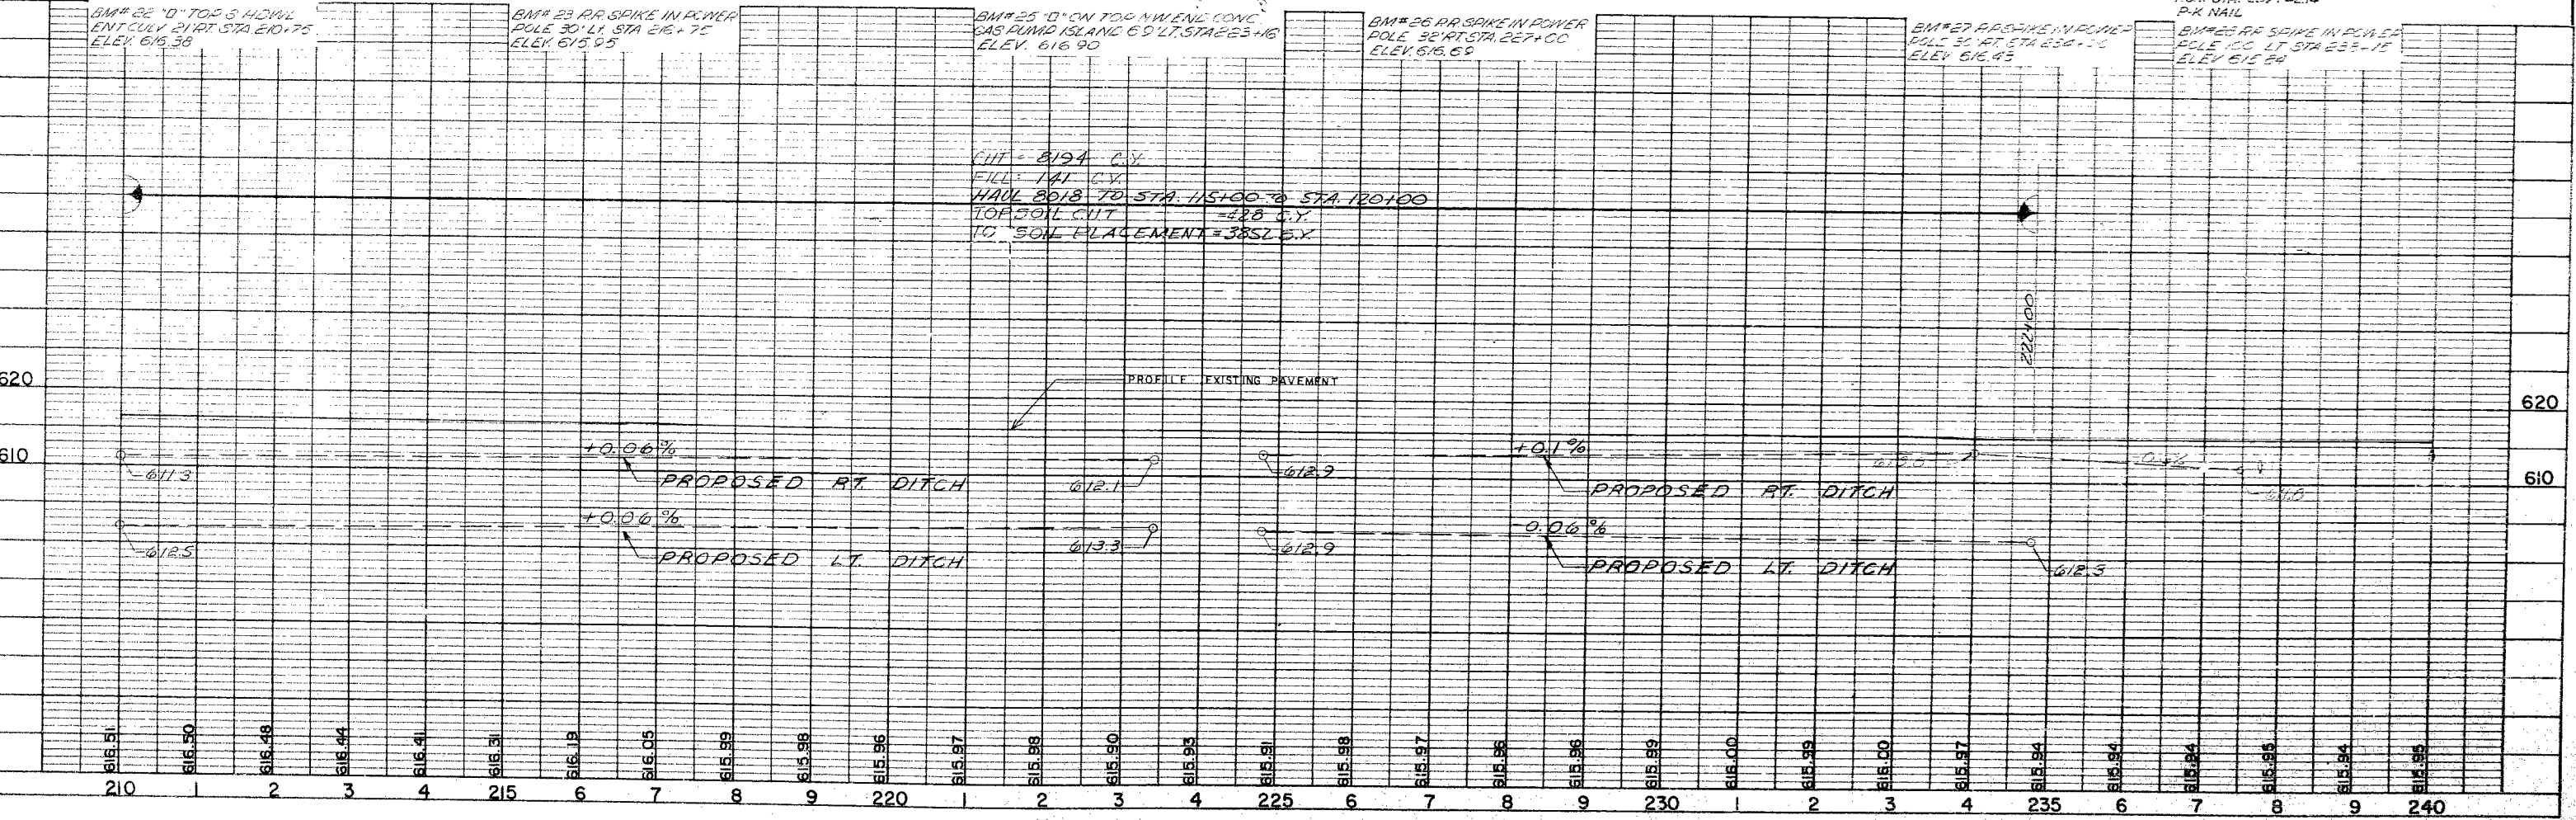
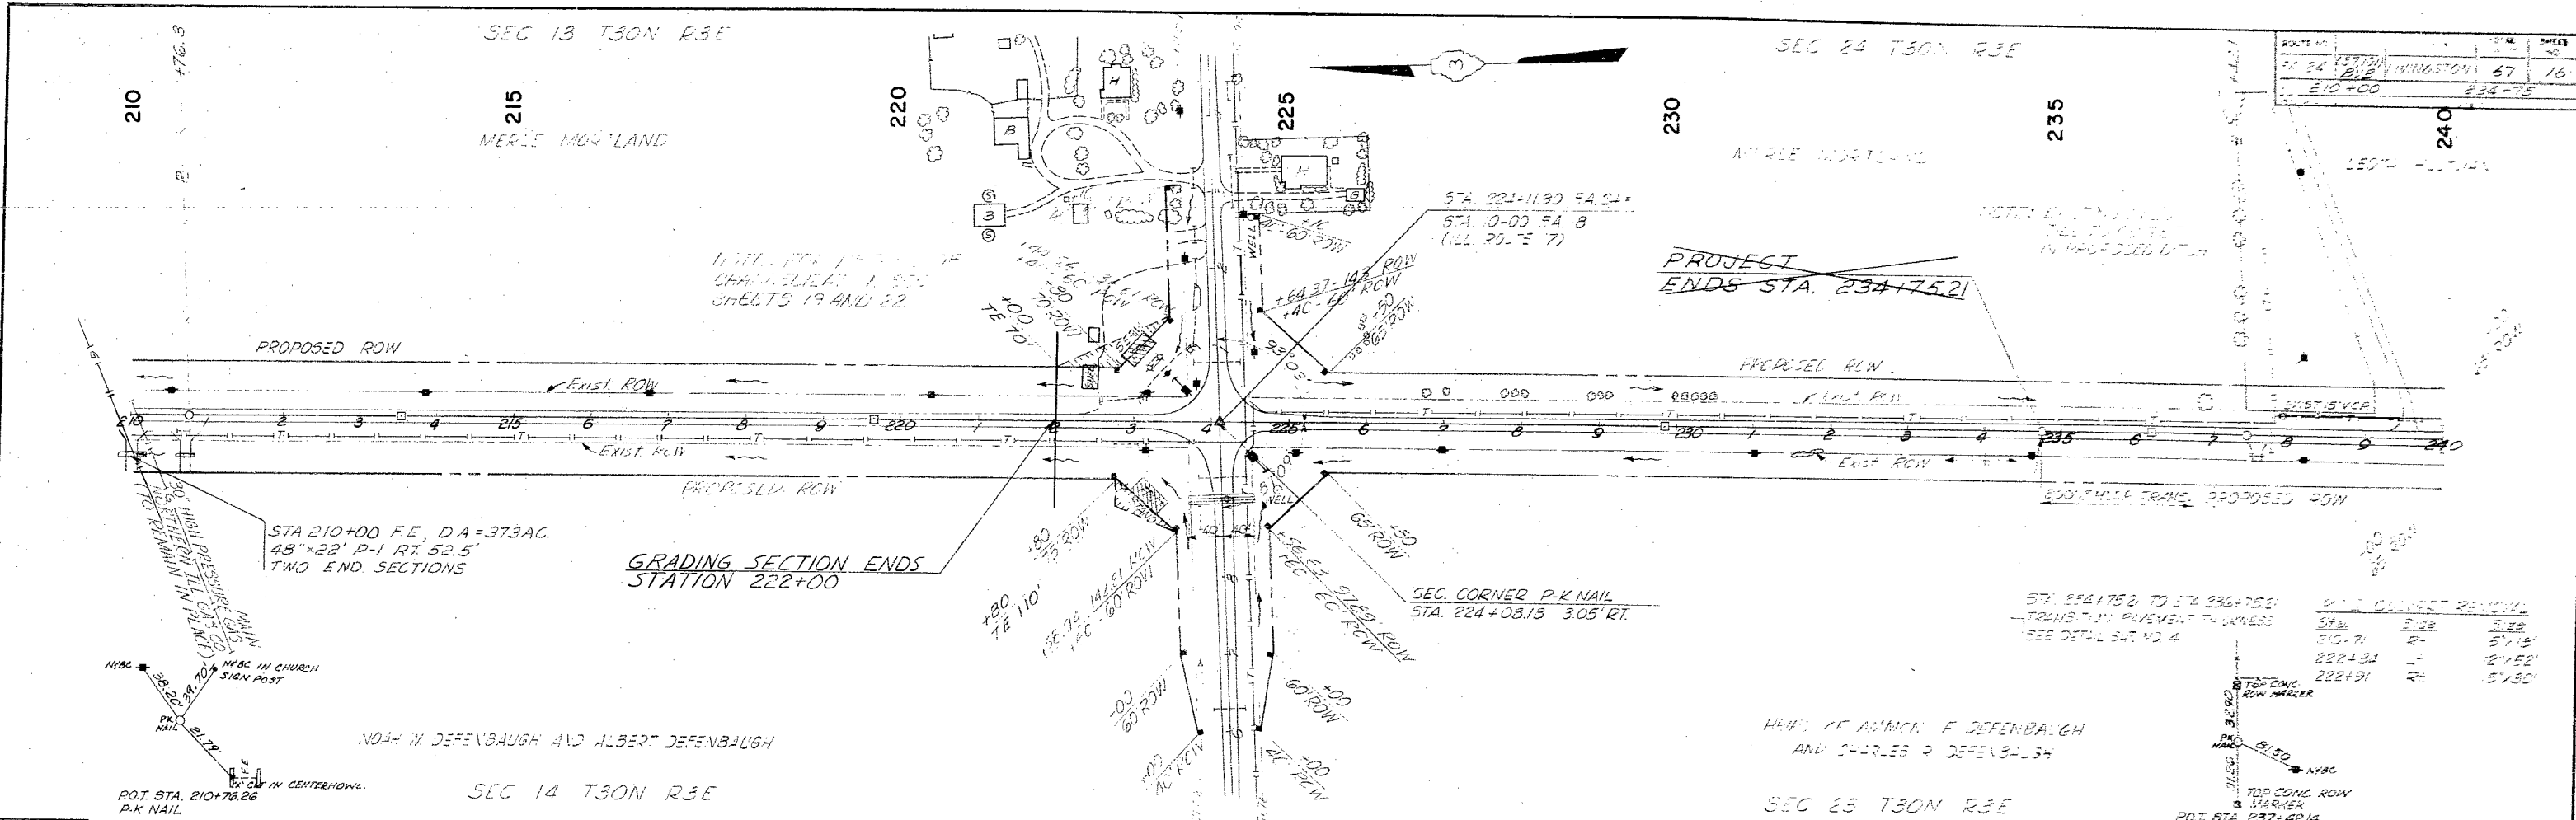


PLATE I - PLAN PROFILE & P.A. STANDARD  
 THE FREDERICK POST CO., CHICAGO

P1 STA 7+72.42  
 $\Delta = 17^{\circ}29'00''$   
 $D = 5^{\circ}00'$   
 $T = 97.85'$   
 $R = 636.62'$   
 $L = 194.26'$   
 $E = 7.42'$   
 $SE = 0.0066''$   
 ATTAIN SE. 6+08 TO 7+08  
 REMOVE SE. 8+35 TO 9+35

P1 STA 13+00.00  
 $\Delta = 64^{\circ}33'00''$   
 $D = 18^{\circ}00'$   
 $T = 201.03'$   
 $R = 318.31'$   
 $L = 358.61'$   
 $E = 58.17'$   
 $SE = 0.0401''$   
 ATTAIN SE. 10+32 TO 11+52  
 REMOVE SE. 14+24 TO 15+28

P1 STA 17+62.22  
 $\Delta = 54^{\circ}37'45''$   
 $D = 16^{\circ}00'$   
 $T = 164.59'$   
 $R = 318.31'$   
 $L = 303.50'$   
 $E = 39.95'$   
 $SE = 0.0401''$   
 ATTAIN SE. 15+28 TO 16+31  
 REMOVE SE. 18+68 TO 19+68

LIMITS OF GRADING


STA 2+57 BEGIN IMPROVEMENT

STA 2+50 TO STA 7+00  
SIDE DITCH RT. - 324 EX  
FRANCES A. DUVALL

SEC 11 T30N R3E

LAVERNE LENTMAN

STA 8+00 END GRADING THIS CONTRACT

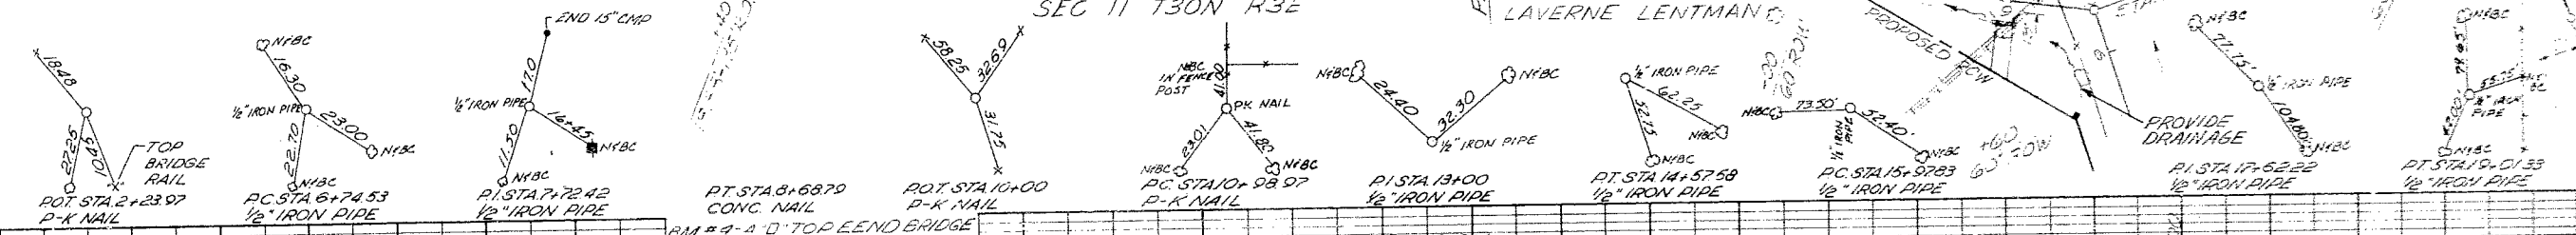

PVI STA 2+83  
 ELEV. 593.37  
 $VC = 130'$   
 $E = 0.74$   
 $K = 0.30$

PVI STA 2+80  
 ELEV. 597.55  
 $VC = 40'$   
 $E = 0.00$   
 $K = 0.66$

PVI STA 8+00  
 ELEV. 590.27  
 $VC = 300'$   
 $E = 0.98$   
 $K = 1.12$

PVI STA 12+00  
 ELEV. 591.11  
 $VC = 300'$   
 $E = 1.08$   
 $K = 1.04$

PVI STA 18+00  
 ELEV. 599.71  
 $VC = 200'$   
 $E = 0.88$   
 $K = 0.95$

CUT = 35,822 CY  
 FILL = 1894 CY  
 HAUL = 16804 CY TO STA. 100+00 TO STA. 102+00  
 TOP SOIL CUT = 986 CY  
 TOP SOIL PLACEMENT = 8874.5 CY  
 HAUL 17,351 CY TO STA. 102+00 TO 105+35

NOTE: STA 9+50 TO STA 10+25 USE TYPICAL SECTION 13

MEET EXISTING SURFACE AT STA 3+50

GRADE THIS CONTRACT TO 3" BELOW P.G.L. AS SHOWN.

PVI STA 11+10  
 ELEV. 585.84  
 $VC = 100'$   
 $E = 1.40$   
 $K = 0.32$

SIDE ROAD LT. STA. 0+75

PROPOSED RT. DITCH

SIDE ROAD RT. STA. 125+50


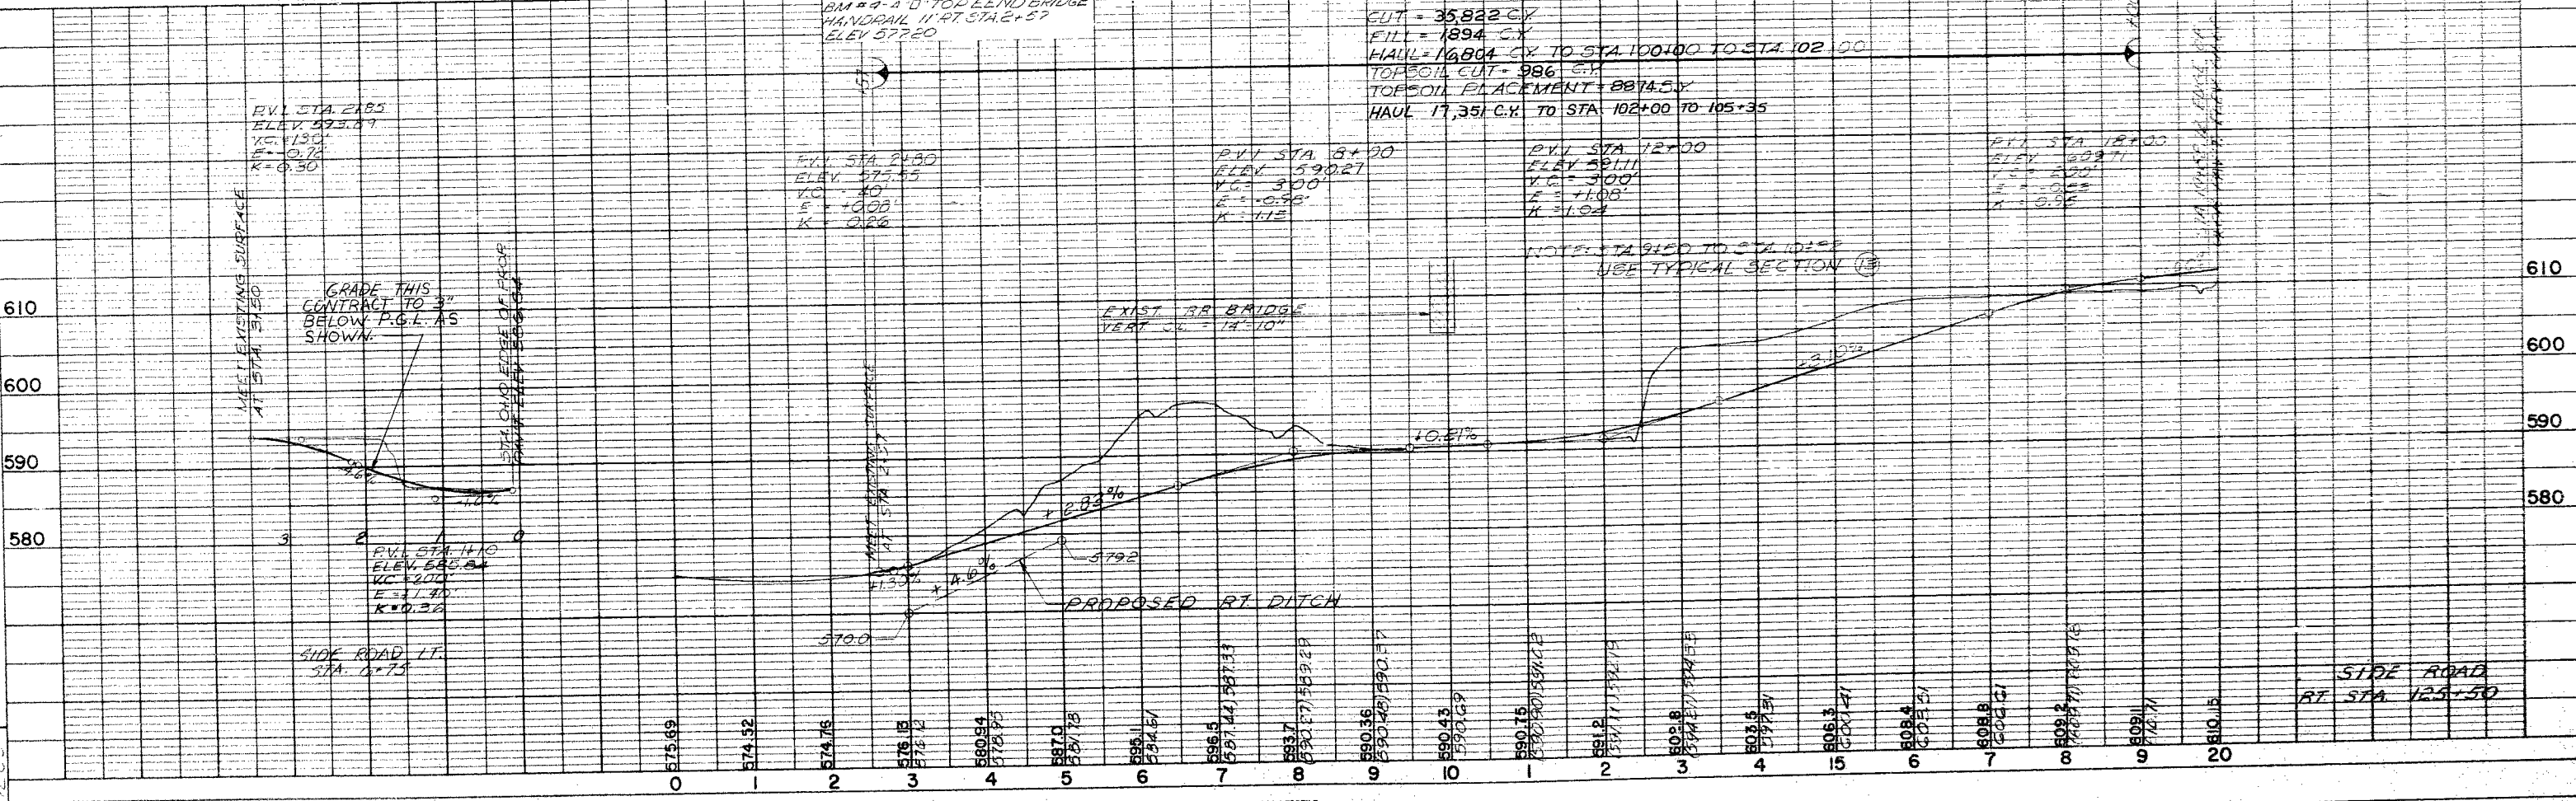


PLATE 1 - PLAN PROFILE B. P. R. STANDARD THE FREDERICK POST CO., CHICAGO

GROUP NO.	SECTION	COUNTY	TOWNSHIP	RANGE
FA 24	13701	LIVINGSTON	67	18
STA.	TO STA.			
RD. ROAD DIST. NO. 7   LANCES   PROJECT				

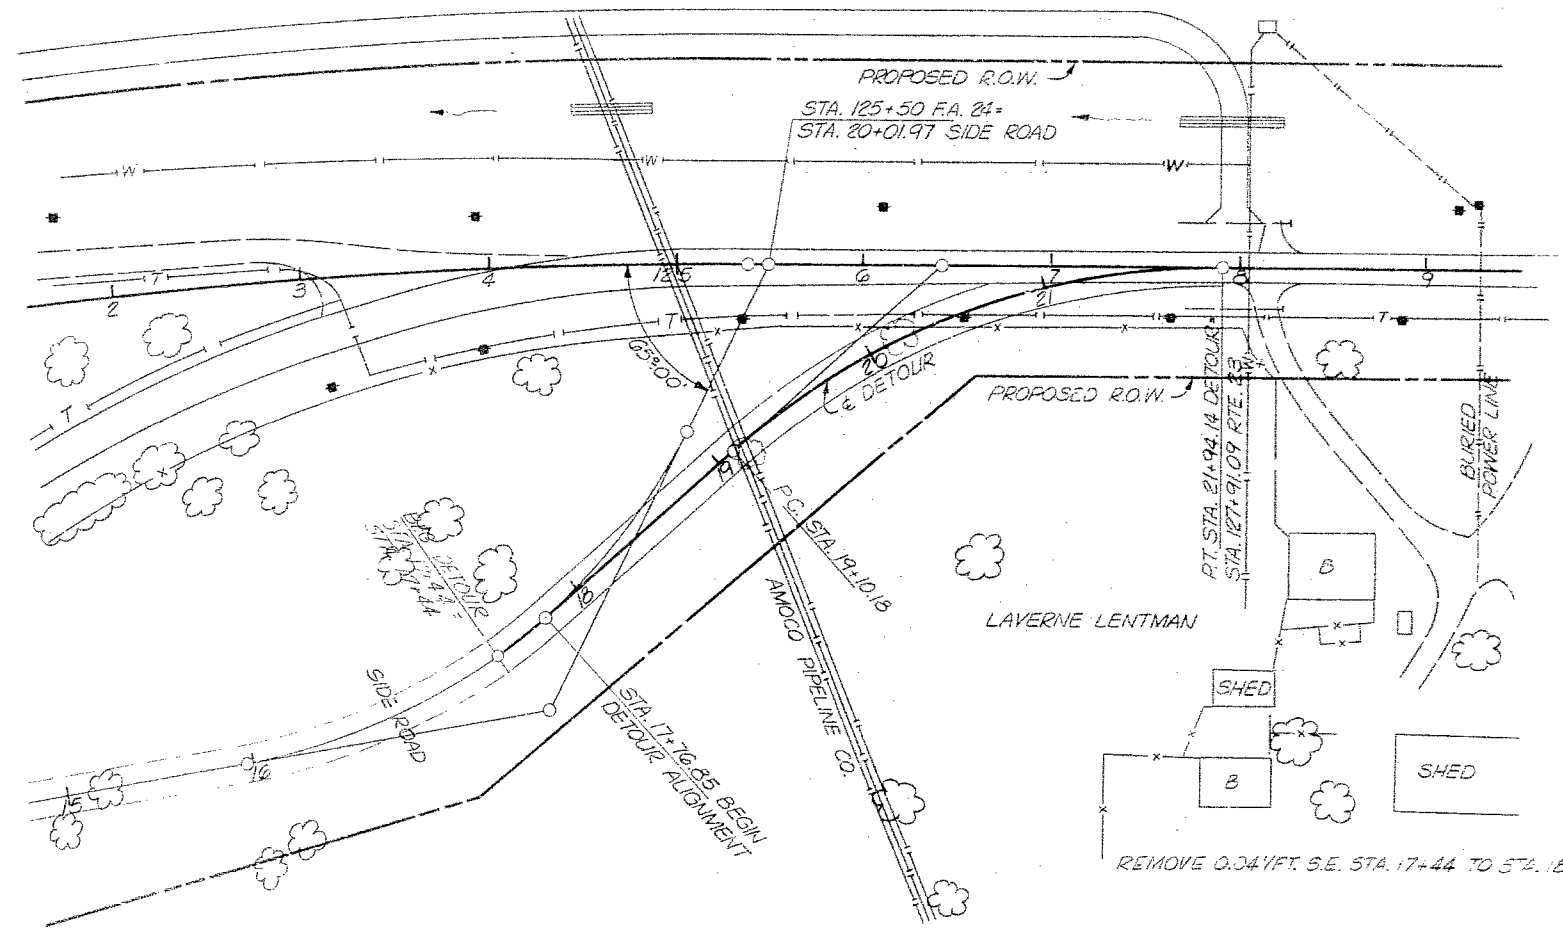

FOR INFORMATION ONLY

P.I. STA. 20+59.08 DETOUR = STA. 26+42.9 F.A. 24  
 L = 42° 35' 20" RT.  
 D = 15° 00' 00"  
 T = 148.90'  
 R = 381.97'  
 L = 283.96'  
 E = 28.00'  
 S.E. 0.04VFT.  
 ATTAIN S.E. STA. 18+44 TO STA. 19+44  
 REMOVE S.E. TO 0.016 VFT. STA. 20+25 TO STA. 20+75

SCALE IN FEET 0 50 100

SEC. 11 T30N R3E

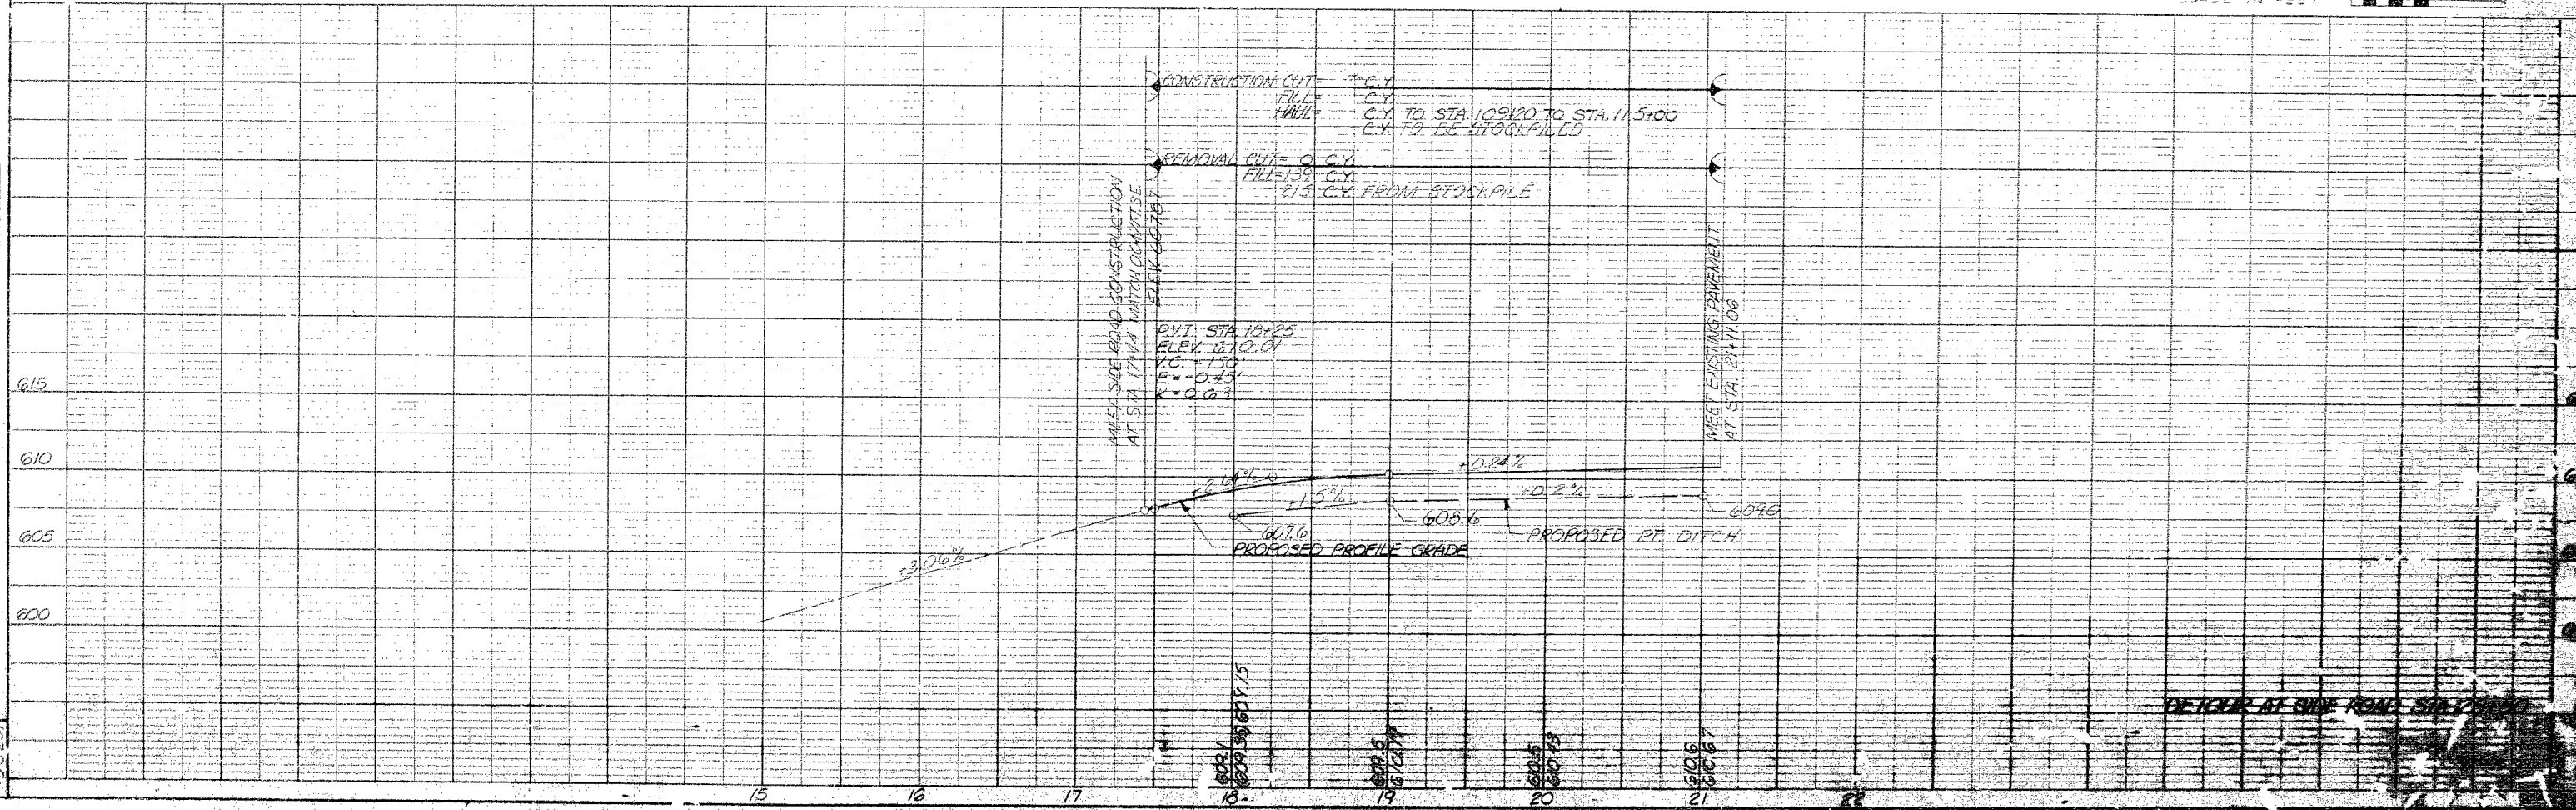


PLATE 1 - PLAN - PROFILE

DATE: 5-2-75  
 SURVEYED BY: JAMES JONES  
 ALIGNED CHECKED BY: JAMES JONES  
 PLAN NO. 1

DATE: 5-2-75  
 PROFILE NO. 1  
 CHECKED BY: JAMES JONES  
 PLOTTED BY: JAMES JONES  
 8 M.S. NOTED  
 STRUCTURE UNLIT AND UNPAVED

75-207


STATE OF ILLINOIS  
DEPARTMENT OF TRANSPORTATION

ROUTE NO.	SECTION	COUNTY	TOTAL SHEETS	SHEET NO.
S.B.L. F.A. 24	37.101 BVB	LIVINGSTON	67	15
FED. ROAD DIST. NO. 7		ILLINOIS	FED. AID PROJECT	

SHEET NO. 1  
22 SHEETS


B.M.: "5" Top Headwall of R.R. Bridge 50' Lt. Sta. 108+20 Elev. 615.03.  
Existing Structure: SA Rte. 16A, Sec. 315D built in 1924. Reinf. Concrete Deck Girders and closed Abutments. Bridge to be removed after construction of new structure and roadway. (By Others)

This portion of the embankment backfill to be constructed by Bridge Contractor after the abutment is in place. (Typ.)

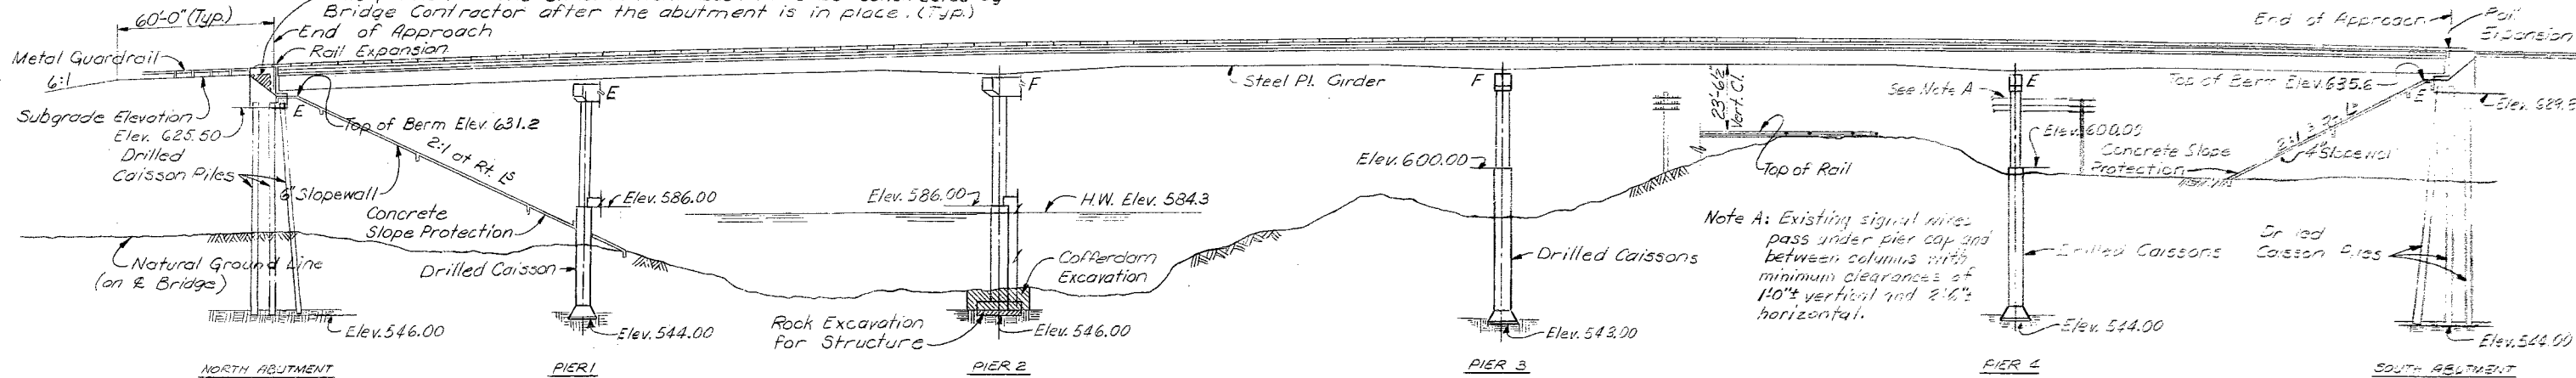

WATERWAY INFORMATION



Drainage Area 1080 sq. mi.  
Present Opening 4970 sq. ft. (below 50-yr H.W.E.)  
Required Opening 5600 sq. ft. (below 50-yr H.W.E.)  
Proposed Opening 6100 sq. ft. (below 50-yr H.W.E.)  
Q(50) 26,000 c.f.s.  
Q(100) 29,300 c.f.s.  
The created head is negligible.

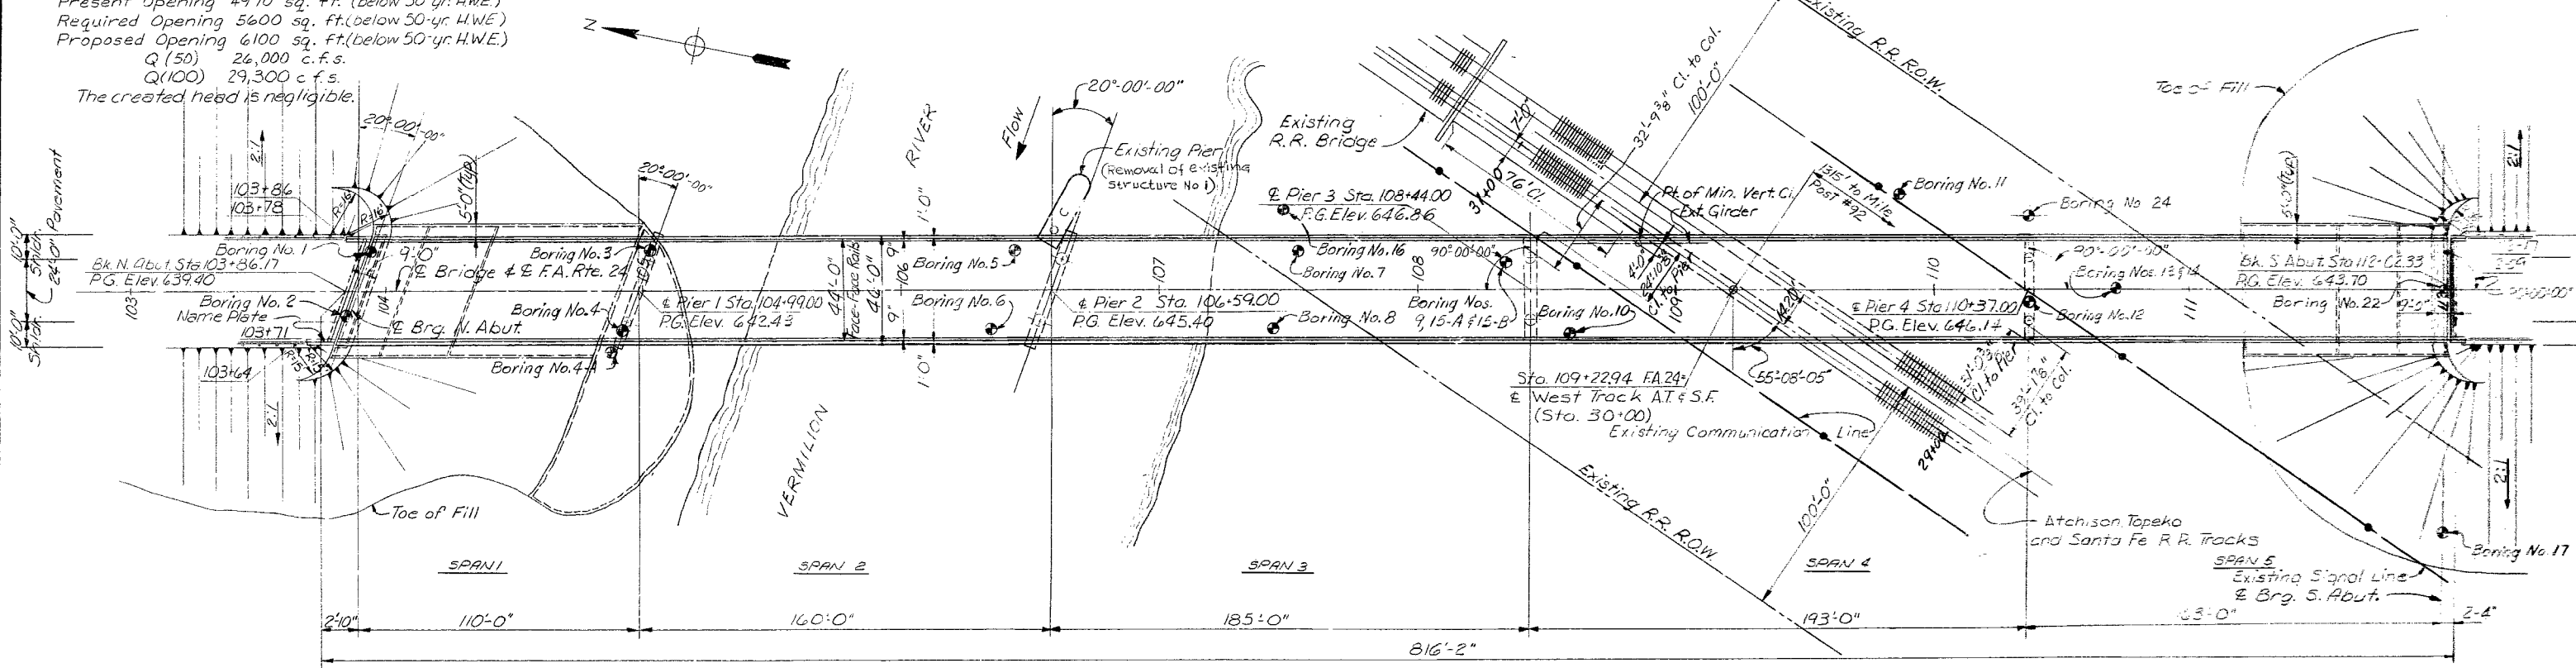

LIST OF DRAWINGS

- |   |                                       |
|---|---------------------------------------|
| 1. GENERAL PLAN AND ELEVATION                           | 12. SLAB                              |
| 2. GENERAL NOTES, ESTIMATED QUANTITIES & FOOTING LAYOUT | 13. SLAB                              |
| 3. STRUCTURAL STEEL                                     | 14. PARAPET AND SLAB POURING SEQUENCE |
| 4. STRUCTURAL STEEL                                     | 15. ALUMINUM RAILING                  |
| 5. STRUCTURAL STEEL                                     | 16. NORTH ABUTMENT                    |
| 6. STRUCTURAL STEEL                                     | 17. SOUTH ABUTMENT                    |
| 7. BEARINGS   | 18. PIER 1                            |
| 8. MOMENTS AND REACTIONS                                | 19. PIER 2                            |
| 9. DECK ELEVATIONS                                      | 20. PIER 3                            |
| 10. DECK ELEVATIONS                                     | 21. PIER 4                            |
| 11. DECK ELEVATIONS                                     | 22. NEOPRENE EXPANSION JOINT          |

DESIGNED C. Wiczcerek  
S. Franklin  
CHECKED G. Rauber  
DRAWN D. Ammons  
CHECKED G. Dee

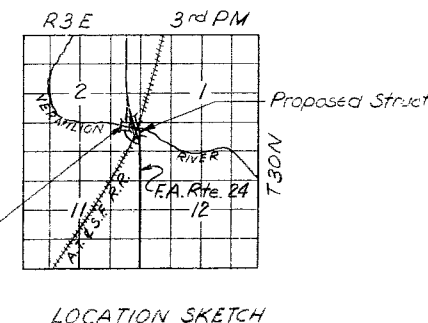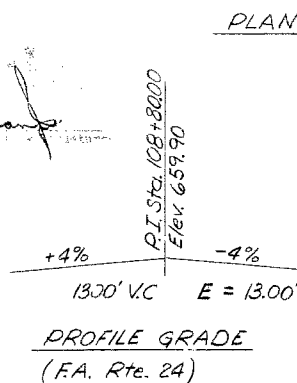

STATION 106+39  
BUILT 197 BY  
STATE OF ILLINOIS  
F.A. RT. 24 SEC.(37,101) BVB  
F.A. PROJ.BR-F-68(24)  
LOADING HS20

NAME PLATE  
(See Std. 2113)

STATE OF ILLINOIS  
LIVINGSTON COUNTY  
2543  
1700  
1970  
REPUBLICAN PARTY

NOTES  
For Boring Data, see Special Provisions  
Abutment berms shall be sloped 2" per foot to drain.  
For details and sections thru slope walls, see Sheet 2.  
For General Notes and Estimated Quantities, see Sheet 2.

GENERAL PLAN AND ELEVATION  
F.A. ROUTE 24 (ILL. 23) OVER  
VERMILION RIVER AND THE ATCHISON  
TOPEKA & SANTA FE RAILROAD  
F.A. RT. 24 SEC.(37,101) BVB  
LIVINGSTON COUNTY  
STATION 106+39

Note: Do not scale this drawing. Follow dimensions.

Revised 9-1-78

Rev. 9.12.70

GENERAL NOTES

STATE OF ILLINOIS  
DEPARTMENT OF TRANSPORTATION

ROUTE NO.	SECTION	COUNTY	TOTAL SHEETS	SHEET NO.
S.B.L. F.A. 24	37,101 BVB	LIVINGSTON	67	20
FED. ROAD DIST. NO. 7	ILLINOIS	FED. AID PROJECT		

SHEET NO. 2  
22 SHEETS

CONSTRUCTION SPECIFICATIONS:

State of Illinois Standard Specifications for Road and Bridge Construction (1973 Edition) and Special Provisions.

DESIGN SPECIFICATIONS:

Division I of the AASHTO "Standard Specifications for Highway Bridges" (1973 Edition) including all Interim Specifications.

DESIGN LOADING:

Live Load - HS20-44  
Dead Load - Weight of structure includes reinforced concrete at 150 lbs. per cu. ft.; 18 lbs. per sq. ft. for Class I Surface Course and provisions for a future wearing surface of 25 lbs. per sq. ft. of roadway.

DESIGN UNIT STRESSES:

Concrete in Flexure:  
fc = 1,200 psi (Deck Slab)  
fc = 1,400 psi (Curbs, Parapets) Substructure fc = 3500 psi.  
Reinforcing Steel: (ASTM 615)  
Grade 40 fs = 20,000 psi. tension, fy = 40,000 psi.  
Grade 60 fs = 24,000 psi. tension, fy = 60,000 psi.  
Structural Steel:  
Structural Carbon Steel (M183)  
fs = 20,000 psi.

CONCRETE:

The concrete rail section above the mandatory construction joint at the top of the slab shall be constructed of Class X Concrete, except the aggregates shall conform to the requirements of Handrail Concrete.

REINFORCEMENT:

All reinforcement shall conform to A.S.T.M. A615, Grade 40 except as otherwise noted for Pier 4 and spirals.

PAINTING:

The basic lead silico chromate paint system shall be used for shop and field painting of Structural Steel.

PROTECTIVE COAT:

Protective Coat shall not be applied to surfaces to which Waterproofing Membrane System is applied.

STRUCTURAL STEEL:

Fasteners shall be high strength bolts. Bolts 7/8" φ, open holes 15/16" φ unless otherwise noted.  
Anchor bolts shall be set before bolting cross frames over supports.  
Field welding of construction accessories will not be permitted to the bottom flange of girders nor to the top flange for a distance equal to one-fourth the span length each way from the pier supports. Field welding in other areas will be permitted only when approved by the Engineer.  
The main load carrying member components subject to the supplemental requirements for notch toughness are the flanges as designated in the elevation view along with the webs and all splice plates of the steel girders.

EMBANKMENTS AND SLOPE WALLS:

The embankment configurations shown shall be the minimum embankment that must be constructed prior to construction of the abutments.  
Layout of slope walls may be varied in the field to suit ground conditions as directed by the Engineer.



CAISSON CONCRETE:

For construction requirements and payment for Caisson Concrete see Special Provisions; fc = 3500 psi.


TOTAL BILL OF MATERIAL

Item	Unit	Super.	Sub.	Total
Cofferdam Excavation	Cu. Yd.	—	230.0	230.0
Caisson Concrete	Cu. Yd.	—	764.6	764.6
Class X Concrete	Cu. Yd.	1116.2	24.0	2027.2
Reinforcement Bars	Lbs.	304,610	158,620	464,230
*Structural Steel	Lump Sum	1	—	1
Stud Shear Connectors	Each	7,311	—	7,311
Aluminum Railings	Lin. Ft.	1,686	—	1,686
Slope Wall 6 Inch	Sq. Yd.	—	1251	1251
Slope Wall 4 Inch	Sq. Yd.	—	664	664
Name Plates	Each	1	—	1
Neoprene Expansion Joint (6 1/2")	Lin. Ft.	93	—	93
Removal Of Existing Structures (Pier)	Each	—	1	1
Rock Excavation For Structure	Cu. Yd.	—	7.0	7.0
Cofferdams	Each	—	1	1



\*Calculated plan wt. of structural steel = 1,727,125 Lb.

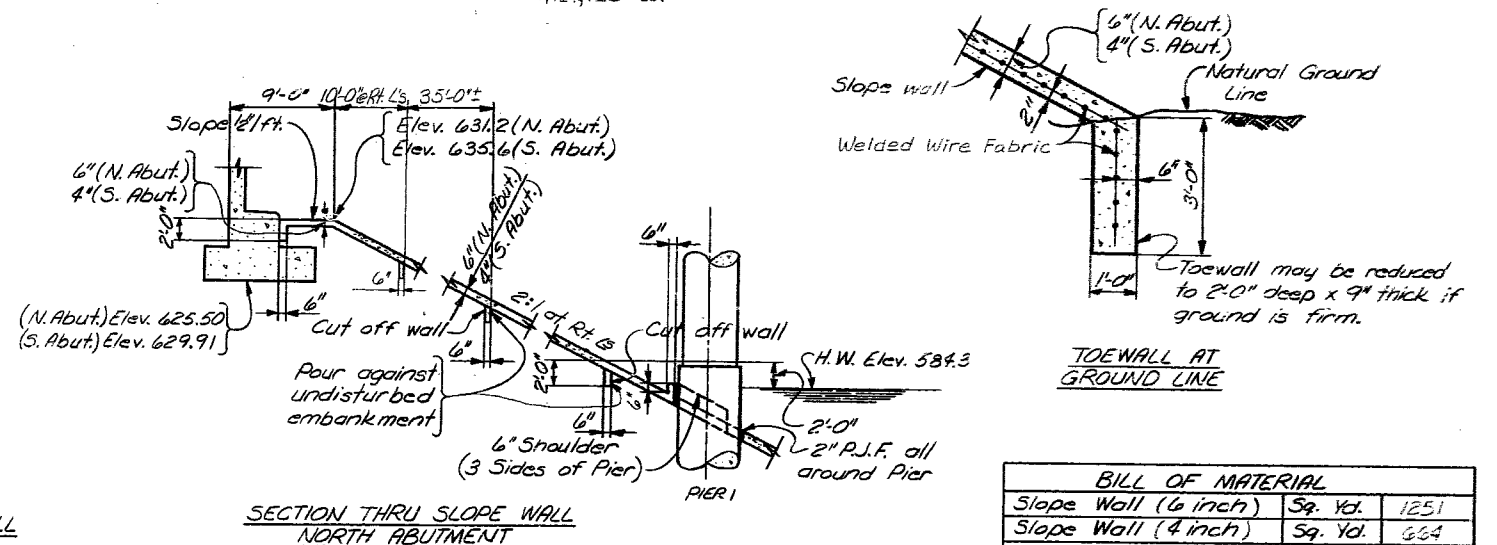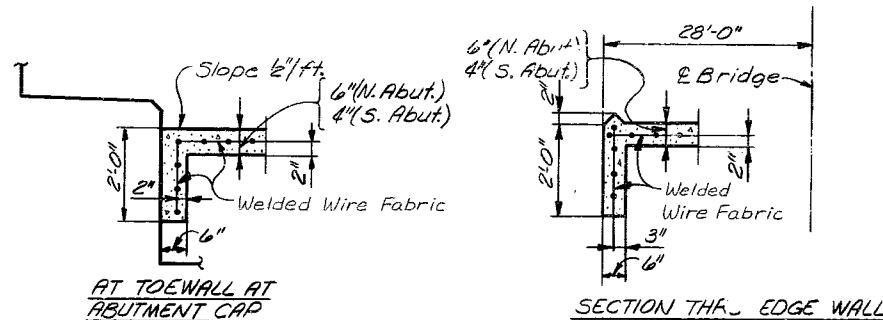

BILL OF MATERIAL		
Slope Wall (6 inch)	Sq. Yd.	1251
Slope Wall (4 inch)	Sq. Yd.	664

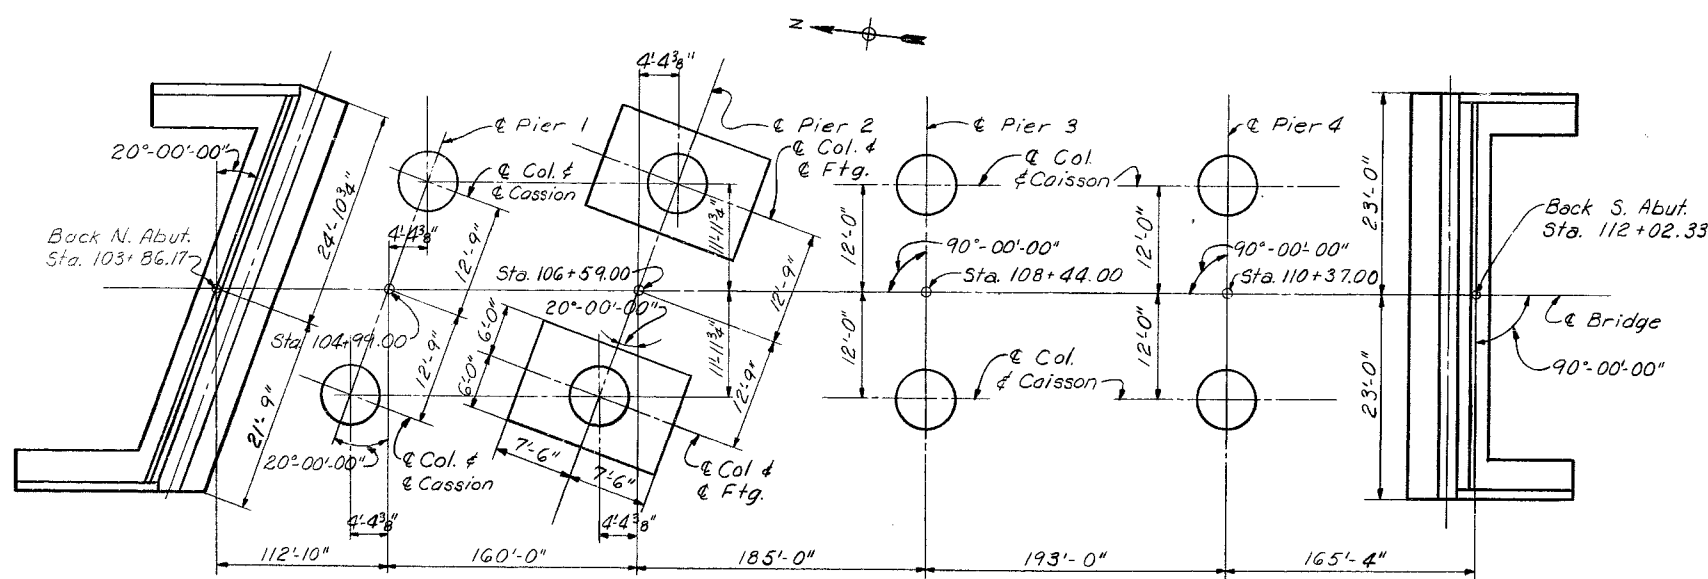

SECTION THRU SLOPE WALL  
NORTH ABUTMENT  
Note: Section of South Abut. similar except cut off wall at High Water and joint around pier not required.  
Wire fabric not shown to be 6" x 6" Mesh, No. 4 Wires, wt. 58#/100'.

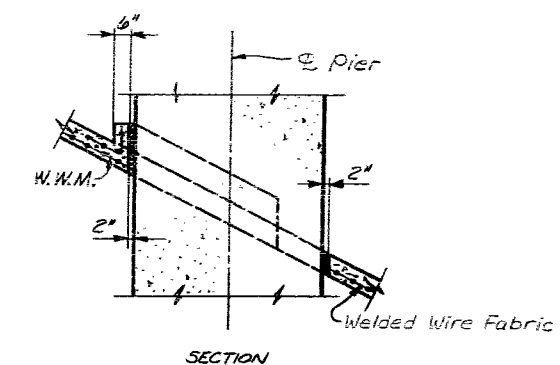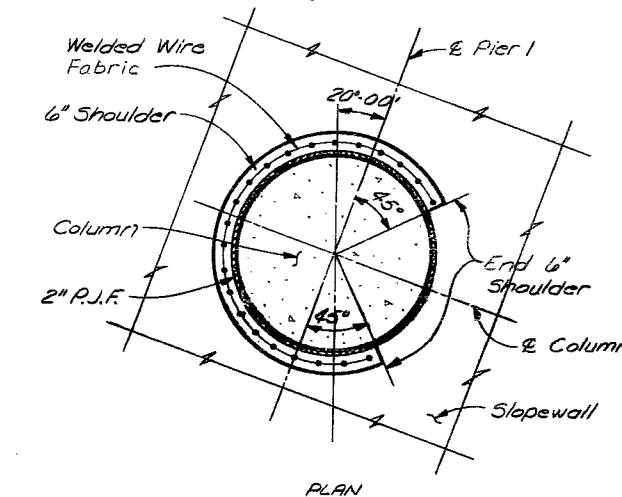


GENERAL NOTES, ESTIMATED QUANTITIES & FOOTING LAYOUT  
F.A. ROUTE 24 (ILL. 23) OVER VERMILION RIVER AND THE ATCHISON TOPEKA & SANTA FE RAILROAD  
F.A. RT. 24 SEC. (37,101) BVB  
LIVINGSTON COUNTY  
STATION 106+39

DESIGNED	
CHECKED	
DRAWN	D. Richardson
CHECKED	G. Dee


Note: Do not scale this drawing. Follow dimensions.

STATE OF ILLINOIS  
DEPARTMENT OF TRANSPORTATION


ROUTE NO.	SECTION	COUNTY	TOTAL SHEETS	SHEET NO.	SHEET NO. 3 22 SHEETS
S.B.I.	37.101	LIVINGSTON	67	21	
F.A.	BYB	ILLINOIS	FED. AID PROJECT		
FED. ROAD DIST. NO.	7				

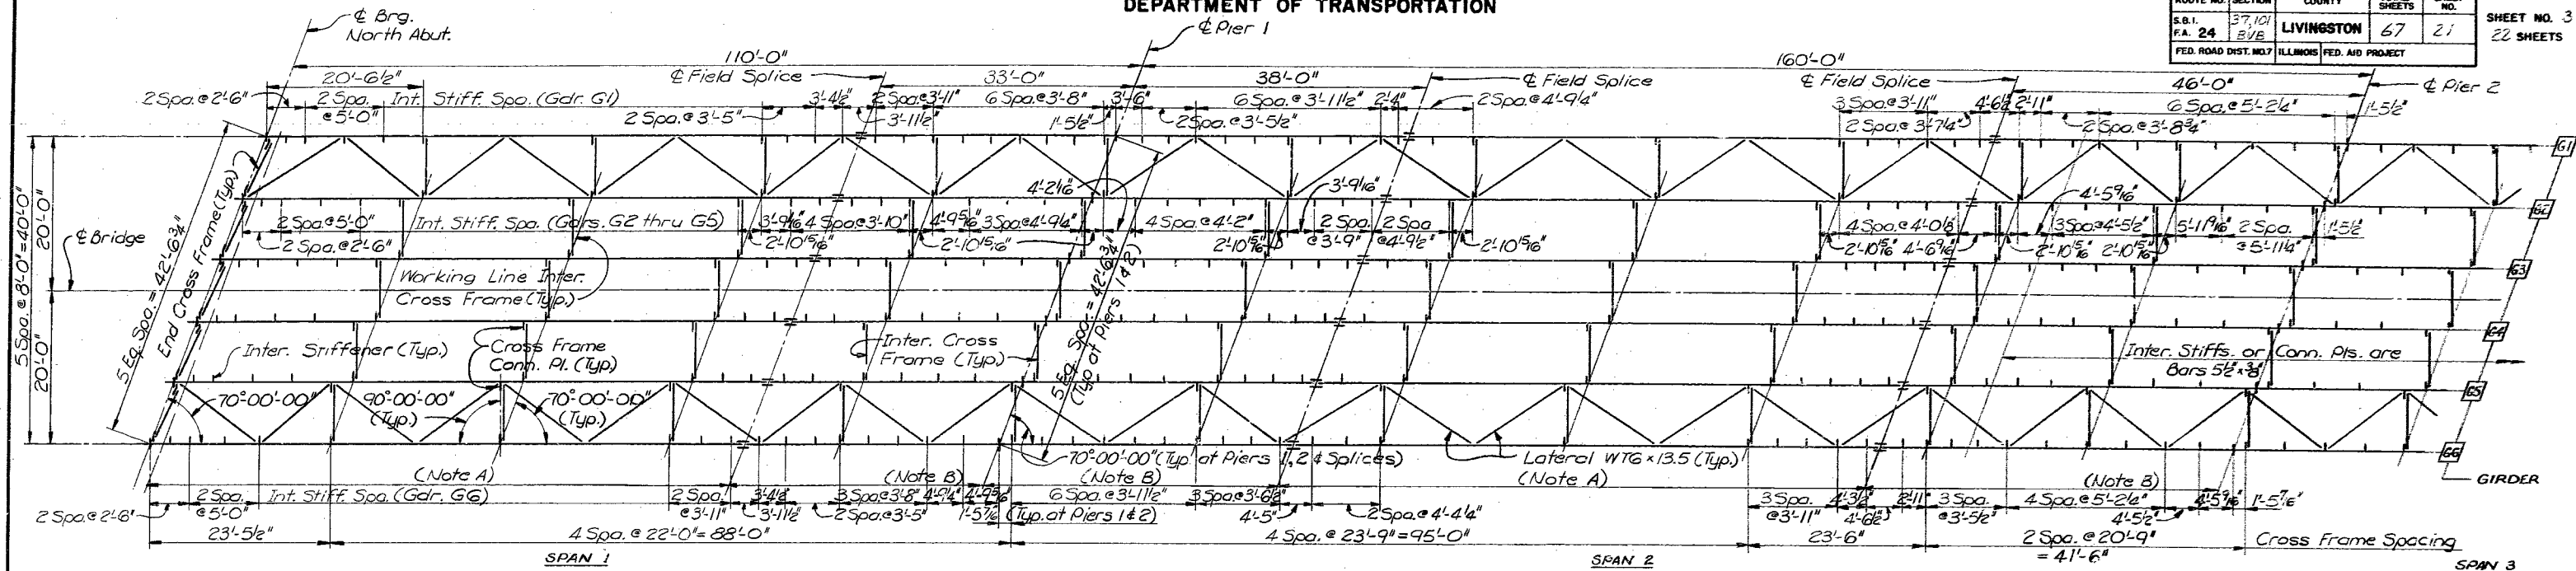

**FRAMING PLAN**  
Note: Intermediate stiffeners and cross frame connection plates are Bars 5" x 5/16" except as noted near Pier 2 in plan.

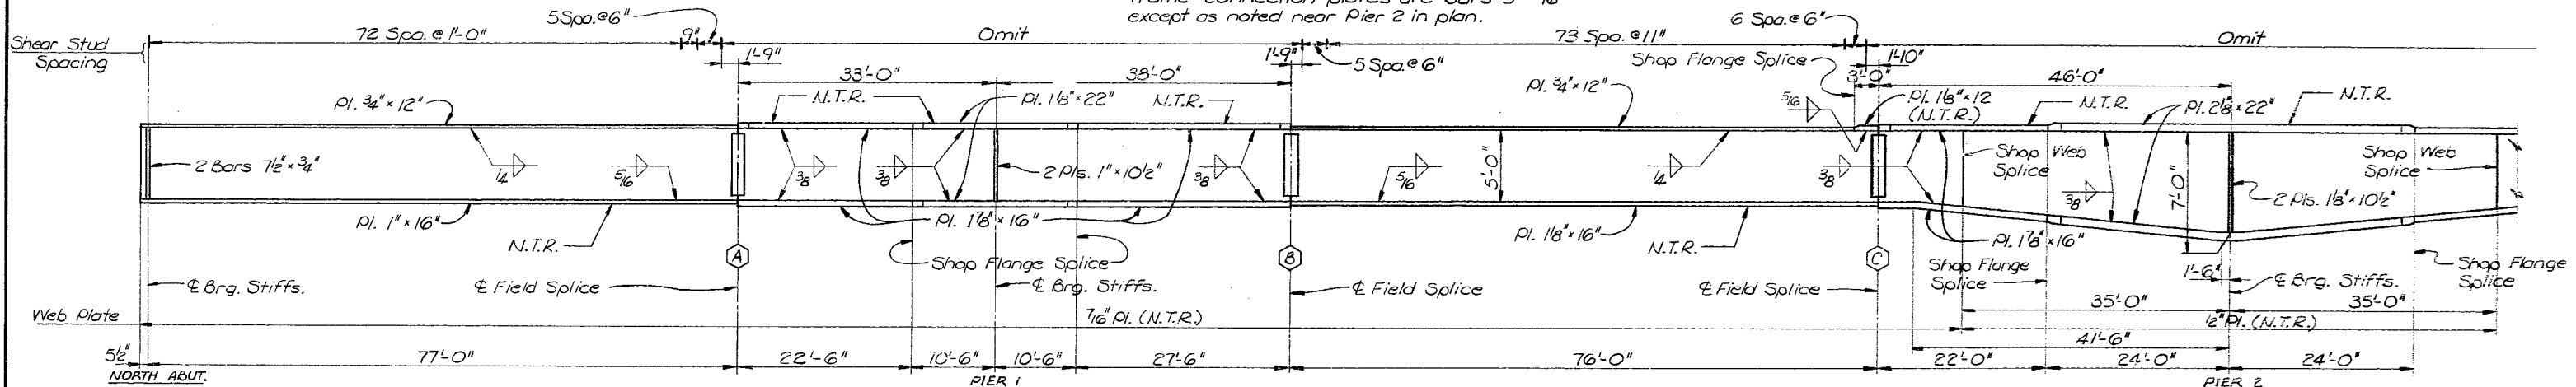

**ELEVATION - GIRDERS G1 THRU G6**  
Note: Field splice flange plates and intermediate stiffeners not shown.  
O - Denotes type of field splice.

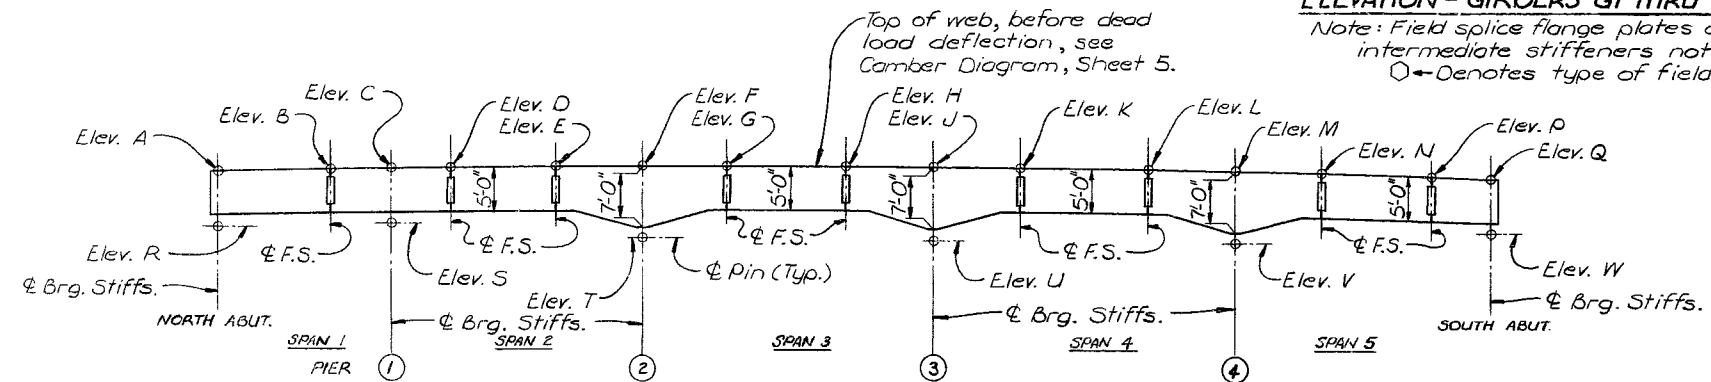

**GIRDER LAYOUT**  
Note: All splices and bearing stiffeners shall be vertical.  
F.S. indicates Field Splice.

**NOTES**  
Longitudinal dimensions are measured horizontally along the center line of girders. For Girder Details, see Sheet 6.  
"N.T.R." indicates plates subject to the Supplemental Requirements for Notch Toughness.  
For Structural Steel Notes, see Sheet 6.

Note A: Intermediate stiffeners or cross frame connection plates used as intermediate stiffeners shall be welded to top flange of girders.  
Note B: Intermediate stiffeners or cross frame connection plates used as intermediate stiffeners shall be welded to bottom flange of girders.  
Note: Welding for cross frame connection plates shall be same as intermediate stiffeners shown on plans.

DESIGNED	C. Wiczorek
CHECKED	S. Franklin
DRAWN	G. Dee
CHECKED	R. Butterfield

Girder	GIRDER ELEVATIONS														E PIN ELEVATIONS						
	Elev. A	Elev. B	Elev. C	Elev. D	Elev. E	Elev. F	Elev. G	Elev. H	Elev. J	Elev. K	Elev. L	Elev. M	Elev. N	Elev. P	Elev. Q	Elev. R	Elev. S	Elev. T	Elev. U	Elev. V	Elev. W
G1	638.450	640.487	641.255	642.140	643.494	644.130	644.766	645.424	645.506	645.588	645.200	644.780	644.377	643.248	642.457	632.867	635.432	636.286	637.672	636.947	636.790
G2	638.530	640.580	641.355	642.246	643.614	644.258	644.902	645.591	645.673	645.755	645.367	644.946	644.544	643.414	642.624	632.947	635.532	636.414	637.839	637.113	636.957
G3	638.568	640.632	641.412	642.310	643.688	644.344	645.000	645.717	645.798	645.879	645.492	645.071	644.669	643.539	642.749	632.984	635.589	636.500	637.964	637.238	637.082
G4	638.480	640.557	641.344	642.249	643.637	644.304	644.971	645.718	645.798	645.878	645.492	645.071	644.669	643.539	642.749	632.896	635.521	636.461	637.964	637.238	637.082
G5	638.266	640.358	641.150	642.062	643.461	644.139	644.818	645.596	645.673	645.749	645.367	644.946	644.544	643.414	642.624	632.683	635.327	636.295	637.839	637.113	636.957
G6	638.010	640.116	640.914	641.833	643.245	643.932	644.619	645.429	645.506	645.583	645.200	644.780	644.377	643.248	642.457	632.427	635.091	636.088	636.672	636.447	636.790


Note: Do not scale this drawing. Follow dimensions.

**STRUCTURAL STEEL**  
F.A. ROUTE 24 (I.L. 23) OVER  
VERMILION RIVER AND THE ATCHISON  
TOPEKA & SANTA FE RAILROAD  
F.A. RT. 24 SEC. (37101) BYB  
LIVINGSTON COUNTY  
STATION 106+39

STATE OF ILLINOIS  
DEPARTMENT OF TRANSPORTATION


ROUTE NO.	SECTION	COUNTY	TOTAL SHEETS	SHEET NO.
S.B.I. 37101	BVB	LIVINGSTON	67	22
F.A. 24				
FED. ROAD DIST. NO. 7	ILLINOIS FED. AID PROJECT			

SHEET NO. 4  
22 SHEETS

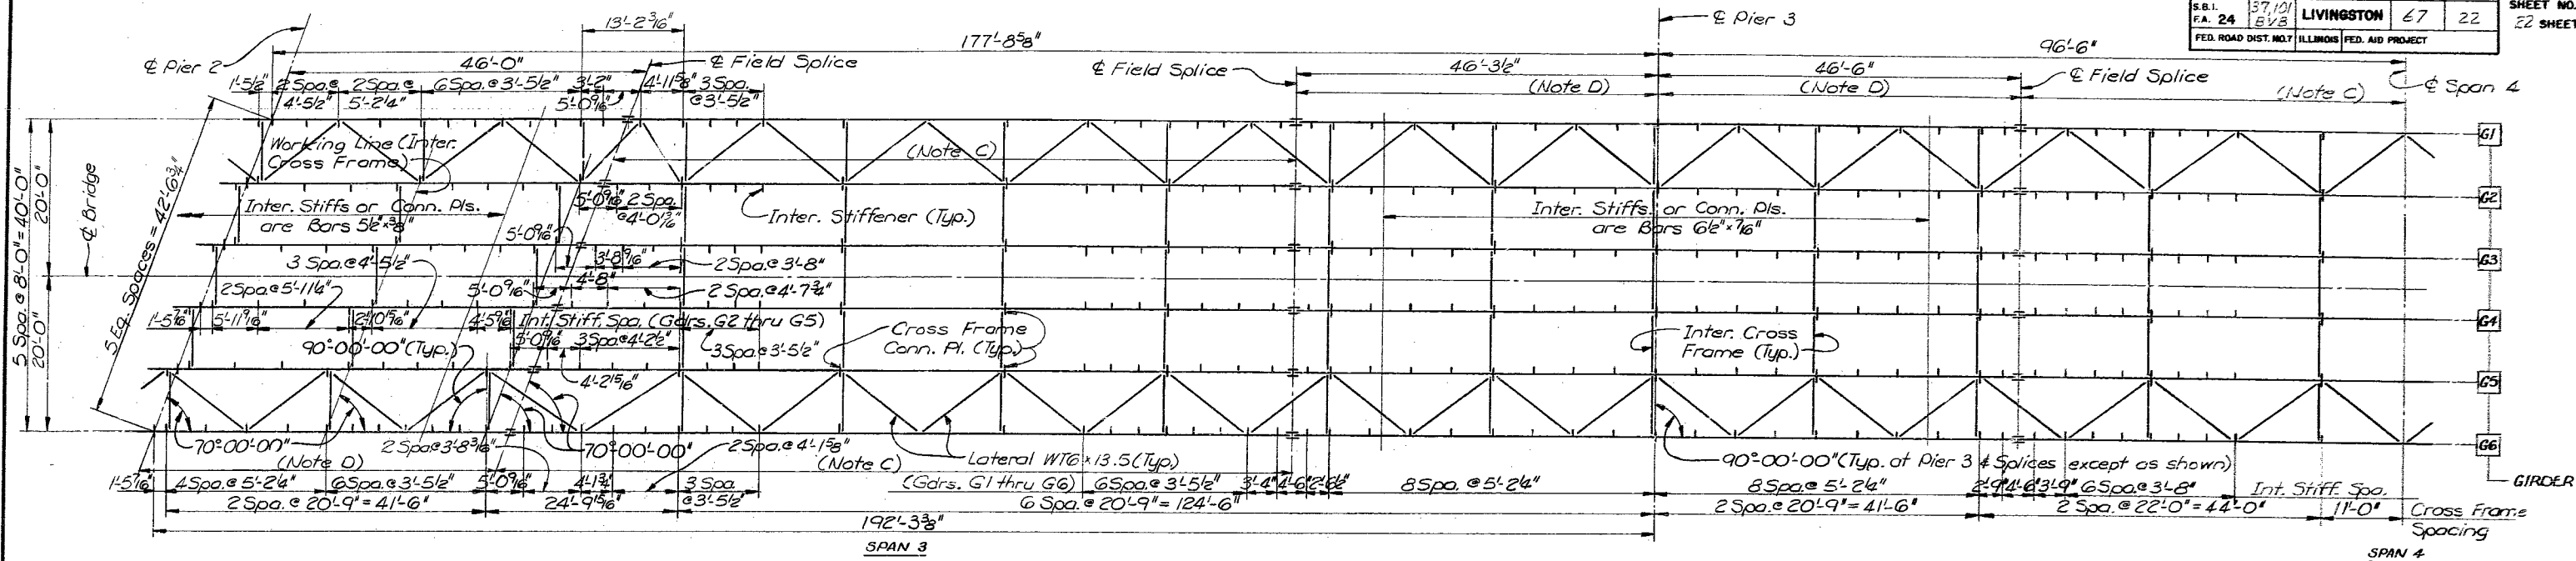

**FRAMING PLAN**

Note: Intermediate stiffeners and cross frame connection plates are Bars 5" x 5/16" except as noted near Piers 2 and 3 in plan.

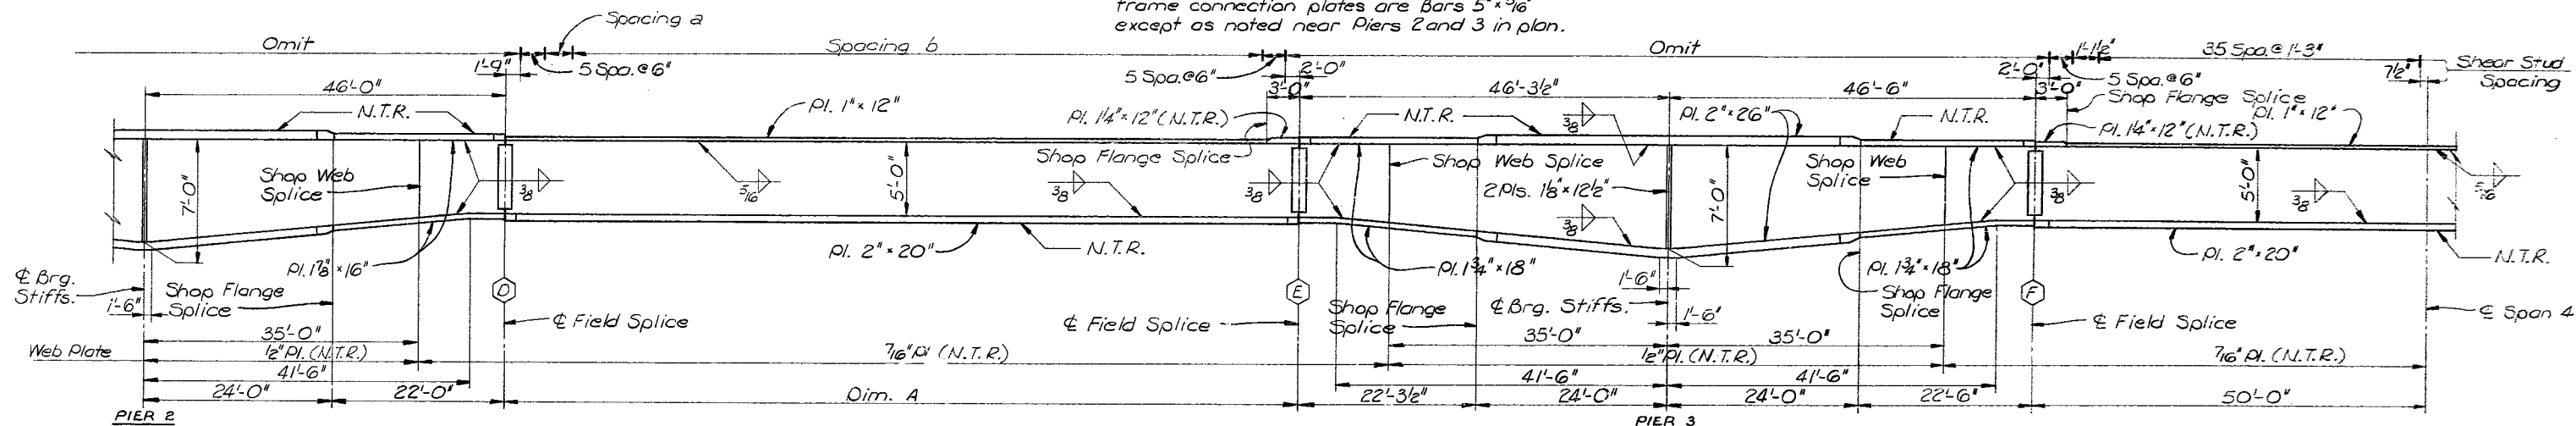

**ELEVATION - GIRDERS G1 THRU G6**

Note: Field splice flange plates and intermediate stiffeners not shown.  
○ ← Denotes type of field splice.

Girder	Dimension A	Spacing a	Spacing b
G1	85'-5 1/8"	11 1/8"	72 Spa. @ 1'-0 5/8"
G2	88'-4 1/8"	10 1/8"	72 Spa. @ 1'-1 1/8"
G3	91'-3"	9"	72 Spa. @ 1'-1 5/8"
G4	94'-2"	8"	72 Spa. @ 1'-2 1/8"
G5	97'-0 5/8"	6 5/8"	72 Spa. @ 1'-2 5/8"
G6	99'-11 1/8"	2 Spa. @ 7 1/8"	72 Spa. @ 1'-3"

Note C: Intermediate stiffeners or cross frame connection plates used as intermediate stiffeners shall be welded to top flange of girders.

Note D: Intermediate stiffeners or cross frame connection plates used as intermediate stiffeners shall be welded to bottom flange of girders.

Note: Welding for cross frame connection plates shall be same as intermediate stiffeners shown on plans.

**NOTES**  
Longitudinal dimensions are measured horizontally along the center line of girders. For Girder Details, see Sheet 6. "N.T.R." indicates plates subject to the Supplemental Requirements for Notch Toughness. For Structural Steel Notes, see Sheet 6.

DESIGNED	C. Wiczorek
CHECKED	S. Franklin
DRAWN	G. Dee
CHECKED	R. Butterfield




**STRUCTURAL STEEL**  
F.A. ROUTE 24 (ILL. 23) OVER  
VERMILION RIVER AND THE ATCHISON  
TOPEKA & SANTA FE RAILROAD  
F.A. RT 24 SEC. (37101) BVB  
LIVINGSTON COUNTY  
STATION 106+39

Note: Do not scale this drawing. Follow dimensions.

STATE OF ILLINOIS  
DEPARTMENT OF TRANSPORTATION

ROUTE NO.	SECTION	COUNTY	TOTAL SHEETS	SHEET NO.
S.B.I. E.A. 24	37101 BVB	LIVINGSTON	67	23
FED. ROAD DIST. NO. 7		ILLINOIS FED. AID PROJECT		

SHEET NO. 5  
22 SHEETS

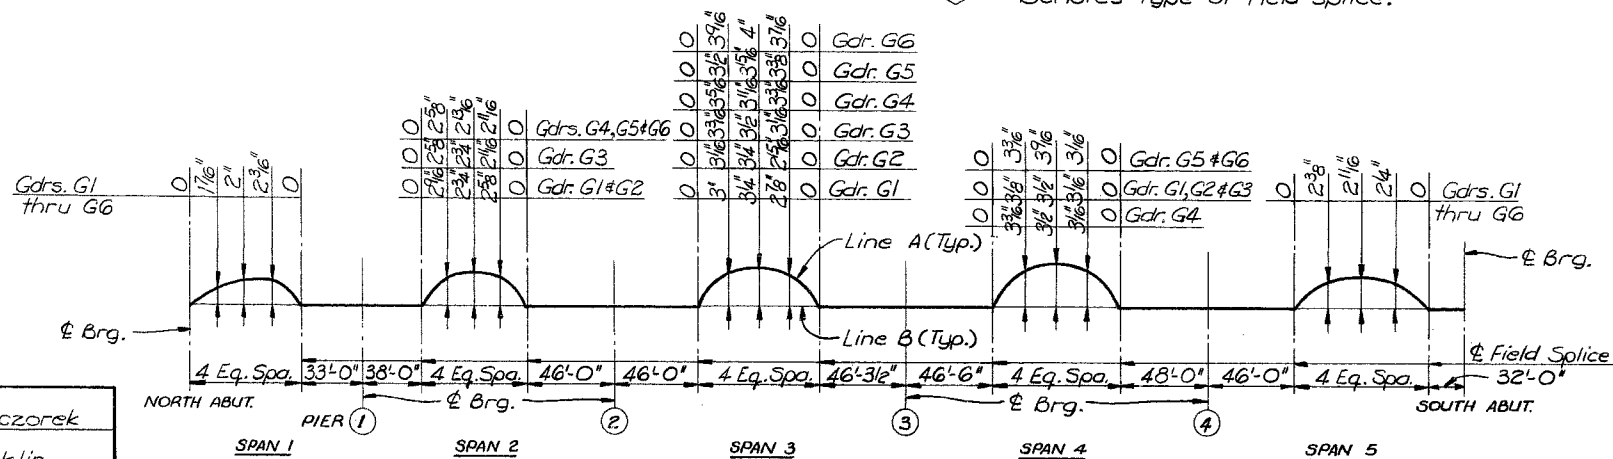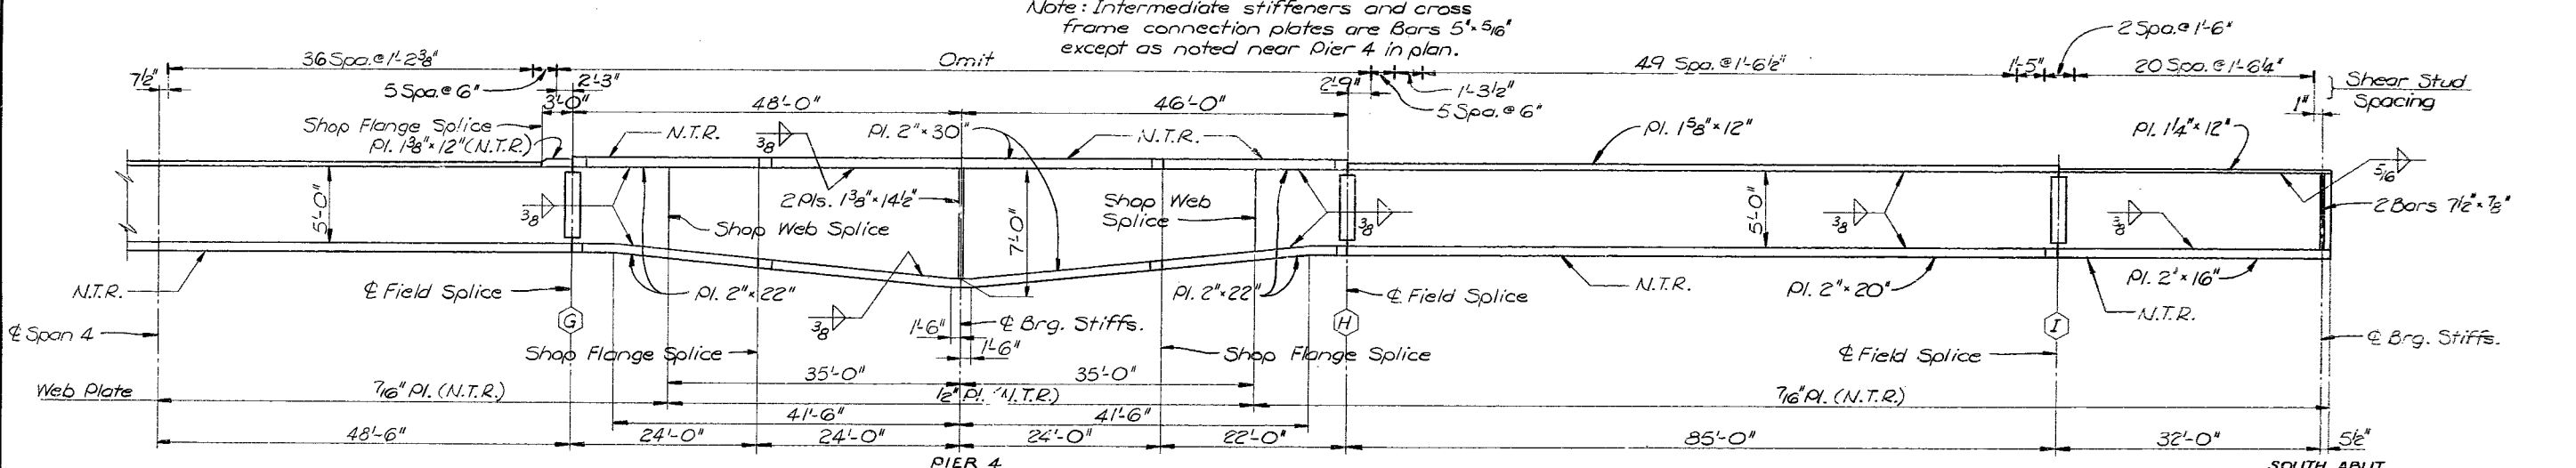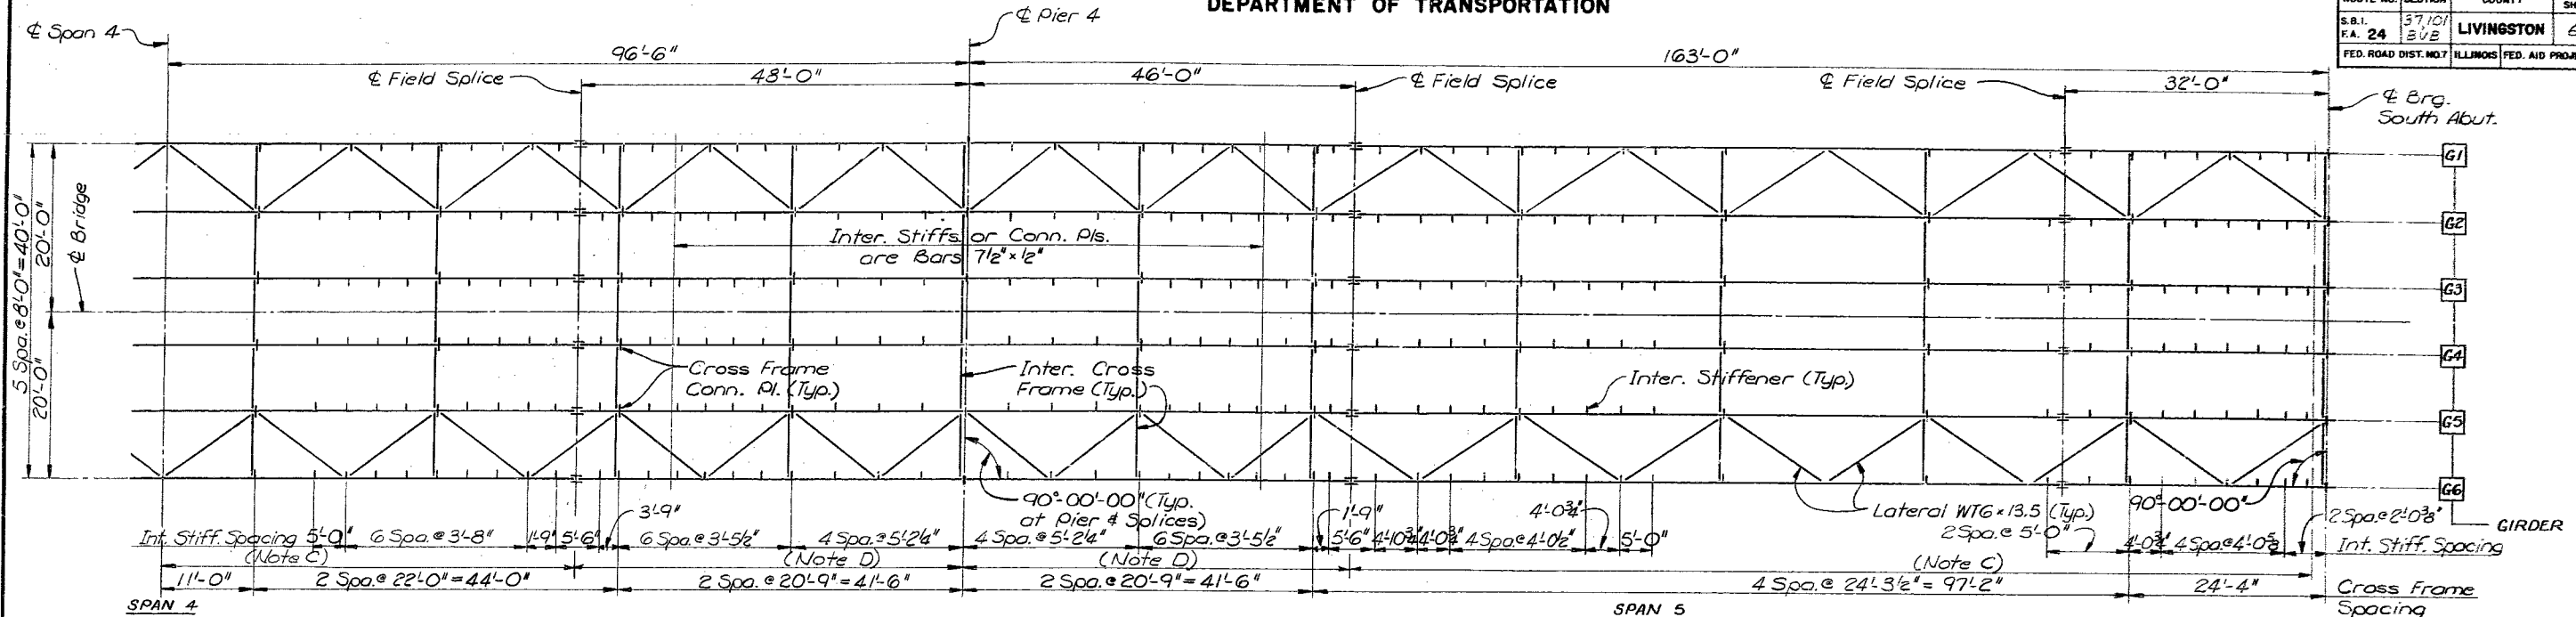

**NOTES**

Note C: Intermediate stiffeners or cross frame connection plates used as intermediate stiffeners shall be welded to top flange of girders.

Note D: Intermediate stiffeners or cross frame connection plates used as intermediate stiffeners shall be welded to bottom flange of girders.

Note: Welding for cross frame connection plates shall be same as intermediate stiffeners shown on plans.

Longitudinal dimensions are measured horizontally along the center line of girders. For Girders Details, see Sheet 6. "N.T.R." indicates plates subject to the Supplemental Requirements for Notch Toughness. For Structural Steel Notes, see Sheet 6.


**STRUCTURAL STEEL**  
E.A. ROUTE 24 (I.L. 23) OVER  
VERMILION RIVER AND THE ATCHISON  
TOPEKA & SANTA FE RAILROAD  
F.A. RT. 24 SEC. (37101) BVB  
LIVINGSTON COUNTY  
STATION 106+39

DESIGNED	C. Wisczorek
CHECKED	S. Franklin
DRAWN	G. Dee
CHECKED	R. Butterfield

Note: Do not scale this drawing. Follow dimensions.

STATE OF ILLINOIS  
DEPARTMENT OF TRANSPORTATION

ROUTE NO.	SECTION	COUNTY	TOTAL SHEETS	SHEET NO.
S.B.I. 24	37101	LIVINGSTON	67	24
F.A. 24	BVB	ILLINOIS	FED. AID PROJECT	22 SHEETS

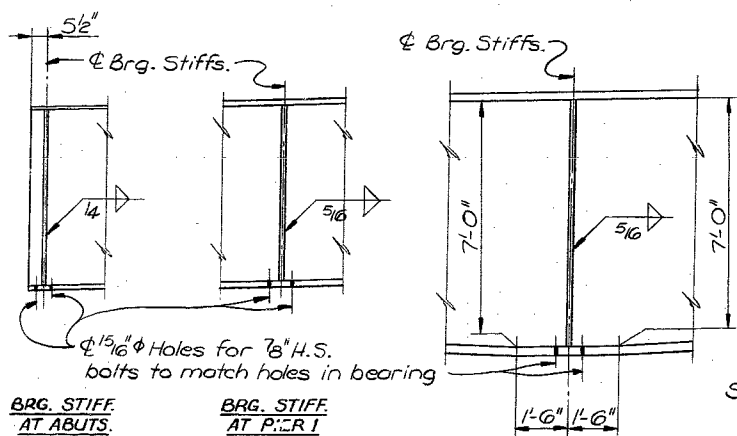

**BRG. STIFF.**  
**AT ABUTS.**


**BRG. STIFF.**  
**AT PIERS**

**BRG. STIFF.**  
**AT PIERS 2, 3 & 4**

Note E: Size of fillet weld,  
3/4" flange plate use 1/4" weld  
flange plates over 3/4" to 1 1/2" use 5/16" weld  
flange plates over 1 1/2" to 2 1/2" use 3/8" weld

**GIRDER ELEVATIONS**

Note: For flange to web welds,  
see Girder Elevations.

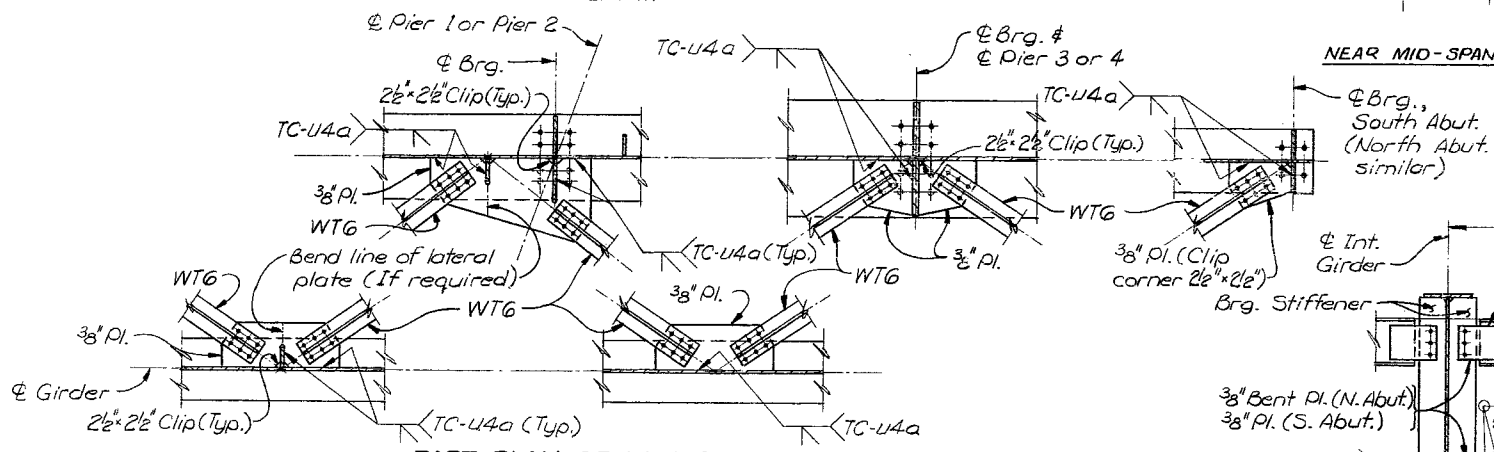


**PART PLAN OF LOWER LATERAL BRACING**

Note: Intermediate and end cross frames  
not shown.  
Cape 3/8" lateral plates where necessary  
to fit around stiffeners.


SPICE	TABLE OF VARIABLES						
	PL. J	PL. K	BAR L	PL. M	PL. N	PL. P	SPA. r
A (Top Flg.)	11 1/2" x 12"	1 1/2" x 12"	5/4" x 3/8"				5 @ 3"
A (Bott. Flg.)				7" x 5 1/2"	6" x 16"	1 1/2" x 16"	3 @ 3"
B (Top Flg.)	1 1/2" x 12"	1 1/2" x 12"	5/4" x 3/8"				4 @ 3"
C (Bott. Flg.)				7" x 11 1/2"	3 1/2" x 16"	9/16" x 16"	4 @ 3"
C (Top Flg.)	3/4" x 12"	5/8" x 12"	5/4" x 1/2"				5 @ 3"
D (Top Flg.)	1 1/2" x 12"	1 1/2" x 12"	5/4" x 5/8"				5 @ 3"
D (Bott. Flg.)				7" x 1 1/2"	6" x 16"	1 1/2" x 16"	13 Alt. @ 3"
E & F (Top Flg.)	1 1/2" x 12"	5/8" x 12"	5/4" x 5/8"				6 @ 3"
E & F (Bott. Flg.)				8" x 1"	4" x 18"	7/8" x 18"	7 @ 3"
G (Top Flg.)	5/8" x 12"	3/4" x 12"	5/4" x 5/8"				7 @ 3"
G & H (Bott. Flg.)				1 1/2" x 9"		1 1/2" x 20"	9 @ 3"
H (Top Flg.)	3/8" x 12"	7/8" x 12"	5/4" x 7/8"				9 @ 3"
I (Top Flg.)	3/8" x 12"	3/4" x 12"	5/4" x 3/4"				8 @ 3"
I (Bott. Flg.)				7" x 1 1/4"		1" x 16"	17 Alt. @ 3"
J (Bott. Flg.)				7" x 1 1/2"	3 1/2" x 16"	9/16" x 16"	7 Alt. @ 3"

DESIGNED	C. Wiczorek
CHECKED	S. Franklin
DRAWN	G. Dee
CHECKED	R. Butterfield

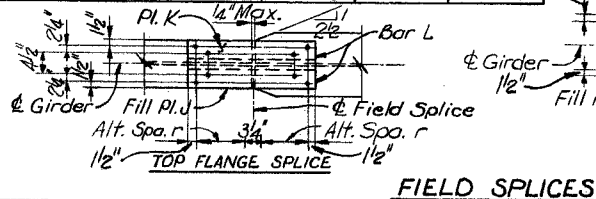


**FIELD SPLICES**

Note: Taper the wider flange at splice.

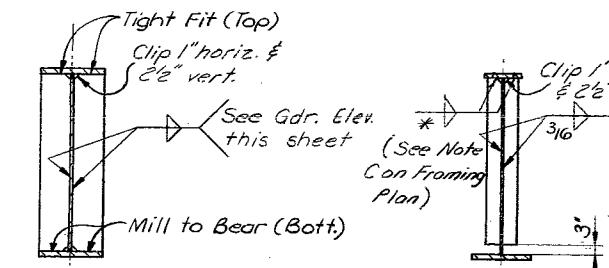


**BEARING STIFFENERS**

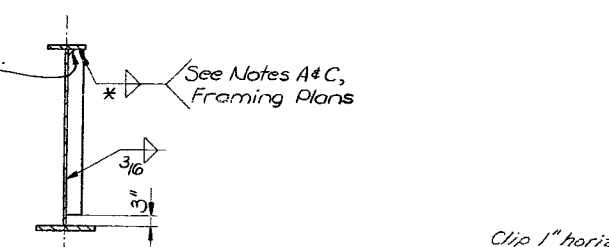


**CROSS FRAME CONNECTION PLATES OR INTERMEDIATE STIFFENERS**

\* Fillet weld size same as shown in Note E.

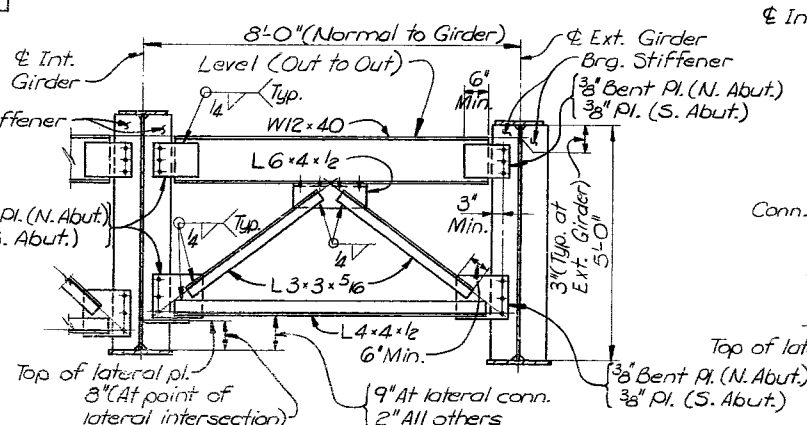


**END CROSS FRAME**

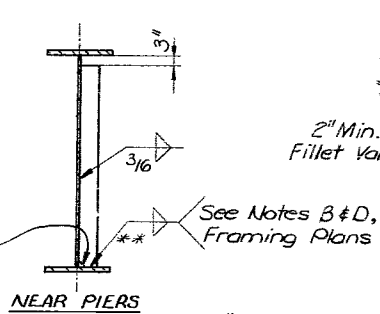


**NEAR PIERS**

\*\* 5/16" for 3/16" Stiffeners  
3/8" for 3/8" & 1/2" Stiffeners

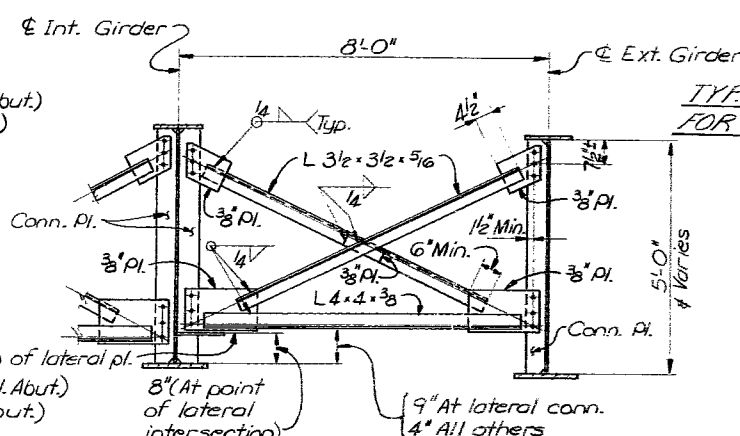

**INTERMEDIATE CROSS FRAME**

Note: Intermediate cross frame  
connection to bearing stiffeners  
similar.

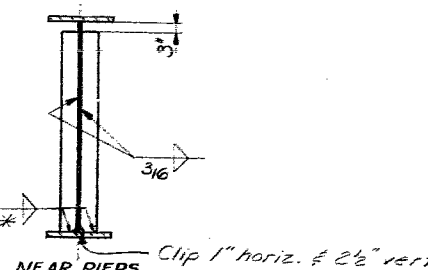

**SHEAR STUDS**  
(7401 - Required)

**TYP. CLIP DETAIL FOR STIFFENERS**

**STRUCTURAL STEEL NOTES**

GENERAL NOTES: See Sheet 2.  
CAMBER: All girders to be cambered as shown on Sheet 5.  
MATERIALS: All structural carbon steel shall conform to A.A.S.H.T.O. M183.  
FIELD CONNECTIONS: All field splices and connections to be bolted with 7/8" High Strength bolts conforming to A.A.S.H.T.O. M164.  
Holes shall be 1 1/16" φ in all lower lateral connection plates and gusset plates of cross frames for 7/8" φ High Strength Bolts. Hardened washers shall be required over holes in laterals and gusset plates.  
All other holes shall be 1 1/16" φ.  
DETAILS: All longitudinal and transverse dimensions are measured horizontally at a normal temperature of 50°F.

**NOTES**


For Bearing Details, see Sheet 7.  
For exact location of stiffeners, see Framing Plans.

**STRUCTURAL STEEL**  
**F.A. ROUTE 24 (ILL. 23) OVER**  
**VERMILION RIVER AND THE ATCHISON**  
**TOPEKA & SANTA FE RAILROAD**  
**F.A. RT. 24 SEC. (37101) BYB**  
**LIVINGSTON COUNTY**  
**STATION 106+39**


Note: Do not scale this drawing. Follow dimensions.

STATE OF ILLINOIS  
DEPARTMENT OF TRANSPORTATION

ROUTE NO.	SECTION	COUNTY	TOTAL SHEETS	SHEET NO.
F.A. 24	37101 BVB	LIVINGSTON	67	25
FED. ROAD DIST. NO. 7		ILLINOIS FED. AID PROJECT		SHEET NO. 7 22 SHEETS

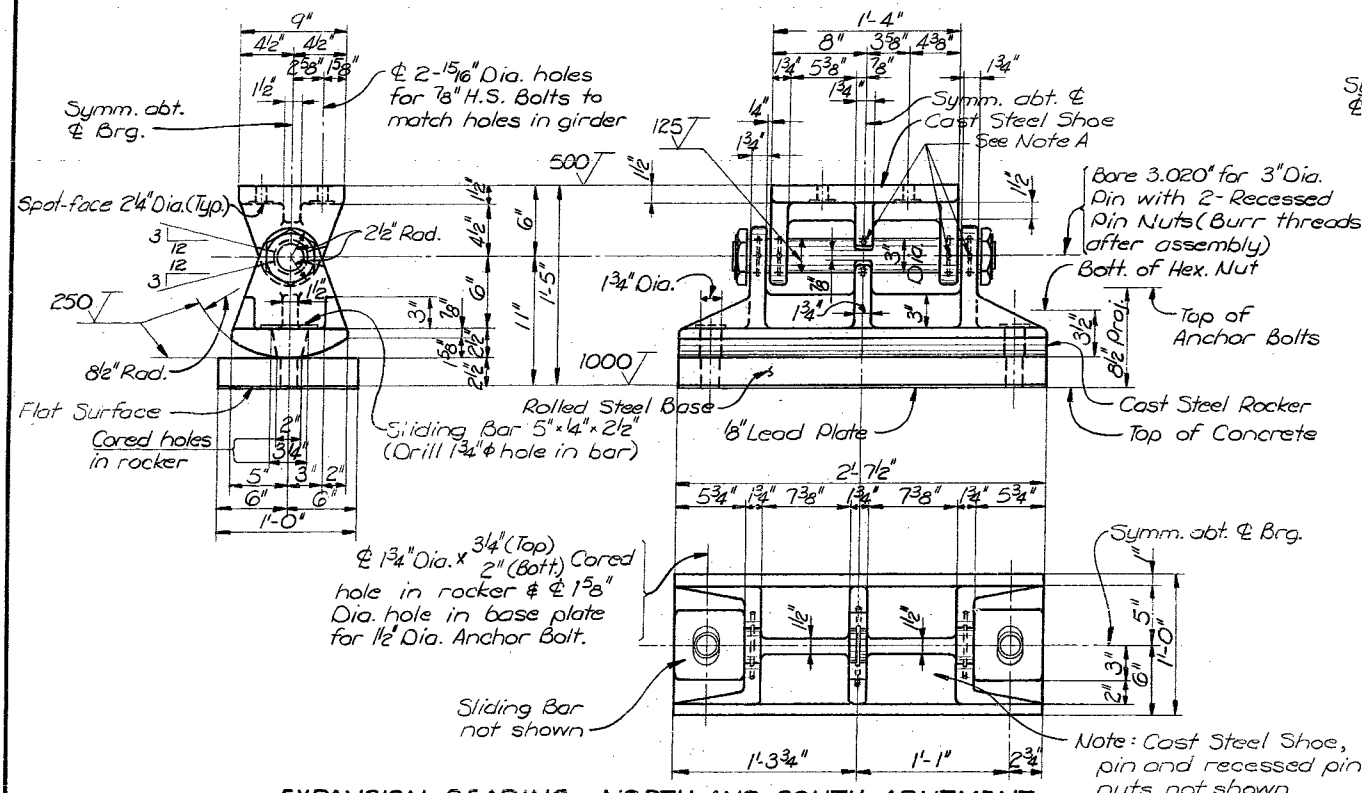


**EXPANSION BEARING - NORTH AND SOUTH ABUTMENT**  
(6 - Required at each abutment)

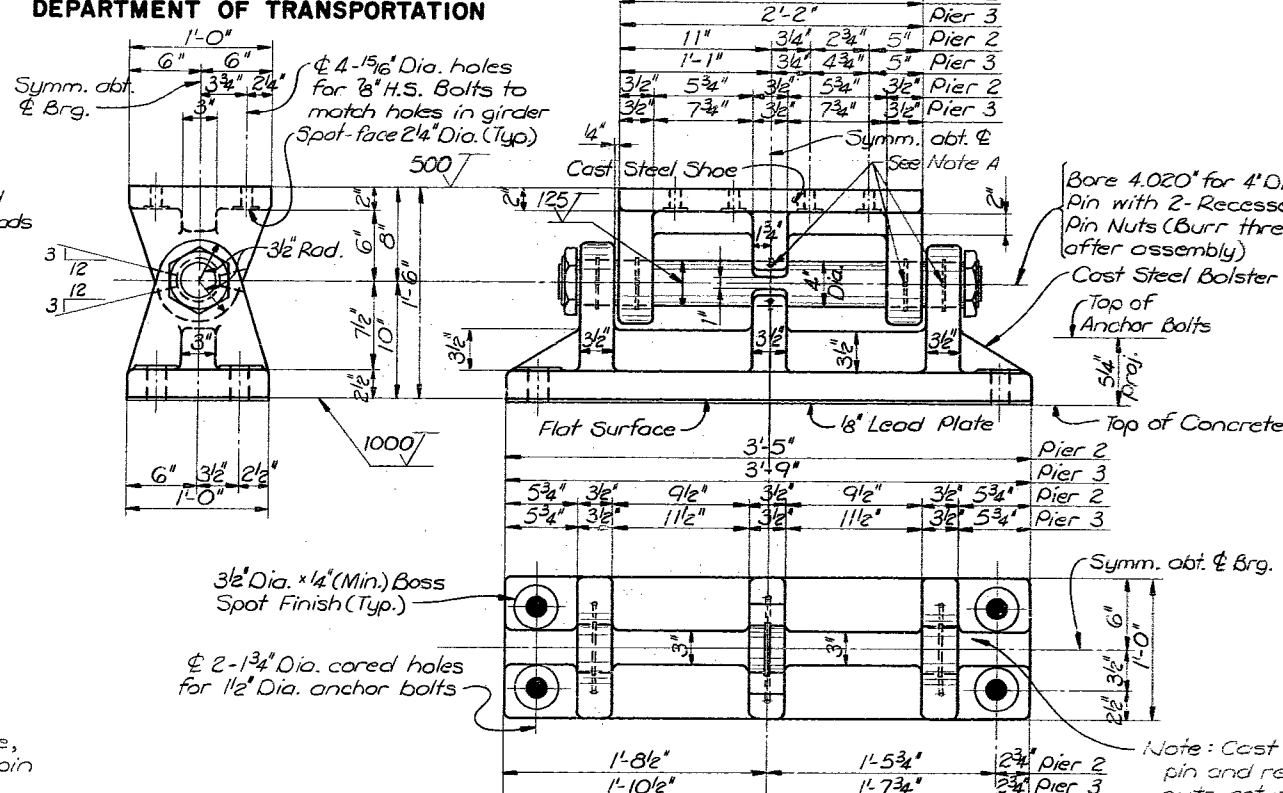

**FIXED BEARING - PIERS 2 AND 3**  
(6 - Required at each pier)

N. & S. Abuts.	Lead Plate	Reqd.
Pier 1	1'-11 1/2"	24-Reqd.
Pier 4	1'-10 3/4"	12-Reqd.
Pier 1	1'-11 3/4"	12-Reqd.
Piers 2 & 3	1'-8 1/4"	48-Reqd.

**ANCHOR BOLTS**  
Note: Number of anchor bolts shown are total for both piers or abutments.

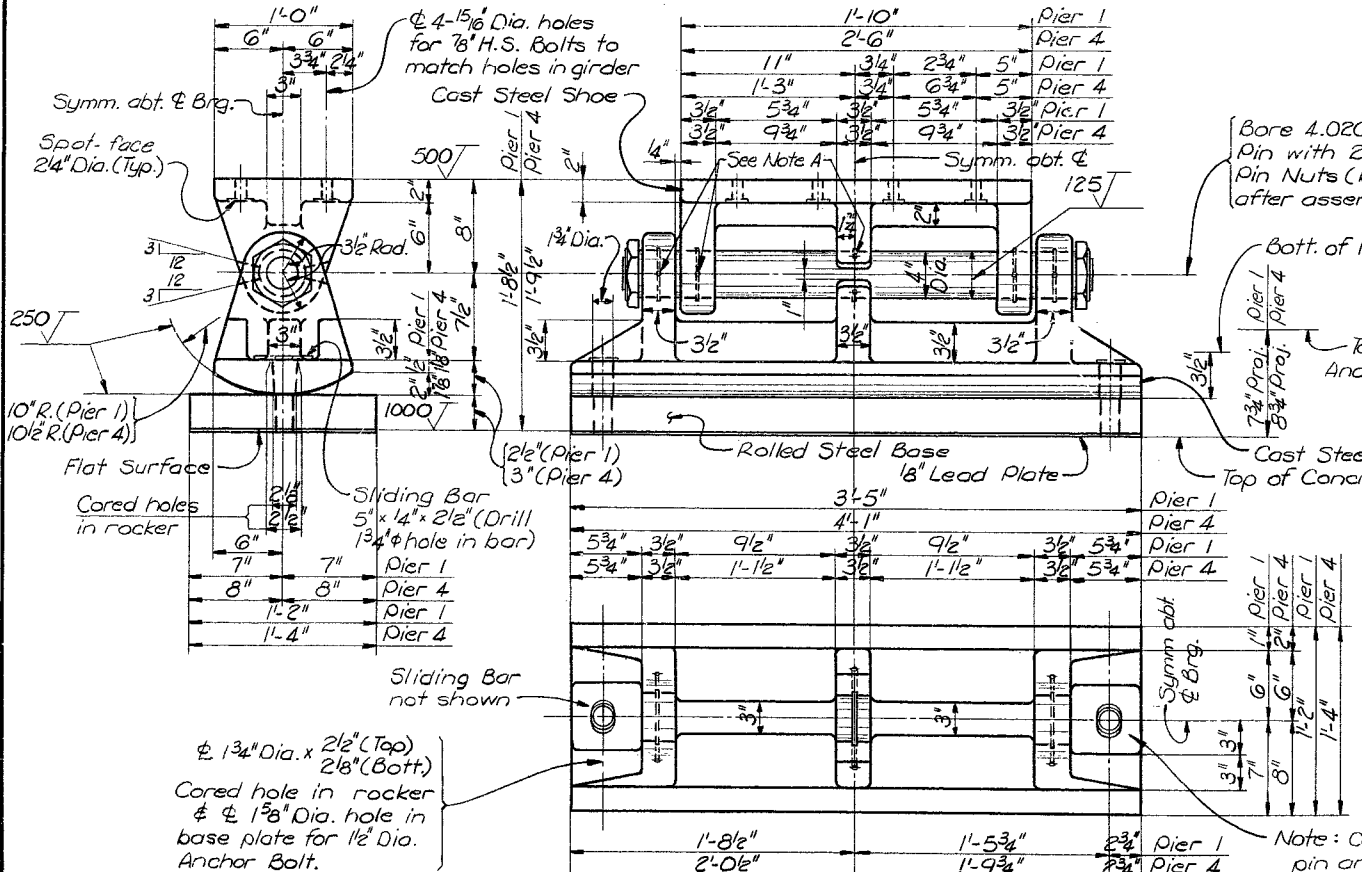


**EXPANSION BEARING - PIERS 1 AND 4**  
(6 - Required at each pier)

Note A: Drill 1/4" dia hole to grease groove. Drill and tap for grease fitting (Typ.)

**BEARING NOTES**

For Structural Steel Notes, see Sheet 6.  
All fillets to be 3/4" radius unless otherwise shown.  
Structural steel weldments of equal sections and strength may be substituted for the castings.  
Lead plates shall conform to A.A.S.H.T.O. M112. Weight of lead plates shall be included in weight of Structural Steel.  
All material shall conform A.A.S.H.T.O. M183 except as otherwise noted.  
Castings shall conform to A.A.S.H.T.O. M192, Class 70.  
Anchor bolts shall conform to A.S.T.M. A307.  
Weight of castings shall be computed on the basis of the minimum thickness of material shown. Drafts supplied at the convenience of the fabricator shall not be included in payment.  
Where finished surfaces are indicated on the drawings, the surface finishes shall conform to the American National Standards Institute surface roughness requirements in A.N.S.I. 846.1.  
Bearing seat surfaces shall be constructed or adjusted to the designated elevations within a tolerance of ± 1/8 inch. Adjustment shall be made either by grinding the surface or by shimming the bearing. Two 1/8" adjusting shims, of the dimensions of the bottom bearing plate, shall be provided for each bearing in addition to all other plates or shims.  
Pins shall conform to S.A.E. 8620 material and shall be heat treated and case hardened to a depth of 0.12" to 0.15" to a hardness of 58 HRC. Pins shall be polished to a smooth finish after case hardening.

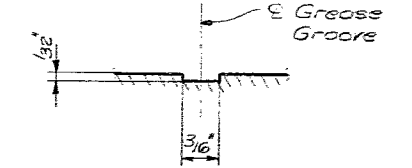

**GREASE GROOVE ON SADDLE**  
Note: Grease bearing assembly with molybdenum grease before installation.

**BEARINGS**  
**F.A. ROUTE 24 (ILL. 23) OVER**  
**VERMILION RIVER AND THE ATCHISON**  
**TOPEKA & SANTA FE RAILROAD**  
**F.A. RT. 24 SEC. (37101) BVB**  
**LIVINGSTON COUNTY**  
**STATION 106+39**

DESIGNED	C. Wiczorek
CHECKED	S. Franklin
DRAWN	G. Dee
CHECKED	R. Butterfield

Note: Do not scale this drawing. Follow dimensions.

STATE OF ILLINOIS  
DEPARTMENT OF TRANSPORTATION

ROUTE NO.	SECTION	COUNTY	TOTAL SHEETS	SHEET NO.
S.B.I. F.A. 24	37,101 BVB	LIVINGSTON	67	26
FED. ROAD DIST. NO. 7	ILLINOIS	FED. AID PROJECT		

SHEET NO. 6  
22 SHEETS

MOMENT TABLE - Unsymmetrical Composite 5 Spans  
(Composite in Positive Moment Areas Only)

	INTERIOR GIRDER MOMENT TABLE																	
	SPAN 1 0.4 PT.	PIER 1	SPAN 2 0.5 PT.	PIER 2				SPAN 3 - 0.5 PT.				PIER 3				SPAN 4 0.5 PT.	PIER 4	SPAN 5 0.6 PT.
				G1 & G2	G3	G4	G5 & G6	G1 & G2	G3	G4	G5 & G6	G1 & G2	G3	G4	G5 & G6			
I <sub>s</sub> (IN <sup>4</sup> )	30161	86862	31550	198071	198071	198071	198071	47713	47713	47713	47713	216982	216982	216982	216982	47713	246566	60061
I <sub>c</sub> (IN <sup>4</sup> )	81457	—	86634	—	—	—	—	136197	136197	136197	136197	—	—	—	—	136197	—	138741
S <sub>s</sub> (IN <sup>3</sup> )	1125	2725	1217	4489	4489	4489	4489	2291	2291	2291	2291	4931	4931	4931	4931	2291	5604	2447
S <sub>c</sub> (IN <sup>3</sup> )	1590	—	1714	—	—	—	—	3065	3065	3065	3065	—	—	—	—	3065	—	3062
DL (K/IN)	1.048	1.185	1.053	1.152	1.152	1.152	1.152	1.133	1.133	1.133	1.133	1.284	1.284	1.284	1.284	1.132	1.355	1.125
MDL (K)	699	2156	644	3510	3570	3631	3692	1108	1144	1180	1217	3961	4023	4086	4148	986	4918	1717
P <sub>s</sub> DL (KSI)	7.5	9.5	6.4	7.4	9.5	9.7	9.9	5.8	6.0	6.2	6.4	9.6	9.8	9.9	10.1	5.2	10.5	8.4
SD <sub>L</sub> (K/IN)	0.485	0.485	0.485	0.485	0.485	0.485	0.485	0.485	0.485	0.485	0.485	0.485	0.485	0.485	0.485	0.485	0.485	0.485
MSDL (K)	389	787	477	1328	1351	1374	1397	616	636	656	677	1461	1484	1507	1530	636	1798	847
MLL (K)	1031	1306	1241	2059	2095	2130	2166	1565	1615	1667	1720	2306	2342	2378	2415	1645	2449	1683
MIMP (K)	220	251	217	349	353	357	361	256	262	268	273	370	374	378	382	258	404	293
TOTAL (K)	1640	2344	1935	3736	3799	3861	3924	2437	2513	2591	2670	4137	4200	4263	4327	2539	4601	2823
P <sub>s</sub> LL (KSI)	12.4	10.3	13.6	10.0	10.2	10.3	10.5	9.5	9.8	10.1	10.5	10.1	10.2	10.4	10.5	9.9	9.9	11.1
P <sub>s</sub> TOTAL (KSI)	19.9	19.8	20.0	19.4	19.7	20.0	20.4	15.3	15.8	16.3	16.9	19.7	20.0	20.3	20.6	15.1	20.4	19.5
V <sub>R</sub> (K)	56.1	—	57.6	—	—	—	—	63.6	63.6	63.6	63.6	—	—	—	—	62.7	—	59.2

I<sub>s</sub> and S<sub>s</sub> are the moment of inertia and section modulus of the steel section.  
I<sub>c</sub> and S<sub>c</sub> are the moment of inertia and section modulus of the composite section used in computing f<sub>s</sub>.  
V<sub>R</sub> is the maximum LL + Impact shear range for positive moment areas used to determine shear connector spacing.

REACTION TABLE

	INTERIOR GIRDER REACTION TABLE					
	ABUT. 1	PIER 1	PIER 2	PIER 3	PIER 4	ABUT. 2
R <sub>DL</sub> (K)	58.3	231.2	295.9	316.9	352.7	41.7
R <sub>LL</sub> (K)	51.2	98.8	118.5	125.1	125.8	57.5
R <sub>IMP</sub> (K)	10.9	19.0	19.9	19.9	20.8	10.0
R <sub>TOTAL</sub> (K)	120.4	349.0	434.3	461.9	499.3	159.2

DESIGNED	C. Wiczorek
CHECKED	S. Franklin
DRAWN	R. Rois
CHECKED	E. Petzold

329  
753314




MOMENTS AND REACTIONS  
F.A. ROUTE 24 (ILL. 23) OVER  
VERMILION RIVER AND THE ATCHISON  
TOPLKA & SANTA FE RAILROAD  
F.A. RT. 24 SEC. (37,101) BVB  
LIVINGSTON COUNTY  
STATION 106+39

STATE OF ILLINOIS  
DEPARTMENT OF TRANSPORTATION

ROUTE NO.	SECTION	COUNTY	TOTAL SHEETS	SHEET NO.
S.B.I. F.A. 24	37.101 BVB	LIVINGSTON	67	27
FED. ROAD DIST. NO. 7	ILLINOIS	FED. AID PROJECT		

SHEET NO. 9  
22 SHEETS

LOCATION	STATION	THEORETICAL GRADE ELEVATIONS	THEORETICAL GRADE ELEVATIONS ADJUSTED FOR DEAD LOAD DEFLECTIONS
Back N. Abut.	10386.162	639.271	639.271
€ Brg. N. Abut.	10389.000	639.357	639.357
1	10399.000	639.656	639.658
2	10409.000	639.949	640.007
3	10419.000	640.236	640.314
4	10429.000	640.517	640.605
5	10439.000	640.791	640.877
6	10449.000	641.059	641.133
7	10459.000	641.321	641.376
8	10469.000	641.577	641.613
9	10479.000	641.827	641.843
10	10489.000	642.071	642.074
€ Brg. Pier 1	10499.000	642.309	642.309
11	10509.000	642.540	642.548
12	10519.000	642.765	642.788
13	10529.000	642.984	643.030
14	10539.000	643.197	643.269
15	10549.000	643.404	643.495
16	10559.000	643.605	643.712
17	10569.000	643.799	643.914
18	10579.000	643.987	644.099
19	10589.000	644.169	644.268
20	10599.000	644.345	644.427
21	10609.000	644.515	644.574
22	10619.000	644.679	644.715
23	10629.000	644.837	644.853
24	10639.000	644.988	644.993
25	10649.000	645.133	645.134
€ Brg. Pier 2	10659.000	645.272	645.272
26	10669.000	645.405	645.418
27	10679.000	645.532	645.564
28	10689.000	645.653	645.710
29	10699.000	645.767	645.855
30	10709.000	645.875	645.995
31	10719.000	645.977	646.028
32	10729.000	646.073	646.248
33	10739.000	646.163	646.353
34	10749.000	646.247	646.444
35	10759.000	646.325	646.515
36	10769.000	646.396	646.573
37	10779.000	646.461	646.616
38	10789.000	646.520	646.646
39	10799.000	646.573	646.665
40	10809.000	646.620	646.682
41	10819.000	646.661	646.698
42	10829.000	646.695	646.712
43	10839.000	646.723	646.727
€ Brg. Pier 3	10844.000	646.733	646.733
44	10854.000	646.754	646.757
45	10864.000	646.767	646.779
46	10874.000	646.774	646.801
47	10884.000	646.775	646.823
48	10894.000	646.769	646.842
49	10904.000	646.757	646.853
50	10914.000	646.739	646.857
51	10924.000	646.715	646.847
52	10934.000	646.685	646.824
53	10944.000	646.649	646.787
54	10954.000	646.607	646.734
55	10964.000	646.558	646.665
56	10974.000	646.503	646.586
57	10984.000	646.442	646.500
58	10994.000	646.375	646.410
59	11004.000	646.302	646.320
60	11014.000	646.223	646.229
61	11024.000	646.137	646.138
€ Brg. Pier 4	11037.000	646.017	646.017
62	11047.000	645.917	645.993
63	11057.000	645.811	645.848
64	11067.000	645.699	645.762
65	11077.000	645.581	645.678
66	11087.000	645.457	645.596
67	11097.000	645.326	645.523
68	11107.000	645.189	645.401
69	11117.000	645.047	645.285
70	11127.000	644.898	645.184
71	11137.000	644.743	645.093
72	11147.000	644.581	644.993
73	11157.000	644.414	644.845
74	11167.000	644.241	644.648
75	11177.000	644.061	644.411
76	11187.000	643.875	644.148
€ Brg. S. Abut.	11200.000	643.624	643.624
Back S. Abut.	11202.333	643.578	643.578

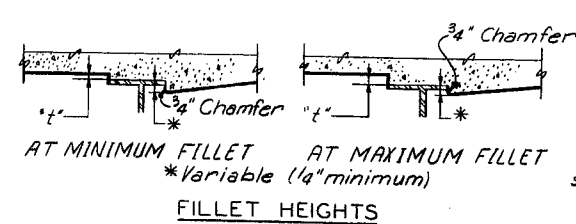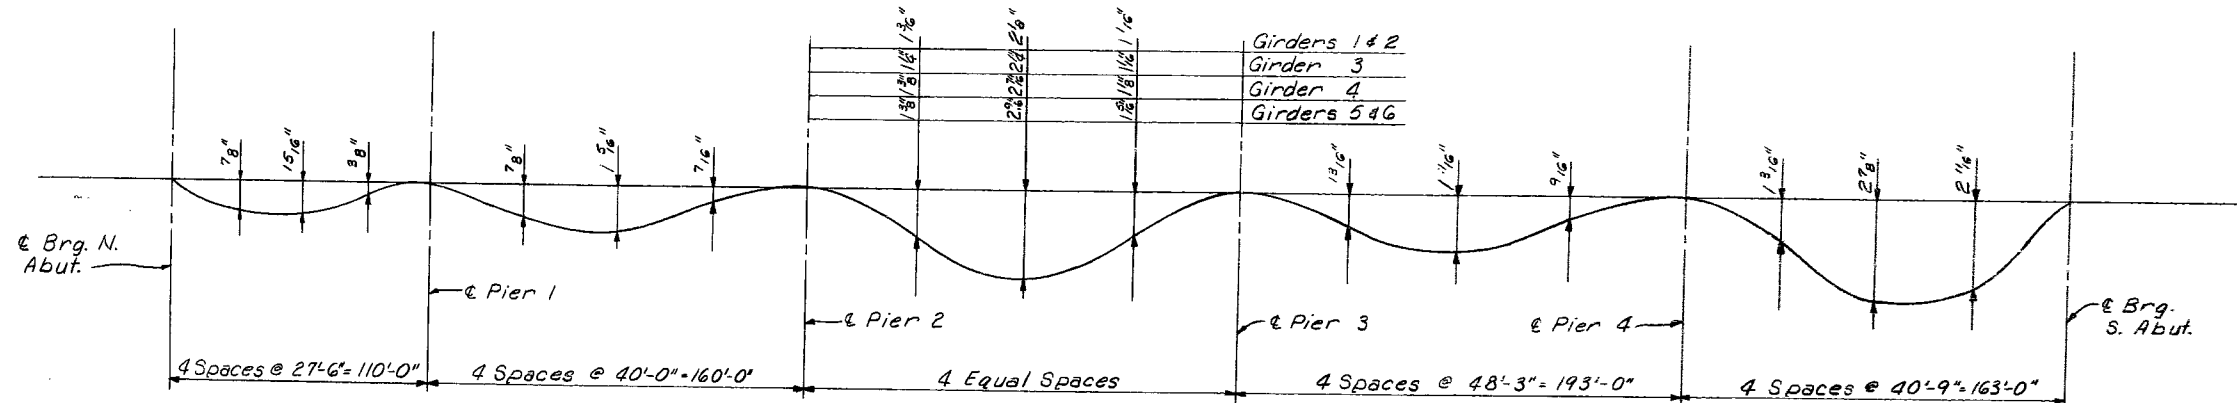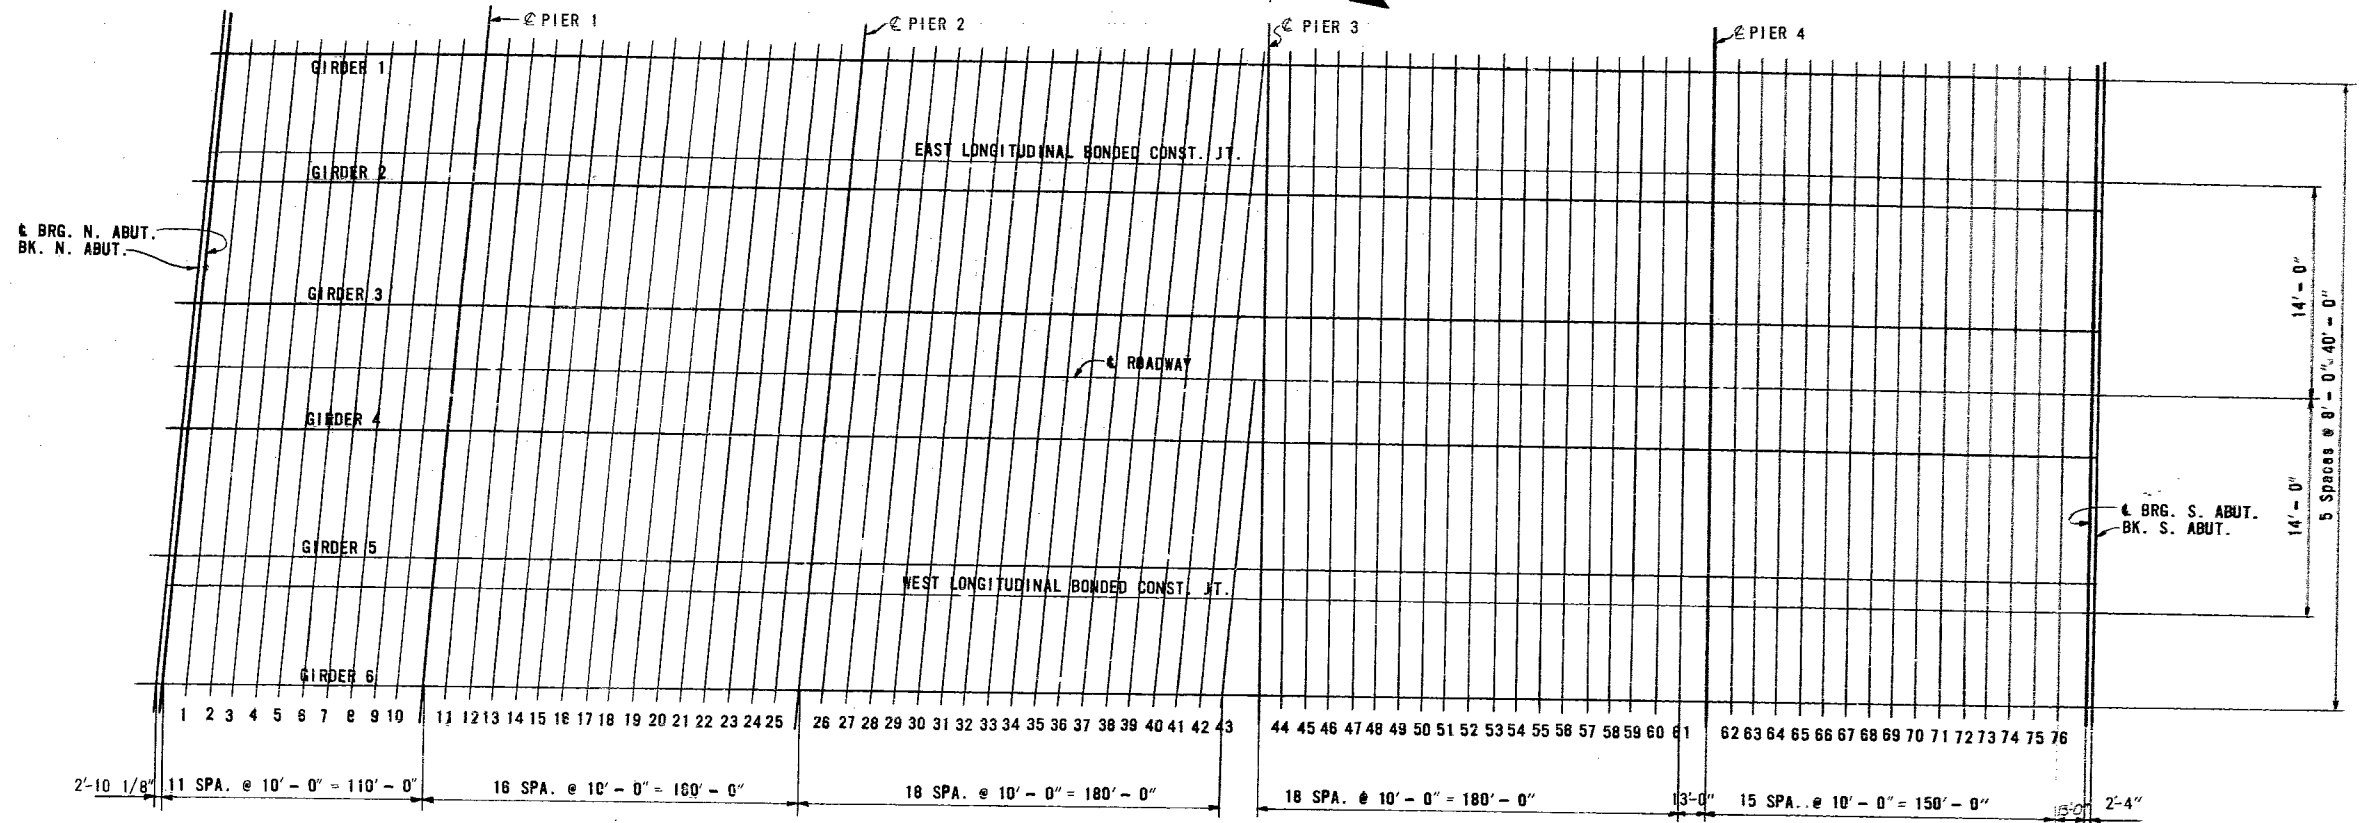

To determine "t": After all steel has been erected, elevations of the top flanges of the girders shall be taken at intervals shown in the Plan. These elevations subtracted from the "Theoretical Grade Elevations Adjusted for Dead Load Deflection" shown on Sheets 10 & 11, minus 3" slab thickness, equals the fillet heights "t" above top flanges of girders.

Note: Do not scale this drawing. Follow dimensions.

DECK ELEVATIONS  
E.A. ROUTE 24 (ILL. 23) OVER  
VERMILION RIVER AND THE ATCHISON  
TOPEKA & SANTA FE RAILROAD  
E.A. RT. 24 SEC. (37.10) BVB  
LIVINGSTON COUNTY  
STATION 106 + 39

DESIGNED BY D. RICHARDSON  
CHECKED BY W.O. WALDEN  
3291  
755235

STATE OF ILLINOIS  
DEPARTMENT OF TRANSPORTATION

ROUTE NO.	SECTION	COUNTY	TOTAL SHEETS	SHEET NO.
S.B.L. F.A. 24	37.101 2VE	LIVINGSTON	67	28
FED. ROAD DIST. NO. 7	ILLINOIS	FED. AID PROJECT		

SHEET NO. 10  
22 SHEETS

GIRDER 1

EAST LONGITUDINAL BONDED CONSTRUCTION JOINT

GIRDER 2

GIRDER 3

LOCATION	STATION	THEORETICAL GRADE ELEVATIONS	THEORETICAL GRADE ELEVATIONS ADJUSTED FOR DEAD LOAD DEFLECTIONS
Back N. Abut.	10393.442	639.137	639.137
± Brg. N. Abut.	10396.279	639.221	639.221
1	10406.279	639.306	639.306
2	10416.279	639.390	639.390
3	10426.279	640.087	640.165
4	10436.279	640.363	640.451
5	10446.279	640.633	640.719
6	10456.279	640.897	640.971
7	10466.279	641.154	641.209
8	10476.279	641.406	641.442
9	10486.279	641.651	641.647
10	10496.279	641.890	641.893
± Brg. Pier 1	10506.279	642.123	642.123
11	10516.279	642.350	642.358
12	10526.279	642.571	642.594
13	10536.279	642.786	642.832
14	10546.279	642.994	643.066
15	10556.279	643.196	643.287
16	10566.279	643.393	643.500
17	10576.279	643.582	643.697
18	10586.279	643.766	643.878
19	10596.279	643.944	644.043
20	10606.279	644.116	644.196
21	10616.279	644.281	644.340
22	10626.279	644.440	644.476
23	10636.279	644.593	644.609
24	10646.279	644.740	644.745
25	10656.279	644.881	644.882
± Brg. Pier 2	10666.279	645.015	645.015
26	10676.279	645.144	645.157
27	10686.279	645.266	645.296
28	10696.279	645.382	645.435
29	10706.279	645.492	645.576
30	10716.279	645.596	645.710
31	10726.279	645.694	645.835
32	10736.279	645.785	645.947
33	10746.279	645.871	646.045
34	10756.279	645.950	646.129
35	10766.279	646.023	646.196
36	10776.279	646.090	646.246
37	10786.279	646.151	646.284
38	10796.179	646.205	646.311
39	10806.279	646.254	646.328
40	10816.279	646.296	646.344
41	10826.279	646.332	646.358
42	10836.279	646.362	646.371
43			
± Brg. Pier 3	10844.000	646.381	646.381
44	10854.000	646.400	646.403
45	10864.000	646.413	646.425
46	10874.000	646.420	646.447
47	10884.000	646.420	646.468
48	10894.000	646.415	646.488
49	10904.000	646.403	646.501
50	10914.000	646.383	646.503
51	10924.000	646.361	646.493
52	10934.000	646.331	646.470
53	10944.000	646.295	646.433
54	10954.000	646.252	646.379
55	10964.000	646.204	646.311
56	10974.000	646.149	646.232
57	10984.000	646.088	646.146
58	10994.000	646.021	646.056
59	11004.000	645.948	645.966
60	11014.000	645.868	645.874
61	11024.000	645.783	645.784
± Brg. Pier 4	11037.000	645.682	645.682
62	11047.000	645.563	645.579
63	11057.000	645.457	645.494
64	11067.000	645.345	645.408
65	11077.000	645.227	645.324
66	11087.000	645.102	645.241
67	11097.000	644.972	645.151
68	11107.000	644.835	645.047
69	11117.000	644.693	644.931
70	11127.000	644.544	644.800
71	11137.000	644.389	644.649
72	11147.000	644.227	644.479
73	11157.000	644.060	644.291
74	11167.000	643.886	644.083
75	11177.000	643.707	643.857
76	11187.000	643.521	643.614
± Brg. S. Abut.	11200.000	643.270	643.270
Back S. Abut.	11202.333	643.224	643.224

LOCATION	STATION	THEORETICAL GRADE ELEVATIONS	THEORETICAL GRADE ELEVATIONS ADJUSTED FOR DEAD LOAD DEFLECTIONS
Back N. Abut.	10391.258	639.192	639.196
± Brg. N. Abut.	10394.096	639.281	639.281
1	10404.096	639.377	639.369
2	10414.096	639.867	639.925
3	10424.096	640.150	640.228
4	10434.096	640.426	640.516
5	10444.096	640.699	640.785
6	10454.096	640.964	641.038
7	10464.096	641.223	641.278
8	10474.096	641.476	641.512
9	10484.096	641.723	641.739
10	10494.096	641.964	641.967
± Brg. Pier 1	10504.096	642.198	642.198
11	10514.096	642.426	642.434
12	10524.096	642.648	642.671
13	10534.096	642.864	642.910
14	10544.096	643.074	643.146
15	10554.096	643.278	643.399
16	10564.096	643.475	643.582
17	10574.096	643.667	643.782
18	10584.096	643.852	643.964
19	10594.096	644.031	644.130
20	10604.096	644.204	644.286
21	10614.096	644.370	644.429
22	10624.096	644.531	644.567
23	10634.096	644.685	644.701
24	10644.096	644.833	644.838
25	10654.096	644.976	644.977
± Brg. Pier 2	10664.096	645.112	645.112
26	10674.096	645.241	645.254
27	10684.096	645.365	645.395
28	10694.096	645.482	645.535
29	10704.096	645.594	645.673
30	10714.096	645.701	645.813
31	10724.096	645.798	645.939
32	10734.096	645.891	646.053
33	10744.096	645.983	646.152
34	10754.096	646.078	646.237
35	10764.096	646.162	646.305
36	10774.096	646.201	646.357
37	10784.096	646.243	646.396
38	10794.096	646.319	646.425
39	10804.096	646.369	646.443
40	10814.096	646.412	646.460
41	10824.096	646.450	646.476
42	10834.096	646.481	646.490
43			
± Brg. Pier 3	10844.000	646.506	646.506
44	10854.000	646.525	646.528
45	10864.000	646.538	646.550
46	10874.000	646.545	646.572
47	10884.000	646.545	646.593
48	10894.000	646.540	646.613
49	10904.000	646.528	646.626
50	10914.000	646.510	646.628
51	10924.000	646.486	646.618
52	10934.000	646.456	646.595
53	10944.000	646.420	646.558
54	10954.000	646.377	646.504
55	10964.000	646.329	646.436
56	10974.000	646.274	646.357
57	10984.000	646.213	646.271
58	10994.000	646.146	646.181
59	11004.000	646.073	646.091
60	11014.000	645.995	645.999
61	11024.000	645.908	645.909
± Brg. Pier 4	11037.000	645.787	645.787
62	11047.000	645.688	645.704
63	11057.000	645.582	645.619
64	11067.000	645.470	645.533
65	11077.000	645.352	645.450
66	11087.000	645.227	645.366
67	11097.000	645.097	645.276
68	11107.000	644.960	645.172
69	11117.000	644.818	645.056
70	11127.000	644.669	644.925
71	11137.000	644.514	644.774
72	11147.000	644.352	644.604
73	11157.000	644.185	644.416
74	11167.000	644.011	644.208
75	11177.000	643.832	643.982
76	11187.000	643.646	643.739
± Brg. S. Abut.	11200.000	643.395	643.395
Back S. Abut.	11202.333	643.349	643.349

LOCATIONS	STATION	THEORETICAL GRADE ELEVATIONS	THEORETICAL GRADE ELEVATIONS ADJUSTED FOR DEAD LOAD DEFLECTIONS
Back N. Abut.	10390.530	639.216	639.216
± Brg. N. Abut.	10393.368	639.301	639.301
1	10403.368	639.397	639.329
2	10413.368	639.888	639.946
3	10423.368	640.172	640.250
4	10433.368	640.450	640.538
5	10443.368	640.739	640.807
6	10453.368	640.987	641.061
7	10463.368	641.246	641.301
8	10473.368	641.500	641.536
9	10483.368	641.747	641.763
10	10493.368	641.985	641.991
± Brg. Pier 1	10503.368	642.223	642.223
11	10513.368	642.452	642.460
12	10523.368	642.674	642.697
13	10533.368	642.890	642.936
14	10543.368	643.107	643.173
15	10553.368	643.305	643.396
16	10563.368	643.503	643.610
17	10573.368	643.694	643.809
18	10583.368	643.880	643.992
19	10593.368	644.060	644.159
20	10603.368	644.233	644.315
21	10613.368	644.400	644.459
22	10623.368	644.561	644.597
23	10633.368	644.716	644.732
24	10643.368	644.865	644.870
25	10653.368	645.007	645.008
± Brg. Pier 2	10663.368	645.144	645.144
26	10673.368	645.274	645.287
27	10683.368	645.396	645.428
28	10693.368	645.516	645.569
29	10703.368	645.628	645.712
30	10713.368	645.733	645.847
31	10723.368	645.833	645.974
32	10733.368	645.926	646.088
33	10743.368	646.013	646.187
34	10753.368	646.094	646.273
35	10763.368	646.169	646.342
36	10773.368	646.238	646.394
37	10783.368	646.300	646.433
38	10793.368	646.357	646.463
39	10803.368	646.407	646.481
40	10813.368	646.451	646.499
41	10823.368	646.489	646.515
42	10833.368	646.521	646.530
43			
± Brg. Pier 3	10844.000	646.548	646.548
44	10854.000	646.567	646.570
45	10864.000	646.580	646.592
46	10874.000	646.586	646.613
47	10884.000	646.587	646.635
48	10894.000	646.581	646.654
49	10904.000	646.570	646.668
50	10914.000	646.552	646.670
51	10924.000	646.528	646.660
52	10934.000	646.498	646.637
53	10944.000	646.461	646.599
54	10954.000	646.419	646.546
55	10964.000	646.370	646.477
56	10974.000	646.316	646.399
57	10984.000	646.255	646.313
58	10994.000	646.188	646.223
59	11004.000	646.114	646.132

**STATE OF ILLINOIS  
DEPARTMENT OF TRANSPORTATION**

ROUTE NO.	SECTION	COUNTY	TOTAL SHEETS	SHEET NO.
S.B.I. F.A. 24	37,101 83B	LIVINGSTON	67	29
FED. ROAD DIST. NO. 7 ILLINOIS FED. AID PROJECT				

SHEET NO. 11  
22 SHEETS

GIRDER 4

LOCATION	STATION	THEORETICAL GRADE ELEVATIONS	THEORETICAL GRADE ELEVATIONS ADJUSTED FOR DEAD LOAD DEFLECTIONS
Back N. Abut.	10384.706	639.164	639.164
± Brg. N. Abut.	10387.544	639.251	639.251
1	10397.544	639.551	639.583
2	10407.544	639.644	639.902
3	10417.544	640.132	640.210
4	10427.544	640.414	640.502
5	10437.544	640.689	640.775
6	10447.544	640.958	641.032
7	10457.544	641.221	641.276
8	10467.544	641.478	641.514
9	10477.544	641.729	641.745
10	10487.544	641.973	641.976
± Brg. Pier 1	10497.544	642.212	642.212
11	10507.544	642.444	642.452
12	10517.544	642.670	642.695
13	10527.544	642.890	642.936
14	10537.544	643.104	643.176
15	10547.544	643.312	643.403
16	10557.544	643.513	643.620
17	10567.544	643.709	643.824
18	10577.544	643.898	644.010
19	10587.544	644.081	644.180
20	10597.544	644.258	644.340
21	10607.544	644.428	644.487
22	10617.544	644.593	644.629
23	10627.544	644.751	644.857
24	10637.544	644.904	644.909
25	10647.544	645.050	645.051
± Brg. Pier 2	10657.544	645.190	645.190
26	10667.544	645.324	645.337
27	10677.544	645.451	645.484
28	10687.544	645.573	645.632
29	10697.544	645.688	645.728
30	10707.544	645.797	645.870
31	10717.544	645.900	646.054
32	10727.544	645.997	646.176
33	10737.544	646.088	646.283
34	10747.544	646.173	646.374
35	10757.544	646.251	646.448
36	10767.544	646.323	646.506
37	10777.544	646.390	646.550
38	10787.544	646.449	646.581
39	10797.544	646.503	646.596
40	10807.544	646.551	646.619
41	10817.544	646.592	646.631
42	10827.544	646.628	646.646
43	10837.544	646.657	646.663
± Brg. Pier 3	10844.000	646.673	646.673
44	10854.000	646.692	646.695
45	10864.000	646.705	646.717
46	10874.000	646.711	646.738
47	10884.000	646.712	646.760
48	10894.000	646.706	646.779
49	10904.000	646.695	646.793
50	10914.000	646.677	646.795
51	10924.000	646.653	646.785
52	10934.000	646.623	646.762
53	10944.000	646.586	646.724
54	10954.000	646.544	646.671
55	10964.000	646.495	646.602
56	10974.000	646.441	646.524
57	10984.000	646.380	646.438
58	10994.000	646.313	646.348
59	11004.000	646.239	646.257
60	11014.000	646.160	646.166
61	11024.000	646.074	646.075
± Brg. Pier 4	11037.000	645.954	645.954
62	11047.000	645.854	645.870
63	11057.000	645.749	645.786
64	11067.000	645.637	645.700
65	11077.000	645.518	645.615
66	11087.000	645.394	645.533
67	11097.000	645.264	645.443
68	11107.000	645.127	645.339
69	11117.000	644.984	645.222
70	11127.000	644.835	645.091
71	11137.000	644.680	644.940
72	11147.000	644.519	644.771
73	11157.000	644.352	644.583
74	11167.000	644.178	644.375
75	11177.000	643.998	644.148
76	11187.000	643.813	643.906
± Brg. S. Abut.	11200.000	643.562	643.562
Back S. Abut.	11202.333	643.516	643.516

GIRDER 5

LOCATION	STATION	THEORETICAL GRADE ELEVATIONS	THEORETICAL GRADE ELEVATIONS ADJUSTED FOR DEAD LOAD DEFLECTIONS
Back N. Abut.	10381.795	638.950	638.950
± Brg. N. Abut.	10384.632	639.037	639.037
1	10394.632	639.339	639.371
2	10404.632	639.634	639.692
3	10414.632	639.924	640.002
4	10424.632	640.207	640.295
5	10434.632	640.484	640.570
6	10444.632	640.755	640.829
7	10454.632	641.020	641.075
8	10464.632	641.279	641.315
9	10474.632	641.531	641.547
10	10484.632	641.778	641.781
± Brg. Pier 1	10494.632	642.018	642.018
11	10504.632	642.252	642.260
12	10514.632	642.480	642.503
13	10524.632	642.702	642.748
14	10534.632	642.917	642.989
15	10544.632	643.127	643.278
16	10554.632	643.330	643.437
17	10564.632	643.527	643.624
18	10574.632	643.718	643.830
19	10584.632	643.903	644.022
20	10594.632	644.082	644.184
21	10604.632	644.254	644.313
22	10614.632	644.421	644.457
23	10624.632	644.581	644.597
24	10634.632	644.735	644.740
25	10644.632	644.883	644.884
± Brg. Pier 2	10654.632	645.025	645.025
26	10664.632	645.160	645.175
27	10674.632	645.290	645.325
28	10684.632	645.413	645.477
29	10694.632	645.530	645.623
30	10704.632	645.641	645.767
31	10714.632	645.746	645.908
32	10724.632	645.845	646.034
33	10734.632	645.937	646.144
34	10744.632	646.024	646.239
35	10754.632	646.104	646.316
36	10764.632	646.178	646.377
37	10774.632	646.246	646.424
38	10784.632	646.308	646.456
39	10794.632	646.363	646.476
40	10804.632	646.413	646.491
41	10814.632	646.456	646.506
42	10824.632	646.495	646.520
43	10834.632	646.524	646.534
± Brg. Pier 3	10844.000	646.545	646.545
44	10854.000	646.567	646.570
45	10864.000	646.580	646.592
46	10874.000	646.586	646.613
47	10884.000	646.587	646.635
48	10894.000	646.581	646.654
49	10904.000	646.570	646.668
50	10914.000	646.552	646.670
51	10924.000	646.528	646.660
52	10934.000	646.498	646.637
53	10944.000	646.461	646.599
54	10954.000	646.419	646.546
55	10964.000	646.370	646.471
56	10974.000	646.316	646.399
57	10984.000	646.255	646.313
58	10994.000	646.188	646.223
59	11004.000	646.114	646.132
60	11014.000	646.035	646.041
61	11024.000	645.949	645.950
± Brg. Pier 4	11037.000	645.829	645.829
62	11047.000	645.729	645.745
63	11057.000	645.624	645.661
64	11067.000	645.512	645.575
65	11077.000	645.393	645.490
66	11087.000	645.269	645.408
67	11097.000	645.139	645.318
68	11107.000	645.002	645.214
69	11117.000	644.859	645.097
70	11127.000	644.710	644.966
71	11137.000	644.555	644.815
72	11147.000	644.394	644.646
73	11157.000	644.227	644.458
74	11167.000	644.053	644.250
75	11177.000	643.873	644.023
76	11187.000	643.688	643.787
± Brg. S. Abut.	11200.000	643.437	643.437
Back S. Abut.	11202.333	643.391	643.391

WEST LONGITUDINAL BONDED CONSTRUCTION JOINT


LOCATION	STATION	THEORETICAL GRADE ELEVATIONS	THEORETICAL GRADE ELEVATIONS ADJUSTED FOR DEAD LOAD DEFLECTIONS
Back N. Abut.	10381.067	638.852	638.852
± Brg. N. Abut.	10383.904	638.973	638.973
1	10393.904	639.273	639.307
2	10403.904	639.571	639.629
3	10413.904	639.861	639.939
4	10423.904	640.145	640.233
5	10433.904	640.423	640.509
6	10443.904	640.694	640.768
7	10453.904	640.959	641.014
8	10463.904	641.219	641.255
9	10473.904	641.472	641.488
10	10483.904	641.718	641.721
± Brg. Pier 1	10493.904	641.959	641.959
11	10503.904	642.194	642.202
12	10513.904	642.422	642.445
13	10523.904	642.644	642.690
14	10533.904	642.860	642.932
15	10543.904	643.070	643.161
16	10553.904	643.274	643.381
17	10563.904	643.471	643.584
18	10573.904	643.663	643.775
19	10583.904	643.848	643.947
20	10593.904	644.027	644.109
21	10603.904	644.200	644.259
22	10613.904	644.367	644.403
23	10623.904	644.528	644.544
24	10633.904	644.682	644.687
25	10643.904	644.831	644.832
± Brg. Pier 2	10653.904	644.973	644.973
26	10663.904	645.109	645.124
27	10673.904	645.239	645.274
28	10683.904	645.363	645.427
29	10693.904	645.480	645.573
30	10703.904	645.592	645.718
31	10713.904	645.697	645.859
32	10723.904	645.796	645.985
33	10733.904	645.889	646.096
34	10743.904	645.976	646.191
35	10753		

STATE OF ILLINOIS  
DEPARTMENT OF TRANSPORTATION


ROUTE NO.	SECTION	COUNTY	TOTAL SHEETS	SHEET NO.
S.B.I. 24	37,101 BVB	LIVINGSTON	67	30
FED. ROAD DIST. NO. 7	ILLINOIS FED. AID PROJECT			

SHEET NO. 12  
22 SHEETS


Note: Bars indicated thus 20x3-#5 etc. indicates 20 lines of bars with 3 lengths per line.

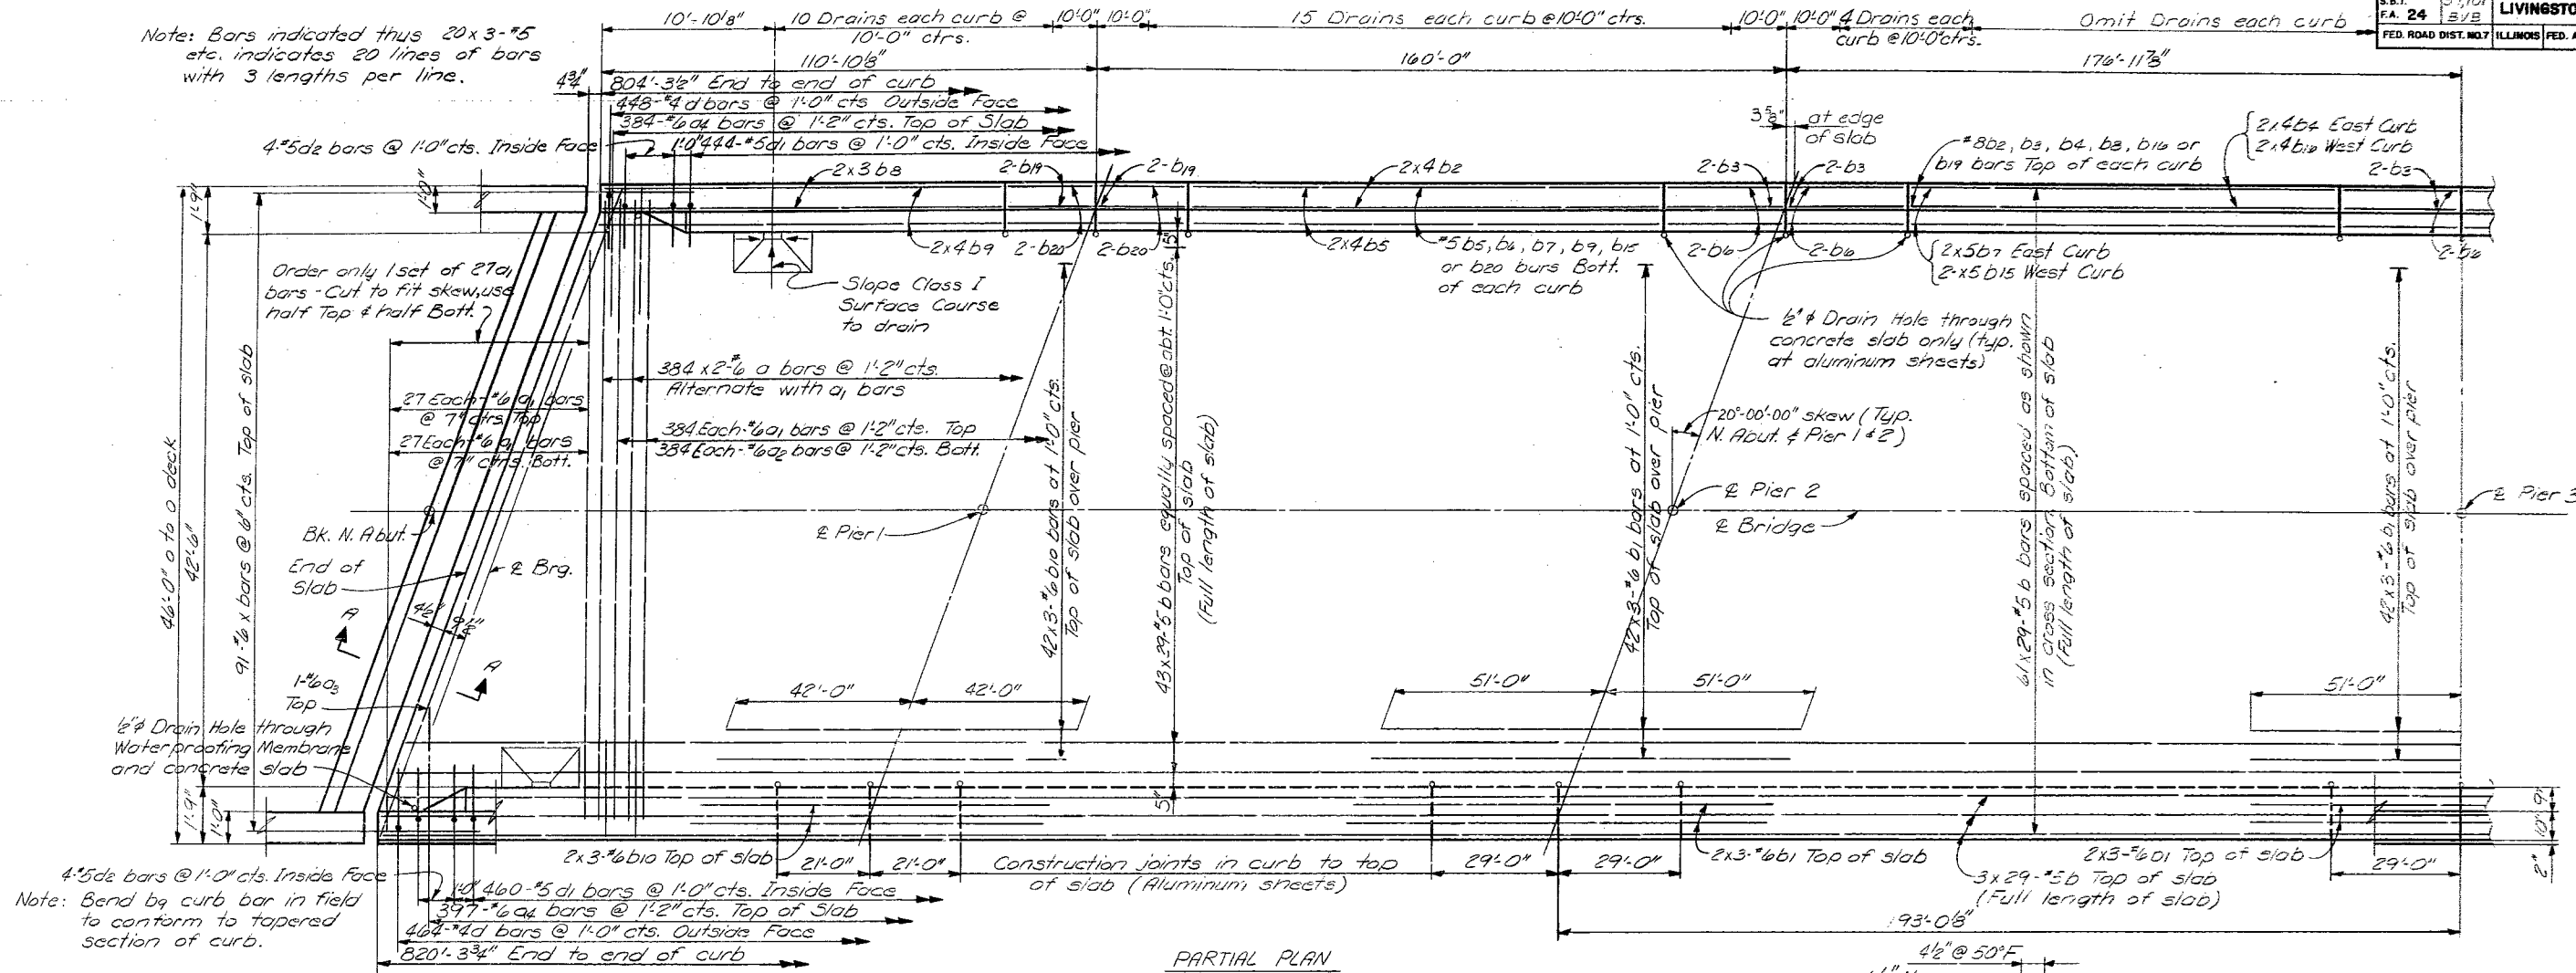

PARTIAL PLAN

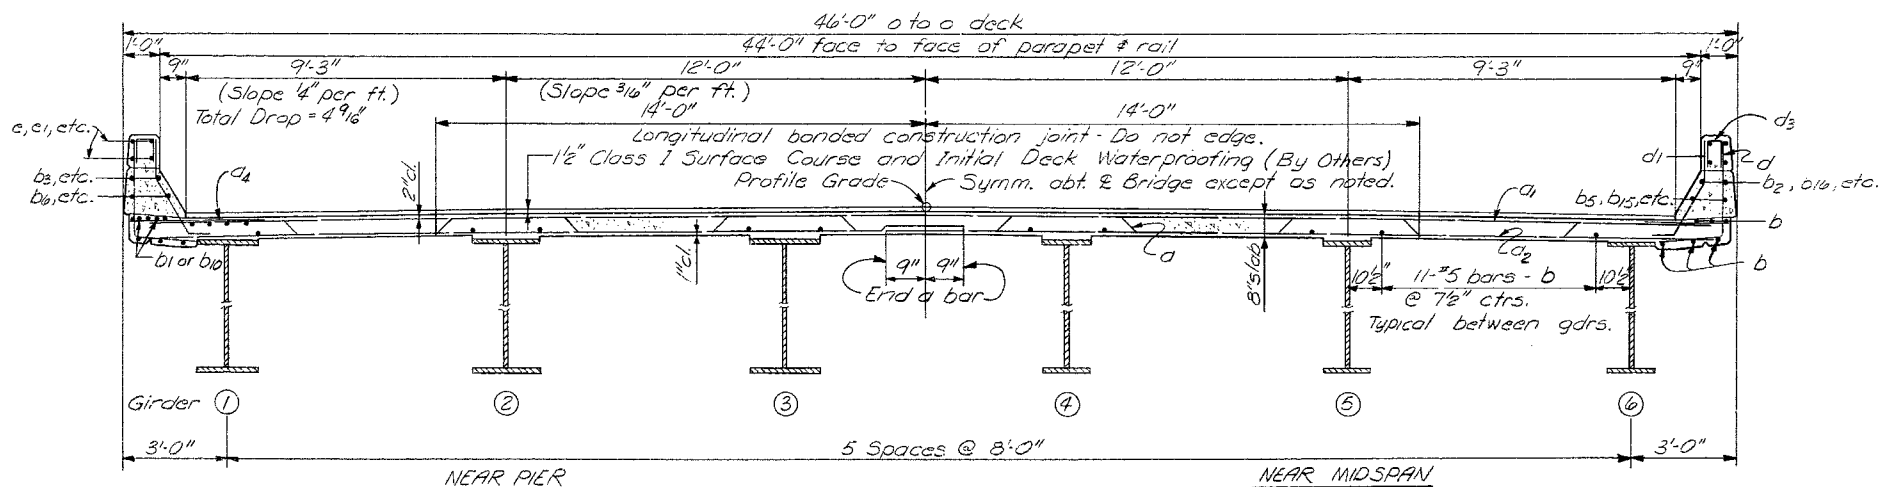

CROSS SECTION  
Looking Up Station

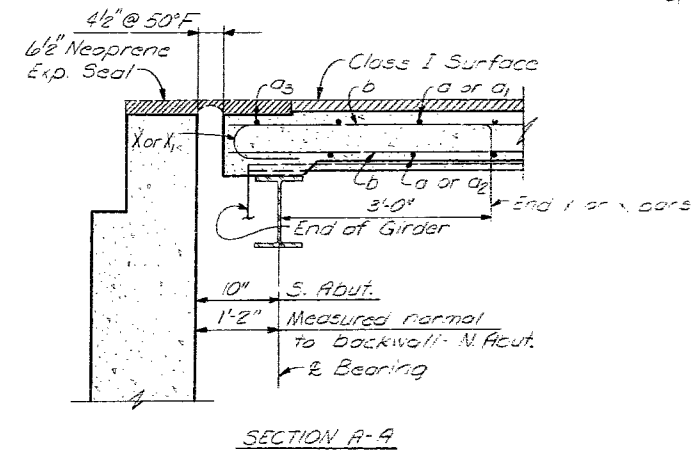

SECTION A-A

NOTES  
Work this sheet with Sheet 13.

DESIGNED	C. Wiczorek
CHECKED	S. R. Franklin
DRAWN	J. O. Smith Jr.
CHECKED	R. V. Butterfield

Note: Do not scale this drawing. Follow dimensions.


SLAB  
F.A. ROUTE 24 (ILL. 23) OVER  
VERMILION RIVER AND THE ATCHISON  
TOPEKA & SANTA FE RAILROAD  
F.A. RT. 24 SEC. (37,101) BVB  
LIVINGSTON COUNTY  
STATION 106+39



STATE OF ILLINOIS  
DEPARTMENT OF TRANSPORTATION


ROUTE NO.	SECTION	COUNTY	TOTAL SHEETS	SHEET NO.
S.B.I. FA 24	37,101 2VB	LIVINGSTON	67	32
FED. ROAD DIST. NO. 7	ILLINOIS	FED. AID PROJECT		

SHEET NO. 14  
22 SHEETS

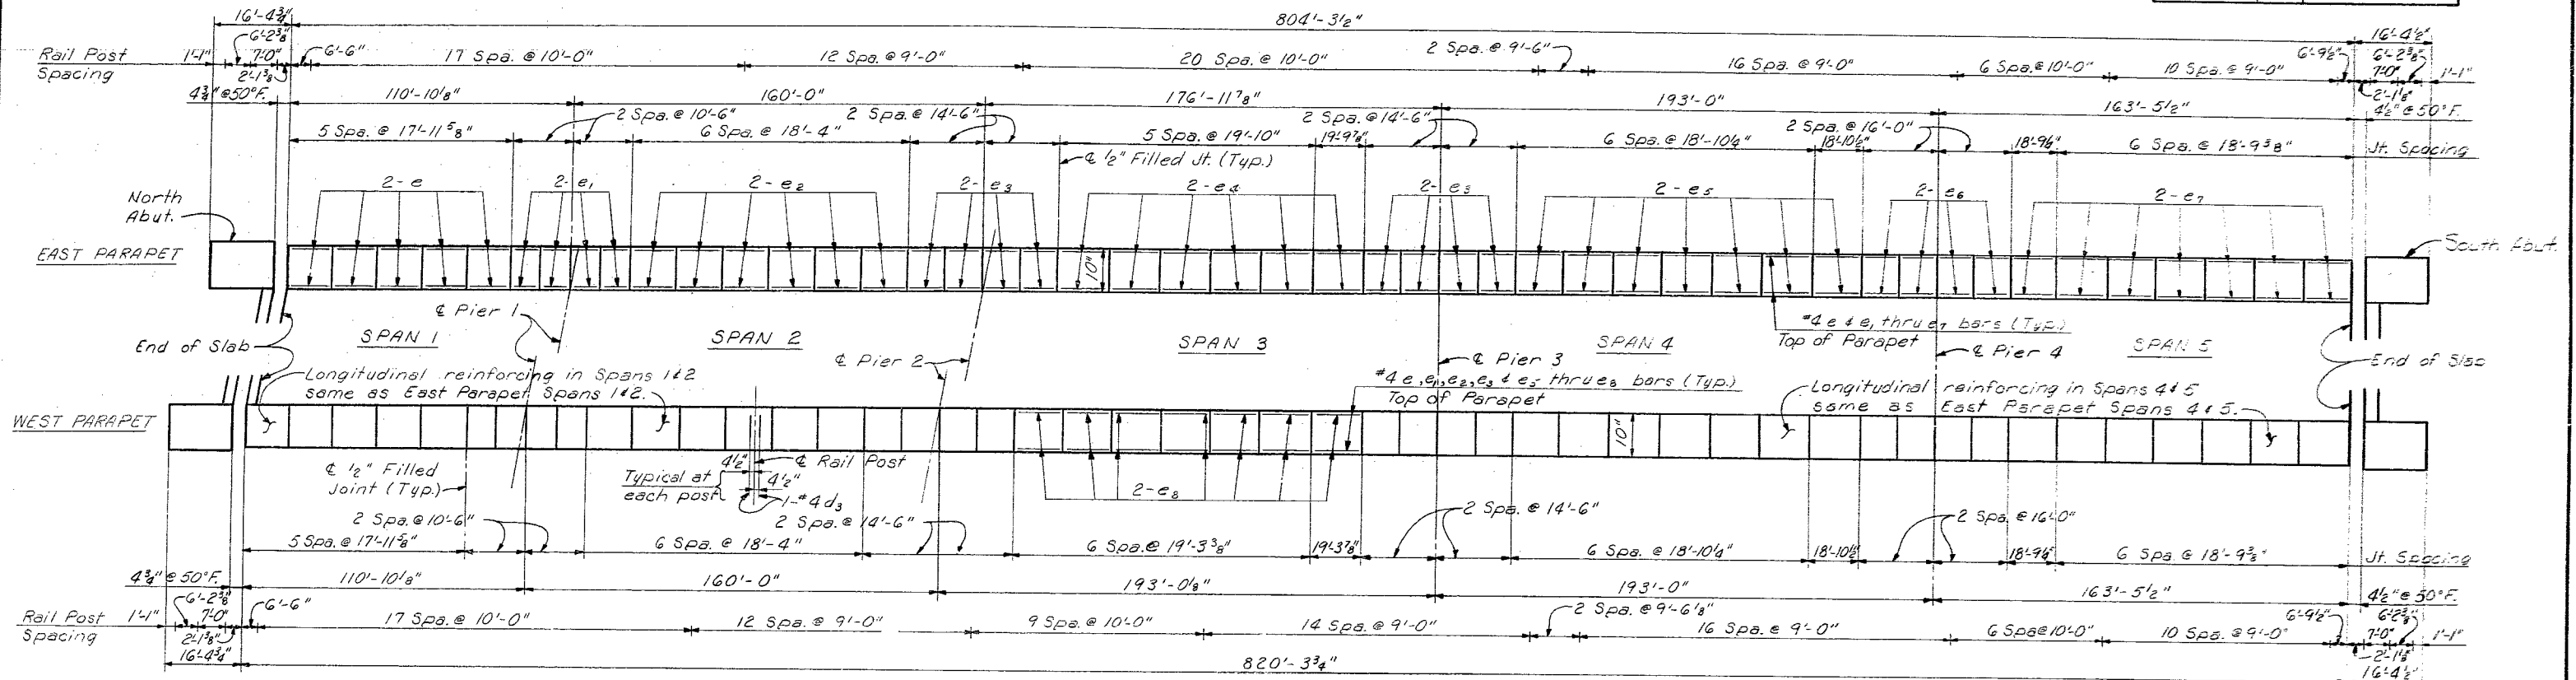


**PLAN OF PARAPET**  
Note: All joints in parapet shall be vertical.  
All longitudinal dimensions are measured along inside face of parapet.

Two component non-staining gray sealing compound with polysulfide liquid polymers-gum grade with primer.

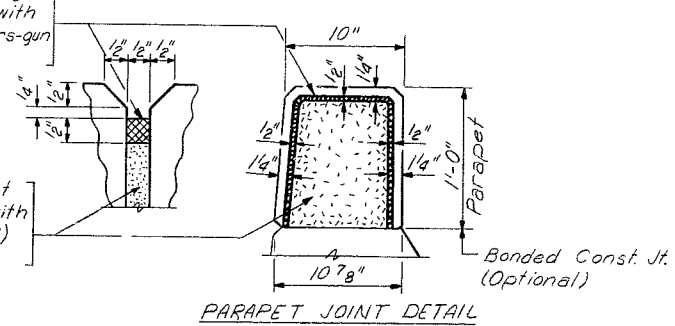



1/2" Preformed Cork Joint Filler (in accordance with Articles 715.07 or 715.08) Cost incidental.

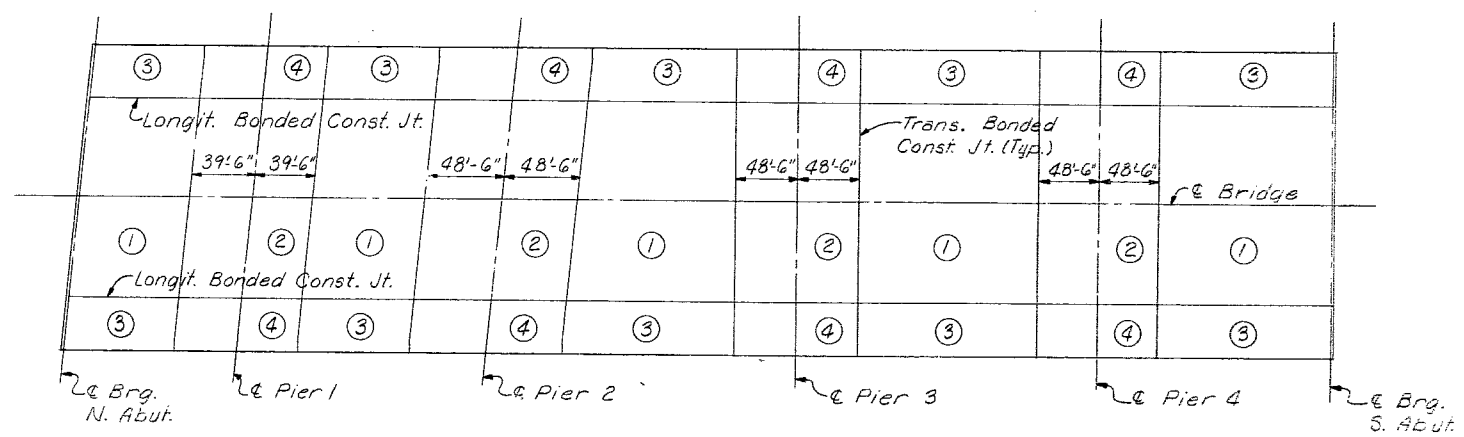

**SLAB POURING SEQUENCE**  
Note: Pouring shall begin preferably at either or both abutments and proceed successively toward the other end. Pours shall be made in order indicated by numbers in circles. If longitudinal joint is omitted, follow pouring sequence for center section of slab.

**BILL OF MATERIAL**

Bar	No.	Size	Length	Shape
d <sub>3</sub>	342	#4	2'-1"	□
e	20	#4	17'-7"	□
e <sub>1</sub>	32	#4	10'-2"	□
e <sub>2</sub>	48	#4	18'-0"	□
e <sub>3</sub>	64	#4	14'-2"	□
e <sub>4</sub>	24	#4	19'-6"	□
e <sub>5</sub>	56	#4	18'-6"	□
e <sub>6</sub>	32	#4	15'-8"	□
e <sub>7</sub>	56	#4	18'-5"	□
e <sub>8</sub>	28	#4	18'-11"	□
Aluminum Railing Lin. Ft.				1,586
Class. X Concrete Cu. Yds.				58.2
Reinforcement Bars Lbs.				4,730

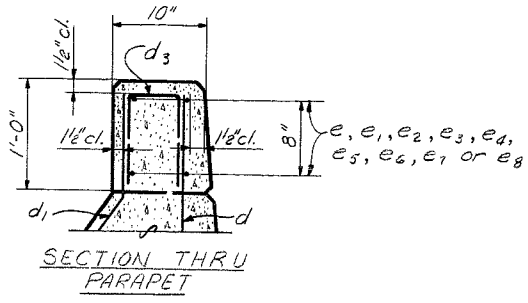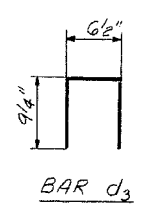

DESIGNED C. Wieczorek  
CHECKED S. Franklin  
DRAWN D. Richardson  
CHECKED G. Dee


**PARAPET AND SLAB POURING SEQUENCE**  
F.A. ROUTE 24 (ILL 23) OVER VERMILION RIVER AND THE ATCHISON TOPEKA & SANTA FE RAILROAD  
F.A. RT. 24 SEC. (37,101) BVB LIVINGSTON COUNTY STATION 106+39

Note: Do not scale this drawing. Follow dimensions.


STATE OF ILLINOIS  
DEPARTMENT OF TRANSPORTATION

ROUTE NO.	SECTION	COUNTY	TOTAL SHEETS	SHEET NO.
F.A. 24	37.101 24B	LIVINGSTON	67	33
FED. ROAD DIST. NO.	ILLINOIS	FED. AID PROJECT		


SHEET NO. 15  
22 SHEETS

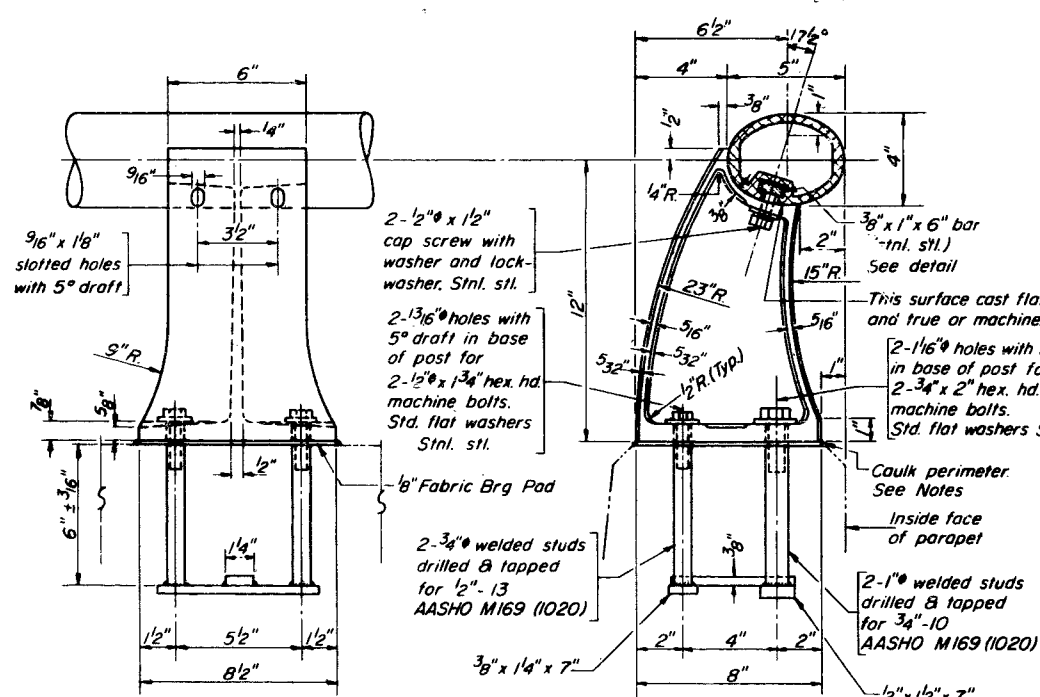


RAIL POST DETAILS

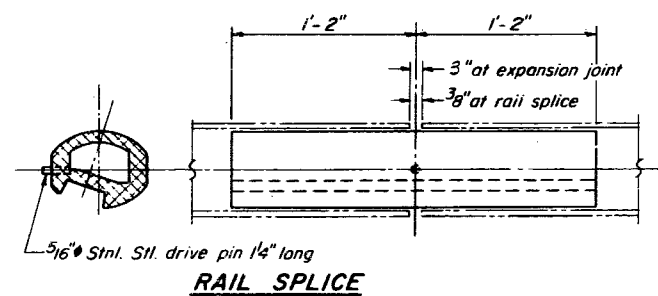



RAIL SPLICE

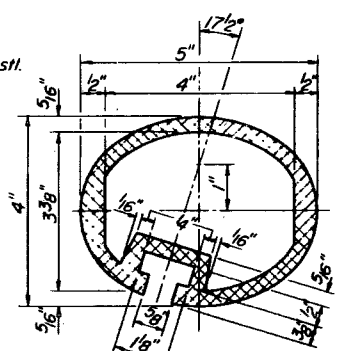

SEC. THRU ELLIPTICAL RAIL SECTION

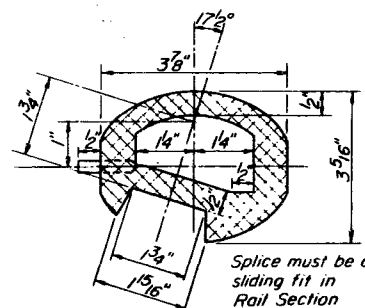

SEC. THRU SPLICE

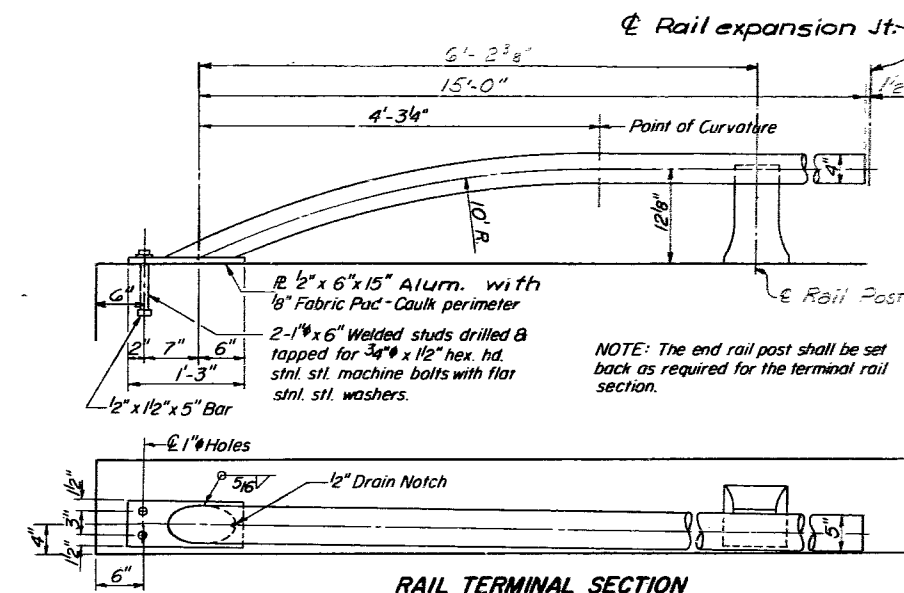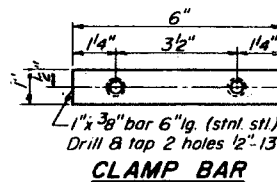

RAIL TERMINAL SECTION

NOTES

For Rail Post Spacing and Estimated Quantity of Rail, see Sheet 14.

For Neoprene Expansion Joint, see Sheet 22.

NOTES:

All Aluminum Alloy Extruded Rail shall be supplied in modular lengths of 30 feet, except at the end of bridge or over open joints in bridge deck where the rail shall be attached to a minimum of 2 posts. If the rail is on a horizontal curve of 2300 foot radius or less, the modular lengths may be reduced but shall be attached to a minimum of 2 posts.

All joints in rail shall be spliced per detail.

Provide 1-1/8" and 2-1/8" Aluminum Shims for 25% of the Posts. Rail element shall be parallel to Grade - high spots shall be ground and low spots shimmed.

Seal perimeter of base of post to parapet with two component non-staining gray sealing compound with polysulfide liquid polymers, gun grade with primer. Fabric Bearing Pad shall have same dimensions as base of post.

Aluminum alloy rail shall conform to ASTM B221 alloy 6061-T6 or 6351-T5 with min. yield 35 ksi, min. tensile 38 ksi, and elongation of 10% in 2 inches.

ALUMINUM RAILING  
F.A. ROUTE 24 (ILL. 23) OVER  
VERMILION RIVER AND THE ATCHISON  
TOPEKA & SANTA FE RAILROAD  
F.A. RT. 24 SEC. (37.101) BVB  
LIVINGSTON COUNTY  
STATION 106+39

DESIGNED C. Wiczorek  
CHECKED S. Franklin  
DRAWN D. Richardson  
CHECKED G. Dee

Note: Do not scale this drawing. Follow dimensions.


STATE OF ILLINOIS  
DEPARTMENT OF TRANSPORTATION

\* Elevation at Front Face of Backwall

ROUTE NO.	SECTION	COUNTY	TOTAL SHEETS	SHEET NO.
S.B.I. 37.101	BVB	LIVINGSTON	67	34
FED. ROAD DIST. NO. 7	ILLINOIS	FED. AID PROJECT		


SHEET NO. 16  
22 SHEETS

Note: Bars indicated thus  $\text{---} \times \text{---} \times \text{---}$  etc. indicates  $\text{---}$  lines of bars with 2 bars per line.

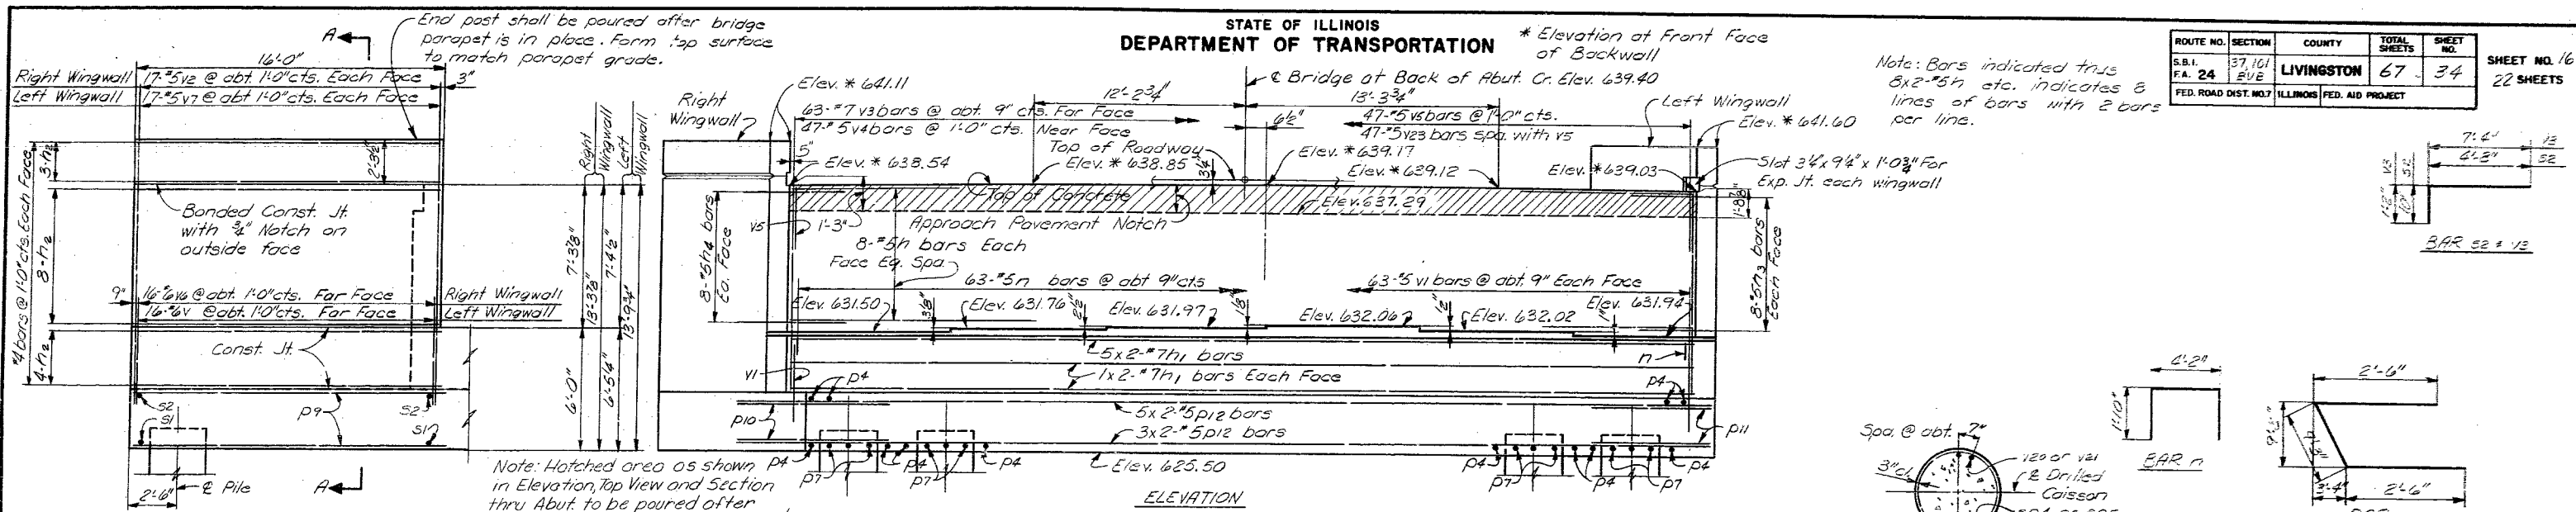


Note: Hatched area as shown in Elevation, Top View and Section thru Abut. to be poured after superstructure forms are removed. Class X concrete (3.0 Cu. Yd.) is included in Total Bill of Materials. (Superstr.)


WING WALL ELEVATION

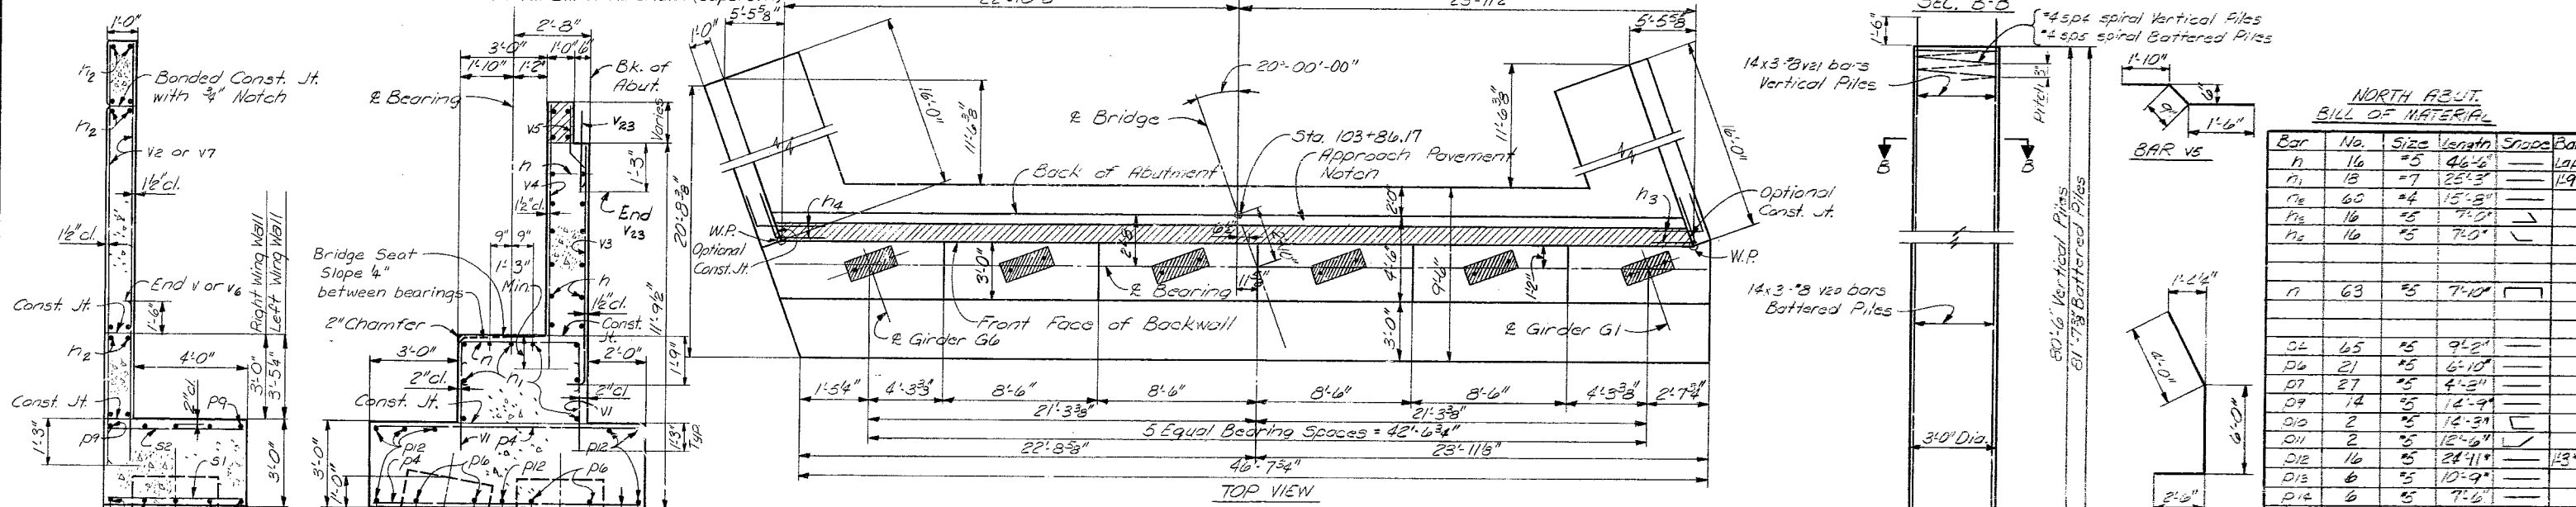

TOP VIEW

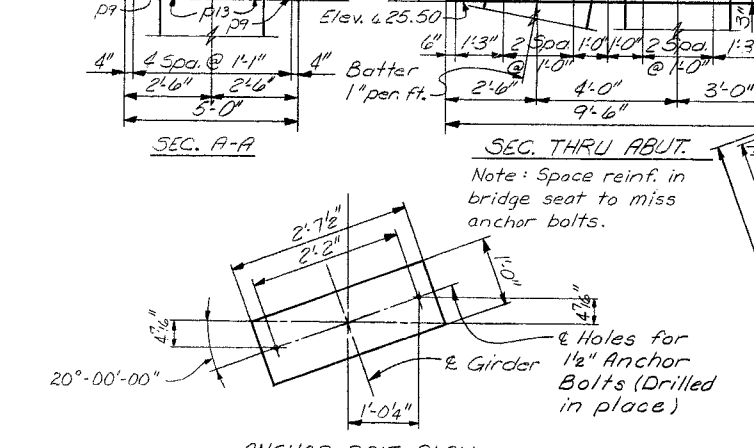

DESIGNED G. J. Roufa  
CHECKED J. A. Liebsch  
DRAWN J. O. Smith Jr.  
CHECKED R. V. Butterfield

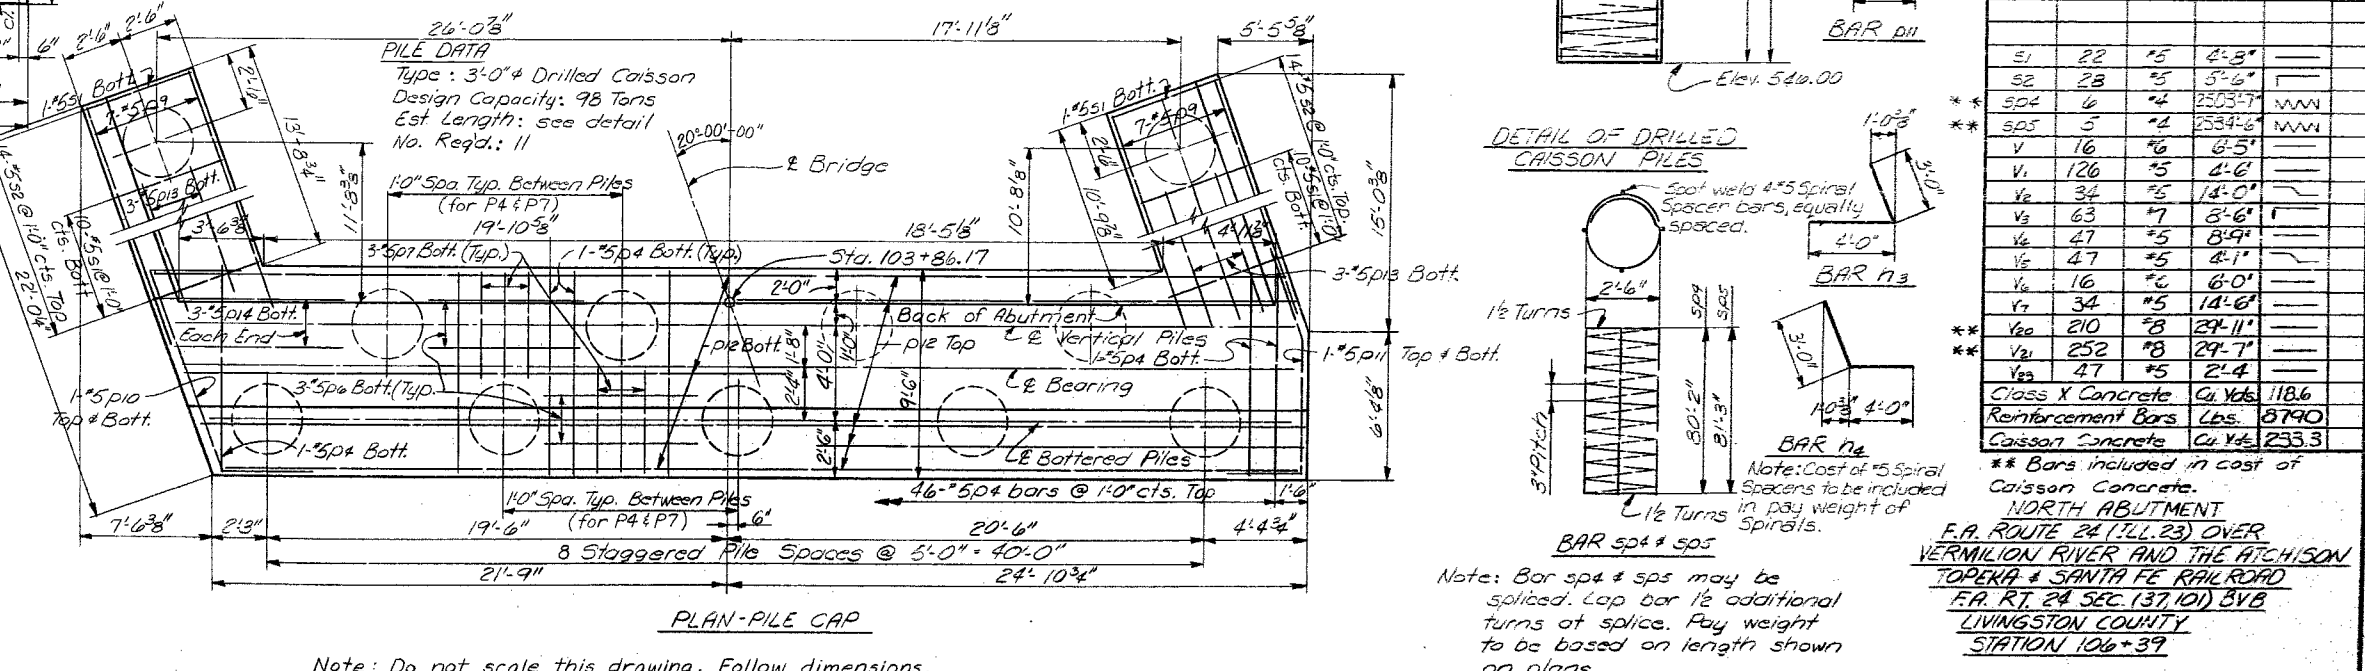

NORTH ABUT. BILL OF MATERIAL

Bar	No.	Size	Length	Shape	Bar
n	16	#5	46'-6"	Lap	
n1	18	#7	25'-3"		119"
n2	60	#4	15'-3"		
n3	16	#5	7'-0"		
n4	16	#5	7'-0"		
n	63	#5	7'-10"		
s2	65	#5	9'-2"		
p6	21	#5	6'-10"		
s7	27	#5	4'-5"		
s9	14	#5	12'-9"		
s10	2	#5	12'-3"		
s11	2	#5	12'-9"		
s12	16	#5	24'-11"		13"
s13	6	#5	10'-9"		
s14	6	#5	7'-6"		
s1	22	#5	2'-5"		
s2	28	#5	5'-6"		
s3	6	#4	253'-7"	WWW	
s4	5	#4	253'-6"	WWW	
v	16	#6	6'-5"		
v1	126	#5	2'-6"		
v2	34	#5	14'-0"		
v3	63	#7	3'-6"		
v4	47	#5	8'-9"		
v5	47	#5	8'-1"		
v6	16	#6	6'-0"		
v7	34	#5	14'-6"		
v8	210	#8	24'-11"		
v9	252	#8	24'-7"		
v10	47	#5	2'-4"		
Class X Concrete	Cu. Yds.		118.6		
Reinforcement Bars	Lbs.		8790		
Caisson Concrete	Cu. Yds.		233.3		

\*\* Bars included in cost of Caisson Concrete.  
NORTH ABUTMENT  
F.A. ROUTE 24 (ILL. 23) OVER VERMILION RIVER AND THE ARCHISON TOPEKA & SANTA FE RAILROAD  
F.A. RT. 24 SEC. (37.101) BVB  
LIVINGSTON COUNTY  
STATION 106+39


STATE OF ILLINOIS  
DEPARTMENT OF TRANSPORTATION \*Elevation at Front Face of Backwall

ROUTE NO.	SECTION	COUNTY	TOTAL SHEETS	SHEET NO.
S.B.I. P.A. 24	37,101 BVB	LIVINGSTON	67	35
FED. ROAD DIST. NO. 7	ILLINOIS	FED. AID PROJECT		


SHEET NO. 17  
22 SHEETS

End post shall be poured after bridge parapet is in place.  
Form top surface to match parapet grade

Note: Bars indicated thus 8x2-5/8 etc. indicates 8 lines of bars with 2 bars per line.

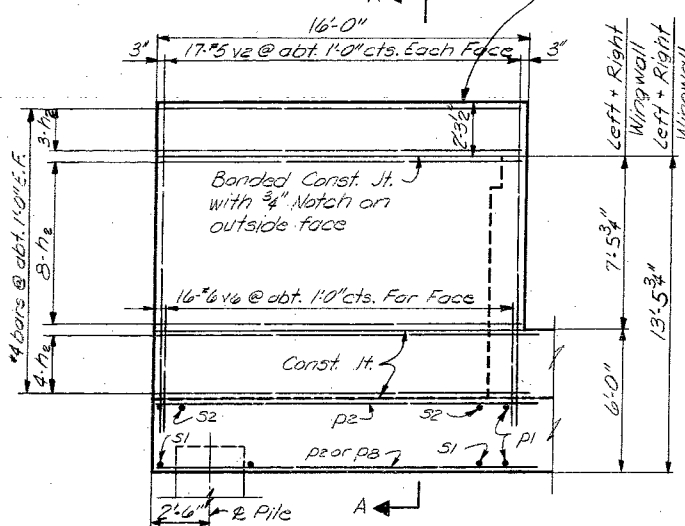


WING WALL ELEVATION

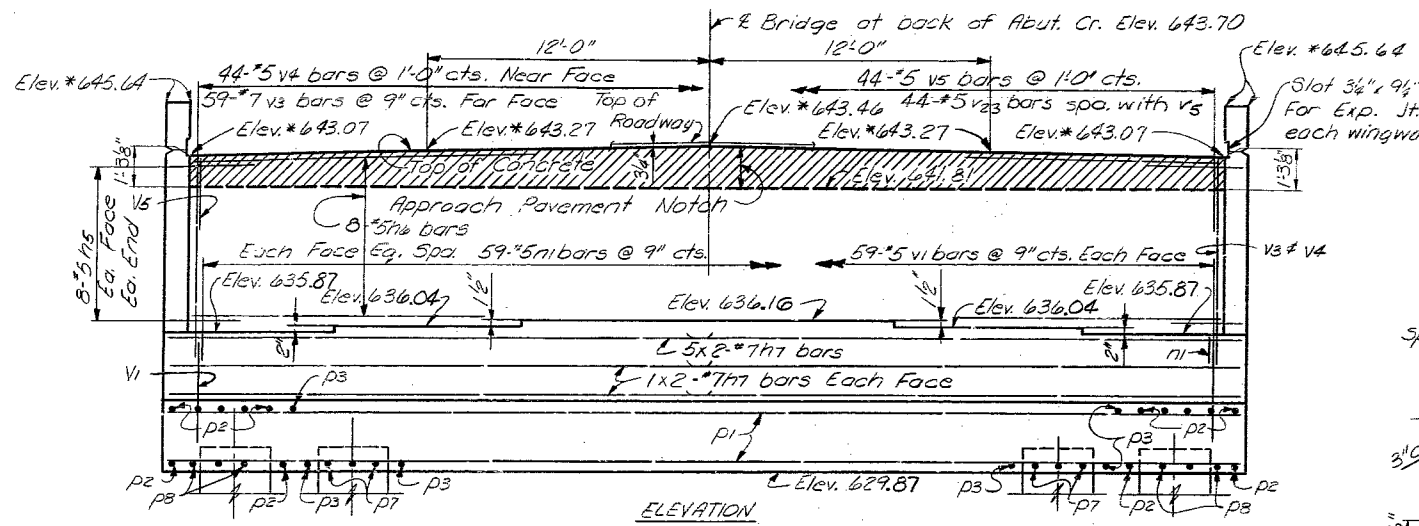


ELEVATION

Note: Hatched area as shown in Elevation, Top View and Section thru Abut. to be poured after superstructure forms are removed. Class X Concrete (2.3 Cu. Yd.) is included in Total Bill of Material (Superstr.)

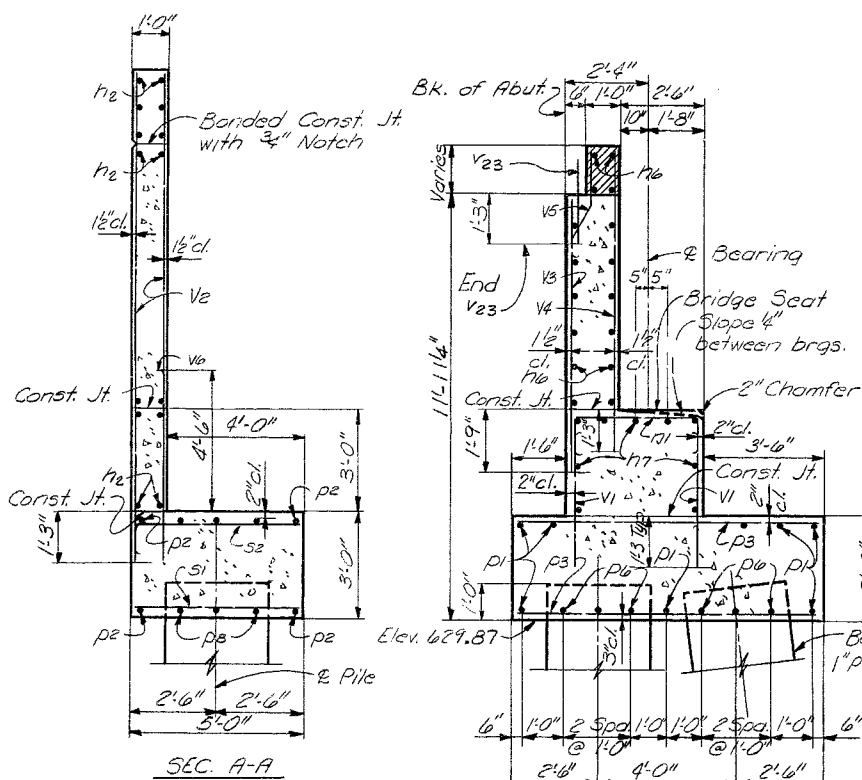


SEC. THRU ABUT.  
Note: Space reinf. in bridge seat to miss anchor bolts.

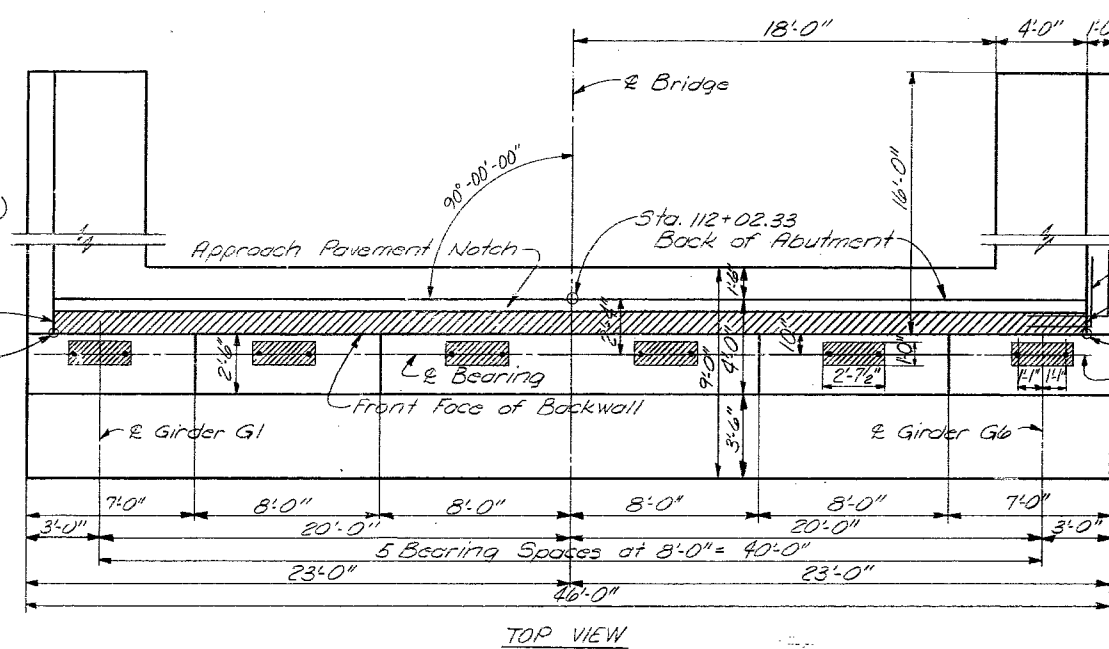

TOP VIEW


PILE DATA

Type: 3'-0" Drilled Caisson  
Design Capacity: 100.5 Tons  
Est. Length: see detail  
No. Required: 11

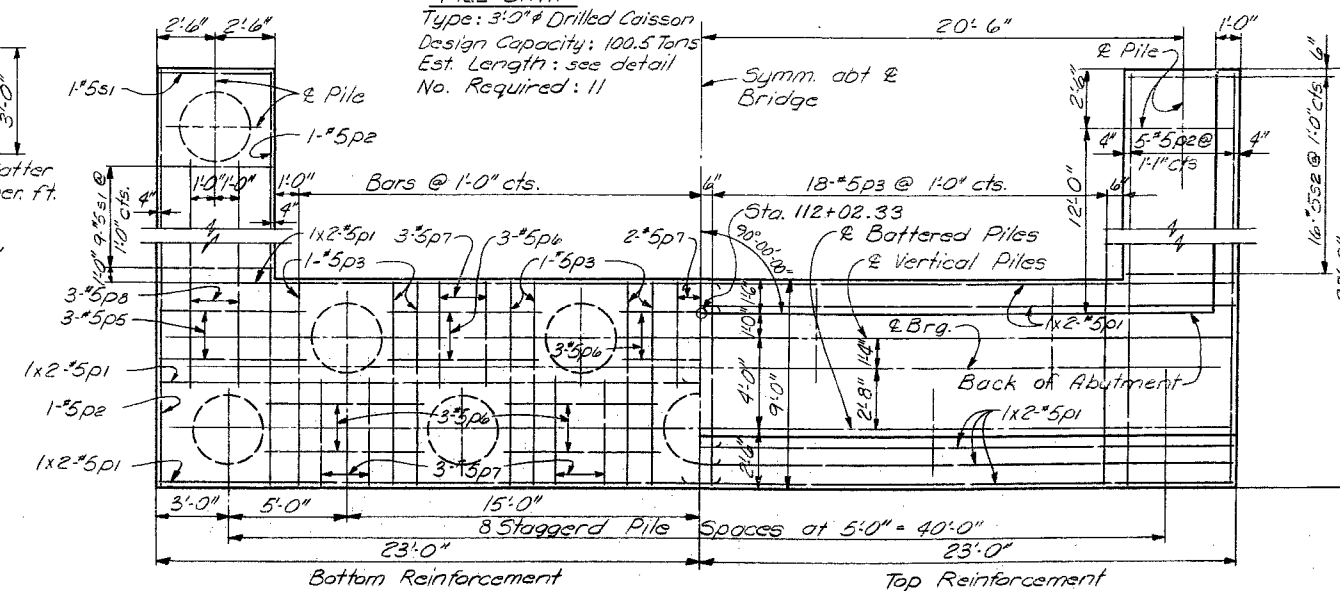

PLAN - PILE CAP

DETAIL OF DRILLED CAISSON PILES

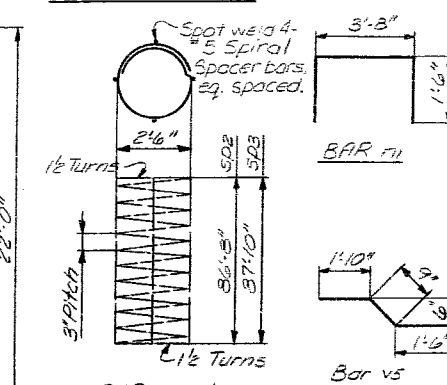

BAR spz & sps

Note: Bar spz and sps may be spliced. Lap bar 1/2 additional turns at splice. Pay weight to be based on length shown on plans.  
Cost of #5 Spiral Spacers to be included in pay weight of spirals.

SOUTH ABUT. BILL OF MATERIAL

Bar	No.	Size	Length	Splice	Barlap
V2	60	#4	15'-8"		
V3	32	#5	7'-0"		
V4	16	#5	43'-8"		
V7	18	#7	23'-9"		1'-9"
V1	59	#5	4'-8"		
D1	16	#5	23'-7"		1'-3"
D2	14	#5	21'-8"		
D3	50	#5	8'-8"		
D5	4	#5	6'-2"		
D6	21	#5	6'-10"		
D7	21	#5	4'-8"		
D8	6	#5	15'-10"		
S1	20	#5	4'-8"		
S2	32	#5	5'-6"		
S2B	6	#4	27'-0"		MM
S2C	5	#4	27'-4"		MM
V1	118	#5	4'-6"		
V2	68	#5	14'-0"		
V3	59	#7	8'-6"		
V4	44	#5	3'-9"		
V5	44	#5	4'-11"		
V6	32	#6	6'-0"		
V12	252	#8	31'-6"		
V13	210	#8	32'-3"		
V23	44	#5	2'-4"		

Class X Concrete Cu. Yds 102.5  
Reinforcement Bars Lbs. 8250  
Caisson Concrete Cu. Yds 252.1  
\*\* Bars included in cost of Caisson Concrete.

SOUTH ABUTMENT  
F.A. ROUTE 24 (ILL. 23) OVER  
VERMILION RIVER AND THE HATCHISON  
TOPEKA & SANTA FE RAILROAD  
F.A. RT. 24 SEC. (37,101) BVB  
LIVINGSTON COUNTY  
STATION 106+39

DESIGNED	G. J. Roufa
CHECKED	J. A. Liebsch
DRAWN	J. O. Smith Jr.
CHECKED	R. V. Butterfield









Note: Do not scale this drawing. Follow dimensions.

STATE OF ILLINOIS  
DEPARTMENT OF TRANSPORTATION

ROUTE NO.	SECTION	COUNTY	TOTAL SHEETS	SHEET NO.
S.B.I. 24	37,101 BVB	LIVINGSTON	67	36
FED. ROAD DIST. NO.	ILLINOIS	FED. AID PROJECT		

SHEET NO. 13  
22 SHEETS

Note: Space reinforcement in cap to miss anchor bolts. All edges shall have standard 3/4" chamfers except as noted. Pour steps monolithically with cap. Maximum Design Bearing Pressure = 9.4 Tons per sq. ft.

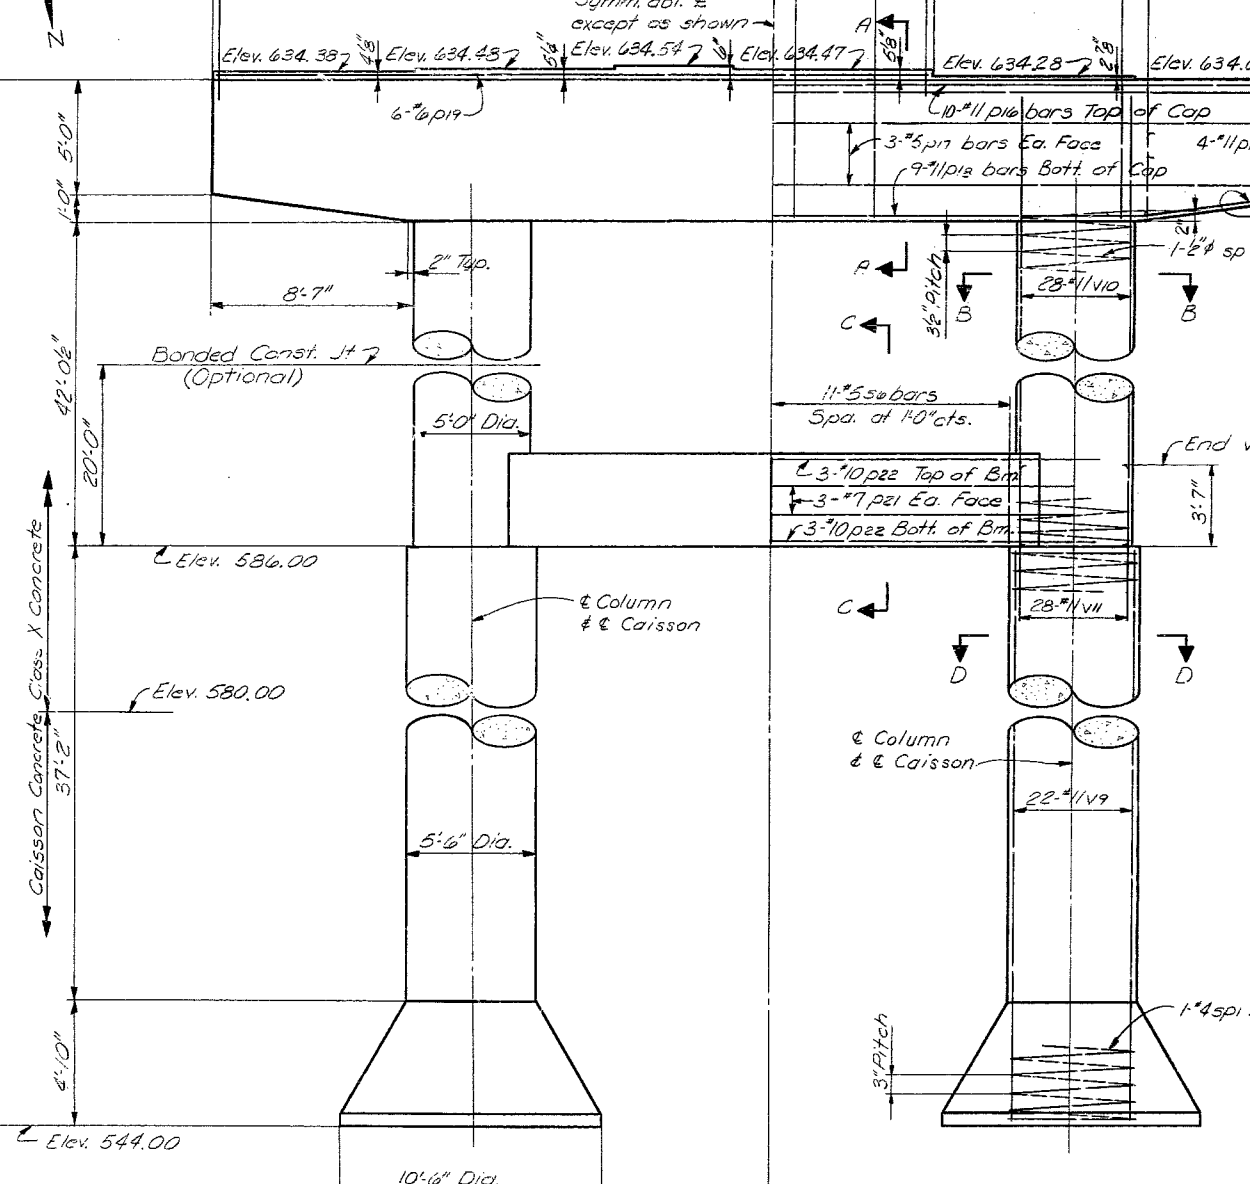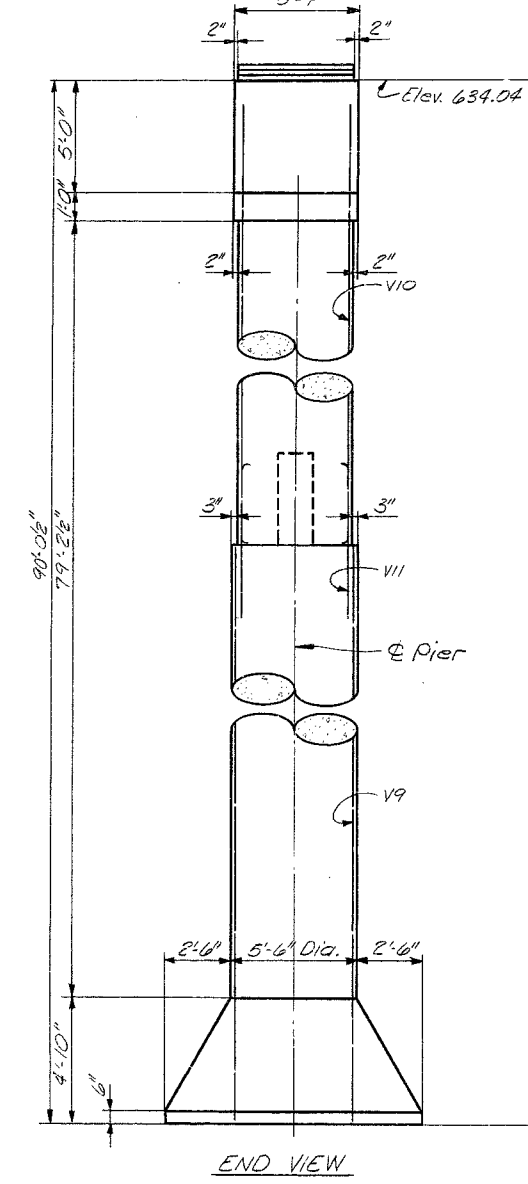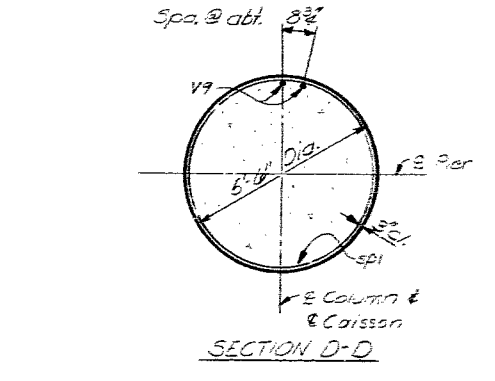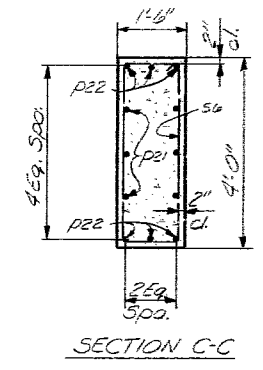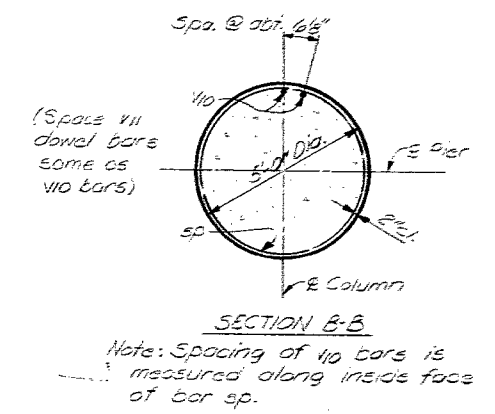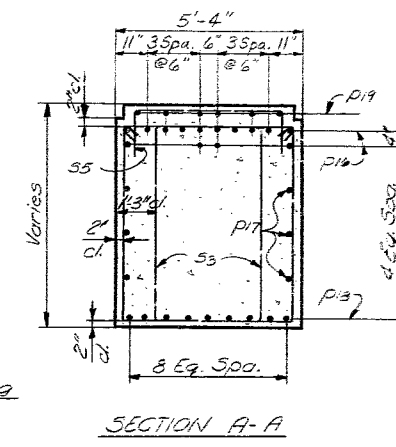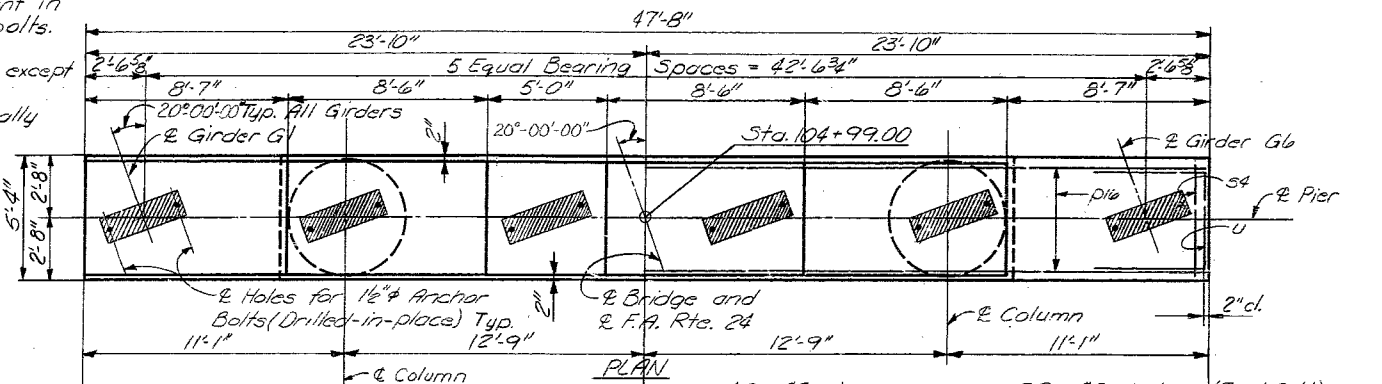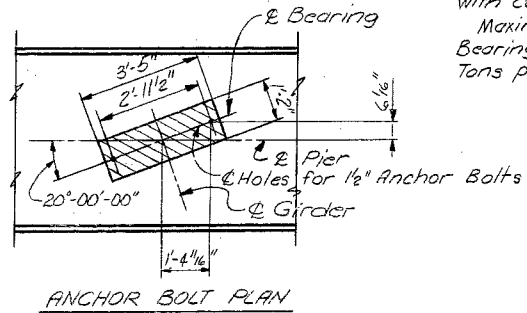


A + B DIMENSIONS

Bar	A	B
s4	3'-11"	3'-6"
ss	4'-8"	1'-6"
u	4'-11"	1'-6"

A + B DIMENSIONS

Bar	A	B
s3	3'-11"	5'-8"
s6	1'-2"	3'-3"

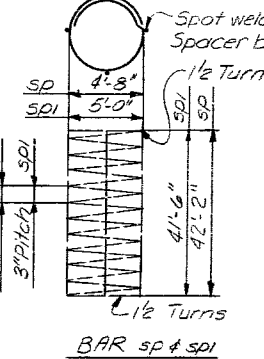

Note: Cost of Spiral Spacers to be included in pay weight of spirals.

Note: Spacing of 14 bars is measured along inside face of bar sp.

PIER 1  
BILL OF MATERIAL

Bar	No.	Size	Length	Splice
p16	14	#11	47'-4"	
p17	6	#5	47'-4"	
p8	9	#11	30'-10"	
p19	6	#6	30'-0"	
p20	10	#6	14'-9"	
s21	6	#7	25'-6"	
p22	6	#10	27'-0"	
s3	56	#5	20'-4"	
s4	56	#5	10'-11"	
s5	31	#4	7'-8"	
s6	21	#5	10'-10"	
s7	2	#2	21'-2 1/2"	
s21	2	#4	26'-2 1/2"	
u	8	#6	7'-11"	
v9	44	#11	41'-2"	
v10	56	#11	47'-0"	
v11	56	#11	7'-4"	
Class X Concrete			Cu. Yds. 133.8	
Caisson Concrete			Cu. Yds. 14.7	
Reinforcement Bars			Lbs. 28,140	

\* Bar included in cost of Caisson Concrete.  
PIER 1  
F.A. ROUTE 24 (ILL. 23) OVER VERMILION RIVER AND THE ARCHISON TOPEKA & SANTA FE RAILROAD  
F.A. RT. 24 SEC. (37,101) BVB  
LIVINGSTON COUNTY  
STATION 106+39





DESIGNED S.W. Yordy  
CHECKED G.J. Roufa  
DRAWN J.O. Smith Jr.  
CHECKED R.V. Butterfield

Note: Do not scale this drawing. Follow dimensions.


STATE OF ILLINOIS  
DEPARTMENT OF TRANSPORTATION

ROUTE NO.	SECTION	COUNTY	TOTAL SHEETS	SHEET NO.
S.B.I. F.A. 24	37,101 BVE	LIVINGSTON	67	37
FED. ROAD DIST. NO. 7	ILLINOIS FED. AID PROJECT			22 SHEETS



Note: Space reinforcement in cap to miss anchor bolts.  
All edges shall have standard 3/4" chamfers except as noted.  
Four steps mandolithically with cap.  
Maximum Design Bearing Pressure = 8.5 Tons per sq. ft.

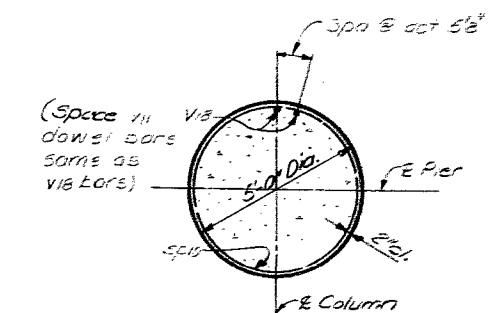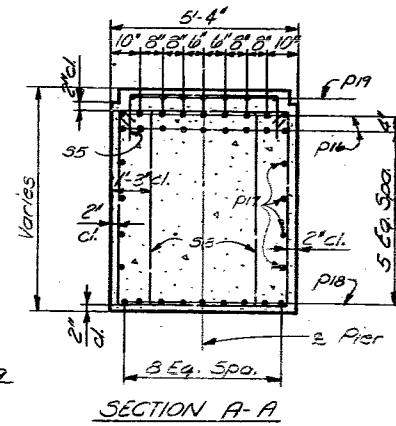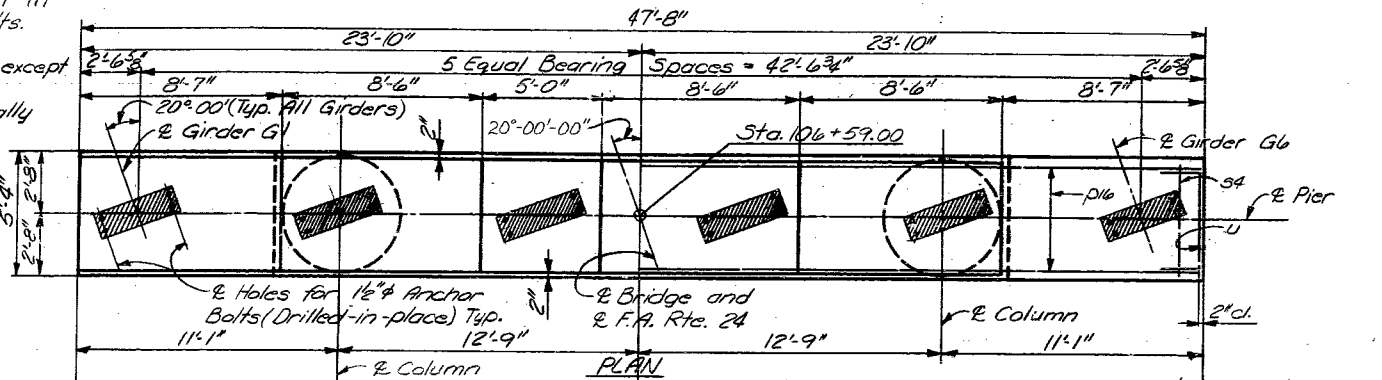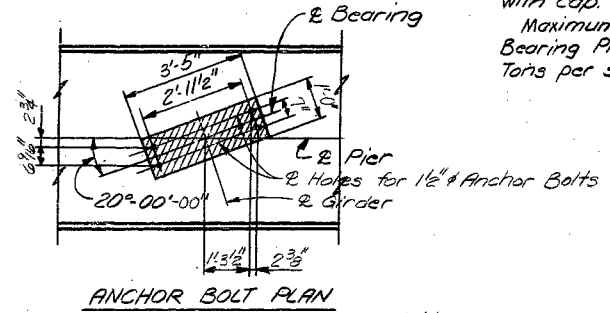

SECTION B-B  
Note: Spacing of 1/2 bars is measured along inside face of bar sp11.





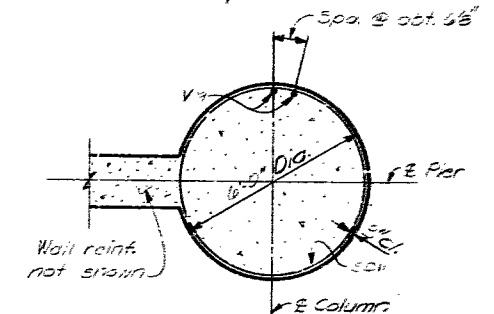


SECTION D-D  
Note: Spacing of 1/4 bars is measured along inside face of bar sp11.

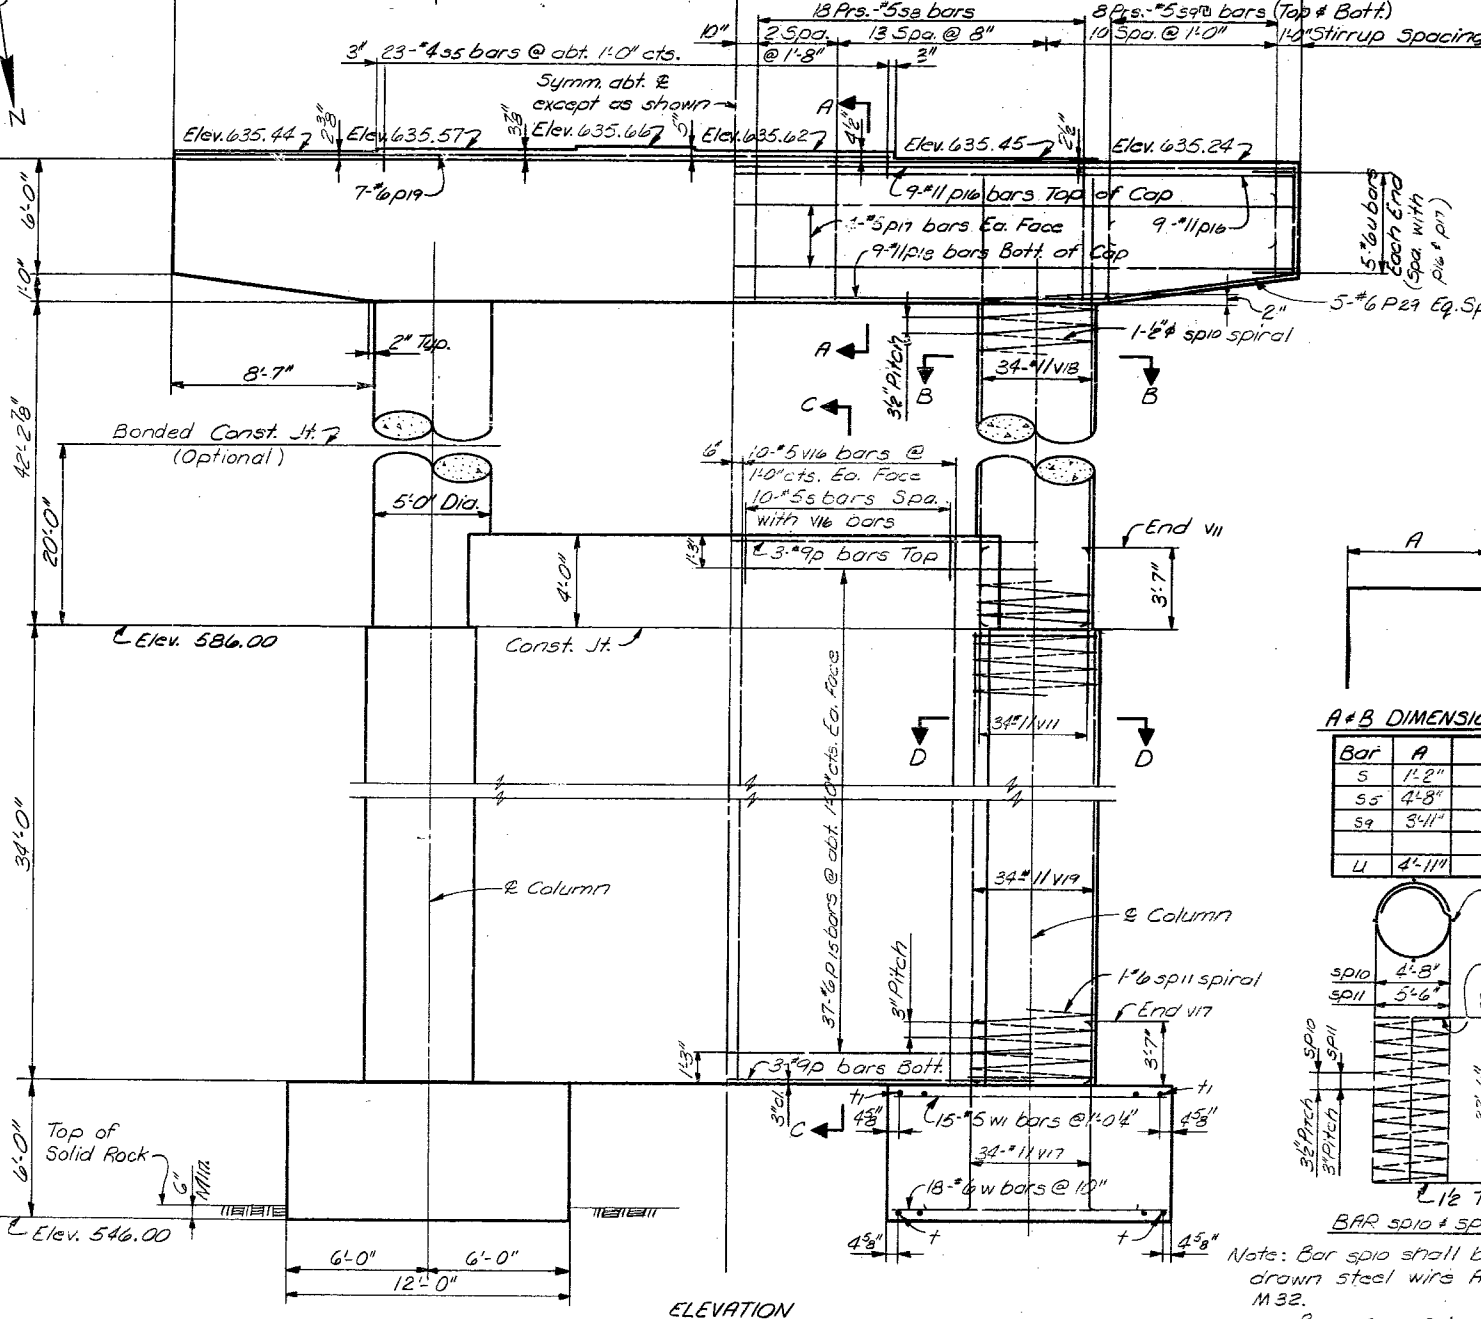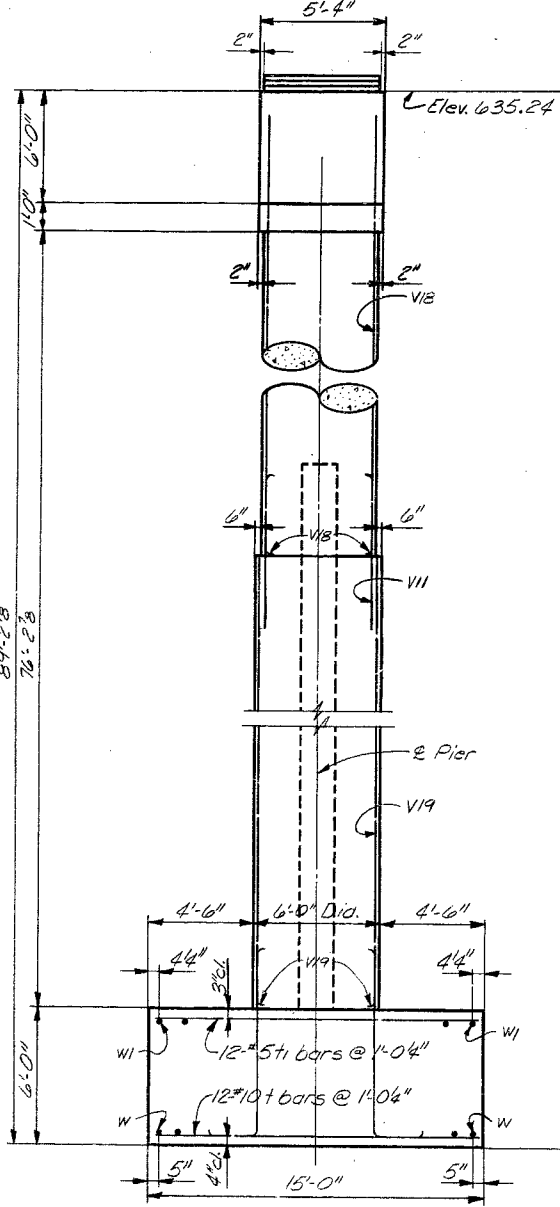

A & B DIMENSIONS

Bar	A	B
5	1'-2"	2'-0"
55	4'-8"	1'-6"
59	3'-11"	3'-11"
U	4'-11"	1'-6"

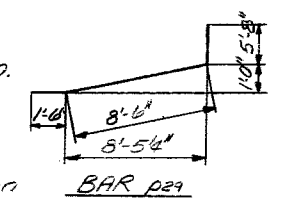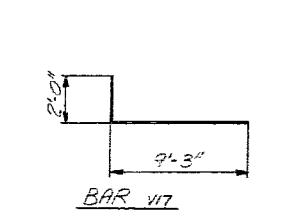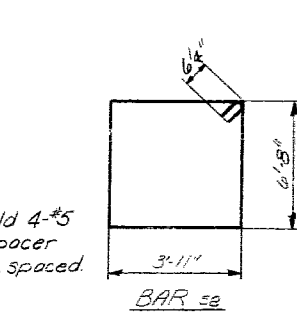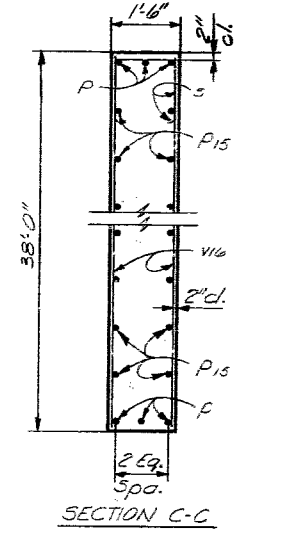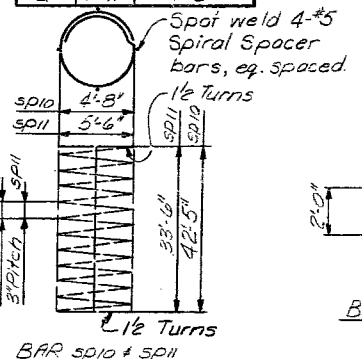

Note: Bar sp10 shall be cold drawn steel wire A.A.S.H.T.O. M32.  
Bar sp10 and sp11 may be spliced, cap bar 1/2 additional turns at splice. Pay weight to be based on length shown on plans.  
Cost of spiral spaces to be included in pay weight of spirals.

PIER 2  
BILL OF MATERIAL

Bar	No.	Size	Length	Spaced
P	6	#9	25'-6"	
P5	74	#6	25'-6"	
P10	18	#1	47'-4"	
P7	8	#5	47'-4"	
P13	9	#1	30'-0"	
P17	7	#6	30'-0"	
P25	10	#6	15'-8"	
S	20	#5	5'-2"	
S17	23	#4	7'-8"	
S2	72	#5	22'-4"	
S9	64	#5	11'-9"	
sp10	2	#3	2156'-0"	WWW
sp11	2	#6	2340'-0"	WWW
T	24	#10	12'-6"	
+1	24	#5	12'-6"	
W	36	#6	11'-6"	
W1	30	#5	11'-6"	
U	10	#6	7'-11"	
V11	68	#11	7'-4"	
V16	40	#5	37'-8"	
V17	63	#11	11'-3"	
V18	63	#11	45'-3"	
V19	63	#11	33'-8"	
Class X Concrete	Cu. Yds.	320.6		
Reinforcement Bars	Lbs.	23,740		
Cofferdams	Each	1		
Rock Excavation for Structure	Cu. Yd.	7.0		

PIER 2  
F.A. ROUTE 24 (ILL. 23) OVER  
VERMILION RIVER AND THE ARCHISON  
TOPEKA & SANTA FE RAILROAD  
F.A. RT. 24 SEC. (37,101) BVE  
LIVINGSTON COUNTY  
STATION 106+39





DESIGNED S. Yordy  
CHECKED G. Roufa,  
DRAWN J.O. Smith Jr.  
CHECKED G. J. Dee

Note: Do not scale this drawing. Follow dimensions.





STATE OF ILLINOIS  
DEPARTMENT OF TRANSPORTATION

ROUTE NO.	SECTION	COUNTY	SHEETS	SHEET NO.
S.B.I.	37101	LIVINGSTON	67	37A
F.A. 24	BYE	ILLINOIS FED. AID PROJECT		22 SHEETS

Note: Space reinforcement in cap to miss anchor bolts.  
All edges shall have standard 3/4" chamfers except as noted.  
Four steps monolithically with cap.  
Maximum Design Bearing Pressure = 8.5 Tons per sq. ft.

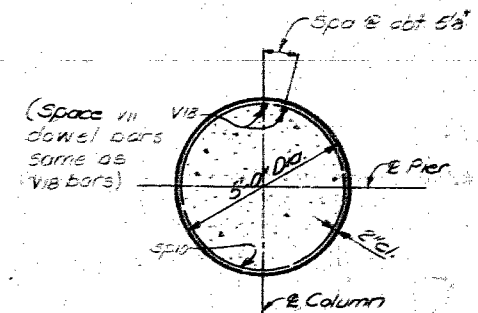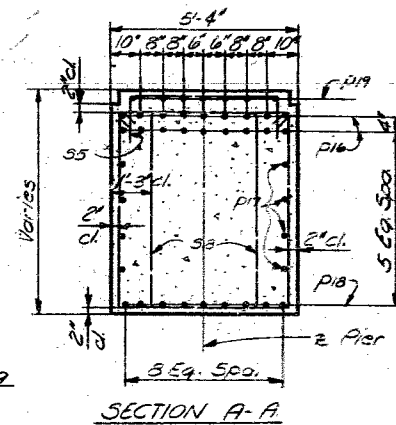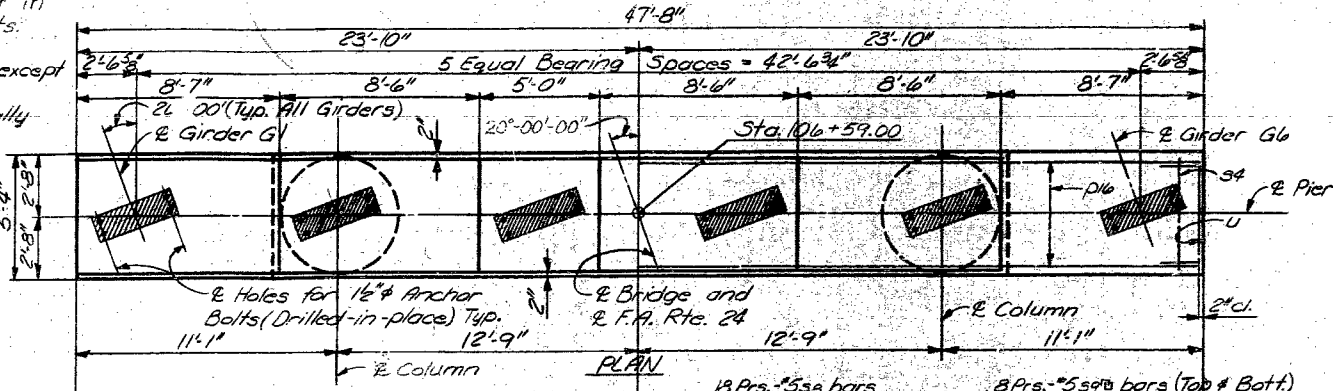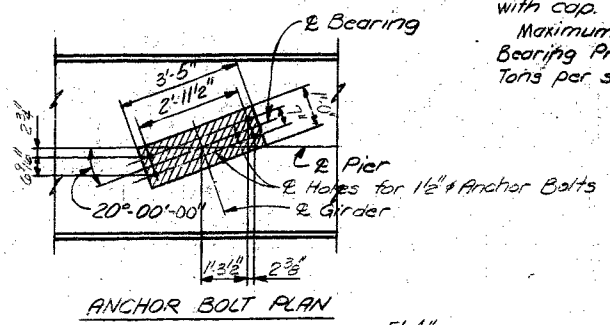


SECTION B-B  
Note: Spacing of 1/8 bars is measured along inside face of bar sp10.

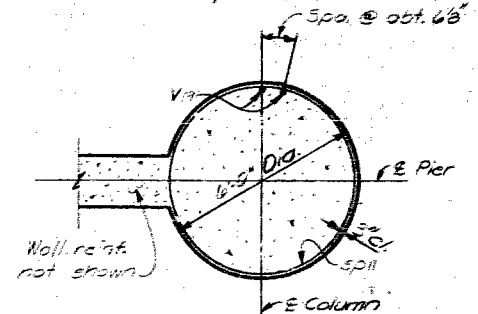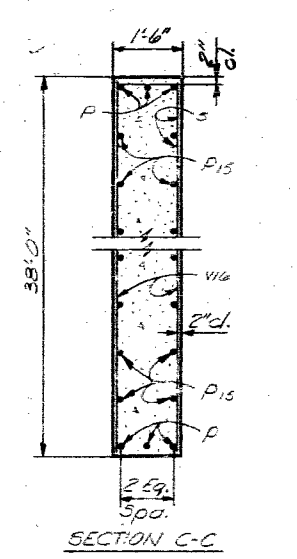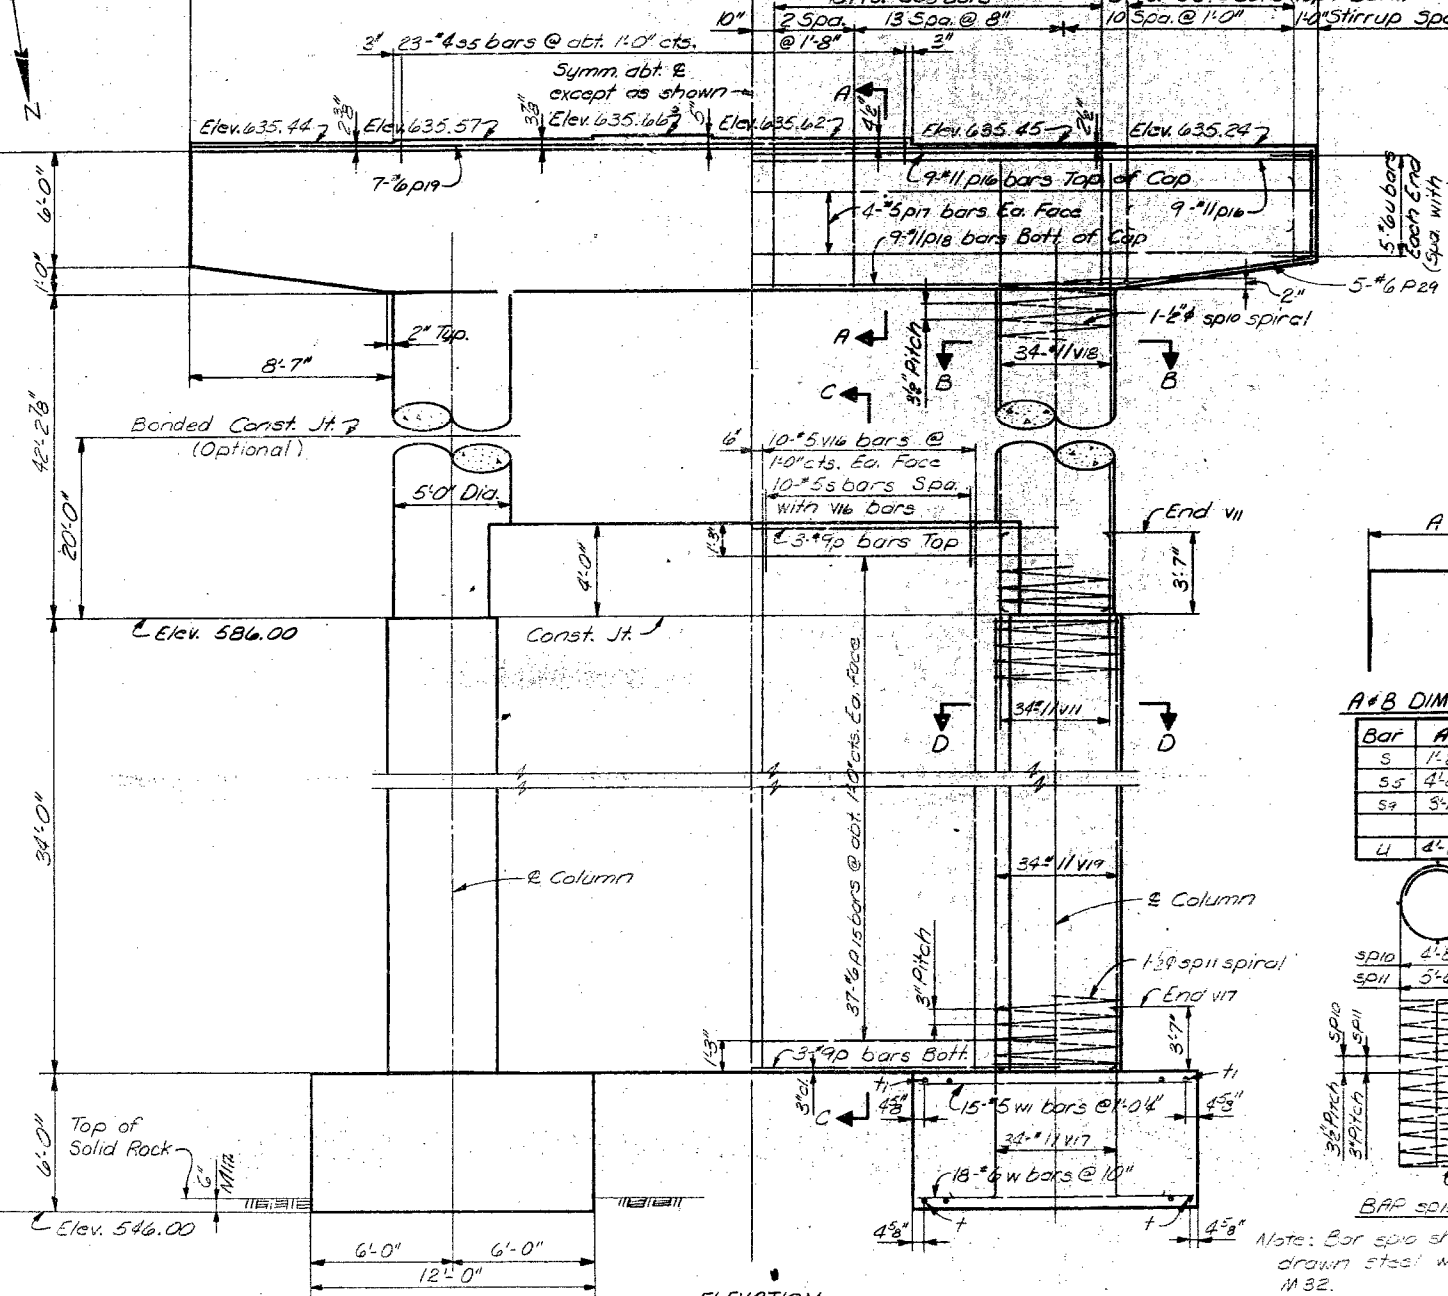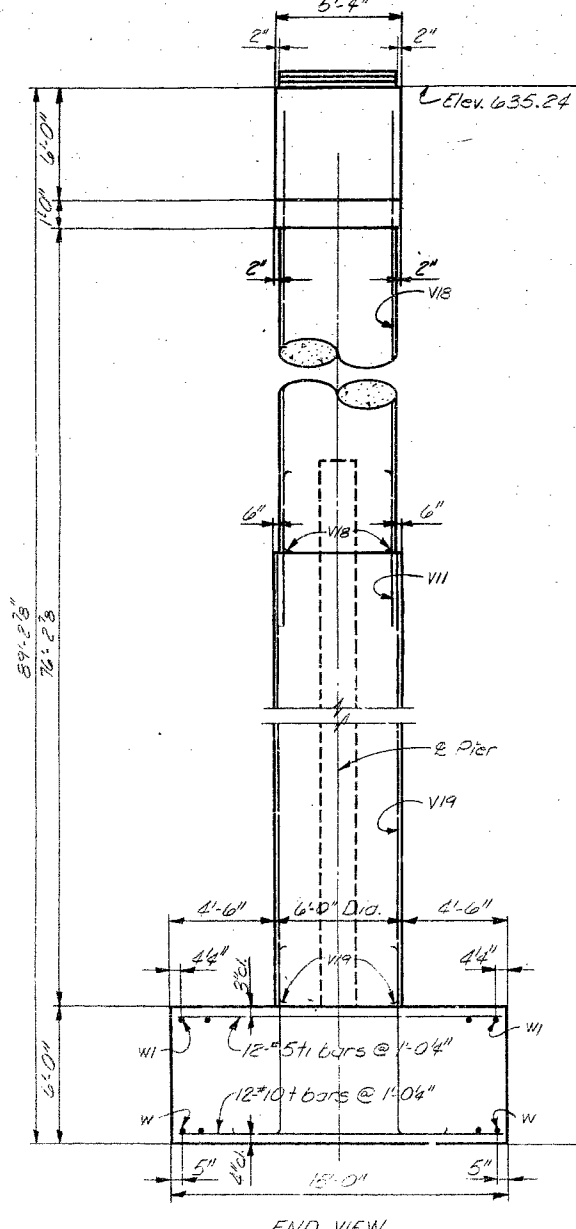

SECTION D-D  
Note: Spacing of 1/8 bars is measured along inside face of bar sp11.

A\*B DIMENSIONS

Bar	A	B
S	1'-2"	2'-0"
S5	4'-8"	1'-6"
S9	3'-11"	3'-11"
U	2'-11"	1'-6"

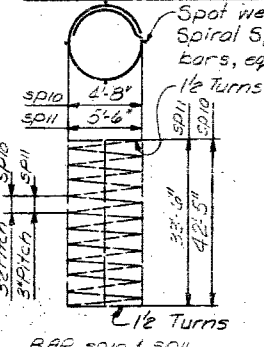

Note: Bar sp10 shall be cold drawn steel wire A.A.S.H.T.O. M32.  
Bar sp11 and sp12 may be spliced. Lap bar 1/2 additional turns of spiral. Pay weight to be based on length shown on plans.  
Cost of spiral spaces to be included in pay weight of spirals.

PIER 2  
BILL OF MATERIAL

Bar	No.	Size	Length	Spods
P	6	#9	25'-6"	
P15	74	#6	25'-6"	
P16	18	#11	47'-2"	
P17	8	#5	47'-2"	
P18	9	#11	30'-0"	
P19	7	#6	30'-0"	
P20	10	#6	15'-5"	
S	20	#5	5'-2"	
S5	23	#4	7'-8"	
S9	72	#5	22'-4"	
S9	62	#5	11'-9"	
sp10	2	1 1/2"	815'-0"	WNM
sp11	2	1 1/2"	2340'-6"	WNM
T	24	#10	14'-0"	
T1	24	#8	14'-0"	
W	36	#6	11'-0"	
W1	30	#5	11'-0"	
U	10	#6	7'-11"	
V11	43	#11	7'-4"	
V16	40	#5	37'-8"	
V17	43	#11	11'-3"	
V18	38	#11	18'-3"	
V19	45	#11	33'-3"	
Class: Concrete				Cu. Yds. 320.6
Reinforcement Bars				Lbs. 23,740
Cofferdams				Each 1
Rock Excavation for Structure				Cu. Yds. 7.0

PIER 2  
F.A. ROUTE 24 (ILL. 23) OVER  
VERMILION RIVER AND THE ARCHISON  
TOPEKA & SANTA FE RAILROAD  
F.A. RT. 24 SEC. (37.101) BYE  
LIVINGSTON COUNTY  
STATION 106+59

DESIGNED S. Yordy  
CHECKED G. Rosta  
DRAWN J.O. Smith Jr.  
CHECKED G. J. Doe

AS REVISED

Note: Do not scale this drawing. Follow dimensions.

3291  
755500









As Revised 1/16/71 L.W.

STATE OF ILLINOIS  
DEPARTMENT OF TRANSPORTATION

ROUTE NO. SECTION	COUNTY	TOTAL SHEETS	SHEET NO.
S.B.I. 37,101	LIVINGSTON	67	38
F.A. 24	ILLINOIS FED. AID PROJECT		

SHEET NO. 20  
22 SHEETS

Note: Space reinforcement in cap to miss anchor bolts. All edges shall have standard 3/4" chamfers except as noted. Four steps monolithically with cap. Maximum Design Bearing Pressure = 9.1 Tons per sq. ft.

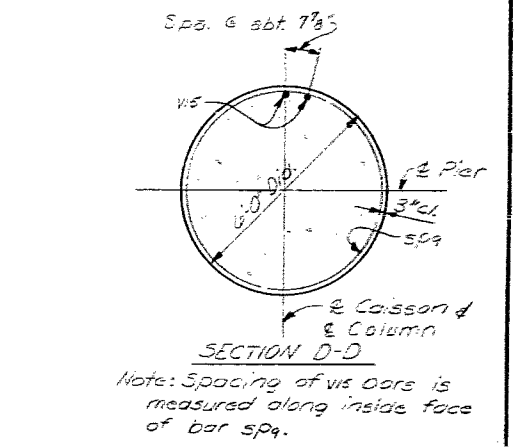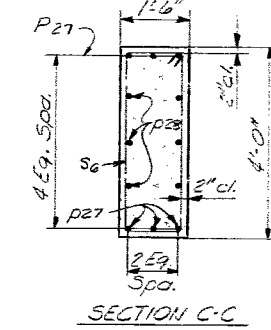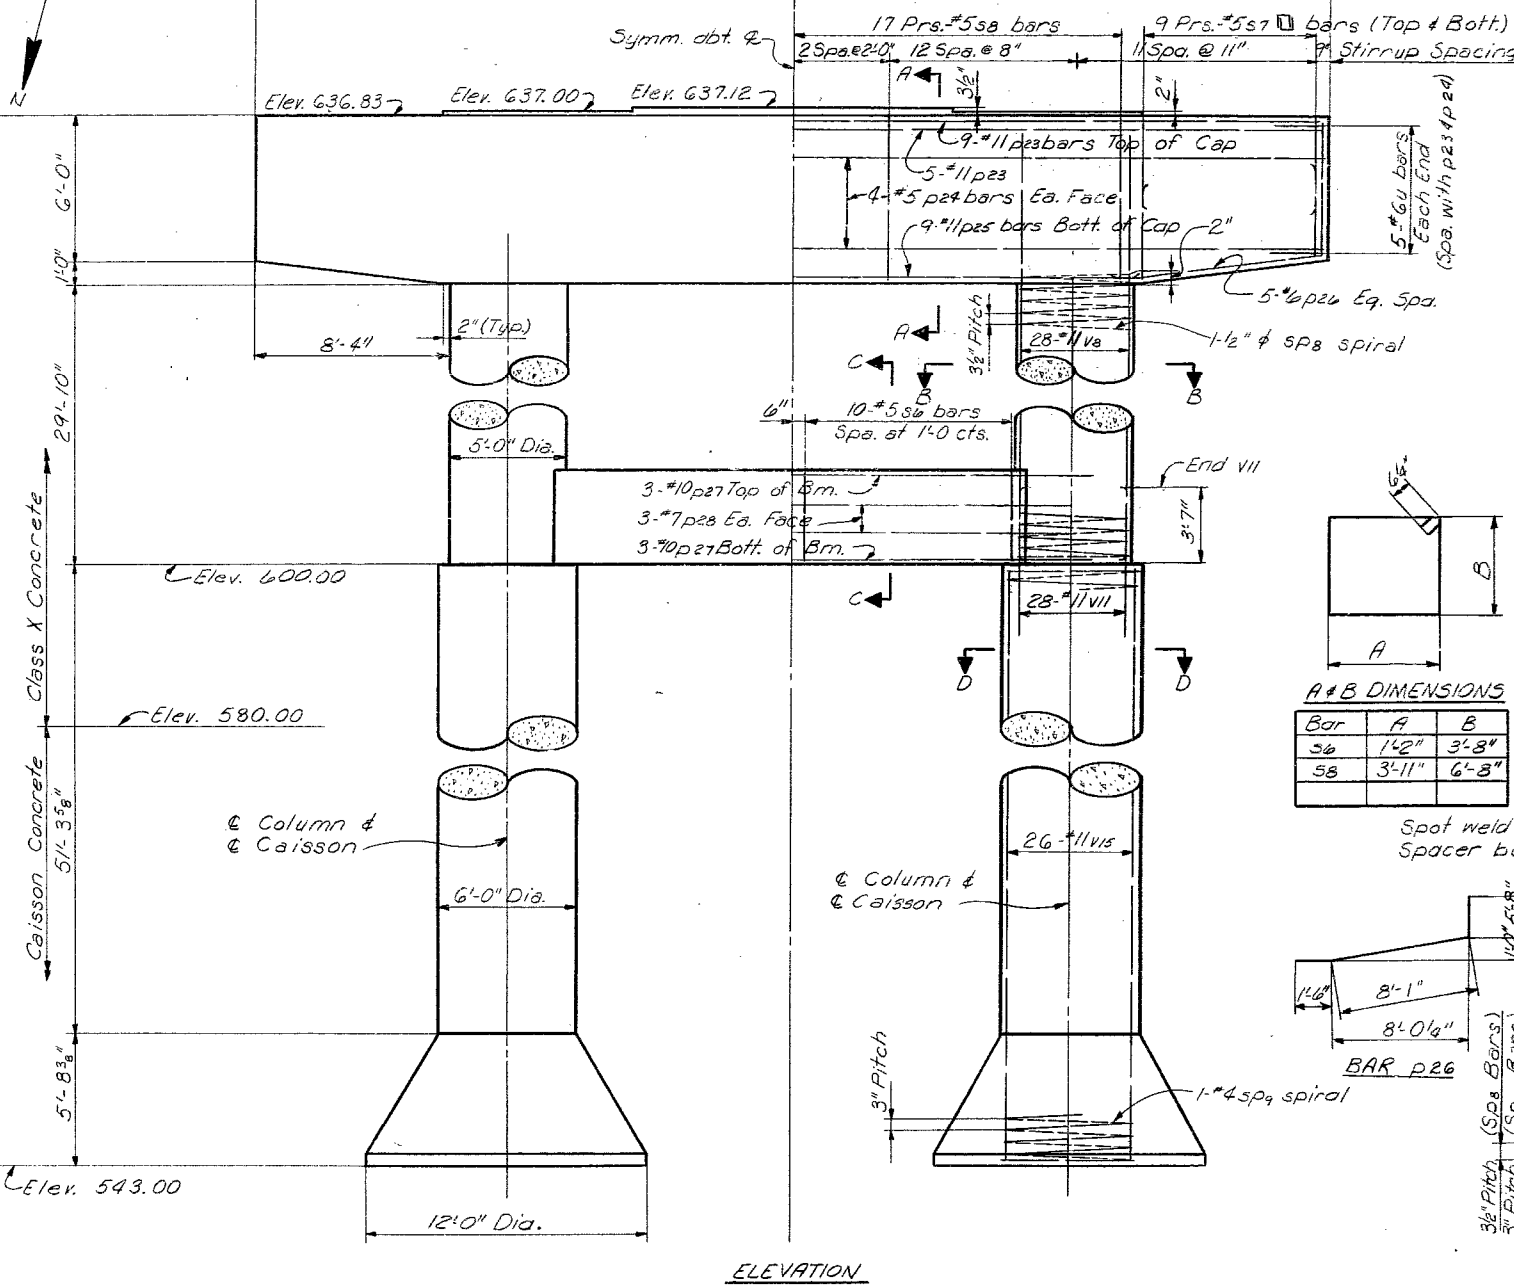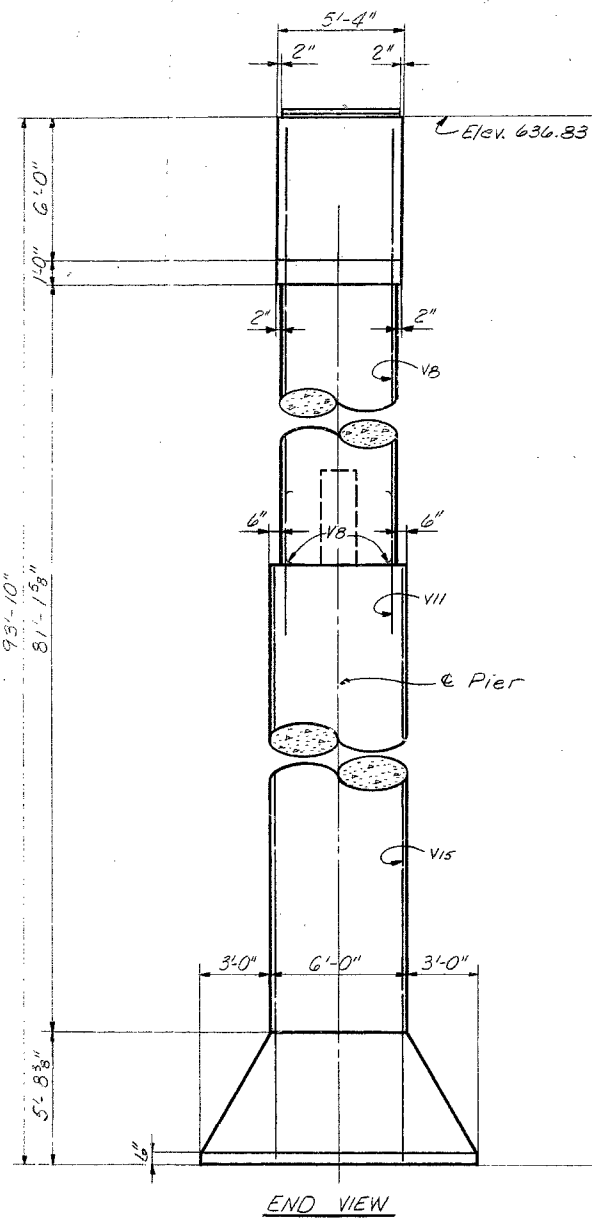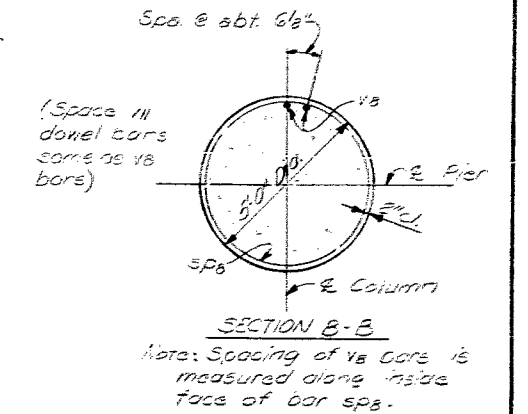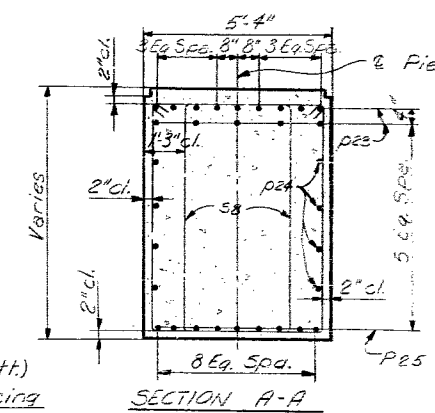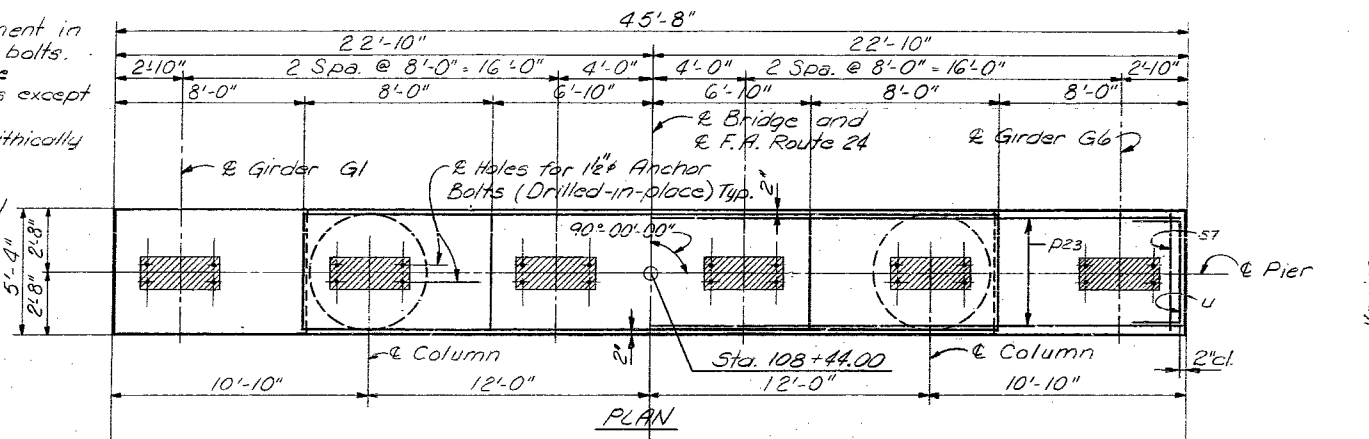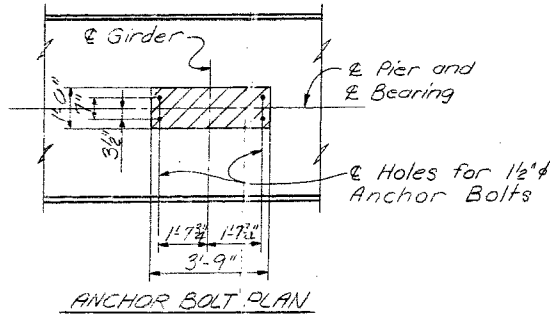


A x B DIMENSIONS

Bar	A	B
s6	1'-2"	3'-3"
s8	3'-11"	6'-8"

A x B DIMENSIONS

Bar	A	B
s7	3'-11"	4'-0"
u	4'-11"	1'-6"

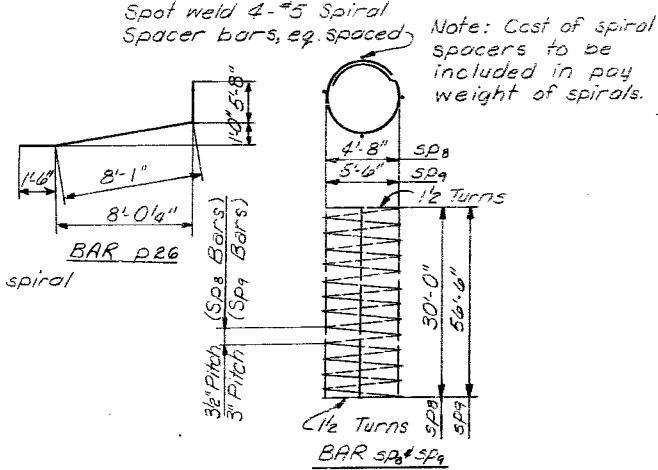

PIER 3  
BILL OF MATERIAL

Bar	No.	Size	Length	Shape
p23	14	#11	25'-4"	—
p24	8	#5	45'-4"	—
p25	9	#11	29'-4"	—
p26	10	#6	15'-3"	—
p27	6	#10	25'-6"	—
p28	6	#7	25'-6"	—
s6	20	#5	10'-10"	□
s7	72	#5	11'-11"	□
s8	66	#5	22'-4"	□
sp8	2	1/2"	1538'-3"	—
sp9	2	#4	3927'-3"	—
u	10	#6	7'-11"	□
v8	56	#11	36'-0"	—
v7	56	#11	7'-4"	—
v15	52	#11	56'-6"	—
Class X Concrete				Cu. Yds. 152.3
Caisson Concrete				Cu. Yds. 95.1
Reinforcement Bars				Lbs. 24,060

\* Bar included in cost of Caisson Concrete.

DESIGNED	S. Yordy
CHECKED	G. Roufa
DRAWN	D. Richardson
CHECKED	G. Dee

Note: Do not scale this drawing. Follow dimensions.

Note: Bar sp8 shall be cold drawn steel wire A.A.S.H.T.O. M32. Bar sp8 and sp9 may be spliced. Lap bar 1/2 additional turns at splice. Pay weight to be based on length shown on plans.





PIER 3  
F.A. ROUTE 24 (ILL. 23) OVER  
VERMILION RIVER AND THE FITCHSON  
TOPERA & SANTA FE RAILROAD  
F.A. RT. 24 SEC. (37,101) B.V.B.  
LIVINGSTON COUNTY  
STATION 106+39

STATE OF ILLINOIS  
DEPARTMENT OF TRANSPORTATION





ROUTE NO.	SECTION	COUNTY	TOTAL SHEETS	SHEET NO.
S.B.I. 24	EVB	LIVINGSTON	67	39
FED. ROAD DIST. NO. 7	ILLINOIS	FED. AID PROJECT		

SHEET NO. 21  
22 SHEETS

Note: Space reinforcement in cap to miss anchor bolts.  
All edges shall have standard 3/4" chamfers except as noted.  
Pour steps monolithically with cap.  
Maximum Design Bearing Pressure = 10.0 Tons per sq. ft.

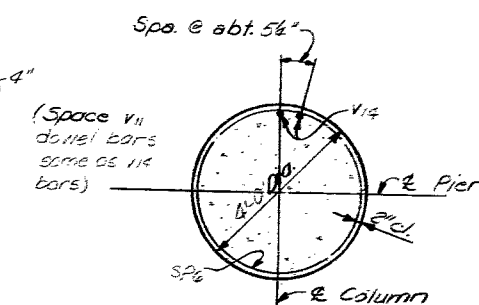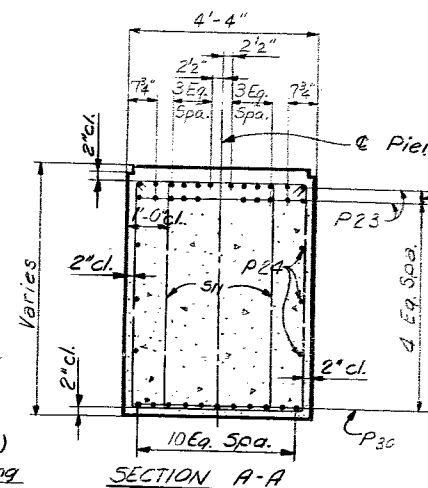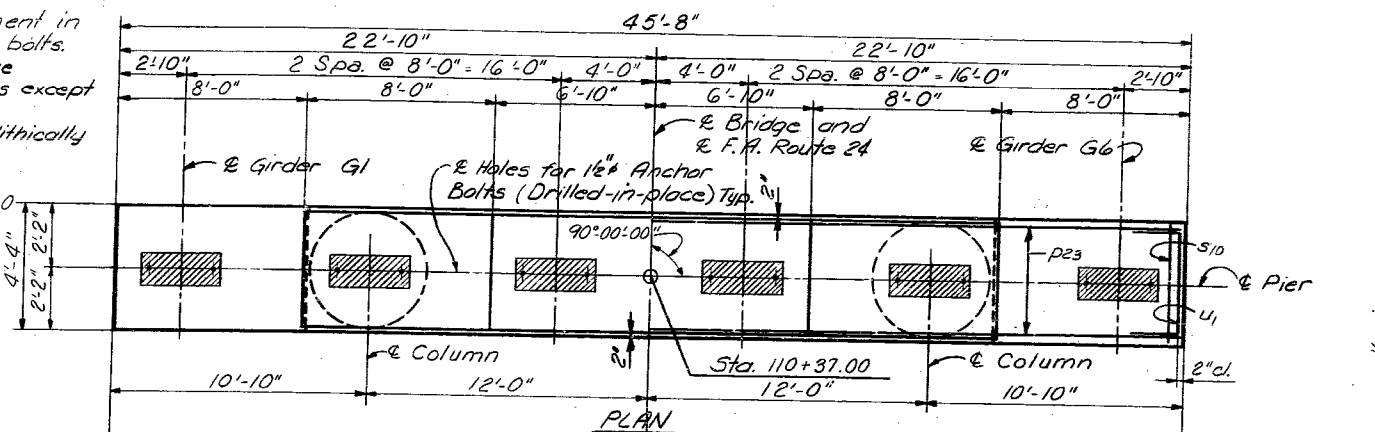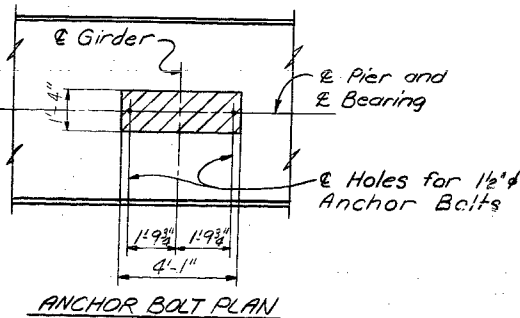

Note: Spacing of V14 bars is measured along inside face of bar SP6.

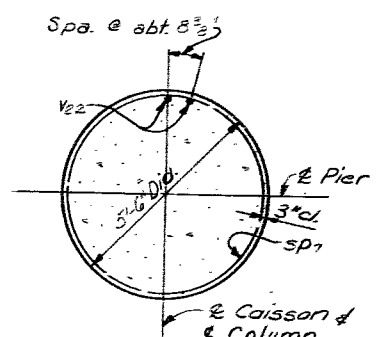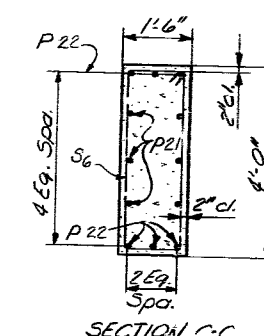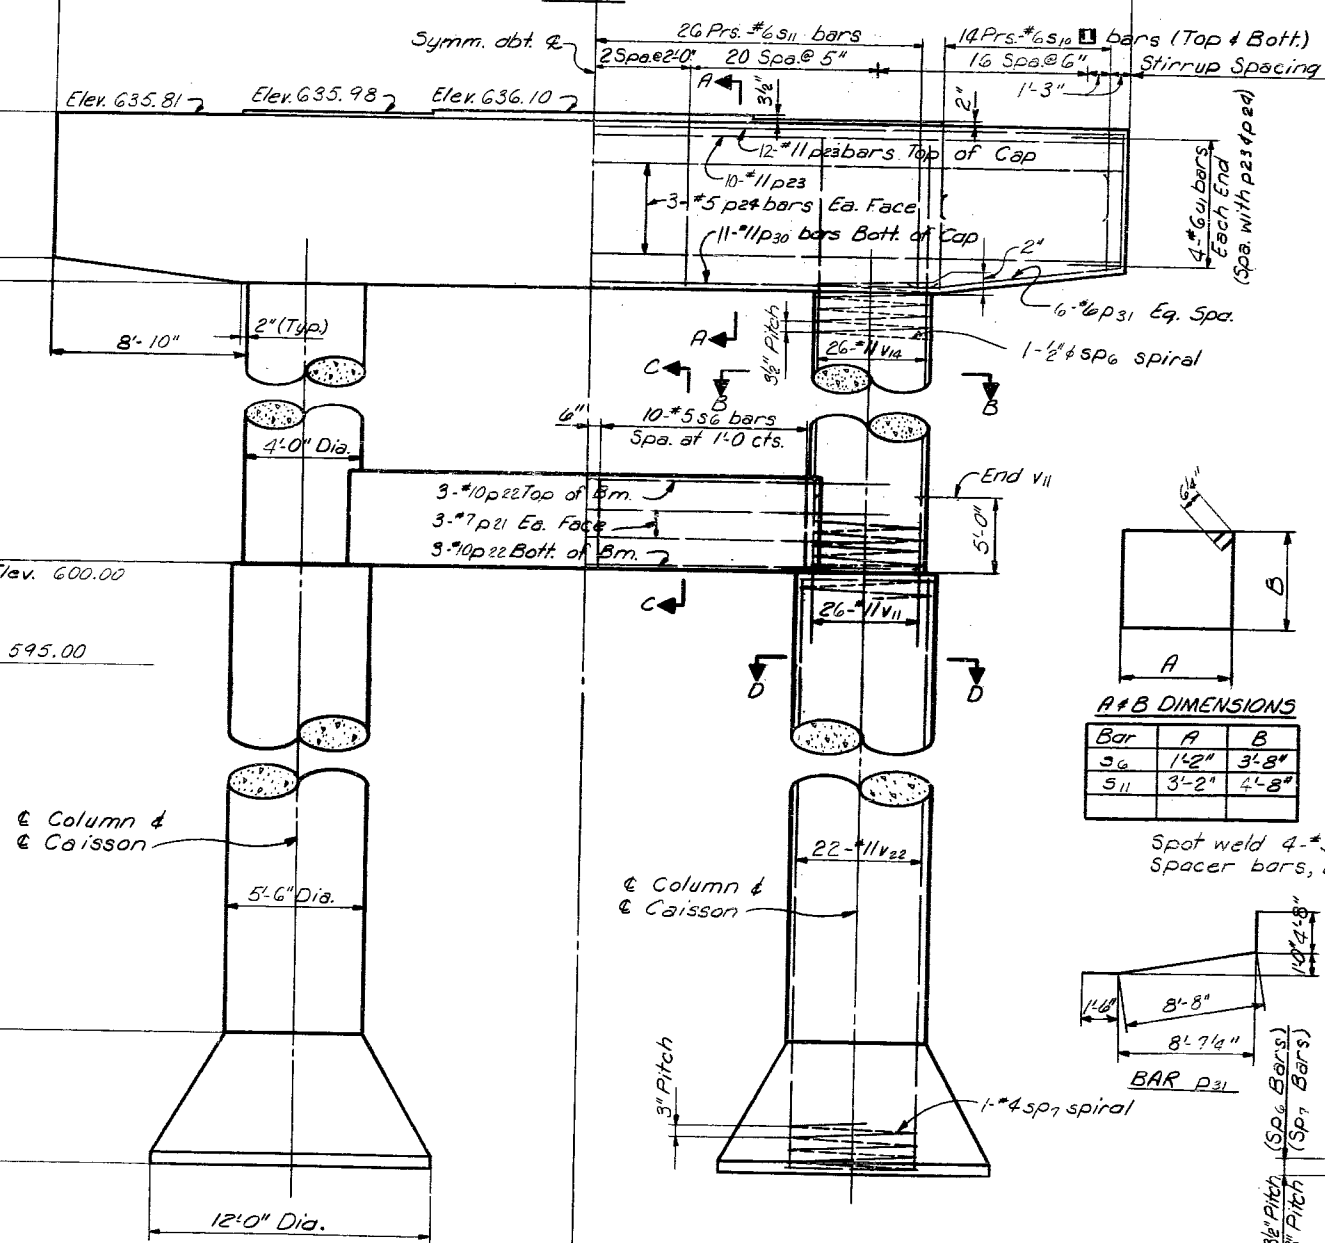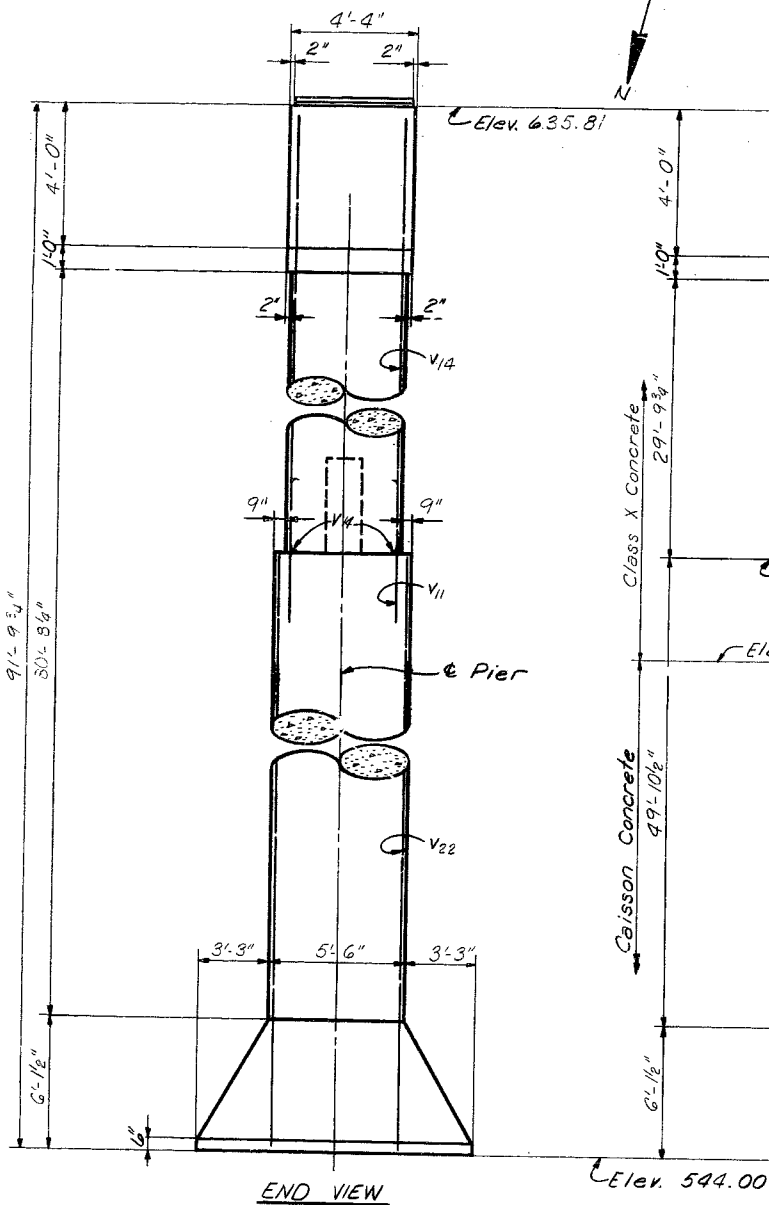


Note: Spacing of V22 bars is measured along inside face of bar SP7.

PIER 4  
BILL OF MATERIAL

Bar	No.	Size	Length	Shape
P21	6	#7	25'-6"	—
P22	6	#10	27'-0"	—
P23	22	#11	45'-4"	—
P24	6	#5	45'-4"	—
P25	11	#11	28'-4"	—
P30	12	#6	14'-0"	—
SG	20	#5	10'-10"	□
S10	112	#6	9'-2"	□
S11	102	#6	16'-10"	□
SP6	2	1/2 #4	1,205'-9"	—
SP7	2	#4	3,505'-3"	—
U1	8	#6	6'-11"	□
V14	52	#11	7'-4"	—
V18	52	#11	35'-0"	—
V22	44	#11	53'-6"	—

Class X Concrete Cu. Yds. 77.2  
Caisson Concrete Cu. Yds. 109.4  
Reinforcement Bars Lbs. 26,640

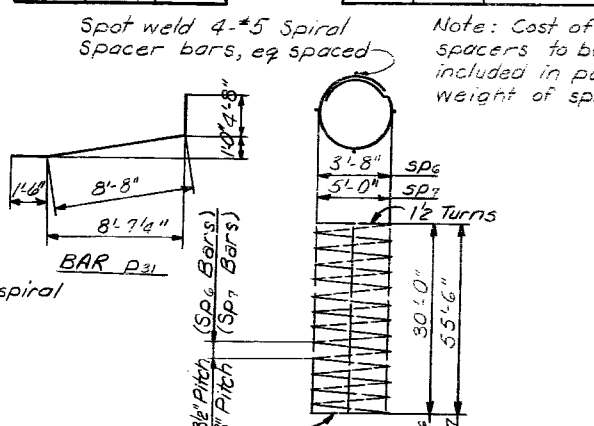



NOTES  
All reinforcing steel shall conform to A.S.T.M. A615 Grade 40, except column bars V14 & V18 shall conform to A.S.T.M. A615, Grade 60.  
Note: Bar SP6 shall be cold drawn steel wire A.A.S.H.T.O. M32.  
Bar SP6 and SP7 may be spliced. Lap bar 1/2 additional turns at splice. Pay weight to be based on length shown on plans.

DESIGNED S. Vordy  
CHECKED G. Rofa  
DRAWN D. Richardson  
CHECKED G. Oee


Note: Do not scale this drawing. Follow dimensions.

STATE OF ILLINOIS  
DEPARTMENT OF TRANSPORTATION

ROUTE NO.	SECTION	COUNTY	TOTAL SHEETS	SHEET NO.	SHEET NO. 22 22 SHEETS
24	37.101 BVB	LIVINGSTON	67	40	
FED. ROAD DIST. NO. 7		PLANING	FED. AID PROJECT		

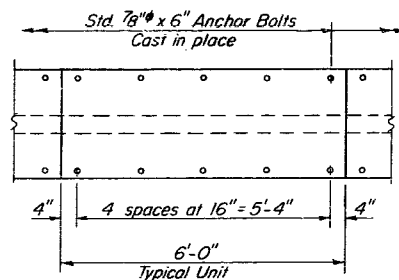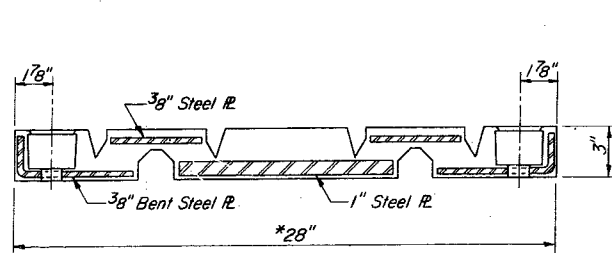

PLAN


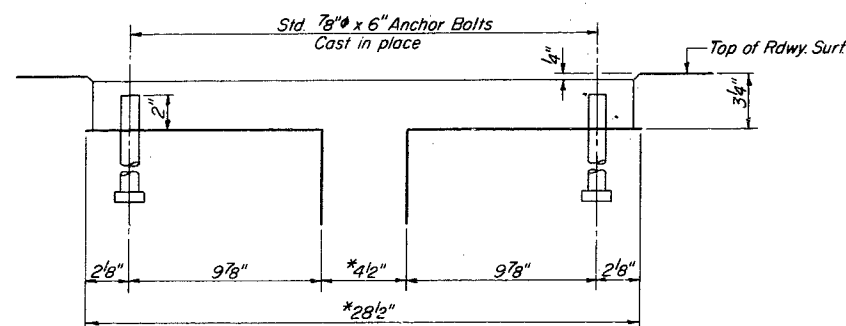


CROSS SECTION


\*At 50° F  
Dimensions are at right angles.

**TRANSFLEX MODEL 650**  
(Structural Rubber Products Co.)

Note: Anchor bolts require a clipped washer, lockwasher and hex nut.

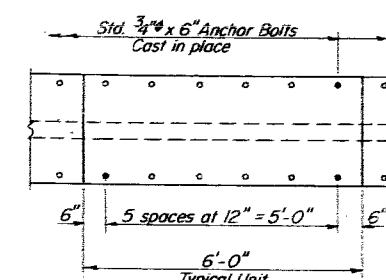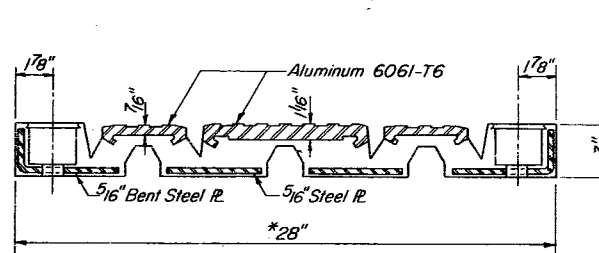

PLAN

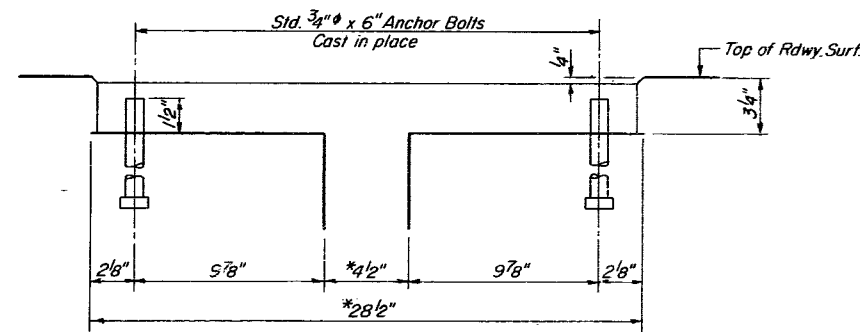


CROSS SECTION


\*At 50° F  
Dimensions are at right angles.

Note: Anchor bolts require a clipped washer, lockwasher and hex nut.

**WABOFLEX MODEL SR 6.5**  
(Watson-Bowman Associates Inc.)

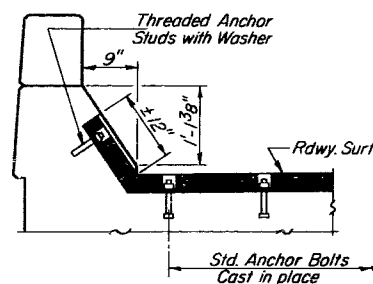

AT CURB

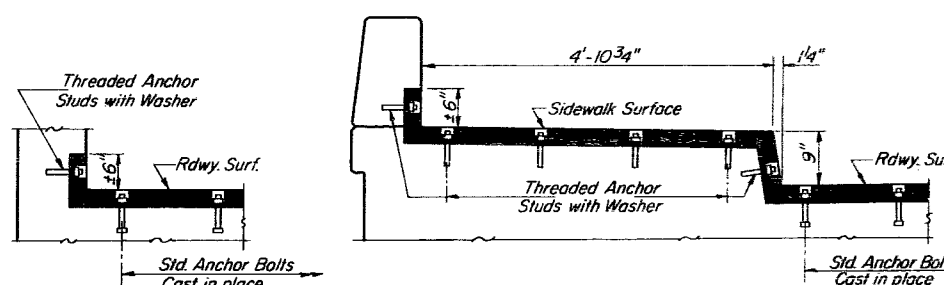

AT ABUTMENT

AT SIDEWALK


TYPICAL END TREATMENTS

NOTE:  
Joint openings shall be adjusted in accordance with Article 503.07 (c) of the Std. Spec's. when the deck is poured at an ambient temperature other than 50° F.

**NEOPRENE EXPANSION JOINTS (6 1/2")**  
FOR EXPANSION LENGTH OF DECK = 320 ft. to 520 ft.


F.A. ROUTE 24 (ILL. 23) OVER  
VERMILION RIVER AND THE ATCHISON  
TOPEKA & SANTA FE RAILROAD  
F.A. RT. 24 SEC. (37.101) BVB  
LIVINGSTON COUNTY  
STATION 106+39

DESIGNED	_____
CHECKED	_____
DRAWN	_____
CHECKED	_____

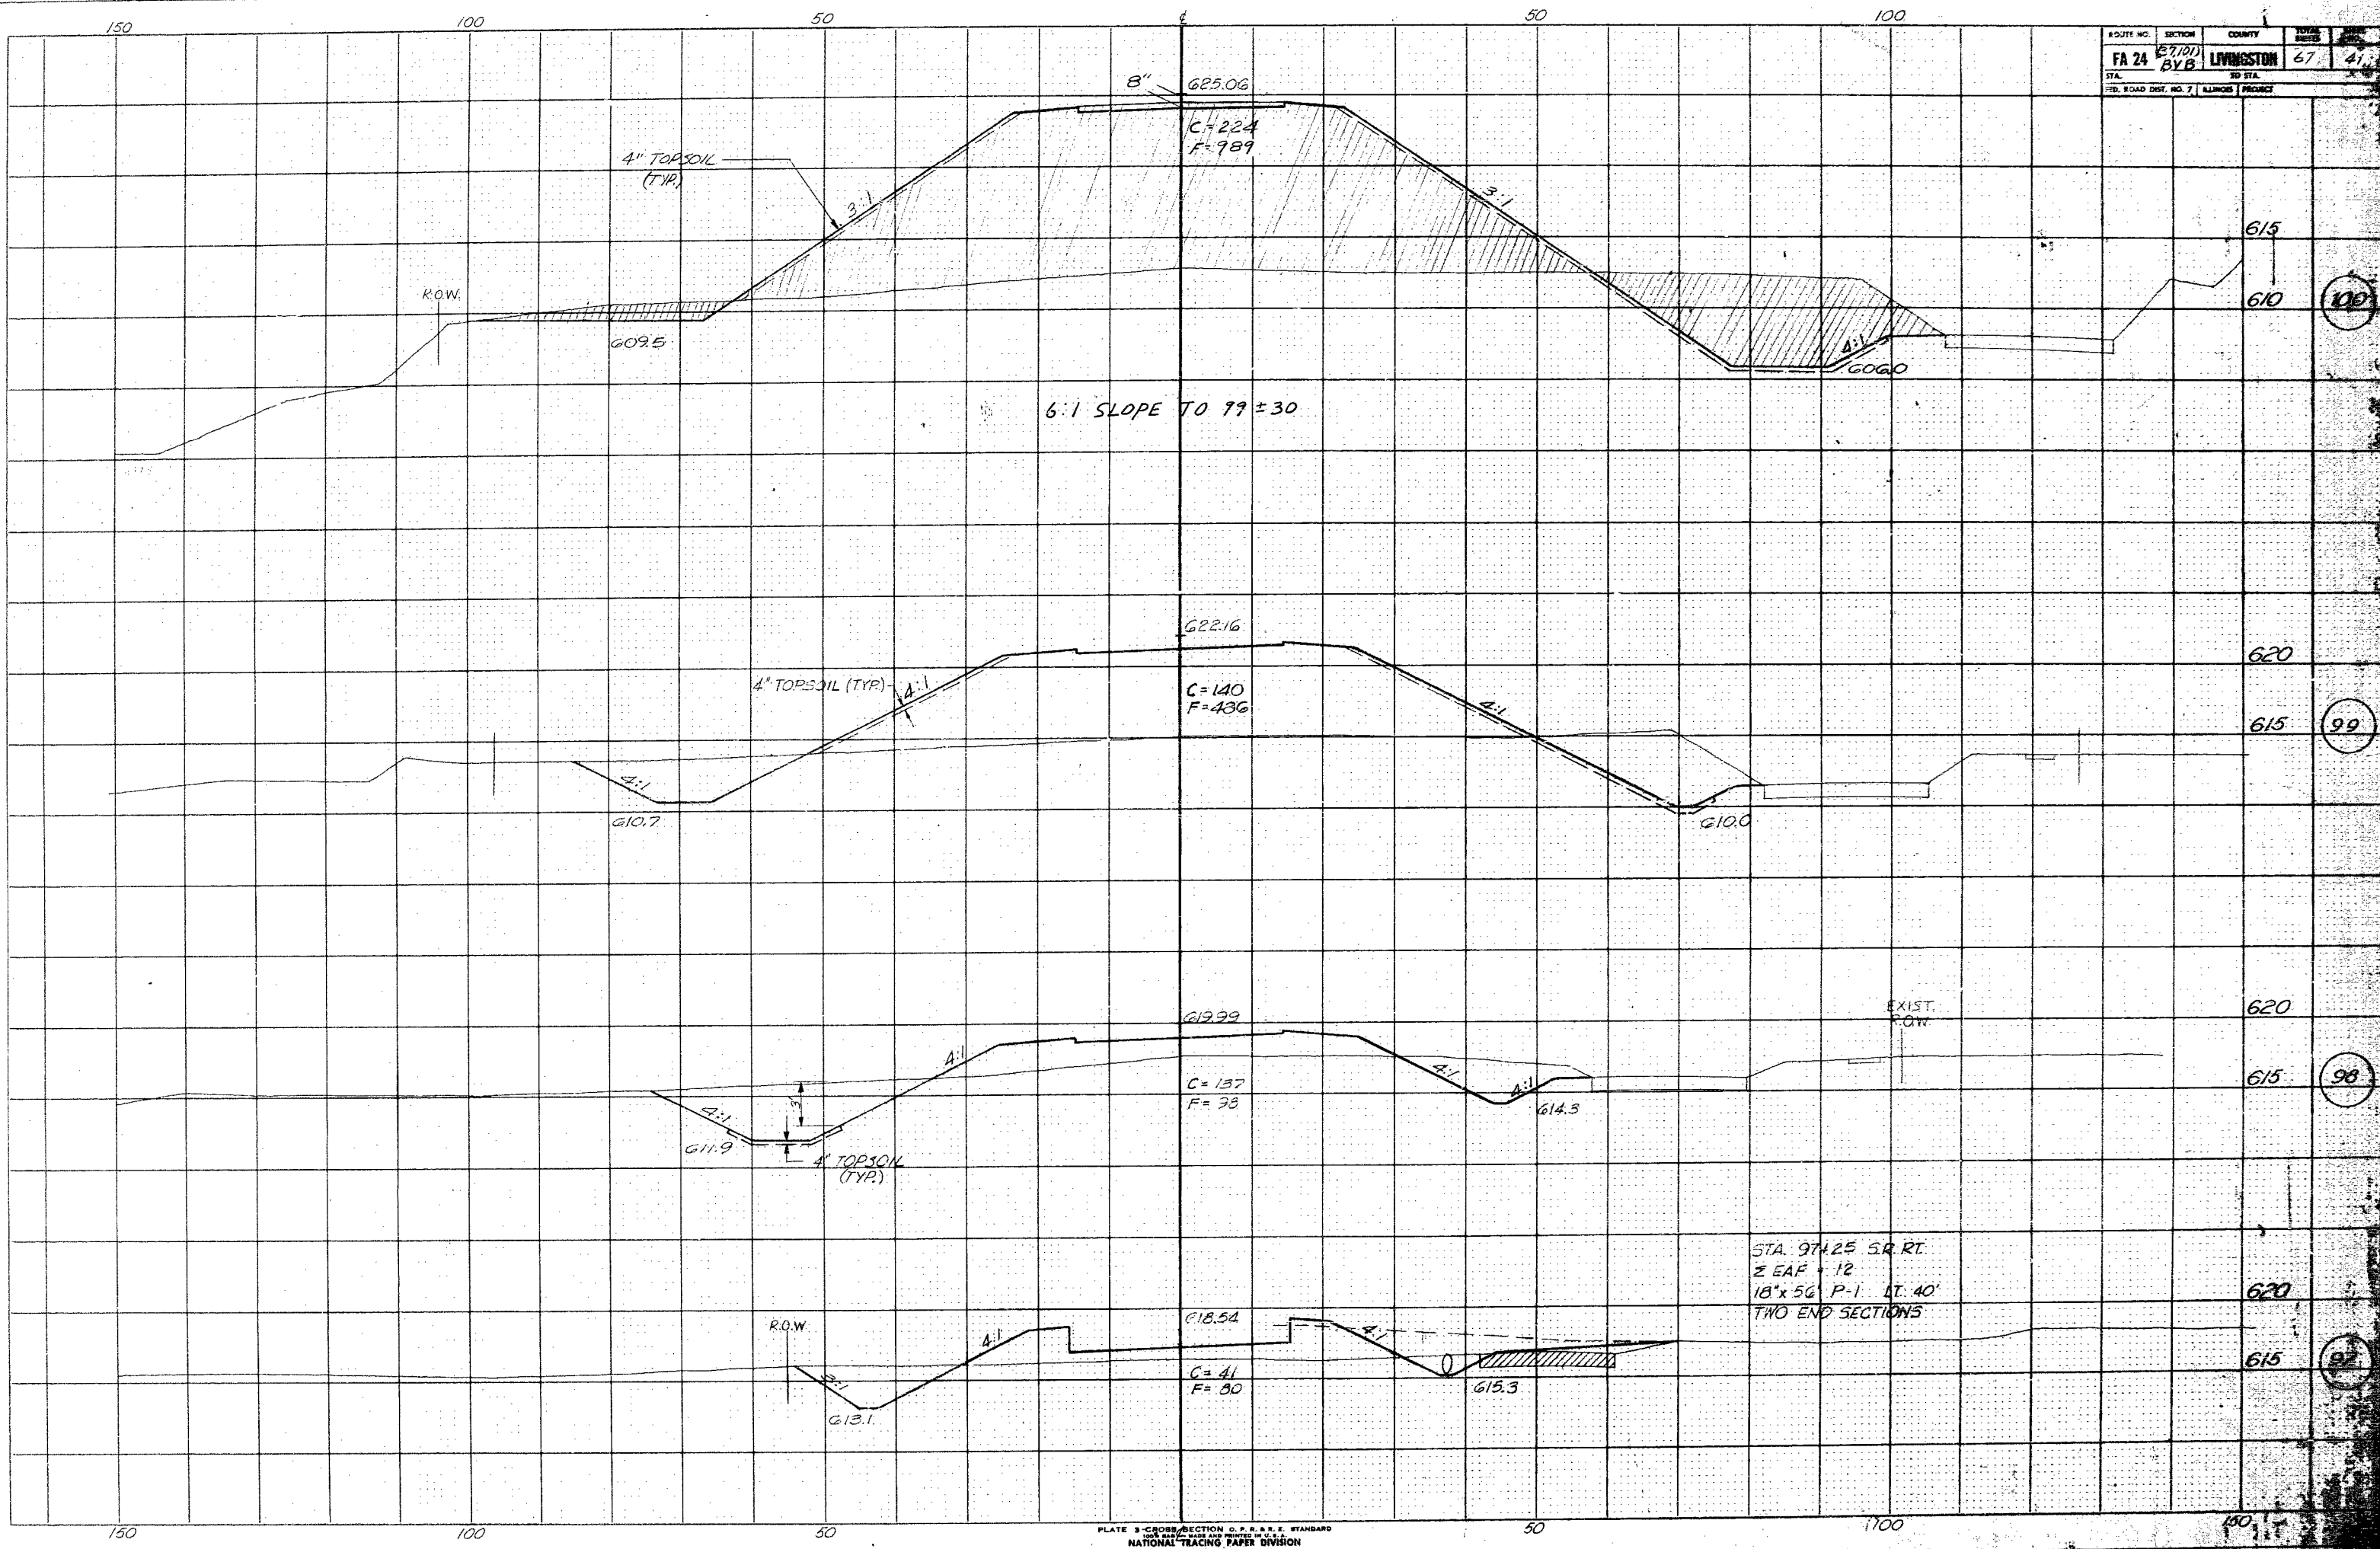


FINAL SURVEY  
 DATE  
 BY  
 CHECKED  
 APPROVED  
 PLOTTED  
 TEMPLATE  
 AREAS  
 NOTE BOOK  
 NO.

ORIGINAL SURVEY  
 DATE  
 BY  
 CHECKED  
 APPROVED  
 PLOTTED  
 TEMPLATE  
 AREAS  
 NOTE BOOK  
 NO.

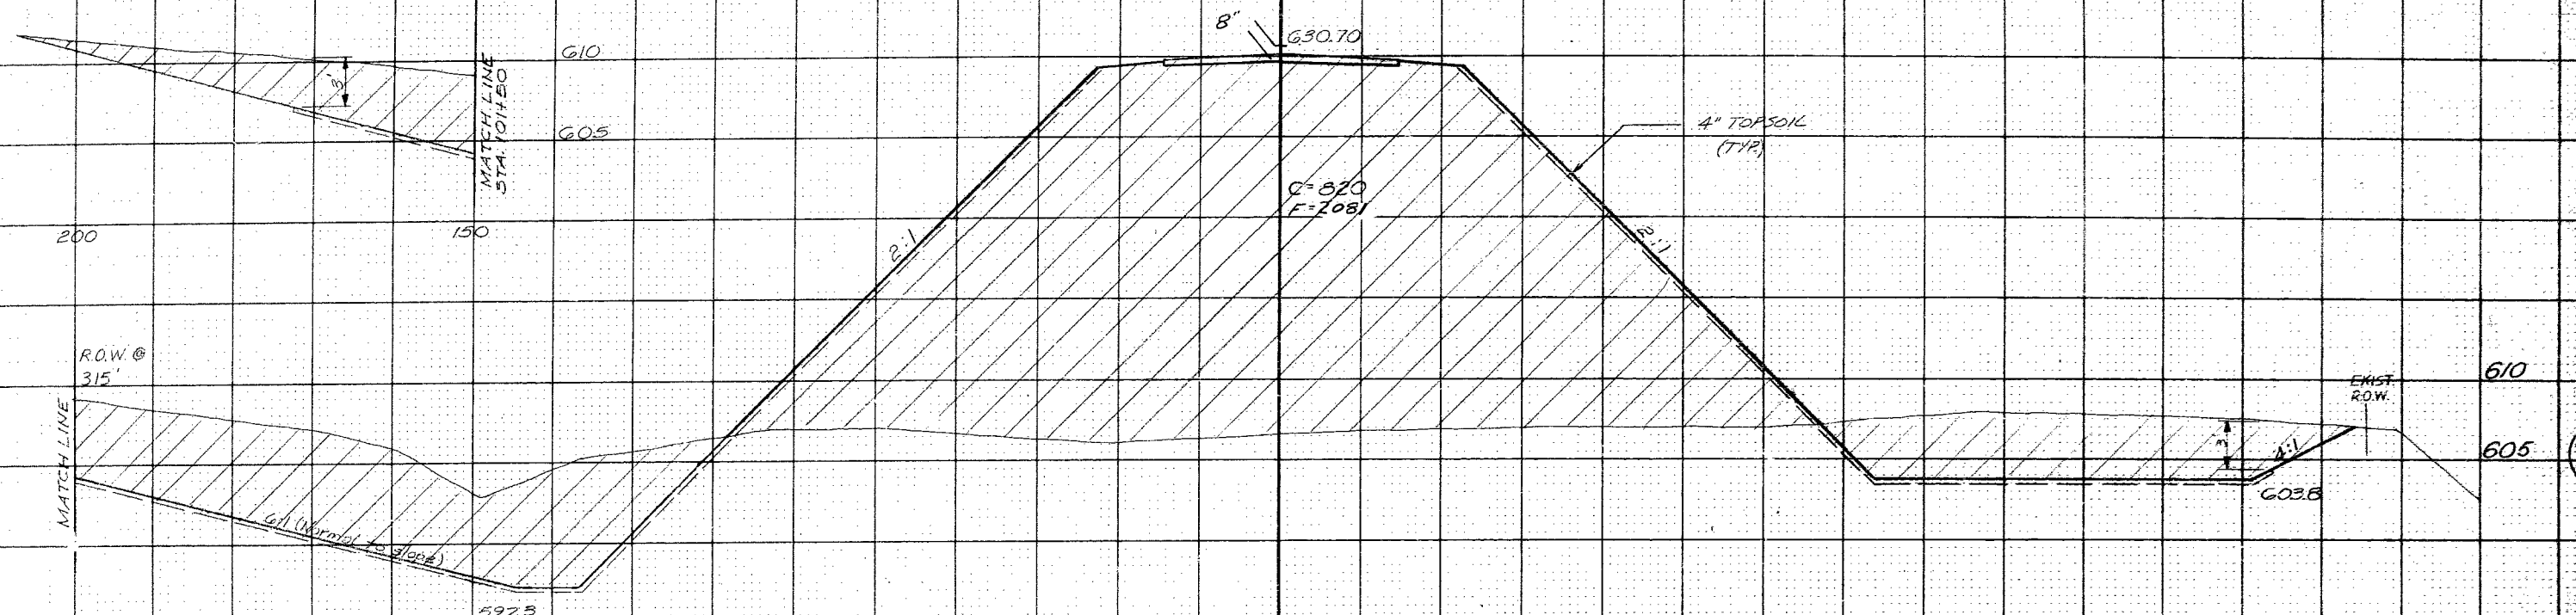


STA. 100+50 LT. + RT.  
 BY OTHERS  
 (2) INLET SPECIAL  
 45' S5T1-12"  
 54' PIPE DRAINS  
 1 END SECTION 12"

2' MIN. COVER

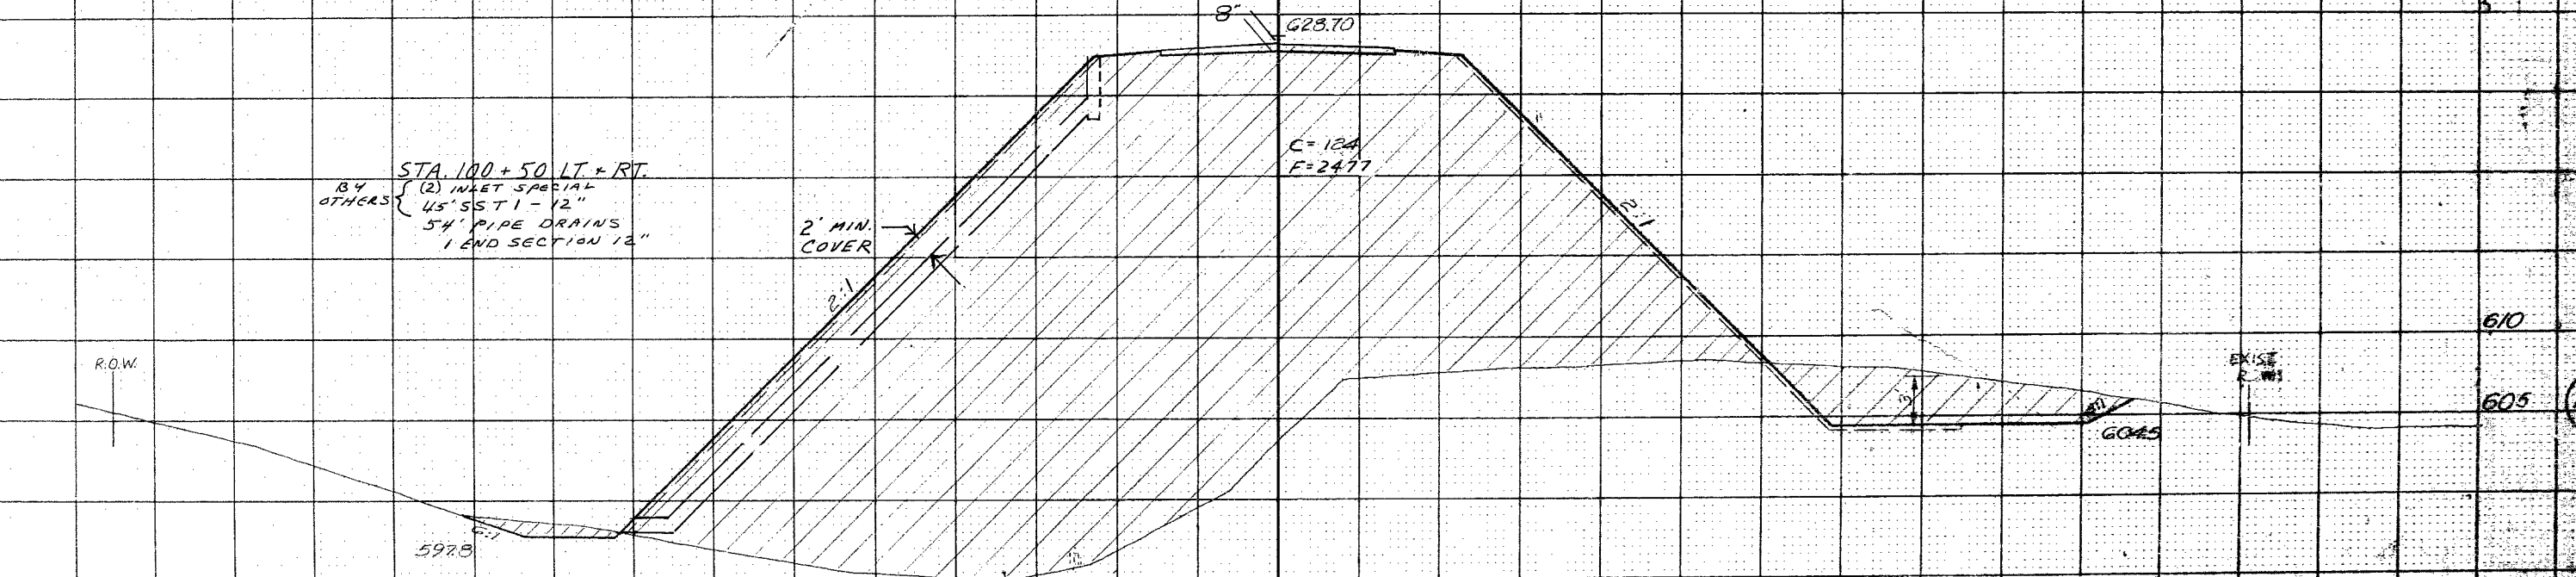

ROUTE NO.	SECTION	COUNTY	TOTAL SHEETS	SHEET NO.
FA 24	81B	LIVINGSTON	67	43
STA.	TO STA.			
178.5	605			
FD. ROAD DIST. NO. 7   ELMOND PROJECT				

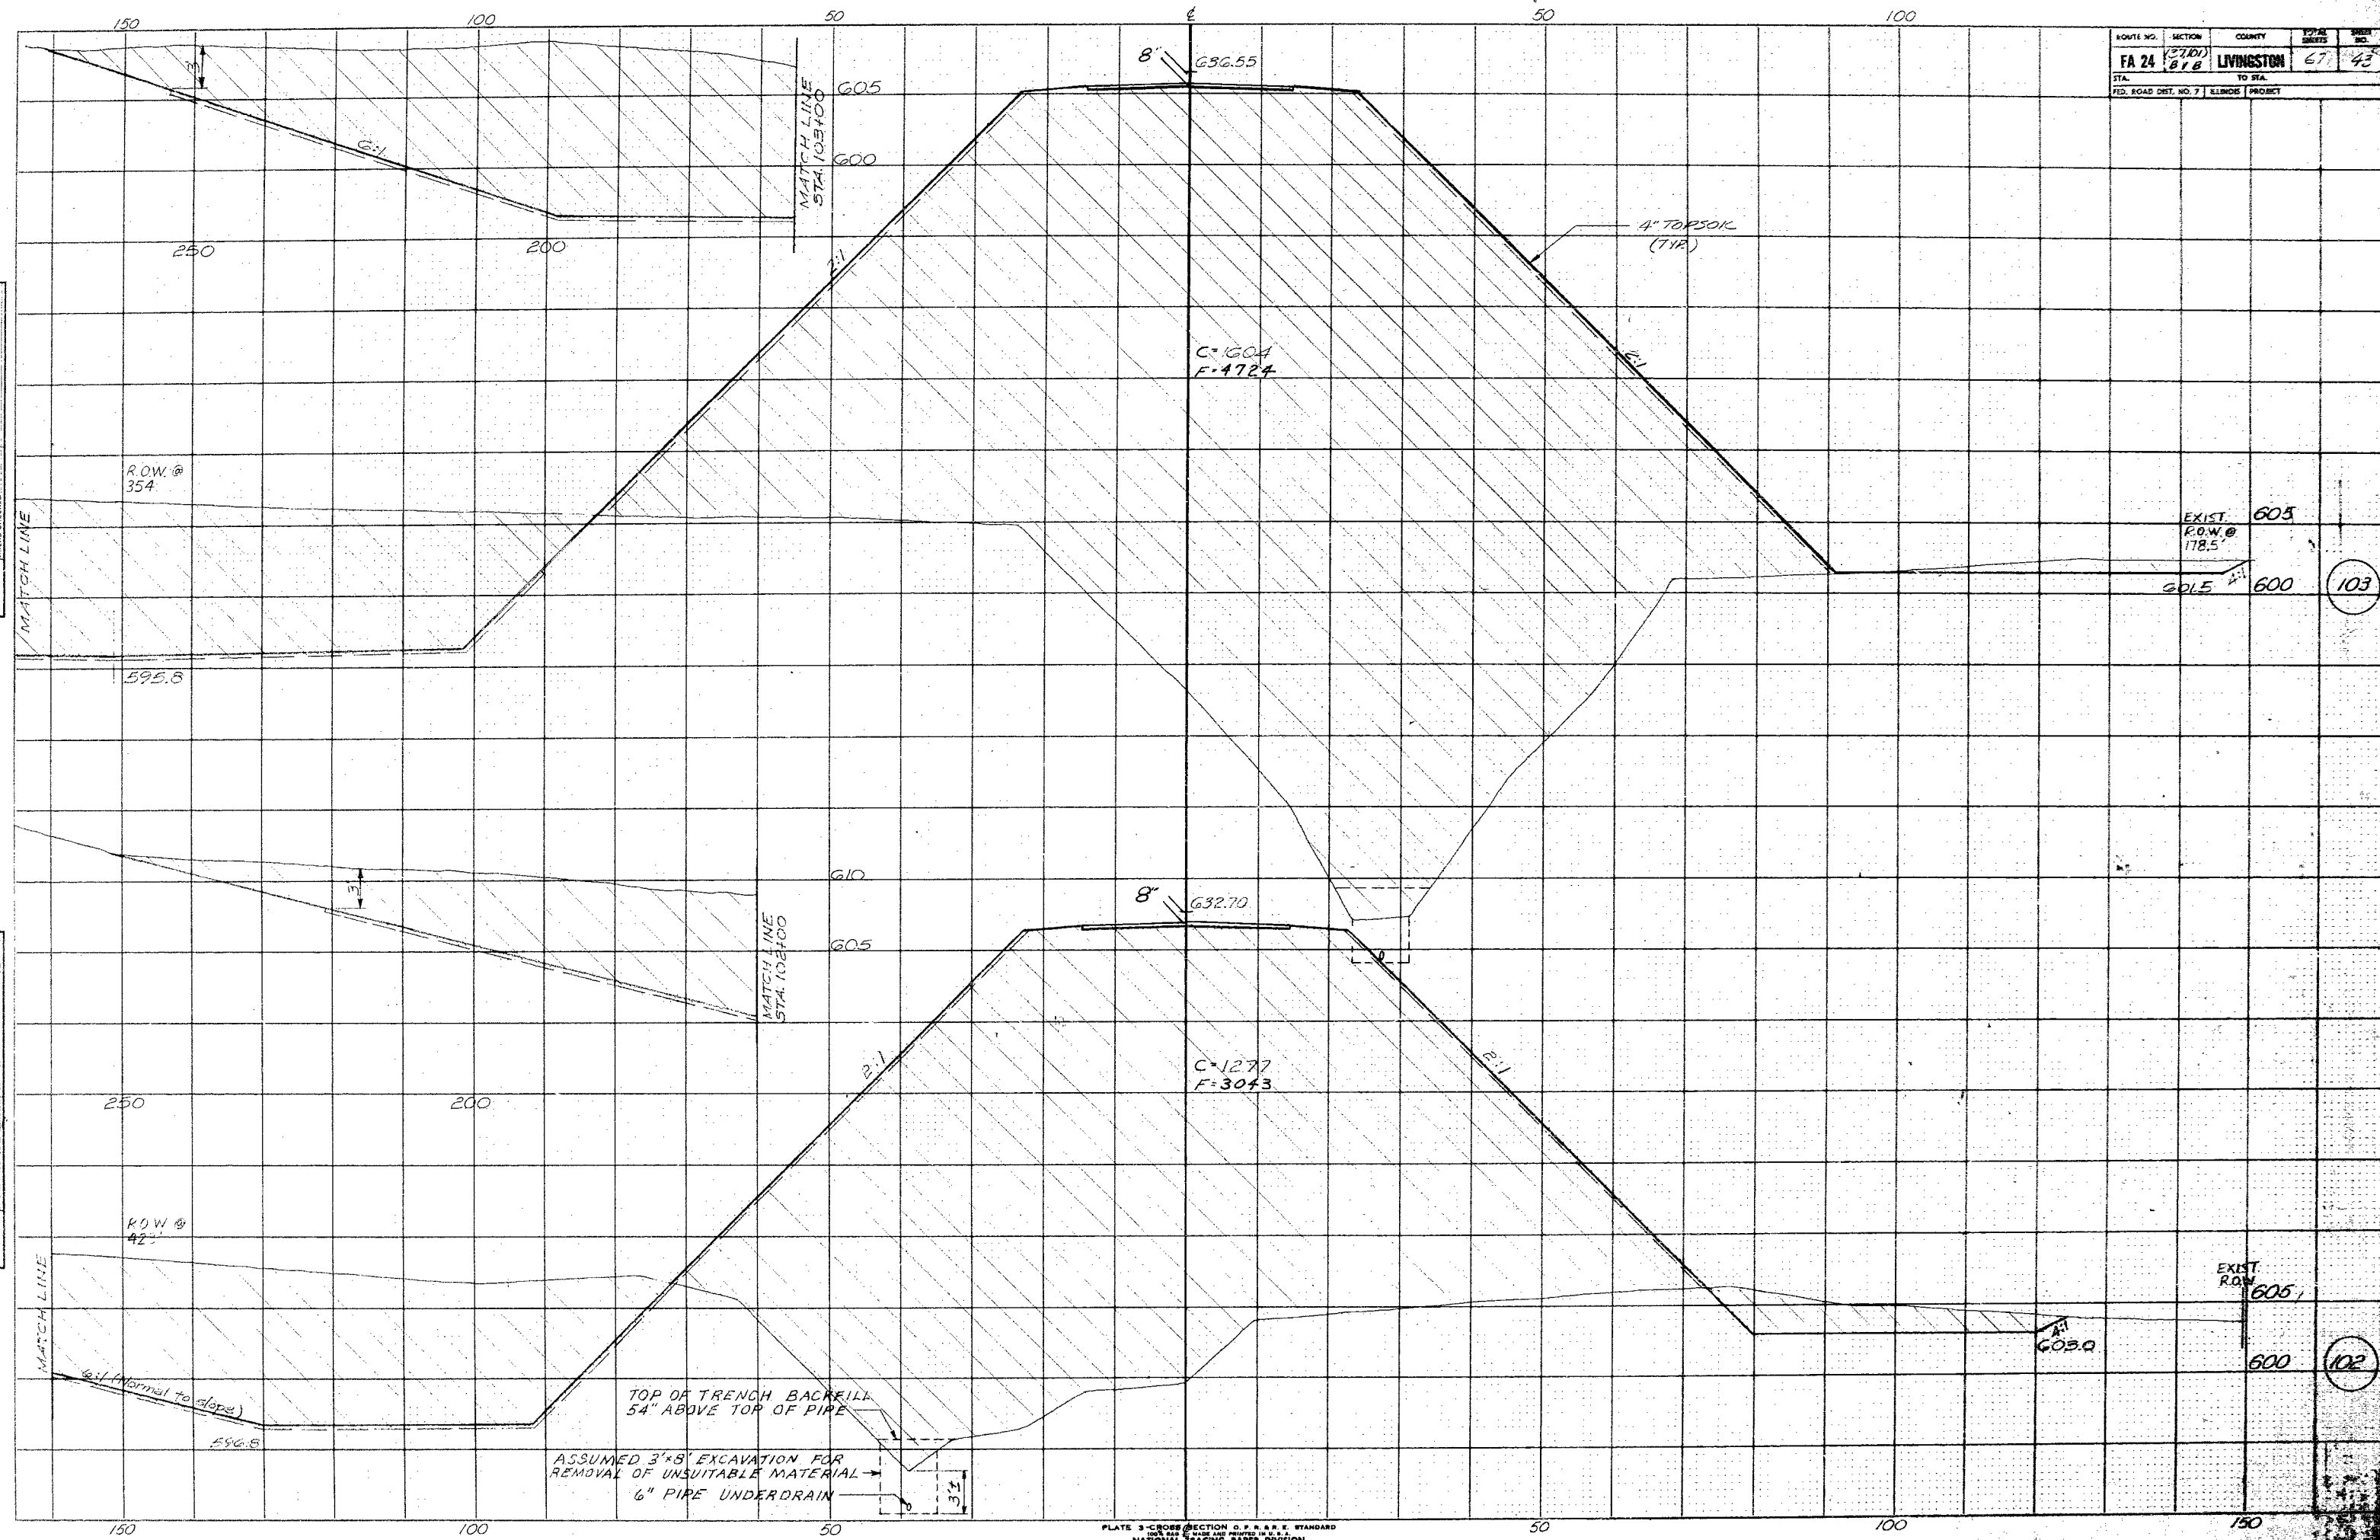

DATE: \_\_\_\_\_  
 BY: \_\_\_\_\_  
 SURVEYED: \_\_\_\_\_  
 PLOTTED: \_\_\_\_\_  
 CHECKED: \_\_\_\_\_  
 ORIGINAL SURVEY NO. \_\_\_\_\_  
 PHOTOGRAMMETRY NO. 1-72

DATE: \_\_\_\_\_  
 BY: \_\_\_\_\_  
 SURVEYED: \_\_\_\_\_  
 PLOTTED: \_\_\_\_\_  
 CHECKED: \_\_\_\_\_  
 ORIGINAL SURVEY NO. \_\_\_\_\_  
 PHOTOGRAMMETRY NO. 1-72

TOP OF TRENCH BACKFILL  
 54" ABOVE TOP OF PIPE


ASSUMED 3'x8' EXCAVATION FOR  
 REMOVAL OF UNSUITABLE MATERIAL  
 6" PIPE UNDERDRAIN

103

102

572

ROUTE NO.	SECTION	COUNTY	FILE NO.	SHEET NO.
FA 24	87B	LIVINGSTON	67	44
STA.	TO STA.			
FED. ROAD DIST. NO. 7   LIVINGSTON PROJECT				

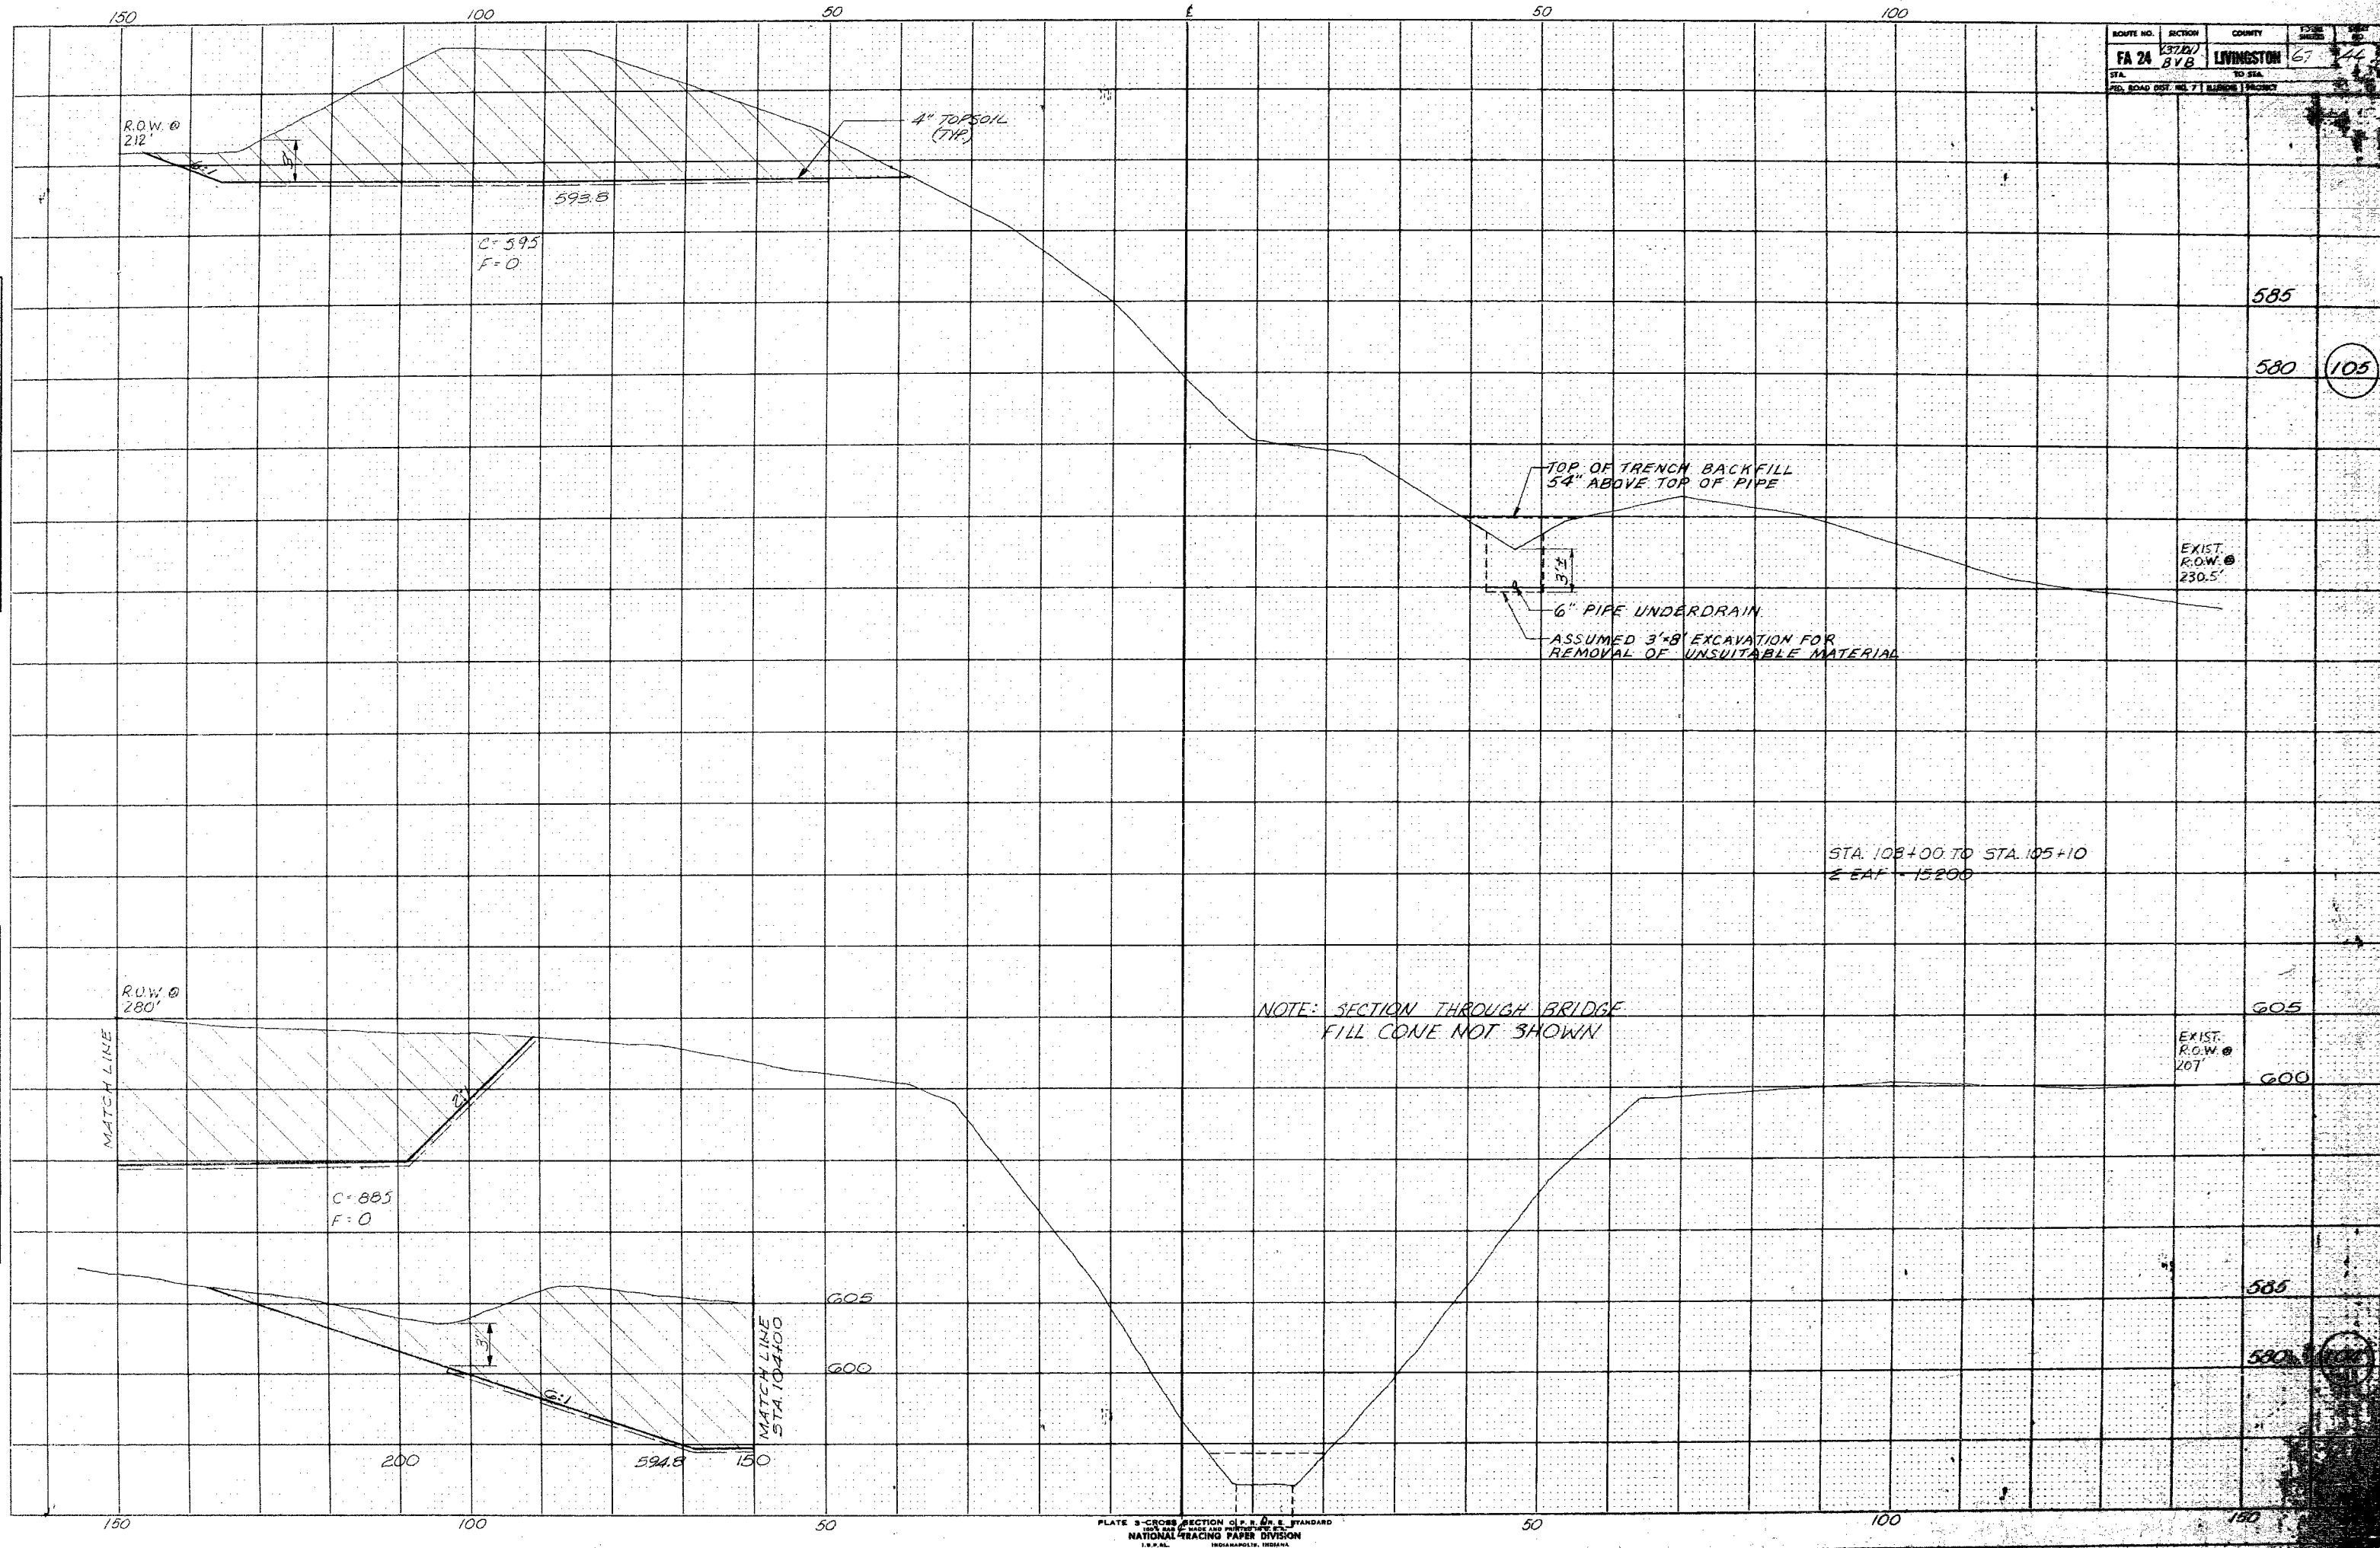

STA. 108+00 TO STA. 105+10  
 E EAT - 15200

NOTE: SECTION THROUGH BRIDGE  
 FILL CONE NOT SHOWN

DATE: \_\_\_\_\_ BY: \_\_\_\_\_  
 SURVEYED: \_\_\_\_\_  
 TEMPLATE: \_\_\_\_\_  
 NOTE BOOK: \_\_\_\_\_  
 NO. \_\_\_\_\_  
 AREAS CHECKED: \_\_\_\_\_

DATE: \_\_\_\_\_ BY: \_\_\_\_\_  
 SURVEYED: \_\_\_\_\_  
 TEMPLATE: \_\_\_\_\_  
 NOTE BOOK: \_\_\_\_\_  
 NO. \_\_\_\_\_  
 AREAS CHECKED: \_\_\_\_\_


STR

150 100 50 0 50 100 150

ROUTE NO.	SECTION	COUNTY	TOTAL SHEETS	SHEET NO.
FA 24	37.00	LIVINGSTON	57	45
STA.	TO STA.			
RD. ROAD DIST. NO. 7	KILMORRIS PROJECT			

FINAL SURVEY  
 SURVEYED BY  
 PLOTTED BY  
 CHECKED BY  
 DATE  
 NOTE BOOK NO.  
 TEMPLATE NO.  
 AREAS CHECKED

ORIGINAL SURVEY  
 SURVEYED BY  
 PLOTTED BY  
 CHECKED BY  
 DATE  
 PHOTOGRAMMETRY 4-70  
 ERG JLD 1-72  
 NOTE BOOK NO.  
 TEMPLATE NO.  
 AREAS CHECKED

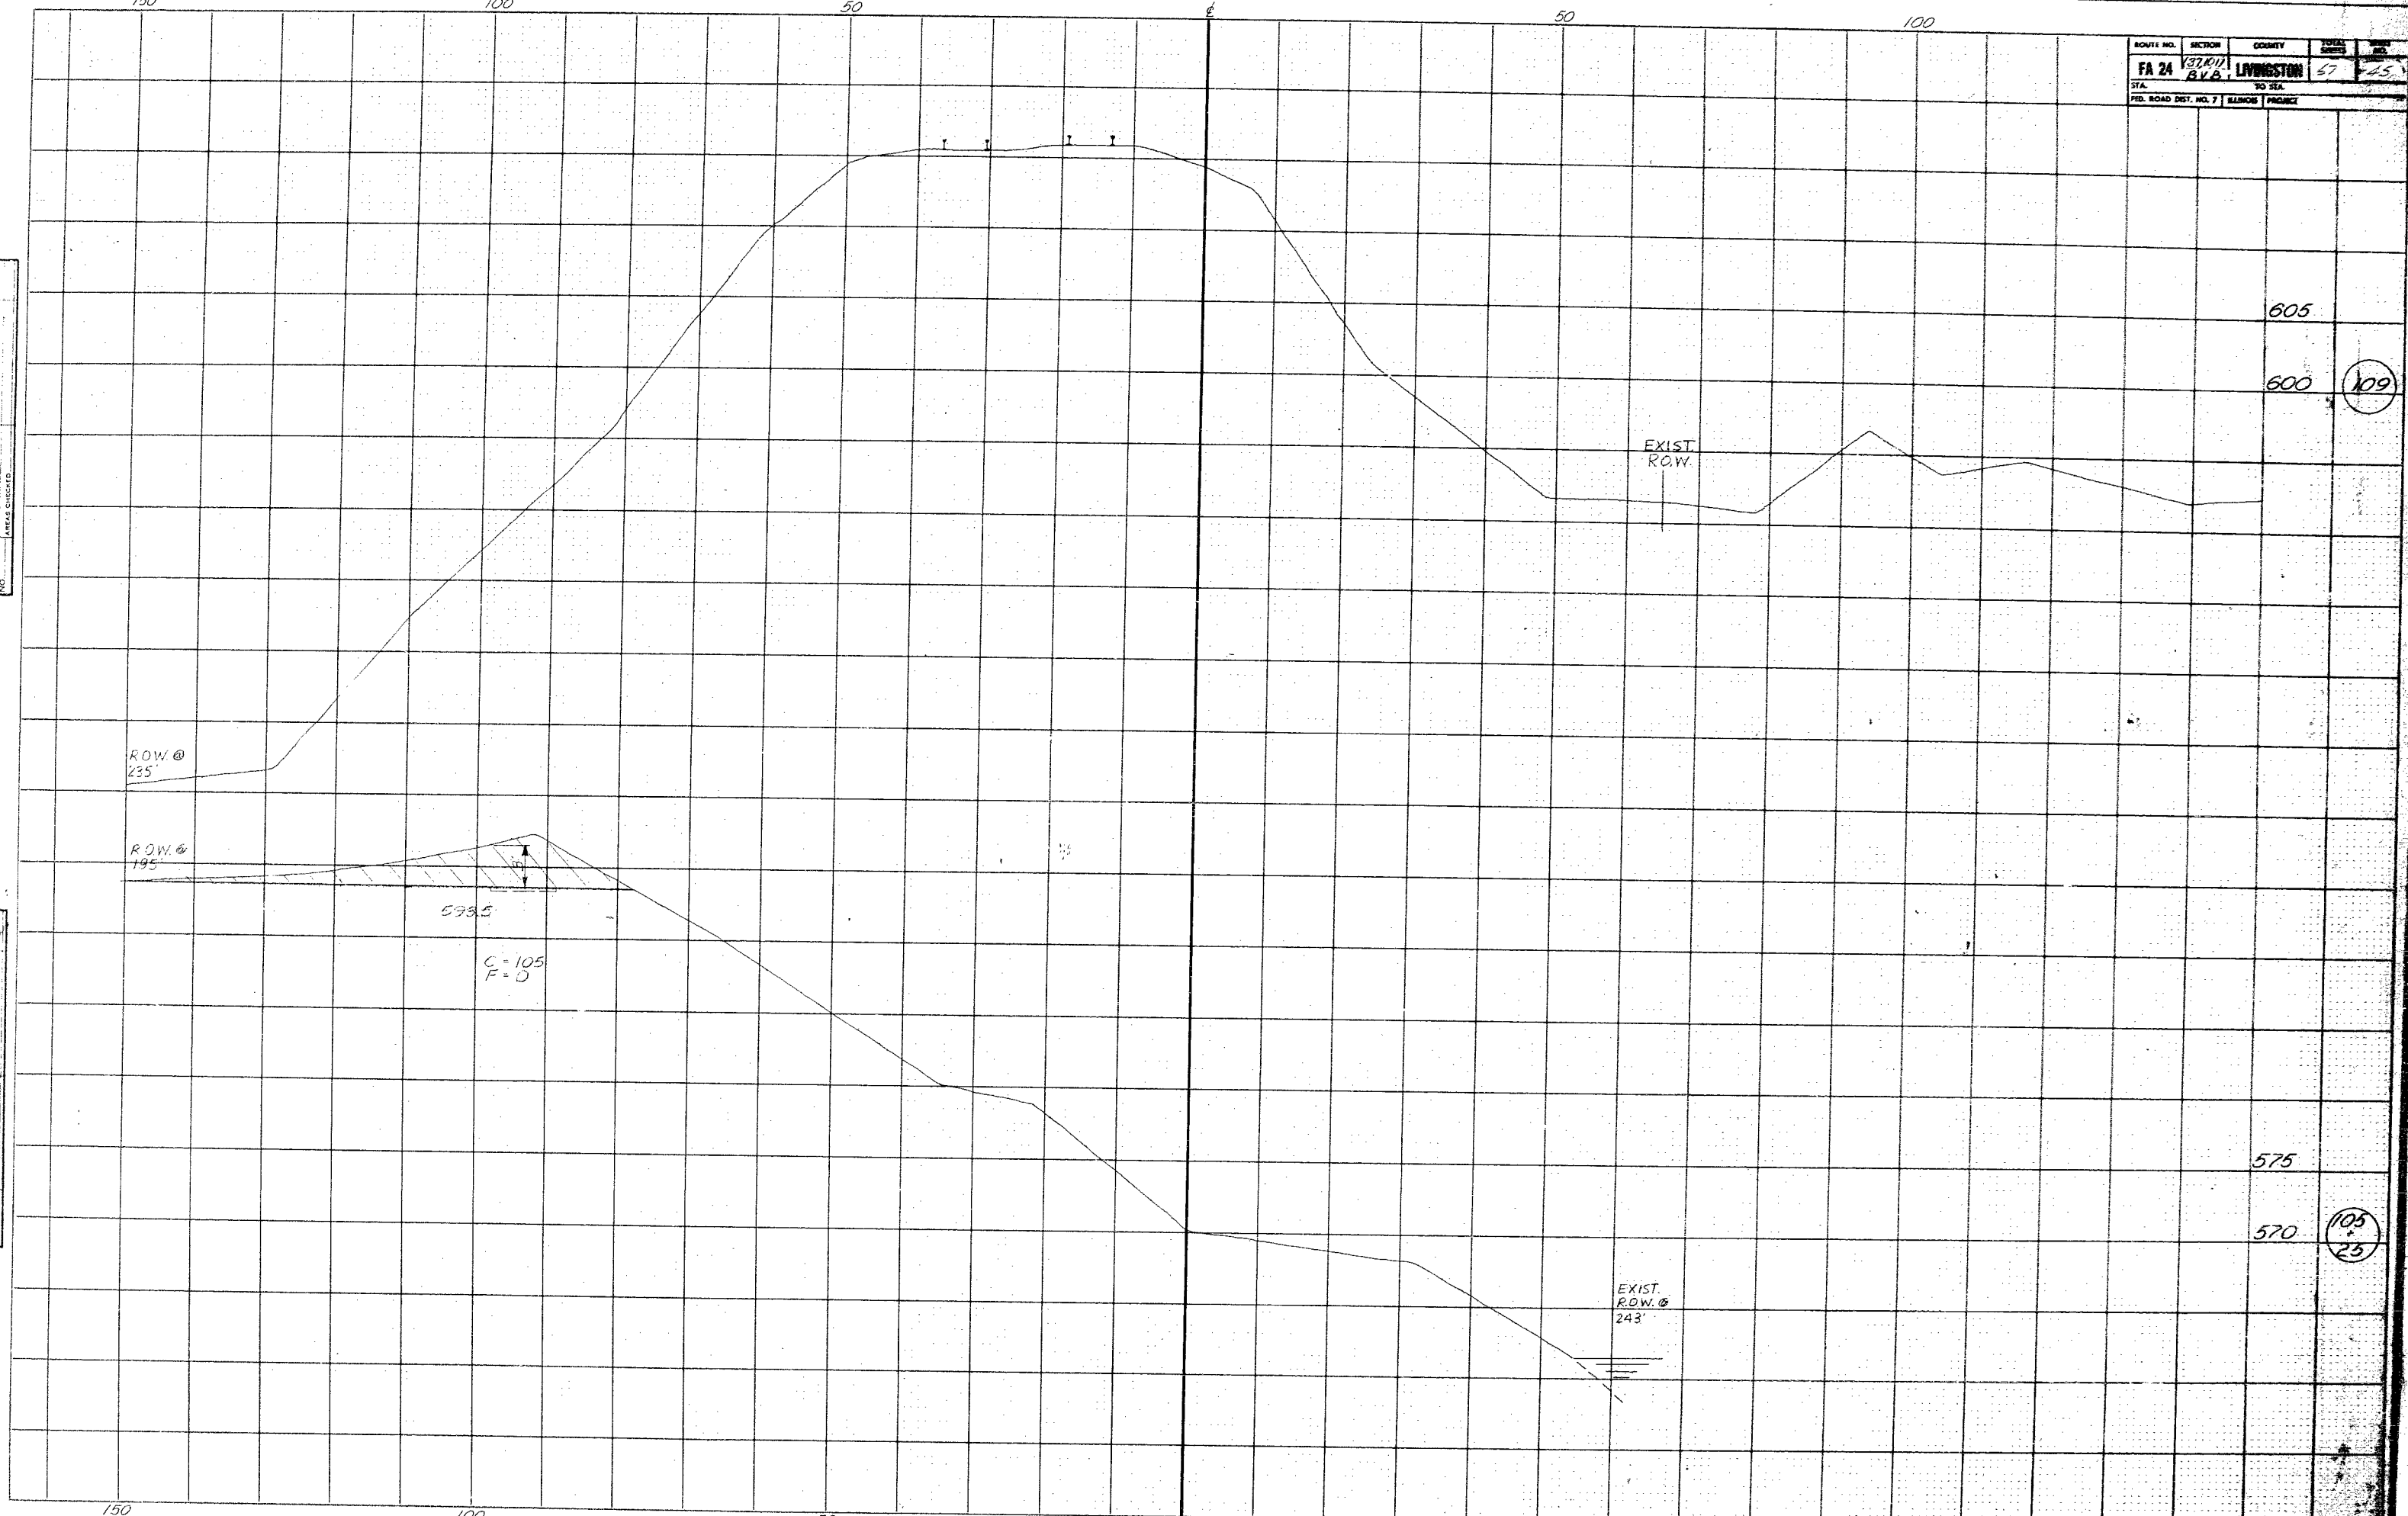


STR

150 100 50 0 50 100


ROUTE NO.	SECTION	COUNTY	PROJECT
FA 24	BV8	LIVINGSTON	67-46
STA.	TO SEE		
PUB. ROAD DIST. NO. 7			

DATE: \_\_\_\_\_  
 BY: \_\_\_\_\_  
 CHECKED: \_\_\_\_\_  
 SURVEY NO. \_\_\_\_\_  
 PLANET: \_\_\_\_\_  
 TEMPLATE: \_\_\_\_\_  
 NOTE BOOK: \_\_\_\_\_  
 NO. \_\_\_\_\_  
 AREAS CHECKED: \_\_\_\_\_

DATE: 11/1/72  
 BY: J. J. GIBSON  
 CHECKED: \_\_\_\_\_  
 SURVEY NO. 2072  
 PLANET: \_\_\_\_\_  
 TEMPLATE: \_\_\_\_\_  
 NOTE BOOK: \_\_\_\_\_  
 NO. \_\_\_\_\_  
 AREAS CHECKED: \_\_\_\_\_

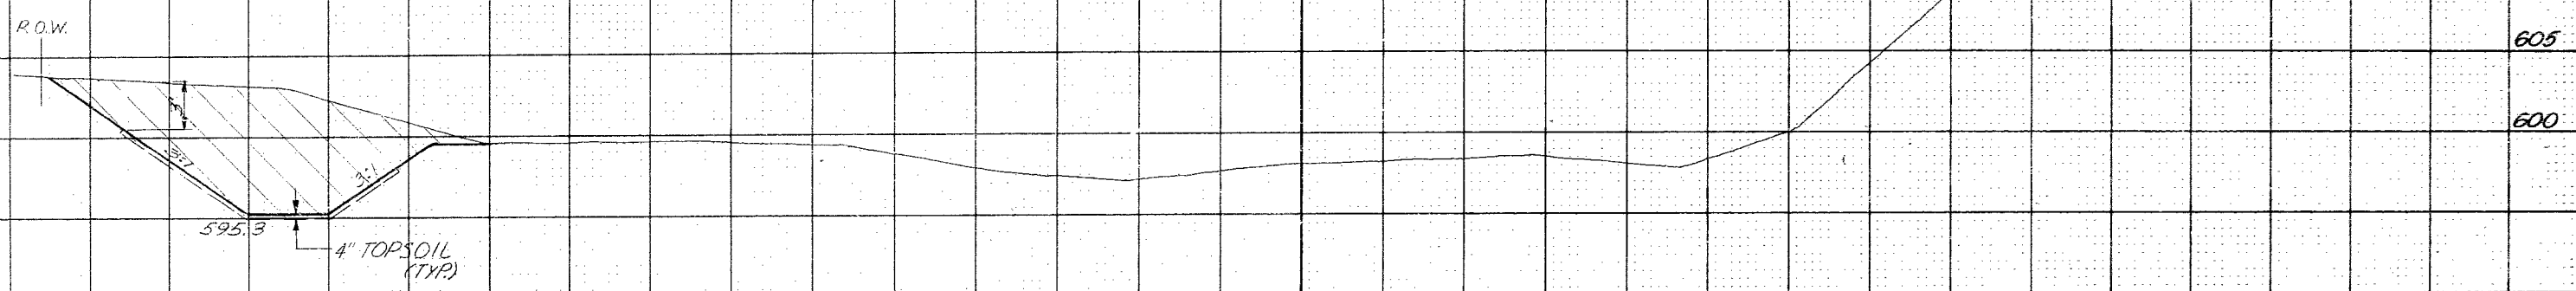

C=228  
 F=0

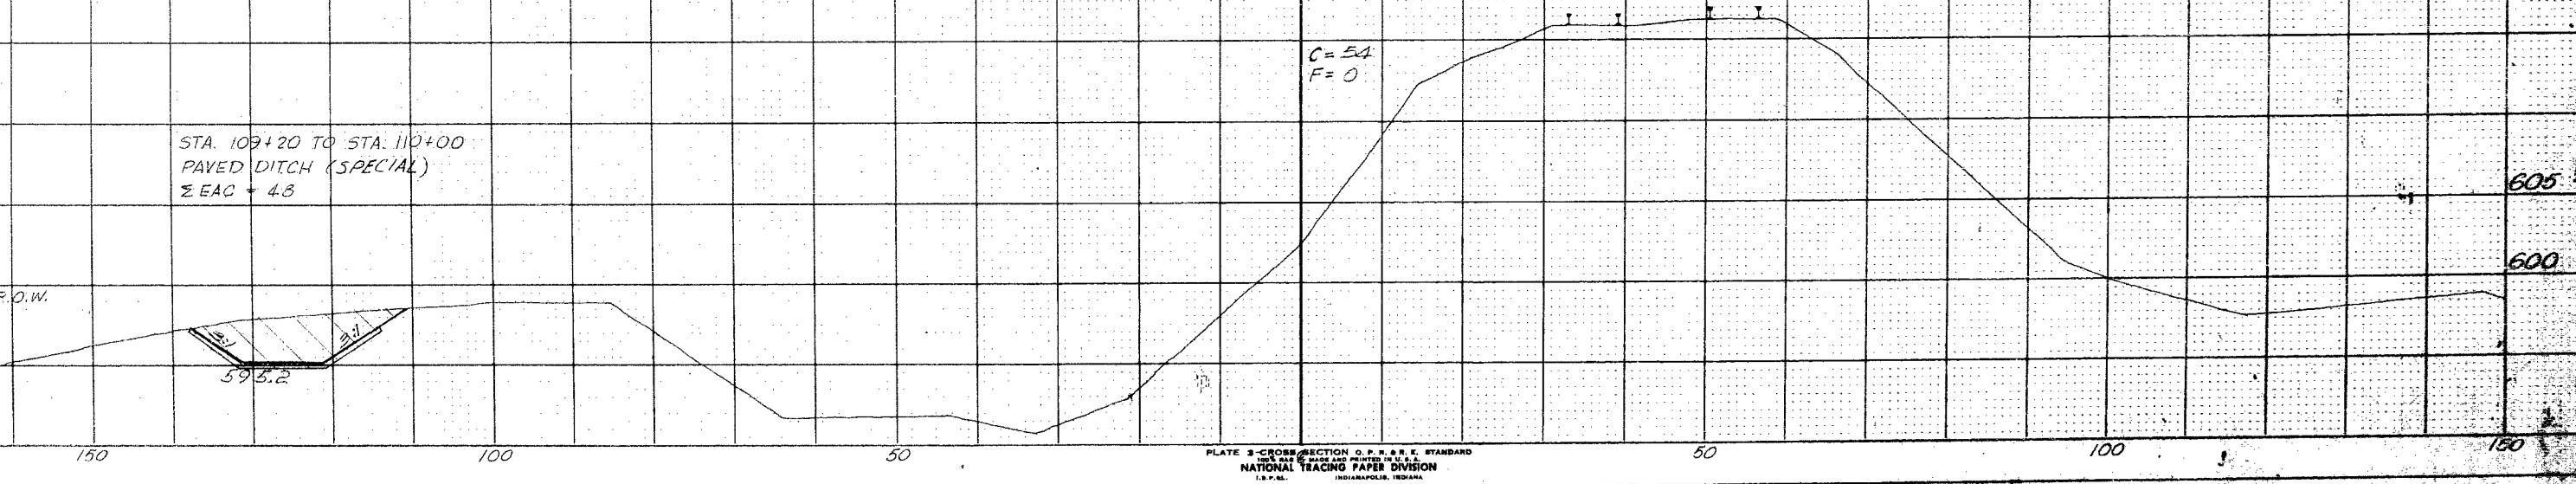

STA. 109+20 TO STA. 110+00  
 PAVED DITCH (SPECIAL)  
 Σ EAC + 4.8


C=54  
 F=0

STR

ROUTE NO.	SECTION	COUNTY	DATE
FA 24	137.100	LIVINGSTON	67 47
BY	BY	BY	BY
BY	BY	BY	BY
BY	BY	BY	BY

FINAL SURVEY  
 SURVEYED BY  
 PLOTTED BY  
 NOTE BOOK NO.  
 NO. AREAS CHECKED

ORIGINAL SURVEY  
 SURVEYED BY  
 PLOTTED BY  
 NOTE BOOK NO.  
 NO. AREAS CHECKED

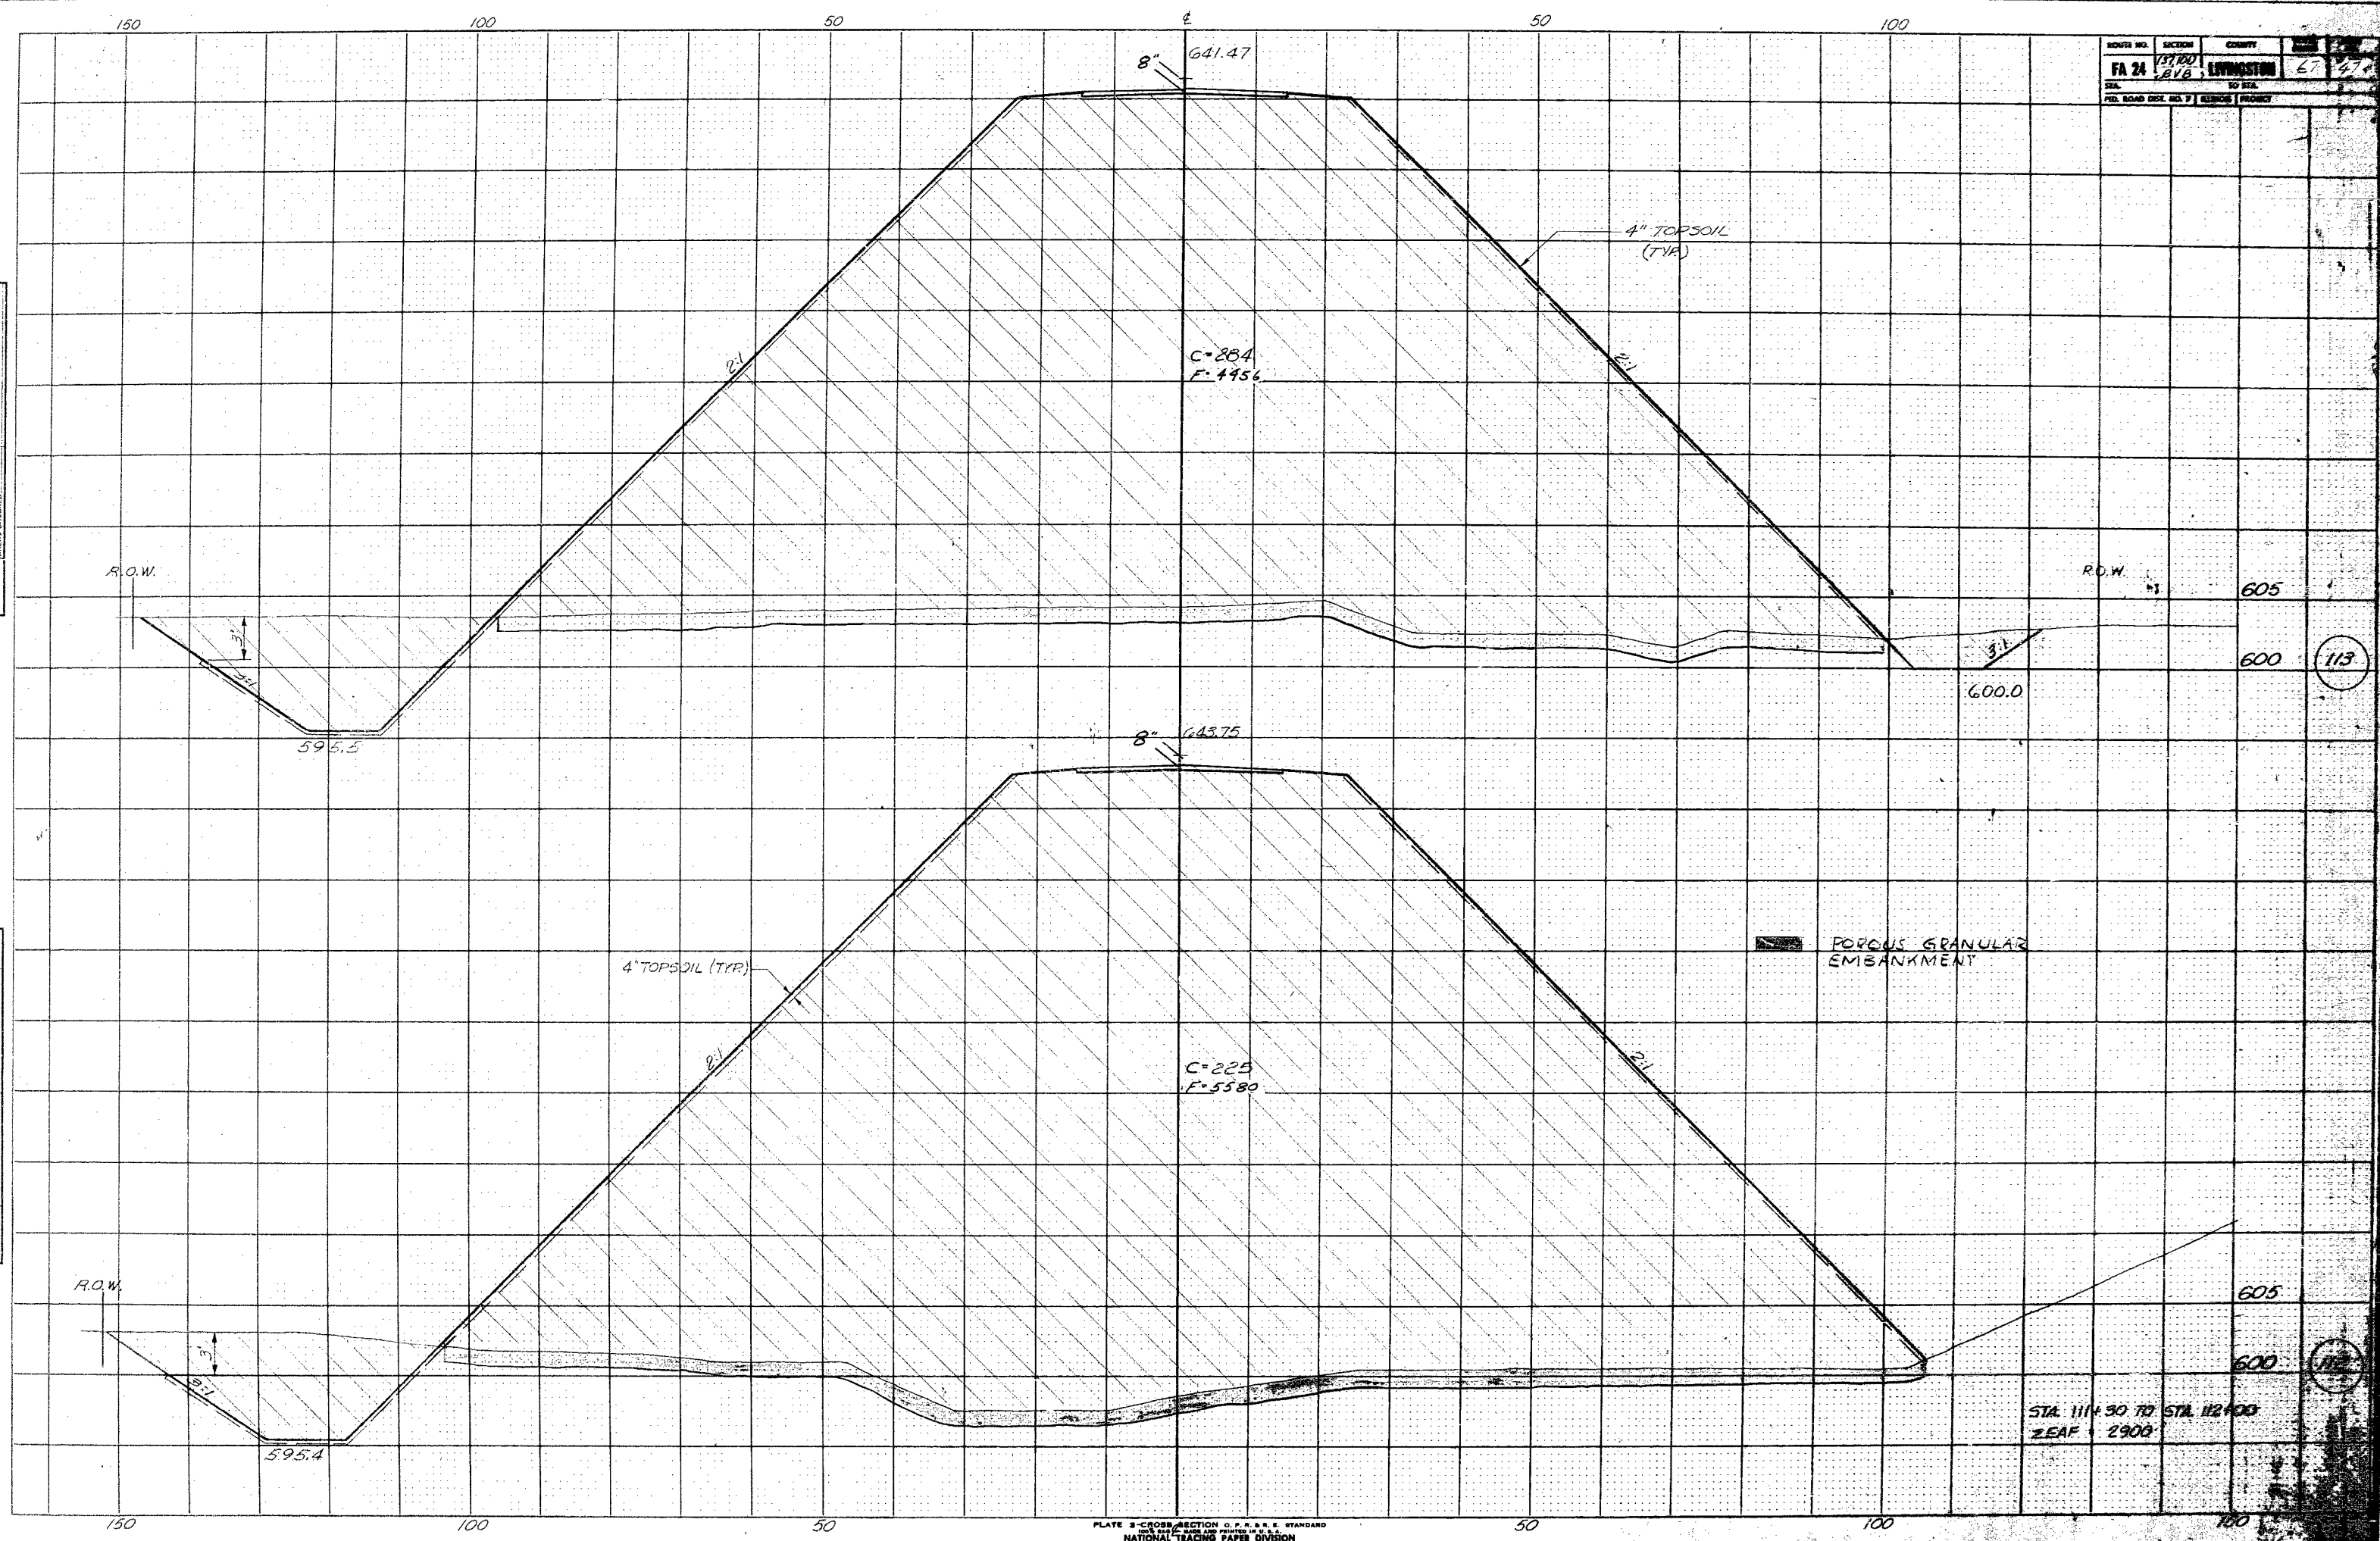


113

112

STA. 1114.90 TO STA. 1121.00  
 Z.E.A.P. 2908

ROUTE NO.	SECTION	COUNTY	TOTAL SHEETS	SHEET NO.
FA 24	3700 388	LIVINGSTON	67	48
STA. TO STA.				
FED. ROAD DIST. NO. 7   SALMON PROJECT				

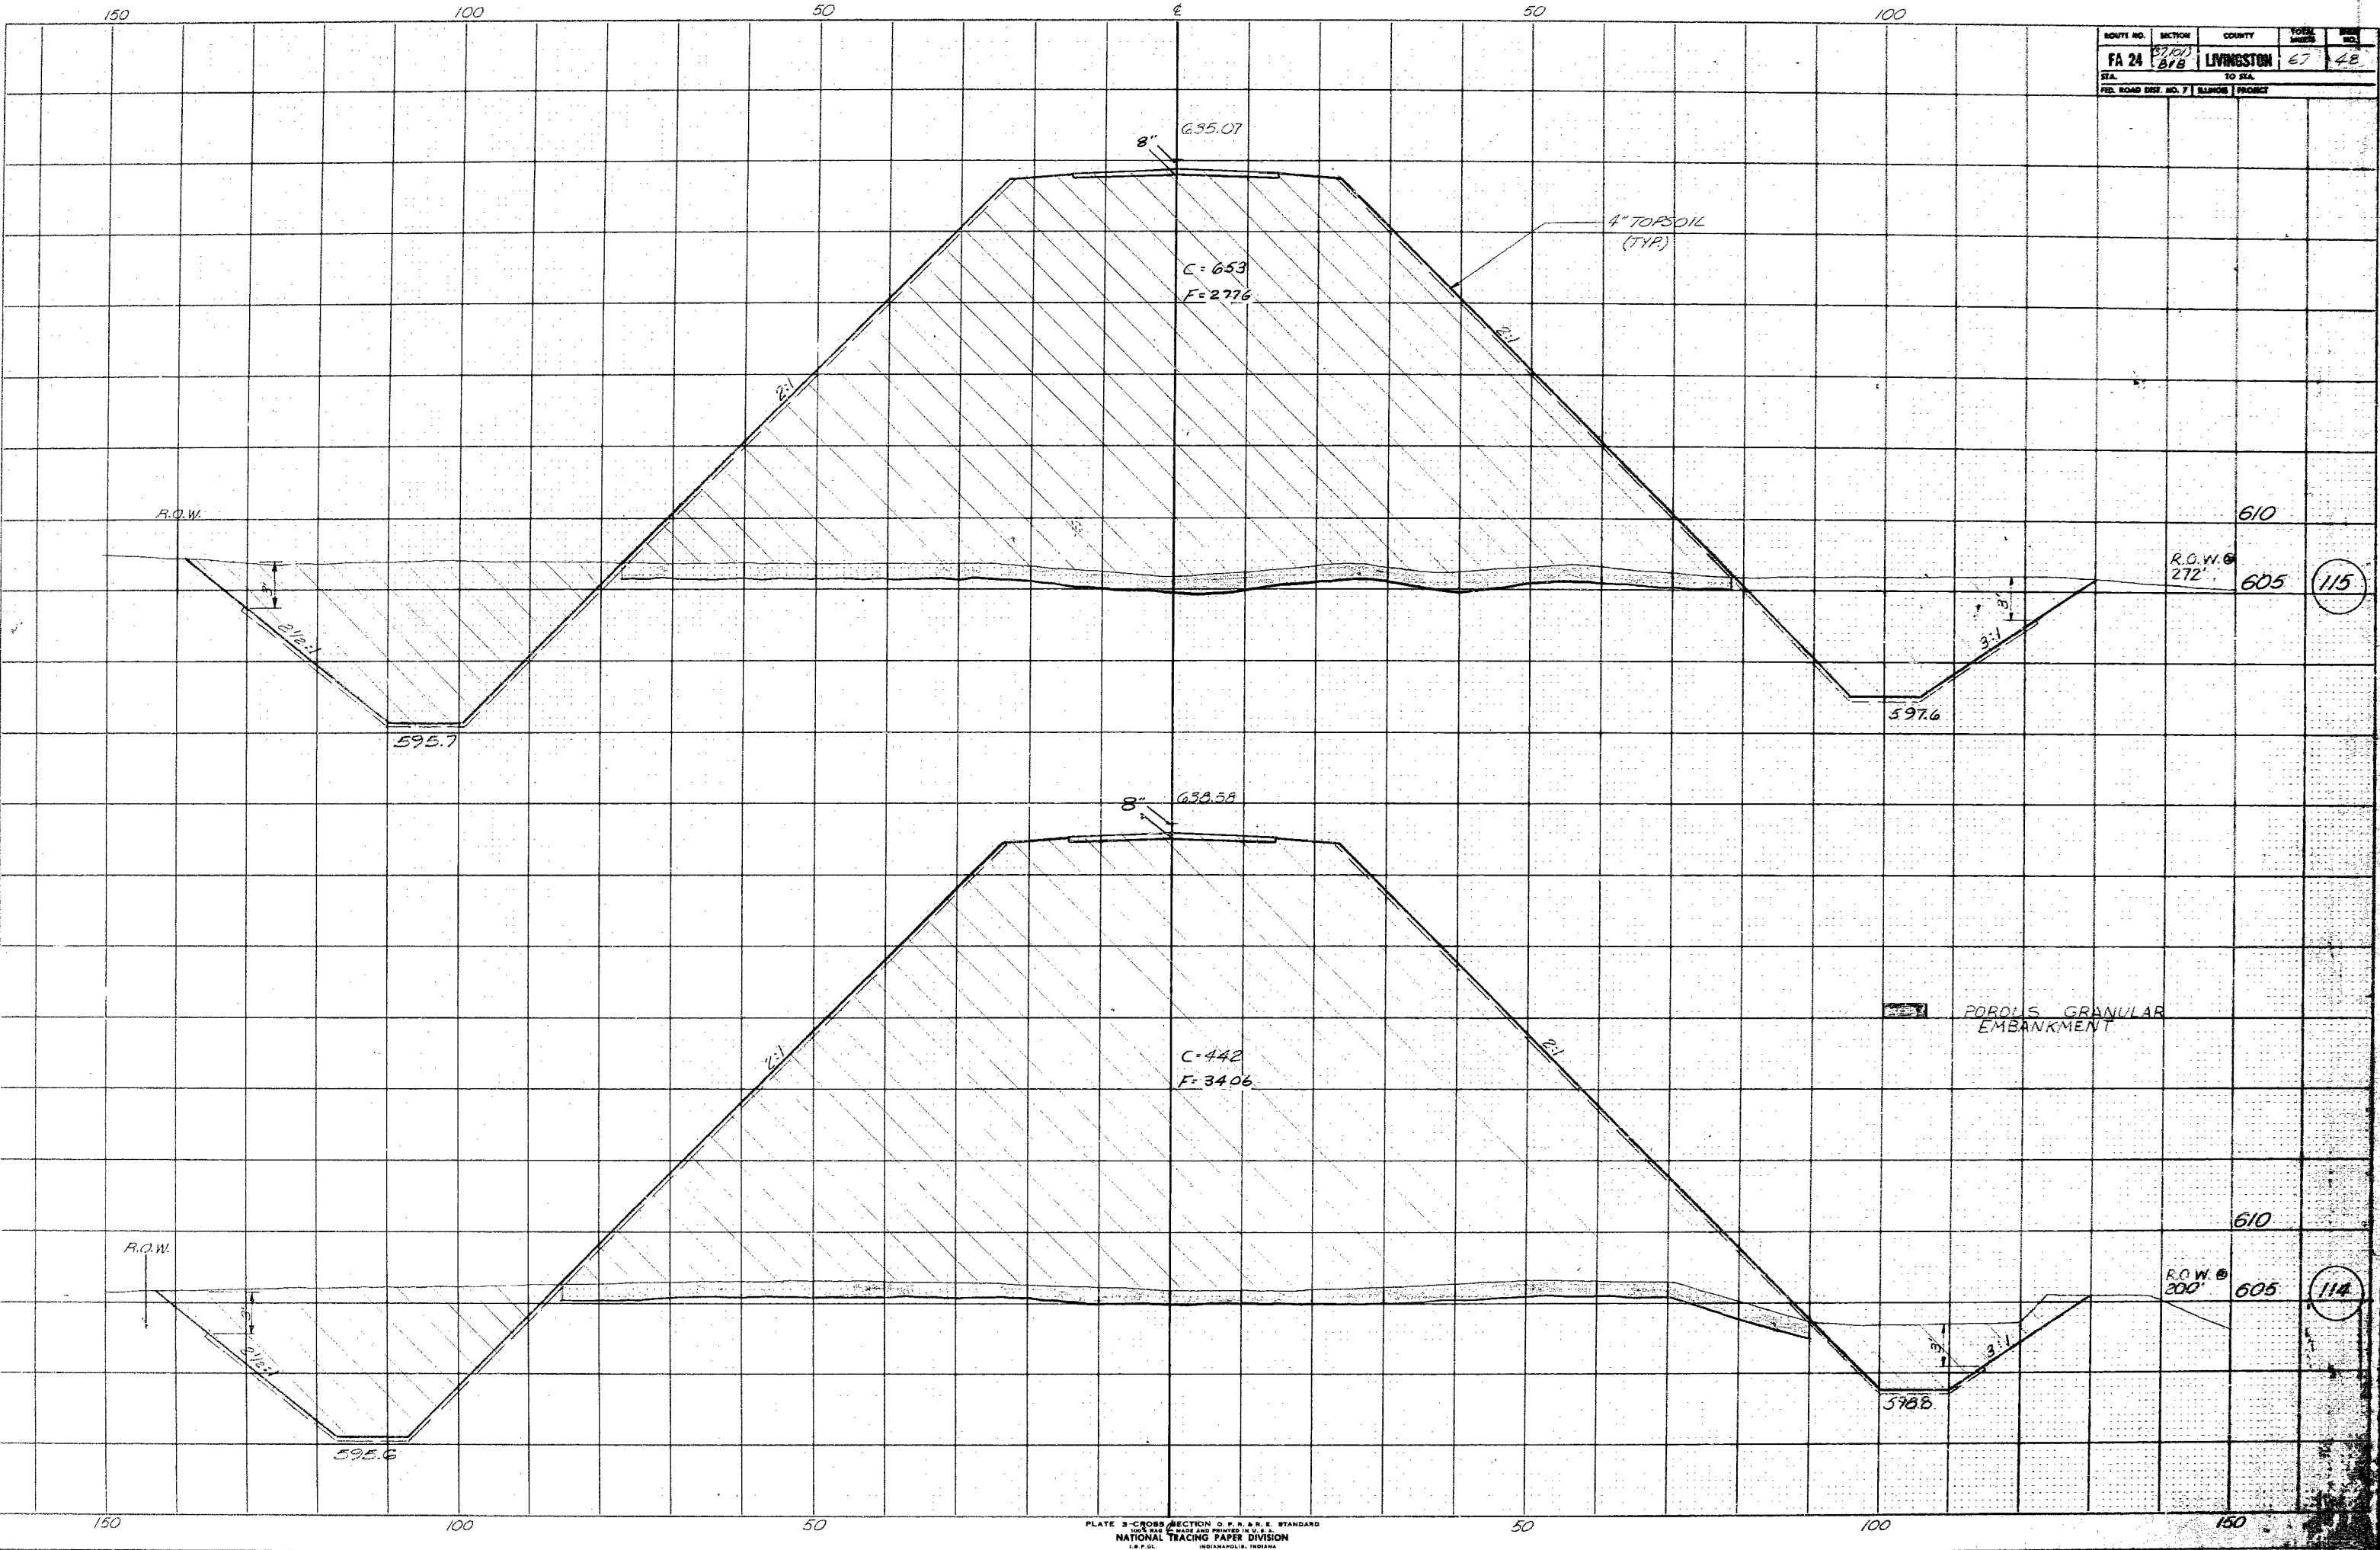


DATE: \_\_\_\_\_ BY: \_\_\_\_\_  
 SURVEYED: \_\_\_\_\_  
 ORIGINAL SURVEY: \_\_\_\_\_  
 NOTE BOOK: \_\_\_\_\_  
 NO. \_\_\_\_\_


DATE: 4-22-72 BY: R. B. K.  
 SURVEYED: \_\_\_\_\_  
 ORIGINAL SURVEY: \_\_\_\_\_  
 NOTE BOOK: \_\_\_\_\_  
 NO. \_\_\_\_\_

ROUTE NO.	SECTION	COUNTY	TOTAL SHEETS	SHEET NO.
FA 24	257.00 84.8	LIVINGSTON	67	42
STA.	TO STA.			
PUB. ROAD DIST. NO. 7	BRIDGE	PROJECT		

DATE  
BY  
SURVEYED  
PLOTTED  
CHECKED  
NO. OF BOOKS  
AREAS  
AREAS CHECKED

DATE  
BY  
SURVEYED  
PLOTTED  
CHECKED  
NO. OF BOOKS  
AREAS  
AREAS CHECKED

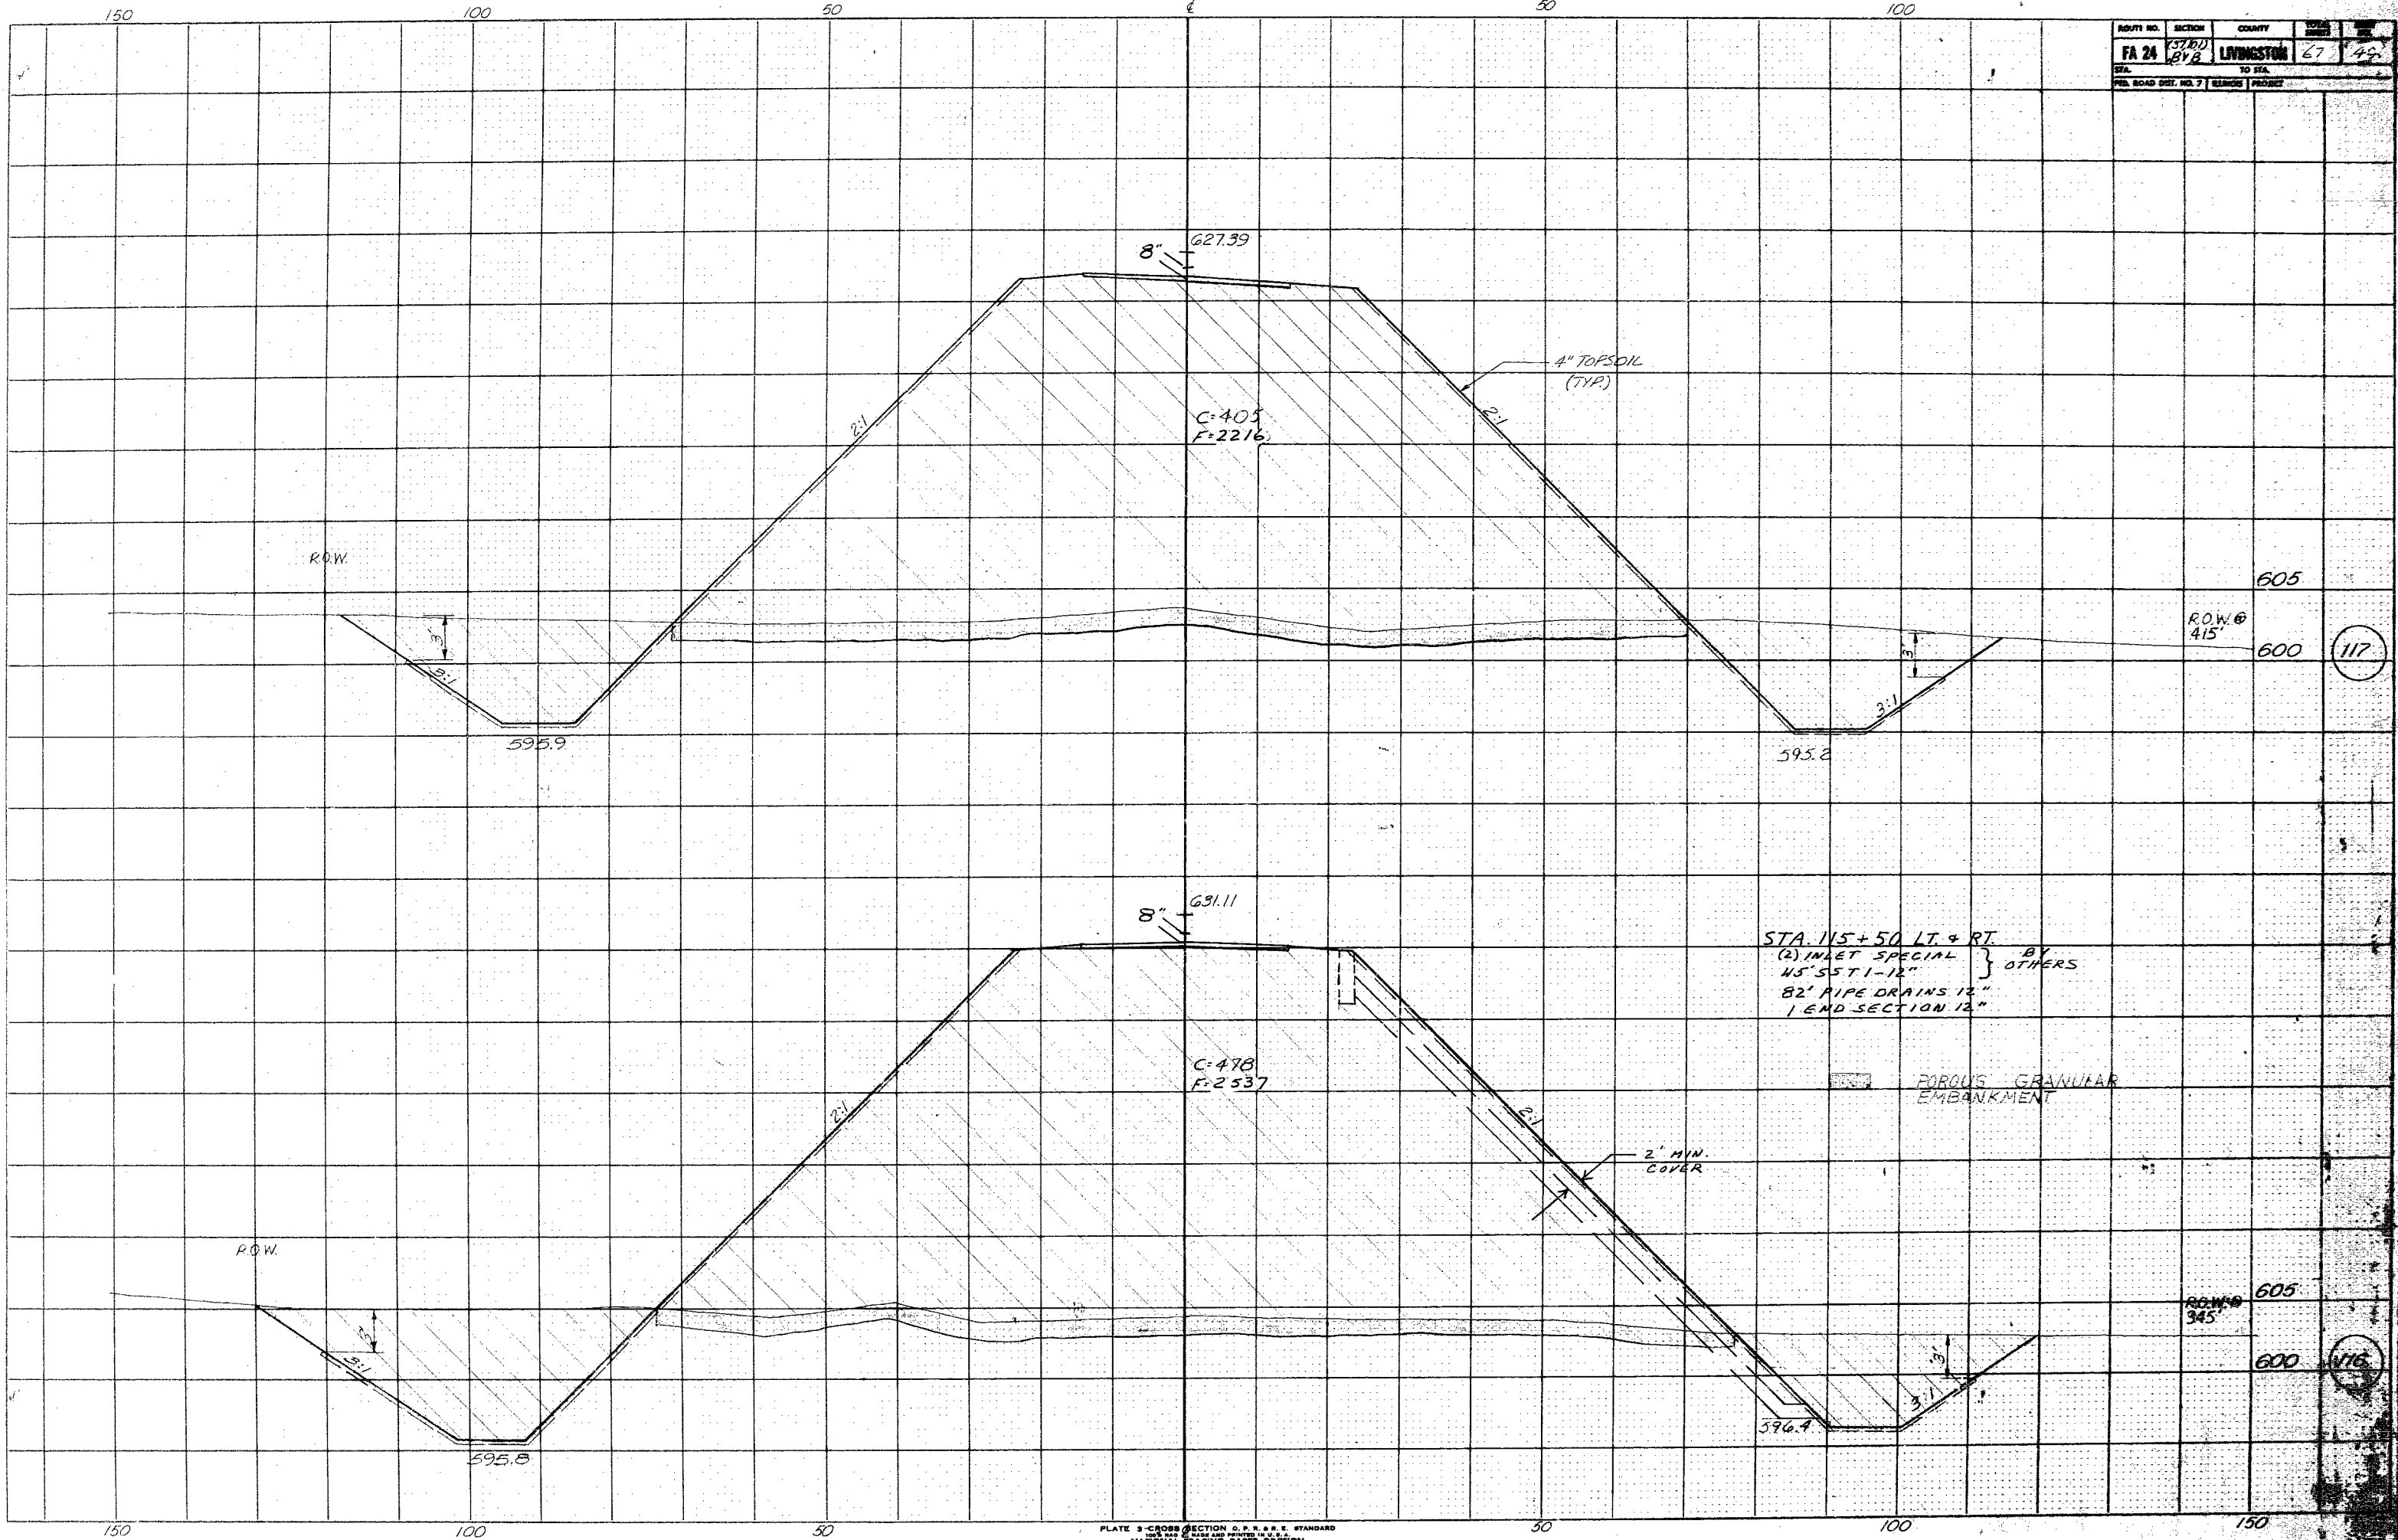

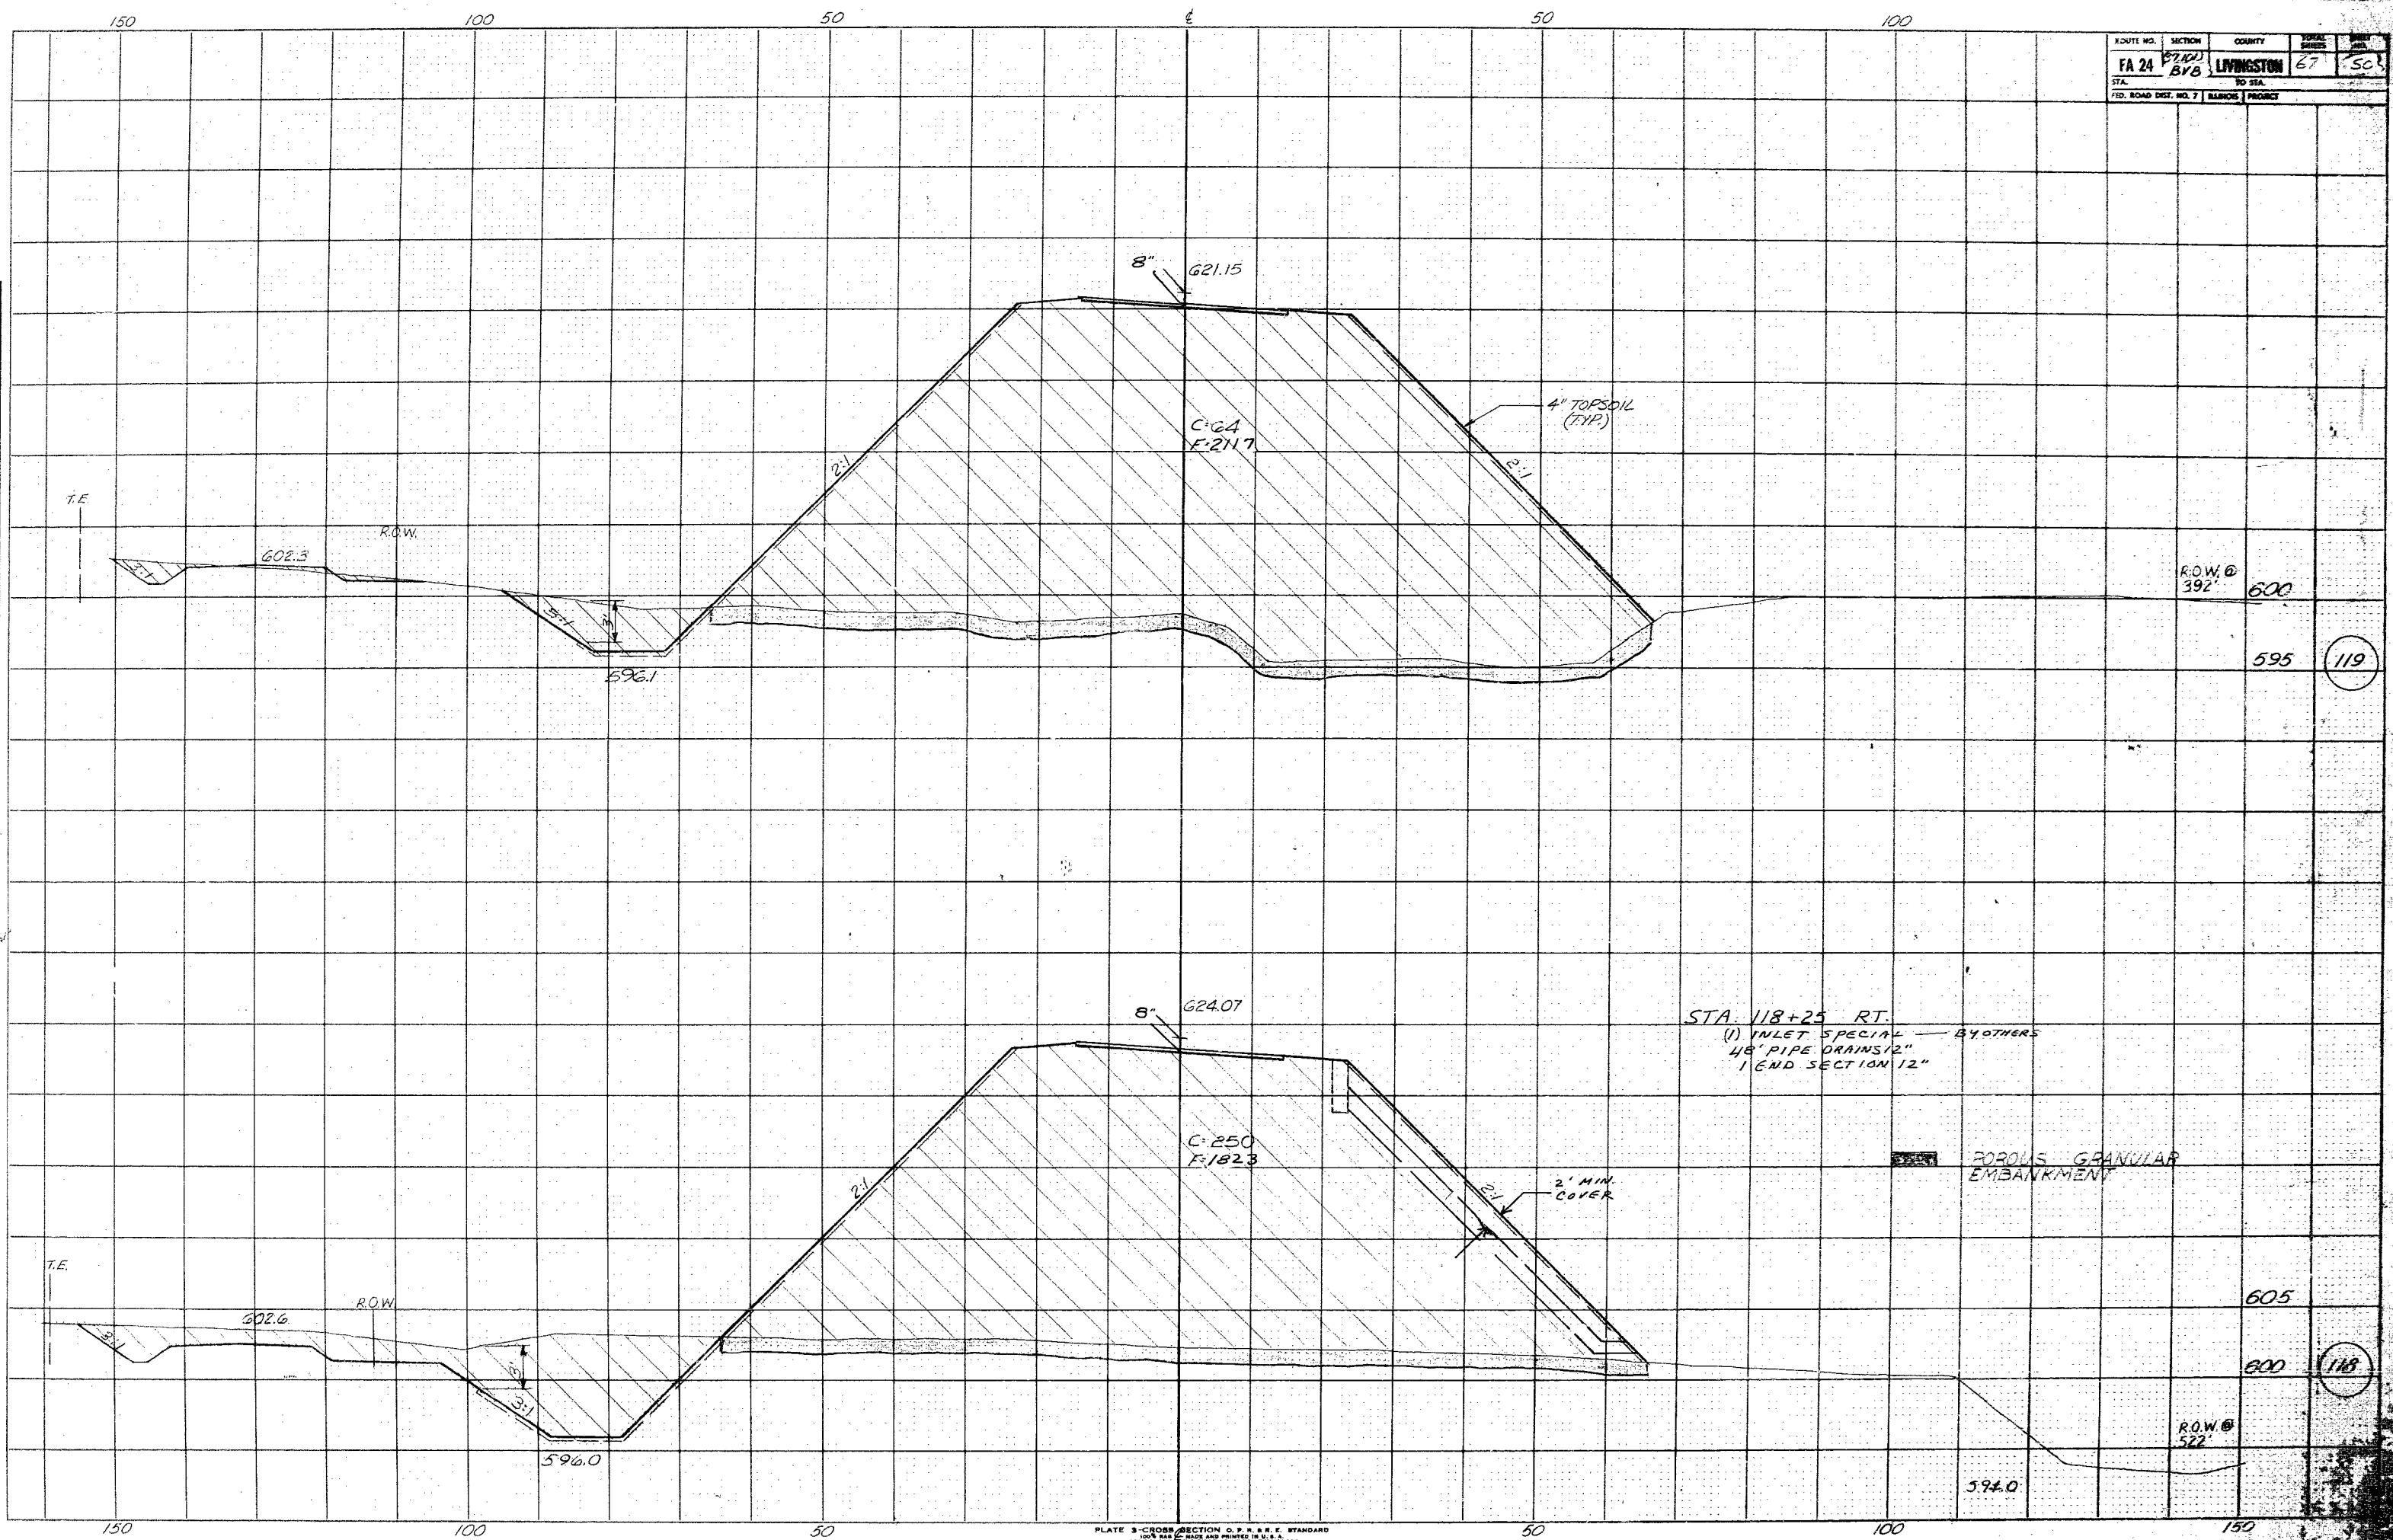

BY  
 DATE  
 CHECKED  
 DATE  
 ORIGINAL SURVEY  
 PLOTTED  
 DATE  
 NO.

BY  
 DATE  
 CHECKED  
 DATE  
 ORIGINAL SURVEY  
 PLOTTED  
 DATE  
 NO.

150

100

50

0

50


100

ROUTE NO.	SECTION	COUNTY	TOWNSHIP	RANGE
FA 24	B1B	LEWIS & CLARK	67	S1
STA.	119+95			
PUB. ROAD DIST. NO. 7				



6:1 SLOPE TO R1±50  
 END EMBANKMENT STA. 120+50 THIS CONTRACT

STA. 119+95 LT.  
 1 INLET SPECIAL — BY OTHERS  
 68" PIPE DRAINS 12"  
 1 END SECTION 12"

STA. 119+95 RT.  
 1 INLET SPECIAL — BY OTHERS  
 48" PIPE DRAINS 12"  
 1 END SECTION 12"

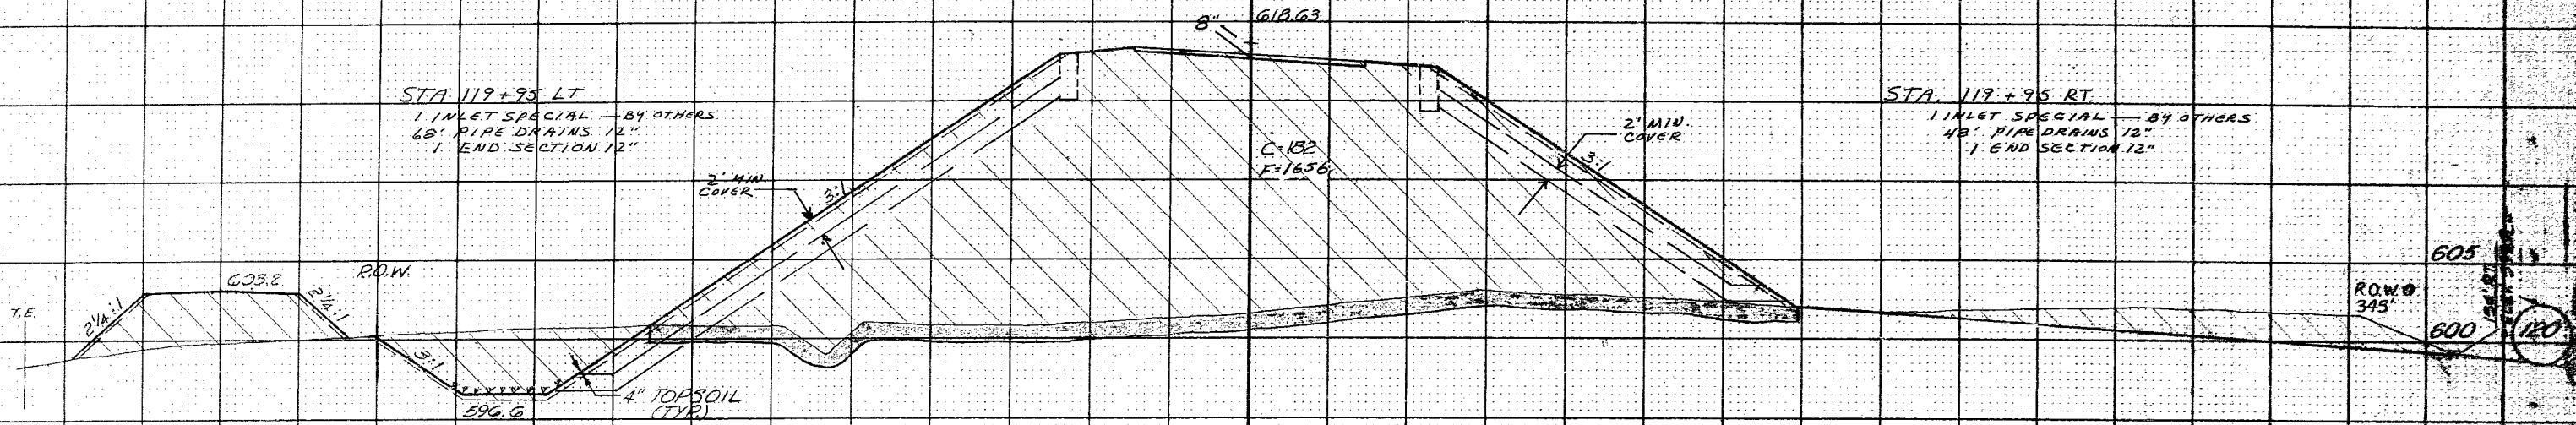

STA. 119+80 SK. 30' LA  
 30' x 34' P-2 LT. 130'  
 TWO END SECTIONS

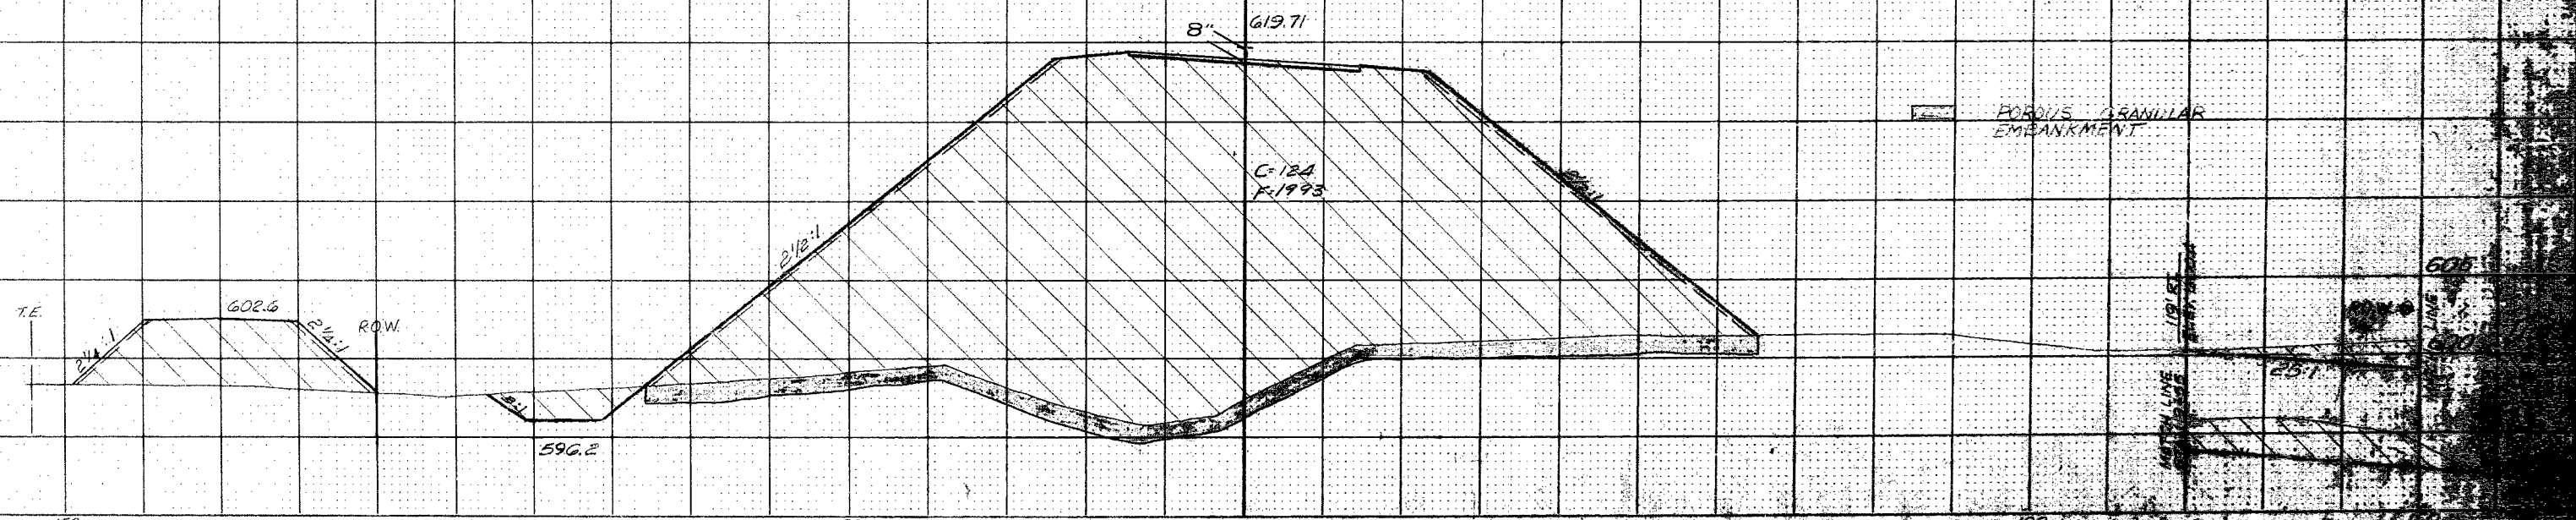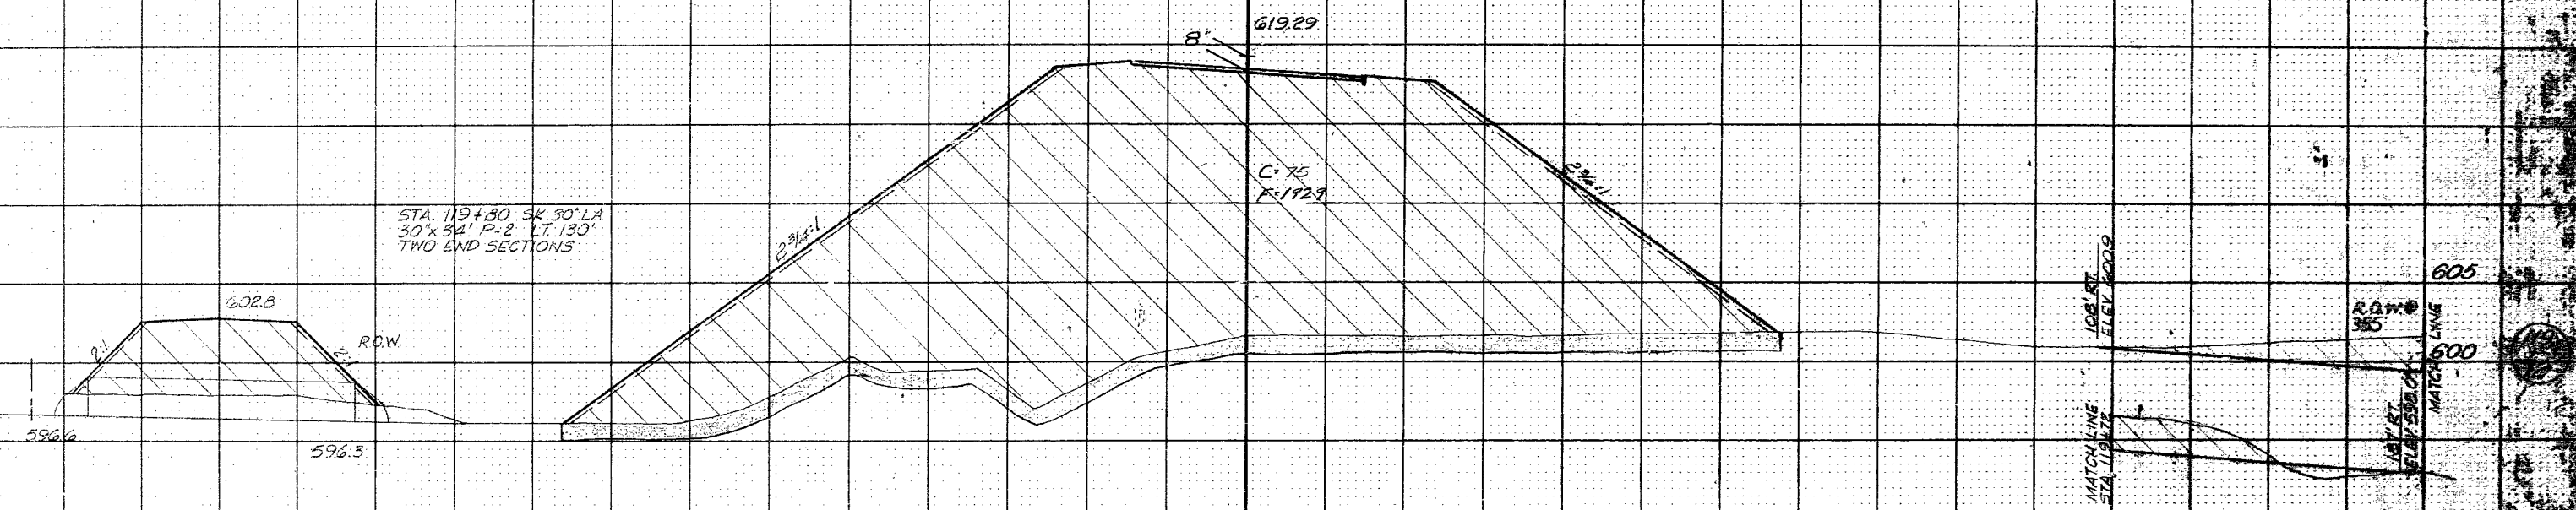


DATE  
 BY  
 CHECKED  
 APPROVED  
 SURVEY  
 NO.

DATE  
 BY  
 CHECKED  
 APPROVED  
 SURVEY  
 NO.

STA 124+65 10' WIDE BERM LT.  
 Z EAF = 169  
 3-30" X 46' P.2 LT 83'  
 SIX END SECTIONS

STA 125+50 S.P. 197  
 Z EAC = 3  
 Z EAF = 20

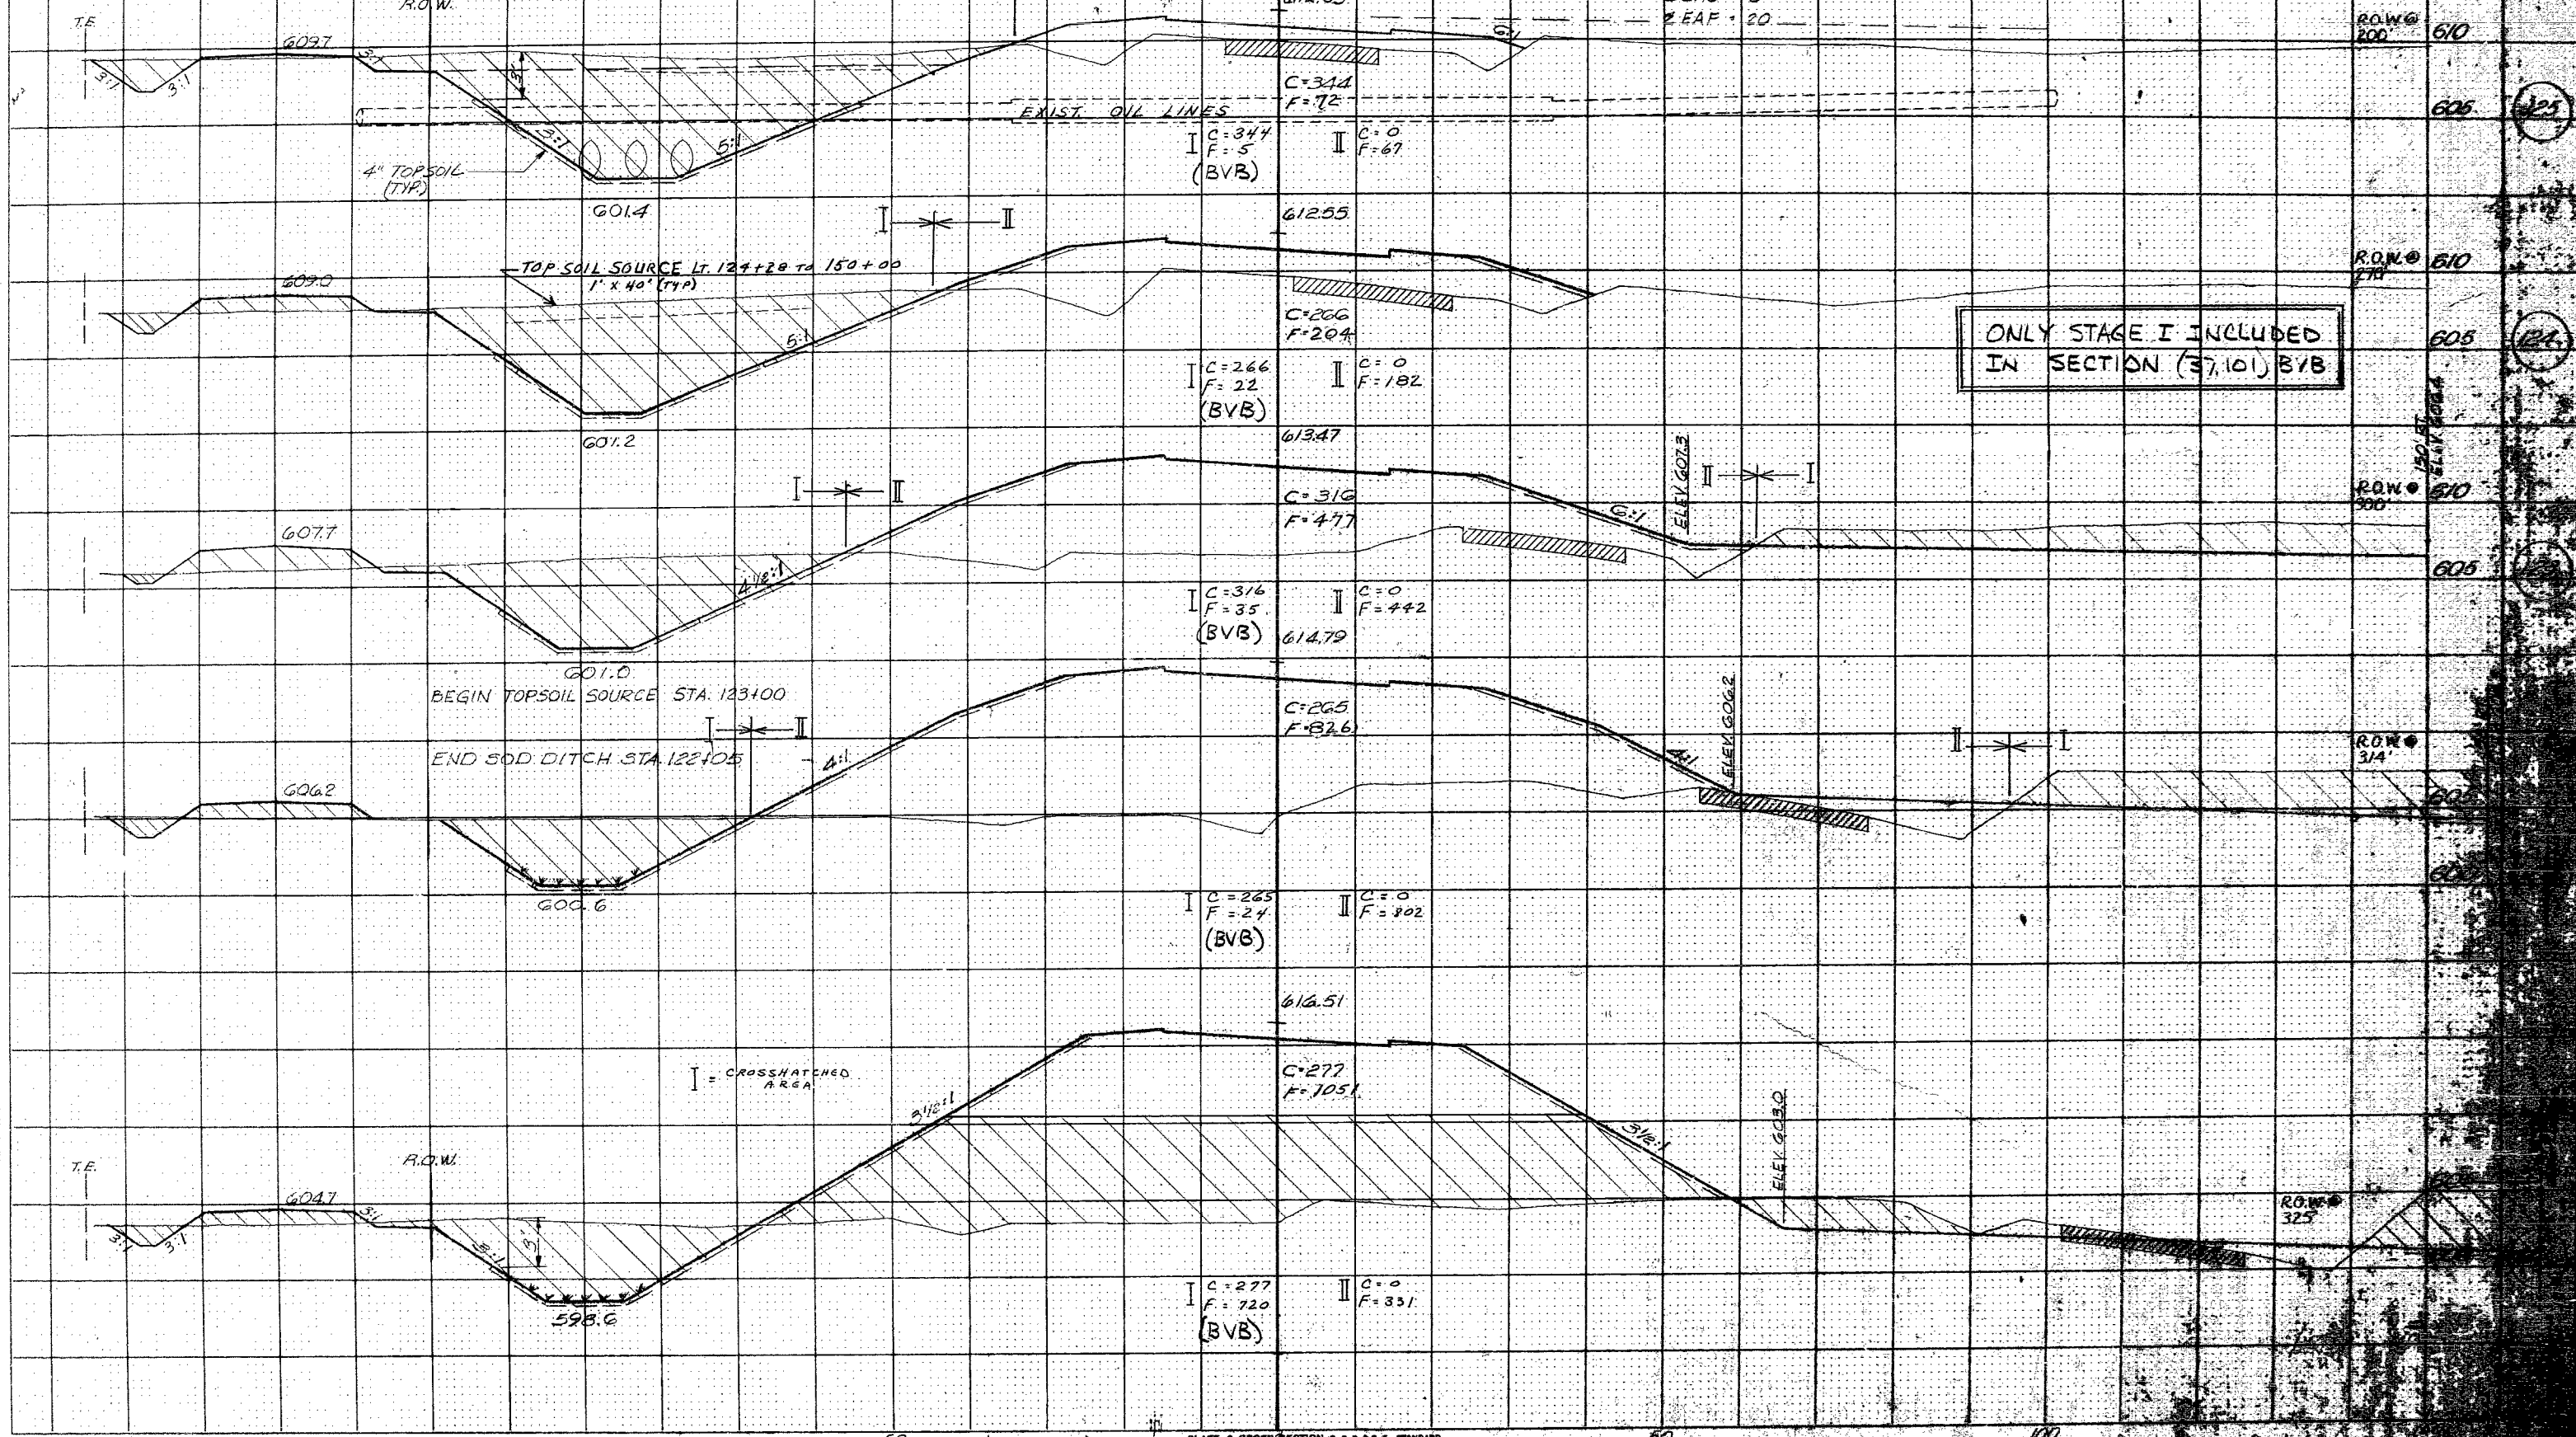

ONLY STAGE I INCLUDED  
 IN SECTION (37.101) BVB

I = CROSSHATCHED AREA

FINAL SURVEY PLOTTED NOTE BOOK NO. 132

ORIGINAL SURVEY PLOTTED NOTE BOOK NO. 132

ROUTE NO. FA 28  
 COUNTY LINCOLN  
 SECTION 67  
 TOWNSHIP 53


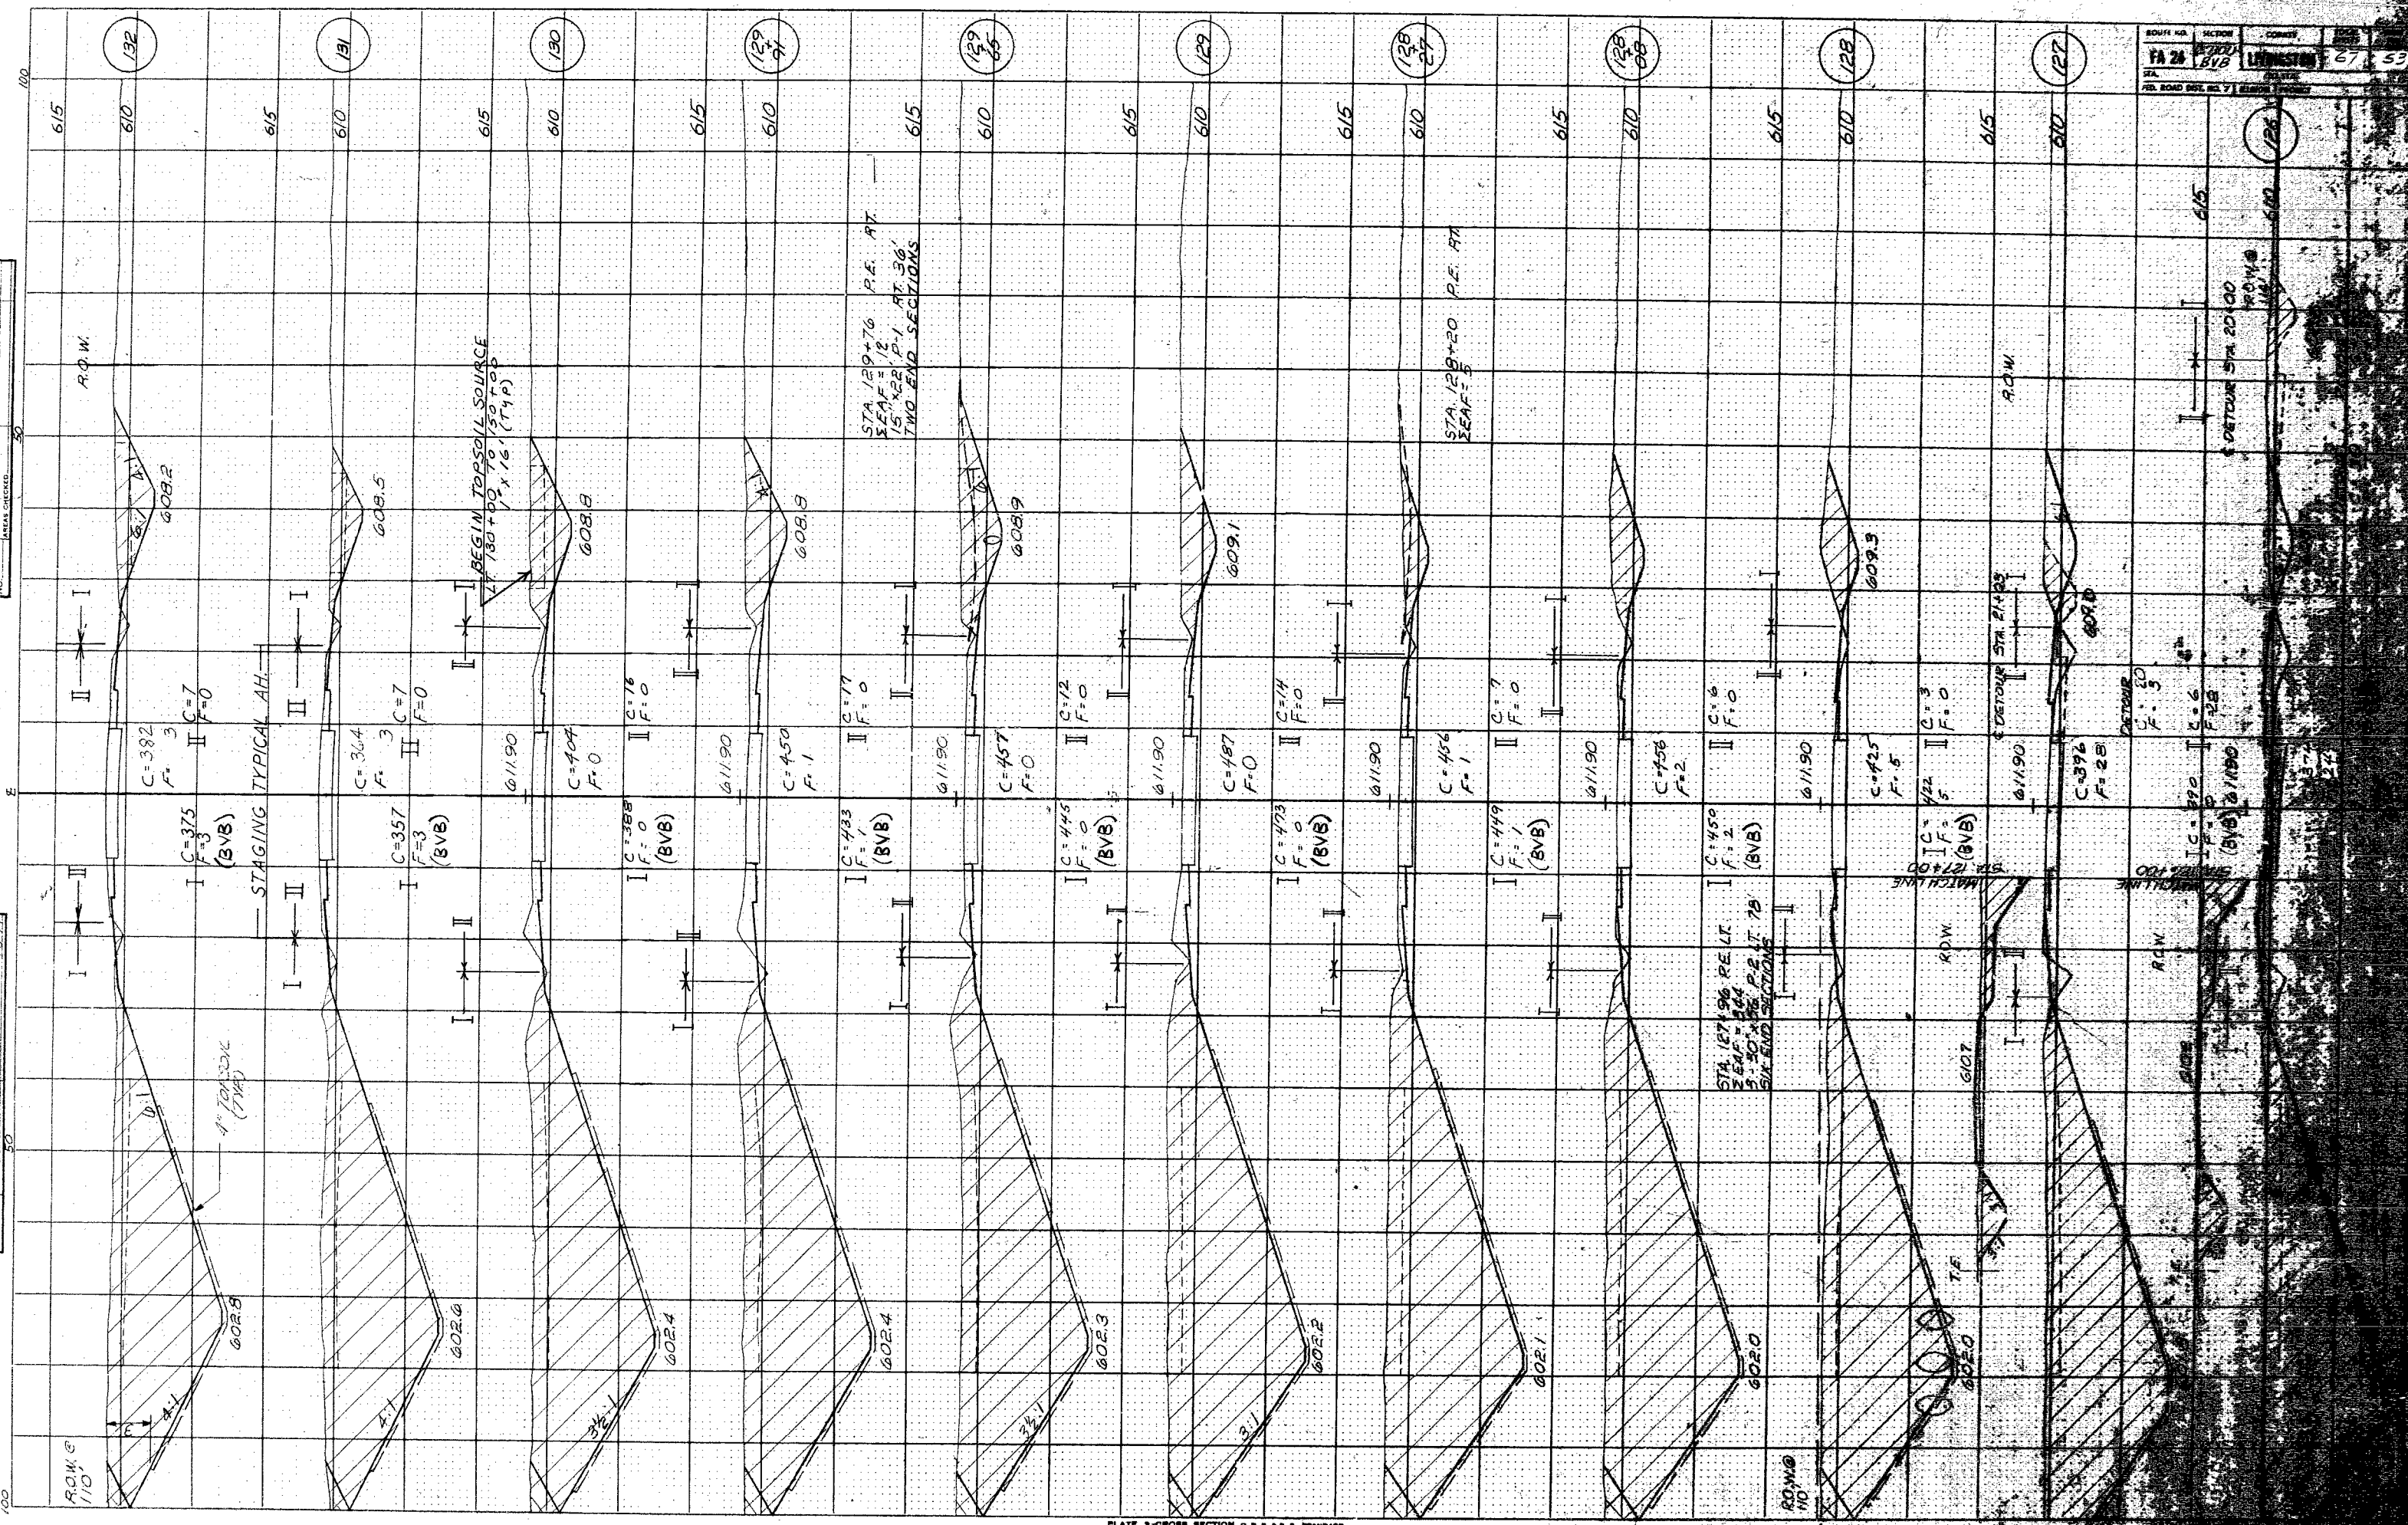


PLATE 3-CROSS SECTION O.P.A.S.E. STANDARD  
 NATIONAL TRACING PAPER DIVISION  
 I.P.S.M. CO., INC. CINCINNATI, OHIO

ORIGINAL SURVEY PLOTTED DATE  
 SURVEY PLOTTED DATE  
 NOTE BOOK NO. 117  
 AREAS CHECKED R.M.R. 6.72

FINAL SURVEY PLOTTED DATE  
 SURVEY PLOTTED DATE  
 NOTE BOOK NO. 117  
 AREAS CHECKED

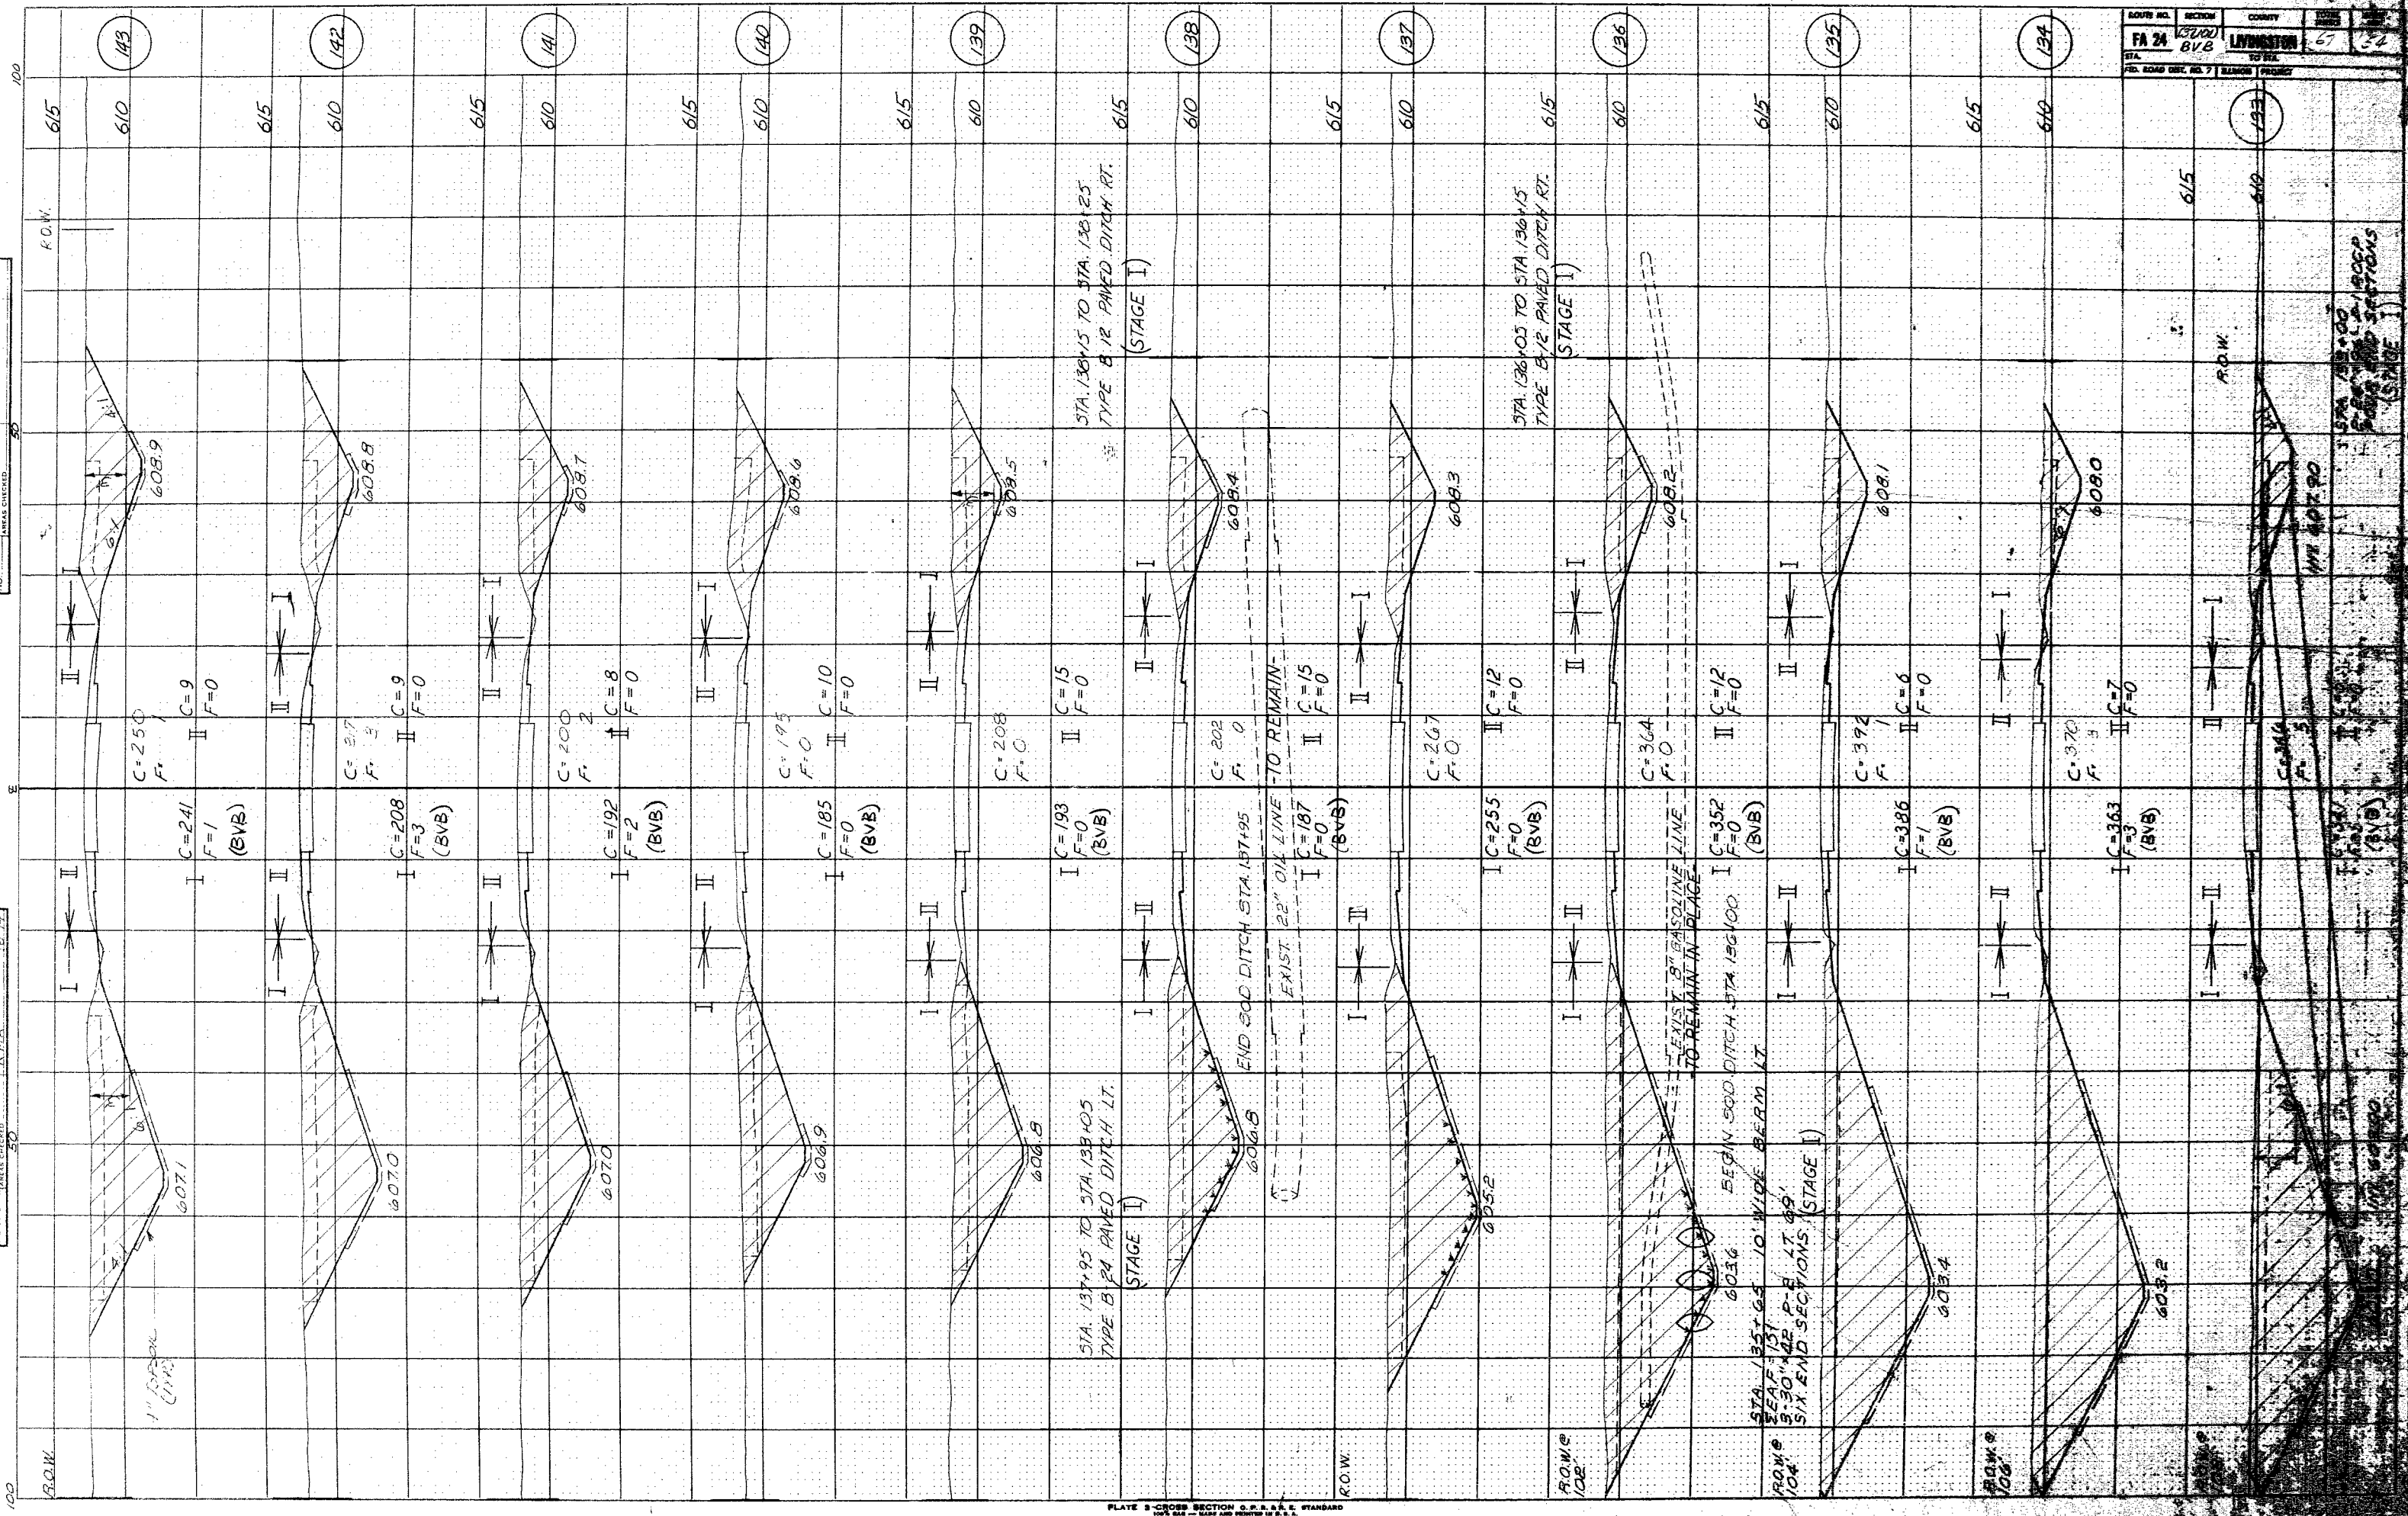

ROUTE NO.	SECTION	COUNTY	DATE
FA 24	81200	LIVINGSTON	67
STA.	BV8		62
FOR ROAD DIST. NO. 71 BARRON PROJECT			

PLATE 3-CROSS SECTION G.P.S.A.S. STANDARD  
 NATIONAL TRACING PAPER DIVISION  
 I.P.A. CO., INC. URBANVILLE, GEORGIA

STA. 137+00 TO STA. 138+00  
 TYPE B 1/2 PAVED DITCHES  
 (STAGE I)

STA. 138+00 TO STA. 139+25  
 TYPE B 1/2 PAVED DITCH RT.  
 (STAGE I)

STA. 139+25 TO STA. 139+95  
 TYPE B 1/2 PAVED DITCH LT.  
 (STAGE I)

STA. 139+95 TO STA. 140+05  
 TYPE B 1/2 PAVED DITCH LT.  
 (STAGE I)


STA. 140+05 TO STA. 141+05  
 TYPE B 1/2 PAVED DITCH LT.  
 (STAGE I)

STA. 141+05 TO STA. 142+05  
 TYPE B 1/2 PAVED DITCH LT.  
 (STAGE I)

STA. 142+05 TO STA. 143+05  
 TYPE B 1/2 PAVED DITCH LT.  
 (STAGE I)

FINAL SURVEY PLOTTED BY DATE  
 NOTE BOOK NO. AREA CHECKED

ORIGINAL SURVEY PLOTTED BY DATE  
 PHOTOGRAPHIC COPY BY DATE  
 NOTE BOOK NO. AREA CHECKED

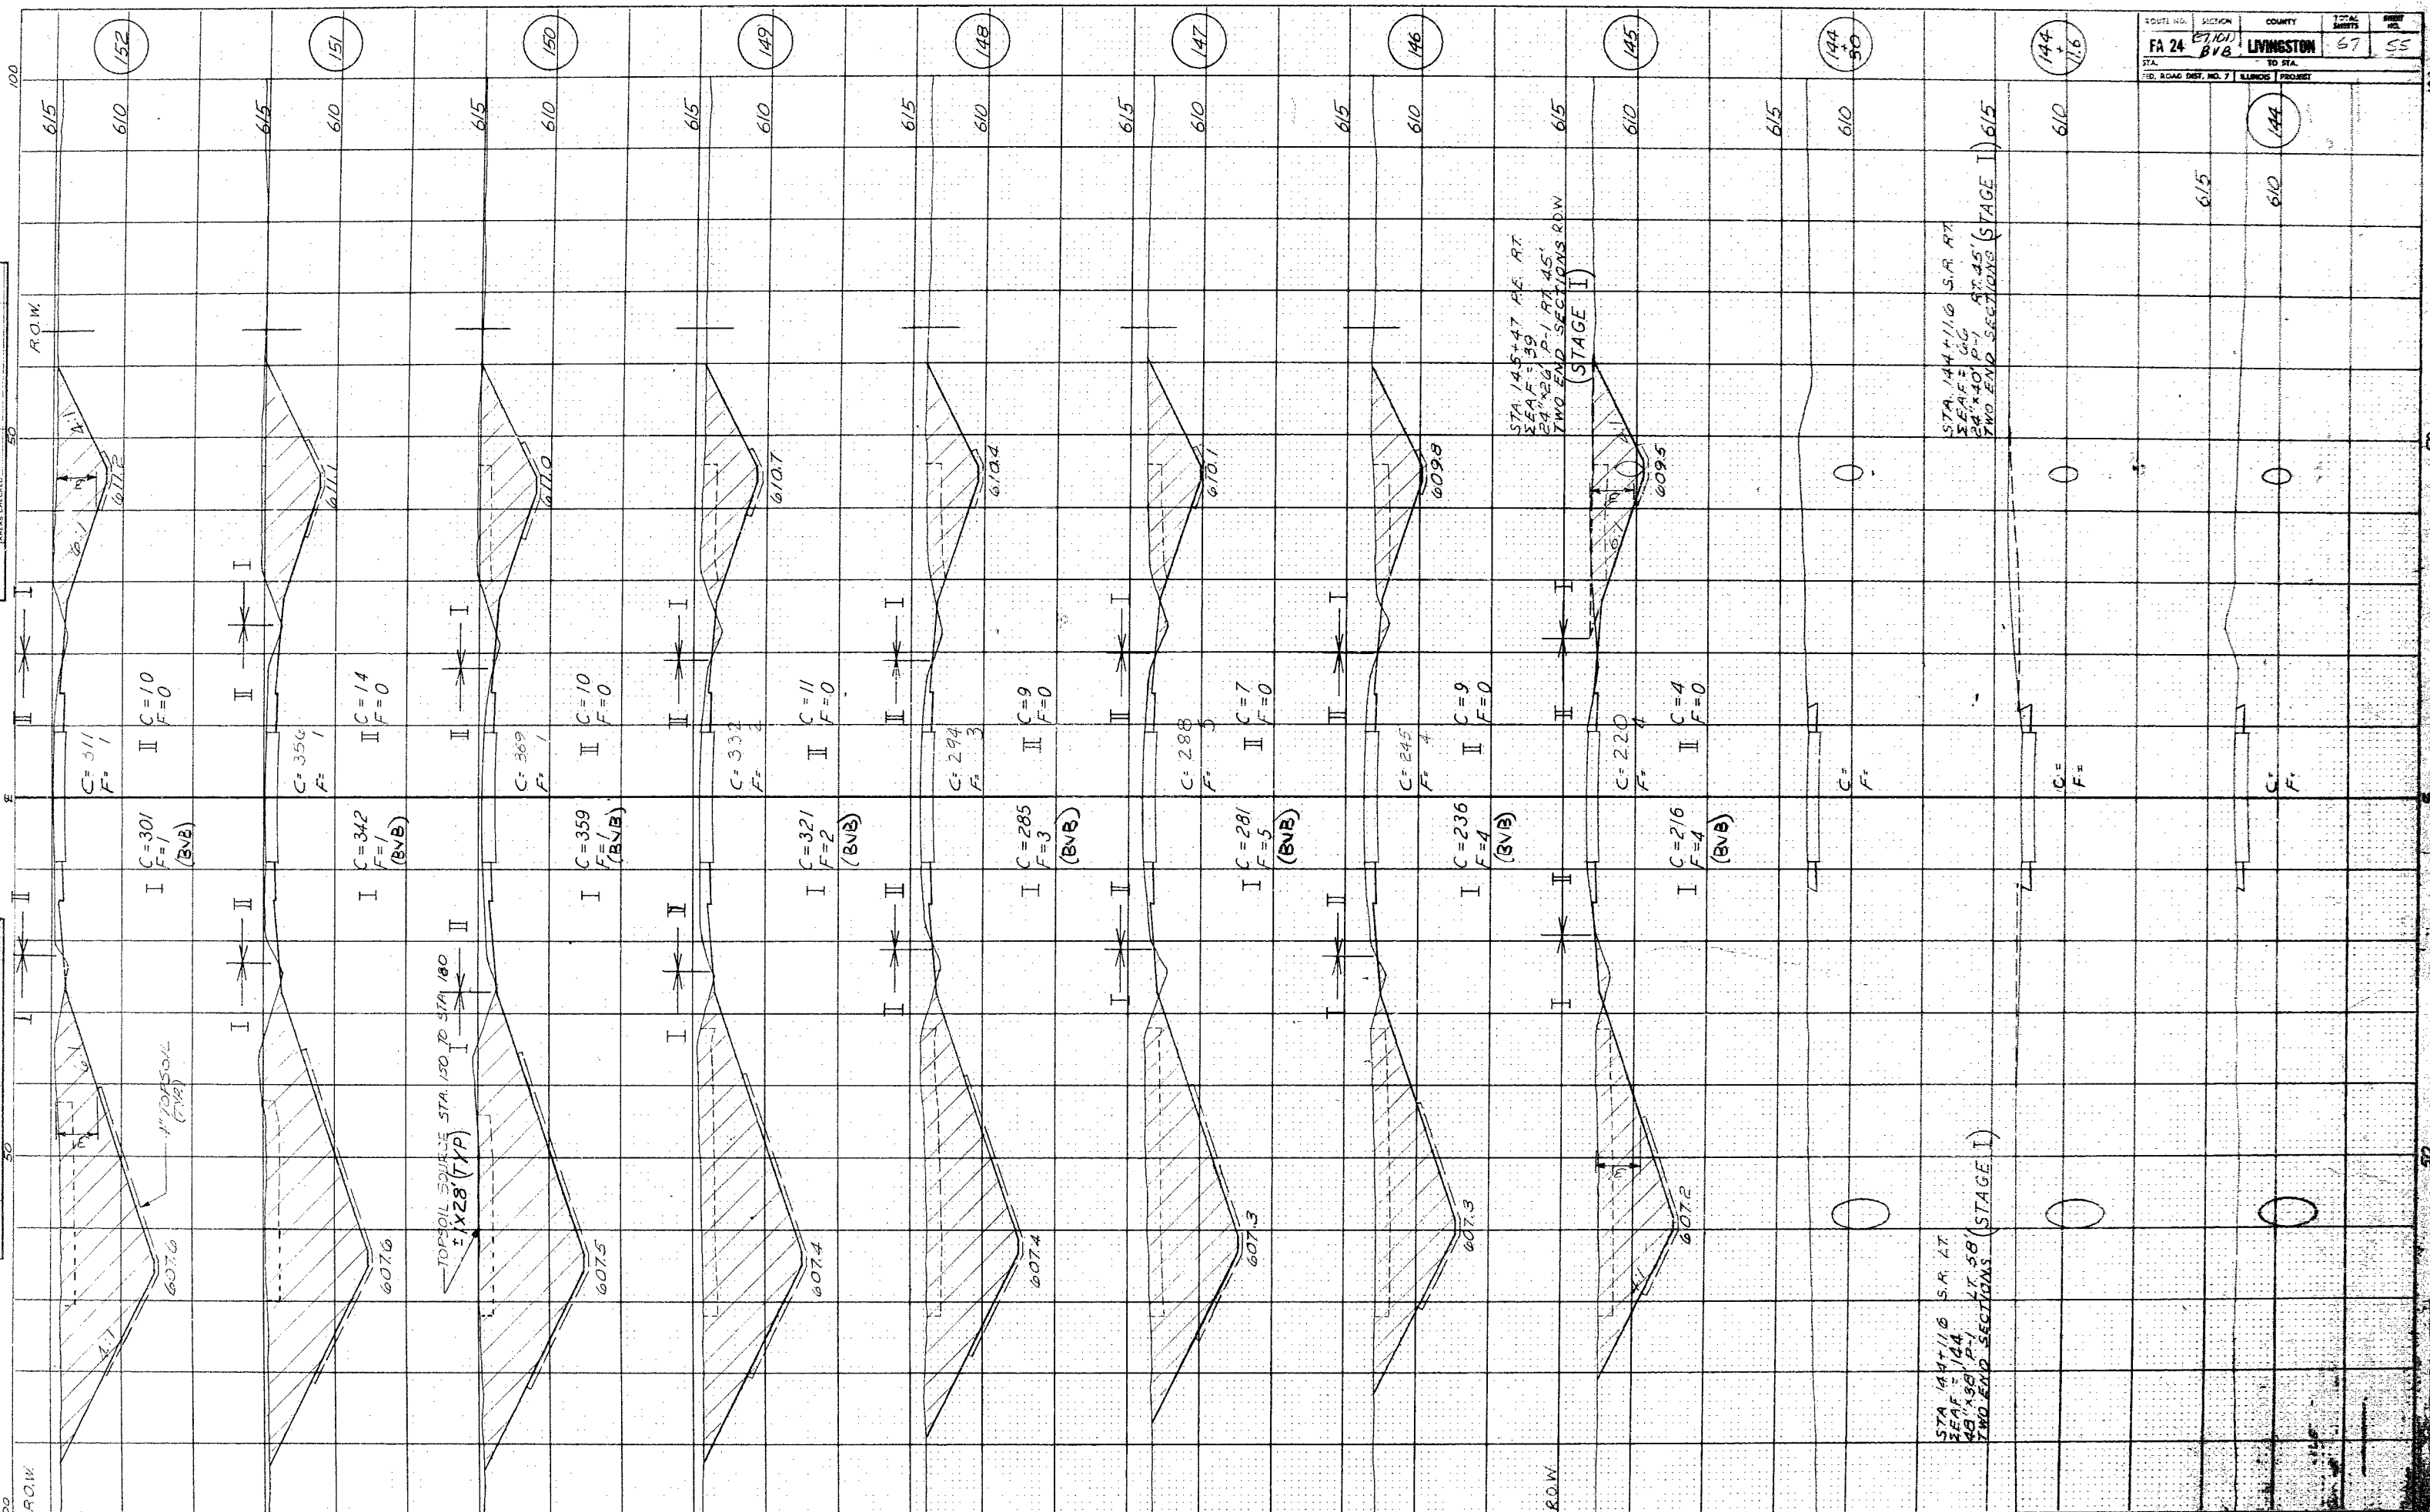

ROUTE NO.	SECTION	COUNTY	TOTAL SHEETS	SHEET NO.
FA 24	87101 B18	LIVINGSTON	67	55
STA.	TO STA.			
RD. NO. DIST. NO. 7	LLINOIS	PROJECT		

PLATE 3 - CROSS SECTION Q.P.A.S.E. STANDARD  
 NATIONAL TRACING PAPER DIVISION  
 14 P.A. CO., INC. INDIANAPOLIS, INDIANA

FINAL SURVEY  
 INVENTED  
 PLOTTED  
 NOTE BOOK  
 TEMPLATE  
 NO. 1  
 AREA CHECKED

ORIGINAL SURVEY  
 INVENTED  
 PLOTTED  
 NOTE BOOK  
 TEMPLATE  
 NO. 1  
 AREA CHECKED

ROUTE NO. SECTION COUNTY  
 FA 24 37107 BVB LIVINGSTON  
 STA. NO. 67 56  
 ROAD DIST. NO. 7 BRIDGE PROJECT

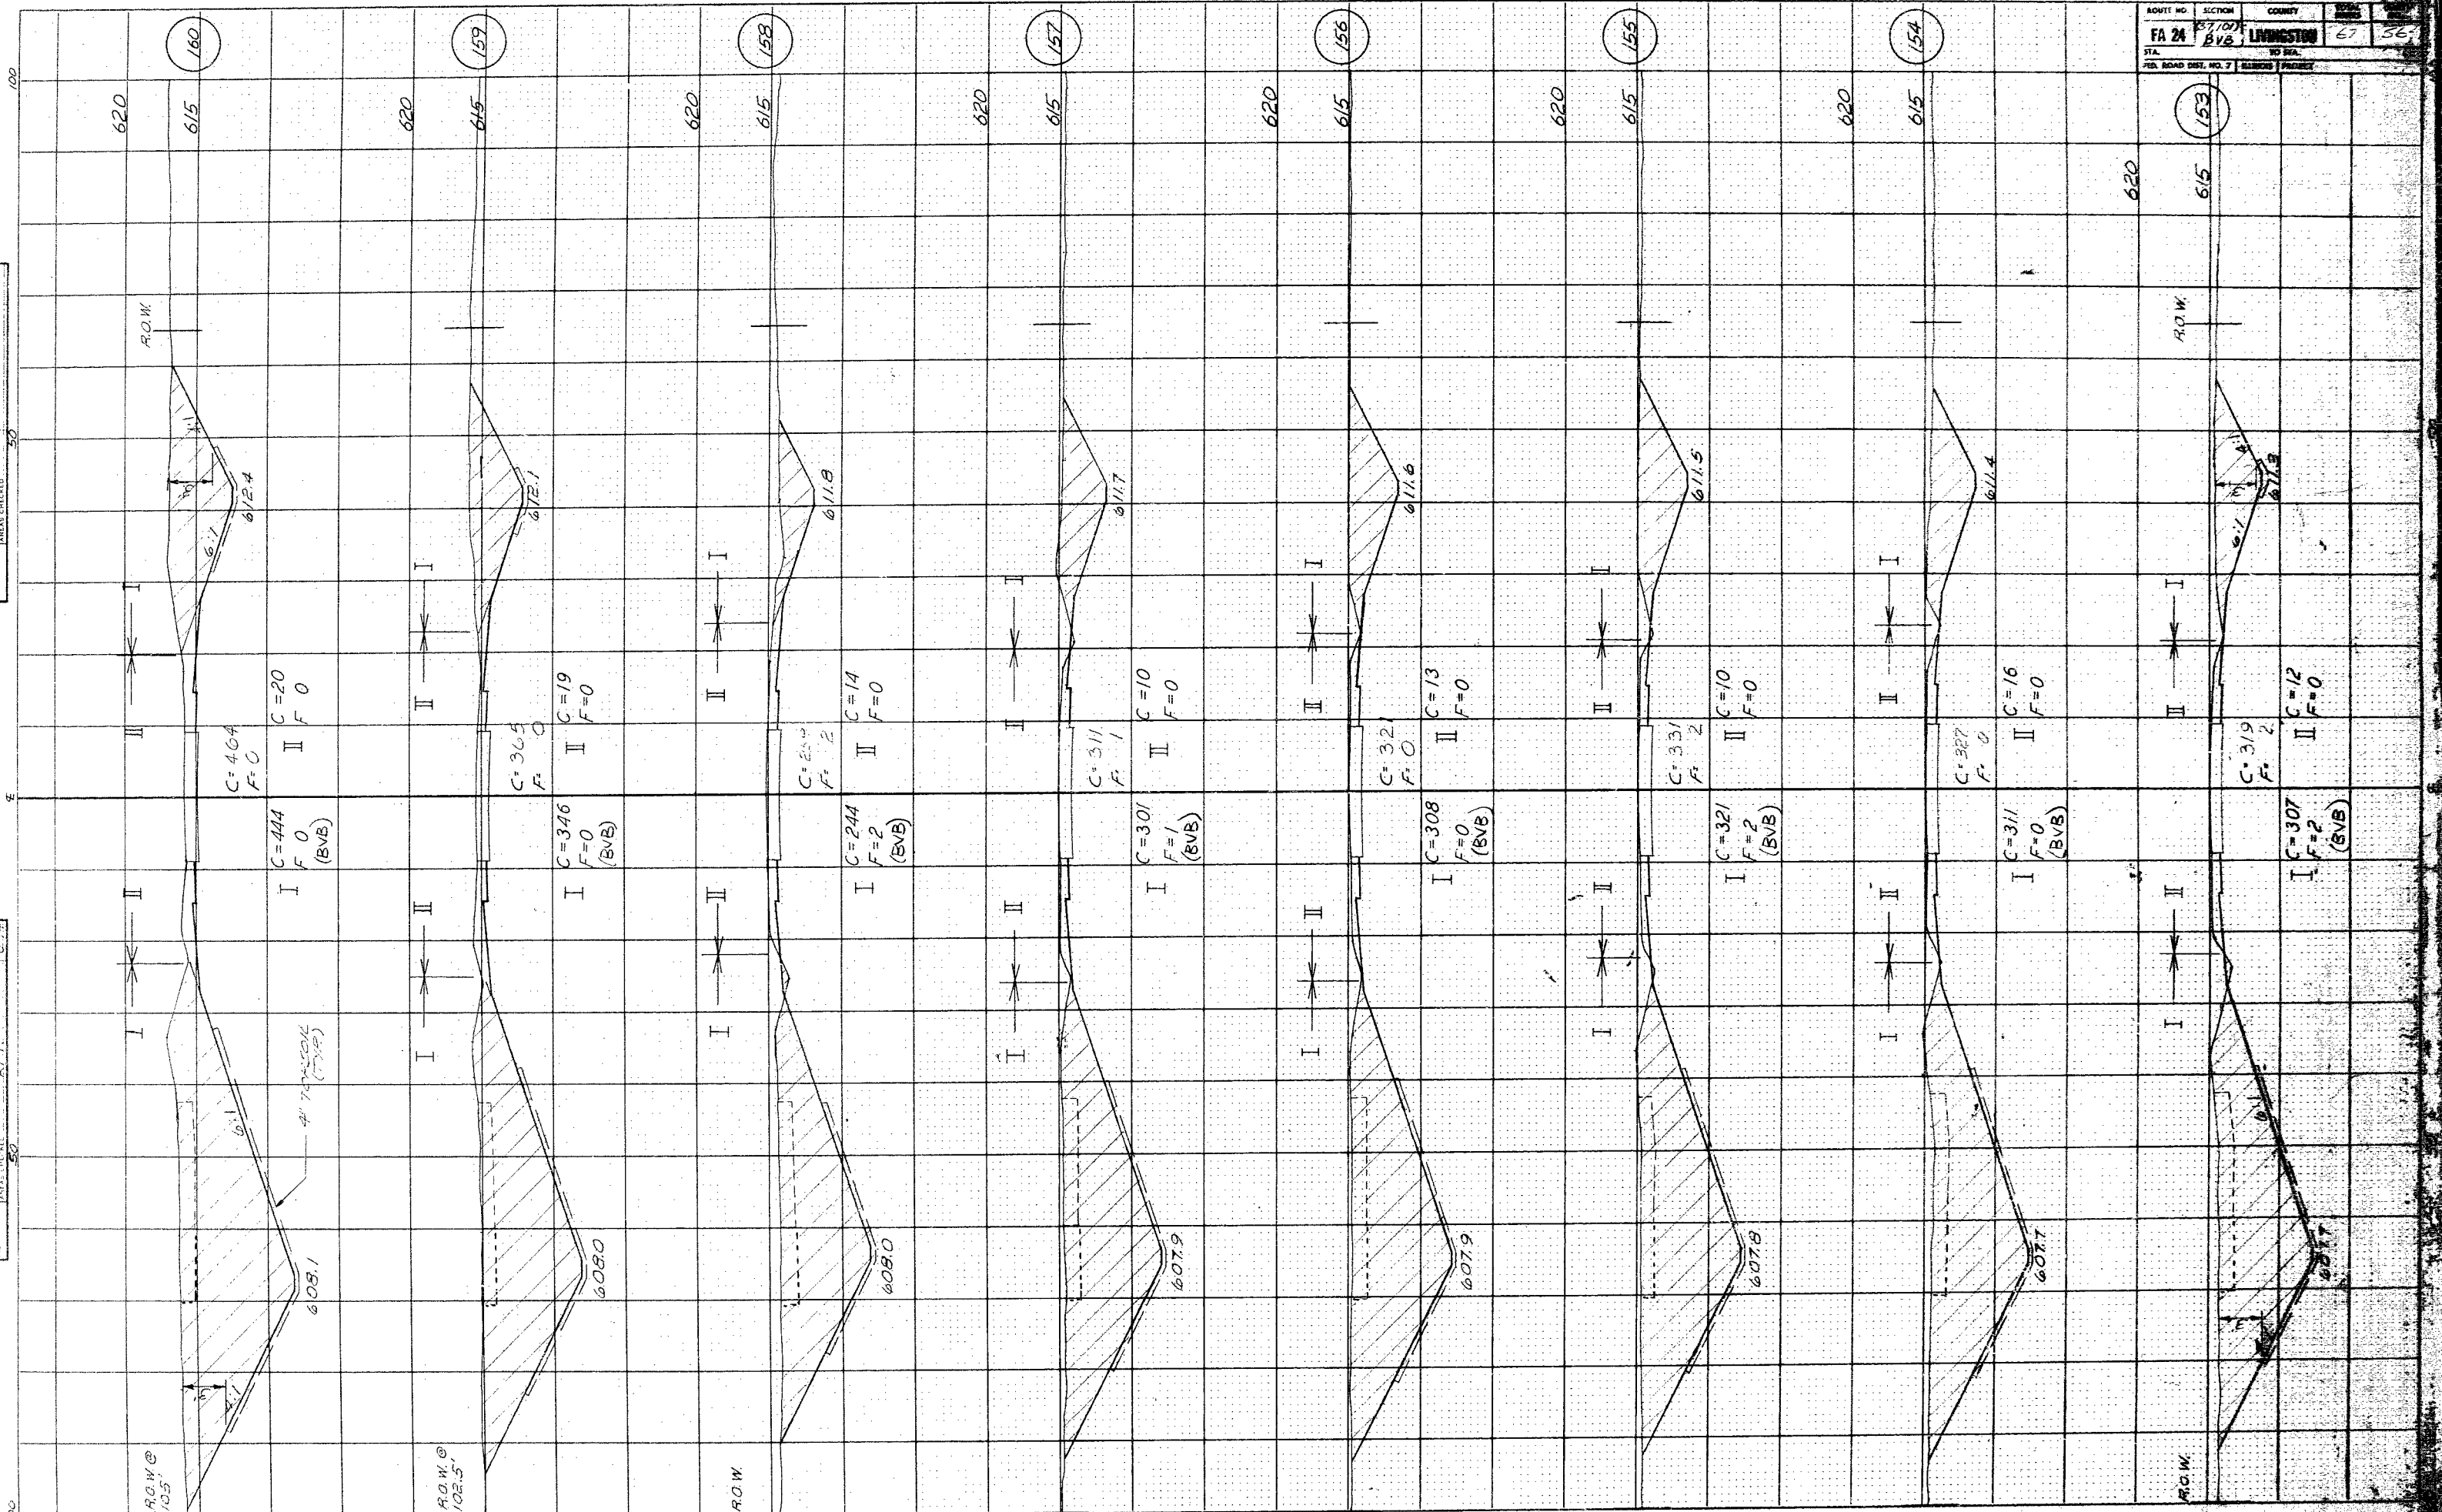


PLATE 3 - CROSS SECTION O. P. R. & E. STANDARD  
 NATIONAL TRACING PAPER DIVISION  
 I. S. P. & L. CO., INC. INDIANAPOLIS, INDIANA

FINAL SURVEY  
 SURVEYED  
 PLOTTED  
 NOTE BOOK  
 AREAS  
 CHECKED

ORIGINAL SURVEY  
 SURVEYED  
 PLOTTED  
 NOTE BOOK  
 AREAS  
 CHECKED

ROUTE NO. SECTION COUNTY  
 FA 24 87.00 LIVINGSTON  
 NO. ROAD DIST. NO. 7


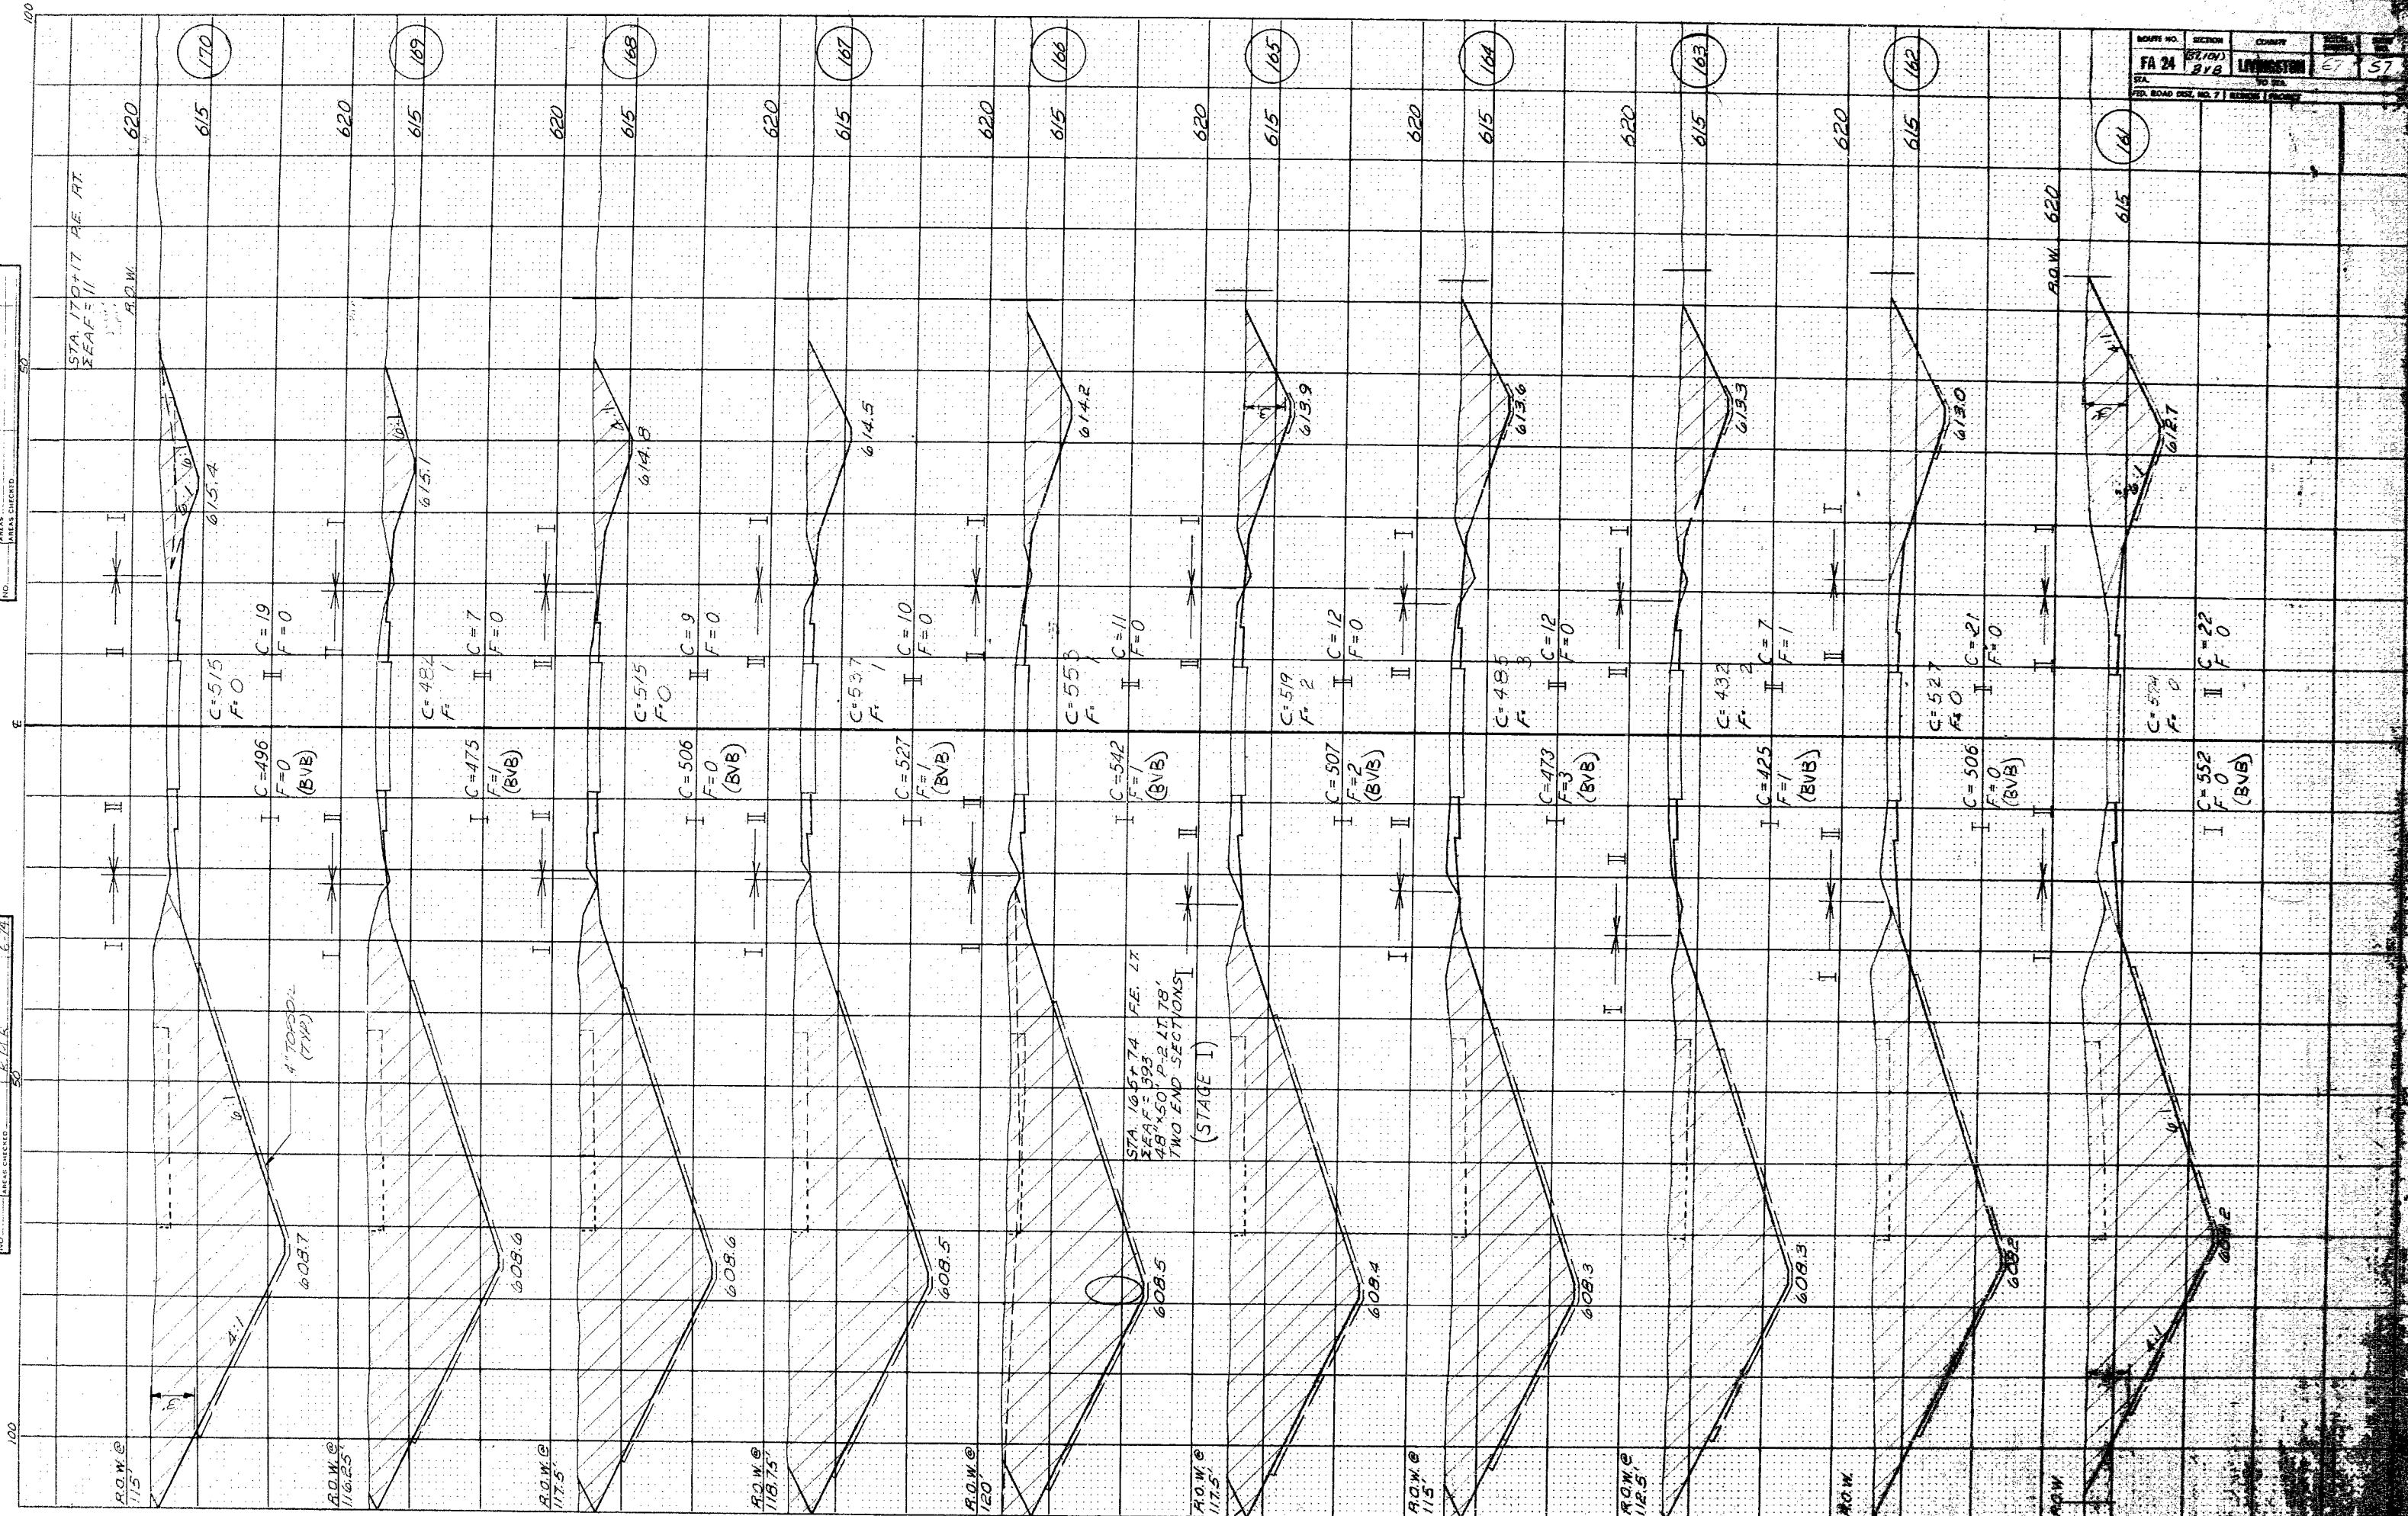


PLATE 3-CROSS SECTION O.P.R.S.S.E. STANDARD  
 NATIONAL TRACING PAPER DIVISION  
 INDIANAPOLIS, INDIANA

FINAL SURVEY PLOTTED  
 NOTE BOOK NO. 5-278  
 DATE 5-27-28

ORIGINAL SURVEY PLOTTED  
 NOTE BOOK NO. 5-278  
 DATE 5-27-28

ROUTE NO. SECTION COUNTY  
 FA 24 157.001 BVB LIVINGSTON 67 58  
 STA. TO STA.  
 FID. ROAD DIST. NO. 7 157.001 PROJECT

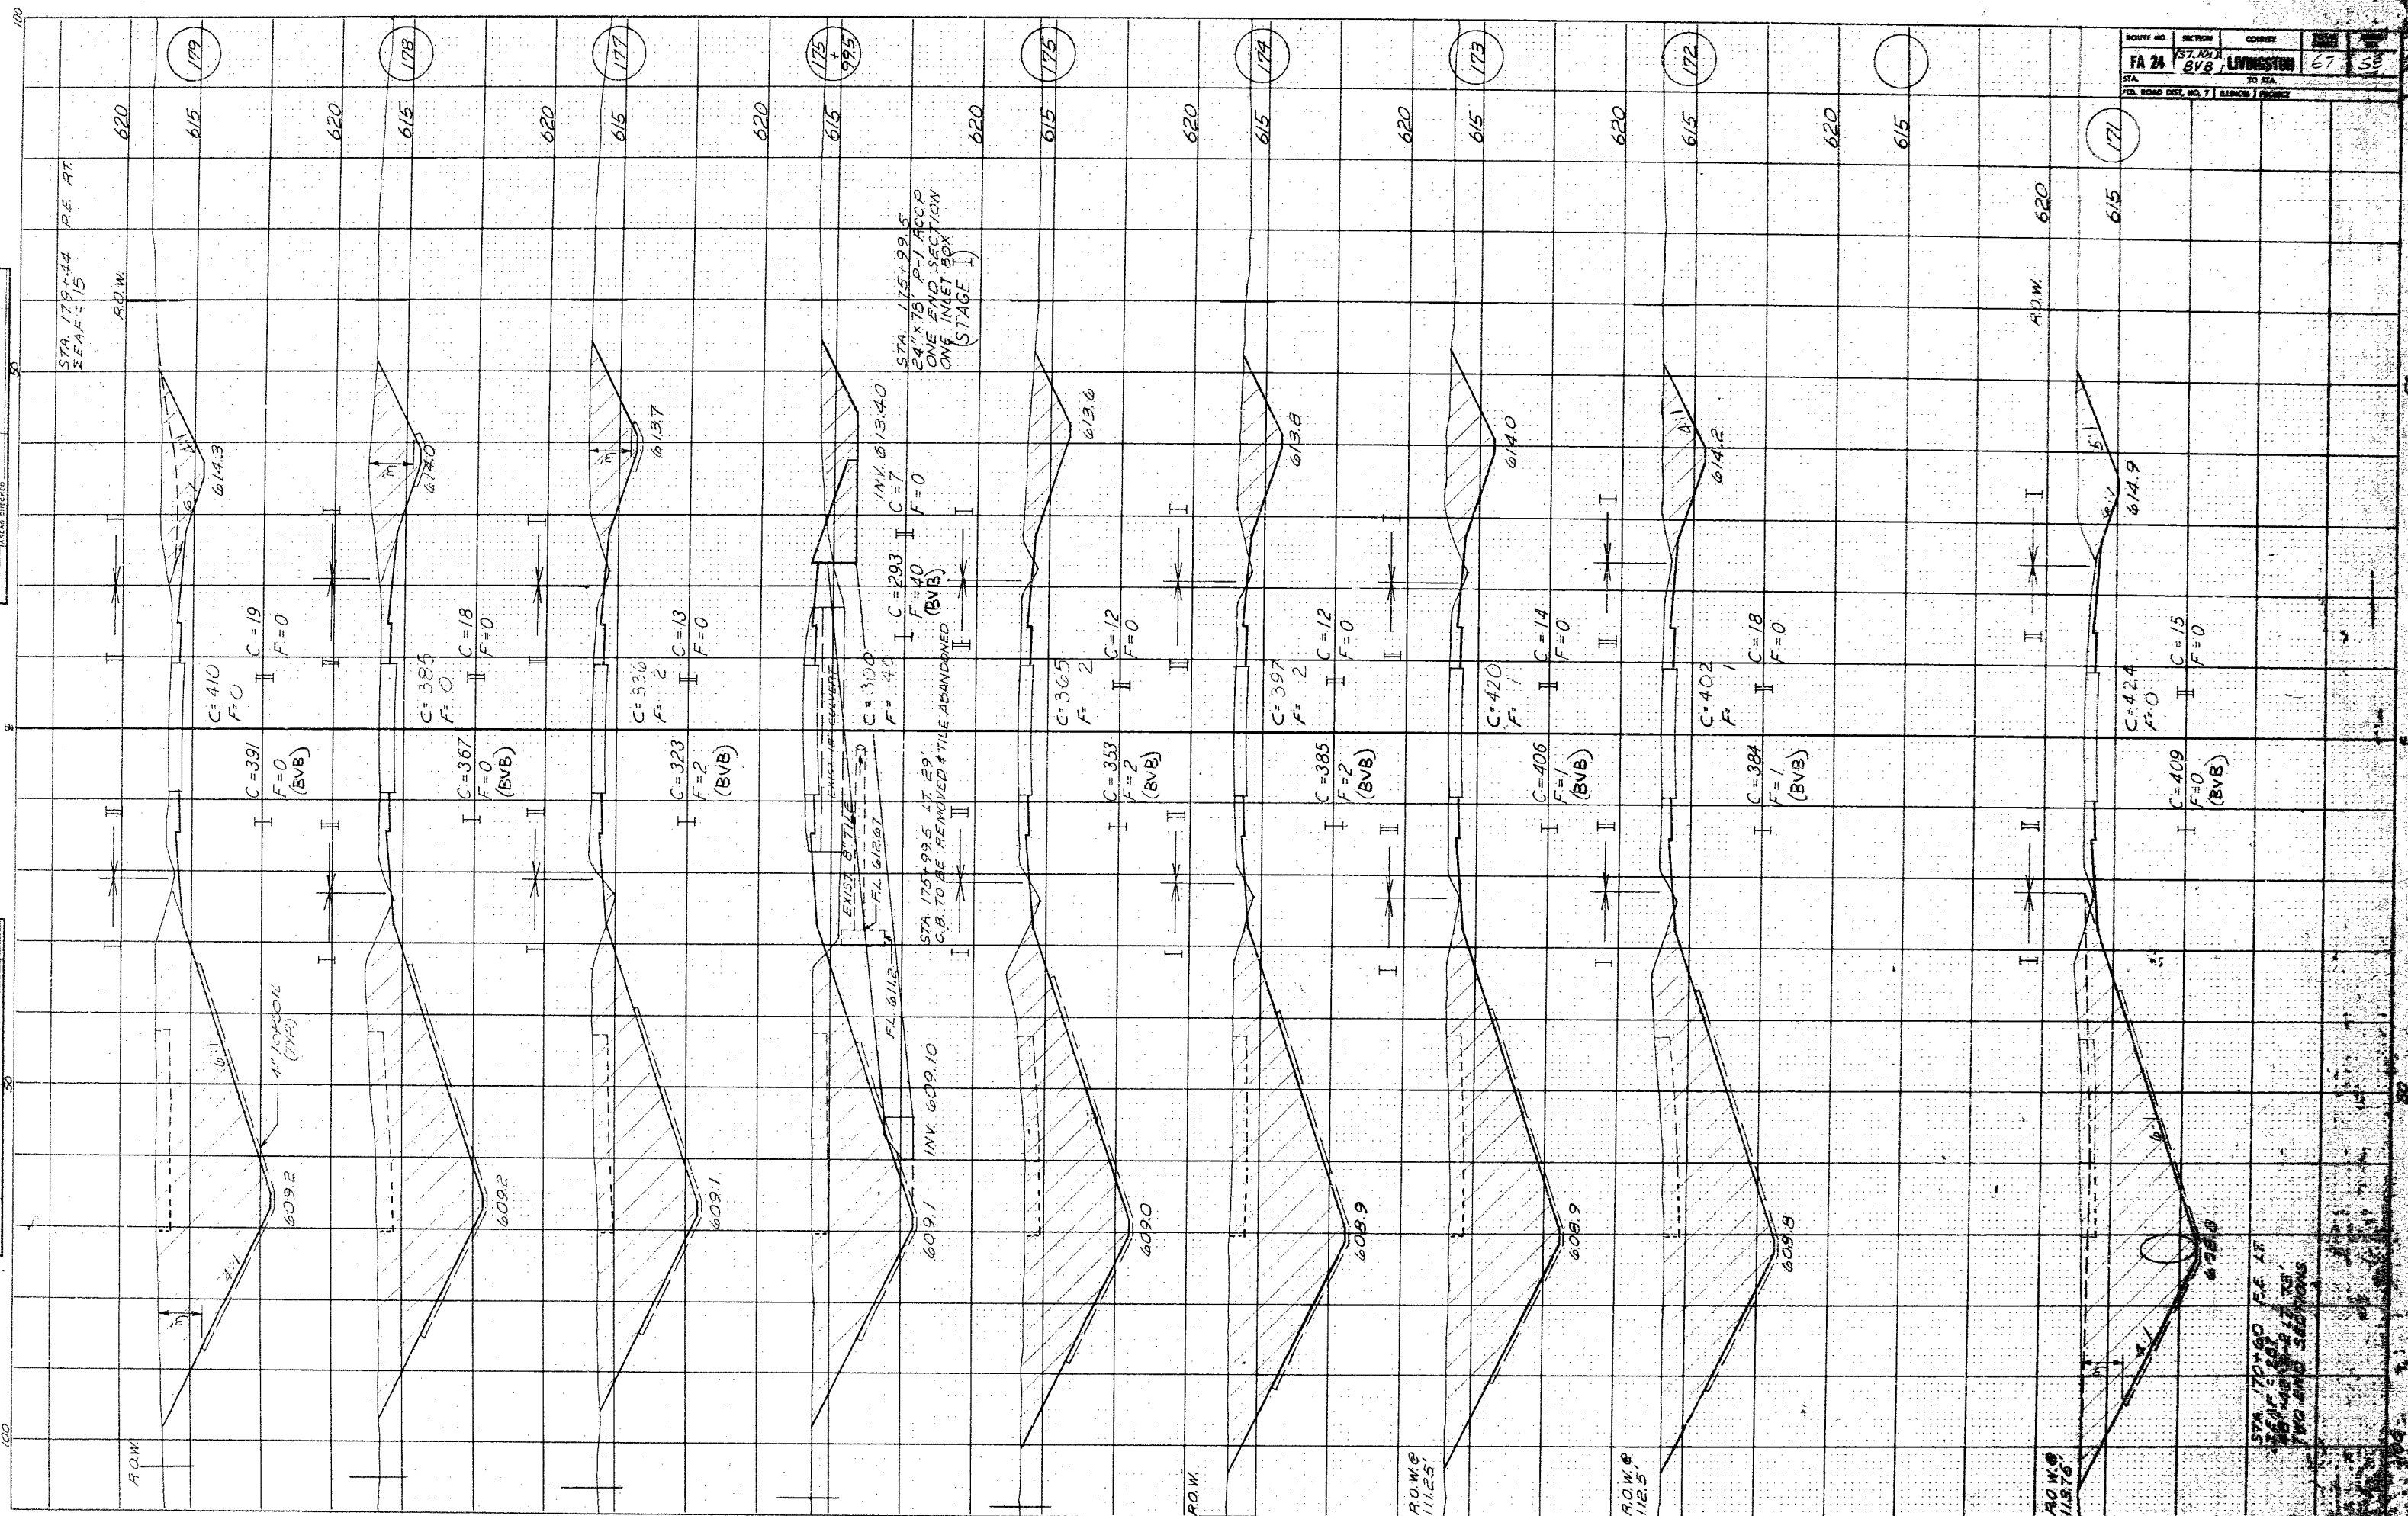

STA. 175+99.5 AT 29'  
 C.B. TO BE REMOVED & TILE ADVANCED

R.O.W. @ 11.25'

FINAL SURVEY SURVEYED BY DATE  
 PLOTTED BY DATE  
 NOTE BOOK NO. DATE  
 AREA CHECKED

ORIGINAL SURVEY SURVEYED BY DATE  
 PLOTTED BY DATE  
 NOTE BOOK NO. DATE  
 AREA CHECKED

ROUTE NO.	SECTION	COUNTY	DEPARTMENT
FA 24	37.1A1	LINCOLN	67
STA.	BY B	TO STA.	59
31 ROAD DIST. NO. 7			


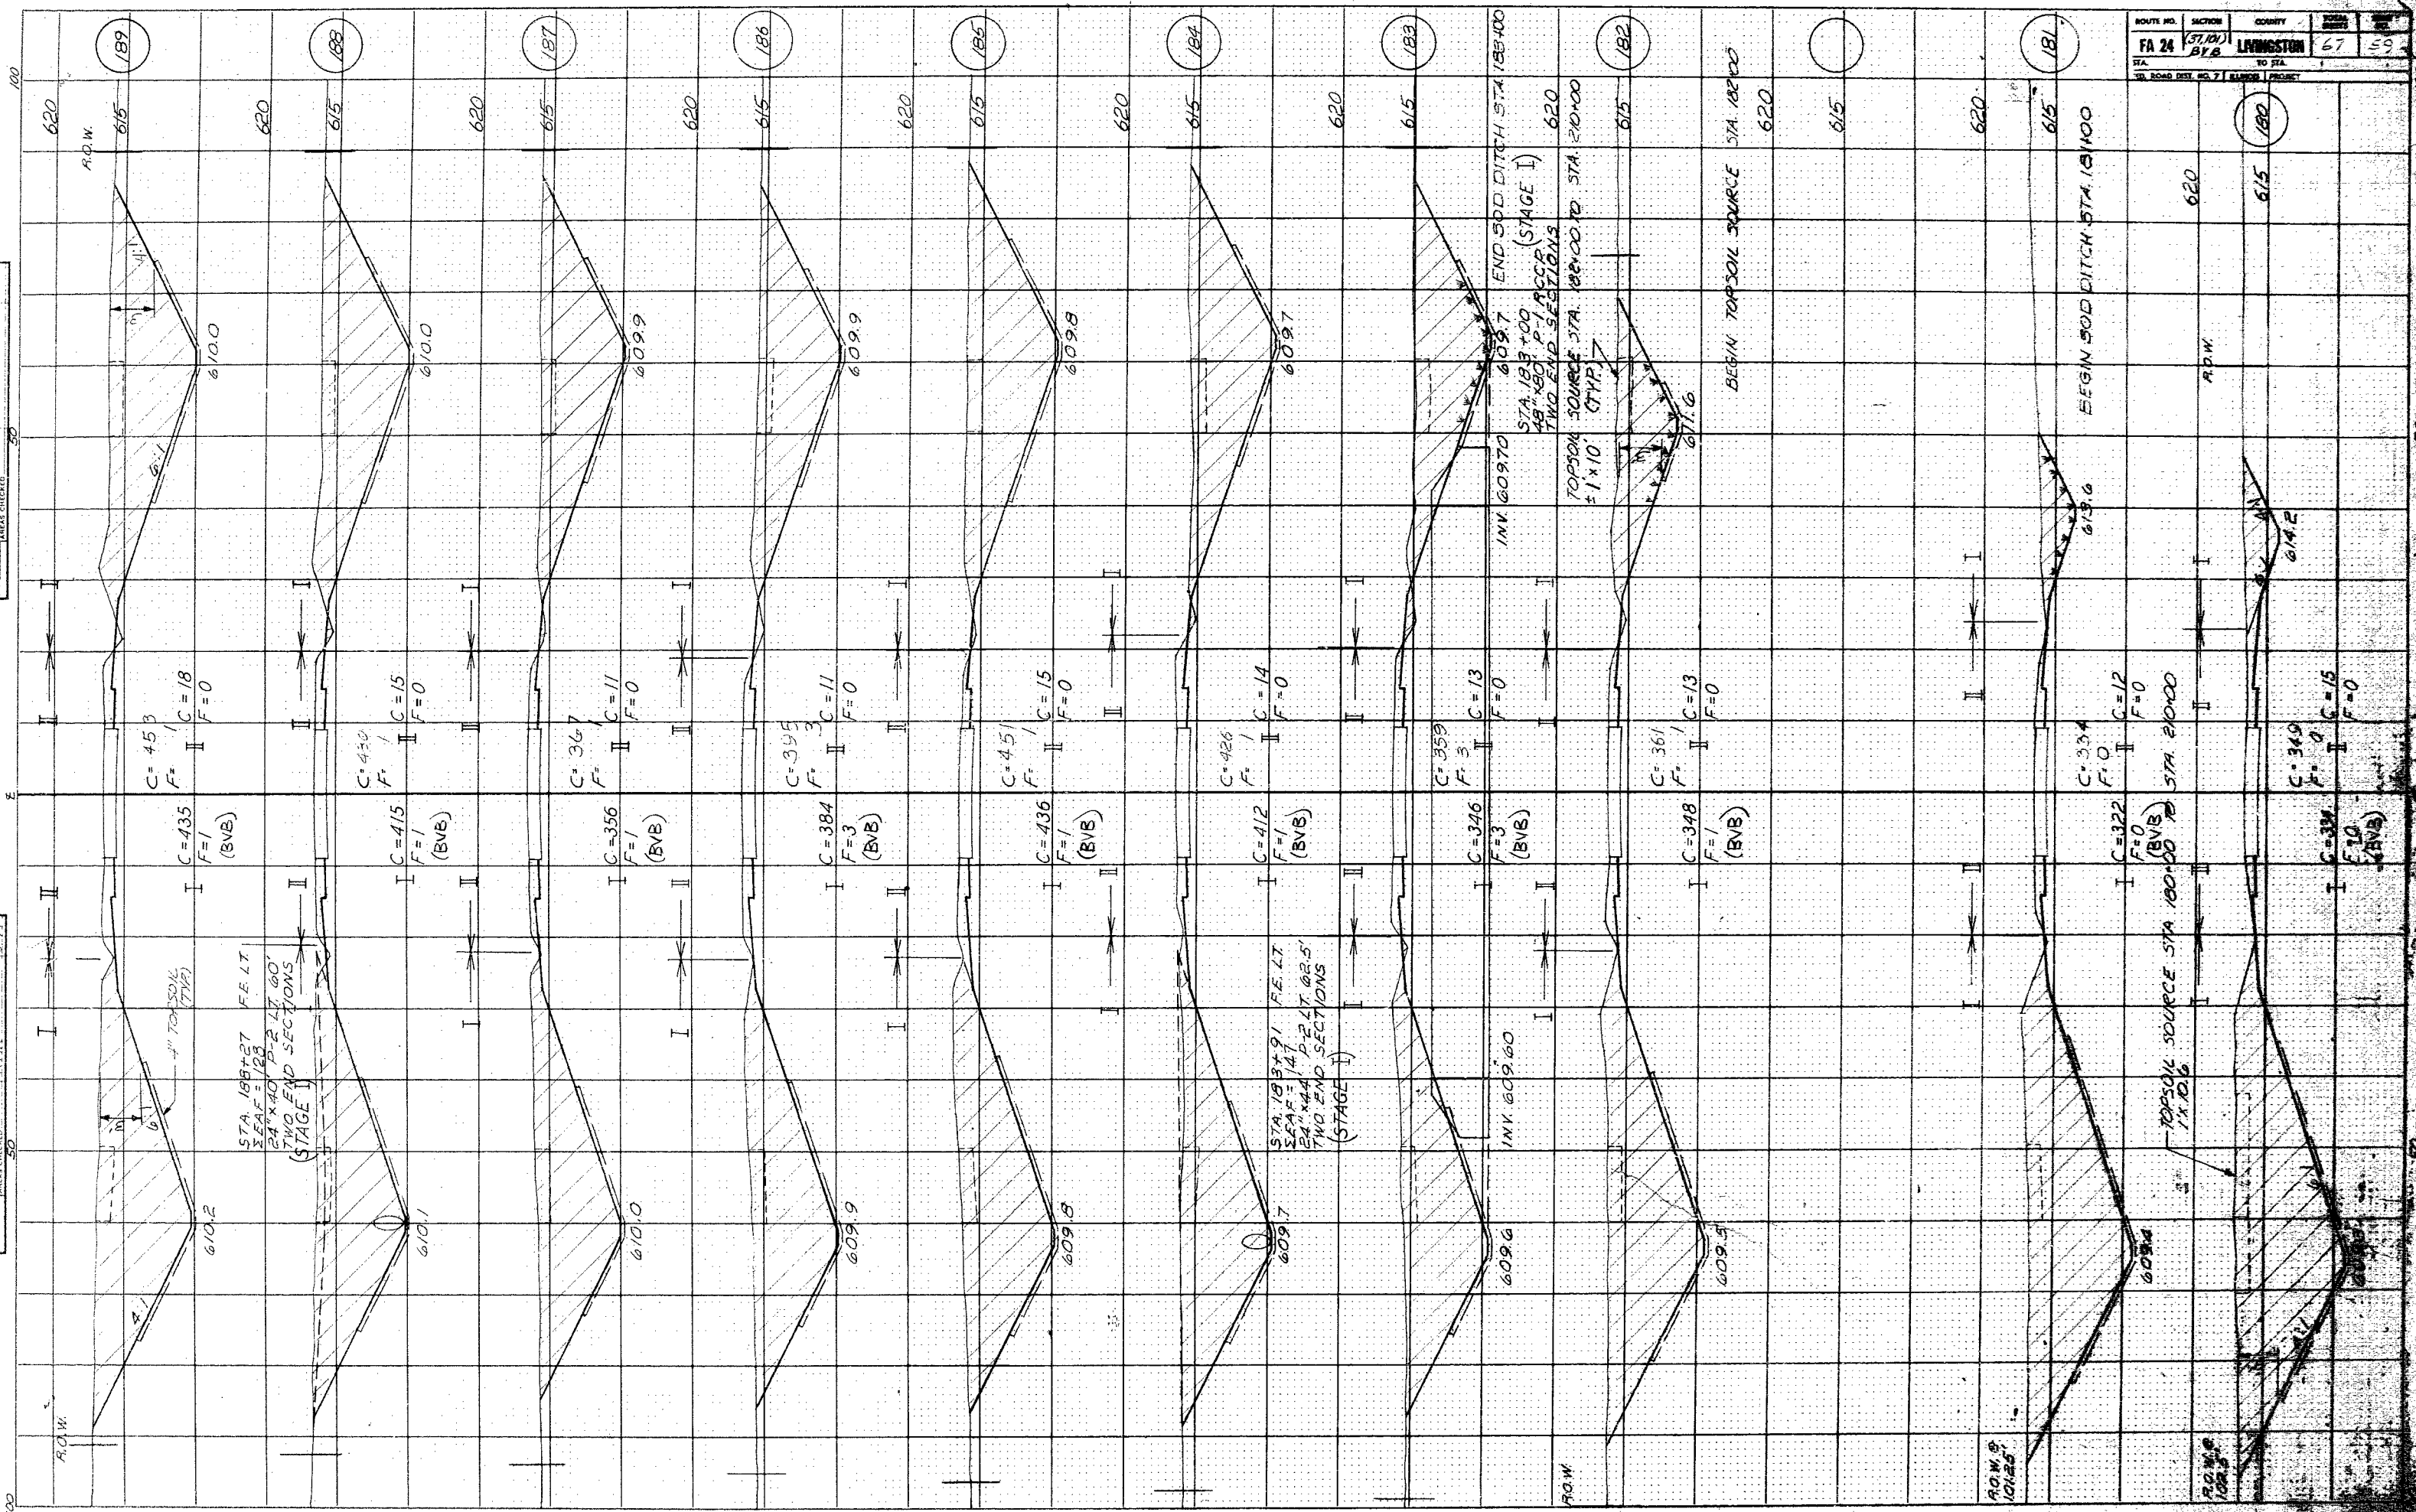


PLATE 3-CROSS SECTION O.P.R.S.E. STANDARD  
 NATIONAL TRACING PAPER DIVISION  
 14 P. M. CO., INC. INDIANAPOLIS, INDIANA

FINAL SURVEY  
 NOTE BOOK  
 NO. \_\_\_\_\_  
 DATE \_\_\_\_\_  
 BY \_\_\_\_\_  
 CHECKED \_\_\_\_\_  
 AREA CHECKED \_\_\_\_\_

ORIGINAL SURVEY  
 NOTE BOOK  
 NO. \_\_\_\_\_  
 DATE \_\_\_\_\_  
 BY \_\_\_\_\_  
 CHECKED \_\_\_\_\_  
 AREA CHECKED \_\_\_\_\_


ROUTE NO. SECTION COUNTY TOTAL STATION  
 FA 24 (37100) B18 LIVINGSTON 67 30  
 STA. TO STA.  
 750 ROAD DIST. NO. 7 ELMORE RECORD

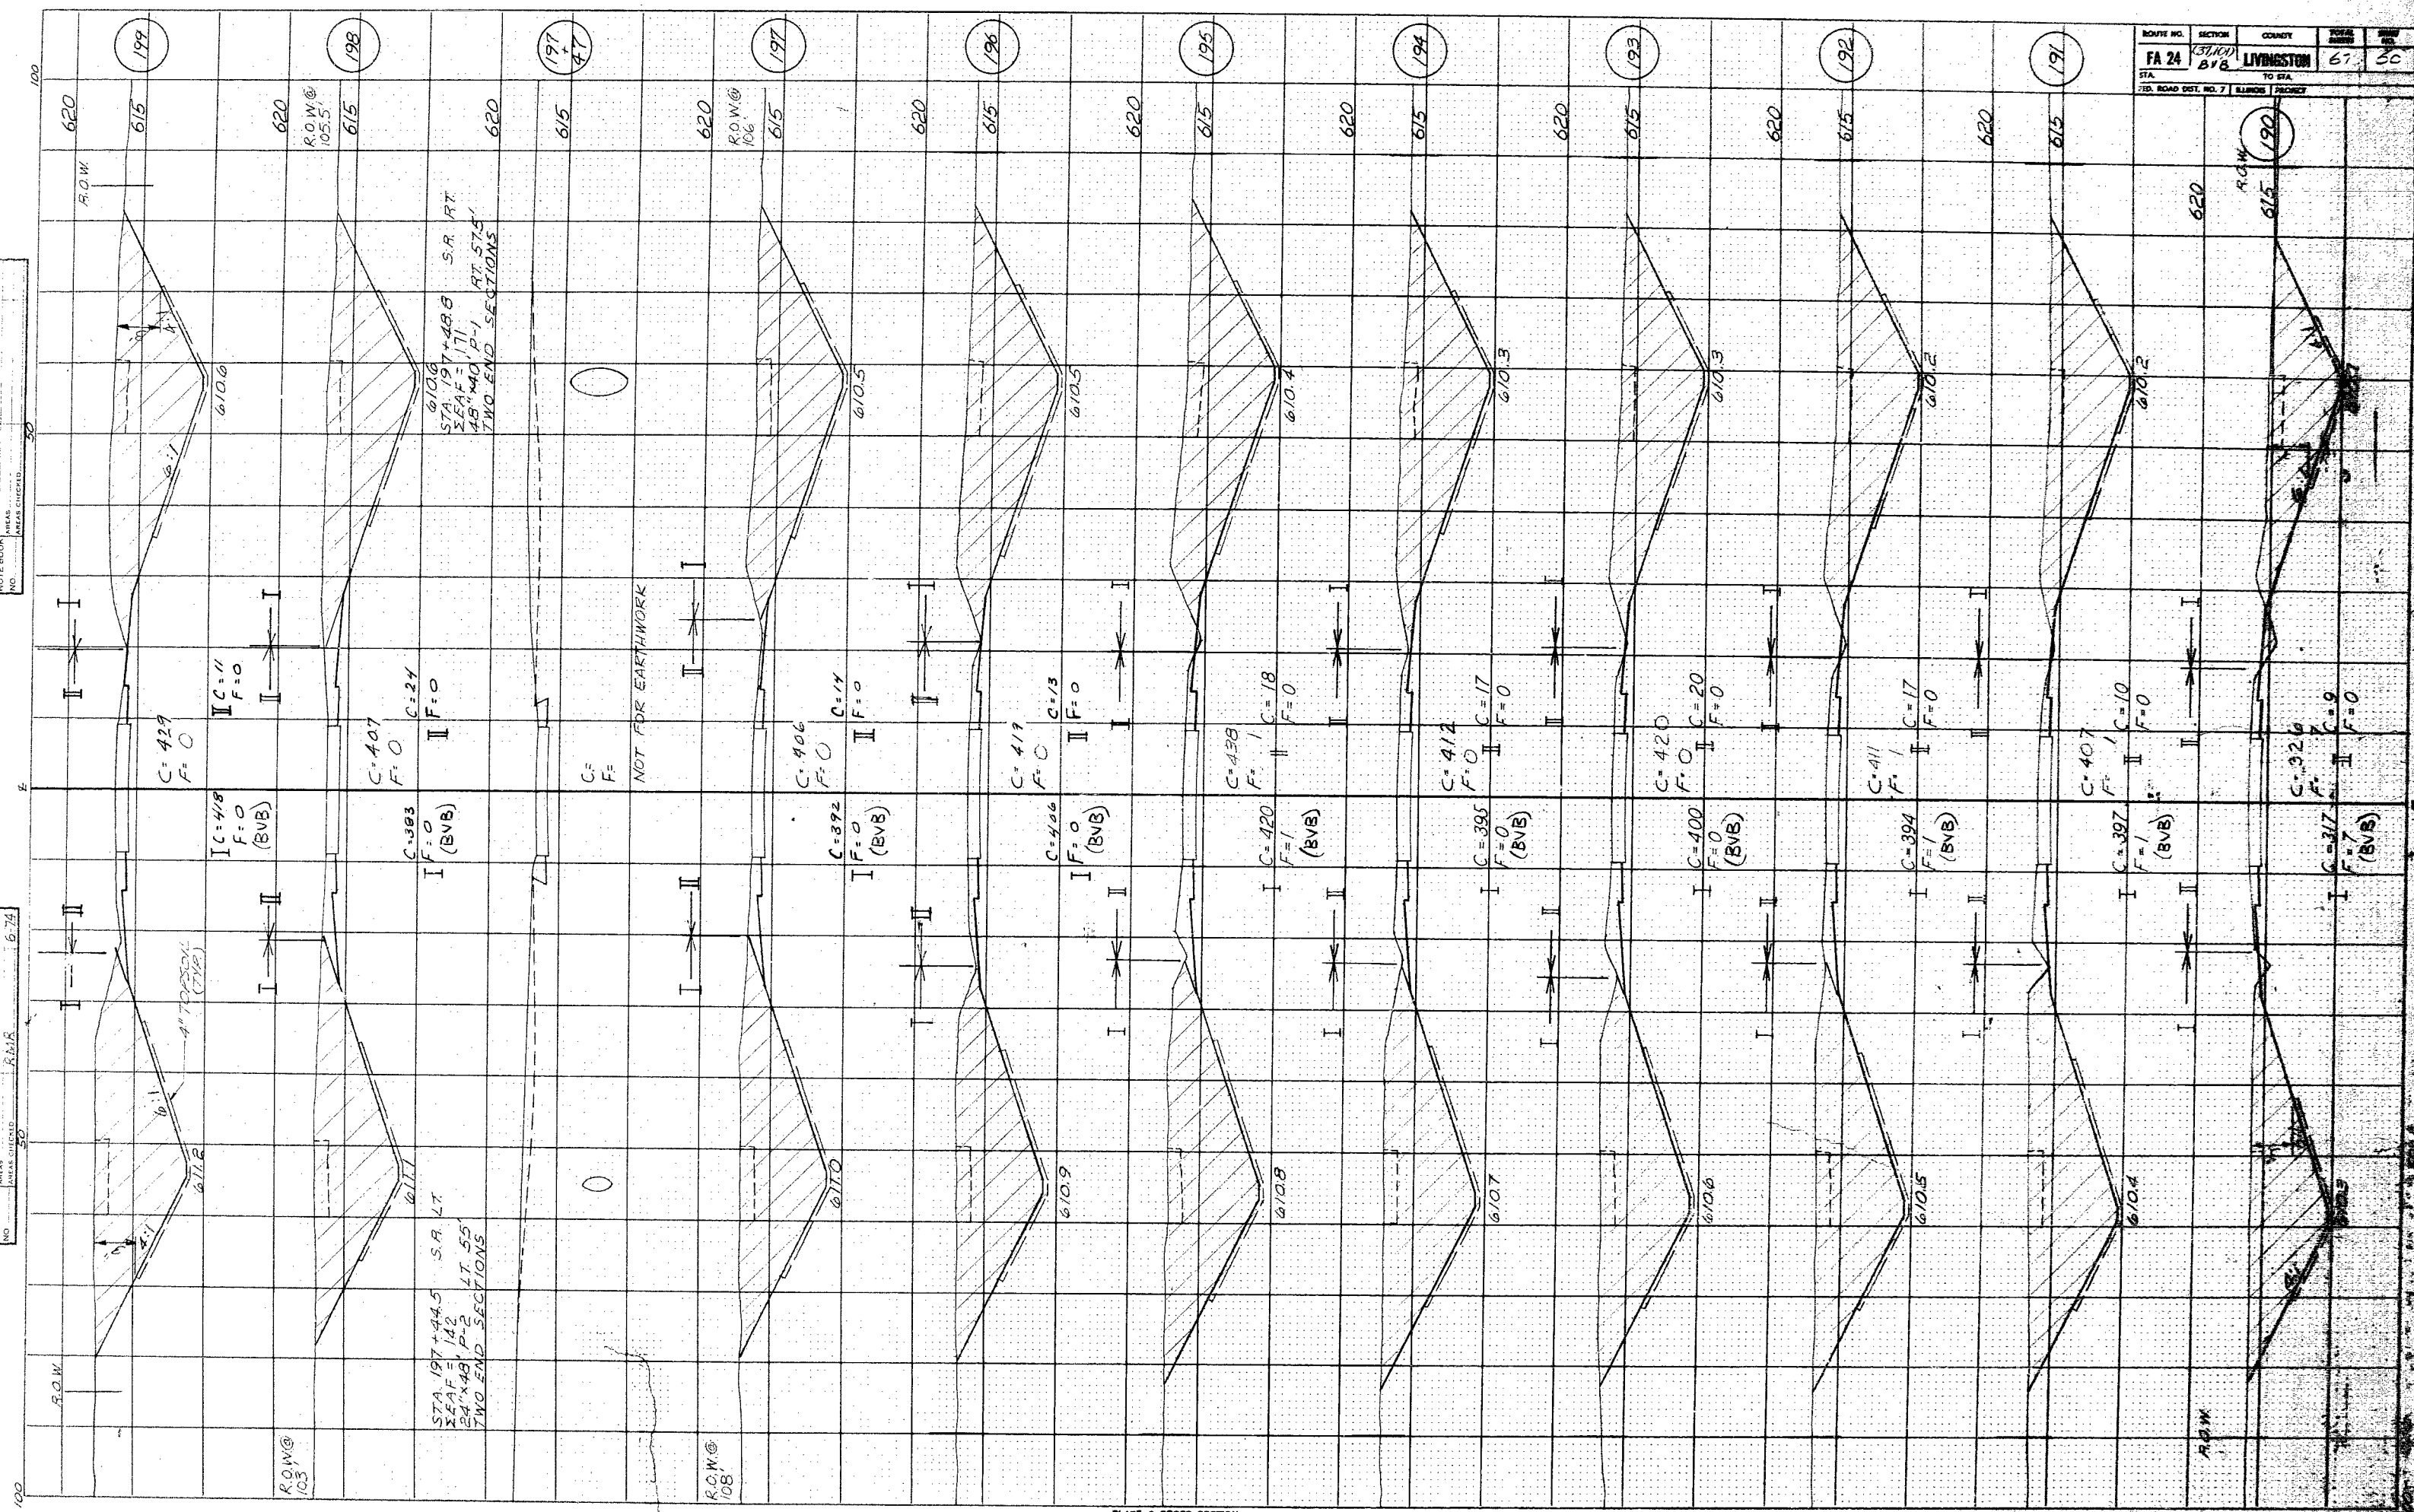


FINAL SURVEY PHOTO PLATE NO. DATE

ORIGINAL SURVEY PHOTO PLATE NO. DATE  
 PHOTOGRAMMETRY 4-72  
 MVR - 1916 7-77  
 R.M.R. 6-74

ROUTE NO.	SECTION	COUNTY	TOTAL SHEETS	SHEET NO.
FA 24	27101	LIVINGSTON	67	67
STA.	TO STA.			
RD. ROAD DIST. NO. 7	BLINDS (PROJECT)			

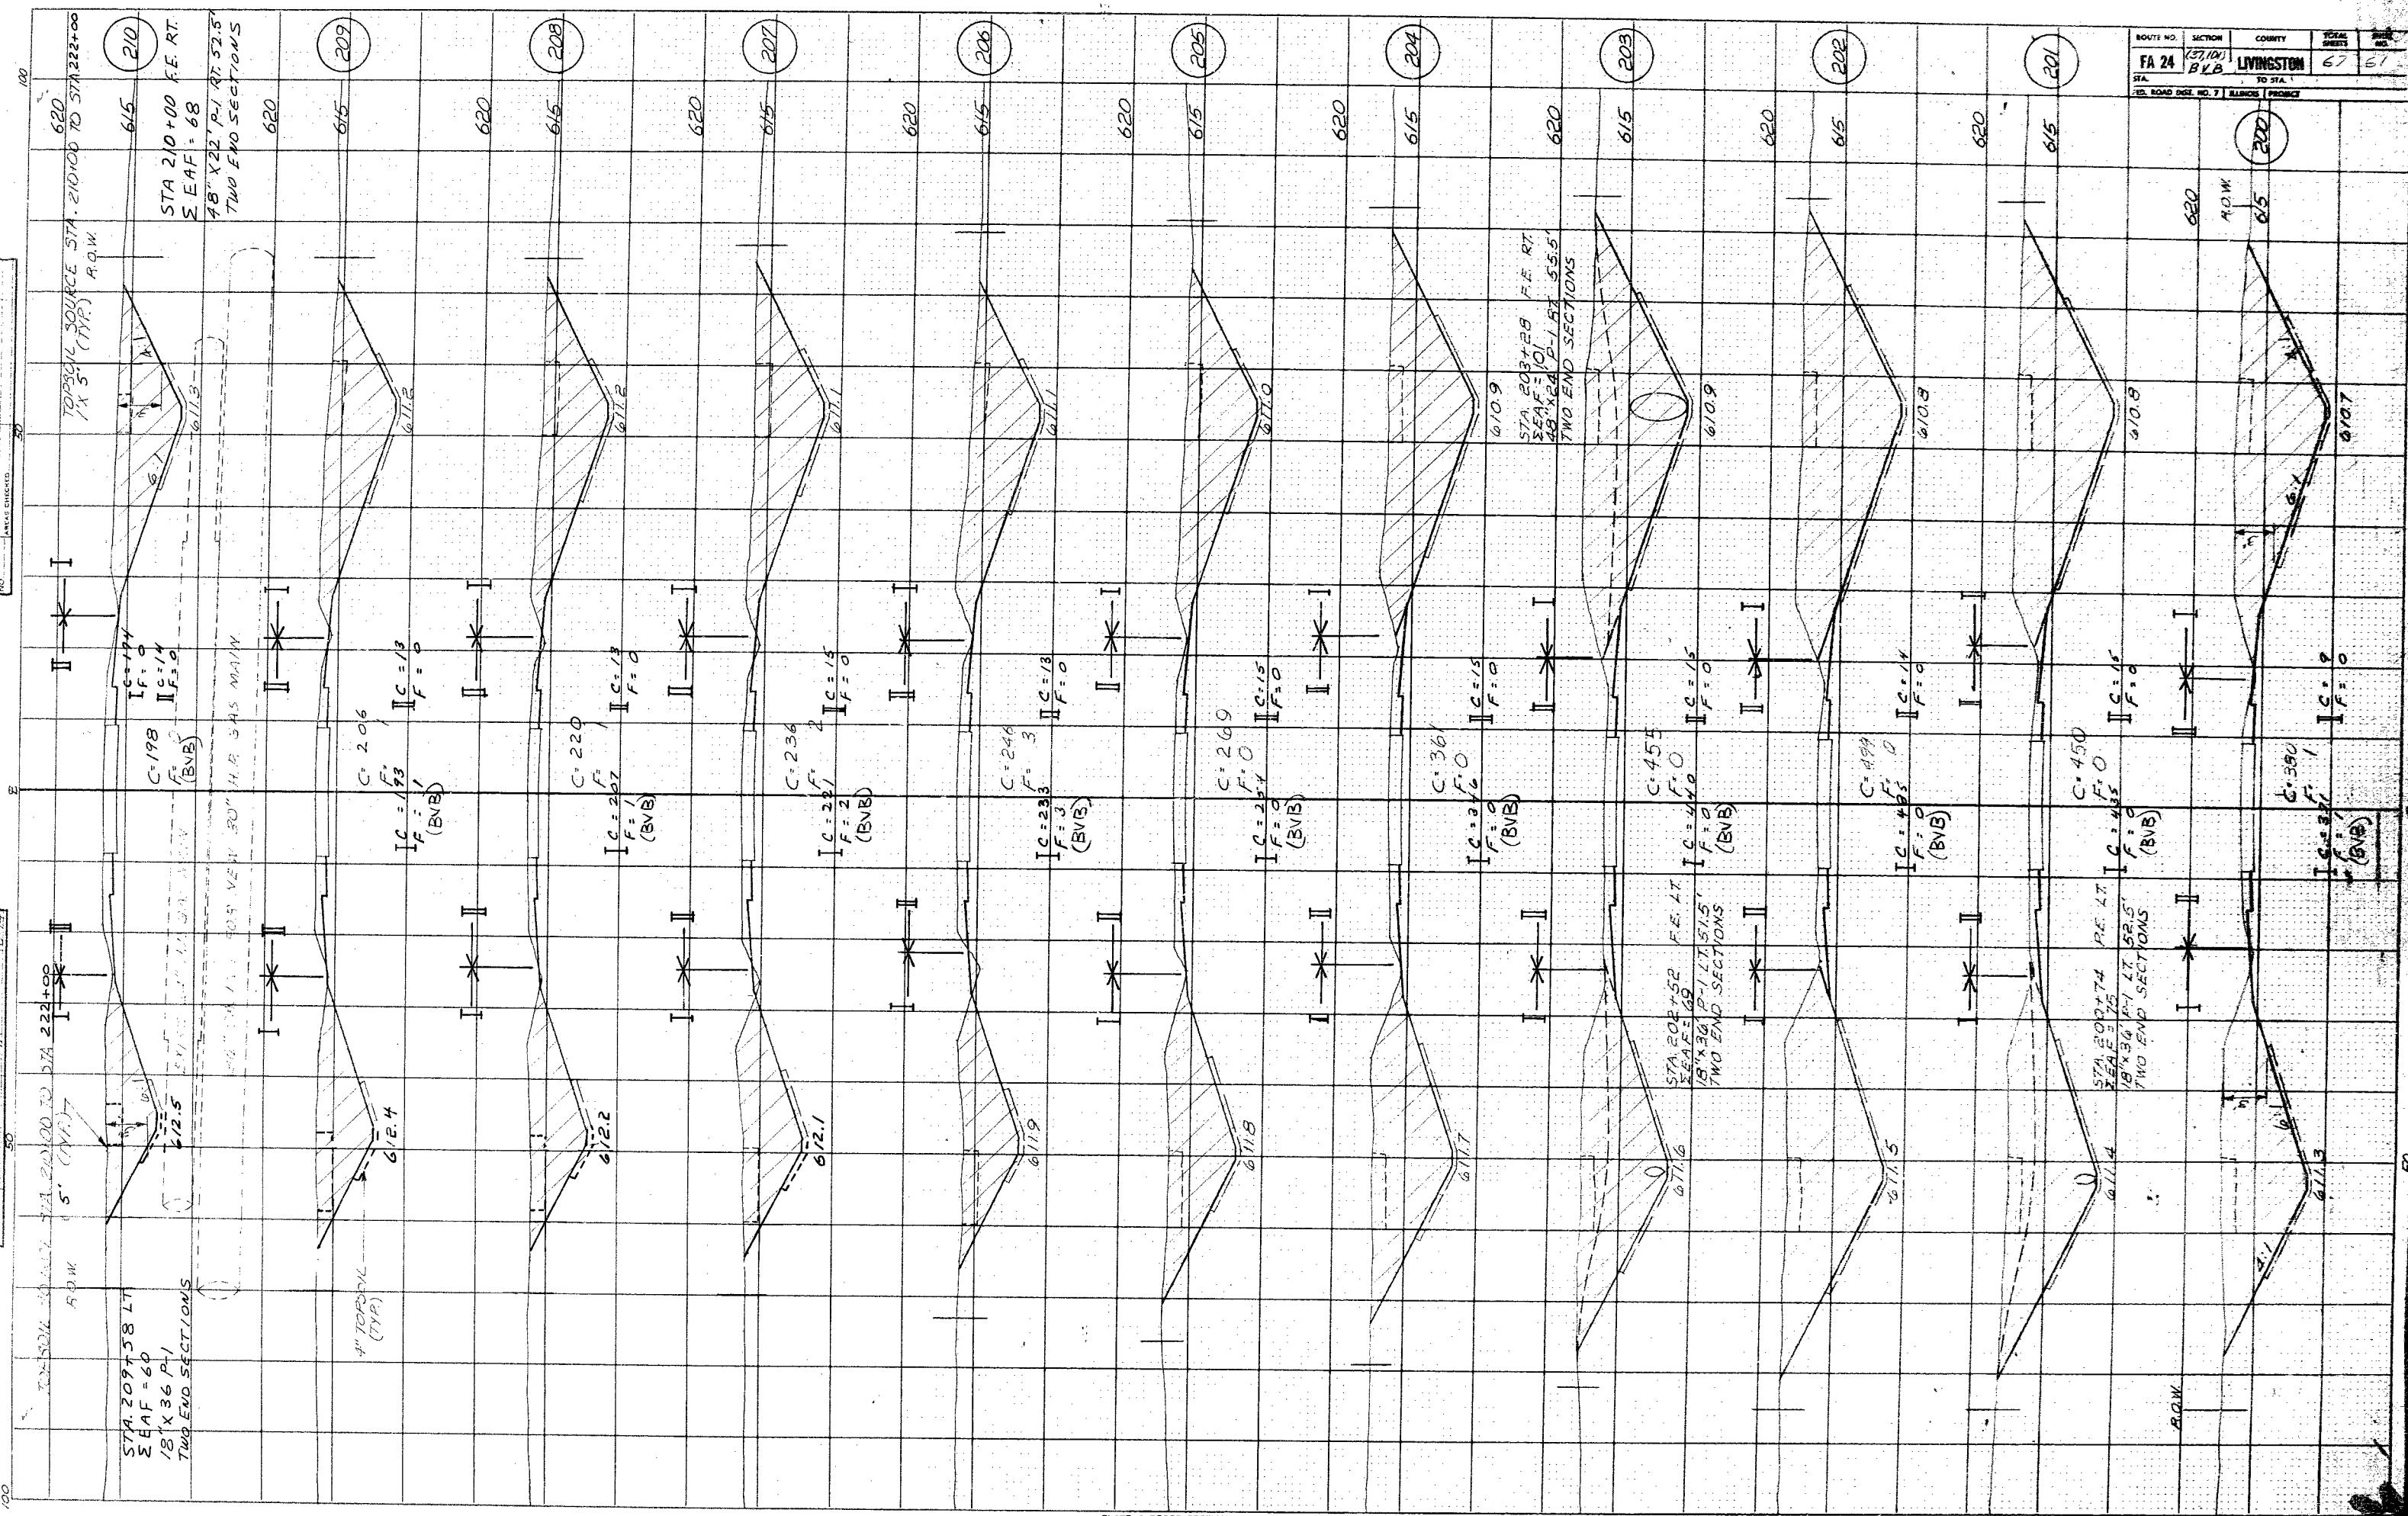

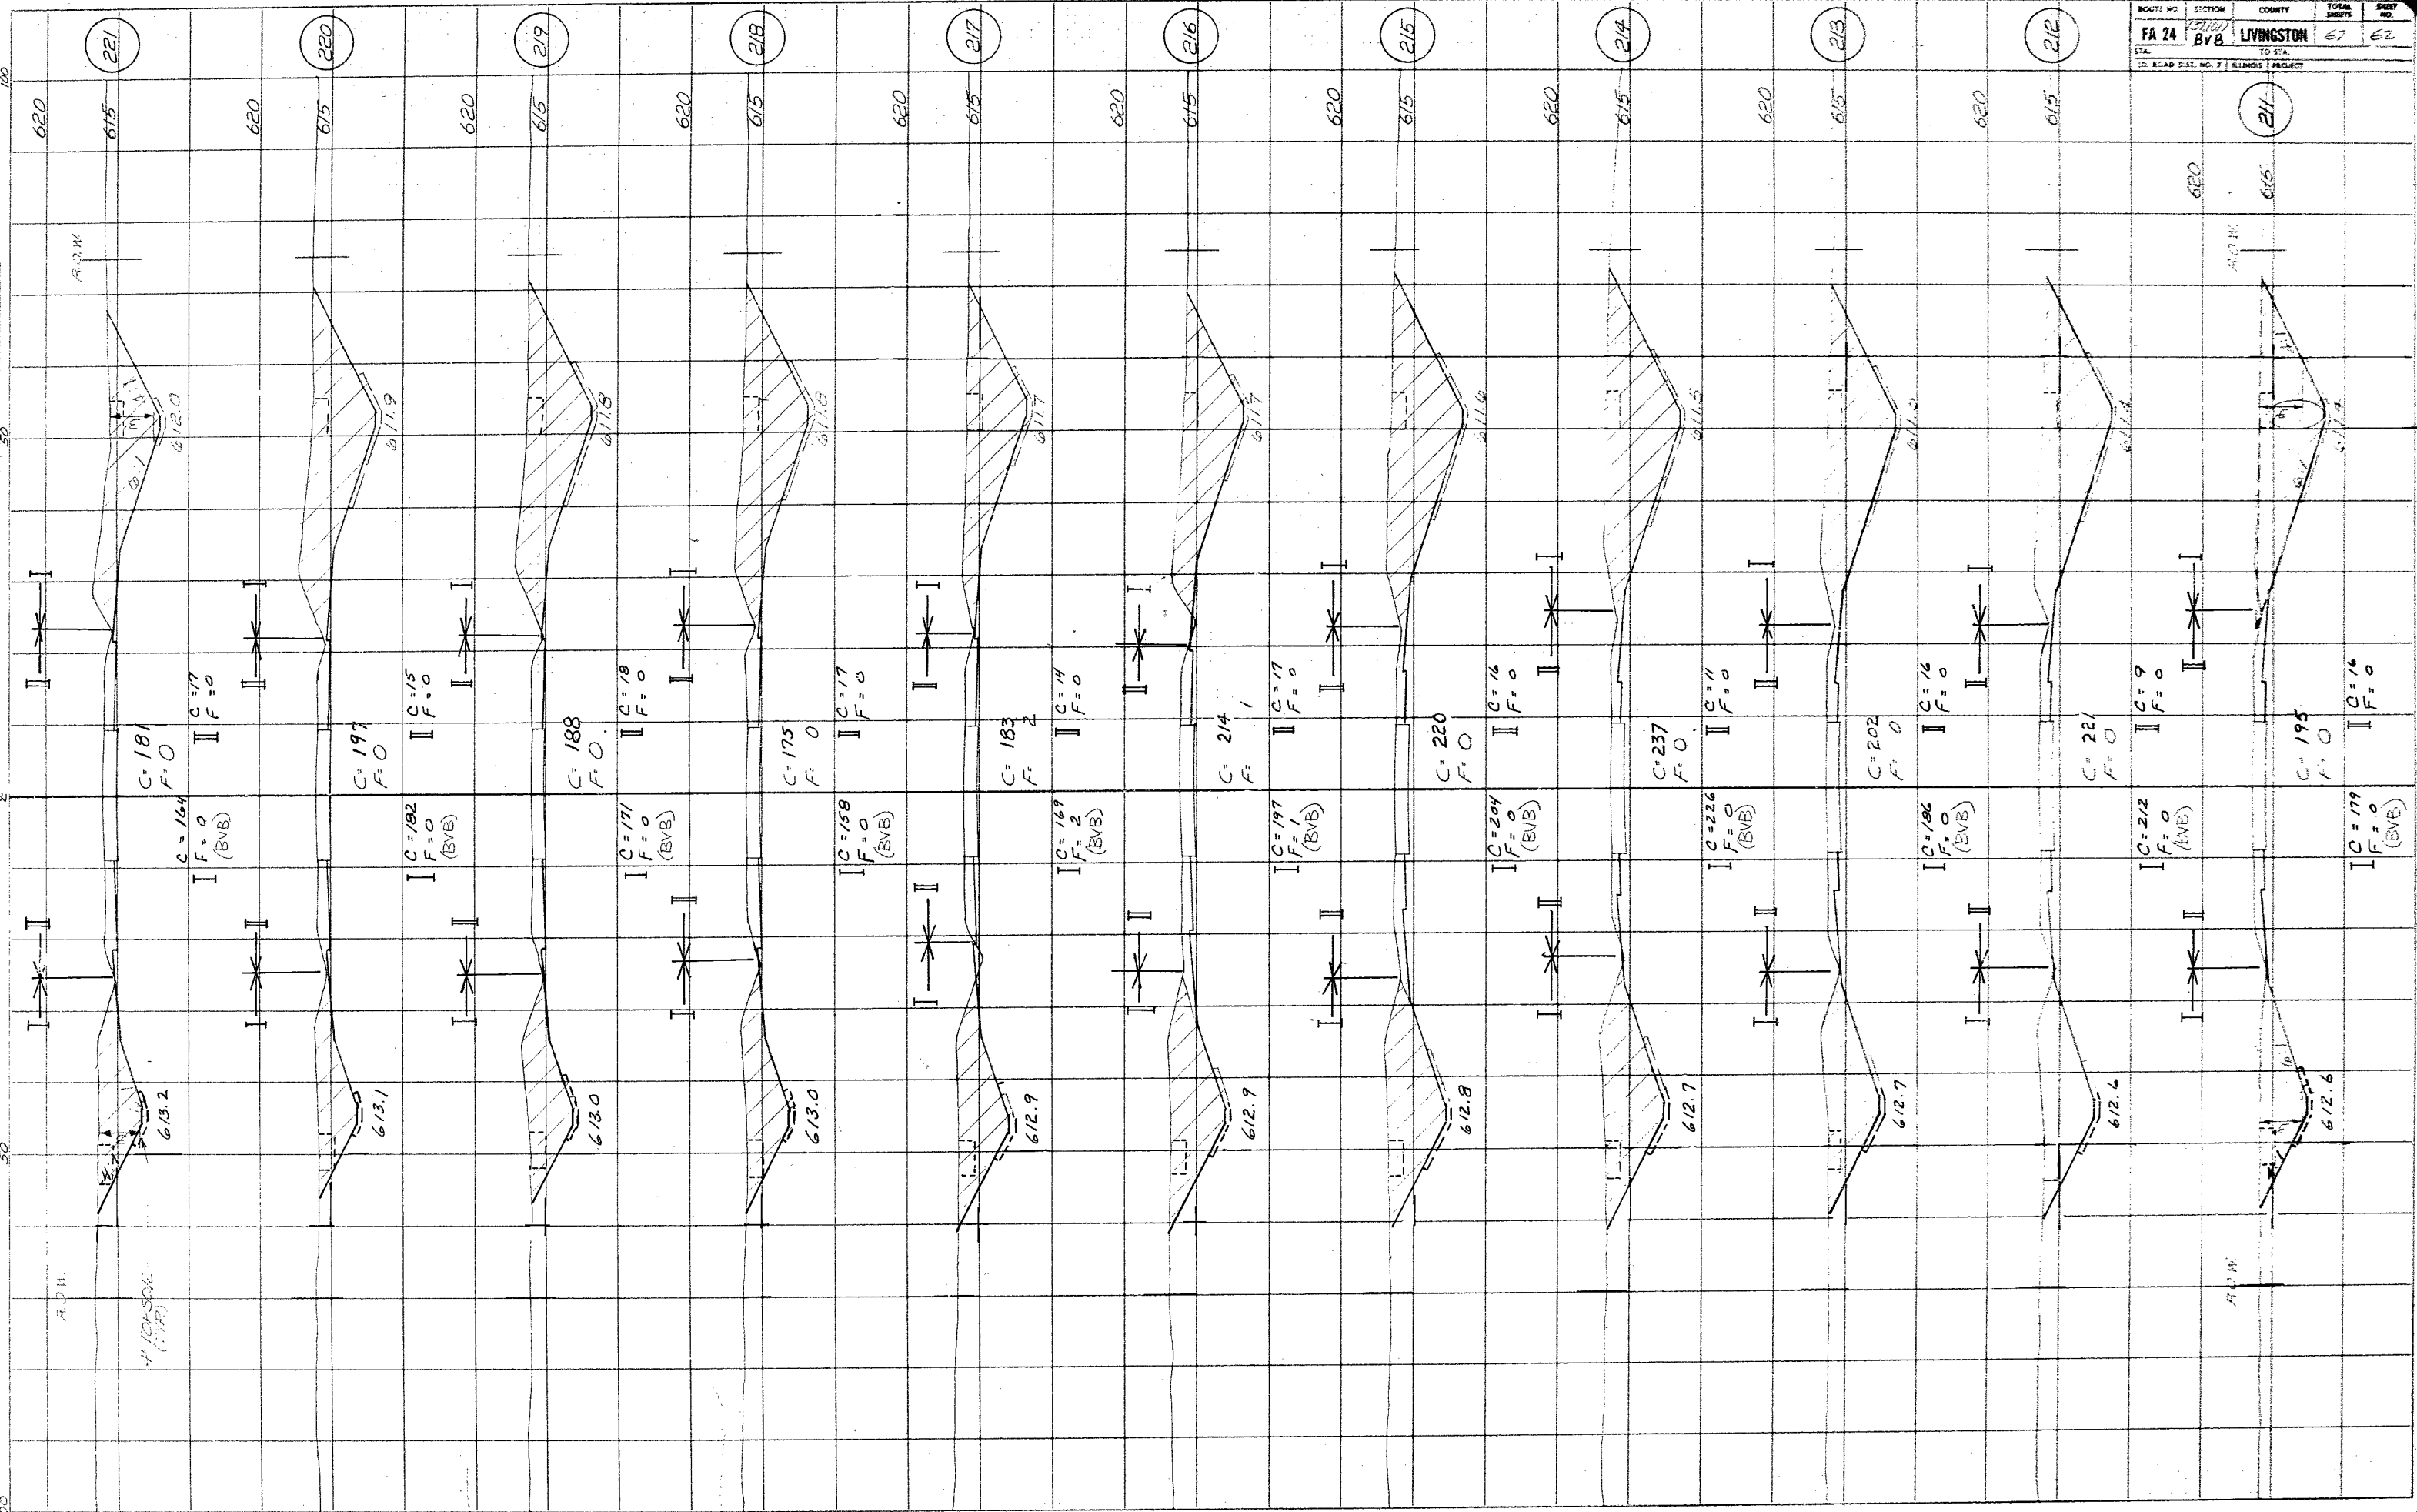


FINAL SURVEY PLOTTED  
 NOTE BOOK  
 CHECKED

PHOTOGRAMMETRY 4-30  
 MVR  
 BAG 11-51  
 R.M.E.

FINAL SURVEY  
 DATE: 11-21-57  
 PROJECT: MVA  
 AREA: R. 11 E. S. 17 N.  
 NO. 11-21-57

ORIGINAL SURVEY  
 DATE: 11-21-57  
 PROJECT: MVA  
 AREA: R. 11 E. S. 17 N.  
 NO. 11-21-57

ROUTE NO.	SECTION	COUNTY	TOTAL SHEETS	SHEET NO.
FA 24	B710	LIVINGSTON	67	63
STA.	TO STA.			
100	119			
D. ROAD DIST. NO. 7 LAMONS PROJECT				

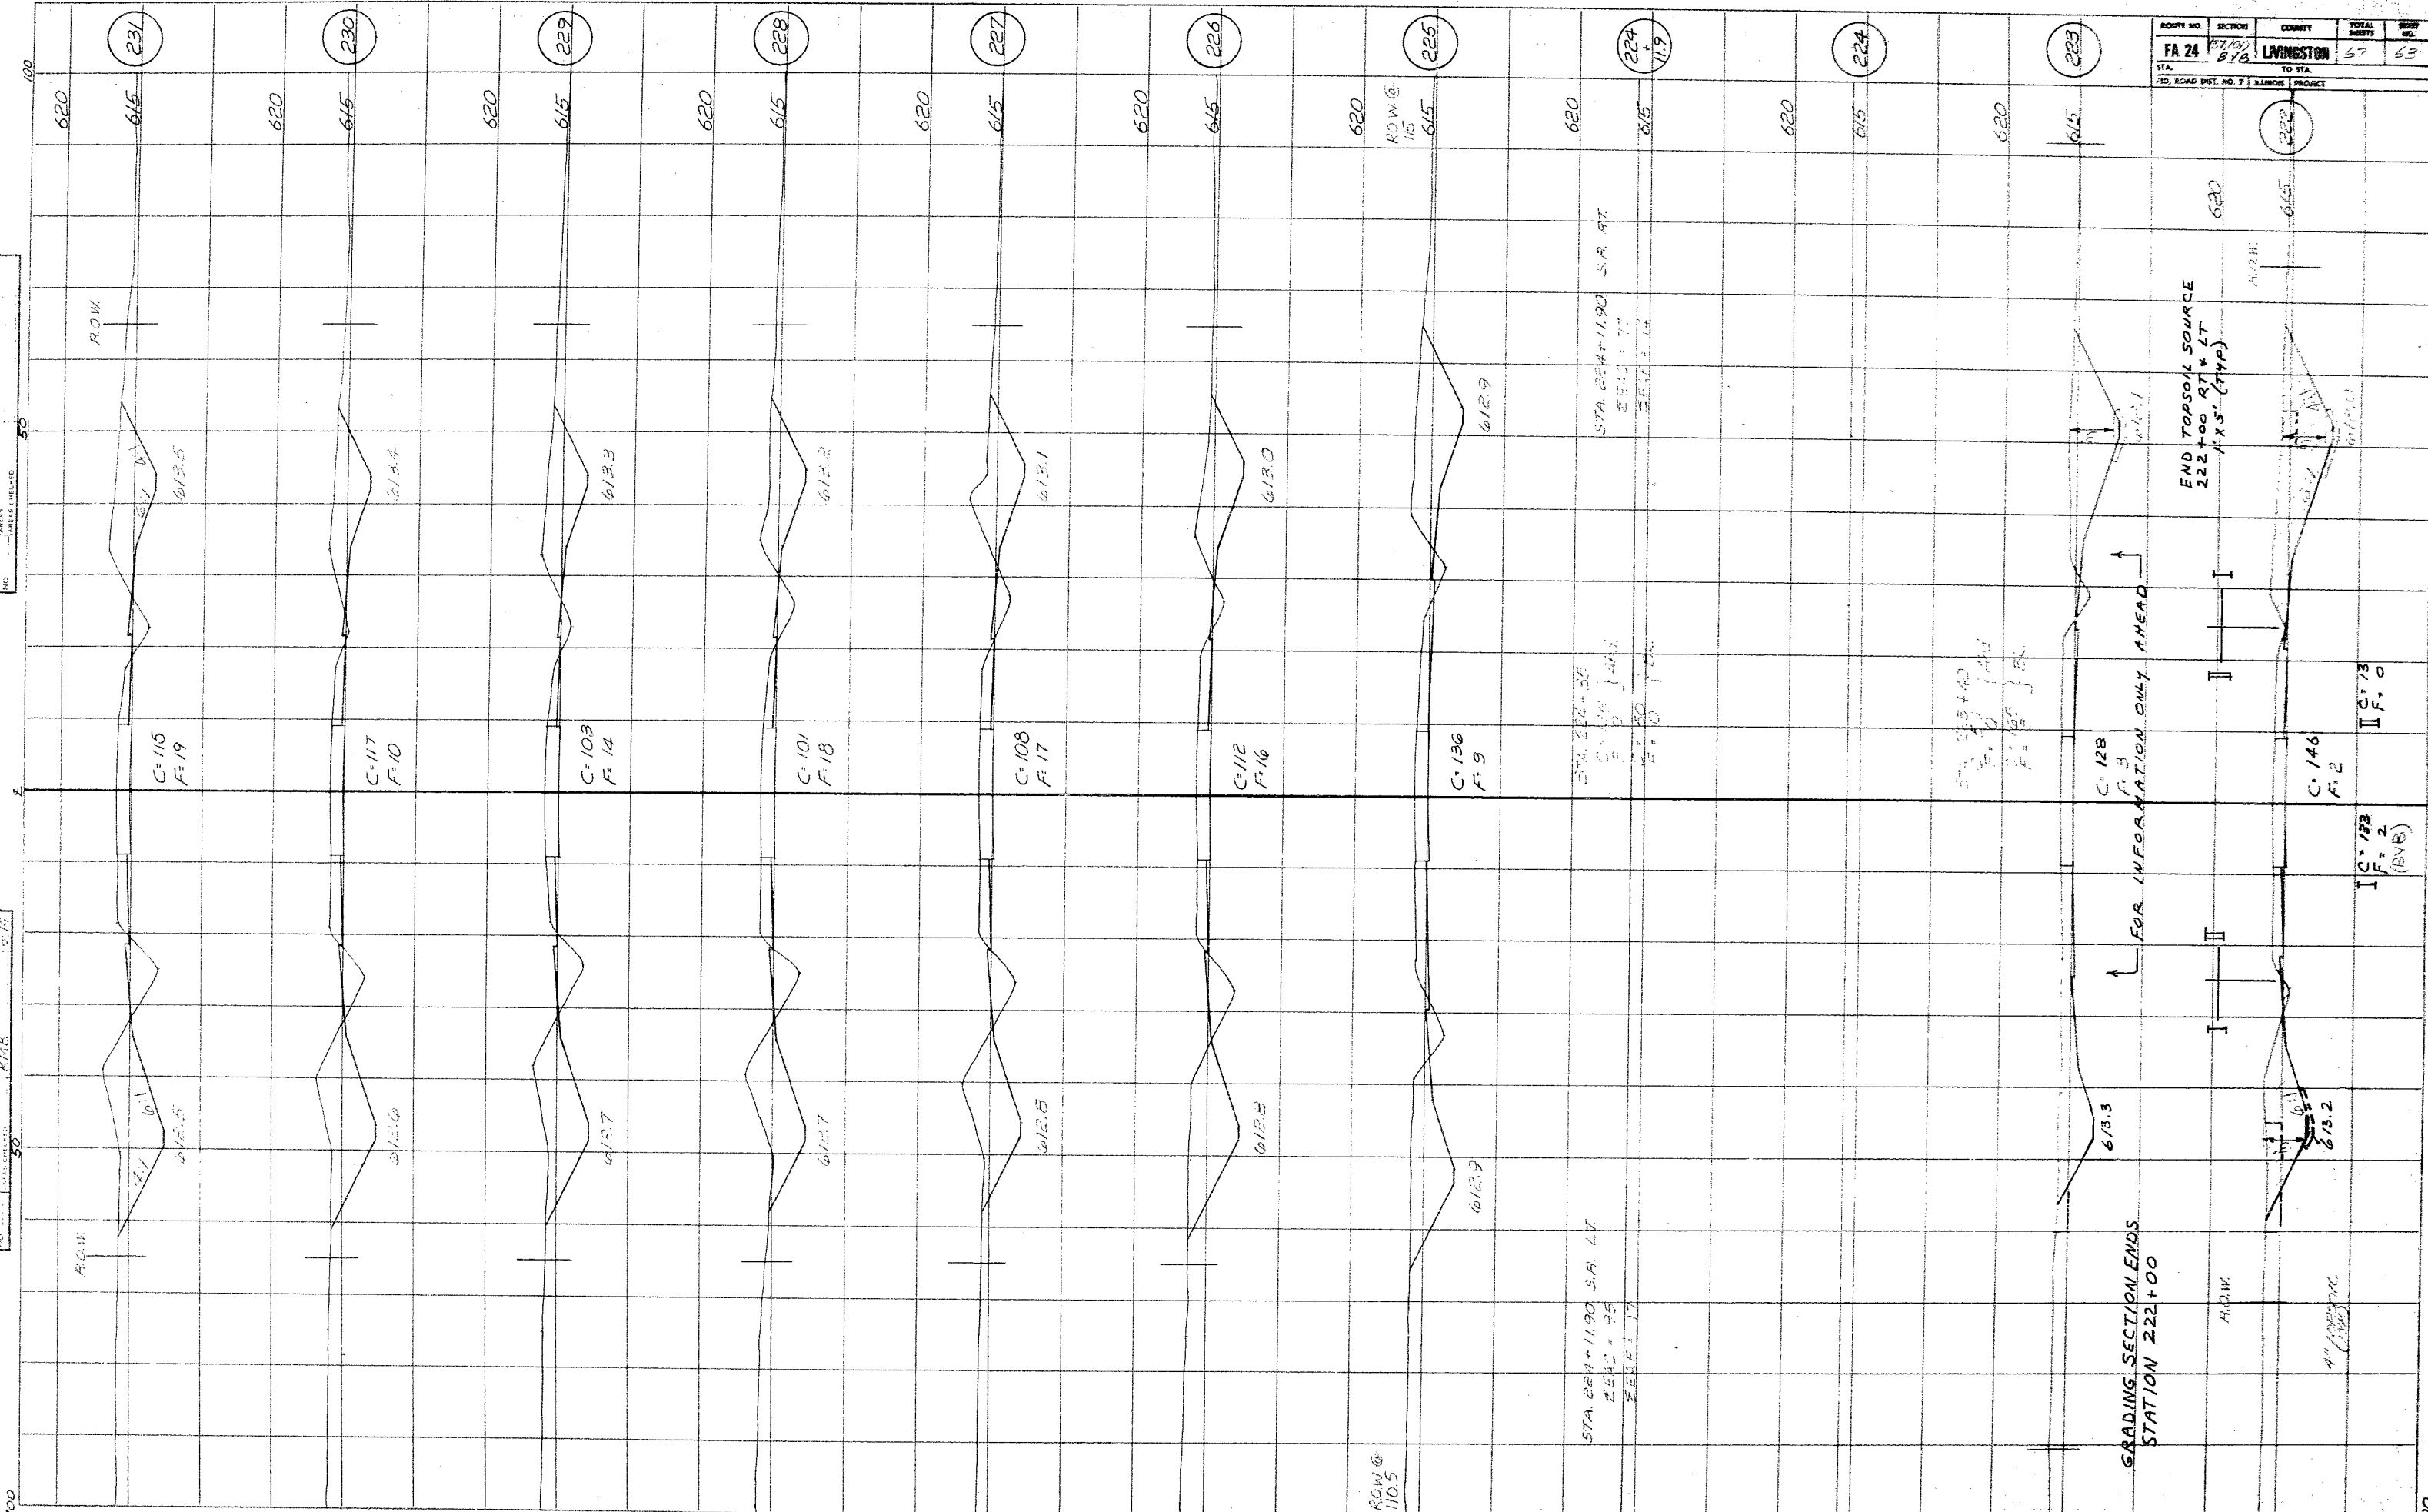


119

FINAL SURVEY  
 SURVEYOR'S NAME  
 DATE  
 SHEET NO. 64

ORIGINAL SURVEY  
 SURVEYOR'S NAME  
 DATE  
 SHEET NO. 64

ROUTE NO.	SECTION	COUNTY	TOTAL SHEETS	SHEET NO.
FA 24	1200	LIVINGSTON	67	64

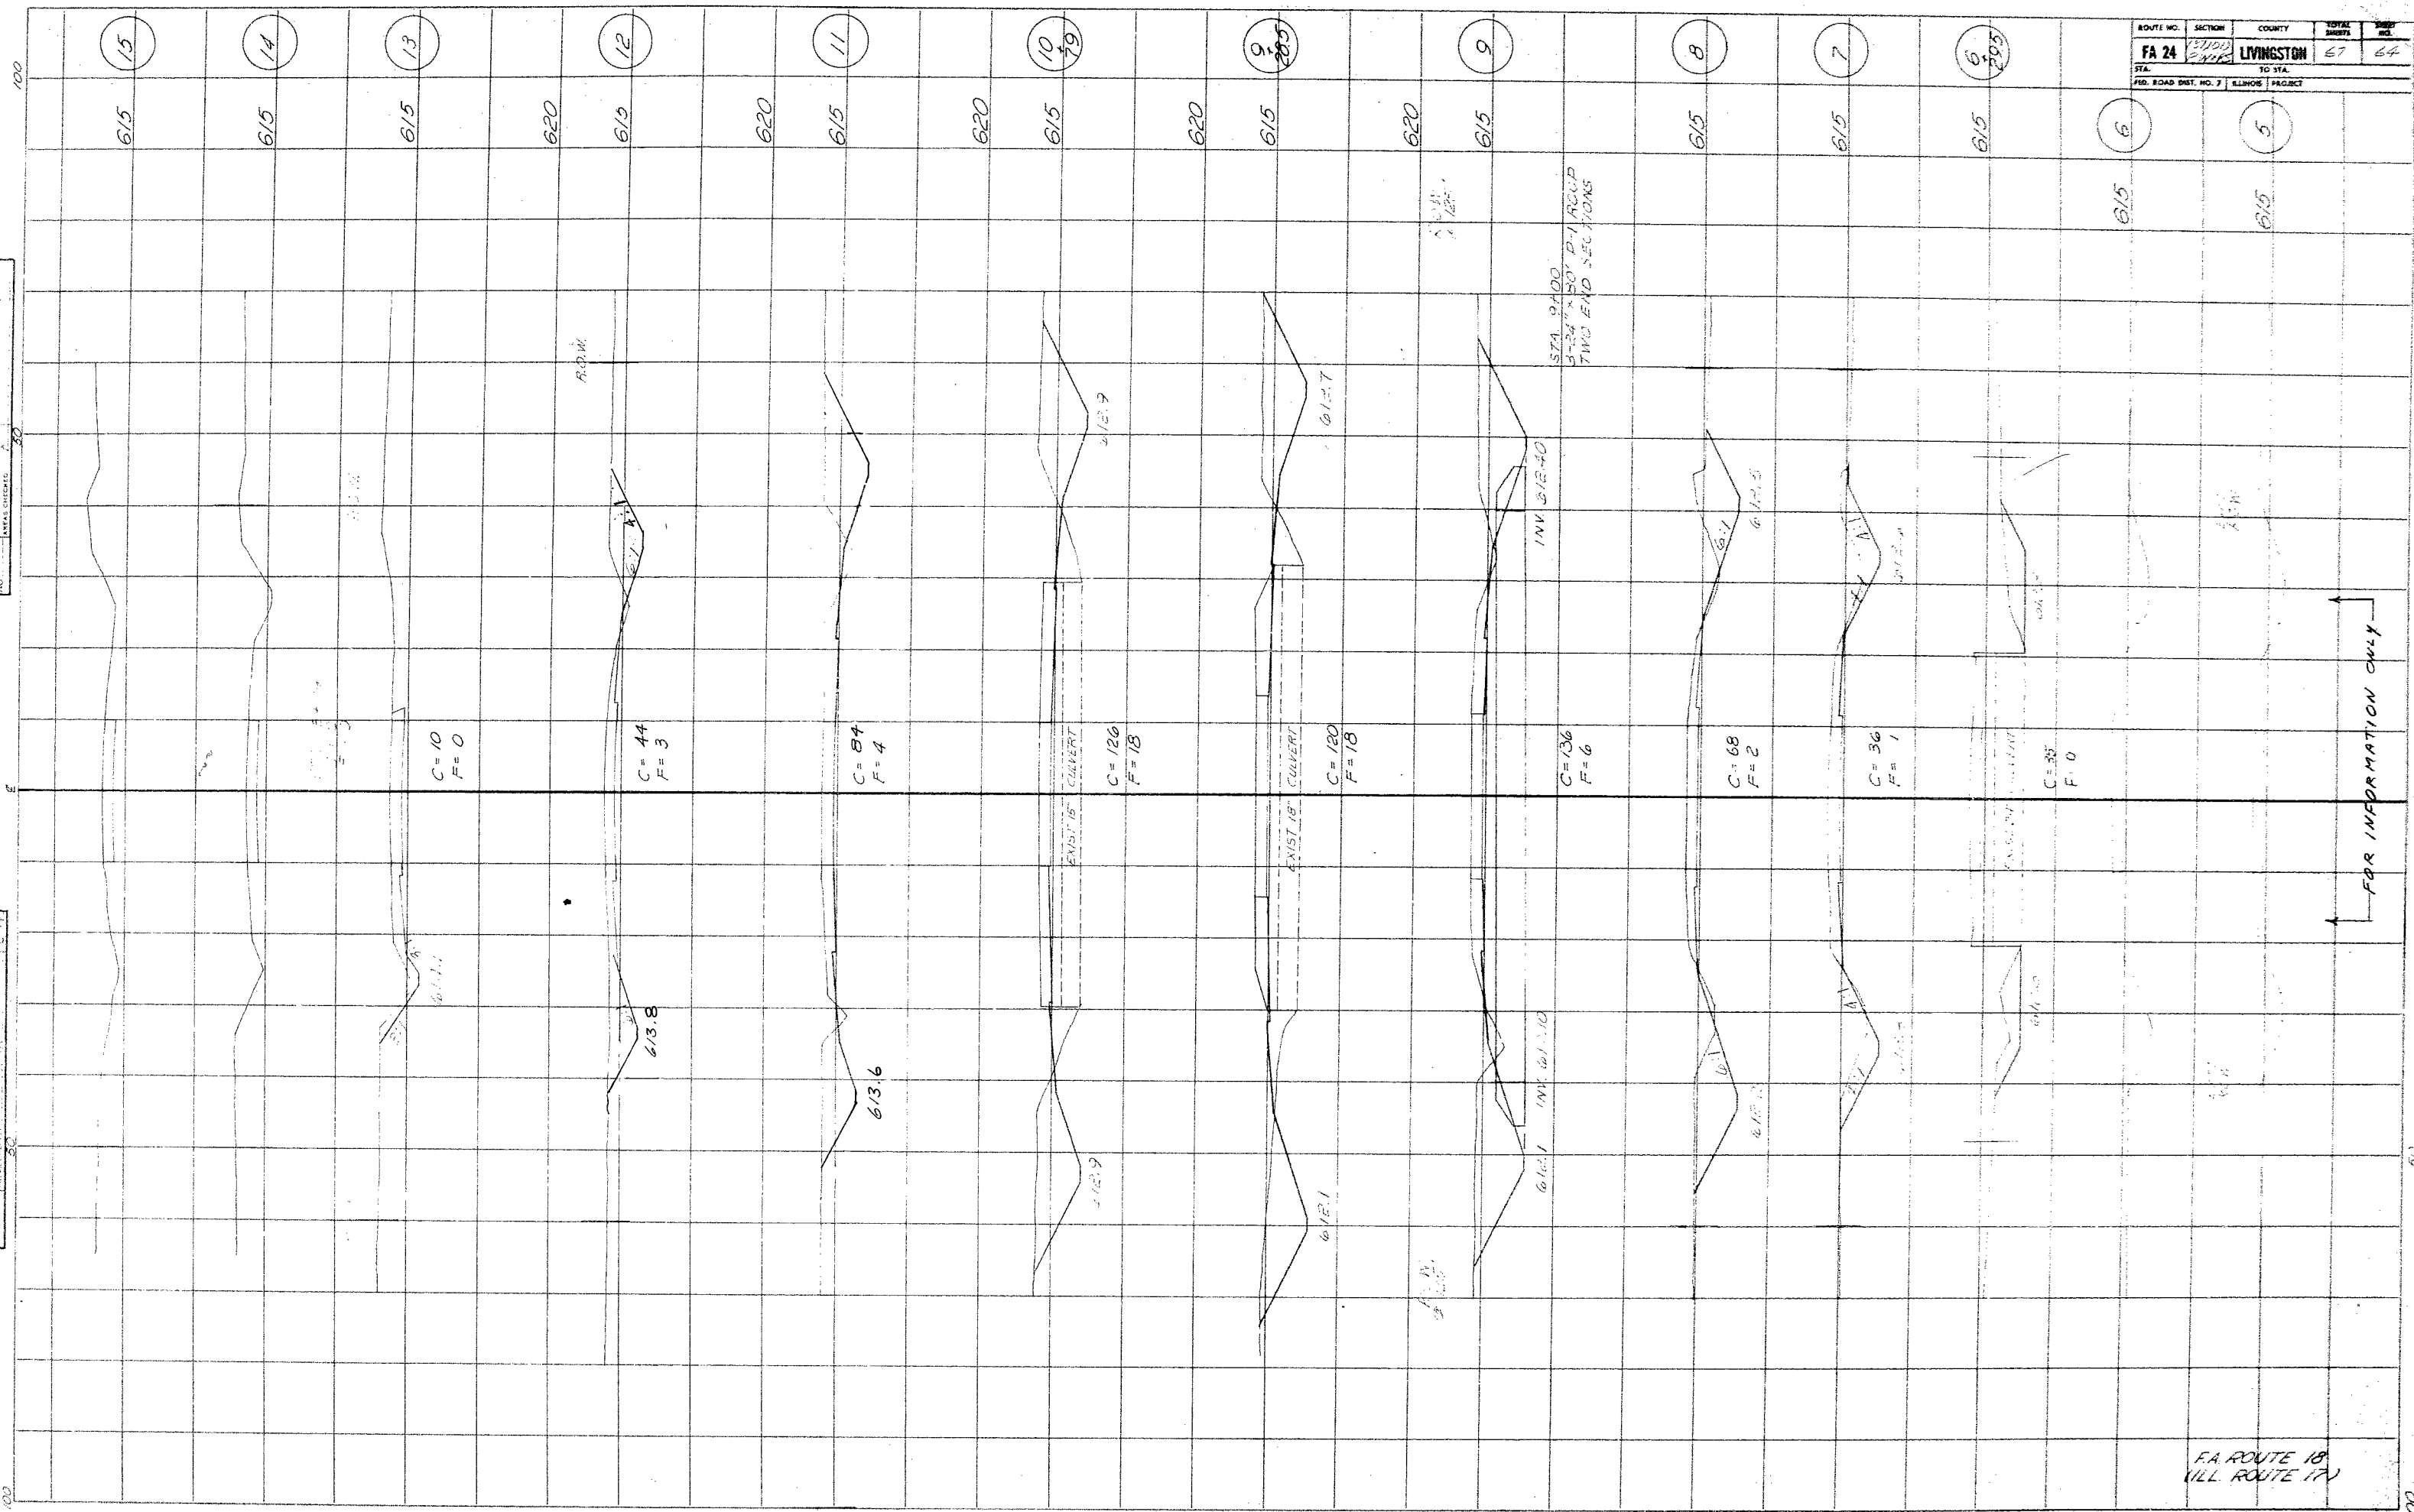

FOR INFORMATION ONLY


FA ROUTE 18  
 (ILL. ROUTE 17)



FINAL SURVEY  
 SURVEY NO. 27  
 DATE 11-27-71  
 NOTE BOOK NO. 101  
 TEMPLATE NO. 101  
 AREA CHECKED

ORIGINAL SURVEY  
 SURVEY NO. 27  
 DATE 11-27-71  
 NOTE BOOK NO. 101  
 TEMPLATE NO. 101  
 AREA CHECKED

ROUTE NO.	SECTION	COUNTY	TOTAL PAGES	SHEET NO.
FA 24	233	LIVINGSTON	67	65
STA.	TO STA.			
130	ROAD DIST. NO. 7		ILLINOIS PROJECT	

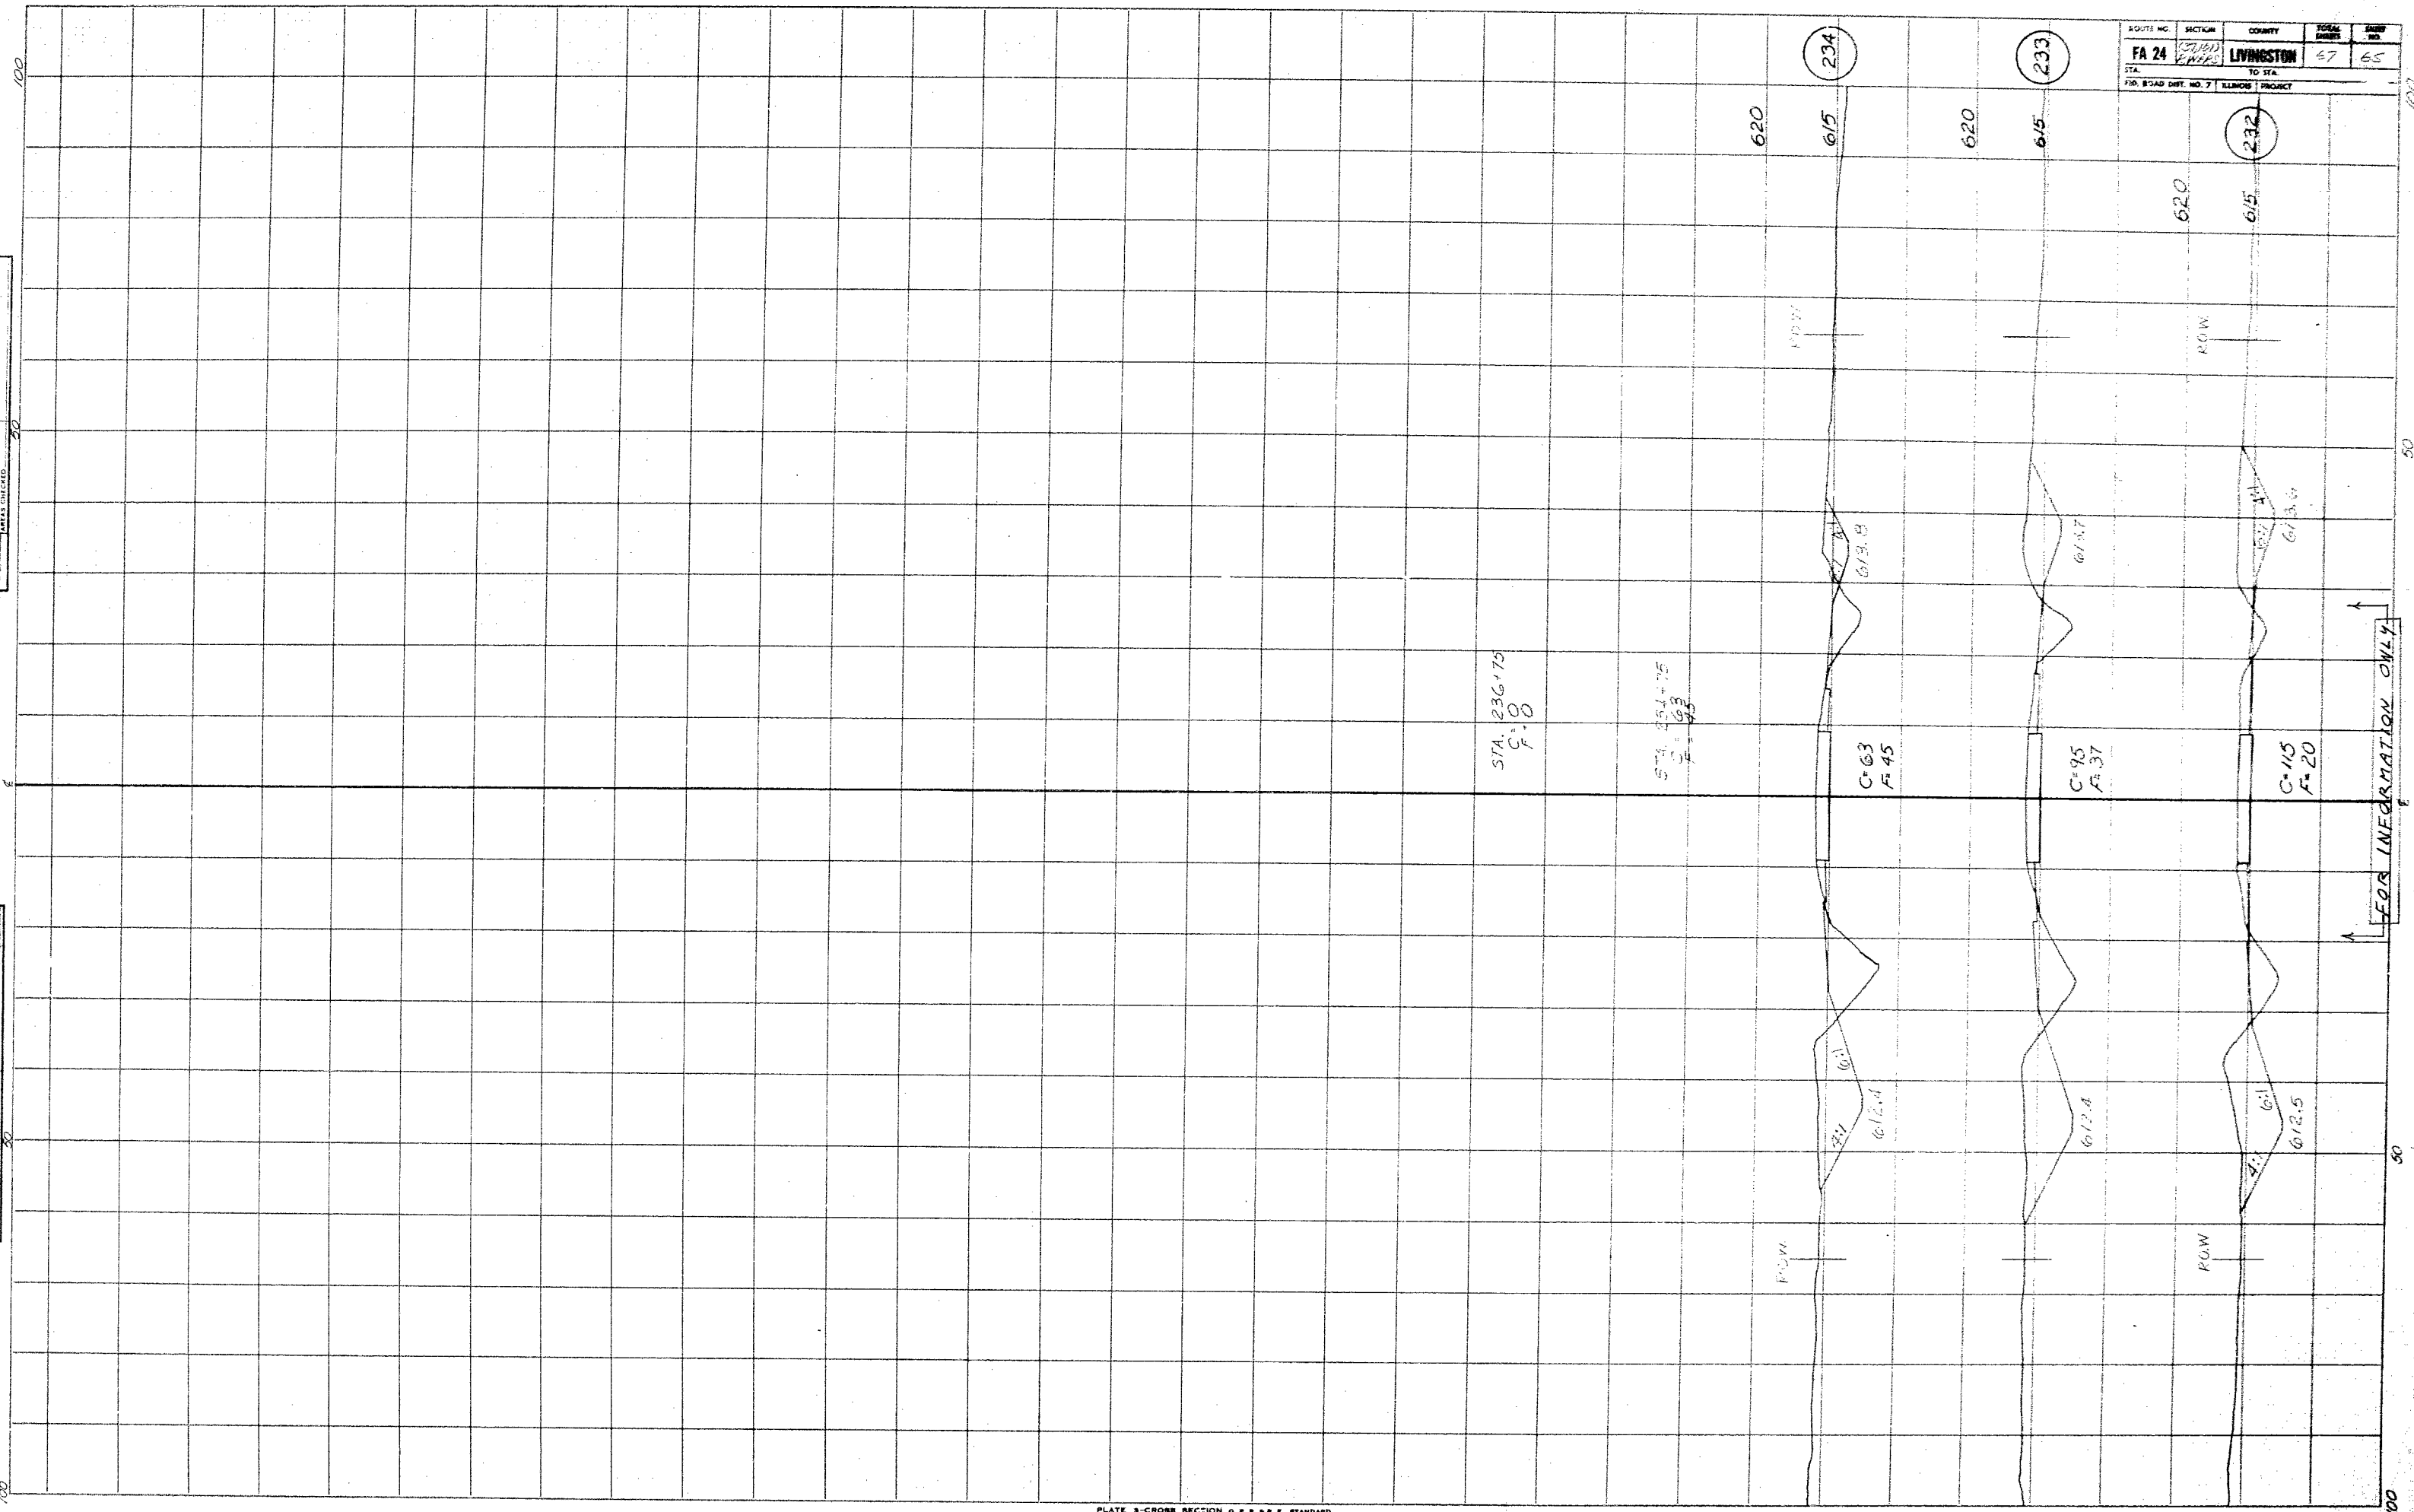

FINAL SURVEY BY DATE  
 REVISIONS BY DATE  
 NO. OF BOOKS NO. OF SHEETS  
 NO. OF BOOKS CHECKED

ORIGINAL SURVEY BY DATE  
 REVISIONS BY DATE  
 NO. OF BOOKS NO. OF SHEETS  
 NO. OF BOOKS CHECKED

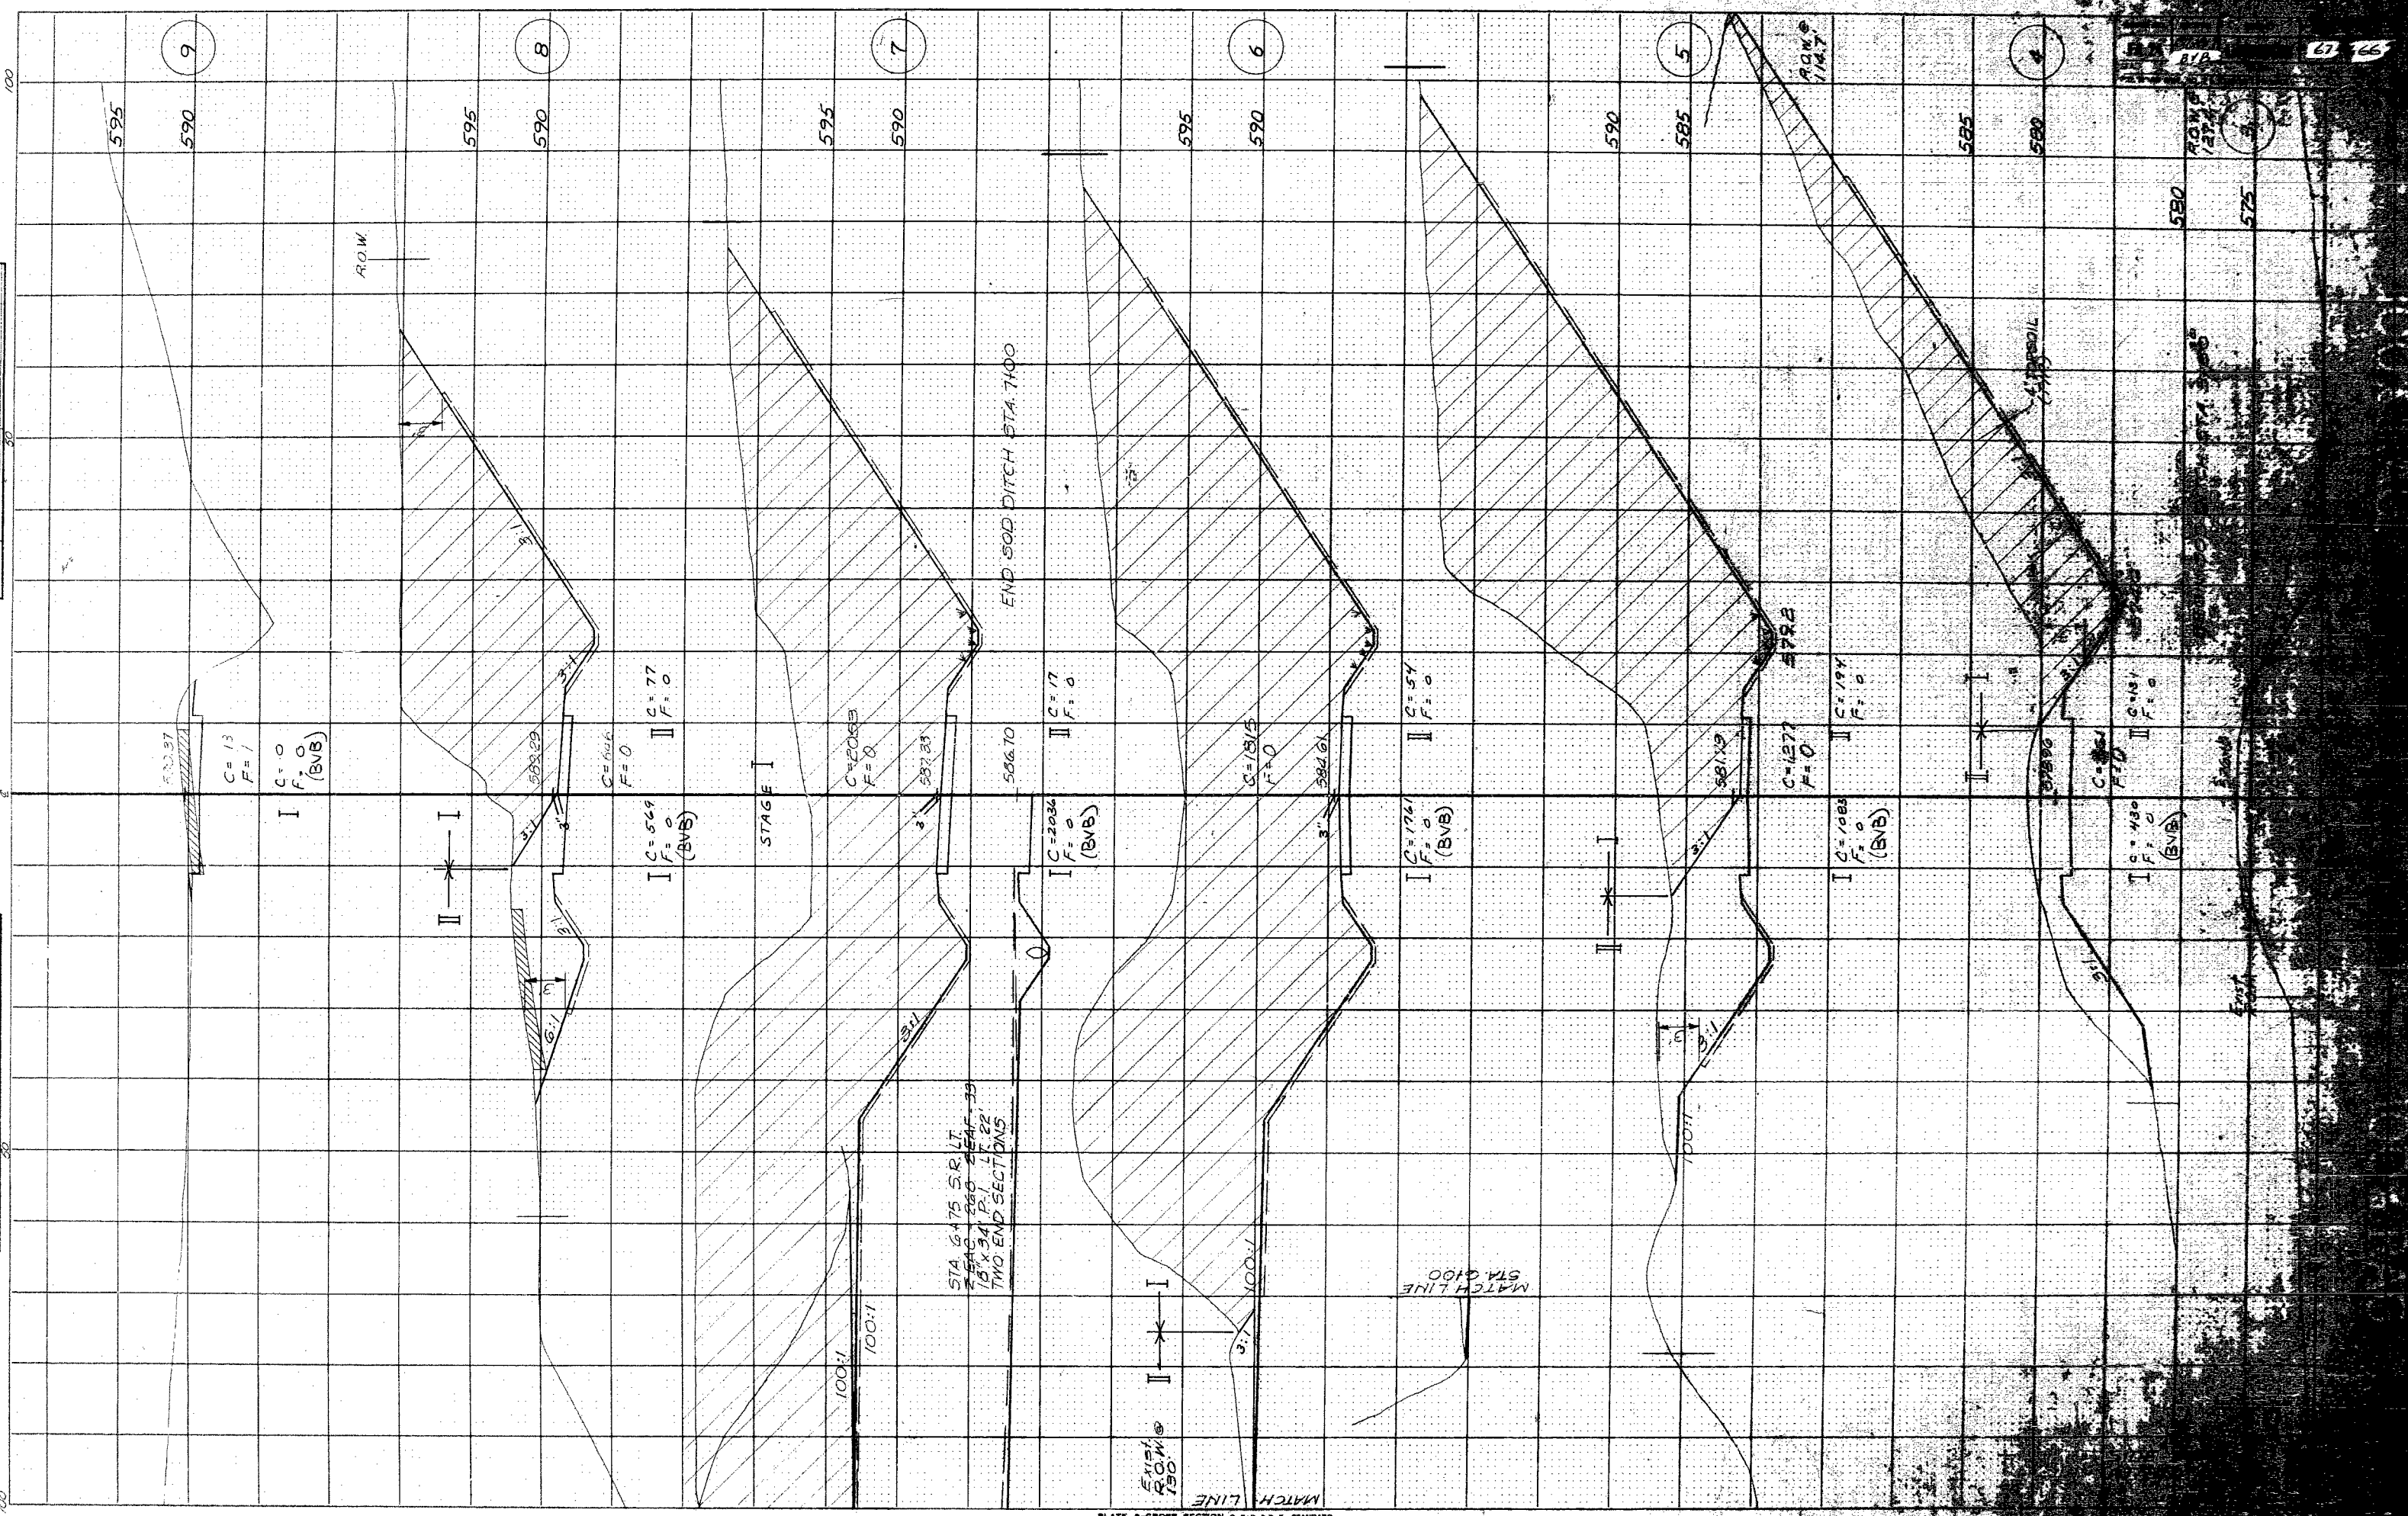


PLATE 3-CROSS SECTION O. P. R. P. E. STANDARD  
 NATIONAL TRACING PAPER DIVISION  
 INDIANAPOLIS, INDIANA

ORIGINAL SURVEY PLOTTED  
 SURVEY PLOTTED  
 NOTE BOOK NO. 100  
 AREAS CHECKED  
 DATE 1-22-72  
 PROJECT NUMBER 500V  
 SHEET 3-72  
 F.M.R.

FINAL SURVEY PLOTTED  
 SURVEY PLOTTED  
 NOTE BOOK NO. 100  
 AREAS CHECKED

