INDEX OF SHEETS

- COVER SHEET
- 2. INDEX OF SHEETS, STATE STANDARDS, & GENERAL NOTES
- .-5. SUMMARY OF QUANTITIES
- 6. TYPICAL SECTIONS
- 7. ALIGNMENT, TIES AND BENCHMARKS
- 8.-9. PLAN AND PROFILE SHEETS
- 10. PARKING LOT PLAN
- 11. PLATFORM AREA EXISTING AND DEMOLITION PLAN
- 11. PLAIFORM AREA EXISTING
- 12. PLATFORM AREA PLAN & PROFILE13. PLATFORM AREA GRADE POINT CHARTS
- 14. PLATFORM AREA SITE PLAN
- 15.-17 EROSION AND SEDIMENT CONTROL PLANS
- 18.-20. DRAINAGE AND UTILITY PLANS
- 21. DRAINAGE AND UTILITY DETENTION POND EXPANSION PLAN
- 22. PAVEMENT MARKING & SIGNING PLAN
- 23.-30. STREET LIGHTING PLAN AND DETAILS
- 31.-35. PLATFORM AREA ELECTRICAL PLANS AND DETAILS
- 36.-41. CONSTRUCTION DETAILS
- 42.—44. PLATFORM AREA DETAILS
- 45.-47. BUILDING STRUCTURAL PLANS AND DETAILS
- 48.-50. ARCHITECTURAL PLANS AND DETAILS 51.-52. MECHANICAL PLANS AND DETAILS
- ET EA DICTRICT ONE CTANDADDO
- 53.—54. DISTRICT ONE STANDARDS
- 55.—61. ACCESS ROAD CROSS SECTIONS
 62.—64. PLATFORM AREA CROSS SECTIONS

HIGHWAY STANDARDS

- 000001-06 STANDARD SYMBOLS, ABBREVIATIONS AND PATTERNS
- 280001-07 TEMPORARY EROSION CONTROL SYSTEMS
- 424001-09 PERPENDICULAR CURB RAMPS
- 424016-03 MID BLOCK CURB RAMPS
- 542301-03 PRECAST REINFORCED CONCRETE FLARED END SECTION
- 542311-06 TRAVERSABLE PIPE GRATE
- 601001-05 PIPE UNDERDRAINS
- 601101-02 CONCRETE HEADWALL FOR PIPE UNDERDRAINS
- 602001-02 CATCH BASIN TYPE A
- 602011-02 CATCH BASIN TYPE C
- 602301-04 INLET, TYPE A
- 602401-03 MANHOLE, TYPE A
- 602601-04 PRECAST REINFORCED CONCRETE FLAT SLAB TOP
- 602701-02 MANHOLE STEPS
- 604001-04 FRAME AND LIDS, TYPE 1
- 604051-04 FRAME AND GRATE, TYPE 11
- 604056-04 FRAME AND GRATE, TYPE 11V
- 606001-06 CONCRETE CURB TYPE B AND COMBINATION CONCRETE CURB AND GUTTER
- 664001-02 CHAIN LINK FENCE
- 701001-02 OFF-RD OPERATIONS, 2L, 2W, 15' (4.5 m) AWAY
- 701006-05 OFF-RD OPERATIONS, 2L, 2W, MORE THAN 15' (4.5 m) TO 24" (600mm) FROM PAVEMENT EDGE
- 701101-05 OFF-RD OPERATIONS, MULTILANE, 15' (4.5 m) TO 24" (600 mm) FROM EDGE OF PAVEMENT
- 701427-05 LANE CLOSURE, MULTILANE, INTERMITTENT OR MOVING OPER., FOR SPEEDS \leq 40 MPH
- 701901-06 TRAFFIC CONTROL DEVICES
- 720001-01 SIGN PANEL MOUNTING DETAILS
- 720006-04 SIGN PANEL ERECTIONS DETAILS
- 720011-01 METAL POSTS FOR SIGNS, MARKERS AND DELINEATORS
- 728001-01 TELESCOPING STEEL SIGN SUPPORT
- 729001-01 APPLICATIONS OF TYPES A AND B METAL POSTS (FOR SIGNS & MARKERS)
- 731001-01 BASE FOR TELESCOPING STEEL SIGN SUPPORT
- 780001-05 TYPICAL PAVEMENT MARKINGS

GENERAL NOTES

- 1. ALL ROADWAY CONSTRUCTION SHALL CONFORM TO THE "STANDARD SPECIFICATIONS FOR ROAD AND BRIDGE CONSTRUCTION", ADOPTED APRIL 1, 2016 BY THE ILLINOIS DEPARTMENT OF TRANSPORTATION AND ALL AMENDMENTS THERETO, AND IN ACCORDANCE WITH THE LATEST EDITION OF THE SPECIFICATIONS FOR CONSTRUCTION IN THE VILLAGE OF ROMEOVILLE AND IN CASE OF CONFLICT, THE MORE STRINGENT CODE SHALL TAKE PRECEDENCE.
- 2. ALL STORM SEWER, SANITARY SEWER AND WATER MAIN CONSTRUCTION SHALL CONFORM TO THE "STANDARD SPECIFICATIONS FOR WATER AND SEWER MAIN CONSTRUCTION IN ILLINOIS", PUBLISHED JUNE 2014, AND IN ACCORDANCE WITH THE SPECIFICATIONS FOR CONSTRUCTION IN THE VILLAGE OF ROMEOVILLE UNLESS OTHERWISE NOTED ON THE PLANS.
- 3. THE CONTRACTOR SHALL BE RESPONSIBLE FOR HAVING THE UTILITY COMPANIES LOCATE THEIR FACILITIES IN THE FIELD PRIOR TO CONSTRUCTION AND SHALL ALSO BE RESPONSIBLE FOR THE MAINTENANCE AND PRESERVATION OF THESE FACILITIES. THE ENGINEER DOES NOT WARRANT THE LOCATION OF ANY EXISTING UTILITIES SHOWN ON THE PLAN. THE CONTRACTOR SHALL CALL J.U.L.I.E. AT 800-892-0123 AND THE VILLAGE OF ROMEOVILLE (815-886-1870) FOR UTILITY LOCATIONS.
- 4. THE CONTRACTOR IS RESPONSIBLE FOR VERIFYING THE NATURE AND STATUS OF ALL UTILITY RELOCATION WORK PRIOR TO THE START OF CONSTRUCTION. THE CONTRACTOR SHALL TAKE APPROPRIATE MEASURES TO VERIFY THAT CONSTRUCTION OPERATIONS DO NOT INTERFERE WITH UTILITY FACILITIES AND RELOCATION WORK. THE SCHEDULE SHOULD REFLECT CONSTRUCTION SEQUENCING, WHICH COORDINATES WITH ALL UTILITY RELOCATION WORK. THE CONTRACTOR SHALL BE REQUIRED TO ADJUST THE ORDER OF WORK FROM TIME TO TIME, TO COORDINATE SAME WITH UTILITY RELOCATION WORK, AND SHALL PREPARE REVISED SCHEDULE (S) IN COMPLIANCE THEREWITH AS DIRECTED BY THE OWNER. THE OWNER AND THE ENGINEER SHALL BE NOTIFIED IN WRITING BY THE CONTRACTOR AT LEAST 48 HOURS PRIOR TO THE START OF ANY OPERATION REQUIRED COOPERATION WITH OTHERS. ALL OTHER AGENCIES, UNLESS OTHERWISE NOTED, WILL BE NOTIFIED IN WRITING BY THE CONTRACTOR TEN (10) DAYS PRIOR TO THE START OF ANY SUCH OPERATION. THE UTILITY COMPANIES HAVE BEEN CONTACTOR IN REFERENCE TO UTILITIES THEY OWN AND OPERATE WITHIN THE LIMITS FOR THIS PROJECT. ALL KNOWN DATA FROM THESE AGENCIES HAS BEEN INCORPORATED INTO THE PLANS. IT IS HOWEVER, THE CONTRACTOR'S RESPONSIBILITY TO CONFIRM OR ESTABLISH THE EXISTENCE OF ALL UTILITY FACILITIES AND THEIR EXACT LOCATIONS, WHETHER CONTAINED IN THE DATA SUBMITTED BY THESE AGENCIES OR NOT, AND TO SAFELY SCHEDULE ALL UTILITY RELOCATIONS.
- 5. ALL CONTRACTORS SHALL KEEP ACCESS AVAILABLE AT ALL TIMES FOR ALL TYPES OF TRAFFIC AS DIRECTED BY THE ENGINEER.
- 6. CONTRACTOR SHALL TAKE PHOTOS AND VIDEO RECORD WORK AREA PRIOR TO CONSTRUCTION FOR THE PURPOSE OF DOCUMENTING EXISTING CONDITIONS.
- 7. THE CONTRACTOR SHALL PRESERVE ALL CONSTRUCTION STAKES UNTIL THEY ARE NO LONGER NEEDED. STAKES DESTROYED OR DISTURBED BY THE CONTRACTOR PRIOR TO THEIR USE SHALL BE RESET BY THE ENGINEER AT THE CONTRACTOR'S EXPENSE.
- 8. REMOVAL OF SPECIFIED ITEMS, INCLUDING BUT NOT LIMITED TO, PAVEMENT, SIDEWALK, CURB, CURB AND GUTTER, CULVERTS, ETC. SHALL BE DISPOSED OF OFF-SITE BY THE CONTRACTOR. THE CONTRACTOR IS RESPONSIBLE FOR ALL PERMITS REQUIRED FOR SUCH DISPOSAL. THE REMOVAL SHALL BE ACCOMPLISHED BY MEANS OF A SAW CUT JOINT, AT THE DIRECTION OF THE ENGINEER. THIS WORK SHALL NOT BE PAID FOR SEPARATELY, BUT SHALL BE INCLUDED IN THE UNIT PRICE BID FOR THE VARIOUS REMOVAL ITEMS.
- 9. THE CONTRACTOR SHALL COLLECT AND REMOVE ALL CONSTRUCTION DEBRIS, EXCESS MATERIALS, TRASH, OIL AND GREASE RESIDUE, MACHINERY, TOOLS AND OTHER MISCELLANEOUS ITEMS WHICH WERE NOT PRESENT PRIOR TO PROJECT COMMENCEMENT AT NO ADDITIONAL EXPENSE TO THE OWNER. THE CONTRACTOR SHALL BE RESPONSIBLE FOR ACQUIRING ALL PERMITS NECESSARY FOR THE HAULING AND DISPOSAL REQUIRED FOR CLEAN—UP AS DIRECTED BY THE ENGINEER OR OWNER. BURNING ON THE SITE IS NOT PERMITTED.
- 10. AT THE CLOSE OF EACH WORKING DAY AND AT THE CONCLUSION OF CONSTRUCTION OPERATIONS, ALL DRAINAGE STRUCTURES AND FLOW LINES SHALL BE FREE FORM DIRT AND DEBRIS.
- 11. THE TRENCHES FOR PIPE INSTALLATION SHALL BE KEPT DRY AT ALL TIMES DURING PIPE PLACEMENT. APPROPRIATE FACILITIES TO MAINTAIN THE DRY TRENCH SHALL BE PROVIDED BY THE CONTRACTOR AND THE COST OF SUCH SHALL BE INCLUDED IN THE UNIT PRICE BID AND APPROVED BY THE ENGINEER PRIOR TO IMPLEMENTATION. NO ADDITIONAL COMPENSATION SHALL BE MADE FOR DEWATERING DURING CONSTRUCTION UNLESS APPROVED IN WRITING BY THE OWNER.
- 12. TRENCH BACKFILL WILL BE REQUIRED TO THE FULL DEPTH ABOVE STORM SEWERS AND CULVERTS WITHIN TWO (2) FEET OF PROPOSED OR EXISTING PAVEMENT.
- 13. IT SHALL BE THE CONTRACTOR'S RESPONSIBILITY TO VERIFY ALL DIMENSIONS AND CONDITIONS EXISTING IN THE FIELD PRIOR TO CONSTRUCTION AND ORDERING OF MATERIALS.
- 14. THE THICKNESS OF HMA MIXTURE STATED IN THE SPECIFICATIONS IS THE NOMINAL THICKNESS. DEVIATIONS FROM THE NOMINAL THICKNESS WILL BE PERMITTED WHEN SUCH DEVIATIONS FROM THE NOMINAL THICKNESS OCCUR DUE TO IRREGULARITIES IN THE EXISTING SURFACE OR BASE ON WHICH THE HMA SURFACE IS PLACED.
- 15. THE CONTRACTOR SHALL CONTACT ROBINSON ENGINEERING (708)331-6700 AND THE VILLAGE OF ROMEOVILLE (815) 886-1870 A MINIMUM OF 72 HOURS IN ADVANCE OF BEGINNING WORK.

PLATFORM AREA DIVISION OF WORK

PRIME CONTRACTOR

- COORDINATION WITH METRA FORCES REQUIRED FOR PLATFORM WORK
- GRADE AND PREPARE SUBGRADE PER PLANS AND DETAILS
- FURNISH AND INSTALL 12.5 INCH AGGREGATE BASE (PLATFORMS)
- FURNISH AND INSTALL GEOTECHNICAL FILTER FABRIC (PLATFORMS)
- FURNISH AND INSTALL PRIME COAT AND HOT-MIX ASPHALT (PLATFORMS)
- FURNISH AND INSTALL CONCRETE FOUNDATIONS FOR PLATFORM LIGHTING
- PROVIDE MATERIALS ONLY FOR PLATFORM AREA LIGHT POLES PER THE SPECIFICATIONS
- PROVIDE MATERIALS ONLY FOR PLATFORM AND STATION SIGNAGE
- FURNISH MATERIALS AND CONSTRUCT PROPOSED WARMING SHELTER BUILDING
- FURNISH AND INSTALL CONCRETE SIDEWALKS, DRAINAGE IMPROVEMENTS, AND FENCING
- FURNISH AND INSTALL EROSION CONTROL AND RESTORATION ITEMS

METRA FORCES

- FURNISH AND INSTALL STRUCTURAL REINFORCED POLYMER COMPOSITE DECK PANELS WITH INTEGRAL DETECTABLE WARNINGS, CRUSHED LIMESTONE SCREENING, TIMBERS, HEADERS, HARDWARE, STAKES, DOWELS, AND ALL OTHER PLATFORM WORK NOT LISTED UNDER THE VILLAGE CONTRACTOR DIVISION OF WORK.
- INSTALL PLATFORM LIGHTING (MATERIALS PROVIDED BY VILLAGE CONTRACTOR)
- INSTALL SIGNAGE (MATERIALS PROVIDED BY VILLAGE CONTRACTOR)

CANADIAN NATIONAL RAILWAY (CN) FORCES

FURNISH AND INSTALL AT-GRADE PEDESTRIAN CROSSING

EARTHWORK NOTES

- 1. GENERAL
 - A. IT IS THE CONTRACTOR'S RESPONSIBILITY TO UNDERSTAND THE SOIL AND GROUNDWATER CONDITIONS AT THE SITE.
 - B. THE ELEVATIONS SHOWN ON THE CONSTRUCTION PLANS ARE FINISHED GRADE AND SUBGRADE ELEVATIONS (AS NOTED) AND THAT PAVEMENT THICKNESS, TOPSOIL, ETC. MUST BE ACCOUNTED FOR.
 - C. THE CONTRACTOR SHALL MAINTAIN POSITIVE DRAINAGE DURING CONSTRUCTION, AND PREVENT STORMWATER FROM RUNNING INTO OR STANDING IN EXCAVATED AREAS. THE FAILURE TO PROVIDE PROPER DRAINAGE WILL NEGATE ANY POSSIBLE ADDED COMPENSATION REQUESTED DUE TO DELAYS OR UNSUITABLE MATERIALS CREATED AS A RESULT THEREOF. FINAL GRADES SHALL BE PROTECTED AGAINST DAMAGE FROM EROSION, SEDIMENTATION AND TRAFFIC.
 - D. PLANS FOR THE SITE DEWATERING, IF EMPLOYED, SHALL BE SUBMITTED AND APPROVED PRIOR TO IMPLEMENTATION. NO ADDITIONAL COMPENSATION SHALL BE MADE FOR DEWATERING DURING CONSTRUCTION.
 - E. THE CONTRACTOR SHALL BE RESPONSIBLE FOR IMPLEMENTATION OF THE "SOIL EROSION AND SEDIMENTATION CONTROL MEASURES". THE INITIAL ESTABLISHMENT OF EROSION CONTROL PROCEDURES AND THE PLACEMENT OF SILT AND FILTER FENCING, ETC. TO PROTECT ADJACENT PROPERTY, WETLANDS, ETC. SHALL OCCUR BEFORE GRADING BEGINS.
 - F. ALL STORM INLETS SHALL BE PROTECTED BY INLET FILTERS. PLACEMENTS AND MAINTENANCE OR SILT BARRIER SHALL BE AS DIRECTED BY THE ENGINEER, BASED ON ACTUAL GRADING. GRADE THE AREA WITHIN FOUR (4) FEET AROUND STRUCTURES ONE (1) FOOT BELOW RIM TO SERVE AS A SEDIMENTATION BASIN DURING CONSTRUCTION.
 - G. FINAL LOCATION OF SILT FENCE SHALL BE ADJUSTED BASED ON ACTUAL SITE GRADING CONDITIONS. ADDITIONAL MEASURES SHALL BE ADDED AS DIRECTED BY THE ENGINEER.

H. ALL AREAS DISTURBED DURING CONSTRUCTION SHALL BE RESEEDED AS SOON AS PRACTICAL.

STORM SEWER NOTES

- 1. STORM SEWER PIPE: ALL STORM SEWER PIPE SHALL BE RCP.
- 2. BEDDING: ALL STORM SEWERS SHALL BE INSTALLED ON A TYPE B GRANULAR BEDDING, ¼" TO 1" IN SIZE (CA-7) WITH A MINIMUM THICKNESS EQUAL TO ¼ THE OUTSIDE DIAMETER OF THE SEWER PIPE BUT NOT LESS THAT 4". BLOCKING OF ANY KIND FOR GRADE IS NOT PERMITTED. THE BEDDING MATERIALS SHALL BE COMPACTED TO 90% OF MODIFIED PROCTOR DENSITY. BEDDING SHALL EXTEND TO THE SPRINGLINE OF THE PIPE.
- 3. COVER: THE CONTRACTOR SHALL MAINTAIN AT LEAST ONE (1') FOOT OF COVER OVER THE TOP OF SHALLOW PIPES AT ALL TIMES DURING CONSTRUCTION. THE CONTRACTOR SHALL MOUND OVER ANY PIPES WHICH HAVE LESS THAN ONE (1') FOOT OF COVER DURING CONSTRUCTION UNTIL THE AREA IS FINAL GRADED OR PAVED.
- 4. ALL TRENCHES BENEATH PROPOSED OR EXISTING UTILITIES, PAVEMENTS, ROADWAYS, SIDEWALKS, AND FOR A DISTANCE OF TWO (2') FEET ON EITHER SIDE OF SAME, AND/OR WHERE SHOWN ON THE PLANS, SHALL BE BACKFILLED WITH SELECT GRANULAR BACKFILL, CA-7, AND THOROUGHLY MECHANICALLY COMPACTED IN 9" THICK (LOOSE MEASUREMENT) LAYERS. JETTING WITH WATER IS NOT PERMITTED. TRENCH BACKFILL SHALL BE MEASURED ACCORDING TO SECTION 208.03 OF THE STANDARD SPECIFICATIONS.
- 5. ON ALL IMPROVEMENTS THE FRAMES AND LIDS OF EXISTING CATCH BASINS, INLETS, MANHOLES AND VALVE VAULTS WHICH ARE TO BE ABANDONED DUE TO CONSTRUCTION OF THIS IMPROVEMENT ARE TO REMAIN THE PROPERTY OF THE VILLAGE OF ROMEOVILLE AND BE SALVAGED. THE OWNER SHALL BE NOTIFIED AS TO AVAILABILITY FOR PICK—UP.
- 6. THE TOP OF ALL STRUCTURES SHALL BE FLUSH WITH THE ADJACENT SURFACE OR AT THE INDICATED ELEVATIONS SHOWN ON THE PLANS.
- 7. FRAME ELEVATIONS ARE GIVEN ONLY TO ASSIST IN DETERMINING THE APPROXIMATE OVERALL HEIGHT OF THE STRUCTURE. FRAMES ON ALL NEW STRUCTURES WILL BE ADJUSTED TO THE FINAL ELEVATION OF THE AREA IN WHICH THEY ARE LOCATED AS PART OF THE STRUCTURE COST.


RAILROAD COORDINATION

IT IS THE CONTRACTOR'S SOLE RESPONSIBILITY TO COORDINATE WITH THE CANADIAN NATIONAL (CN) RAILWAY WHENEVER CONSTRUCTION ACTIVITY IS WITHIN 25 FEET OF THE RAILROAD ROW. THE CONTRACTOR SHALL RETAIN FLAGMEN EMPLOYED AND DESIGNATED BY THE CANADIAN NATIONAL (CN) RAILWAY TO MONITOR ON—COMING TRAIN TRAFFIC, AND ADVISE CONTRACTOR PERSONNEL WHEN ACTIVITY ON OR NEAR THE RAILROAD RIGHT—OF—WAY MAY PROCEED. THIS ITEM WILL BE PAID FOR ACCORDING TO ARTICLE 107.12 AND WILL BE REIMURSED ACCORDING TO ARTICLE 109.05.

NEW AVENUE ACCESS

FOR CONSTRUCTION ACTIVITIES ON THE EAST SIDE OF THE RAILROAD TRACKS, THE CONTRACTOR ACCESS SHALL BE FROM NEW AVENUE. QUANTITIES FOR AGGREGATE FOR TEMPORARY ACCESS HAVE BEEN INCLUDED FOR THIS PURPOSE. FOR THE ENTIRE PROJECT, IT SHALL BE THE CONTRACTOR'S RESPONSIBILITY TO COORDINATE WITH THE INDIVIDUAL UTILITY/PIPELINE COMPANIES IN OR NEAR THE WORK AREAS WHEN EQUIPMENT/MATERIALS WILL CROSS THEIR FACILITIES TO ENSURE ALL THE UTILITY PROTECTION REQUIREMENTS ARE MET. ANY NECESSARY UTILITY PROTECTION MEASURES WILL BE AT THE CONTRACTOR'S EXPENSE.

^^^^^

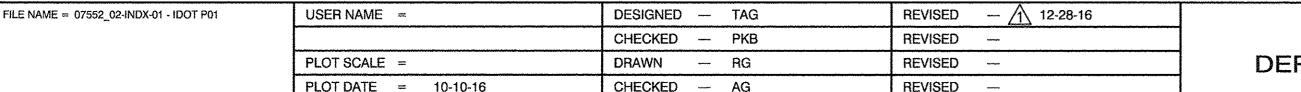

STATE OF ILLINOIS
DEPARTMENT OF TRANSPORTATION

ROMEOVILLE METRA LOT
PROPOSED ACCESS ROAD
INDEX OF SHEETS, STATE STANDARDS & GENERAL NOTES

SHEET NO. 2 OF 64 SHEETS STA.

SCALE:

 F.A.U. RTE.
 SECTION
 COUNTY
 TOTAL SHEET NO.

 282
 10-00056-00-PK
 WILL
 64
 2

 CONTRACT NO. 61 D08

 FED. ROAD DIST. NO. 1 ILLINOIS FED. AID PROJECT CMM-9003(600)