


R7-201-3
REFLECTIVE: NO
MOUNT: FLAG
(18"x18")
PEO-19-ST

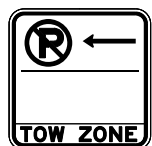

R7-201-3
REFLECTIVE: NO
MOUNT: FLAG
(18"x18")
PEO-20-ST




W14-2
REFLECTIVE: YES
MOUNT: CENTER
(30"x24")
PEO-17A-LP



W14-2
REFLECTIVE: YES
MOUNT: CENTER
(36"x36")
PEO-26-ST
PEO-27-LP

SIGN NUMBERING CODE EXAMPLE

DIRECTION OF TRAFFIC: EB-03-LP
MOUNTING TYPE: ST - STEEL POST, LP - LIGHT POLE BANDING, BM - BRIDGE MOUNTED, TS - TELESCOPING STEEL, CU - CUSTOM
SIGN PANEL NUMBER: PEO - PEORIA STREET, EB - EASTBOUND EISENHOWER EXPY, WB - WESTBOUND EISENHOWER EXPY

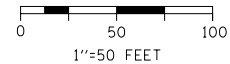

D:\60W29-Sht-Sign-01.dgn
USER NAME = BAWtor1
PLOT SCALE = 100.0000' / 1"
PLOT DATE = 12/19/2013

DESIGNED - JDT
DRAWN - JTR
CHECKED - JMG
DATE - 10/30/2013
REVISED - 12/18/2013
REVISED -
REVISED -
REVISED -


**STATE OF ILLINOIS
DEPARTMENT OF TRANSPORTATION**

**SIGNING PLAN
PEORIA STREET**

SCALE: 1"=50' SHEET 3 OF 4 SHEETS STA. 3700+00 TO STA. 3710+00

F.A.I. RTE.	SECTION	COUNTY	TOTAL SHEETS	SHEET NO.
90/94/290	2013-01R	COOK	356	101
CONTRACT NO. 60W29				
ILLINOIS FED. AID PROJECT				

FILE PATH = p:\388035-par1\escomon\me\local\PEOCD\00\Documents\01_Americas\Transportation\60269938_Circle\Phase_1\1000_CAD\006_Roadway\Sheets\60W29_Contract\0160W29-Sht-Sign-01.dgn

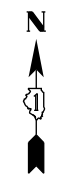

Congress Pkwy
2 LEFT LANES

EB-01-BM

WEST Kennedy Expy
Wisconsin

EB-02-BM

EAST Ryan Expy
Indiana
EXIT ONLY

EB-04-BM

Peoria St
900 W

WB-04-TS

MORGAN STREET

SANGAMON STREET


PEORIA STREET

GREEN STREET

HALSTED STREET

I-290 EXPRESSWAY

I-290 EXPRESSWAY

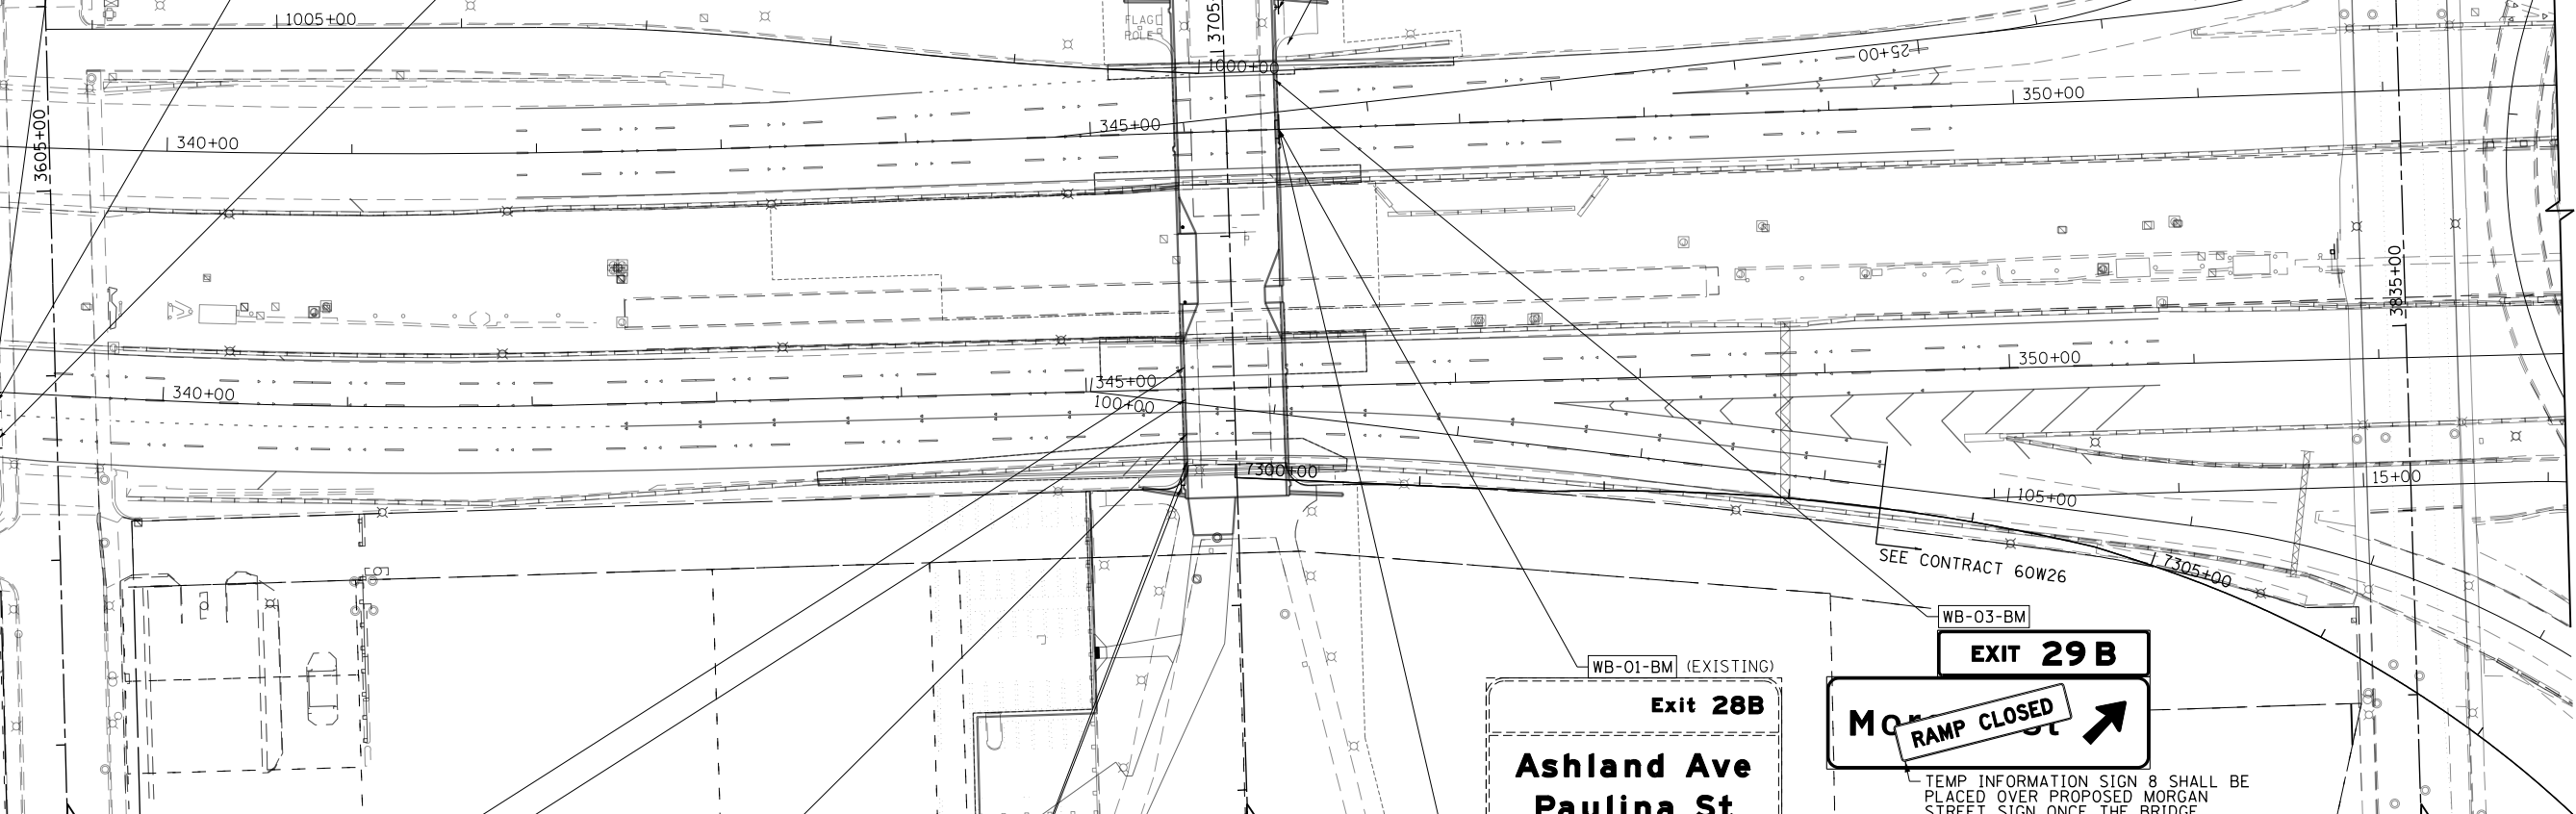

MORGAN STREET

PEORIA STREET

HALSTED STREET

(EXISTING) EB-06-BM
WEST Kennedy Expy
Wisconsin

(EXISTING) EB-07-BM
EAST Ryan Expy
Indiana

EB-08-BM
Peoria St
900 W

WB-01-BM (EXISTING)
Exit 28B
Ashland Ave
Paulina St
3/4 MILE


WB-03-BM
EXIT 29B
MORGAN STREET
RAMP CLOSED

WB-02-BM
EXIT 28B
Ashland Ave
3/4 MILE

TEMP INFORMATION SIGN 8 SHALL BE PLACED OVER PROPOSED MORGAN STREET SIGN ONCE THE BRIDGE MOUNT IS PLACED ON BRIDGE AND SHALL REMAIN AFTER CONSTRUCTION OF PEORIA STREET BRIDGE IS COMPLETE.

SIGN NUMBERING CODE EXAMPLE

DIRECTION OF TRAFFIC	MOUNTING TYPE
PEO - PEORIA STREET	ST - STEEL POST
EB - EASTBOUND EISENHOWER EXPY	LP - LIGHT POLE BANDING
WB - WESTBOUND EISENHOWER EXPY	BM - BRIDGE MOUNTED
SIGN PANEL NUMBER	TS - TELESCOPING STEEL

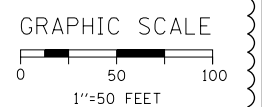

FILE PATH = c:\pwworking\userman\062045391\0160W29-Sht-Sign-03.dgn



D160W29-Sht-Sign-03.dgn	DESIGNED - JDT	REVISED - A 01/20/2014
USER NAME = mnboldwin	DRAWN - JTR	REVISED -
PLOT SCALE = 100.0000' / in.	CHECKED - JMG	REVISED -
PLOT DATE = 1/21/2014	DATE - 10/30/2013	REVISED -

STATE OF ILLINOIS
DEPARTMENT OF TRANSPORTATION

SIGNING PLAN			
I-290			
SCALE: 1"=50'	SHEET 4	OF 4 SHEETS	STA. 339+00 TO STA. 353+00

F.A.I. RTE.	SECTION	COUNTY	TOTAL SHEETS	SHEET NO.
90/94/290	2013-011R	COOK	356	102
CONTRACT NO. 60W29				
ILLINOIS FED. AID PROJECT				

GENERAL NOTES

SPECIFICATIONS:

DESIGN: AASHTO Standard Specifications for Structural Supports for Highway Signs, Luminaires and Traffic Signals. ("AASHTO Specifications") (2)

CONSTRUCTION: Current (at time of letting) Illinois Department of Transportation Standard Specifications for Road and Bridge Construction, Supplemental Specifications and Special Provisions. ("Standard Specifications")

LOADING: 90 M.P.H. WIND VELOCITY

WALKWAY LOADING: Dead load plus 500 lbs. concentrated live load.

MINIMUM CLEARANCE: 3" greater than bridge members at all locations. (All Obstructions)

WELDING: All welds to be continuous unless otherwise shown. All welding to be done in accordance with current AWS D1.1 Structural Welding Code (Steel) and the Standard Specifications.

MATERIALS: All Structural Steel Pipe shall be ASTM A53 Grade B with a minimum yield of 35,000 p.s.i., or A500 Grade B or C with a minimum yield of 46,000 p.s.i. If A500 pipe is substituted for A53, then the outside diameter shall be as detailed and wall thickness greater than or equal to A53. All Structural Steel Plates and Shapes shall conform to AASHTO M270 Gr. 36, Gr. 50 (M183, M223 Gr. 50).

HIGH STRENGTH BOLTS: All bolts, washers, nuts and locknuts shall satisfy the requirements of ASTM designation A307 unless noted as "H.S." which shall require AASHTO M164 (A325), ASTM A449, or approved alternate. All fasteners shall be hot dip galvanized per AASHTO M232 unless otherwise specified.


GALVANIZING: All Steel Grating, Plates, Shapes and Pipe shall be Hot Dip Galvanized after fabrication in accordance with AASHTO M111. Painting is not permitted.

ANCHOR RODS: All-threaded rod shall conform to ASTM F1554 Grade 105, 3/4" ϕ x 12" long, each with one plate washer and locknut and be hot dip galvanized per AASHTO M232. They shall be either cast into the concrete or epoxy grouted in accordance with Section 584 of the Standard Specifications. Minimum embedment in concrete shall be 9".


- (1) Bracket spacing $g \leq 6'-0"$, max. Spacing shall be uniform if possible but may vary $\pm 6"$ to miss existing obstruction (rail post, light poles, web stiffeners, splice plates, etc.). Adjust bracket lengths accordingly on skewed structures.
- (2) Any design modifications shall be based on the current version of applicable specifications and submitted for the Engineer's approval.
- (3) Unit price includes grating, handrail, brackets, supports, anchor bolts, fasteners, fabrication, delivery, erection, field drilling and other necessary items. Limits of payment are based on grating length (cw, dw) unless otherwise specified. For Safety Chain Details and Details D, F and G, see Base Sheet BM-4.
- (4) If walkway bracket at safety chain location is behind sign, add angle to bracket. See detail on Base Sheet BM-4.

TOTAL BILL OF MATERIAL


(3) OVERHEAD SIGN STRUCTURE - BRIDGE MOUNTED	Foot	35
--	------	----

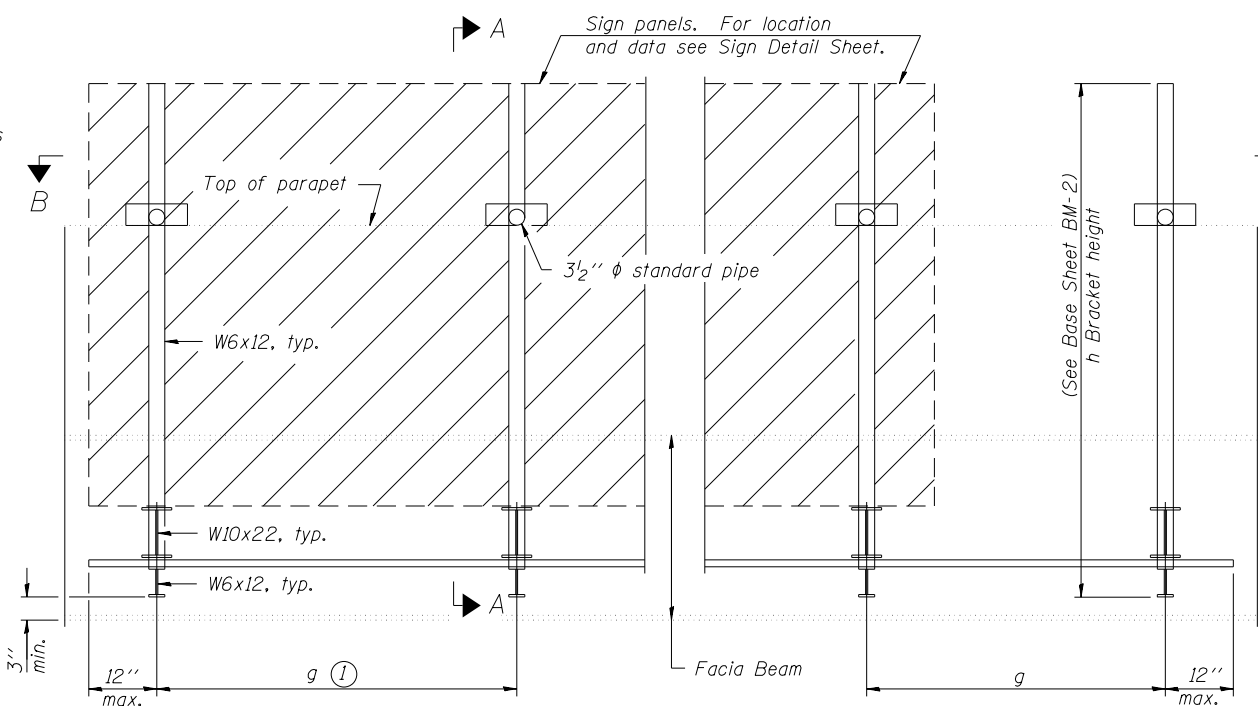


TYPICAL FRONT ELEVATION
(With lights, safety chain and handrail omitted for clarity.)

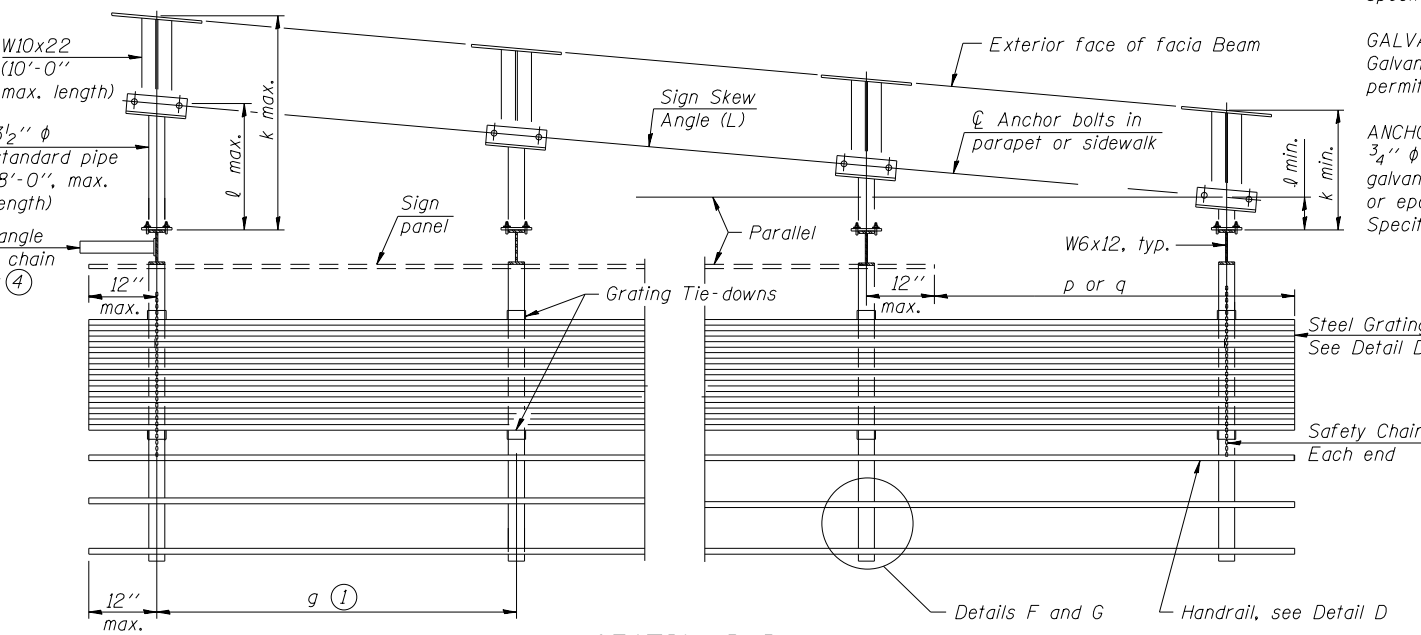


SECTION B-B
(Shown: Left Sign Skew > 15°)

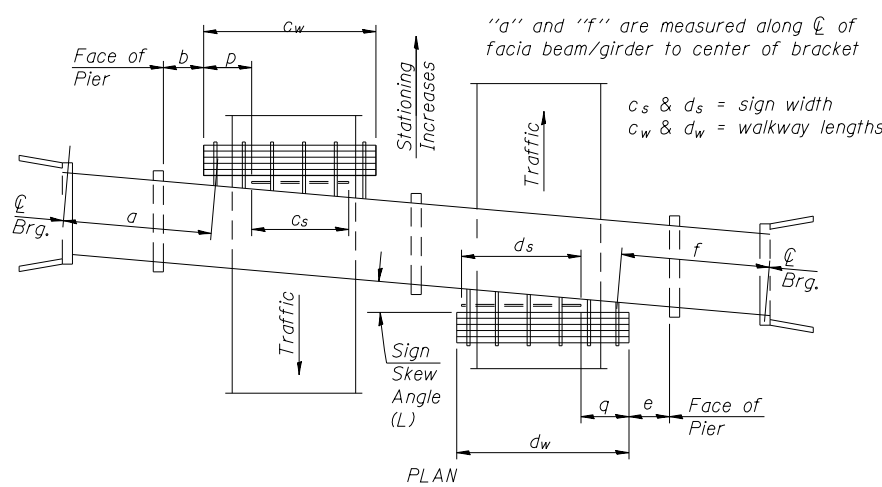

WALKWAY AND HANDRAIL SKETCH
(Road plan beneath structure varies.)

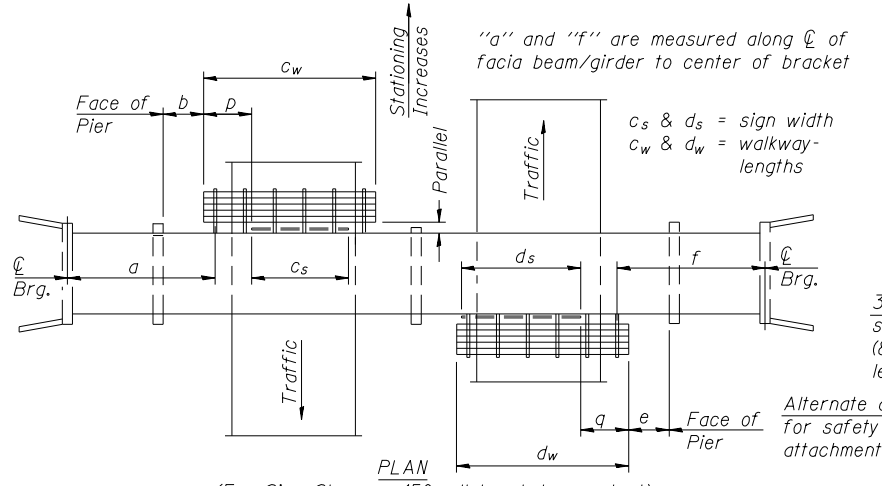

WALKWAY AND HANDRAIL SKETCH
(Road plan beneath structure varies.)

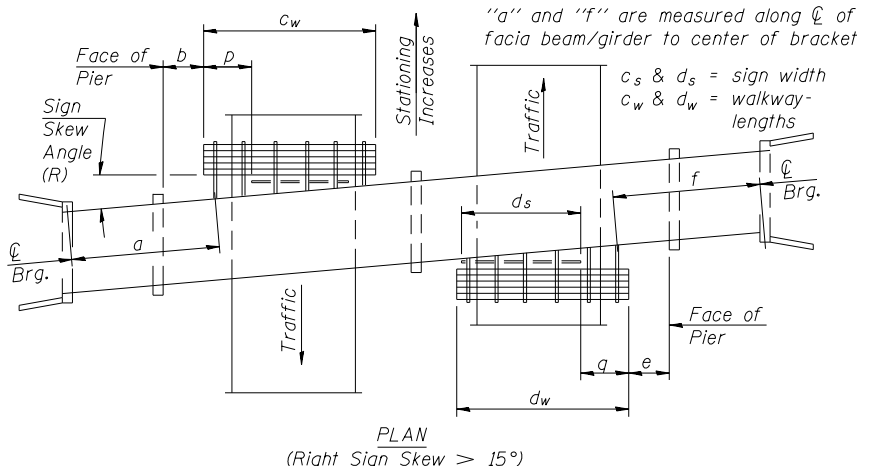

WALKWAY AND HANDRAIL SKETCH
(Road plan beneath structure varies.)

Structure Number	Sign Skew Angle (L) or (R)	Bridge Station	Bridge Structure Number	Contract Route Designation	a	b	c _s	c _w	d _s	d _w	e	f	g	No. of Brackets (Total)	p	q	Total Grating/Hndrl. Lengths (c _w + d _w)
1B0161290L029.7A	0°	3704+57	016-1708	MUN 2090	-	-	-	-	17'-0"	0'-0"	-	64'-0 3/4"	5'-0"	4	-	0'-0"	0'-0"
1B0161290L029.7B	0°	3705+12	016-1708	MUN 2090	-	-	-	-	18'-0"	0'-0"	-	8'-6 3/4"	5'-4"	4	-	0'-0"	0'-0"

Dimensions a, b, e, f & g may vary as approved by the Engineer, see (1).
When c_w < c_s and/or d_w < d_s, use alternate brackets without walkway supports where applicable, see (3).

FILE PATH = p:\388035\pmt\lsc\comline\local\p\wec\000\Documents\01_Americas\Transportation\60269938_Circle\Phase 1\1000_CAD\005_Roadway_Sheets\60W29-Sht-Sign-Det-02.dgn






D160W29-Sht-Sign-Det-02.dgn	DESIGNED - WJC	REVISED -
USER NAME = BAW1tor1	DRAWN - WJC	REVISED -
PLOT SCALE = 2.0000' / in.	CHECKED - KAM	REVISED -
PLOT DATE = 10/28/2013	DATE - 10/30/2013	REVISED -

STATE OF ILLINOIS
DEPARTMENT OF TRANSPORTATION

BRIDGE MOUNT SIGN STRUCTURES GENERAL PLAN AND ELEVATION	
SCALE: NONE	SHEET 1 OF 5 SHEETS STA. TO STA.

F.A.I. R.E.	SECTION	COUNTY	TOTAL SHEETS	SHEET NO.
90/94/290	2013-011R	COOK	356	103
CONTRACT NO. 60W29			ILLINOIS FED. AID PROJECT	

FILE PATH = p:\388035-projects\11000-CD-005-Roadway\Sheets\60W29-Sht-Sign-Det-03.dgn

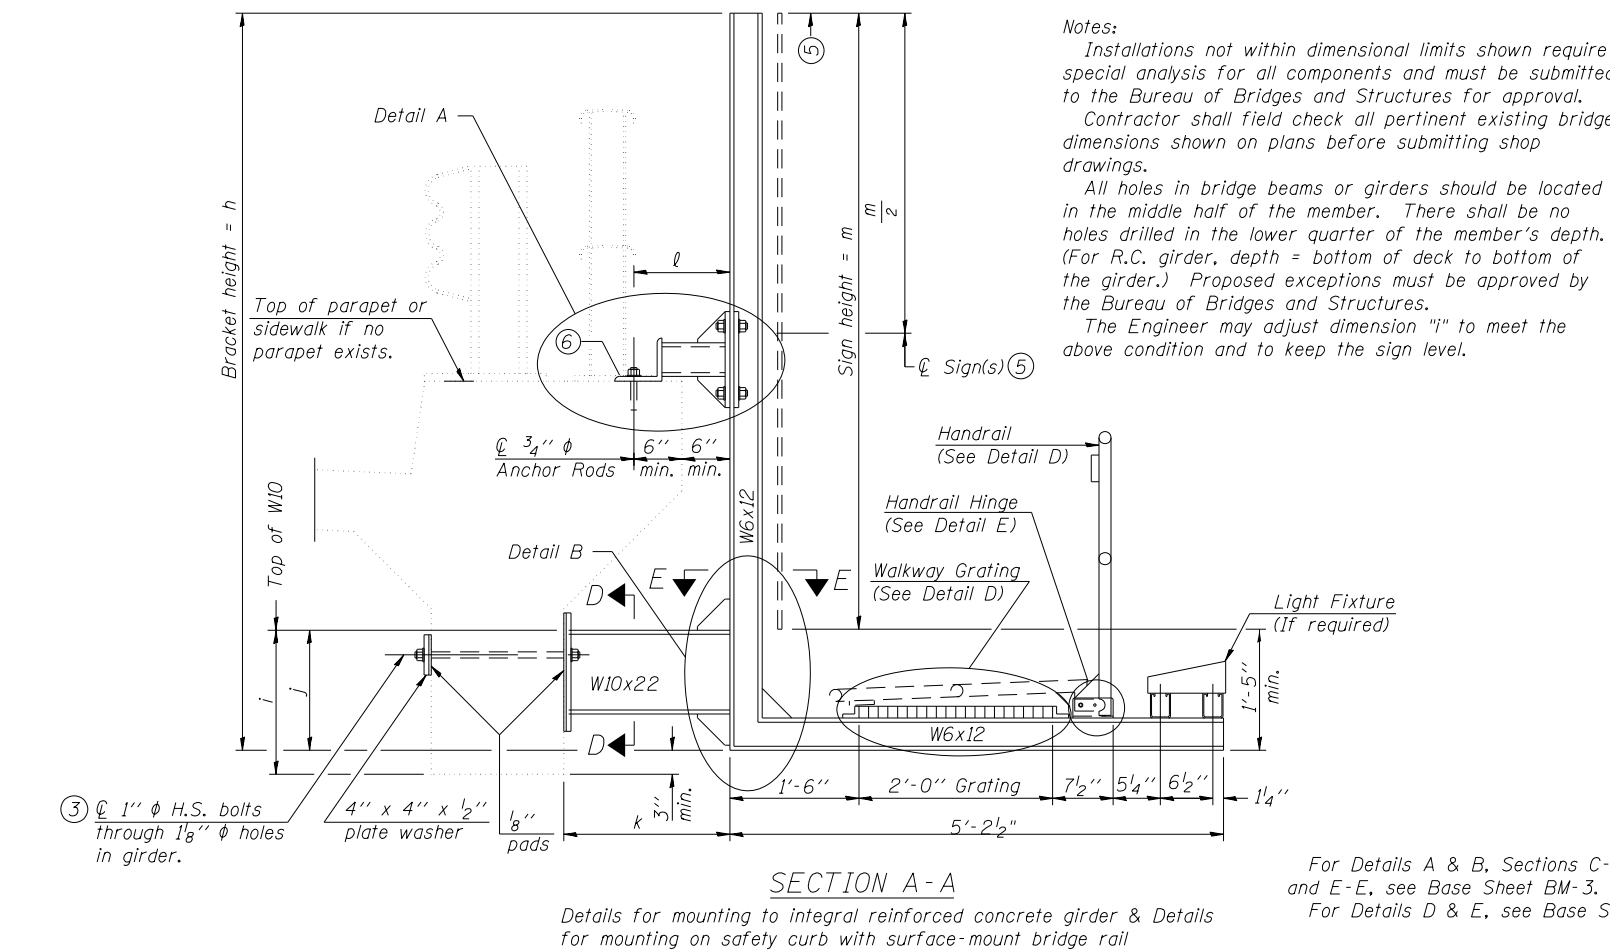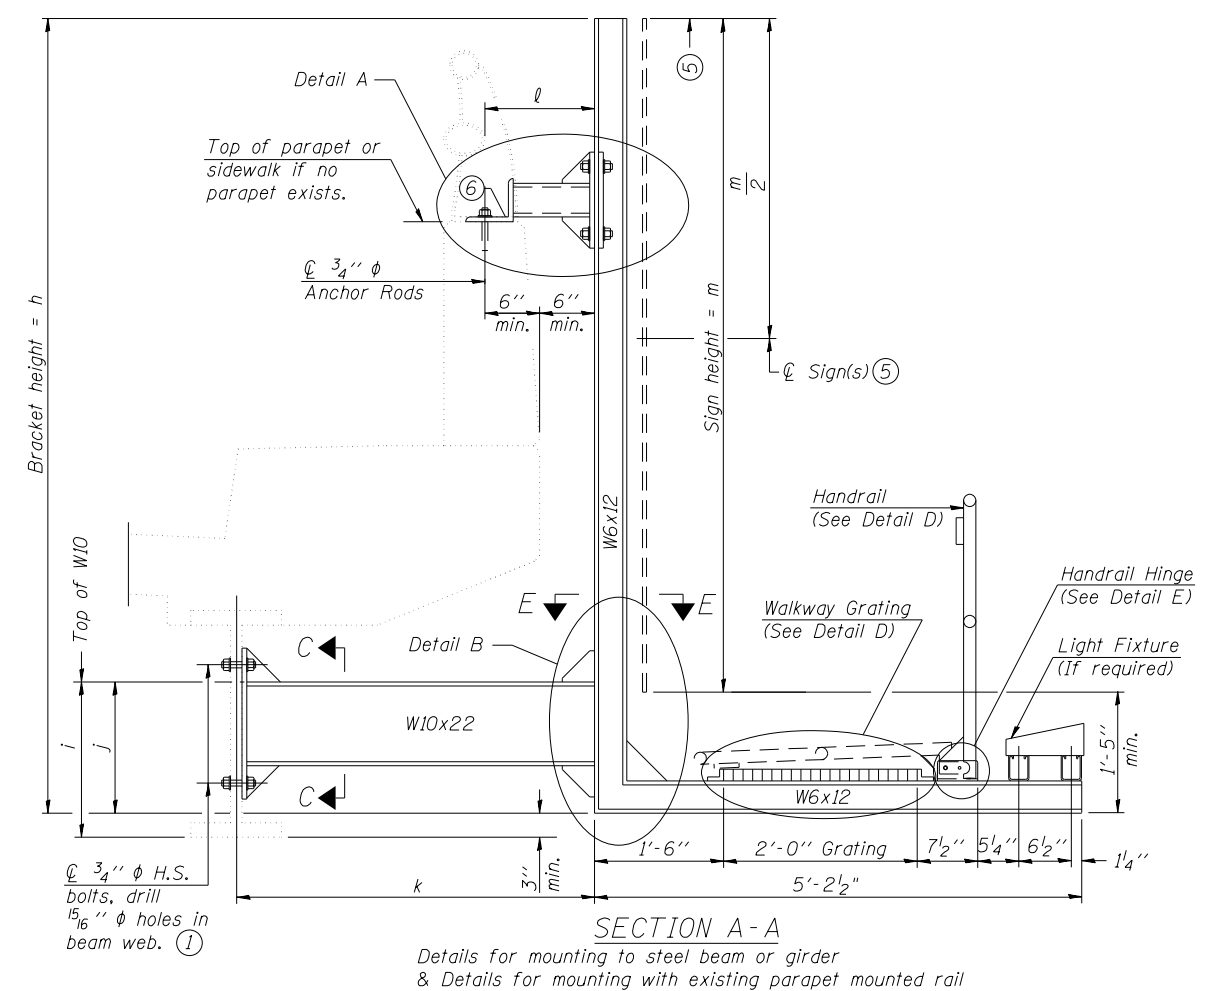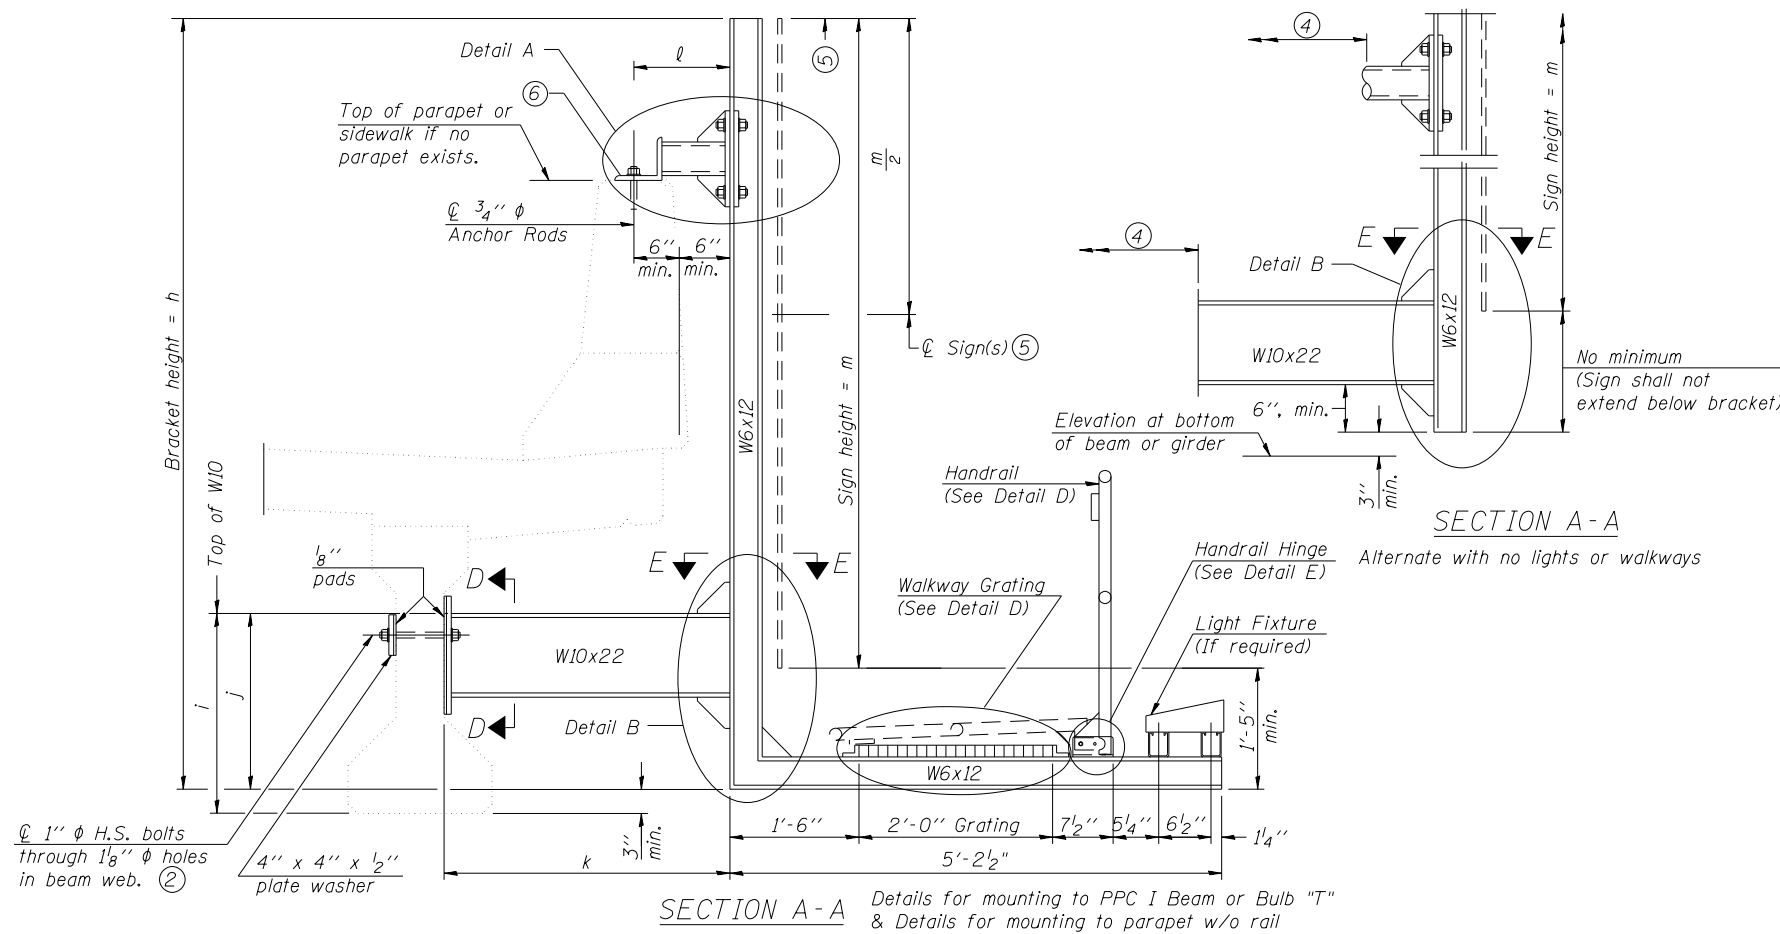

- ① Holes in new steel members may be drilled in the fabrication shop or in the field. Field drill existing members.
- ② For new PPC I beams, holes shall be formed during casting. For existing PPC I beams, prestressing strand locations shall be determined and spaced to miss strands by 6", min. Minimize spalling during field drilling of existing beams.
- ③ For new construction, form holes. For existing RC beams, locate primary reinforcement and space holes to miss by 6", min. Minimize spalling and concrete fracturing/damage during field drilling of existing concrete. Spalls over 1/4" deep or beyond the coverage of the 4x4 plate washer shall be repaired with epoxy mortar before installing washer.
- ④ For attachment details of 3 1/2" pipe and W10x22, see other sections as applicable.
- ⑤ Sign shall not extend more than 6" above top of bracket, and this dimension may vary to keep sign level if bridge is on grade or vertical curve. Multiple signs of various heights shall share a common horizontal centerline and use equal bracket heights. If no sign is attached to a W6x12 vertical (bracket only supporting walkway), dimension h shall be the same as an adjacent bracket with a sign attached, unless Engineer specifically directs shorter brackets due to locational restraints on future uses. (See Detail A for minimum bracket height.)
- ⑥ For bridge mounted sign structures installed on new bridges with railing, during design, bracket spacing must be coordinated with railing post spacing and the Contractor must install upper brackets prior to railing installation. For bridge mounted sign structures installed on existing bridges with railing, during design, brackets spacing must be coordinated with railing post spacing and the Contractor must temporarily remove sections of railing to facilitate upper bracket installation. If it is determined during design that existing railings can't be removed, alternate upper connection details must be developed for the contract plans and approved by the Bureau of Bridges and Structures.

Structure Number	Station	h	i	j	k max. (10'-0" max.)	l max. (8'-0" max.)	m (15'-0" max.)
1B0161290L029.7A	3704+57	8'-0 1/8"	1'-10 3/16"	1'-4 1/8"	4'-0"	1'-6"	8'-6"
1B0161290L029.7B	3705+12	7'-8 1/16"	1'-9 1/16"	1'-4 1/8"	4'-0"	1'-6"	7'-6"

For Details A & B, Sections C-C, D-D and E-E, see Base Sheet BM-3.
For Details D & E, see Base Sheet BM-4.



D160W29-Sht-Sign-Det-03.dgn	DESIGNED - WJC	REVISED -
USER NAME = BAW1tor1	DRAWN - WJC	REVISED -
PLOT SCALE = 2.0000' / in.	CHECKED - KAM	REVISED -
PLOT DATE = 10/28/2013	DATE - 10/30/2013	REVISED -


**STATE OF ILLINOIS
DEPARTMENT OF TRANSPORTATION**

BRIDGE MOUNT SIGN STRUCTURES WALKWAY AND CONNECTION DETAILS			
SCALE: NONE	SHEET 2	OF 5 SHEETS	STA. TO STA.


F.A.I. R.E.	SECTION	COUNTY	TOTAL SHEETS	SHEET NO.
90/94/290	2013-011R	COOK	356	104
ILLINOIS FED. AID PROJECT				

CONTRACT NO. 60W29


FILE PATH = p:\388035-projects\trans\trans\11\000-CD-005-Roadway\Sheets\60W29-Sht-Sign-Det-04.dgn

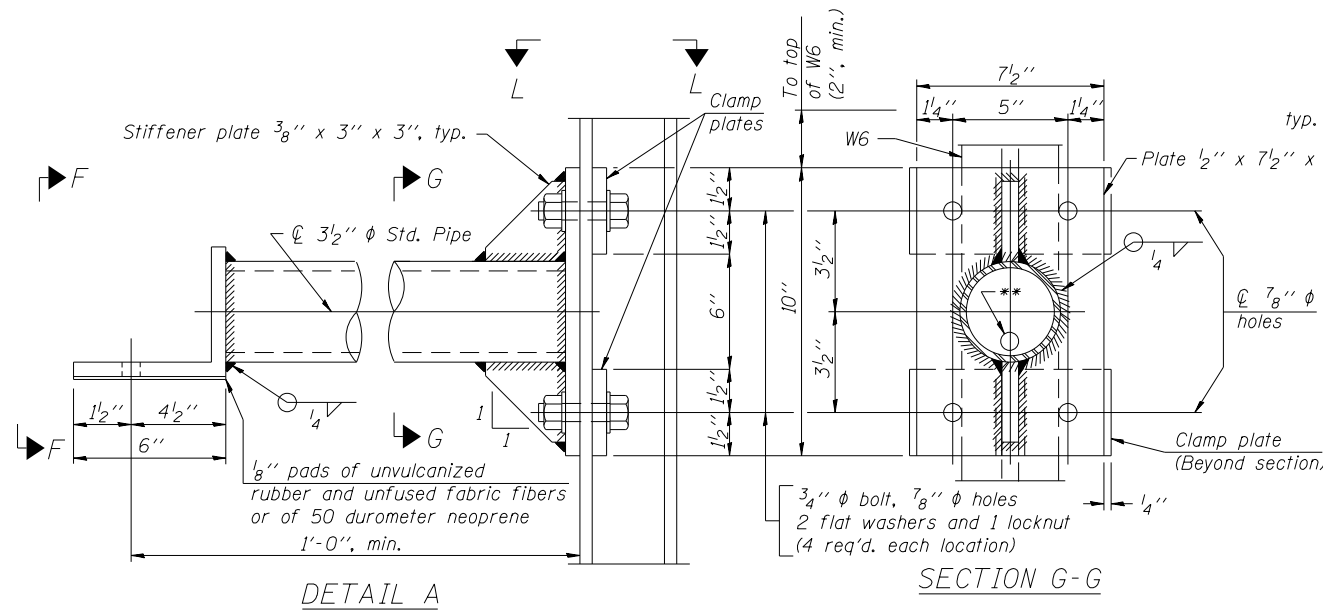


DETAIL A

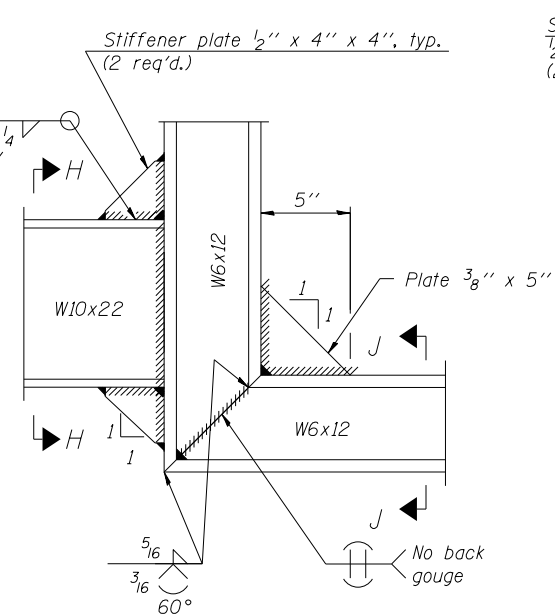


DETAIL B - WELDED W10x22 TO W6x12 CONNECTION

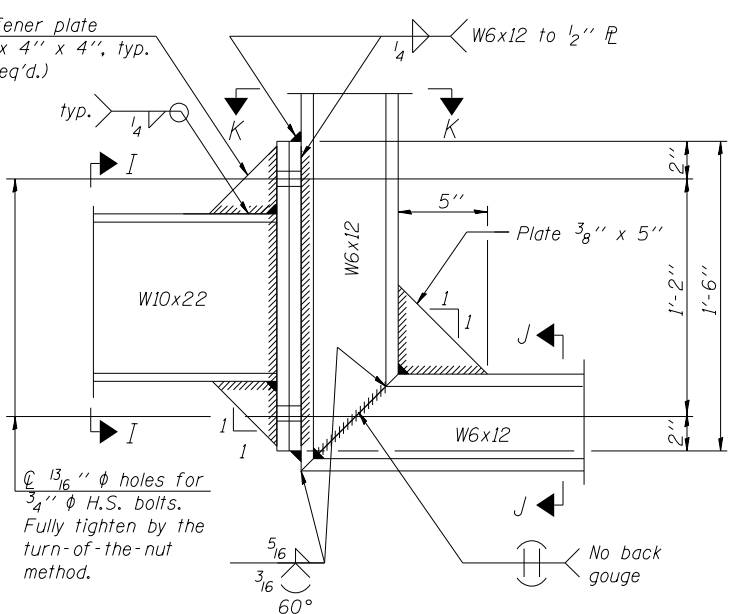


DETAIL B - ALTERNATE BOLTED W10x22 TO W6x12 CONNECTION

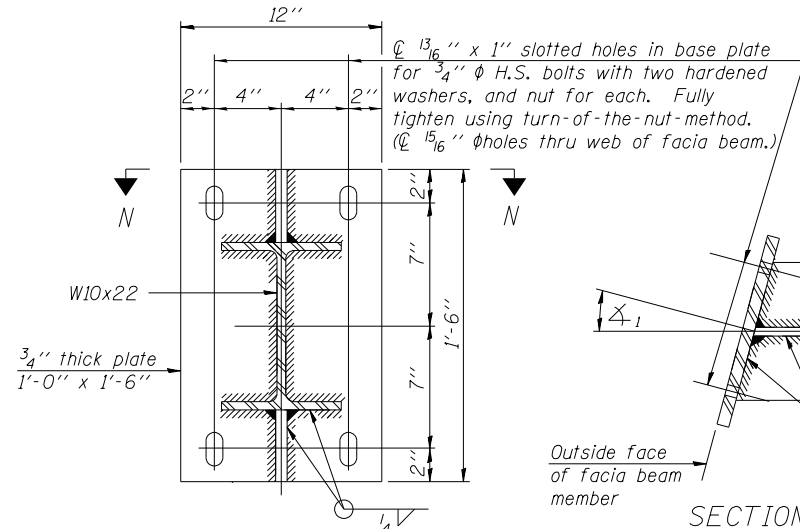


SECTION C-C
Steel beam or girder connection plate details

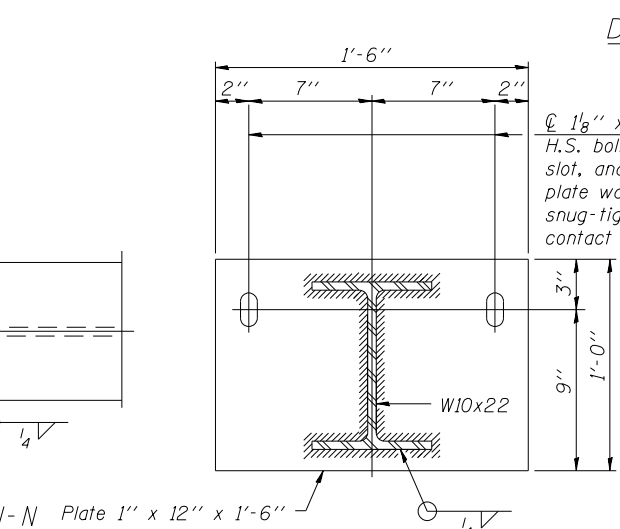


SECTION D-D
Concrete beam or girder connection plate details.

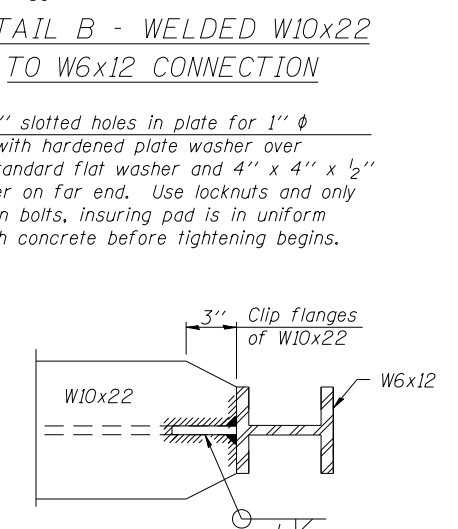


SECTION E-E

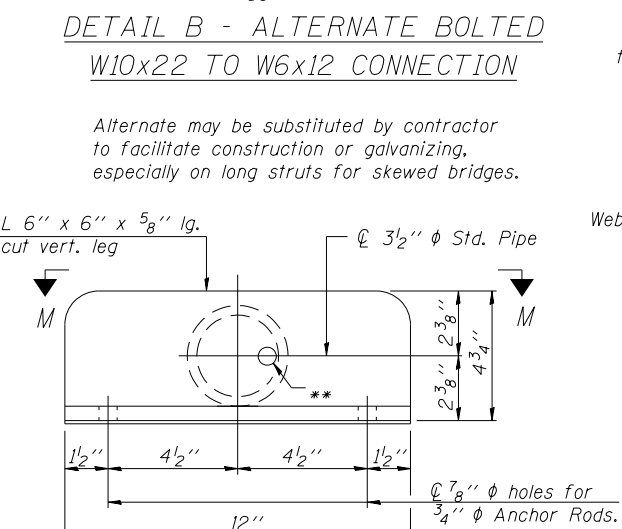


VIEW F-F

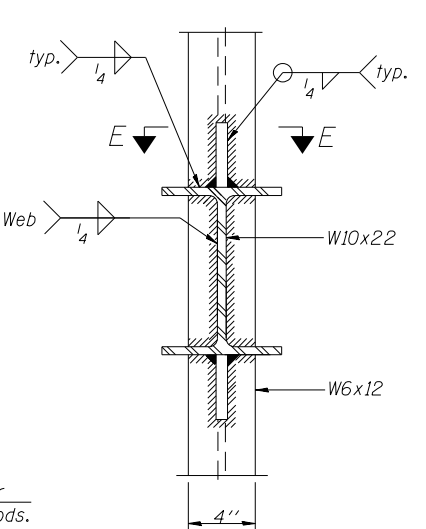


SECTION H-H

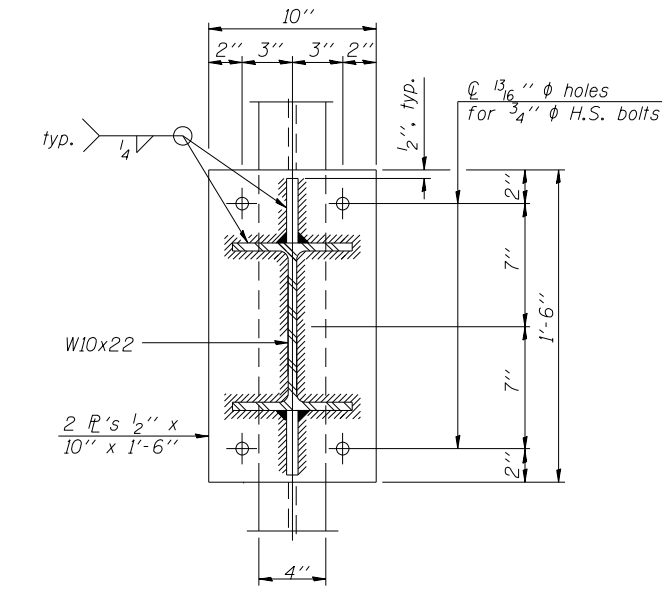


SECTION I-I

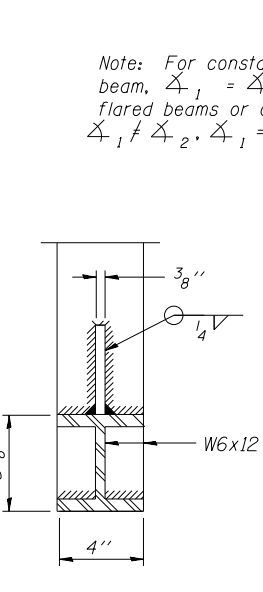


SECTION J-J

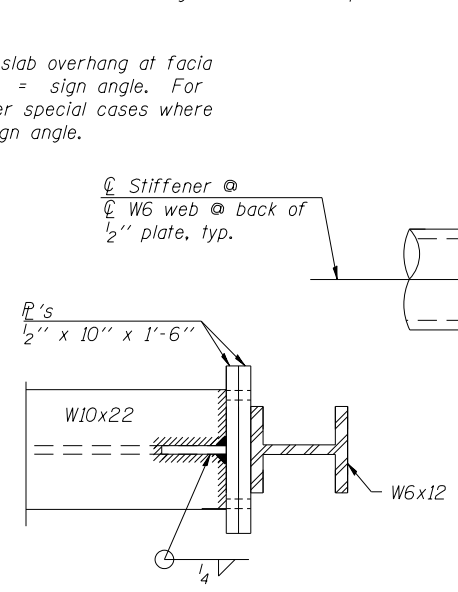


SECTION K-K

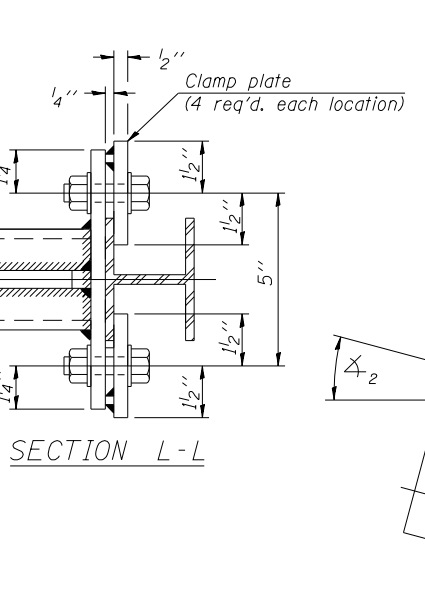

SECTION L-L

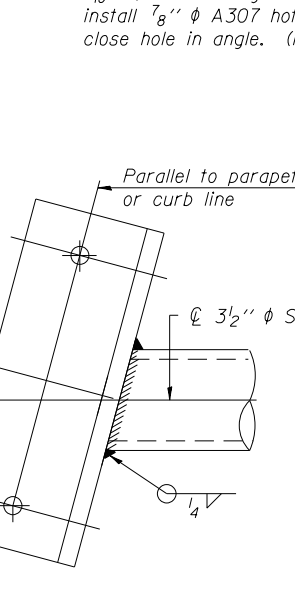

SECTION M-M
Skewed connection detail for 3 1/2" pipe to parapet.

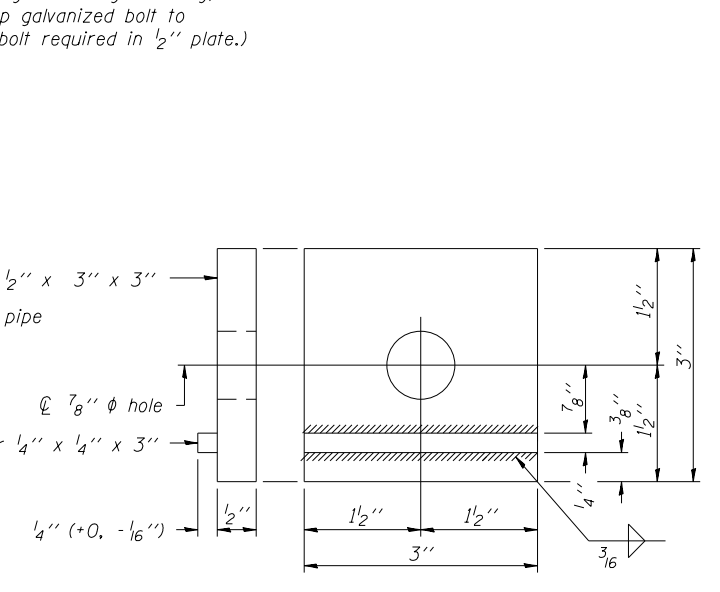

CLAMP PLATE DETAILS

Note: For constant slab overhang at fascia beam, $\Delta_1 = \Delta_2 =$ sign angle. For flared beams or other special cases where $\Delta_1 \neq \Delta_2$, $\Delta_1 =$ sign angle.

** 1 3/16" diameter holes for galvanizing. After galvanizing, install 7/8" diameter A307 hot-dip galvanized bolt to close hole in angle. (No bolt required in 1/2" plate.)





DI60W29-Sht-Sign-Det-04.dgn	DESIGNED - WJC	REVISED -
USER NAME = BAW1tor1	DRAWN - WJC	REVISED -
PLOT SCALE = 2.0000' / in.	CHECKED - KAM	REVISED -
PLOT DATE = 10/28/2013	DATE - 10/30/2013	REVISED -

STATE OF ILLINOIS
DEPARTMENT OF TRANSPORTATION

BRIDGE MOUNT SIGN STRUCTURES CONNECTION DETAILS			
SCALE: NONE	SHEET 3	OF 5 SHEETS	STA. TO STA.

F.A.I. R.E.	SECTION	COUNTY	TOTAL SHEETS	SHEET NO.
90/94/290	2013-011R	COOK	356	105
CONTRACT NO. 60W29				
ILLINOIS FED. AID PROJECT				

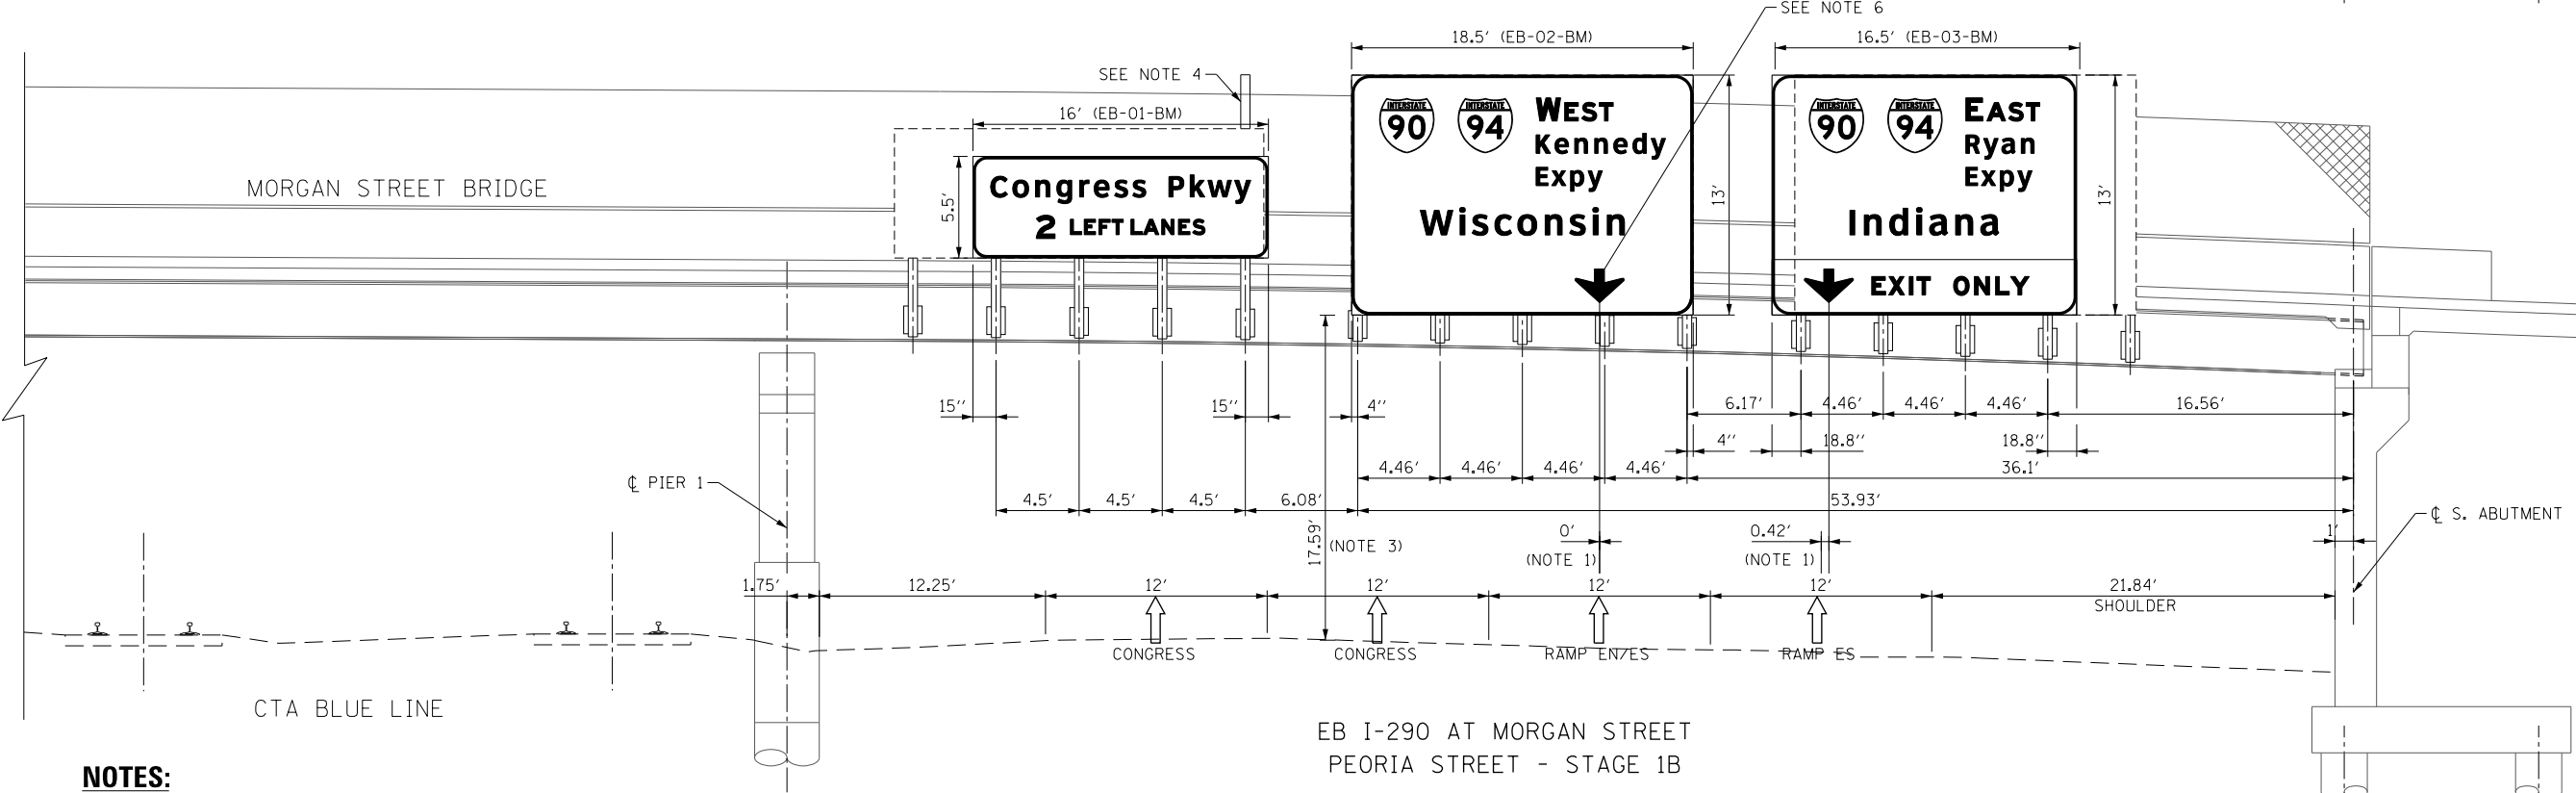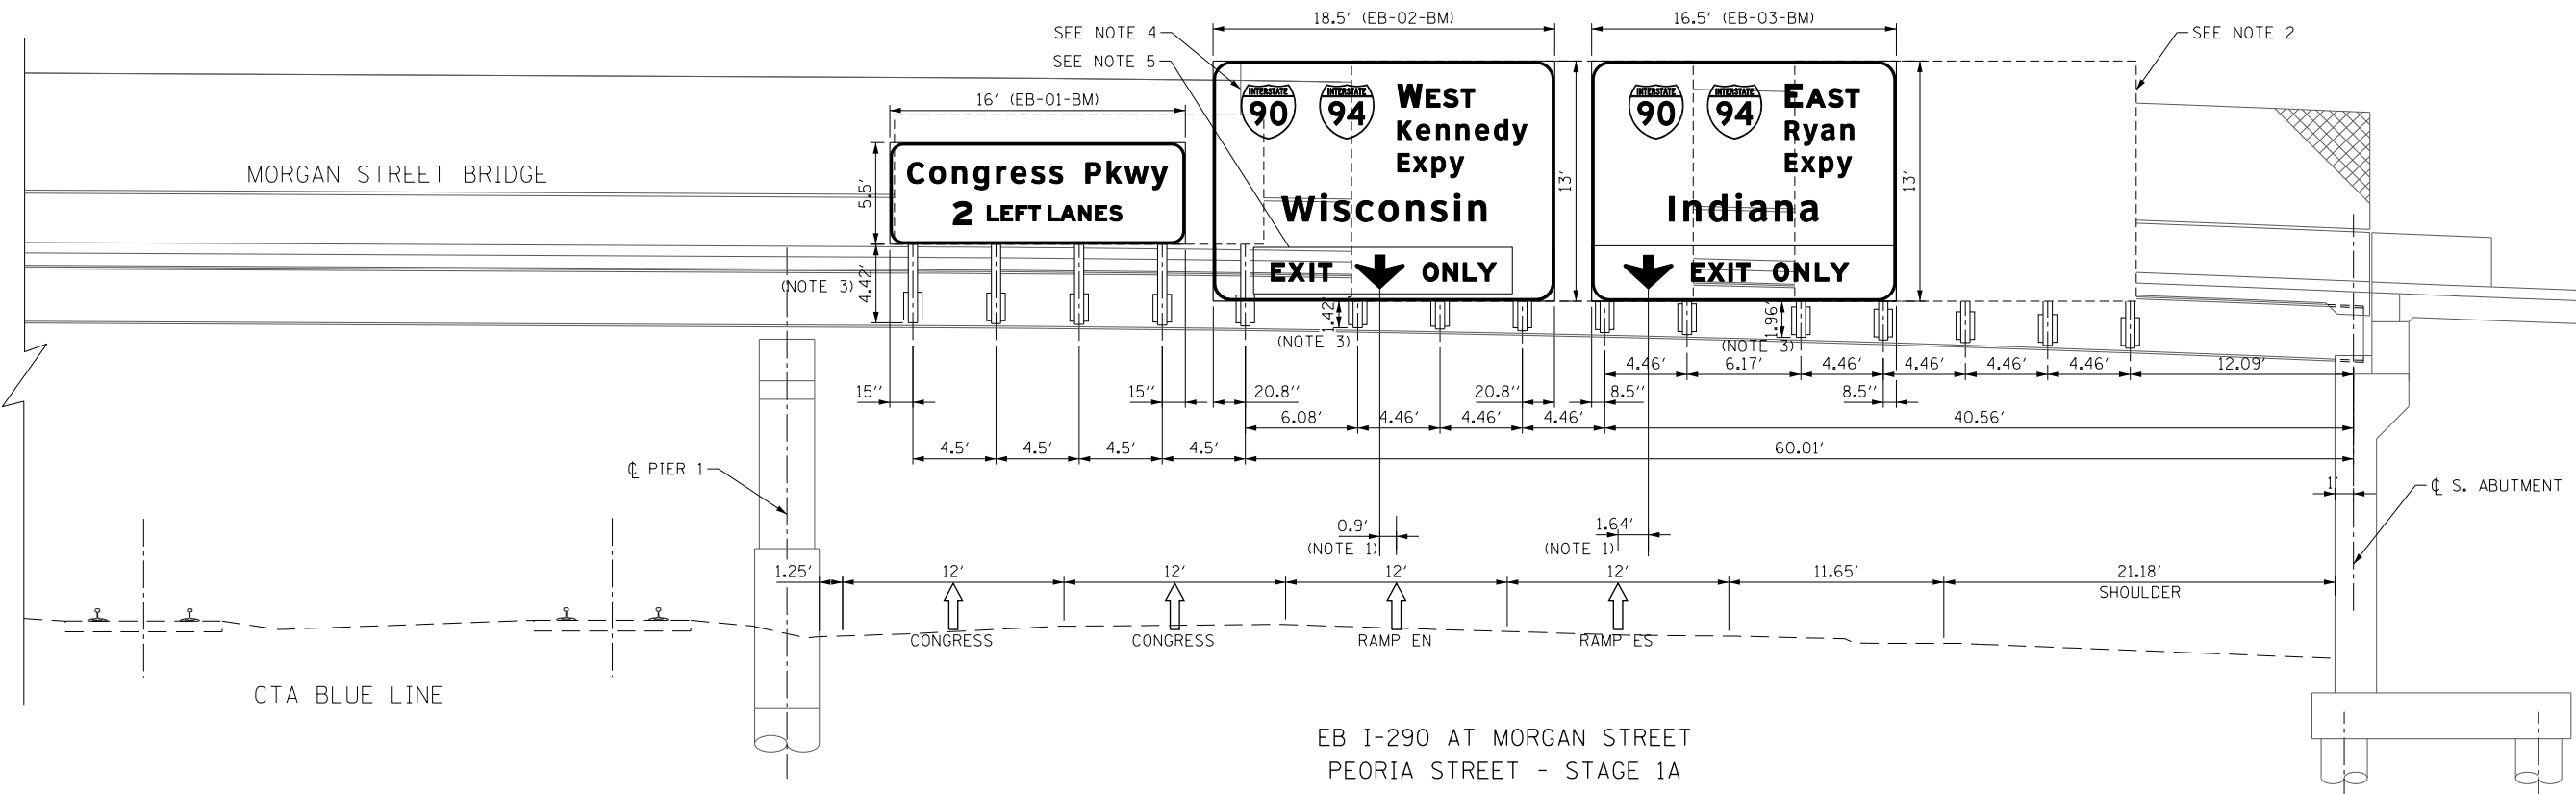

NOTES:

1. THE DIMENSIONS ARE SHOWN RELATIVE TO THE CENTER OF THE 12' LANE.
2. THE DASHED OUTLINE IN THE DETAIL SHOWS THE FUTURE PERMANENT SIGNS AFTER MAINLINE RECONSTRUCTION IS COMPLETE (TYPICAL). PEORIA STREET OVERHEAD SIGNS SHALL BE PLACED ON THE BRACKETS ERECTED IN CONTRACT 60W25.
3. THE BOTTOM OF SIGN PANEL DIMENSION SHOWN IN THE DETAILS SHALL BE MAINTAINED THROUGH STAGES 1A, 1B, AND POST-CONSTRUCTION. THE DIMENSIONS ARE BASED ON THE PROPOSED BRIDGE MOUNT DESIGN SHOWN IN CONTRACT 60W25.
4. THE RIGHT VERTICAL BRACKET SHALL BE INSTALLED IN CONTRACT 60W25 TO ACCOMMODATE SIGN EB-02-BM DURING STAGE 1A AND POST-CONSTRUCTION. ANY ADJUSTMENTS TO THE BRACKETS DURING THIS CONTRACT SHALL BE INCLUDED IN THE COST OF THE SIGN PANEL AND PAID FOR AS SIGN PANEL TYPE-3. NO ADDITIONAL COMPENSATION SHALL BE ALLOWED.
5. THE CONTRACTOR SHALL COVER THE EXISTING DOWN ARROW WITH A TEMPORARY INFORMATION SIGN AS SHOWN. TO BE PAID FOR AS TEMPORARY INFORMATION SIGNING.
6. THE CONTRACTOR SHALL UNCOVER THE EXISTING DOWN ARROW. SEE SHEET 107 FOR DETAILS.

FILE PATH = c:\pwworking\trnsystems\60204539\0160W29-sht-Sign-Det-05.dgn



D160W29-sht-Sign-Det-05.dgn
 USER NAME = mboldwin
 PLOT SCALE = 10.0000" / in.
 PLOT DATE = 1/21/2014

DESIGNED - JDT
 DRAWN - JTR
 CHECKED - JMG
 DATE - 10/30/2013

REVISED - 01/20/2014
 REVISED -
 REVISED -
 REVISED -


**STATE OF ILLINOIS
 DEPARTMENT OF TRANSPORTATION**

**OVERHEAD SIGN STRUCTURES
 SIGN LAYOUT**

SCALE: NONE SHEET 4 OF 5 SHEETS STA. TO STA.

F.A.I. RTE. 90/94/290	SECTION 2013-011R	COUNTY COOK	TOTAL SHEETS 356	SHEET NO. 106
CONTRACT NO. 60W29			ILLINOIS FED. AID PROJECT	



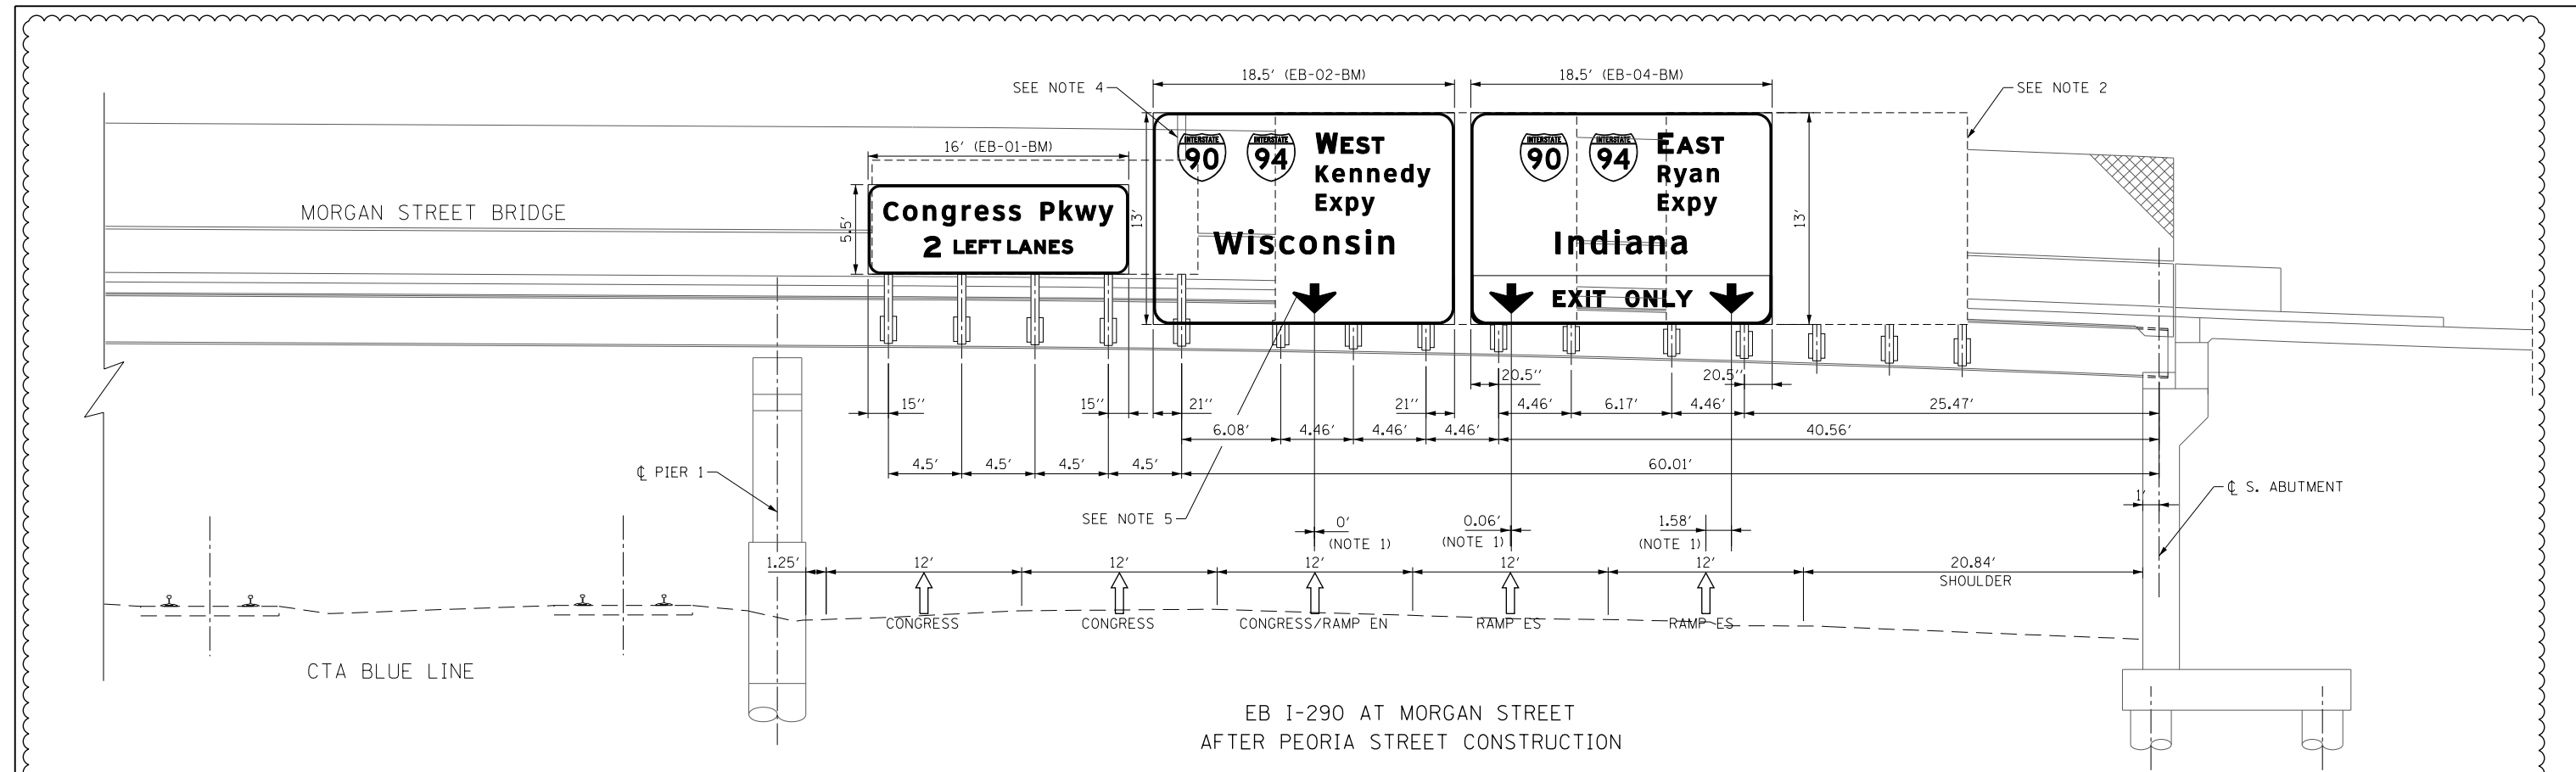

NOTES:

1. THE DIMENSIONS ARE SHOWN RELATIVE TO THE CENTER OF THE 12' LANE.
2. THE DASHED OUTLINE IN THE DETAIL SHOWS THE FUTURE PERMANENT SIGNS AFTER MAINLINE RECONSTRUCTION IS COMPLETE (TYPICAL). PEORIA STREET OVERHEAD SIGNS SHALL BE PLACED ON THE BRIDGE MOUNTS ERECTED IN CONTRACT 60W25.
3. THE BOTTOM OF SIGN PANEL ELEVATION SHOWN IN THE DETAILS SHALL BE MAINTAINED THROUGH STAGES 1A, 1B, AND POST-CONSTRUCTION.
4. THE RIGHT VERTICAL BRACKET SHALL BE INSTALLED IN CONTRACT 60W25 TO ACCOMMODATE SIGN EB-02-BM DURING STAGE 1A AND POST-CONSTRUCTION. ANY ADJUSTMENTS TO THE BRACKETS DURING THIS CONTRACT SHALL BE INCLUDED IN THE COST OF THE SIGN PANEL AND PAID FOR AS SIGN PANEL TYPE-3. NO ADDITIONAL COMPENSATION SHALL BE ALLOWED.
5. RELOCATE THE PROPOSED DEMOUNTABLE DOWN ARROW OVER THE CENTER OF THE LANE ONCE TRAFFIC IS IN THE FINAL CONFIGURATION. SEE SHEET 107 FOR DETAILS.

FILE PATH = c:\pwworking\jason\work\60W25\10160W25\10160W25-sht-Sign-Det-05.dgn



D:\60W25-sht-Sign-Det-05.dgn	DESIGNED - JDT	REVISED - 01/20/2014
USER NAME = mnboldwin	DRAWN - JTR	REVISED -
PLOT SCALE = 10.0000" / in.	CHECKED - JMG	REVISED -
PLOT DATE = 1/21/2014	DATE - 10/30/2013	REVISED -


**STATE OF ILLINOIS
DEPARTMENT OF TRANSPORTATION**

OVERHEAD SIGN STRUCTURES SIGN LAYOUT			
SCALE: NONE	SHEET 4A	OF 5 SHEETS	STA. TO STA.

F.A.I. RTE.	SECTION	COUNTY	TOTAL SHEETS	SHEET NO.
90/94/290	2013-011R	COOK	356	106A
CONTRACT NO. 60W29				
ILLINOIS FED. AID PROJECT				



SIGN DETAIL
1:100

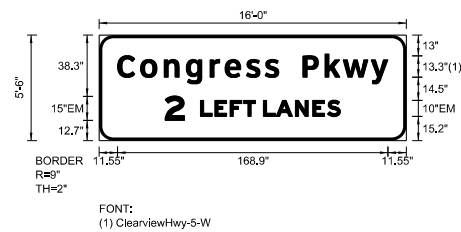

Panel Style: guide_fwy_supplemental.ssi
Dimensions are in inches.tenths
Letter locations are panel edge to lower left corner


SIGN NUMBER	EB-01-BM
WIDTH x HGHT.	16'-0" x 5'-6"
BORDER WIDTH	2"
CORNER RADIUS	9"
MOUNTING	Overhead
BACKGROUND	TYPE: Reflective - ZZ COLOR: Green - 3M 4097
LEGENDBORDER	TYPE: Reflective - ZZ COLOR: White - 3M 4090

SYMBOL	ROT	X	Y	WID	HT

LETTER POSITIONS (X) LENGTH SERIES/SIZE

Letter	Position (X)	Length	Series/Size
C	11.5	168.9	ClearviewHwy-5-W
o	25.9	168.9	ClearviewHwy-5-W
n	40.7	168.9	ClearviewHwy-5-W
g	54.5	168.9	ClearviewHwy-5-W
r	69.3	168.9	ClearviewHwy-5-W
e	78.7	168.9	ClearviewHwy-5-W
s	92	168.9	ClearviewHwy-5-W
s	103.8	168.9	ClearviewHwy-5-W
	112.3		
P	127.4		
k	141.2		
w	152.6		
y	170		
2	41.2	109.7	EM 2000
L	63.3	109.7	EM 2000
E	72.3	109.7	EM 2000
F	81.8	109.7	EM 2000
T	90.3	109.7	EM 2000
L	97.7	109.7	EM 2000
A	102.7	109.7	EM 2000
N	110.7	109.7	EM 2000
E	122.6	109.7	EM 2000
S	133.5	109.7	EM 2000
	142.7		

SIGN DETAIL
1:100

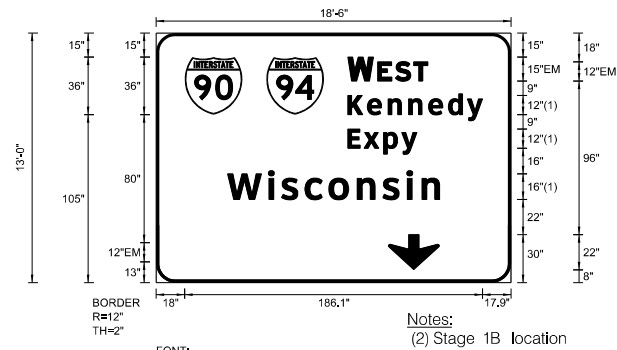

Panel Style: guide_fwy_overhead.ssi
Dimensions are in inches.tenths
Letter locations are panel edge to lower left corner

SIGN NUMBER	EB-02-BM
WIDTH x HGHT.	18'-6" x 13'-0"
BORDER WIDTH	2"
CORNER RADIUS	12"
MOUNTING	Overhead
BACKGROUND	TYPE: Reflective - ZZ COLOR: Green - 3M 4097
LEGENDBORDER	TYPE: Reflective - ZZ COLOR: White - 3M 4090

SYMBOL	ROT	X	Y	WID	HT
M1_1	0	18	105	36	36
M1_1	0	69	105	36	36
ARDOWN (2)	0	145	8	32	22
ARDOWN (3)	0	103	8	32	22

- Notes:
(2) Stage 1B location
(3) Final Stage location

(4) All arrows on overhead signs shall be demountable. Furnishing and relocating proposed demountable arrows will not be paid for separately and shall be included in the unit cost of SIGN PANEL - TYPE 3.

LETTER POSITIONS (X) LENGTH SERIES/SIZE

Letter	Position (X)	Length	Series/Size
W	120	50	EM 2000
E	138.6	50	EM 2000
S	149.6	50	EM 2000
T	161.1	50	EM 2000
K	120	84.1	ClearviewHwy-5-W
e	132.2	84.1	ClearviewHwy-5-W
n	145.1	84.1	ClearviewHwy-5-W
n	158	84.1	ClearviewHwy-5-W
e	170.4	84.1	ClearviewHwy-5-W
d	182.9	84.1	ClearviewHwy-5-W
y	194.7	84.1	ClearviewHwy-5-W
E	120	43.1	ClearviewHwy-5-W
x	130	43.1	ClearviewHwy-5-W
p	142.3	43.1	ClearviewHwy-5-W
y	153.7	43.1	ClearviewHwy-5-W
W	44.7	132.6	ClearviewHwy-5-W
i	70.3	132.6	ClearviewHwy-5-W
s	78.5	132.6	ClearviewHwy-5-W
c	93.2	132.6	ClearviewHwy-5-W
o	108	132.6	ClearviewHwy-5-W
n	125.8	132.6	ClearviewHwy-5-W
s	141.7	132.6	ClearviewHwy-5-W
i	156.8	132.6	ClearviewHwy-5-W
n	166.3	132.6	ClearviewHwy-5-W

FILE PATH = c:\pwworking\lascor00\pwworking\lascor00\02204531\0160W29-sht-Sign-Det-06.dgn



DI60W29-sht-Sign-Det-06.dgn	DESIGNED - JDT	REVISED - 01/20/2014
USER NAME = mnboldwin	DRAWN - JTR	REVISED -
PLOT SCALE = 200.0000' / in.	CHECKED - JMG	REVISED -
PLOT DATE = 1/21/2014	DATE - 10/30/2013	REVISED -

**STATE OF ILLINOIS
DEPARTMENT OF TRANSPORTATION**


**OVERHEAD SIGN STRUCTURES
SIGN PANEL DETAILS**

SCALE: NONE SHEET 5 OF 5 SHEETS STA. TO STA.

F.A.I. RTE. 90/94/290	SECTION 2013-011R	COUNTY COOK	TOTAL SHEETS 356	SHEET NO. 107
ILLINOIS FED. AID PROJECT			CONTRACT NO. 60W29	



SIGN DETAIL
1:100

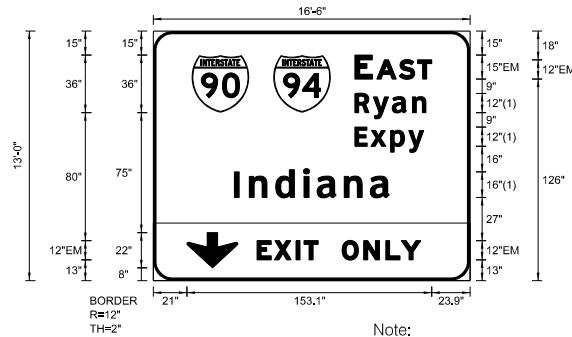

Panel Style: guide_fw_overhead.ssi
 Dimensions are in inches.tenths
 Letter locations are panel edge to lower left corner

Font: (1) ClearviewHwy-5-W
 Note: All arrows on overhead signs shall be demountable. Furnishing and relocating proposed demountable arrows will not be paid for separately and shall be included in the unit cost of SIGN PANEL - TYPE 3.


SIGN NUMBER	EB-03-BM
WIDTH x HGHT.	16'-6" x 13'-0"
BORDER WIDTH	2"
CORNER RADIUS	12"
MOUNTING	Overhead
BACKGROUND	TYPE: Reflective - ZZ COLOR: Green - 3M 4097
LEGEND/BORDER	TYPE: Reflective - ZZ COLOR: White - 3M 4090

SYMBOL	ROT	X	Y	WID	HT
M1_1	0	23.9	105	36	36
M1_1	0	74.9	105	36	36
ARDOWN	0	21	8	32	22

LETTER POSITIONS (X) LENGTH SERIES/SIZE

Letter	X	Length	Series/Size
E	125.9	48.1	EM 2000 15,12
A	139.7		
S	153.7		
T	165.2		
R	125.9	44.5	ClearviewHwy-5-W 129.8
y	137.6		
a	149.3		
n	162.1		
E	125.9	43.1	ClearviewHwy-5-W 129.8
x	136		
p	148.3		
y	159.6		
I	50.6	96.9	ClearviewHwy-5-W 1613
n	60		
d	76.5		
i	93.9		
a	102.4		
n	119.4		
a	135.6		
E	64.9	102.3	EM 2000 12
X	75.8		
I	89.2		
T	94.2		
O	118.1		
N	131.6		
L	145.3		
Y	155.1		

SIGN DETAIL
1:100

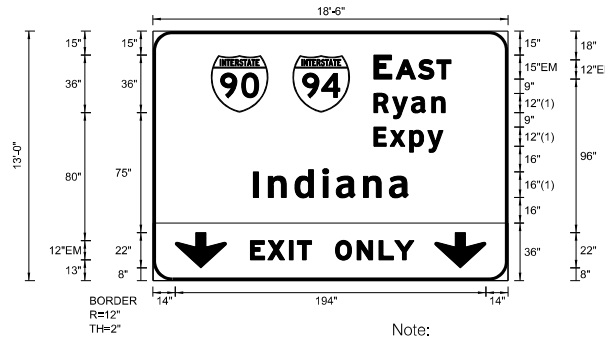

Panel Style: guide_fw_overhead.ssi
 Dimensions are in inches.tenths
 Letter locations are panel edge to lower left corner

Font: (1) ClearviewHwy-5-W
 Note: All arrows on overhead signs shall be demountable. Furnishing and relocating proposed demountable arrows will not be paid for separately and shall be included in the unit cost of SIGN PANEL - TYPE 3.

SIGN NUMBER	EB-04-BM
WIDTH x HGHT.	18'-6" x 13'-0"
BORDER WIDTH	2"
CORNER RADIUS	12"
MOUNTING	Overhead
BACKGROUND	TYPE: Reflective - ZZ COLOR: Green - 3M 4097
LEGEND/BORDER	TYPE: Reflective - ZZ COLOR: White - 3M 4090

SYMBOL	ROT	X	Y	WID	HT
M1_1	0	36.2	105	36	36
M1_1	0	87.2	105	36	36
ARDOWN	0	14	8	32	22
ARDOWN	0	176	8	32	22

LETTER POSITIONS (X) LENGTH SERIES/SIZE

Letter	X	Length	Series/Size
E	138.2	48.1	EM 2000 15,12
A	152		
S	165.9		
T	177.4		
R	138.2	44.5	ClearviewHwy-5-W 129.8
y	149.8		
a	161.6		
n	174.3		
E	138.2	43.1	ClearviewHwy-5-W 129.8
x	148.2		
p	160.5		
y	171.9		
I	62.8	96.9	ClearviewHwy-5-W 1613
n	72.2		
d	88.7		
i	106.1		
a	114.6		
n	131.6		
a	147.8		
E	60.9	102.3	EM 2000 12
X	71.8		
I	85.2		
T	90.2		
O	114.1		
N	127.6		
L	141.4		
Y	151.1		

FILE PATH = c:\pwworking\lsc\work\00\juoremma\020453\1\016\W29-sht-Sign-Det-06.dgn



DI60W29-sht-Sign-Det-06.dgn	DESIGNED - JDT	REVISED - 01/20/2014
USER NAME = mboldwin	DRAWN - JTR	REVISED -
PLOT SCALE = 200.0000' / in.	CHECKED - JMG	REVISED -
PLOT DATE = 1/21/2014	DATE - 10/30/2013	REVISED -


STATE OF ILLINOIS
DEPARTMENT OF TRANSPORTATION

OVERHEAD SIGN STRUCTURES SIGN PANEL DETAILS			
SCALE: NONE	SHEET 5A	OF 5 SHEETS	STA. TO STA.

F.A.I. RTE. 90/94/290	SECTION 2013-011R	COUNTY COOK	TOTAL SHEETS 356	SHEET NO. 107A
ILLINOIS FED. AID PROJECT				CONTRACT NO. 60W29



SIGN DETAIL
1:100

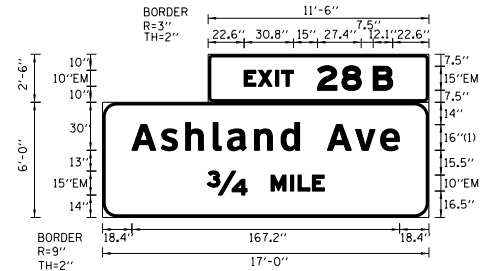

Panel Style: guide_exp_overhead.ssi
 Dimensions are in inches.tenths
 Letter locations are panel edge to lower left corner

FONT:
 (1) ClearviewHwy-5-W

M.U.T.C.D.: 2009 Edition


SIGN NUMBER	WB-02A-BM & WB-02B-BM
WIDTH x HGHT.	17'-0" x 6'-0"
BORDER WIDTH	2"
CORNER RADIUS	9" (Guide), 3" (Exit)
MOUNTING	Overhead
BACKGROUND	TYPE: Reflective - ZZ COLOR: Green - 3M 4097
LEGEND/BORDER	TYPE: Reflective - ZZ COLOR: White - 3M 4090

SYMBOL	ROT	X	Y	WID	HT

LETTER POSITIONS (X)

E	X	I	T	2	8	B							LENGTH	SERIES SIZE
22.6	31.4	42.2	46	68.4	83.7	103.3							92.9	EM 2000 10,15
A	s	h	I	a	n	d	A	v	e				167.2	ClearviewHwy-5-W 1613
18.4	36.6	52	69.2	78.1	95.1	111.6	123.2	140.5	158.1	173.8				
34	M	I	L	E									73.3	EM 2000 15,10
65.4	105.3	117.4	122.2	131.2										

SIGN DETAIL
1:100

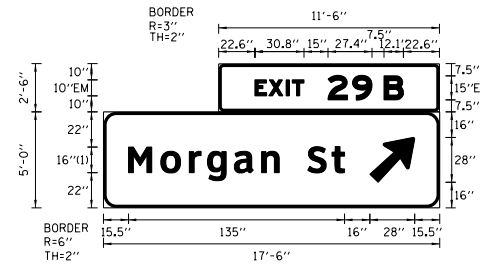

Panel Style: guide_exp_overhead.ssi
 Dimensions are in inches.tenths
 Letter locations are panel edge to lower left corner

FONT:
 (1) ClearviewHwy-5-W

M.U.T.C.D.: 2009 Edition

Note:
 All arrows on overhead signs shall be demountable. Furnishing and relocating proposed demountable arrows will not be paid for separately and shall be included in the unit cost of SIGN PANEL - TYPE 3.

SIGN NUMBER	WB-03A-BM & WB-03B-BM
WIDTH x HGHT.	17'-6" x 5'-0"
BORDER WIDTH	2"
CORNER RADIUS	6" (Guide), 3" (Exit)
MOUNTING	Overhead
BACKGROUND	TYPE: Reflective - ZZ COLOR: Green - 3M 4097
LEGEND/BORDER	TYPE: Reflective - ZZ COLOR: White - 3M 4090

SYMBOL	ROT	X	Y	WID	HT
AR_Type A	315	166.5	16	22.2	35.6

LETTER POSITIONS (X)

E	X	I	T	2	9	B							LENGTH	SERIES SIZE
22.6	31.4	42.2	46	68.4	83.7	103.3							92.9	EM 2000 10,15
M	o	r	g	a	n	S	t						135.1	ClearviewHwy-5-W 1613
15.5	35.8	53.6	65	81.8	98.8	109.9	127.6	142.7						

FILE PATH = c:\pwworking\lsc\com00\juoremaa\02204539\016\W29-sht-Sign-Det-06.dgn



D160W29-sht-Sign-Det-06.dgn
 USER NAME = mnboldwin
 PLOT SCALE = 200.0000' / in.
 PLOT DATE = 1/21/2014

DESIGNED - JDT
 DRAWN - JTR
 CHECKED - JMG
 DATE - 10/30/2013

REVISED - 01/20/2014
 REVISED -
 REVISED -
 REVISED -


STATE OF ILLINOIS
 DEPARTMENT OF TRANSPORTATION

OVERHEAD SIGN STRUCTURES
 SIGN PANEL DETAILS


SCALE: NONE SHEET 5B OF 5 SHEETS STA. TO STA.

F.A.I. RTE. 90/94/290	SECTION 2013-011R	COUNTY COOK	TOTAL SHEETS 356	SHEET NO. 107B
ILLINOIS FED. AID PROJECT			CONTRACT NO. 60W29	


A

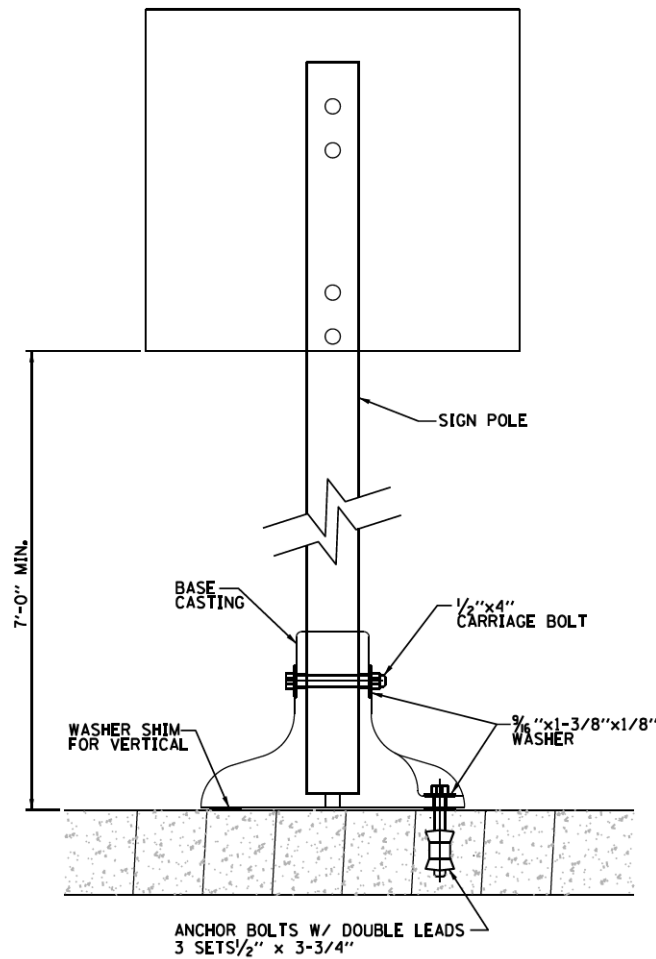


DRILL MOUNTED INSTALLATION DETAIL
NOT TO SCALE

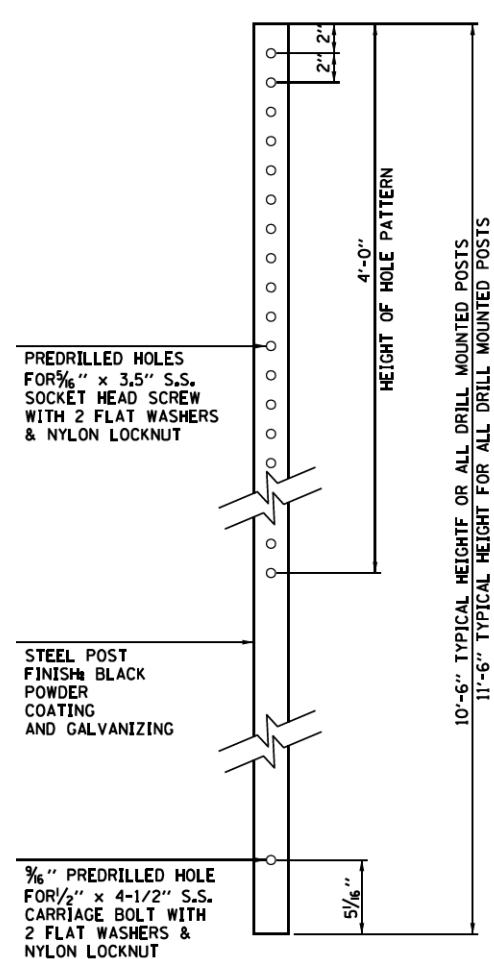


1 ELEVATION: DRILLED SIGN POST
NOT TO SCALE

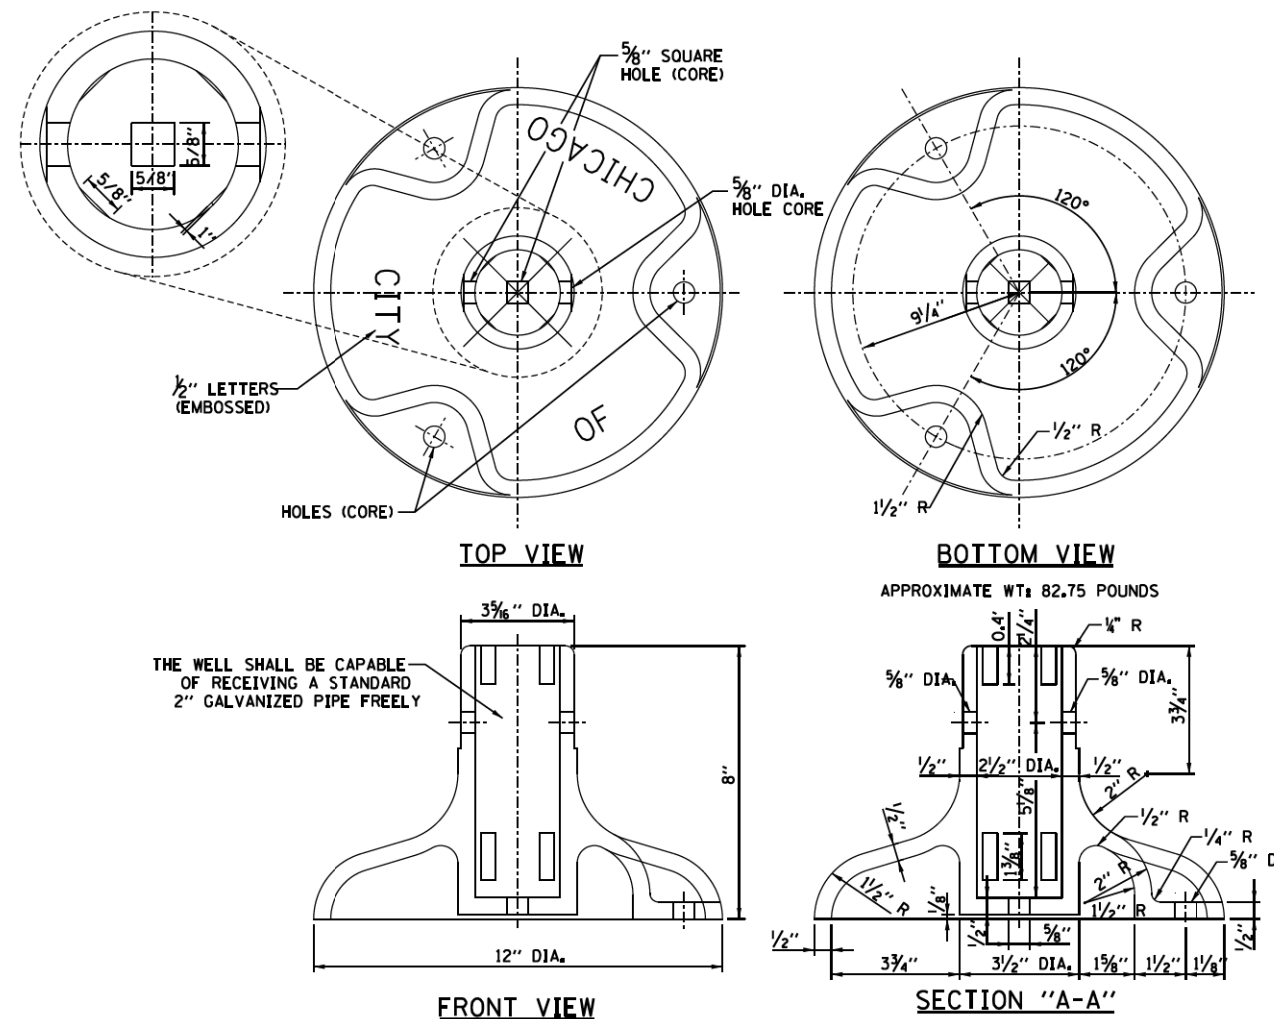


SIGN POLE BASE DETAIL
NOT TO SCALE

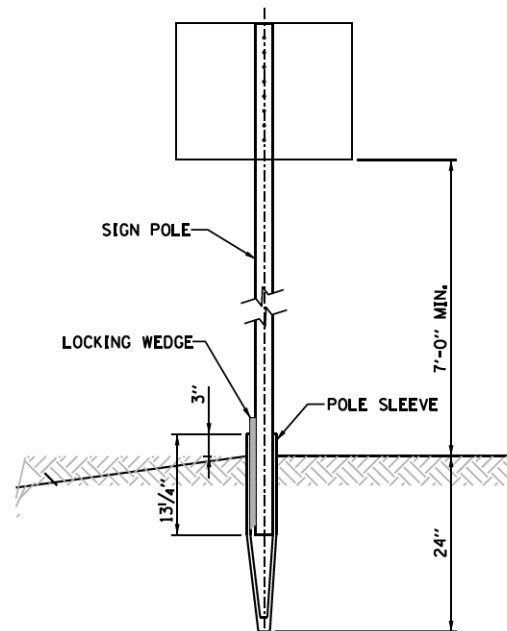


GROUND DIG INSTALLATION DETAIL
NOT TO SCALE

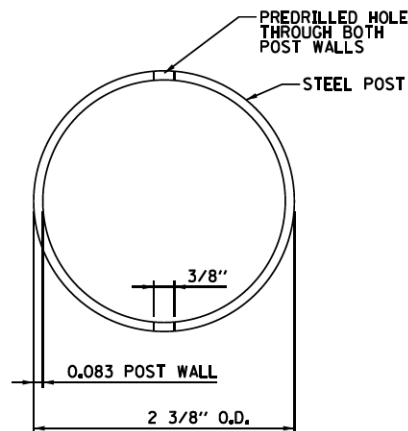

2 ELEVATION: DRILLED POST
NOT TO SCALE

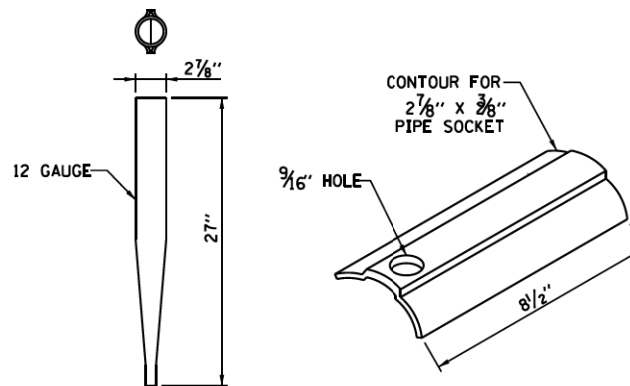

PIPE SOCKET AND WEDGE DETAIL
NOT TO SCALE

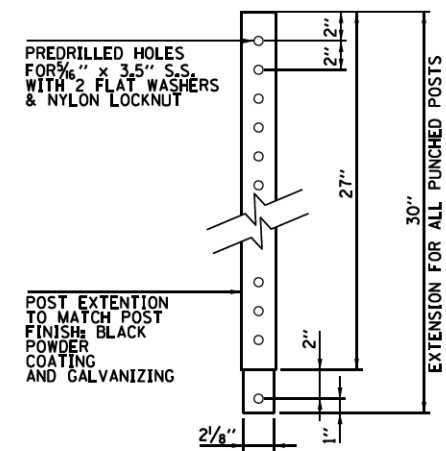

SECTION: DRILLED POST EXTENSION
NOT TO SCALE

NOTE:
PROVIDE ADDITIONAL TWO SETS OF PREDRILLED HOLES ON EXTENSION. HOLES SHALL BE LOCATED AT 30° ANGLE TO HOLES SHOWN IN SECTION 3. HOLES SHALL ACCOMMODATE 5/8\"/>

FILE PATH = p:\388035-p\m\l\escomon\me\local\p\ae\cd\00\Documents\01_Americas\Transportation\60269938_Circle\Phase_1\1\000_CAD\006_Roadway_Sheets\60W29_sht-Sign-Det-07.dgn

D:\60W29-sht-Sign-Det-07.dgn	DESIGNED - JDT	REVISED -
USER NAME = BAWtor1	DRAWN - BAW	REVISED -
PLOT SCALE = 20.0000' / in.	CHECKED - JMG	REVISED -
PLOT DATE = 10/28/2013	DATE - 10/30/2013	REVISED -


**STATE OF ILLINOIS
DEPARTMENT OF TRANSPORTATION**

SIGNING DETAILS

SCALE: NONE SHEET 1 OF 3 SHEETS STA. TO STA.

F.A.I. RE.	SECTION	COUNTY	TOTAL SHEETS	SHEET NO.
90/94/290	2013-011R	COOK	356	108
CONTRACT NO. 60W29			ILLINOIS FED. AID PROJECT	


FILE PATH = p:\388035\pmt\lsc\comon\me\local\p\wec\000\Documents\01_Americas\Transportation\66269938_Circle\Phase_1\000_CAD\006_Roadway\Sheets\60W29_Contract\0160W29-sht-Sign-Det-08.dgn

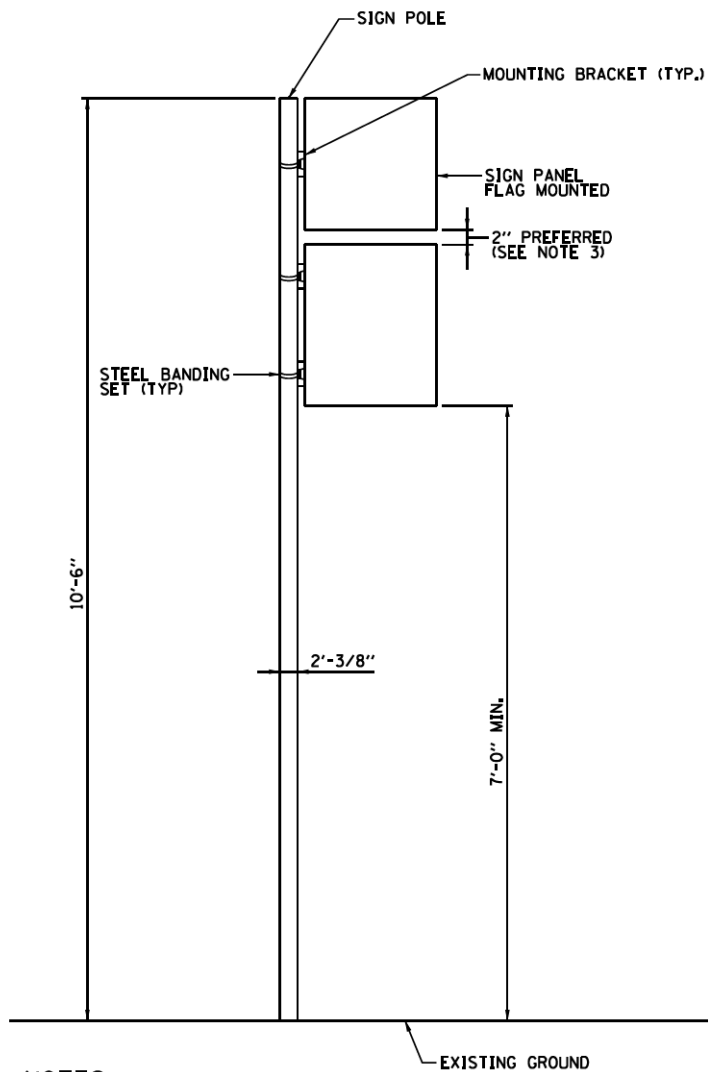

NOTES:

1. PROVIDE ONE MOUNTING BRACKET FOR SIGNS 18" AND UNDER.
2. PROVIDE TWO MOUNTING BRACKETS FOR SIGNS OVER 18".
3. REDUCE SPACING IF REQUIRED TO MAINTAIN MIN. 7'-0" CLEARANCE TO BOTTOM OF SIGN.
4. FLAG MOUNT SIGNS TOWARD SIDEWALK ALONG ARTERIAL STREETS.
5. FLAG MOUNT ALL PARKING REGULATIONS SIGNS.


FLAG MOUNTED SIGN INSTALLATION DETAIL
NOT TO SCALE

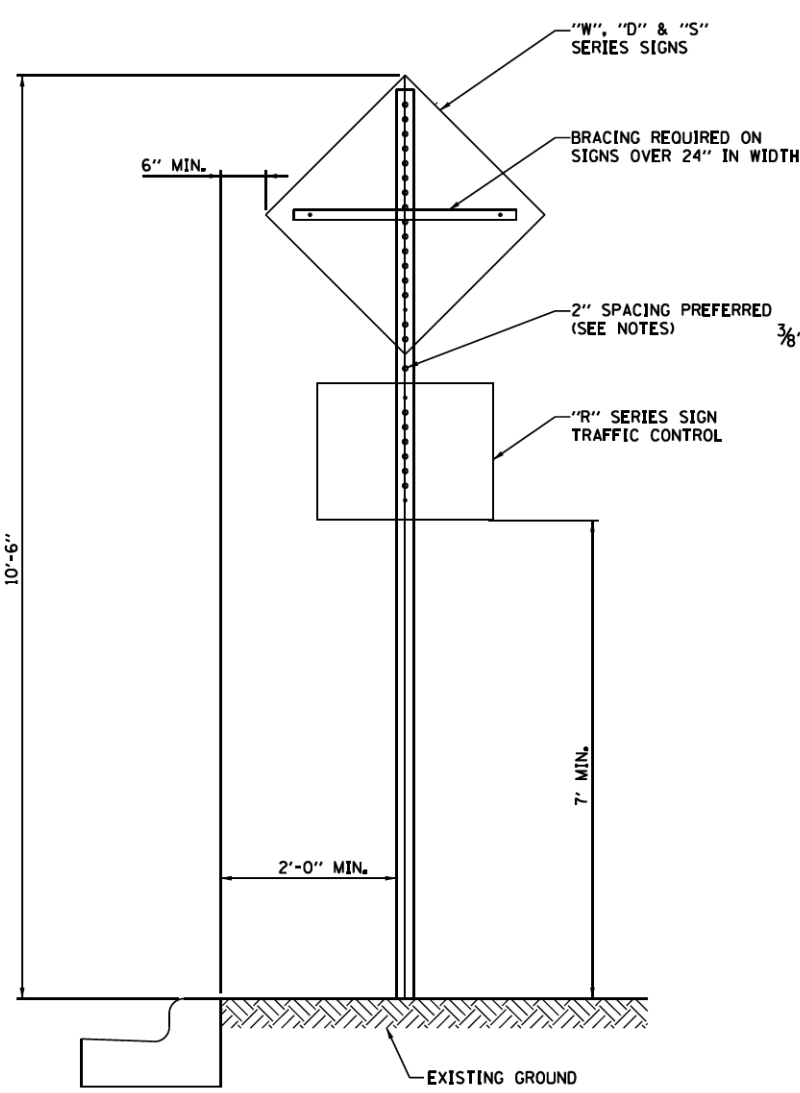

NOTE:

2" SPACING MAY BE REDUCED IF REQUIRED TO MAINTAIN MIN. 7'-0" CLEARANCE TO BASE OF SIGN.

CENTER MOUNTED SIGN INSTALLATION
NOT TO SCALE

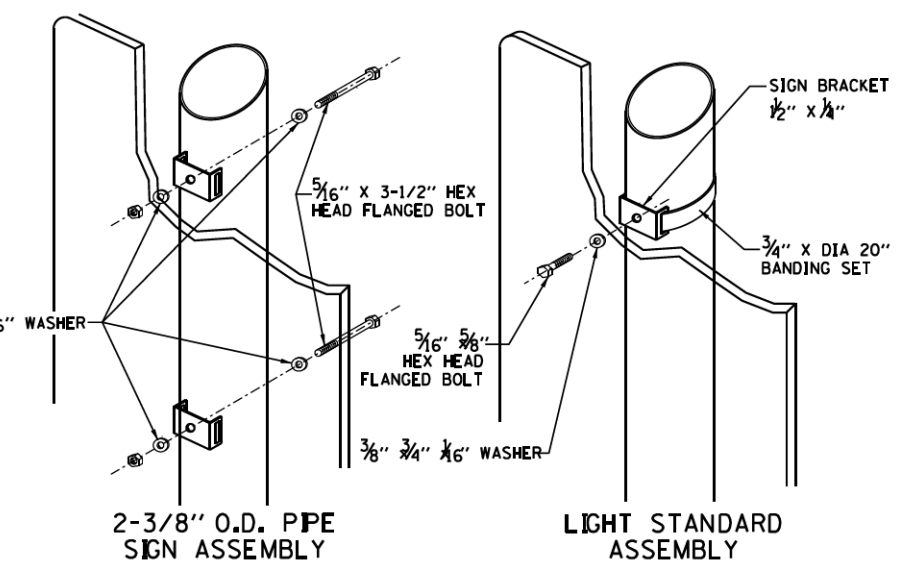


NOTE:

SIGN INSTALLATION STARTS AT 10'-6". PROVIDE MINIMUM 7'-0" CLEARANCE BETWEEN GROUND AND BOTTOM OF SIGN. RAISE INITIAL INSTALLATION HEIGHT IF REQ'D TO MAINTAIN 7' CLEAR.

REQUIREMENT


- 2 BANDS PER SIGN UNDER 6'
- 3 BANDS PER SIGN OVER 6'

CENTER MOUNTED SIGN ASSEMBLY
NOT TO SCALE

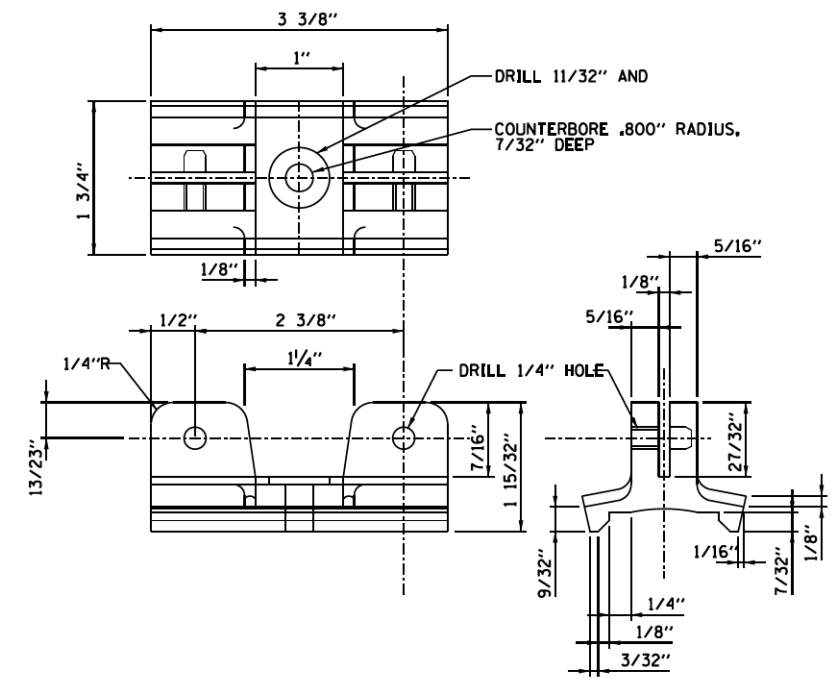

SIGN MOUNTING MATERIAL: ALUMINUM-ZINC ALLOY TENZALLOY

SIGN MOUNTING BRACKET DETAIL
NOT TO SCALE (VERSION 2A)

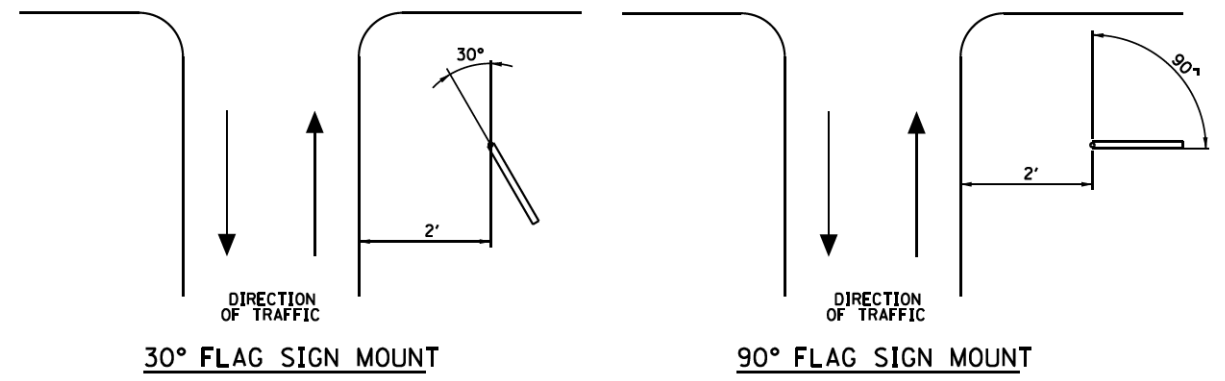

SIGN MOUNTING DETAILS
NOT TO SCALE


D160W29-sht-Sign-Det-08.dgn	DESIGNED - JDT	REVISED -
USER NAME = BAWtor1	DRAWN - BAW	REVISED -
PLOT SCALE = 20.0000' / in.	CHECKED - JMG	REVISED -
PLOT DATE = 10/28/2013	DATE - 10/30/2013	REVISED -

STATE OF ILLINOIS
DEPARTMENT OF TRANSPORTATION

SIGNING DETAILS	
SCALE: NONE	SHEET 2 OF 3 SHEETS STA. TO STA.


F.A.I. RTE.	SECTION	COUNTY	TOTAL SHEETS	SHEET NO.
90/94/290	2013-011R	COOK	356	109
CONTRACT NO. 60W29				
ILLINOIS FED. AID PROJECT				

REGULATORY TRAFFIC SIGNS
(CHICAGO STYLE)

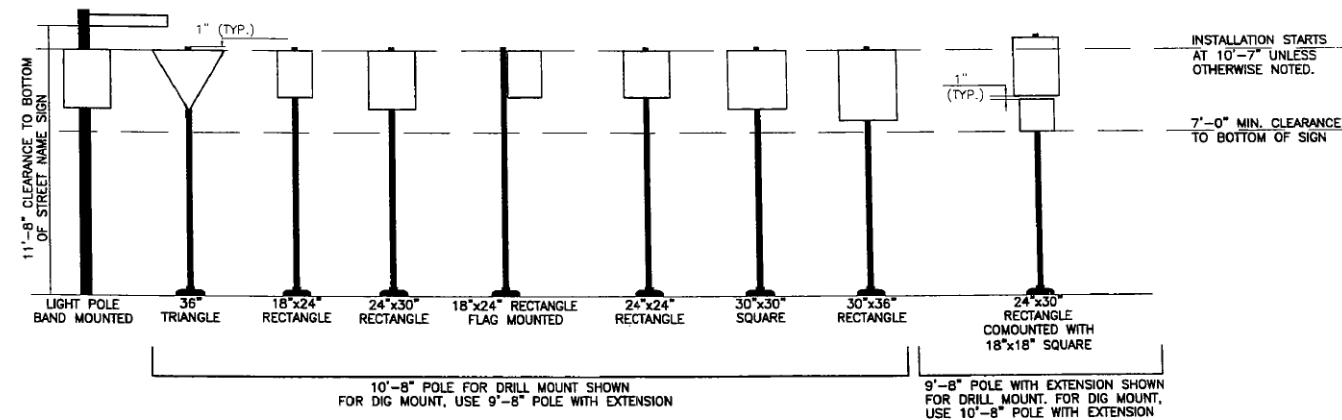

TYPICAL LAYOUT
NOT TO SCALE

REGULATORY PARKING SIGNS
(CHICAGO STYLE)

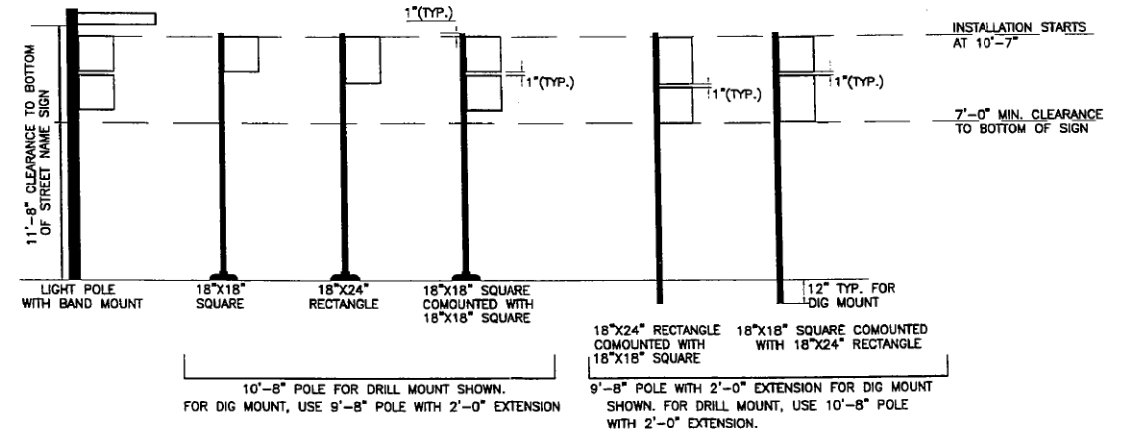

TYPICAL LAYOUT
NOT TO SCALE

FILE PATH = p:\388035\pmt\escomon\me\local\p\wec\00\Documents\01_Americas\Transportation\60269938_Circle\Phase_1\1000_CAD\005_Roadway_Sheets\60W29_sht_Sign-Det-09.dgn



DI60W29-Sign-Det-09.dgn	DESIGNED - JDT	REVISED -
USER NAME = BAW:tor t	DRAWN - BAW	REVISED -
PLOT SCALE = 20.0000' / in.	CHECKED - JMG	REVISED -
PLOT DATE = 10/28/2013	DATE - 10/30/2013	REVISED -


STATE OF ILLINOIS
DEPARTMENT OF TRANSPORTATION

SIGNING DETAILS

SCALE: NONE SHEET 3 OF 3 SHEETS STA. TO STA.



F.A.I. RTE.	SECTION	COUNTY	TOTAL SHEETS	SHEET NO.
90/94/290	2013-011R	COOK	356	110
CONTRACT NO. 60W29				
ILLINOIS FED. AID PROJECT				

ELECTRICAL SYMBOLS FOR PROPOSED WORK

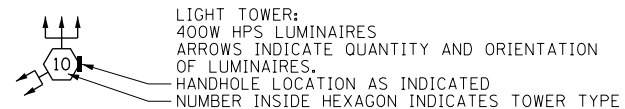


TYPE	TOWER HEIGHT
10	100 FEET
11	110 FEET
12	120 FEET

LIGHTING UNIT: TYPE AS INDICATED

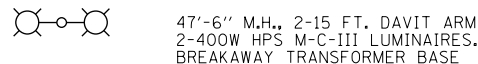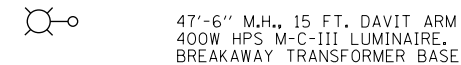

TEMPORARY LUMINAIRE AND POLE

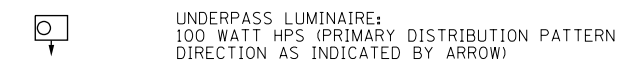

UNDERPASS LUMINAIRE: 100 WATT HPS (PRIMARY DISTRIBUTION PATTERN DIRECTION AS INDICATED BY ARROW)

ELECTRIC HANDHOLE: TYPE AS INDICATED

TYPE E1: PRECAST CONCRETE, 21.5"x21.5"x30", IDOT STANDARD 814001

TYPE E2: PRECAST CONCRETE-HEAVY DUTY, 22"x22"x30", IDOT STANDARD 814001

TYPE C1: COMMUNICATIONS VAULT, 49 5/8"x32 1/8"x57"

TYPE S1: PRECAST CONCRETE-HEAVY DUTY, 22"x22"x36"

TYPE S2: PRECAST CONCRETE-HEAVY DUTY SPECIAL, 30"x30"x36"

JUNCTION BOX: TYPE AND SIZE AS INDICATED ON PLANS

PULL BOX: TYPE AND SIZE AS INDICATED ON PLANS

TELEPHONE CONNECTION

FIBER OPTIC COMMUNICATIONS HUT

EXISTING LIGHTING UNIT, TWIN LUMINAIRE

EXISTING LIGHTING UNIT

EXISTING TEMPORARY LIGHTING UNIT

EXISTING CDOT LIGHTING UNIT

EXISTING UNDERPASS LUMINAIRE

EXISTING ELECTRIC HANDHOLE

EXISTING JUNCTION BOX

EXISTING PULL BOX

EXISTING TELEPHONE CONNECTION

EXISTING FIBER OPTIC COMMUNICATIONS HUT

EXISTING ELECTRIC HANDHOLE/MANHOLE

EXISTING CDOT SURVEILLANCE CABINET

LIGHTED SIGN STRUCTURE-CANTILEVER TYPE (NUMBER OF FLUORESCENT FIXTURES AS INDICATED - TYP.)

LIGHTED SIGN STRUCTURE-TRUSS TYPE

LIGHTED SIGN STRUCTURE-BRIDGE MOUNT TYPE

DYNAMIC MESSAGE SIGN

FLASHING BEACON SIGN

CLOSED CIRCUIT TELEVISION CAMERA

MICROWAVE DETECTOR

DETECTOR LOOP

CONTROLLER CABINET: LIGHTING, RADIO CONTROL DUPLEX TYPE WITH SCADA (DOOR SIDE AS INDICATED)

CONTROLLER CABINET: SURVEILLANCE

CONTROLLER CABINET: SURVEILLANCE, TYPE 334

RAMP METER SIGNAL POLE/HEAD

RAMP METER FLASHER POST

TEMPORARY WOOD POLE, 50 FOOT LENGTH (10 FOOT BURIED, 40 FOOT INSTALLED HEIGHT)

HIGHWAY ADVISORY RADIO ANTENNA

ELECTRIC UTILITY POLE

CCTV CAMERA POLE

POLE MOUNTED ELECTRIC UTILITY TRANSFORMER(S)

ELECTRICAL SYMBOLS FOR EXISTING CONDITIONS

EXISTING CDOT ELECTRIC HANDHOLE/MANHOLE

EXISTING LIGHTED SIGN STRUCTURE-CANTILEVER TYPE

EXISTING LIGHTED SIGN STRUCTURE-TRUSS TYPE

EXISTING LIGHTED SIGN STRUCTURE-BRIDGE MOUNT TYPE

EXISTING DYNAMIC MESSAGE SIGN

EXISTING FLASHING BEACON SIGN

EXISTING CLOSED CIRCUIT TELEVISION CAMERA

EXISTING MICROWAVE DETECTOR

EXISTING DETECTOR LOOP

EXISTING LIGHTING CONTROLLER, DUPLEX

EXISTING CONTROLLER CABINET

PAD MOUNTED ELECTRIC UTILITY TRANSFORMER

GROUND ROD

MAIN SERVICE FUSED DISCONNECT SWITCH (RATING AS INDICATED)

PHOTOCELL

AERIAL CABLE

FLEXIBLE CONDUIT

RACEWAY EMBEDDED IN STRUCTURE

EXPOSED CONDUIT

RACEWAY OR DIRECT BURIAL CABLE UNDERGROUND WITHOUT ENCASEMENT

RIGID GALVANIZED STEEL CONDUIT SLEEVE, TRENCHED OR PUSHED

UNDERGROUND REINFORCED CONCRETE ENCASED CONDUIT DUCTBANK, UNLESS NOTED OTHERWISE. (NUMBER, TYPE, AND SIZE OF DUCTS AS SHOWN)

CONDUIT TURNED DOWN

CONDUIT TURNED UP

EXISTING RAMP METER FLASHER

EXISTING HIGHWAY ADVISORY RADIO ANTENNA

EXISTING CCTV CAMERA POLE

EXISTING UTILITY SERVICE CONNECTION, POLE MOUNTED

EXISTING UTILITY SERVICE CONNECTION, PAD MOUNTED

EXISTING CONCEALED CONDUIT IN STRUCTURE

EXISTING EXPOSED CONDUIT











EXISTING RACEWAY OR DIRECT BURIED CABLE WITHOUT ENCASEMENT

EXISTING CONCEALED CONDUIT UNDERGROUND, TRENCHED OR PUSHED

EXISTING ELECTRIC CABLE IN CONDUIT SLEEVE

EXISTING AERIAL CABLE TO REMAIN

GENERAL ELECTRICAL CALLOUTS

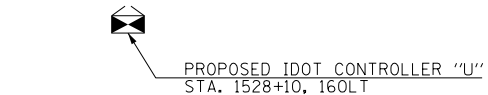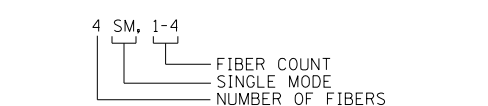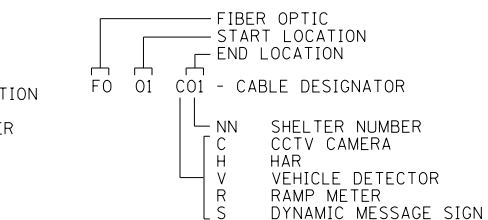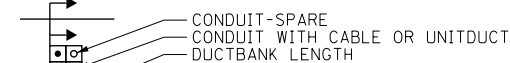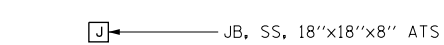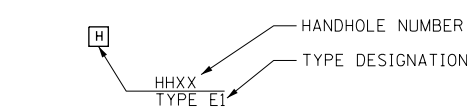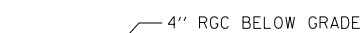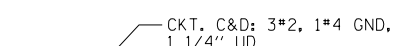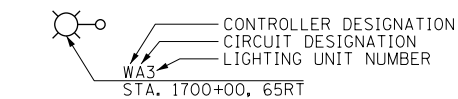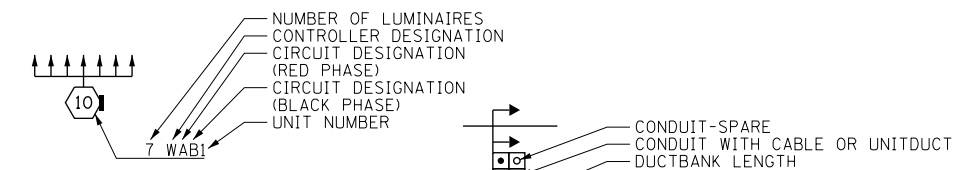

TYPICAL EXISTING TO BE REMOVED SYMBOLS

EXISTING LIGHTING UNIT TO BE REMOVED

EXISTING UNDERPASS LUMINAIRE TO BE REMOVED

EXISTING JUNCTION BOX TO BE REMOVED

EXISTING LIGHTED SIGN STRUCTURE-CANTILEVER TYPE TO BE REMOVED

DYNAMIC MESSAGE SIGN TO BE REMOVED

FLASHING BEACON SIGN TO BE REMOVED

EXISTING LIGHTING CONTROLLER, DUPLEX TO BE REMOVED

EXISTING CONTROLLER CABINET TO BE REMOVED

EXISTING DETECTOR LOOP TO BE REMOVED

EXISTING RAMP METER SIGNAL POLE/HEAD TO BE REMOVED

EXISTING RAMP METER FLASHER TO BE REMOVED

EXISTING POLE MOUNTED UTILITY SERVICE CONNECTION TO BE REMOVED

FILE PATH = p:\388035-p\mt\ecommon\me\local\p\AECOM\Documents\01_Americas\Transportation\60269938_Circle\Phase_1\000_CAD\016_Electrical\Sheets\60W29_Contract\0160W29-sht-Light-01



D160W29-sht-Light-01
 USER NAME = BAW:tor t
 PLOT SCALE = 2.0000' / in.
 PLOT DATE = 12/19/2013

DESIGNED - WDS
 DRAWN - CAM
 CHECKED - JPC
 DATE - 10/30/2013

REVISED - 12/18/2013
 REVISED -
 REVISED -
 REVISED -


STATE OF ILLINOIS
 DEPARTMENT OF TRANSPORTATION

IDOT ELECTRICAL SYMBOLS

SCALE: NONE SHEET 1 OF 19 SHEETS STA. TO STA.

F.A.I. RTE.	SECTION	COUNTY	TOTAL SHEETS	SHEET NO.
90/94/290	2013-011R	COOK	356	111
CONTRACT NO. 60W29				
ILLINOIS FED. AID PROJECT				

E-01

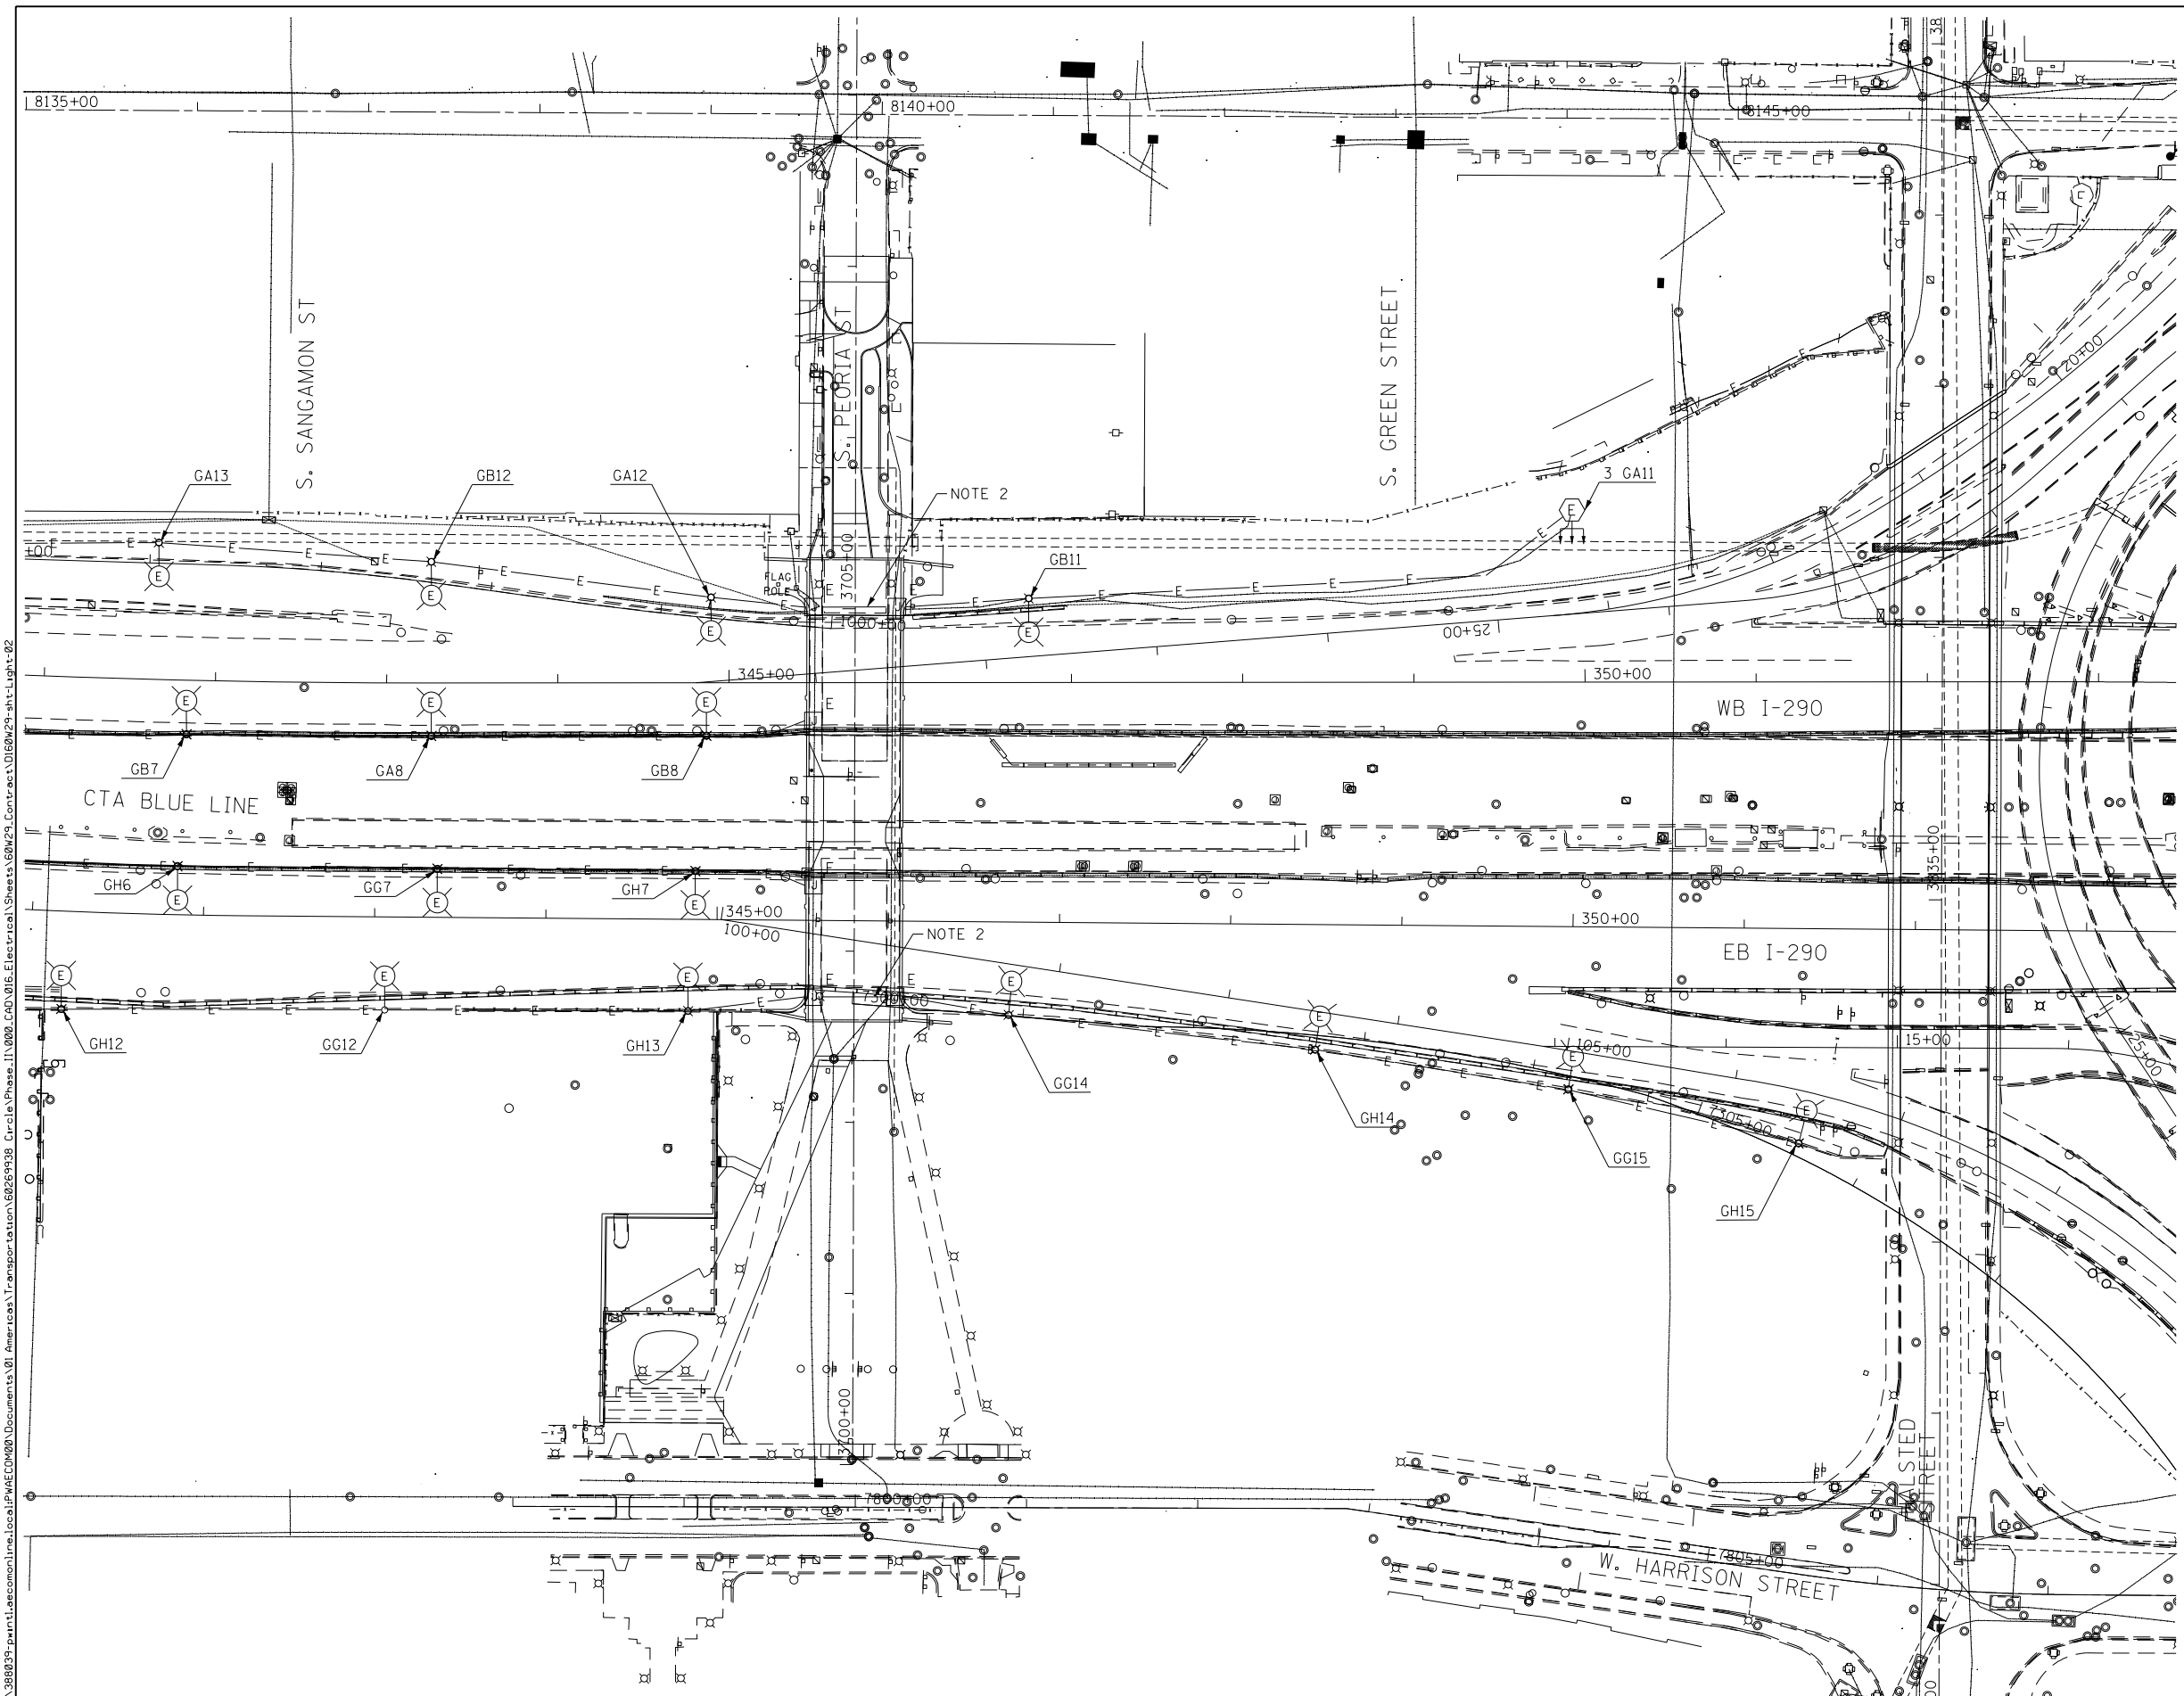

NOTES:

1. SEE DRAWING E-01 FOR IDOT ELECTRICAL SYMBOLS.
2. THE EXISTING CONDUIT ATTACHED TO STRUCTURE FOR THE ROADWAY LIGHTING CIRCUITS CANNOT BE DISCONNECTED AND REMOVED UNTIL THE TEMPORARY FEED HAS BEEN INSTALLED. SEE DRAWING E-03 FOR THE TEMPORARY POWER PLANS.

FILE PATH = p:\38803\pmt\lsc\monline\local\p\AEC\000\Documents\01_Americas\Transportation\60269938_Circle\Phase 1\1000_CAD\016_Electrical\Sheets\60W29_sht-Light-02



D160W29-sht-Light-02
 USER NAME = BAW:tor.t
 PLOT SCALE = 100.0000' / in.
 PLOT DATE = 10/28/2013


DESIGNED - WDS	REVISED -
DRAWN - CAM	REVISED -
CHECKED - JPC	REVISED -
DATE - 10/30/2013	REVISED -

**STATE OF ILLINOIS
 DEPARTMENT OF TRANSPORTATION**

**I-290 EXISTING/DEMOLITION
 LIGHTING PLAN**

SCALE: 1"=50' SHEET 2 OF 19 SHEETS STA. TO STA.

F.A.I. RTE. 90/94/290	SECTION 2013-011R	COUNTY COOK	TOTAL SHEETS 356	SHEET NO. 112
CONTRACT NO. 60W29			ILLINOIS FED. AID PROJECT	

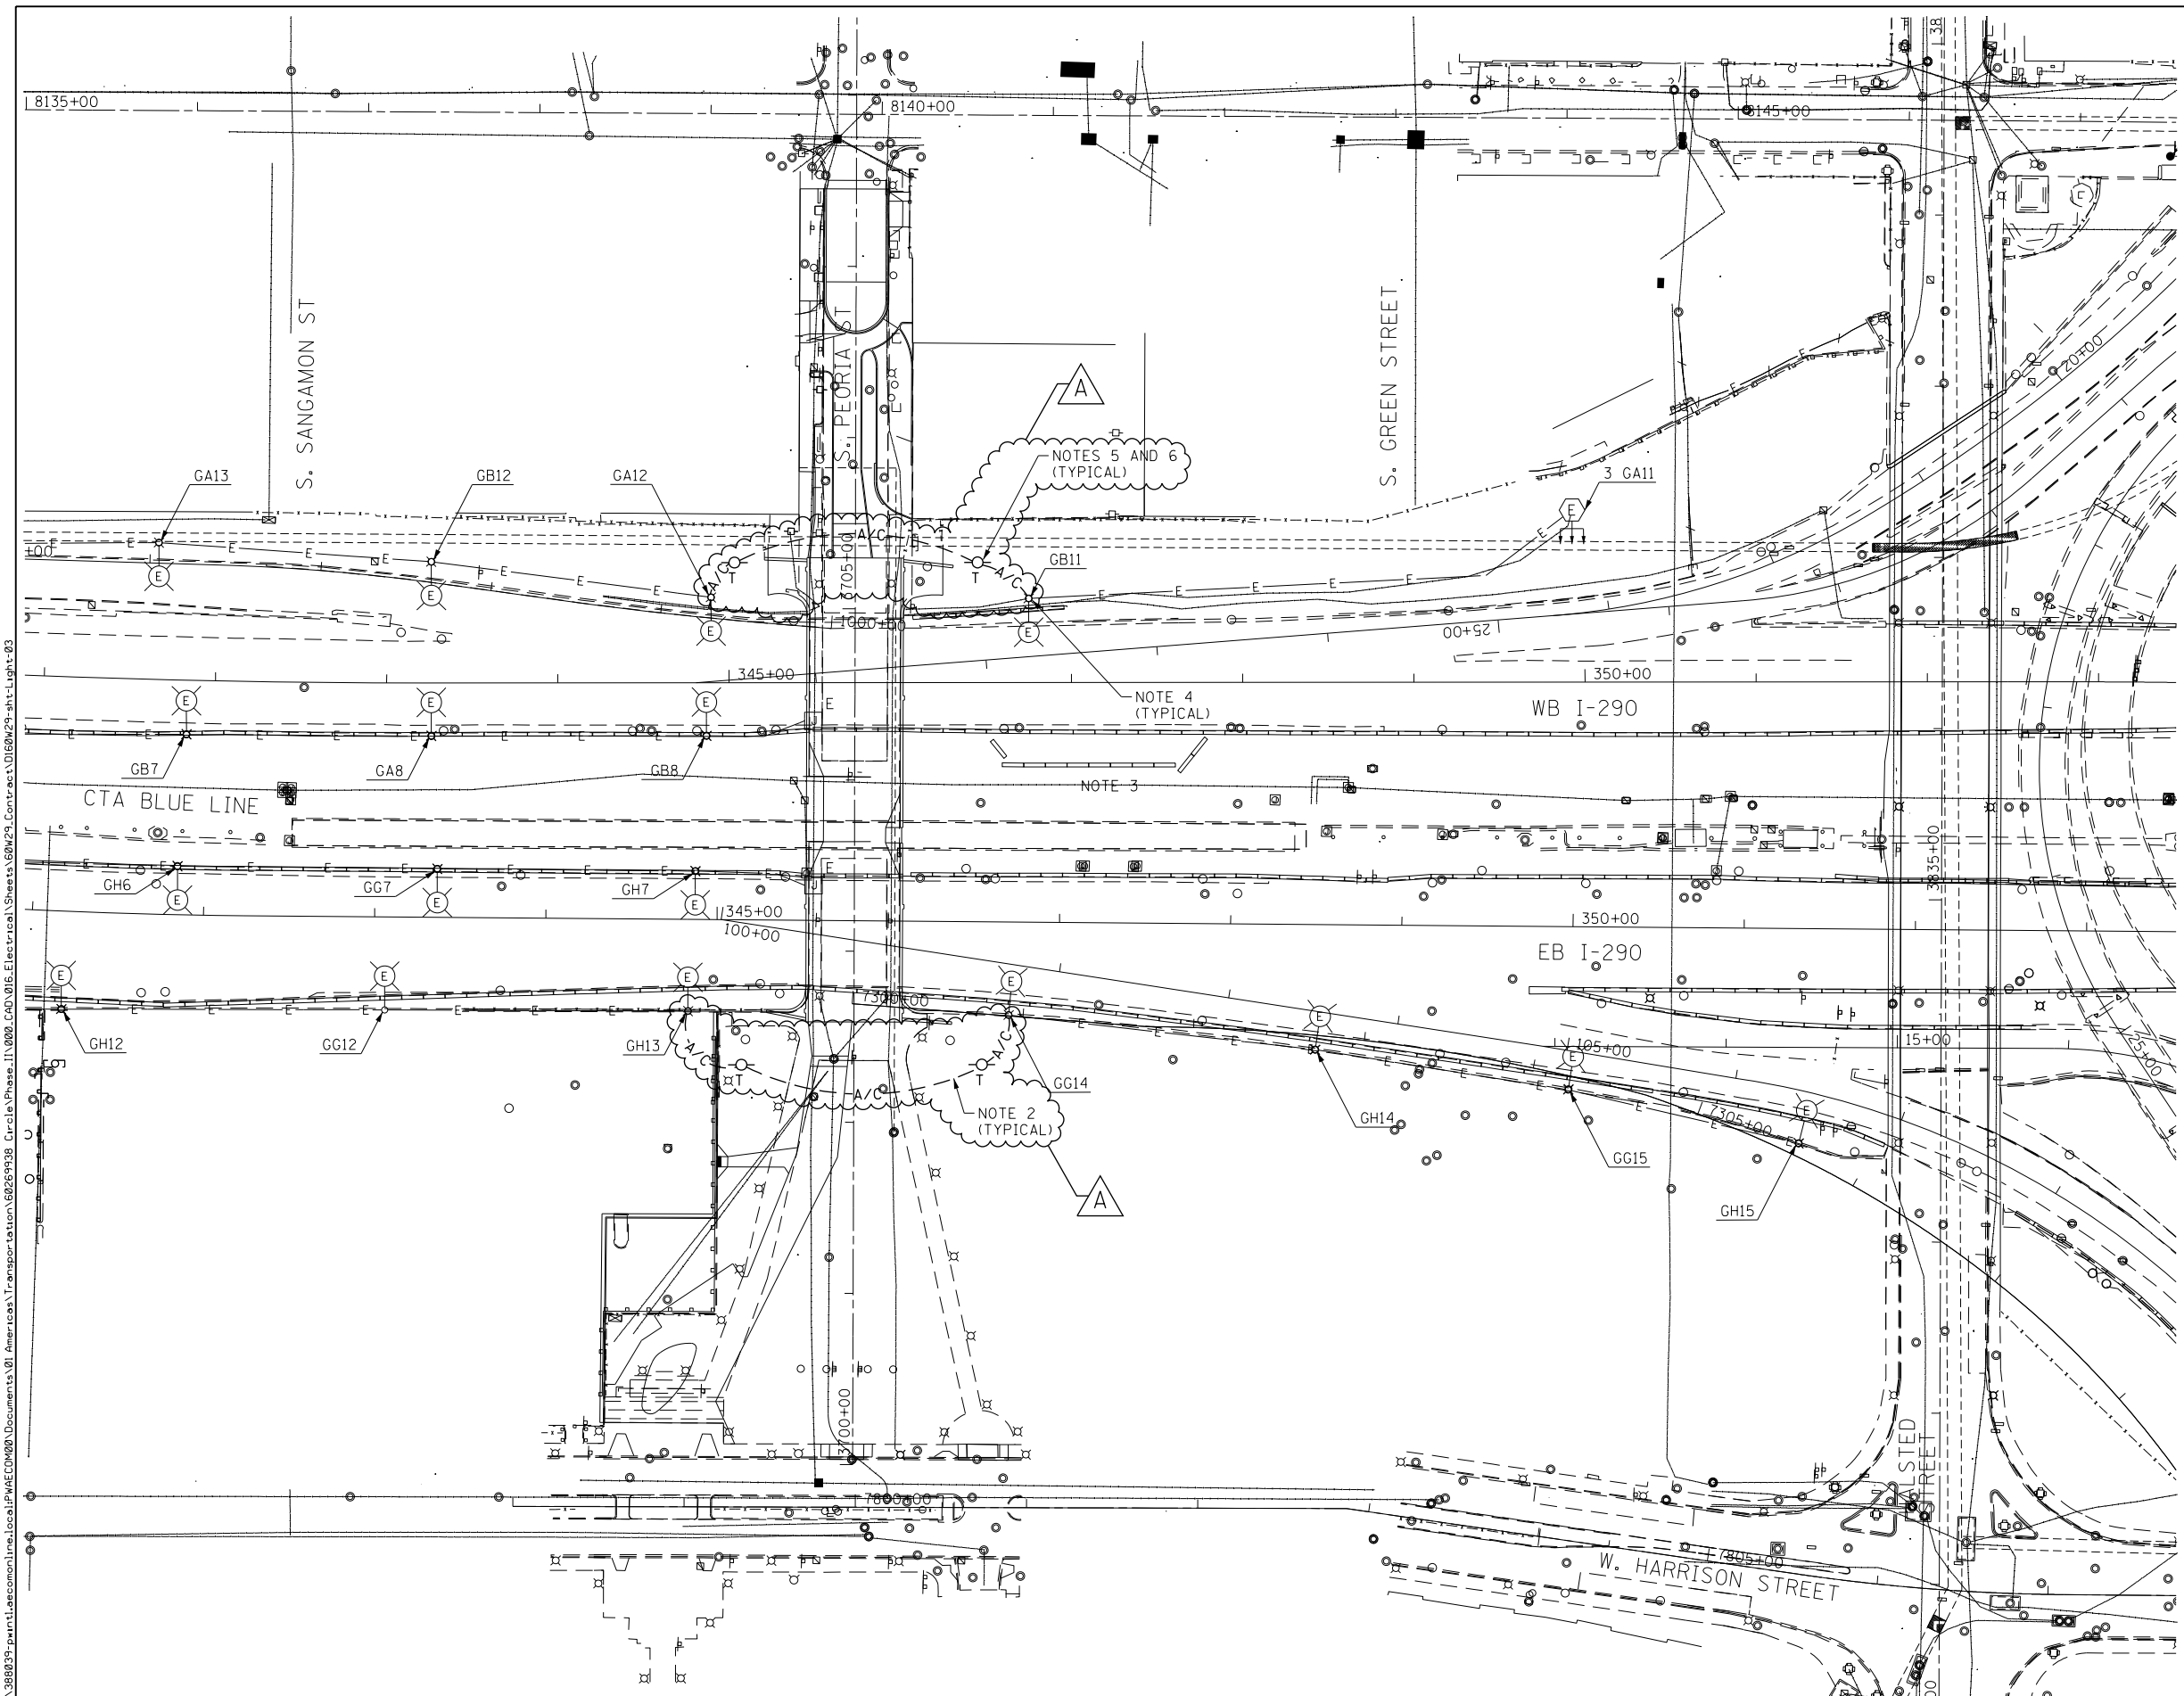

- NOTES:**
- SEE DRAWING E-01 FOR IDOT ELECTRICAL SYMBOLS.
 - PROVIDE A TEMPORARY AERIAL CABLE POWER FEED FOR THE ROADWAY LIGHTING CIRCUITS. THE FEED SHALL BE 3-1/2" NO. 2 WITH MESSENGER.
 - THIS DRAWING SHOWS THE INTERIM TEMPORARY POWER FEEDS REQUIRED TO BE INSTALLED PRIOR TO THE PEORIA STREET BRIDGE RECONSTRUCTION WORK. DRAWING NO. E-04 SHOWS THE FINAL CONDITIONS FOR THE TEMPORARY ROADWAY LIGHTING CONNECTIONS TO REMAIN AT THE CONCLUSION OF THIS CONTRACT.
 - ATTACH AERIAL CABLES TO EXISTING LIGHT POLES.
 - PROVIDE 25 FEET OF SLACK CABLE ON EACH TEMPORARY WOOD POLE TO ALLOW FOR RELOCATION OF WOOD POLES DURING CONSTRUCTION.
 - THE TEMPORARY WOOD POLES AND ASSOCIATED AERIAL CABLES SHALL BE REMOVED AND DISPOSED OF AT THE CONCLUSION OF THE CONTRACT.

FILE PATH = p:\388035\pmt\aescom\line\local\p\AECD\00\Documents\01_Americas\Transportation\60269938_Circle\Phase\1\000_CAD\015_Electrical\Sheets\60W29_sht-Light-03




D160W29-sht-Light-03
 USER NAME = BAW:tor:t
 PLOT SCALE = 100.0000' / in.
 PLOT DATE = 12/19/2013

DESIGNED - WDS	REVISED - 12/18/2013
DRAWN - CAM	REVISED -
CHECKED - JPC	REVISED -
DATE - 10/30/2013	REVISED -

STATE OF ILLINOIS
DEPARTMENT OF TRANSPORTATION


I-290 TEMPORARY POWER PLAN
 SCALE: 1"=50' SHEET 3 OF 19 SHEETS STA. TO STA.

F.A.I. RTE. 90/94/290	SECTION 2013-01R	COUNTY COOK	TOTAL SHEETS 356	SHEET NO. 113
CONTRACT NO. 60W29			ILLINOIS FED. AID PROJECT	

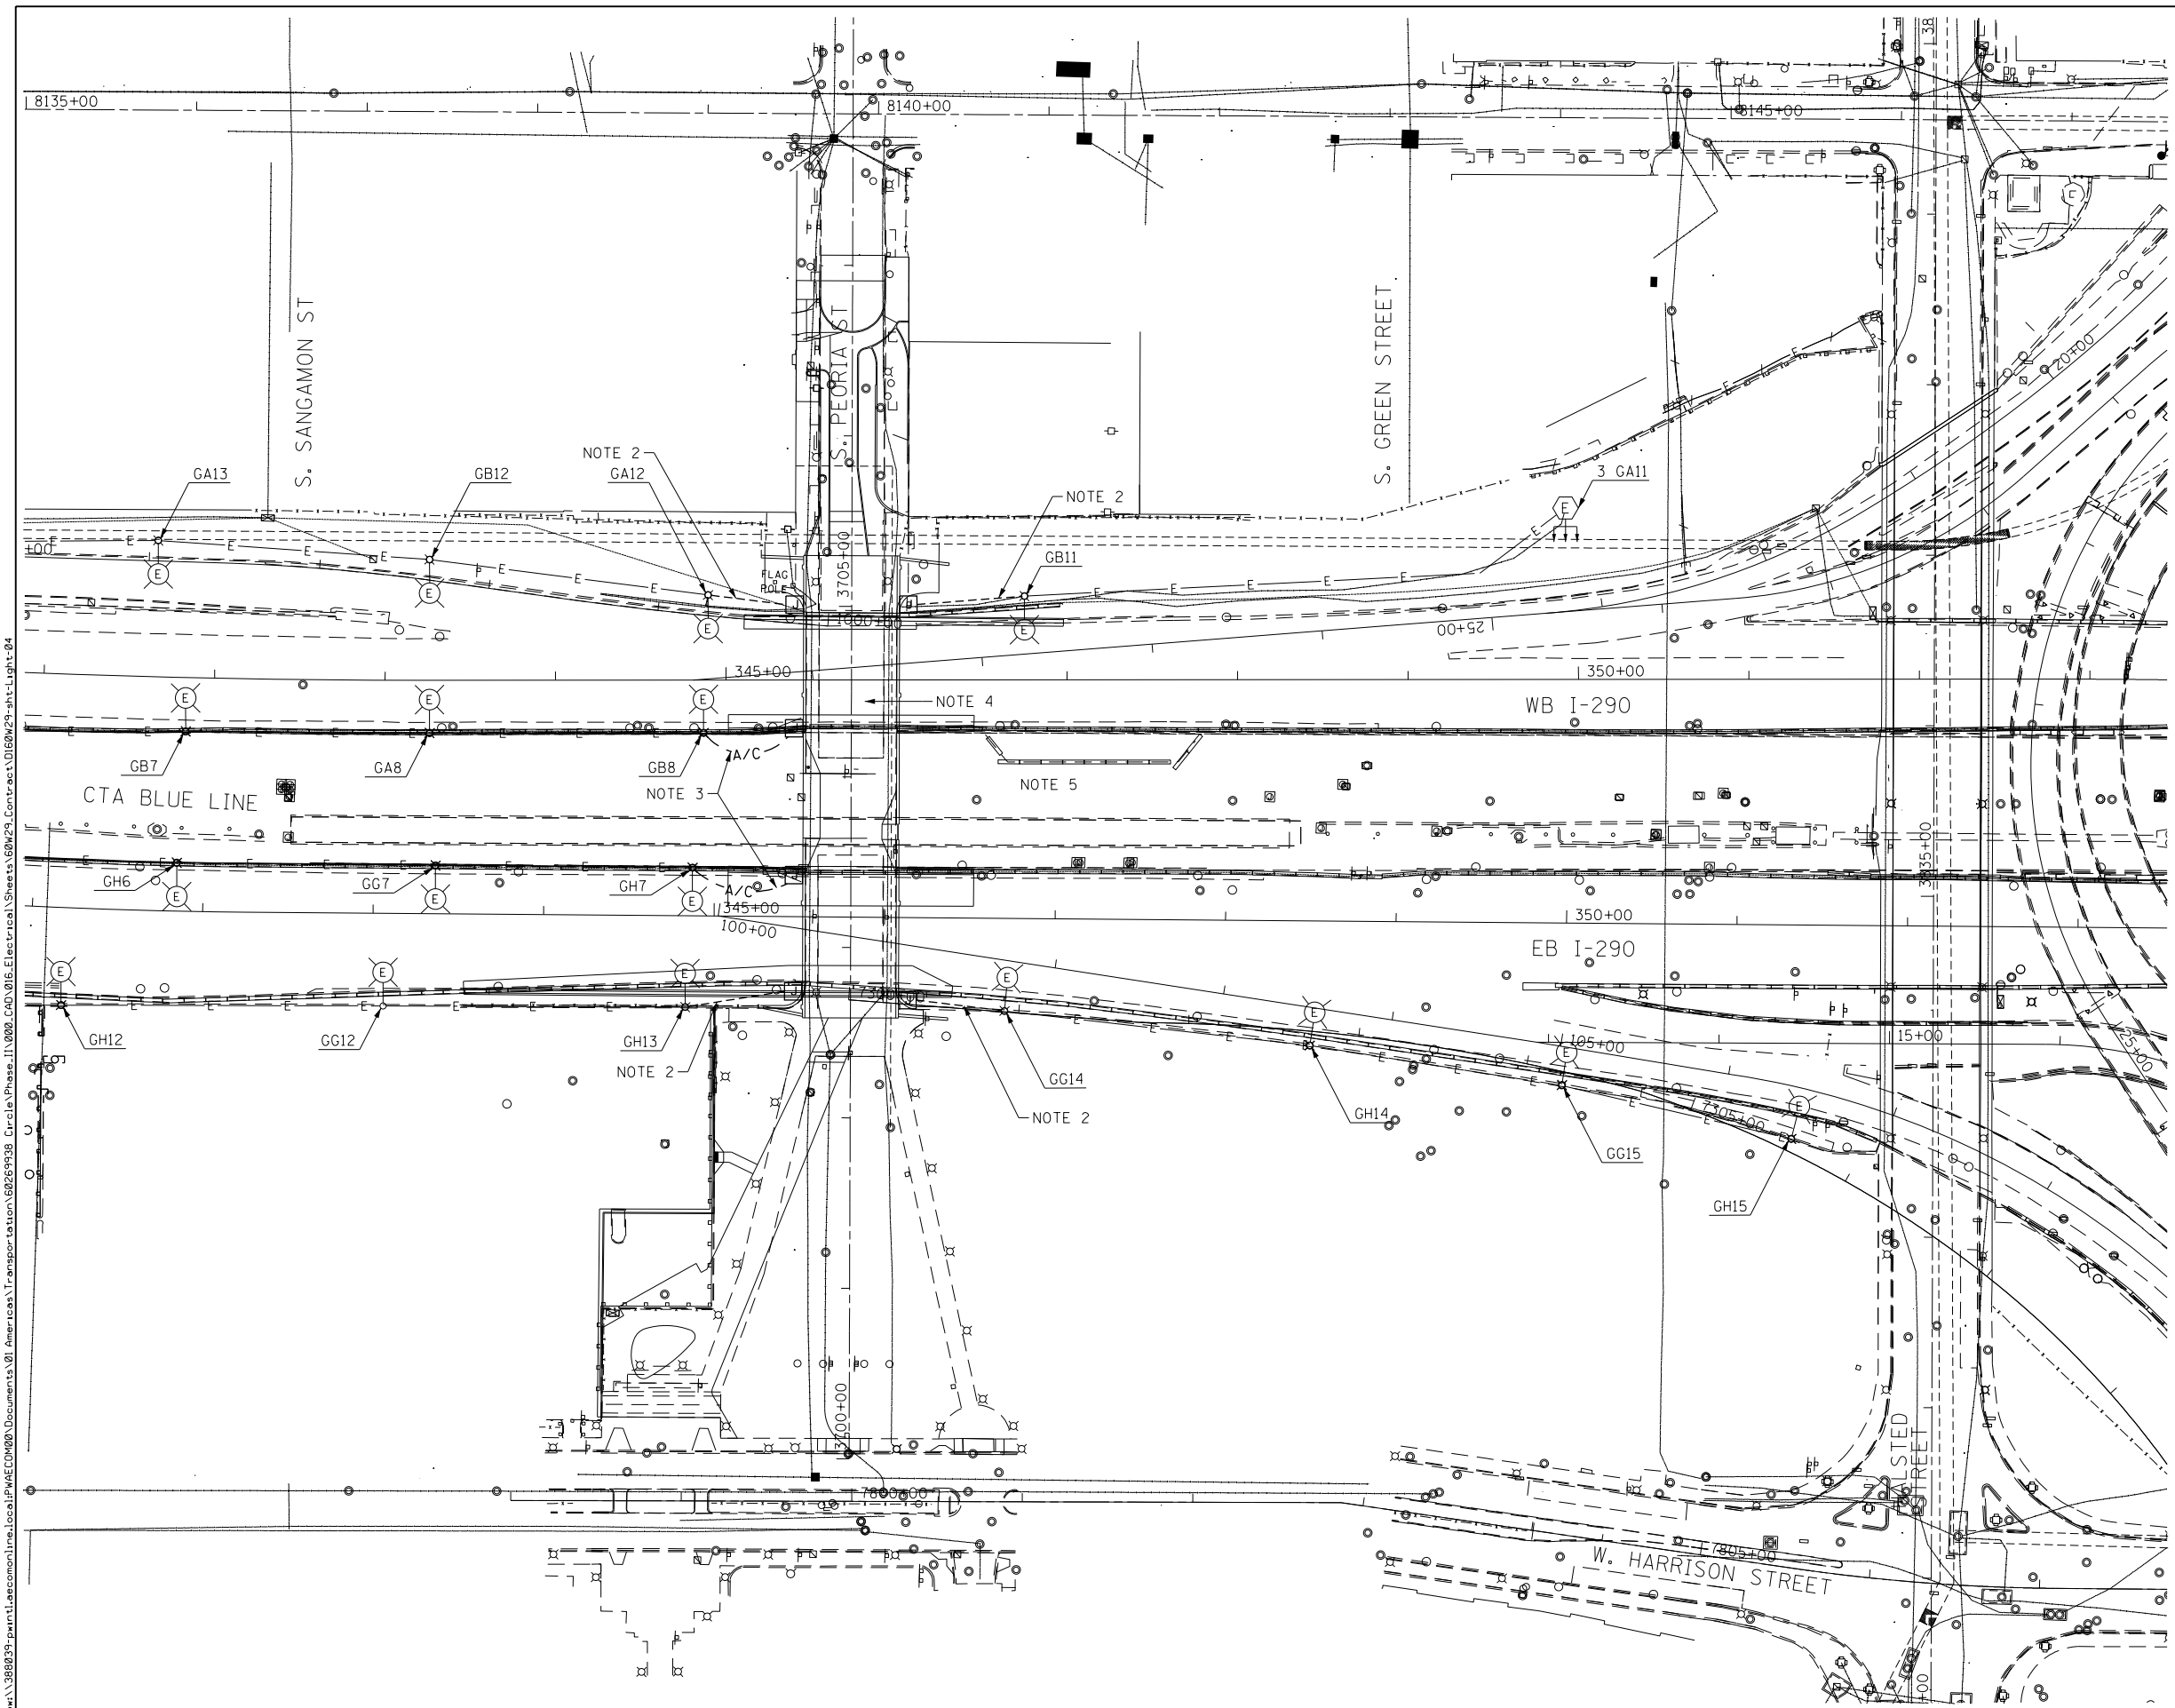

NOTES:

1. SEE DRAWING E-01 FOR IDOT ELECTRICAL SYMBOLS.
2. PROVIDE 3-1/2 NO. 2 WITH 1/2 NO. 4 GROUND XLP TYPE USE CABLES IN 1 1/2" UNIT DUCT.
3. PROVIDE A TEMPORARY AERIAL CABLE FEED, 3-1/2 NO. 2 WITH MESSENGER FROM JUNCTION BOX MOUNTED ON THE BRIDGE TO THE EXISTING MEDIAN WALL MOUNTED LIGHTING UNIT AS SHOWN. CONNECT THE ROADWAY LIGHTING UNITS TO THE UNDERPASS LIGHTING SYSTEM.
4. SEE DRAWING NO. E-05 FOR THE PEORIA STREET UNDERPASS LIGHTING PLAN.
5. THIS DRAWING SHOWS THE FINAL CONDITIONS FOR THE TEMPORARY ROADWAY LIGHTING CONNECTIONS.

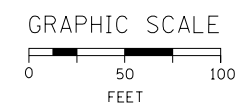

E-04

FILE PATH = p:\388035\pmt\aescom\line\local\p\AECD\00\Documents\01_Americas\Transportation\60269938_Circle\Phase\1\000_CAD\016_Electrical\Sheets\60W29_sht-Light-04



DI60W29-sht-Light-04
 USER NAME = BAW:tor.t
 PLOT SCALE = 100.0000' / in.
 PLOT DATE = 10/28/2013

DESIGNED - WDS	REVISED -
DRAWN - CAM	REVISED -
CHECKED - JPC	REVISED -
DATE - 10/30/2013	REVISED -


**STATE OF ILLINOIS
 DEPARTMENT OF TRANSPORTATION**

I-290 PROPOSED LIGHTING PLAN

SCALE: 1"=50' SHEET 4 OF 19 SHEETS STA. TO STA.



F.A.I. RTE.	SECTION	COUNTY	TOTAL SHEETS	SHEET NO.
90/94/290	2013-011R	COOK	356	114
CONTRACT NO. 60W29			ILLINOIS FED. AID PROJECT	

FILE PATH = p:\388035\part1\escom\line\local\p\AEC\000\Documents\01_Americas\Transportation\62629938_Circle\Phase 1\000_CAD\016_Electrical\Sheets\60W29_Contract\0160W29-sht-Light-05

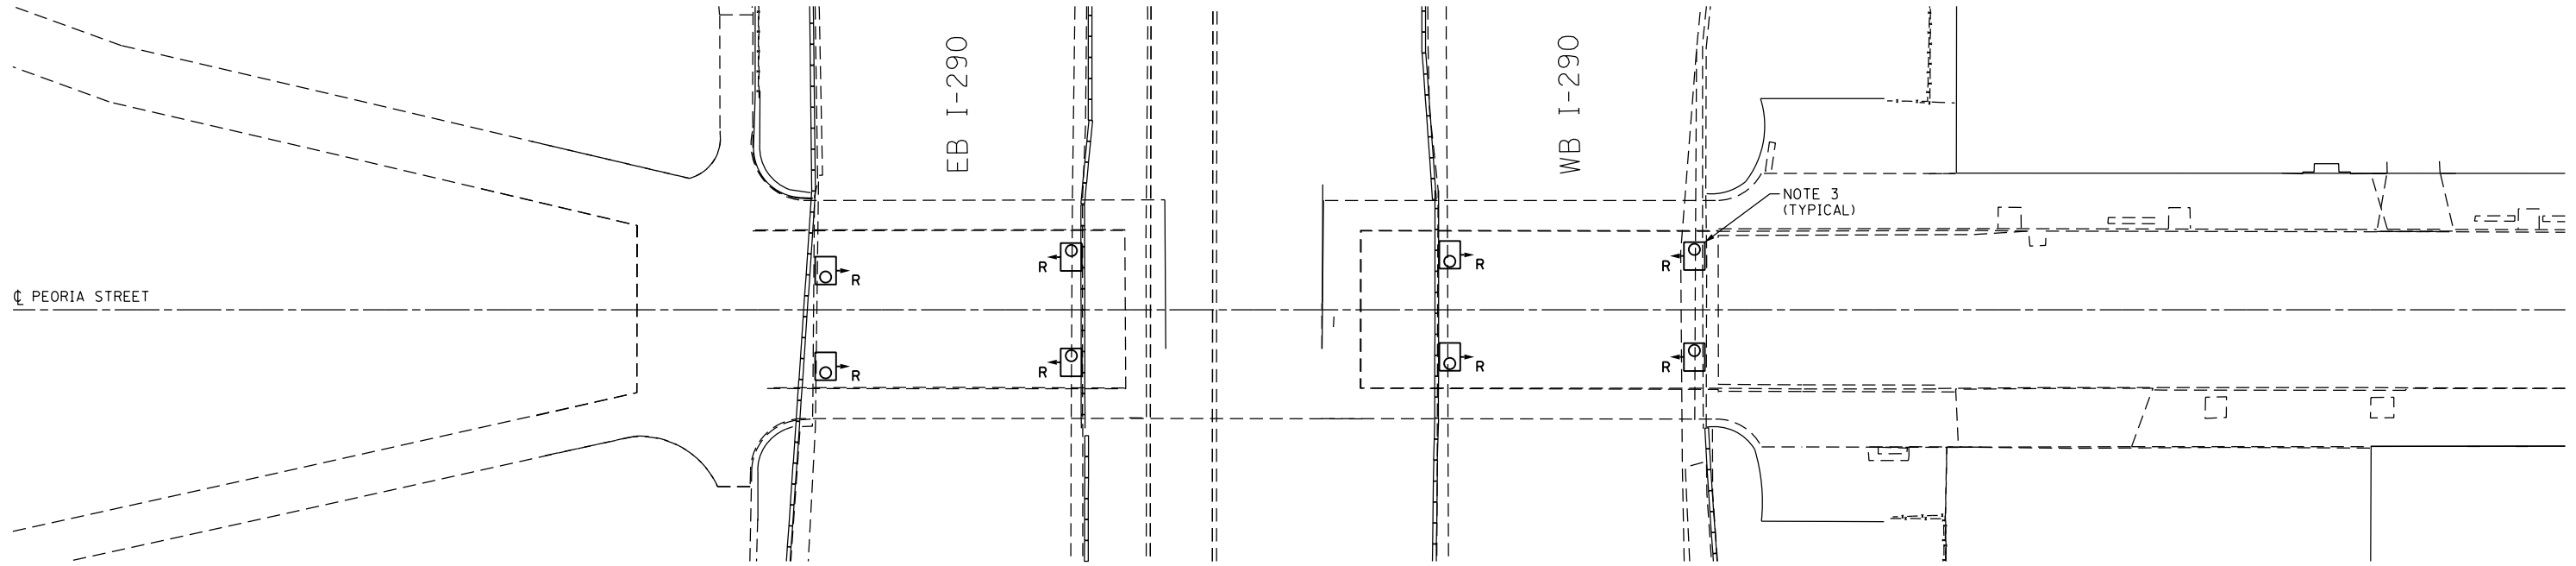

EXISTING UNDERPASS LIGHTING PLAN

NOTES 2 AND 3

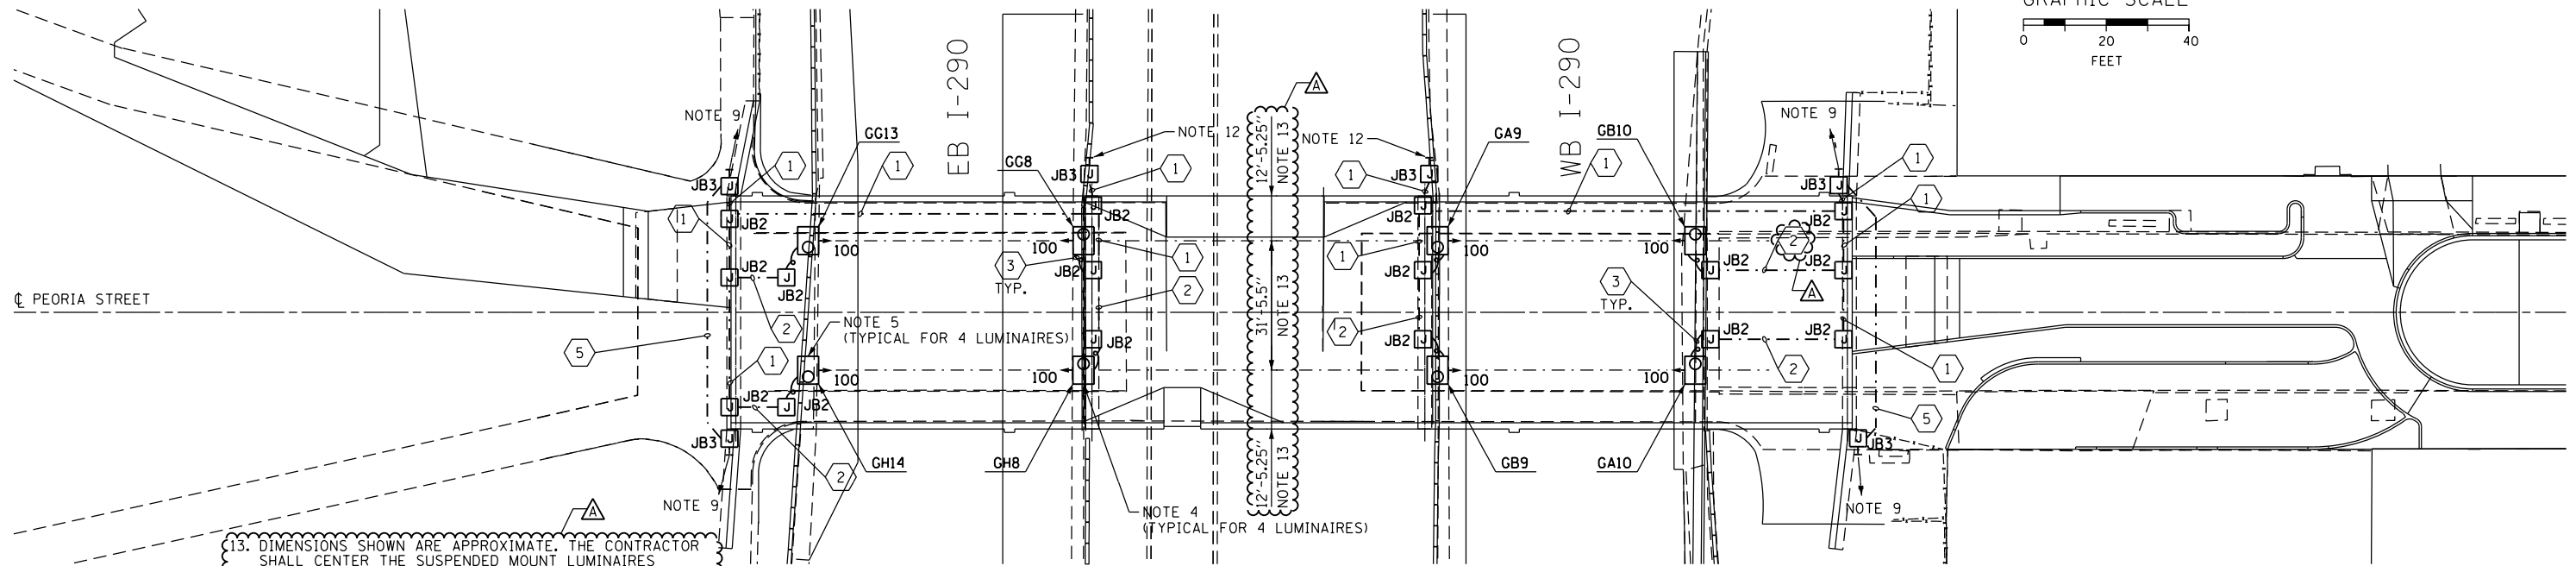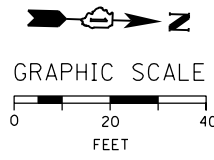

13. DIMENSIONS SHOWN ARE APPROXIMATE. THE CONTRACTOR SHALL CENTER THE SUSPENDED MOUNT LUMINAIRES BETWEEN THE BRIDGE GIRDERS. ALL UNDERPASS LIGHTING WORK MUST BE COORDINATED WITH THE CONDUITS ATTACHED TO STRUCTURE TO BE INSTALLED BETWEEN THE BRIDGE GIRDERS AND AS DIRECTED BY THE ENGINEER.

NOTES:

- SEE DRAWING E-01 FOR IDOT ELECTRICAL SYMBOLS AND ABBREVIATIONS.
- LOCATIONS OF EXISTING ELECTRICAL EQUIPMENT SHOWN ON THIS DRAWING ARE APPROXIMATIONS AND MUST BE VERIFIED IN THE FIELD BY THE CONTRACTOR.
- THE REMOVAL OF EXISTING UNDERPASS LUMINAIRES MUST INCLUDE THE REMOVAL OF ALL CABLES, CONDUIT, JUNCTION BOXES, AND HARDWARE ASSOCIATED WITH THE EXISTING UNDERPASS LIGHTING. COST FOR THIS WORK WILL NOT BE PAID FOR SEPARATELY BUT WILL BE INCLUDED AS PART OF THE "REMOVAL OF LIGHTING UNIT, SALVAGE" PAY ITEM.
- SEE IDOT STANDARD DRAWING BE-902 FOR ADDITIONAL INSTALLATION DETAILS FOR PROPOSED PIER/ABUTMENT WALL MOUNTED UNDERPASS LUMINAIRES.
- SEE IDOT STANDARD DRAWING BE-900 FOR ADDITIONAL INSTALLATION DETAILS FOR PROPOSED SUSPENDED MOUNT UNDERPASS LUMINAIRES.
- ALL PROPOSED UNDERPASS LIGHTING UNITS SHOWN ON THIS DRAWING WILL BE FED FROM EXISTING IDOT LIGHTING CONTROLLER "G".
- SUSPENDED MOUNT UNDERPASS LUMINAIRES SETBACK FROM THE EDGE OF PAVEMENT SHALL BE 2 FEET.
- ALL VERTICAL CONDUIT RUNS ROUTED DOWN THE STRUCTURE SHALL BE INSTALLED ON THE INSIDE OF THE PIER FACING AWAY FROM TRAFFIC FLOW.
- SEE DRAWING E-04 FOR CONTINUATION OF LIGHTING CIRCUIT.

PROPOSED UNDERPASS LIGHTING PLAN

- ROUTE NEW CABLES IN UNIT DUCT FROM PROPOSED JUNCTION BOX ON HALSTED ST. BRIDGE TO THE UNDERPASS LIGHTING SYSTEM FROM EXISTING LIGHT TOWER ZC02. ALLOW 200 FEET OF CABLES IN UNIT DUCT FOR BIDDING PURPOSES.
- ROUTE NEW CABLES IN UNIT DUCT FROM PROPOSED JUNCTION BOX ON PEORIA ST. BRIDGE TO THE EXISTING LIGHTING CIRCUITS LOCATED IN THE EXISTING LIGHT POLE TO PROVIDE A TEMPORARY POWER CONNECTION AS SHOWN. SEE DRAWING E-03 FOR CONTINUATION.
- SEE DRAWING E-03 FOR TEMPORARY POWER CONNECTIONS TO UNDER PASS LIGHTING SYSTEM.

100 WATT, HPS UNDERPASS LUMINAIRE WITH TYPE 4 DISTRIBUTION

JUNCTION BOX SCHEDULE		
NO.	SIZE	DESCRIPTION
JB1	6"x6"x4"	STAINLESS STEEL, ATTACHED TO STRUCTURE, UNDERPASS LIGHTING
JB2	12"x10"x6"	STAINLESS STEEL, ATTACHED TO STRUCTURE, UNDERPASS LIGHTING
JB3	18"x18"x8"	STAINLESS STEEL, ATTACHED TO STRUCTURE, UNDERPASS LIGHTING

CABLE / CONDUIT SCHEDULE

1	3-1/2"x10, 1-1/2"x10 GND IN 1" DIA PVCC RGC ATTACHED TO STRUCTURE (CKTS AS INDICATED ON THIS DRAWING)
2	2-1/2"x10, 1-1/2"x10 GND IN 1" DIA PVCC RGC ATTACHED TO STRUCTURE (CKTS AS INDICATED ON THIS DRAWING)
3	2-1/2"x10, 1-1/2"x10 GND IN 1" DIA LIQUID TIGHT FLEXIBLE CONDUIT (CKTS AS INDICATED ON THIS DRAWING)
4	3-1/2"x2, 1-1/2"x4 GND XLP TYPE USE CABLES IN A 1 1/2" UNIT DUCT (CKTS AS INDICATED ON THIS DRAWING)
5	3-1/2"x2, 1-1/2"x4 GND XLP TYPE USE CABLES IN A 3" DIA. PVCC RGC ATTACHED TO STRUCTURE (CKTS AS INDICATED ON THIS DRAWING)



D160W29-sht-Light-05
 USER NAME = myersc
 PLOT SCALE = 40.0000' / in.
 PLOT DATE = 1/20/2014

DESIGNED - WDS
 DRAWN - CAM
 CHECKED - WDS
 DATE - 10/30/2013

REVISED - A 1/20/2014
 REVISED -
 REVISED -
 REVISED -

STATE OF ILLINOIS
 DEPARTMENT OF TRANSPORTATION


PEORIA STREET UNDERPASS LIGHTING PLAN

SCALE: 1"=20' SHEET 5 OF 19 SHEETS STA. TO STA.

F.A.I. RTE.	SECTION	COUNTY	TOTAL SHEETS	SHEET NO.
90/94/290	2013-011R	COOK	356	115
CONTRACT NO. 60W29				
ILLINOIS FED. AID PROJECT				

E-05


c:\pwworking\acem00\bwitort\d0220246\DI60W29-sht-Light-06.dgn
 12/19/2013 10:29:49 AM

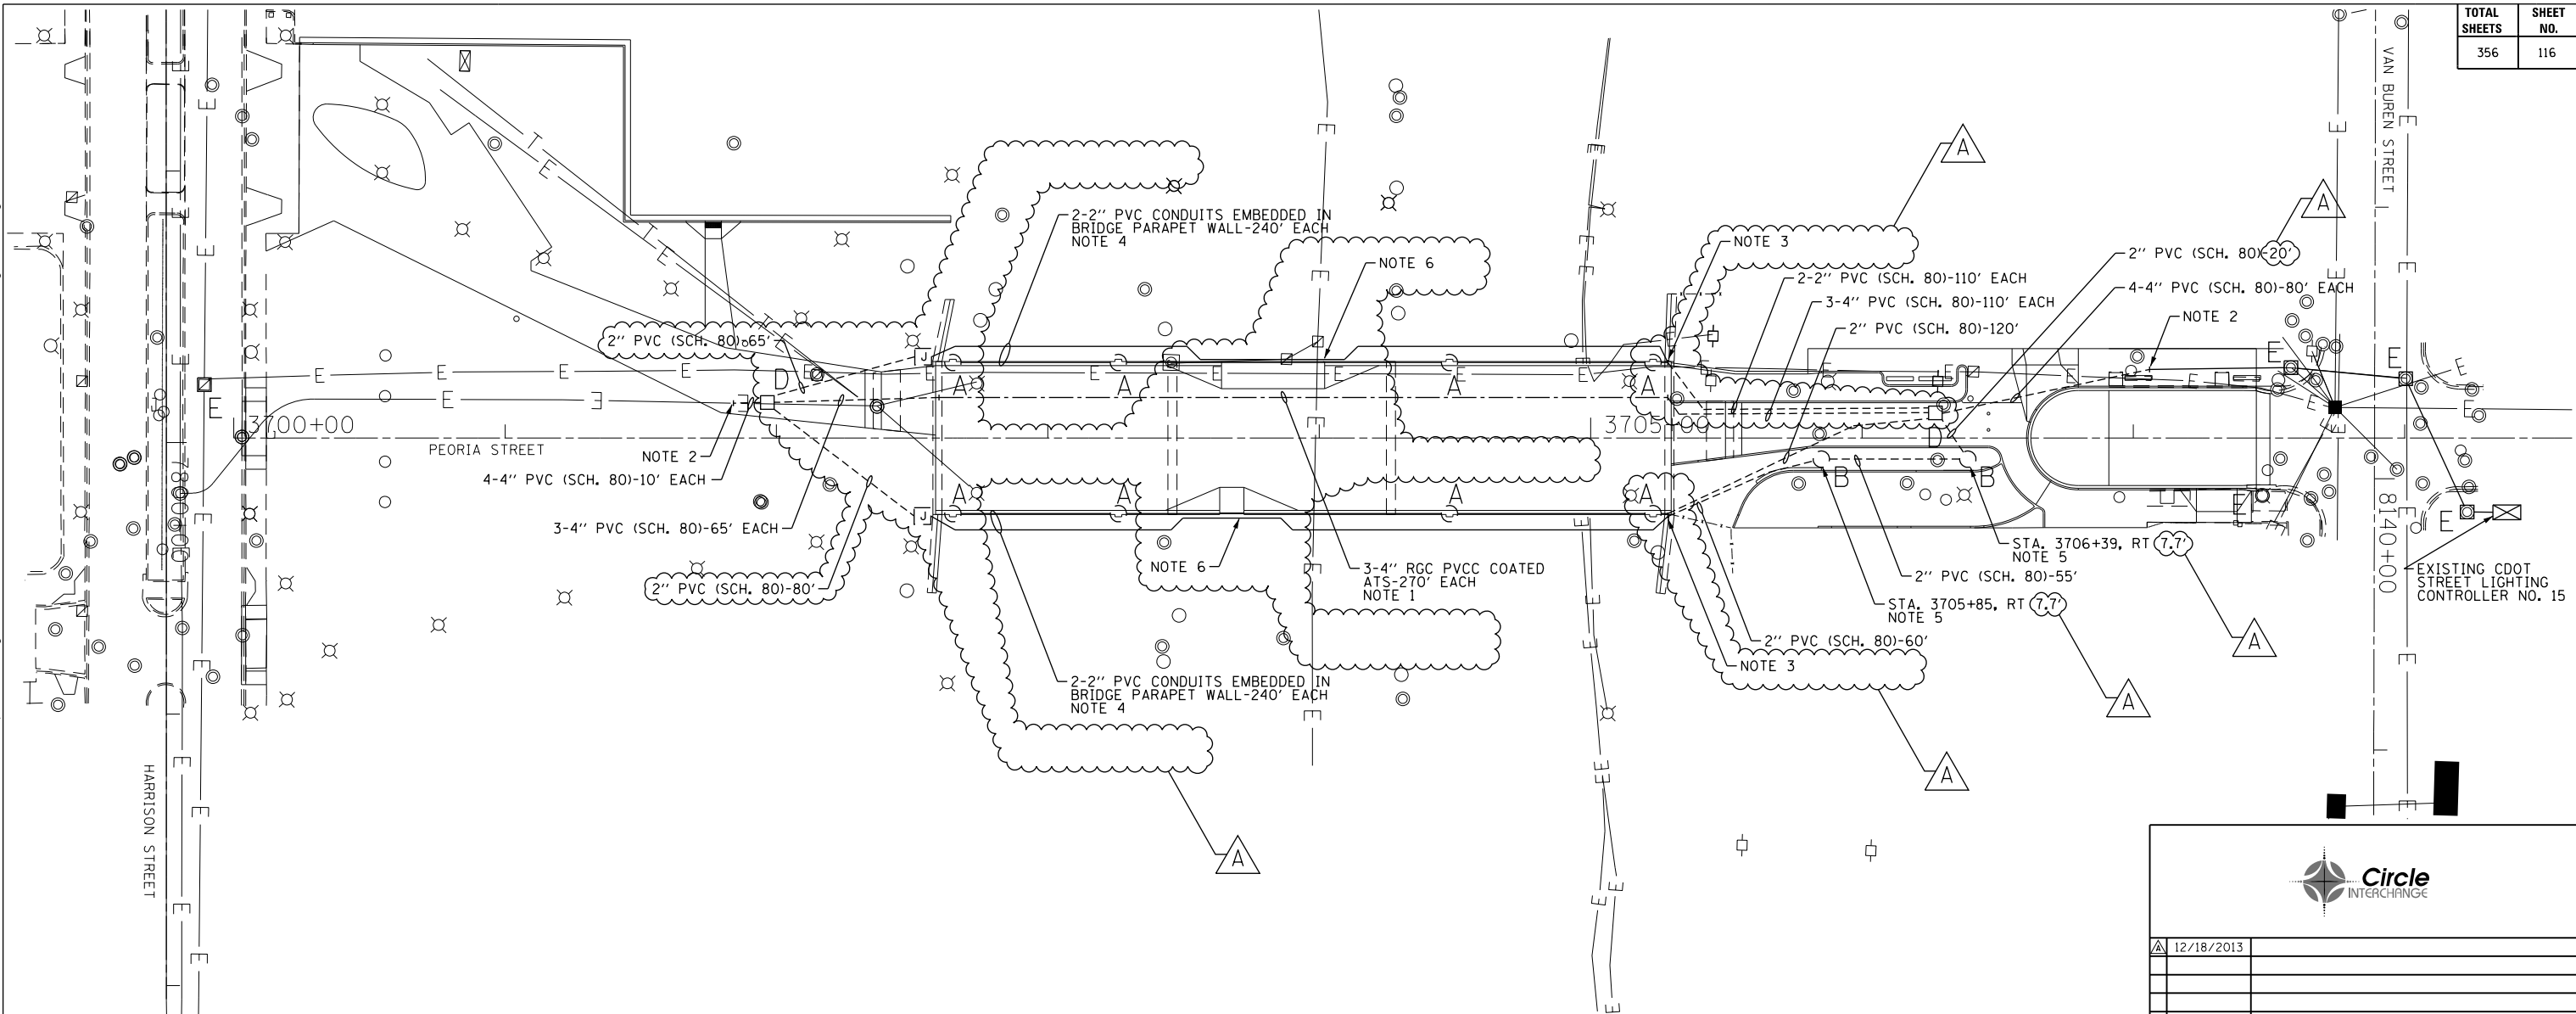

"A"	LIGHT POLE FOUNDATION IS INTEGRAL TO THE BRIDGE STRUCTURE PARAPET WALL. SEE STRUCTURAL PLANS FOR DETAILS AND FINAL LOCATION OF FOUNDATION.
"B"	PROVIDE 20"x5', 1" A.R., 10" B.C. FOUNDATION FOR LIGHT POLE, PER DWG. NOS. 565 AND 837.
"C"	DRILL EXISTING HANDHOLE/MANHOLE.
"D"	PROVIDE 3'x4'x4' CONCRETE MANHOLE PER DRAWING NO. 729 WITH 30" FRAME AND COVER PER DRAWING NO. 847.
"E"	EXISTING TO REMAIN.

NOTES:

- PROVIDE THREE 4-INCH RIGID GALVANIZED STEEL PVC COATED CONDUITS ATTACHED TO STRUCTURE. THE CONDUITS SHALL BE MOUNTED UNDER THE BRIDGE DECK. SEE STRUCTURAL PLANS FOR LOCATION OF CONDUITS.
- INTERCEPT EXISTING CITY CONDUITS AND CONNECT TO PROPOSED CONDUITS AS SHOWN.
- SEE DRAWING NO. E-12, EMBEDDED BRIDGE CONDUIT DETAIL-A FOR CONDUIT EXITING PARAPET WALL DETAILS.
- PROVIDE TWO 2-INCH SCHEDULE 40 PVC CONDUITS IN BOTH BRIDGE PARAPET WALLS; ONE FOR THE LIGHTING CIRCUITS AND ONE SPARE. SEE STRUCTURAL PLANS FOR LOCATIONS, DETAILS AND INSTALLATION OF CONDUITS.
- INSTALL LIGHT POLE FOUNDATION IN THE CENTER OF THE ISLAND.
- SEE DRAWING NO. E-12, EMBEDDED BRIDGE CONDUIT DETAIL-B FOR CONDUIT ROUTED IN SUPERSTRUCTURE AROUND THE CTA STATION.

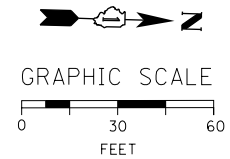


FOR LIGHTING CABLE AND EQUIPMENT INSTALLATION PLANS SEE DRAWING NO. E-07.
 FOR LIGHTING REMOVAL PLANS SEE DRAWING NO. E-08.

DATE: 12/18/2013	REVISION:
CITY OF CHICAGO DEPARTMENT OF TRANSPORTATION DIVISION OF ENGINEERING	
CONSULTANT: <small>303 EAST WACKER DRIVE, SUITE 1400 CHICAGO, IL 60601-5276 PHONE: (312) 313-7100 FAX: (312) 313-6800</small>	
WORK ORDER NO. _____	DATE _____
COST ALLOCATION ACCOUNT _____	
APPROPRIATION ACCOUNT _____	MATERIAL _____ LABOR _____
PEORIA STREET LIGHTING CONDUIT AND FOUNDATION PLAN	
CITY OF CHICAGO <small>DEPT. OF TRANSPORTATION DIVISION OF ELECTRICAL OPERATIONS</small>	
DRAFTSMAN: CAM	CHIEF DRAFTSMAN: JPC
ENGINEER: WDS	
SUPERVISING ENGINEER/ELEC. DESIGN ENGR. JPC	
ENGINEER OF ELECTRICITY:	
GEN'L SUPT. OF ELECTRICITY:	
DEPUTY COMMISSIONER:	
SIZE: 22" 34"	SCALE: 1" = 30'
DATE: 05/14/13	DATE:
C.D.O.T. PROJECT NO.:	DWG. NO.:
6 OF 19	


E-06

c:\pwworking\aecom\00\bw\itort\d0220246\DI60W29-sht-Light-07.dgn
 12/19/2013 10:29:21 AM

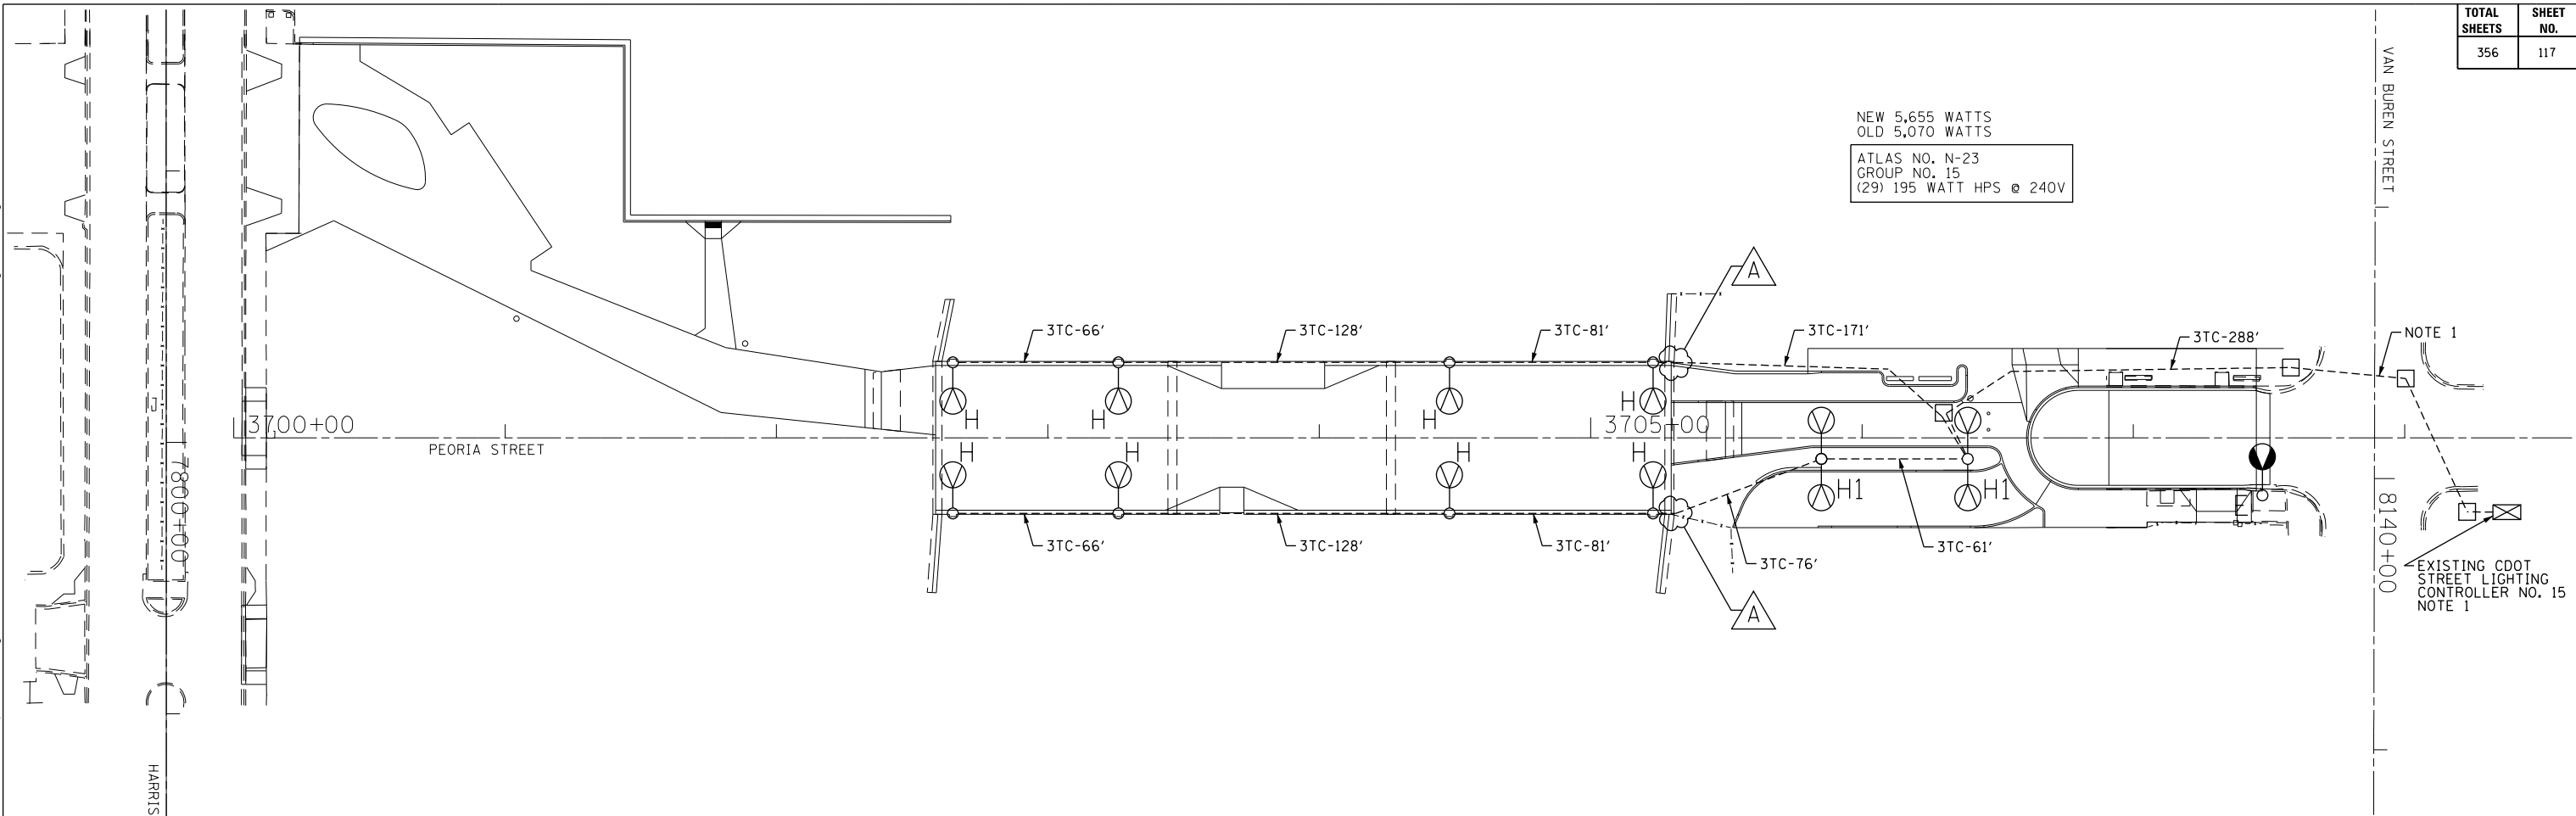

NEW 5,655 WATTS
 OLD 5,070 WATTS
 ATLAS NO. N-23
 GROUP NO. 15
 (29) 195 WATT HPS @ 240V

NOTE 1
 EXISTING CDOT STREET LIGHTING CONTROLLER NO. 15
 NOTE 1

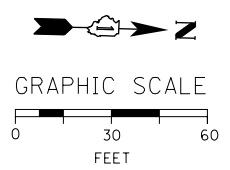

NOTES:

1. ROUTE NEW LIGHTING CIRCUIT THROUGH EXISTING CITY CONDUITS AND MANHOLES INTO THE EXISTING CDOT LIGHTING CONTROLLER AND MAKE THE NECESSARY CONNECTIONS TO THE EXISTING CIRCUIT BREAKERS. THIS WORK WILL NOT BE PAID FOR SEPARATELY AND SHALL BE INCLUDED IN THE COST OF THE "CABLE IN CONDUIT, TRIPLEX" PAY ITEM.

"H" PROVIDE 12.5' ALUMINUM POLE, 150W HPS LUMINAIRE AND 8 FOOT ALUMINUM DAVIT ARM PER DRAWING NOS. 940 AND 945.
 "H1" PROVIDE 12.5' ALUMINUM POLE, TWO 150W HPS LUMINAIRES AND TWIN 8 FOOT DAVIT ARMS PER DRAWING NOS. 940 AND 945.

DATE	12/18/2013	REVISION	
CITY OF CHICAGO			
DEPARTMENT OF TRANSPORTATION DIVISION OF ENGINEERING			
CONSULTANT: <small>303 EAST WACKER DRIVE, SUITE 1400 CHICAGO, IL 60601-5276 PHONE: (312) 313-7100 FAX: (312) 313-6800</small>			
WORK ORDER NO.		DATE	
COST ALLOCATION ACCOUNT			
APPROPRIATION ACCOUNT		MATERIAL	
		LABOR	
PEORIA STREET LIGHTING CABLE AND EQUIPMENT INSTALLATION PLAN			
CITY OF CHICAGO			
DEPT. OF TRANSPORTATION DIVISION OF ELECTRICAL OPERATIONS			
DRAFTSMAN:	CHIEF DRAFTSMAN:	ENGINEER:	
CAM		WDS	
SUPERVISING ENGINEER:	ELEC. DESIGN ENGR.		
JPC			
ENGINEER OF ELECTRICITY:		E-07	
GEN'L SUPT. OF ELECTRICITY:			
DEPUTY COMMISSIONER:			
SIZE: 22" 34"	SCALE: 1" = 30'	DATE:	
DATE: 05/14/13		DWG. NO.:	
C.D.O.T. PROJECT NO.:		7 OF 19	

FOR CONDUIT AND FOUNDATION PLANS
 SEE DRAWING NO. E-06.
 FOR LIGHTING REMOVAL PLANS SEE
 DRAWING NO. E-08.



UIC
CUPPA HALL
BUILDING NO. 641

3-4" OEMC (CITY) CONDUITS AT S
TO BE REMOVED
NOTE 1

NOTE 2

NOTE

EXISTING CDOT
STREET LIGHTING
CONTROLLER NO. 15

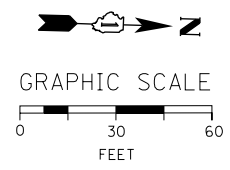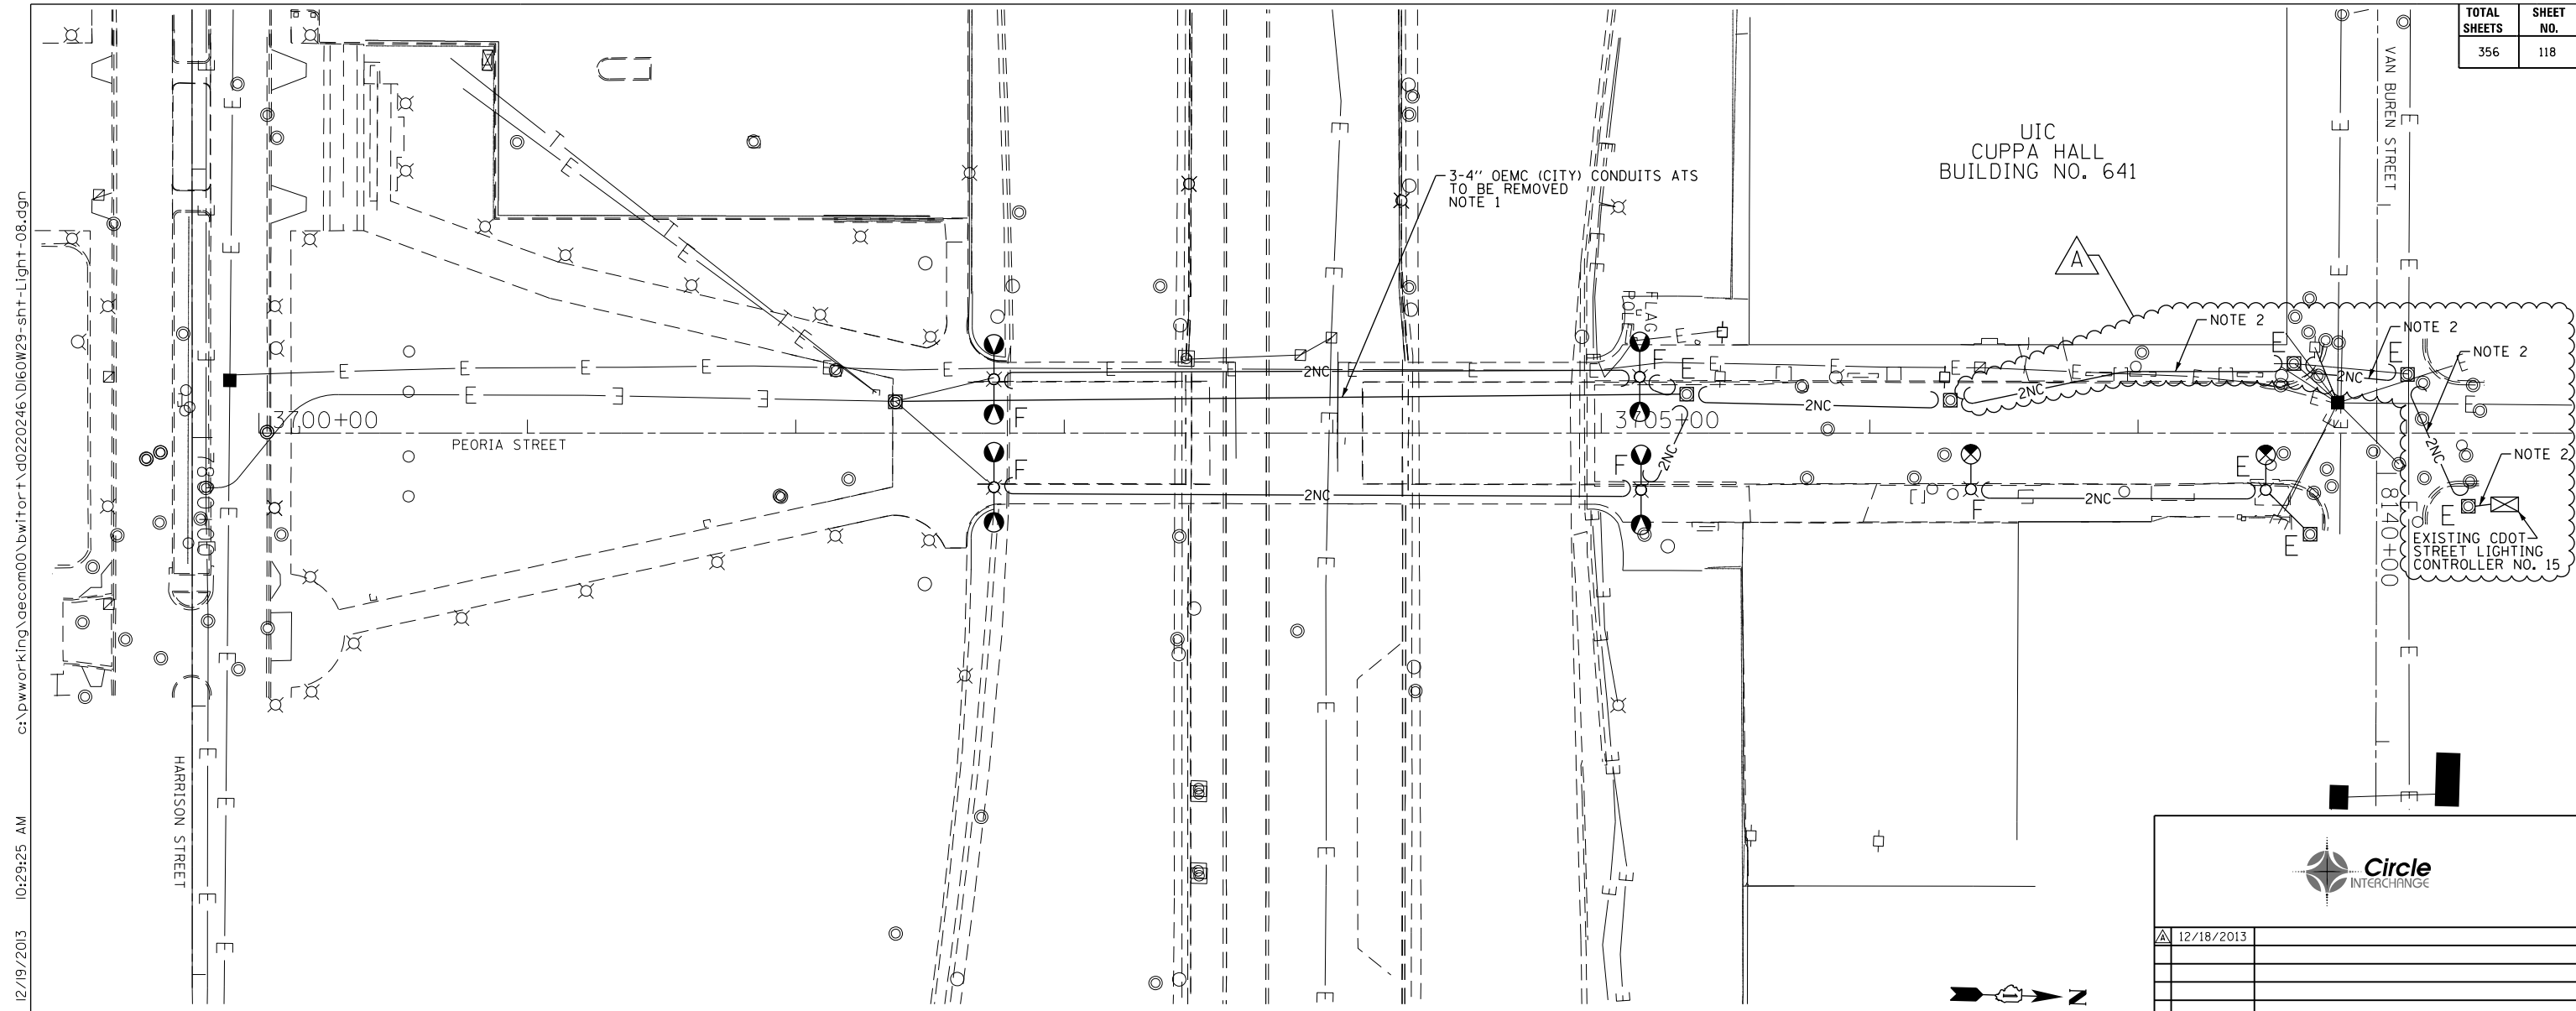

NOTES:

1. THE EXISTING CDOT CONDUITS ATTACHED TO THE UNDERSIDE OF THE BRIDGE STRUCTURE MAY CONTAIN ASBESTOS MATERIALS. THE CONDUITS SHALL BE REMOVED AND DISPOSED OF PROPERLY PRIOR TO THE BRIDGE DEMOLITION. CONDUITS TESTED AND CONFIRMED TO CONTAIN ASBESTOS MUST BE REMOVED IN ACCORDANCE WITH THE SPECIAL PROVISION "REMOVAL OF ASBESTOS CEMENT CONDUIT". ASBESTOS CONDUIT REMOVAL SHALL BE PAID FOR UNDER THE "REMOVAL OF ASBESTOS CEMENT CONDUIT" PAY ITEM.
2. REMOVE EXISTING LIGHTING CABLES FROM EXISTING CONDUIT TO BE REUSED. EXISTING CONDUIT TO BE REUSED SHALL BE RODDED AND CLEANED PRIOR TO INSTALLING THE NEW LIGHTING CABLES. SEE DRAWINGS E-06 AND E-07 FOR THE EXISTING CONDUITS TO BE REUSED. EXISTING CABLES IN EXISTING CONDUIT NOT BEING REUSED TO INSTALL NEW CABLES SHALL BE ABANDONED IN PLACE. THE CONTRACTOR WILL NOT BE PAID FOR REMOVING CABLES FROM EXISTING ABANDONED CONDUITS NOT BEING REUSED.


"E" EXISTING TO REMAIN
"F" REMOVE AND SALVAGE EXISTING STEEL POLE, LUMINAIRE(S), MAST ARM(S) AND BALLAST HOUSING. BREAKDOWN CONCRETE FOUNDATION COMPLETE.

FOR CONDUIT AND FOUNDATION PLANS
SEE DRAWING NO. E-06.
FOR LIGHTING CABLE AND EQUIPMENT
INSTALLATION PLANS SEE DRAWING NO. E-07.

DATE	REVISION
CITY OF CHICAGO DEPARTMENT OF TRANSPORTATION DIVISION OF ENGINEERING	
CONSULTANT: AECOM <small>303 EAST WACKER DRIVE, SUITE 1400 CHICAGO, IL 60601-5276 PHONE: (312) 373-7700 FAX: (312) 373-6800</small>	
WORK ORDER NO.	DATE
COST ALLOCATION ACCOUNT	
APPROPRIATION ACCOUNT	MATERIAL LABOR
PEORIA STREET LIGHTING REMOVAL PLAN	
CITY OF CHICAGO DEPT. OF TRANSPORTATION DIVISION OF ELECTRICAL OPERATIONS	
DRAFTSMAN: CAM	ENGINEER: WDS
SUPERVISING ENGINEER: JPC	ELEC. DESIGN ENGR.
ENGINEER OF ELECTRICITY:	
GEN'L SUPT. OF ELECTRICITY:	
DEPUTY COMMISSIONER:	
SIZE: 22" 34"	SCALE: 1" = 30'
DATE: 05/14/13	DATE:
C.D.O.T. PROJECT NO.:	DWG. NO.:

E-08

12/19/2013 10:29:25 AM c:\pwworking\acom00\bwitort\d0220246\DI60W29-sht-Light-08.dgn

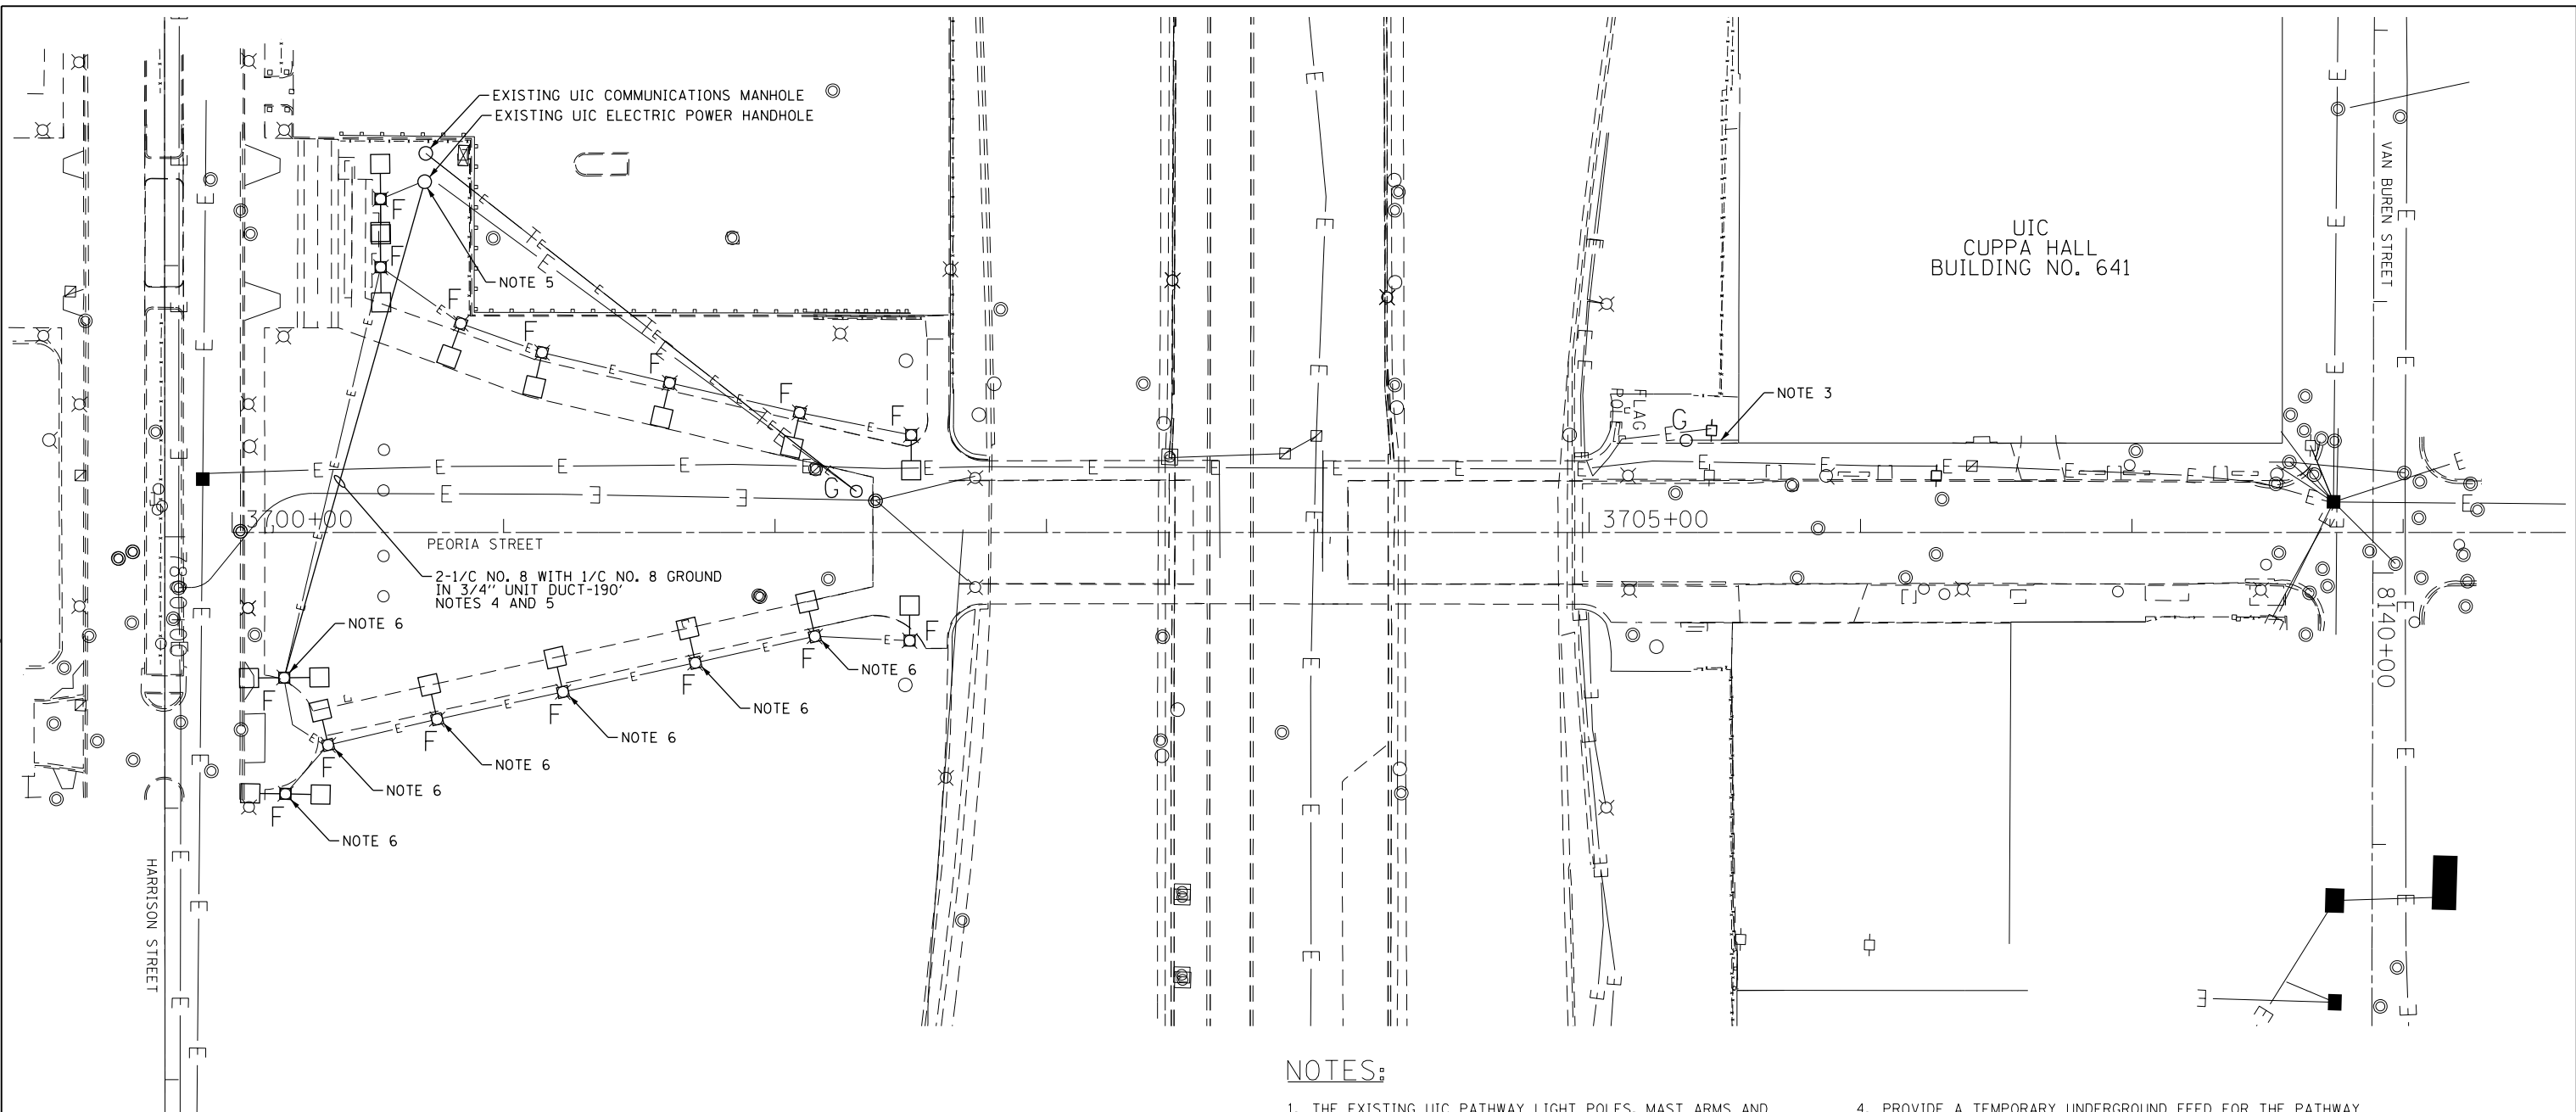

"E" EXISTING TO REMAIN
 "F" REMOVE EXISTING UIC LIGHT POLE FOUNDATION COMPLETE. NOTES 1 AND 6
 "G" REMOVE EXISTING ETU FOUNDATION COMPLETE. NOTE 2

NOTES:


- THE EXISTING UIC PATHWAY LIGHT POLES, MAST ARMS AND LUMINAIRES WILL BE REMOVED BY OTHERS. THE CONTRACTOR SHALL COORDINATE THIS REMOVAL WORK WITH UIC'S FACILITIES MANAGEMENT. UIC FACILITIES MANAGEMENT CONTACT INFORMATION IS AS FOLLOWS:

 PABLO ACEVEDO 312-996-2106
 KEVIN O'SHEA 312-996-2883
 CLARENCE BRIDGES 312-413-5946

 THE CONTRACTOR MUST CONTACT UIC'S FACILITIES MANAGEMENT A MINIMUM OF TWO WEEKS PRIOR TO THE REMOVAL OF THE EXISTING UIC PATHWAY LIGHTING UNITS.
- THE EXISTING UIC ETU BOLLARD SHALL BE REMOVED BY OTHERS. THE CONTRACTOR SHALL COORDINATE THE REMOVAL WORK WITH UIC'S TELECOM/ACCC ENGINEERING DEPARTMENT. UIC'S TELECOM/ACCC ENGINEERING DEPARTMENT INFORMATION IS AS FOLLOWS:

 BRIAN NG 312-413-8254
 BEVERLY BAILEY 312-213-7419
 TOM WIESE 815-272-6607

 THE CONTRACTOR MUST CONTACT UIC'S TELECOM/ACCC GROUP A MINIMUM OF TWO WEEKS PRIOR TO THE REMOVAL OF THE EXISTING UIC ETU BOLLARDS.
- THE EXISTING POWER AND DATA FEED FOR THE ETU BOLLARD IS ROUTED INTO BUILDING 641-CUPPA HALL. THE EXISTING POWER AND DATA CONDUITS SHALL BE SAWCUT, CAPPED AND PROTECTED DURING CONSTRUCTION FOR FUTURE USE. SEE DRAWING E-10 FOR PROPOSED CONDUIT CONNECTIONS.
- PROVIDE A TEMPORARY UNDERGROUND FEED FOR THE PATHWAY LIGHTING CIRCUITS ON THE EAST PATHWAY AS SHOWN. THE TEMPORARY FEED SHALL BE PROTECTED DURING CONSTRUCTION STAGES 1B THROUGH STAGE 3 UNTIL IT IS NO LONGER REQUIRED.
- THE TEMPORARY LIGHTING FEED SHALL BE SPLICED TO EXISTING UIC LIGHTING CIRCUITS LOCATED WITHIN THE EXISTING UIC POWER HANDHOLE. CONTRACTOR SHALL PROVIDE A WATERPROOF CONNECTION FOR ALL SPLICES.
- THE EXISTING UIC PATHWAY LIGHTING UNITS WILL REMAIN IN PLACE AND OPERATIONAL UNTIL THE END OF STAGE 2 OF THE SUGGESTED CONSTRUCTION SCHEDULE. THE CONTRACTOR SHALL PROTECT THE LIGHTING UNITS UNTIL THE ENGINEER DIRECTS THE CONTRACTOR TO REMOVE THEM.

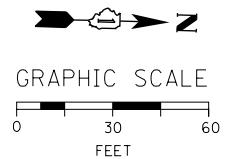

FILE PATH = p:\388035-par\lsc\comon\me\local\p\AEC\000\Documents\01_Americas\Transportation\62629938_Circle\Phase_1\1000_CAD\015_Electrical\Sheets\60W29_sht-Light-09



D160W29-sht-Light-09
 USER NAME = BAW:tor t
 PLOT SCALE = 60.0000' / in.
 PLOT DATE = 12/19/2013



DESIGNED - WDS
 DRAWN - CAM
 CHECKED - WDS
 DATE - 10/30/2013
 REVISED - 12/18/2013
 REVISED -
 REVISED -
 REVISED -

STATE OF ILLINOIS
DEPARTMENT OF TRANSPORTATION

EXISTING/TEMPORARY/DEMOLITION PLAN
UNIVERSITY OF ILLINOIS AT CHICAGO
 SCALE: 1"=30' SHEET 9 OF 19 SHEETS STA. TO STA.

F.A.I. RTE. 90/94/290	SECTION 2013-011R	COUNTY COOK	TOTAL SHEETS 356	SHEET NO. 119
ILLINOIS FED. AID PROJECT			CONTRACT NO. 60W29	

FILE PATH = p:\388035\pmt\aecon\line\local\PECD000\Documents\01_Americas\Transportation\62629938_Circle\Phase_1\1000_CND\016_Electrical\Sheets\60W29_sht-Light-10

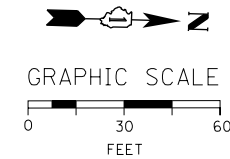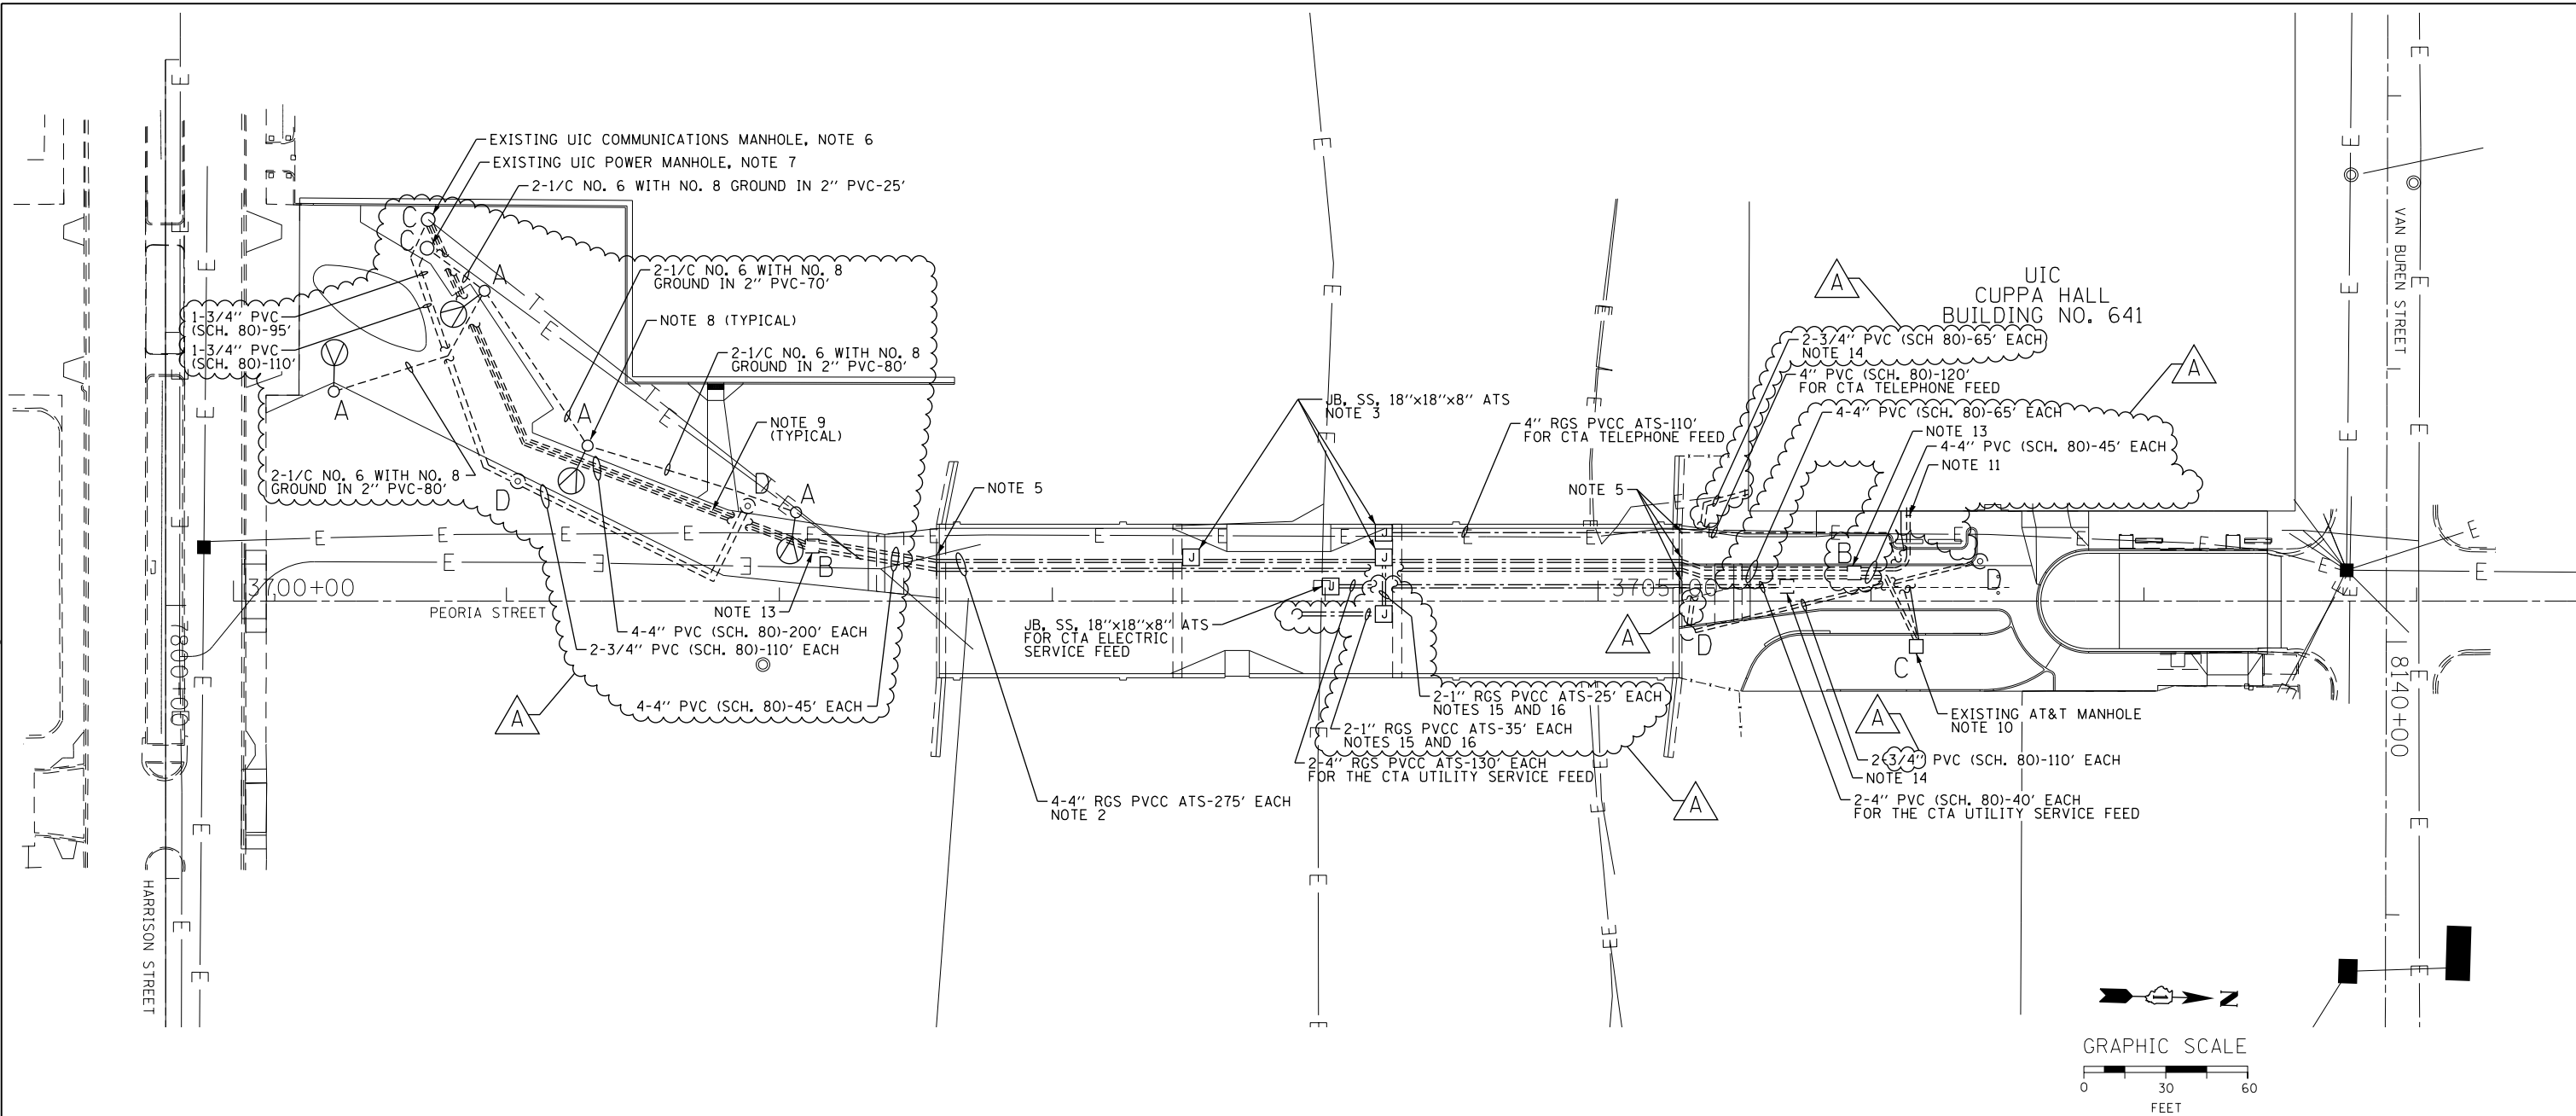

- "A" PROVIDE AN 12.5' ALUMINUM LIGHT POLE, 150W HPS, LUMINAIRE AND 8 FOOT ALUMINUM DAVIT ARM AND ALL ASSOCIATED COMPONENTS PER DRAWING NOS. 940 AND 945. PROVIDE 20"x5", 1" A.R., 10" B.C. FOUNDATION FOR LIGHT POLE, PER DRAWING NOS. 565 AND 837.
- "B" PROVIDE 3'x4'x4' CONCRETE MANHOLE PER DRAWING NO. 729 WITH 30" FRAME AND COVER PER DRAWING NO. 847.
- "C" DRILL EXISTING MANHOLE/HANDHOLE.
- "D" PROVIDE AN ETU BOLLARD FOUNDATION WITH TWO QUAZITE JUNCTION BOXES PER DETAILS SHOWN ON DRAWING E-11. QUAZITE JUNCTION BOXES NOT SHOWN ON THIS DRAWING, BUT REQUIRED FOR THE INSTALLATION. FINAL LOCATION OF FOUNDATION TO BE STAKED IN THE FIELD AND APPROVED BY A UIC REPRESENTATIVE PRIOR TO BEGINNING ANY ETU BOLLARD FOUNDATION WORK.
- "E" EXISTING TO REMAIN.

NOTES:

1. SEE DRAWING E-01 FOR ELECTRICAL SYMBOLS.
2. PROVIDE FOUR 4-INCH RIGID GALVANIZED STEEL PVC COATED CONDUITS ATTACHED TO STRUCTURE. THE CONDUITS SHALL BE MOUNTED UNDER THE BRIDGE DECK. SEE STRUCTURAL PLANS FOR LOCATION OF CONDUITS.
3. THE PROPOSED JUNCTION BOX SHALL BE INSTALLED DIRECTLY ABOVE THE INSIDE FACE OF THE PIER STRUCTURE TO ALLOW FOR EASY CONNECTION TO FUTURE CONDUITS ATTACHED TO AND ROUTED UP THE PIER FACE. ROUTE TWO OF THE 4-INCH UIC CONDUITS THROUGH THE JUNCTION BOX.
4. INTERCEPT EXISTING CONDUITS AND CONNECT TO PROPOSED MANHOLE AS SHOWN.
5. SEE DRAWING NO. E-12 FOR EMBEDDED CONDUIT EXITING PARAPET WALL DETAILS.
6. ROUTE THE NEW COMMUNICATIONS CONDUITS TO THE EXISTING UIC COMMUNICATIONS MANHOLE AS SHOWN. COORDINATE ALL WORK WITH UIC'S TELECOM/ACCC ENGINEERING DEPARTMENT. SEE DRAWING E-09 FOR UIC CONTACT INFORMATION.
7. ROUTE NEW LIGHTING CONDUIT AND CABLES TO THE EXISTING UIC POWER MANHOLE. CONNECT THE NEW PATHWAY LIGHTING CIRCUIT TO THE EXISTING UIC LIGHTING CIRCUIT LOCATED INSIDE THE MANHOLE. PROVIDE WATERPROOF CONNECTIONS FOR ALL SPLICES.
8. INSTALL LIGHT POLE FOUNDATION IN GRADE 3 FEET FROM THE FACE OF CURB TO CENTER OF FOUNDATION.
9. PROVIDE A POLYPROPYLENE, TWISTED YELLOW, ROT AND MILDEW RESISTANT PULL ROPE IN ALL EMPTY CONDUITS. THE ROPE SHALL BE A MINIMUM 3/8 INCHES IN DIAMETER WITH 2400 STRENGTH POUNDS.
10. ROUTE TWO 4-INCH CONDUITS FROM THE UIC MANHOLE TO THE AT&T MANHOLE. THIS WORK SHALL BE COORDINATED WITH AT&T.
11. ROUTE TWO 4-INCH CONDUITS TO UIC BUILDING NO. 461-CUPPA HALL AND INTERCEPT THE EXISTING TWO 4-INCH CONDUITS. CONNECT THE NEW CONDUITS TO THE EXISTING CONDUITS. PROVIDE CONDUIT REDUCERS AS NEEDED. LOCATION OF EXISTING CONDUITS TO BE DETERMINED IN THE FIELD BY THE CONTRACTOR. ALL WORK TO BE COORDINATED WITH UIC.
12. ROUTE TWO 3/4-INCH PVC CONDUITS (1 DATA, 1 POWER) FROM THE PROPOSED ETU JUNCTION BOXES AND FOUNDATION TO INTERCEPT THE EXISTING CONDUIT STUBOUTS LOCATED ON THE SOUTH SIDE OF UIC BUILDING NO. 461-CUPPA HALL. CONNECT THE NEW CONDUITS TO THE EXISTING CONDUITS. LOCATION OF EXISTING CONDUITS TO BE DETERMINED IN THE FIELD BY THE CONTRACTOR. ALL WORK SHALL BE COORDINATED WITH UIC.
13. THE UIC COMMUNICATIONS LOGO SHALL BE STAMPED ON THE MANHOLE COVER. COORDINATE THIS WORK WITH UIC TELECOM/ACCC ENGINEERING DEPARTMENT.
14. COMED MANHOLE FOR CTA UTILITY FEED BY OTHERS.
15. ROUTE TWO 1-INCH RIGID GALVANIZED STEEL PVC COATED CONDUITS ATTACHED TO STRUCTURE FROM THE JUNCTION BOX TO THE CONDUIT SLEEVE THROUGH THE BRIDGE DECK FOR THE UIC MESSAGE BOARD. SEE THE STRUCTURAL DRAWINGS FOR THE LOCATION OF THE CONDUIT SLEEVE THROUGH THE BRIDGE DECK.
16. SEE DETAIL ON DRAWING E-12 FOR CONDUIT INSTALLATION PLAN - PIER 2.




D160W29-sht-Light-10	DESIGNED - WDS	REVISED - 12/18/2013
USER NAME = BAW:tor t	DRAWN - CAM	REVISED -
PLOT SCALE = 60.0000' / in.	CHECKED - WDS	REVISED -
PLOT DATE = 12/19/2013	DATE - 10/30/2013	REVISED -

STATE OF ILLINOIS
DEPARTMENT OF TRANSPORTATION

PROPOSED LIGHTING PLAN	
UNIVERSITY OF ILLINOIS AT CHICAGO	
SCALE: 1"=30'	SHEET 10 OF 19 SHEETS STA. TO STA.

F.A.I. RTE. 90/94/290	SECTION 2013-011R	COUNTY COOK	TOTAL SHEETS 356	SHEET NO. 120
CONTRACT NO. 60W29				
ILLINOIS FED. AID PROJECT				

BOLLARD BASE FOR STANDARD E.T.U.'s & P.A.U.'s

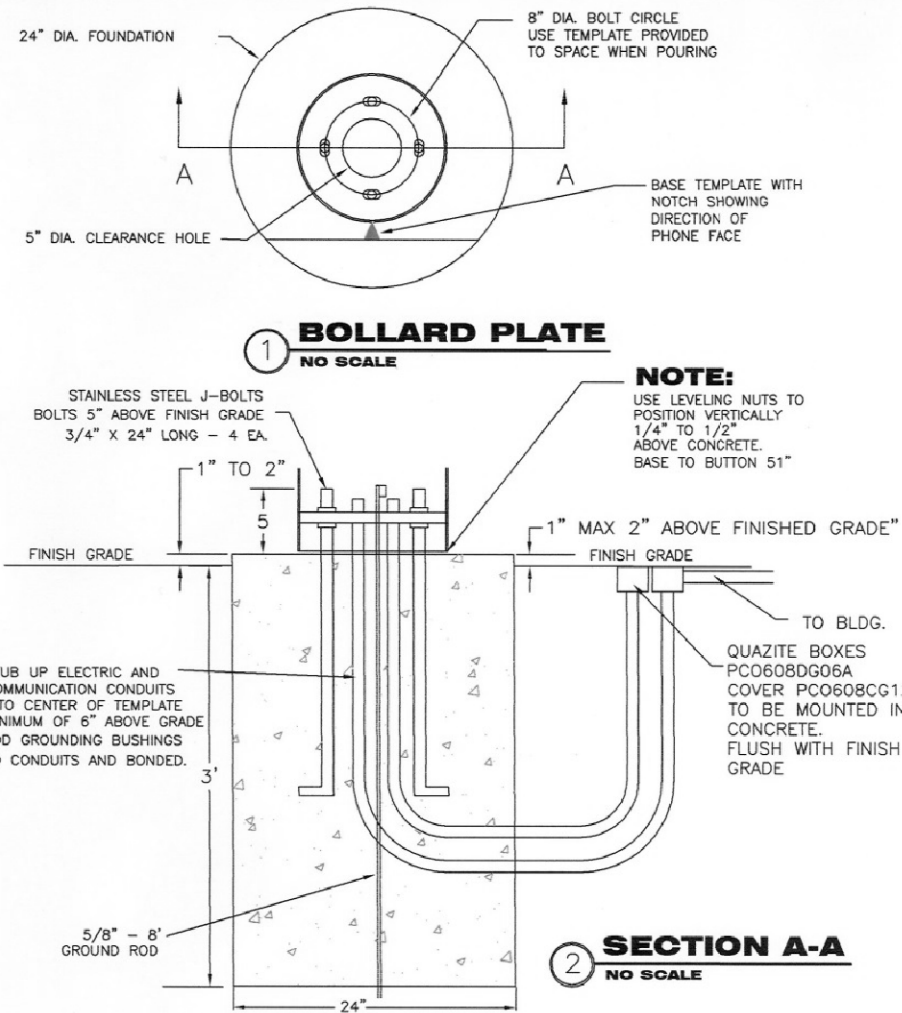

FILE: BOLLARD.DWG	DRAWN BY: T. E. D.	UNIVERSITY OF ILLINOIS AT CHICAGO TELECOMMUNICATIONS DEPARTMENT
DWG: E.T.U. & P.A.U. BOLLARD BASE	DATE: 07.10.97	
	SHEET: 1 OF 1	
	SCALE: NO SCALE	



EMERGENCY TELEPHONE UNIT BOLLARD

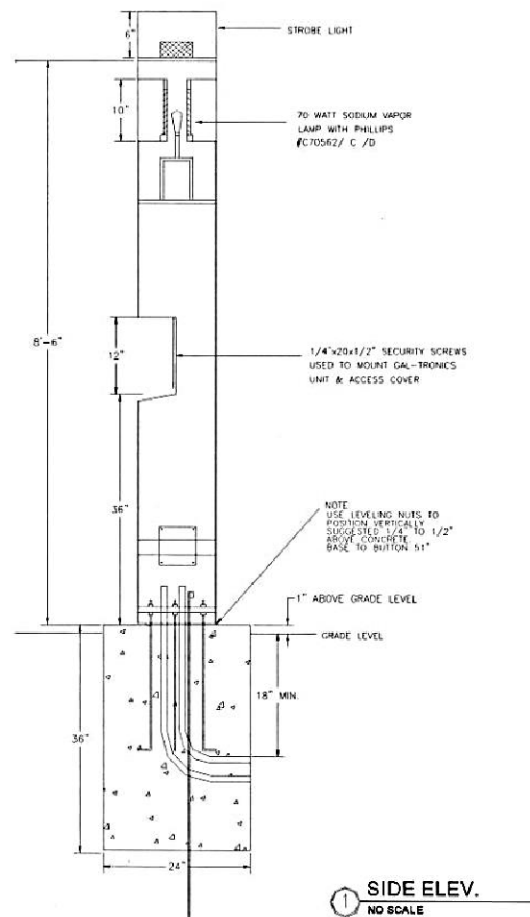


DIAGRAM 17A

FILE: BOLLARD.DWG	DRAWN BY: T.E.D. rv	UNIVERSITY OF ILLINOIS AT CHICAGO TELECOMMUNICATIONS DEPARTMENT
DWG: E.T.U. COMMUNICATIONS BOLLARD	DATE: 07/10/97	
	SHEET: 1 OF 1	
	SCALE: NO SCALE	



ETU AND PAU CONDUIT INSTALLATION


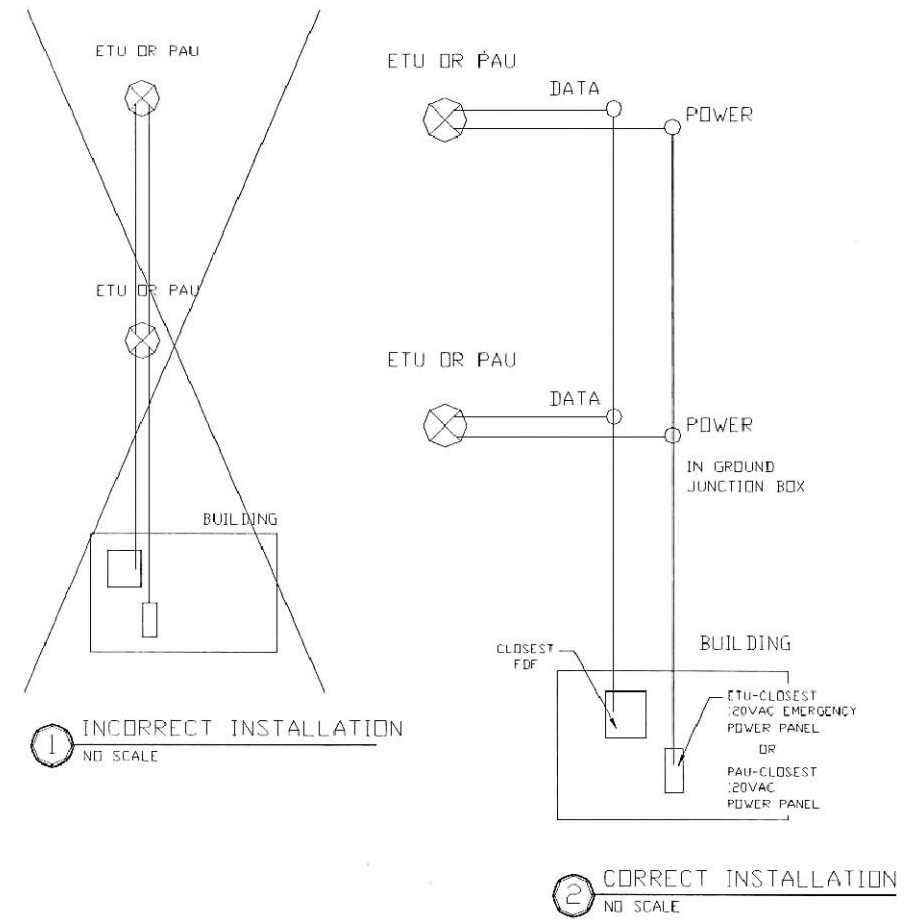


DIAGRAM 17i


FILE: ETUDIGRM.DWG	DRAWN BY: T. E. D.	UNIVERSITY OF ILLINOIS AT CHICAGO TELECOMMUNICATIONS DEPARTMENT
DWG: ETU - PAU CORRECT INSTALLATION	DATE: 07.30.97	
	SHEET: 1 OF 1	
	SCALE: NO SCALE	




FILE PATH = p:\388035\pmt\lsc\comon\line\local\p\AECOM\00\Documents\01\Americas\Transportation\60269938_Circle\Phase_1\1000_CAD\016_Electrical\Sheets\60W29_sht-Light-11

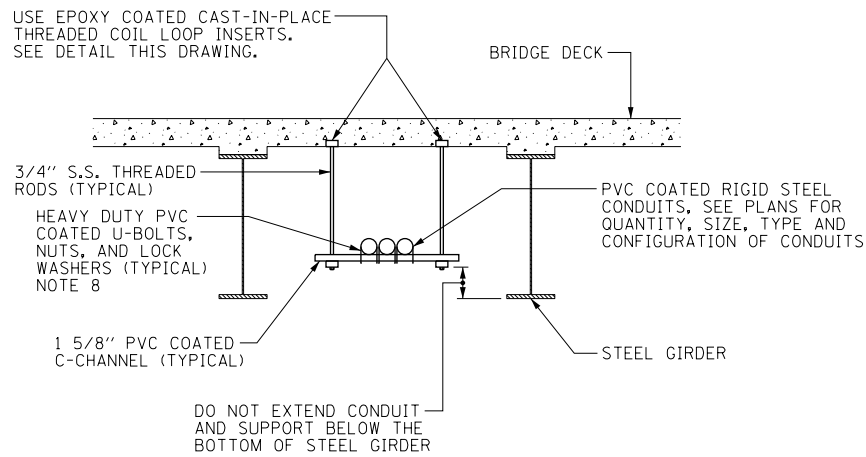


TYPICAL CONDUIT SUPPORT ATTACHED TO BRIDGE DECK DETAIL
SCALE: NOT TO SCALE
NOTE 11

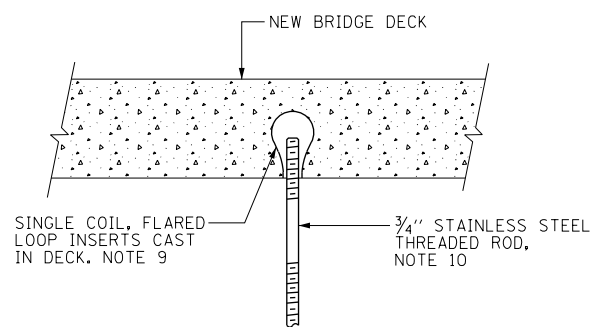


BRIDGE DECK THREADED ROD INSTALLATION ANCHOR DETAILS
SCALE: NOT TO SCALE

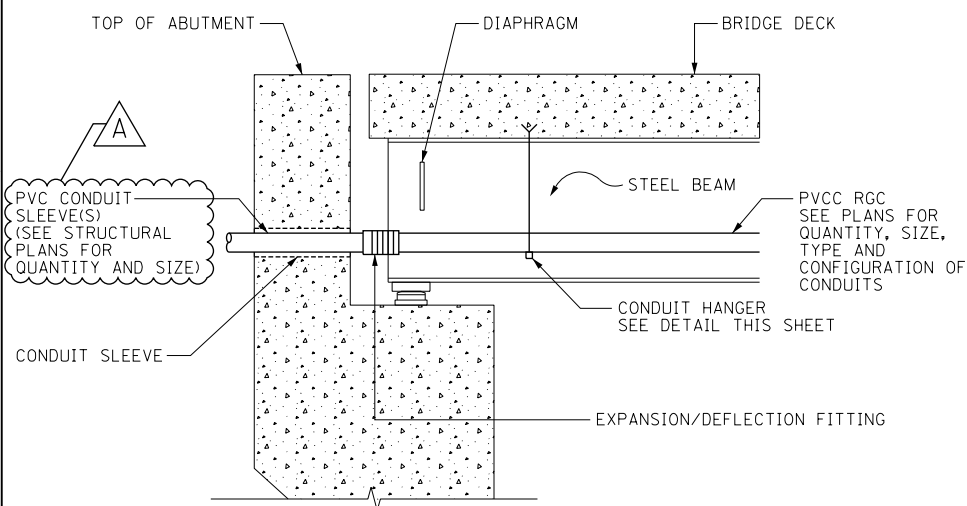


TYPICAL CONDUIT INSTALLATION THROUGH ABUTMENT WALL
SCALE: NOT TO SCALE

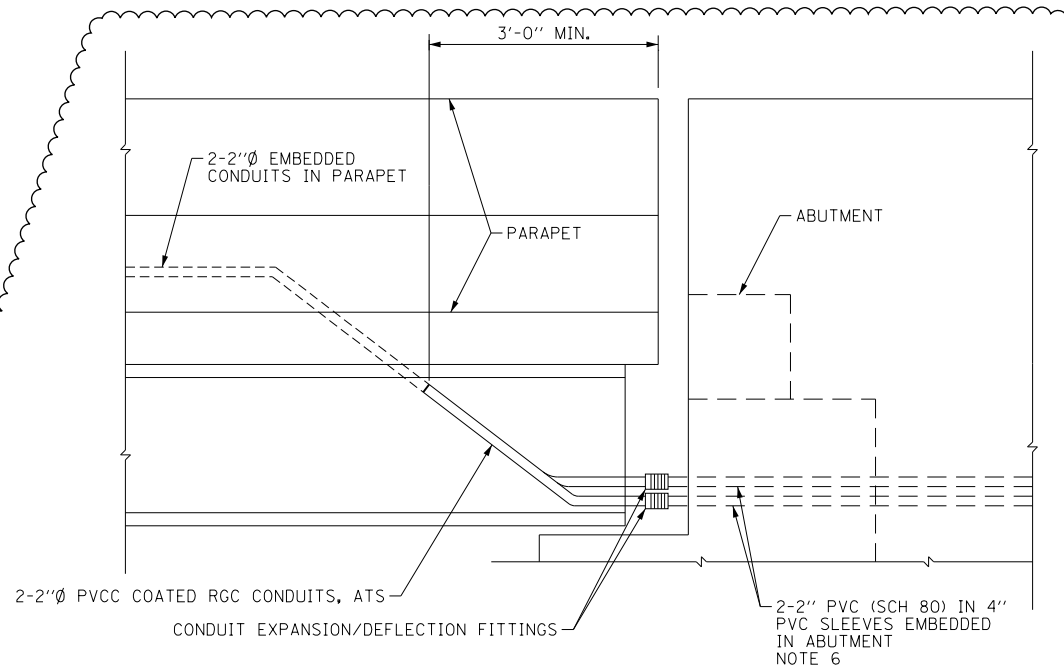

EMBEDDED BRIDGE CONDUIT DETAIL-A
SCALE: NOT TO SCALE

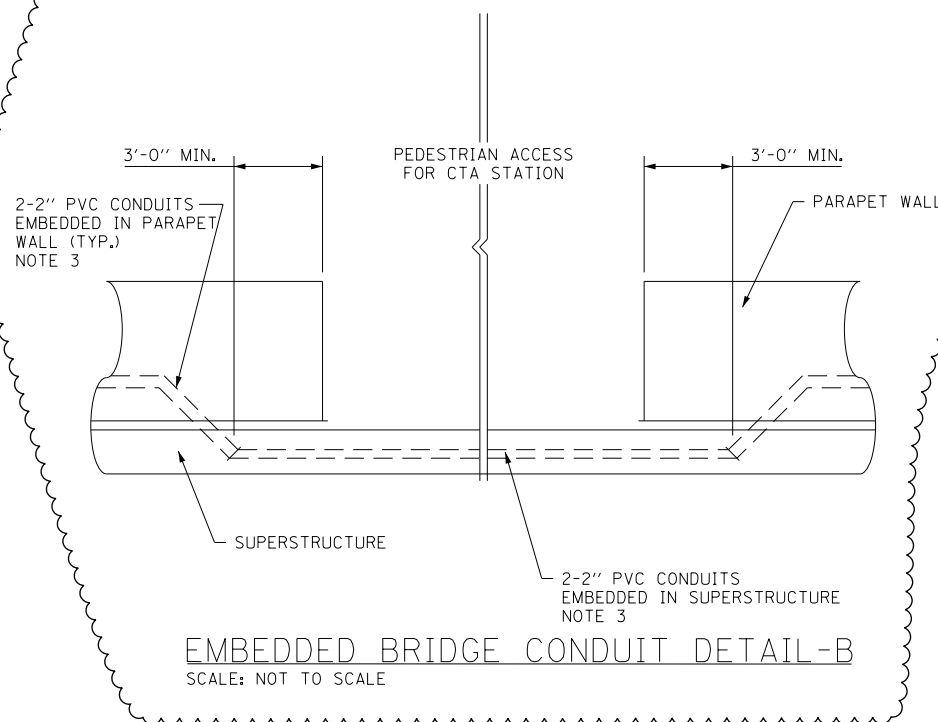

EMBEDDED BRIDGE CONDUIT DETAIL-B
SCALE: NOT TO SCALE

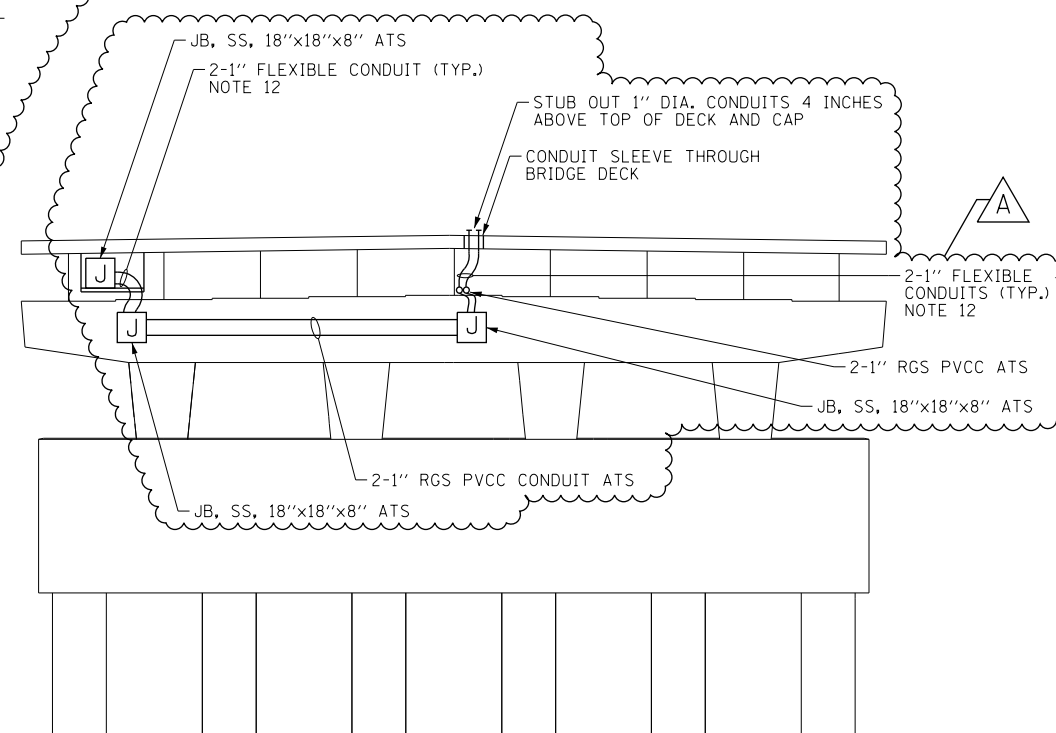

CONDUIT INSTALLATION PLAN - PIER 2 (LOOKING NORTH)
SCALE: NOT TO SCALE

NOTES:

- SEE DRAWING E-01 FOR IDOT ELECTRICAL SYMBOLS.
- 2" PVCC CONDUITS SHALL HAVE A MINIMUM BENDING RADIUS OF 10".
- SEE STRUCTURAL PLANS FOR LOCATION OF EMBEDDED CONDUITS.
- JUNCTION BOXES SHALL HAVE A 1 1/2" WIRE MESH DRAIN IN THE BOTTOM.
- WEATHERPROOF FLEXIBLE CONDUIT WILL NOT BE PAID FOR SEPARATELY, BUT SHALL BE CONSIDERED AS INCLUDED IN THE PRICE FOR "CONDUIT EMBEDDED IN STRUCTURE" PAY ITEM. COST OF 4" SLEEVES IS INCLUDED WITH CONCRETE STRUCTURES.
- COORDINATE THE LOCATION OF THE CONDUITS ROUTED THROUGH THE ABUTMENT WITH THE LOCATION OF THE SLEEVE OPENINGS SHOWN ON THE STRUCTURAL PLANS.
- SEE PLAN DRAWINGS FOR THE PROPOSED CONDUIT ROUTING.
- ALL MOUNTING HARDWARE FOR CONDUIT SUPPORTS AND PVCC RGC MUST BE PVC COATED.
- THE CONTRACTOR MUST USE APPROVED SINGLE COIL FLARED LOOP INSERTS WHEN PENDANT MOUNTING THREADED RODS TO A NEW BRIDGE DECK. THE FLARED LOOP INSERTS MUST BE CAST INTO THE CONCRETE DECK. THE CONTRACTOR IS RESPONSIBLE FOR LOCATING AND COORDINATING THE INSERT LOCATIONS WITH THE BRIDGE DECK CONTRACTOR.
- THE CONTRACTOR MUST COORDINATE THREADED ROD END SIZES WITH THE C-CHANNEL AND FLARED LOOP INSERT MANUFACTURERS.
- THE CONDUIT SUPPORT SYSTEM ATTACHED TO THE BRIDGE DECK, INCLUDING THE INSERTS, WILL NOT BE PAID FOR SEPARATELY, BUT SHALL BE CONSIDERED AS INCLUDED IN THE PRICE FOR THE "CONDUIT ATTACHED TO STRUCTURE" PAY ITEM.
- WEATHERPROOF FLEXIBLE CONDUIT WILL NOT BE PAID FOR SEPARATELY, BUT SHALL BE CONSIDERED AS INCLUDED IN THE PRICE FOR "CONDUIT ATTACHED TO STRUCTURE" PAY ITEM.

FILE PATH = p:\388035\part1\ascomon\me\local\p\AECD000\Documents\01_Americas\Transportation\66269938_Circle\Phase_1\000_CAD\016_Electrical\Sheets\60W29_sht-Light-12



D160W29-sht-Light-12
USER NAME = BAW\rtort
PLOT SCALE = 2.0000' / in.
PLOT DATE = 12/19/2013

DESIGNED - WDS
DRAWN - CAM
CHECKED - WDS
DATE - 10/30/2013
REVISED - 12/18/2013



**STATE OF ILLINOIS
DEPARTMENT OF TRANSPORTATION**

MISCELLANEOUS ELECTRICAL DETAILS

SCALE: N.T.S. SHEET 12 OF 19 SHEETS STA. TO STA.

F.A.I. RTE.	SECTION	COUNTY	TOTAL SHEETS	SHEET NO.
90/94/290	2013-01R	COOK	356	122
CONTRACT NO. 60W29			ILLINOIS FED. AID PROJECT	

FILE PATH = p:\388035-p\m\l\ec\com\l\ne\local\p\AECDWG\Documents\01_Americas\Transportation\60269938_Circle\Phase_1\1000_CAD\016_Electrical\Sheets\60W29_sht-Light-13

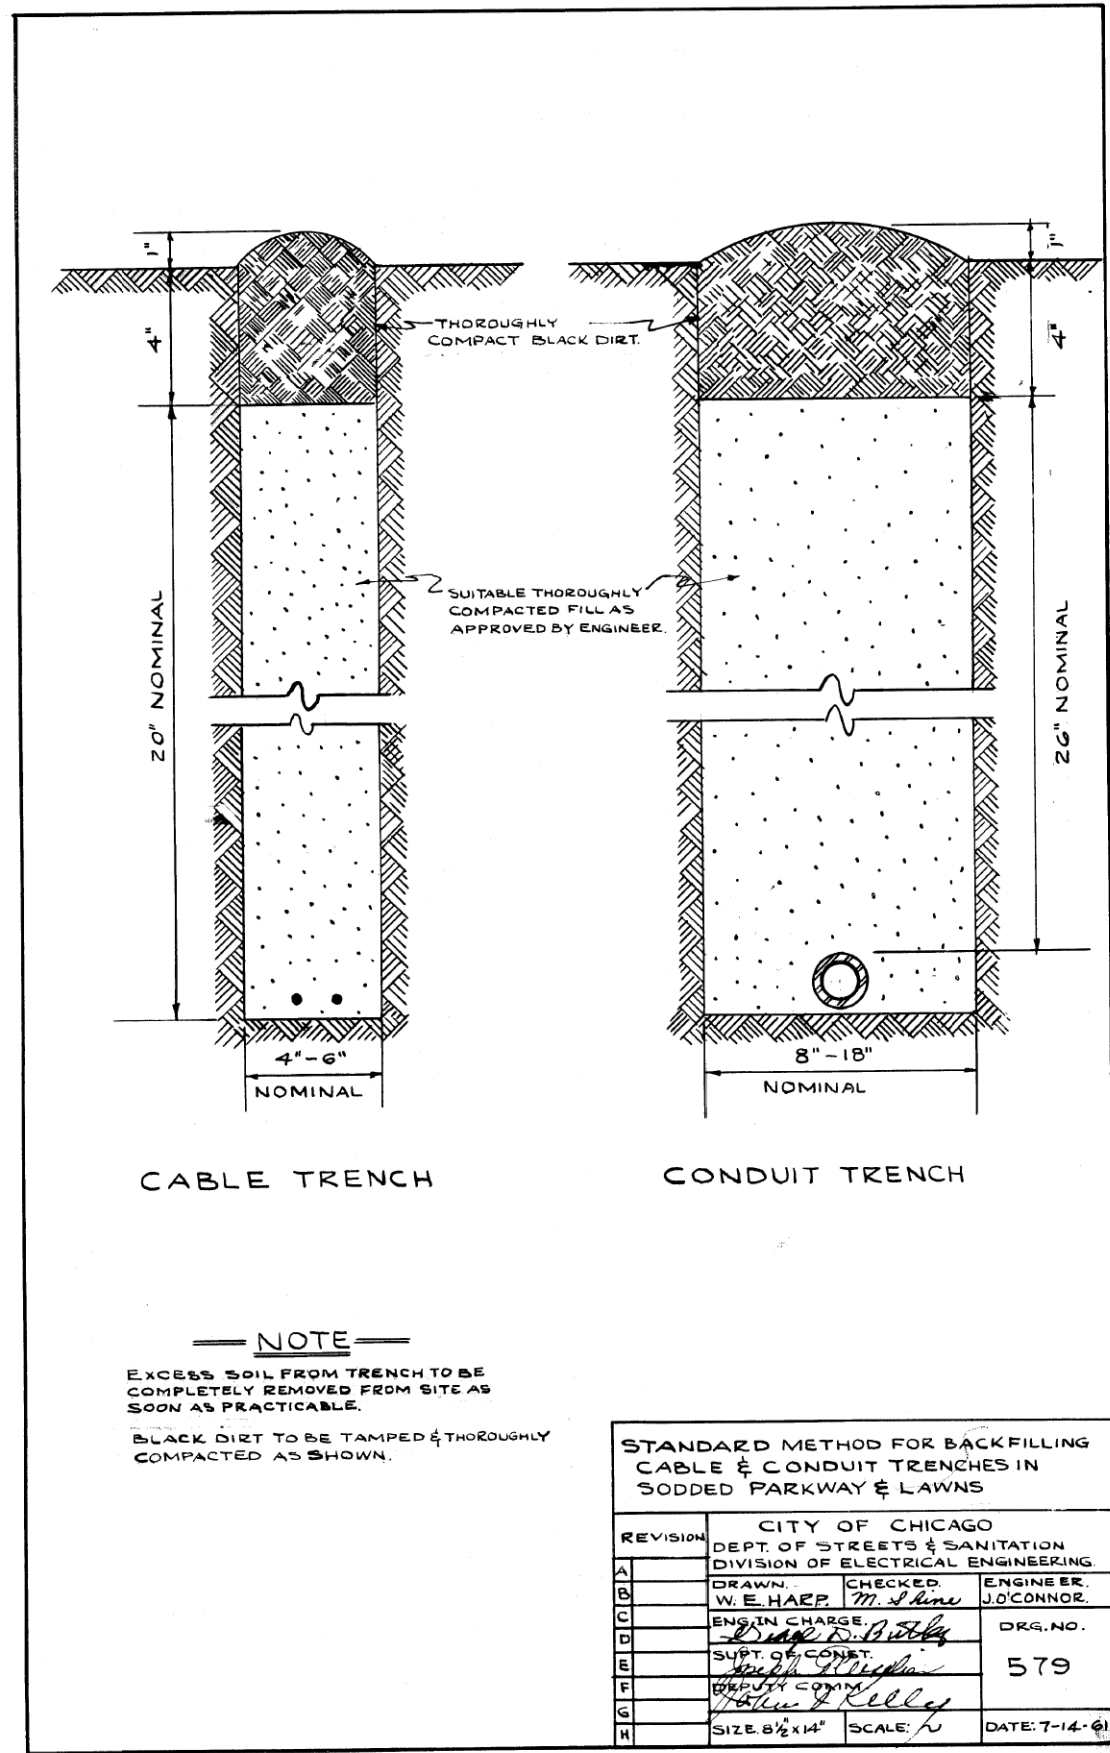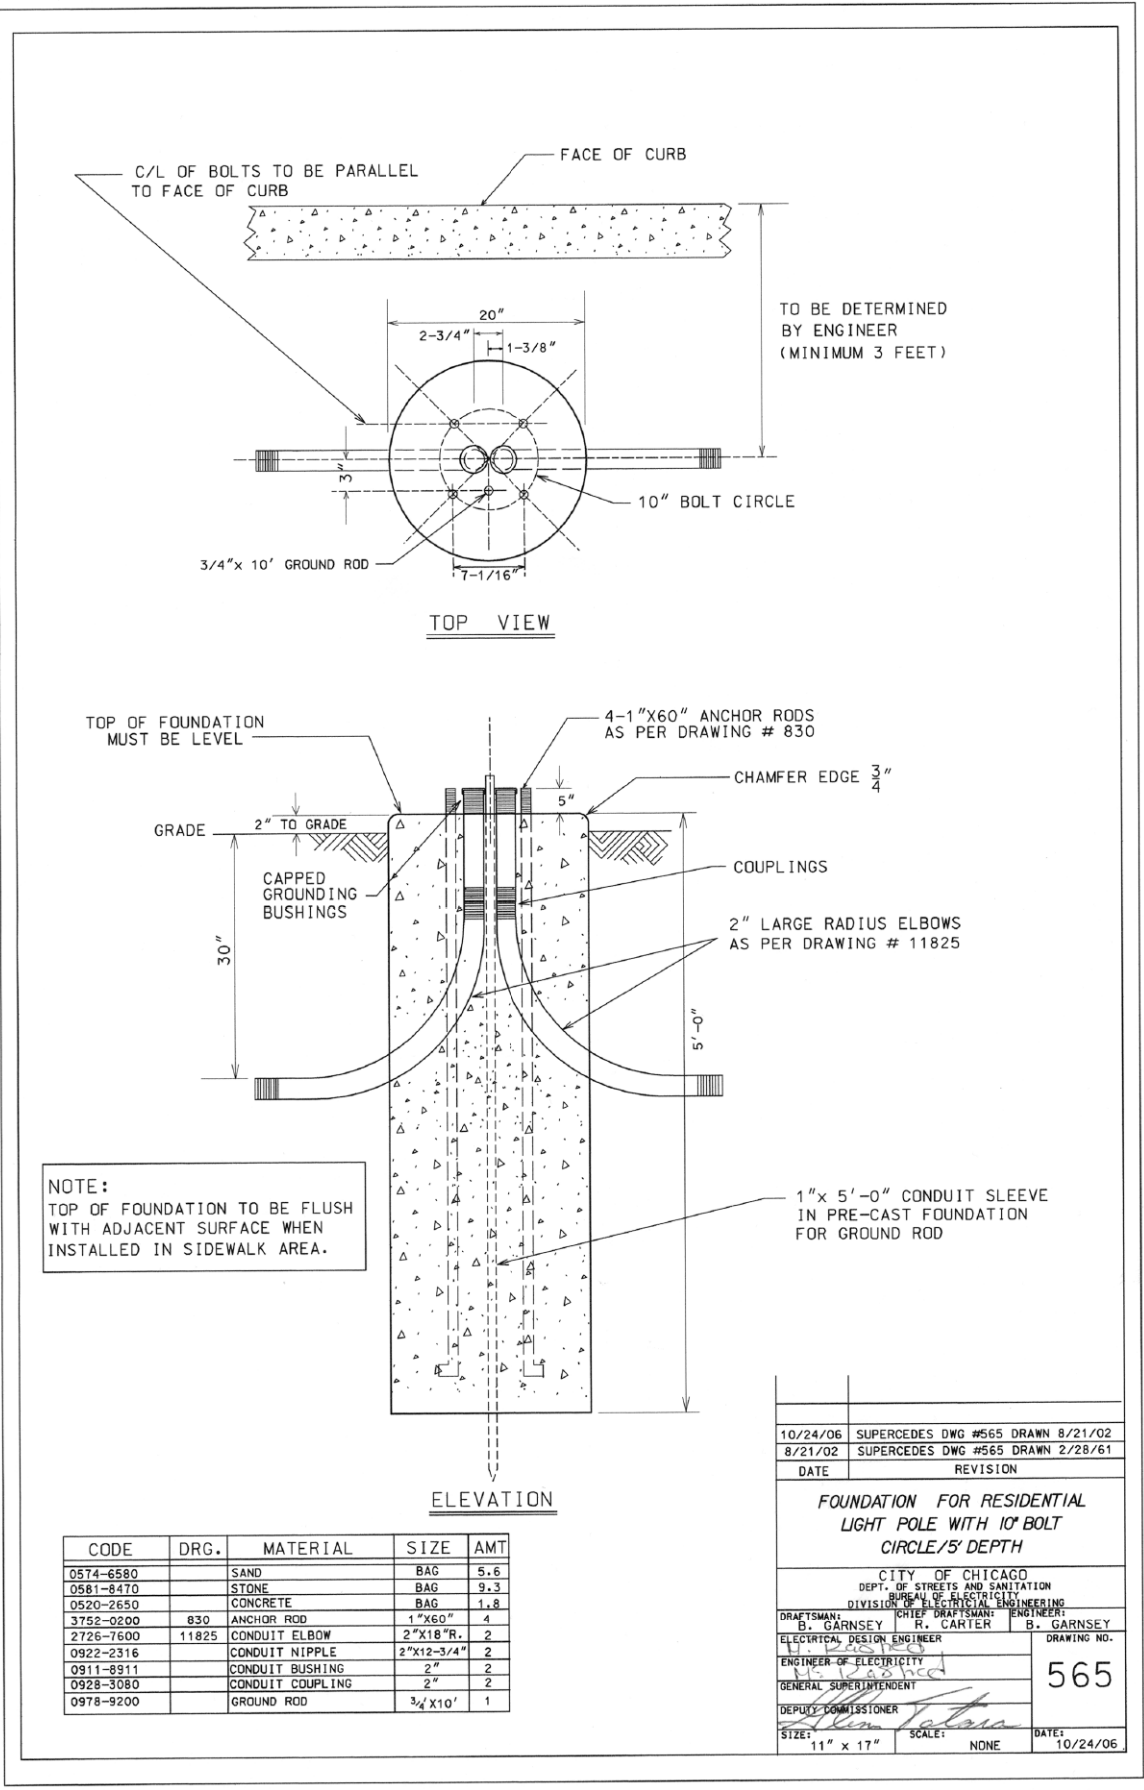

J:\ALL 2\STANDARD\565.DGN 12/11/2006 10:56:45 AM



D160W29-sht-Light-13
USER NAME = BAW:tor t
PLOT SCALE = 2.0000 ' / in.
PLOT DATE = 10/28/2013

DESIGNED - WDS
DRAWN - CAM
CHECKED - WDS
DATE - 10/30/2013

REVISED -
REVISED -
REVISED -
REVISED -

STATE OF ILLINOIS
DEPARTMENT OF TRANSPORTATION

MISCELLANEOUS ELECTRICAL DETAILS

SCALE: N.T.S. SHEET 13 OF 19 SHEETS STA. TO STA.

F.A.I. R.E.	SECTION	COUNTY	TOTAL SHEETS	SHEET NO.
90/94/290	2013-011R	COOK	356	123
ILLINOIS FED. AID PROJECT			CONTRACT NO. 60W29	




DI60W29-sht-Light-14	DESIGNED - WDS	REVISED -
USER NAME = BAWtor1	DRAWN - CAM	REVISED -
PLOT SCALE = 2.0000' / in.	CHECKED - WDS	REVISED -
PLOT DATE = 10/28/2013	DATE - 10/30/2013	REVISED -

STATE OF ILLINOIS
DEPARTMENT OF TRANSPORTATION


MISCELLANEOUS ELECTRICAL DETAILS

SCALE: N.T.S. SHEET 14 OF 19 SHEETS STA. TO STA.


F.A.I. R.E.	SECTION	COUNTY	TOTAL SHEETS	SHEET NO.
90/94/290	2013-011R	COOK	356	124
CONTRACT NO. 60W29			ILLINOIS FED. AID PROJECT	

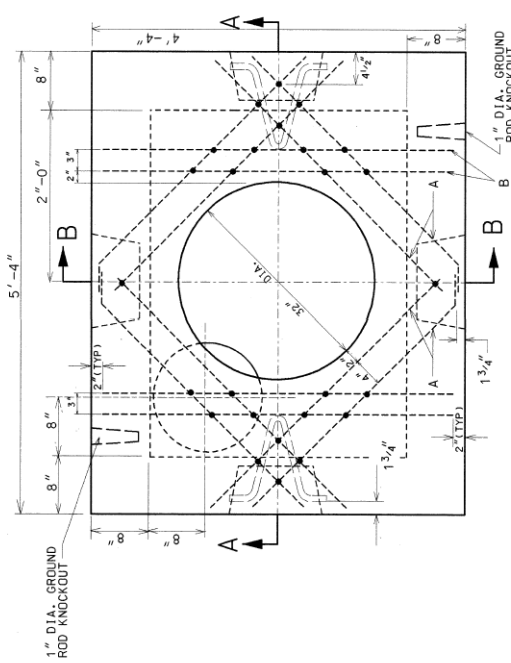

ROOF PLAN

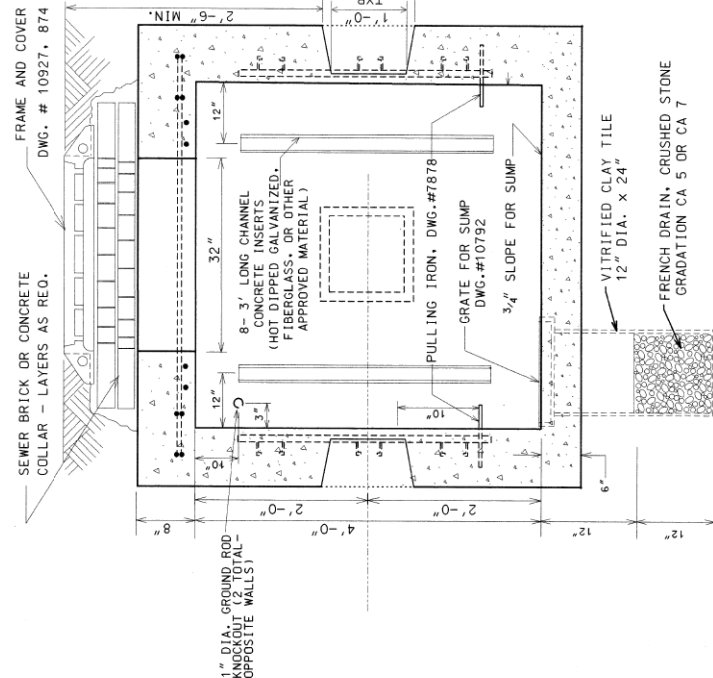

SECTION A-A

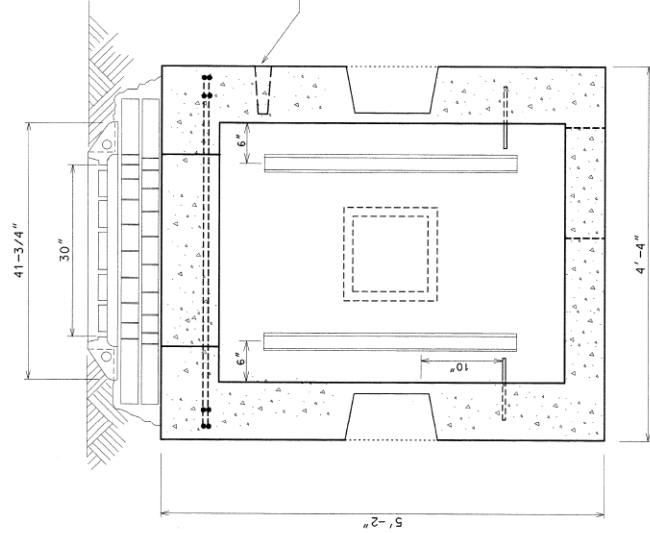

SECTION B-B

EXCAVATION (CONSTRUCTION INFORMATION)

COMPLETE MANHOLE	5.0 CU. YDS.
NEW ROOF ONLY	2.0 CU. YDS.
SHEETING MANHOLE	150.0 50' FT.

#5 REINFORCING BARS

BAR	LENGTH	NO. OF BARS	TOTAL FT.
A	2'-9"	8	22'-0"
B	4'-0"	4	16'-0"

MATERIALS FOR ROOF ONLY


CONCRETE	0.5 CU. YDS.
REINFORCING BARS #5	38'

DRG.	MATERIAL	CODE	SIZE	No. Req.
	FORM FOR MANHOLE	17-6874-6000	3'x4'x4'	1
	CONDUIT END BELL	17-6445-3320	AS REQ.	
	TILE - SEWER	39-4036-3200	12"/24"	
	SLAB BOLSTER	20-5472-9650	3/4" x 38'	
	TIE WIRE	13-9938-6106	#20GA.35'	
7878	PULLING IRON	02-4483-6370	3/4" x 2	
	CONCRETE	05-3267-2940	3 CU. YDS.	
	SEWER BRICK	05-1452-9720	370. 50	
10792	GRATE FOR SUMP	02-4368-7100	15" x 15" x 1	
	GROUND ROD	09-7796-9200	3/4" x 10'	
	GROUND ROD CLAMP	09-2636-3240	3/4" x 1	
	CRUSHED STONE	05-9057-5471	3/4" x ONE LINE	
874	MANHOLE FRAME	02-4299-5524	30" x 1	
10927	MANHOLE COVER	02-4574-5040	30" x 1	
	CONC. CHANNEL INSERT	02-4574-5040	3" x 8	

- NOTES:
1. PRECAST MANHOLES MUST BE PROVIDED WITH CHANNEL INSERTS, PULLING IRONS, AND CONDUIT KNOCK-OUTS.
 2. ALL CONCRETE MUST BE PORTLAND CEMENT CONCRETE MEETING LOCAL REQUIREMENTS FOR CONCRETE FOR PRE-CAST STRUCTURES, OR CLASS S1 CONCRETE FOR CAST-IN-PLACE STRUCTURES.
 3. REINFORCING BARS MUST MEET ASTM A615 GRADE 60.

8/21/02 SUPERCEDES DWG. 729 DATED JAN 12, 1996	REVISION
1/12/96 SUPERCEDES DWG. 729 DATED NOV. 21, 1973	REVISION
3' x 4' x 4'	
CONCRETE MANHOLE WITH 30" FRAME AND COVER	
CITY OF CHICAGO DEPT. OF STREETS & SANITATION BUREAU OF ELECTRICITY DIVISION OF ELECTRICAL ENGINEERING	
DRAFTSMAN: R. CARTER	DRAWING NO. 729
ELECTRICAL DESIGN ENGINEER: B. GARNSEY	DATE: 9/21/02
ENGINEER IN CHARGE: B. GARNSEY	SCALE: NONE
DEPUTY ADMINISTRATOR: [Signature]	SIZE: 11" x 22"

NOTE: TERMINATE ALL METALLIC CONDUIT WITH GROUNDING BUSHING & GROUND TO GROUND ROD WHEN METALLIC CONDUIT IS USED DELETED GROUNDING CONDUCTOR

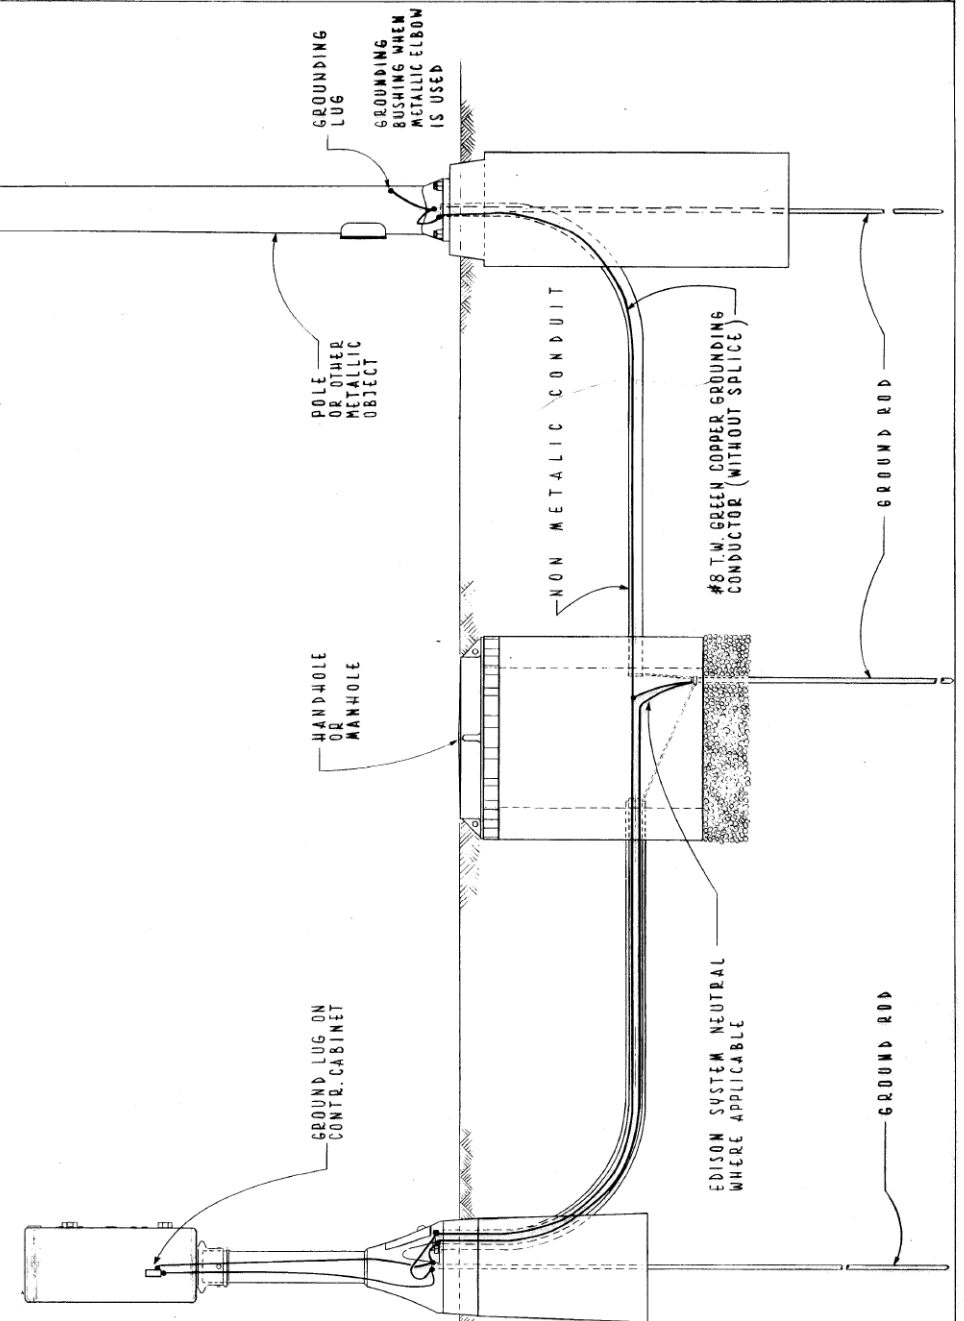


TYPICAL GROUNDING METHODS FOR BUREAU OF ELECTRICITY EQUIPMENT

CITY OF CHICAGO
DEPT. OF STREETS & SANITATION
BUREAU OF ELECTRICITY
DIVISION OF ELEC. ENGINEERING

REVISED	DRAWN: E. GERULIS	CHECKED: M. SHINE	ENGINEER: J. O'CONNOR
A	ENG. OF ELEC.		DWG. NO. 736
B	SUPT. OF CONST.		
C	PER. OF CONST.		
D	PER. OF CONST.		
E	PER. OF CONST.		
F	PER. OF CONST.		


SIZE: 8 1/2" x 14" SCALE: 1" = 10' DATE: 5-17-76

CONDUIT INSTALLATION UNDER PAVED STREET

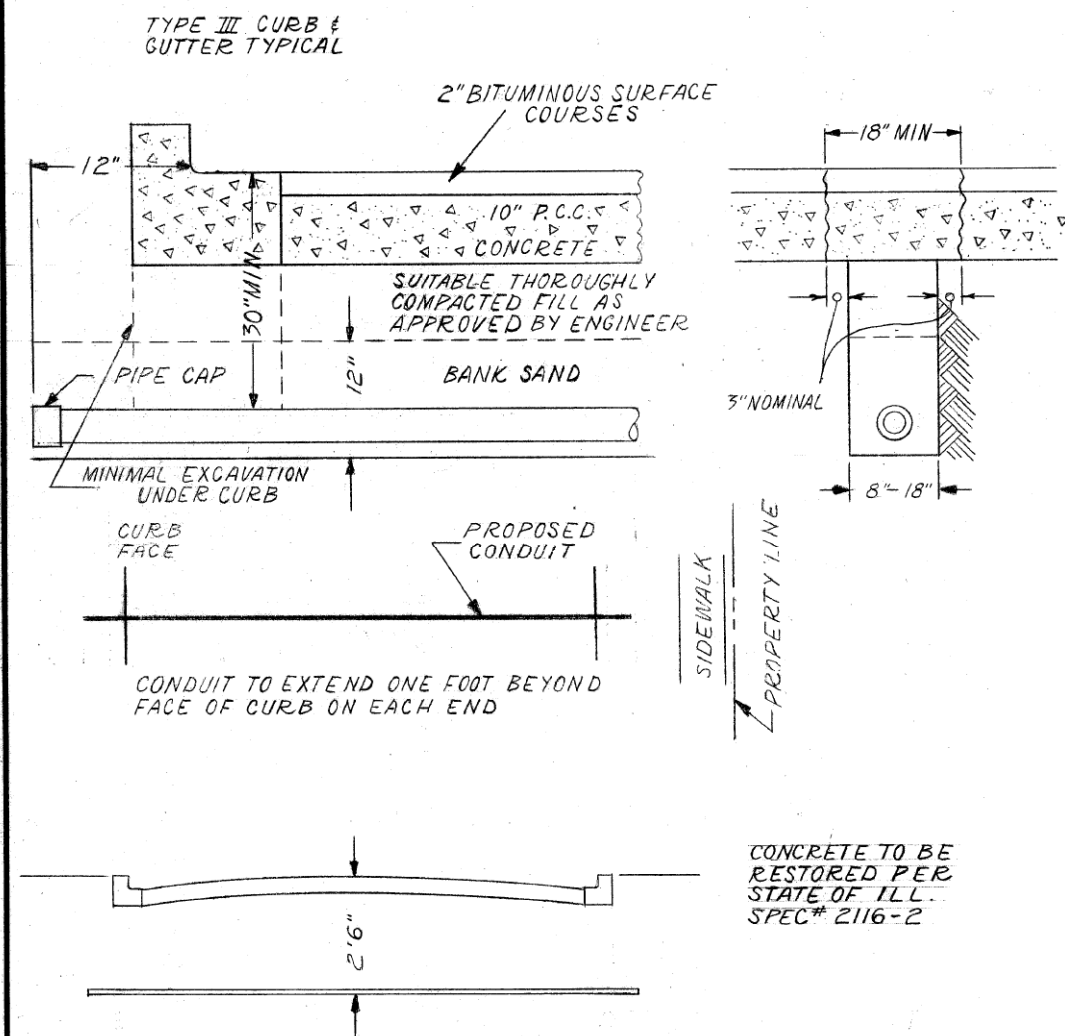

INSTALLATION METHOD OF INSTALLING CONDUIT UNDER PAVED ROADWAY		
CITY OF CHICAGO DEPT. OF STREETS AND SANITATION BUREAU OF ELECTRICITY DIVISION OF ELECTRICAL ENGINEERING		
DRAWN A.M. JOHNSON	CHECKED R. SYCKOWSKI	ENGINEER R.L. MARTIN
 THOMAS HILDUFF ENGINEER OF ELECTRICITY		DRG. NO. 813
 CHARLES E. BUNKLEY DEPT. OF STREETS DEPUTY COMM.		DATE 3-13-81
SIZE 8 1/2" X 14"	SCALE N.T.S.	DATE 3-13-81

CONDUIT INSTALLATION THROUGH EXISTING
MANHOLE OR HANDHOLE WALL

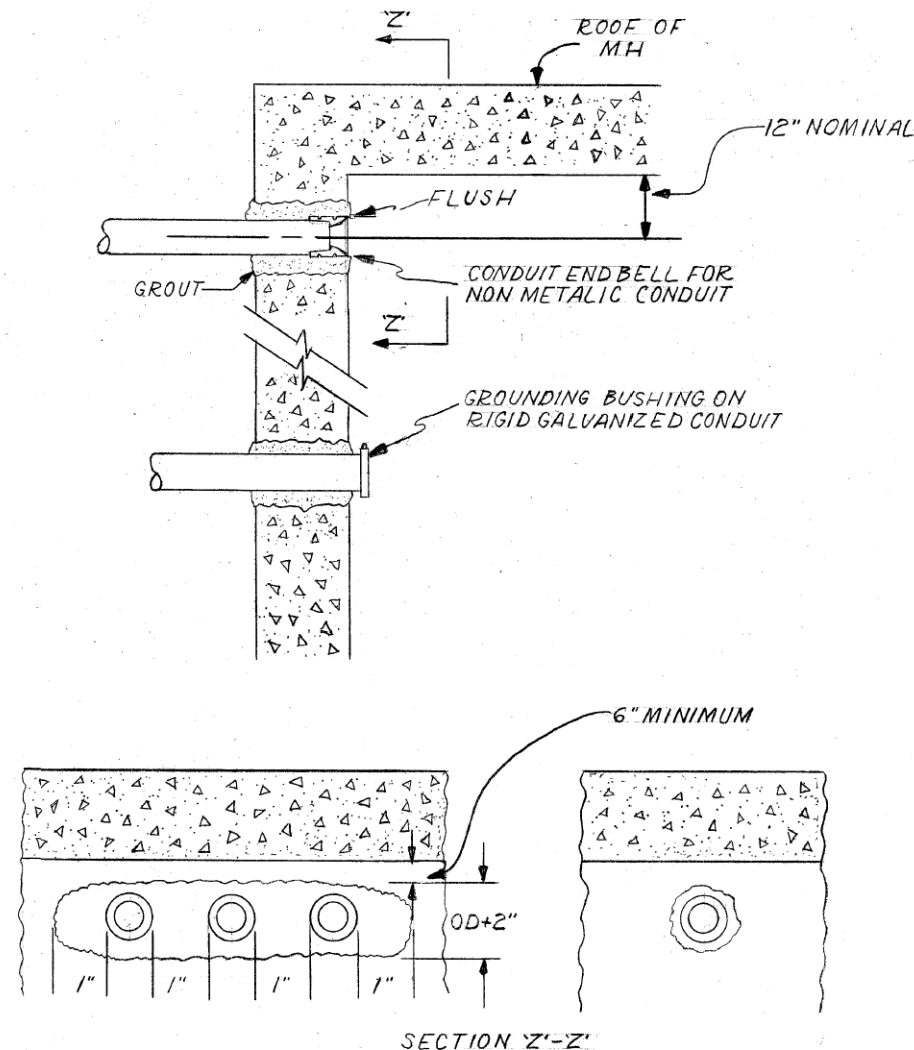

OPENING THROUGH WALL TO BE KEPT TO MINIMUM SIZE TO ADMIT CONDUIT AND SUFFICIENT GROUT TO ASSURE SEALING WALL.

INSTALLATION METHOD OF INSTALLING CONDUIT THRU MANHOLE WALL		
CITY OF CHICAGO DEPT. OF STREETS AND SANITATION BUREAU OF ELECTRICITY DIVISION OF ELECTRICAL ENGINEERING		
DRAWN A.M. JOHNSON	CHECKED R. SYCKOWSKI	ENGINEER R.L. MARTIN
 THOMAS HILDUFF ENGINEER OF ELECTRICITY		DRG. NO. 814
 CHARLES E. BUNKLEY DEPT. OF STREETS DEPUTY COMM.		DATE 3-13-81
SIZE 8 1/2" X 14"	SCALE N.T.S.	DATE 3-13-81

STATE OF ILLINOIS
DEPARTMENT OF TRANSPORTATION

MISCELLANEOUS ELECTRICAL DETAILS

SCALE: N.T.S. SHEET 15 OF 19 SHEETS STA. TO STA.

F.A.I. RTE. 90/94/290	SECTION 2013-011R	COUNTY COOK	TOTAL SHEETS 356	SHEET NO. 125
CONTRACT NO. 60W29				
ILLINOIS FED. AID PROJECT				

D160W29-sht-Light-15	DESIGNED - WDS	REVISED -
USER NAME = BAW:tor1	DRAWN - CAM	REVISED -
PLOT SCALE = 2.0000' / in.	CHECKED - WDS	REVISED -
PLOT DATE = 10/28/2013	DATE - 10/30/2013	REVISED -



DI60W29-sht-Light-17
 USER NAME = BAW:tor t
 PLOT SCALE = 2.0000' / in.
 PLOT DATE = 10/28/2013

DESIGNED - WDS
 DRAWN - CAM
 CHECKED - WDS
 DATE - 10/30/2013

REVISED -
 REVISED -
 REVISED -
 REVISED -

STATE OF ILLINOIS
 DEPARTMENT OF TRANSPORTATION


MISCELLANEOUS ELECTRICAL DETAILS

SCALE: N.T.S. SHEET 17 OF 19 SHEETS STA. TO STA.

F.A.I. R.T.E.	SECTION	COUNTY	TOTAL SHEETS	SHEET NO.
90/94/290	2013-011R	COOK	356	127
CONTRACT NO. 60W29			ILLINOIS FED. AID PROJECT	

INSTALLATION NOTES


- STEP 1. COAT EXPOSED PORTION OF ANCHOR BOLTS WITH APPROVED ANTI RUSTING GREASE ("60" OR EQUAL).
- STEP 2. INSTALL LOWER LEVELLING NUTS & WASHERS, SET AT APPROPRIATE LEVEL. USE TABLE FOR APPROPRIATE NUTS.
- STEP 3. MOUNT POLE OR PEDESTAL, ATTACH TOP WASHERS AND NUTS HAND TIGHT.
- STEP 4. TIGHTEN CONDUIT BUSHING, ALL MASTARMS, STREET LIGHTS, TO POLE & TIGHTEN ALL NUTS.
- STEP 5. ATTACH NUT COVERS WHERE REQUIRED.
- STEP 6. DO NOT SCROUT IN SPACES BETWEEN BOTTOM OF POLE & TOP OF FOUNDATION. TOP OF FOUNDATION OR SURFACE OF SIDEWALK MUST BE LEFT CLEAN AND SMOOTH.
- STEP 7. POLE OR PEDESTAL IS TO BE PERFECTLY PLUMB. NO "KANE" IS TO BE LEFT.

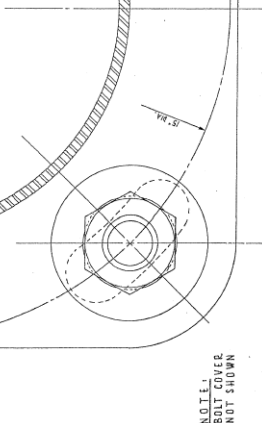

TABLE


IF NECESSARY TO BE TIGHTENED WITH RAIN ANCHOR BOLT AS THIS PRACTICALLY REDUCES THE TENSILE STRENGTH OF ANCHOR BOLT. COAT ANCHOR BOLT WITH RUST-OLEUM HARD HAT ZINC RICH COMPOUND.

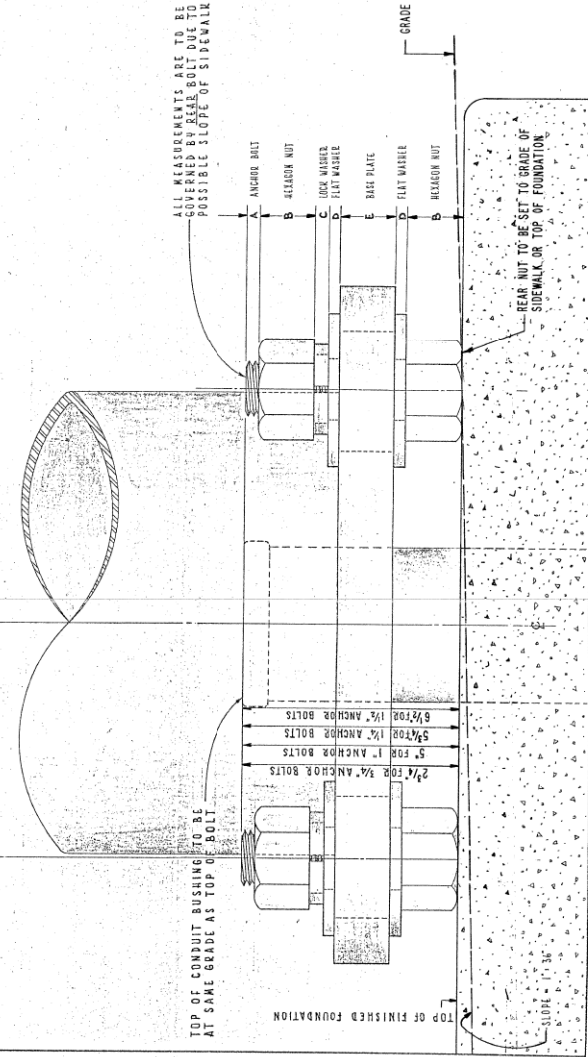


ALL MEASUREMENTS ARE TO BE GOVERNED BY REAR BOLT DUE TO POSSIBLE SLOPE OF SIDEWALK

REAR NUT TO BE SET TO GRADE OF SIDEWALK OR TOP OF FOUNDATION

GRADE OF SIDEWALK

CONSTRUCTION METHOD FOR "DOUBLE-NUT" INSTALLATION OF POLES AND PEDESTALS

CITY OF CHICAGO
 DEPT. OF ELECTRICAL ENGINEERING
 837
 DATE: 10/28/2013

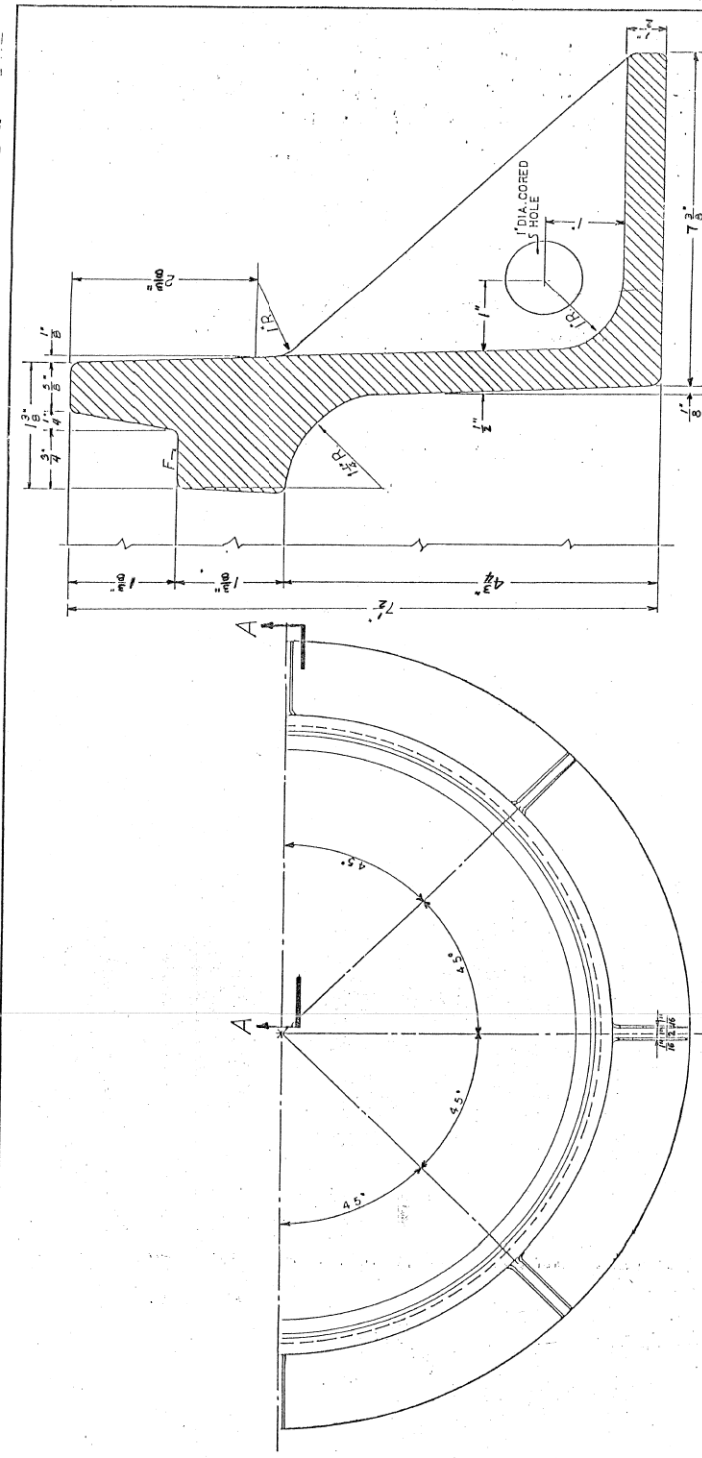


HALF PLAN

MATERIAL - CAST IRON
 ESTIMATED WEIGHT APPROX. 250 LB.

F - DENOTES BEARING SURFACE SHALL BE MACHINED SMOOTH.

TYPICAL SECTION THRU FRAME

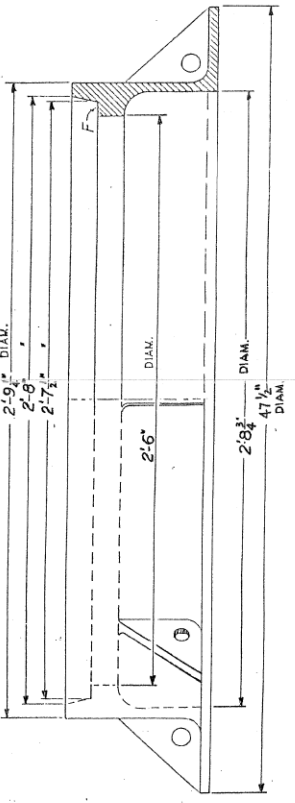

HALF ELEVATION

HALF SECTION AA

COMMODITY CODE NO.

30" CIRCULAR STREET MANHOLE FRAME
 CITY OF CHICAGO
 DEPT. OF ELECTRICAL ENGINEERING
 DIVISION OF ELECTRICAL ENGINEERING
 874
 SUPERSEDES DRG # 10926 G
 DATED 4-6-35



D160W29-sht-Light-18
 USER NAME = BAW1ort
 PLOT SCALE = 2.0000' / in.
 PLOT DATE = 10/28/2013



DESIGNED - WDS
 DRAWN - CAM
 CHECKED - WDS
 DATE - 10/30/2013
 REVISED -
 REVISED -
 REVISED -
 REVISED -

STATE OF ILLINOIS
 DEPARTMENT OF TRANSPORTATION


MISCELLANEOUS ELECTRICAL DETAILS

SCALE: N.T.S. SHEET 18 OF 19 SHEETS STA. TO STA.

F.A.I. R.T.E.	SECTION	COUNTY	TOTAL SHEETS	SHEET NO.
90/94/290	2013-011R	COOK	356	128
CONTRACT NO. 60W29				
ILLINOIS FED. AID PROJECT				

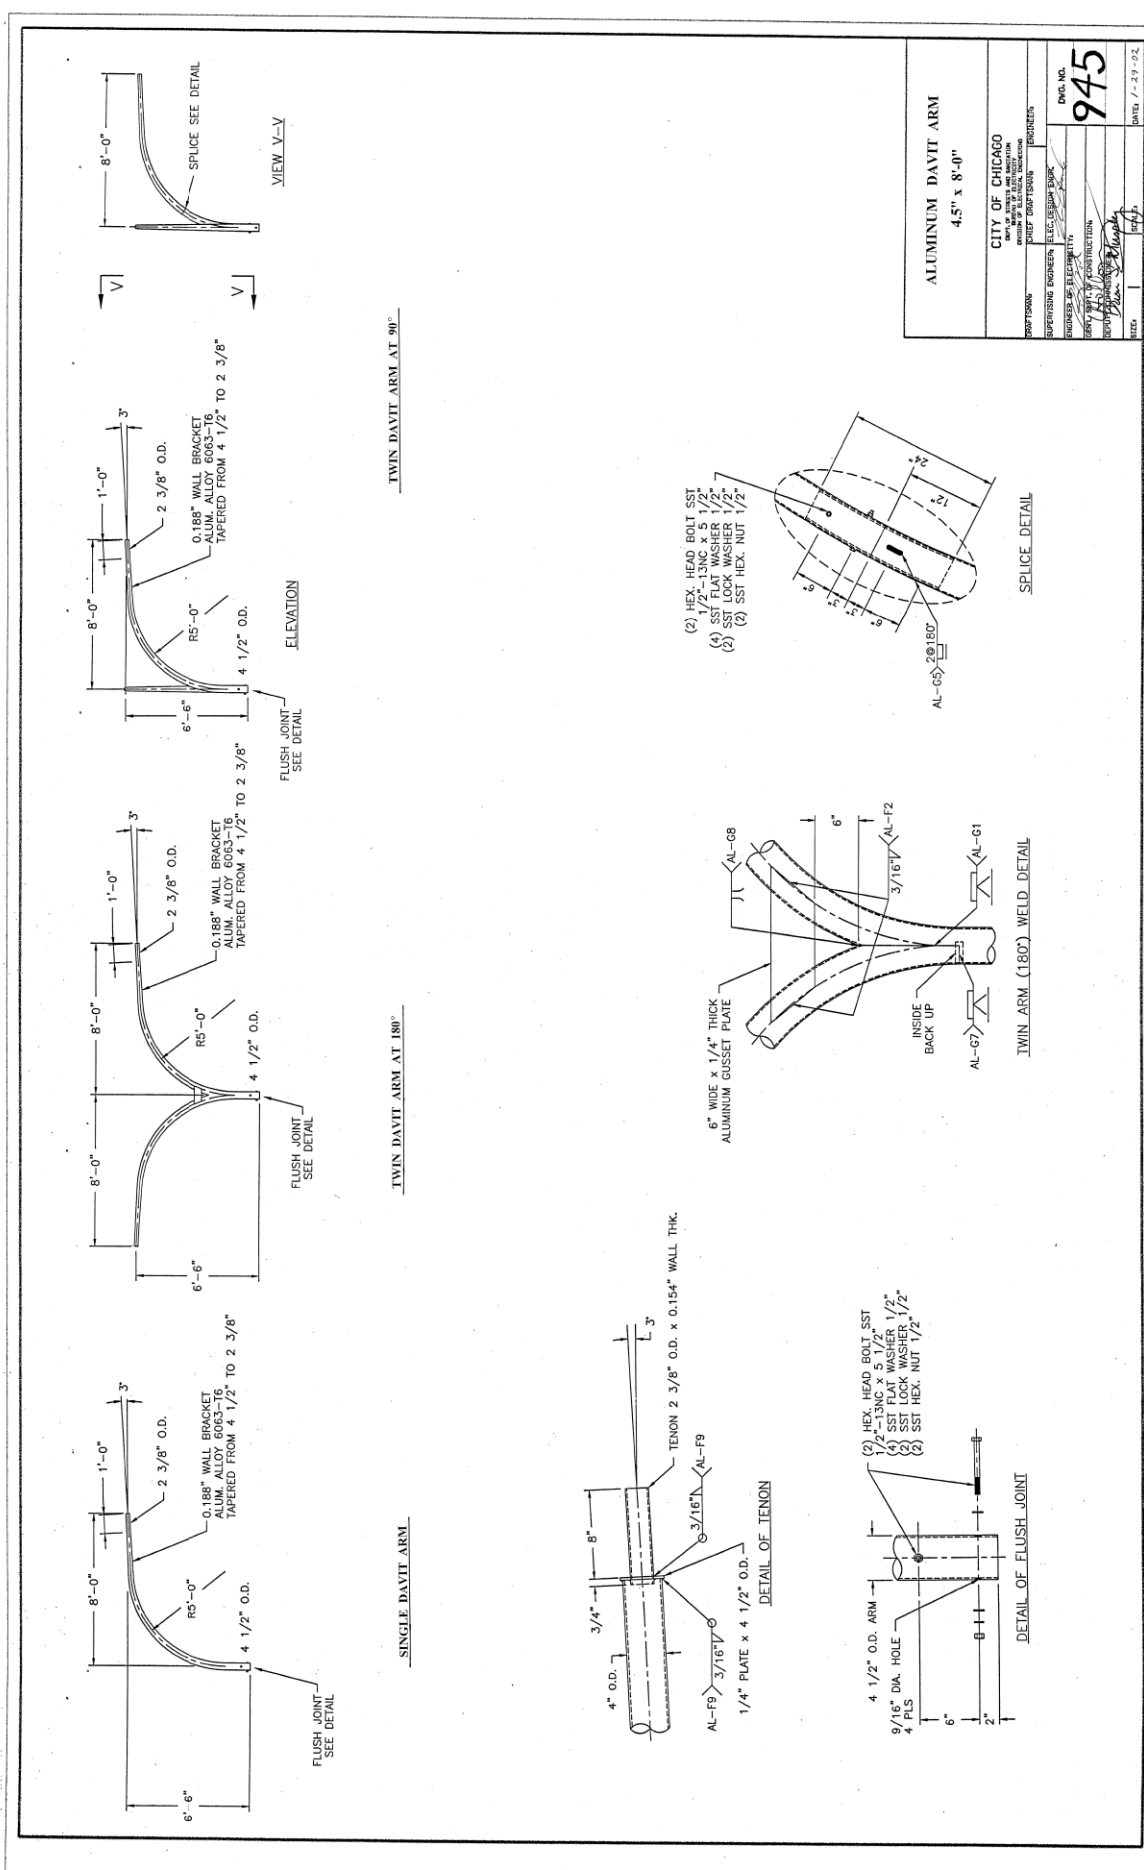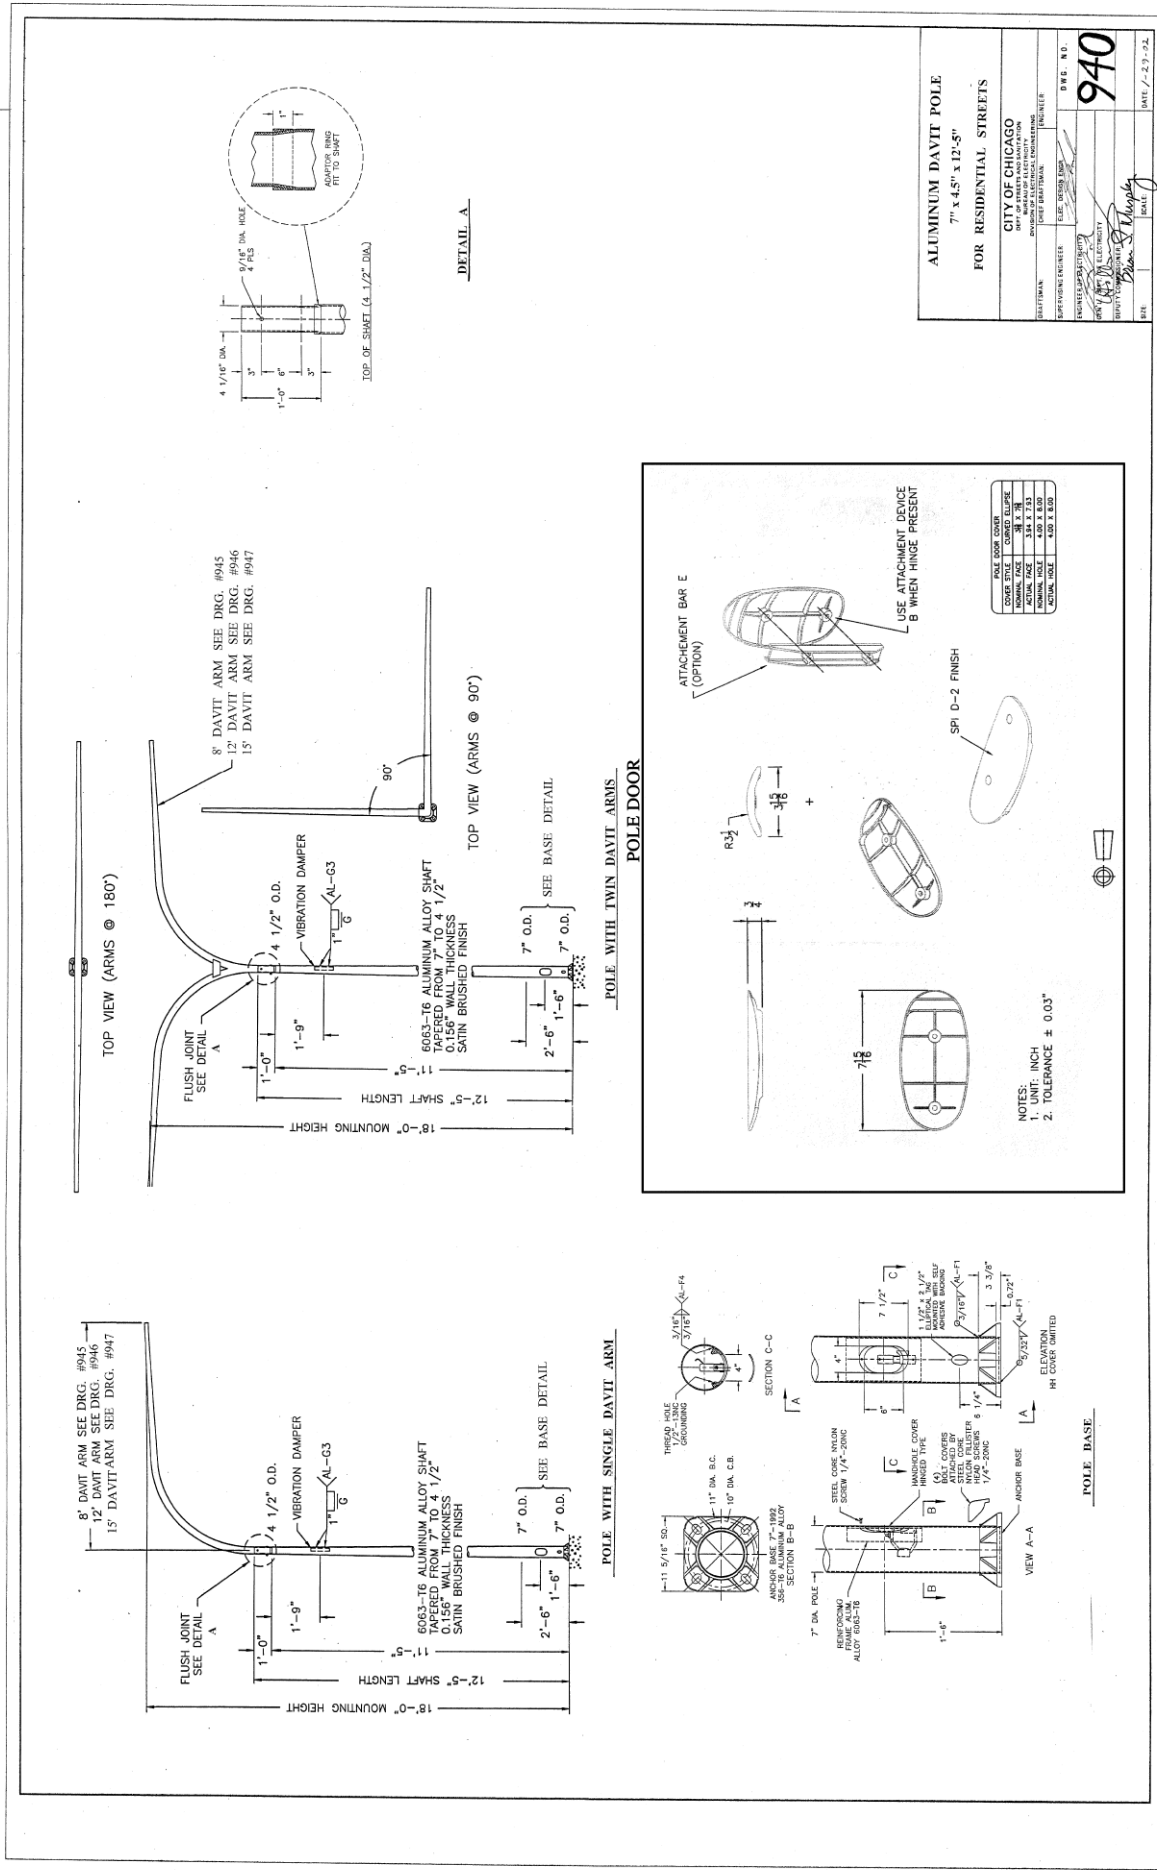


FILE PATH = p:\388035\pmt\aeconom\line\local\p\AECD\00\Documents\01_Americas\Transportation\60269938_Circle\Phase_1\1000_CAD\016_Electrical\Sheets\60W29_Contract\0160W29-sht-Light-19

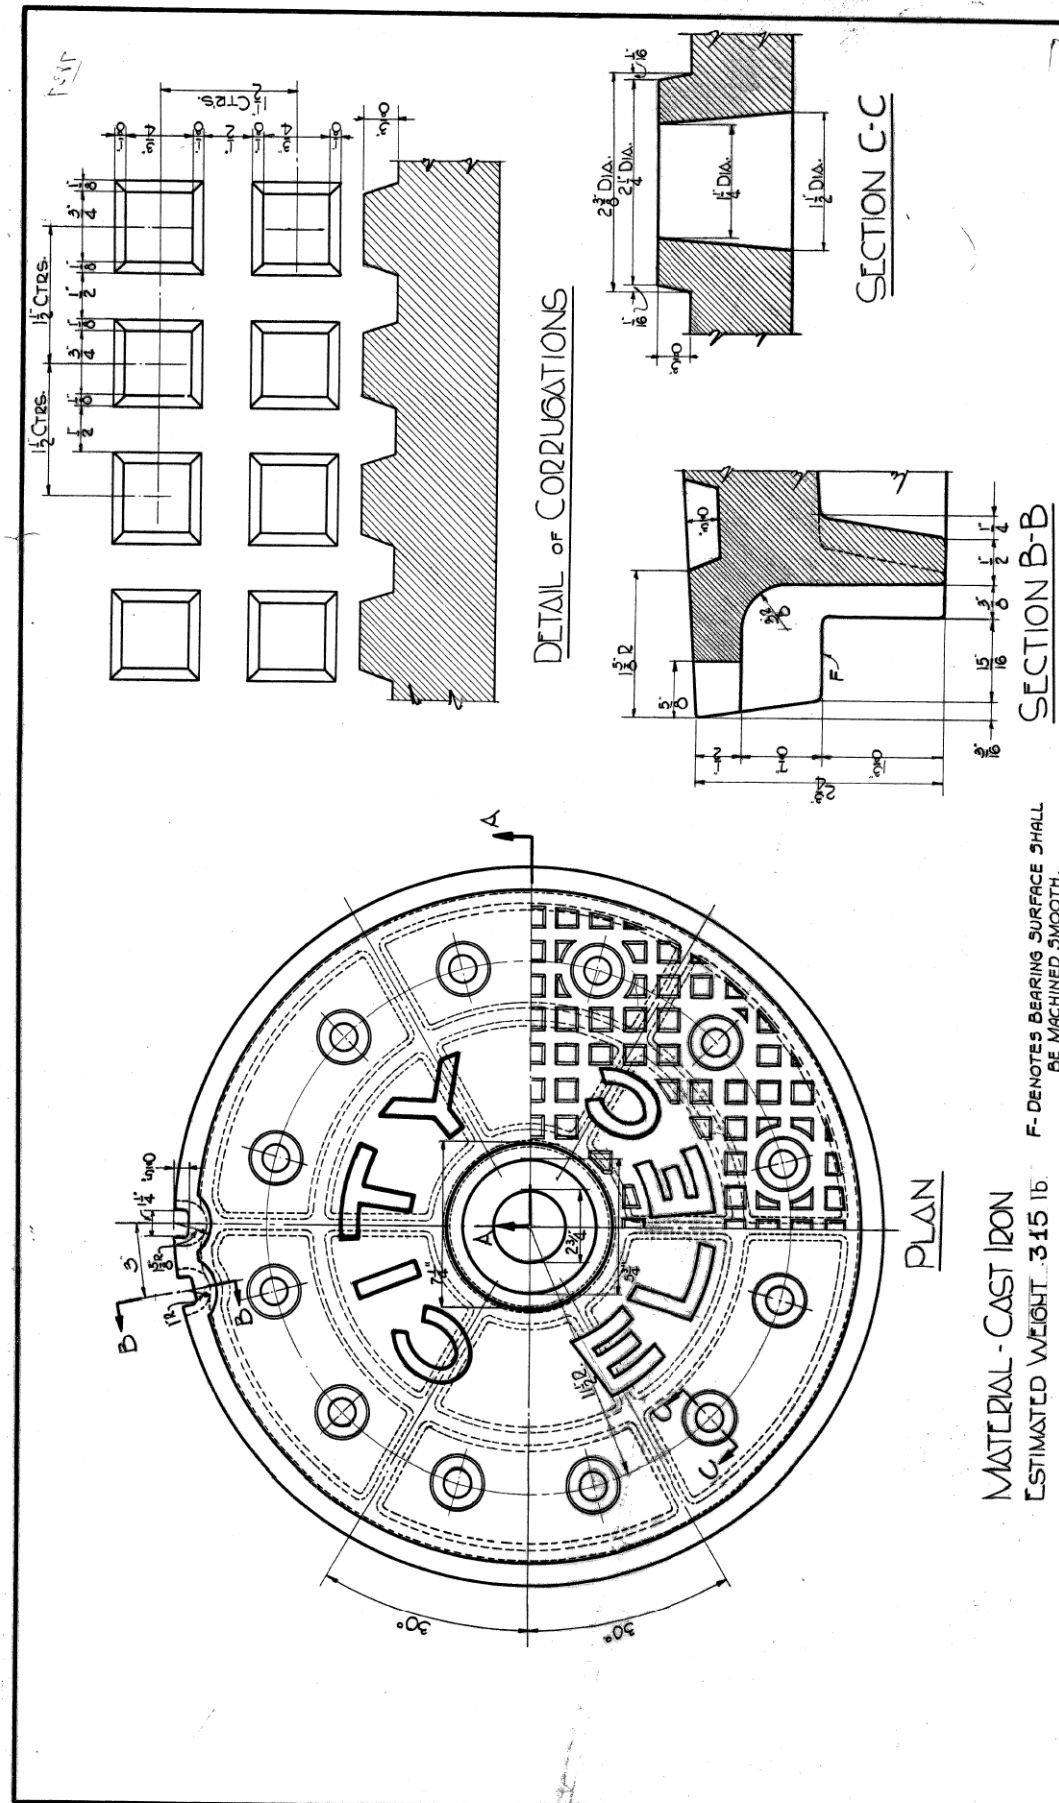


MATERIAL - CAST IRON
ESTIMATED WEIGHT 315 lb

F - DENOTES BEARING SURFACE SHALL BE MACHINED SMOOTH.

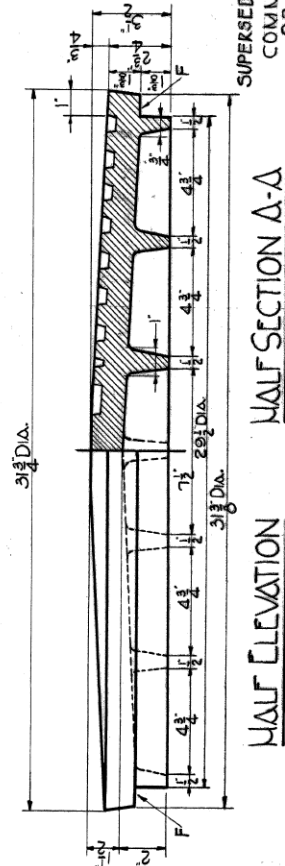



HALF SECTION A-A

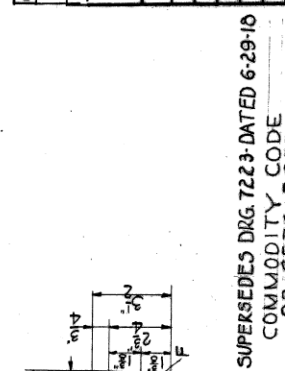


SECTION B-B

DETAIL OF CORRUGATIONS

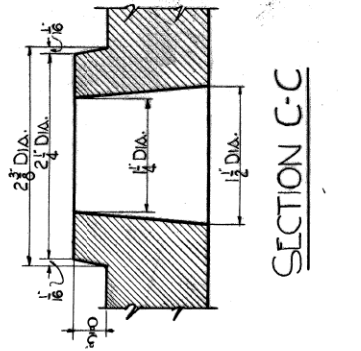

SECTION C-C

WEIGHT	REVISED
IDENTIFICATION LETTERS ON COVER CHANGED	REVISED
30" CIRCULAR STREET MANHOLE COVER	
CITY OF CHICAGO DEPT. OF STREETS AND SANITATION DIVISION OF ELECTRICAL ENGINEERING	
REVISED	DATE
A	12-7-53
B	9-7-79
C	9-9-85
D	
E	
F	
G	
SUPERSEDES DRG. 7223 DATED 6-29-10 COMMODITY CODE 02-4574-5630	
DRAWN BY: <i>[Signature]</i>	
CHECKED BY: <i>[Signature]</i>	
DESIGNED BY: <i>[Signature]</i>	
PROJECT NO. 10927	
SHEET NO. 4-3-84	

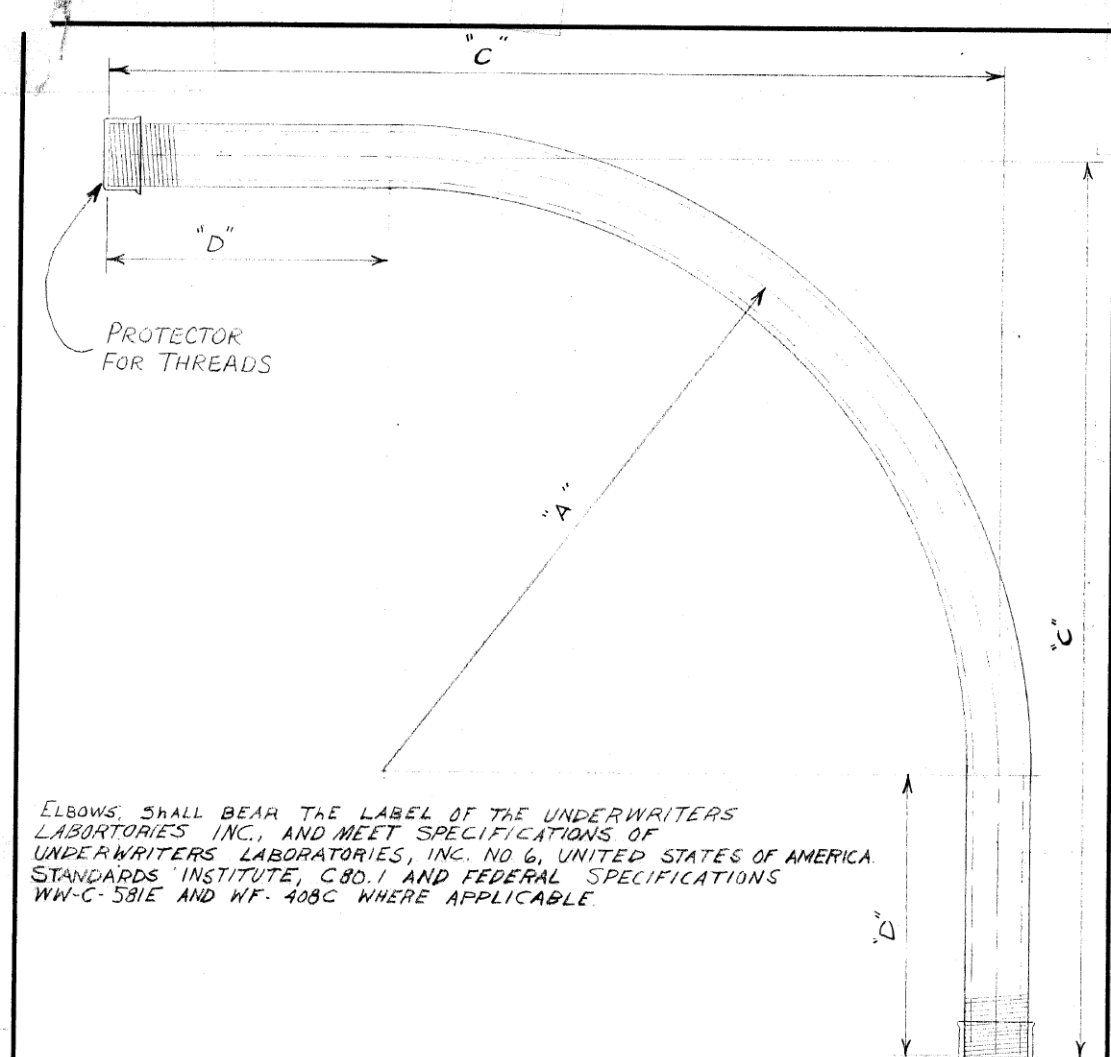

ELBOWS SHALL BEAR THE LABEL OF THE UNDERWRITERS LABORATORIES INC., AND MEET SPECIFICATIONS OF UNDERWRITERS LABORATORIES, INC. NO 6, UNITED STATES OF AMERICA. STANDARDS INSTITUTE, C80.1 AND FEDERAL SPECIFICATIONS WW-C-581E AND WF-408C WHERE APPLICABLE

NOTE: TWO THREAD PROTECTORS TO BE FURNISHED ON EACH ELBOW, PROTECTOR TO COVER A MINIMUM OF TEN THREADS.

REAM BOTH ENDS TO REMOVE BURRS

CONDUIT SIZE	DIMENSIONS			COMMODITY CODE
	"A"	"C"	"D"	

B SPECIFICATIONS REVISED		
A REVISED DIMENSIONS ON 3" x 4" CONDUIT L.P.		
ELBOW, CONDUIT, RIGID GALVANIZED STEEL, LARGE RADIUS		
REVISED	CITY OF CHICAGO	
A	DEPT. OF STREETS AND SANITATION	
B	BUREAU OF ELECTRICITY	
C	DIVISION OF ELECTRICAL ENGINEERING	
D	DRAWN	CHECKED
E	LOU PURDY	M.S.
F	ENGINEER	M. SHINE
G	DRG. NO.	11825
DEPUTY COMM. DATE 6-2-71		SCALE: 3/16"
SIZE 8 1/2" x 14"		



DI60W29-sht-Light-19
USER NAME = BAW:ort
PLOT SCALE = 2.0000' / in.
PLOT DATE = 10/28/2013

DESIGNED - WDS
DRAWN - CAM
CHECKED - WDS
DATE - 10/30/2013

REVISED -
REVISED -
REVISED -
REVISED -

STATE OF ILLINOIS
DEPARTMENT OF TRANSPORTATION


MISCELLANEOUS ELECTRICAL DETAILS

SCALE: N.T.S. SHEET 19 OF 19 SHEETS STA. TO STA.

F.A.I. RTE.	SECTION	COUNTY	TOTAL SHEETS	SHEET NO.
90/94/290	2013-011R	COOK	356	129
CONTRACT NO. 60W29				
ILLINOIS FED. AID PROJECT				

SANGAMON ST.

PEORIA ST.

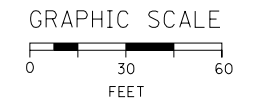

EXISTING ITS CONDUIT AND CABLES TO BE ABANDONED.

EXISTING ITS CABINET G1 TO REMAIN. DISCONNECT AND REMOVE CABLES TO BE ABANDONED (INCIDENTAL TO MAINTAINING ITS DURING CONSTRUCTION ITEM)

EXISTING ITS CONDUIT AND CABLES AT5 TO BE ABANDONED

EXISTING ITS CONDUIT AND CABLES TO BE ABANDONED

EXISTING HAND HOLE TO BE REPLACED

EXISTING ITS CABLES TO BE REPLACED BY OTHERS

EXISTING HAND HOLE TO REMAIN

EXISTING LOOPS TO BE REPLACED BY OTHERS

125+00

345+00

350+00

WB I-290

EXISTING ITS CABLES TO BE ABANDONED

EXISTING ITS CABINET Z3 TO BE REMOVED BY OTHERS

345+00

100+00


EB I-290

350+00

105+00



DI60W29-sht-ITS-01
USER NAME = BAW:tor t
PLOT SCALE = 60.0000 ' / in.
PLOT DATE = 12/19/2013

 DESIGNED - JML
DRAWN - JML
CHECKED - WDS
DATE - 10/30/2013
REVISED -  12/18/2013
REVISED -
REVISED -
REVISED -

STATE OF ILLINOIS
DEPARTMENT OF TRANSPORTATION

ITS REMOVAL PLAN
I-290


SCALE: 1" = 30' SHEET 1 OF 3 SHEETS STA. 342+26 TO STA. 351+80

F.A.I. RTE.	SECTION	COUNTY	TOTAL SHEETS	SHEET NO.
90/94/290	2013-011R	COOK	356	130
CONTRACT NO. 60W29				
ILLINOIS FED. AID PROJECT				

FILE PATH = p:\388035\pmt\aeconom\line\local\AECON\Documents\01_Americas\Transportation\60269938_Circle\Phase_1\000_CAD\005_Roadway\Sheets\60W29_Contract\DI60W29-sht-ITS-01



NOT TO SCALE

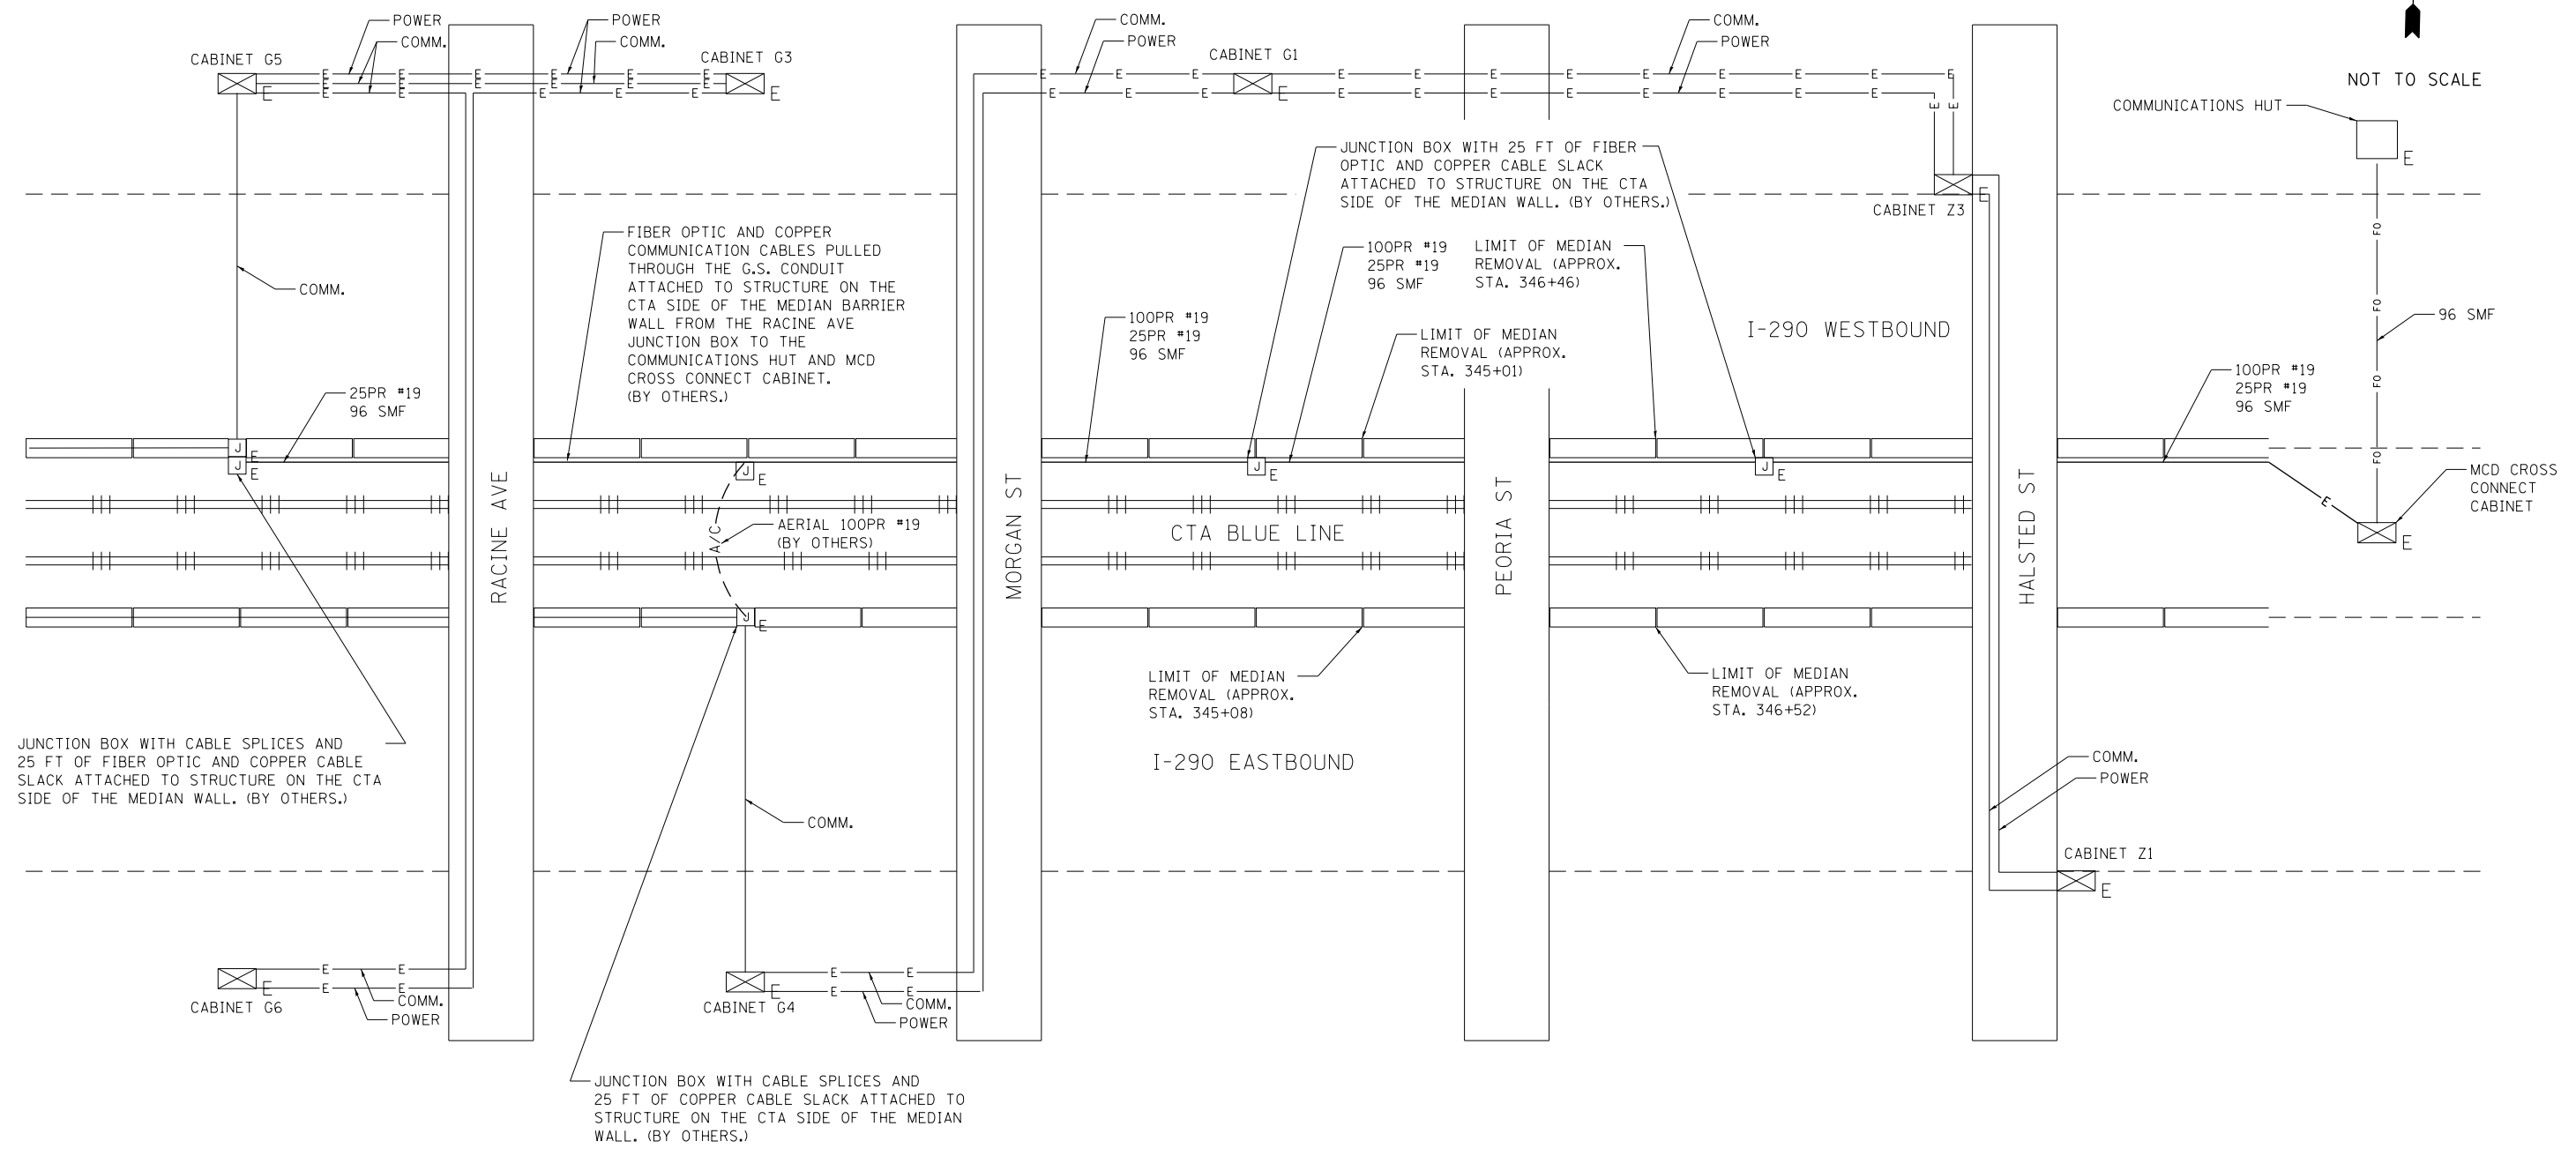

NOTES

1. THE ITS COMMUNICATION CABLES HAVE BEEN REROUTED BY OTHERS TO ALLOW SUFFICIENT SLACK TO MAINTAIN THE ITS CONNECTIONS DURING PIER REMOVAL ACTIVITIES.
2. THE CONTRACTOR IS RESPONSIBLE FOR MAINTAINING THE REROUTED ITS INFRASTRUCTURE IN CONDUIT ATTACHED TO STRUCTURE.
3. THE CONTRACTOR MUST MAINTAIN THE ITS CONNECTION THROUGH THE PIER REMOVAL WORK ZONE. MAINTAINING THE CONDUIT ATTACHED TO STRUCTURE MAY NOT BE POSSIBLE IN THE PIER REMOVAL WORK ZONE. THE CONTRACTOR MAY REMOVE THE CONDUIT ATTACHED TO STRUCTURE AND PROTECT IT IN PLACE THROUGH THE WORK ZONE DURING CONSTRUCTION ACTIVITIES. THE CONTRACTOR MUST REATTACH THE CONDUIT TO STRUCTURE ON THE CTA SIDE OF THE MEDIAN BARRIER ONCE PIER CONSTRUCTION ACTIVITIES ARE COMPLETE.
4. THE CONTRACTOR SHALL COORDINATE MAINTAINING ITS ACTIVITIES WITH ADJACENT IDOT PROJECTS.
5. SEE THE MAINTAINING ITS DURING CONSTRUCTION SPECIAL PROVISION FOR ADDITIONAL INFORMATION.
6. THIS DRAWING IS DIAGRAMMATICAL AND FOR INFORMATIONAL PURPOSES ONLY.

FILE PATH = par\388035-par\1\aescom\line\local\p\AECOM\Documents\01_Americas\Transportation\60269938_Circle\Phase_1\000_CAD\005_Roadway\Sheets\60W29_sht-ITS-02






DI60W29-sht-ITS-02	DESIGNED - JML	REVISED -
USER NAME = BAW\jort	DRAWN - JML	REVISED -
PLOT SCALE = 60.0000' / in.	CHECKED - WDS	REVISED -
PLOT DATE = 10/28/2013	DATE - 10/30/2013	REVISED -

**STATE OF ILLINOIS
DEPARTMENT OF TRANSPORTATION**

**MAINTAINING ITS DURING PIER REMOVAL PLAN
I-290**

SCALE: NO SCALE SHEET 2 OF 3 SHEETS STA. TO STA.

F.A.I. RTE.	SECTION	COUNTY	TOTAL SHEETS	SHEET NO.
90/94/290	2013-011R	COOK	356	131
CONTRACT NO. 60W29				
ILLINOIS FED. AID PROJECT				

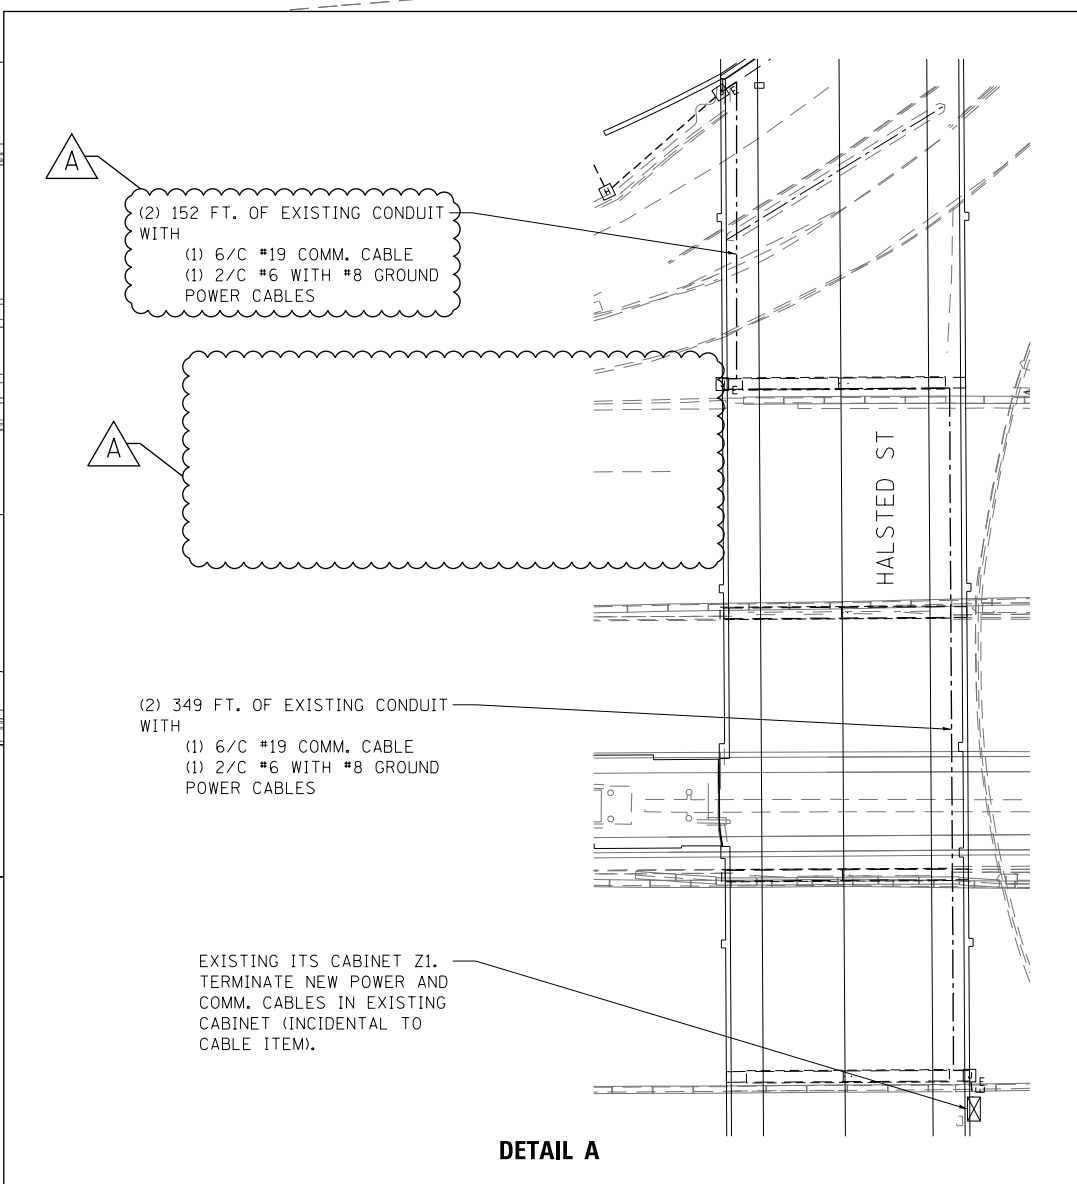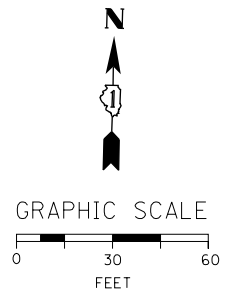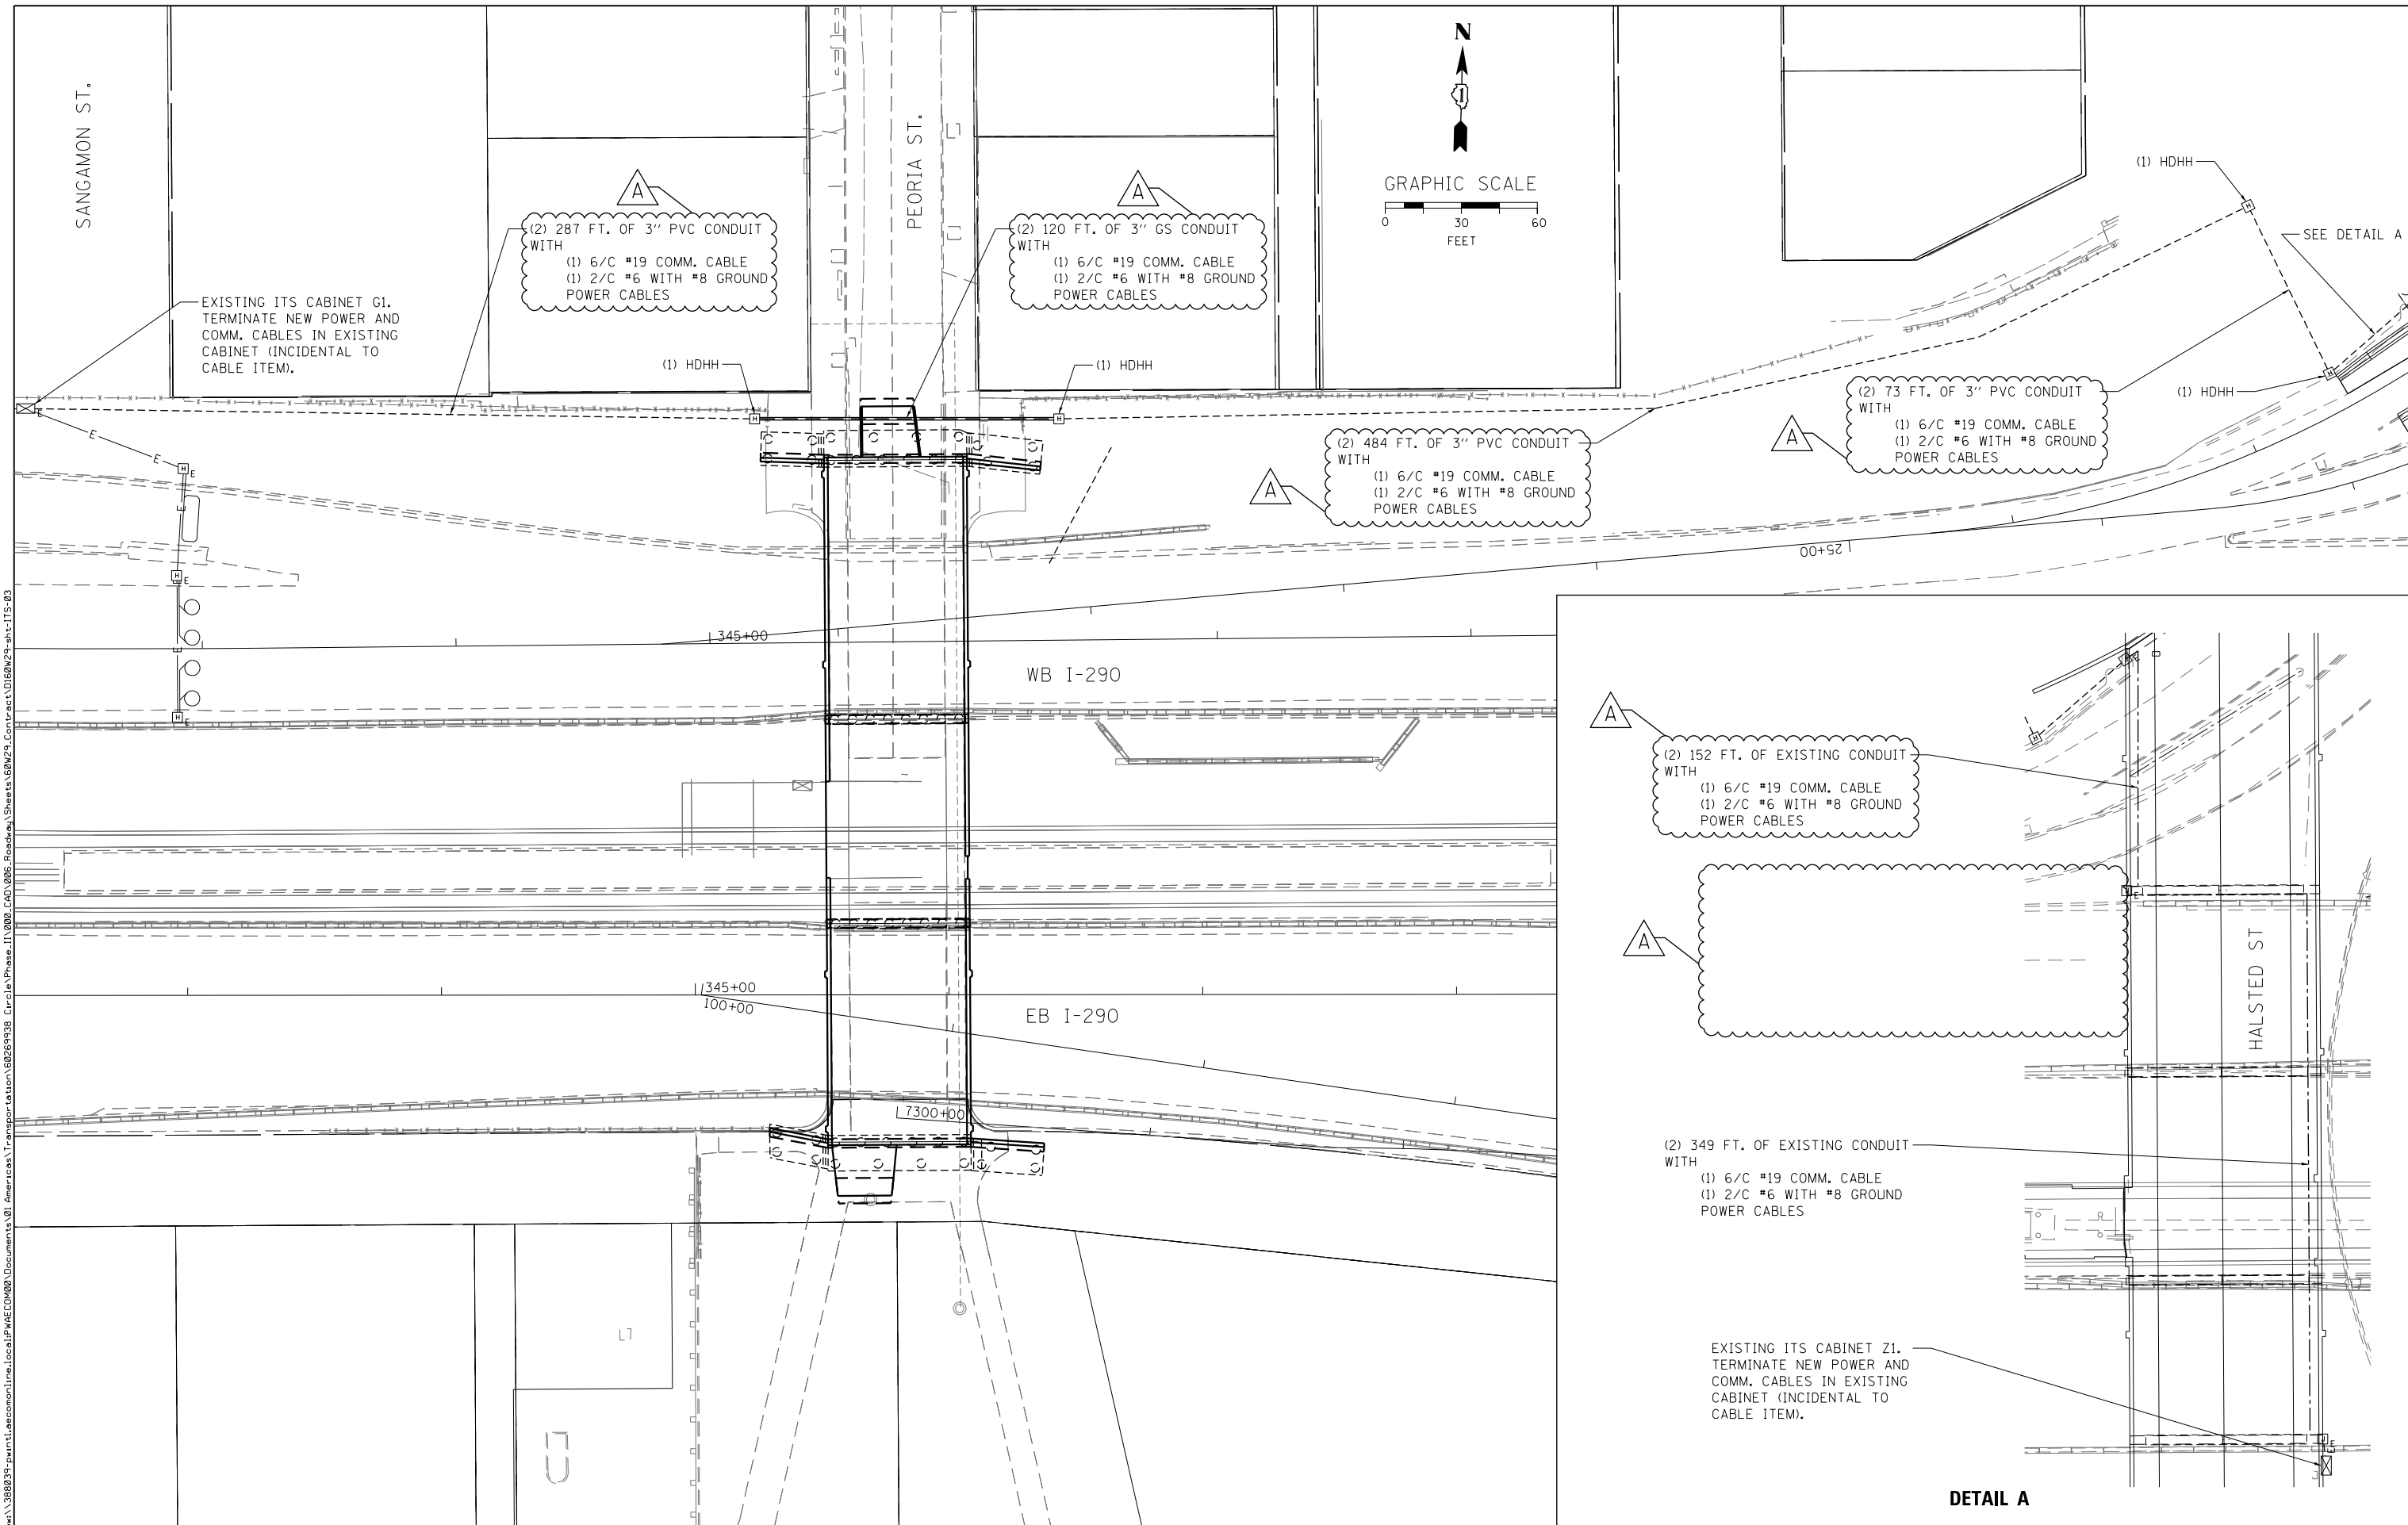

FILE PATH = p:\388039\pmt\aecon\line\local\PEACOM\Documents\01_Americas\Transportation\60269938_Circle\Phase_1\1000_CAD\005_Roadway_Sheets\60W29_sht-ITS-03



D160W29-sht-ITS-03
 USER NAME = BAW:tor t
 PLOT SCALE = 60.0000' / in.
 PLOT DATE = 12/19/2013

DESIGNED - JML	REVISED - 12/18/2013
DRAWN - JML	REVISED -
CHECKED - WDS	REVISED -
DATE - 10/30/2013	REVISED -

**STATE OF ILLINOIS
 DEPARTMENT OF TRANSPORTATION**

**PROPOSED ITS PLAN
 I-290**

SCALE: 1" = 30' SHEET 3 OF 3 SHEETS STA. 342+26 TO STA. 351+80

F.A.I. RTE.	SECTION	COUNTY	TOTAL SHEETS	SHEET NO.
90/94/290	2013-011R	COOK	356	132
CONTRACT NO. 60W29				
ILLINOIS FED. AID PROJECT				


Bench Mark: Chisel "X" on S. flange bolt of F.H. on W. side of Peoria Street first F.H. S. of Van Buren Street.
Elev. 594.37

Existing Structure: SN 016-2082. Constructed in 1950 under F.A. Route 131 Section 2525.1-1B.
Three span bridge that measures 219'-8" from back-to-back of abutments.
Out-to-out width of 56'-4". The spans are supported by 36" wide flange steel I-beams. Substructure is reinforced concrete piers and abutments on creosoted timber piles. The existing bridge is to be removed and replaced.


The bridge will be closed to pedestrian traffic and detoured during construction.
Existing equipment located in the head house is to be salvaged and relocated in the existing CTA Glass Station adjacent to the structure. The existing CTA Station is to remain closed during construction.

No Salvage.


APPROVED
For Structural Adequacy Only
D. Carl Kuyper
Engineer of Bridges & Structures

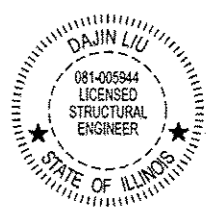


Dajin Liu
DAJIN LIU, P.E., S.E.
NO. 081-005944
EXP. DATE 11/30/2014

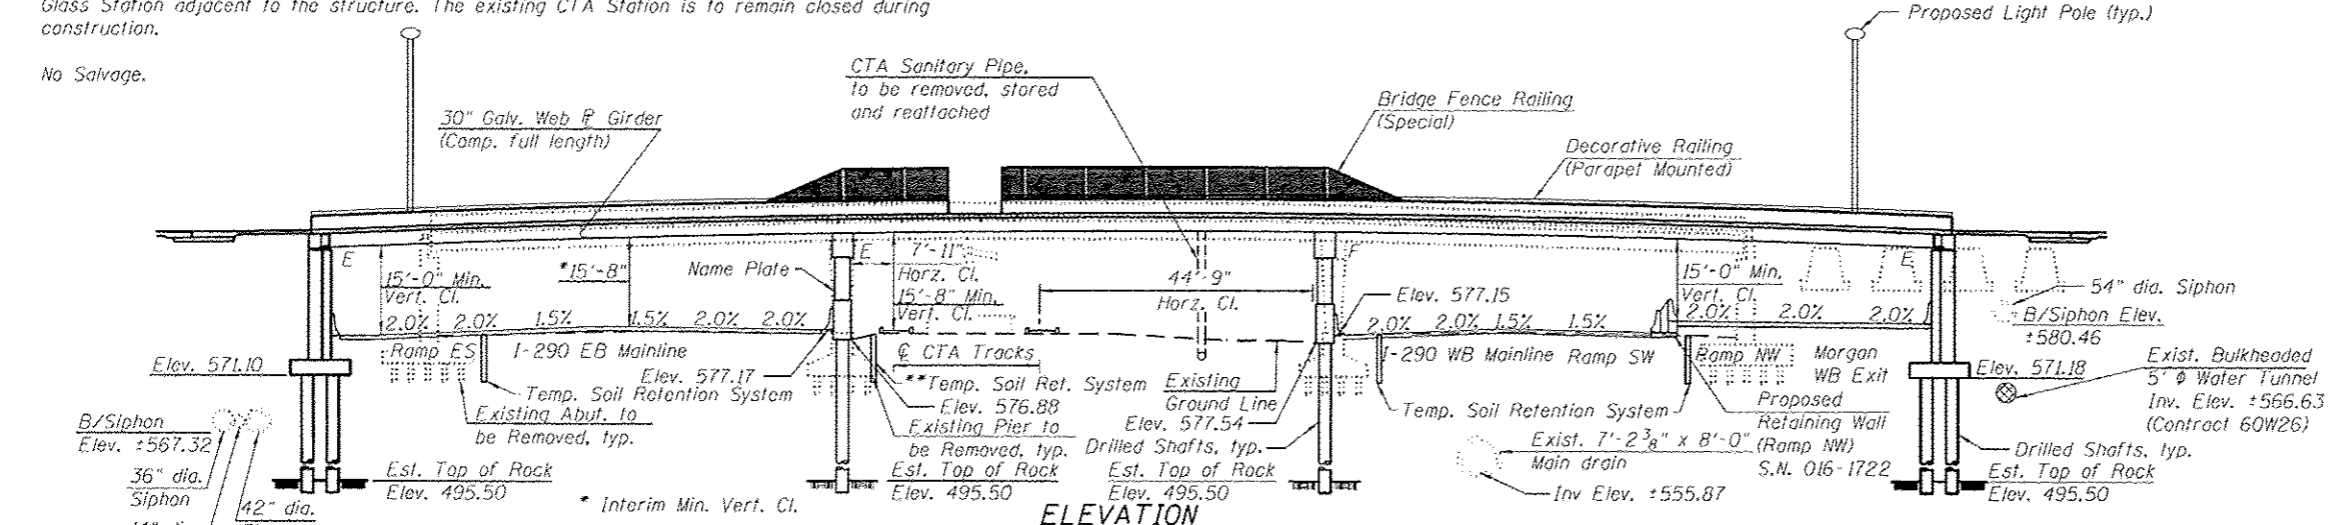

ELEVATION

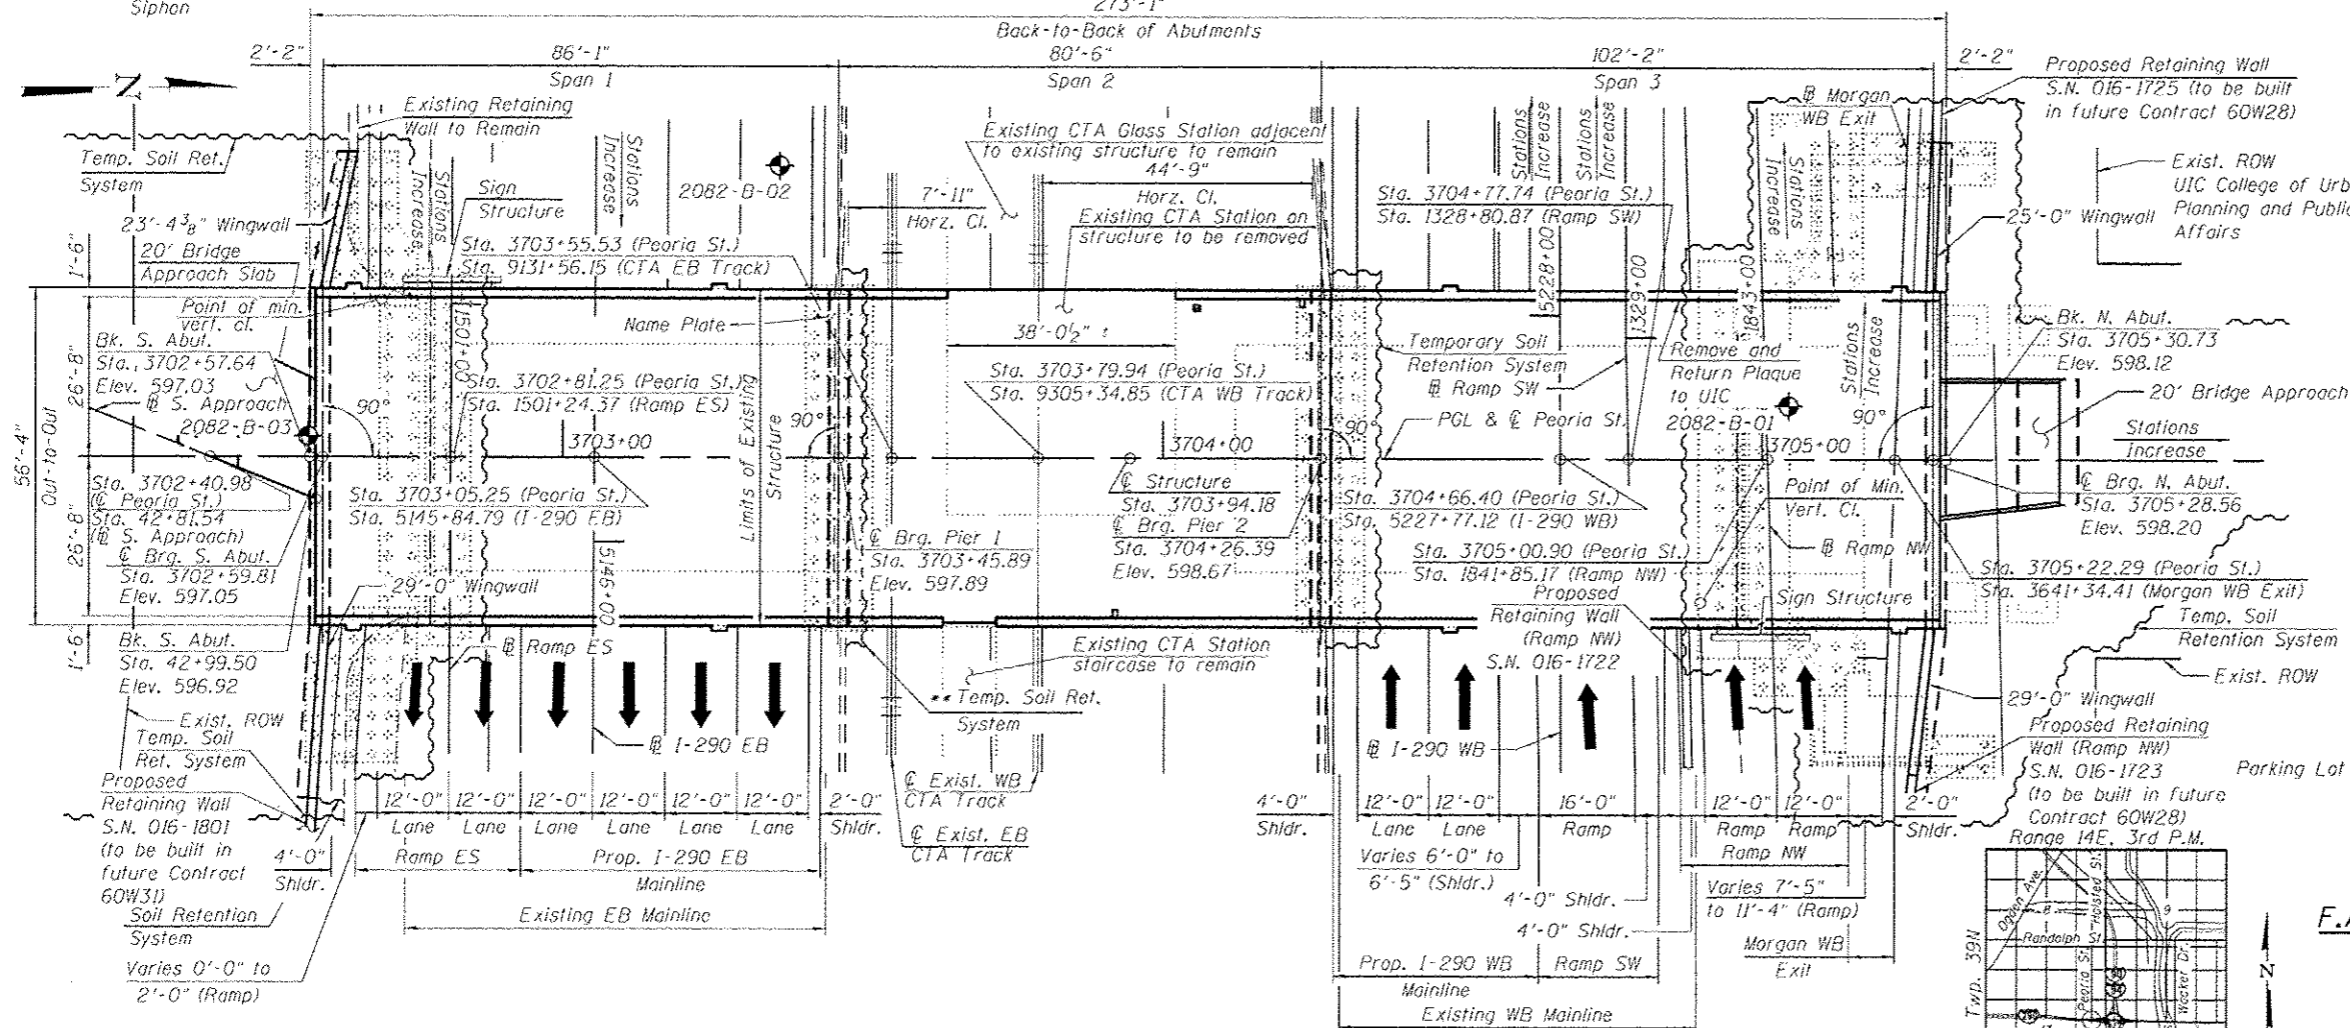

PLAN

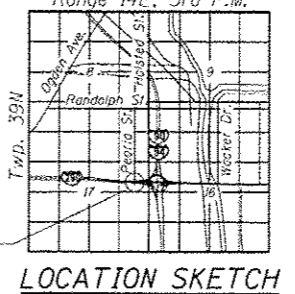

LOCATION SKETCH

** Construction of Pier 1 is adjacent to the EB CTA Blue Line track. Construction activities require a modification to the normal operation of CTA service to facilitate access to perform work on or near the CTA Right-of-Way will be allowed with CTA Track Access Occurrences. See Special Provision for CTA Flagging and Coordination.

LOADING HL-93

Allow 50# sq. ft. for future wearing surface.

DESIGN SPECIFICATIONS

2012 AASHTO LRFD Bridge Design Specifications
6th Edition, with 2013 Interim Revisions

DESIGN STRESSES

FIELD UNITS
f'c = 3,500 psi
f'c = 21,000 psi (Ultra-High Performance Concrete)
fy = 60,000 psi (Reinforcement)
fy = 50,000 psi (M270 Grade 50)
fy = 36,000 psi (M270 Grade 36)

PRECAST UNITS

f'c = 5,000 psi

SEISMIC DATA

Seismic Performance Zone (SPZ) = 1
Design Spectral Acceleration at 1.0 sec. (S₀₁) = 0.086g
Design Spectral Acceleration at 0.2 sec. (S₀₅) = 0.153g
Soil Site Class = D

GENERAL PLAN & ELEVATION
PEORIA STREET OVER
F.A.I. 290 (EISENHOWER EXPRESSWAY) AND CTA
MUN 2090 SECTION 2013-011R
COOK COUNTY
STATION 3703+94.18
STRUCTURE NO. 016-1708

Note:
For limits of Protective Shield, See Sheet 7 of 55.
See Sheet 3 for Legend.



USER NAME: BAW1101+	DESIGNED: WJC	REVISED:
CHECKED: KAH/MDS/DL	REVISIONS:	
DRAWN: WJC	REVISIONS:	
CHECKED: KAH/MDS/DL	REVISIONS:	

STATE OF ILLINOIS
DEPARTMENT OF TRANSPORTATION

SHEET NO. 1 OF 55 SHEETS

MUN	SECTION	COUNTY	TOTAL SHEETS	SHEET NO.
2090	2013-011R	COOK	356	133
CONTRACT NO. 60W29			ILLINOIS FED. AID PROJECT	

GENERAL NOTES:

- Fasteners shall be ASTM A325 Type 1, hot dip galvanized bolts. Bolts $\frac{7}{8}$ in. ϕ , holes $\frac{15}{16}$ in. ϕ , unless otherwise noted (See special provision for Hot Dip Galvanizing for Structural Steel).
- Calculated weight of Structural Steel = $\frac{475,950}{1}$ pounds (AASHTO M270 Grade 50).
Calculated weight of Structural Steel = $\frac{42,720}{1}$ pounds (AASHTO M270 Grade 36).
- All structural steel shall be hot dip galvanized. Cost included in Furnishing and Erecting Structural Steel. See special provisions for Hot Dipped Galvanizing for Structural Steel.
- Girders have bearing stiffeners and connection plates as required design. Additional stiffeners may be added at the Contractor's expense as necessary to prevent distortion of the girders during galvanizing. The Contractor shall coordinate with the fabricator and the galvanizer to determine if additional stiffeners are necessary, and where these should be placed. Any proposed changes shall be submitted to the Engineer for approval prior to making any changes.
- Temporary stiffener angles shall be bolted to each side of the splice ends of each girder segment to prevent distortion during galvanizing. Temporary stiffener angles shall bolt or fit tight against the top and bottom flanges and shall include spacer tubes to minimize damage to galvanizing during removal. Cost included with "Furnishing and Erecting Structural Steel".
- No field welding is permitted except as specified in the contract documents.
- Reinforcement bars designated (E) shall be epoxy coated.
- Plan dimensions and details relative to existing plans are subject to nominal construction variations. The Contractor shall field verify existing dimensions and details affecting new construction and make necessary approved adjustments prior to construction or ordering of materials. Such variations shall not be cause for additional compensation for a change in scope of the work, however, the Contractor will be paid for the quantity actually furnished at the unit price bid for the work.
- Bearing seat surfaces shall be constructed or adjusted to the designated elevations within a tolerance of $\frac{1}{8}$ inch (0.01 ft.). Adjustment shall be made either by grinding the surface or by shimming the bearings.
- Concrete Sealer shall be applied to the designated areas of the Piers, Abutments and Wingwalls.
- For Conduit Attached to Structure quantities and details, see Electrical Plans.
- The contractor shall exercise extreme caution during construction to make certain that construction activities, live load surcharge and other loads applied to the structures will not have detrimental effects on the adjacent building foundations. Driving piles and temporary sheet piling is not allowed.
- For light pole support system, see Electrical Plans.
- Abandoned 5' diameter CTA Water Tunnel shall be filled prior to the start of drilled shaft construction in a previous contract. The Contractor shall verify with the Engineer that the tunnel has been filled prior to the start of drilled shaft construction. A number of the drilled shaft foundations will be placed through this tunnel. Drilling operations must account for the presence of debris, brick material, CLSM and bedding material in addition to soil and other expected materials to be encountered.
- The existing structural steel coating contains lead. The Contractor shall take appropriate precautions to deal with the presence of lead on this project.
- Slipforming of parapets is not allowed.
- Cast-in-place deck except parapets is not allowed.
- For drilled shaft locations where permanent casing is required as shown on the plans, the casing will be paid for under the Permanent Casing pay item. If contractor elects to use permanent casing for ease of construction in locations where permanent casing is not required on the plans the casing will not be paid for separately and is included in the Drilled Shaft in Soil pay item.
- Post-tensioning for precast deck panel is not allowed.


INDEX OF SHEETS

- General Plan and Elevation
- General Data 1
- General Data 2
- Foundation Layout
- Temporary Soil Retention Details 1
- Temporary Soil Retention Details 2
- Existing Structure Removal Details 1
- Existing Structure Removal Details 2
- Existing Structure Removal Details 3
- Top of Slab Elevations 1
- Top of Slab Elevations 2
- Top of Slab Elevations 3
- Top of Approach Slab Elevations
- Bridge Deck Overlay
- Precast Deck Panel Plan and Cross Section
- Precast Deck Panel Details 1
- Precast Deck Panel Details 2
- Precast Deck Panel Details 3
- Precast Deck Panel Details 4
- Precast Deck Panel Details 5
- Parapet Elevations and Details
- Superstructure Details 1
- Superstructure Details 2
- Bridge Approach Slab Details 1
- Bridge Approach Slab Details 2
- Decorative Railing Parapet Mounted
- Parapet Architectural Treatment
- Bridge Fence Railing (Special) Elevations
- Bridge Fence Railing (Special)
- Bridge Drainage System
- Drainage Scupper, DS-II
- Framing Plan
- Structural Steel Details 1
- Structural Steel Details 2
- Structural Steel Details 3
- Abutment Bearing Details
- Pier Bearing Details
- South Abutment Plan and Elevation
- South Abutment Details 1
- South Abutment Details 2
- North Abutment Plan and Elevation
- North Abutment Details 1
- North Abutment Details 2
- Pier 1 Plan and Elevation
- Pier 1 Details
- Pier 1 Architectural Details
- Pier 2 Plan and Elevation
- Pier 2 Details
- Pier 2 Architectural Details
- ComEd Bridge Deck Cross Section
- Conduit Support Hanger Detail and Bill of Materials
- Conduit Support and Conduit Layout
- AT&T Conduit Hangers Precast Deck Panel Layout
- AT&T Conduit Hangers Precast Deck Cross Section
- AT&T Conduit Hangers Section and Details
- AT&T Conduit Hangers Precast Panel Details
- Boring Logs 1
- Boring Logs 2
- Boring Logs 3

STATION 3703+94.18
BUILT 20-- BY
STATE OF ILLINOIS
M.U.N. 2090 SEC. 2013-011R
LOADING HL-93
STR. NO. 016-1708

NAME PLATE

See Std. 515001

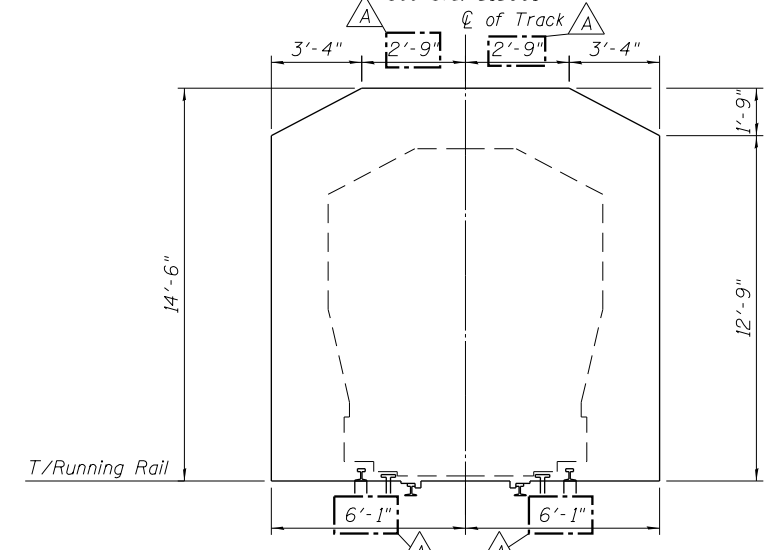

MINIMUM CTA CONSTRUCTION CLEARANCES

TOTAL BILL OF MATERIAL

Item	Unit	Super	Sub	Total
Removal of Existing Structures	Each			1
Protective Shield	Sq. Yd.	1394		1394
Structure Excavation	Cu. Yd.		3293	3293
Concrete Structures	Cu. Yd.		1031.2	1031.2
Rubbed Finish	Sq. Ft.	1945	2120	4065
Concrete Superstructure	Cu. Yd.	209.3		209.3
Form Liner Textured Surface	Sq. Ft.		1020	1020
Protective Coat	Sq. Yd.	395		395
Furnishing and Erecting Structural Steel	L. Sum		1	1
Stud Shear Connectors	Each	6,806		6,806
Reinforcement Bars	Pound		292,640	292,640
Reinforcement Bars, Epoxy Coated	Pound	18,270	148,620	166,890
Name Plates	Each		1	1
Permanent Casing	Foot		1554	1554
Drilled Shaft in Soil	Cu. Yd.		1318.9	1318.9
Drilled Shaft in Rock	Cu. Yd.		38.2	38.2
Elastomeric Bearing Assembly, Type I	Each	18		18
Elastomeric Bearing Assembly, Type II	Each	9		9
Anchor Bolts, 1 1/4"	Each	18		18
Anchor Bolts, 1 1/4"	Each	36		36
Concrete Sealer	Sq. Ft.		8,122	8,122
Geocomposite Wall Drain	Sq. Yd.		498	498
Chain Link Fence, 4'	Foot		5	5
Pile Extraction	Each		77	77
Decorative Railing (Parapet Mounted)	Foot	496		496
Crosshole Sonic Logging	Each		4	4
Foundation Removal	Each		8	8
Bridge Fence Railing (Special)	Foot	129		129
Granular Backfill for Structures	Cu. Yd.		647	647
Bridge Deck Latex Concrete Overlay, 2 1/4 Inches	Sq. Yd.	1614		1,614
Welded Wire Fabric 6x6	Sq. Yd.	66		66
Drainage Scuppers, DS-II	Each	2		2
Drainage System	L. Sum	1		1
Pipe Underdrains for Structures 4"	Foot		267	267
Temporary Soil Retention System	Sq. Ft.		9,532	9,532
Soil Retention System	Sq. Ft.		104	104
Precast Concrete Deck Panels	Sq. Ft.	15,272		15,272

4:59:40 PM 0161708-60W29-5002-GenNote-1.dgn



USER NAME = wjcollett1	DESIGNED KAH	REVISED 12/18/2013 JRM/KAH
CHECKED MDS	REVISOR	
PLOT SCALE = 0x2.0000 '1' / 1n.	DRAWN RLS	REVISOR
PLOT DATE = 1/10/2014	CHECKED MDS	REVISOR


**STATE OF ILLINOIS
DEPARTMENT OF TRANSPORTATION**

**GENERAL DATA 1
STRUCTURE NO. 016-1708**







SHEET NO. 2 OF 55 SHEETS

MUN 2090	SECTION 2013-011R	COUNTY COOK	TOTAL SHEETS 356	SHEET NO. 134
CONTRACT NO. 60W29			ILLINOIS FED. AID PROJECT	

10:31:00 AM 0161708-60W29-5003-CenNote-2.dgn

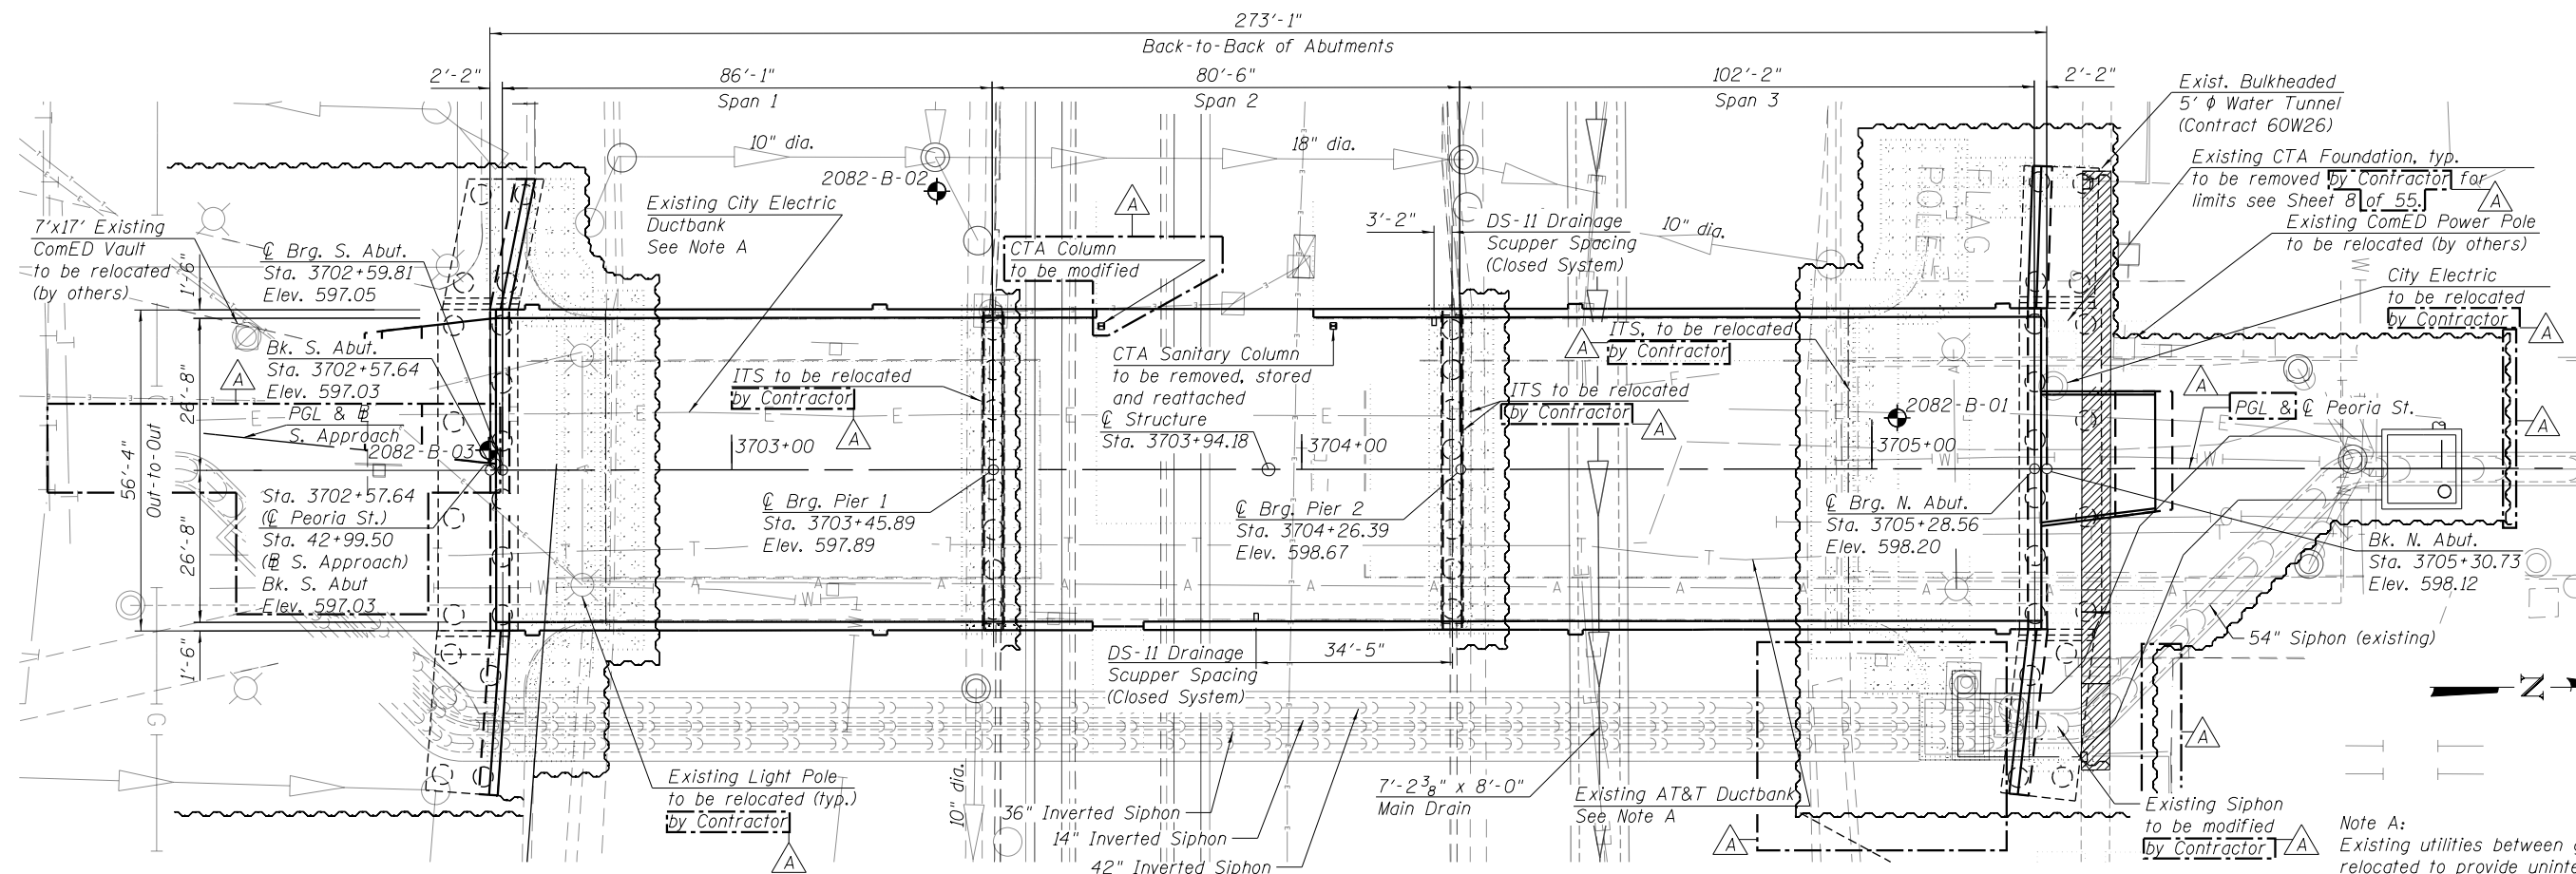

Note A:
Existing utilities between girders will be relocated to provide uninterrupted service during construction.

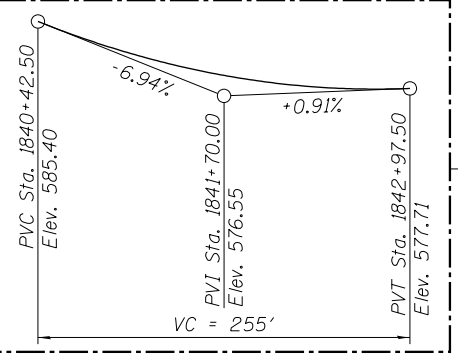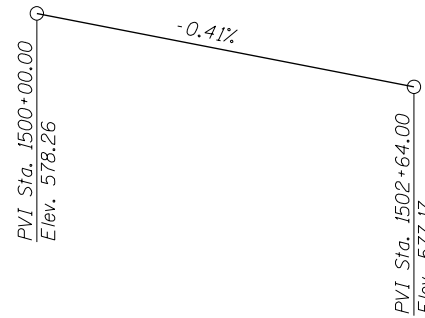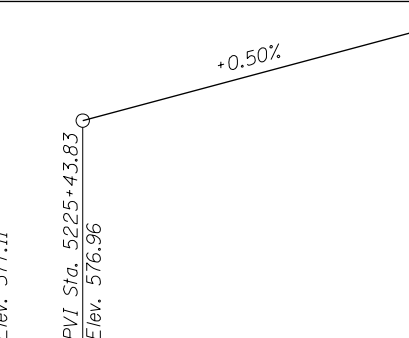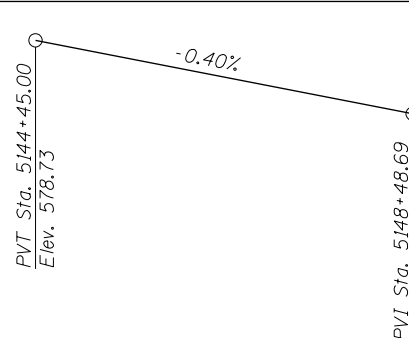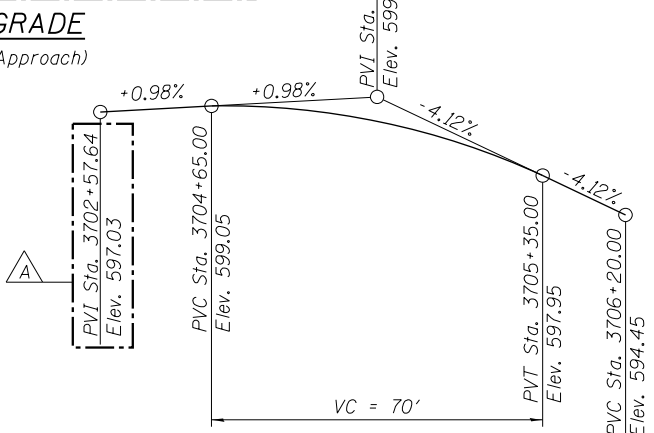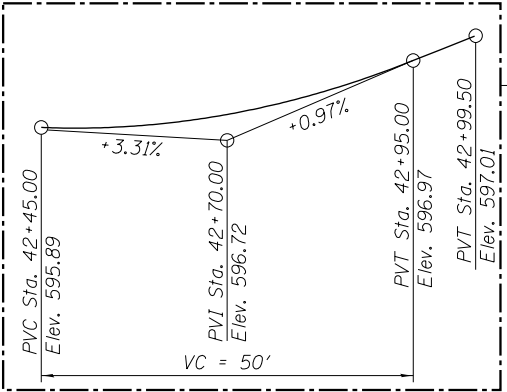

Notes:
For ITS Plans see Sheets 130 thru 132 of 356.
For Siphon Plans see Sheets 71 thru 76 of 356.
For Lighting Plans see Sheet 118 and 120 of 356.

LEGEND:

Aerial Line	— A — A
Combined Sewer	—>>>>>>
Electric	— E — E
Storm Sewer	—>>>>
Telephone	— T — T
Gas	— G — G
ITS	— — — —
Water	— W — W
Power Pole	□
Light Pole	⊙
Soil Boring	⊕
Bulkhead and area filled with CLSM	▨





USER NAME = BAWItor†	DESIGNED KAH	REVISED	12/18/2013 KAH/MDS
PLLOT SCALE = 32:0.0037' / in.	CHECKED MDS	REVISED	
PLLOT DATE = 12/19/2013	DRAWN RLS	REVISED	
	CHECKED MDS	REVISED	


STATE OF ILLINOIS
DEPARTMENT OF TRANSPORTATION

GENERAL DATA 2
STRUCTURE NO. 016-1708
SHEET NO. 3 OF 55 SHEETS


MUN	SECTION	COUNTY	TOTAL SHEETS	SHEET NO.
2090	2013-011R	COOK	356	135
CONTRACT NO. 60W29			ILLINOIS FED. AID PROJECT	

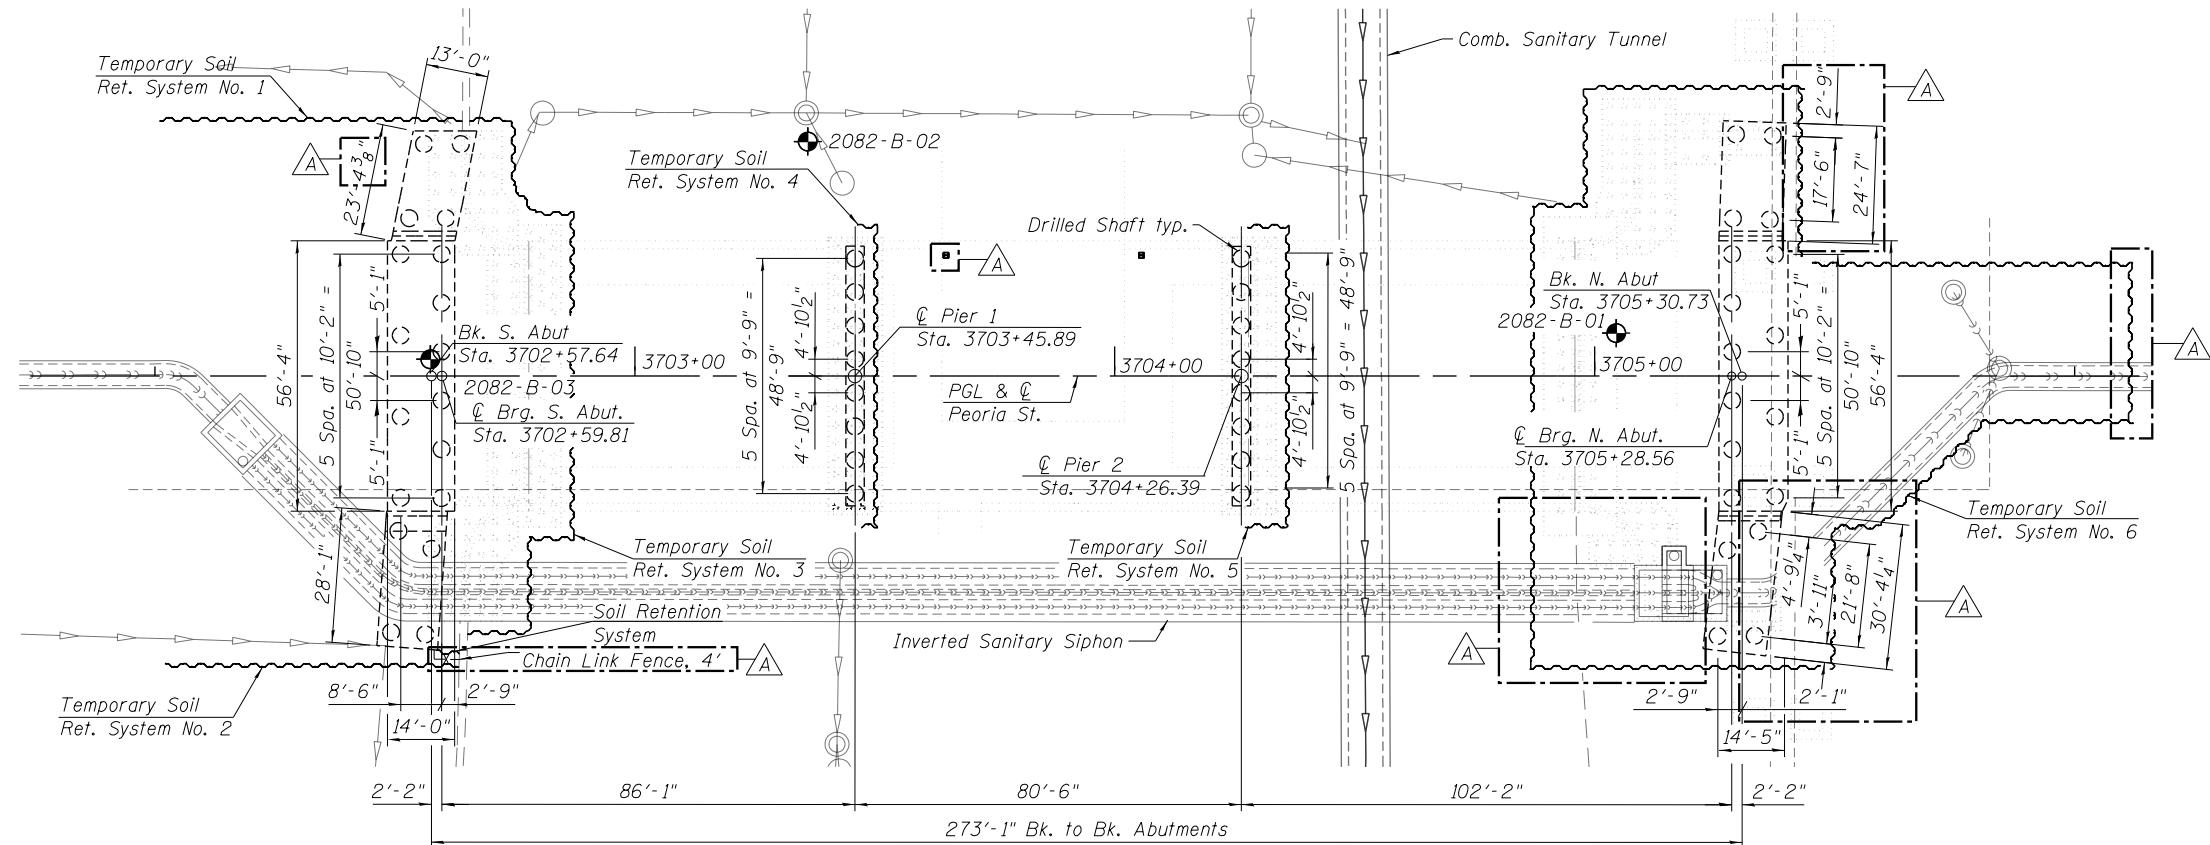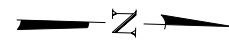

FOUNDATION LAYOUT

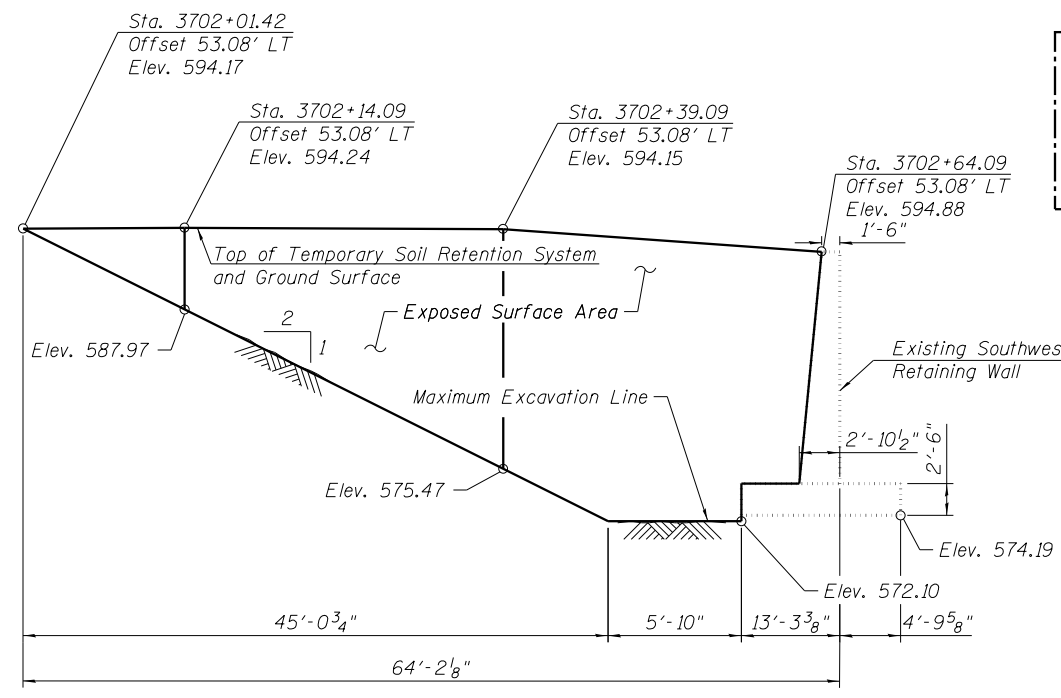

TEMPORARY SOIL RETENTION SYSTEM NO. 1
(At South Abutment)

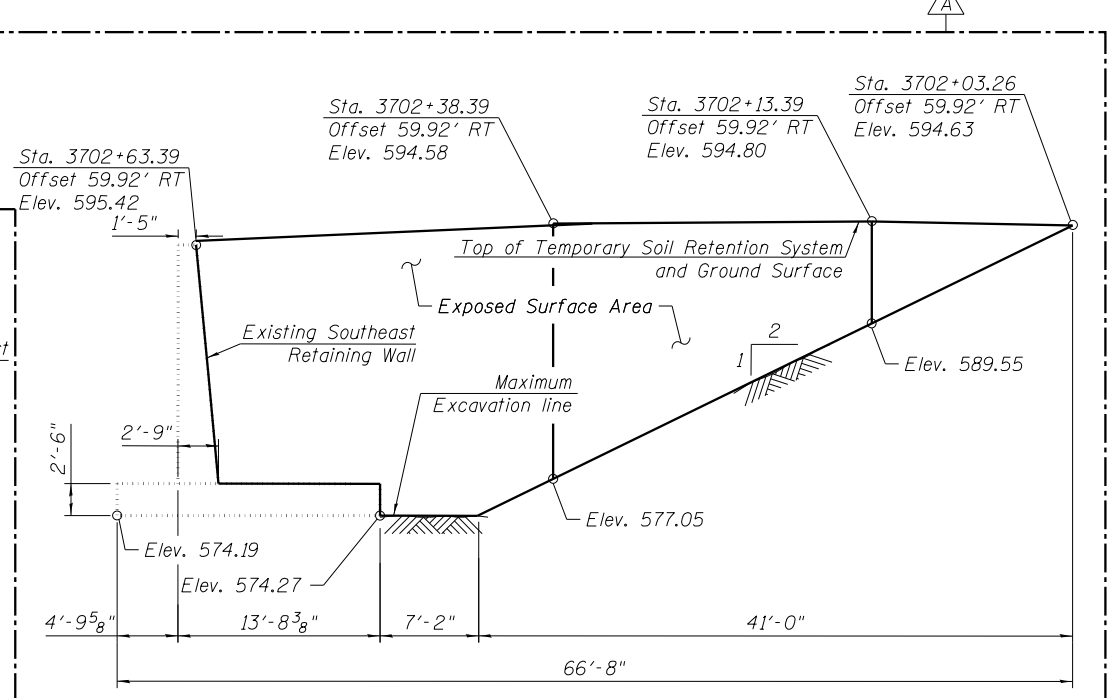

TEMPORARY SOIL RETENTION SYSTEM NO. 2
(At South Abutment)

LEGEND:

- Combined Sewer
- Storm Sewer
- ITS Fiber Optic
- Chain Link Fence, 4'
- Light Pole
- Soil Boring

Notes:
 Driving piles and temporary sheet piling is not allowed.
 A cantilevered sheet piling design does not appear feasible and additional members or other retention systems may be necessary. The Contractor shall submit a temporary soil retention system design including plan details and calculations for review and acceptance by the Engineer.
 See the Utility Plan on sheet 3 of 55 for existing utilities. The maximum allowable excavation slope is 1:2 (V:H).
 For additional Temporary Soil Retention System details see sheets 5 and 6 of 55.
 For Soil Retention System details see sheet 6 of 55.
 The portion of Temporary Soil Retention No. 6 in conflict with the existing siphon cannot be constructed until the temporary siphon bypass is constructed. For Siphon Plans see Sheet 71 thru 76 of 356.
 For Chain Link Fence quantity, see Sheet 6 of 356.

BILL OF MATERIAL

Item	Unit	Quantity
Temporary Soil Retention System	Sq. Ft.	1608

11/27/10 AM 0161708-60W29-5004-SubStruct-Foundations.dgn



USER NAME = kahastings	DESIGNED JRM/KAH	REVISED 12/18/2013 KAH
PLOT SCALE = 40:0.0046 ' / in.	CHECKED - MDS	REVISED -
PLOT DATE = 1/10/2014	DRAWN - RLS	REVISED -
	CHECKED - MDS	REVISED -


STATE OF ILLINOIS
DEPARTMENT OF TRANSPORTATION

FOUNDATION LAYOUT
STRUCTURE NO. 016-1708


SHEET NO. 4 OF 55 SHEETS

MUN	SECTION	COUNTY	TOTAL SHEETS	SHEET NO.
2090	2013-011R	COOK	356	136
CONTRACT NO.			60W29	


ILLINOIS FED. AID PROJECT

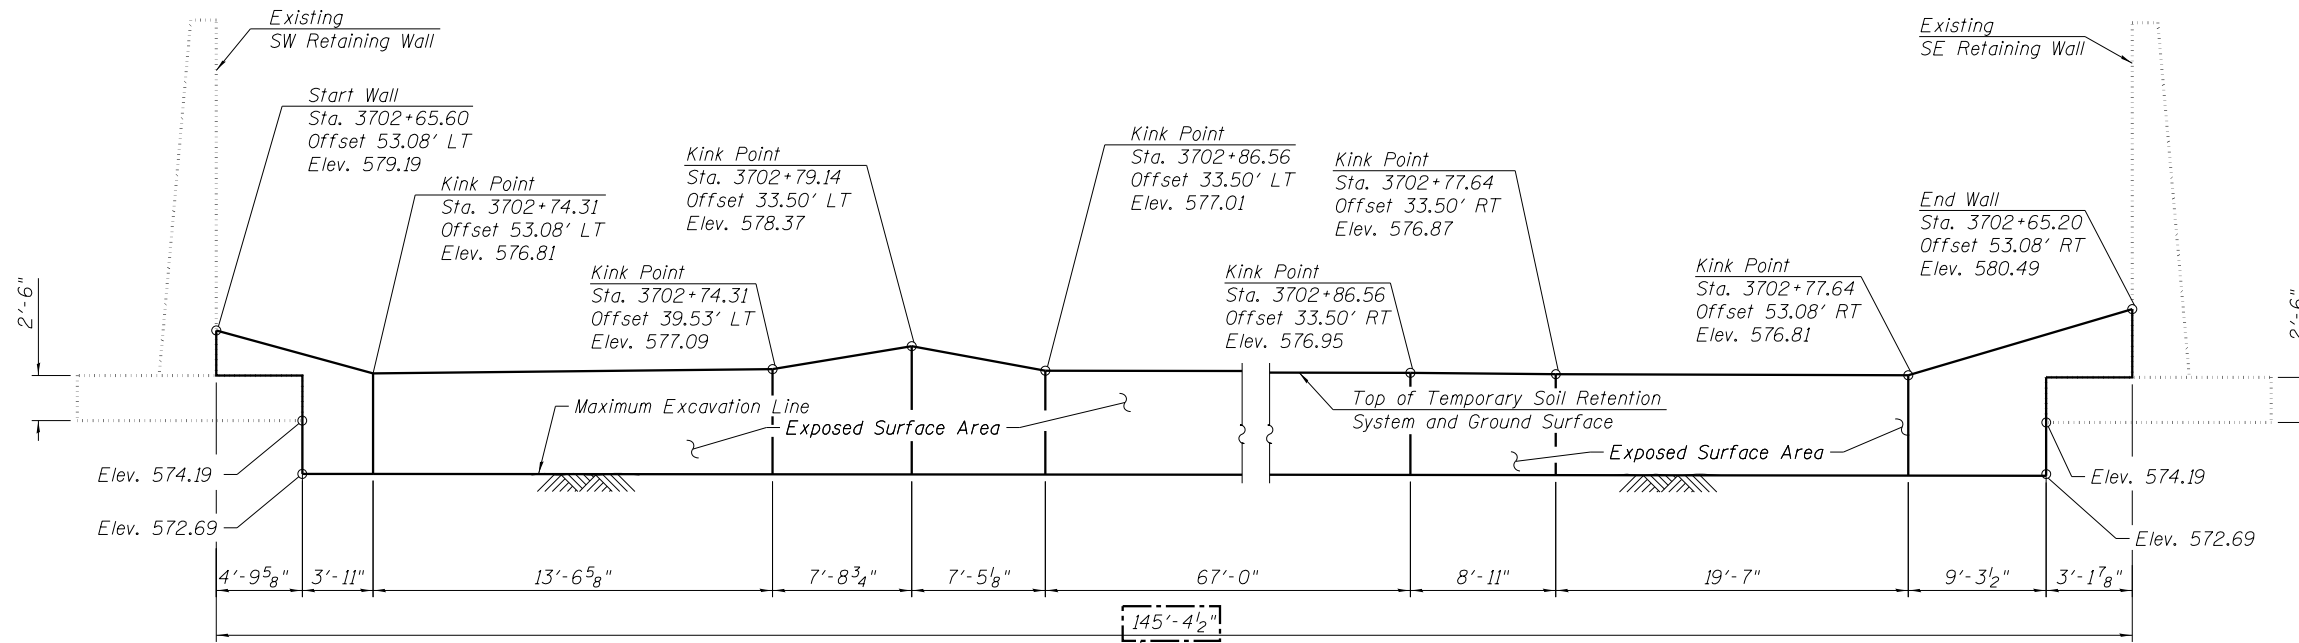

TEMPORARY SOIL RETENTION SYSTEM NO. 3
(At South Abutment)

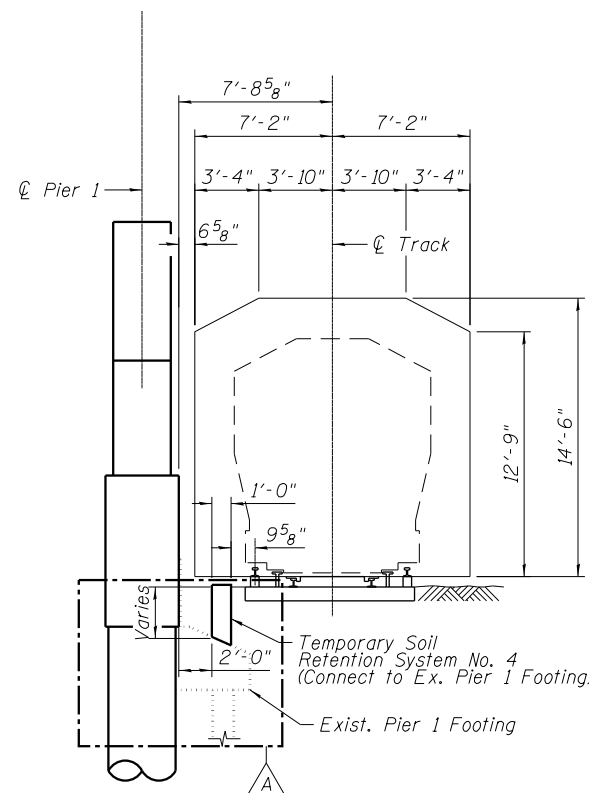

SECTION THRU CTA TRACKS
(At Pier 1)

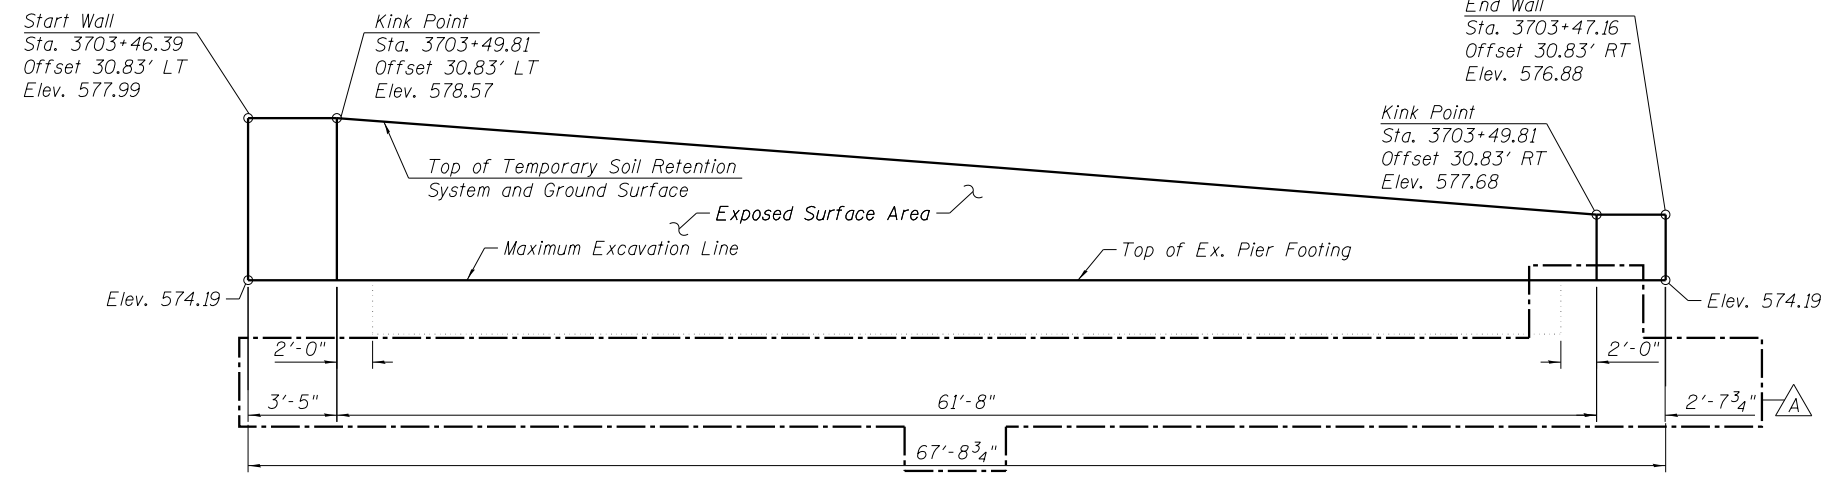

TEMPORARY SOIL RETENTION SYSTEM NO. 4
(At Pier 1)

Notes:
 Driving piles and temporary sheet piling is not allowed.
 A cantilevered sheet piling design does not appear feasible and additional members or other retention systems may be necessary. The Contractor shall submit a soil retention system design including plan details and calculations for review and acceptance by the Engineer and the CTA.
 The maximum allowable excavation slope is 1:2 (V:H).
 CTA EB Blue Line is to be shutdown during installation of Temporary Soil Retention System No. 4. Closure to be coordinated with the CTA. See Special Provision for CTA Flagging and Coordination.
 To maintain stability of Temporary Soil Retention 4, the temporary soil retention system shall be installed at 10'-0" increments. Existing Pier 1 footing shall be removed in 10'-0" increments and backfilled with compacted material to the top of existing footing.
 Temporary Soil Retention Systems exposed to railroad surcharge shall follow the design criteria per: CTA Infrastructure Design Criteria Manual, Rev. 04 March 2013, Structural - Chapter 7.

BILL OF MATERIAL

Item	Unit	Quantity
Temporary Soil Retention System	Sq. Ft.	902

4/4/2014 PM 0161708-60W29-5005-Substruct-TempExc1.dgn




USER NAME = kahastings	DESIGNED KAH	REVISED A 12/18/2013 KAH
PLOT SCALE = 10:8,0000 ' : ' / in.	CHECKED MDS	REVISED
PLOT DATE = 1/10/2014	DRAWN AJP	REVISED
	CHECKED MDS	REVISED

STATE OF ILLINOIS
DEPARTMENT OF TRANSPORTATION

TEMPORARY SOIL RETENTION DETAILS 1
STRUCTURE NO. 016-1708

SHEET NO. 5 OF 55 SHEETS


MUN	SECTION	COUNTY	TOTAL SHEETS	SHEET NO.
2090	2013-011R	COOK	356	137
CONTRACT NO.			60W29	
ILLINOIS FED. AID PROJECT				

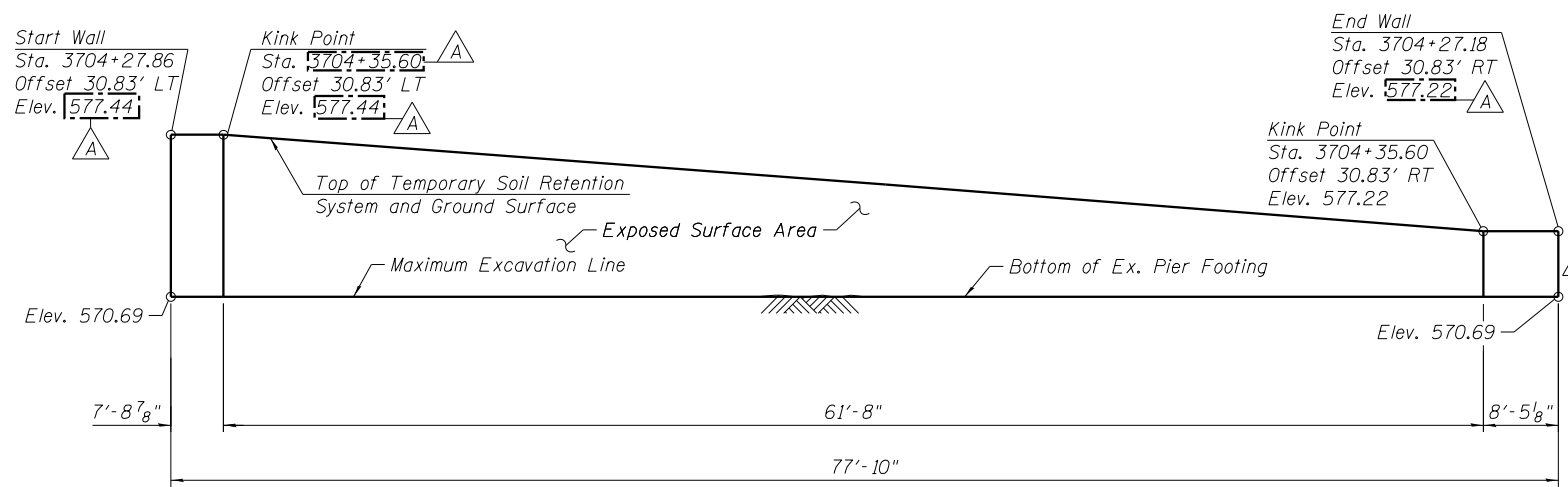

TEMPORARY SOIL RETENTION SYSTEM NO. 5


(At Pier 2)

Notes:
 Driving piles and temporary sheet piling is not allowed. A cantilevered sheet piling design does not appear feasible and additional members or other retention systems may be necessary. The Contractor shall submit a soil retention system design including plan details and calculations for review and acceptance by The Engineer.
 The maximum allowable excavation slope is 1:2 (V:H).
 The portion of Temporary Soil Retention No. 6 in conflict with the existing siphon cannot be constructed until the temporary bypass is constructed. For Siphon Plans see Sheet 71 thru 76 of 356. The existing siphon and the existing 54" combined storm sewer location shall be verified in the field and approved by the Engineer prior to temporary soil retention construction.
 Any damage to the existing siphon and the existing 54" combined storm sewer during construction shall be repaired at the Contractors expense.
 Chain Link Fence, 4' shall be installed behind the Soil Retention System at the South Abutment.

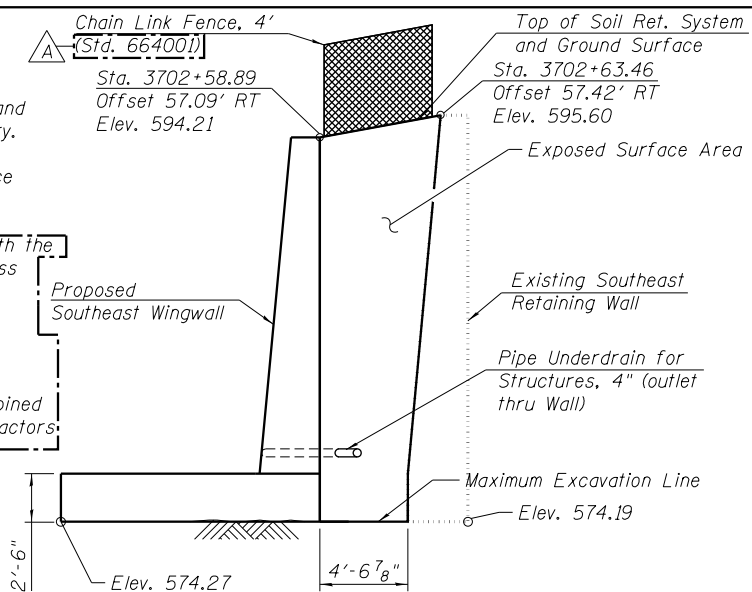


SOIL RETENTION SYSTEM

(At South Abutment)

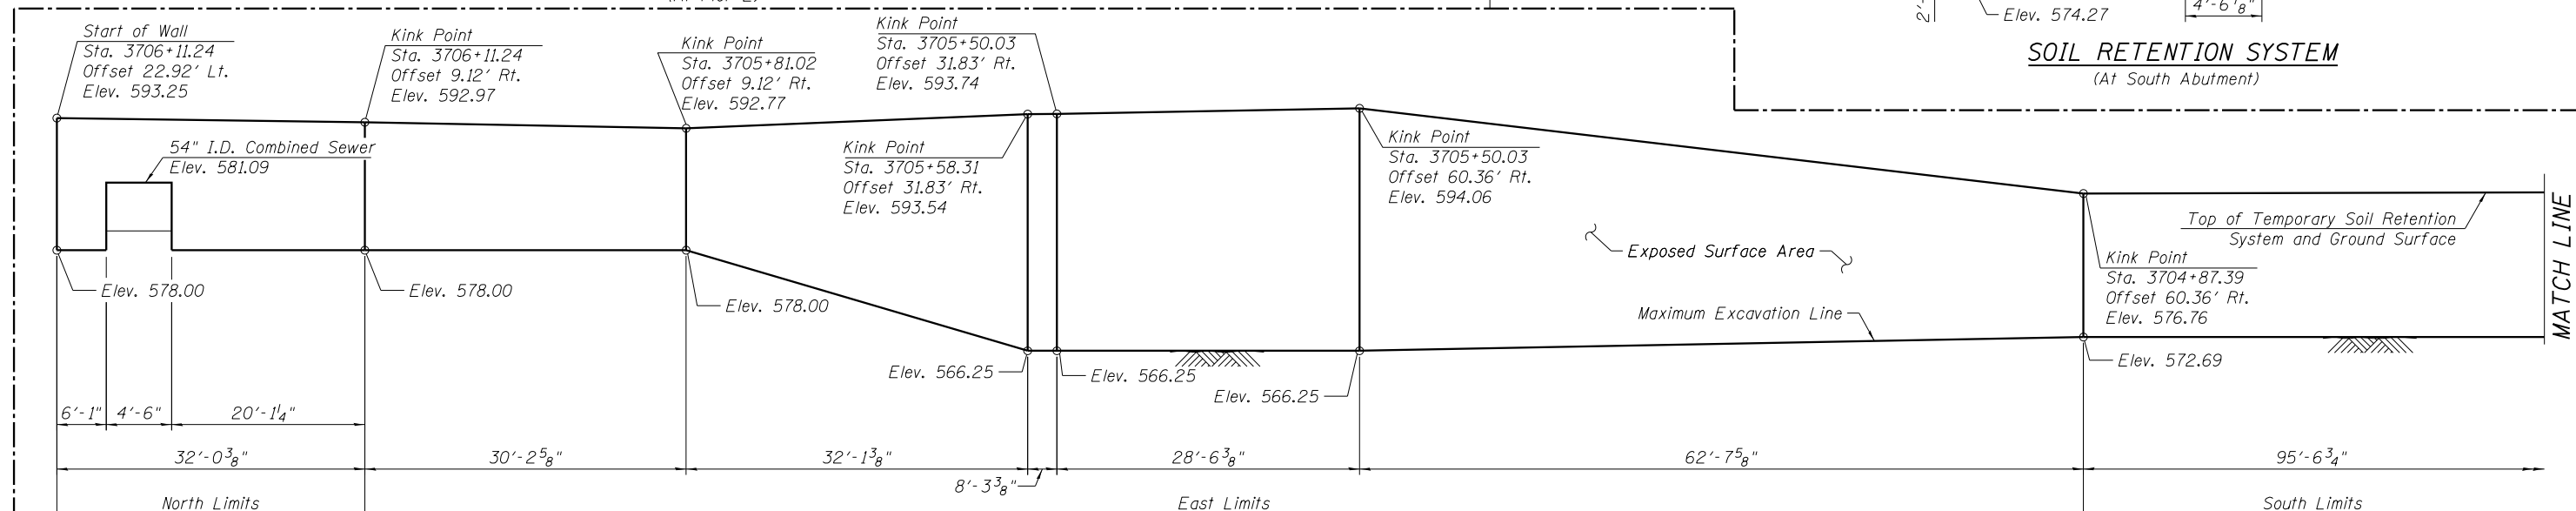

TEMPORARY SOIL RETENTION SYSTEM NO. 6

(At North Abutment)

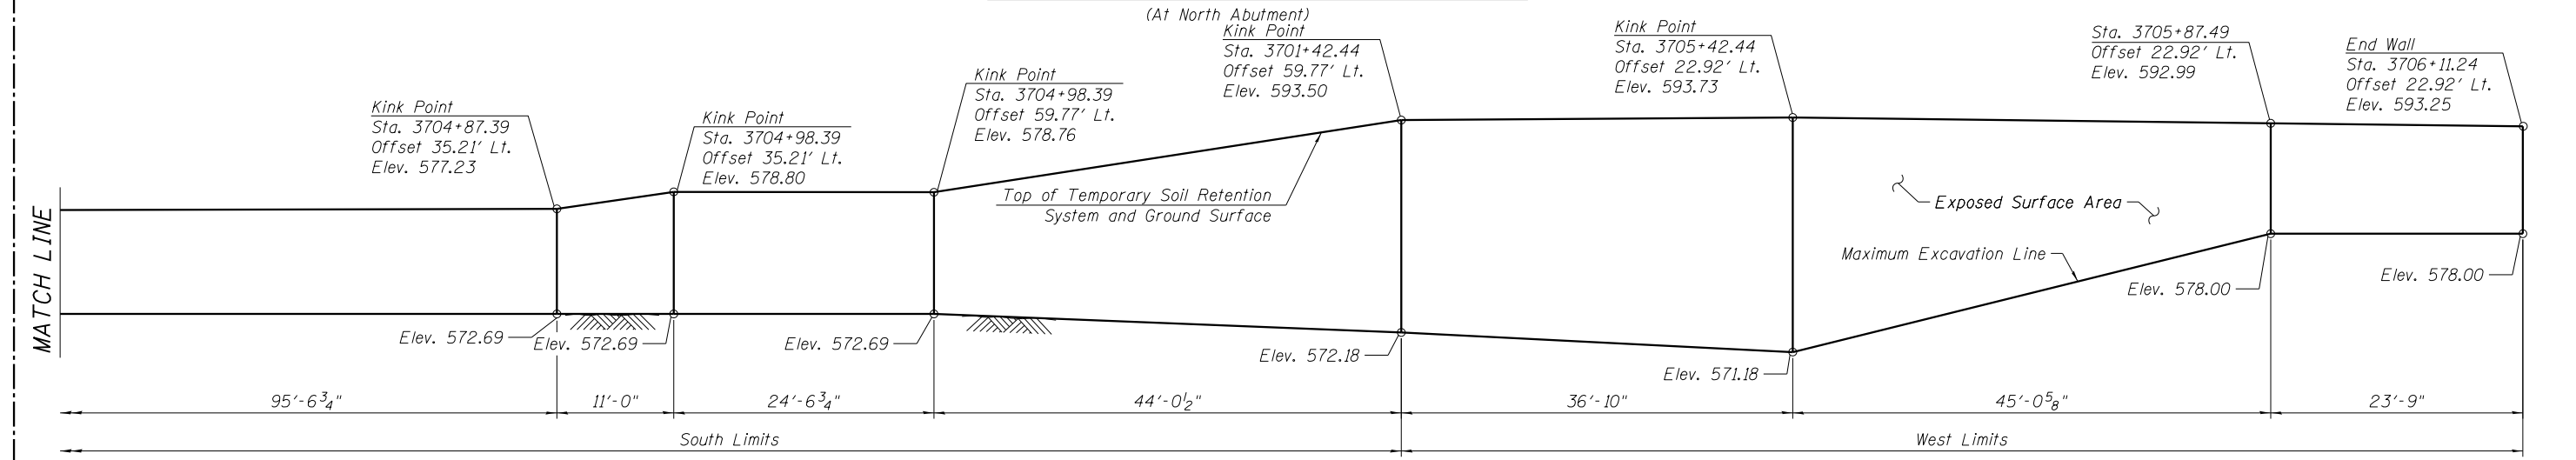

TEMPORARY SOIL RETENTION SYSTEM NO. 6

(At North Abutment)

BILL OF MATERIAL

Item	Unit	Quantity
Chain Link Fence, 4'	Foot	5
Temporary Soil Retention System	Sq. Ft.	7,022
Soil Retention System	Sq. Ft.	104

3:55:22 PM 01/17/08-60W29-5006-Substruct - TempExc2.dgn




USER NAME = kahastings	DESIGNED KAH	REVISED A 12/18/2013 KAH/MDS
PLOT SCALE = 8x0.0000 ' / in.	CHECKED MDS	REVISED
PLOT DATE = 1/10/2014	DRAWN AJP	REVISED
	CHECKED MDS	REVISED

**STATE OF ILLINOIS
DEPARTMENT OF TRANSPORTATION**

**TEMPORARY SOIL RETENTION DETAILS 2
STRUCTURE NO. 016-1708**

SHEET NO. 6 OF 55 SHEETS

MUN	SECTION	COUNTY	TOTAL SHEETS	SHEET NO.
2090	2013-011R	COOK	356	138
CONTRACT NO.			60W29	
ILLINOIS FED. AID PROJECT				

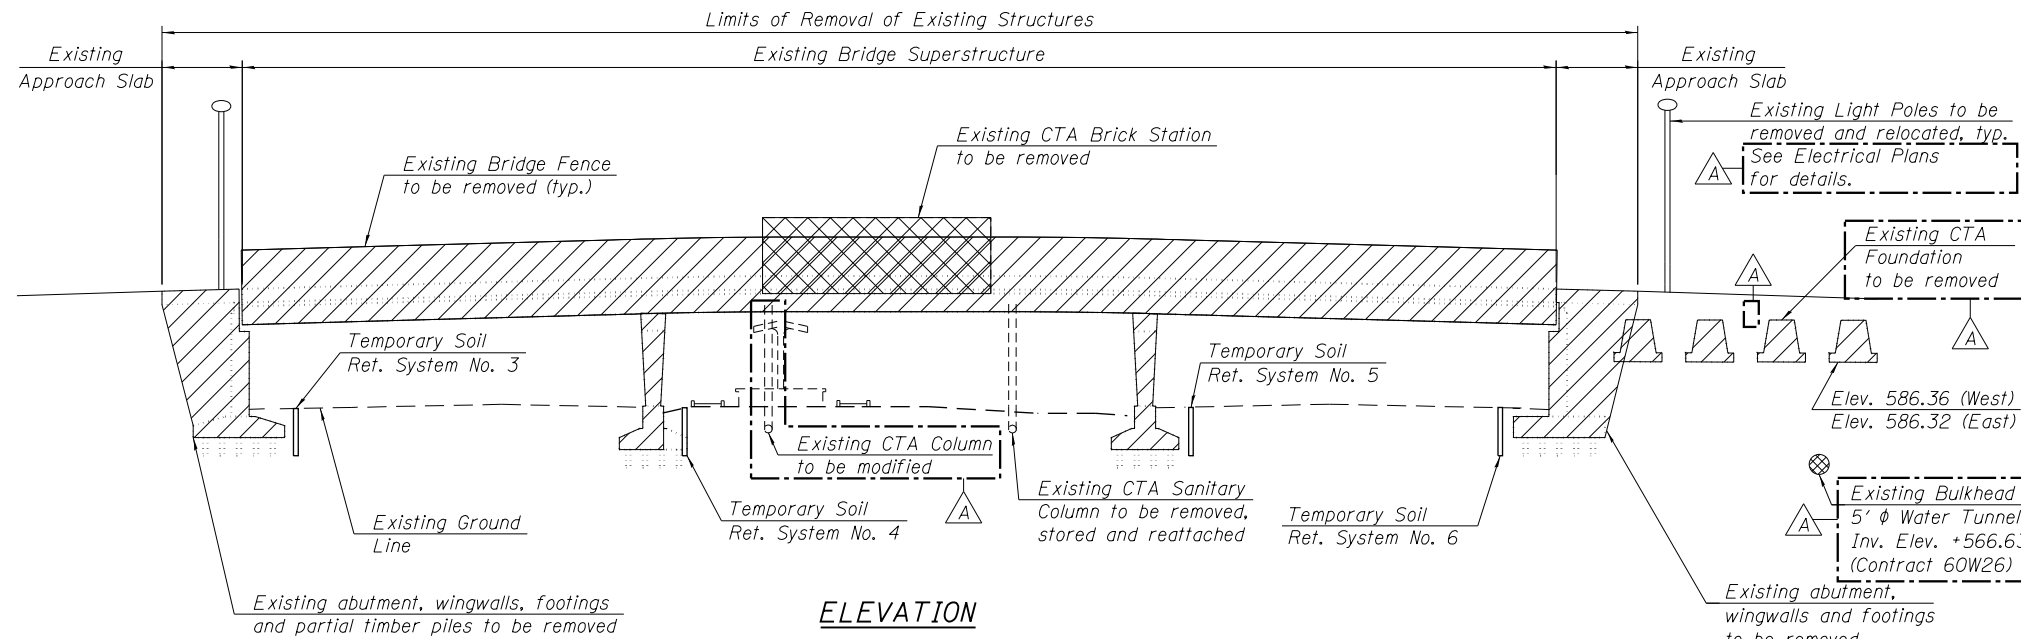

Notes:

For substructure removal, pile extraction and partial timber pile removal details, see Sheets 8 and 9 of 55.

Existing utilities between girders will be relocated to provide uninterrupted service during construction (by others). Utilities to be incorporated into new structure (by others).

The Contractor is responsible to protect the CTA tracks from falling objects and debris during removal of the existing structure.

For existing approach slab removal quantities, see Roadway plans.



Contractor to coordinate with CTA for removal, by CTA personnel, of existing station house including, but not limited to, revenue collecting machines, agent's kiosk, turnstiles, rotogates, transportation information boards, train arrival/departure information sign, advertising displays, miscellaneous signage, etc. in the existing brick station.

The cost of removing the existing CTA Brick Station is included in the cost of Removal of Existing Structures.

Temporary shoring for the existing remaining CTA station and for the CTA staircase must be in place before removal of existing structures. See CTA structural plans.

Removal of existing structures shall be in accordance with Section 501 of the Standard Specifications. This item shall include complete removal of the concrete bridge rails, concrete deck and superstructure. This item also includes partial removal of the abutment wall and wingwall down to a minimum of 1'-0" below proposed finish grade or as noted in plans.

See Sheet 35 of 55 for CTA Sanitary Column attachment details.

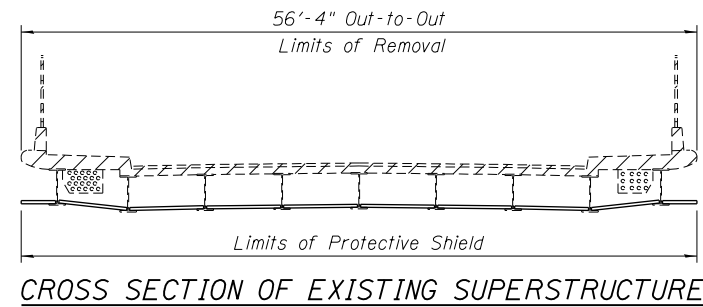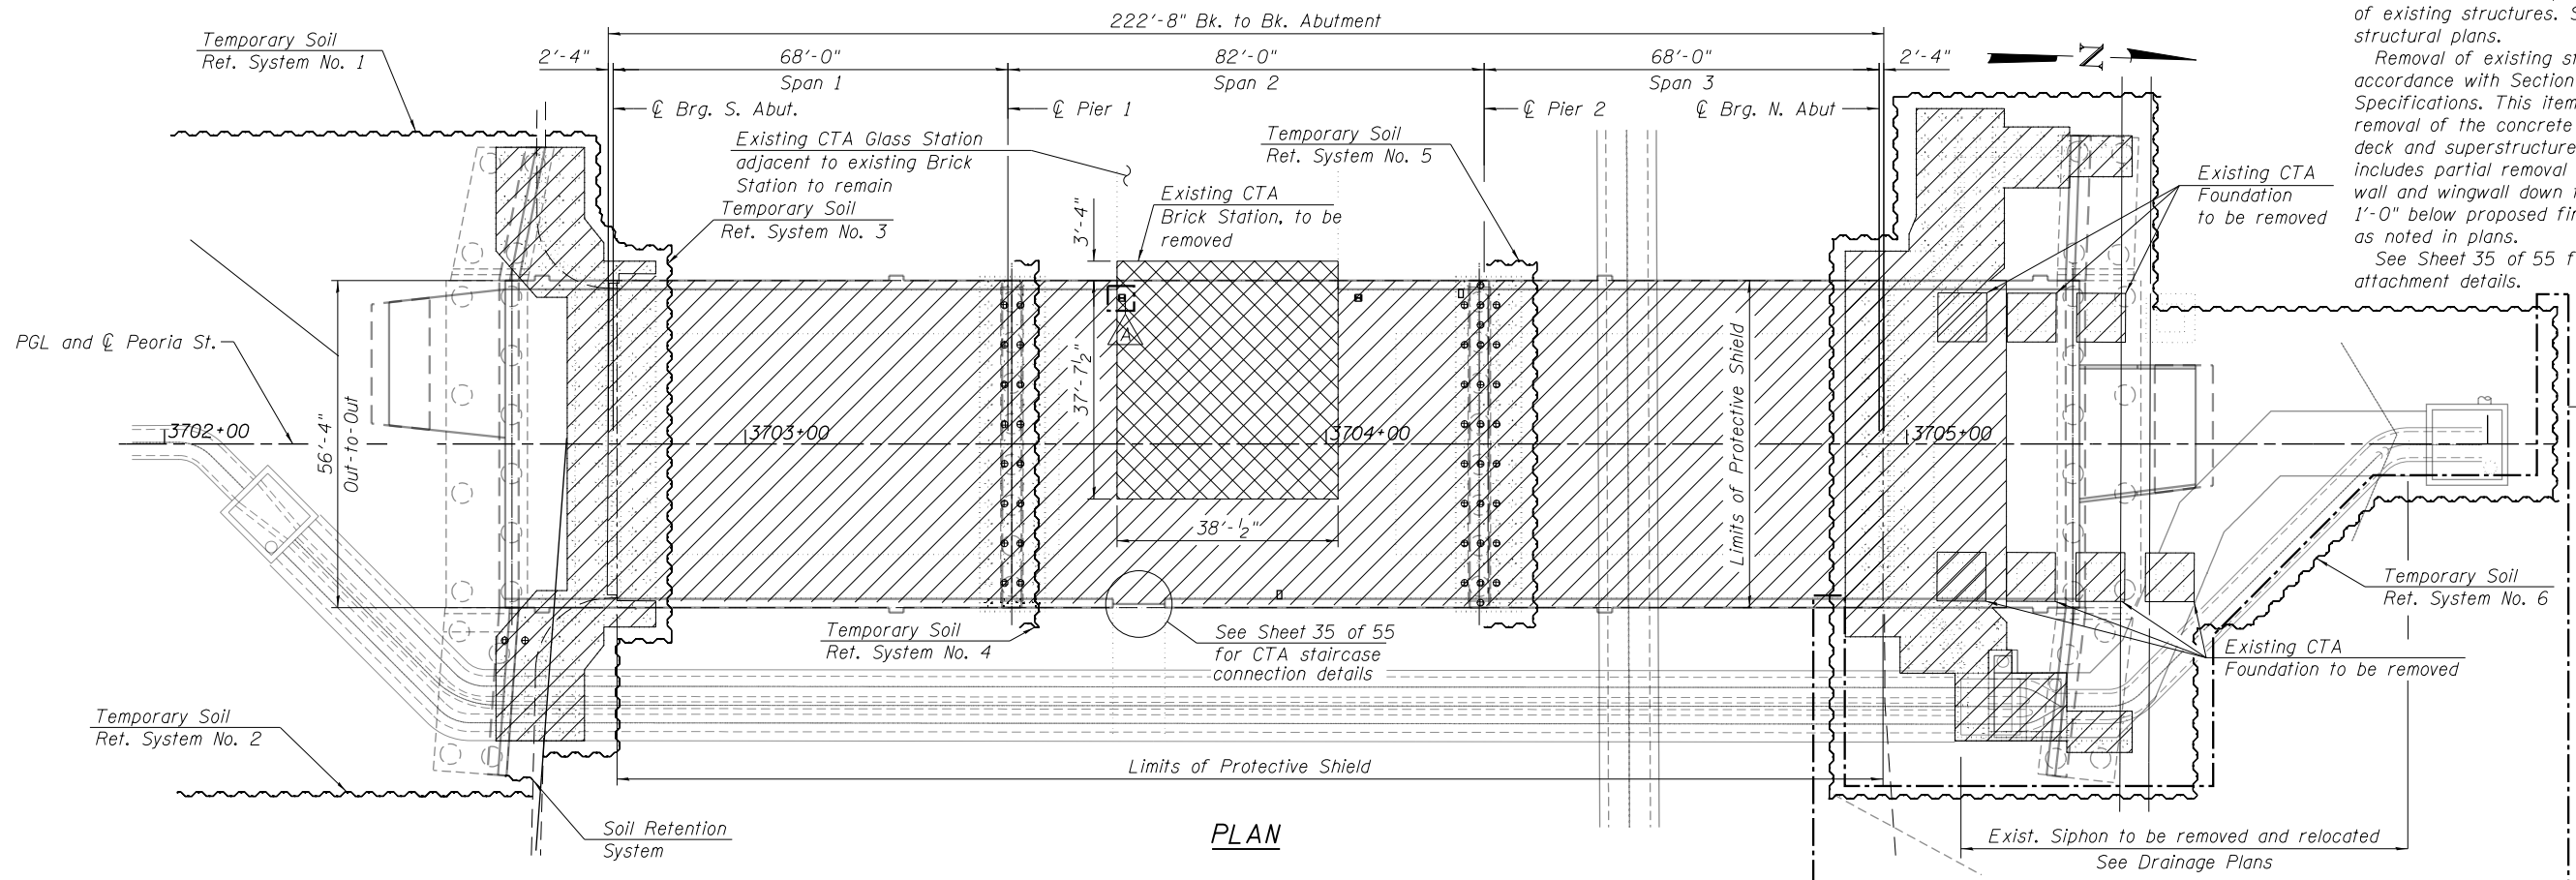

LEGEND:

	Removal Area
	Existing CTA Brick Station to be removed

BILL OF MATERIAL

Item	Unit	Quantity
Removal of Existing Structures	Each	1
Protective Shield	Sq. Yd.	1394

10:31:13 AM 0161708-60W29-5007-Removal_Det1.dgn







USER NAME = BAWIort	DESIGNED KAH	REVISED A 12/18/2013 KAH
PLOT SCALE = 32:0.0037' / in.	CHECKED MDS	REVISED
PLOT DATE = 12/19/2013	DRAWN AJP	REVISED
	CHECKED MDS	REVISED

**STATE OF ILLINOIS
DEPARTMENT OF TRANSPORTATION**

**EXISTING STRUCTURE REMOVAL DETAILS 1
STRUCTURE NO. 016-1708**

SHEET NO. 7 OF 55 SHEETS

MUN 2090	SECTION 2013-011R	COUNTY COOK	TOTAL SHEETS 356	SHEET NO. 139
CONTRACT NO. 60W29			ILLINOIS FED. AID PROJECT	

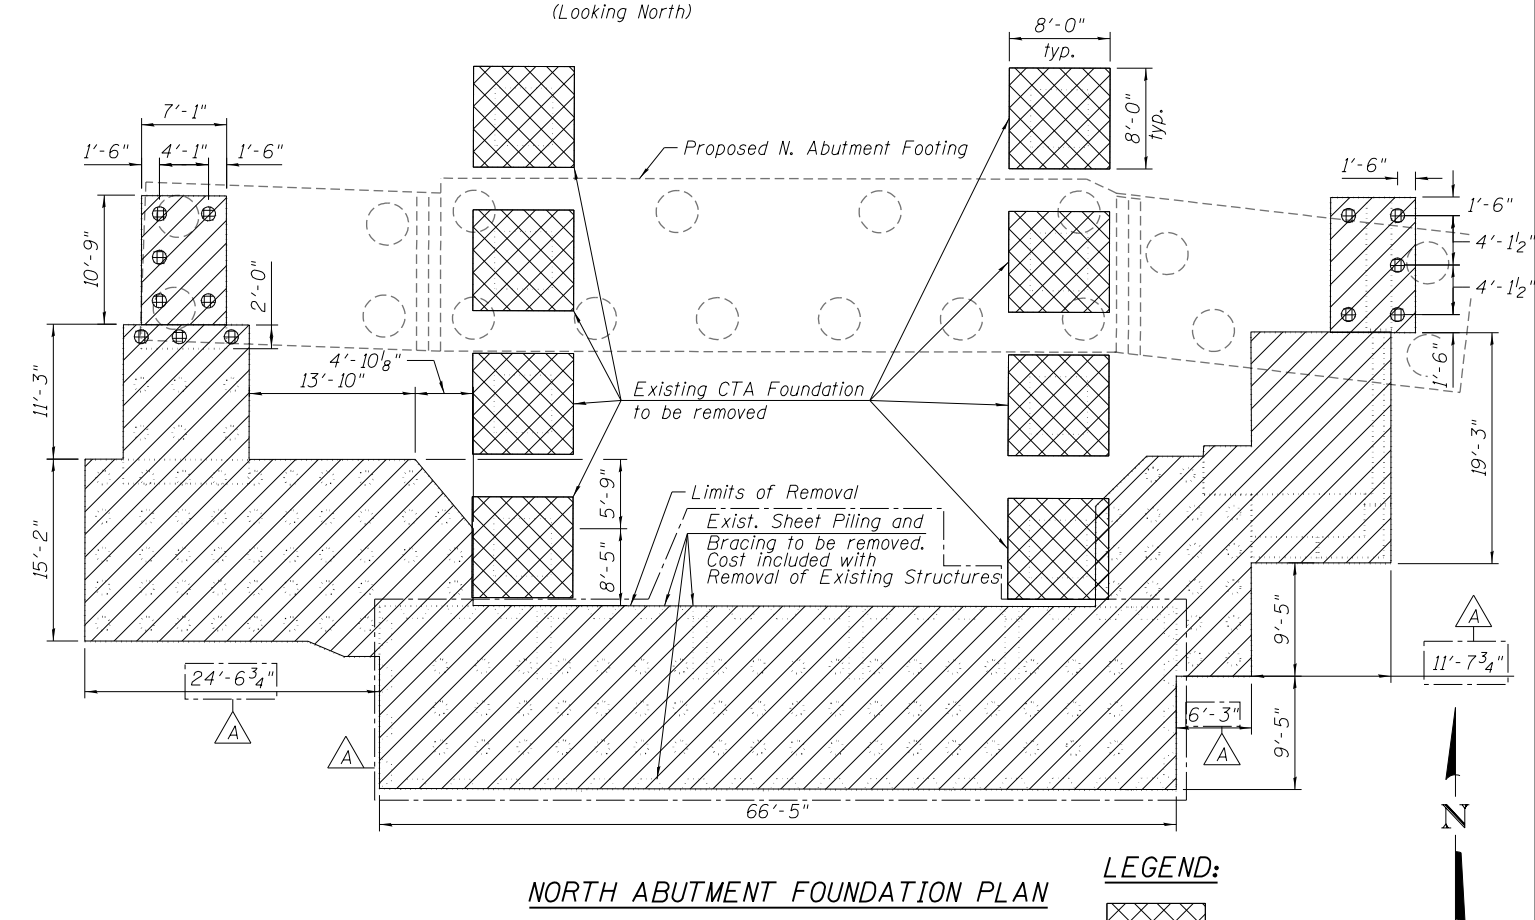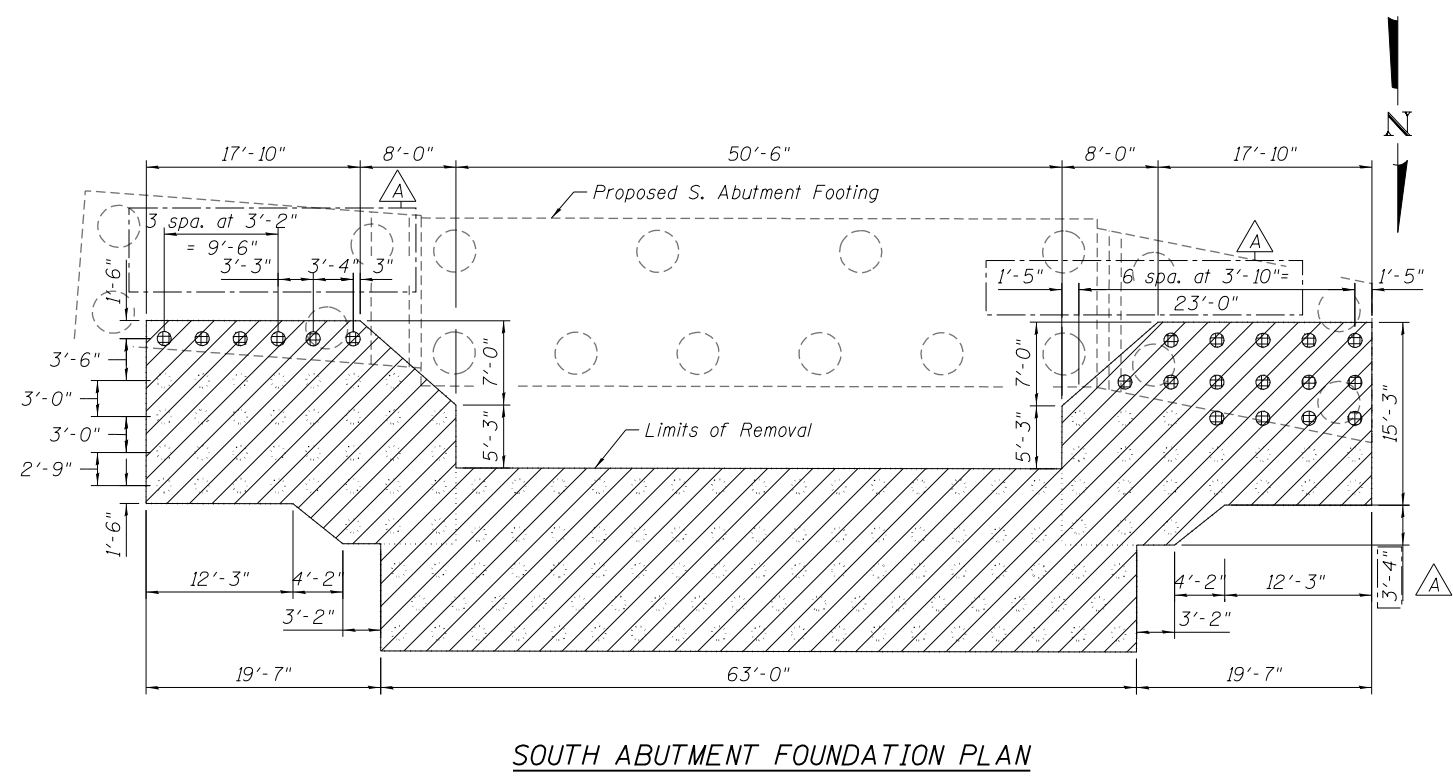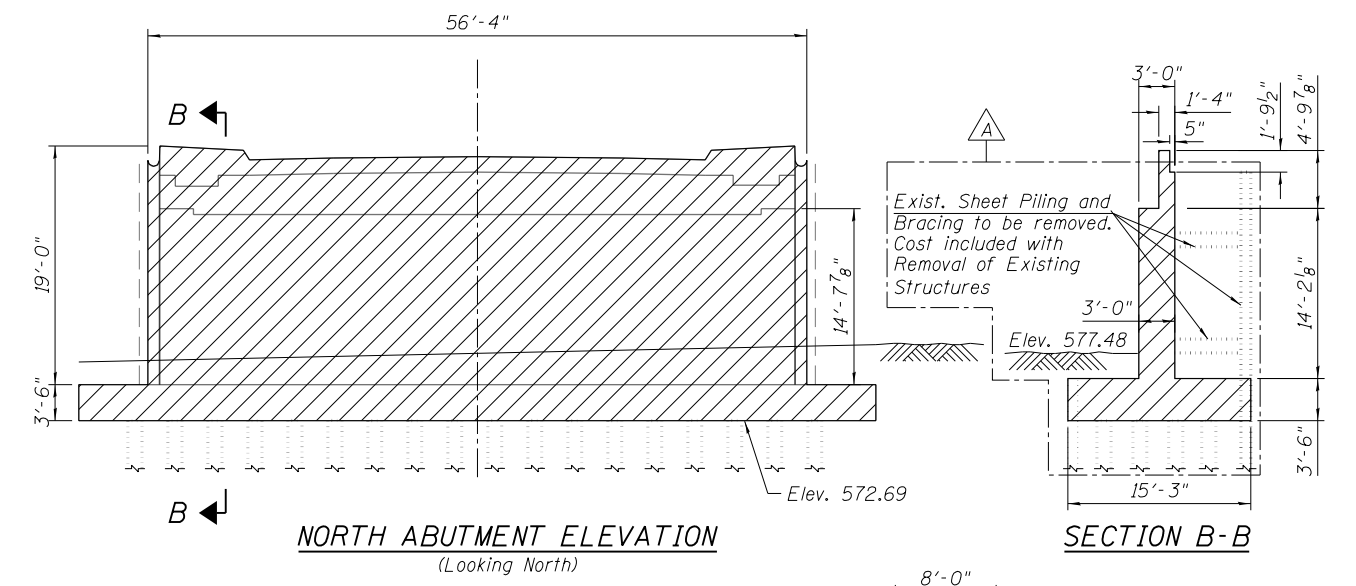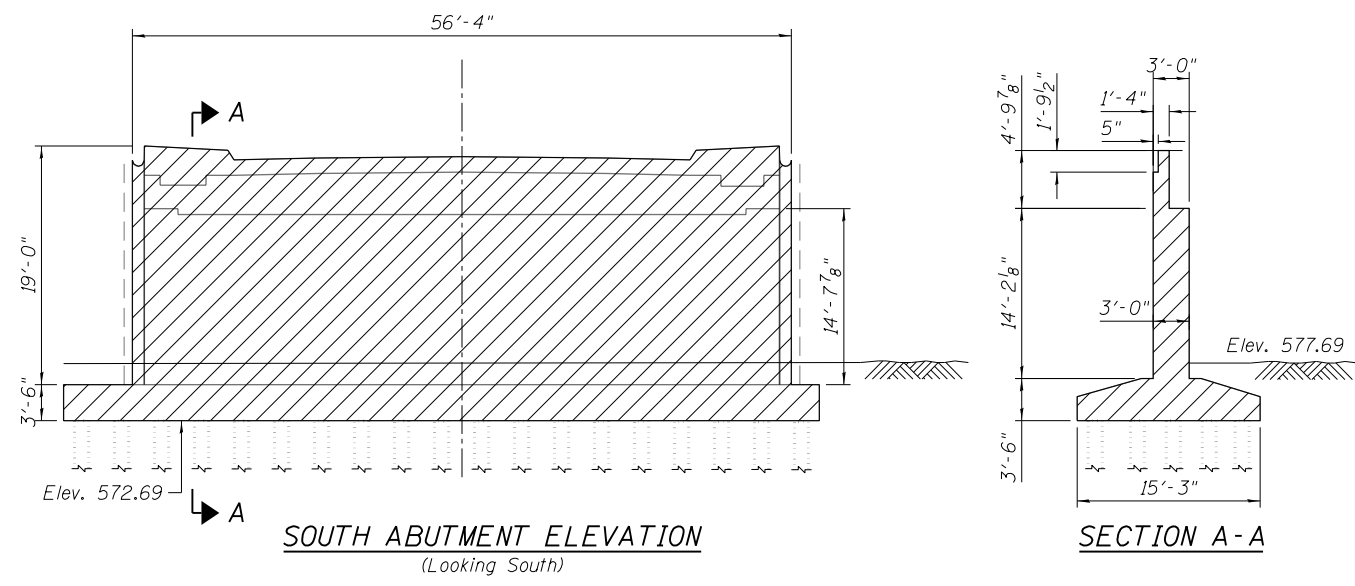

BILL OF MATERIAL

Item	Unit	Quantity
Pile Extraction	Each	34
Foundation Removal	Each	8

LEGEND:

- Foundation Removal
- Removal of Existing Structures
- Pile Extraction

10:31:15 AM 0161708-60W29-5008-Removal.Det2.dgn




USER NAME = BAWIort	DESIGNED KAH	REVISED A 12/18/2013 KAH/MDS
PLOT SCALE = 16:0.0000 ' / in.	CHECKED MDS	REVISED
PLOT DATE = 12/19/2013	DRAWN AJP	REVISED
	CHECKED MDS	REVISED

**STATE OF ILLINOIS
DEPARTMENT OF TRANSPORTATION**

**EXISTING STRUCTURE REMOVAL DETAILS 2
STRUCTURE NO. 016-1708**


SHEET NO. 8 OF 55 SHEETS

MUN 2090	SECTION 2013-011R	COUNTY COOK	TOTAL SHEETS 356	SHEET NO. 140
CONTRACT NO. 60W29			ILLINOIS FED. AID PROJECT	

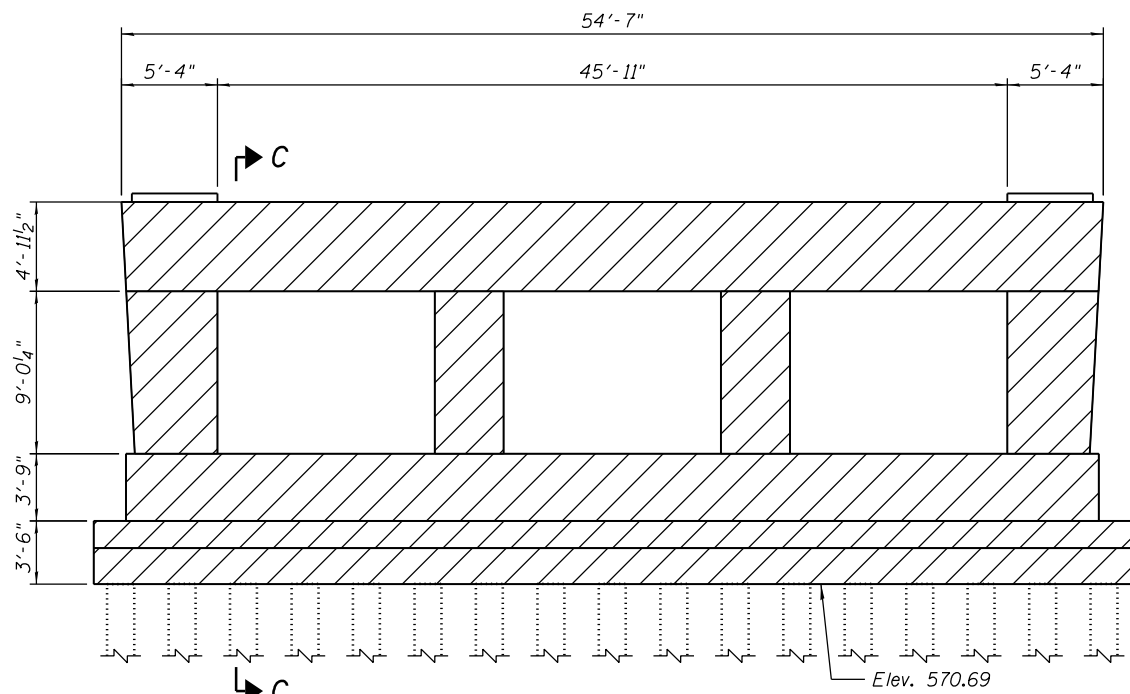


PIER 1 ELEVATION

(Looking North)

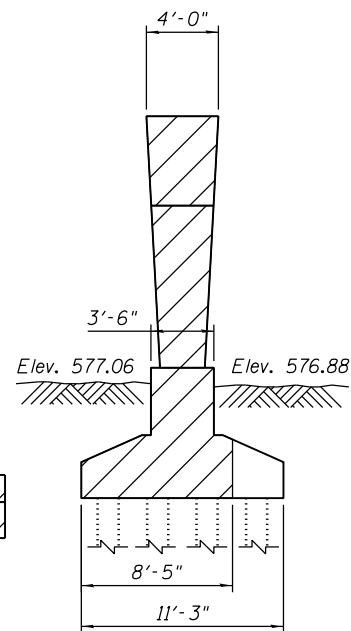


SECTION C-C

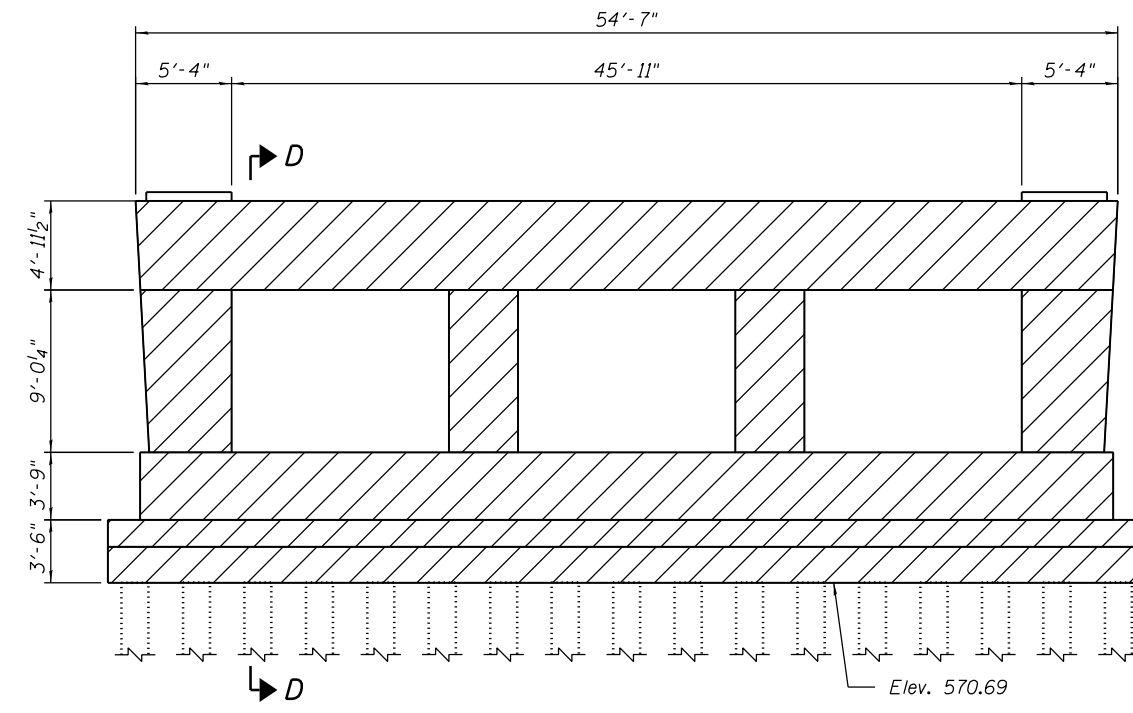


PIER 2 ELEVATION

(Looking North)

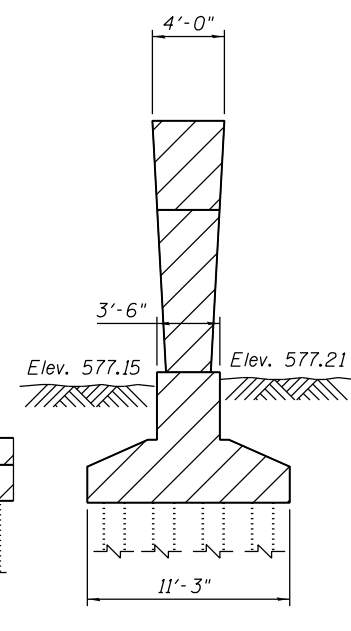


SECTION D-D

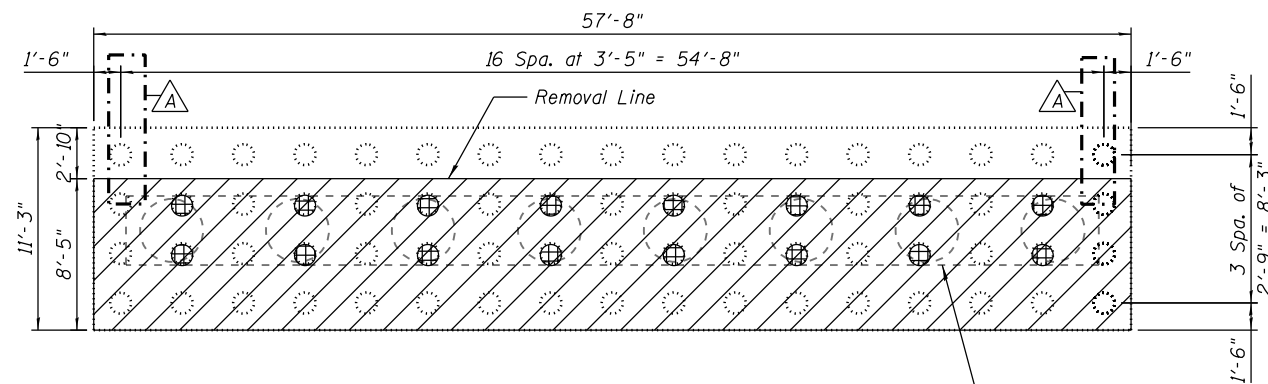

PIER 1 FOUNDATION PLAN

Proposed Pier 1
Crashwall

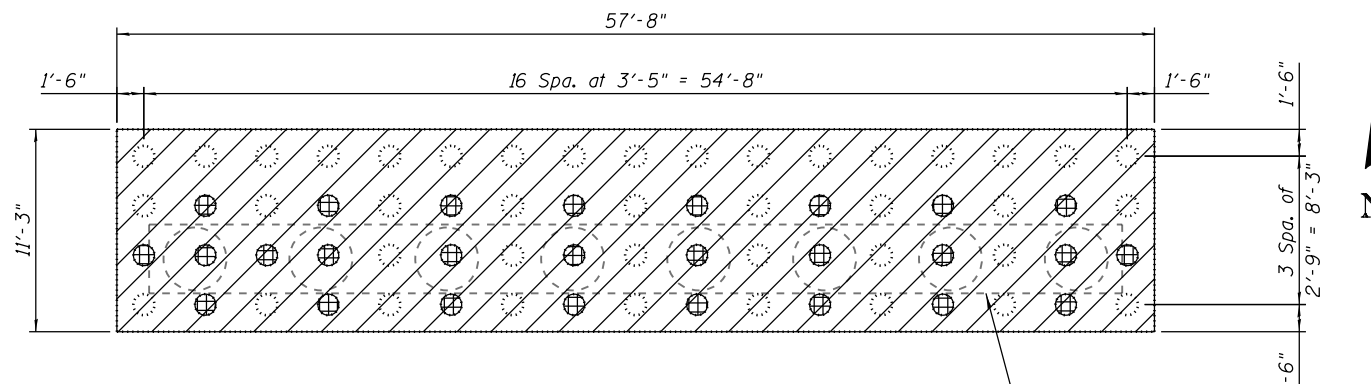

PIER 2 FOUNDATION PLAN

Proposed Pier 2
Crashwall

Note: To maintain stability of Temporary Soil Retention 4, the temporary soil retention system shall be installed at 10'-0" increments. Existing Pier 1 footing shall be removed in 10'-0" increments and backfilled with compacted material to the top of existing footing.

BILL OF MATERIAL

Item	Unit	Quantity
Pile Extraction	Each	43

LEGEND:

Removal of Existing Structures

Pile Extraction

3:52:11 PM 0161708-60W29-5009-Removal_Details.dgn



USER NAME = rlschultz	DESIGNED KAH	REVISION 12/18/2013 KAH/MDS
PLOT SCALE = 10:8,0000 ' / in.	CHECKED MDS	REVISION
PLOT DATE = 1/21/2014	DRAWN AJP	REVISION
	CHECKED MDS	REVISION


**STATE OF ILLINOIS
DEPARTMENT OF TRANSPORTATION**

**EXISTING STRUCTURE REMOVAL DETAILS 3
STRUCTURE NO. 016-1708**


SHEET NO. 9 OF 55 SHEETS

MUN	SECTION	COUNTY	TOTAL SHEETS	SHEET NO.
2090	2013-011R	COOK	356	141
CONTRACT NO. 60W29				

ILLINOIS FED. AID PROJECT

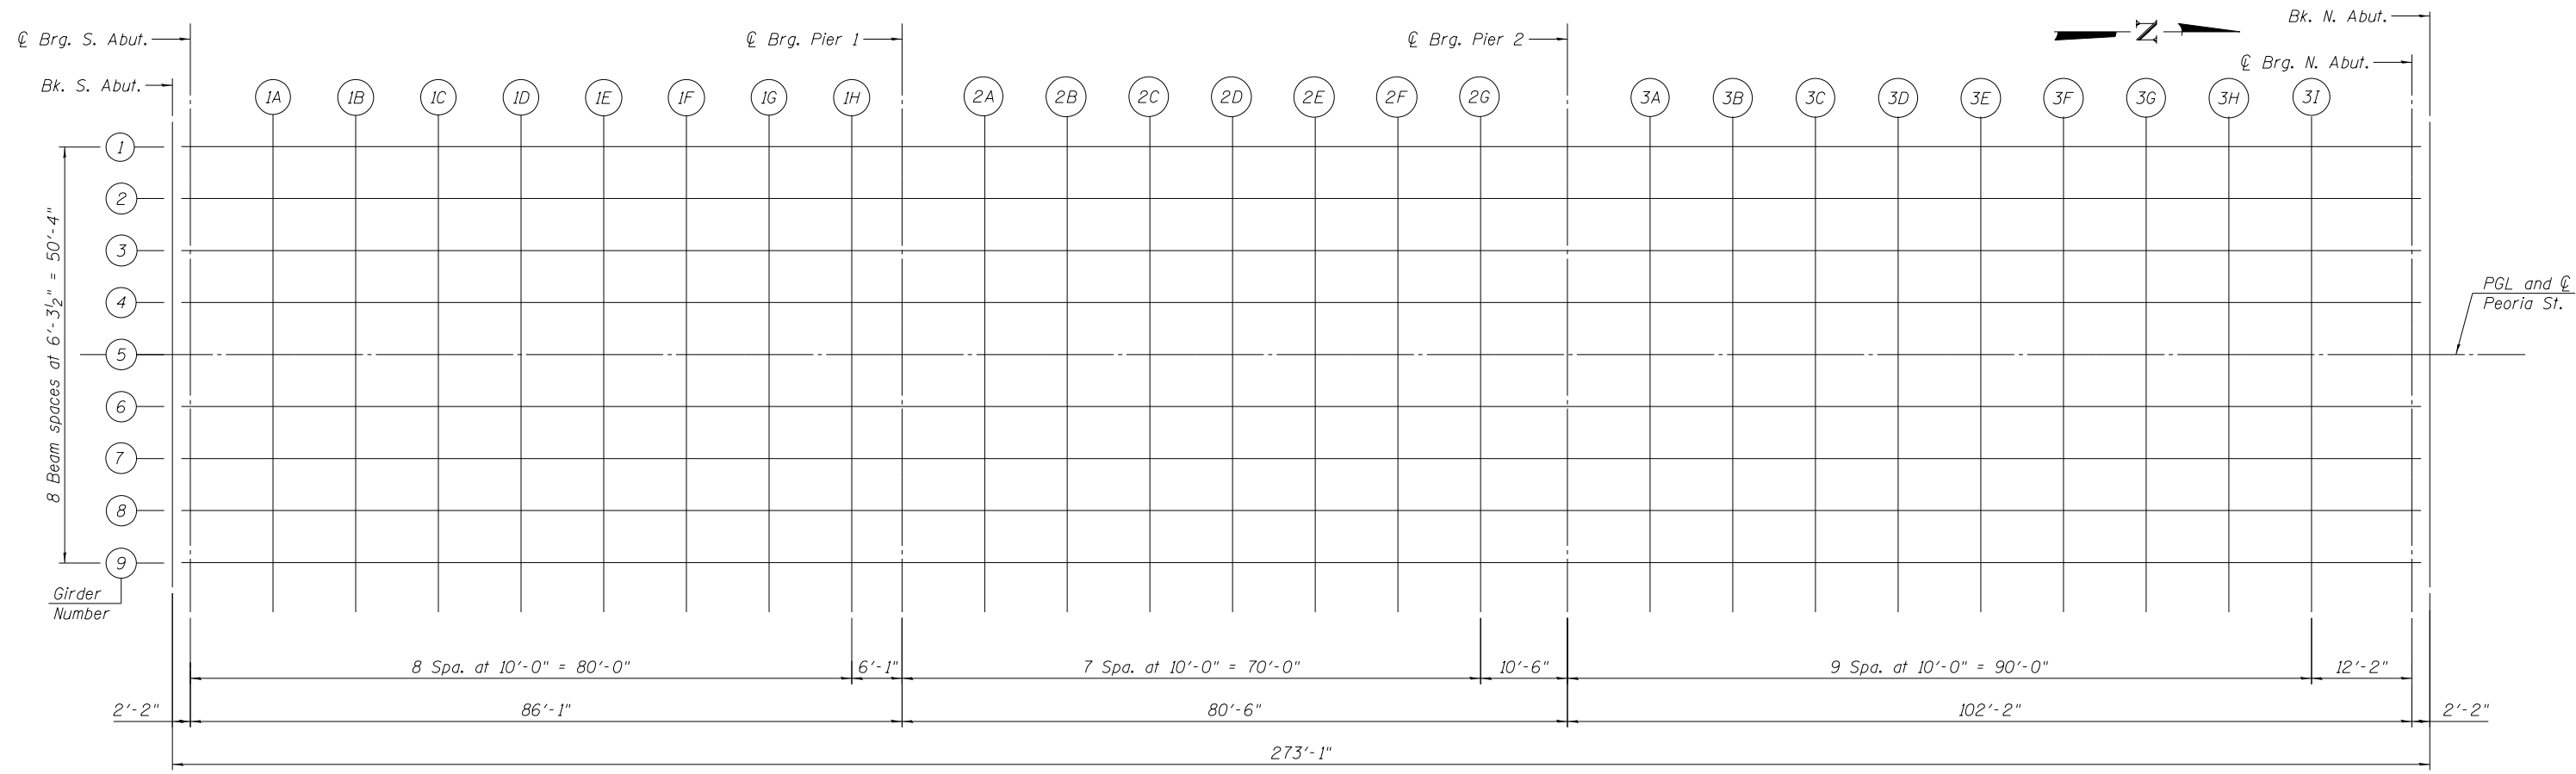


PLAN

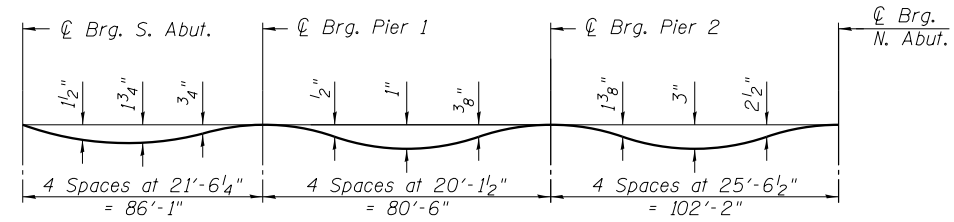


GIRDER 1 DEAD LOAD DEFLECTION DIAGRAM

(Includes weight of concrete, Bridge Deck Overlay, Bridge Fence Railing, Decorative Railing, Utility and Partial CTA Station.)

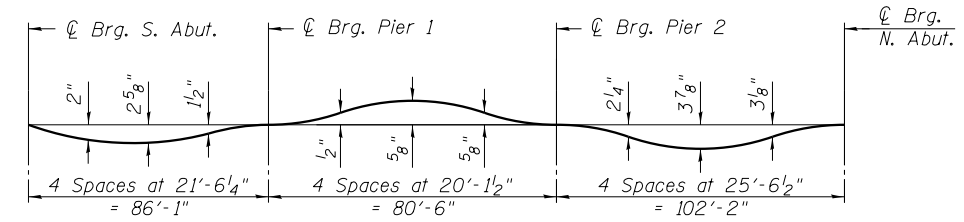


GIRDERS 2 THRU 8 DEAD LOAD DEFLECTION DIAGRAM

(Includes weight of concrete, Bridge Deck Overlay, Bridge Fence Railing, Decorative Railing and Utility.)

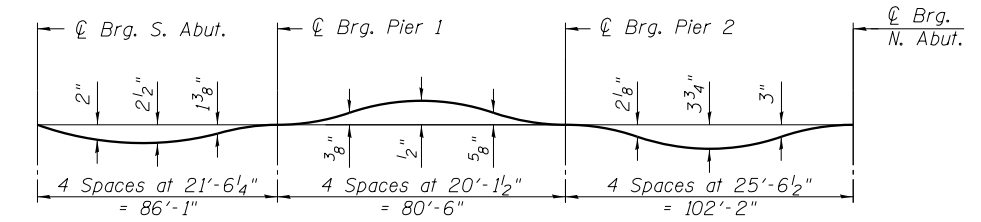

GIRDER 9 DEAD LOAD DEFLECTION DIAGRAM

(Includes weight of concrete, Bridge Deck Overlay, Bridge Fence Railing, Decorative Railing, Utility and CTA Stairway.)

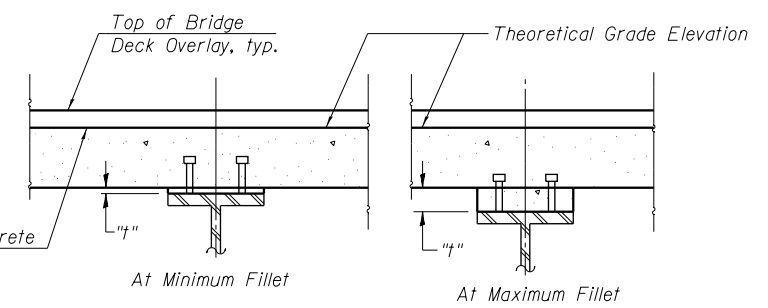

FILLET HEIGHTS

To determine "t": After all structural steel has been erected, elevations of the top flanges of the beams shall be taken at intervals shown on sheets 11 and 12 of 55. These elevations subtracted from the "Theoretical Grade Elevations Adjusted for Dead Load Deflection" shown on sheet 11 and 12 of 55, minus Precast Concrete Deck Panel thickness, equals the fillet heights "t" above top flange of beams.

Notes:
The above deflections are not to be used in the field if the engineer is working from the grade elevations adjusted for dead load deflections as shown on Sheets 11 and 12 of 55. Elevations shown on Sheets 11 and 12 of 55 are at top of Precast Concrete Deck Panel.

11:01:50 PM 01/17/08-60W29-5010-TopSlab-1.dgn



USER NAME = BAWIortt	DESIGNED = WJC	REVISED
PLOT SCALE = 20:0.0000 '1' / 1in.	CHECKED = DL	REVISED
PLOT DATE = 10/28/2013	DRAWN = RLS	REVISED
	CHECKED = DL	REVISED

STATE OF ILLINOIS
DEPARTMENT OF TRANSPORTATION

TOP OF SLAB ELEVATIONS 1
STRUCTURE NO. 016-1708

SHEET NO. 10 OF 55 SHEETS

MUN	SECTION	COUNTY	TOTAL SHEETS	SHEET NO.
2090	2013-011R	COOK	356	142
CONTRACT NO.			60W29	
ILLINOIS FED. AID PROJECT				

GIRDER 1

Table for GIRDER 1 with columns: Location, Station, Offset, Theoretical Grade Elevations*, Theoretical Grade Elevations Adjusted For Dead Load Deflection*. Includes sections for Bk. S. Abut., CL Brq. S. Abut., CL Brq. Pier 1, CL Brq. Pier 2, and CL Brq. N. Abut.

GIRDER 2

Table for GIRDER 2 with columns: Location, Station, Offset, Theoretical Grade Elevations*, Theoretical Grade Elevations Adjusted For Dead Load Deflection*. Includes sections for Bk. S. Abut., CL Brq. S. Abut., CL Brq. Pier 1, CL Brq. Pier 2, and CL Brq. N. Abut.

GIRDER 3

Table for GIRDER 3 with columns: Location, Station, Offset, Theoretical Grade Elevations*, Theoretical Grade Elevations Adjusted For Dead Load Deflection*. Includes sections for Bk. S. Abut., CL Brq. S. Abut., CL Brq. Pier 1, CL Brq. Pier 2, and CL Brq. N. Abut.

GIRDER 4

Table for GIRDER 4 with columns: Location, Station, Offset, Theoretical Grade Elevations*, Theoretical Grade Elevations Adjusted For Dead Load Deflection*. Includes sections for Bk. S. Abut., CL Brq. S. Abut., CL Brq. Pier 1, CL Brq. Pier 2, and CL Brq. N. Abut.

GIRDER 5, PGL. & C ROADWAY

Table for GIRDER 5, PGL. & C ROADWAY with columns: Location, Station, Offset, Theoretical Grade Elevations*, Theoretical Grade Elevations Adjusted For Dead Load Deflection*. Includes sections for Bk. S. Abut., CL Brq. S. Abut., CL Brq. Pier 1, CL Brq. Pier 2, and CL Brq. N. Abut.

GIRDER 6

Table for GIRDER 6 with columns: Location, Station, Offset, Theoretical Grade Elevations*, Theoretical Grade Elevations Adjusted For Dead Load Deflection*. Includes sections for Bk. S. Abut., CL Brq. S. Abut., CL Brq. Pier 1, CL Brq. Pier 2, and CL Brq. N. Abut.

* Elevations are taken at the top of the Precast Concrete Deck Panels.

10/31/19 AM 0161708-60W29-5011-TopSlab-2



Project information table including USER NAME (BAWtorf), DESIGNED (WJC), CHECKED (DL), DRAWN (RLS), PLOT DATE (12/19/2013), and REVISIONS.

STATE OF ILLINOIS DEPARTMENT OF TRANSPORTATION

TOP OF SLAB ELEVATIONS 2 STRUCTURE NO. 016-1708

SHEET NO. 11 OF 55 SHEETS

Municipal and project details table including MUN (2090), SECTION (2013-011R), COUNTY (COOK), CONTRACT NO. (60W29), and SHEET NO. (143).

ILLINOIS FED. AID PROJECT

GIRDER 7

GIRDER 8

GIRDER 9

Location	Station	Offset	Theoretical Grade Elevations*	Theoretical Grade Elevations Adjusted For Dead Load Deflection *	
A- [CL Brg. S. Abut.] Bk. S. Abut.	3702+57.64	12.58	596.65	596.65	
	3702+59.81	12.58	596.67	596.67	
	1A 3702+69.81	12.58	596.77	596.86	
	1B 3702+79.81	12.58	596.87	597.03	
	1C 3702+89.81	12.58	596.97	597.17	
	1D 3702+99.81	12.58	597.06	597.28	
	1E 3703+09.81	12.58	597.16	597.36	
	1F 3703+19.81	12.58	597.26	597.41	
	1G 3703+29.81	12.58	597.36	597.45	
	1H 3703+39.81	12.58	597.45	597.49	
A- [CL Brg. Pier 1]	3703+45.89	12.58	597.51	597.51	
	2A 3703+55.89	12.58	597.61	597.58	
	2B 3703+65.89	12.58	597.71	597.66	
	2C 3703+75.89	12.58	597.81	597.75	
	2D 3703+85.89	12.58	597.90	597.85	
	2E 3703+95.89	12.58	598.00	597.94	
	2F 3704+05.89	12.58	598.10	598.04	
	2G 3704+15.89	12.58	598.20	598.16	
	3A 3704+26.39	12.58	598.30	598.30	
	3B 3704+36.39	12.58	598.40	598.46	
A- [CL Brg. Pier 2]	3704+46.39	12.58	598.49	598.63	
	3C 3704+56.39	12.58	598.59	598.81	
	3D 3704+66.39	12.58	598.69	598.97	
	3E 3704+76.39	12.58	598.74	599.06	
	3F 3704+86.39	12.58	598.72	599.05	
	3G 3704+96.39	12.58	598.62	598.92	
	3H 3705+06.39	12.58	598.46	598.69	
	3I 3705+16.39	12.58	598.22	598.35	
	A- [CL Brg. N. Abut.] Bk. N. Abut.	3705+28.56	12.58	597.83	597.83
		3705+30.73	12.58	597.74	597.74

Location	Station	Offset	Theoretical Grade Elevations*	Theoretical Grade Elevations Adjusted For Dead Load Deflection *	
A- [CL Brg. S. Abut.] Bk. S. Abut.	3702+57.64	18.88	596.56	596.56	
	3702+59.81	18.88	596.58	596.58	
	1A 3702+69.81	18.88	596.68	596.77	
	1B 3702+79.81	18.88	596.77	596.94	
	1C 3702+89.81	18.88	596.87	597.08	
	1D 3702+99.81	18.88	596.97	597.19	
	1E 3703+09.81	18.88	597.07	597.27	
	1F 3703+19.81	18.88	597.16	597.32	
	1G 3703+29.81	18.88	597.26	597.35	
	1H 3703+39.81	18.88	597.36	597.39	
A- [CL Brg. Pier 1]	3703+45.89	18.88	597.42	597.42	
	2A 3703+55.89	18.88	597.52	597.49	
	2B 3703+65.89	18.88	597.61	597.57	
	2C 3703+75.89	18.88	597.71	597.66	
	2D 3703+85.89	18.88	597.81	597.75	
	2E 3703+95.89	18.88	597.91	597.85	
	2F 3704+05.89	18.88	598.00	597.95	
	2G 3704+15.89	18.88	598.10	598.06	
	3A 3704+26.39	18.88	598.20	598.20	
	3B 3704+36.39	18.88	598.30	598.37	
A- [CL Brg. Pier 2]	3704+46.39	18.88	598.40	598.54	
	3C 3704+56.39	18.88	598.50	598.71	
	3D 3704+66.39	18.88	598.59	598.88	
	3E 3704+76.39	18.88	598.64	598.97	
	3F 3704+86.39	18.88	598.62	598.95	
	3G 3704+96.39	18.88	598.53	598.83	
	3H 3705+06.39	18.88	598.36	598.59	
	3I 3705+16.39	18.88	598.12	598.26	
	A- [CL Brg. N. Abut.] Bk. N. Abut.	3705+28.56	18.88	597.73	597.73
		3705+30.73	18.88	597.65	597.65

Location	Station	Offset	Theoretical Grade Elevations*	Theoretical Grade Elevations Adjusted For Dead Load Deflection *	
A- [CL Brg. S. Abut.] Bk. S. Abut.	3702+57.64	25.17	596.46	596.46	
	3702+59.81	25.17	596.49	596.49	
	1A 3702+69.81	25.17	596.58	596.67	
	1B 3702+79.81	25.17	596.68	596.83	
	1C 3702+89.81	25.17	596.78	596.97	
	1D 3702+99.81	25.17	596.88	597.08	
	1E 3703+09.81	25.17	596.97	597.16	
	1F 3703+19.81	25.17	597.07	597.21	
	1G 3703+29.81	25.17	597.17	597.25	
	1H 3703+39.81	25.17	597.27	597.29	
A- [CL Brg. Pier 1]	3703+45.89	25.17	597.32	597.32	
	2A 3703+55.89	25.17	597.42	597.40	
	2B 3703+65.89	25.17	597.52	597.48	
	2C 3703+75.89	25.17	597.62	597.58	
	2D 3703+85.89	25.17	597.71	597.67	
	2E 3703+95.89	25.17	597.81	597.76	
	2F 3704+05.89	25.17	597.91	597.86	
	2G 3704+15.89	25.17	598.01	597.97	
	3A 3704+26.39	25.17	598.11	598.11	
	3B 3704+36.39	25.17	598.21	598.27	
A- [CL Brg. Pier 2]	3704+46.39	25.17	598.30	598.44	
	3C 3704+56.39	25.17	598.40	598.61	
	3D 3704+66.39	25.17	598.50	598.77	
	3E 3704+76.39	25.17	598.55	598.86	
	3F 3704+86.39	25.17	598.53	598.85	
	3G 3704+96.39	25.17	598.43	598.72	
	3H 3705+06.39	25.17	598.27	598.49	
	3I 3705+16.39	25.17	598.03	598.16	
	A- [CL Brg. N. Abut.] Bk. N. Abut.	3705+28.56	25.17	597.64	597.64
		3705+30.73	25.17	597.56	597.56

* Elevations are taken at the top of the Precast Concrete Deck Panels.

10:31:20 AM
01/17/08-60W29-5012-TopSlab.3



USER NAME = BAWItoft	DESIGNED WJC	REVISED A 12/18/2013 WJC/DL
	CHECKED DL	REVISED
PLOT SCALE = 0x2.0000 '1" / 1in.	DRAWN RLS	REVISED
PLOT DATE = 12/19/2013	CHECKED DL	REVISED

**STATE OF ILLINOIS
DEPARTMENT OF TRANSPORTATION**

**TOP OF SLAB ELEVATIONS 3
STRUCTURE NO. 016-1708**

SHEET NO. 12 OF 55 SHEETS

MUN	SECTION	COUNTY	TOTAL SHEETS	SHEET NO.
2090	2013-011R	COOK	356	144
CONTRACT NO.			60W29	
ILLINOIS FED. AID PROJECT				

A

S. APPR. WEST CURB LINE

Location	Station	Offset	Theoretical Grade Elevations
S. End South Appr. Slab	42+78.19	-21.10	596.53
A1	42+88.02	-23.26	596.61
Slope Transition Line	42+96.86	-25.21	596.63
* N. End South Appr. Slab	3702+58.64	-26.67	596.64

S. APPR. PGL & EAST CURB LINE

Location	Station	Offset	Theoretical Grade Elevations
S. End South Appr. Slab	42+80.40	0.00	596.77
A1	42+90.45	0.00	596.92
Slope Transition Line	42+96.86	0.00	596.98
* N. End South Appr. Slab	3702+58.64	-1.10	597.02

* Stations and offsets at the North End of the South Approach Slab are taken along the PGL of the Peoria Street Bridge.

N. APPR. WEST CURB LINE

Location	Station	Offset	Theoretical Grade Elevations
S. End North Appr. Slab	3705+29.73	-13.00	597.96
A2	3705+39.73	-13.00	597.64
N. End North Appr. Slab	3705+49.73	-13.00	597.31

N. APPR. CROWN

Location	Station	Offset	Theoretical Grade Elevations
S. End North Appr. Slab	3705+29.73	0.00	598.16
A2	3705+39.73	-2.50	597.80
N. End North Appr. Slab	3705+49.73	-5.00	597.43



N. APPR. PGL & C ROADWAY

Location	Station	Offset	Theoretical Grade Elevations
S. End North Appr. Slab	3705+29.73	0.00	598.16
A2	3705+39.73	0.00	597.76
N. End North Appr. Slab	3705+49.73	0.00	597.35

N. APPR. EAST CURB LINE

Location	Station	Offset	Theoretical Grade Elevations
S. End North Appr. Slab	3705+29.73	9.46	598.02
A2	3705+39.73	8.21	597.64
N. End North Appr. Slab	3705+49.73	6.96	597.25

A

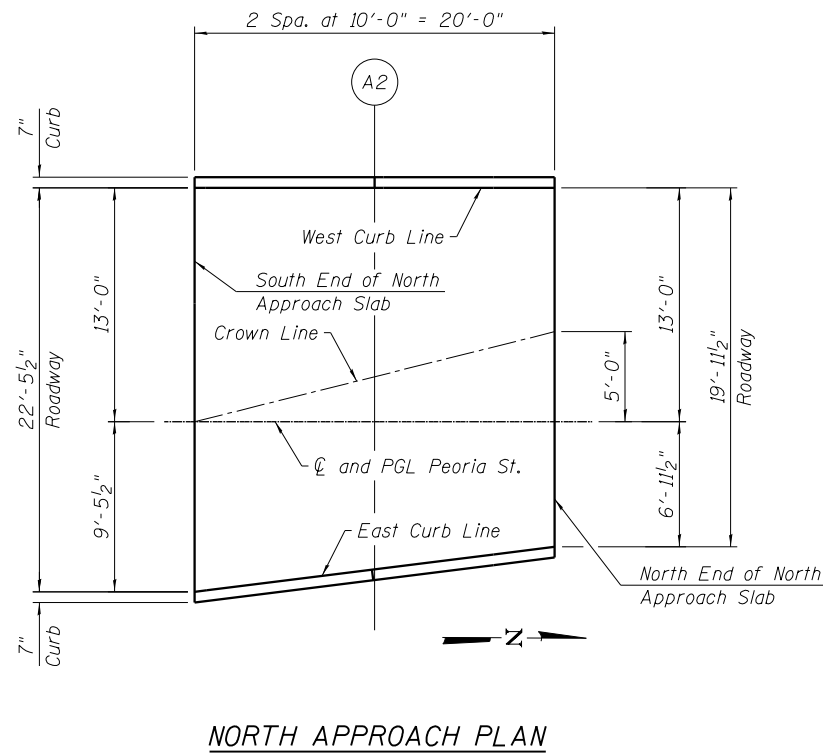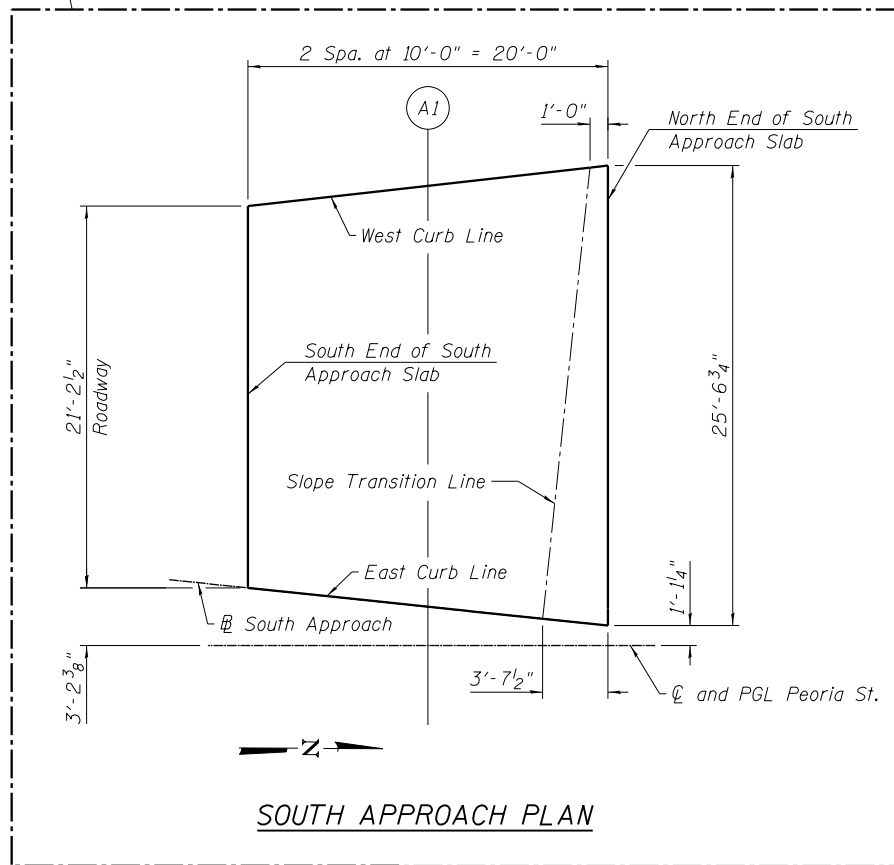

10:31:21 AM 01/17/08-60W29-5013-TopSlab-5.dgn




USER NAME = BAWIort	DESIGNED WJC	REVISED A 12/18/2013 WJC/DL
PLOT SCALE = 10:8.0012 ' / in.	CHECKED DL	REVISED
PLOT DATE = 12/19/2013	DRAWN WJC	REVISED
	CHECKED DL	REVISED

STATE OF ILLINOIS
DEPARTMENT OF TRANSPORTATION

TOP OF APPROACH SLAB ELEVATIONS
STRUCTURE NO. 016-1708

SHEET NO. 13 OF 55 SHEETS

MUN	SECTION	COUNTY	TOTAL SHEETS	SHEET NO.
2090	2013-011R	COOK	356	145
CONTRACT NO.			60W29	
ILLINOIS FED. AID PROJECT				

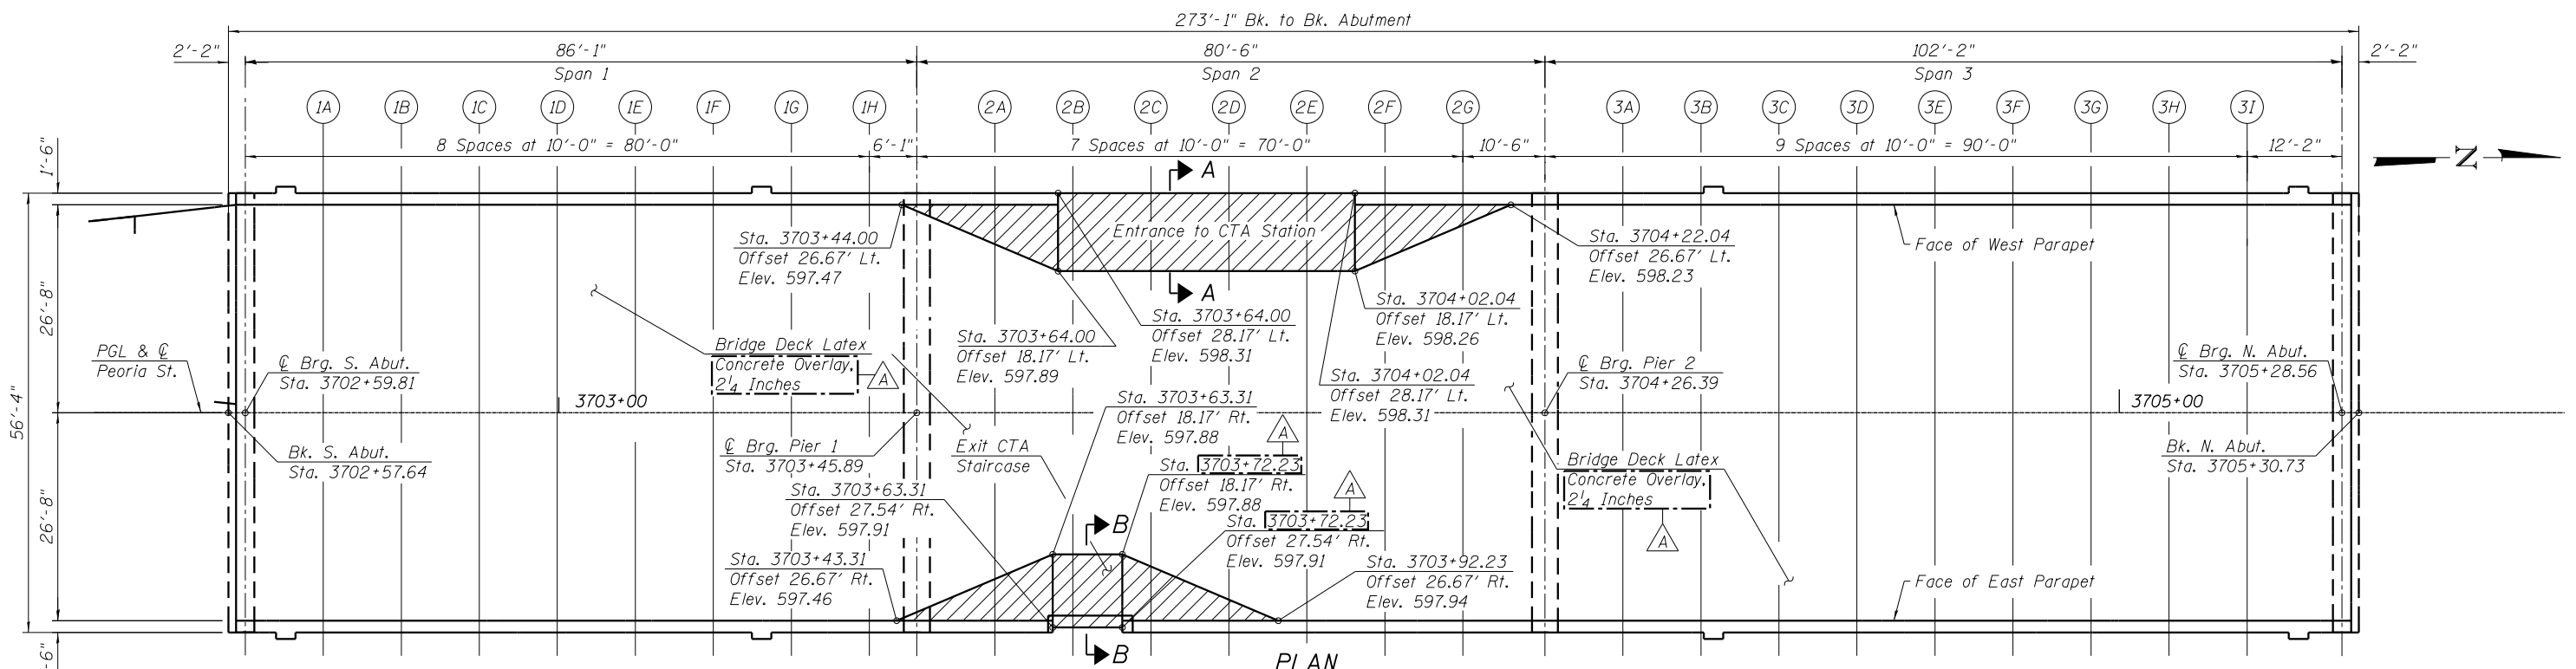


PLAN


FACE OF WEST PARAPET

PGL & C ROADWAY

FACE OF EAST PARAPET

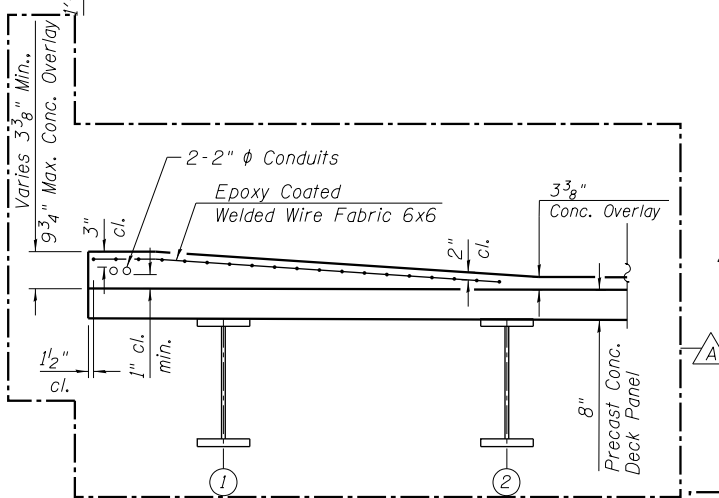

SECTION A-A

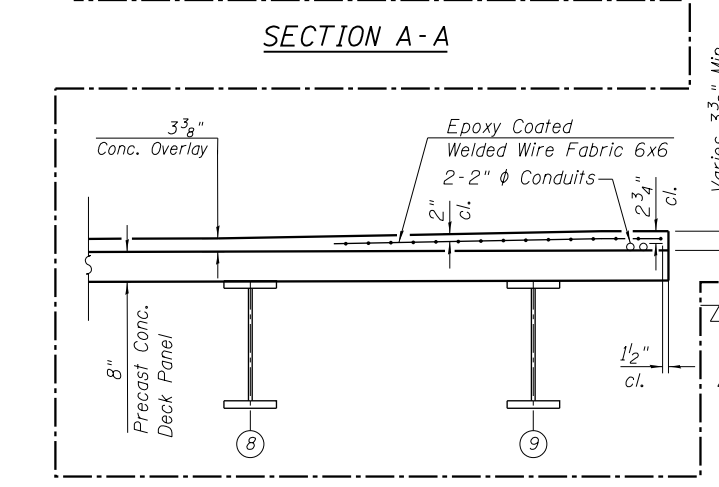

SECTION B-B

Location	Station	Offset	Theoretical Grade Elevations	Overlay Thickness	Location	Station	Offset	Theoretical Grade Elevations	Overlay Thickness	Location	Station	Offset	Theoretical Grade Elevations	Overlay Thickness
Bk. S. Abut.	3702+57.64	-26.67	596.63	2.25	Bk. S. Abut.	3702+57.64	0.00	597.03	2.25	Bk. S. Abut.	3702+57.64	26.67	596.63	2.25
CL Brg. S. Abut.	3702+59.81	-26.67	596.65	2.25	CL Brg. S. Abut.	3702+59.81	0.00	597.05	2.25	CL Brg. S. Abut.	3702+59.81	26.67	596.65	2.25
1A	3702+69.81	-26.67	596.75	2.25	1A	3702+69.81	0.00	597.15	2.25	1A	3702+69.81	26.67	596.75	2.25
1B	3702+79.81	-26.67	596.85	2.25	1B	3702+79.81	0.00	597.25	2.25	1B	3702+79.81	26.67	596.85	2.25
1C	3702+89.81	-26.67	596.94	2.25	1C	3702+89.81	0.00	597.34	2.25	1C	3702+89.81	26.67	596.94	2.25
1D	3702+99.81	-26.67	597.04	2.25	1D	3702+99.81	0.00	597.44	2.25	1D	3702+99.81	26.67	597.04	2.25
1E	3703+09.81	-26.67	597.14	2.25	1E	3703+09.81	0.00	597.54	2.25	1E	3703+09.81	26.67	597.14	2.25
1F	3703+19.81	-26.67	597.24	2.25	1F	3703+19.81	0.00	597.64	2.25	1F	3703+19.81	26.67	597.24	2.25
1G	3703+29.81	-26.67	597.33	2.25	1G	3703+29.81	0.00	597.73	2.25	1G	3703+29.81	26.67	597.33	2.25
1H	3703+39.81	-26.67	597.43	2.25	1H	3703+39.81	0.00	597.83	2.25	1H	3703+39.81	26.67	597.43	2.25
CL Brg. Pier 1	3703+45.89	-26.67	597.51	2.46	CL Brg. Pier 1	3703+45.89	0.00	597.89	2.25	CL Brg. Pier 1	3703+45.89	26.67	597.49	2.29
2A	3703+55.89	-26.67	597.85	5.35	2A	3703+55.89	0.00	597.99	2.25	2A	3703+55.89	26.67	597.68	3.37
2B	3703+65.89	-26.67	598.31	9.81	2B	3703+65.89	0.00	598.08	2.25	2B	3703+65.89	26.67	597.91	5.16
2C	3703+75.89	-26.67	598.31	8.61	2C	3703+75.89	0.00	598.18	2.25	2C	3703+75.89	26.67	597.88	3.49
2D	3703+85.89	-26.67	598.31	7.41	2D	3703+85.89	0.00	598.28	2.25	2D	3703+85.89	26.67	597.90	2.43
2E	3703+95.89	-26.67	598.31	6.21	2E	3703+95.89	0.00	598.38	2.25	2E	3703+95.89	26.67	597.98	2.25
2F	3704+05.89	-26.67	598.48	7.22	2F	3704+05.89	0.00	598.47	2.25	2F	3704+05.89	26.67	598.07	2.25
2G	3704+15.89	-26.67	598.55	6.78	2G	3704+15.89	0.00	598.57	2.25	2G	3704+15.89	26.67	598.17	2.25
CL Brg. Pier 2	3704+26.39	-26.67	598.27	2.25	CL Brg. Pier 2	3704+26.39	0.00	598.67	2.25	CL Brg. Pier 2	3704+26.39	26.67	598.27	2.25
3A	3704+36.39	-26.67	598.37	2.25	3A	3704+36.39	0.00	598.77	2.25	3A	3704+36.39	26.67	598.37	2.25
3B	3704+46.39	-26.67	598.47	2.25	3B	3704+46.39	0.00	598.87	2.25	3B	3704+46.39	26.67	598.47	2.25
3C	3704+56.39	-26.67	598.57	2.25	3C	3704+56.39	0.00	598.97	2.25	3C	3704+56.39	26.67	598.57	2.25
3D	3704+66.39	-26.67	598.66	2.25	3D	3704+66.39	0.00	599.06	2.25	3D	3704+66.39	26.67	598.66	2.25
3E	3704+76.39	-26.67	598.71	2.25	3E	3704+76.39	0.00	599.11	2.25	3E	3704+76.39	26.67	598.71	2.25
3F	3704+86.39	-26.67	598.69	2.25	3F	3704+86.39	0.00	599.09	2.25	3F	3704+86.39	26.67	598.69	2.25
3G	3704+96.39	-26.67	598.60	2.25	3G	3704+96.39	0.00	599.00	2.25	3G	3704+96.39	26.67	598.60	2.25
3H	3705+06.39	-26.67	598.43	2.25	3H	3705+06.39	0.00	598.83	2.25	3H	3705+06.39	26.67	598.43	2.25
3I	3705+16.39	-26.67	598.19	2.25	3I	3705+16.39	0.00	598.59	2.25	3I	3705+16.39	26.67	598.19	2.25
CL Brg. N. Abut.	3705+28.56	-26.67	597.80	2.25	CL Brg. N. Abut.	3705+28.56	0.00	598.20	2.25	CL Brg. N. Abut.	3705+28.56	26.67	597.80	2.25
Bk. N. Abut.	3705+30.73	-26.67	597.44	2.25	Bk. N. Abut.	3705+30.73	0.00	598.12	2.25	Bk. N. Abut.	3705+30.73	26.67	597.44	2.25

LEGEND
 Bridge Deck Latex Concrete Overlay, depth greater than 3/2"

Notes:
 For Top of Slab Elevations for precast concrete deck panels see Sheets 10 through 12 of 55.
 For scoring pattern of Bridge Deck Concrete Overlay, 2 1/4 Inches see Sheets 91 and 92 of 356.
 Score shall be the width and depth of a bridge deck groove, as specified in Article 503.16(a)(3)b.
 Bridge Deck Latex Concrete Overlay depth varies from 2 1/4" to 9 3/4". Additional concrete shall be included in the cost of Bridge Deck Latex Concrete Overlay, 2 1/4 Inches. Bridge Deck Latex Concrete Overlay greater than 3 1/2" shall be reinforced with epoxy coated Welded Wire Fabric 6x6.

BILL OF MATERIAL

Item	Unit	Quantity
Bridge Deck Latex Concrete Overlay, 2 1/4 Inches	Sq. Yd.	1614
Welded Wire Fabric 6x6	Sq. Yd.	66

10/23/10 AM 0161708-60W29-5014-TopSlab_4.dgn




USER NAME = kahastings	DESIGNED KAH	REVISED A 12/18/2013 KAH/WJC
PLOT SCALE = 21:4.0024 " / in.	CHECKED WJC	REVISED
PLOT DATE = 1/10/2014	DRAWN RLS	REVISED
	CHECKED WJC	REVISED

STATE OF ILLINOIS
DEPARTMENT OF TRANSPORTATION

BRIDGE DECK OVERLAY
STRUCTURE NO. 016-1708


SHEET NO. 14 OF 55 SHEETS

MUN 2090	SECTION 2013-011R	COUNTY COOK	TOTAL SHEETS 356	SHEET NO. 146
CONTRACT NO. 60W29			ILLINOIS FED. AID PROJECT FED. AID PROJECT	

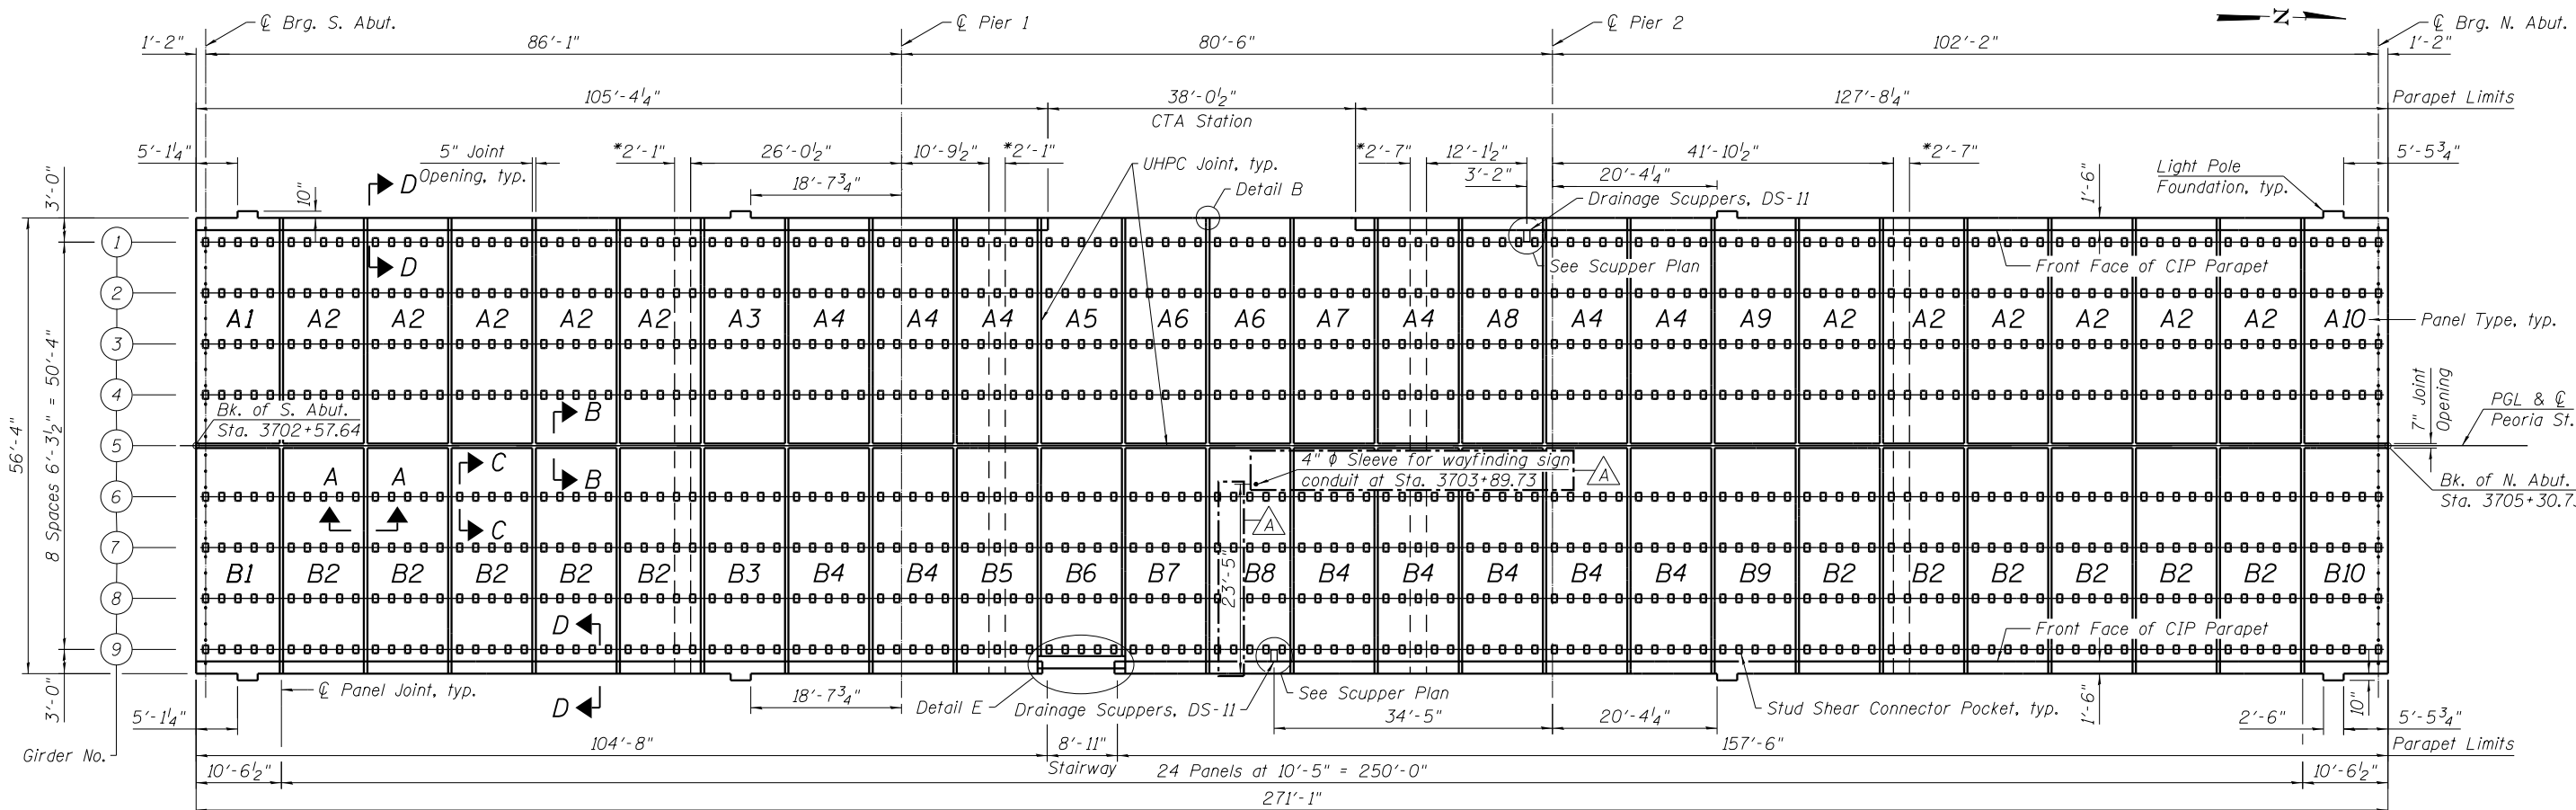

PRECAST DECK PANEL PLAN

* Do not place stud shear connectors within this region (field splice).

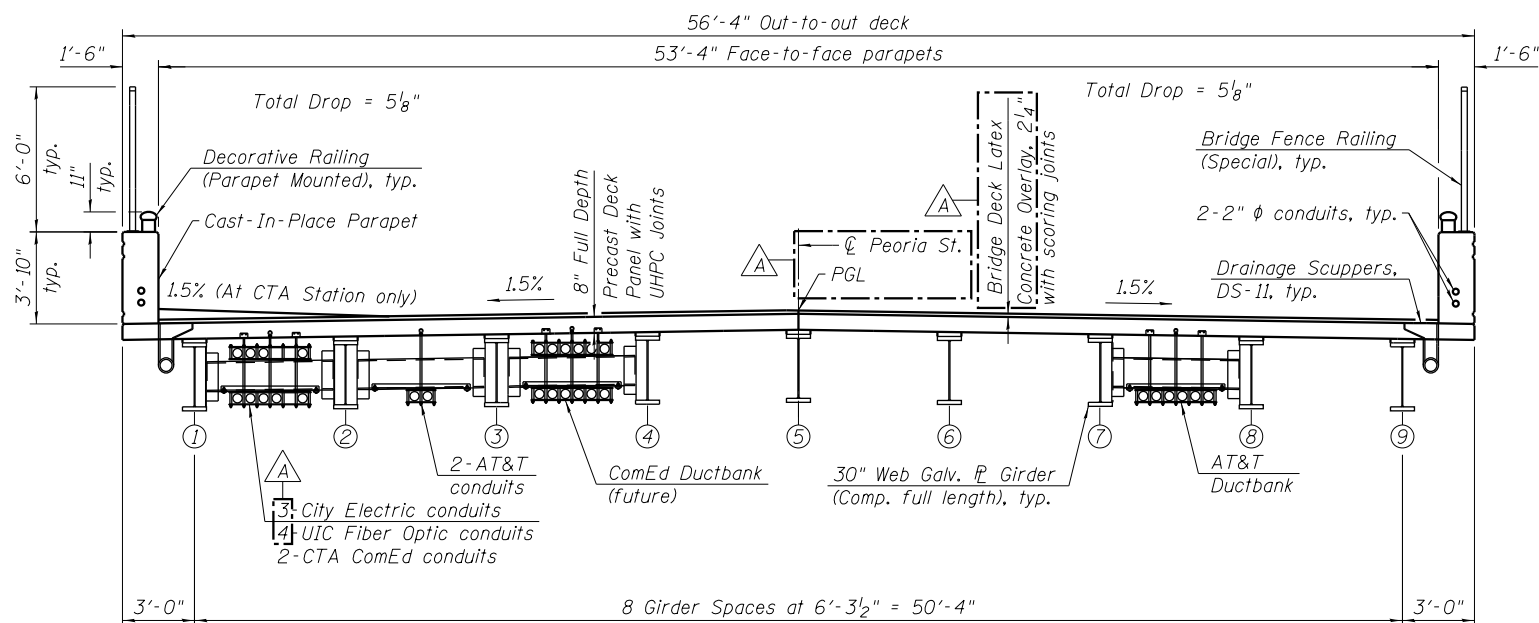

CROSS SECTION
(Looking North)

SUGGESTED CONSTRUCTION SEQUENCE

- Erect steel girders.
- Cast abutment diaphragms.
- Clean surfaces of deck panel shear keys and stud shear connector pockets.
- Install drainage scuppers.
- Preset leveling bolts to anticipated height.
- Erect precast concrete deck panels according to the erection sequence for Stage 1.
- Adjust leveling devices on deck panels to bring panels to grade.
- All leveling bolts shall be torqued to approximately the same value (20 percent maximum deviation).
- Form and cast transverse and longitudinal UHPC joints for Stage 1.
- Repeat steps 6-9 according to the erection sequence for Stage 2.
- Install stud shear connectors in all blockouts.
- Form fillets between the top of the girders and the bottom of the deck panels.
- Grout all fillets and stud shear connector pockets with a flowable, non-shrink grout.
- Cast Concrete Superstructure slab at CTA stairway.
- Cast parapets.
- Place latex concrete overlay.


Precast Concrete Deck Panel Notes:

Contractor shall field verify all dimensions and horizontal locations prior to ordering materials to verify fit-up of new deck panels. The panel layout and dimensions provided are suggested. Final panel layout and dimensions shall be shown on the panel shop drawings. All panel dimensions provided on the superstructure plans are plan dimensions. The fabrication dimensions on the panel shop drawings shall account for the profile and slope of the proposed bridge deck. Contractor shall be responsible for exercising care in lifting, handling, storing, and transportation of the precast slab panels to prevent cracking or damage. Panels shall be lifted by devices as designed by the contractor and approved by the Engineer. UHPC shall reach a strength of 14.5 ksi before live loads or deck overlay can be applied to the bridge. Contractor shall apply set retarder to inside of side bulkheads and to stud pocket blockouts on the day prior to a pour to avoid interference with form setup. After form stripping, set retarder shall be thoroughly cleaned off keyways (and stud pockets) using a water blast to create the desired exposed aggregate finish.

BILL OF MATERIAL

Item	Unit	Total
Precast Concrete Deck Panels	Sq. Ft.	15,272

Notes:
See Sheet 16 of 55 for Sections A-A, B-B, C-C, D-D, Detail B and Scupper Plan.
See Sheet 23 of 55 for Detail E.
See Sheet 20 of 55 for Bill of Material.
See Sheet 21 of 55 for parapet reinforcement.
Type and location of precast inserts for utility hangers shall be coordinated with the utility companies. Cost included in Precast Concrete Deck Panels.
See Lighting Plans for parapet conduit sleeve locations.
See Roadway Plans for scoring joint details.

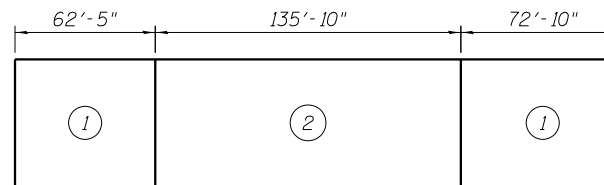

PANEL ERECTION SEQUENCE

Location of the 4" ϕ sleeve for the wayfinding sign conduit shall be confirmed with the University of Illinois at Chicago prior to fabrication of the deck panels.

10:31:24 AM 0161708-60W29-5015-Deck_Plan&Section.dgn



USER NAME = BAWIort	DESIGNED JRM	REVISED Δ 12/18/2013 JRM
PLOT SCALE = 21:4.0024 " / in.	CHECKED WJC	REVISED
PLOT DATE = 12/19/2013	DRAWN RLS	REVISED
	CHECKED DL	REVISED










STATE OF ILLINOIS
DEPARTMENT OF TRANSPORTATION

PRECAST DECK PANEL PLAN AND CROSS SECTION
STRUCTURE NO. 016-1708






SHEET NO. 15 OF 55 SHEETS

MUN	SECTION	COUNTY	TOTAL SHEETS	SHEET NO.
2090	2013-011R	COOK	356	147
CONTRACT NO. 60W29				

ILLINOIS FED. AID PROJECT

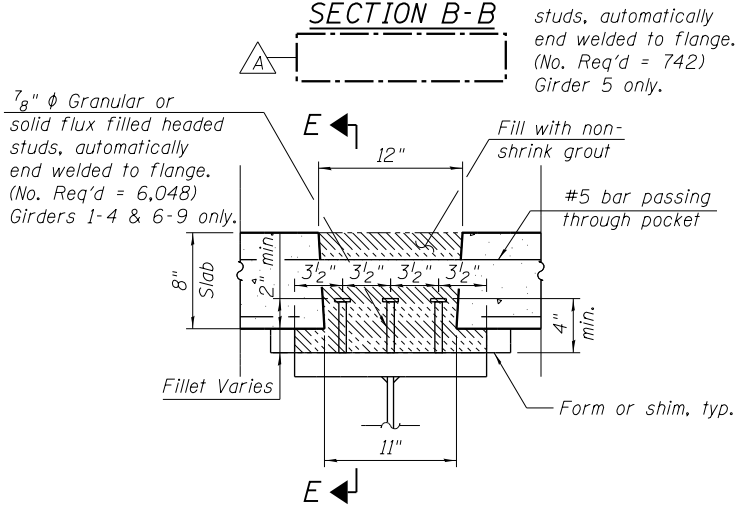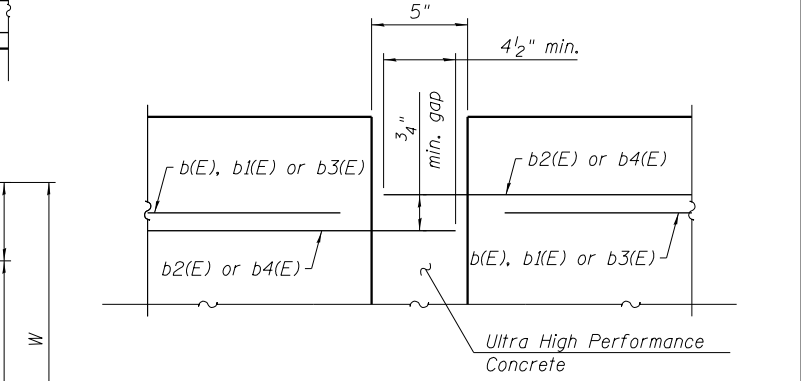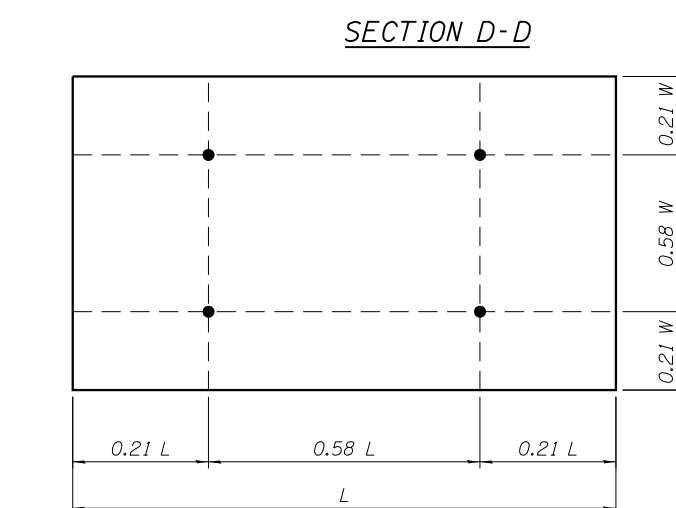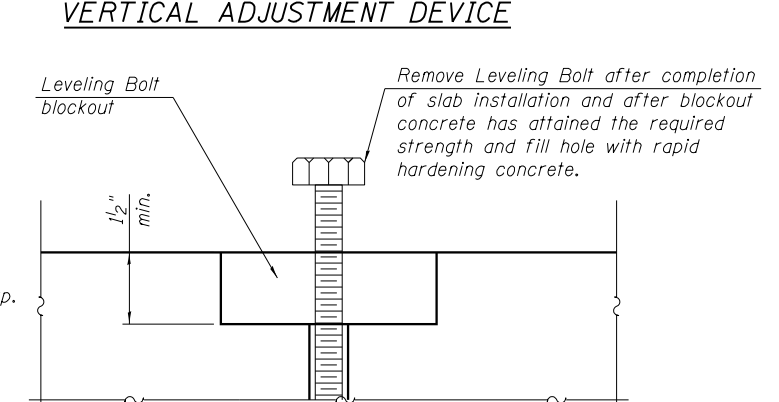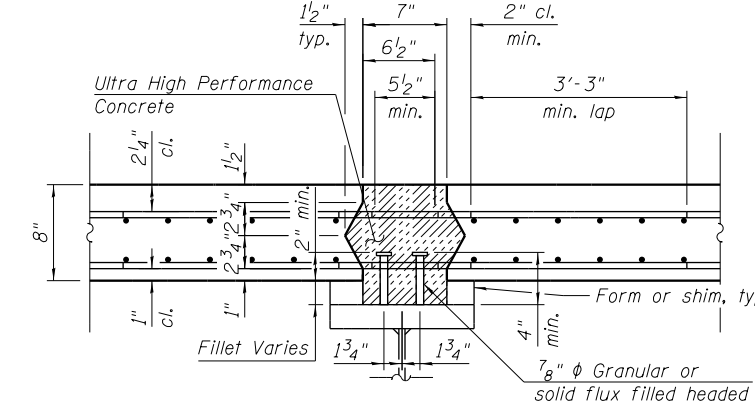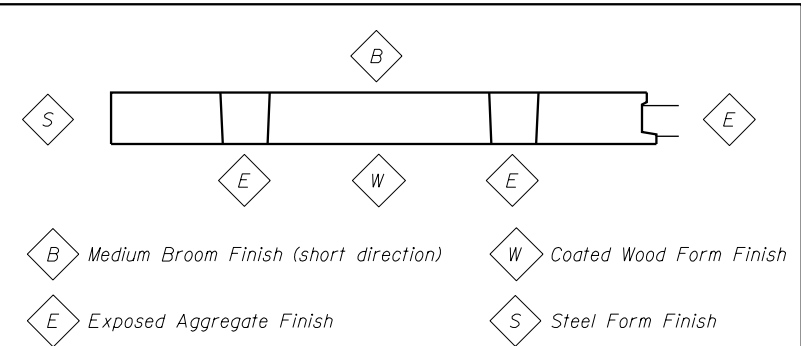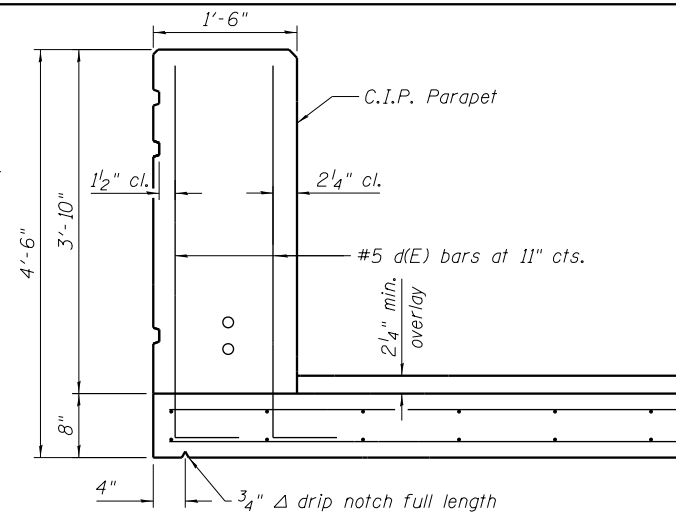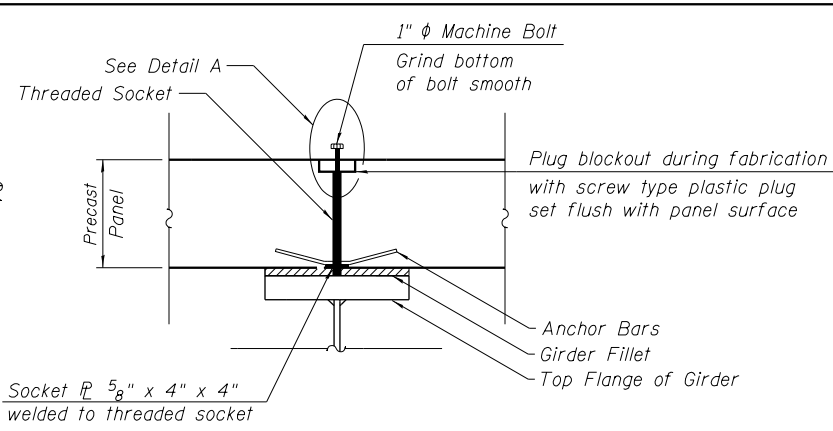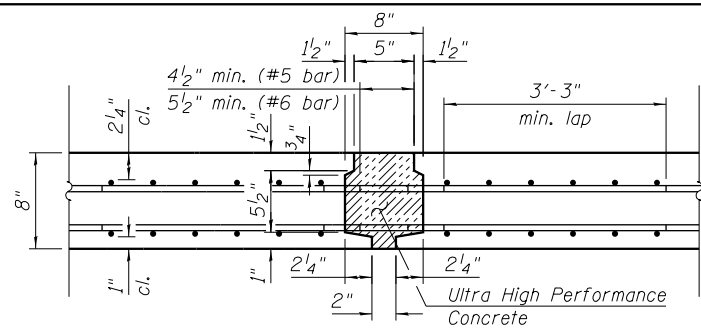

Vertical Adjustment Device Notes:
 A machine bolt or similar shall provide smooth and detailed vertical adjustment to the panel after placement on the girders.
 During panel installation, all vertical adjustment devices shall be in full contact with the girders.
 The location, spacing and final details of the vertical adjustment devices shall be designed for at least 100% more than the load of the precast panel, barrier and any construction loading as determined by the Contractor.
 The vertical adjustment devices shall be fully removable and the voids filled with rapid hardening concrete after the girder or stringer haunch has been placed and cured.
 The details shown are for schematic only and alternatives are permitted. Details and layout of the vertical adjustment devices shall be signed and sealed by a Illinois Licensed Structural Engineer and submitted to the Engineer for review prior to casting the panels.
 The cost of the vertical adjustment devices, including furnishing, installing, removing and all work required for repairing the slab panels after removal, shall be included in the cost of Precast Concrete Deck Panels.

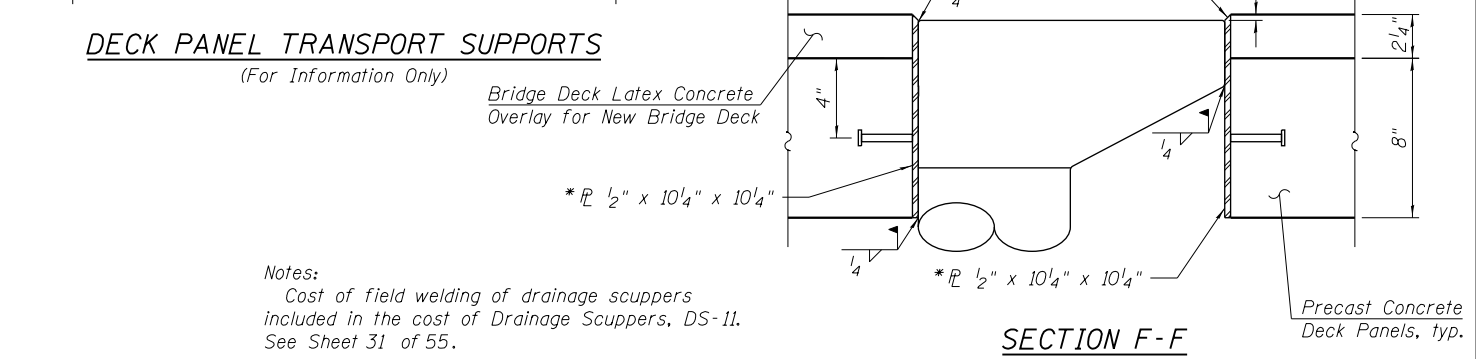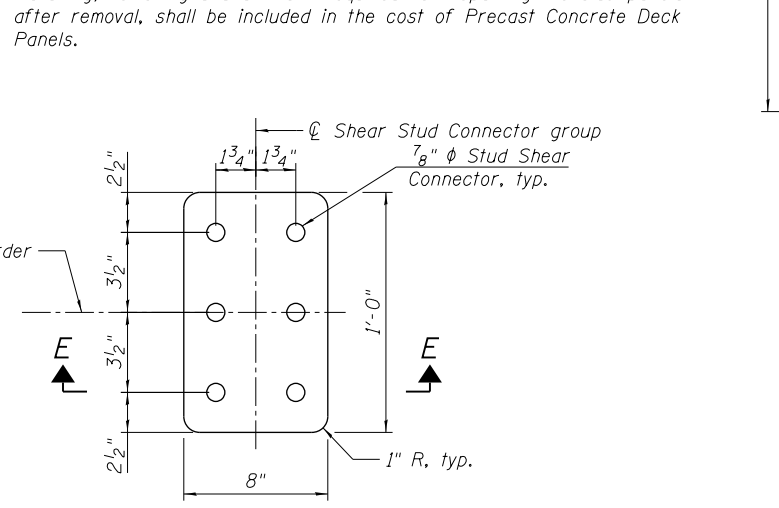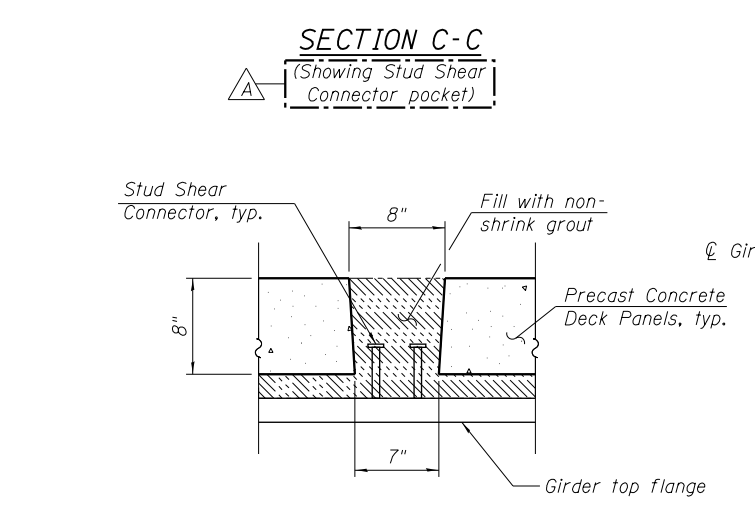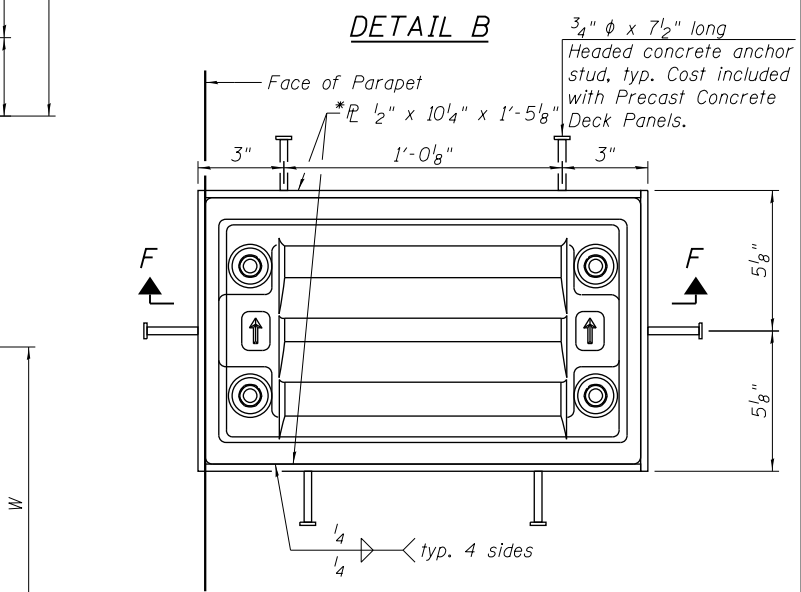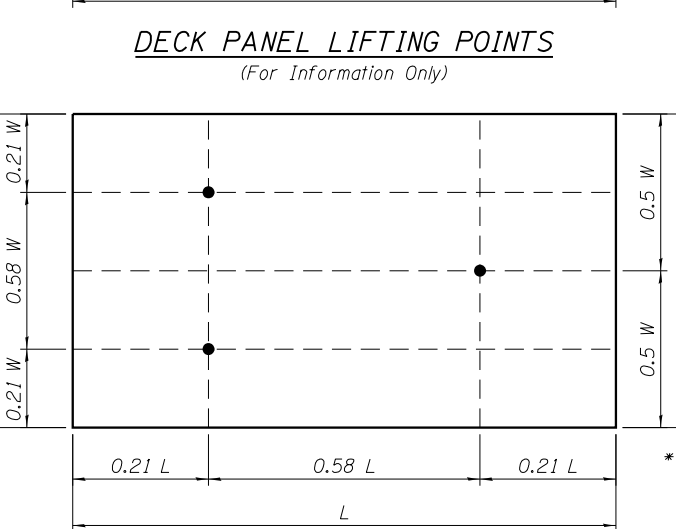

Notes:
 Cost of field welding of drainage scuppers included in the cost of Drainage Scuppers, DS-11. See Sheet 31 of 55.

10:31:26 AM
 0161708-60W29-5016-Deck_PnDet1.dgn




USER NAME = BAWItoft	DESIGNED JRM	REVISED A 12/18/2013 JRM
PLOT SCALE = 0x2' / 1"	CHECKED WJC	REVISED
PLOT DATE = 12/19/2013	DRAWN RLS	REVISED
	CHECKED DL	REVISED

STATE OF ILLINOIS
 DEPARTMENT OF TRANSPORTATION


PRECAST DECK PANEL DETAILS 1
 STRUCTURE NO. 016-1708
 SHEET NO. 16 OF 55 SHEETS

MUN 2090	SECTION 2013-011R	COUNTY COOK	TOTAL SHEETS 356	SHEET NO. 148
CONTRACT NO. 60W29			ILLINOIS FED. AID PROJECT	

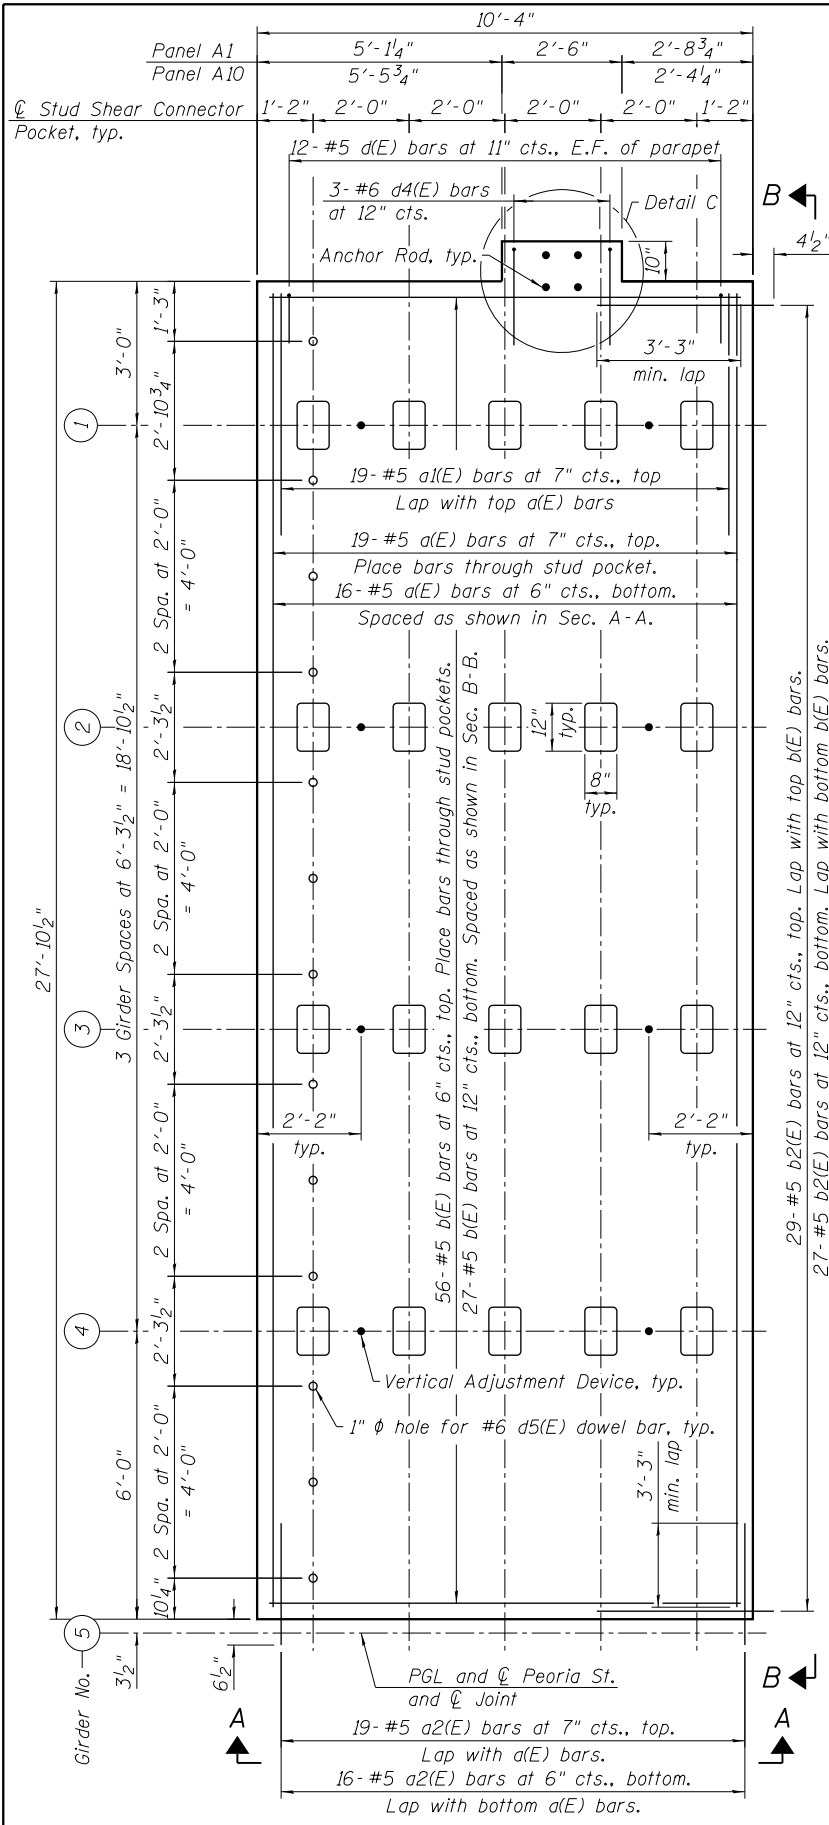


REINFORCING PLAN - DECK PANEL A1

(1 required)
Deck Panel A10 opposite hand (1 required)

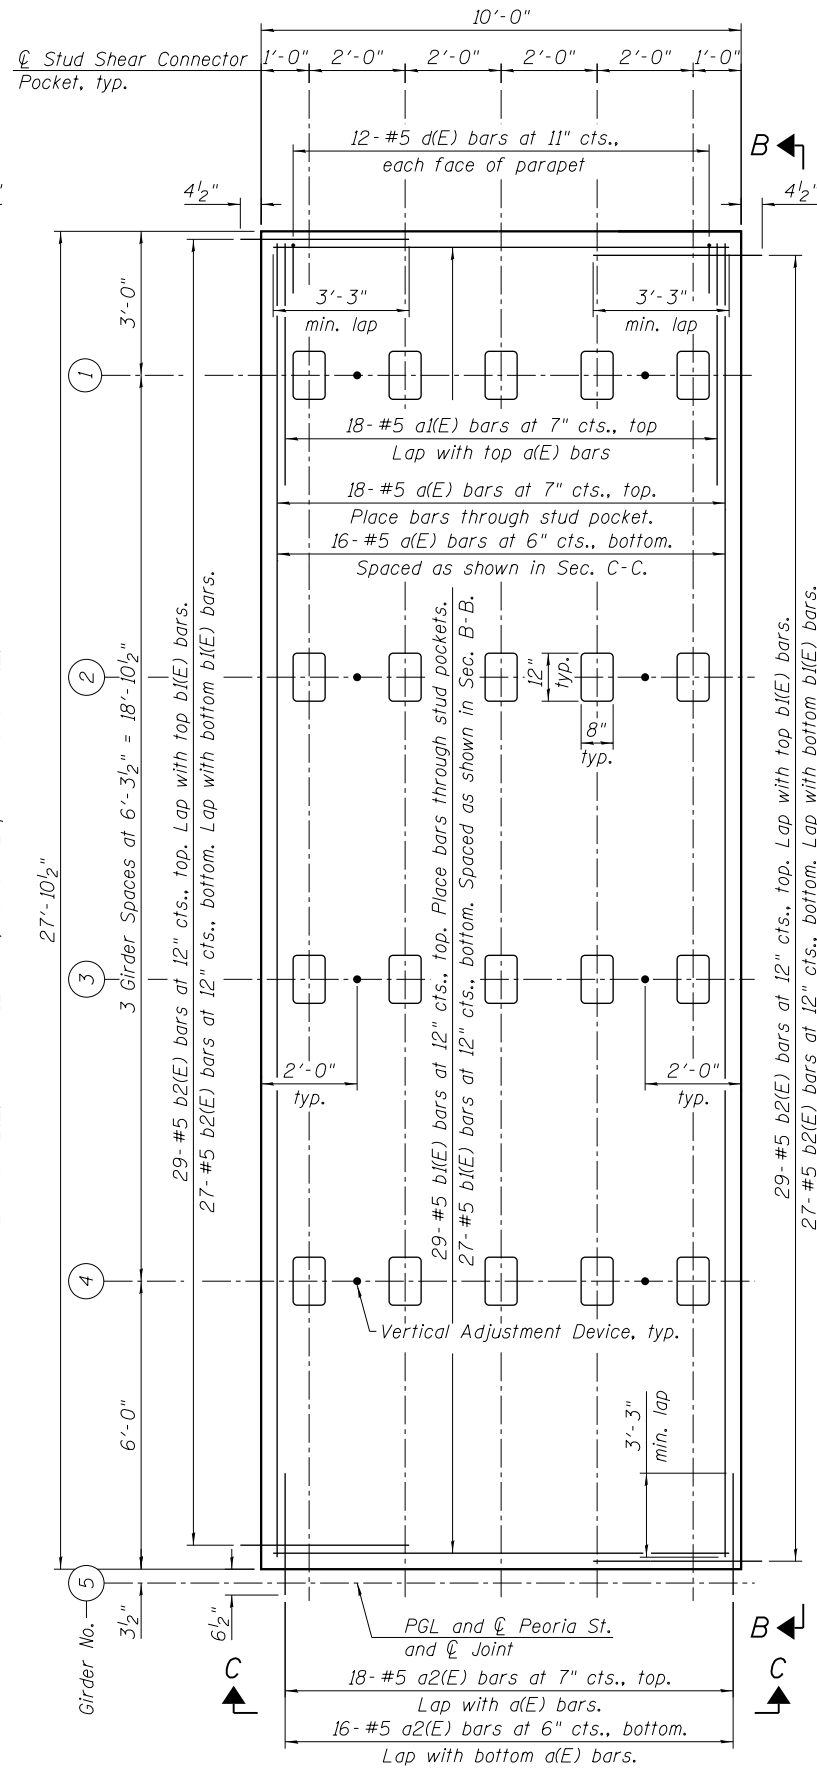


REINFORCING PLAN - DECK PANEL A2

(11 required)

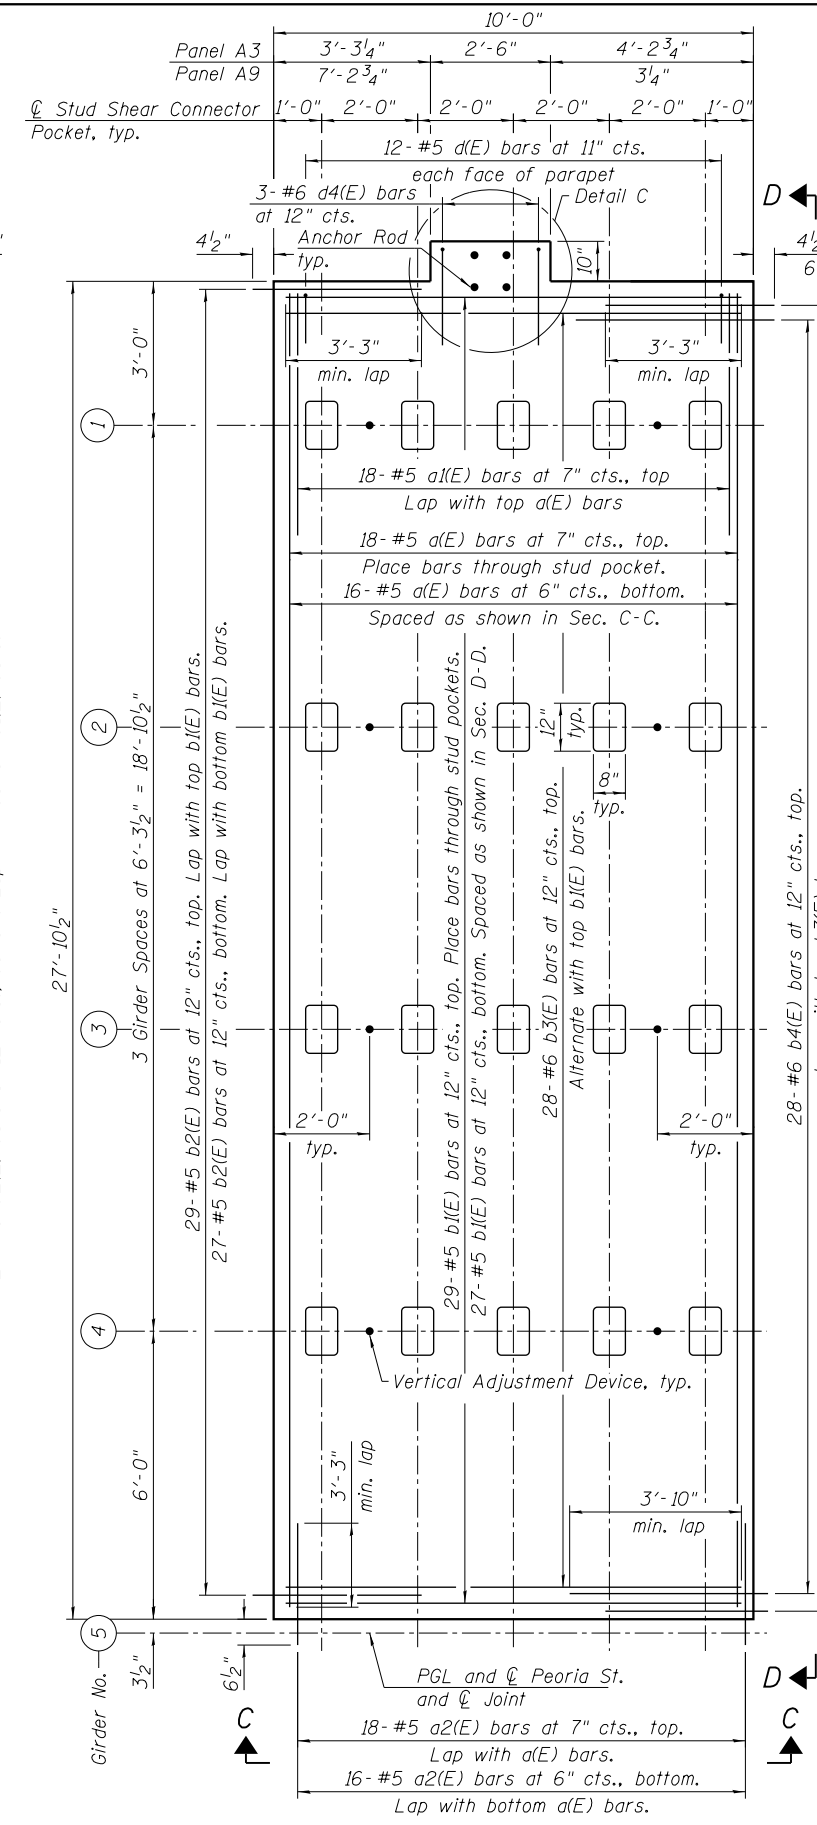

REINFORCING PLAN - DECK PANEL A3

(1 required)
Deck Panel A9 opposite hand (1 required)

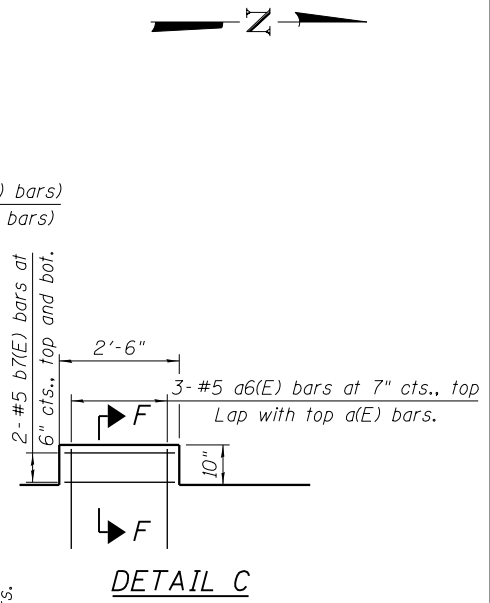

DETAIL C

Notes:
Provide a 3/4" min. gap between adjacent b2(E) or b4(E) dowels within UHPC joints. See Detail B on sheet 16 of 55.
For Sections A-A, B-B, C-C and D-D see Sheet 20 of 55.
For Section F-F, see Sheet 21 of 55.
See Sheet 20 of 55 for anchor rod details.

11/02/2013 PM 01:16:17 68-60W29-5017-Deck_PnlDet2.dgn



USER NAME = BAWIort	DESIGNED = JRM	REVISED
	CHECKED = WJC	REVISED
PLOT SCALE = 4x0.0000 '1' / 1in.	DRAWN = RLS	REVISED
PLOT DATE = 10/28/2013	CHECKED = DL	REVISED






**STATE OF ILLINOIS
DEPARTMENT OF TRANSPORTATION**

**PRECAST DECK PANEL DETAILS 2
STRUCTURE NO. 016-1708**

SHEET NO. 17 OF 55 SHEETS

MUN	SECTION	COUNTY	TOTAL SHEETS	SHEET NO.
2090	2013-011R	COOK	356	149
CONTRACT NO.			60W29	
ILLINOIS FED. AID PROJECT				

11/02/13 4:09 PM
0161708-60W29-5018-Deck_PnlDet3.dgn

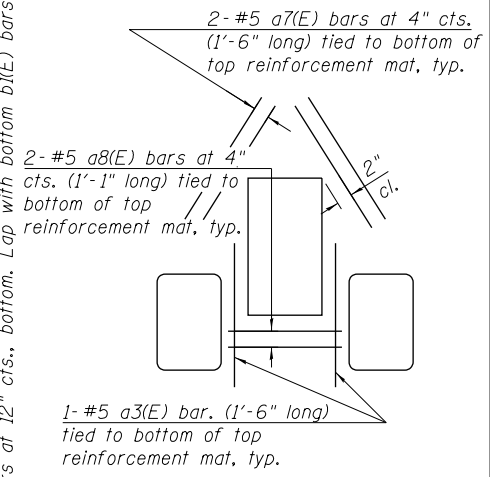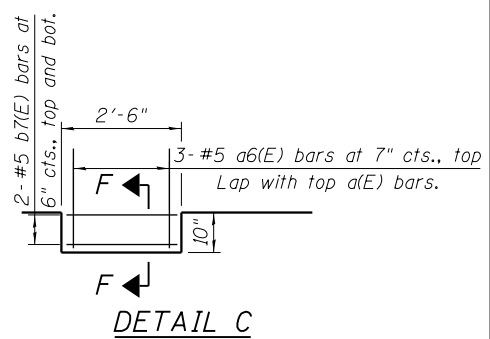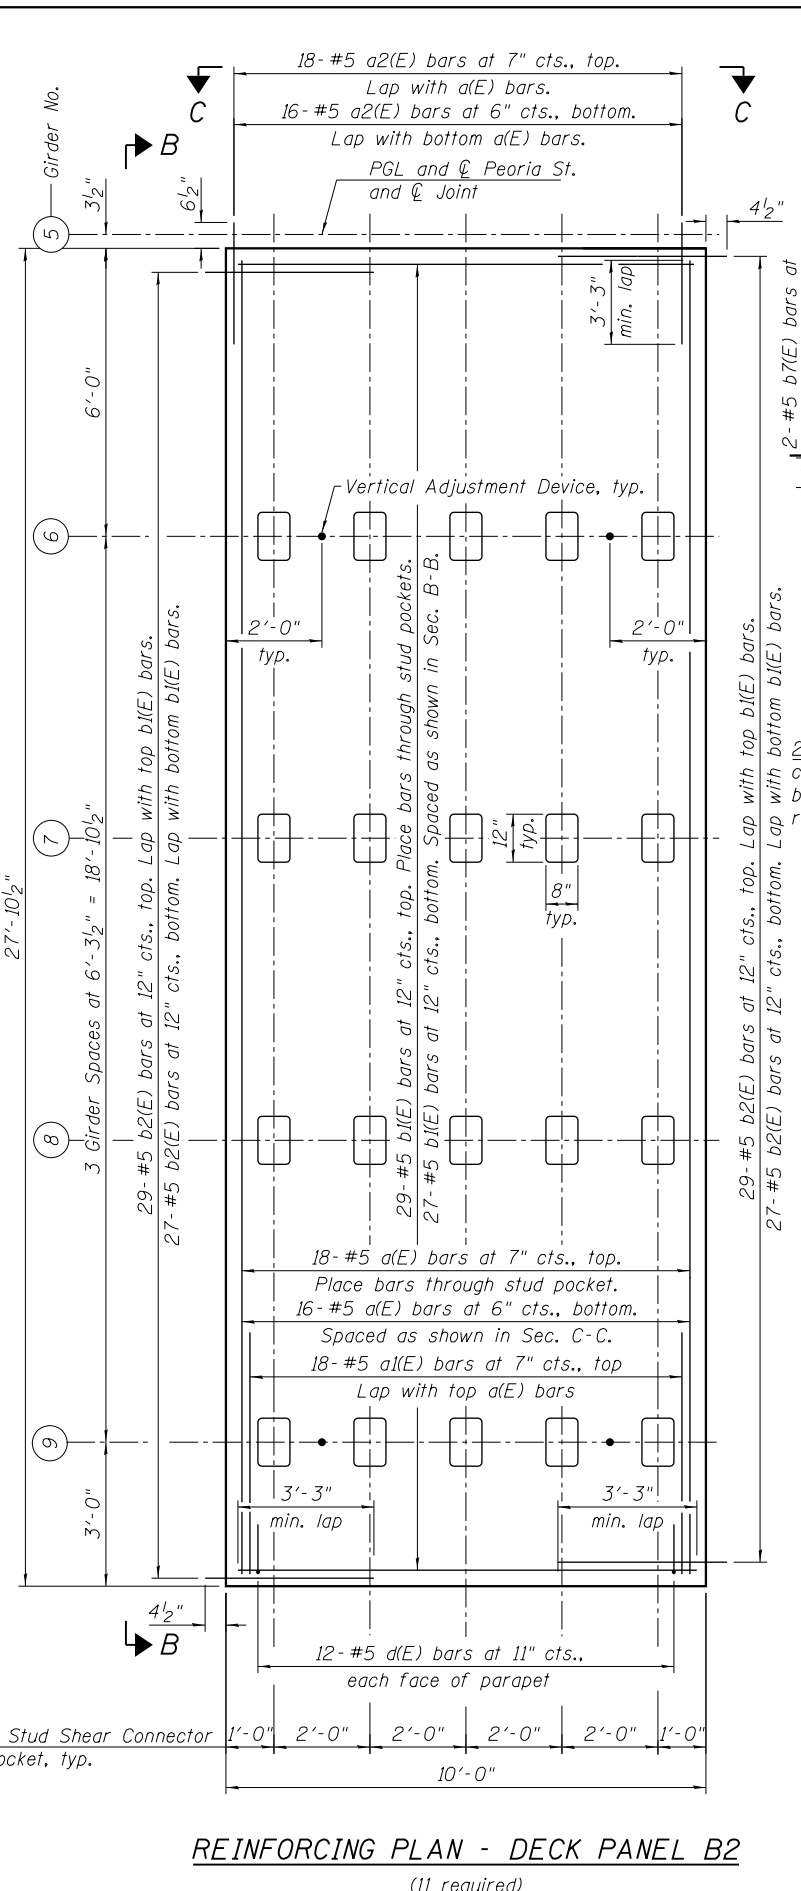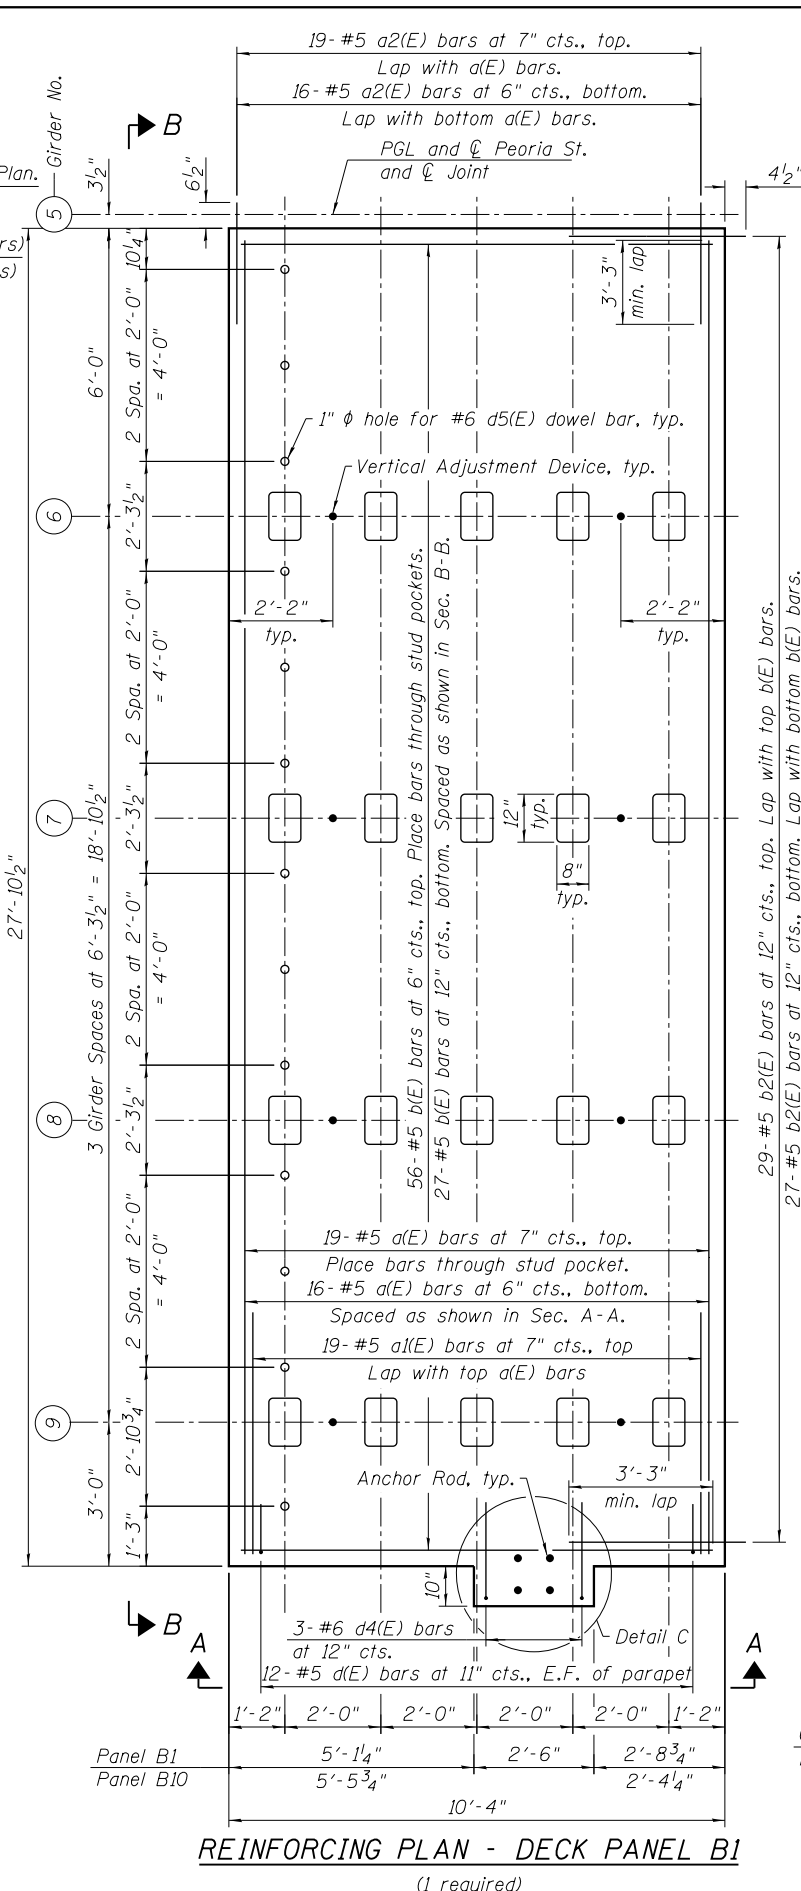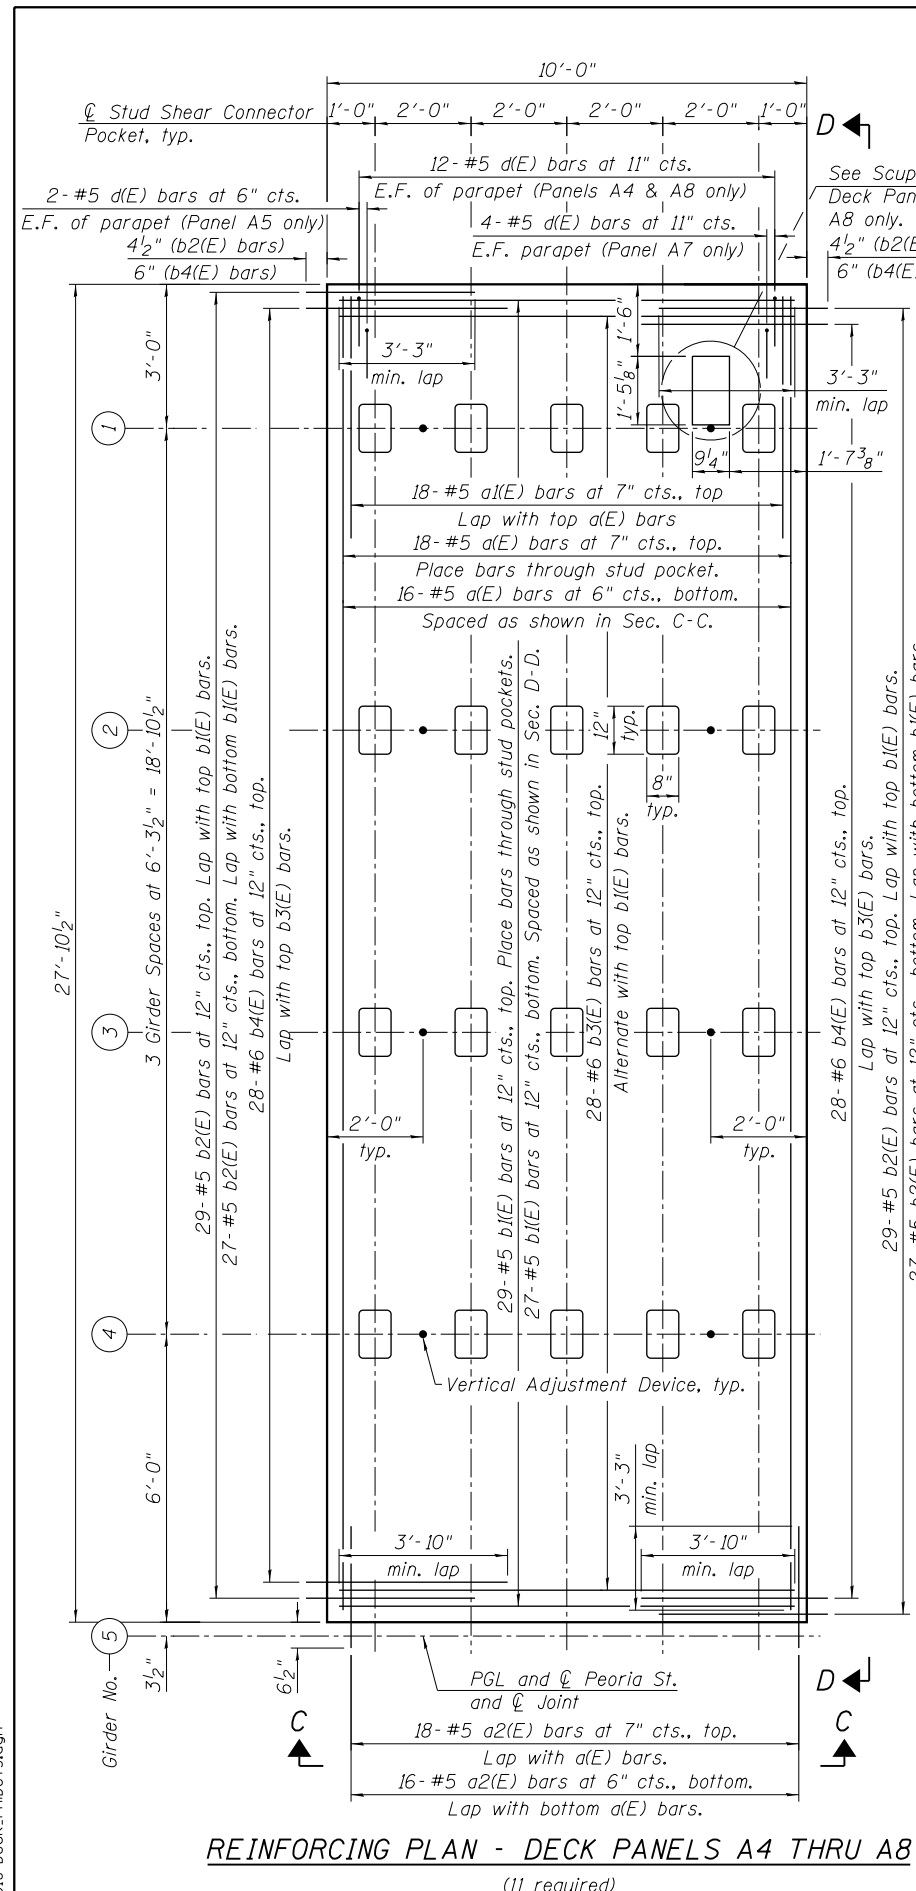

Notes:
Provide a 3/4" min. gap between adjacent b2(E) or b4(E) dowels within UHPC joints. See Detail B on Sheet 16 of 55.
For Sections A-A, B-B, C-C and D-D see Sheet 20 of 55.
See Sheet 20 of 55 for anchor rod details.
For Section F-F, see Sheet 21 of 55.



USER NAME = BAWItoft	DESIGNED JRM	REVISED
CHECKED WJC	REVISIONS	
PLOT SCALE = 4:0.0000 '1" / in.	DRAWN RLS	REVISED
PLOT DATE = 10/28/2013	CHECKED DL	REVISED


STATE OF ILLINOIS
DEPARTMENT OF TRANSPORTATION

PRECAST DECK PANEL DETAILS 3
STRUCTURE NO. 016-1708


MUN	SECTION	COUNTY	TOTAL SHEETS	SHEET NO.
2090	2013-011R	COOK	356	150
CONTRACT NO.			60W29	
ILLINOIS FED. AID PROJECT				

SHEET NO. 18 OF 55 SHEETS


10:31:32 AM
0161708-60W29-5019-Deck_PnlDet4.dgn

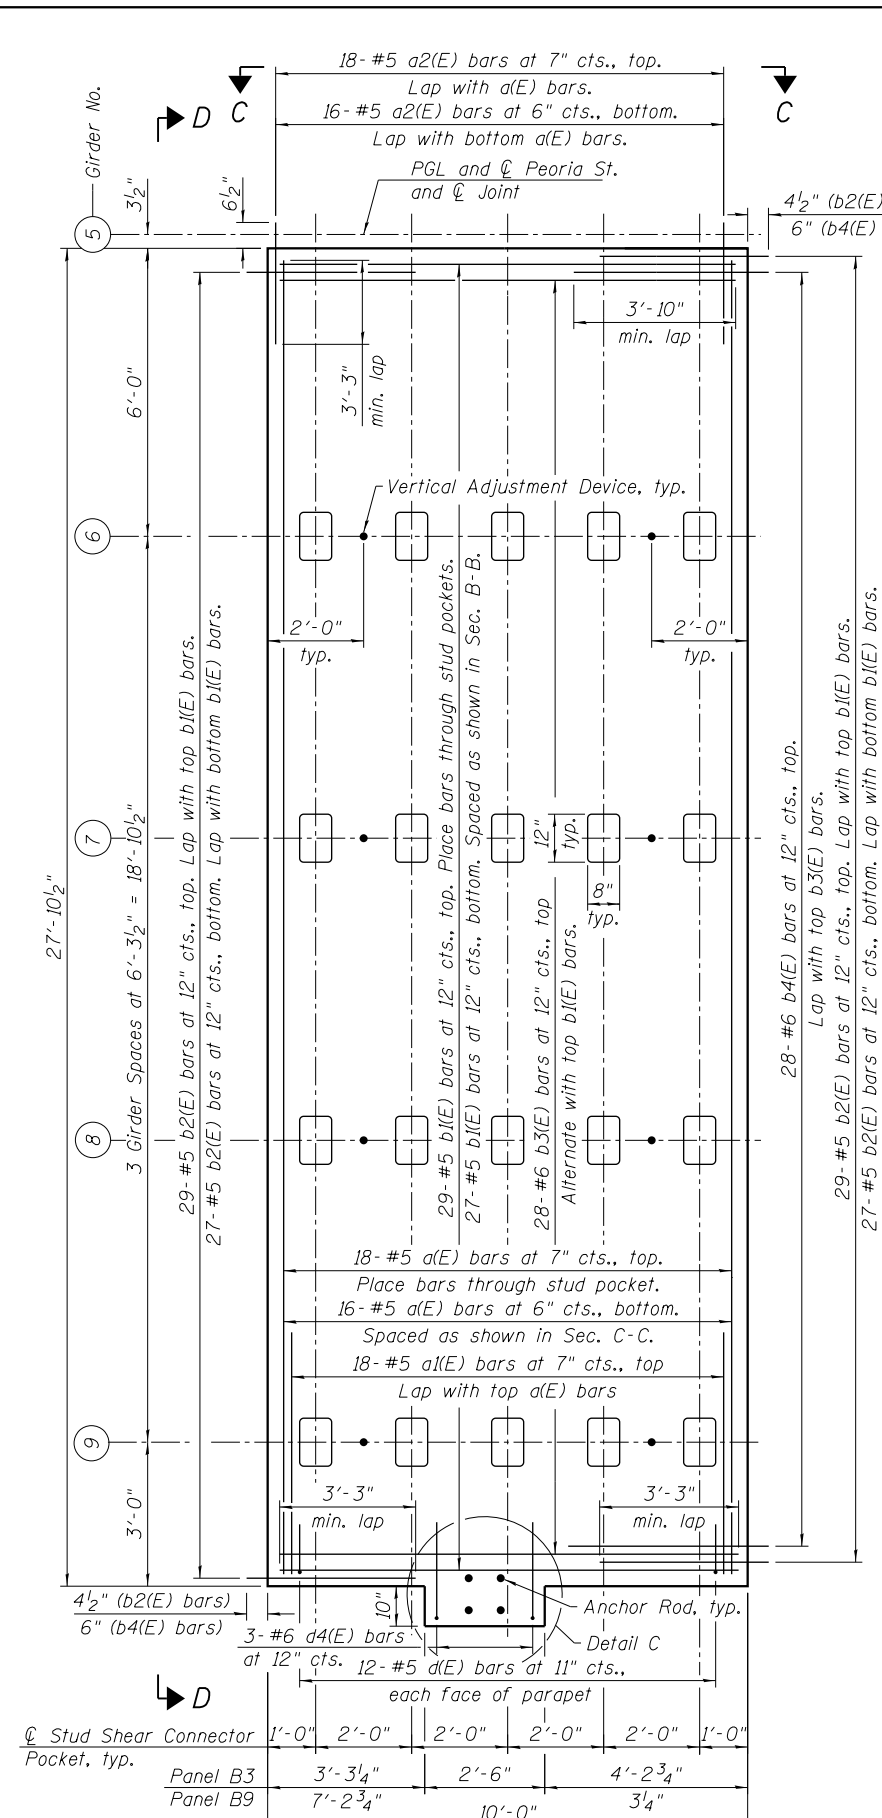

REINFORCING PLAN - DECK PANEL B3
(1 required)
Deck Panel B9 opposite hand (1 required)

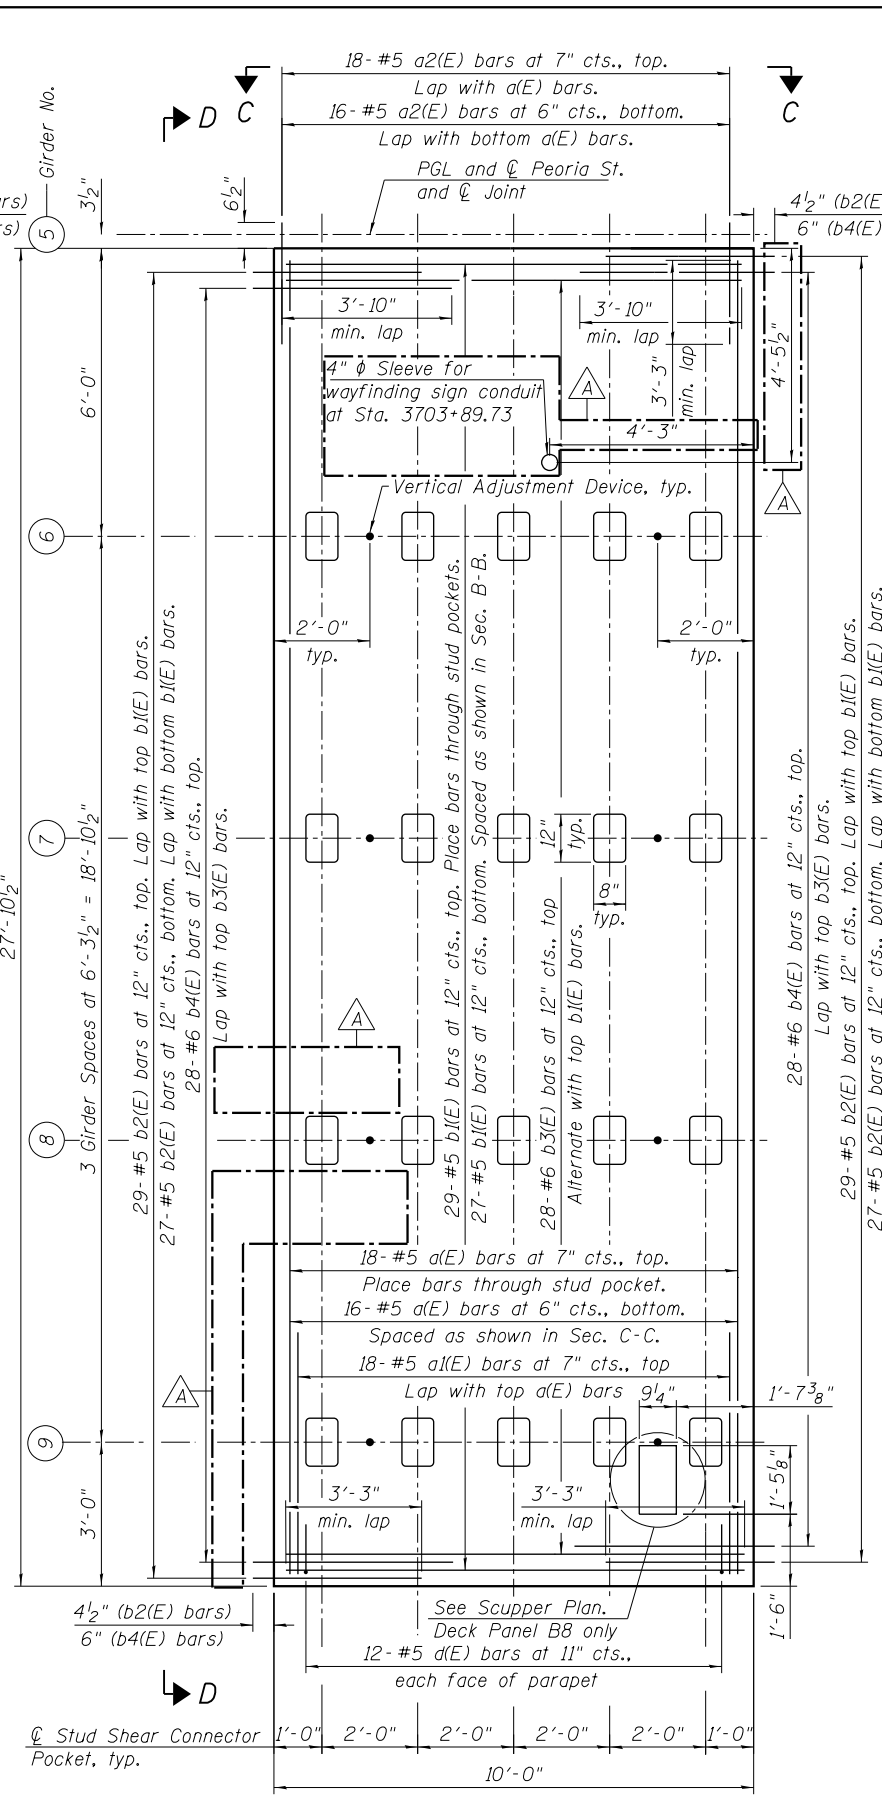

REINFORCING PLAN - DECK PANELS B4 AND B8
(8 required)

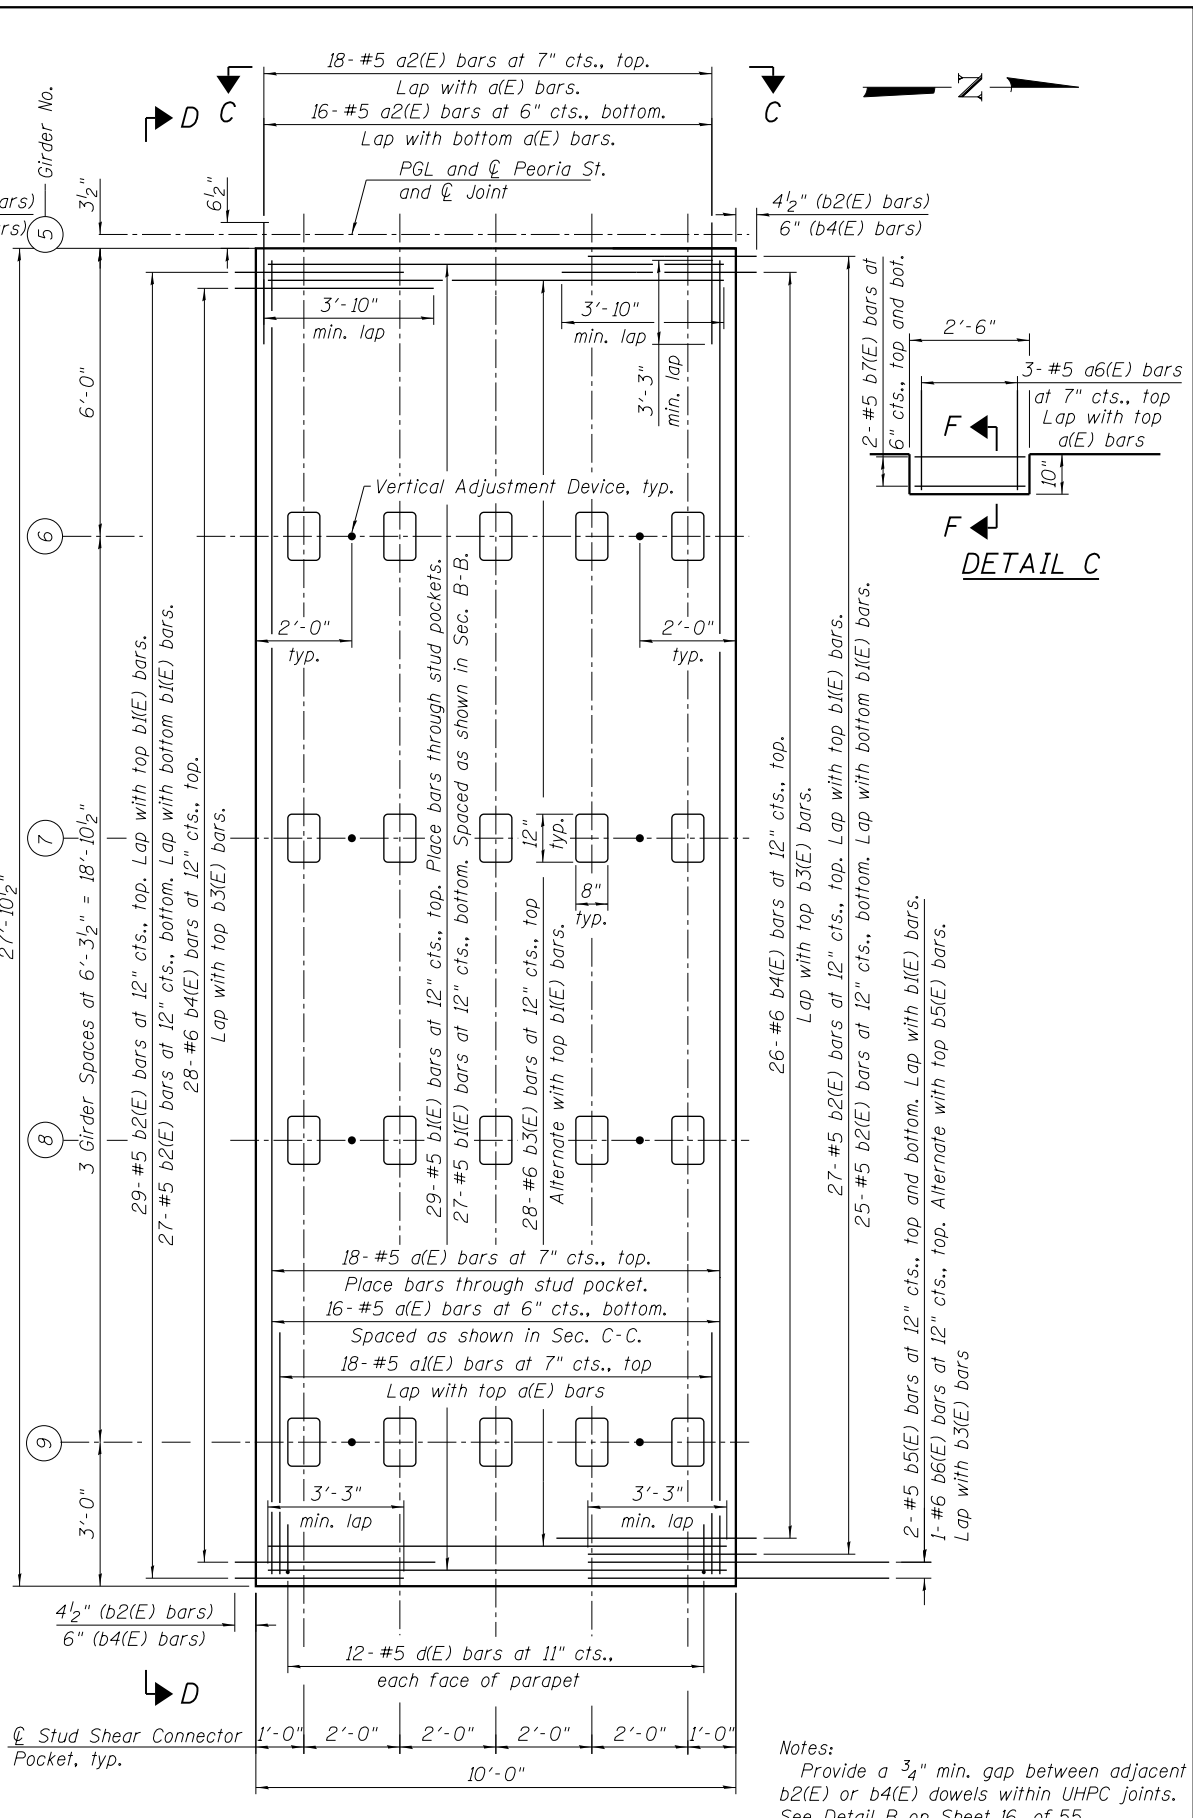

REINFORCING PLAN - DECK PANEL B5
(1 required)
Deck Panel B7 opposite hand (1 required)

Notes:
Provide a 3/4" min. gap between adjacent b2(E) or b4(E) dowels within UHPC joints. See Detail B on Sheet 16 of 55.
For Sections C-C and D-D see Sheet 20 of 55.
For Scupper Plan, see Sheet 18 of 55.
For Section F-F, see Sheet 21 of 55.




USER NAME = BAWIort	DESIGNED JRM	REVISED A 12/18/2013 JRM
PLOT SCALE = 4:0.0000 '1' / in.	CHECKED WJC	REVISED
PLOT DATE = 12/19/2013	DRAWN RLS	REVISED
	CHECKED DL	REVISED

**STATE OF ILLINOIS
DEPARTMENT OF TRANSPORTATION**


**PRECAST DECK PANEL DETAILS 4
STRUCTURE NO. 016-1708**

SHEET NO. 19 OF 55 SHEETS


MUN	SECTION	COUNTY	TOTAL SHEETS	SHEET NO.
2090	2013-011R	COOK	356	151
CONTRACT NO.			60W29	
ILLINOIS FED. AID PROJECT				

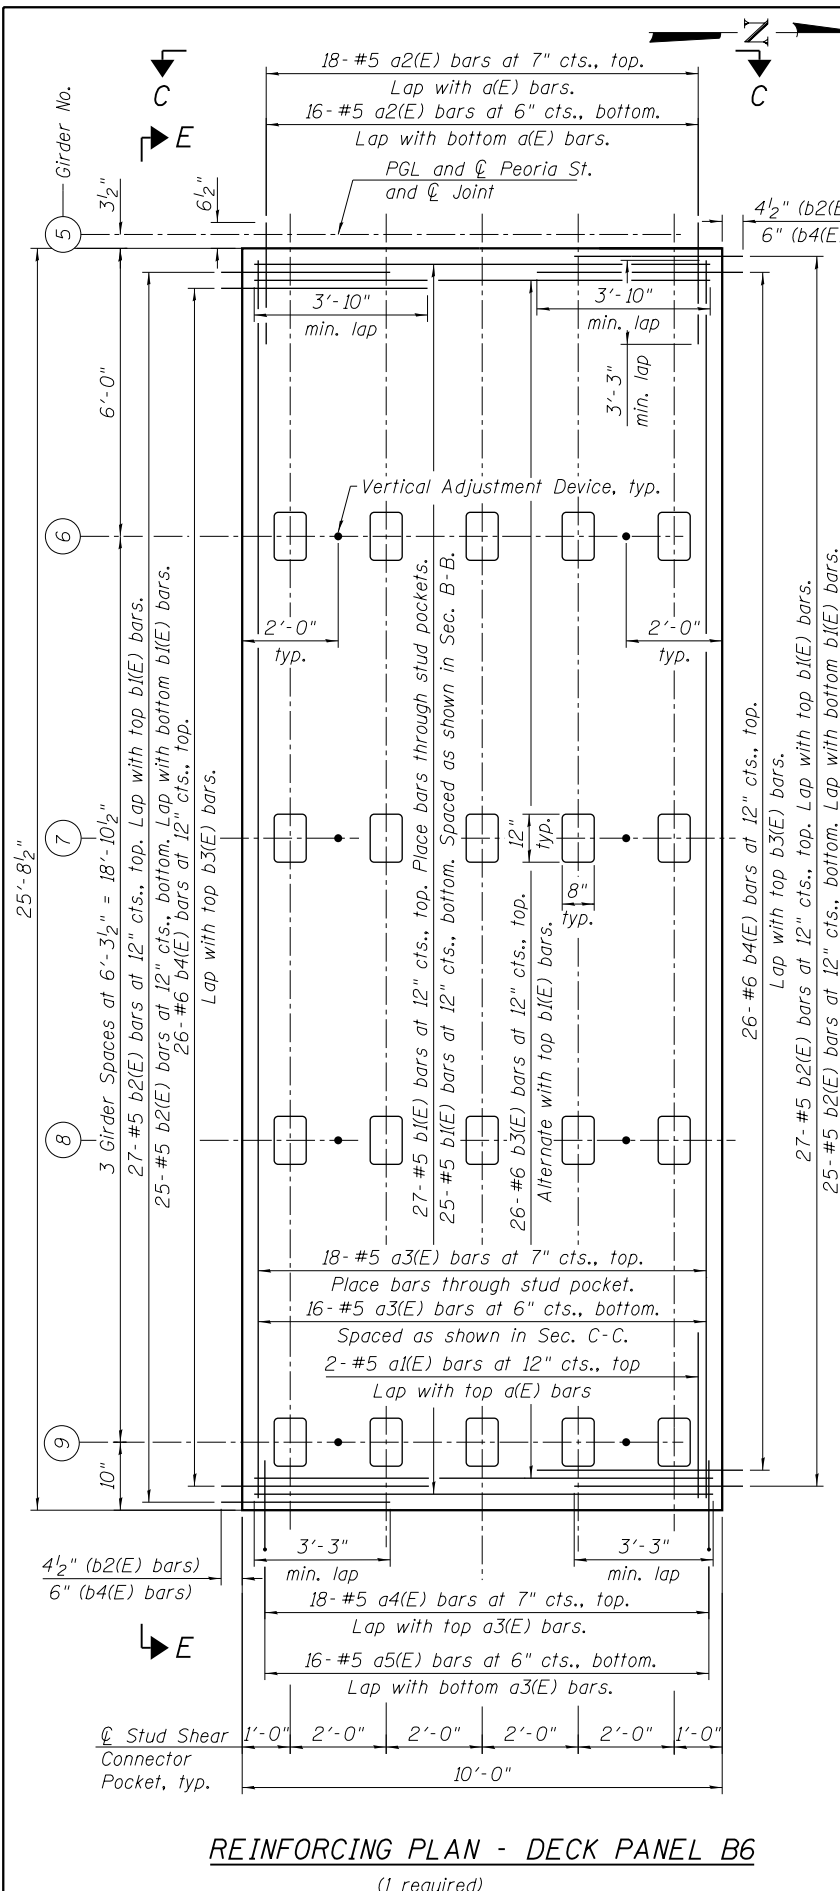


REINFORCING PLAN - DECK PANEL B6
(1 required)

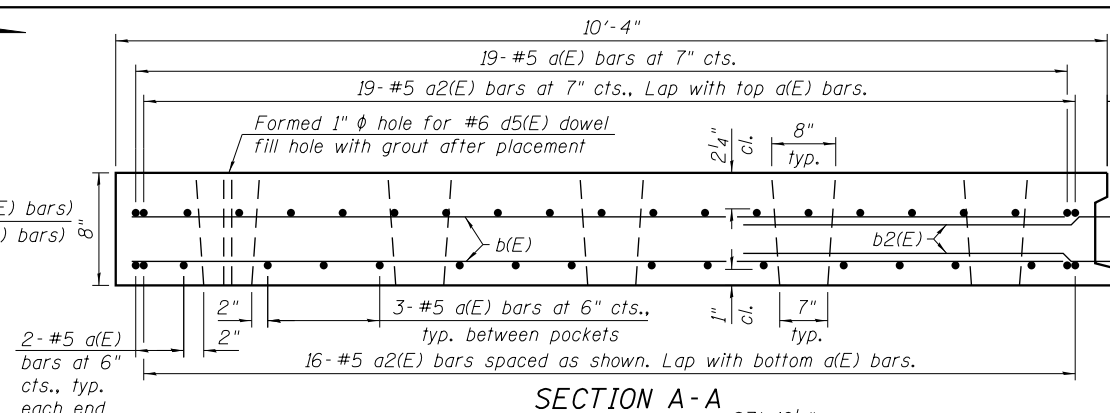


SECTION A-A

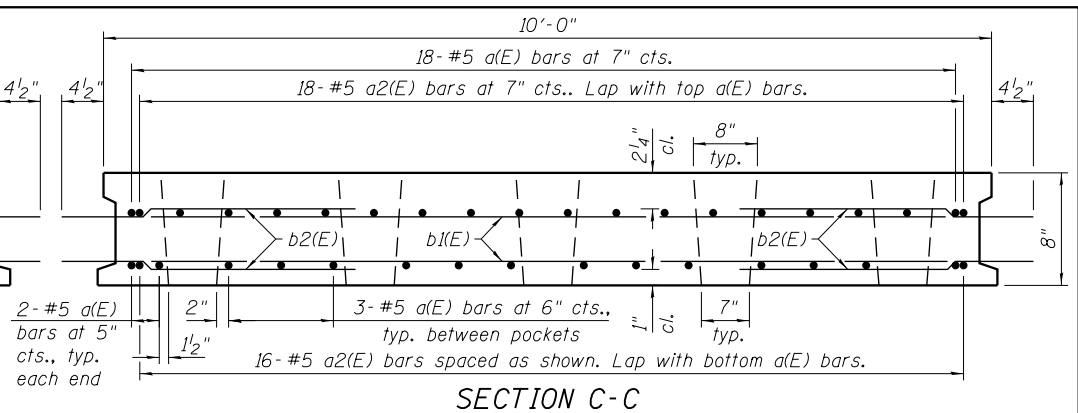


SECTION C-C

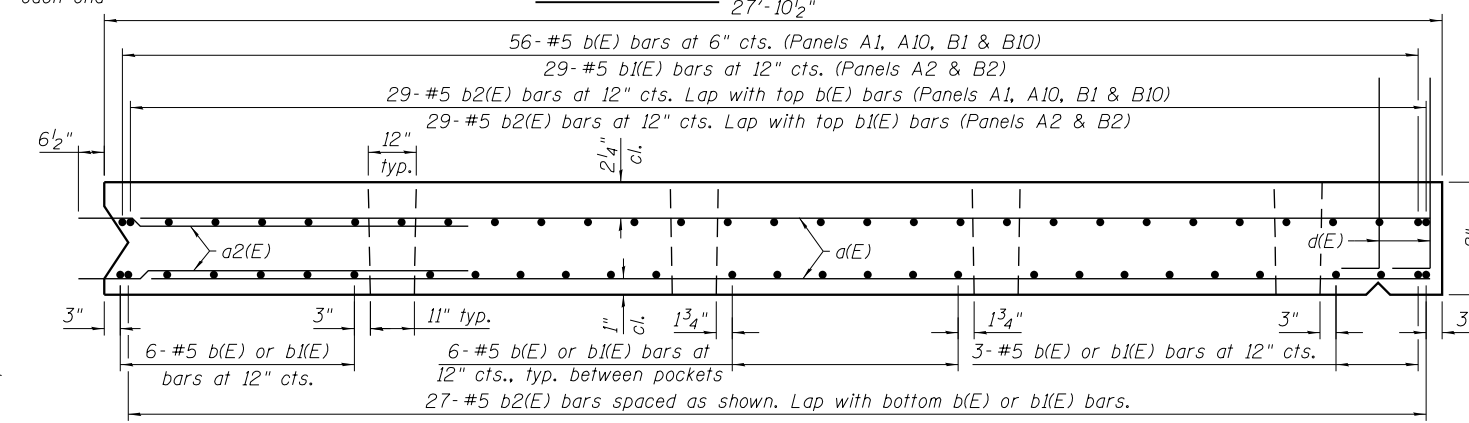


SECTION B-B

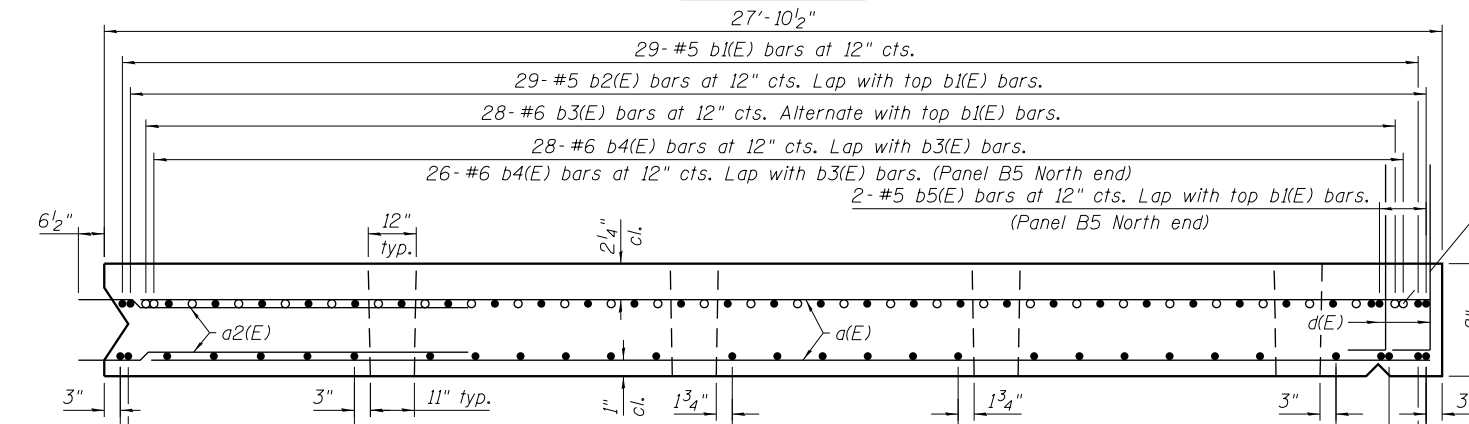

SECTION D-D

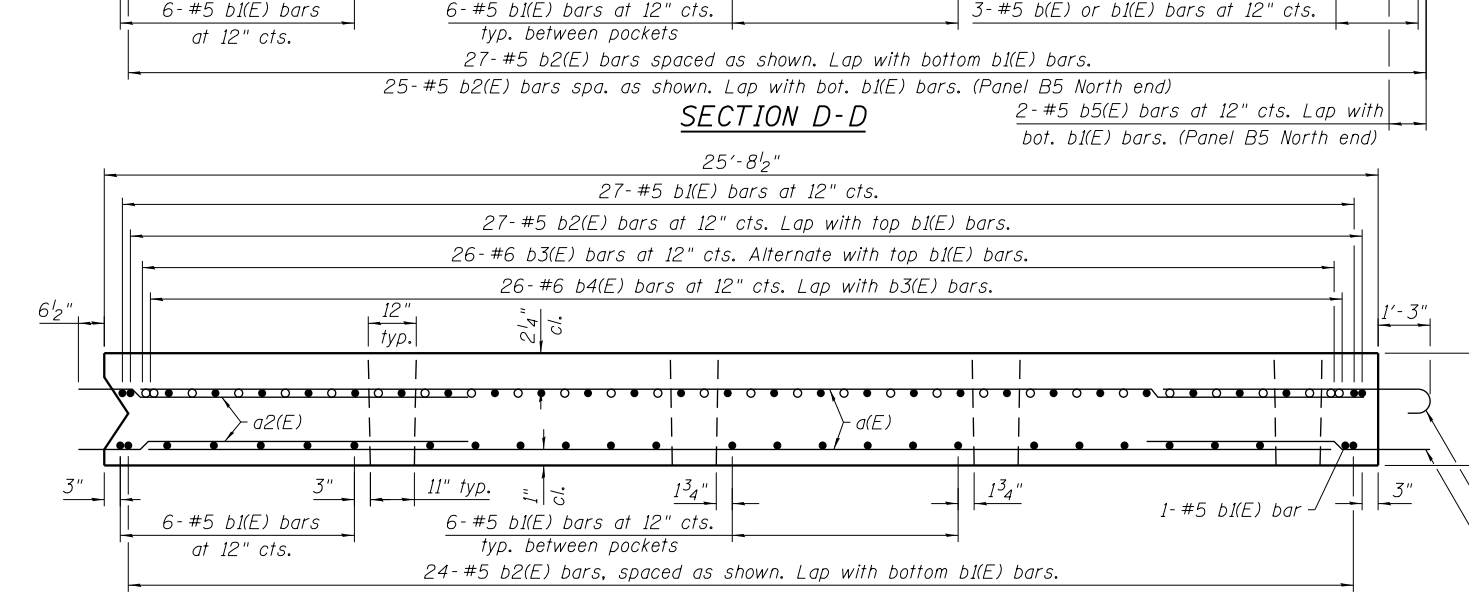

SECTION E-E

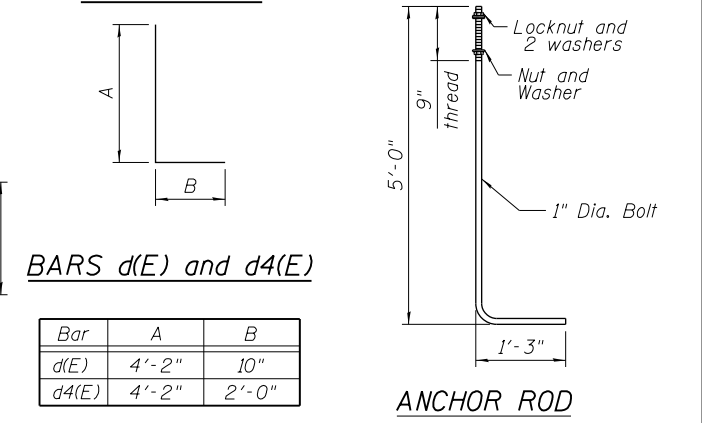


ANCHOR ROD

Cost of anchor rods is included with Precast Concrete Deck Panels. (ASTM F 1554 Grade 105) Full length hot dip galvanized

BARS d(E) and d4(E)

Bar	A	B
d(E)	4'-2"	10"
d4(E)	4'-2"	2'-0"

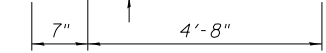

BAR a4(E)

1- #6 b6(E) bar. Alternate with b5(E) bars. Lap with top b1(E) bar. (Panel B5 North end)

***BILL OF MATERIAL**

Bar	No.	Size	Length	Shape
a(E)	1738	#5	27'-6"	—
a1(E)	924	#5	6'-6"	—
a2(E)	1738	#5	4'-0"	—
a3(E)	34	#5	25'-4"	—
a4(E)	18	#5	5'-3"	—
a5(E)	16	#5	5'-4"	—
a6(E)	12	#5	4'-1"	—
a7(E)	12	#5	1'-6"	—
a8(E)	4	#5	1'-1"	—
b(E)	332	#5	10'-0"	—
b1(E)	2684	#5	9'-8"	—
b2(E)	2892	#5	3'-10"	—
b3(E)	726	#6	9'-8"	—
b4(E)	1336	#6	4'-6"	—
b5(E)	4	#5	6'-10"	—
b6(E)	1	#6	8'-0"	—
b7(E)	16	#5	2'-2"	—
d(E)	1144	#5	5'-0"	L
d4(E)	24	#6	6'-2"	L
* Reinforcement Bars, Epoxy Coated			Pound	132,430
* Ultra High Performance Concrete			Cu. Yd.	25.1

* For information only

Notes:
Provide a 3/4" min. gap between adjacent b2(E) or b4(E) dowels within UHPC joints. See Detail B on sheet 16 of 55.

11:03:39 PM 0161708-60W29-5020-Deck_PnlDet5.dgn




USER NAME = BAWItoft	DESIGNED JRM	REVISED
CHECKED WJC	REVISED	
PLOT SCALE = 4x0.0000 '1' / in.	DRAWN RLS	REVISED
PLOT DATE = 10/28/2013	CHECKED DL	REVISED

STATE OF ILLINOIS
DEPARTMENT OF TRANSPORTATION

PRECAST DECK PANEL DETAILS 5
STRUCTURE NO. 016-1708


SHEET NO. 20 OF 55 SHEETS

MUN	SECTION	COUNTY	TOTAL SHEETS	SHEET NO.
2090	2013-011R	COOK	356	152
CONTRACT NO.			60W29	
ILLINOIS FED. AID PROJECT				

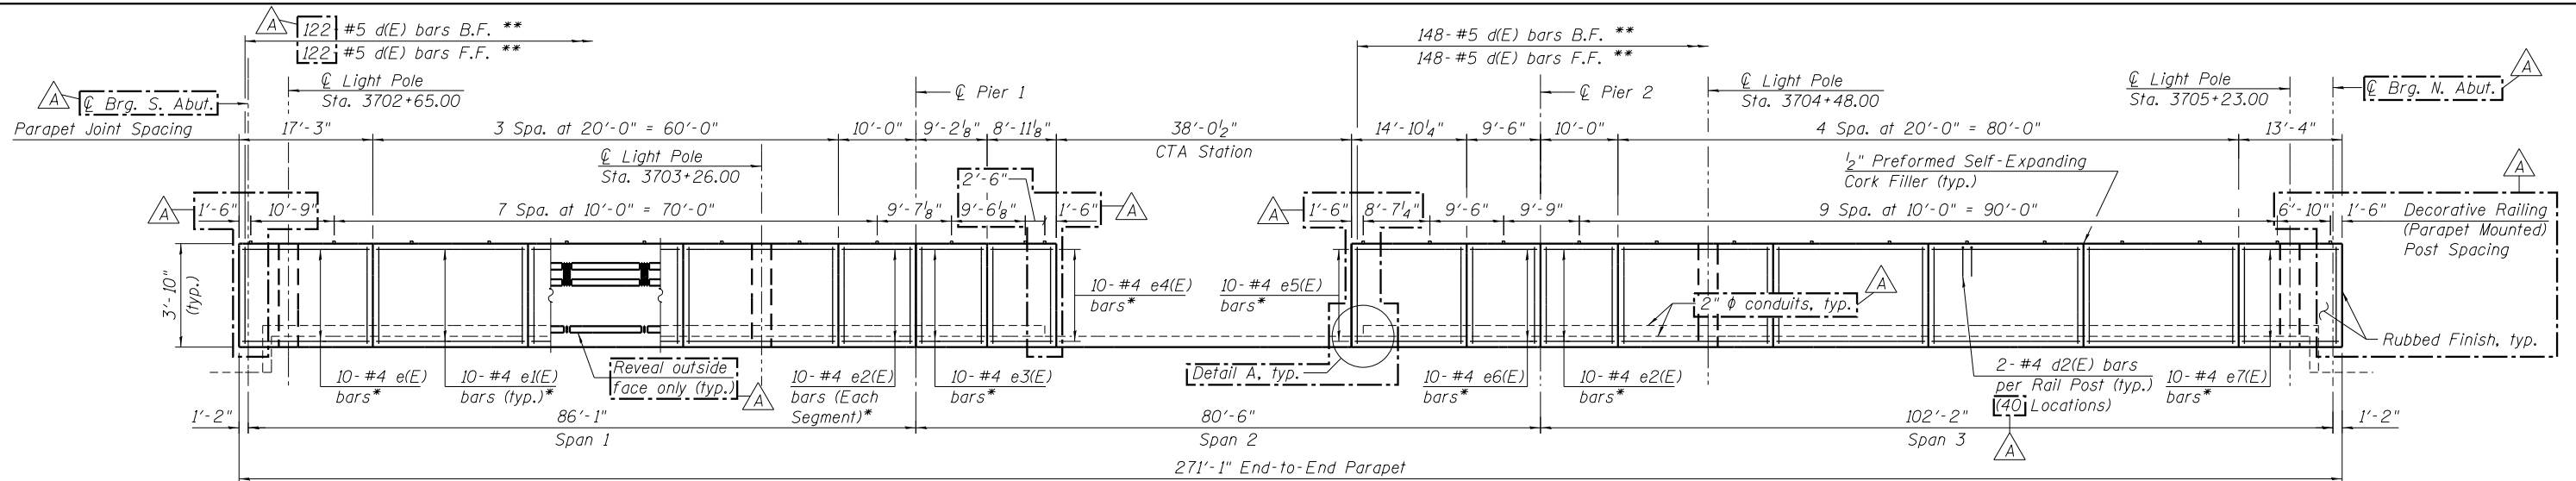

INSIDE ELEVATION OF WEST PARAPET

(Looking West)



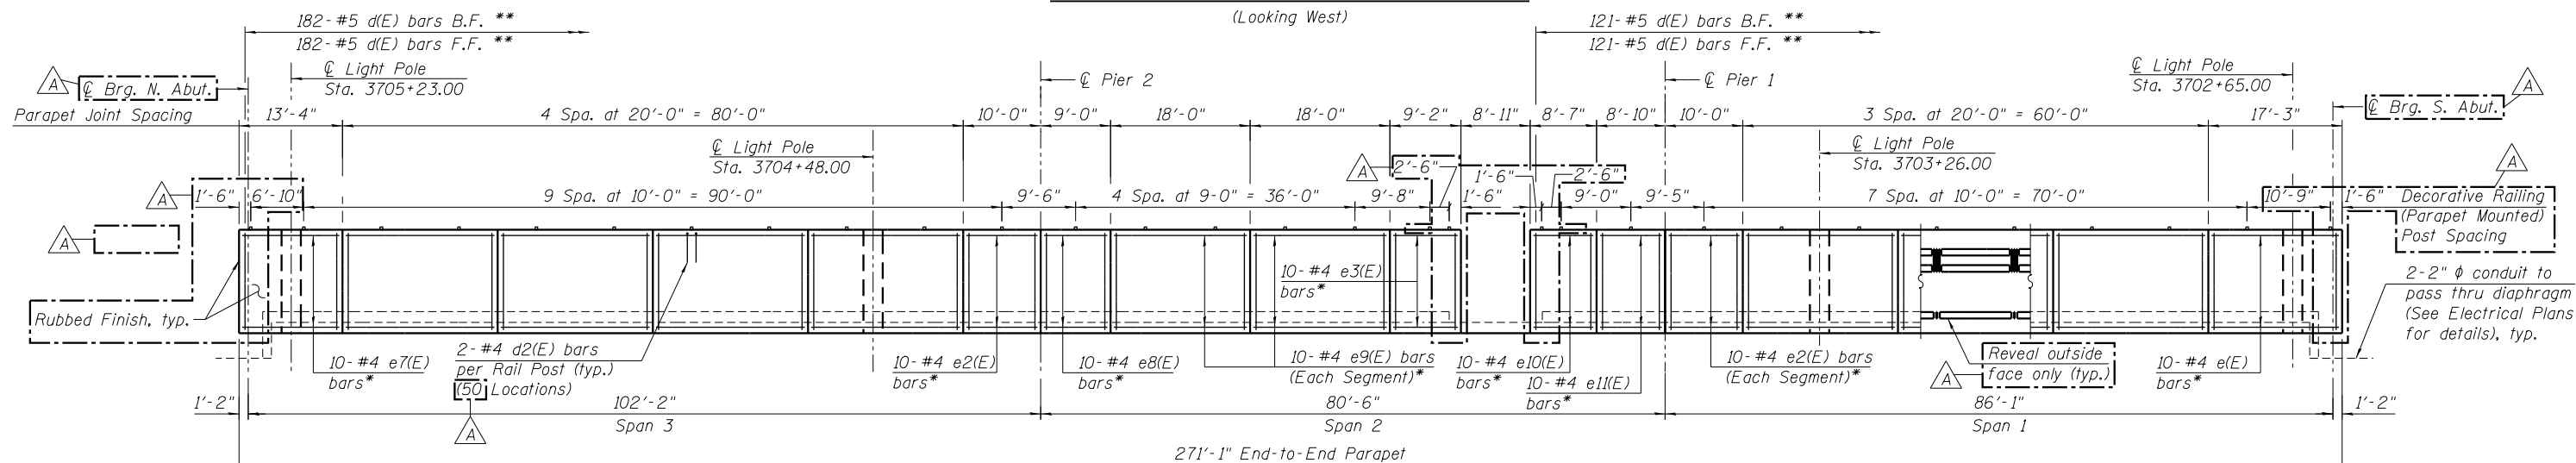


INSIDE ELEVATION OF EAST PARAPET

(Looking East)

- * See Section thru Parapet on Sheet 23 of 55 for spacing.
- ** See Sheets 17 thru 20 of 55 for spacing of d(E) and d4(E) bars. Bars are included with Precast Concrete Deck Panels. See Sheet 20 of 55 for Bill of Material.

Notes:
 For notes, bar diagrams, section through parapet and Bill of Material, see Sheet 23 of 55.
 All edges shall be chamfered 3/4".
 For architectural details on the parapets and Decorative Railing (Parapet Mounted) details, see Sheet 26 of 55.
 For Bridge Fence Railing (Special) layout and post spacing, see Sheet 28 of 55.
 For Bridge Fence Railing (Special) details, see Sheet 29 of 55.
 The cost of reveal is included in cost of Concrete Superstructure.
 Rubbed Finish shall be applied to the inside face and ends of parapet only.

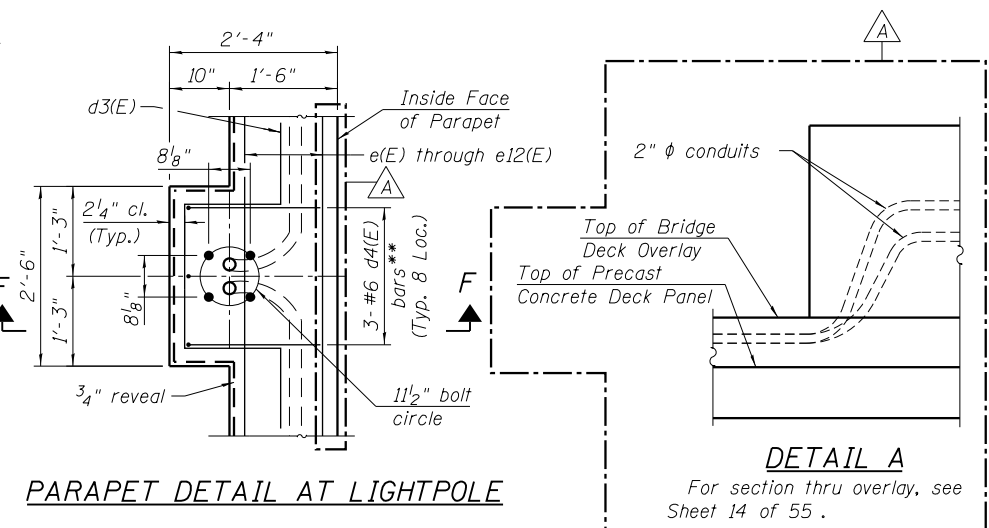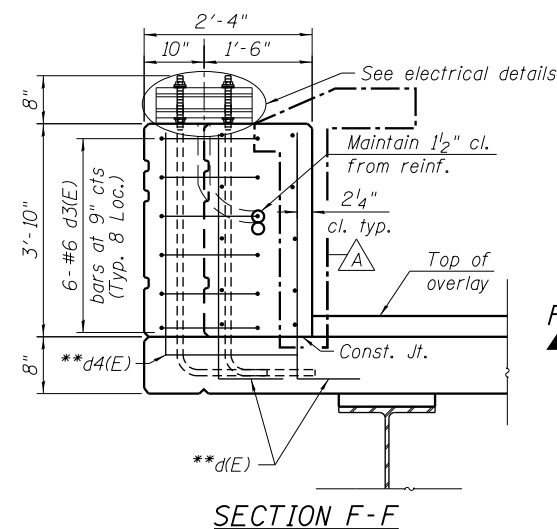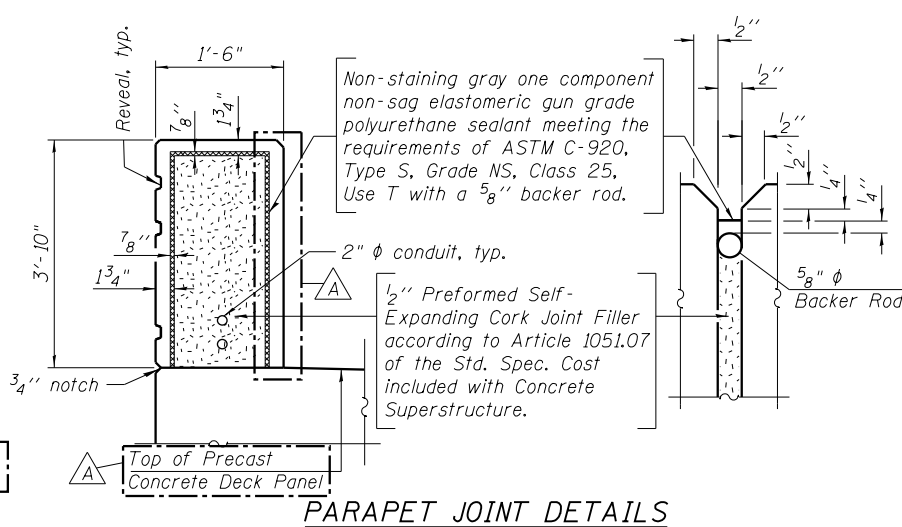

DETAIL A

For section thru overlay, see Sheet 14 of 55.

4/26/18 PM 0161708-60W29-5021-Parapet.dgn




USER NAME = wjcolletti	DESIGNED WJC	REVISED A 12/18/2013 WJC/JRM
PLOT SCALE = 21:4.0000 '"/in.	CHECKED DL	REVISED
PLOT DATE = 1/10/2014	DRAWN SLW	REVISED
	CHECKED JRM	REVISED

**STATE OF ILLINOIS
DEPARTMENT OF TRANSPORTATION**

**PARAPET ELEVATIONS AND DETAILS
STRUCTURE NO. 016-1708**





SHEET NO. 21 OF 55 SHEETS

MUN 2090	SECTION 2013-011R	COUNTY COOK	TOTAL SHEETS 356	SHEET NO. 153
CONTRACT NO. 60W29			ILLINOIS FED. AID PROJECT	

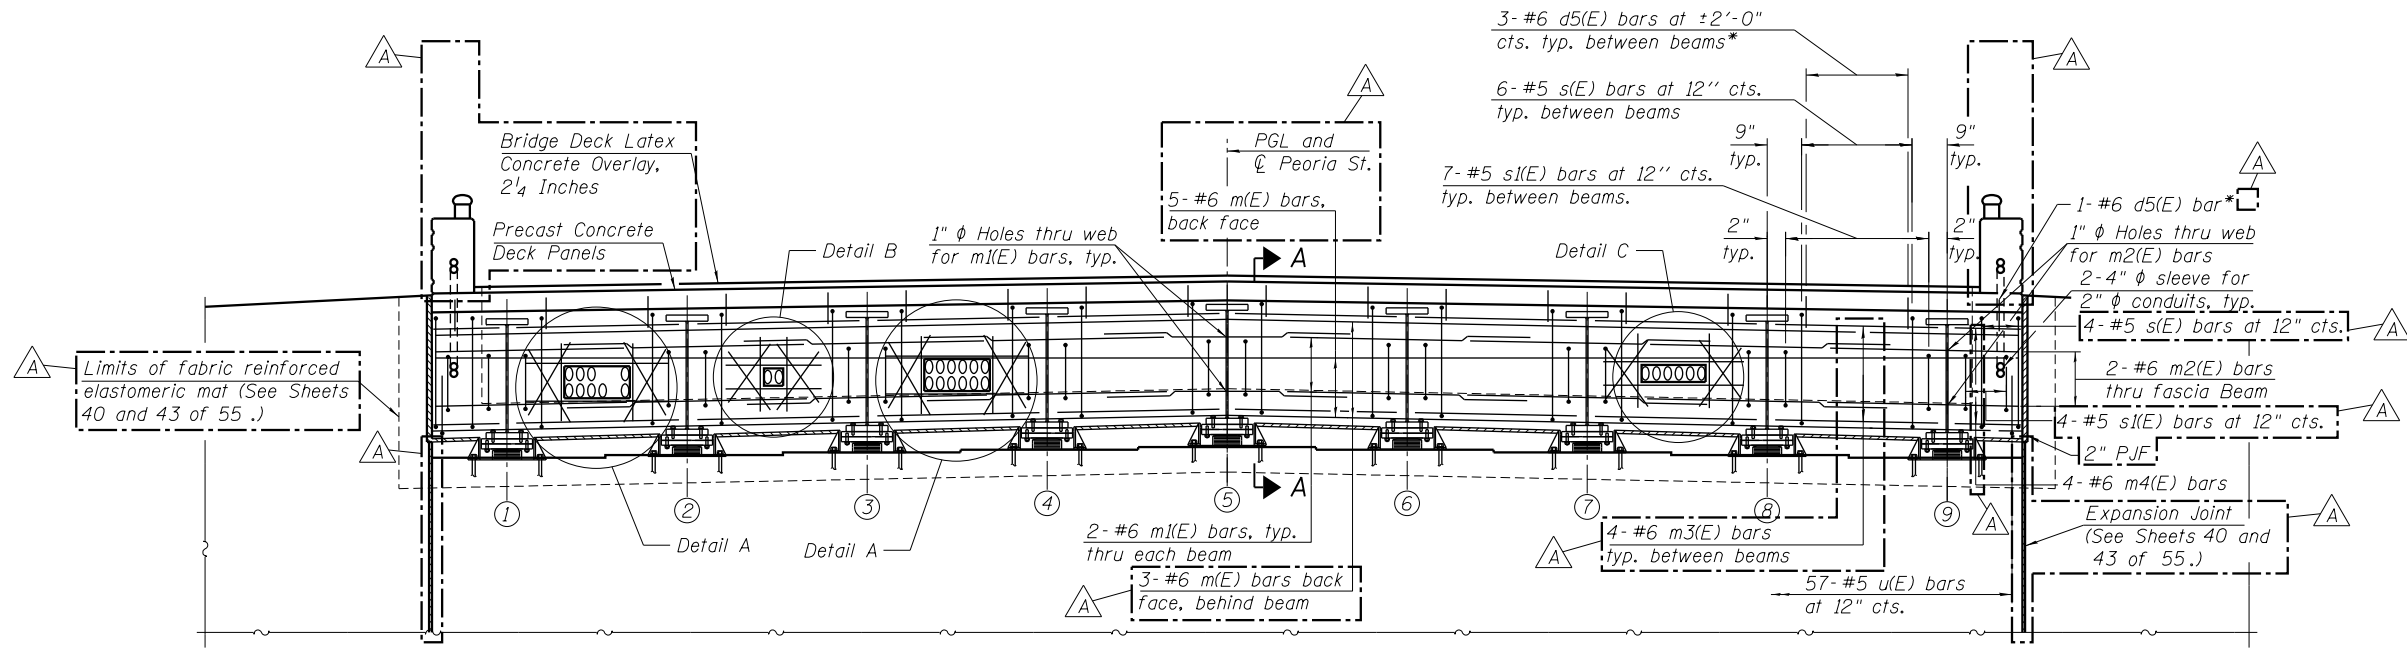

DIAPHRAGM ELEVATION
(North Abutment shown, South Abutment opposite hand)

* See Sheets 17 thru 20 of 55 for spacing of d5(E) bars.

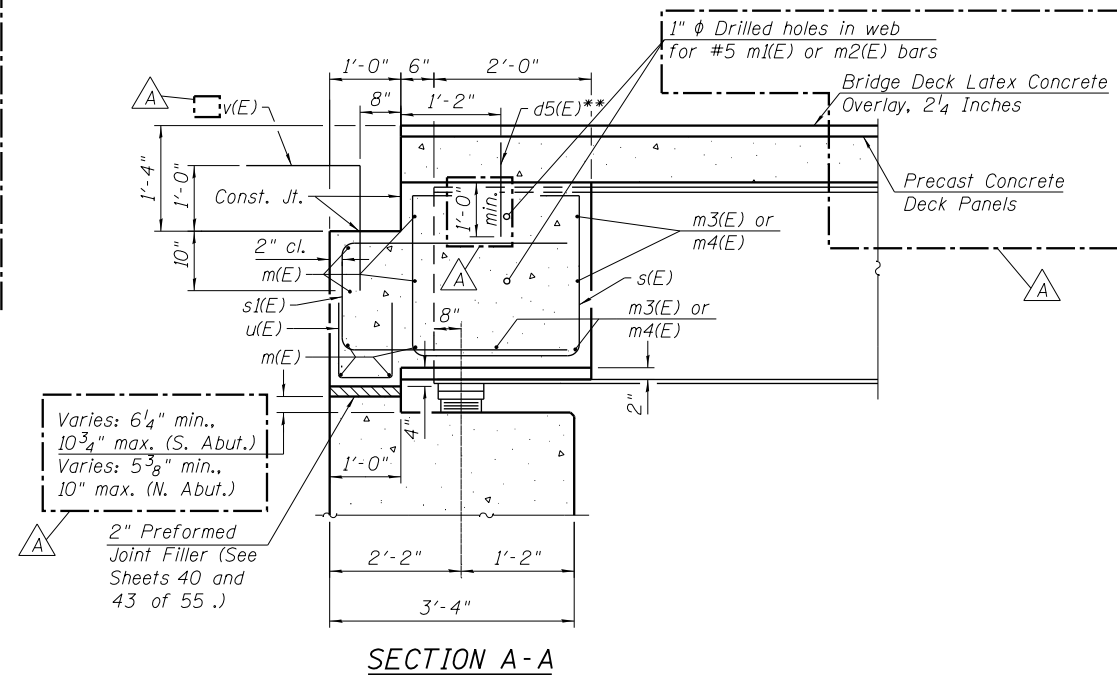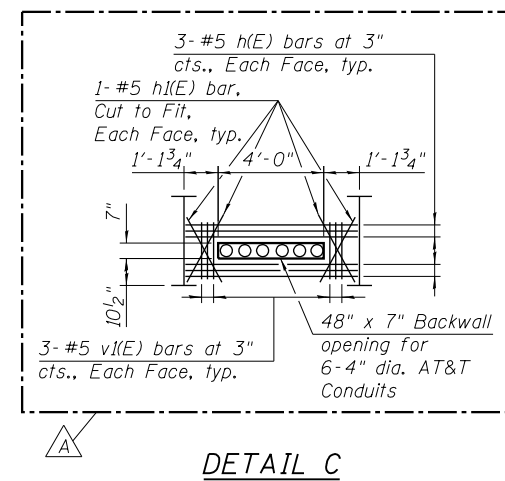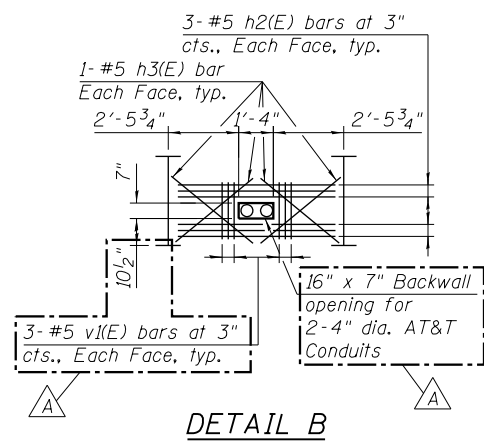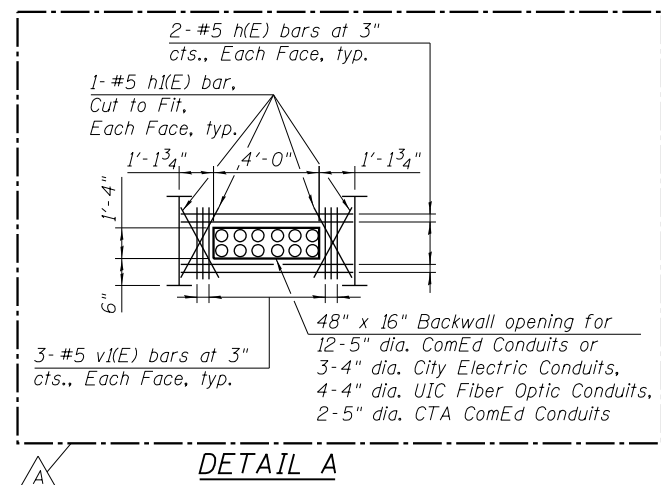

** Drill and set d5(E) bars into the concrete diaphragm according to Article 584 of the Standard Specifications. Method and grout are subject to approval of the Engineer. Cost included with Reinforcement Bars, Epoxy Coated.

Note:
Utility sleeve installed in this Contract. Conduit provided by Others. Contractor to coordinate with utility owner for location and size of the utility sleeves. Cost of utility sleeves included in Concrete Structures.
See Sheet 23 of 55 for Bill of Material.
See Sheet 24 of 55 for spacing of v(E) bars.

10:31:40 AM 0161708-60W29-5022-SuperStruct-Detail.dgn



USER NAME = BAWIort	DESIGNED WJC	REVISED Δ 12/18/2013 WJC/JRM
PLOT SCALE = 32:0.0000 ' : ' / in.	CHECKED JRM	REVISED
PLOT DATE = 12/19/2013	DRAWN WJC	REVISED
	CHECKED JRM	REVISED


STATE OF ILLINOIS
DEPARTMENT OF TRANSPORTATION

SUPERSTRUCTURE DETAILS 1
STRUCTURE NO. 016-1708


SHEET NO. 22 OF 55 SHEETS

MUN	SECTION	COUNTY	TOTAL SHEETS	SHEET NO.
2090	2013-011R	COOK	356	154
CONTRACT NO.			60W29	



ILLINOIS FED. AID PROJECT

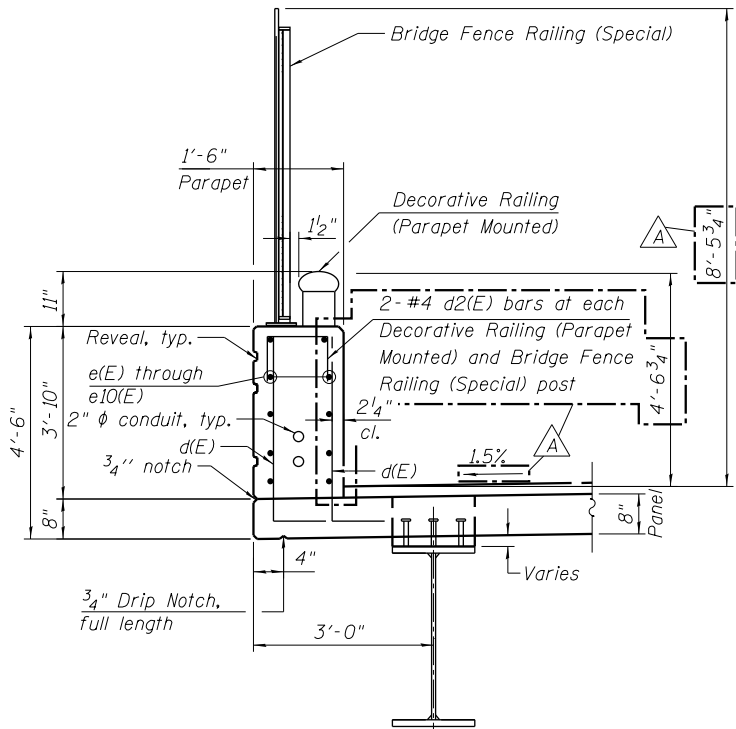


SECTION THROUGH WEST PARAPET
(Looking Up-Station, East Parapet similar, opposite hand)

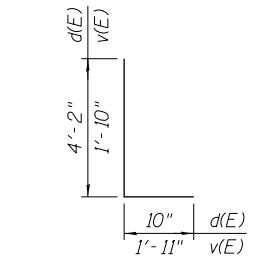


BAR d(E) and v(E)

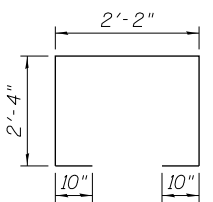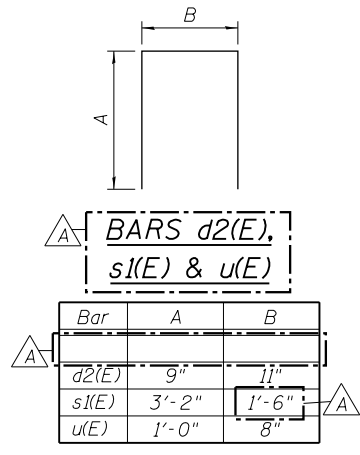


BAR s(E)

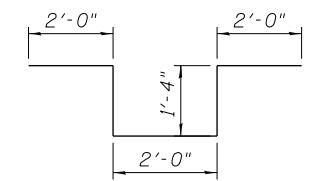

BARS d3(E)

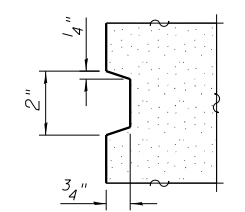


REVEAL DETAIL

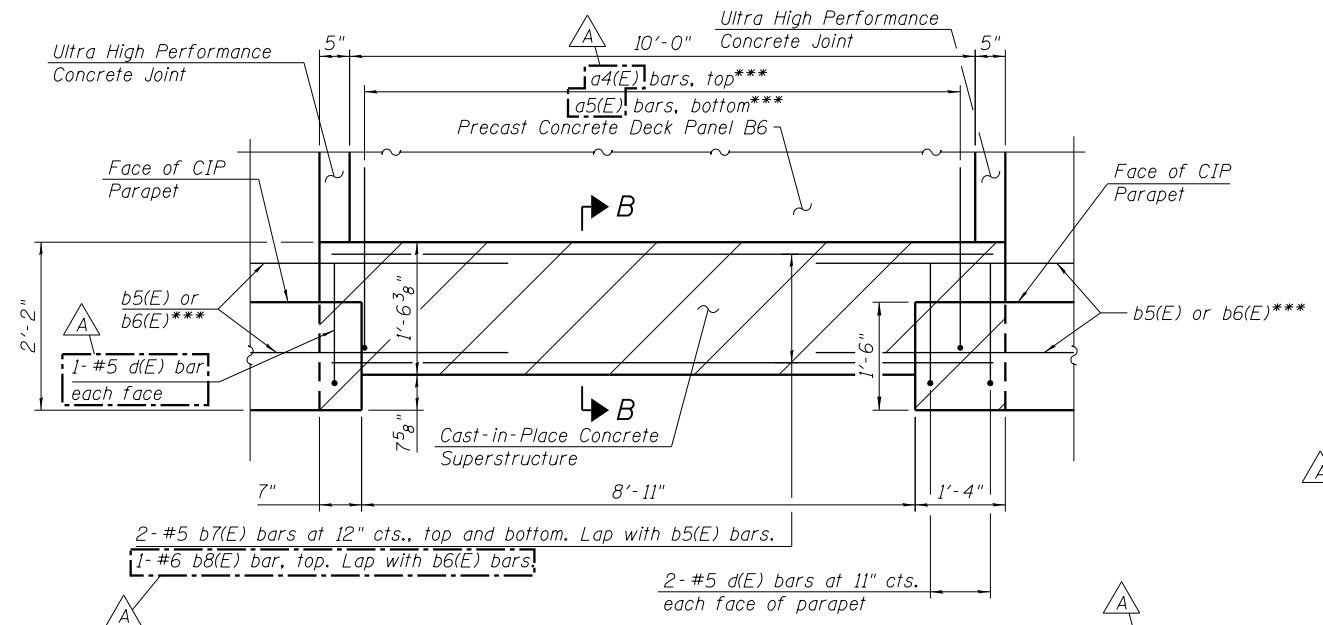

DETAIL E
(At CTA Stairway)

*** Cost included with Precast Concrete Deck Panels. See sheet 20 of 55 for Bill of Material.

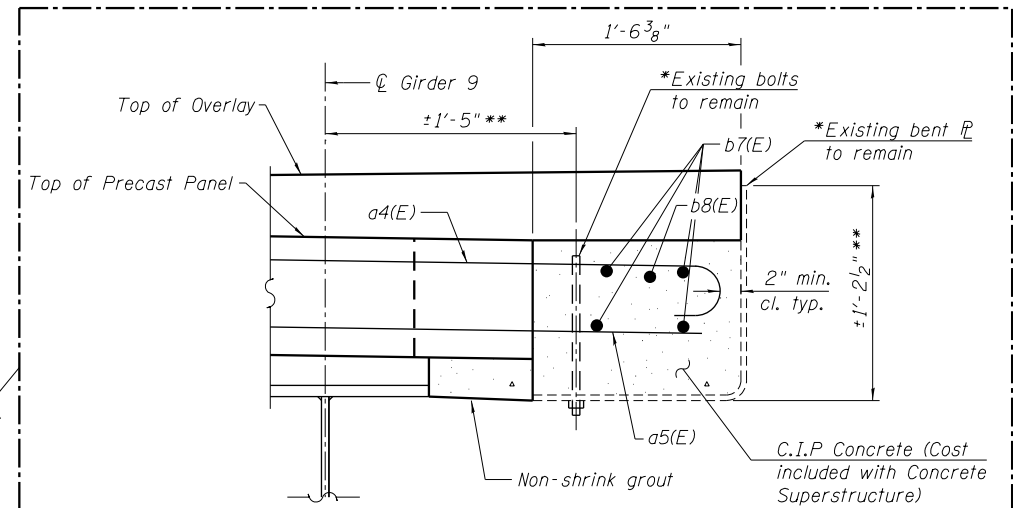

SECTION B-B

* See CTA Building Plans for additional details.
** The Contractor shall field verify existing dimensions and details affecting new construction and make necessary approved adjustments prior to construction or ordering of materials.

BILL OF MATERIAL

Bar	No.	Size	Length	Shape
b7(E)	4	#5	10'-6"	
b8(E)	1	#6	10'-6"	
d(E)	6	#5	5'-0"	
d2(E)	180	#4	2'-5"	
d3(E)	48	#6	8'-8"	
d5(E)	52	#6	1'-6"	
e(E)	20	#4	16'-11"	
e1(E)	140	#4	19'-8"	
e2(E)	40	#4	9'-8"	
e3(E)	20	#4	8'-10"	
e4(E)	10	#4	8'-7"	
e5(E)	10	#4	14'-6"	
e6(E)	10	#4	9'-2"	
e7(E)	20	#4	13'-0"	
e8(E)	10	#4	8'-8"	
e9(E)	20	#4	17'-8"	
e10(E)	10	#4	8'-3"	
e11(E)	10	#4	8'-6"	
h(E)	28	#5	5'-11"	
h1(E)	24	#5	2'-3"	
h2(E)	12	#5	4'-5"	
h3(E)	8	#5	2'-10"	
m(E)	16	#6	56'-0"	
m1(E)	28	#6	10'-2"	
m2(E)	8	#6	7'-11"	
m3(E)	64	#6	5'-11"	
m4(E)	16	#6	2'-8"	
s(E)	112	#5	8'-6"	
s1(E)	128	#5	7'-10"	
u(E)	114	#5	2'-8"	
v(E)	51	#5	3'-9"	
v1(E)	48	#5	2'-0"	
Concrete Superstructure		Cu. Yd.	144.1	
Protective Coat		Sq. Yd.	299	
Reinforcement Bars, Epoxy Coated		Pound	9,830	
Rubbed Finish		Sq. Ft.	1,945	

MIN. BAR LAP
#5 bar = 3'-3"
#6 bar = 3'-10"

Note:
See sheet 35 of 55 for additional CTA Stairway connection details.

4:38:10 PM 0161708-60W29-5023-SuperStruct-Detail2.dgn




USER NAME = wjcollett1	DESIGNED WJC	REVISED A 12/18/2013 WJC/JRM
PLOT SCALE = 32x0.0000 ' / in.	CHECKED JRM	REVISED
PLOT DATE = 1/10/2014	DRAWN WJC	REVISED
	CHECKED JRM	REVISED

STATE OF ILLINOIS
DEPARTMENT OF TRANSPORTATION


SUPERSTRUCTURE DETAILS 2
STRUCTURE NO. 016-1708

SHEET NO. 23 OF 55 SHEETS

MUN 2090	SECTION 2013-011R	COUNTY COOK	TOTAL SHEETS 356	SHEET NO. 155
CONTRACT NO. 60W29			ILLINOIS FED. AID PROJECT	

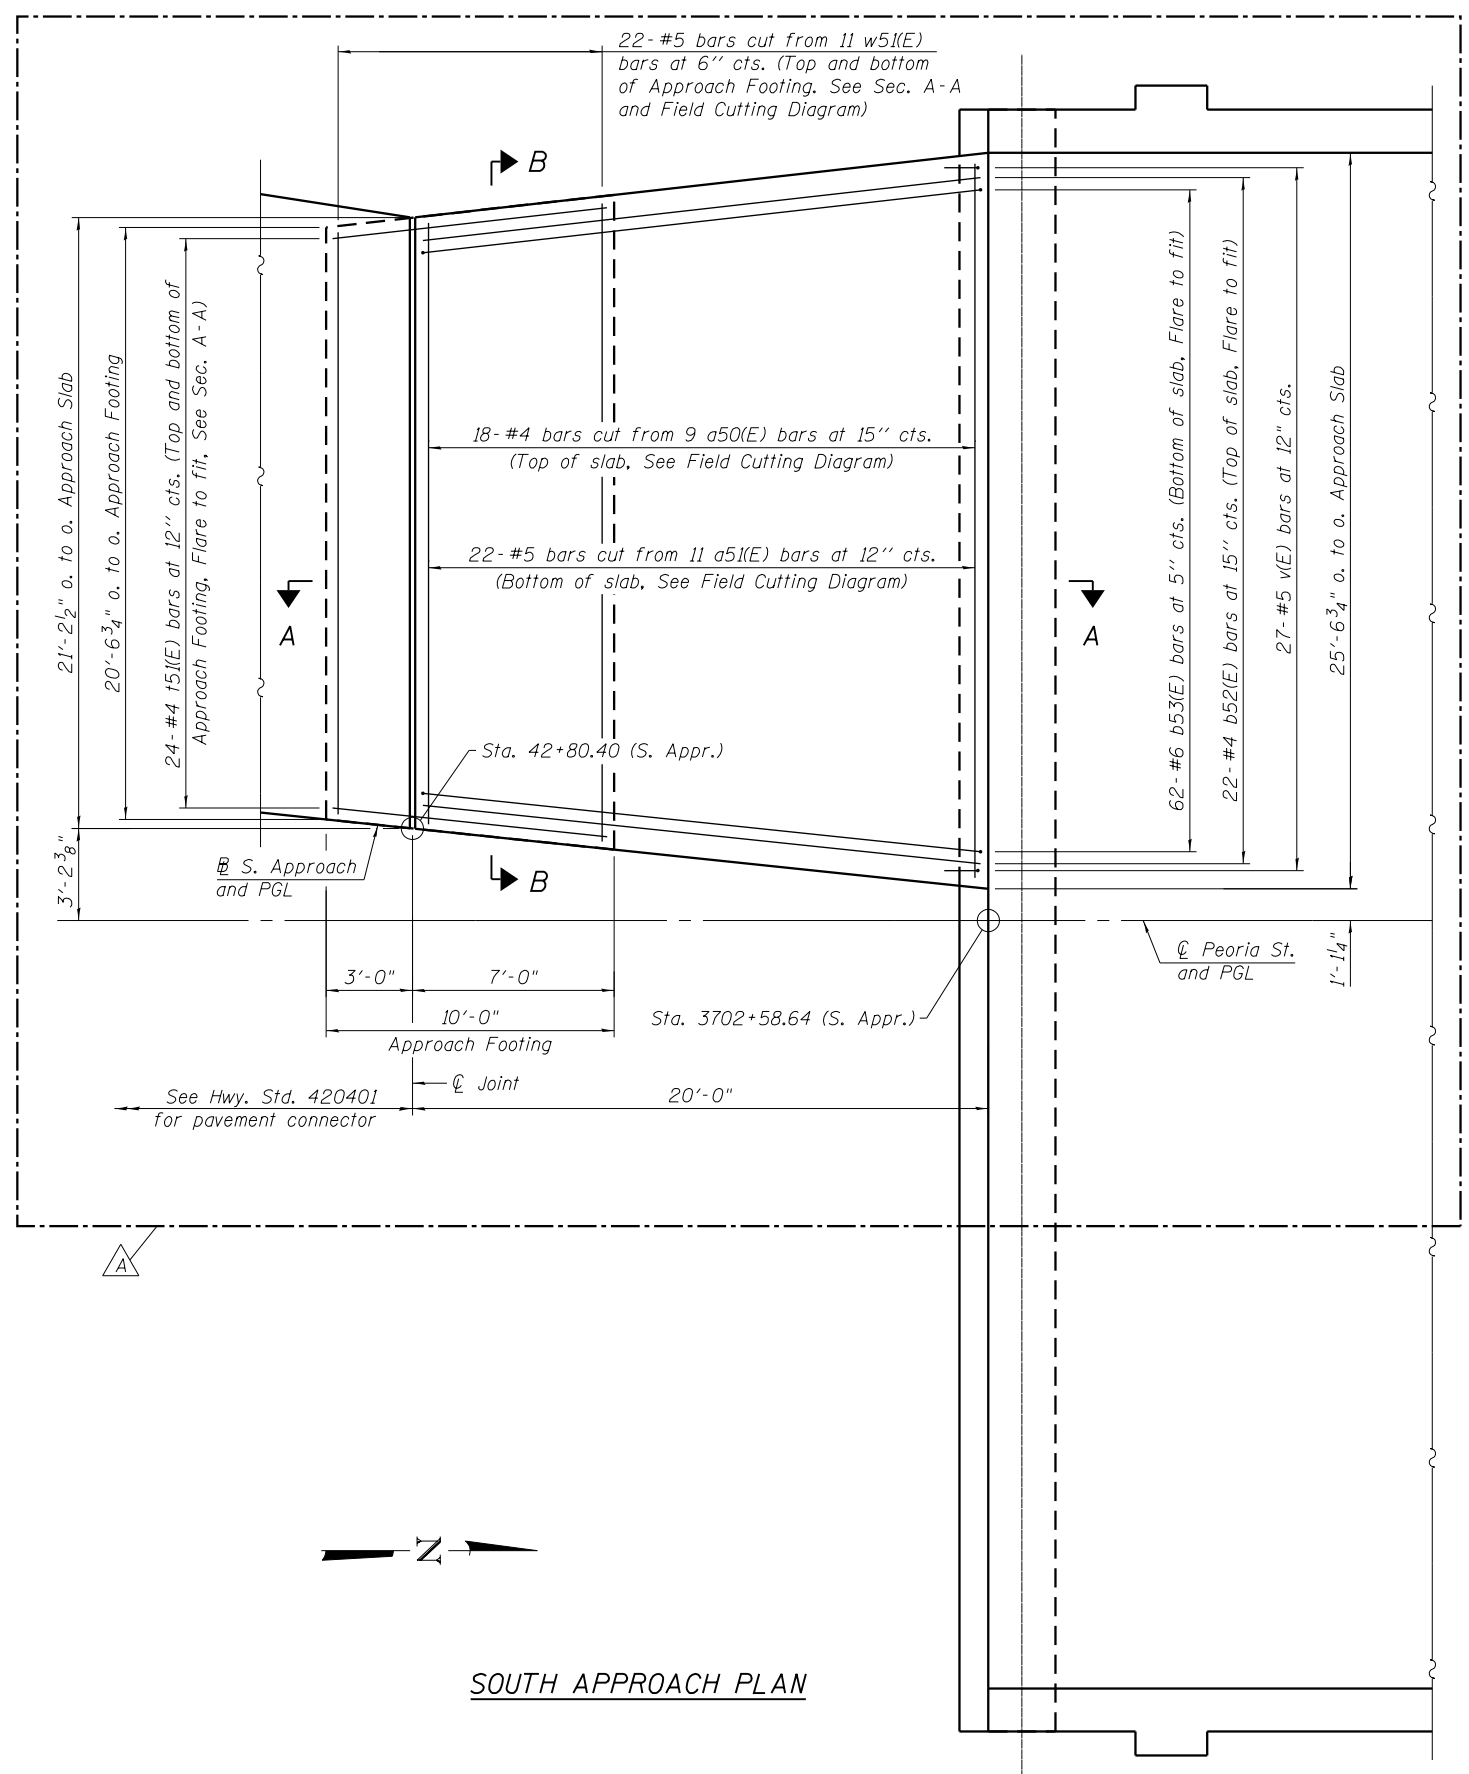

SOUTH APPROACH PLAN

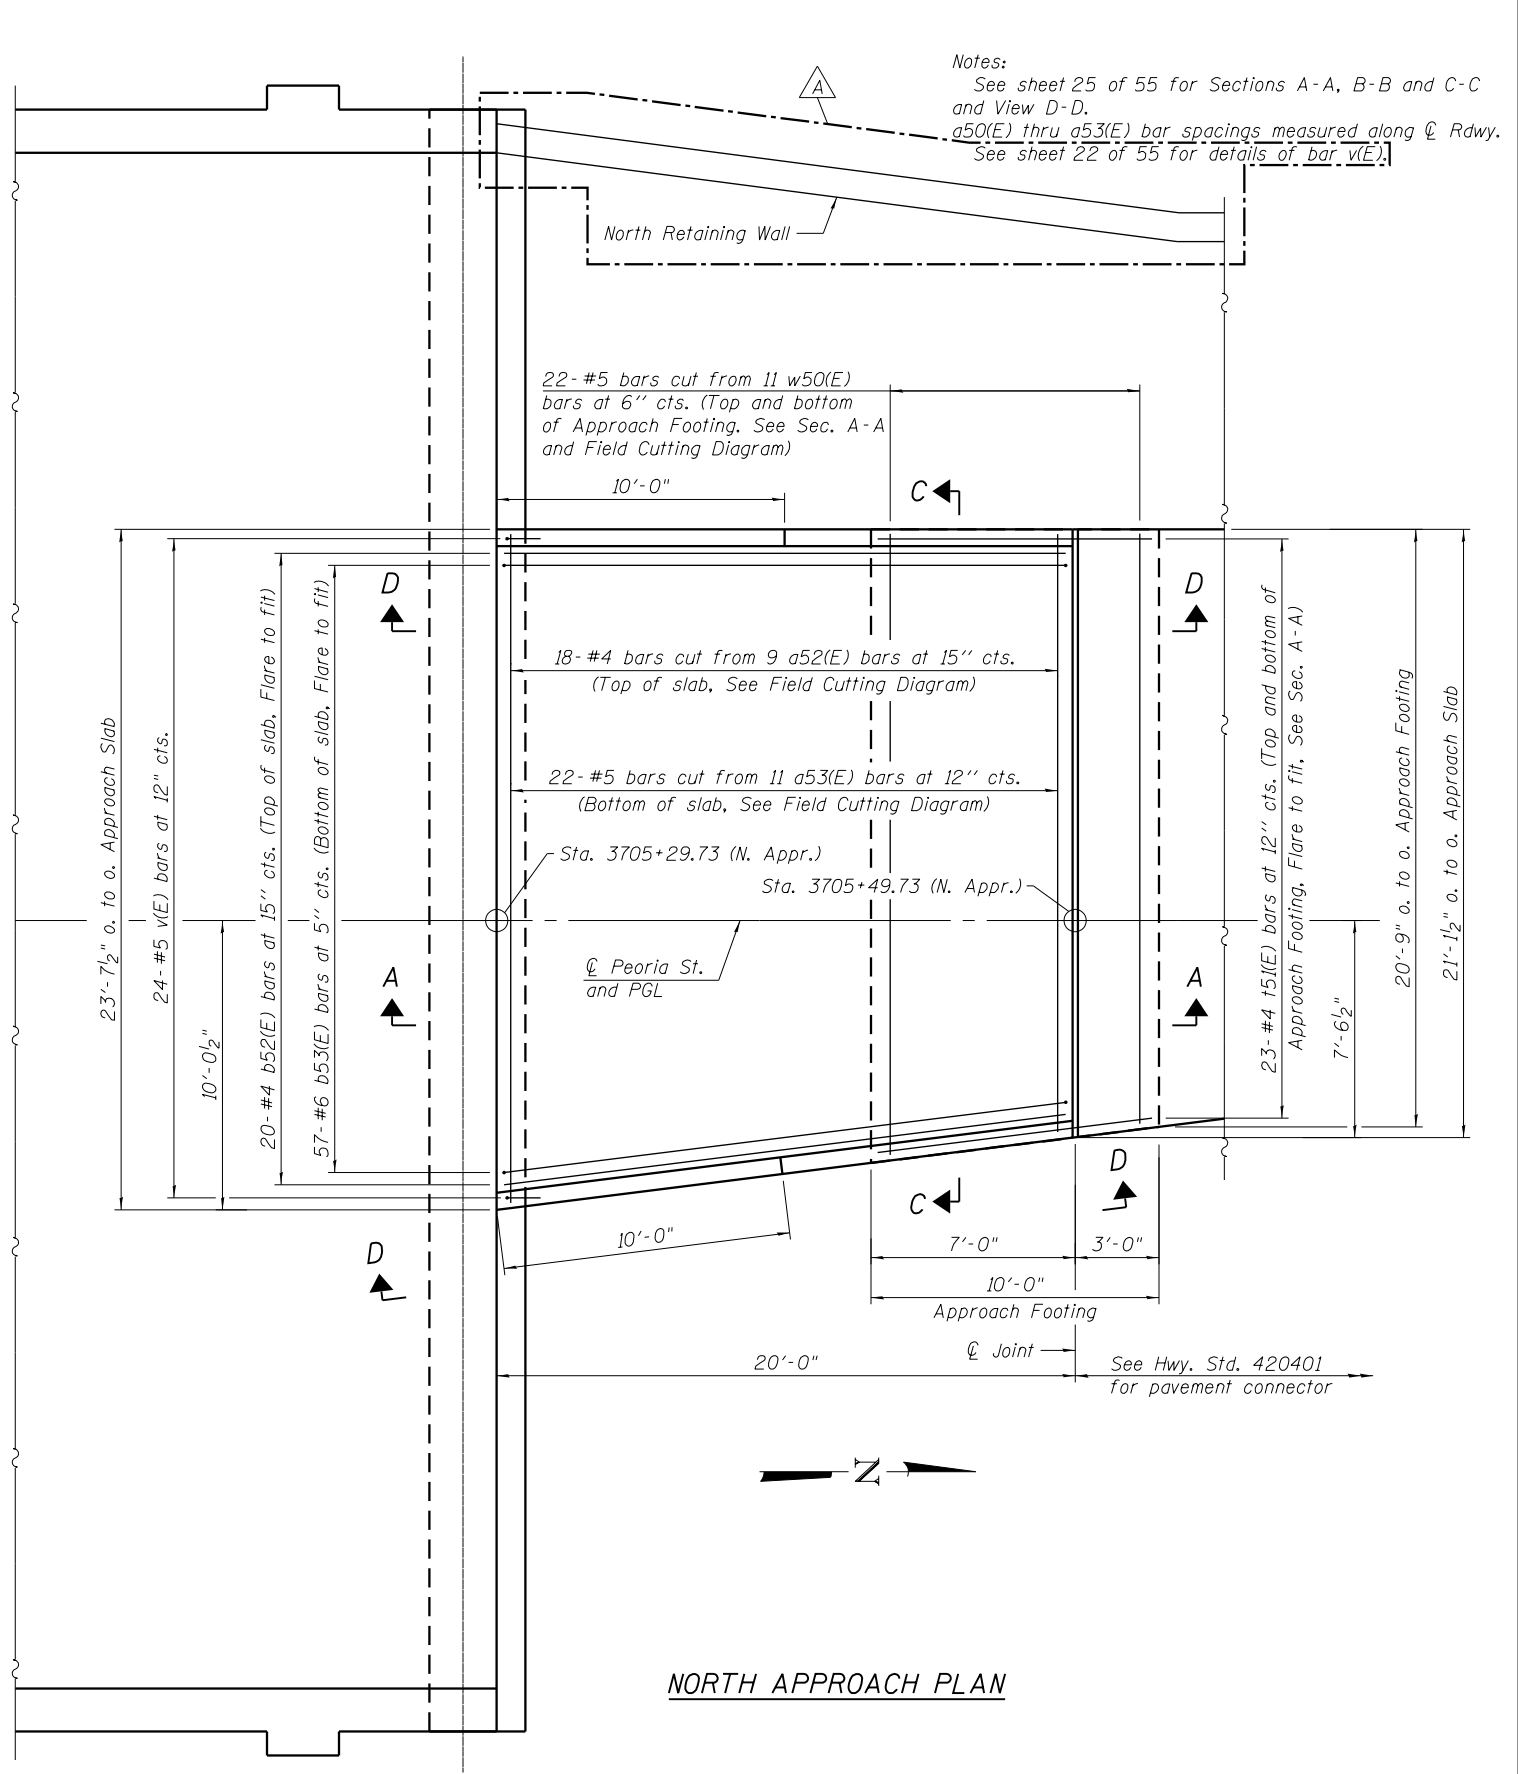

NORTH APPROACH PLAN

Notes:
 See sheet 25 of 55 for Sections A-A, B-B and C-C and View D-D.
 a50(E) thru a53(E) bar spacings measured along $\text{\textcircled{C}}$ Rdwy.
 See sheet 22 of 55 for details of bar v(E).

10:32:12 AM 0161708-60W29-5024-ApprSlab_Details1.dgn




USER NAME = BAWIort	DESIGNED WJC	REVISED Δ 12/18/2013 WJC/DL
PLOT SCALE = 0:2.0000 ' / in.	CHECKED DL	REVISED
PLOT DATE = 12/19/2013	DRAWN WJC	REVISED
	CHECKED DL	REVISED

STATE OF ILLINOIS
 DEPARTMENT OF TRANSPORTATION

BRIDGE APPROACH SLAB DETAILS 1
 STRUCTURE NO. 016-1708





SHEET NO. 24 OF 55 SHEETS

MUN	SECTION	COUNTY	TOTAL SHEETS	SHEET NO.
2090	2013-011R	COOK	356	156
CONTRACT NO.			60W29	
ILLINOIS FED. AID PROJECT				

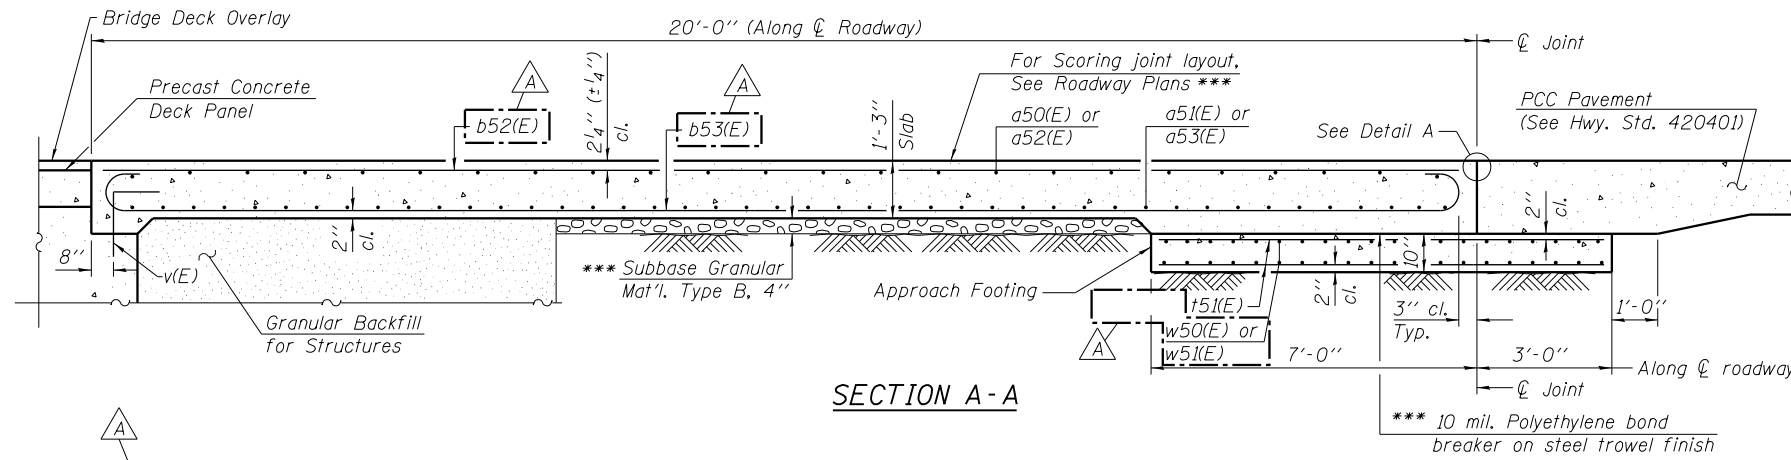

Notes:
 Approach slab and curb concrete shall be paid for as Concrete Superstructure.
 Approach footing concrete shall be paid for as Concrete Structures.
 Reinforcement shall be paid for as Reinforcement Bars, Epoxy Coated.
 For v(E) bar details, see sheet 23 of 55.
 The approach footing maximum applied service bearing pressure (Q_{max}) = 2.0 ksf.
 Cost of excavation for approach footing included with Concrete Structures.
 For Granular Backfill for Structures and drainage treatment details, see sheet 40 of 55.
 The joint opening shall be determined per Article 520.04 except that on jointless structures, the distance described as the bridge length between the nearest fixed bearings each way from the joint shall be taken as half the bridge length plus the approach slab length. The minimum dimension shall be 1 1/2" for installation purposes.

*** Cost included with Concrete Superstructure.

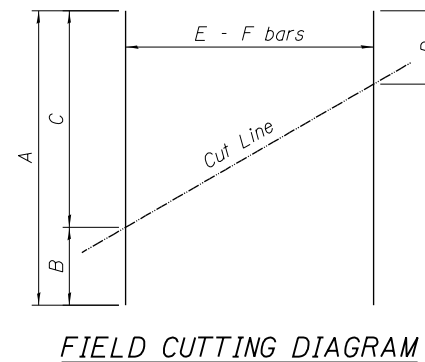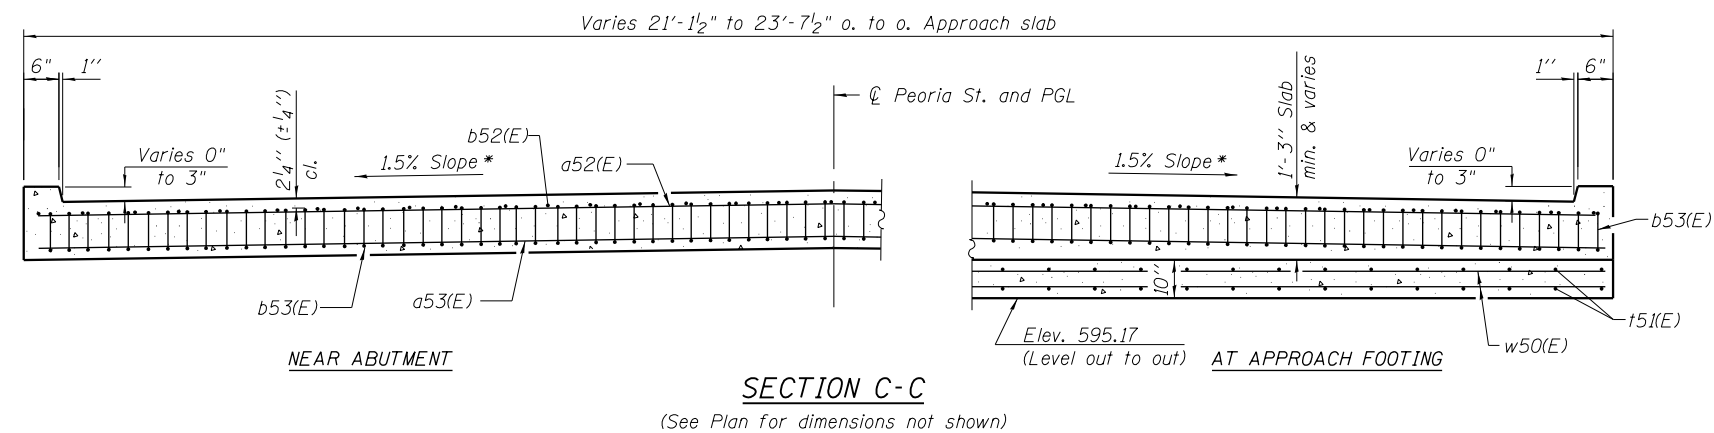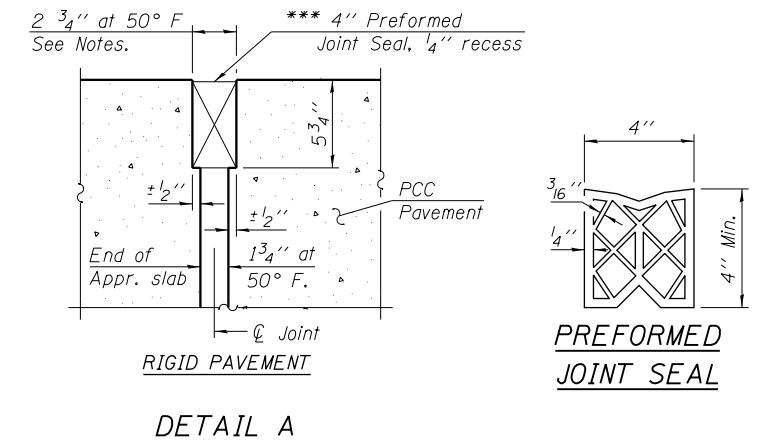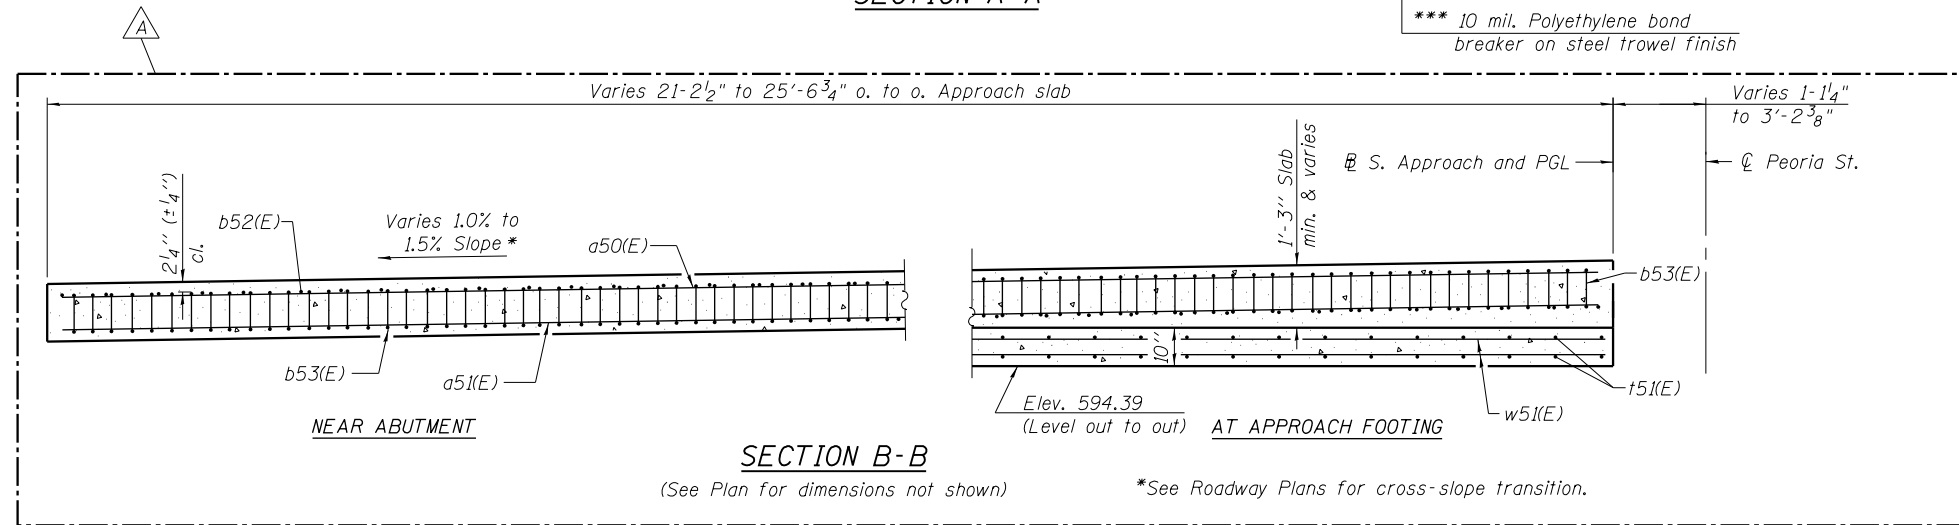

FIELD CUTTING DIAGRAM

Order bars full length. Cut as Shown and use remainder of bars in opposite face.



FIELD CUTTING TABLE

Bar	A	B	C	D	E	F
a50(E)	46'-1"	23'-2"	22'-11"	20'-11"	9	#4
a51(E)	46'-1"	23'-2"	22'-11"	20'-11"	11	#5
a52(E)	44'-1"	20'-10"	23'-3"	22'-1"	9	#4
a53(E)	44'-1"	20'-10"	23'-3"	22'-1"	11	#5
w50(E)	42'-1"	20'-5"	21'-8"	21'-1"	11	#5
w51(E)	42'-7"	21'-4"	21'-3"	20'-3"	11	#5

TWO APPROACHES
 BILL OF MATERIAL

Bar	No.	Size	Length	Shape
a50(E)	9	#4	46'-1"	—
a51(E)	11	#5	46'-1"	—
a52(E)	9	#4	44'-1"	—
a53(E)	11	#5	44'-1"	—
b52(E)	42	#4	19'-10"	—
b53(E)	119	#6	21'-0"	—
t51(E)	94	#4	9'-8"	—
w50(E)	22	#5	42'-1"	—
w51(E)	22	#5	42'-7"	—
Concrete Superstructure		Cu. Yd.	42.4	—
Concrete Structures		Cu. Yd.	13.3	—
Reinforcement Bars, Epoxy Coated		Pound	8,440	—

** Cut to fit in field

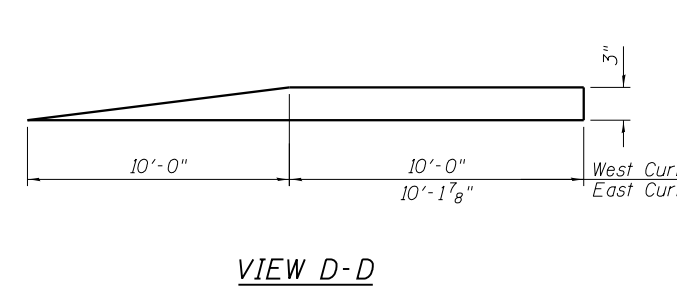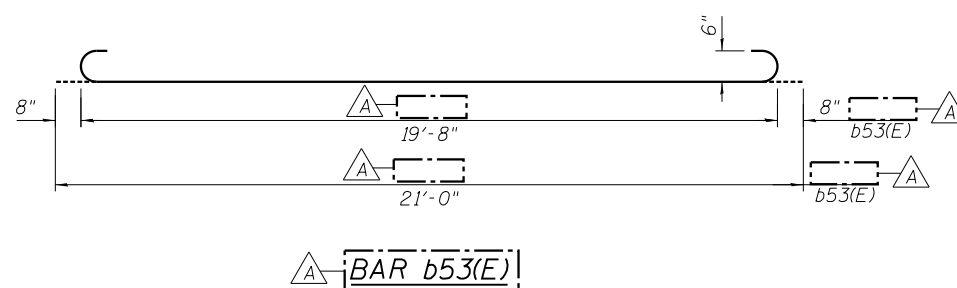


10:32:13 AM 0161708-60W29-5025-ApprSlab_Details2.dgn




USER NAME = BAWIort	DESIGNED = WJC	REVISED = 12/18/2013 WJC/DL
CHECKED = DL	REVISIONS	
PLOT SCALE = 0:2.0000 '1" / in.	DRAWN = WJC	REVISIONS
PLOT DATE = 12/19/2013	CHECKED = DL	REVISIONS

STATE OF ILLINOIS
 DEPARTMENT OF TRANSPORTATION

BRIDGE APPROACH SLAB DETAILS 2
 STRUCTURE NO. 016-1708


SHEET NO. 25 OF 55 SHEETS

MUN	SECTION	COUNTY	TOTAL SHEETS	SHEET NO.
2090	2013-011R	COOK	356	157
CONTRACT NO.			60W29	
ILLINOIS FED. AID PROJECT				

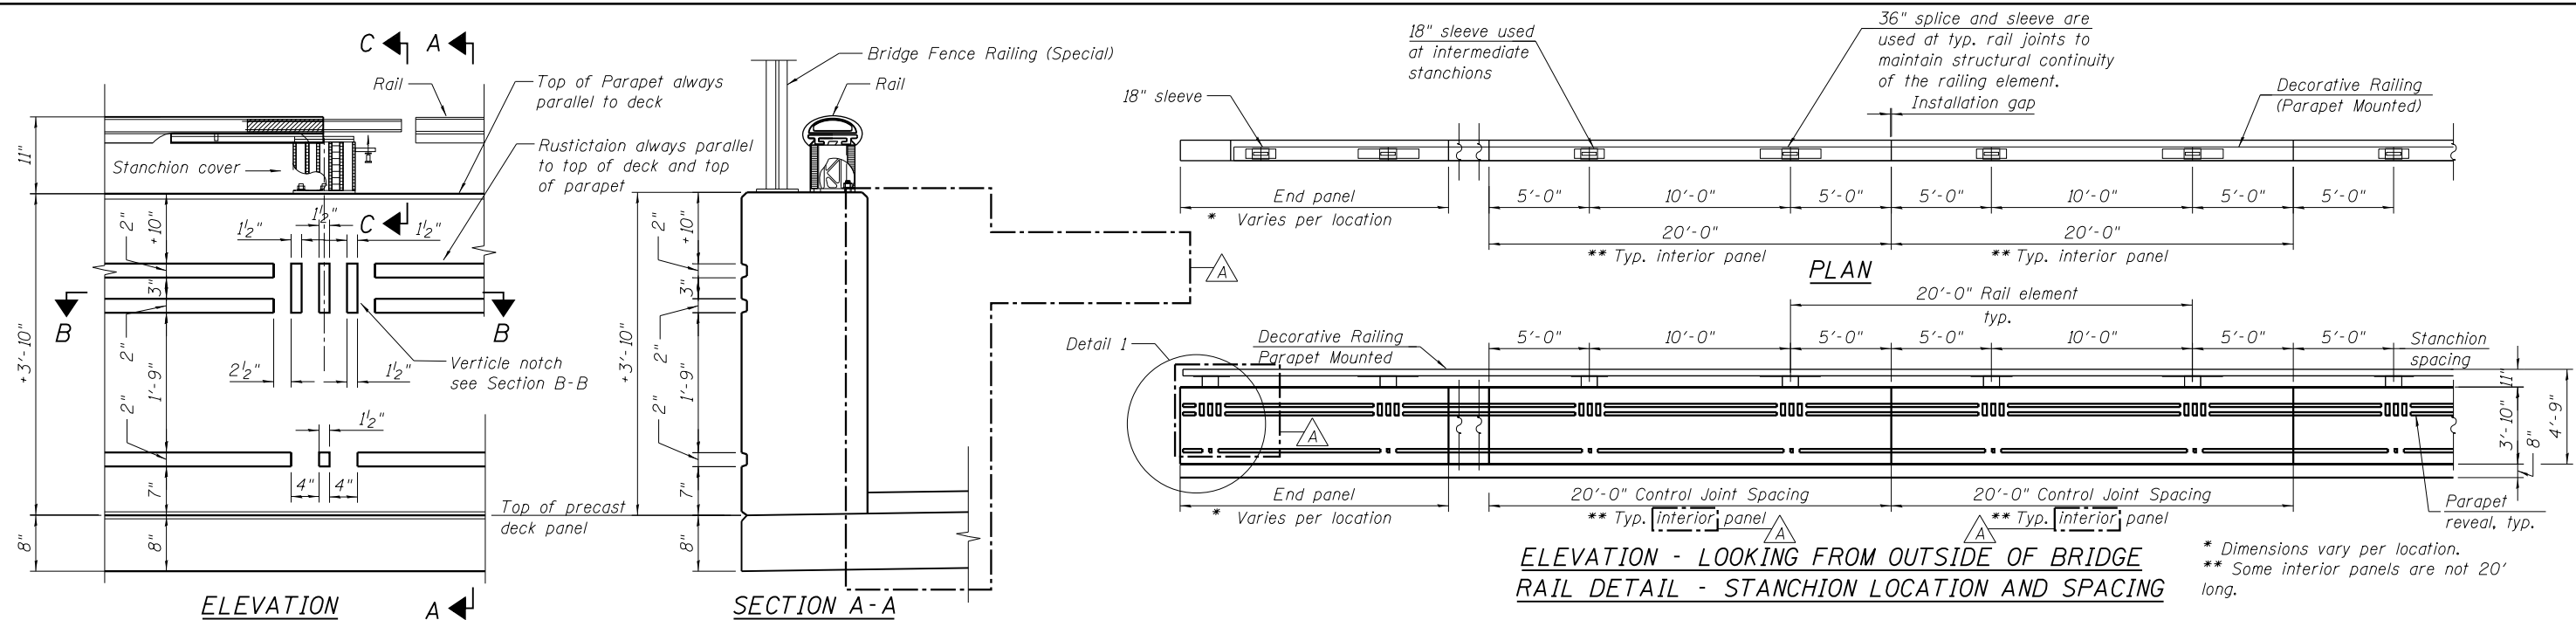


ELEVATION - LOOKING FROM OUTSIDE OF BRIDGE
RAIL DETAIL - STANCHION LOCATION AND SPACING


* Dimensions vary per location.
 ** Some interior panels are not 20' long.

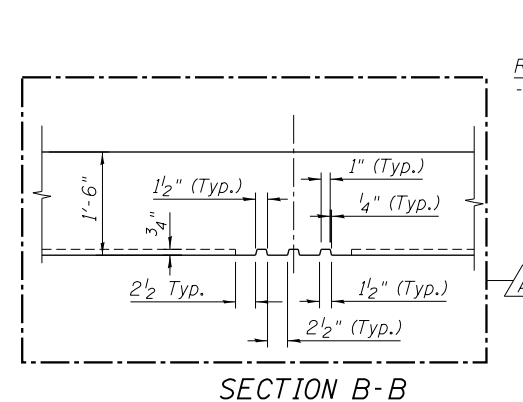


SECTION B-B

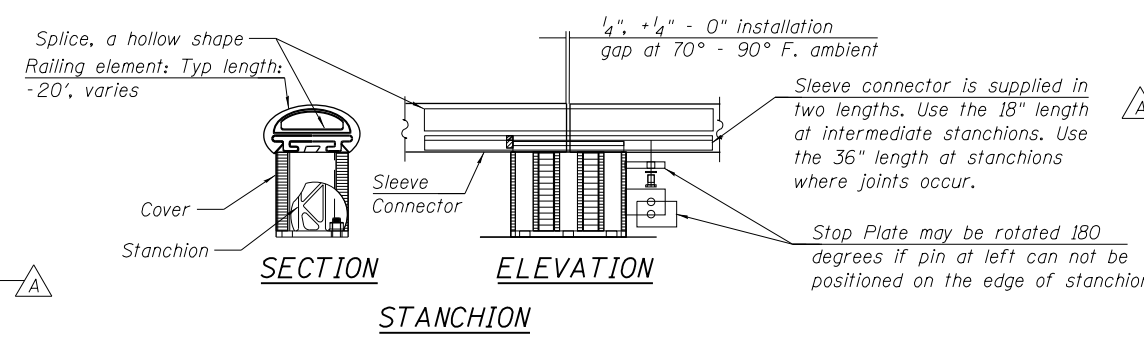


TYPICAL CHICAGO RAIL DETAIL

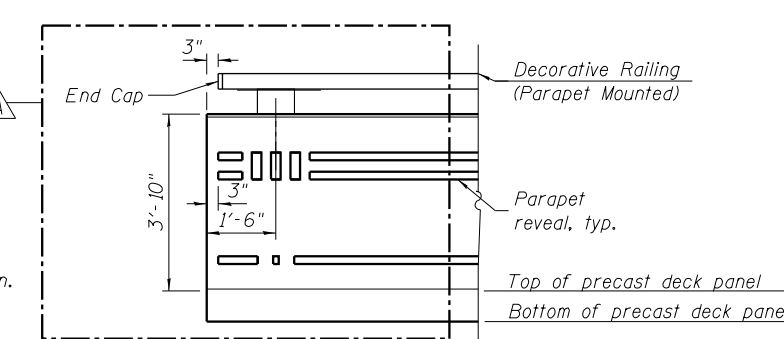


RAIL DETAIL 1 - AT END OF PARAPET

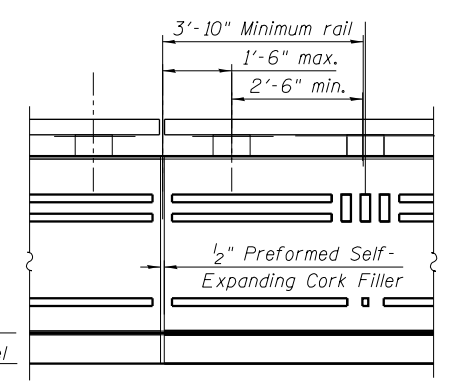

RAIL DETAIL 2 - AT PARAPET JOINT

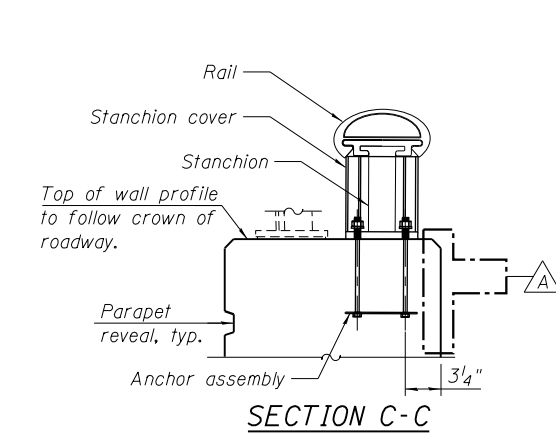


SECTION C-C

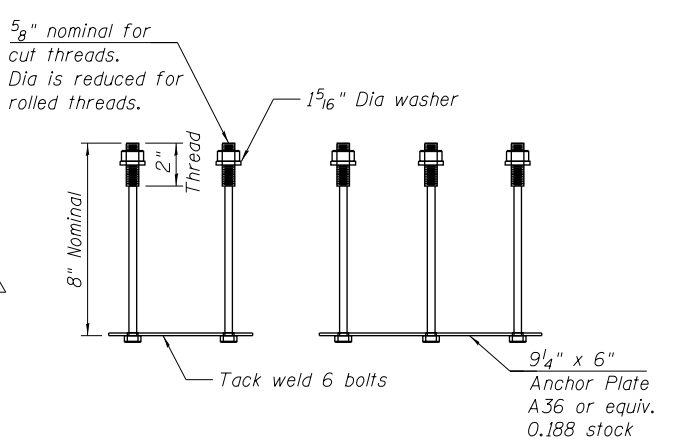


ANCHOR ASSEMBLY NOTES:

- All fasteners to meet, or exceed, ASTM A307 Grade C strength requirements.
- Galvanize per Article 509.05 of the Standard Specifications after fabrication.
- The position of parapet reinforcing must avoid the anchor bolts and anchor plate of the anchor assembly. See Sheet 21 of 55 for rebar details.

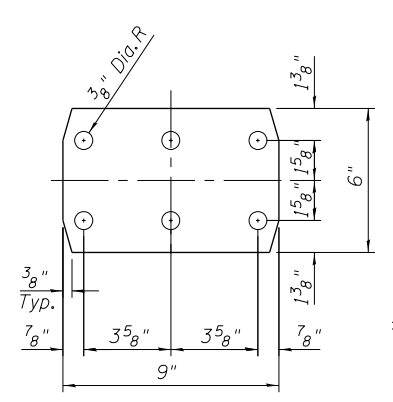


ELASTOMERIC PAD NOTES:

- Elastomeric pad for stanchion made from 1/16 inch thick stock.
- One required per stanchion.

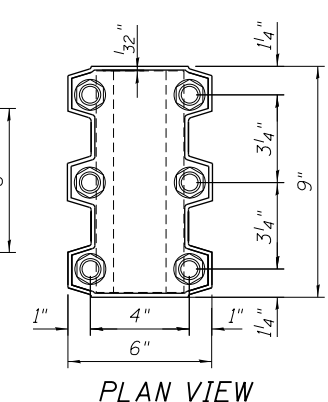

PLAN VIEW

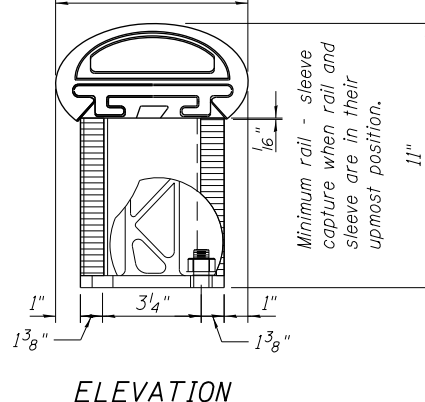

ELEVATION

STANCHION COVER NOTES:

- Cover is shown superimposed over stanchion with anchors in place.
- The stanchion cover is a non-structural element, serving an aesthetic function. It rests on the flange of the stanchion, without fasteners and is captured in place by the rail and stanchion.

Notes:
 Rustication may vary at terminal ends and is subject to site conditions and site approval. In all other situations, the middle 2.5" x 1.5" rustication is aligned with the center of the stanchion.
 Field cutting of rail elements is acceptable. The cut edge will no longer be anodized. Saw cut only, flame cut not allowed.
 End caps shall be used at all rail terminals. Railing system to be produced using extruded aluminum that can be clear anodized.
 Alloy selection is based on the design which must be supplied by the contractor and the color requirement. See Special Provisions for Decorative Railing (Parapet Mounted).
 The reveal on the Chicago Parapet will not be paid separately and shall be included in the cost of the pay item "Concrete Superstructure". Shop drawings shall be submitted including layout of the Chicago Parapet pattern, Chicago Rail and light poles.
 Physical appearance to be equal to "Valentine Urban Systems - Chicago wall with rail".
 For panel layout, overall stanchion location, spacing and details, see Sheet 21 of 55.

BILL OF MATERIAL

Item	Unit	Total
Decorative Railing (Parapet Mounted)	Foot	496

10:32:15 AM 0161708-60W29-5026-Railing-ParapetMtd.dgn



USER NAME = BAWItoft	DESIGNED = WJC	REVISED = 12/18/2013 WJC/DL
PLOT SCALE = 0:2.0000 '1" / 1in.	CHECKED = KAH	REVISED
PLOT DATE = 12/19/2013	DRAWN = WJC	REVISED
	CHECKED = DL	REVISED

STATE OF ILLINOIS
DEPARTMENT OF TRANSPORTATION

DECORATIVE RAILING PARAPET MOUNTED
STRUCTURE NO. 016-1708

SHEET NO. 26 OF 55 SHEETS


MUN	SECTION	COUNTY	TOTAL SHEETS	SHEET NO.
2090	2013-011R	COOK	356	158
CONTRACT NO.			60W29	
ILLINOIS FED. AID PROJECT				

INTENTIONALLY LEFT BLANK



10:32:17 AM
0161708-60W29-5027-Parapet.dgn






USER NAME = BAWtor+	DESIGNED WJC	REVISED  12/18/2013 WJC/DL
	CHECKED DL	REVISED
PLOT SCALE = 21:4.0000 '1" / in.	DRAWN SLW	REVISED
PLOT DATE = 12/19/2013	CHECKED DL	REVISED

**STATE OF ILLINOIS
DEPARTMENT OF TRANSPORTATION**

**PARAPET ARCHITECTURAL TREATMENT
STRUCTURE NO. 016-1708**

SHEET NO. 27 OF 55 SHEETS

MUN	SECTION	COUNTY	TOTAL SHEETS	SHEET NO.
2090	2013-011R	COOK	356	159
CONTRACT NO.			60W29	
ILLINOIS FED. AID PROJECT				

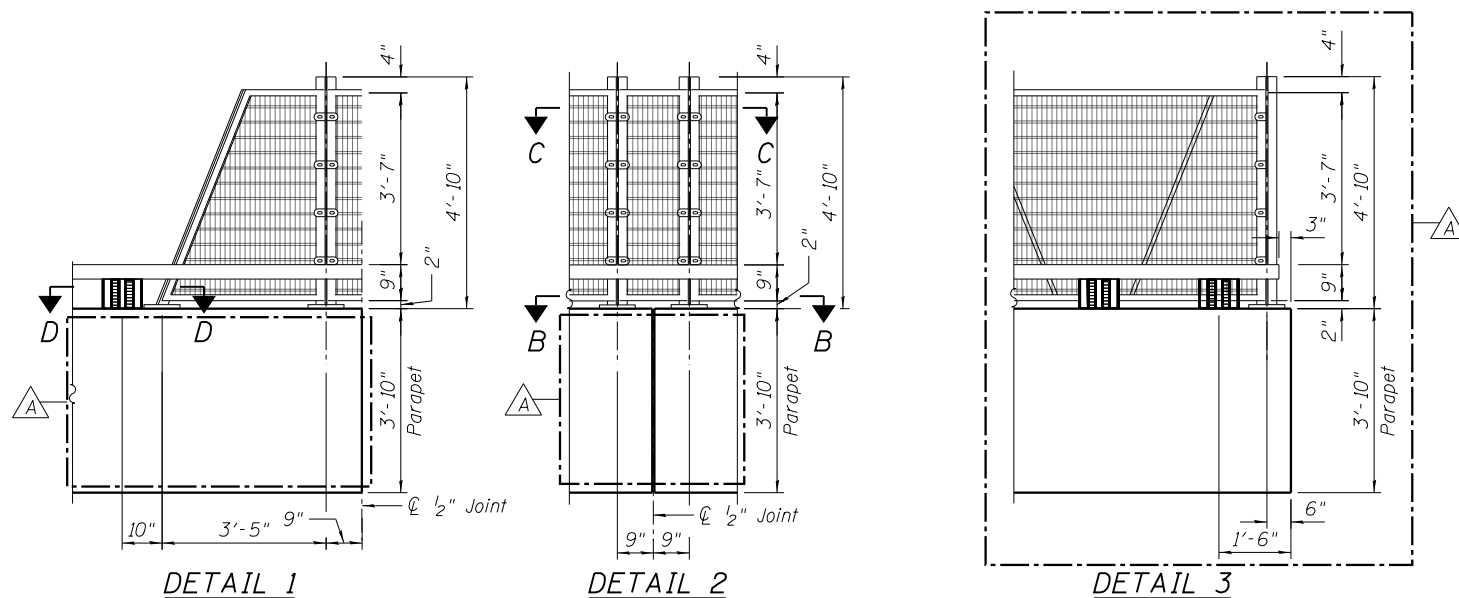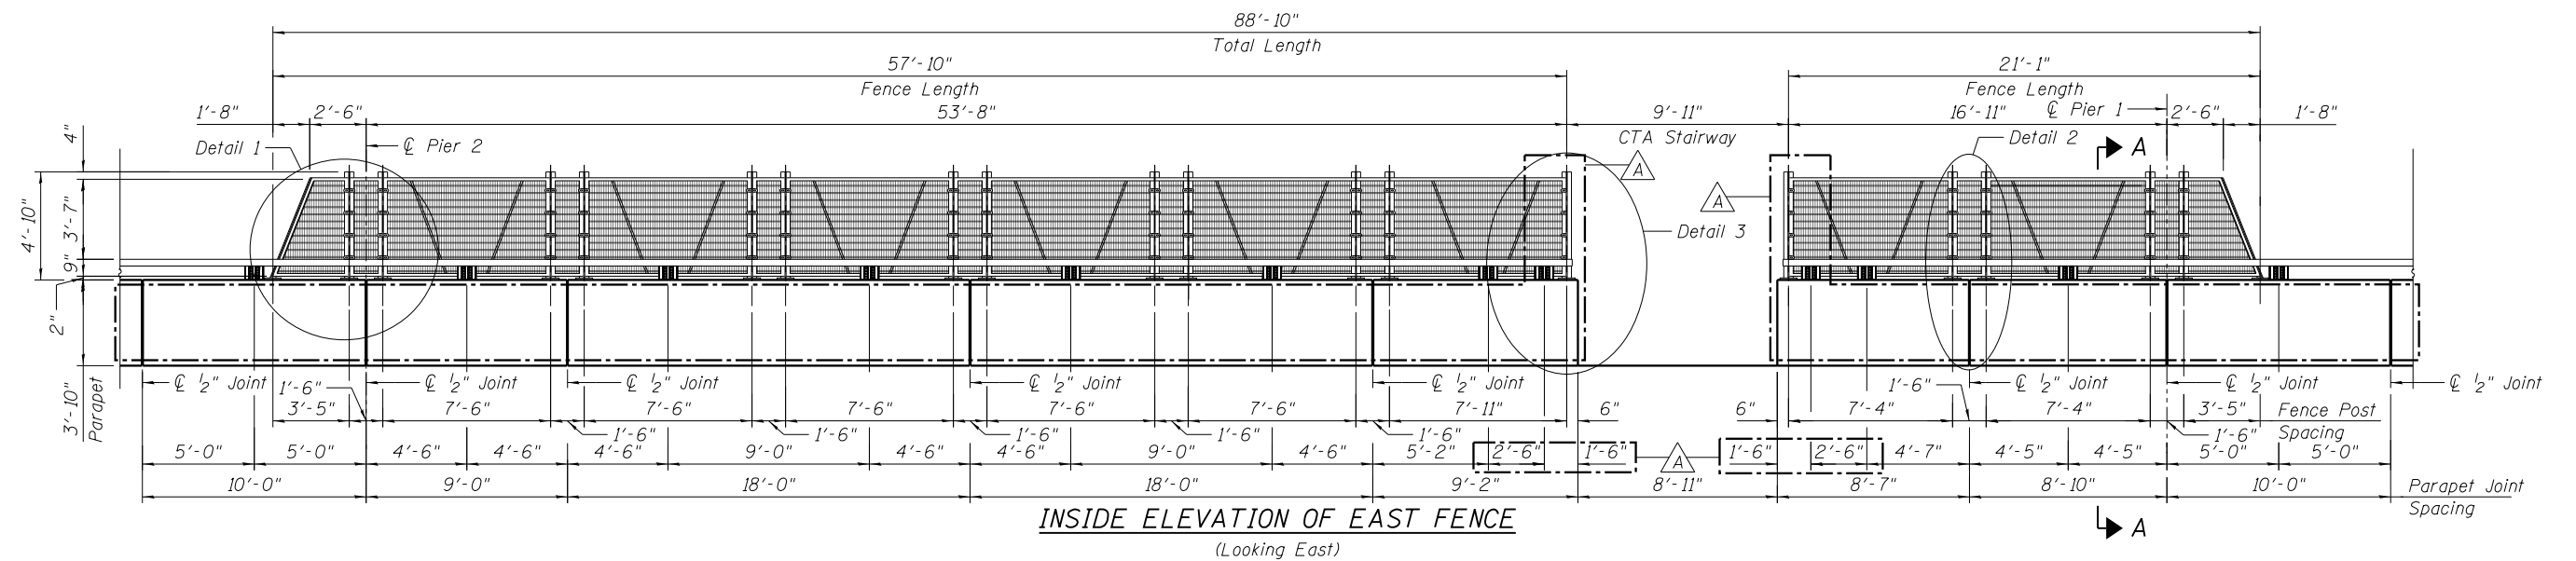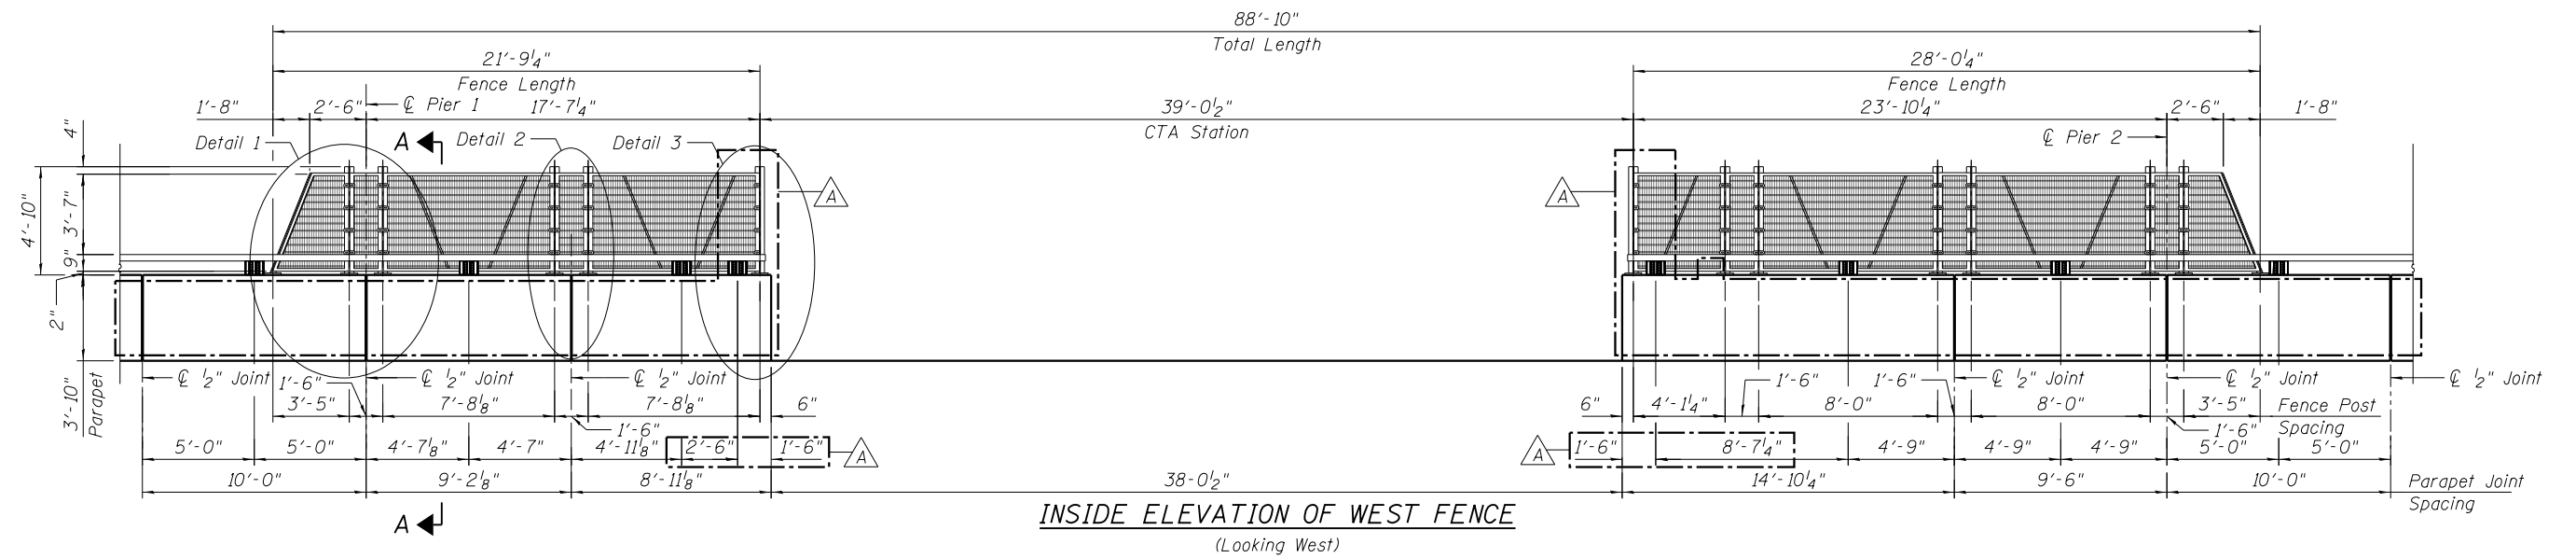

Note:
For Section A-A thru D-D,
see Sheet 29 of 55.

10:32:18 AM 0161708-60W29-5028-Rolling_FenElevations.dgn



USER NAME = BAWitorf	DESIGNED WJC	REVISED A 12/18/2013 WJC/DL
PLOT SCALE = 8x0.0000 ' / in.	CHECKED KAH	REVISED
PLOT DATE = 12/19/2013	DRAWN SLW	REVISED
	CHECKED DL	REVISED

STATE OF ILLINOIS
DEPARTMENT OF TRANSPORTATION

BRIDGE FENCE RAILING (SPECIAL) ELEVATIONS
STRUCTURE NO. 016-1708


SHEET NO. 28 OF 55 SHEETS

MUN	SECTION	COUNTY	TOTAL SHEETS	SHEET NO.
2090	2013-011R	COOK	356	160
CONTRACT NO.			60W29	


ILLINOIS FED. AID PROJECT

BILL OF MATERIAL

Item	Unit	Total
Bridge Fence Railing (Special)	Foot	129

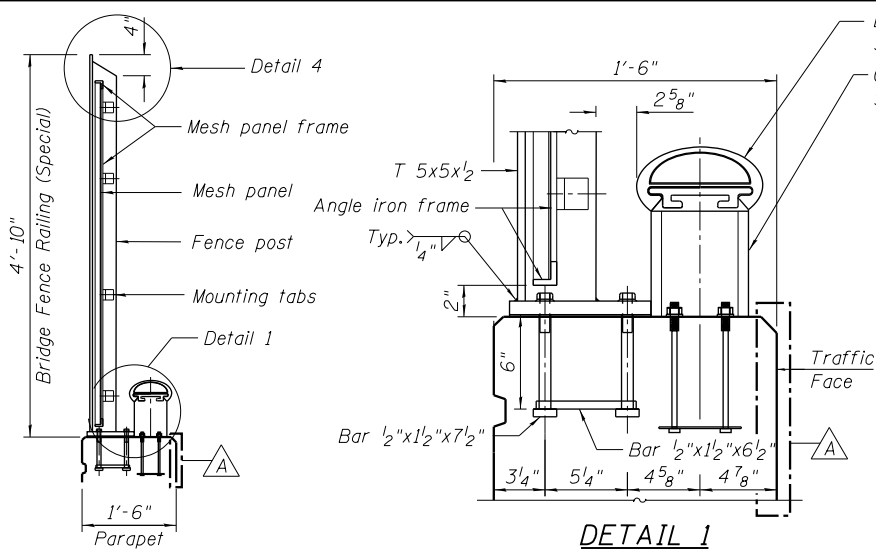


SECTION A-A

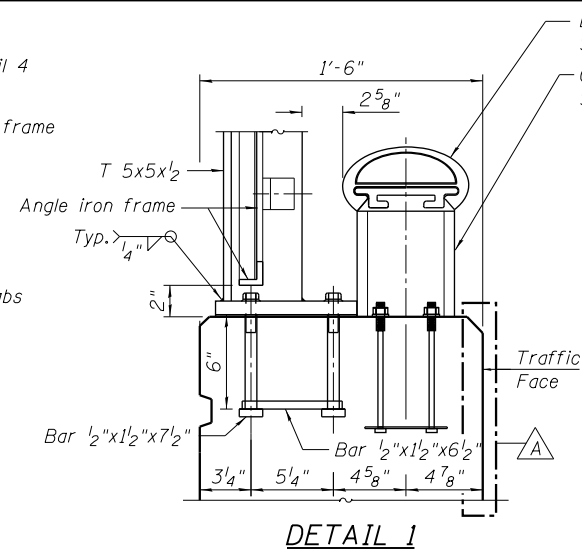


DETAIL 1

Decorative Railing (Parapet Mounted)
See details on Sheet 26 of 55.
Chicago rail stanchion cover.
See details on Sheet 26 of 55.

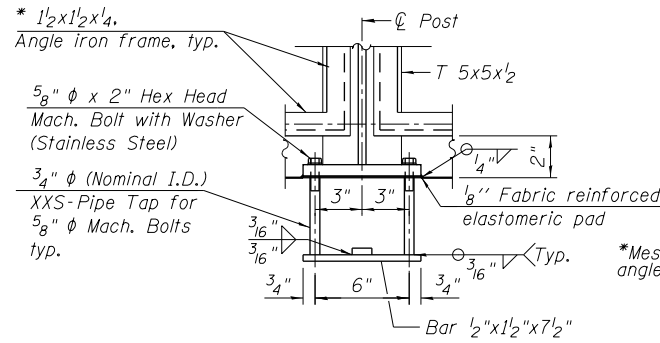


ANCHOR BOLT DETAILS

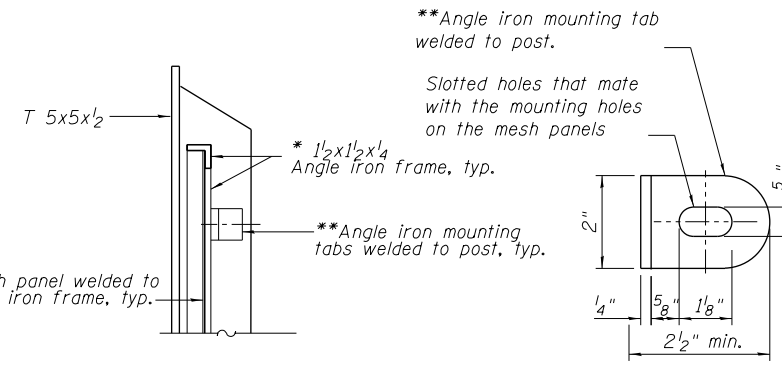


DETAIL 4


MOUNTING TAB DETAIL

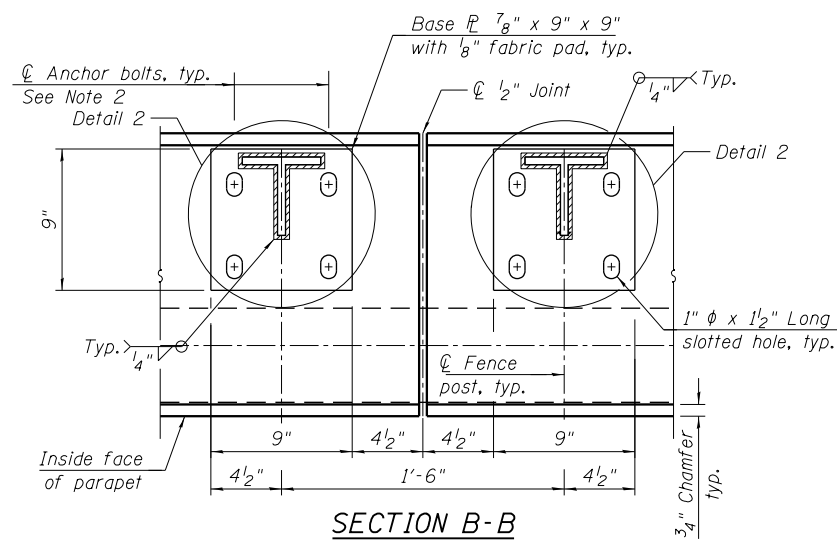


**SECTION B-B
BASE PLATE PLAN**

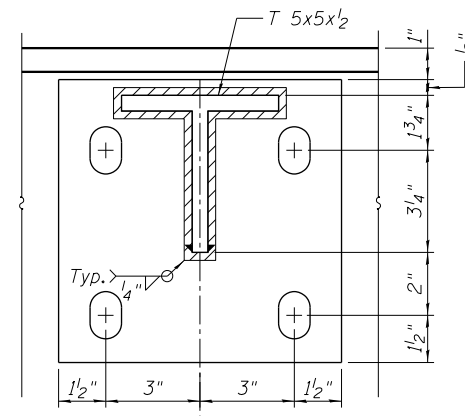


DETAIL 2

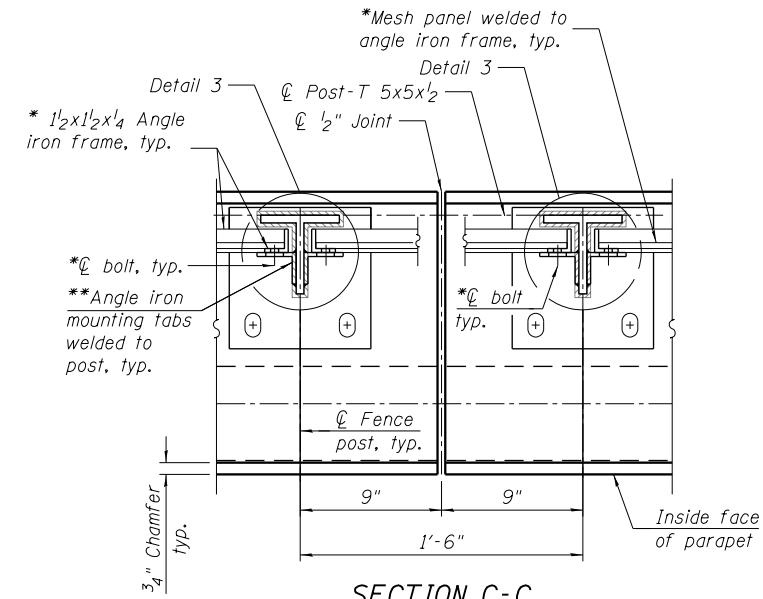

SECTION C-C

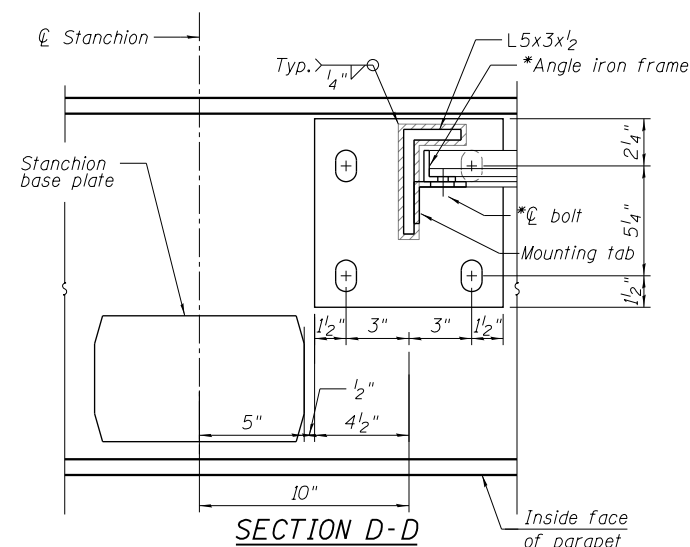

SECTION D-D

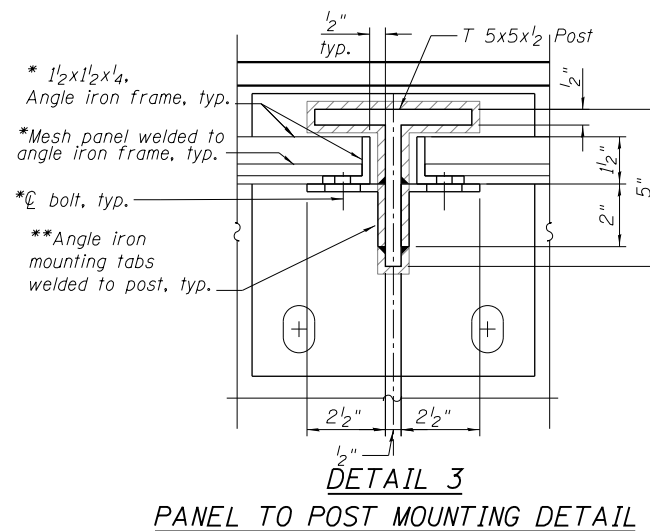

**DETAIL 3
PANEL TO POST MOUNTING DETAIL**

Notes:
All steel rail elements shall be Stainless Steel 316.
In lieu of the cast-in-place anchor device shown, the Contractor has the option of drilling and setting 5/8" ϕ anchor rods according to Article 509.06 of the Standard Specifications. Embedment shall be according to the manufacturer's specifications.
Provide bolted connection with oversized slotted hole to allow for erection tolerance of mesh panel and movement at control joints. Spacing between posts may not be the same at bottom and top of frame due to a slight vertical curve at parapet top surface.
* Fence panels and their mounting system, including angles, bracing, bolts and welds to be designed by wire mesh manufacturer. The design shown is based on Banker Architectural. Approved manufacturer can submit their own mounting system for Engineer's review and approval.
**Number, spacing and size of mounting tabs and slotted holes to be verified and designed by fence manufacturer.

10:32:20 AM
0161708-60W29-5029-Railing_FenSpecial.dgn



USER NAME = BAWIort	DESIGNED WJC	REVISED A 12/18/2013 WJC/DL
PLOT SCALE = 3:0.6600 ' / in.	CHECKED KAH	REVISED
PLOT DATE = 12/19/2013	DRAWN SLW	REVISED
	CHECKED DL	REVISED



**STATE OF ILLINOIS
DEPARTMENT OF TRANSPORTATION**

**BRIDGE FENCE RAILING (SPECIAL)
STRUCTURE NO. 016-1708**


SHEET NO. 29 OF 55 SHEETS

MUN	SECTION	COUNTY	TOTAL SHEETS	SHEET NO.
2090	2013-011R	COOK	356	161
CONTRACT NO.			60W29	


ILLINOIS FED. AID PROJECT

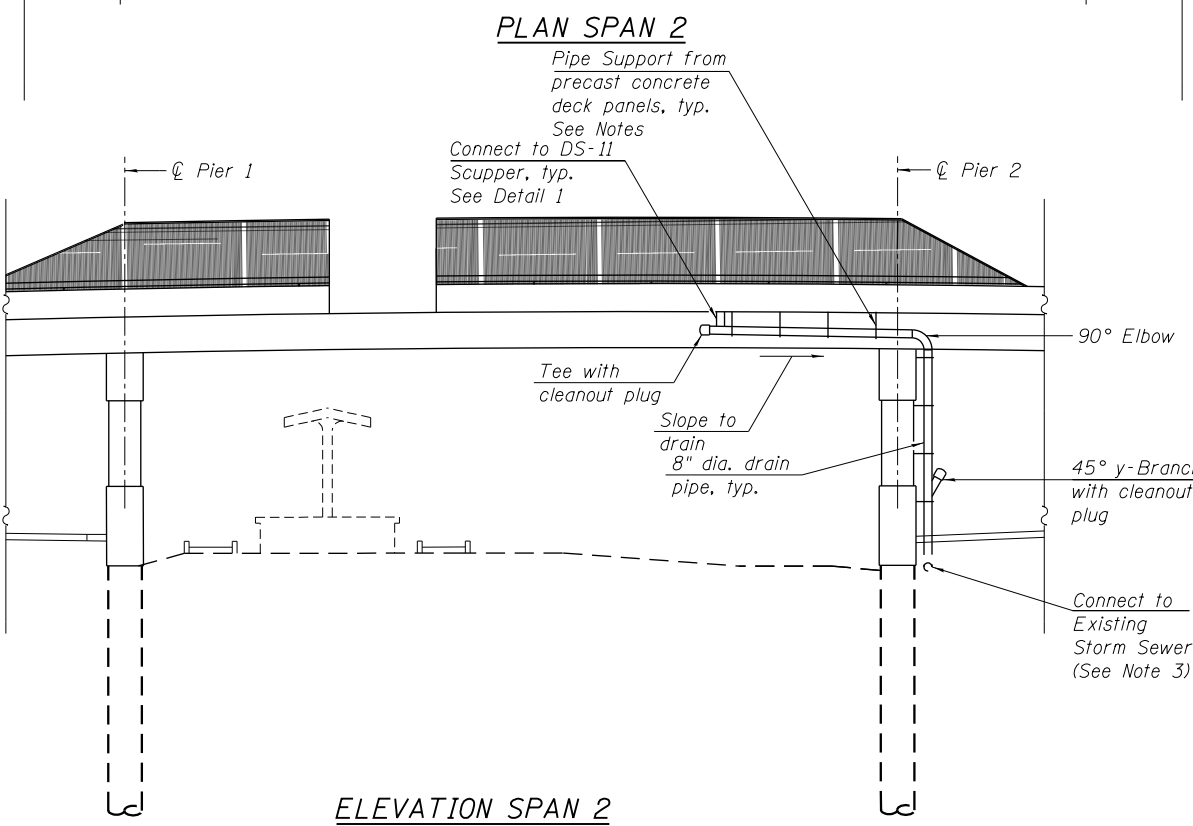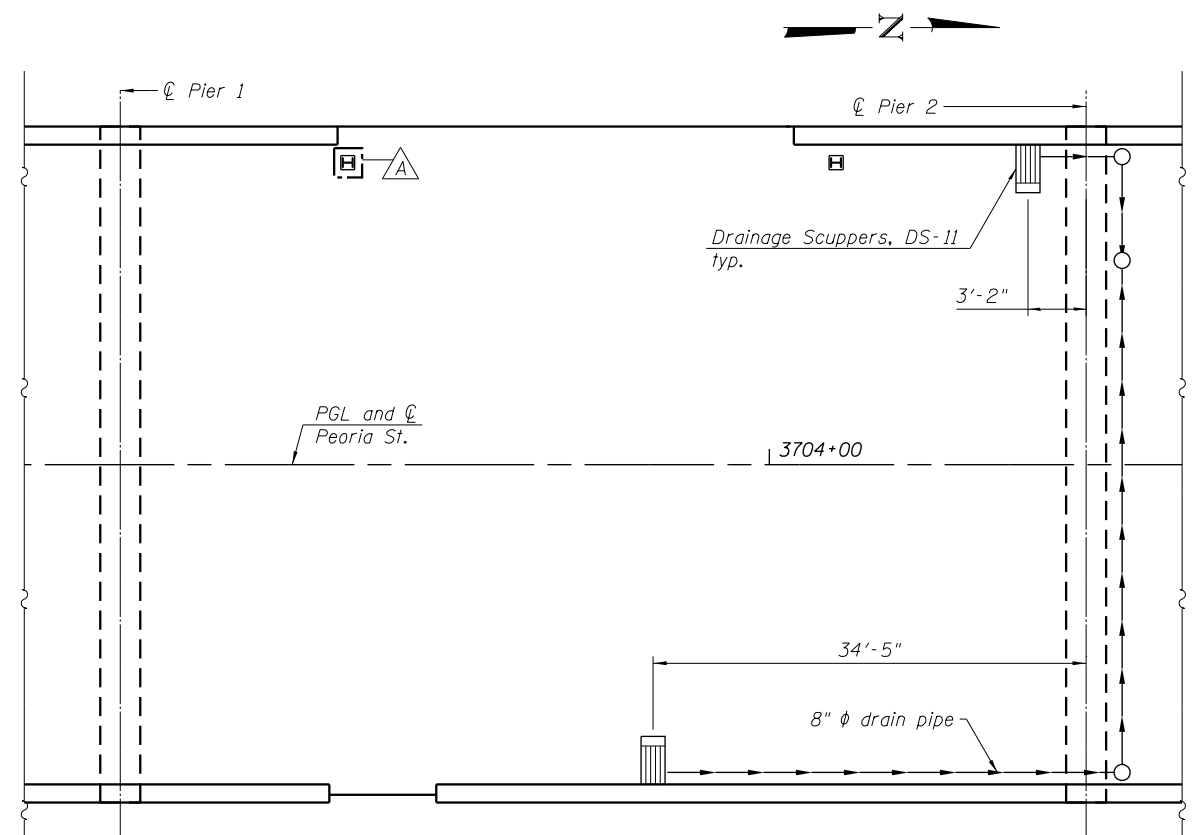



Notes:
 Provide structural support from proposed precast concrete deck panel for drain pipe per manufacturer's recommendation, not to exceed 6' cts. Cost included with Precast Concrete Deck Panels.
 All pipes, pipe fittings and brackets needed shall be included with cost of Drainage System.
 Drainage system shall connect to the existing roadway storm sewer. Cost of connection included in Drainage System. See Sheet 79 of 356 for details.
 Location of structural supports for the drainage system shall be coordinated with the Precast Concrete Deck Panel Manufacturer.
 The drainage system shall be painted with a finish coat of gray, Munsell No. 5B 7/1. **Cost included with Drainage System.**

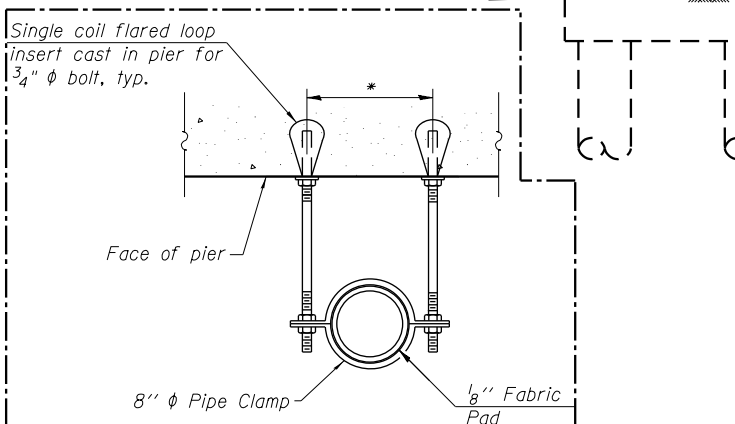


SECTION A-A
 (Pier Detail)
 * Dimension as required by Pipe Clamp Supplier

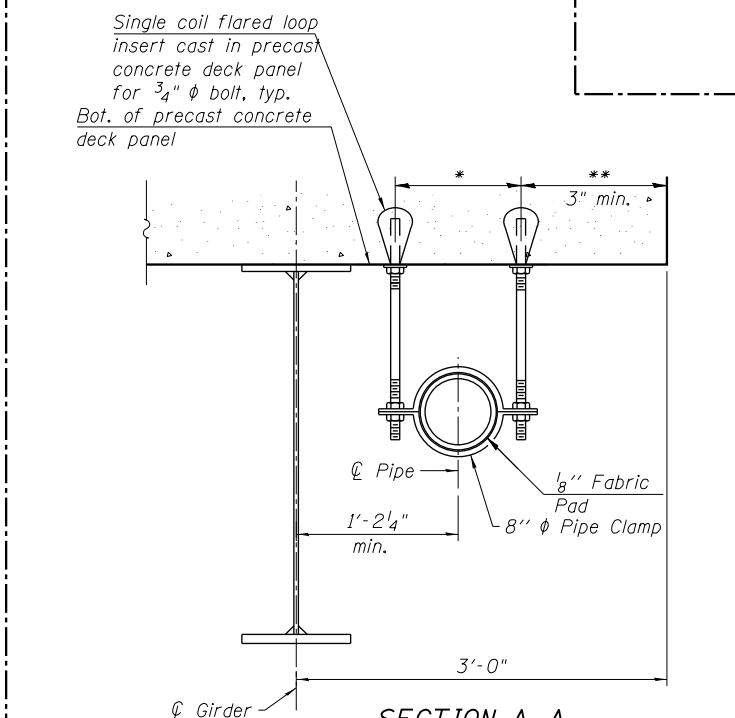

SECTION A-A
 (Bottom of Precast Concrete Deck Panel)
 * Dimension as required by Pipe Clamp Supplier
 ** Dimension to end of precast concrete deck panel

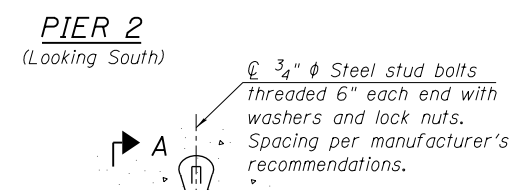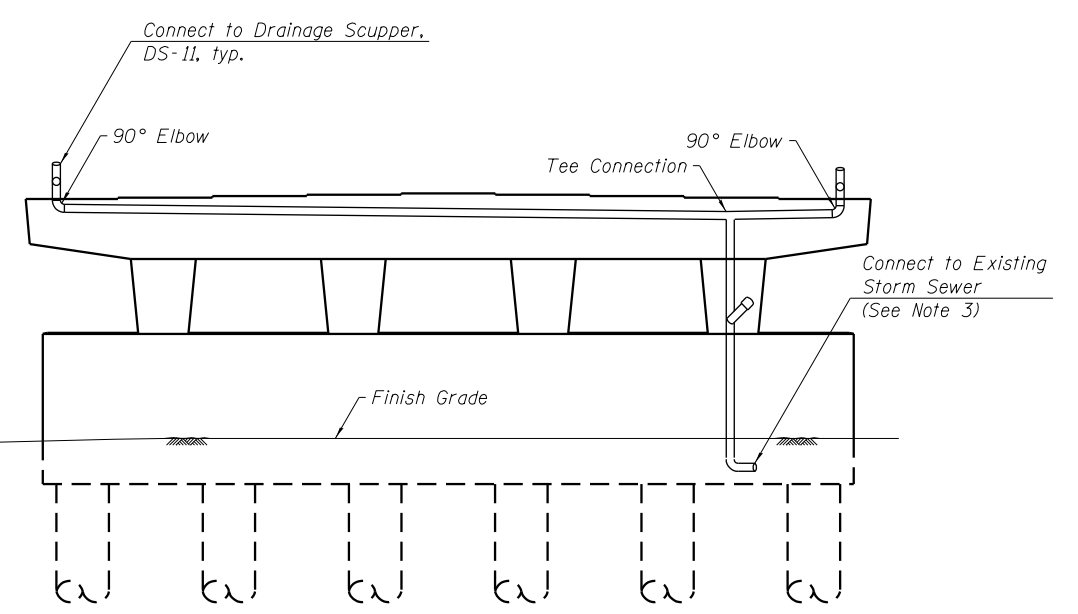

PIPE BRACKET DETAIL

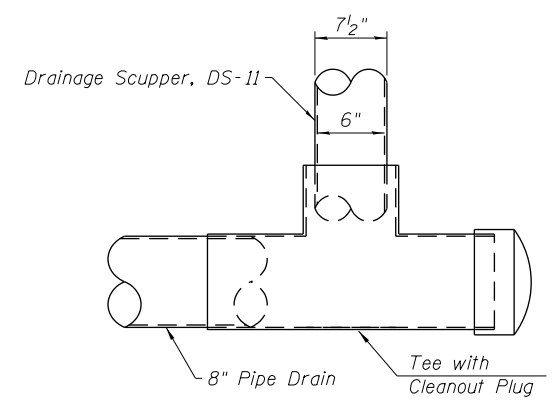

DETAIL 1

LEGEND
 ————— Indicates direction of flow

BILL OF MATERIAL

Item	Unit	Quantity
Drainage System	L. Sum	1

10:32:23 AM 0161708-60W29-5030-Drainage-System.dgn



USER NAME = BAWIort	DESIGNED KAH	REVISED A 12/18/2013 KAH
PLOT SCALE = 16:0 1/4" / in.	CHECKED MDS	REVISED
PLOT DATE = 12/19/2013	DRAWN RLS	REVISED
	CHECKED MDS	REVISED


STATE OF ILLINOIS
DEPARTMENT OF TRANSPORTATION

BRIDGE DRAINAGE SYSTEM
STRUCTURE NO. 016-1708

SHEET NO. 30 OF 55 SHEETS


MUN	SECTION	COUNTY	TOTAL SHEETS	SHEET NO.
2090	2013-011R	COOK	356	162
CONTRACT NO.			60W29	

ILLINOIS FED. AID PROJECT

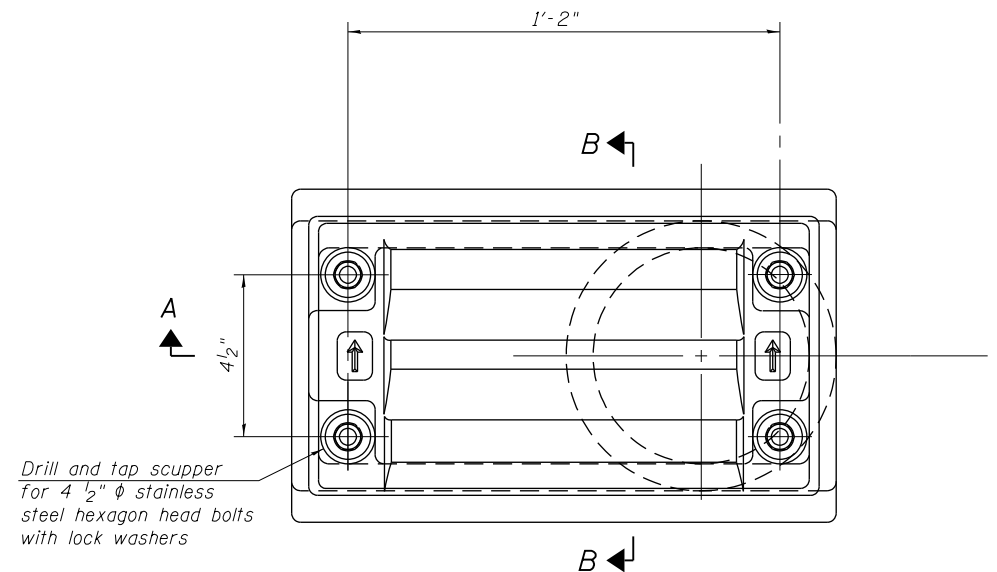


Drill and tap scupper for 4 1/2" φ stainless steel hexagon head bolts with lock washers

PLAN

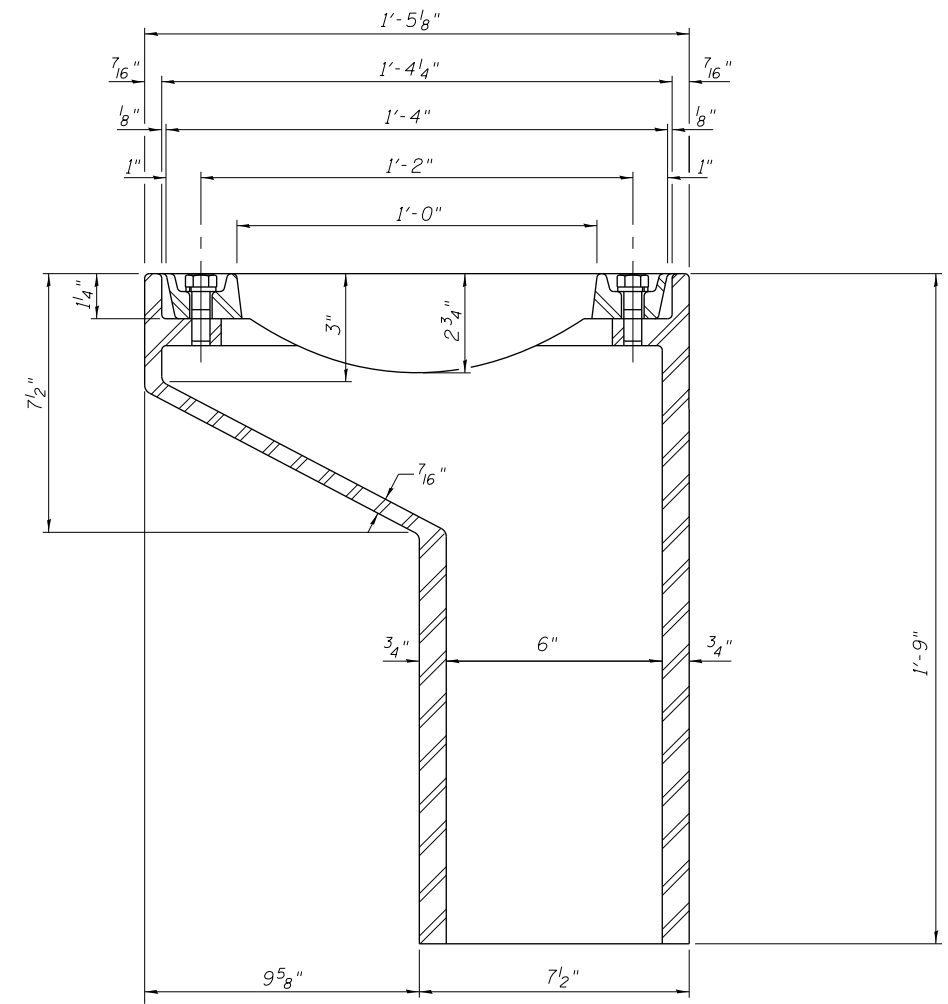


SECTION A-A


See Sheet 15 and 16 of 55 for scupper location relative to parapet.

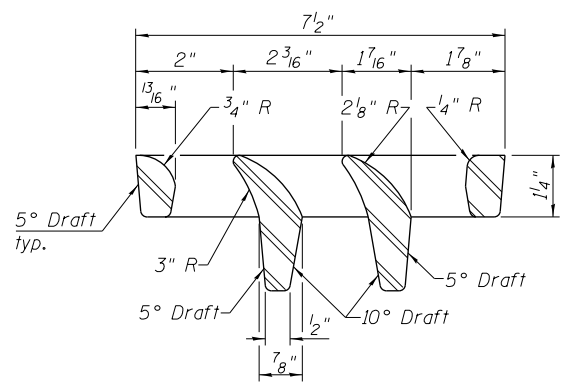

VANE GRATE DETAIL

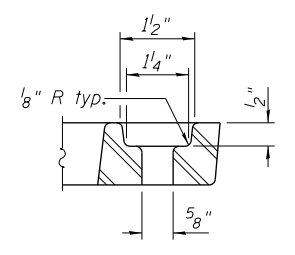

BOLT HOLE DETAIL

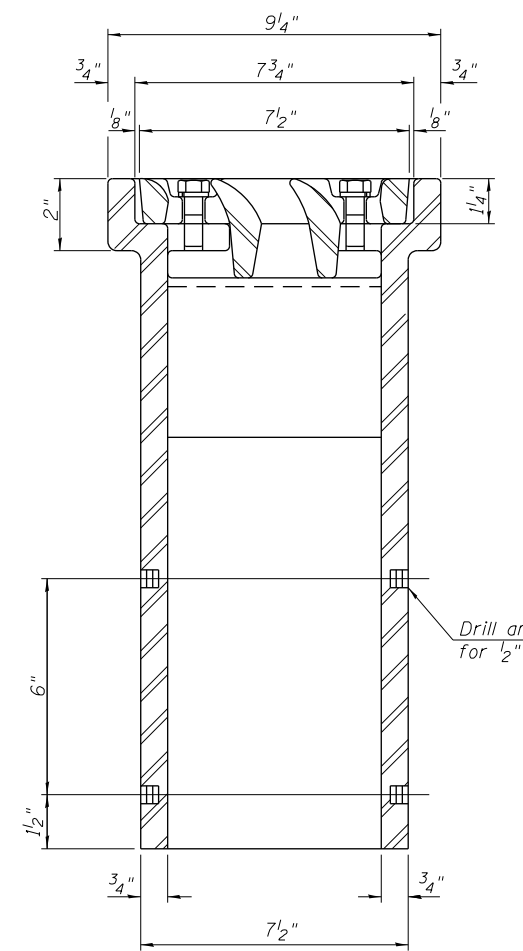

SECTION B-B

Drill and tap 1/2"-13x1/2" DP, for 1/2" φ bolts. (4 locations)

Notes:
 All cast iron parts shall be gray iron conforming to the requirements of AASHTO M 105, Class 35B.
 Bolts, anchor studs, washers and nuts shall conform to the requirements of ASTM A 307 and shall be galvanized according to AASHTO M 232.
 Downspouts located on the exterior side of a painted steel fascia beam shall be painted with the finish coat of gray, Munsell No. 5B 7/1. **Cost included in Drainage System.**
 As an alternate, bolts, anchor studs, washers and nuts may be stainless steel according to Article 1006.29(d) of the Standard Specifications.
 Structural steel weldments of equal sections and of the same configuration may be substituted for the cast iron scupper frame. Fillet or full penetration welds shall be used for the weldments. Details shall be submitted to the Engineer for approval. Structural steel weldments shall not be substituted for the cast iron scupper grate. Structural steel frames and downspouts shall be galvanized according to AASHTO M111.
 The Contractor shall take appropriate measures to assure that Protective Coat is not applied to the scupper.
Cost of the Grate, Frame, Downspout, Anchor Studs, Field Welding, Bolts, Washers and Nuts including complete installation of the scupper shall be paid for at the contract unit price each for Drainage Scupper, DS-11.
 Alternate fiberglass downspout conforming to ASTM D 2996 with a short-time rupture strength hoop tensile stress of 30,000 psi min. may be used in lieu of the cast iron or steel equivalent.
 See Sheet 16 of 55 for additional scupper details.

BILL OF MATERIAL

Item	Unit	Quantity
Drainage Scupper, DS-11	Each	2

10:32:24 AM 01/17/08 60W29-5031-Drainage_ScupperDS11.dgn




USER NAME = BAWitorf	DESIGNED KAH	REVISED 12/18/2013 KAH
PLOT SCALE = 0:2.0000 '1" / in.	CHECKED MDS	REVISED
PLOT DATE = 12/19/2013	DRAWN RLS	REVISED
	CHECKED MDS	REVISED

**STATE OF ILLINOIS
DEPARTMENT OF TRANSPORTATION**


**DRAINAGE SCUPPER, DS-11
STRUCTURE NO. 016-1708**

SHEET NO. 31 OF 55 SHEETS

MUN	SECTION	COUNTY	TOTAL SHEETS	SHEET NO.
2090	2013-011R	COOK	356	163
ILLINOIS FED. AID PROJECT			CONTRACT NO.	60W29

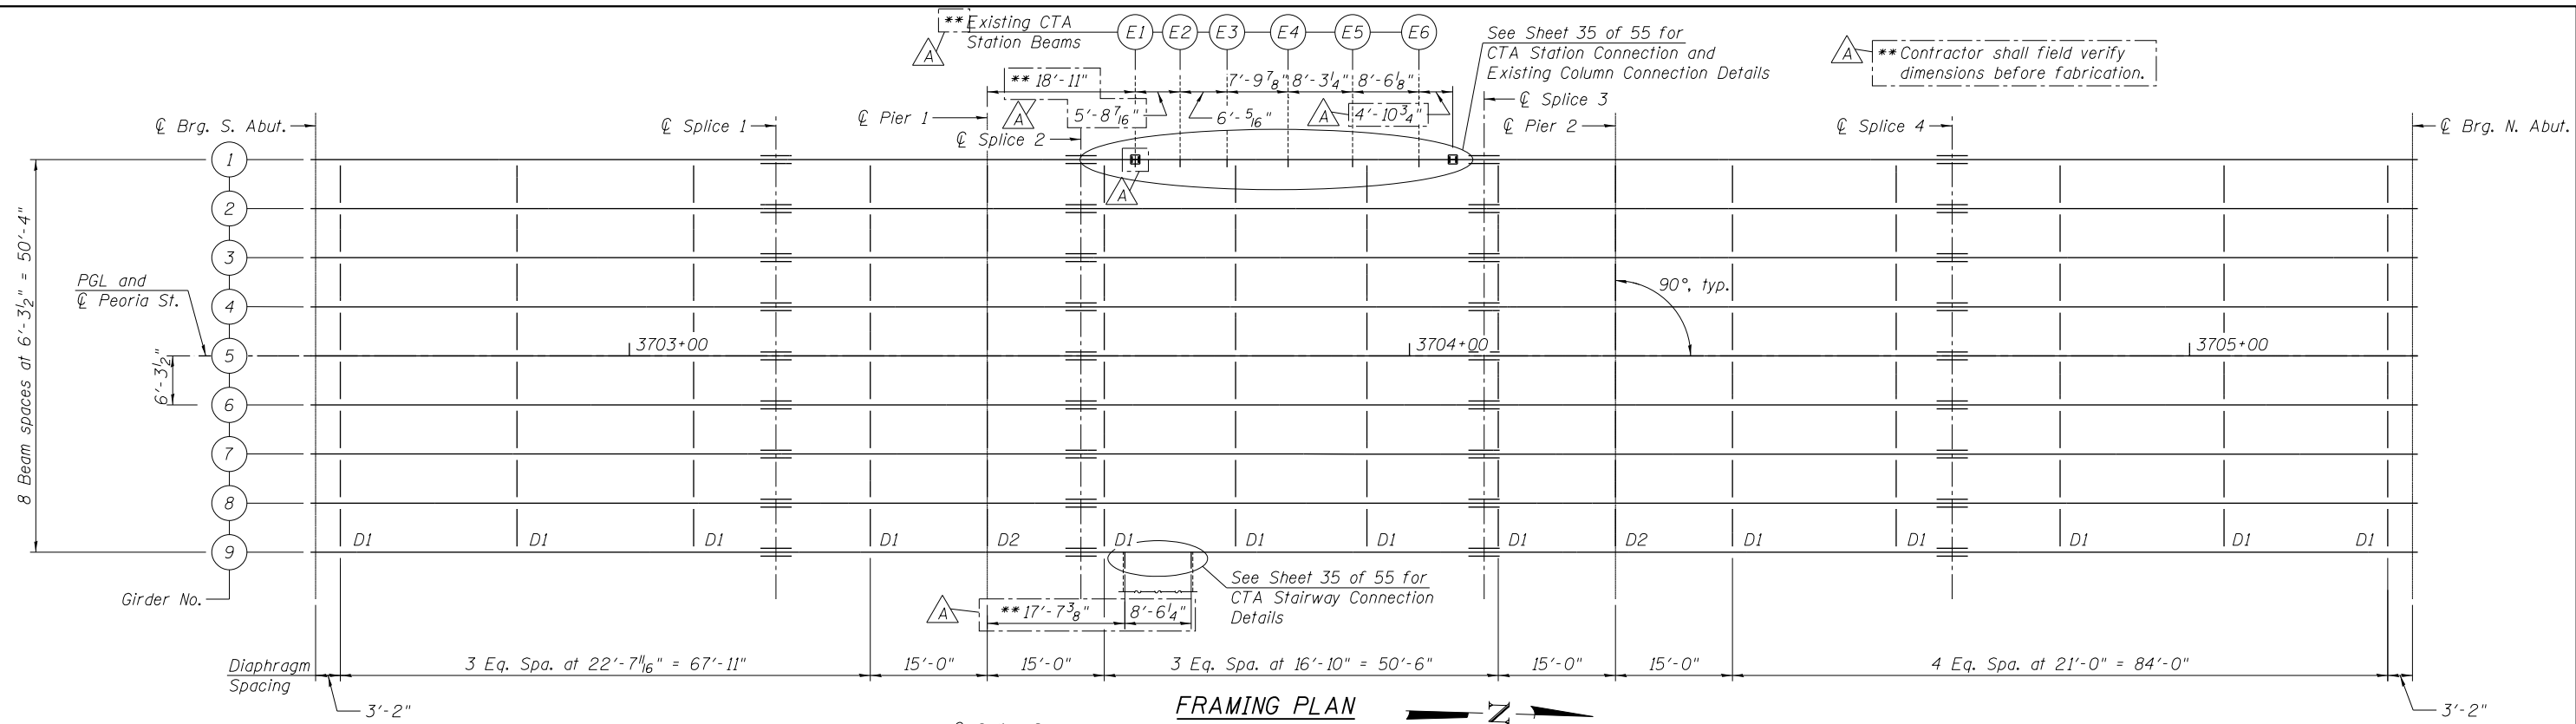

FRAMING PLAN

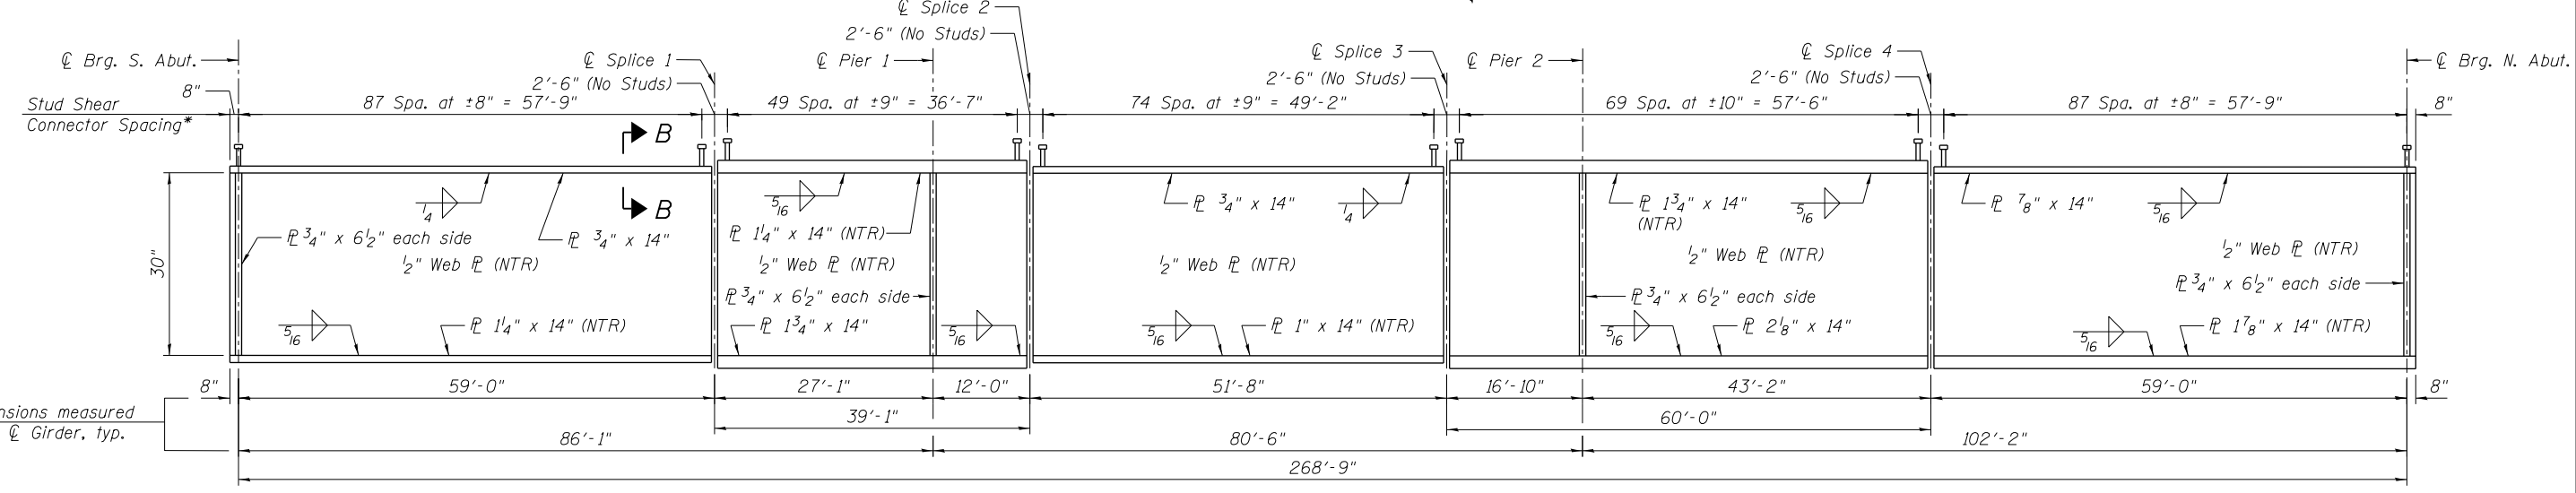


GIRDER ELEVATION


* Stud Shear connector spacing is for girder 5 only. See Sheet 16 of 55 for Section B-B. See Sheet 15 of 55 for stud shear connector configuration for all other girders.

TOP OF WEB ELEVATIONS
(For fabrication use only)

Girder	℄ Brg. S. Abut.	℄ Splice 1	℄ Brg. Pier 1	℄ Splice 2	℄ Splice 3	℄ Brg. Pier 2	℄ Splice 4	℄ Brg. N. Abut.
1	595.66	596.32	596.44	596.50	596.92	597.20	597.94	596.81
2	595.76	596.41	596.54	596.59	597.01	597.30	598.04	596.90
3	595.85	596.51	596.63	596.69	597.10	597.39	598.13	596.99
4	595.95	596.60	596.72	596.78	597.20	597.49	598.23	597.09
5	596.04	596.69	596.82	596.87	597.29	597.58	598.32	597.18
6	595.95	596.60	596.72	596.78	597.20	597.49	598.23	597.09
7	595.85	596.51	596.63	596.69	597.10	597.39	598.13	596.99
8	595.76	596.41	596.54	596.59	597.01	597.30	598.04	596.90
9	595.66	596.32	596.44	596.50	596.92	597.20	597.94	596.81

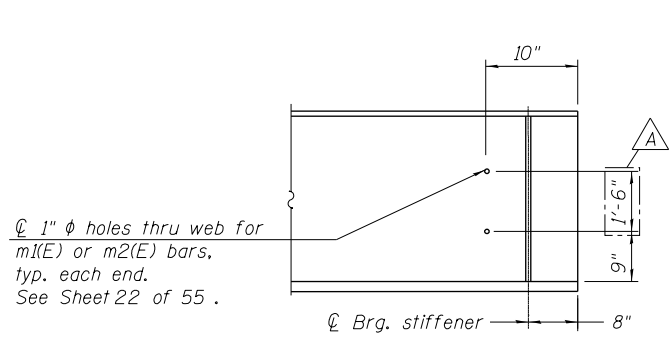

END OF BEAM ELEVATION

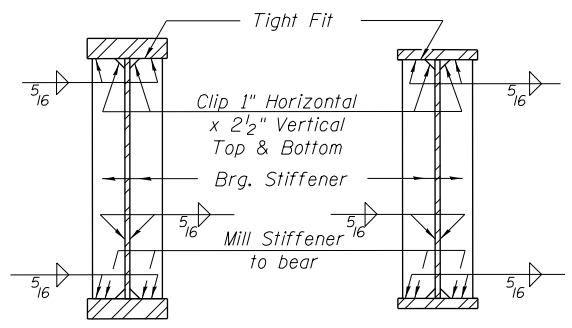

SECTION AT PIER

SECTION AT ABUTMENT

Notes:
 All plates of the girders, including bearing stiffeners and splice plates, shall be AASHTO M 270, Grade 50.
 All diaphragms, angles, fill plates and connecting plates may be AASHTO M270, Grade 36.
 Load carrying components designated "NTR" shall conform to the Impact Testing Requirement, Zone 2.
 All diaphragms shall be installed as steel is erected and secured with erection pins and bolts. Individual diaphragms at supports may be temporarily disconnected to install bearing anchor rods.
 For diaphragm details, see Sheet 33 of 55.
 All structural steel shall be hot dip galvanized. Cost included with Furnishing and Erecting Structural Steel.
 For notes on galvanized steel, see Sheet 2 of 55.
 For Bridge Mounted Sign Structure locations and details, See Roadway Plans.

10:32:25 AM 0161708-60W29-5032-FramePlan.dgn



USER NAME = BAWItoft	DESIGNED WJC	REVISED 12/18/2013 WJC/DL
PLOT SCALE = 21:4.0024 ' / in.	CHECKED DL	REVISED
PLOT DATE = 12/19/2013	DRAWN MTS	REVISED
	CHECKED DL	REVISED

**STATE OF ILLINOIS
DEPARTMENT OF TRANSPORTATION**

**FRAMING PLAN
STRUCTURE NO. 016-1708**

SHEET NO. 32 OF 55 SHEETS

MUN 2090	SECTION 2013-011R	COUNTY COOK	TOTAL SHEETS 356	SHEET NO. 164
CONTRACT NO. 60W29			ILLINOIS FED. AID PROJECT	




GIRDERS 2 THRU 8 MOMENT TABLE (HL-93 LOADING)						
	0.4 Sp. 1	Pier 1	0.5 Sp. 2	Pier 2	0.6 Sp. 3	
I_s	(in ⁴)	7,591	11,346	6,894	14,878	9,738
$I_c(n)$	(in ⁴)	20,181	-	17,607	-	26,236
$I_c(3n)$	(in ⁴)	14,578	-	12,961	-	18,410
$I_c(cr)$	(in ⁴)	-	15,254	-	18,789	-
S_s	(in ³)	556	771	473	939	773
$S_c(n)$	(in ³)	753	-	642	-	1,027
$S_c(3n)$	(in ³)	693	-	590	-	946
$S_c(cr)$	(in ³)	-	869	-	1032	-
DC1	(k/')	0.82	0.87	0.81	0.92	0.86
M _{DC1}	(k)	518	552	-34	851	760
DC2*	(k/')	0.61	0.62	0.62	0.62	0.61
M _{DC2}	(k)	379	408	8	578	532
DW	(k/')	0.19	0.19	0.19	0.19	0.19
M _{DW}	(k)	115	124	0	176	161
M _{ℓ + IM}	(k)	1,009	998	689	1,166	1,269
M _u (Strength I)	(k)	3,060	3,133	1,173	4,091	4,077
φ _r M _n	(k)	3,708	3,817	3,368	4,661	4,871
f _s DC1	(ksi)	11.2	8.6	-0.9	10.9	11.8
f _s DC2	(ksi)	6.6	5.6	0.2	6.7	6.7
f _s DW	(ksi)	2.0	1.7	0.0	2.0	2.0
f _s (ℓ + IM)	(ksi)	16.1	13.8	12.9	13.6	14.8
f _s (Service II)	(ksi)	40.6	33.9	16.1	37.3	39.9
0.95R _n F _{yf}	(ksi)	47.5	47.5	47.5	47.5	47.5
f _s (Total)(Strength I)	(ksi)	-	-	-	-	-
φ _r F _n	(ksi)	-	-	-	-	-
V _f	(k)	25.4	27.7	-	27.8	26.1

GIRDER 1 MOMENT TABLE (PEDESTRIAN LOADING)						
	0.4 Sp. 1	Pier 1	0.5 Sp. 2	Pier 2	0.6 Sp. 3	
I_s	(in ⁴)	7,591	11,346	6,894	14,878	9,738
$I_c(n)$	(in ⁴)	20,061	-	17,508	-	26,060
$I_c(3n)$	(in ⁴)	14,470	-	12,869	-	18,267
$I_c(cr)$	(in ⁴)	-	15,254	-	18,789	-
S_s	(in ³)	556	771	473	939	773
$S_c(n)$	(in ³)	752	-	641	-	1,026
$S_c(3n)$	(in ³)	691	-	589	-	945
$S_c(cr)$	(in ³)	-	869	-	1032	-
DC1	(k/')	0.82	0.87	0.81	0.92	0.86
M _{DC1}	(k)	509	542	-34	837	747
DC2*	(k/')	0.39	0.45	0.47	0.40	0.39
M _{DC2} **	(k)	123	1,173	1,180	1,312	40
DW	(k/')	0.30	0.30	0.30	0.30	0.30
M _{DW}	(k)	184	199	0	282	258
M _{ℓ + IM}	(k)	274	656	344	822	678
M _u (Strength I)	(k)	1,340	3,098	1,777	3,931	2,049
φ _r M _n	(k)	3,765	3,804	3,281	4,649	4,852
f _s DC1	(ksi)	11.0	8.4	-0.9	10.7	11.6
f _s DC2	(ksi)	2.1	16.2	24.1	15.2	0.5
f _s DW	(ksi)	3.2	2.7	0.0	3.3	3.3
f _s (ℓ + IM)	(ksi)	4.4	9.1	6.4	9.6	7.9
f _s (Service II)	(ksi)	22.0	39.2	31.6	41.6	25.7
0.95R _n F _{yf}	(ksi)	47.5	47.5	47.5	47.5	47.5
f _s (Total)(Strength I)	(ksi)	-	50.77	-	54.07	-
φ _r F _n	(ksi)	-	50.0	-	44.6	-
V _f	(k)	0.0	0.0	-	0.0	0.0

GIRDERS 2 THRU 8 REACTION TABLE (HL-93 LOADING)					
	S. Abut.	Pier 1	Pier 2	N. Abut.	
R _{DC1}	(k)	37.50	72.71	92.49	44.54
R _{DC2} ***	(k)	40.26	52.19	62.33	44.24
R _{DW}	(k)	6.53	16.22	19.29	7.74
R _{ℓ + IM}	(k)	74.62	122.49	135.46	78.68
R _{Total}	(k)	158.91	263.61	309.57	175.20

GIRDER 1 REACTION TABLE (PEDESTRIAN LOADING)					
	S. Abut.	Pier 1	Pier 2	N. Abut.	
R _{DC1}	(k)	36.79	71.44	90.96	43.74
R _{DC2} ***	(k)	7.83	120.92	116.42	11.92
R _{DW}	(k)	10.44	25.95	30.86	12.37
R _{ℓ + IM}	(k)	17.15	44.10	49.26	19.75
R _{Total}	(k)	72.21	262.41	287.50	87.78

* Load allowance includes 0.025 k/’ for duct banks. All girders include weight for two 10’ sidewalks for the future condition.
 ** Moment includes six concentrated forces of 19.8 k, 16.6 k, 21.8 k, 26.5 k, 28.4 k and 25.6 k due to the unfactored reactions at the locations of the Existing CTA Station stringers (Beams E1 thru E6, respectively) under dead, snow and wind loads.
 *** Includes Approach Slab Dead Load Reactions at Abutments.

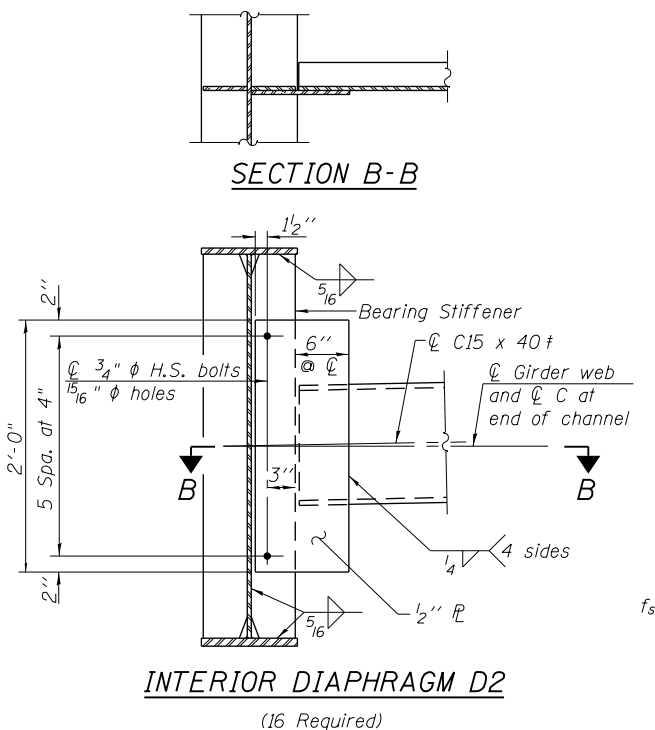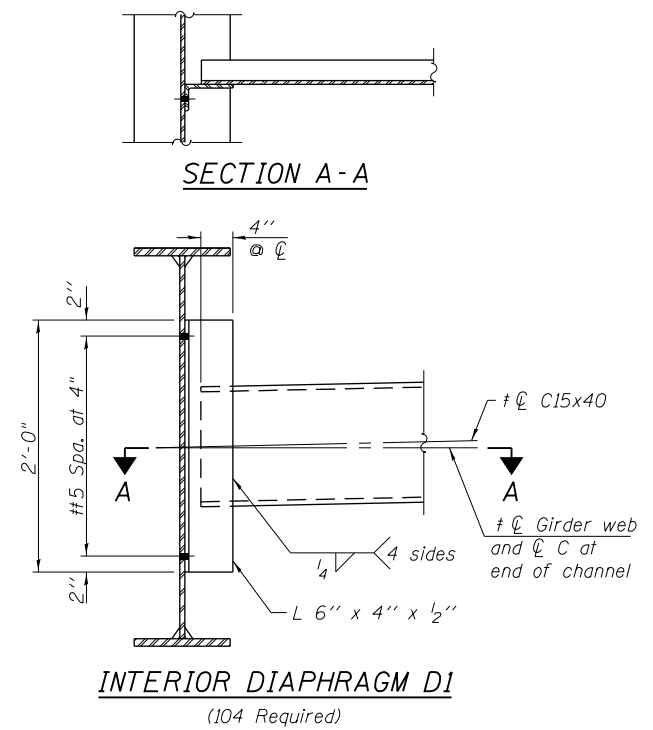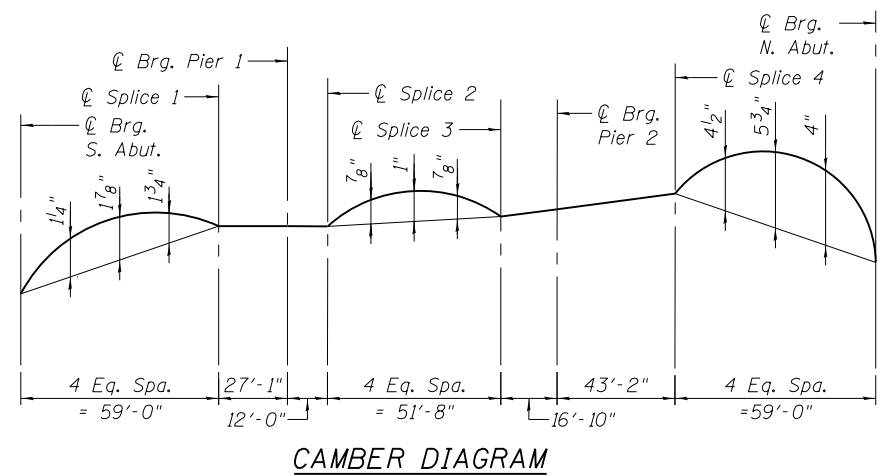

Note:
 Two hardened washers required for each set of oversized holes.
 † Alternate channels C15x50 are permitted to facilitate material acquisition. Calculated weight of structural steel is based on the lighter section. The alternate, if utilized, shall be provided at no additional cost to the Department.
 # 3/4” φ HS bolts, 15/16” φ holes

I_s, S_s : Non-composite moment of inertia and section modulus of the steel section used for computing f_s (Total-Strength I, and Service II) due to non-composite dead loads (in.⁴ and in.³).

$I_c(n), S_c(n)$: Composite moment of inertia and section modulus of the steel and deck based upon the modular ratio, "n", used for computing f_s (Total-Strength I, and Service II) in uncracked sections due to short-term composite live loads (in.⁴ and in.³).

$I_c(3n), S_c(3n)$: Composite moment of inertia and section modulus of the steel and deck based upon 3 times the modular ratio, "3n", used for computing f_s (Total-Strength I, and Service II) in uncracked sections, due to long-term composite (superimposed) dead loads (in.⁴ and in.³).

$I_c(cr), S_c(cr)$: Composite moment of inertia and section modulus of the steel and longitudinal deck reinforcement, used for computing f_s (Total-Strength I and Service II) in cracked sections, due to both short-term composite live loads and long-term composite (superimposed) dead loads (in.⁴ and in.³).

DC1: Un-factored non-composite dead load (kips/ft.).

M_{DC1}: Un-factored moment due to non-composite dead load (kip-ft.).

DC2: Un-factored long-term composite (superimposed excluding future wearing surface) dead load (kips/ft.).

M_{DC2}: Un-factored moment due to long-term composite (superimposed excluding future wearing surface) dead load (kip-ft.).

DW: Un-factored long-term composite (superimposed future wearing surface only) dead load (kips/ft.).

M_{DW}: Un-factored moment due to long-term composite (superimposed future wearing surface only) dead load (kip-ft.).

M_{ℓ + IM}: Un-factored live load moment plus dynamic load allowance (impact) (kip-ft.).

M_u (Strength I): Factored design moment (kip-ft.).
 1.25 (M_{DC1} + M_{DC2}) + 1.5 M_{DW} + 1.75 M_{ℓ + IM}

φ_rM_n: Compact composite positive moment capacity computed according to Article 6.10.7.1 or non-slender negative moment capacity according to Article A6.1.1 or A6.1.2 (kip-ft.).

f_s DC1: Un-factored stress at edge of flange for controlling steel flange due to vertical non-composite dead loads as calculated below (ksi).
 M_{DC1} / S_{nc}

f_s DC2: Un-factored stress at edge of flange for controlling steel flange due to vertical composite dead loads as calculated below (ksi).
 M_{DC2} / S_{c(3n)} or M_{DC2} / S_{c(cr)} as applicable.

f_s DW: Un-factored stress at edge of flange for controlling steel flange due to vertical composite future wearing surface loads as calculated below (ksi).
 M_{DW} / S_{c(3n)} or M_{DW} / S_{c(cr)} as applicable.

f_s (ℓ + IM): Un-factored stress at edge of flange for controlling steel flange due to vertical composite live load plus impact loads as calculated below (ksi).
 M_{ℓ + IM} / S_{c(n)} or M_{DW} / S_{c(cr)} as applicable.

f_s (Service II): Sum of stresses as computed below (ksi).
 f_{sDC1} + f_{sDC2} + f_{sDW} + 1.3 f_s (ℓ + IM)

0.95R_nF_{yf}: Composite stress capacity for Service II loading according to Article 6.10.4.2 (ksi).

f_s (Total)(Strength I): Sum of stresses as computed below on non-compact section (ksi).
 1.25 (f_{sDC1} + f_{sDC2}) + 1.5 f_{sDW} + 1.75 f_s (ℓ + IM)

φ_rF_n: Non-Compact composite positive or negative stress capacity for Strength I loading according to Article 6.10.7 or 6.10.8 (ksi).

V_f: Maximum factored shear range in span computed according to Article 6.10.10.

10:32:27 AM 0161708-60W29-5033-SuperStruct_SteelDet1.dgn















USER NAME = BAWItoft	DESIGNED WJC	REVISED A 12/18/2013 WJC/DL
PLOT SCALE = 0x2.0000 ' / in.	CHECKED DL	REVISED
PLOT DATE = 12/19/2013	DRAWN MTS	REVISED
	CHECKED DL	REVISED

STATE OF ILLINOIS
 DEPARTMENT OF TRANSPORTATION

STRUCTURAL STEEL DETAILS 1
 STRUCTURE NO. 016-1708

MUN	SECTION	COUNTY	TOTAL SHEETS	SHEET NO.
2090	2013-011R	COOK	356	165
CONTRACT NO.			60W29	
ILLINOIS FED. AID PROJECT				

SHEET NO. 33 OF 55 SHEETS

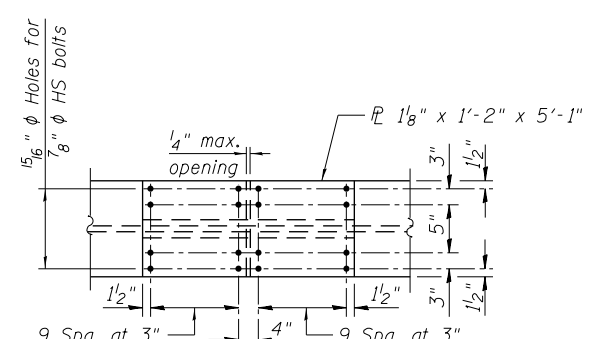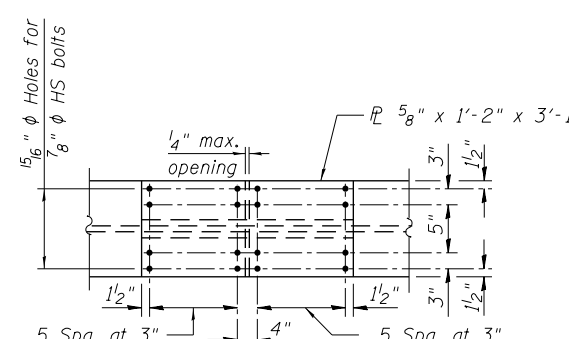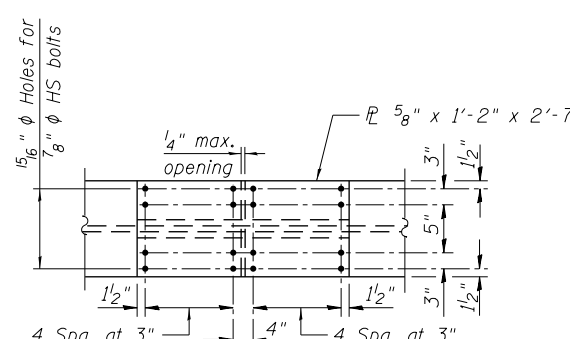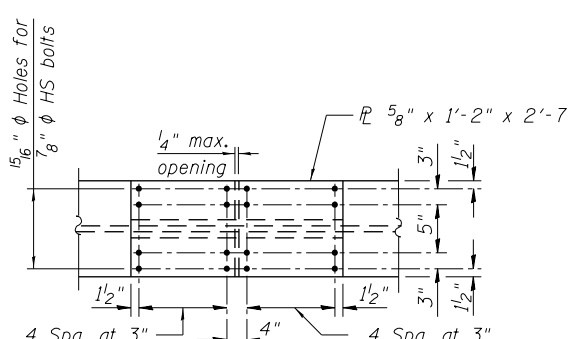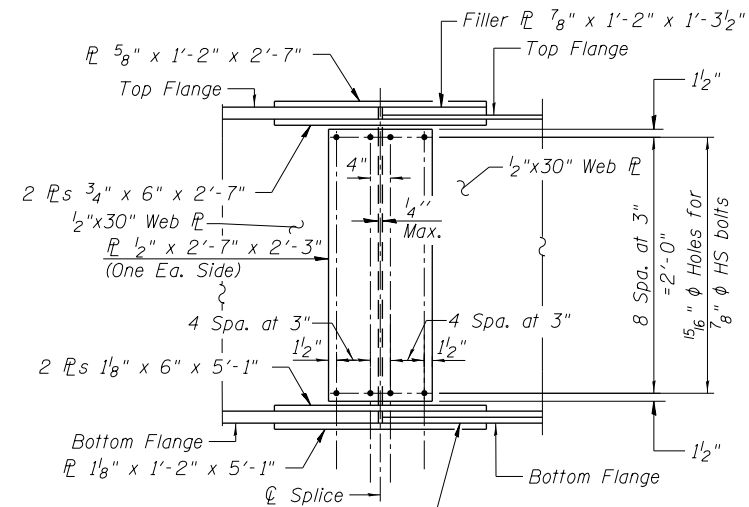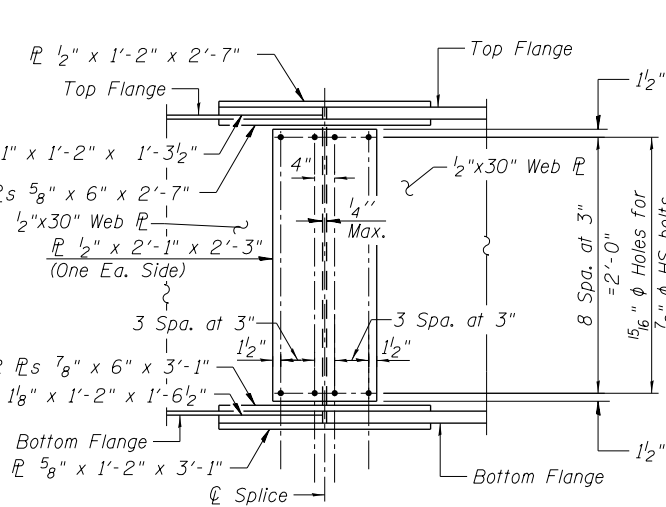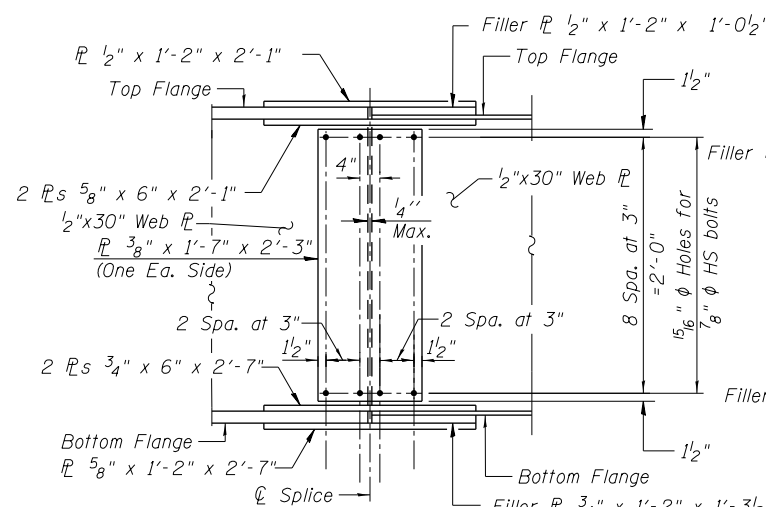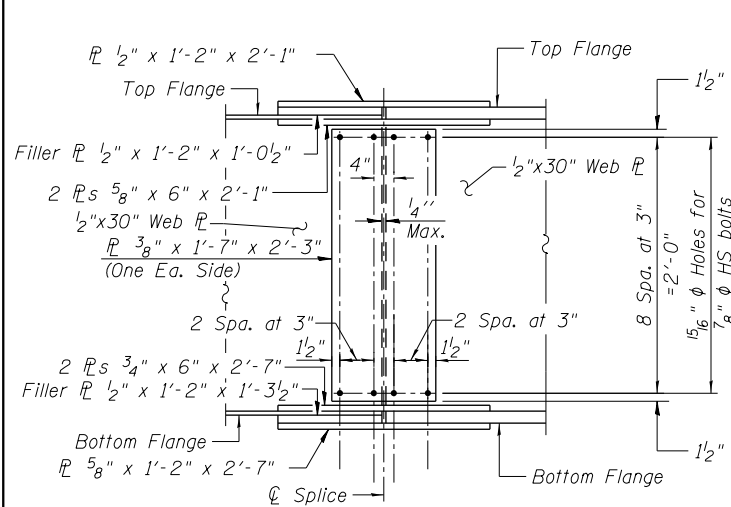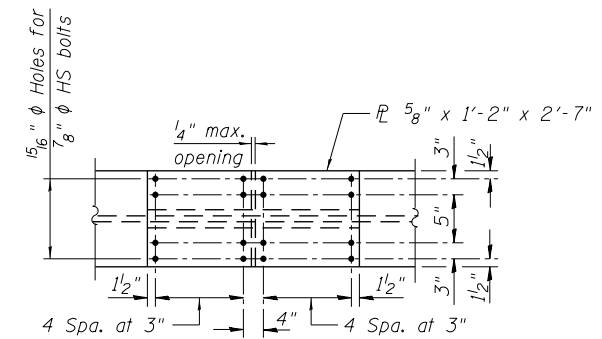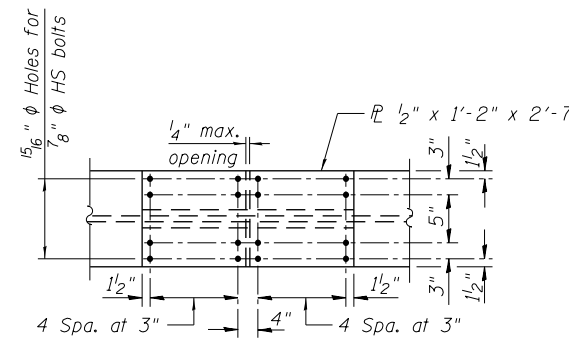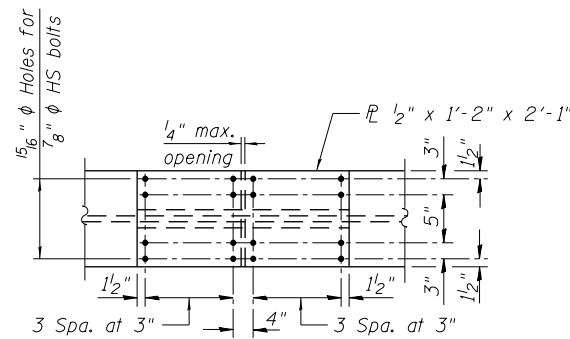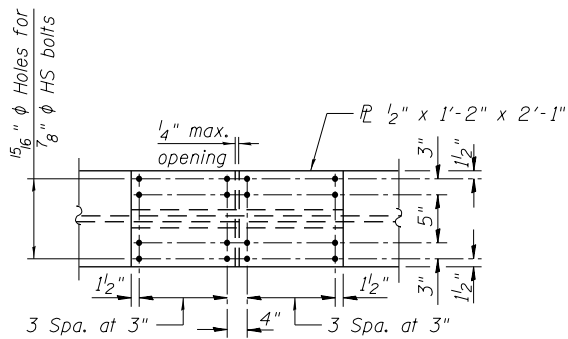

FIELD SPLICE 1 DETAIL

(9 Required)

FIELD SPLICE 2 DETAIL

(9 Required)

FIELD SPLICE 3 DETAIL

(9 Required)

FIELD SPLICE 4 DETAIL

(9 Required)

Notes:
 All splice plates except filler plates shall meet NTR.
 Load carrying components designated "NTR" shall conform to the Impact Testing Requirement, Zone 2.
 All splice plates, except filler plates, shall be AASHTO M 270 Grade 50.

11:04:32 PM 01/17/08 60W29-5034-SuperStruct_SteelDet2.dgn




USER NAME = BAWItoft	DESIGNED = WJC	REVISED
PLOT SCALE = 0x2.0000 '1" / in.	CHECKED = DL	REVISED
PLOT DATE = 10/28/2013	DRAWN = MTS	REVISED
	CHECKED = DL	REVISED

**STATE OF ILLINOIS
 DEPARTMENT OF TRANSPORTATION**

**STRUCTURAL STEEL DETAILS 2
 STRUCTURE NO. 016-1708**


SHEET NO. 34 OF 55 SHEETS

MUN	SECTION	COUNTY	TOTAL SHEETS	SHEET NO.
2090	2013-011R	COOK	356	166
CONTRACT NO.			60W29	
ILLINOIS FED. AID PROJECT				

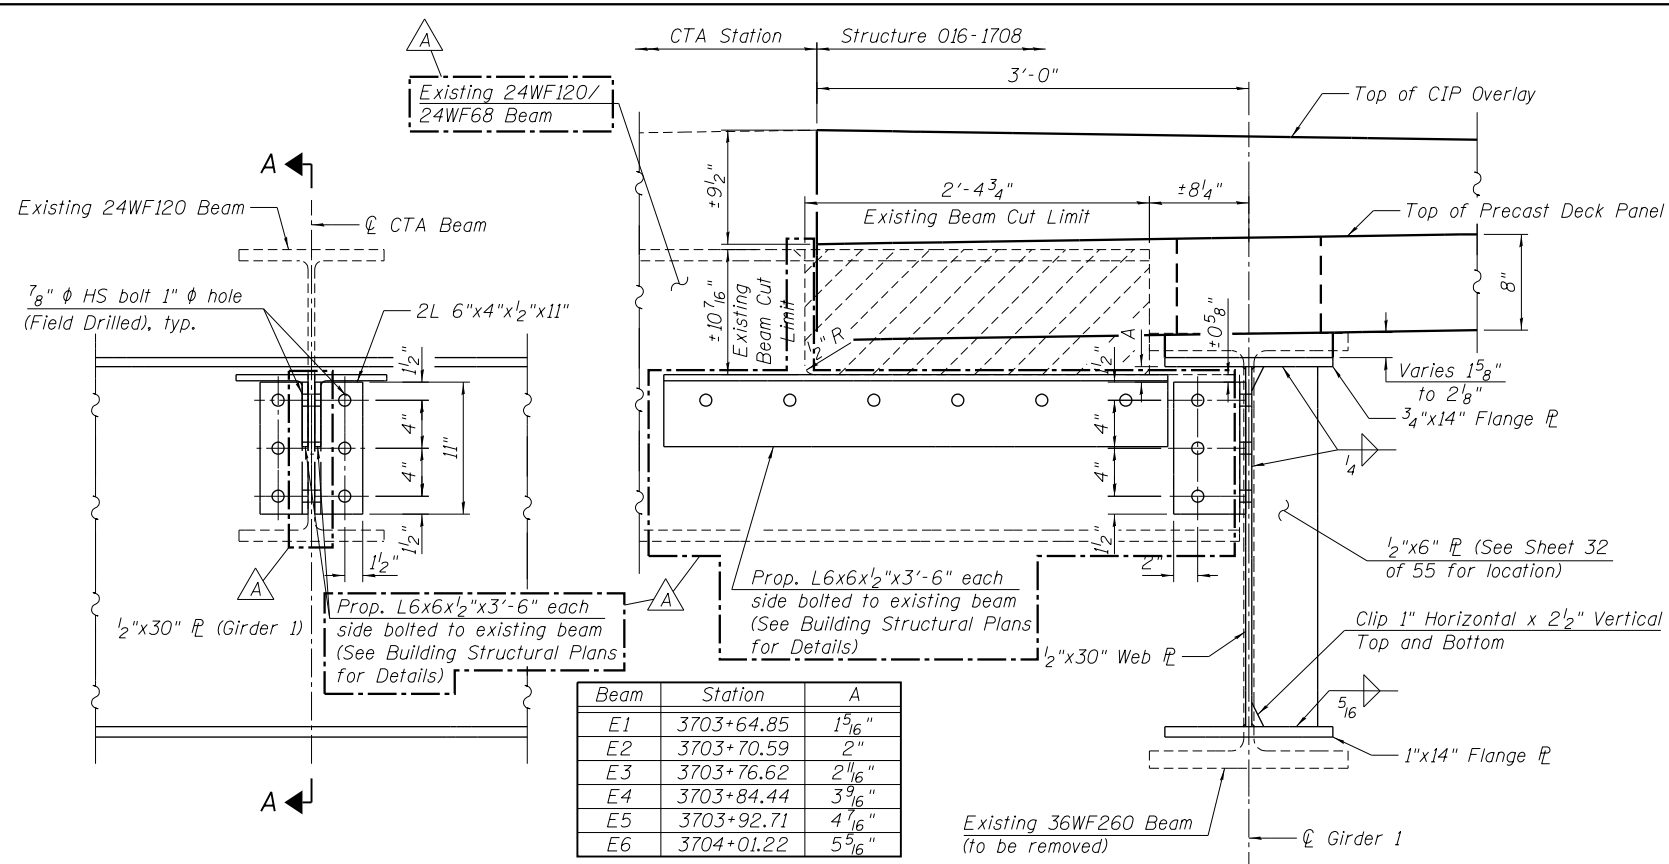


**CTA STATION CONNECTION
ELEVATION**
(Looking East)


SECTION A-A

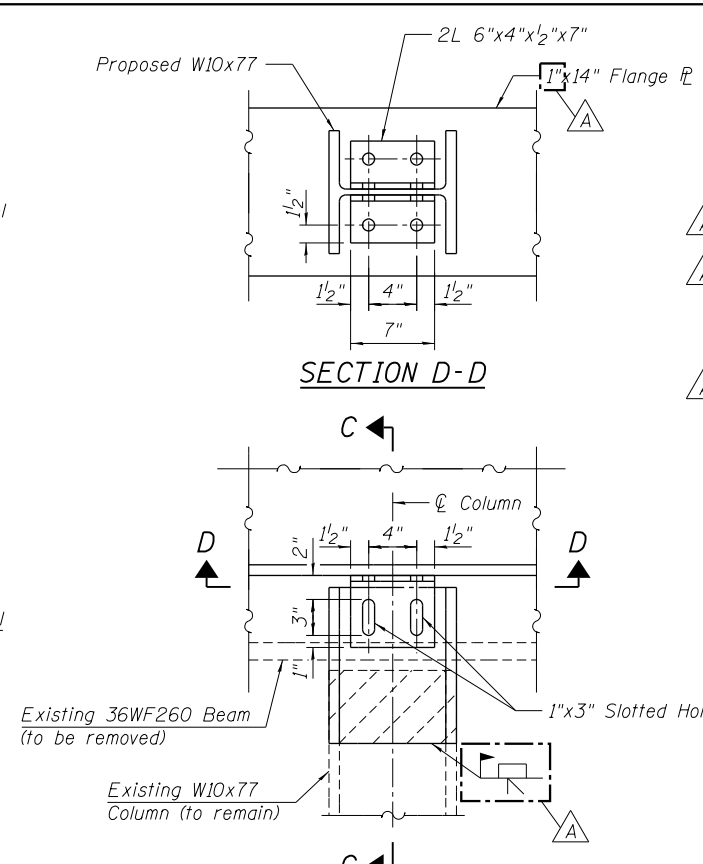


EXISTING COLUMN CONNECTION
(Looking East)

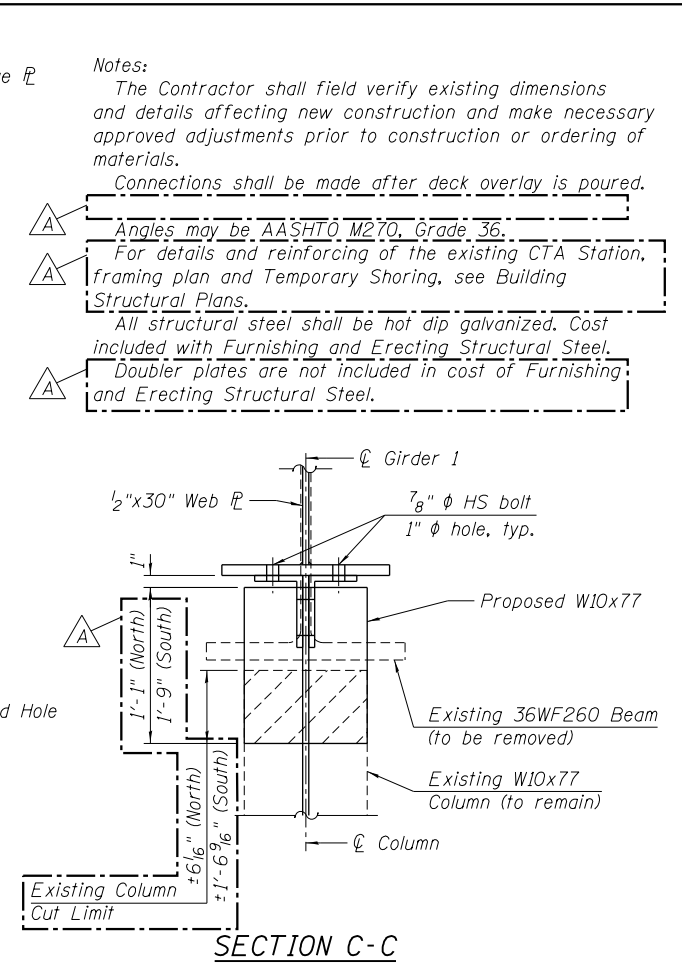

SECTION C-C

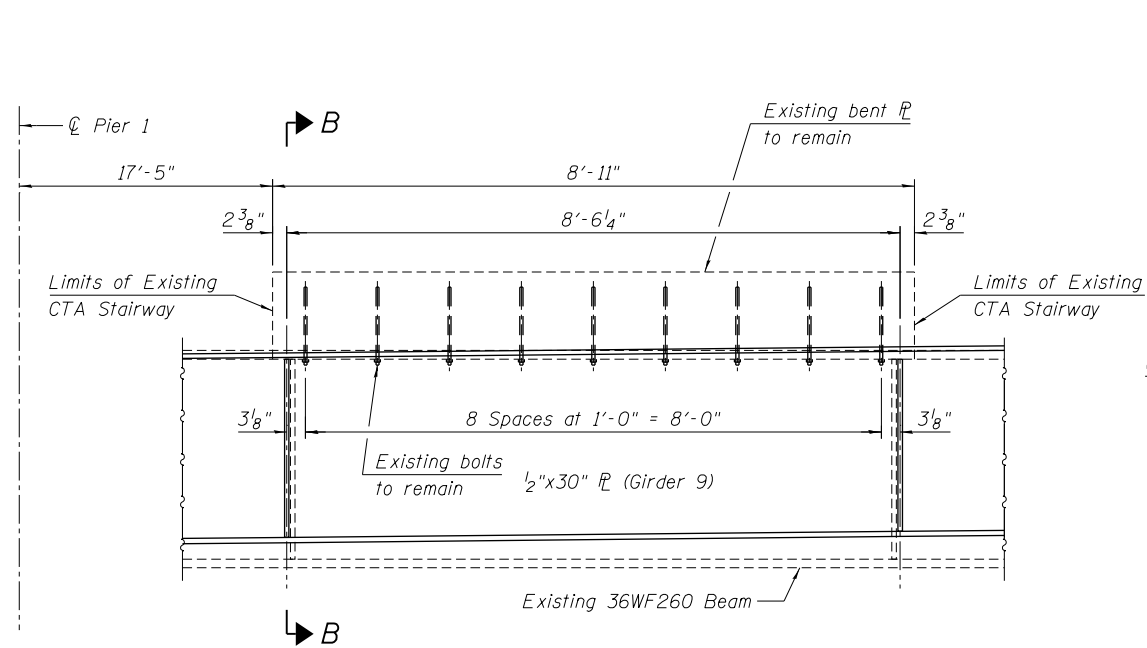


**CTA STAIRWAY CONNECTION
ELEVATION**
(Looking West)

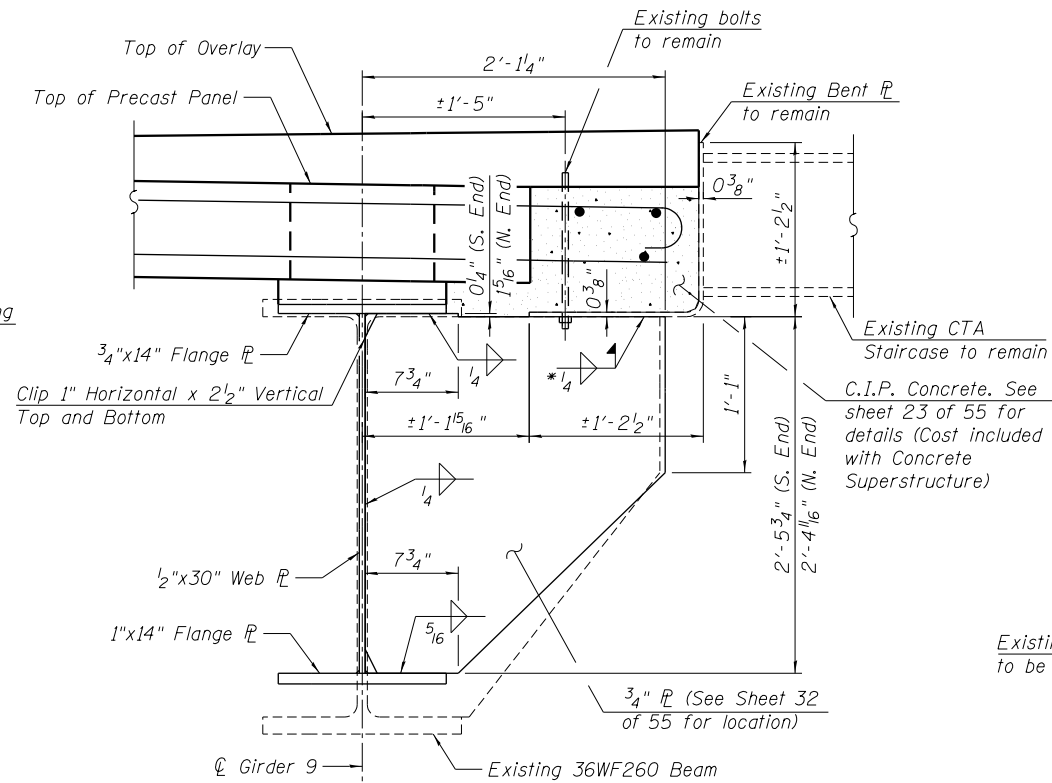

SECTION B-B

*Cost included with Furnishing and Erecting Structural Steel.

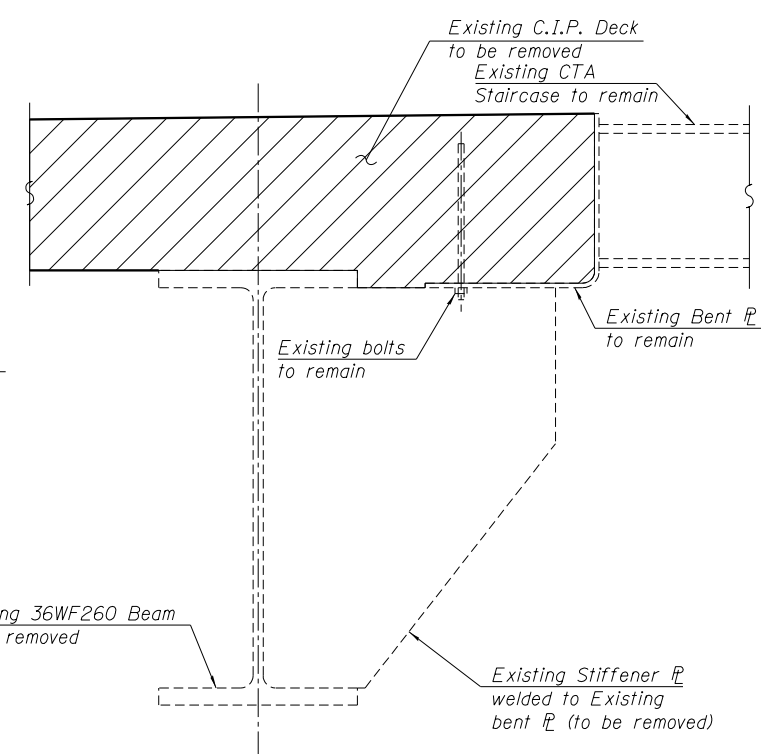

DECK REMOVAL DETAIL

Notes:
The Contractor shall field verify existing dimensions and details affecting new construction and make necessary approved adjustments prior to construction or ordering of materials.
Connections shall be made after deck overlay is poured.
Angles may be AASHTO M270, Grade 36.
For details and reinforcing of the existing CTA Station, framing plan and Temporary Shoring, see Building Structural Plans.
All structural steel shall be hot dip galvanized. Cost included with Furnishing and Erecting Structural Steel.
Doubler plates are not included in cost of Furnishing and Erecting Structural Steel.

12/13/20 PM 0161708-60W29-5035-SuperStruct_SteelDet3.dgn




USER NAME = wjcollett1	DESIGNED WJC	REVISED A 1/20/2014 WJC/DL
PLOT SCALE = 0x2.0000 '1' / in.	CHECKED DL	REVISED
PLOT DATE = 1/20/2014	DRAWN MTS	REVISED
	CHECKED DL/KAH	REVISED

**STATE OF ILLINOIS
DEPARTMENT OF TRANSPORTATION**

**STRUCTURAL STEEL DETAILS 3
STRUCTURE NO. 016-1708**

SHEET NO. 35 OF 55 SHEETS

MUN 2090	SECTION 2013-011R	COUNTY COOK	TOTAL SHEETS 356	SHEET NO. 167
CONTRACT NO. 60W29			ILLINOIS FED. AID PROJECT	

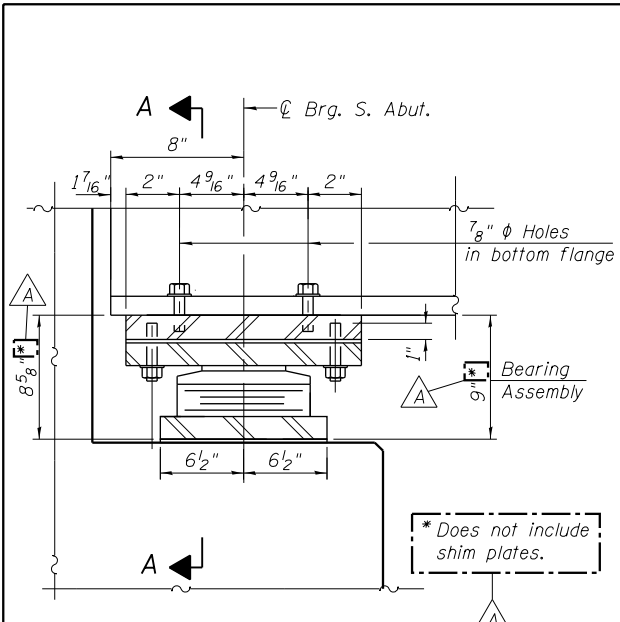


ELEVATION AT ABUT.
(Looking West)

3/4" ϕ ASTM A325 bolt.
hot dip galvanized
per AASHTO M332.
Coat bolts with
anti-seize compound.
2" x 2" x 5/16" PL
washer under nut.
1/4" ϕ Hole in bott PL

Fill PL for crown, shim
PL and 1/8" elastomeric
neoprene leveling pad
according to the
material properties of
Article 1052.02 of the
Standard Specifications.
Cost of pad included with
Elastomeric Bearing Assembly
Type II


2-3/4" ϕ H.S. Bolts w/lock washers (Typ. ea. side)
(Coat bolts with anti-seize compound)
Tapped holes in top PL; 7/8" ϕ holes in bearing PL

TYPE II ELASTOMERIC EXP. BRG.
(at South Abutment)

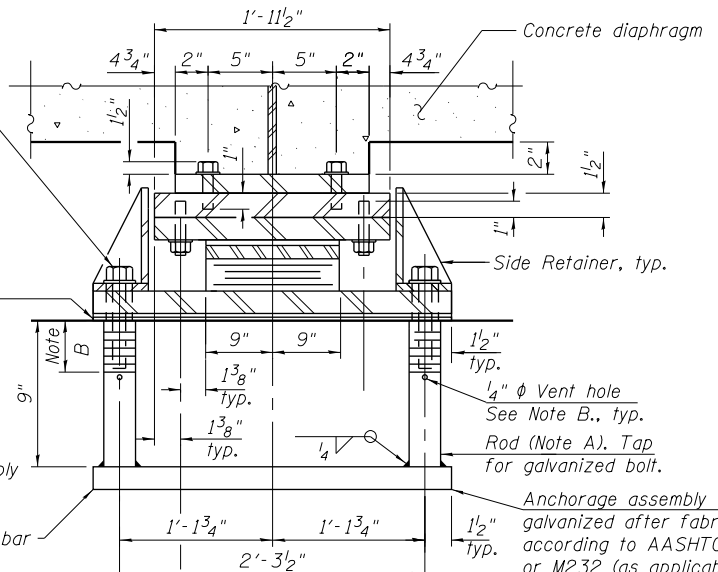

SECTION A-A


Anchorage assembly to be
galvanized after fabrication
according to AASHTO M 111
or M232 (as applicable).
Anchorage assembly shall be
paid for as Structural Steel.

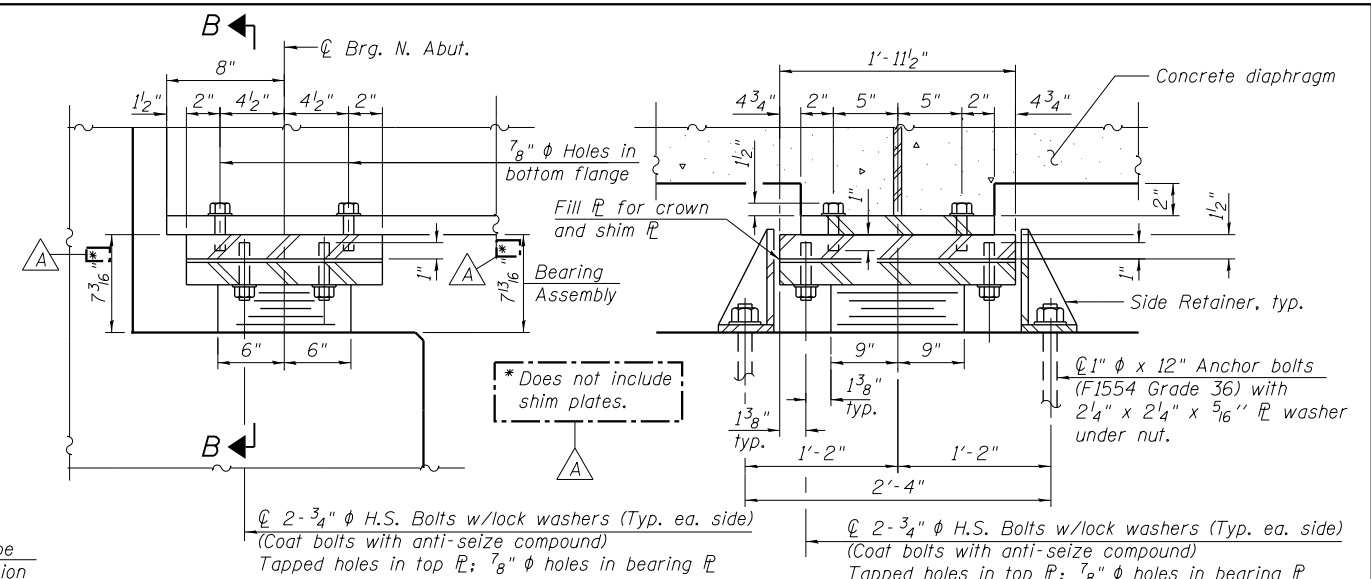

ELEVATION AT ABUT.
(Looking East)

SECTION B-B


TYPE I ELASTOMERIC EXP. BRG.
(at North Abutment)

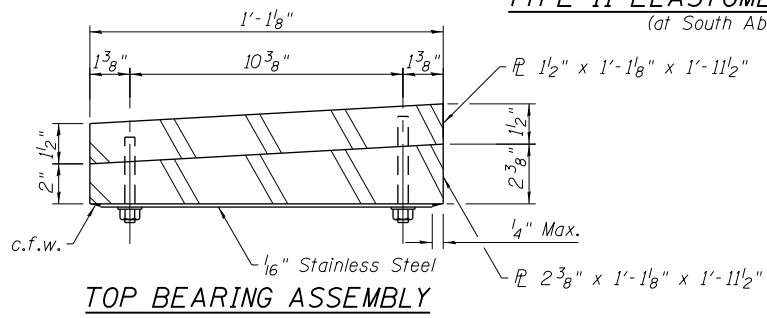

TOP BEARING ASSEMBLY

Note A:
AASHTO M270 G50 or G50W or similar material.
Rod dia. = 1/2" ϕ

Note B:
Bolt engagement 1/4" min., 1 5/8" max., allowing up to 3/8"
adjustment shims. Tap full threads in rod 1 3/4" deep.
Provide 1/4" ϕ galvanizing vent hole below full thread.

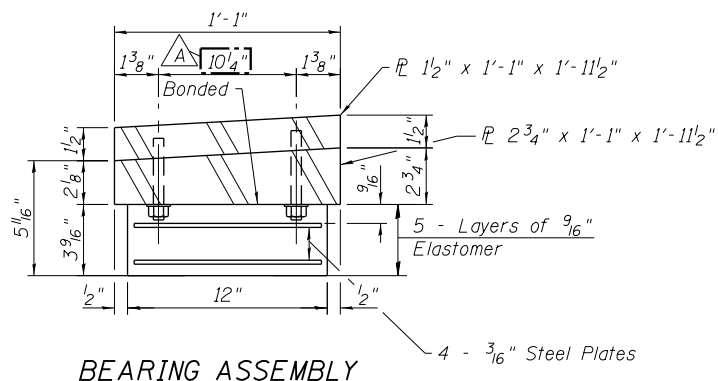

BEARING ASSEMBLY

Notes:
Anchor bolts shall be ASTM F1554 all-thread (or an
Engineer-approved alternate material) of the grade(s)
and diameter(s) specified. The corresponding specified
grade of AASHTO M314 anchor bolts may be used
in lieu of ASTM F1554.

Anchor bolts for side retainers for Type I bearings may
be cast in place or installed in holes drilled before or
after members are in place.

Anchor bolts for Type II bearings shall be placed in
holes drilled in the concrete through holes in the bottom
bearing plate after members are in place. Side retainers
shall be placed after bolts are installed.

Drilled and set anchor bolts shall be installed according to
Article 521.06 of the Standard Specifications.


Side retainers and other steel members required for
the elastomeric bearing assembly shall be included in the
cost of Elastomeric Bearing Assembly, Type I or
Elastomeric Bearing Assembly, Type II.

The 1/8" PTFE sheet shall be bonded directly to the
top steel plate with a two-component, medium viscosity
epoxy resin, conforming to the requirements of the
Federal Specification MMM-A-134, Type I. The bond
agent shall be applied on the full area of the contact
surfaces.


Bonding of 1/8" PTFE sheet during vulcanizing process
will be permitted provided the process and method of
adjusting assembly height is approved by the Engineer.

Two 1/8" adjusting shims shall be provided for each
bearing in addition to all other plates or shims and placed
as shown on bearing details.

All (embedded and separate) bearing plates, side
retainers, anchor bolts, nuts and washers shall be
galvanized according to ASTM M111 or M232 as applicable.

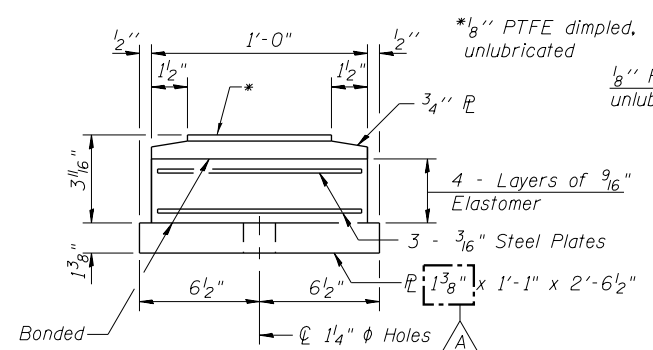


BOTTOM BEARING ASSEMBLY

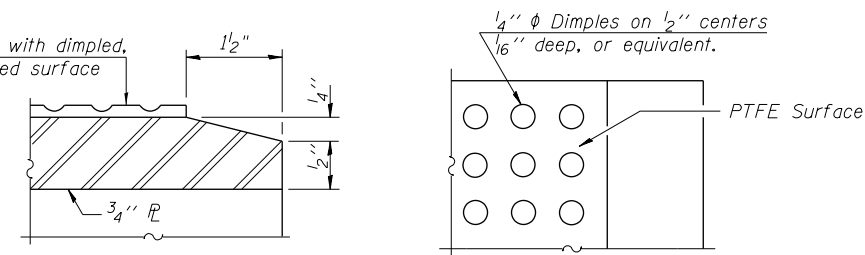


SECTION THRU PTFE

PLAN-PTFE SURFACE

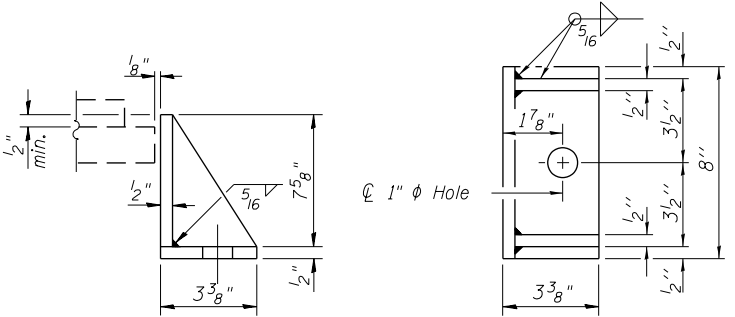

SIDE RETAINER

Equivalent rolled angle with stiffeners
will be allowed in lieu of welded plates.

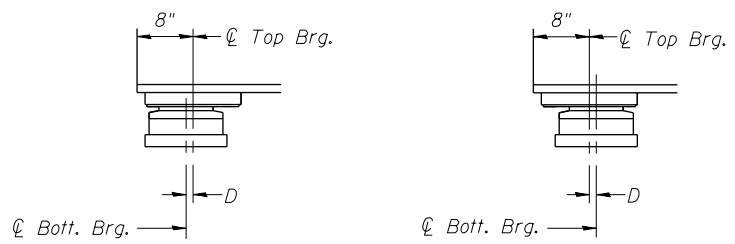


BELOW 50°F.

ABOVE 50°F.

(Move bott. brg. away from fixed brg.) (Move bott. brg. toward fixed brg.)

SETTING ANCHOR BOLTS AT EXP. BRG.

D = 1/8" per each 100' of expansion for every 15° temp.
change from the normal temp. of 50°F.

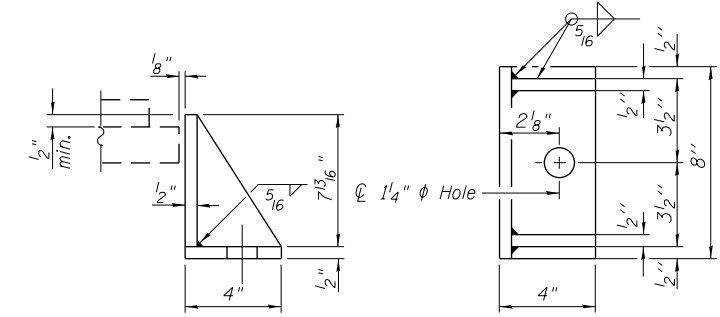

SIDE RETAINER

Equivalent rolled angle with stiffeners
will be allowed in lieu of welded plates.

BILL OF MATERIAL

Item	Unit	Total
Elastomeric Bearing Assembly, Type I	Each	9
Elastomeric Bearing Assembly, Type II	Each	9
Anchor Bolts, 1" ϕ	Each	18

10:32:31 AM 0161708-60W29-5036-Bearing_AbutDetails.dgn




USER NAME = BAWIort	DESIGNED = JRM	REVISED = 12/18/2013 JRM/WJC
PLOT SCALE = 0x2.0000 '1' / in.	CHECKED = WJC	REVISED
PLOT DATE = 12/19/2013	DRAWN = MTS	REVISED
	CHECKED = WJC	REVISED

STATE OF ILLINOIS
DEPARTMENT OF TRANSPORTATION


ABUTMENT BEARING DETAILS
STRUCTURE NO. 016-1708

SHEET NO. 36 OF 55 SHEETS


MUN	SECTION	COUNTY	TOTAL SHEETS	SHEET NO.
2090	2013-011R	COOK	356	168
CONTRACT NO.			60W29	
ILLINOIS FED. AID PROJECT				

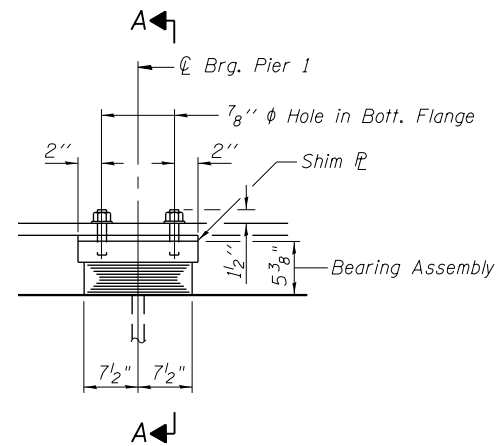


ELEVATION AT PIER
(Looking West)

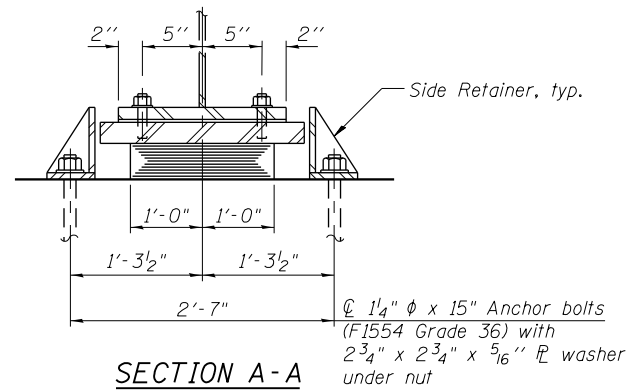

SECTION A-A

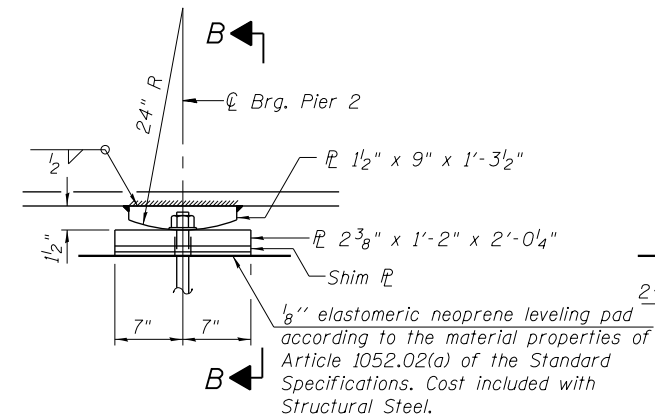




ELEVATION AT PIER
(Looking West)

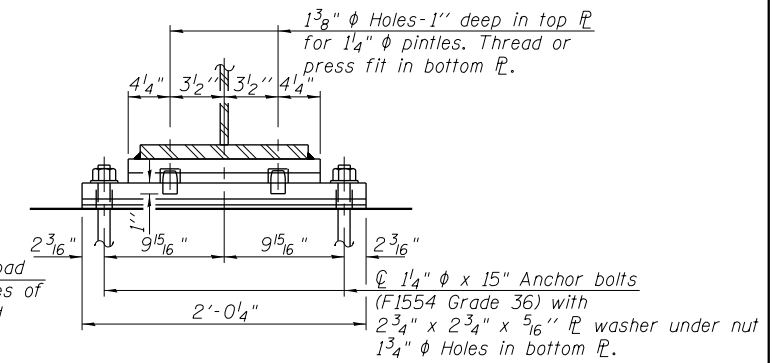

SECTION B-B


TYPE I ELASTOMERIC EXP. BRG.
(At Pier 1)

FIXED BEARING
(At Pier 2)

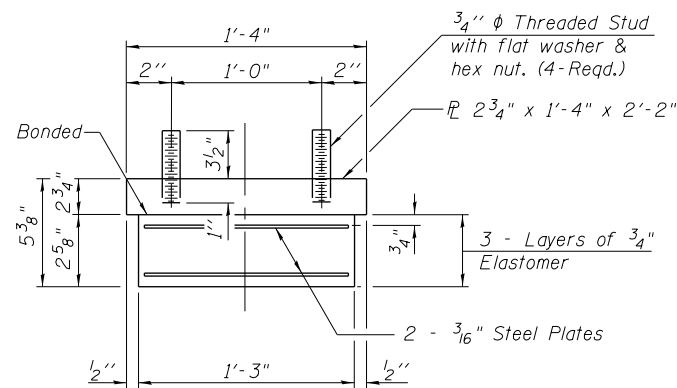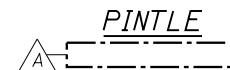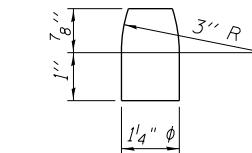

BEARING ASSEMBLY

Note:
Shim plates shall not be placed under Bearing Assembly.

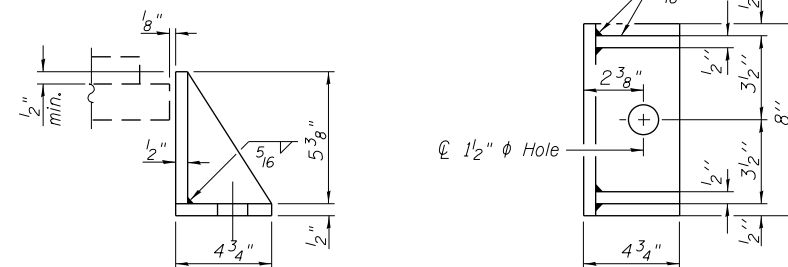

SIDE RETAINER

Equivalent rolled angle with stiffeners will be allowed in lieu of welded plates.

- Notes:
- Anchor bolts shall be ASTM F1554 all-thread (or an Engineer-approved alternate material) of the grade(s) and diameter(s) specified. The corresponding specified grade of AASHTO M314 anchor bolts may be used in lieu of ASTM F1554.
 - Anchor bolts at fixed bearings may be either cast in place or installed in holes drilled after the supported member is in place.
 - Anchor bolts for side retainers may be cast in place or installed in holes drilled before or after members are in place.
 - Drilled and set anchor bolts shall be installed according to Article 521.06 of the Standard Specifications.
 - Side retainers and other steel members required for the elastomeric bearing assembly shall be included in the cost of Elastomeric Bearing Assembly, Type I.
 - Two 1/8" adjusting shims shall be provided for each bearing in addition to all other plates or shims and placed as shown on bearing details.
 - All (embedded and separate) bearing plates, side retainers, anchor bolts, nuts, washers and pintles shall be galvanized according to ASTM M111 or M232 as applicable.

BILL OF MATERIAL

Item	Unit	Total
Elastomeric Bearing Assembly, Type I	Each	9
Anchor Bolts, 1 1/4"	Each	36

10:32:32 AM 0161708-60W29-5037-Bearing_Details.dgn




USER NAME = BAWIort	DESIGNED = JRM	REVISED = 12/18/2013 JRM/WJC
CHECKED = WJC	REVISIONS	
PLOT SCALE = 0:2.0000 '1" / in.	DRAWN = MTS	REVISIONS
PLOT DATE = 12/19/2013	CHECKED = WJC	REVISIONS

STATE OF ILLINOIS
DEPARTMENT OF TRANSPORTATION

PIER BEARING DETAILS
STRUCTURE NO. 016-1708

SHEET NO. 37 OF 55 SHEETS

MUN	SECTION	COUNTY	TOTAL SHEETS	SHEET NO.
2090	2013-011R	COOK	356	169
CONTRACT NO.			60W29	
ILLINOIS FED. AID PROJECT				

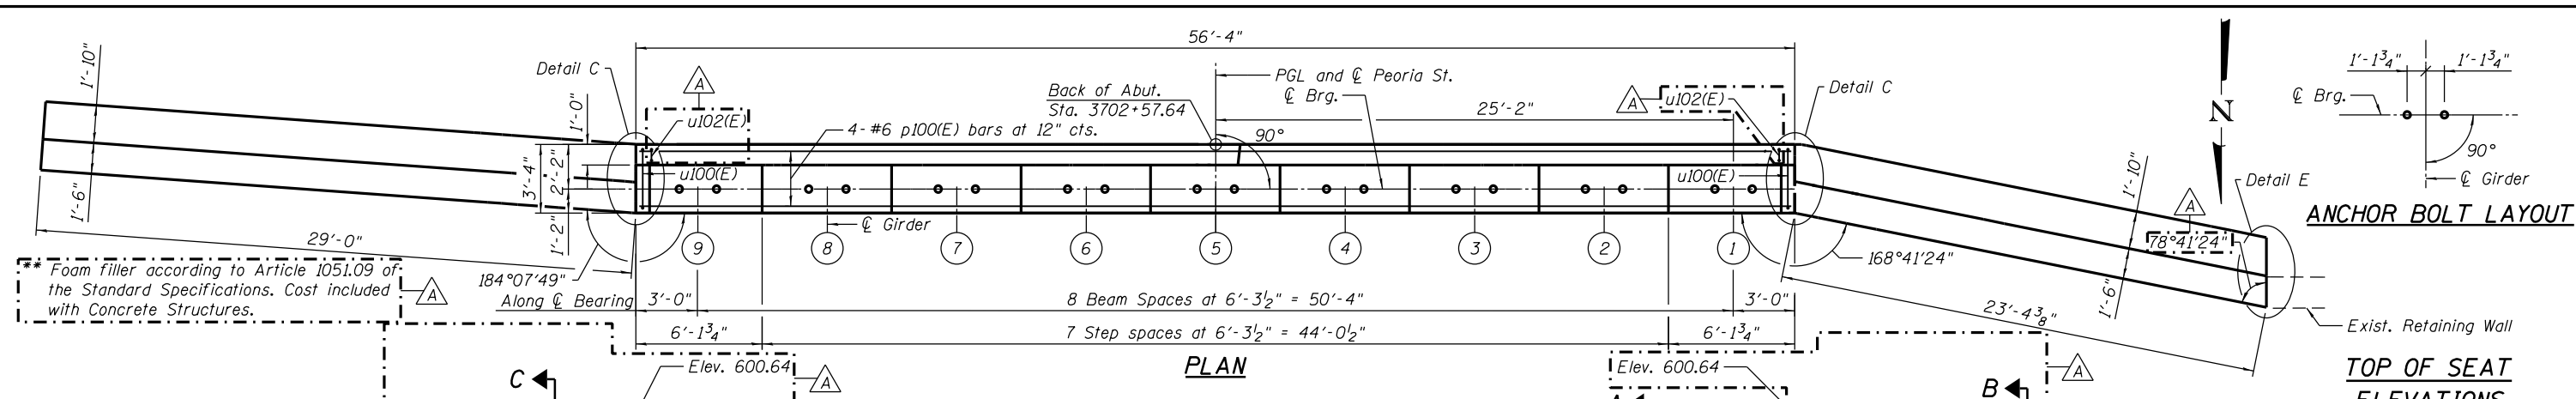


ANCHOR BOLT LAYOUT


TOP OF SEAT ELEVATIONS

Girder No.	Seat Elevation
1	592.31
2	592.41
3	592.50
4	592.60
5	592.69
6	592.60
7	592.50
8	592.41
9	592.31

Notes:
 For Sections A-A and B-B, Details A and B, Drilled Shaft Details and Bill of Material, see Sheet 39 of 55.
 For Section C-C and Details C and E, see Sheet 40 of 55.
 Siphon and drilled shaft locations at the Southeast wingwall shall be verified in the field and approved by the Engineer prior to drilled shaft construction.

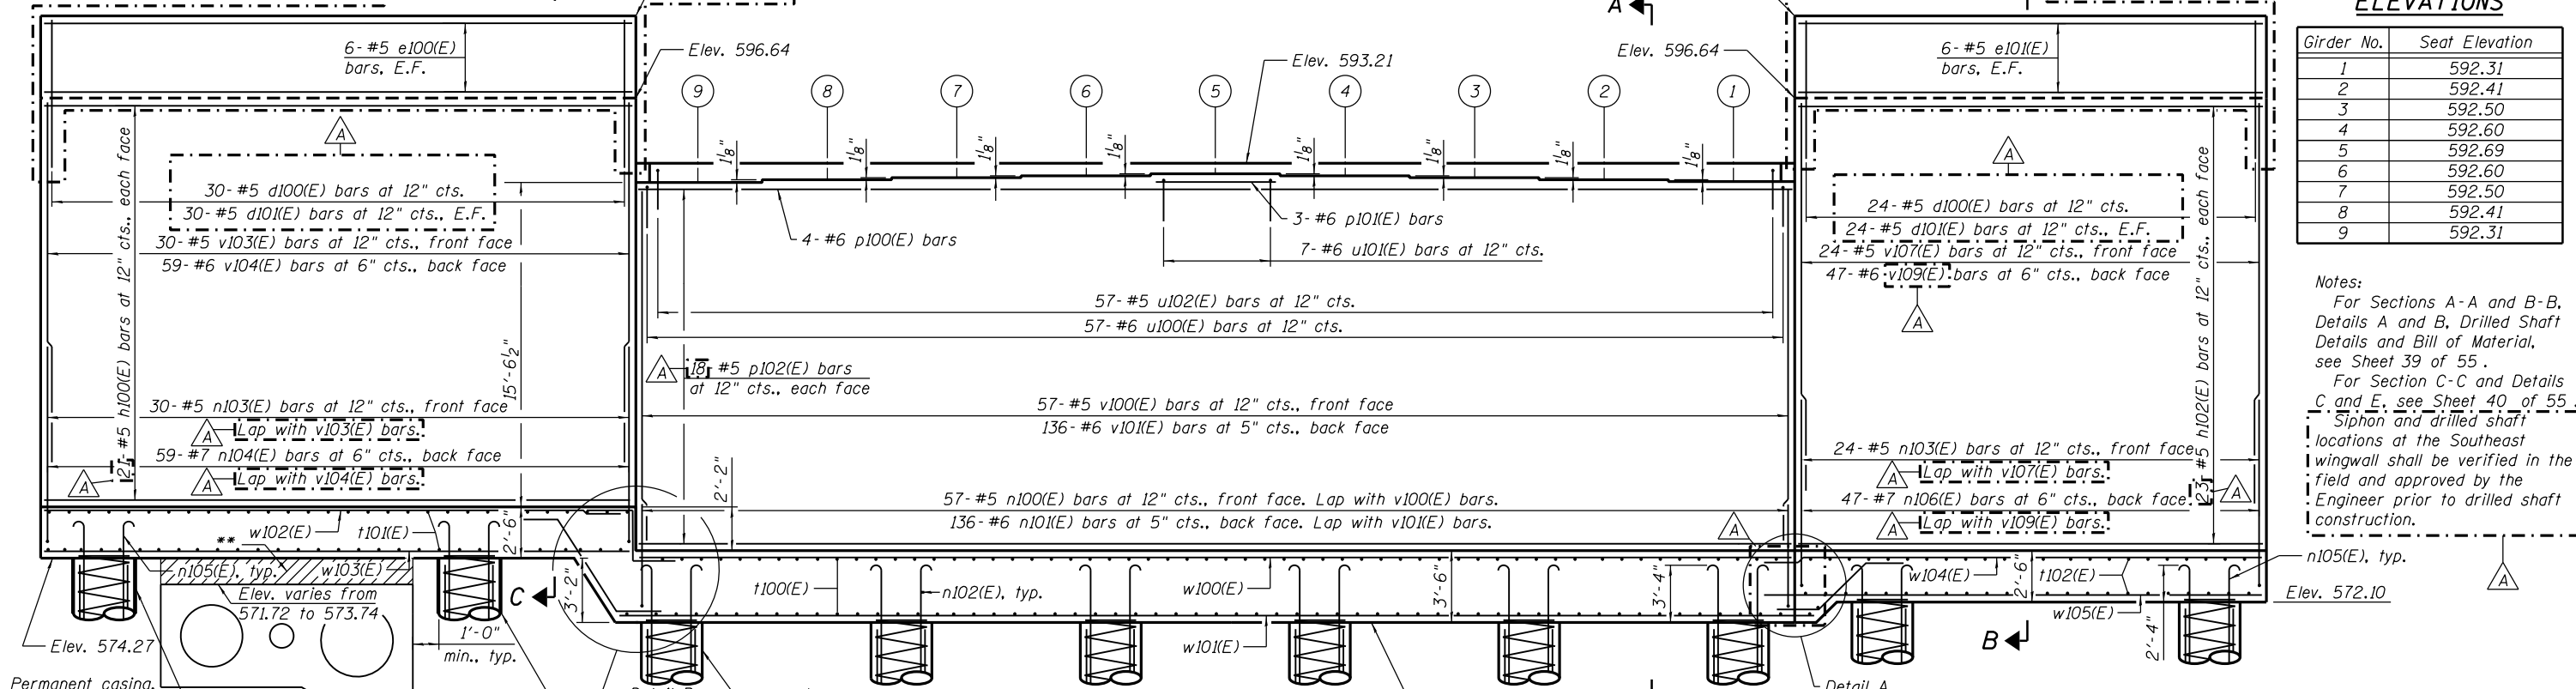

ELEVATION
(Looking South)

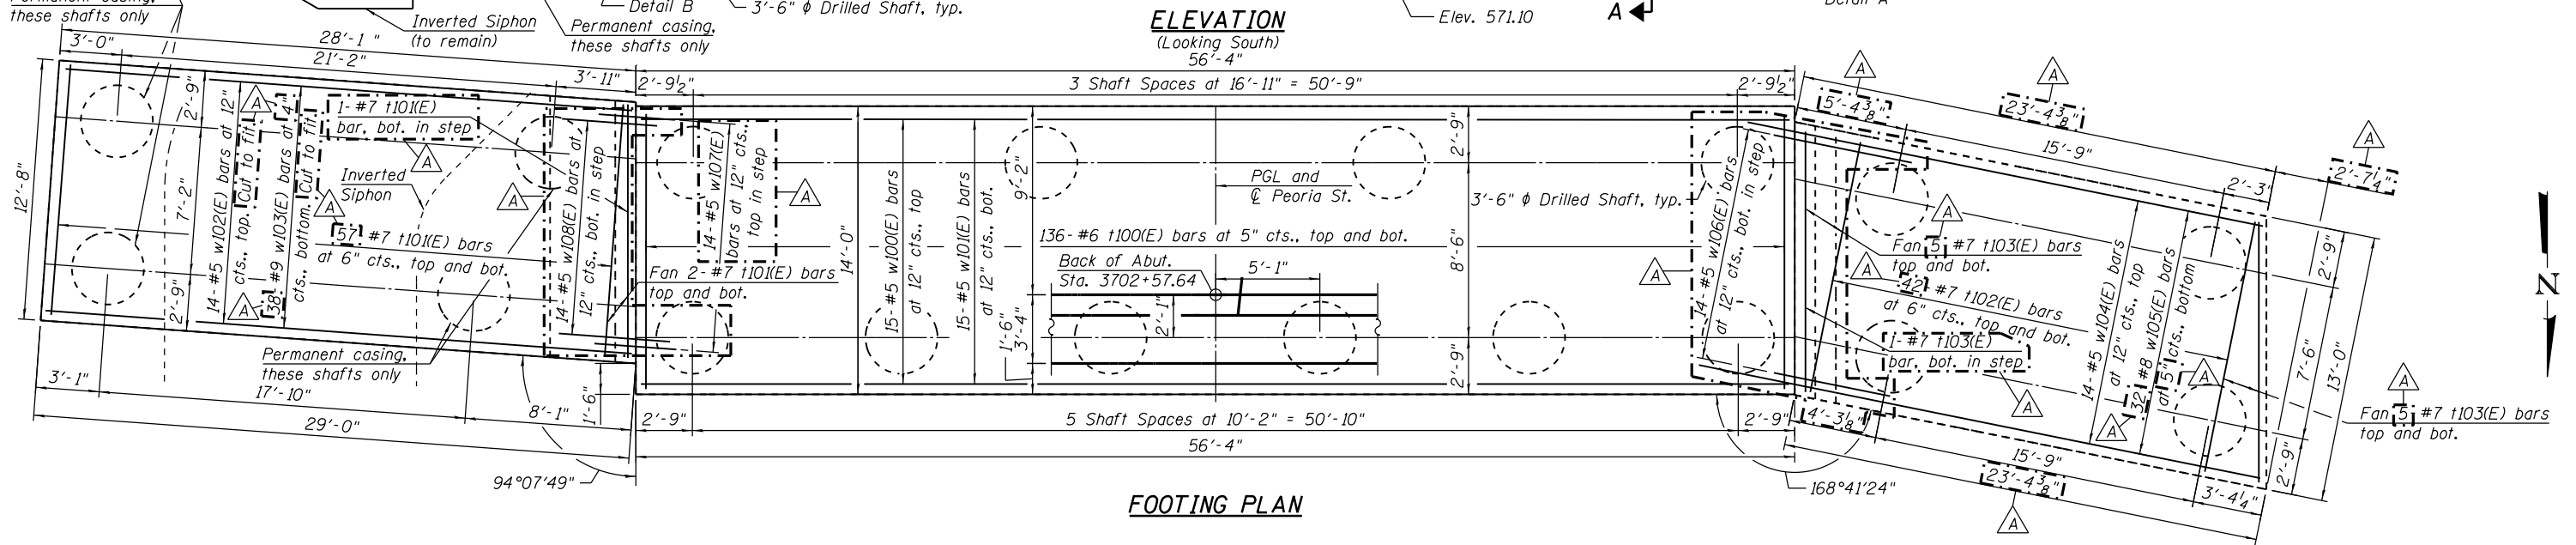

FOOTING PLAN

1:44:00 PM 01/21/2014 6:02:29 - Abutment - SouthP&E.dgn



USER NAME = kahastings	DESIGNED JRM	REVISED A 1/20/2014 JRM/WJC
CHECKED SAS	REVISOR	
PLOT SCALE = 8x0.0018 "/> <td>DRAWN RLS</td> <td>REVISOR</td>	DRAWN RLS	REVISOR
PLOT DATE = 1/21/2014	CHECKED WJC	REVISOR






STATE OF ILLINOIS
DEPARTMENT OF TRANSPORTATION

SOUTH ABUTMENT PLAN AND ELEVATION
STRUCTURE NO. 016-1708

SHEET NO. 38 OF 55 SHEETS

MUN 2090	SECTION 2013-011R	COUNTY COOK	TOTAL SHEETS 356	SHEET NO. 170
CONTRACT NO. 60W29			ILLINOIS FED. AID PROJECT	

* 75'-7 1/4" Limits of Drilled Shaft in Soil (Abutment)
 * 76'-7 1/4" Limits of Drilled Shaft in Soil (Southwest Wingwall)
 * 78'-9 1/4" Limits of Drilled Shaft in Soil (Southeast Wingwall)
 * 78'-9 1/4" Limits of Permanent Casing (Southwest Wingwall)

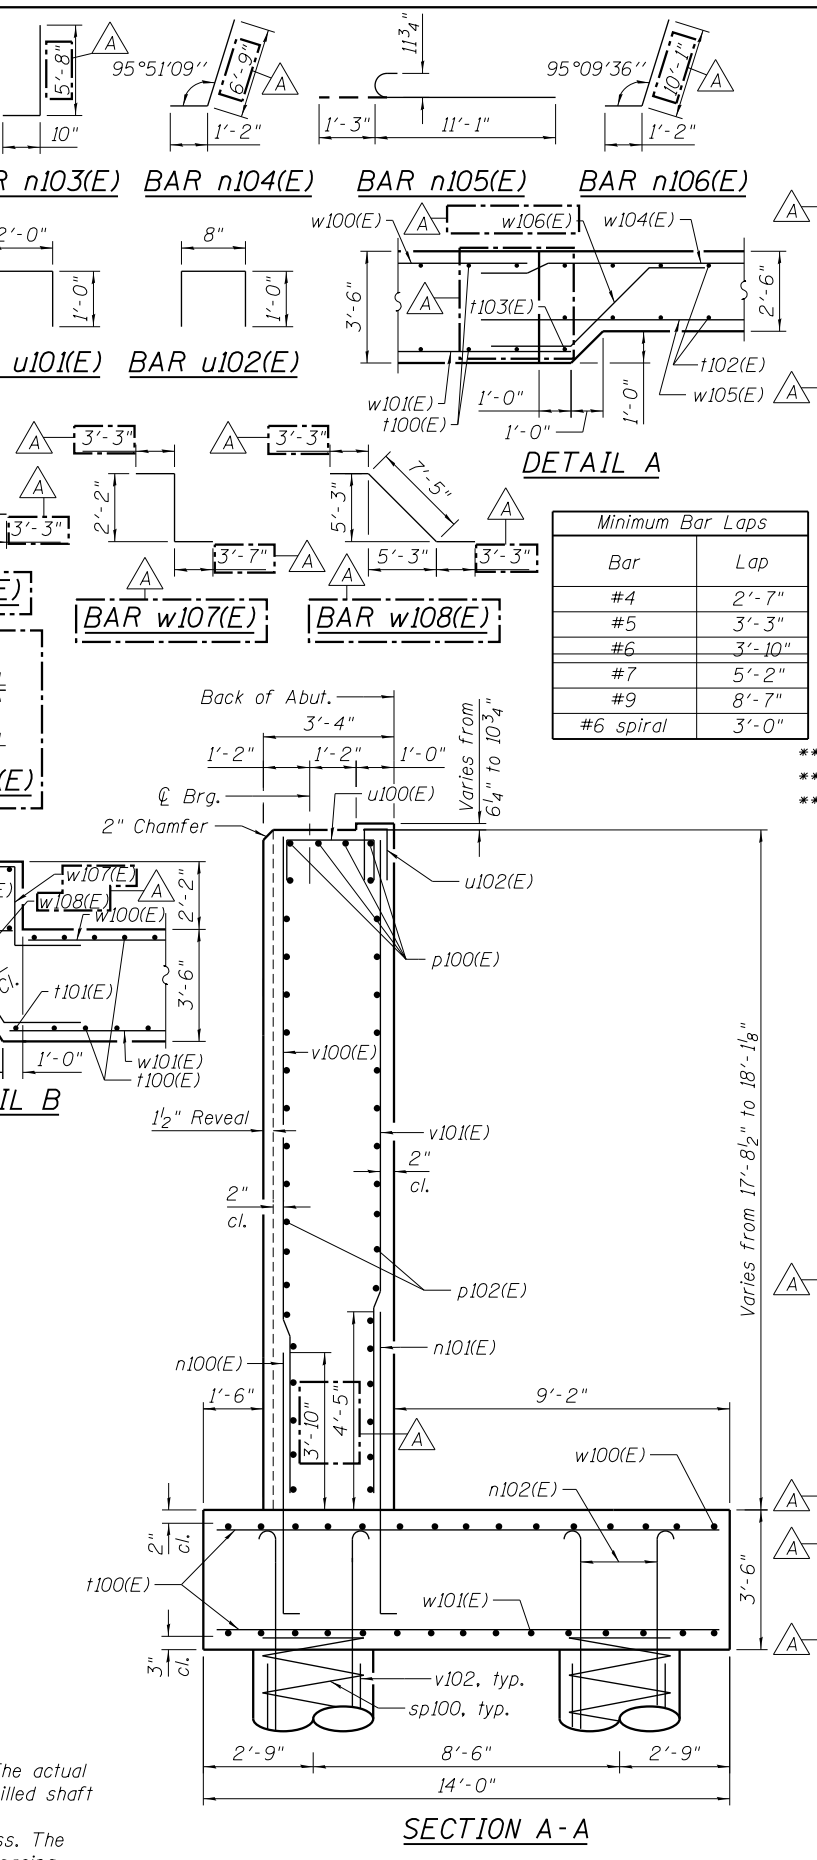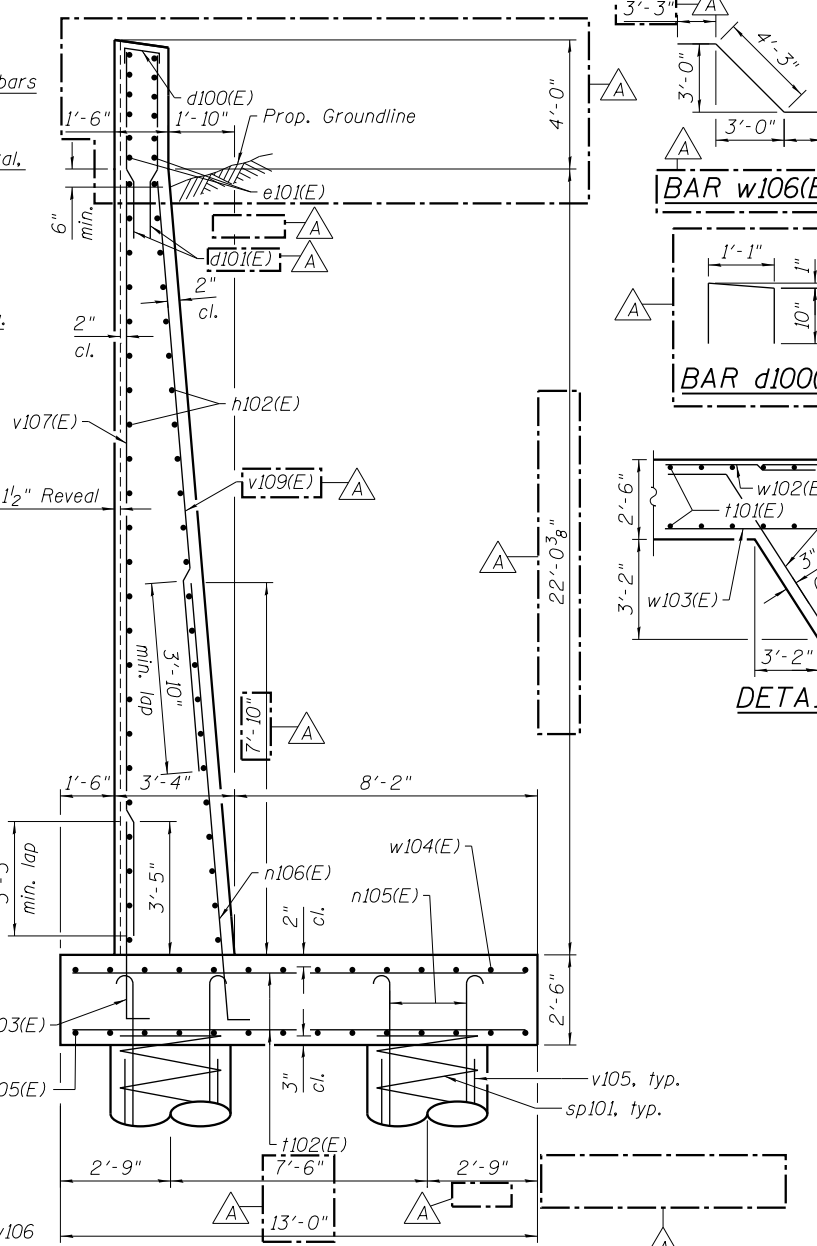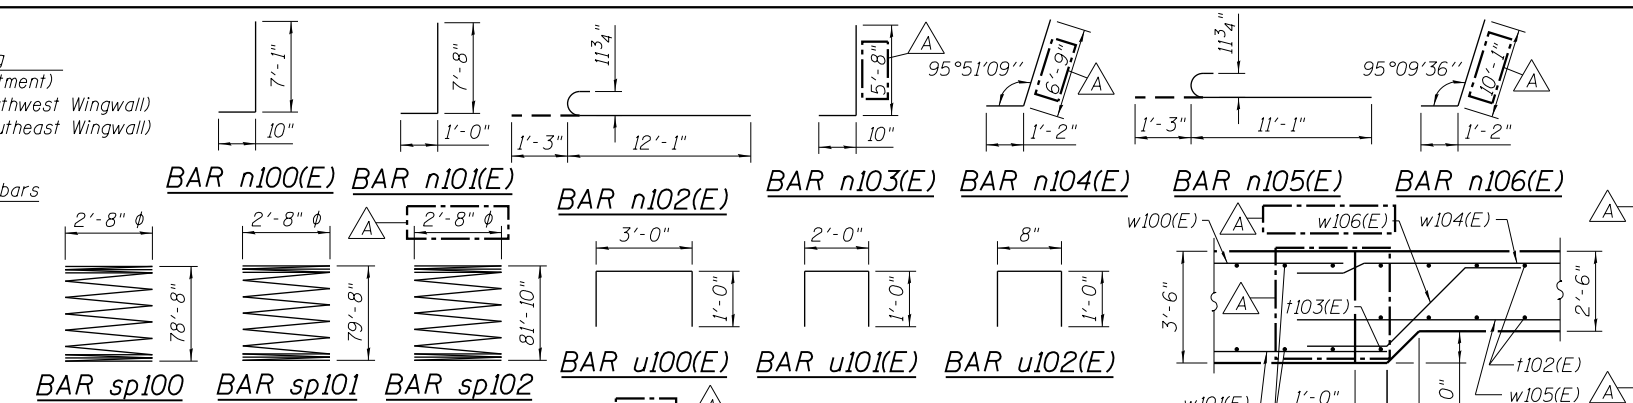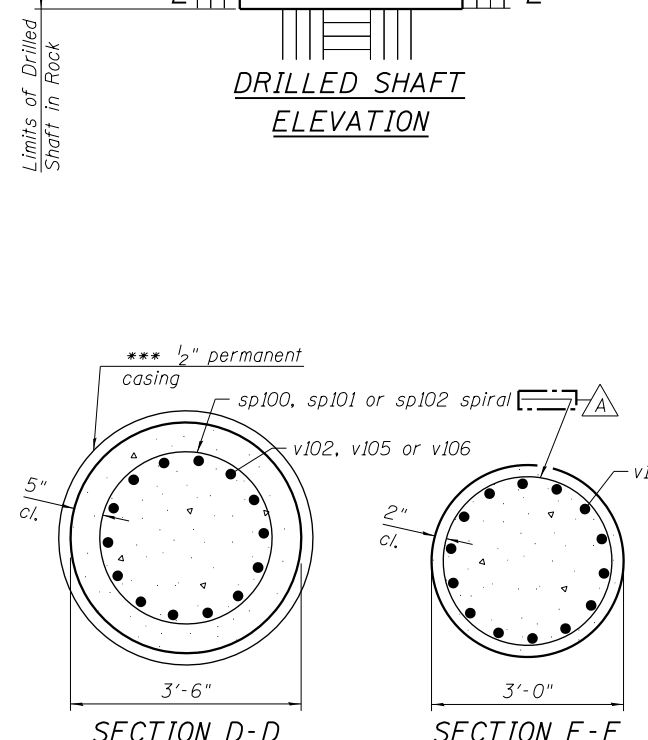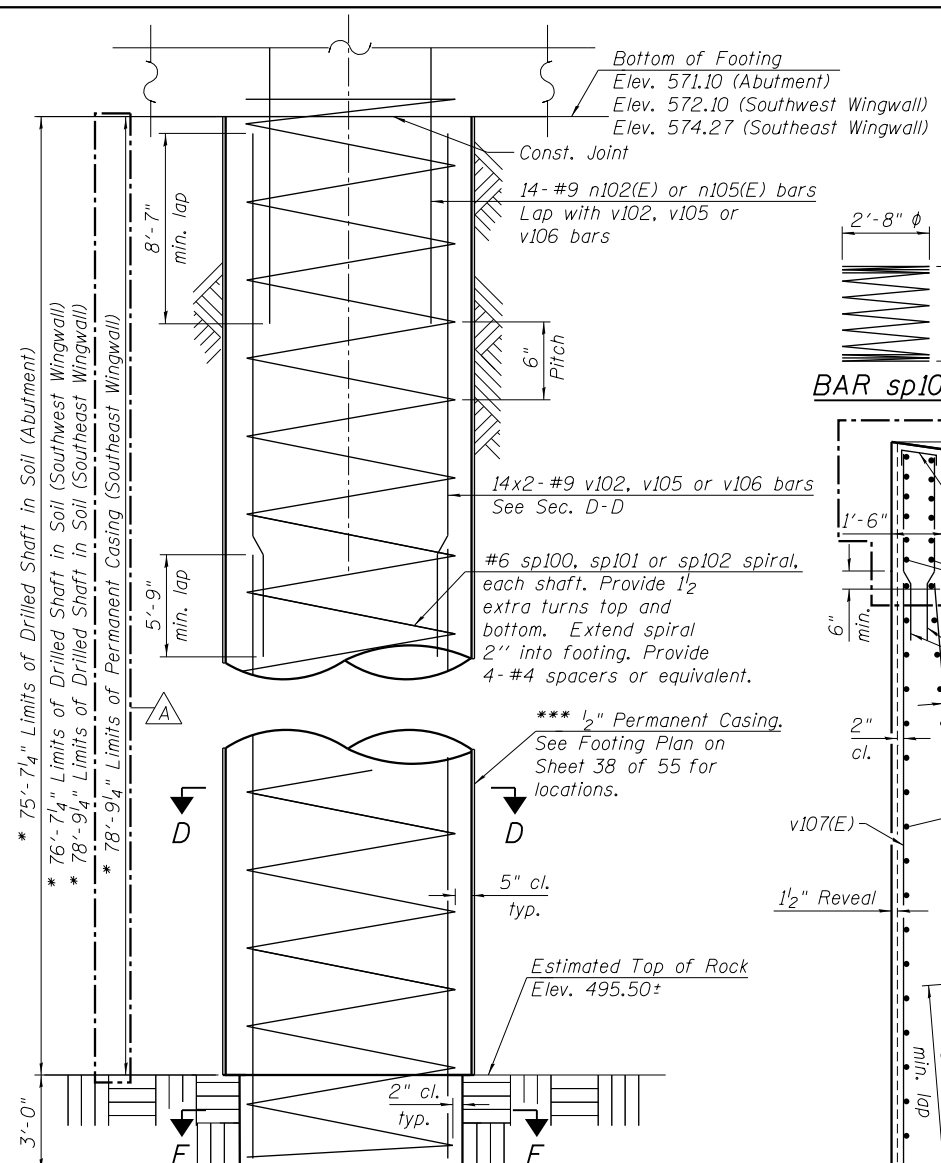

Minimum Bar Laps

Bar	Lap
#4	2'-7"
#5	3'-3"
#6	3'-10"
#7	5'-2"
#9	8'-7"
#6 spiral	3'-0"

BILL OF MATERIAL

Bar	No.	Size	Length	Shape
d100(E)	54	#5	2'-10"	
d101(E)	108	#5	5'-4"	
e100(E)	12	#5	28'-8"	
e101(E)	12	#5	23'-0"	
h100(E)	42	#5	28'-8"	
h102(E)	46	#5	23'-0"	
h104(E)	4	#5	2'-0"	
n100(E)	57	#5	7'-11"	
n101(E)	136	#6	8'-8"	
n102(E)	140	#9	13'-4"	C
n103(E)	54	#5	6'-6"	
n104(E)	59	#7	7'-11"	
n105(E)	112	#9	12'-4"	C
n106(E)	47	#7	11'-3"	
p100(E)	4	#6	56'-0"	
p101(E)	3	#6	5'-11"	
p102(E)	36	#5	56'-0"	
sp100	10	#6	78'-8"	
sp101	4	#6	79'-8"	
sp102	4	#6	81'-10"	
t100(E)	272	#6	13'-8"	
t101(E)	119	#7	12'-4"	
t102(E)	84	#7	12'-8"	
t103(E)	21	#7	12'-11"	
u100(E)	57	#6	5'-0"	
u101(E)	7	#6	4'-0"	
u102(E)	57	#5	2'-8"	
v100(E)	57	#5	17'-4"	
v101(E)	136	#6	17'-4"	
v102	280	#9	42'-0"	
v103(E)	30	#5	19'-6"	
v104(E)	59	#6	19'-0"	
v105	112	#9	42'-6"	
v106	112	#9	43'-8"	
v107(E)	24	#5	21'-8"	
v108(E)	6	#5	1'-8"	
v109(E)	47	#6	17'-10"	
w100(E)	15	#5	56'-0"	
w101(E)	15	#5	58'-0"	
w102(E)	14	#5	28'-8"	
w103(E)	38	#9	28'-8"	
w104(E)	14	#5	25'-4"	
w105(E)	32	#8	27'-2"	
w106(E)	14	#5	10'-9"	
w107(E)	14	#5	9'-0"	
w108(E)	14	#5	13'-11"	

Structure Excavation	Cu. Yd.	1577
Concrete Structures	Cu. Yd.	392.2
Concrete Superstructure	Cu. Yd.	11.4
Reinforcement Bars	Pound	108,920
Reinforcement Bars, Epoxy Coated	Pound	51,640
Permanent Casing	Foot	315
Drilled Shaft in Soil	Cu. Yd.	490.9
Drilled Shaft in Rock	Cu. Yd.	14.3
Concrete Sealer	Sq. Ft.	2079
Geocomposite Wall Drain	Sq. Yd.	239
Granular Backfill for Structures	Cu. Yd.	308

Notes:
 Apply Concrete Sealer to all exposed concrete surfaces of the abutment and wingwalls. Pour steps monolithically with cap.
 Space p100(E), u100(E) and u101(E) bars to miss anchor bolts.
 * The quantities and detailing are based on the estimated elevations shown on the plans. The actual elevations may differ at each shaft and corresponding adjustments shall be made to the drilled shaft and reinforcement quantities and payment limits.
 *** Contractor may need to increase the casing thickness to withstand the installation process. The Estimated Top of Rock/Bottom of Permanent Casing Elevation is shown. The limits of the casing shall be adjusted as necessary, and as approved, such that the actual installed casing length extends to the as-encountered top of rock at each shaft. See Article 516.06(d) of the Standard Specifications.

9:54:50 AM 0161708-60W29-5039-Abutment_SouthDetails1.dgn



USER NAME = jrmickow	DESIGNED JRM	REVISED A 1/20/2014 JRM/WJC
PLOT SCALE = 0x2.0000 '1" / in.	CHECKED SAS	REVISIONS
PLOT DATE = 1/21/2014	DRAWN RLS	REVISIONS
	CHECKED WJC	REVISIONS


**STATE OF ILLINOIS
DEPARTMENT OF TRANSPORTATION**

**SOUTH ABUTMENT DETAILS 1
STRUCTURE NO. 016-1708**


SHEET NO. 39 OF 55 SHEETS

MUN	SECTION	COUNTY	TOTAL SHEETS	SHEET NO.
2090	2013-011R	COOK	356	171

CONTRACT NO. 60W29
ILLINOIS FED. AID PROJECT

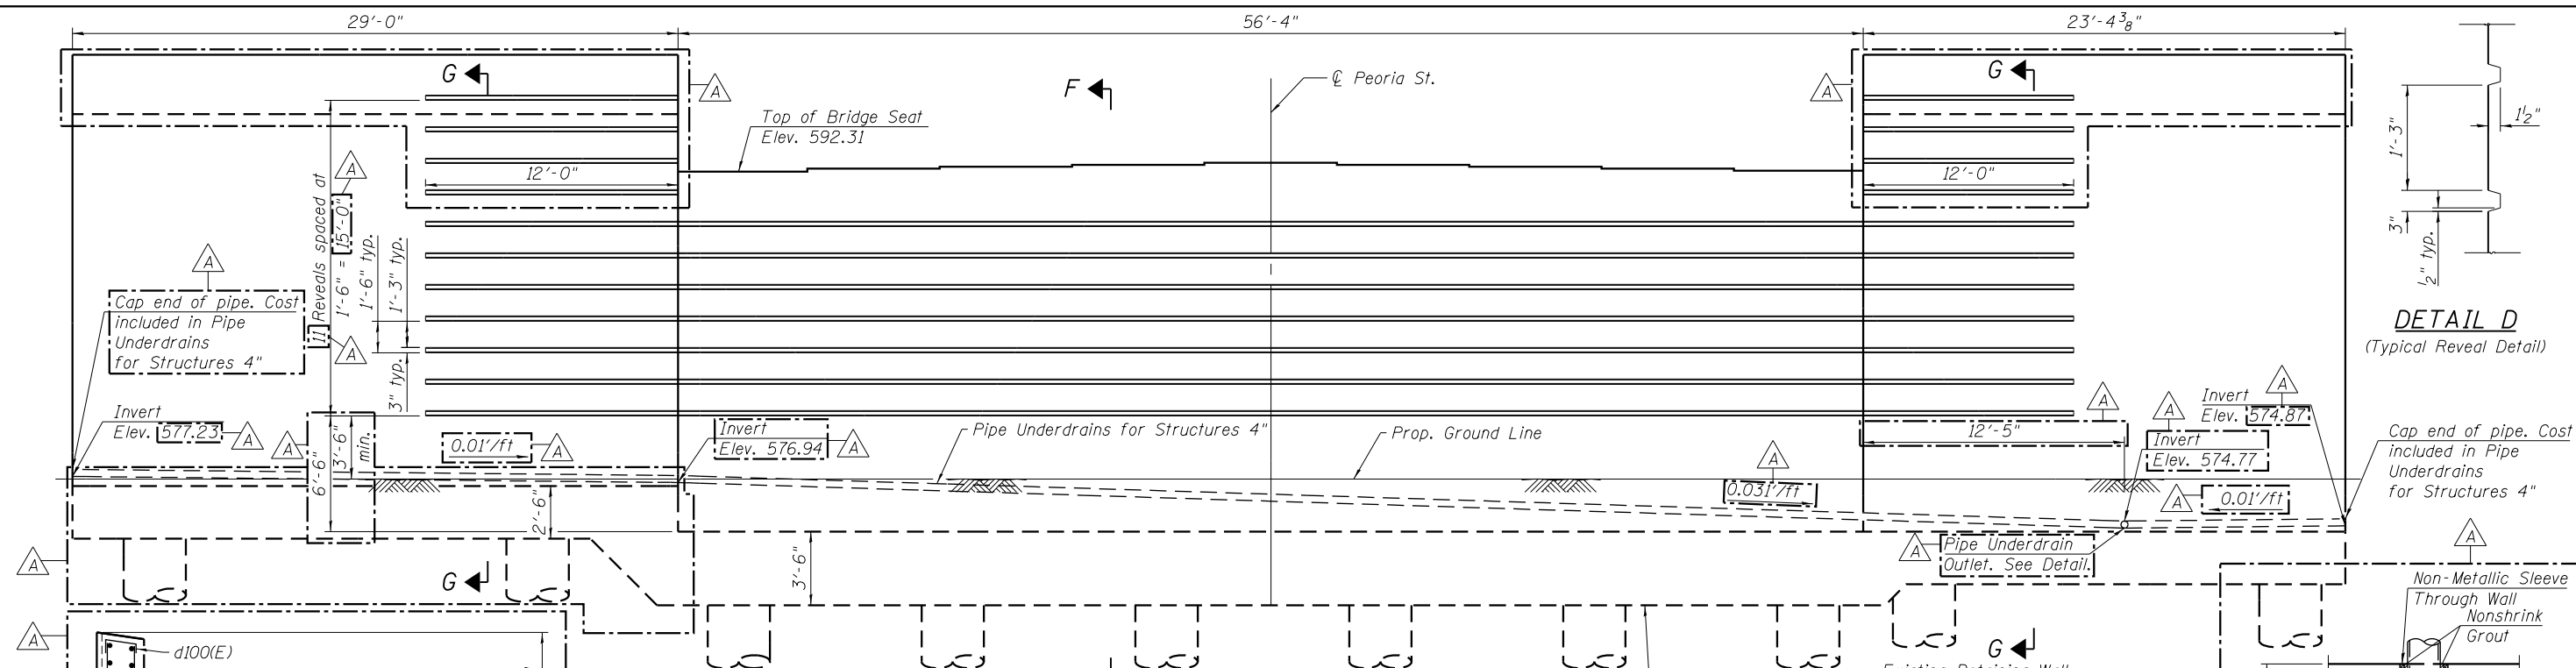


DETAIL D
(Typical Reveal Detail)

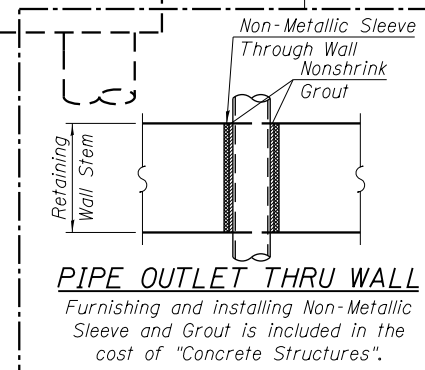

PIPE OUTLET THRU WALL
Furnishing and installing Non-Metallic Sleeve and Grout is included in the cost of "Concrete Structures".

SOUTH ABUTMENT ELEVATION - ARCHITECTURAL DETAILS

Note:
The 3" x 1 1/2" reveal will not be paid separately and shall be included in the cost of the pay item "Concrete Structures".

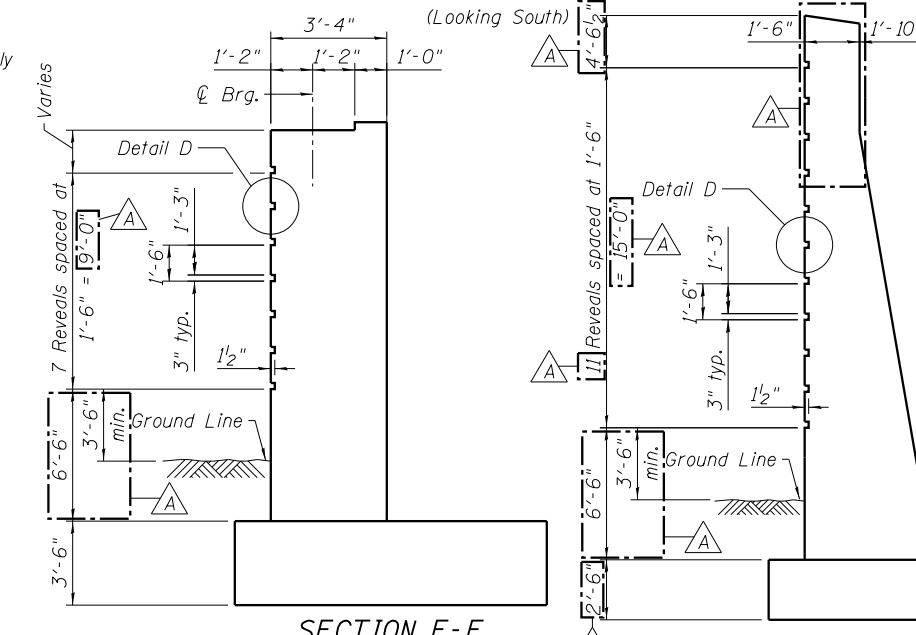


SECTION F-F

SECTION G-G


DETAIL E
Fabric Reinforced Elastomeric Mat according to Section 1028 of the Std. Specs. Fabric mat shall be 24" wide and attached full width and vertically at edges to the abutment cap with a 3/8" x 5" steel plate and 1/2" phi studs with nuts and washers at 12" cts. Cost included with Concrete Superstructure.

2" P.J.F. (per Article 1051.09 of the Standard Specifications) full width and vertically at edges bonded to abutment cap with suitable adhesive as recommended by supplier.

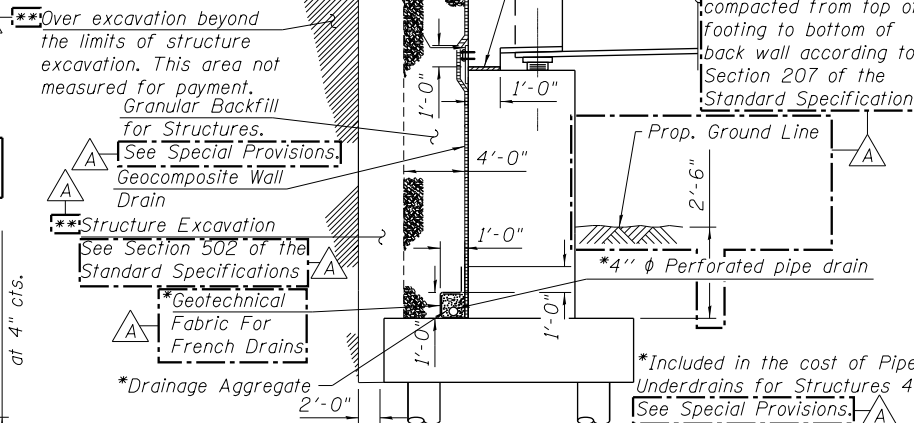


SECTION THRU ABUTMENT


All drainage system components shall extend to the end of each wingwall and an outlet pipe shall extend thru the Southwest wingwall. The pipe shall drain into Structure S-31.
*Included in the cost of Pipe Underdrains for Structures 4". [See Special Provisions.]

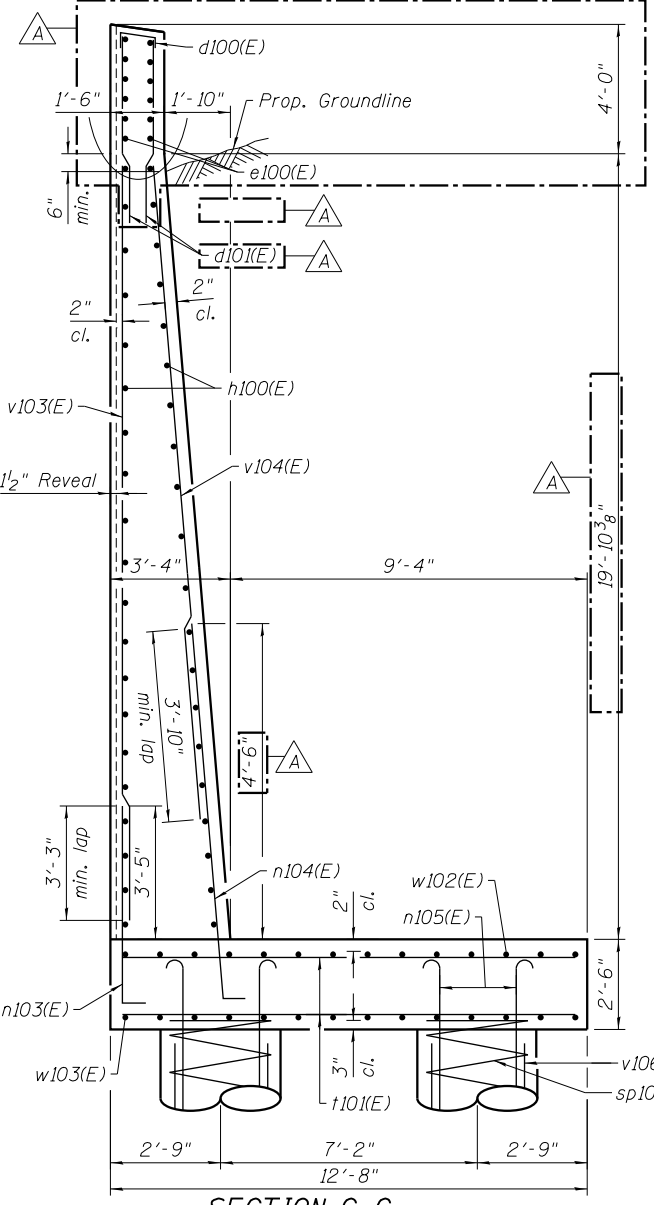

SECTION C-C

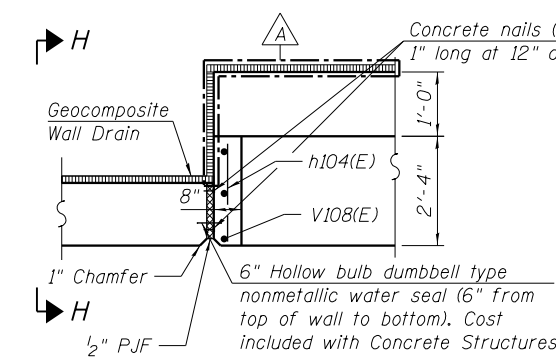

DETAIL C
(East Wall shown, West wall opp. hand)

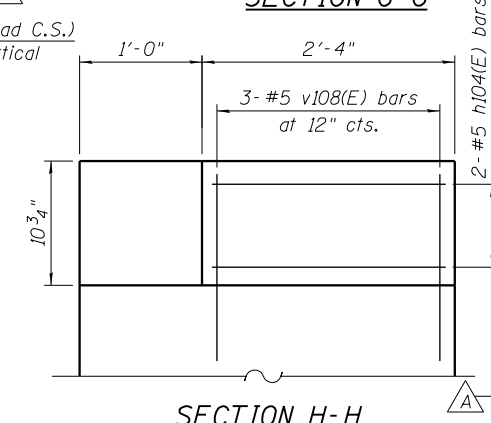

SECTION H-H

BILL OF MATERIAL

Item	Unit	Total
Pipe Underdrains for Structures 4"	Foot	120

9:54:52 AM 01/21/2014 01:17:05 - C:\B27\09\46\012\115\010\400\urmm\en\115\21\fige1.dwg 1:01:15:2.dgn






USER NAME = jrmickow	DESIGNED = JRM	REVISED = 1/20/2014 JRM/WJC
CHECKED = SAS	REVISIONS	
PLOT SCALE = 0x2.0000 '1" / in.	DRAWN = RLS	REVISIONS
PLOT DATE = 1/21/2014	CHECKED = WJC	REVISIONS

STATE OF ILLINOIS
DEPARTMENT OF TRANSPORTATION

SOUTH ABUTMENT DETAILS 2
STRUCTURE NO. 016-1708
SHEET NO. 40 OF 55 SHEETS

MUN	SECTION	COUNTY	TOTAL SHEETS	SHEET NO.
2090	2013-011R	COOK	356	172
CONTRACT NO.			60W29	
ILLINOIS FED. AID PROJECT				

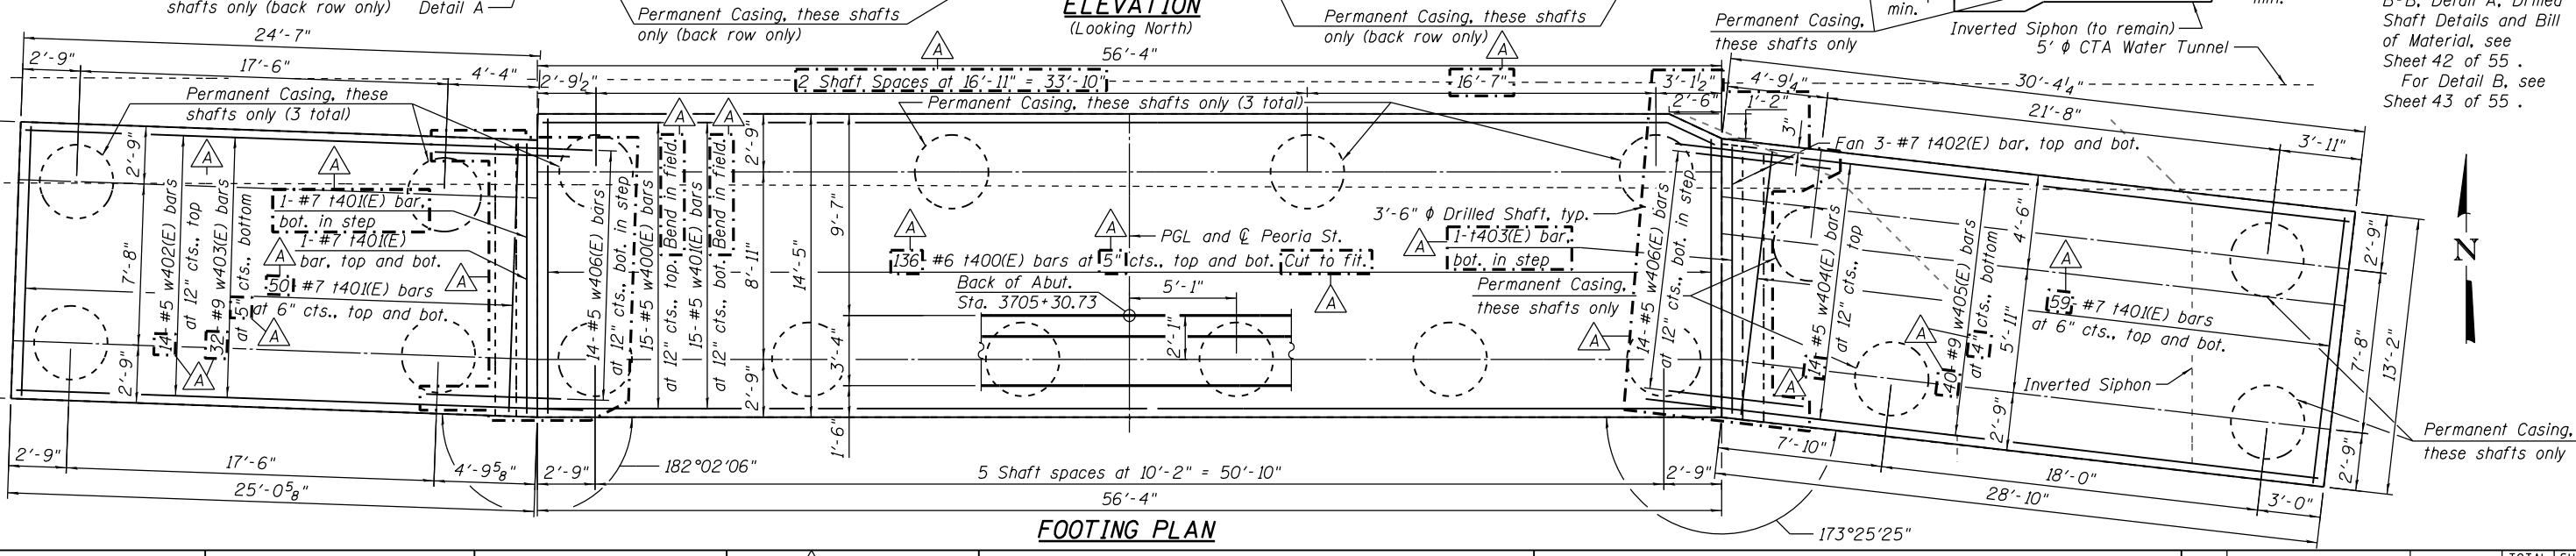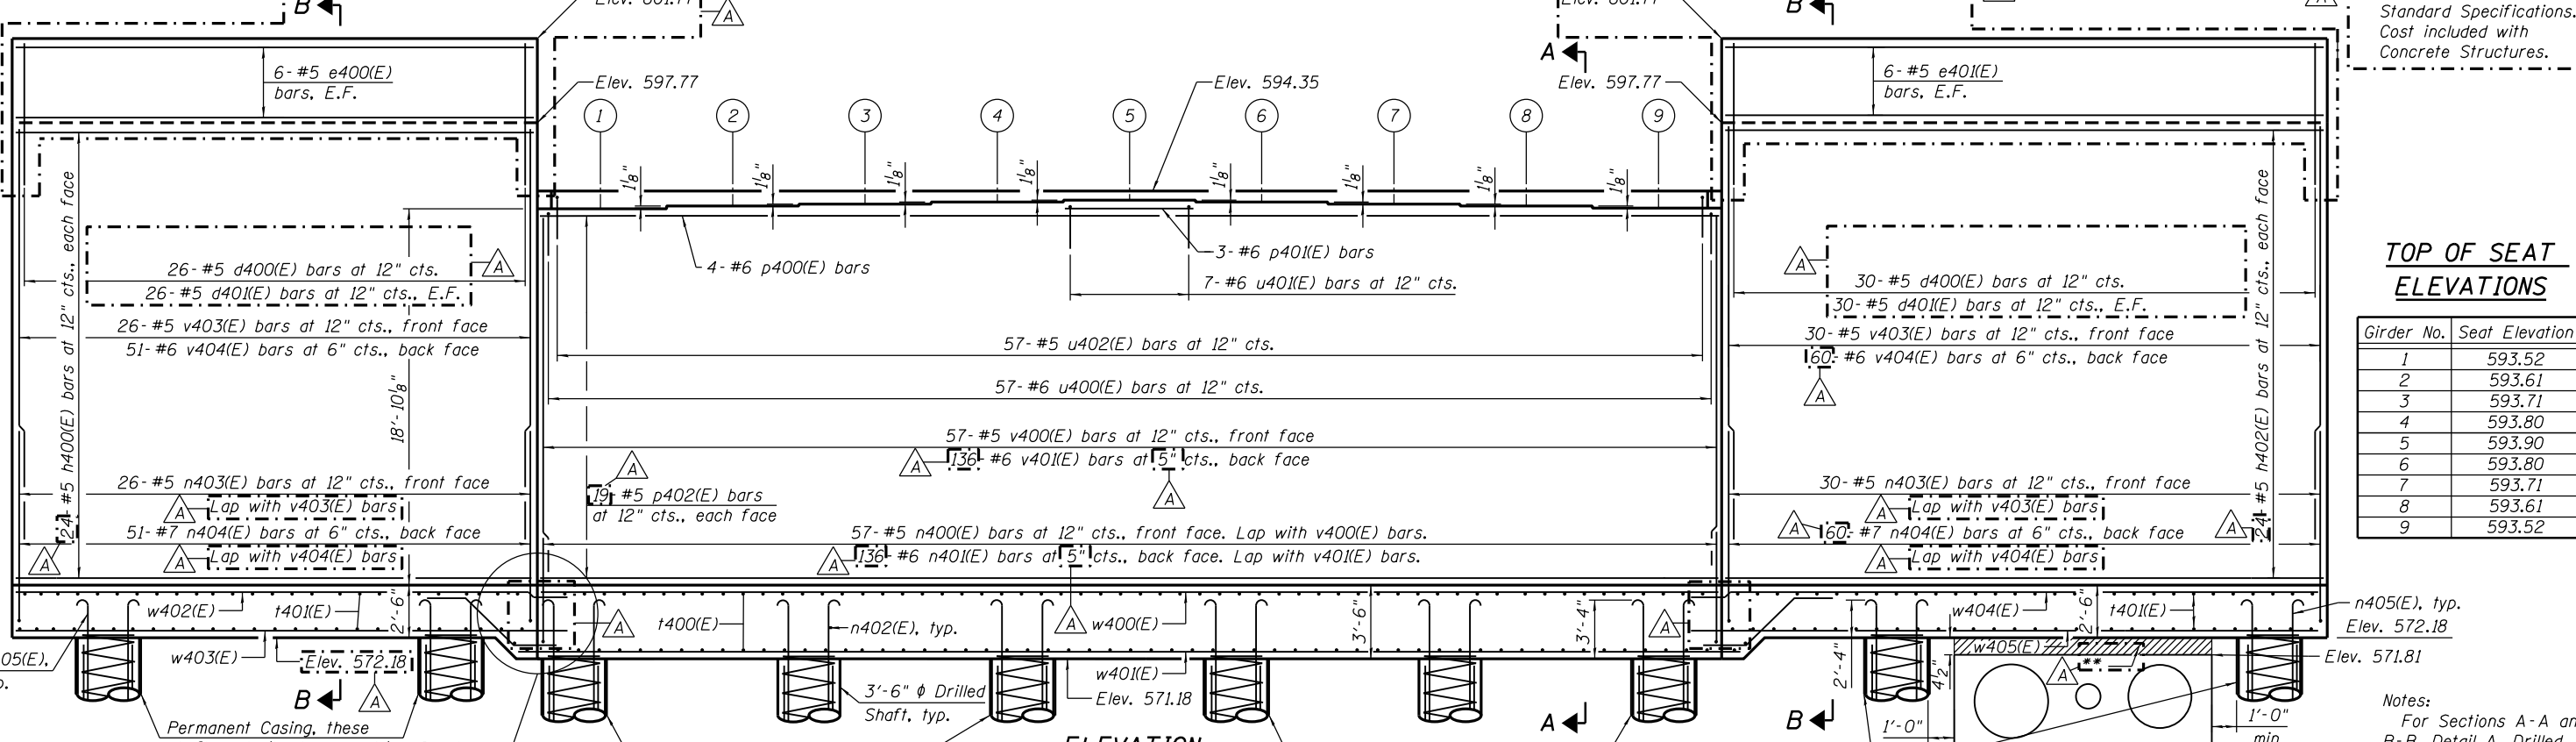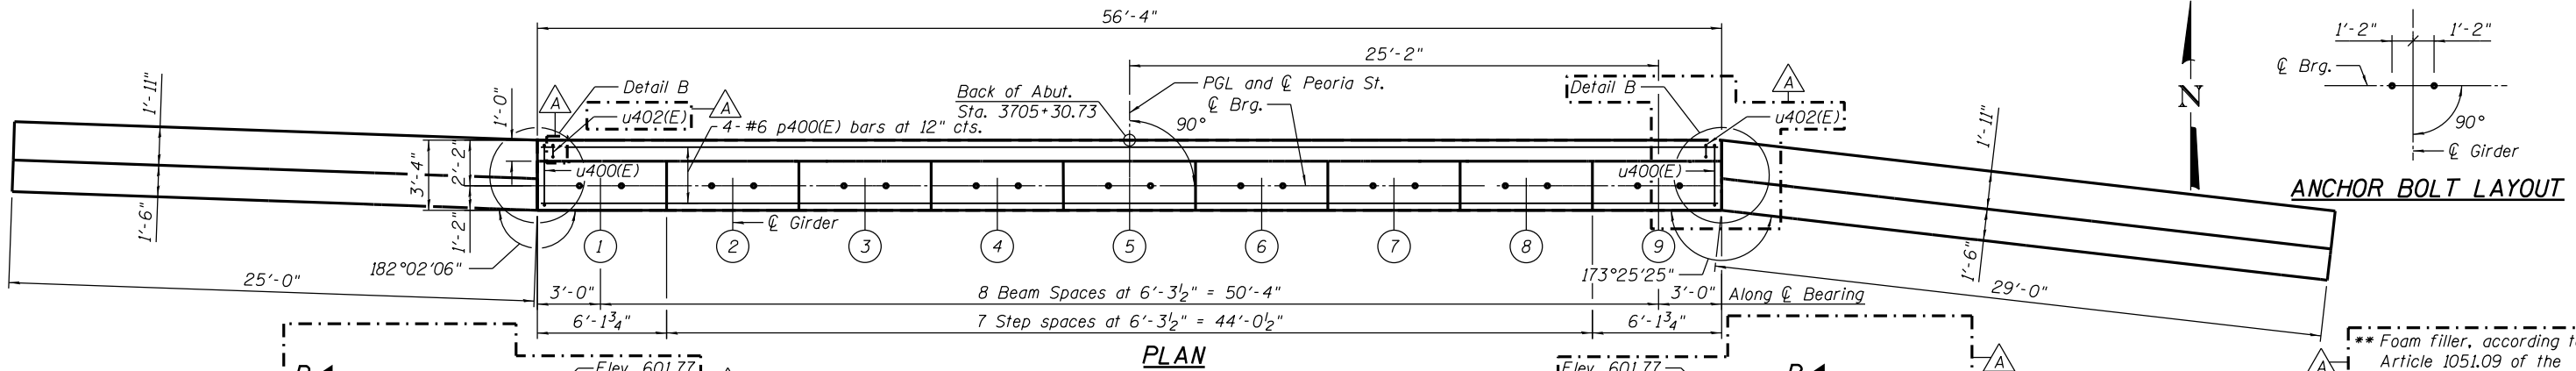

** Foam filler, according to Article 1051.09 of the Standard Specifications. Cost included with Concrete Structures.

TOP OF SEAT ELEVATIONS

Girder No.	Seat Elevation
1	593.52
2	593.61
3	593.71
4	593.80
5	593.90
6	593.80
7	593.71
8	593.61
9	593.52

Notes:
For Sections A-A and B-B, Detail A, Drilled Shaft Details and Bill of Material, see Sheet 42 of 55.
For Detail B, see Sheet 43 of 55.

1:46:52 PM 01/21/2014 6:02:29 - 5041-Abutment_Nor.thp&E.dgn




USER NAME = kahastings	DESIGNED JRM	REVISED A 1/20/2014 JRM/WJC
PLOT SCALE = 8:0 ' / in.	CHECKED SAS	REVISED
PLOT DATE = 1/21/2014	DRAWN MTS	REVISED
	CHECKED WJC	REVISED

**STATE OF ILLINOIS
DEPARTMENT OF TRANSPORTATION**

**NORTH ABUTMENT PLAN AND ELEVATION
STRUCTURE NO. 016-1708**


SHEET NO. 41 OF 55 SHEETS

MUN 2090	SECTION 2013-011R	COUNTY COOK	TOTAL SHEETS 356	SHEET NO. 173
CONTRACT NO. 60W29			ILLINOIS FED. AID PROJECT	

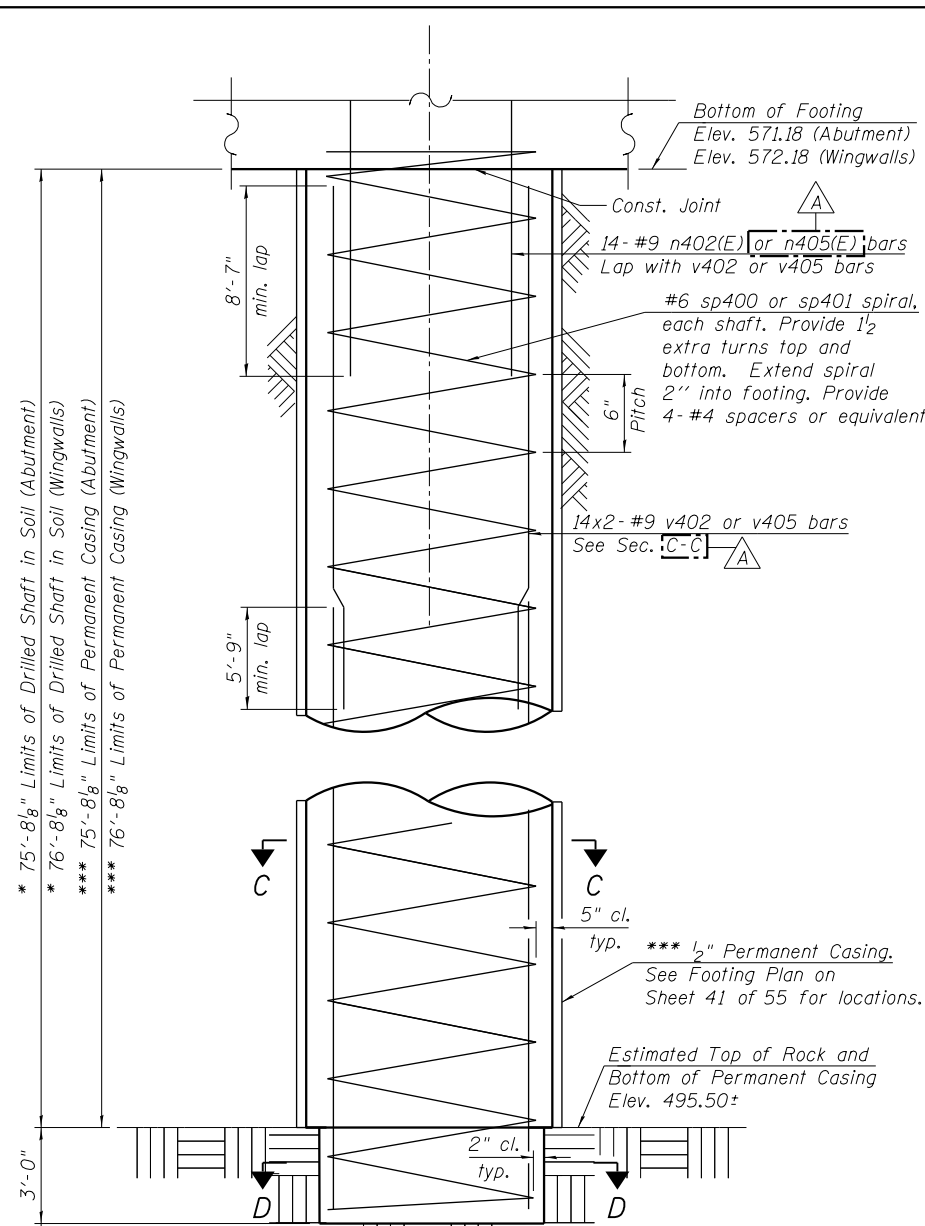

DRILLED SHAFT ELEVATION

Minimum Bar Laps	
Bar	Lap
#4	2'-7"
#5	3'-3"
#6	3'-10"
#7	5'-2"
#9	8'-7"
#6 Spiral	3'-0"

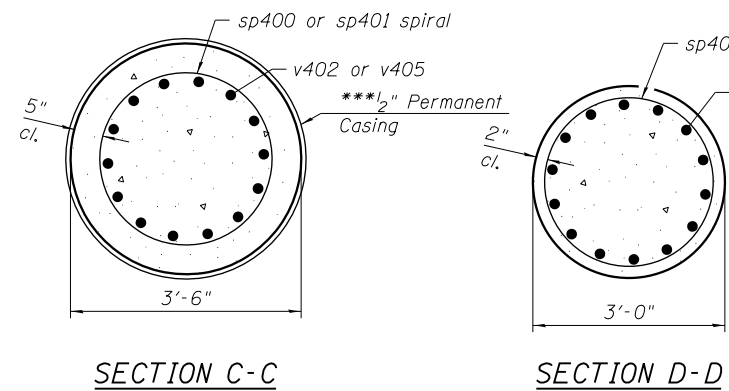


Notes:

Apply Concrete Sealer to all exposed concrete surfaces of the abutment and wingwalls. Pour steps monolithically with cap.

Space p400(E), u400(E) and u401(E) bars to miss anchor bolts.

* The quantities and detailing are based on the estimated elevations shown on the plans. The actual elevations may differ at each shaft and corresponding adjustments shall be made to the drilled shaft and reinforcement quantities and payment limits.

*** Contractor may need to increase the casing thickness to withstand the installation process. The Estimated Top of Rock/Bottom of Permanent Casing Elevation is shown. The limits of the casing shall be adjusted as necessary, and as approved, such that the actual installed casing length extends to the as-encountered top of rock at each shaft. See Article 516.06(d) of the Standard Specifications.

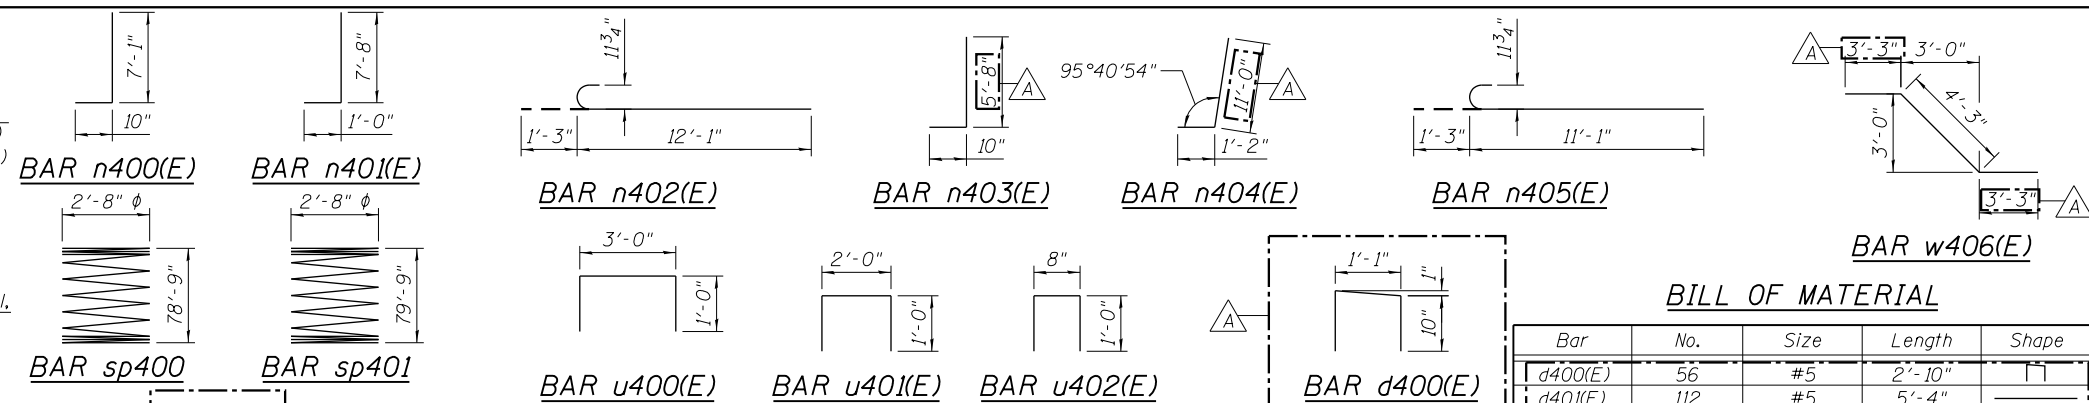



BILL OF MATERIAL

Bar	No.	Size	Length	Shape
d400(E)	56	#5	2'-10"	
d401(E)	112	#5	5'-4"	
e400(E)	12	#5	24'-8"	
e401(E)	12	#5	28'-8"	
h400(E)	48	#5	24'-8"	
h402(E)	48	#5	28'-8"	
h404(E)	4	#5	2'-0"	
n400(E)	57	#5	7'-11"	
n401(E)	136	#6	8'-8"	
n402(E)	140	#9	13'-4"	
n403(E)	56	#5	6'-6"	
n404(E)	111	#7	12'-2"	
n405(E)	112	#9	12'-4"	
p400(E)	4	#6	56'-0"	
p401(E)	3	#6	5'-11"	
p402(E)	38	#5	56'-0"	
sp400	10	#6	78'-9"	
sp401	8	#6	79'-9"	
t400(E)	272	#6	14'-1"	
t401(E)	221	#7	12'-10"	
t402(E)	6	#7	12'-11"	
t403(E)	1	#7	12'-8"	
u400(E)	57	#6	5'-0"	
u401(E)	7	#6	4'-0"	
u402(E)	57	#5	2'-8"	
v400(E)	57	#5	18'-6"	
v401(E)	136	#6	18'-6"	
v402	280	#9	42'-1"	
v403(E)	56	#5	22'-9"	
v404(E)	111	#6	18'-0"	
v405	224	#9	42'-7"	
v406(E)	6	#5	1'-7"	
w400(E)	15	#5	56'-0"	
w401(E)	15	#5	58'-0"	
w402(E)	14	#5	27'-0"	
w403(E)	32	#9	29'-11"	
w404(E)	14	#5	32'-4"	
w405(E)	40	#9	35'-3"	
w406(E)	28	#5	10'-9"	

Structure Excavation	Cu. Yd.	1638
Concrete Structures	Cu. Yd.	420.3
Concrete Superstructure	Cu. Yd.	11.7
Reinforcement Bars	Pound	108,440
Reinforcement Bars, Epoxy Coated	Pound	55,740
Permanent Casing	Foot	763
Drilled Shaft in Soil	Cu. Yd.	488.3
Drilled Shaft in Rock	Cu. Yd.	14.3
Concrete Sealer	Sq. Ft.	2062
Geocomposite Wall Drain	Sq. Yd.	259
Granular Backfill for Structures	Cu. Yd.	339

Bars indicated thus, 1x15-#5 etc., indicates 1 line of bars with 15 lengths per line.

** Length is height of spiral.

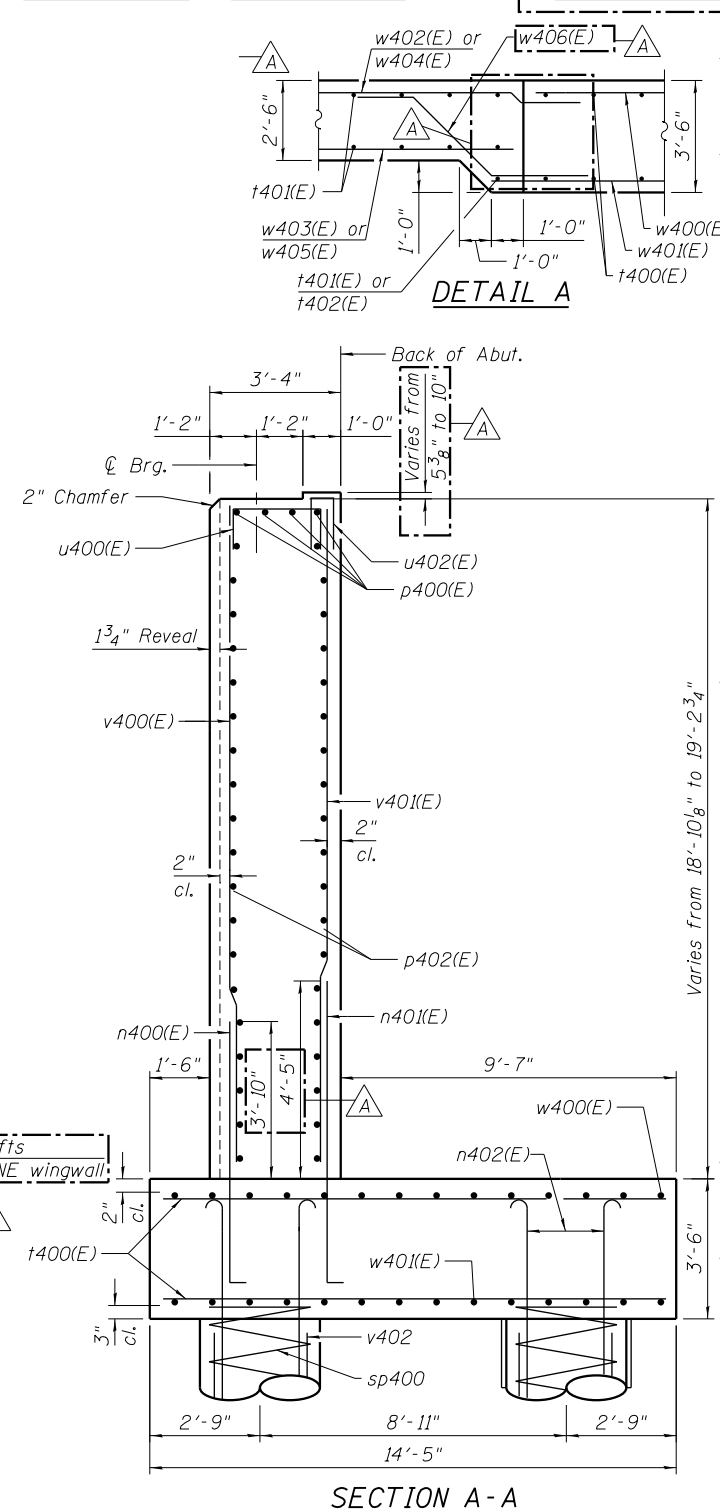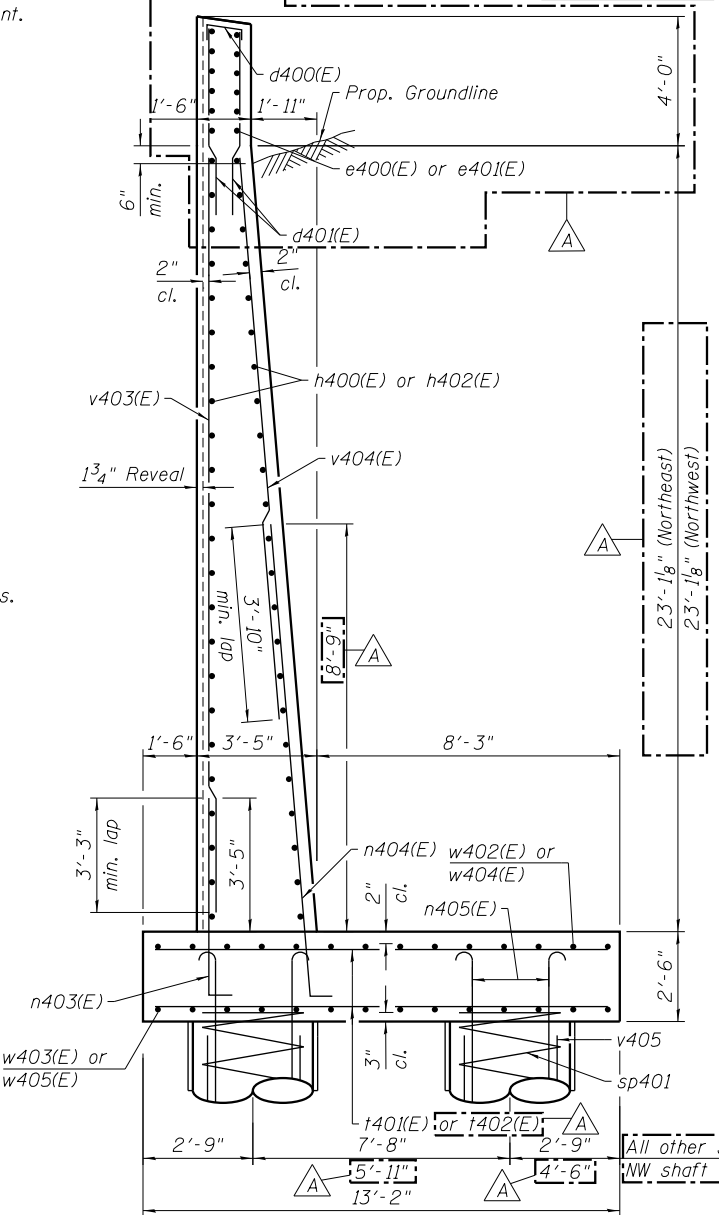

SECTION A-A

STATE OF ILLINOIS
DEPARTMENT OF TRANSPORTATION

NORTH ABUTMENT DETAILS 1
STRUCTURE NO. 016-1708

SHEET NO. 42 OF 55 SHEETS


MUN	SECTION	COUNTY	TOTAL SHEETS	SHEET NO.
2090	2013-011R	COOK	356	174
CONTRACT NO.			60W29	

ILLINOIS FED. AID PROJECT

9:54:54 AM 0161708-60W29-5042-Abutment_NorthDetails1.dgn



USER NAME = jrmickow	DESIGNED JRM	REVISED A 1/20/2014 JRM
	CHECKED SAS	REVISED
PLOT SCALE = 0x2.0000 '1" / in.	DRAWN RLS	REVISED
PLOT DATE = 1/21/2014	CHECKED WJC	REVISED

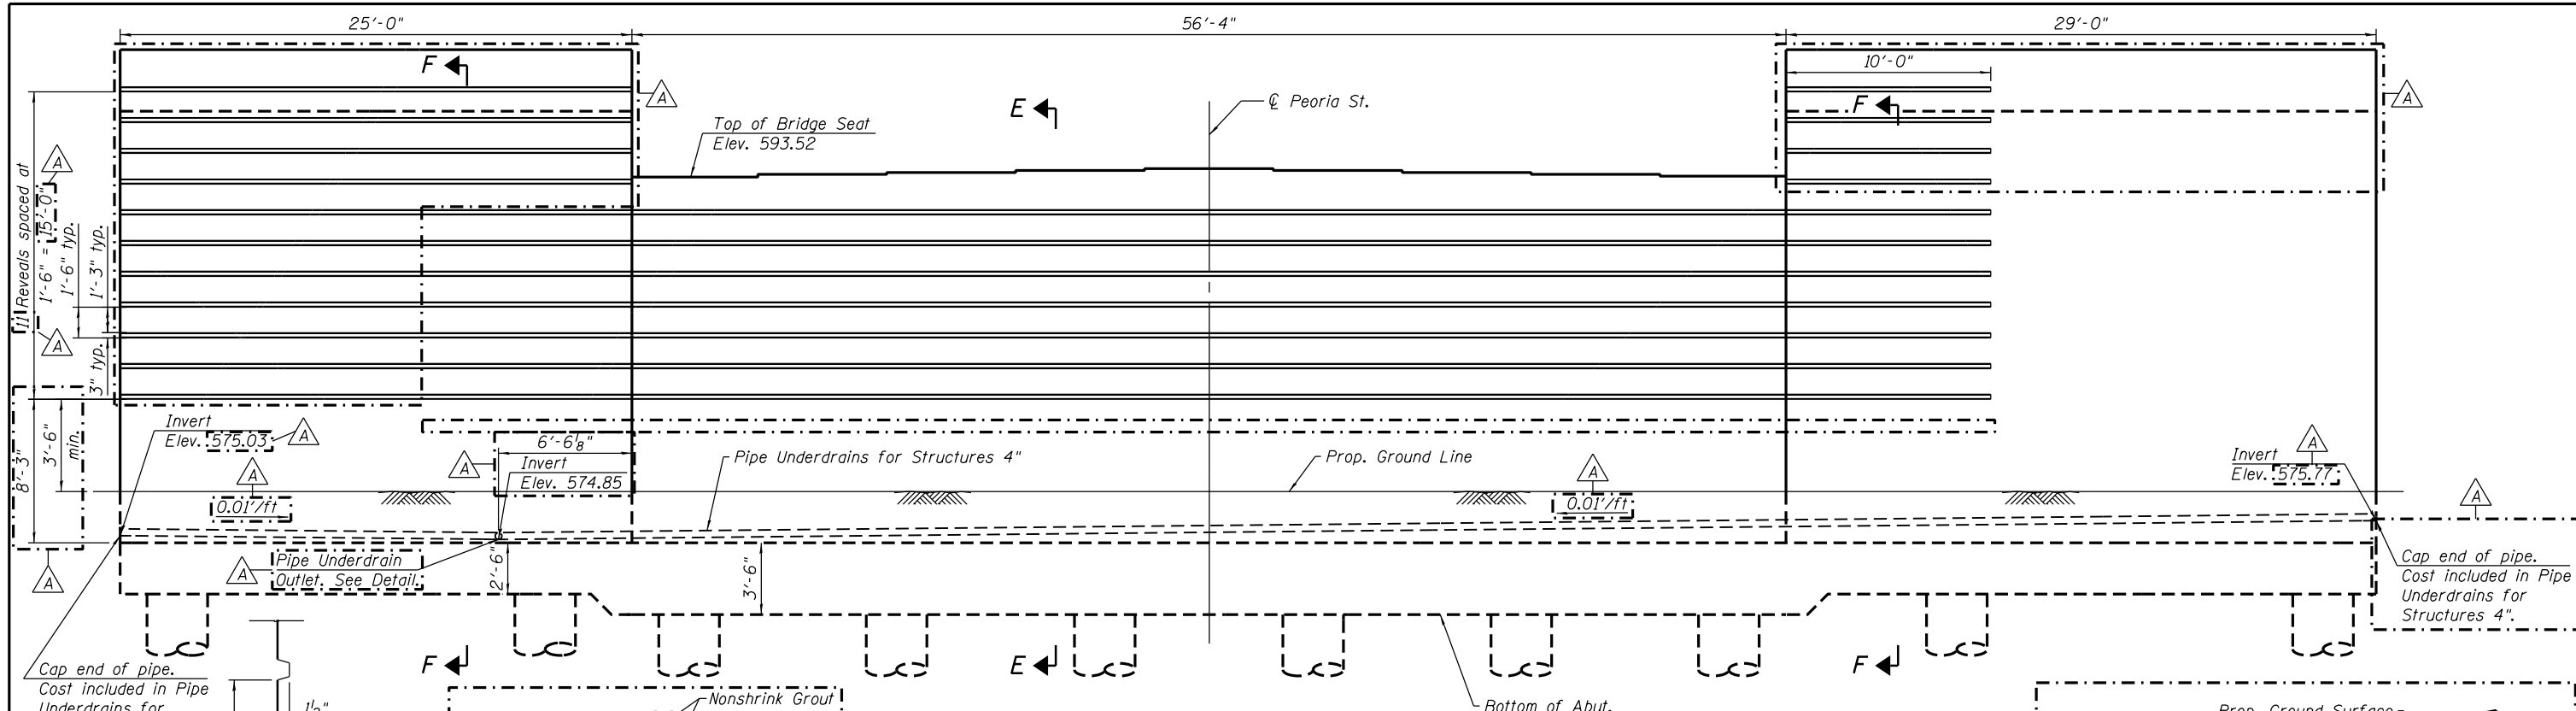

NORTH ABUTMENT ELEVATION - ARCHITECTURAL DETAILS

(Looking North)

Note:
The 3" x 1/2" reveal will not be paid separately and shall be included in the cost of the pay item "Concrete Structures".

Fabric Reinforced Elastomeric Mat according to Section 1028 of the Std. Specs. Fabric mat shall be 24" wide and attached full width and vertically at edges to the abutment cap with a 3/8" x 5" steel plate and 1/2" φ studs with nuts and washers at 12" cts. Cost included with Concrete Superstructure.

2" PJF (per Article 1051.09 of the Standard Specifications) full width and vertically at edges bonded to abutment cap with suitable adhesive as recommended by supplier.

Note:
Granular Backfill for Structures shall be compacted from top of backfill to bottom of back wall according to Section 207 of the Standard Specifications.

**Over excavation beyond the limits of structure excavation. This area not measured for payment.

Granular Backfill For Structures. See Special Provisions.

**Structure Excavation See Section 502 of the Standard Specifications.

Geotechnical Fabric For French Drains

*Drainage Aggregate


*Included in the cost of Pipe Underdrains for Structures 4". See Special Provisions.

**Backfill remainder of Structure Excavation and Over Excavation with same material specified for Roadway Embankment.


All drainage system components shall extend to the end of each wingwall and an outlet pipe shall extend thru the Northwest wingwall. The pipe shall drain into the existing structure at Sta. 345+37.80, offset 35.40' LT.

PIPE OUTLET THRU WALL


Furnishing and installing Non-Metallic Sleeve and Grout is included in the cost of "Concrete Structures".

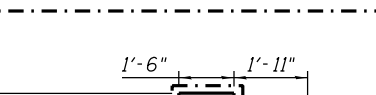

DETAIL C
(Typical Reveal Detail)

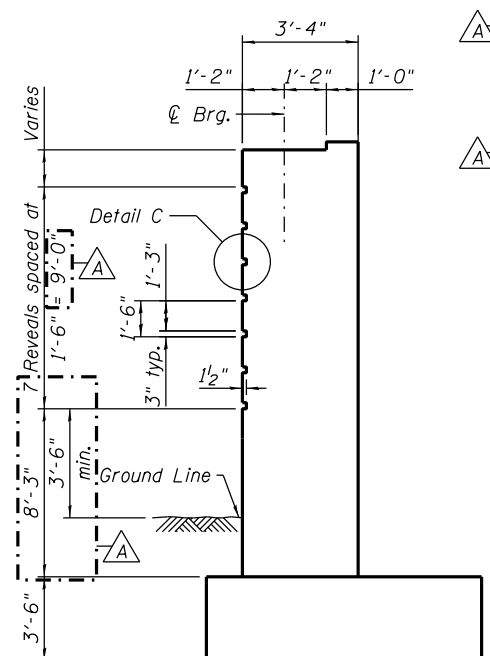


SECTION E-E

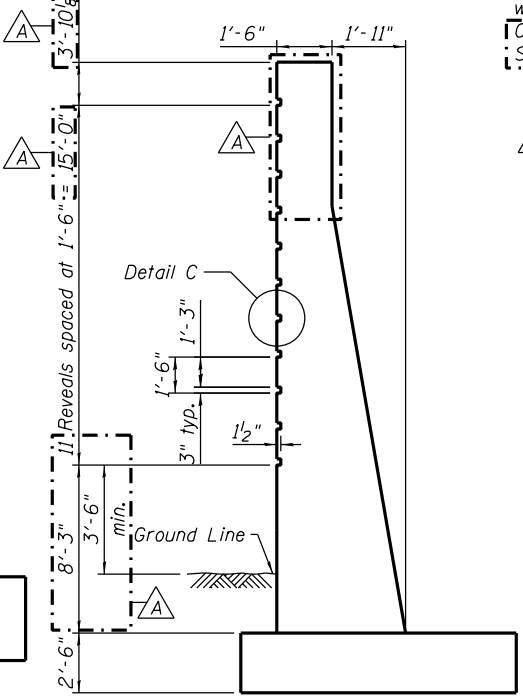


SECTION F-F

SECTION THRU ABUTMENT

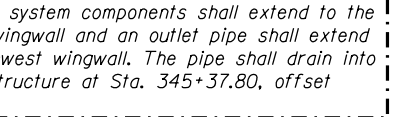


SECTION THRU ABUTMENT

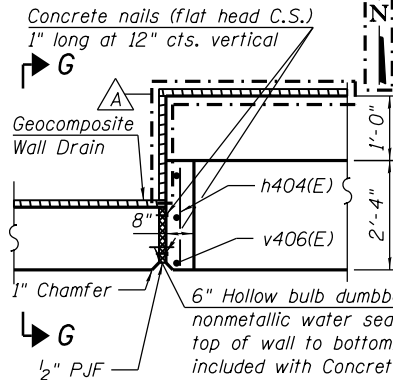


DETAIL B

(West Wall shown, East wall opp. hand)

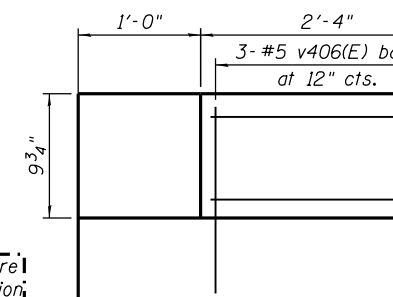

SECTION G-G

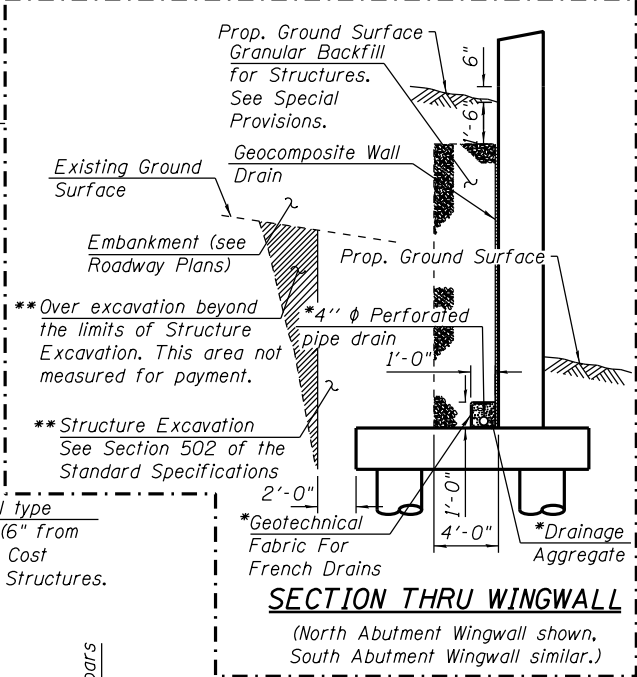

SECTION THRU WINGWALL

(North Abutment Wingwall shown, South Abutment Wingwall similar.)

BILL OF MATERIAL

Item	Unit	Total
Pipe Underdrains for Structures 4"	Foot	147

1:48:17 PM 0161708-60W29-5043-Abutment_NorthDetails2.dgn




USER NAME = kahastings	DESIGNED JRM	REVISION A 1/20/2014 JRM/WJC
PLOT SCALE = 0:2.0000 '1" / 1"	CHECKED SAS	REVISION
PLOT DATE = 1/21/2014	DRAWN RLS	REVISION
	CHECKED WJC	REVISION

STATE OF ILLINOIS
DEPARTMENT OF TRANSPORTATION


NORTH ABUTMENT DETAILS 2
STRUCTURE NO. 016-1708
SHEET NO. 43 OF 55 SHEETS

MUN 2090	SECTION 2013-011R	COUNTY COOK	TOTAL SHEETS 356	SHEET NO. 175
CONTRACT NO. 60W29				


ILLINOIS FED. AID PROJECT

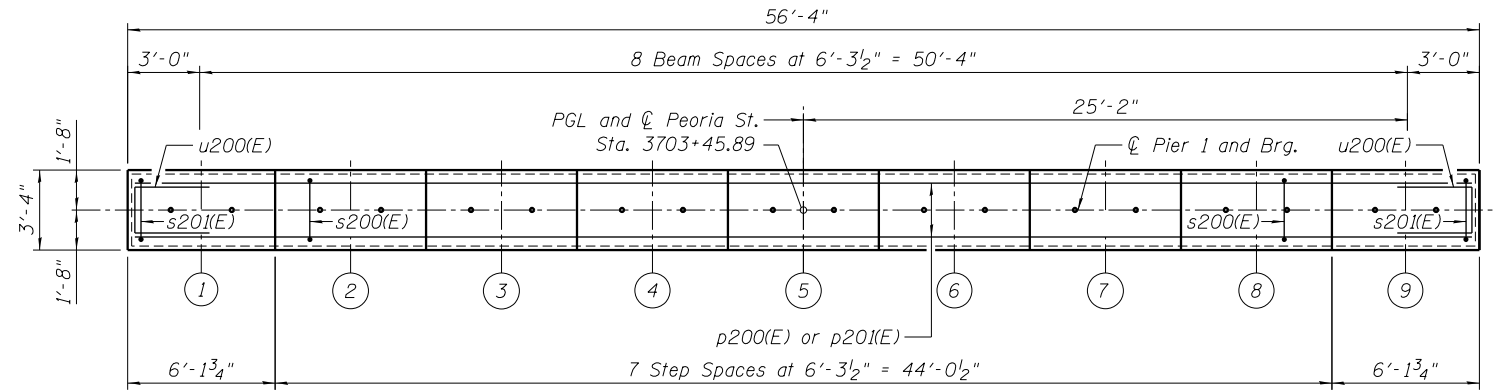


TOP PLAN

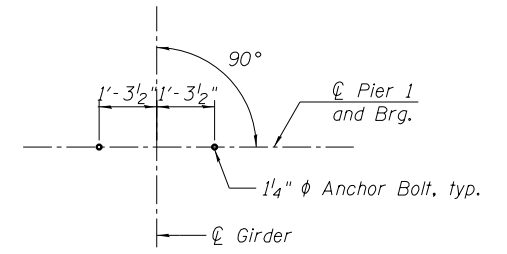

ANCHOR BOLT LAYOUT

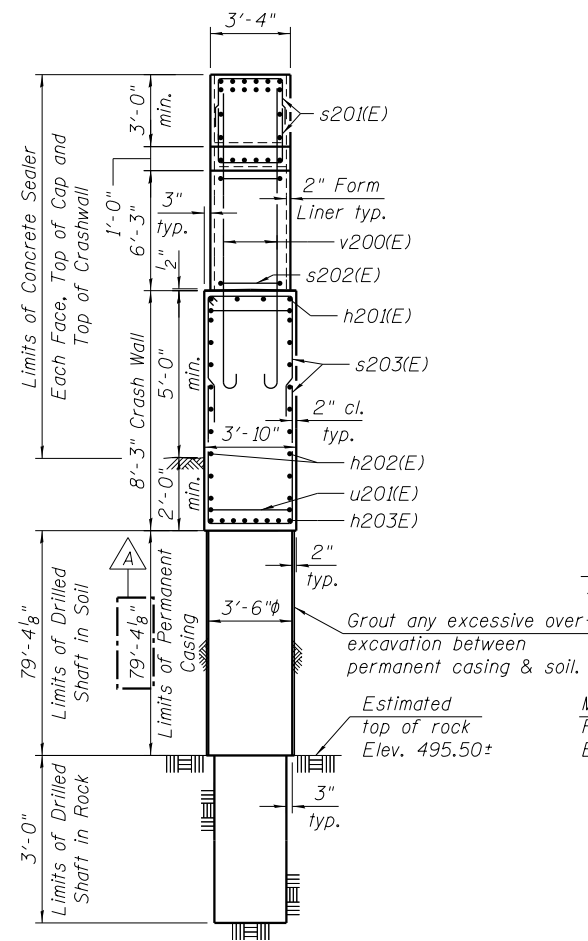

END VIEW

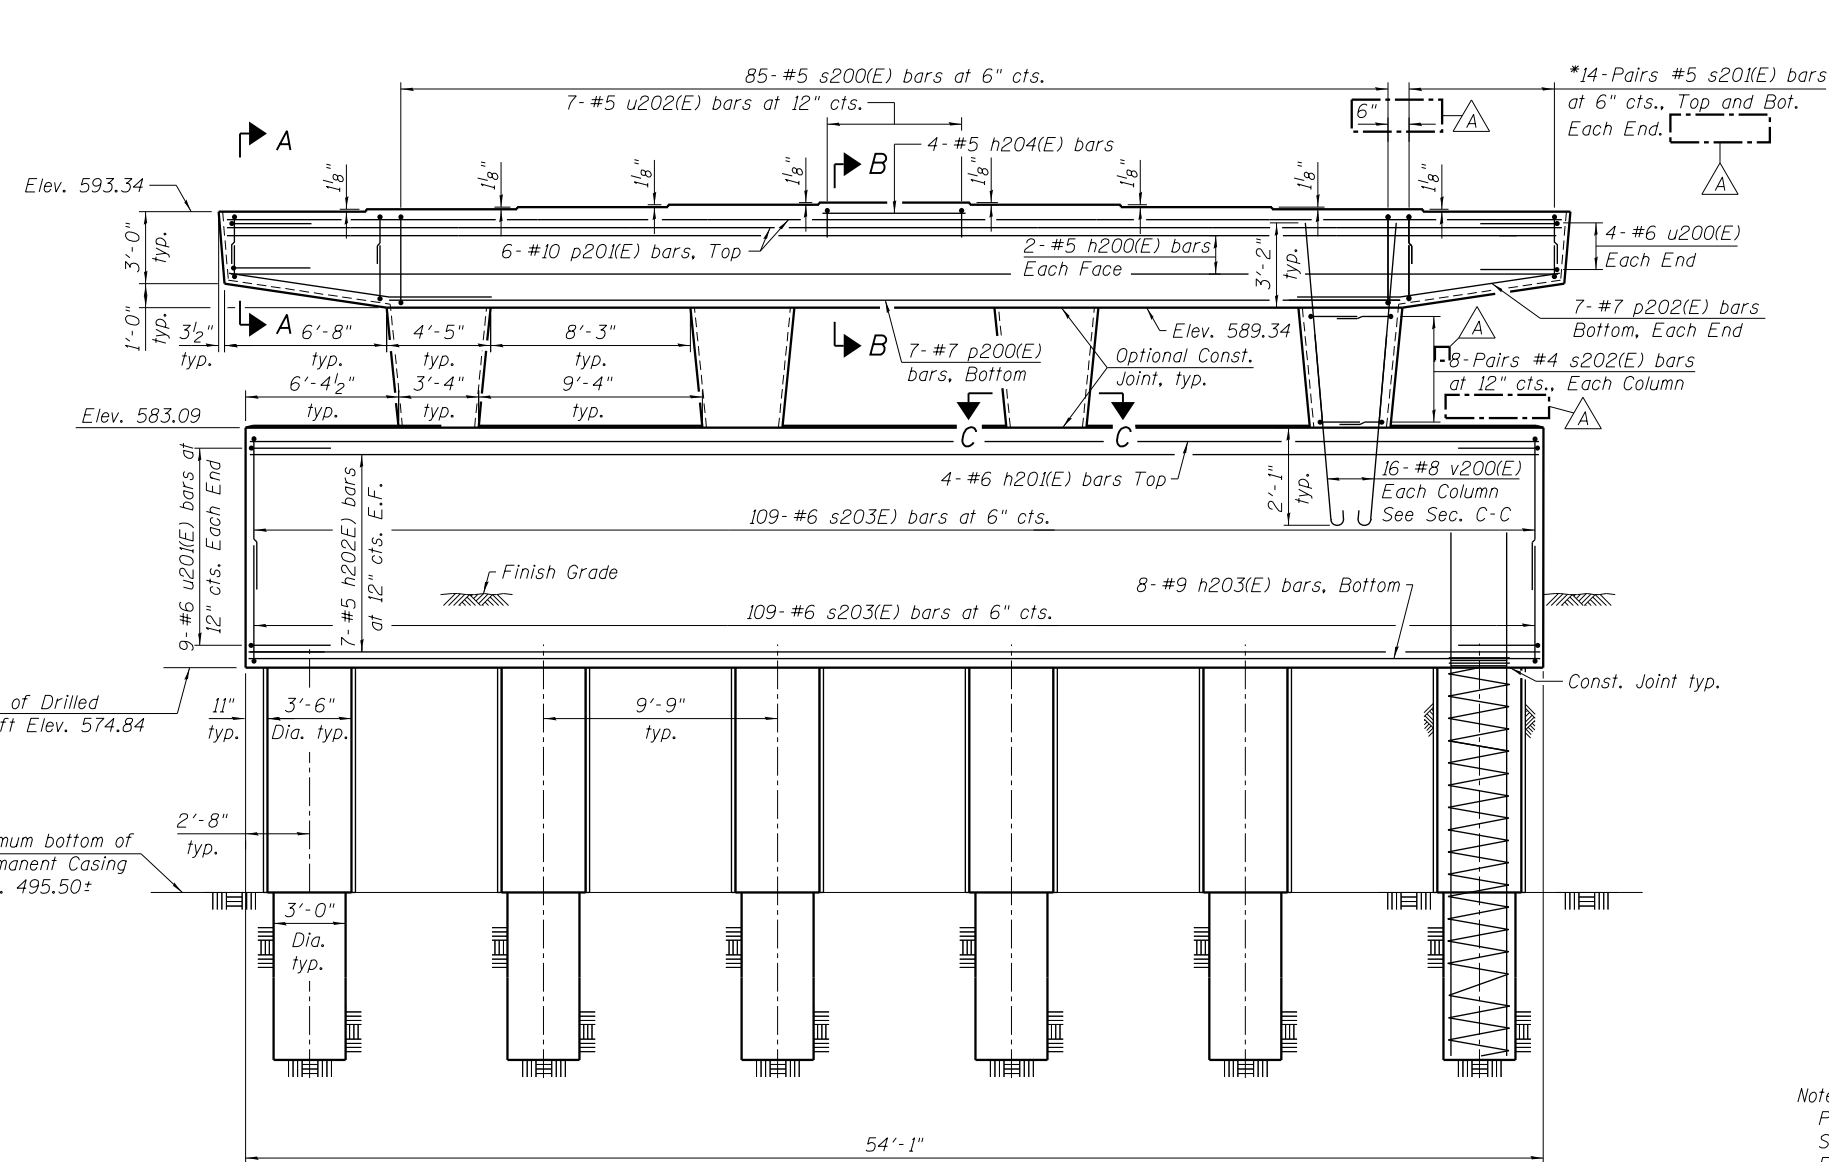

ELEVATION
(Looking North)

* Cut vertical legs of bar to fit. Min. lap is 2'-7" for #5 bars.

TOP OF SEAT ELEVATION

Girder No.	Seat Elevation
1	593.34
2	593.44
3	593.53
4	593.63
5	593.72
6	593.63
7	593.53
8	593.44
9	593.34

Notes:
 Pour steps monolithically with cap.
 Space reinforcement in cap to miss anchor bolts.
 For Sections A-A, B-B, and C-C, Drilled Shaft Details and Bill of Material, see sheet 45 of 55.

12:49:10 PM 01/16/17 08-60W29-5044-Pier1_P&E.dgn



USER NAME = jrmickow	DESIGNED JRM	REVISED A 12/18/2013 JRM/KAH
PLOT SCALE = 8x0.0009 'x' / in.	CHECKED KAH	REVISED
PLOT DATE = 1/8/2014	DRAWN RLS	REVISED
	CHECKED KAH	REVISED

STATE OF ILLINOIS
DEPARTMENT OF TRANSPORTATION

PIER 1 PLAN AND ELEVATION
STRUCTURE NO. 016-1708

SHEET NO. 44 OF 55 SHEETS

MUN 2090	SECTION 2013-011R	COUNTY COOK	TOTAL SHEETS 356	SHEET NO. 176
CONTRACT NO. 60W29			ILLINOIS FED. AID PROJECT	


BILL OF MATERIAL

Bar	No.	Size	Length	Shape
h200(E)	4	#5	55'-2"	
h201(E)	4	#6	53'-9"	
h202(E)	14	#5	53'-9"	
h203(E)	8	#9	53'-9"	
h204(E)	4	#5	5'-11"	
p200(E)	7	#7	42'-1"	
p201(E)	12	#10	55'-8"	
p202(E)	14	#7	11'-11"	
s200(E)	85	#5	13'-7"	□
s201(E)	56	#5	9'-2"	□
s202(E)	64	#4	9'-2"	□
s203(E)	218	#6	15'-4"	□
sp200	6	#6	82'-5"	⊘
u200(E)	8	#6	10'-4"	□
u201(E)	18	#6	11'-2"	□
u202(E)	7	#5	4'-4"	□
v200(E)	64	#8	12'-6"	□
v201	168	#9	44'-0"	
v202(E)	84	#9	14'-6"	
Structure Excavation		Cu. Yd.	42	
Concrete Structures		Cu. Yd.	104.0	
Reinforcement Bars		Pound	37,600	
Reinforcement Bars, Epoxy Coated		Pound	20,530	
Permanent Casing		Foot	476	
Drilled Shaft in Soil		Cu. Yd.	169.8	
Drilled Shaft in Rock		Cu. Yd.	4.8	
Concrete Sealer		Sq. Ft.	1973	

Bars indicated thus 1x15 etc., indicates 1 line of bars with 15 lengths per line.

Notes:
 Apply concrete sealer to all exposed concrete surfaces of the pier.
 * The quantities and reinforcement detailing are based on the top of shaft and the estimated top of rock elevations shown and may change based on the actual top of rock encountered at each shaft and the final top of shaft elevation.
 ** Length is height of spiral.
 *** Contractor may need to increase the casing thickness to withstand the installation process. The Estimated Top of Rock/Bottom of Permanent Casing Elevation is shown. The limits of casing shall be adjusted as necessary, and as approved, such that the actual installed casing length extends to the as-encountered top of rock at each shaft. See Article 516.06(d) of the Standard Specifications.

Minimum Bar Laps	
Bar	Lap
#4	2'-7"
#5	3'-3"
#6	3'-10"
#7	5'-2"
#8	6'-9"
#9	8'-7"
#6 spiral	3'-0"

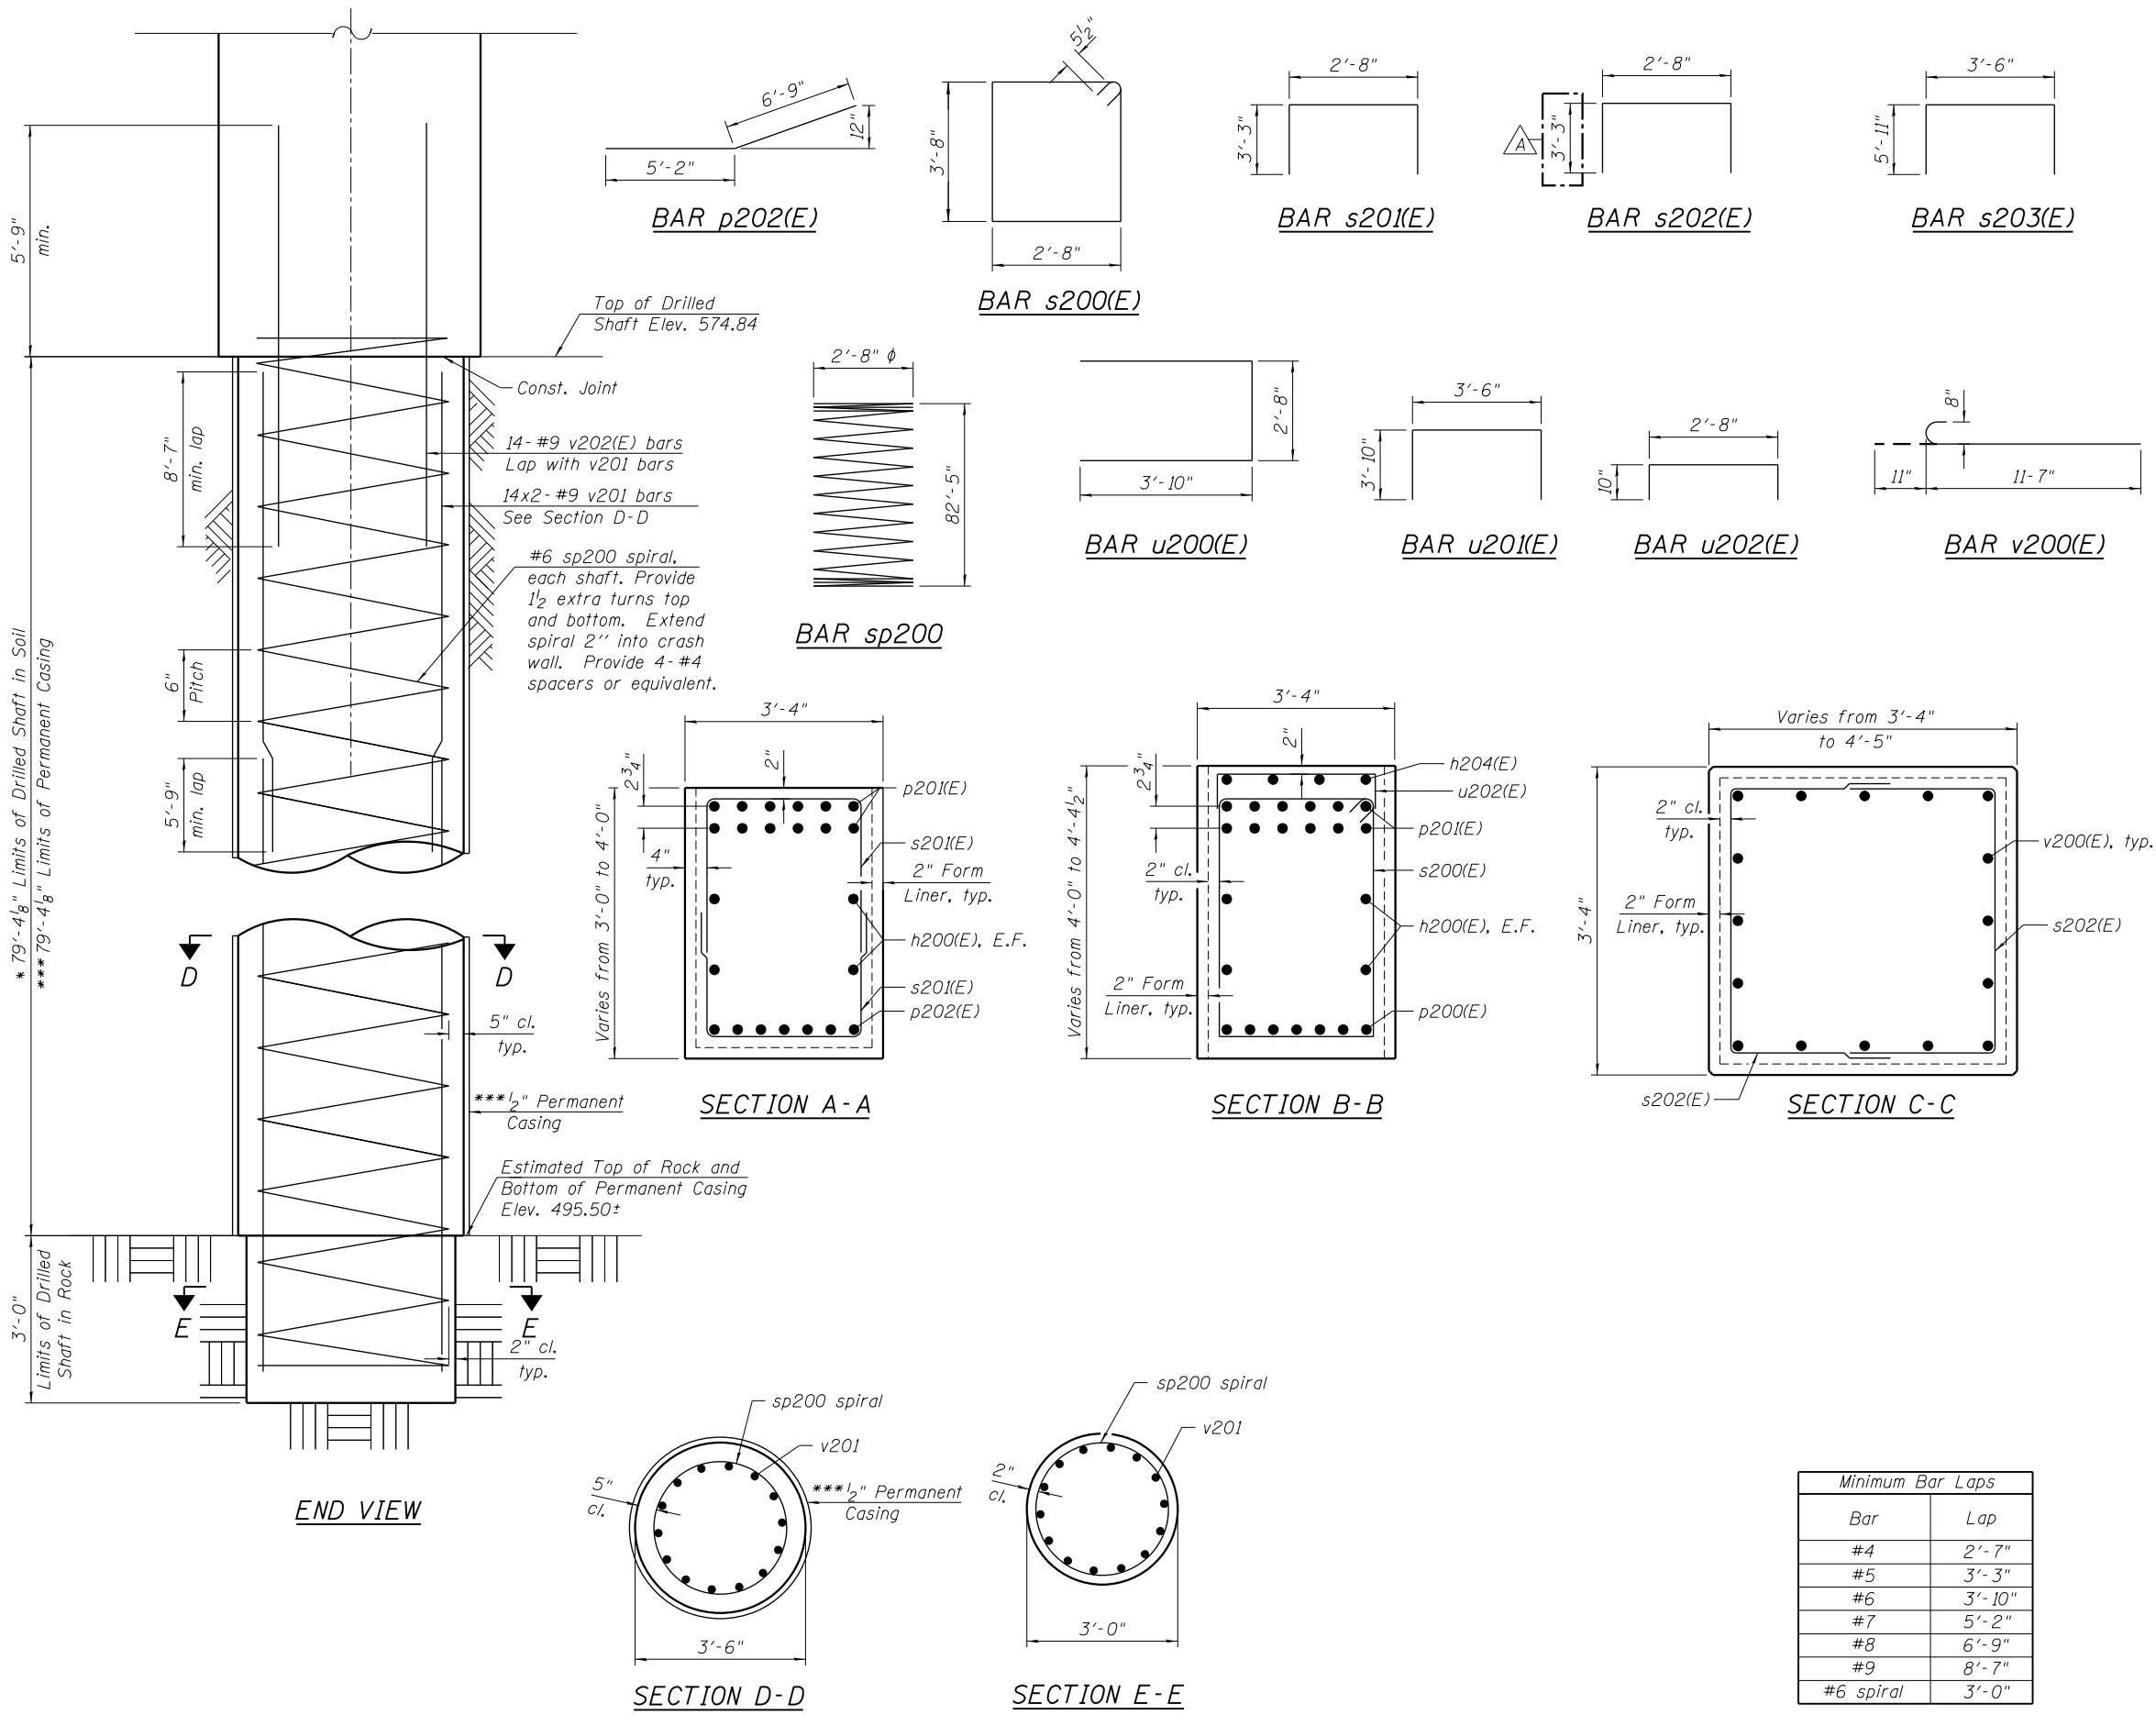

10:32:46 AM 0161708-60W29-5045-Pier1_Details.dgn














USER NAME = BAWItoft	DESIGNED JRM	REVISED 12/18/2013 JRM/KAH
CHECKED KAH	REVISION	
PLOT SCALE = 0x2.0000 '1" / in.	DRAWN RLS	REVISION
PLOT DATE = 12/19/2013	CHECKED KAH	REVISION

**STATE OF ILLINOIS
 DEPARTMENT OF TRANSPORTATION**

**PIER 1 DETAILS
 STRUCTURE NO. 016-1708**

SHEET NO. 45 OF 55 SHEETS


MUN 2090	SECTION 2013-011R	COUNTY COOK	TOTAL SHEETS 356	SHEET NO. 177
CONTRACT NO. 60W29			ILLINOIS FED. AID PROJECT	

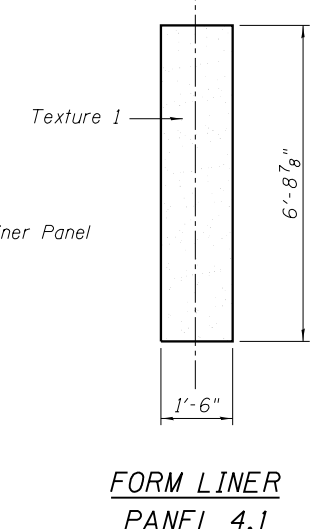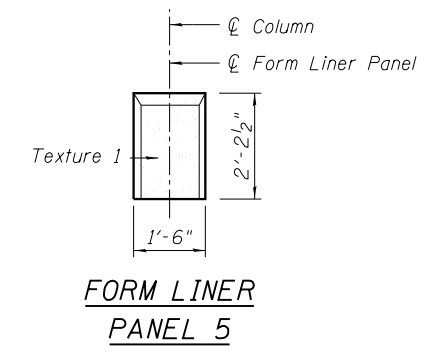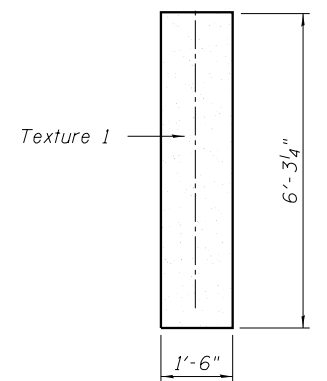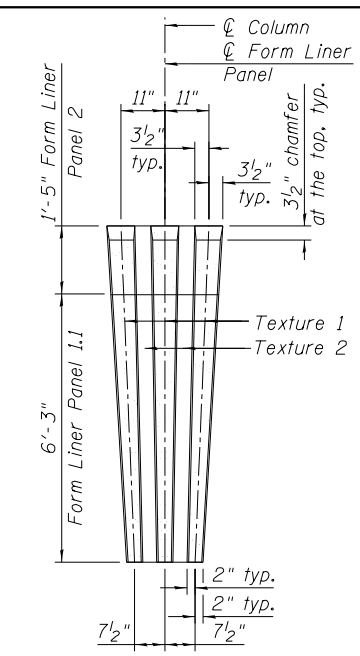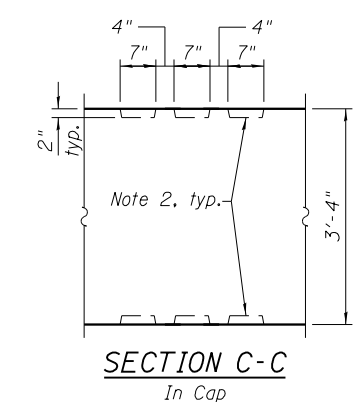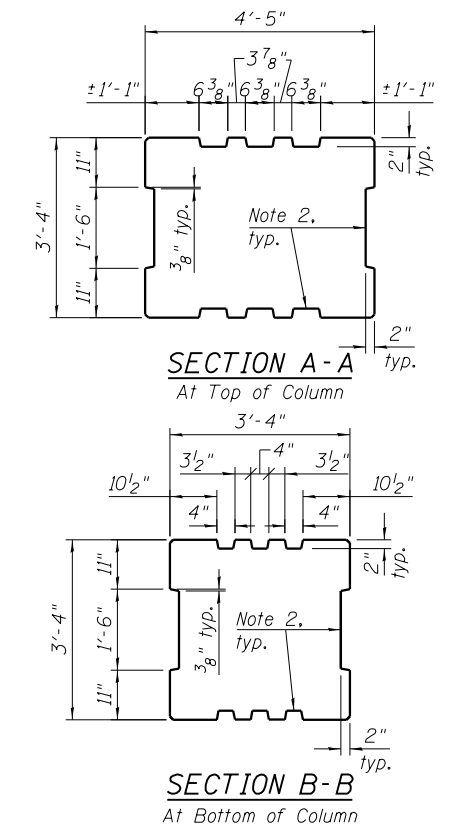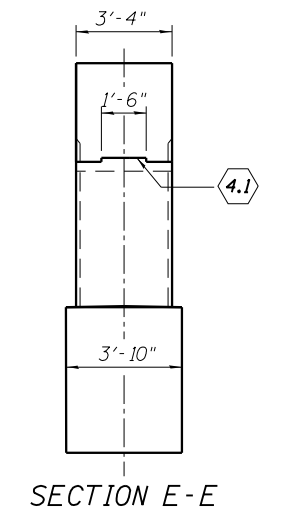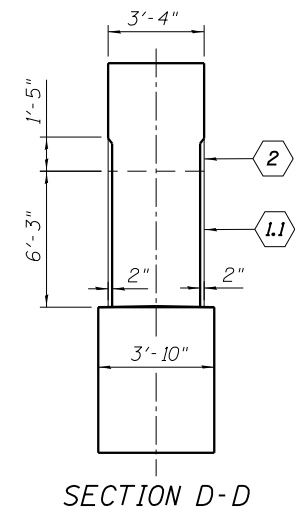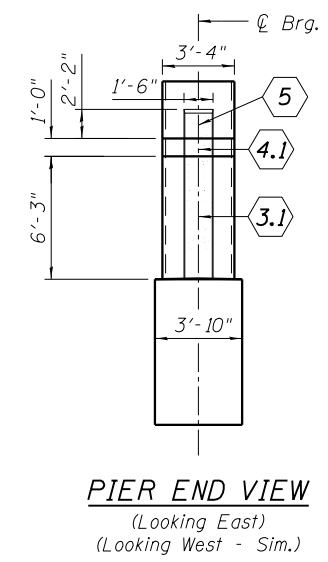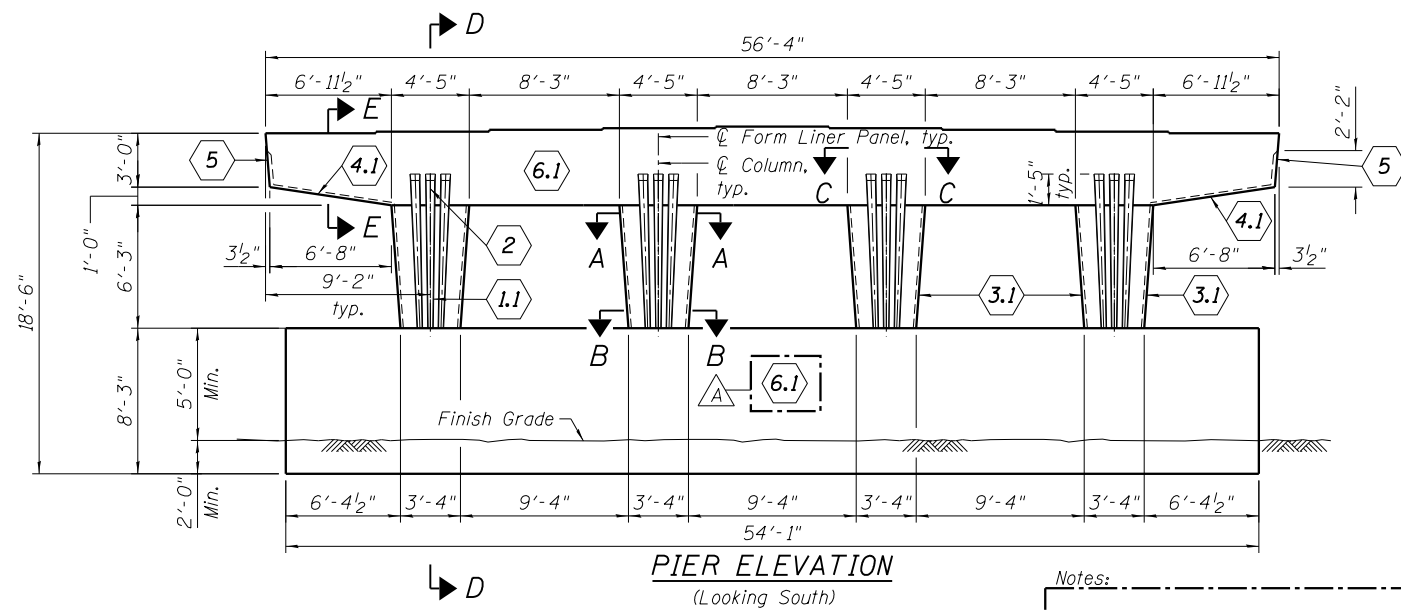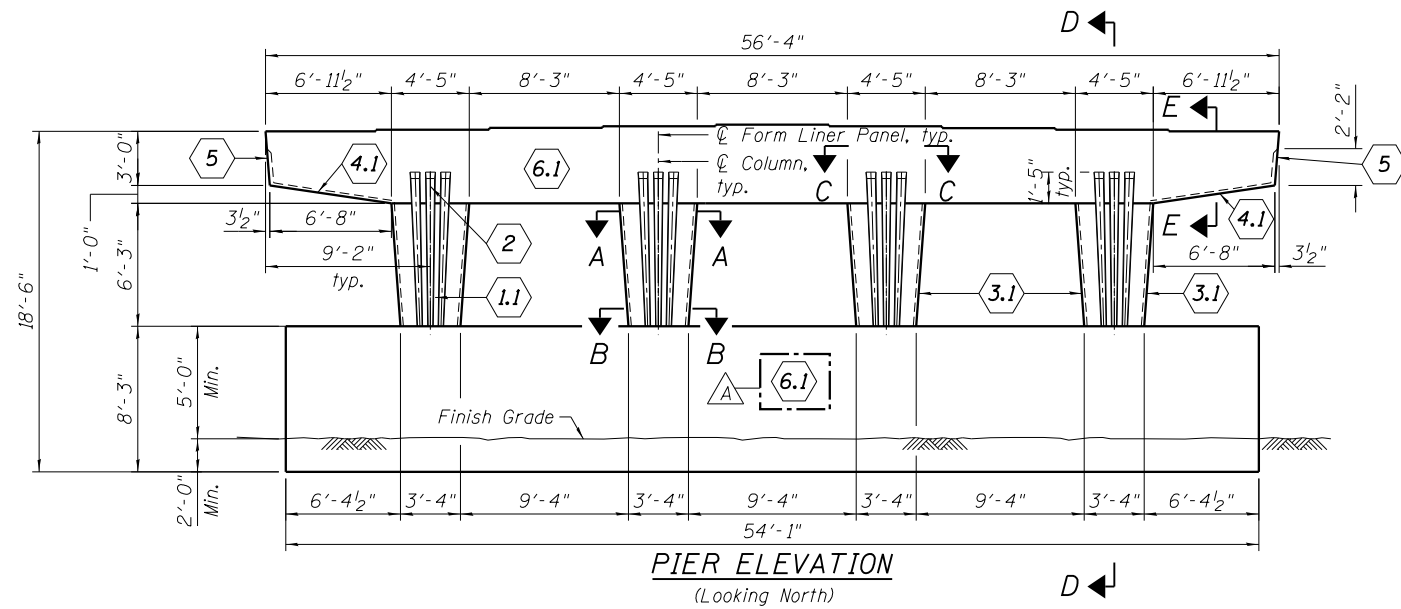

BILL OF MATERIAL

Item	Unit	Total
Rubbed Finish	Sq. Ft.	1089
Form Liner Textured Surface	Sq. Ft.	465

LEGEND

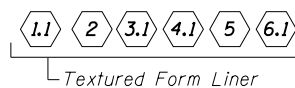

- Notes:**
- Form Liner panel (6.1) shall have a smooth finish. Cost included with Rubbed Finish.
 - Tapered fluting - dimensions vary, see elevation profile.
 - Form Liner panel (2) is continuation of panel (1.1). Keep adjacent form liners aligned.
 - Hand clean and smooth the surface of the construction joint between the pier and cap.
 - Texture 1: Light Sandblast as selected from manufacturer's standard pattern selection. Texture 2: Smooth

10:32:48 AM 0161708-60W29-5046-Pier1_ArchDetails.dgn



USER NAME = BAWIort	DESIGNED JRM	REVISED A 12/18/2013 JRM/KAH
PLOT SCALE = 10:8.0012 ' / in.	CHECKED KAH	REVISED
PLOT DATE = 12/19/2013	DRAWN RLS	REVISED
	CHECKED KAH	REVISED


**STATE OF ILLINOIS
DEPARTMENT OF TRANSPORTATION**

**PIER 1 ARCHITECTURAL DETAILS
STRUCTURE NO. 016-1708**


SHEET NO. 46 OF 55 SHEETS

MUN	SECTION	COUNTY	TOTAL SHEETS	SHEET NO.
2090	2013-011R	COOK	356	178
CONTRACT NO. 60W29				


ILLINOIS FED. AID PROJECT

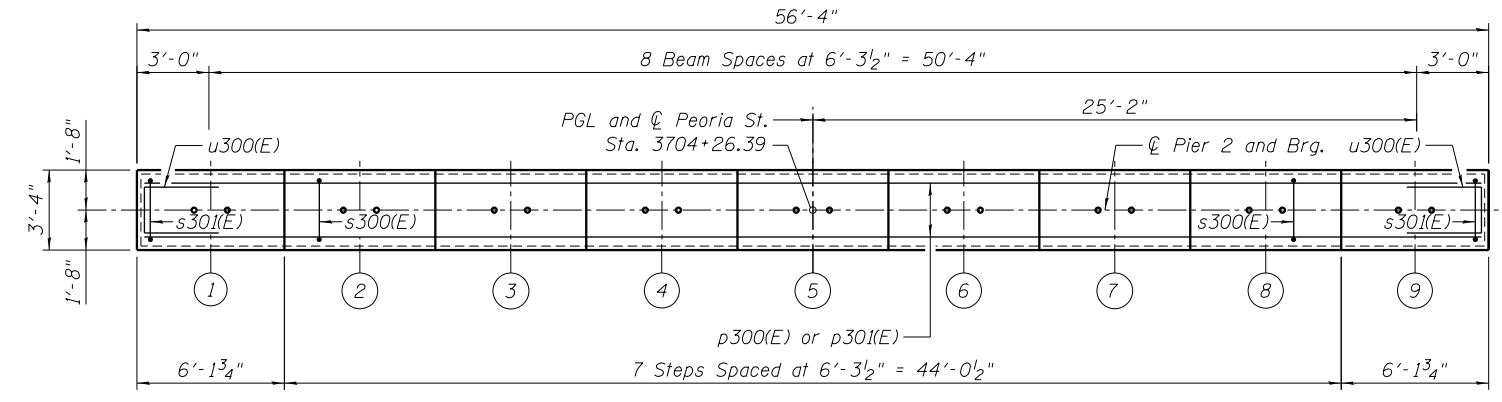


TOP PLAN

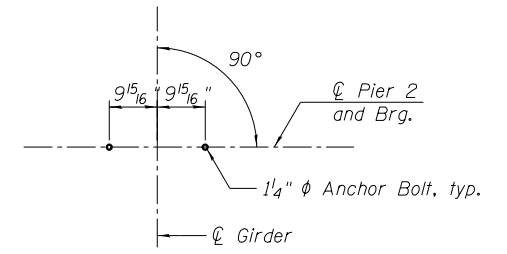

ANCHOR BOLT LAYOUT

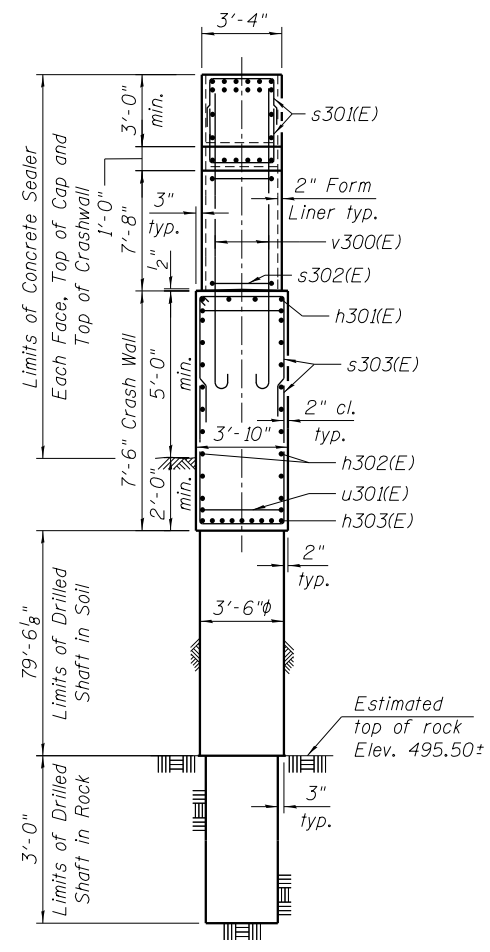

END VIEW

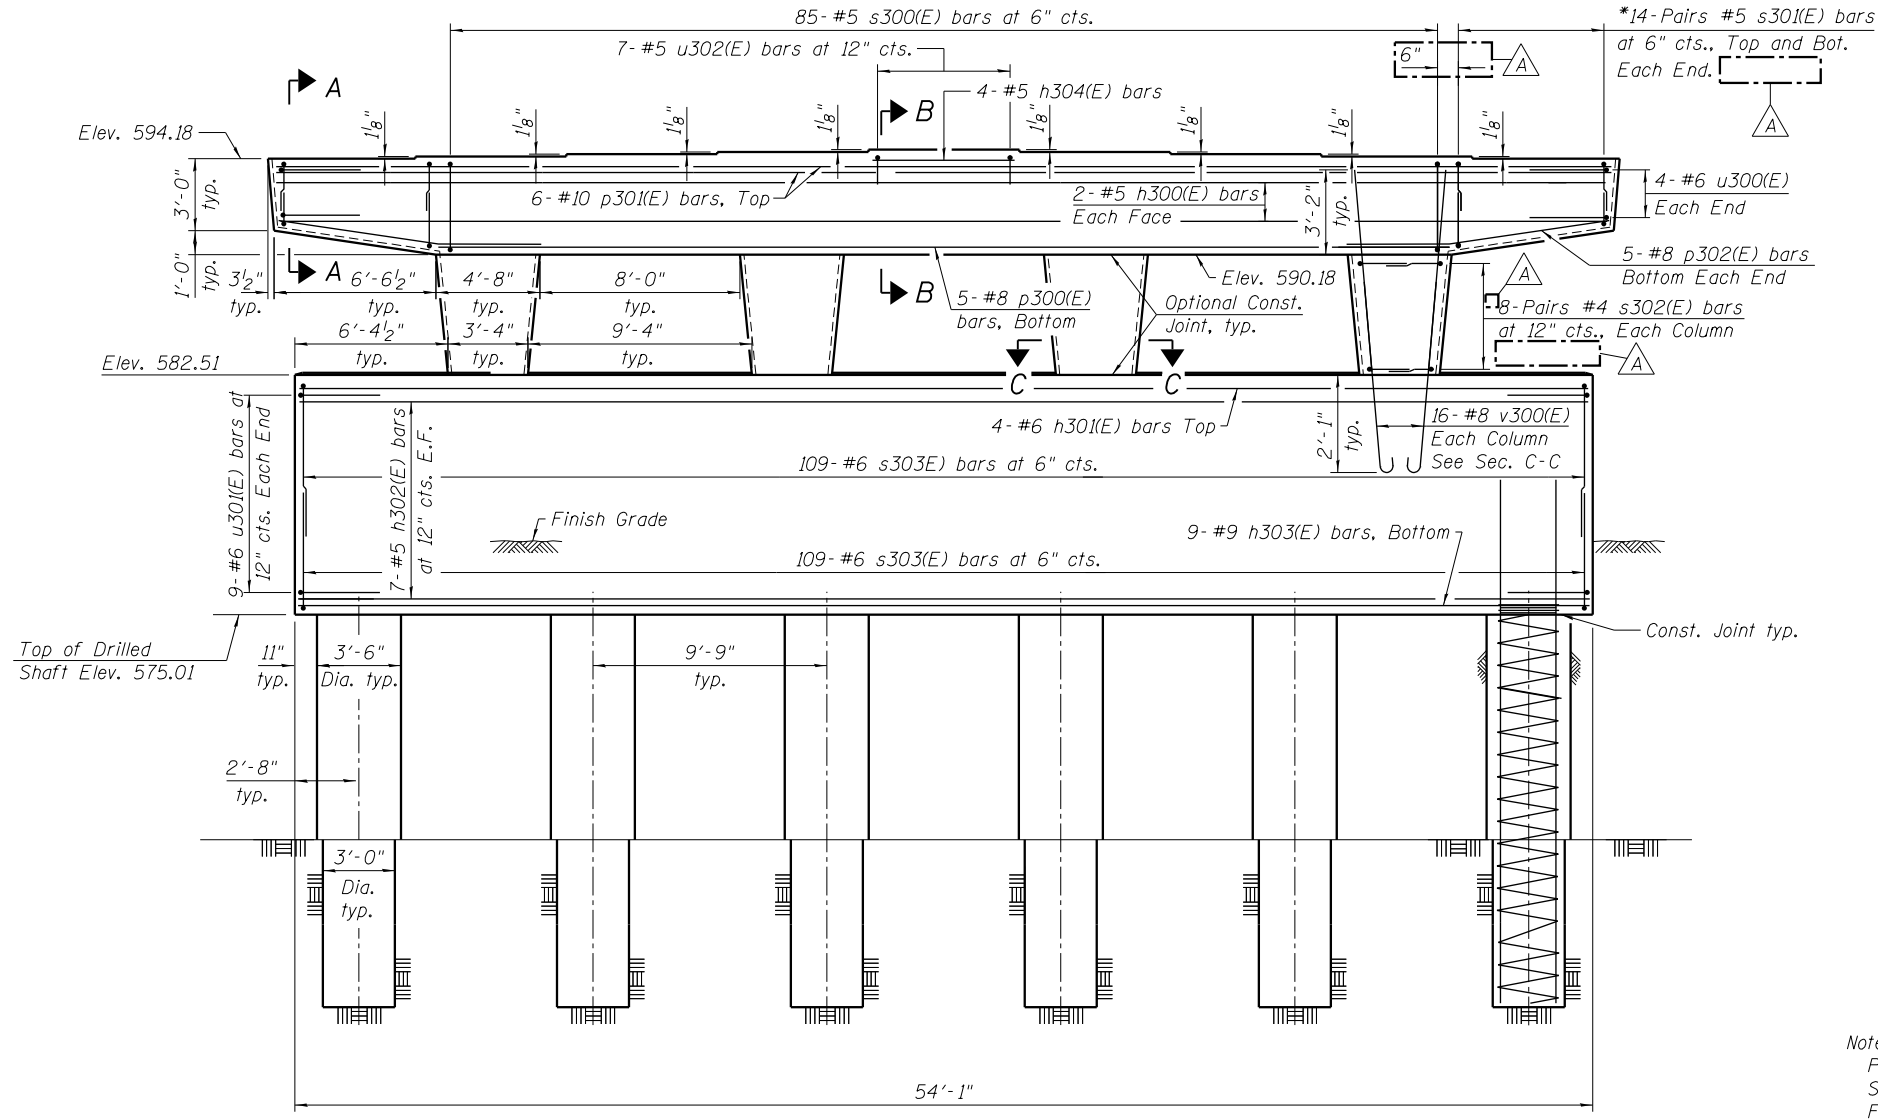

ELEVATION
(Looking North)

*Cut vertical legs of bar to fit. Min lap is 2'-7" for #5 bars.

TOP OF SEAT ELEVATION

Girder No.	Seat Elevation
1	594.18
2	594.27
3	594.37
4	594.46
5	594.56
6	594.46
7	594.37
8	594.27
9	594.18

Notes:
 Pour steps monolithically with cap.
 Space reinforcement in cap to miss anchor bolts.
 For Sections A-A, B-B and C-C, Drilled Shaft
 Details and Bill of Material, see sheet 48 of 55.

5:52:44 PM 0161708-60W29-5047-Pier 2_P&E.dgn



USER NAME = kahastings	DESIGNED JRM	REVISED A 12/18/2013 JRM/KAH
	CHECKED KAH	REVISED
PLOT SCALE = 8x0.0009 ' / in.	DRAWN RLS	REVISED
PLOT DATE = 1/10/2014	CHECKED KAH	REVISED

STATE OF ILLINOIS
DEPARTMENT OF TRANSPORTATION

PIER 2 PLAN AND ELEVATION
STRUCTURE NO. 016-1708

SHEET NO. 47 OF 55 SHEETS

MUN	SECTION	COUNTY	TOTAL SHEETS	SHEET NO.
2090	2013-011R	COOK	356	179
CONTRACT NO.			60W29	
ILLINOIS FED. AID PROJECT				


BILL OF MATERIAL

Bar	No.	Size	Length	Shape
h300(E)	4	#5	55'-2"	—
h301(E)	4	#6	53'-9"	—
h302(E)	14	#5	53'-9"	—
h303(E)	9	#9	53'-9"	—
h304(E)	4	#5	5'-11"	□
p300(E)	5	#8	42'-0"	—
p301(E)	12	#10	55'-8"	—
p302(E)	10	#8	13'-4"	—
s300(E)	85	#5	13'-7"	□
s301(E)	56	#5	9'-2"	□
s302(E)	72	#4	9'-2"	□
s303(E)	218	#6	14'-6"	□
sp300	6	#6	82'-7"	—
u300(E)	8	#6	10'-4"	□
u301(E)	18	#6	11'-2"	□
u302(E)	7	#5	4'-4"	□
v300(E)	64	#8	13'-11"	□
v301	168	#9	44'-1"	—
v302(E)	84	#9	14'-6"	—
Structure Excavation		Cu. Yd.	36	
Concrete Structures		Cu. Yd.	101.4	
Reinforcement Bars		Pound	37,680	
Reinforcement Bars, Epoxy Coated		Pound	20,710	
Drilled Shaft in Soil		Cu. Yd.	170.1	
Drilled Shaft in Rock		Cu. Yd.	4.8	
Concrete Sealer		Sq. Ft.	2008	

Bars indicated thus 1x15 etc., indicates 1 line of bars with 15 lengths per line.

Notes:
 Apply concrete sealer to all exposed concrete surfaces of the pier.
 * The quantities and reinforcement detailing are based on the top of shaft and the estimated top of rock elevations shown and may change based on the actual top of rock encountered at each shaft and the final top of shaft elevation.
 ** Length is height of spiral.

Minimum Bar Laps	
Bar	Lap
#4	2'-7"
#5	3'-3"
#6	3'-10"
#7	5'-2"
#8	6'-9"
#9	8'-7"
#6 spiral	3'-0"

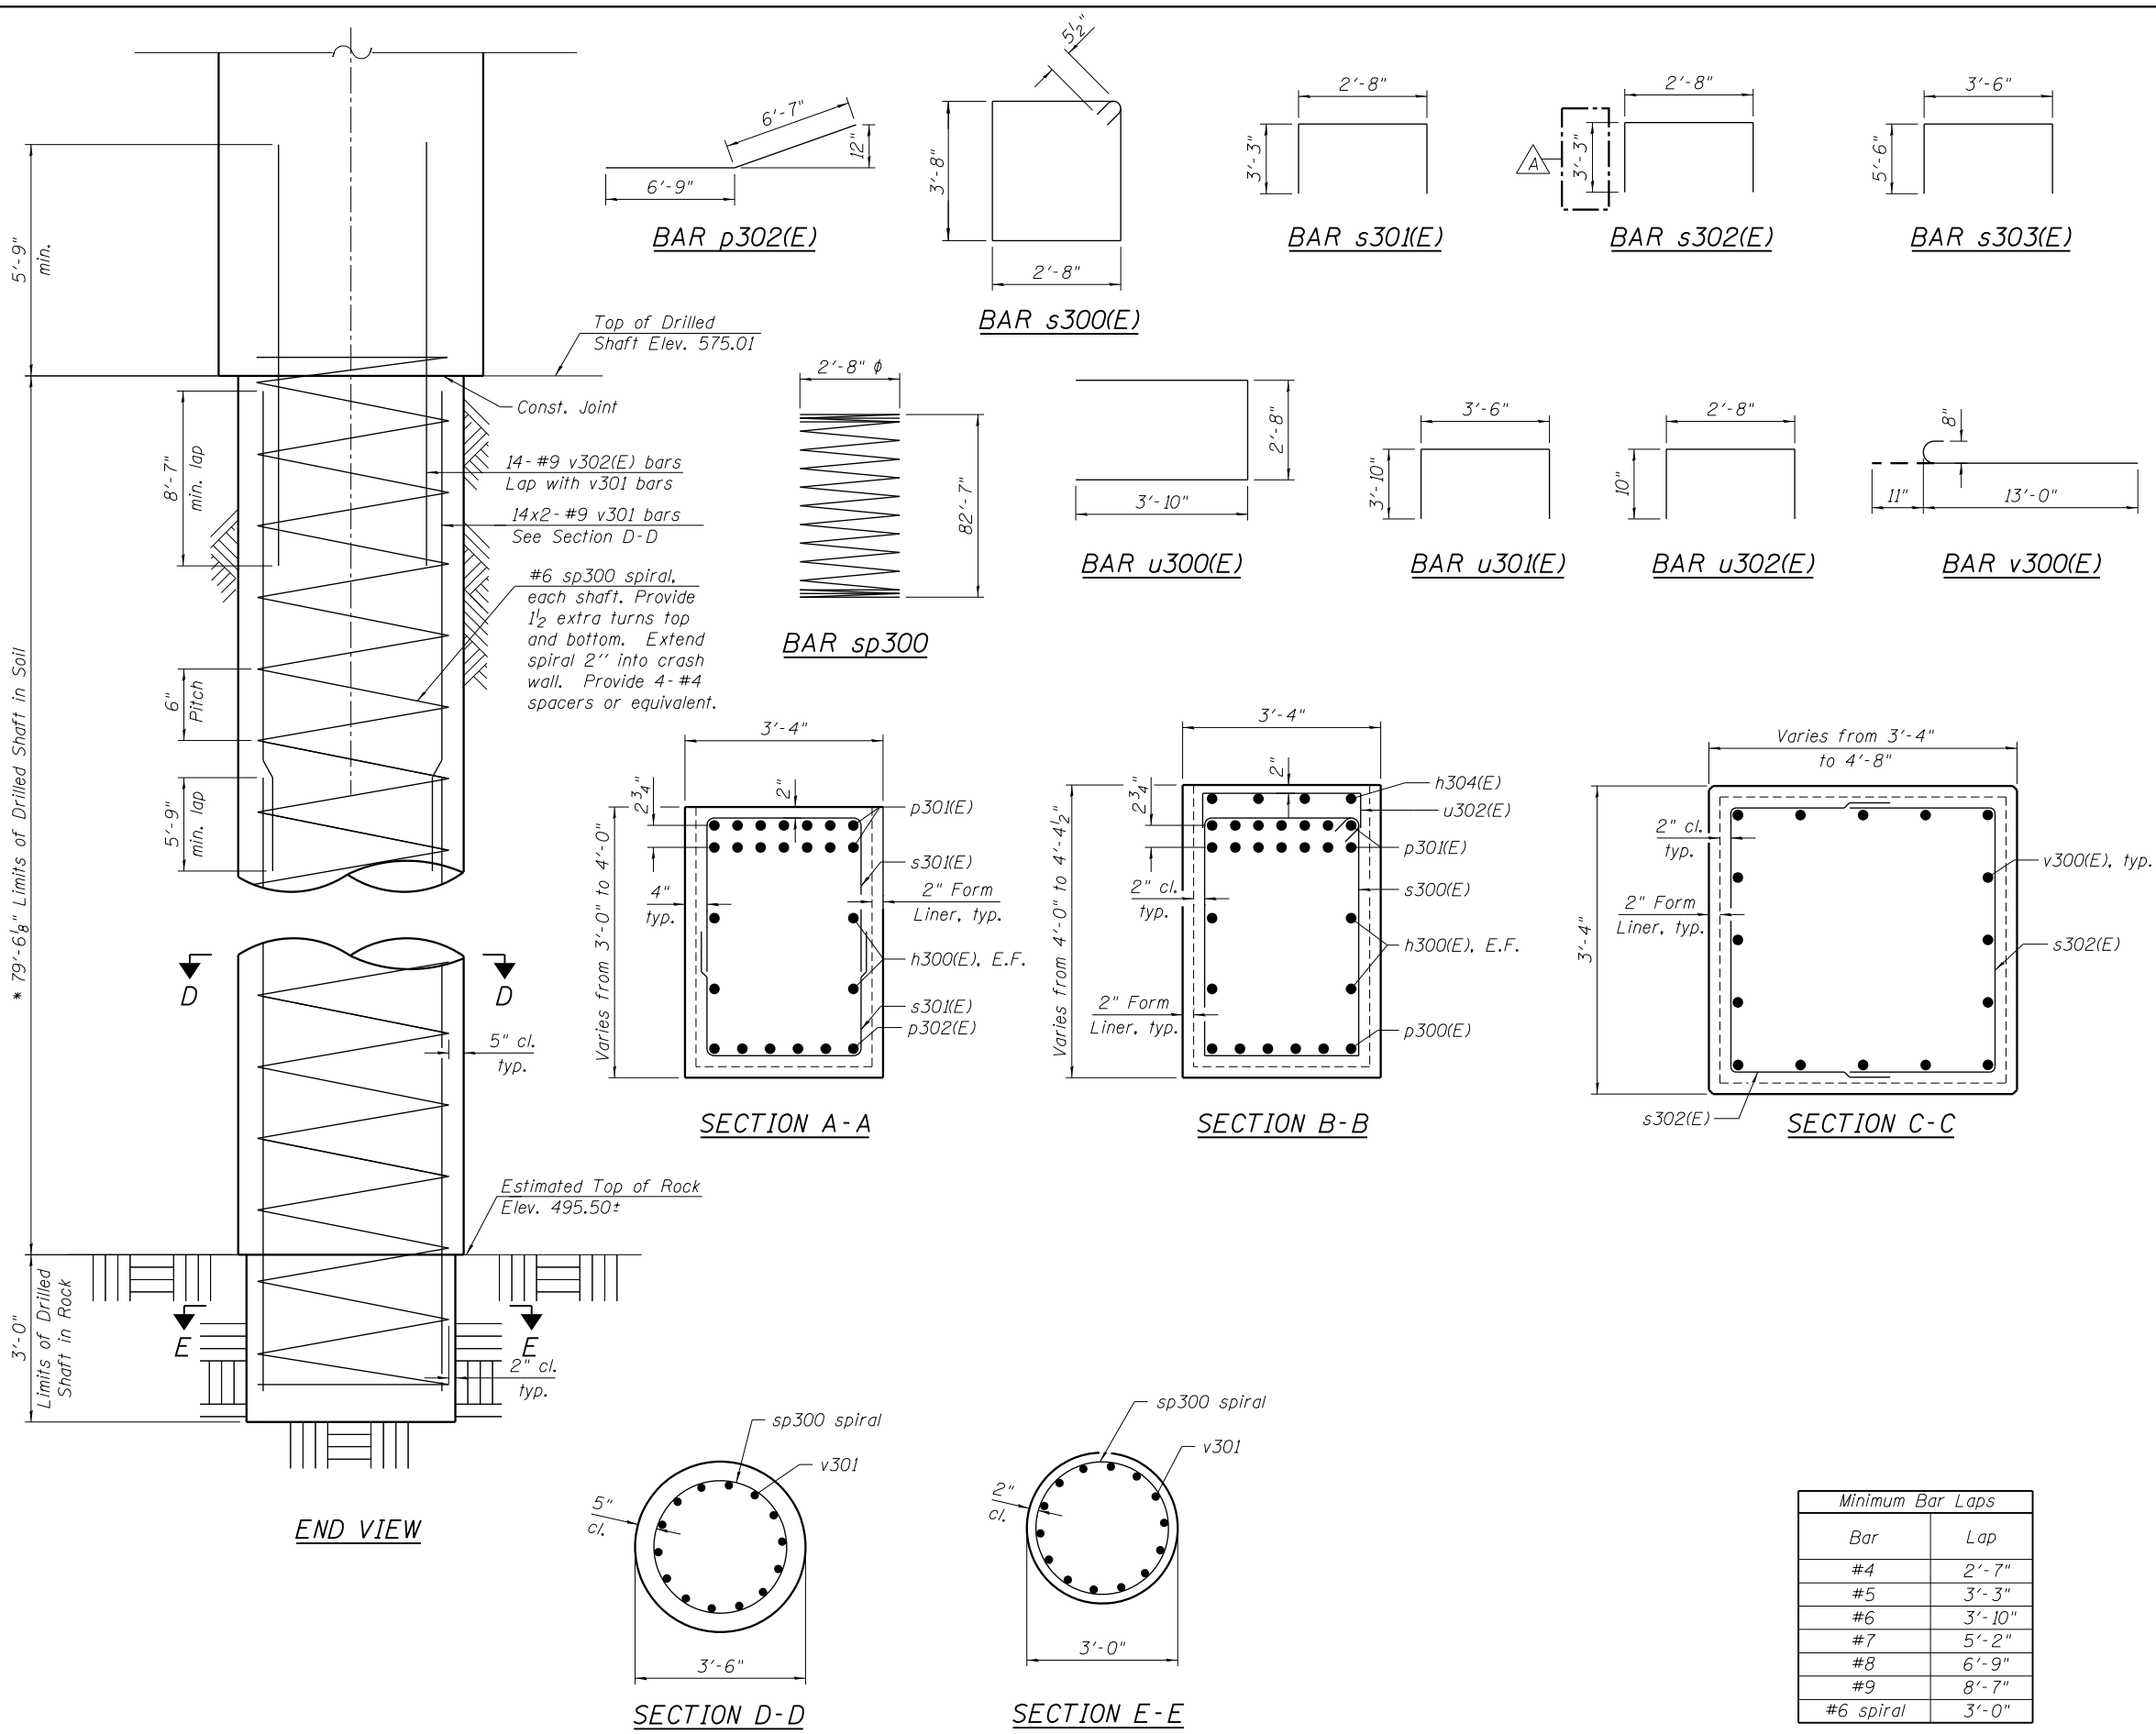

10:32:50 AM 0161708-60W29-5048-Pier2_Details.dgn













USER NAME = BAWIort	DESIGNED JRM	REVISION 12/18/2013 JRM/KAH
PLOT SCALE = 0x2.0000 'x' / in.	CHECKED KAH	REVISION
PLOT DATE = 12/19/2013	DRAWN RLS	REVISION
	CHECKED KAH	REVISION

**STATE OF ILLINOIS
DEPARTMENT OF TRANSPORTATION**

**PIER 2 DETAILS
STRUCTURE NO. 016-1708**

SHEET NO. 48 OF 55 SHEETS

MUN 2090	SECTION 2013-011R	COUNTY COOK	TOTAL SHEETS 356	SHEET NO. 180
CONTRACT NO. 60W29			ILLINOIS FED. AID PROJECT	

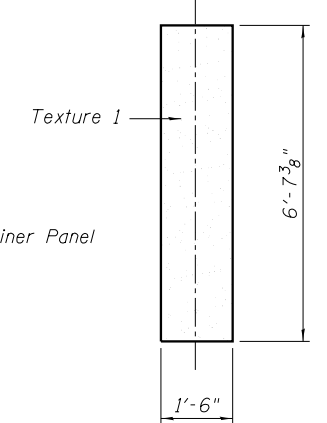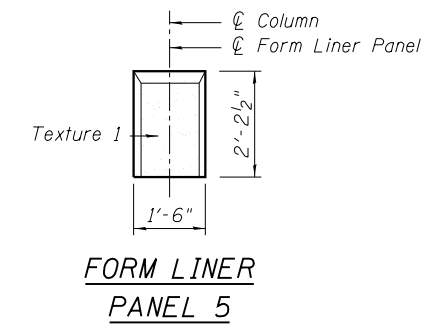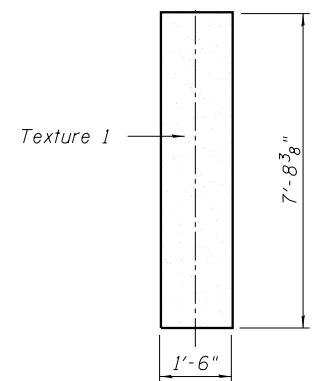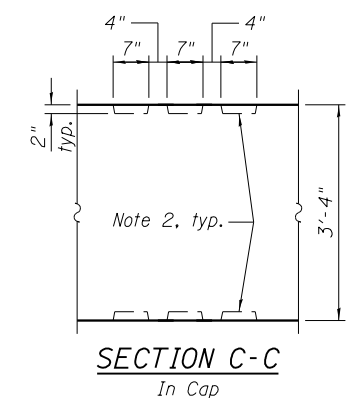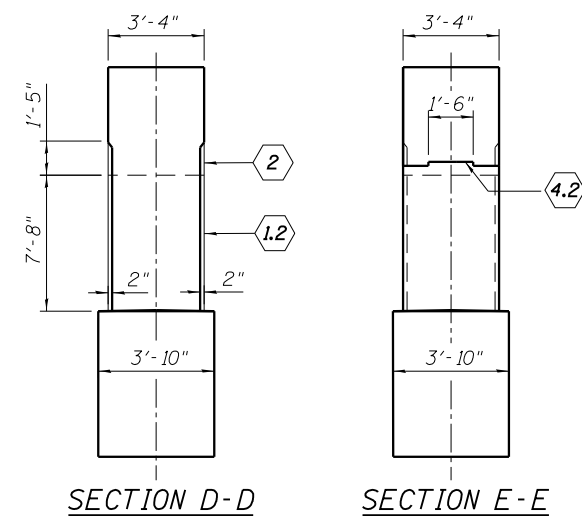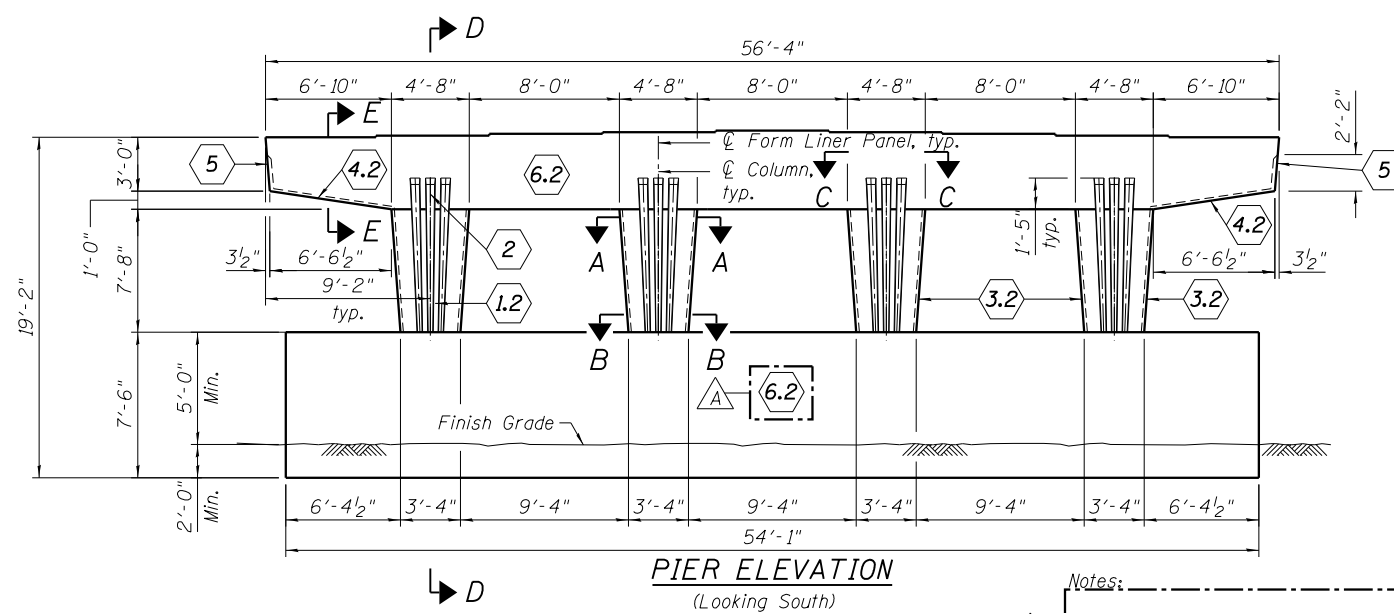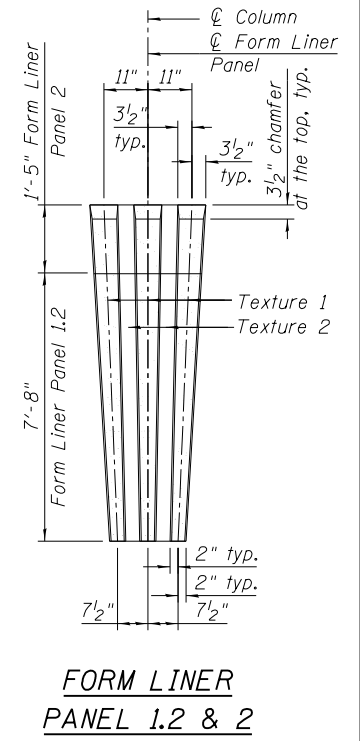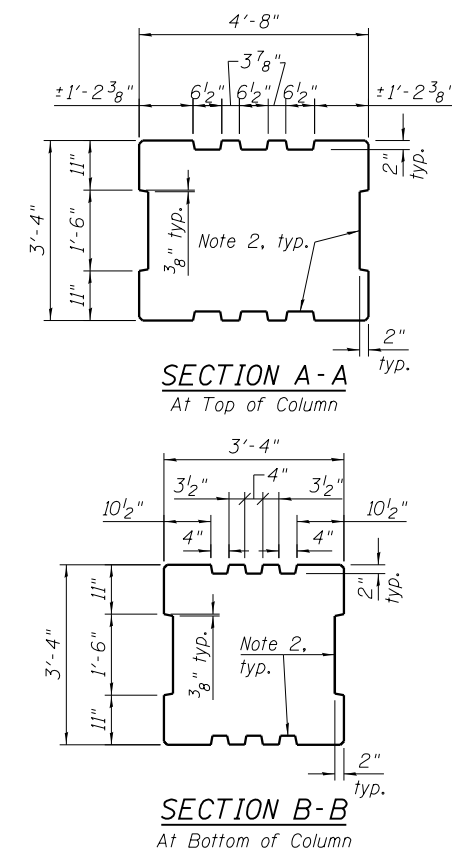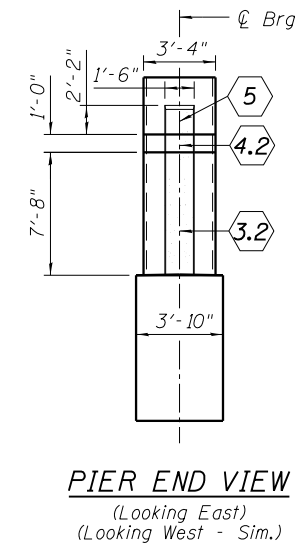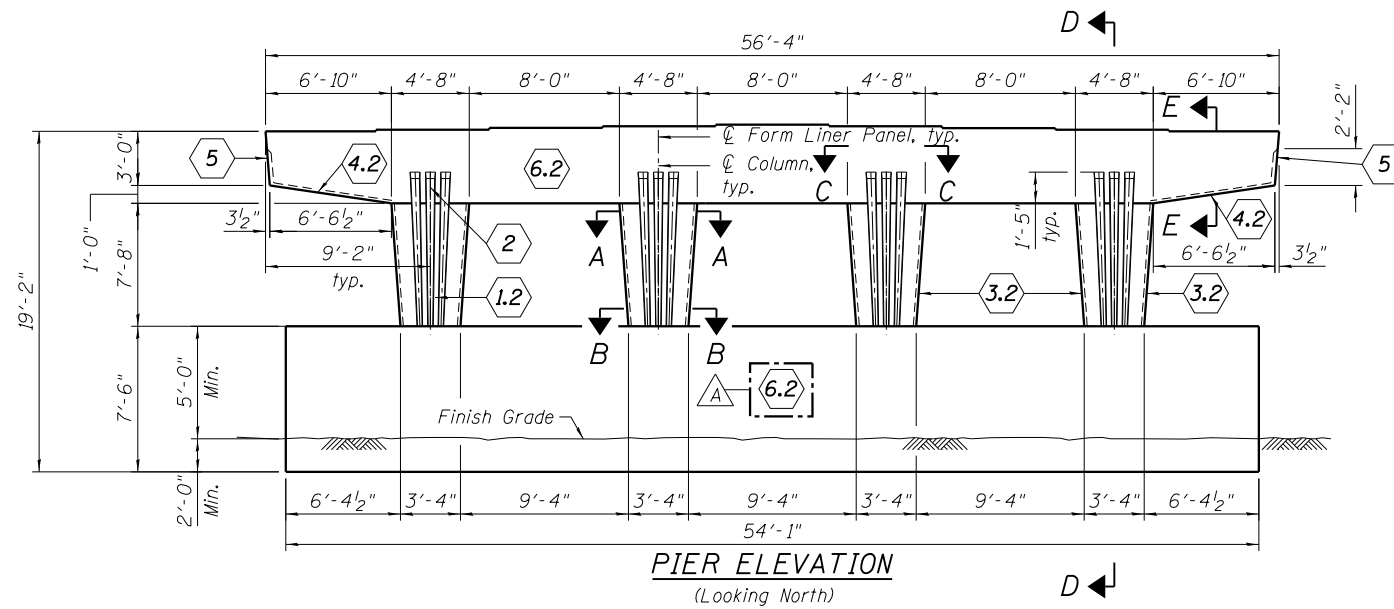


- Notes:**
1. Form liner panel 6.2 shall have a smooth finish. Cost included with Rubbed Finish.
 2. Tapered fluting - dimensions vary, see elevation profile.
 3. Form liner panel 2 is continuation of panel 1.2. Keep adjacent form liners aligned.
 4. Hand clean and smooth the surface of the construction joint between the pier and cap.
 5. Texture 1: Light Sandblast as selected from manufacturer's standard pattern selection. Texture 2: Smooth

BILL OF MATERIAL

Item	Unit	Total
Rubbed Finish	Sq. Ft.	1031
Form Liner Textured Surface	Sq. Ft.	555

LEGEND

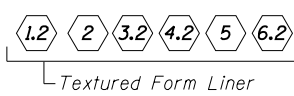

10:32:52 AM 0161708-60W29-5049-Pier 2_ArchDetails.dgn



USER NAME = BAWItoft	DESIGNED JRM	REVISED A 12/18/2013 JRM/KAH
PLOT SCALE = 10:8.0012 '"/in.	CHECKED KAH	REVISED
PLOT DATE = 12/19/2013	DRAWN RLS	REVISED
	CHECKED KAH	REVISED


**STATE OF ILLINOIS
DEPARTMENT OF TRANSPORTATION**

**PIER 2 ARCHITECTURAL DETAILS
STRUCTURE NO. 016-1708**


SHEET NO. 49 OF 55 SHEETS

MUN 2090	SECTION 2013-011R	COUNTY COOK	TOTAL SHEETS 356	SHEET NO. 181
CONTRACT NO. 60W29			ILLINOIS FED. AID PROJECT	


REVISIONS				
ZONE	REV	DESCRIPTION	DATE	APPROVED
	1.0	ADDENDUM A	12-18-2013	BRIAN BB

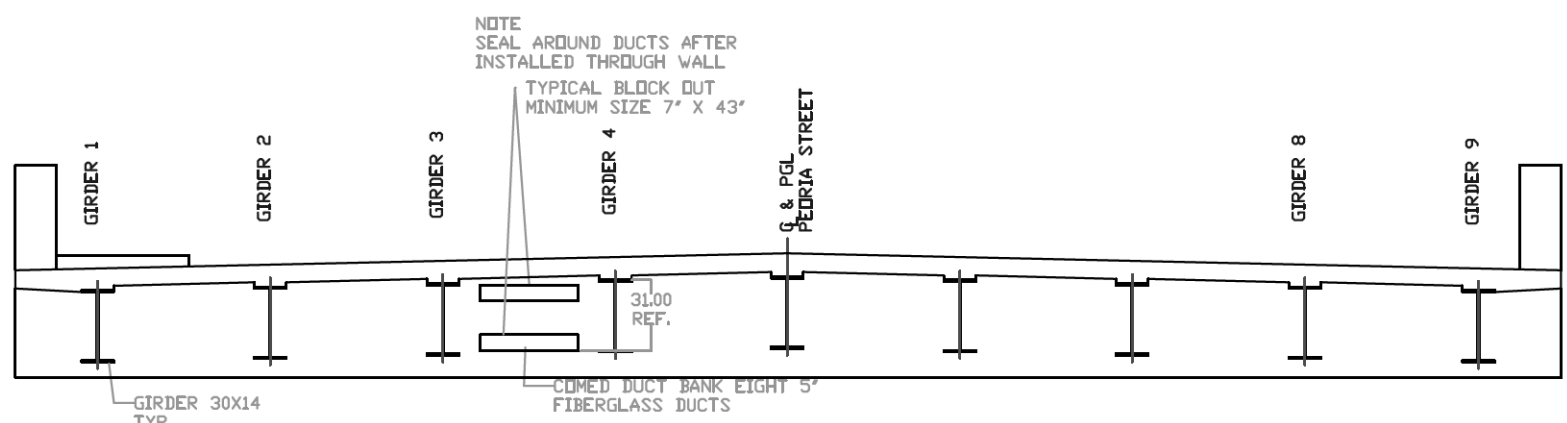

TYPICAL CROSS SECTION
AT ABUTMENT
LOOKING UP STATION
AT NORTH ABUTMENT

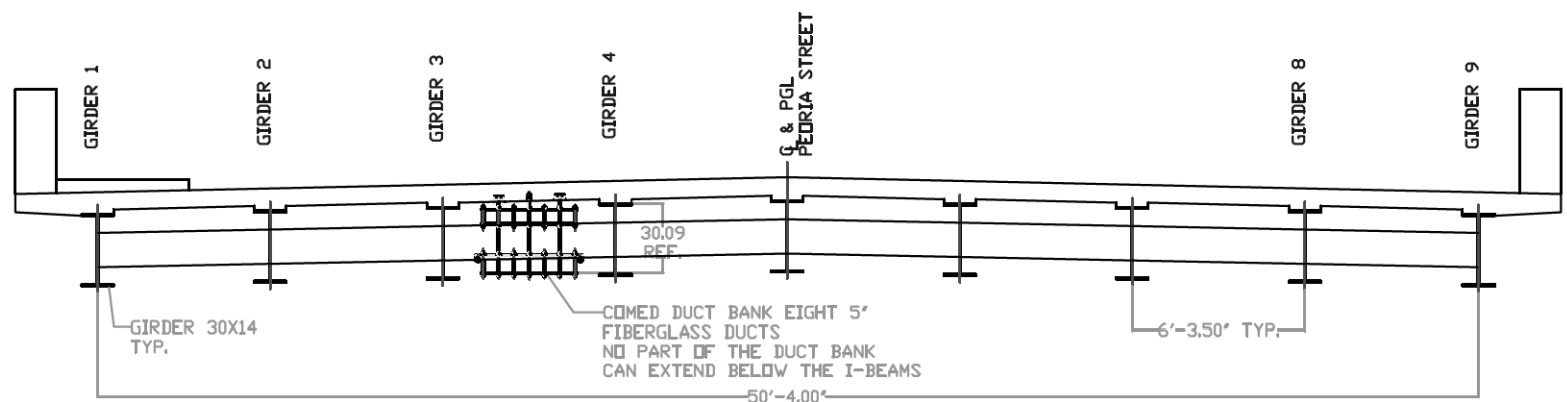

TYPICAL CROSS SECTION
DIAPHRAGM D1
LOOKING UP STATION

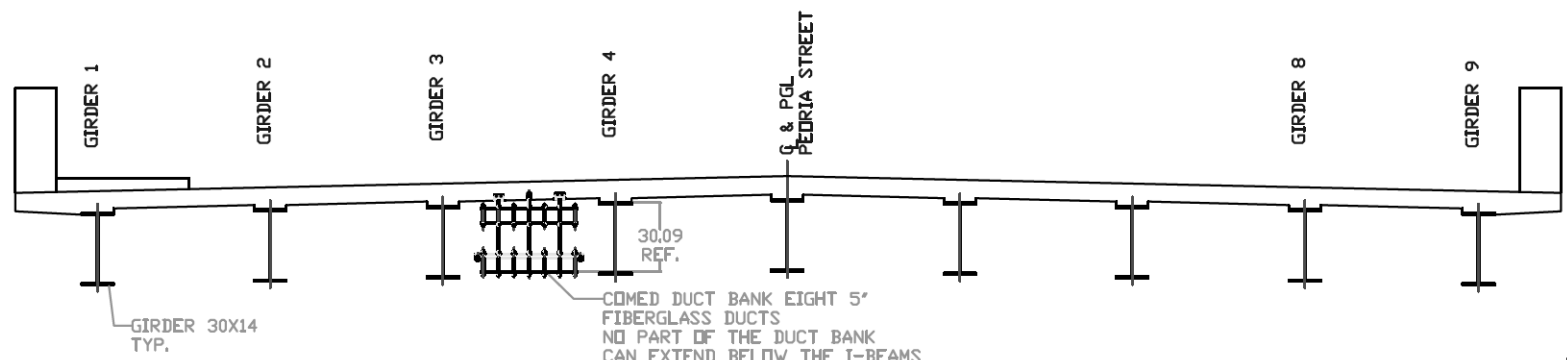

TYPICAL CROSS SECTION
LOOKING UP STATION



FOR INFORMATION ONLY
WORK TO BE PERFORMED BY OTHERS
WITH THE EXCEPTION OF PLACEMENT
OF INSERTS INTO SUPERSTRUCTURE

NOTE
NO PART OF THE CONDUIT SUPPORT HANGER CAN
EXTEND BELOW THE BRIDGE DECK GIRDER
EXTENDED RODS MAY NEED TO BE ALTERED

This drawing is the property
of Condux International, Inc.
and the information thereon is
to be treated as confidential.
It is not to be used, copied
or disclosed to outside
parties without our written
consent


Note:
ALL MEASUREMENTS ARE IN INCHES UNLESS
NOTED OTHERWISE

DRAWING APPROVAL
I _____
APPROVE THIS DRAWING FOR MANUFACTURING
DATE: _____


Bridge Deck Cross Section	CONDUX INTERNATIONAL, INC. MANKATO MN PH. 800-533-2077			
	Project: ComEd Peoria Street Bridge over F.A.I. 290 Eisenhower Expressway, Cook County Illinois			
WEIGHT: 0.0 LBS EA	SIZE	FSCM NO.	DWG NO. TBA	REV 1.0
QUOTE NO. 3985214497	SCALE 1/2	DATE: 10-03-2013	SHEET 182 OF 356	

This drawing is the property of Condux International, Inc. and the information thereon is to be treated as confidential. It is not to be used, copied or disclosed to outside parties without our written consent

REVISIONS				
ZONE	REV	DESCRIPTION	DATE	APPROVED
	1.0	ADDENDUM A	12-18-2013	BRIAN BB

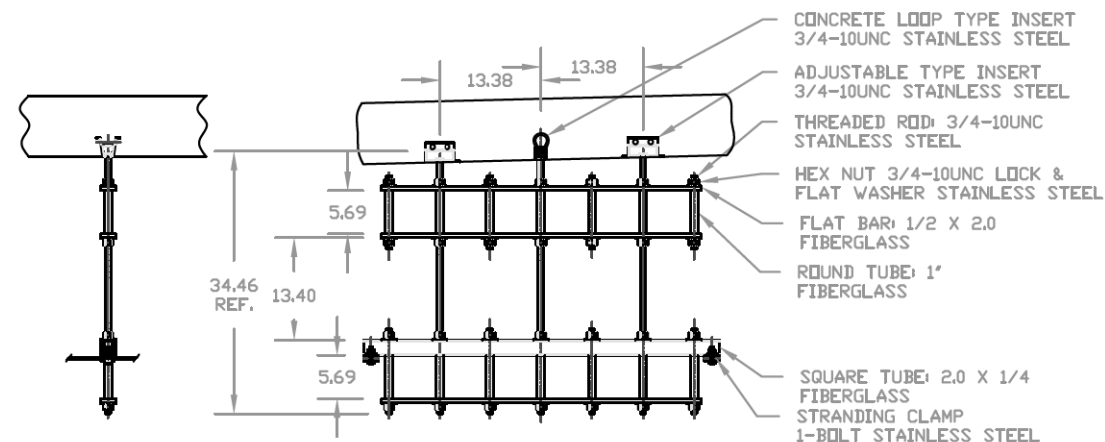

STANDARD SUPPORT HANGER WITH STRANDING CLAMPS

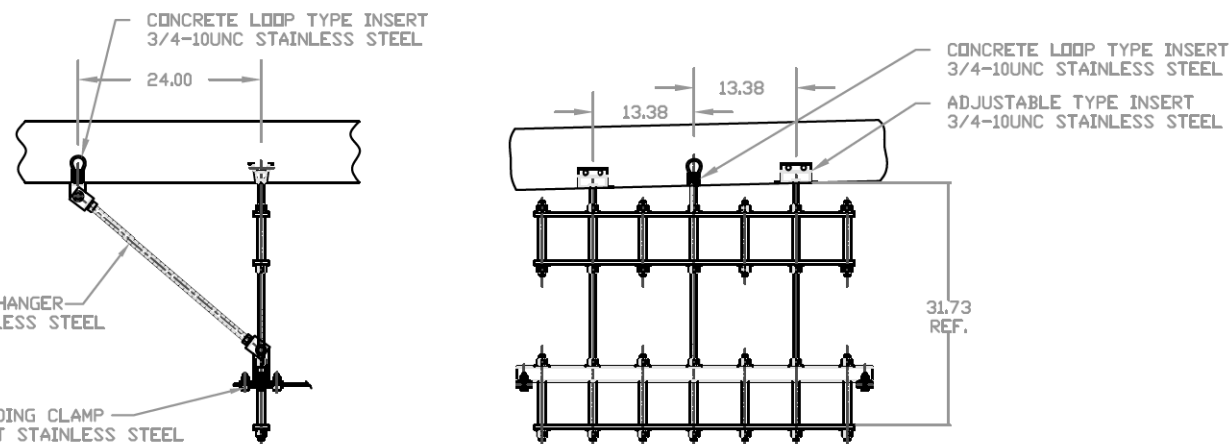

ABUTMENT SUPPORT HANGER WITH STRANDING CLAMPS AND BRACING

CURRENT BILL OF MATERIAL

ITEM NO.	PART NO.	DESCRIPTION	QTY	UNIT
1	TBA	STANDARD CONDUIT SUPPORT HANGER: 2 HIGH X 6 WIDE FIBERGLASS AND STAINLESS STEEL, OPENING FOR EIGHT 5" FGL DUCTS THREADED RODS THREE @ 3/4-10UNC X 38.00 LONG	26	EA.
2	08610236	HANGER BRACE ADJUSTABLE: 36 INCH STAINLESS STEEL	6	EA.
3	08409990	CONCRETE INSERT: 3/4-10 LOOP TYPE, STAINLESS STEEL	32	EA.
4	08558300	CONCRETE INSERT SETTING PLUG: 3/4-10	32	EA.
5	08409929	CONCRETE INSERT ADJUSTABLE: 3/4-10 STAINLESS STEEL	52	EA.
6	08408950	STRANDING WIRE: 1/4 X 500 FT., STAINLESS STEEL	2	EA.
7	08409404	GUY STRAND CLAMP: 3-BOLT, STAINLESS STEEL	6	EA.
8	08409504	GUY STRAND CLAMP: 1-BOLT, STAINLESS STEEL	46	EA.
9	08460053	CONDUIT FIBERGLASS: 5" IPS, MW (.57 I.D. X .096 WALL) MEETING NEMA TC-14A	2240	FT.
10	08460153	CONDUIT STOP COUPLING: 5" IPS MW	10	EA.
11	08460453	CONDUIT EXPANSION JOINT (D-RING TYPE): 5" IPS MW	16	EA.
12	08460953	CONDUIT SPLIT STOP RING: 5" IPS MW	16	EA.
13	08461553	CONDUIT ADAPTER: 5" IPS MW TO 5" GRC	16	EA.
14	08463402	CONDUIT EPOXY ADHESIVE CARTRIDGE	25	EA.
15	02288990	CONDUIT EPOXY ADHESIVE GUN	1	EA.

FOR INFORMATION ONLY
WORK TO BE PERFORMED BY OTHERS
WITH THE EXCEPTION OF PLACEMENT
OF INSERTS INTO SUPERSTRUCTURE

General Construction, Hanger and Conduit Notes
 1.0 Recommended spacing between Support is 10 foot.
 2.0 Support Hanger Material shall be manufactured using 316 stainless steel and fiberglass components.
 3.0 Conduit is 5 inch Fiberglass with minimum wall thickness of .096 inch meeting NEMA TC- 14A Specs.
 4.0 Conduit joints shall be positive locking adhesive bonded bell and spigot.
 5.0 Conduit expansion joints shall be sliding sleeve with provision for 8 inch of travel.
 6.0 Bridge abutments must have a block out or be sleeved to allow the fiberglass conduit to pass through. After conduit is placed through abutment seal up opening with state approved sealant.
 7.0 Place concrete inserts for future support system. Hangers will be installed at a later date.
 8.0 Conduit support hangers weight 2525 LBS total
 Fiberglass conduit weight 2807 LBS total
 cable weight weight 18,942 LBS total
 Grand total being placed on the bridge is 24,274 LBS.

Condux International, Inc. Support hanger meet the following specifications
Fiberglass Items
 Flat Bar: 1/2 x 2.0
 Round Tube: 1.0" O.D., .105 wall
 Square Tube: 2 x 2 x 1/4
 Fiberglass reinforced with polyester resin with surface veil for better weathering, resin shall contain u.v. inhibitor. Fiberglass is made with continuous strand mat and uni-directional roving, gray in color
 Tensile Strength (ASTM D 638) 30,000 PSI
 Tensile Modulus (ASTM D 638) 2.3E6 PSI
 Flexural Strength (ASTM D 790) 30,000 PSI
 Flexural Modulus (ASTM D 790) 2.3E6 PSI
 Compressive Strength (ASTM D 695) 20,000 PSI
 Compressive Modulus 1.4E6 PSI
 Yield shear strength 2000 PSI
 Barcol hardness 50
 Dielectric strength (ASTM D 149) 200 VPM Min.




Stainless steel Hardware Items
 Threaded Rod
 Threaded rod nuts (ASTM/ASME B1.1) (ASTM A307 Grade A) (Tensile Strength 60,000 PSI)
 Hexnut
 Hexnut meets (ANSI/ASME B18.2.2) Material: 316 Stainless steel (ASTM F594)
 Flatwasher
 Flatwasher meets (ANSI/ASME B18.21.1) Material: 316 stainless steel (ASTM F436)
 Lockwasher
 Lockwasher meets (ANSI/ASME B18.21.1) Material: 316 Stainless steel (ASTM F436)
Stranding Items
 Stranding Clamps (1-Bolt & 3-Bolt) Material: 1/4 x 1.5 (316 Stainless Steel)
 Stranding Wire
 Cable: 1/4" Dia (7 X 19 Steel Aircraft) 304 Stainless Steel
Bracing
 Adjustable hanger attachment brackets Material: angle 2.5 x 2.5 x .25 (316 Stainless steel)

NOTE
NO PART OF THE CONDUIT SUPPORT HANGER CAN EXTEND BELOW THE BRIDGE DECK GIRDER
EXTENDED RODS MAY NEED TO BE ALTERED

DRAWING APPROVAL
 I _____
 APPROVE THIS DRAWING FOR MANUFACTURING
 DATE: _____
 Note:
 ALL MEASUREMENTS ARE IN INCHES UNLESS NOTED OTHERWISE

CONDUIT SUPPORT HANGER DETAIL AND BILL OF MATERIALS		CONDEX INTERNATIONAL, INC. MANKATO MN PH. 800-533-2077		
Project: ComEd Peoria Street Bridge over F.A.I. 290 Eisenhower Expressway, Cook County Illinois		TBA		
WEIGHT: 0.0 LBS EA	SIZE	FSCM NO.	DWG NO.	REV 1.0
QUOTE NO. 3985214497	SCALE 1/2	DATE: 10-03-2013	SHEET 183 OF 356	

REVISIONS				
ZONE	REV	DESCRIPTION	DATE	APPROVED
	1.0	ADDENDUM A	12-18-2013	BRIAN BB

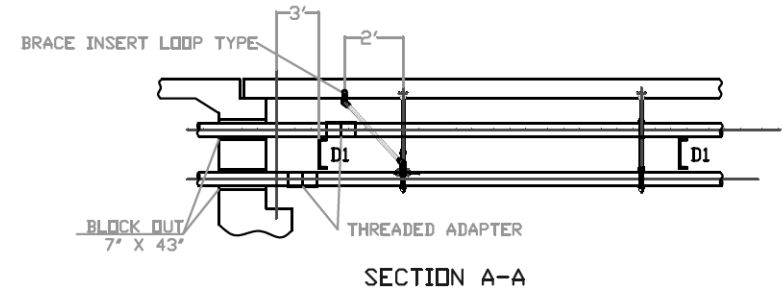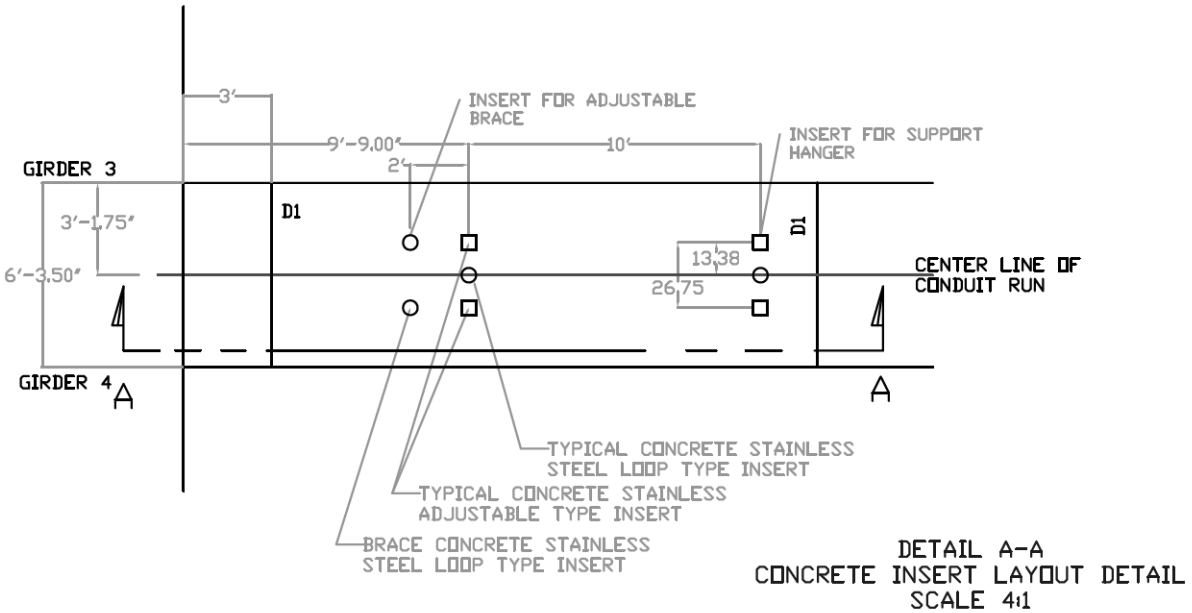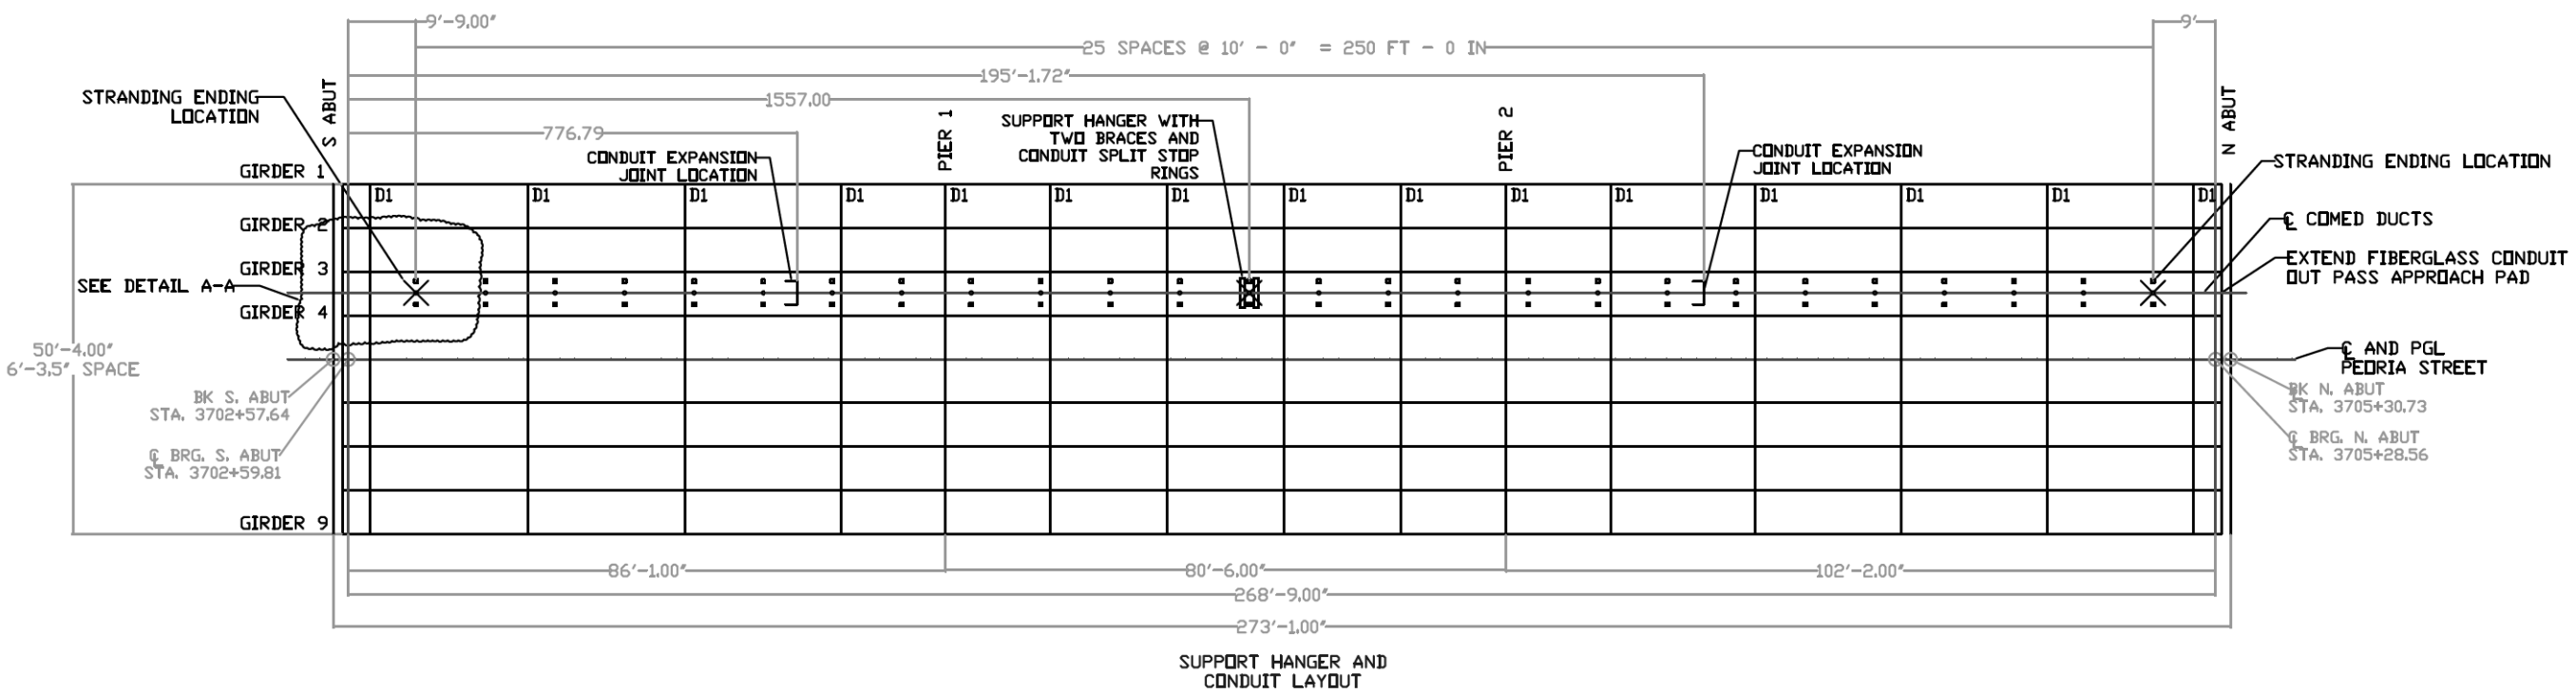


FOR INFORMATION ONLY
 WORK TO BE PERFORMED BY OTHERS
 WITH THE EXCEPTION OF PLACEMENT
 OF INSERTS INTO SUPERSTRUCTURE

This drawing is the property of Condux International, Inc. and the information thereon is to be treated as confidential. It is not to be used, copied or disclosed to outside parties without our written consent.

Note:
 ALL MEASUREMENTS ARE IN INCHES UNLESS NOTED OTHERWISE

DRAWING APPROVAL
 I _____
 APPROVE THIS DRAWING FOR MANUFACTURING
 DATE: _____

CONDUIT SUPPORT AND CONDUIT LAYOUT		CONDUX INTERNATIONAL, INC. MANKATO MN PH. 800-533-2077		
		Project: ComEd Peoria Street Bridge over F.A.I. 290 Eisenhower Expressway, Cook County Illinois		
WEIGHT: 0.0 LBS EA	SIZE	FSCM NO.	DWG NO. TBA	REV
QUOTE NO. 3985214497	SCALE 1/2	DATE: 10-03-2013	SHEET 184 OF 356	

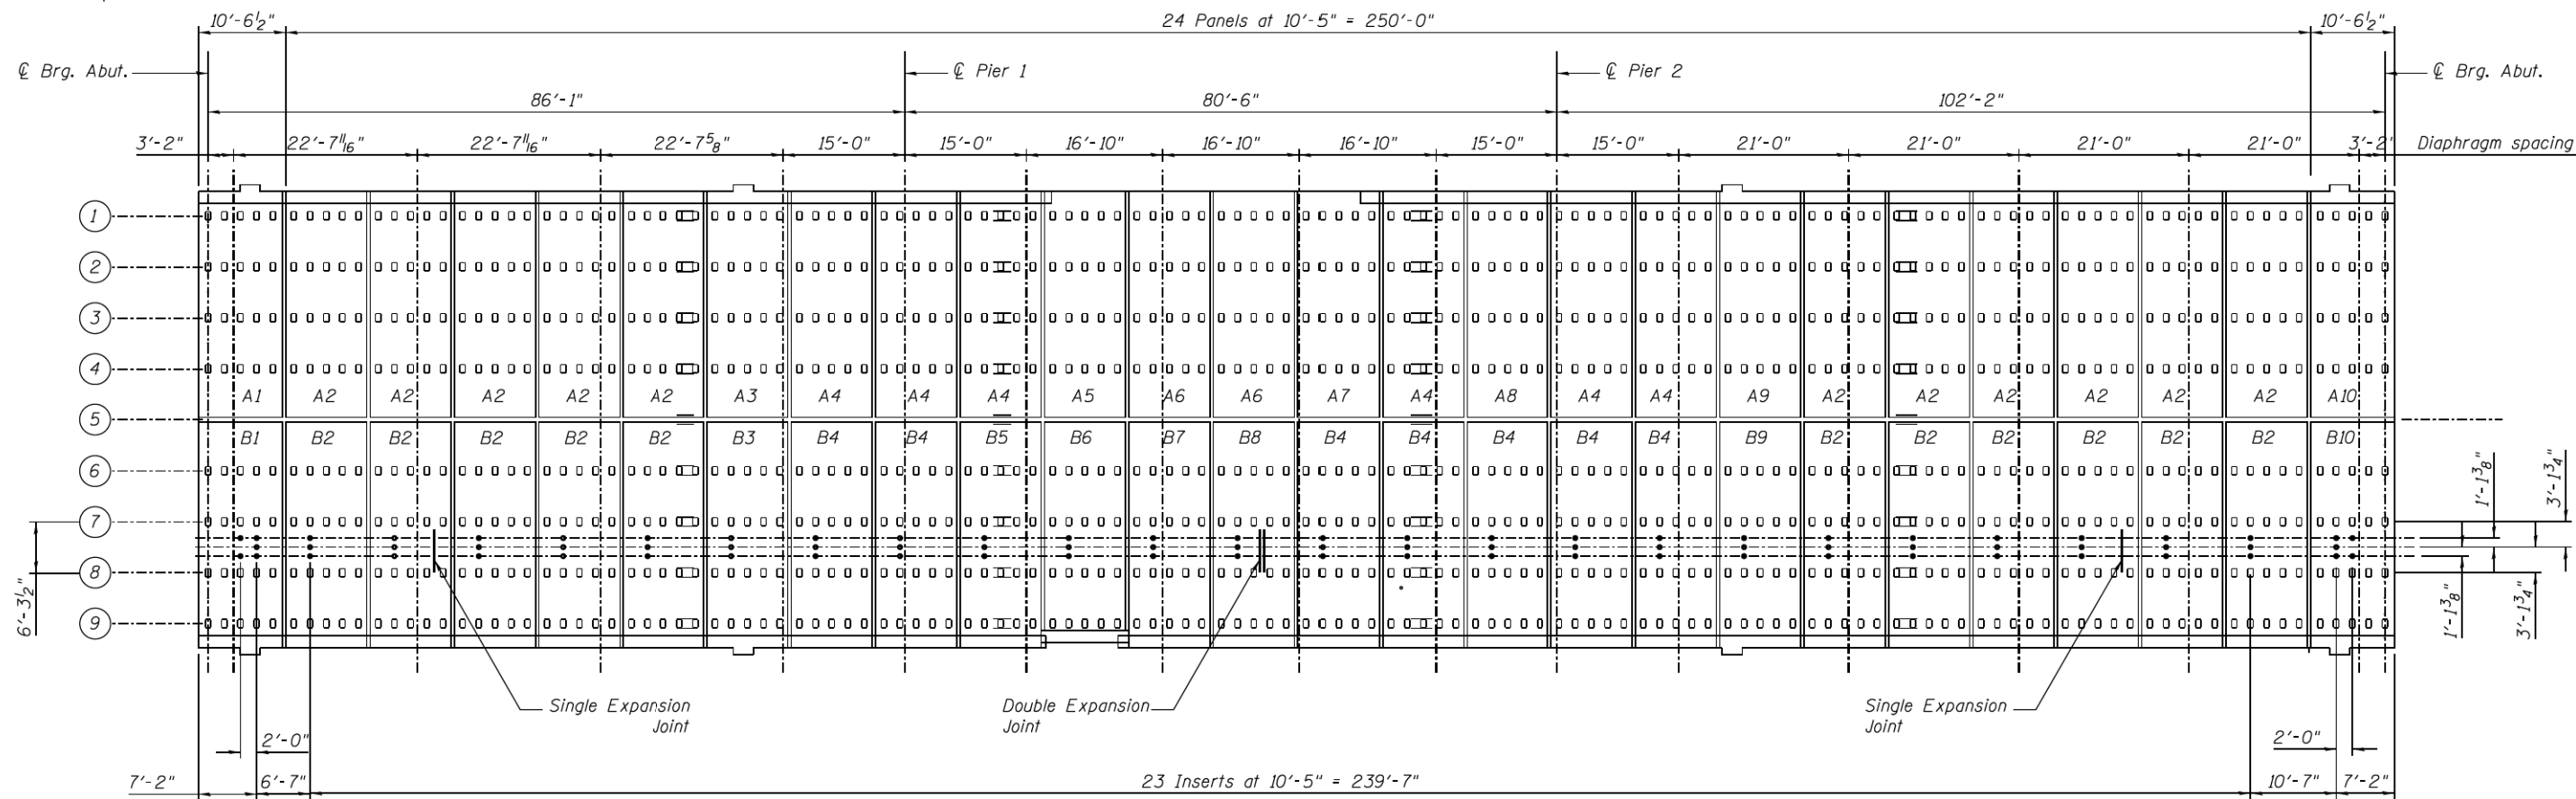

PRECAST DECK PANEL PLAN - AT&T CONDUIT HANGER INSERT LAYOUT

GENERAL NOTES

General Construction Hanger and Conduit Notes:

- Six AT&T ducts shall be placed between girders seven and eight. They shall be four inch PVC conduits inclusive of (2) 3600 Pair copper cables (5.92plf each), (12) 1/4" innerduct cables (0.26plf each), and (12) Fiber cables (0.356plf each)
 - The ducts shall be supported into the bottom of the deck, at 10'-5" intervals, unless shown otherwise on the plans. Support Hanger material shall be manufactured using 316 stainless steel and fiberglass components as specified below.
 - Material Specifications required at each Standard Support Hanger:
 - Fiberglass Items
 - Flat Bars 1/2"x 2"
 - Round Tube 1" O.D., 0.105" wall
 - Square Tube 2"x 2" x 1/4"
 - Fiberglass reinforced with polyester resin for better weathering. Resin shall contain u.v. Inhibitor. Fiberglass is made with continuous strand mat and uni-directional raving, gray in color.
 - Tensile strength (ASTM D 638) 30,000 psi
 - Modules (ASTM D 638) 23E6psi
 - Flexural strength (ASTM D 790) 30,000 psi
 - Compressive Strength (ASTM D 695) 20,000 psi
 - Compressive Modules 14E6 psi
 - Yield Shear Strength 2000 psi
 - Barcol Hardness 50
 - Dielectric strength (ASTM D 149) 200 VPM Min.
- Stainless Steel Hardware Items
- Threaded Rod (ASTM/ASME B1.1) (ASTM A307 Grade) Tensile strength 60,000 psi
 - Hexnut (ANSI/AMSE 18.2.2) 316 Stainless Steel (ASTM F594)


- Flatwasher (ANSI/AMSE 18.2.1) 316 Stainless Steel (ASTM F436)
 - Lockwasher (ANSI/AMSE 18.2.2) 316 Stainless Steel (ASTM F594)
 - Stranding Clamps (1-Bolt & 3-Bolt) 1/4 x 1.5 (316 Stainless steel)
 - Stranding Wire: Cable 1/4" Dia. (7 x 19 Steel Aircraft) (304 Stainless steel)
 - Bracing: Adjustable Hanger attachment brackets (Angle 2.5 x 2.5 x 0.25 (315 Stainless Steel)
- The Conduit joints shall be positive locking adhesive bonded bell and spigot.
 - The Conduit expansion joints shall be sliding sleeves with a provision for eight inches of travel.
 - The Bridge Abutments must have a block out or be sleeved to allow the PVC conduit to pass through. After the conduit is placed through the abutment, the opening is sealed up with a state approved sealant.
 - Place one concrete loop insert and two adjustable inserts per support location for the future support system. The Hangers will be installed at a later date.
 - Type and location of precast inserts for the AT&T hangers shall be coordinated with AT&T. The cost is included with the Precast Concrete Deck Panels.
 - NO PART OF THE CONDUIT SUPPORT HANGER CAN EXTEND BELOW THE BRIDGE DECK GIRDERS. EXTENDED RODS MAY NEED TO BE ALTERED.
- | | |
|-------------------------------------|-----------------|
| 10. 4" PVC Conduits | 3277 lbs |
| 3600 Pair Copper Cables | 3233 lbs |
| Fiber Cables | 1167 lbs |
| 1/4" ID | 865 lbs |
| Hanger Type Supports | 601 lbs |
| Misc. Inserts, Joints | 177 lbs |
| Total being placed on bridge | 9326 lbs |

TOTAL UNIFORM LOADS PER HANGING SUPPORTS


ITEM	Quantity	Unit Wt. lbs/each	Unit Wt. lbs/ft	Total Wt. lbs
4" PVC Conduits	6	2.00	12.00	3276.96
3600 Pair Copper Cables	2	5.92	11.84	3233.27
Fiber Cables	12	0.36	4.27	1166.60
1/4" ID	12	0.26	3.17	865.12
Loop Type Concrete Insert*	30	1.50	N/A	45.00
Adjustable Type Concrete Inserts	52	1.50	N/A	78.00
Hanging Type Support	26	23.10	N/A	600.60
Double Expansion Joints	6	4.00	N/A	24.00
Single Expansion Joints w/out Ring	12	3.00	N/A	36.00
Sum (lbs)	N/A	N/A	N/A	9326
			Sum (plf)	34.15

*Required as shown in Detail "A" and Section "B-B"

P:\projects\13022\001\NCADD Sheets\13022-ATT-552A.dgn

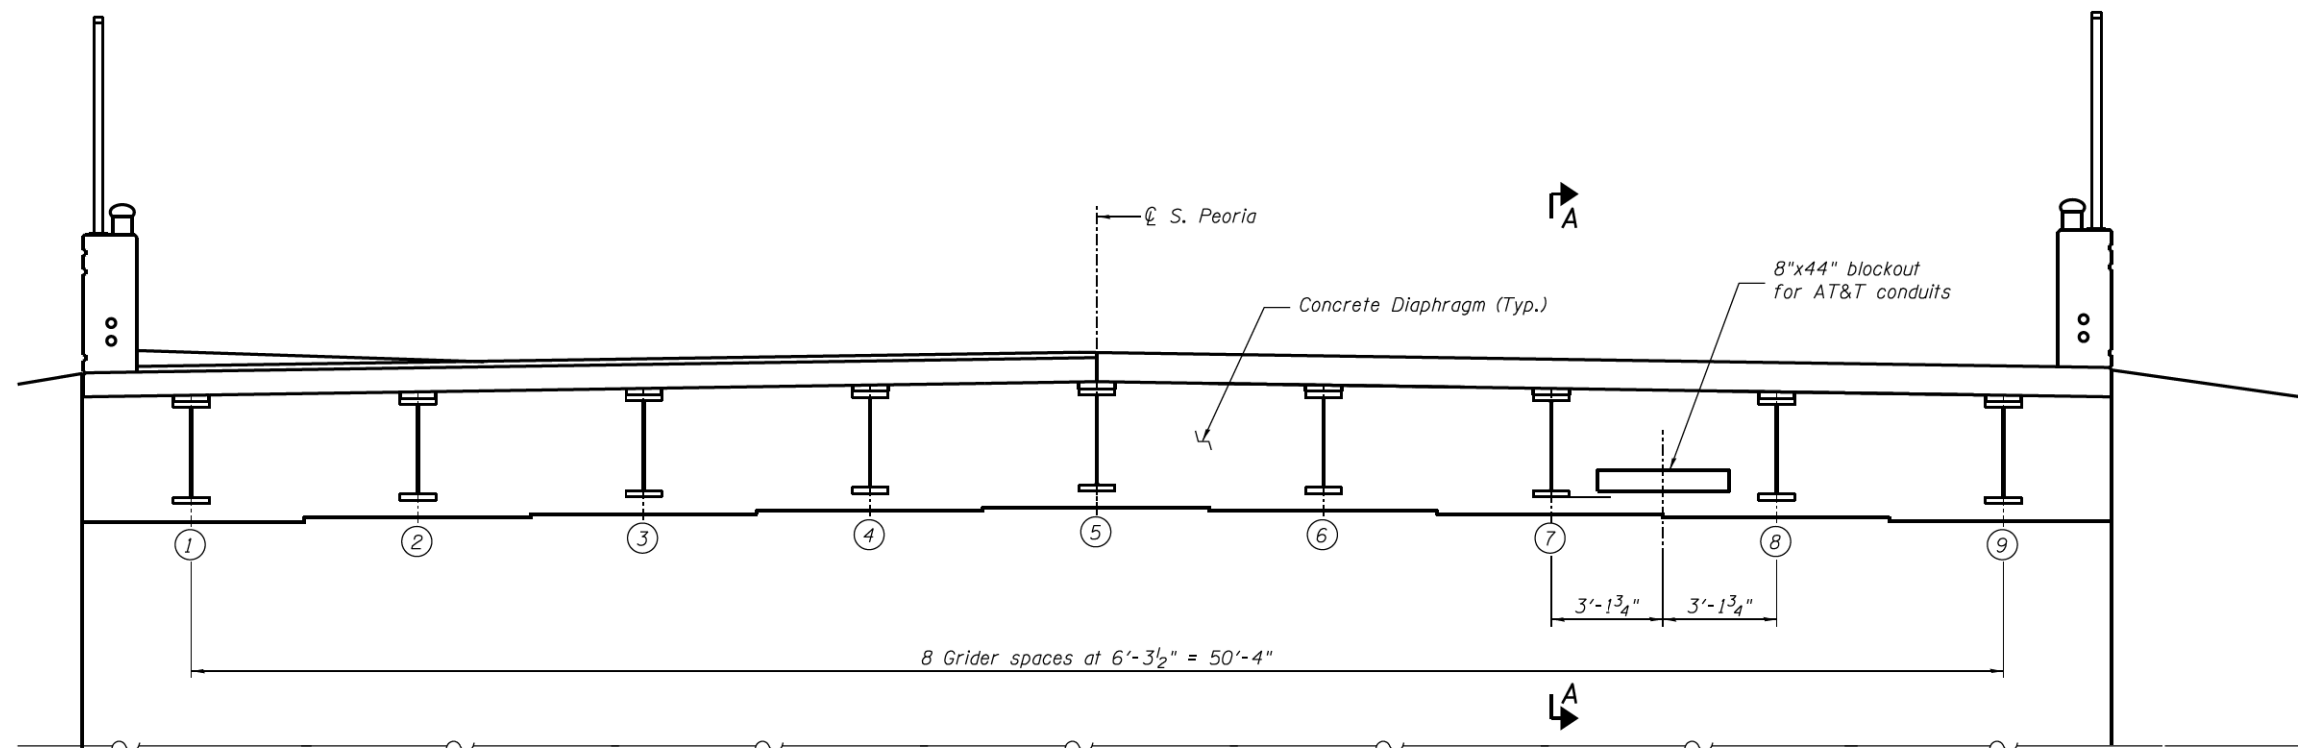

PRECAST DECK CROSS SECTION AT NORTH ABUTMENT
SOUTH ABUTMENT SIMILAR
 (Looking North)

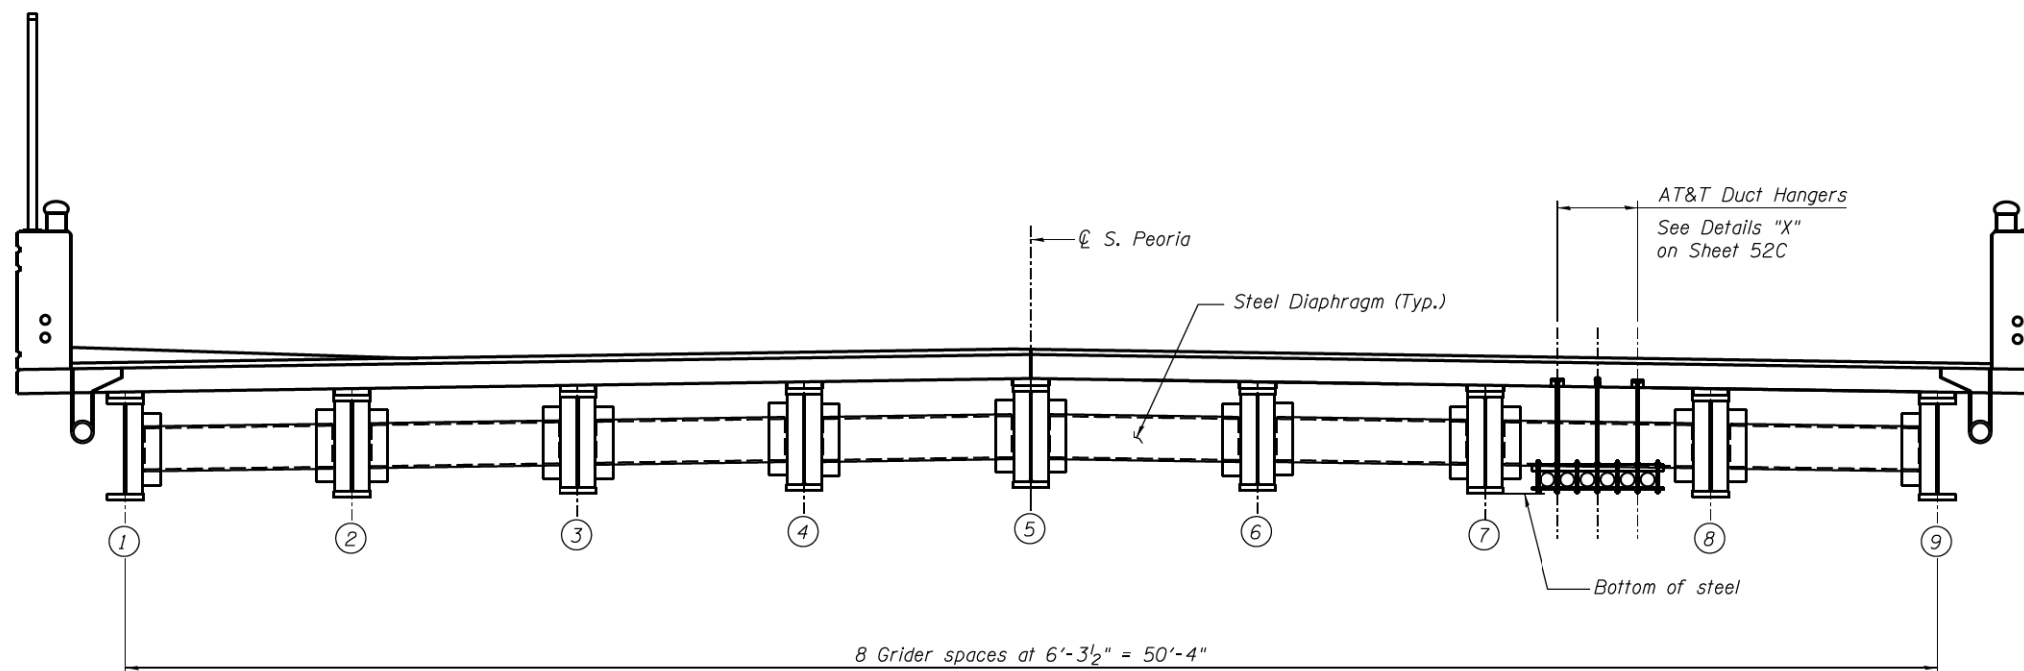

PRECAST DECK CROSS SECTION
 (Looking North)

P:\projects\13022\001\NCADD_Sheets\13022-ATT-52B.dgn






USER NAME = rjcherd,jew	DESIGNED - RD	REVISED Δ 12/18/2013 RJ
PLOT SCALE = None	CHECKED - TB	REVISED
PLOT DATE = 12/13/2013	DRAWN - RJ	REVISED
	CHECKED - TB	REVISED

AT&T PEORIA STREET /I-190
OVERPASS CABLE RELOCATION PROJECT
RE: IDOT CIRCLE INTERCHANGE PROJECT


AT&T CONDUIT HANGERS
PRECAST DECK CROSS SECTIONS

SHEET NO. 52B OF 55 SHEETS

MUN	SECTION	COUNTY	TOTAL SHEETS	SHEET NO.
2090	2012-11R	COOK	356	184B
CONTRACT NO. 60W29			ILLINOIS FED. AID PROJECT	

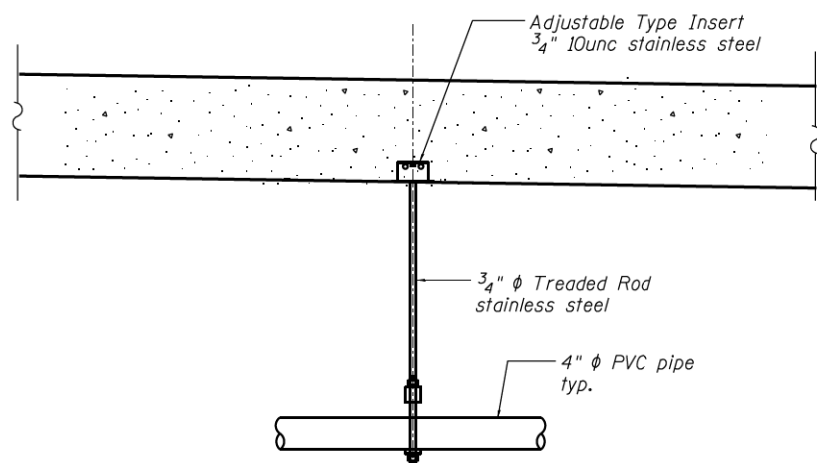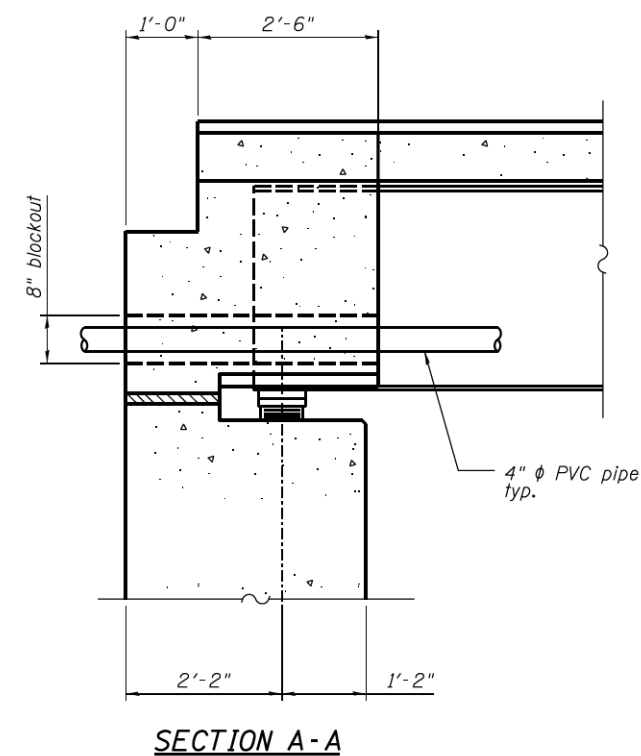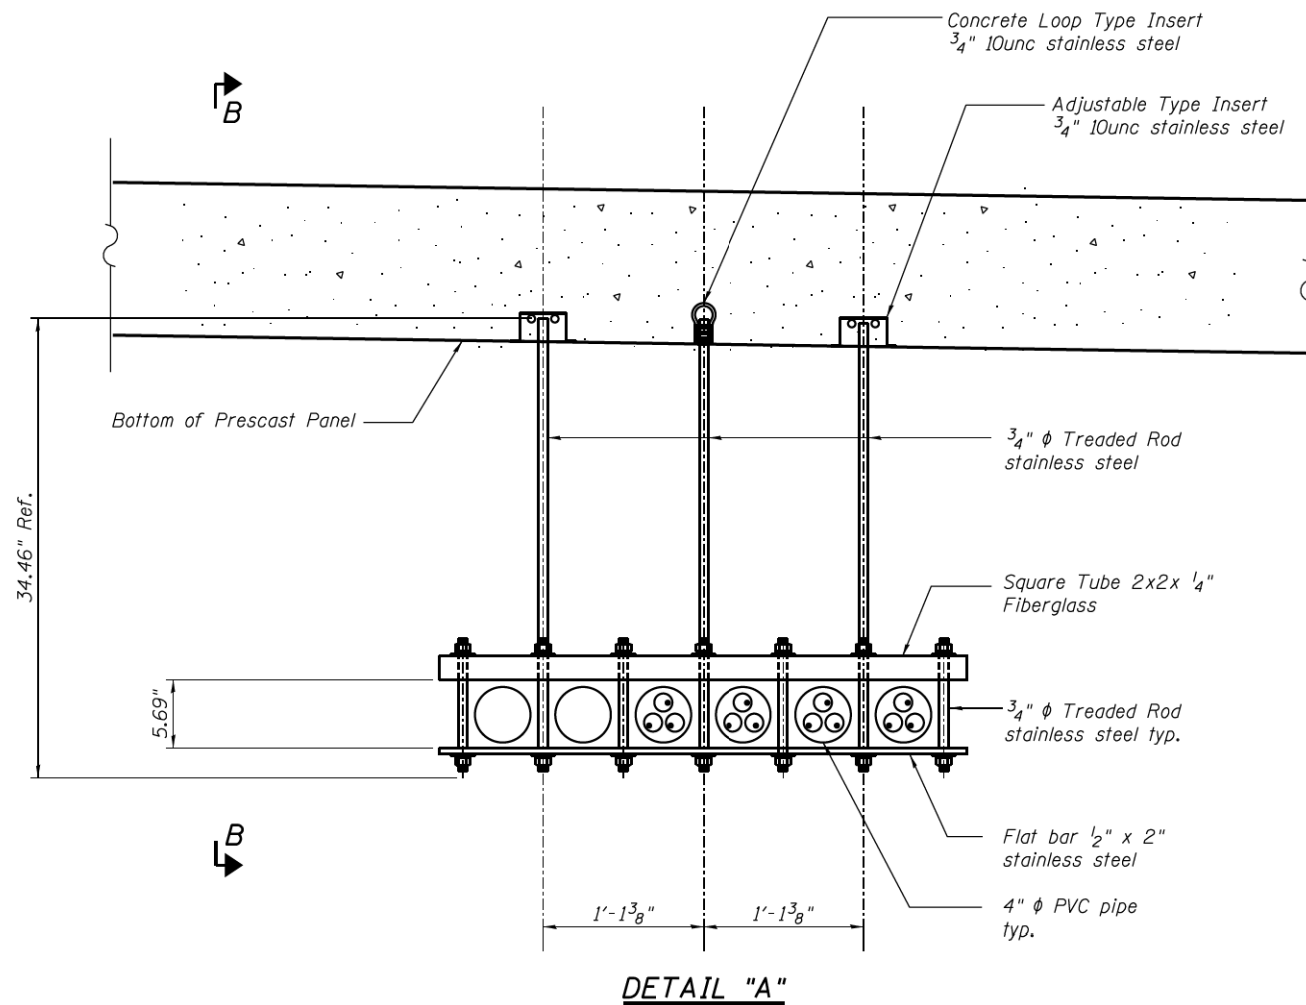

**STANDARD SUPPORT HANGER
WITH STRANDING CLAMPS**

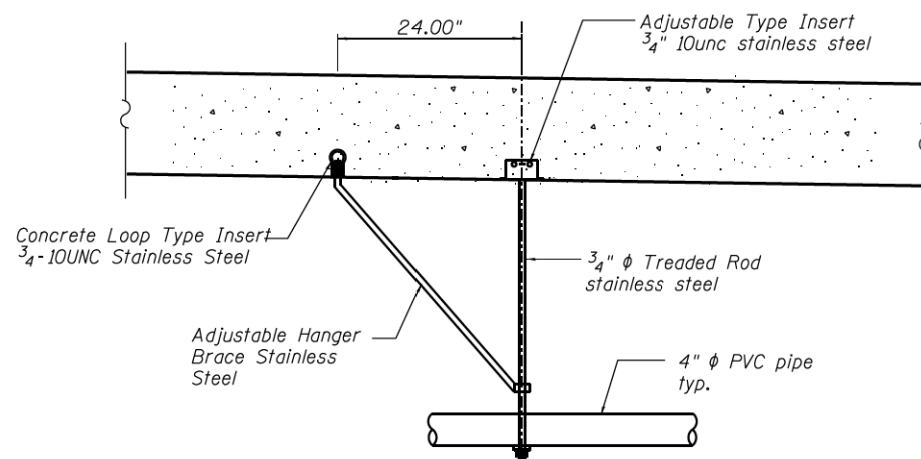

**ABUTMENT SUPPORT HANGER
WITH STRANDING CLAMPS
AND BRACING**

SECTION B-B

▲

P:\projects\13022\001\NS\ADD Sheets\13022-ATT-552C.dgn





USER NAME = rjcherd,jew	DESIGNED - RD	REVISED - 12/18/2013 RJ
PLOT SCALE = None	CHECKED - TB	REVISED
PLOT DATE = 12/13/2013	DRAWN - RJ	REVISED
	CHECKED - TB	REVISED

**AT&T PEORIA STREET /I-190
OVERPASS CABLE RELOCATION PROJECT
RE: IDOT CIRCLE INTERCHANGE PROJECT**

**AT&T CONDUIT HANGERS
SECTIONS AND DETAILS**

SHEET NO. 52C OF 55 SHEETS

MUN	SECTION	COUNTY	TOTAL SHEETS	SHEET NO.
2090	2012-11R	COOK	356	184C
CONTRACT NO. 60W29			ILLINOIS FED. AID PROJECT	

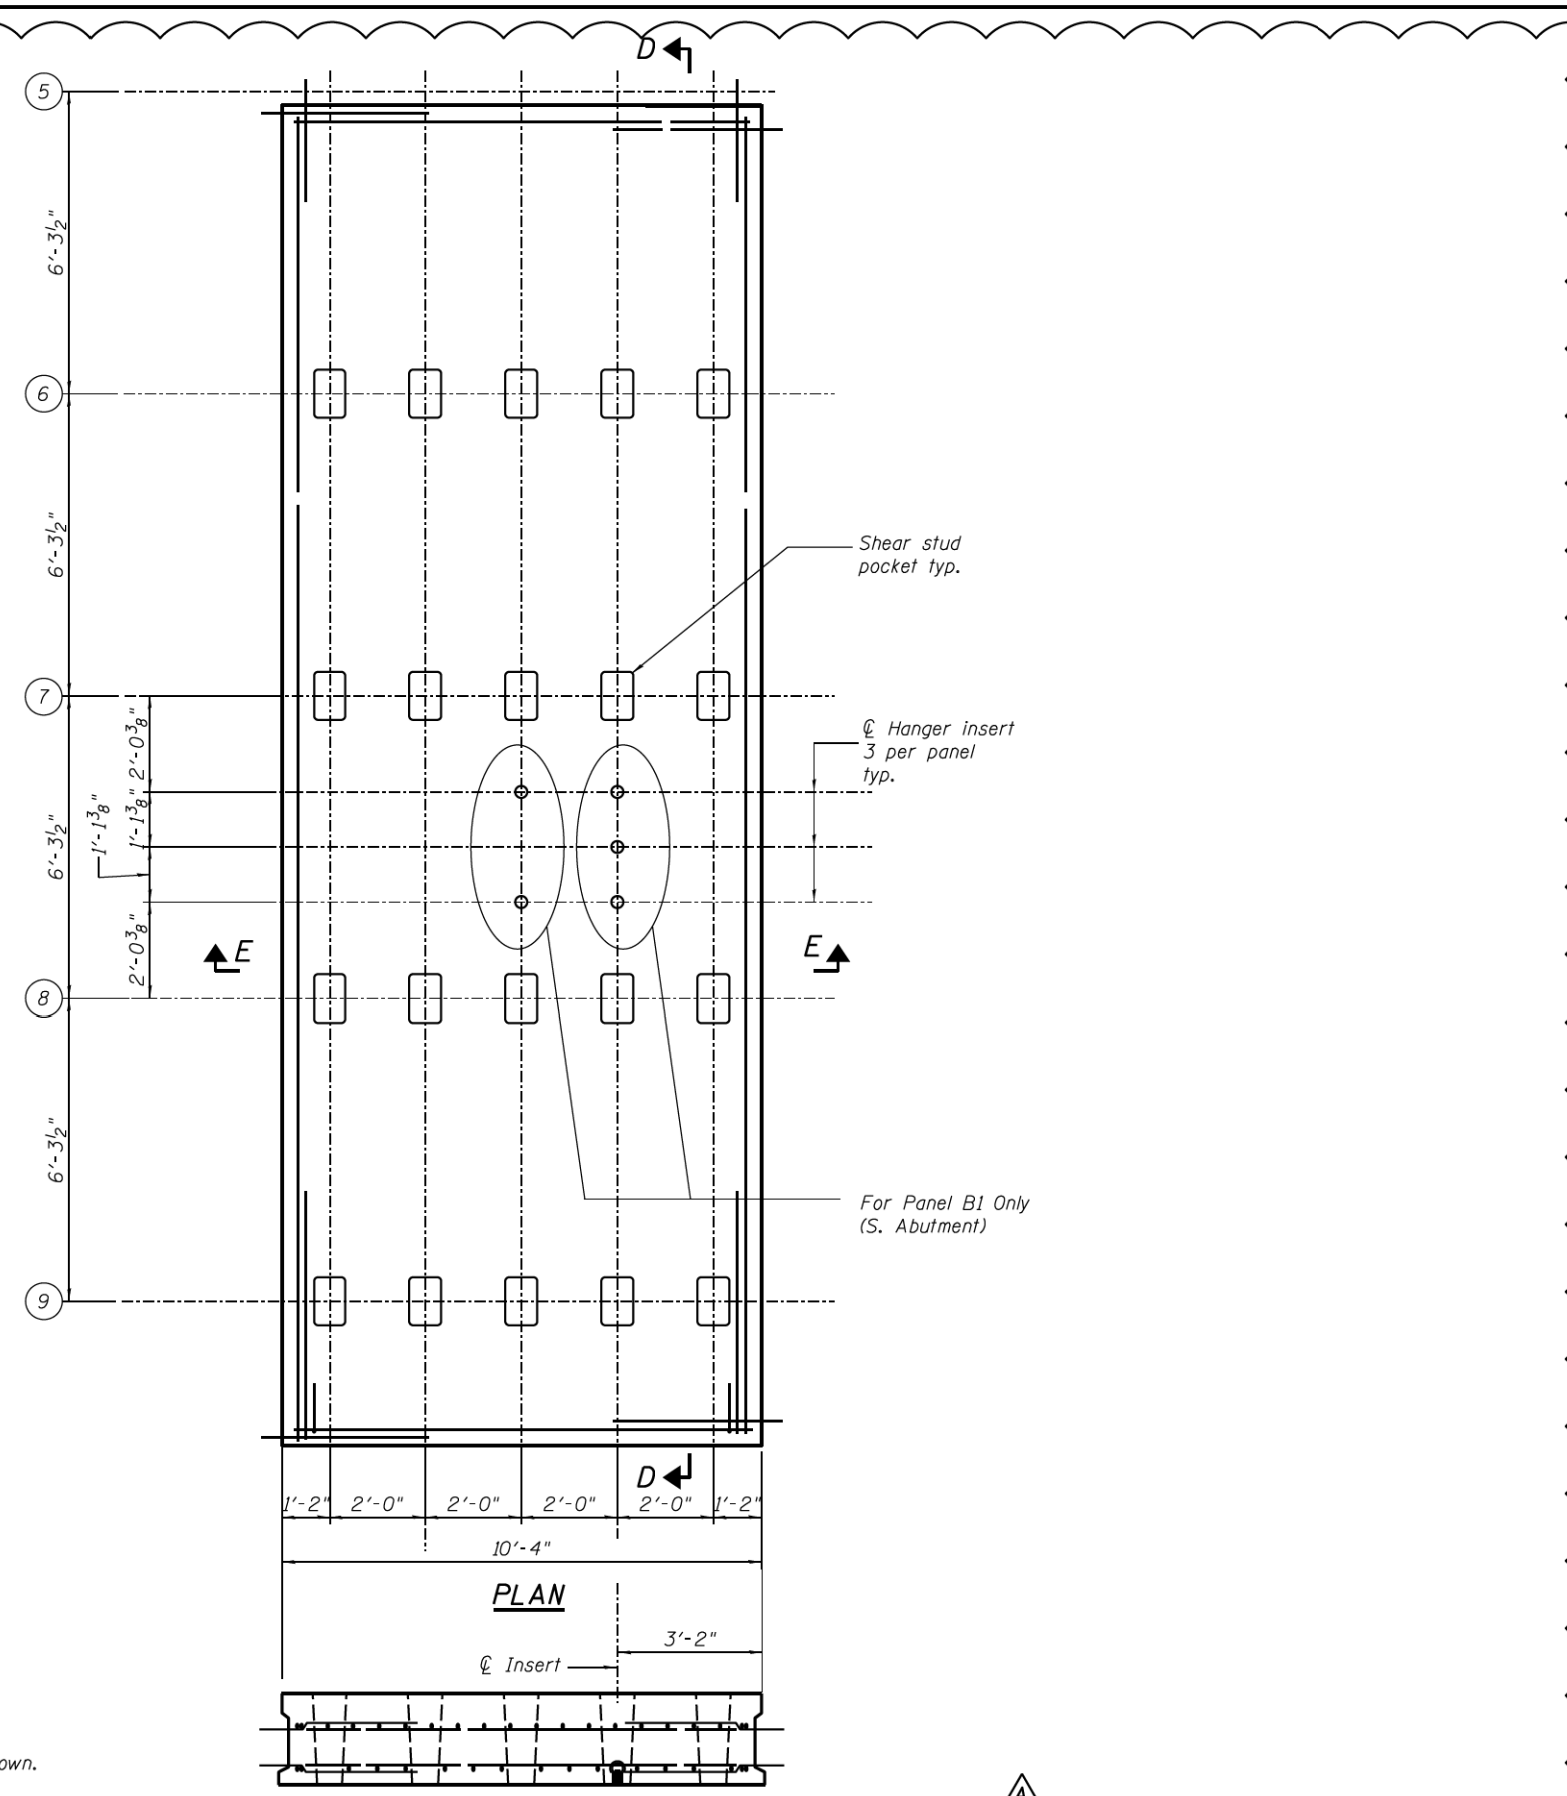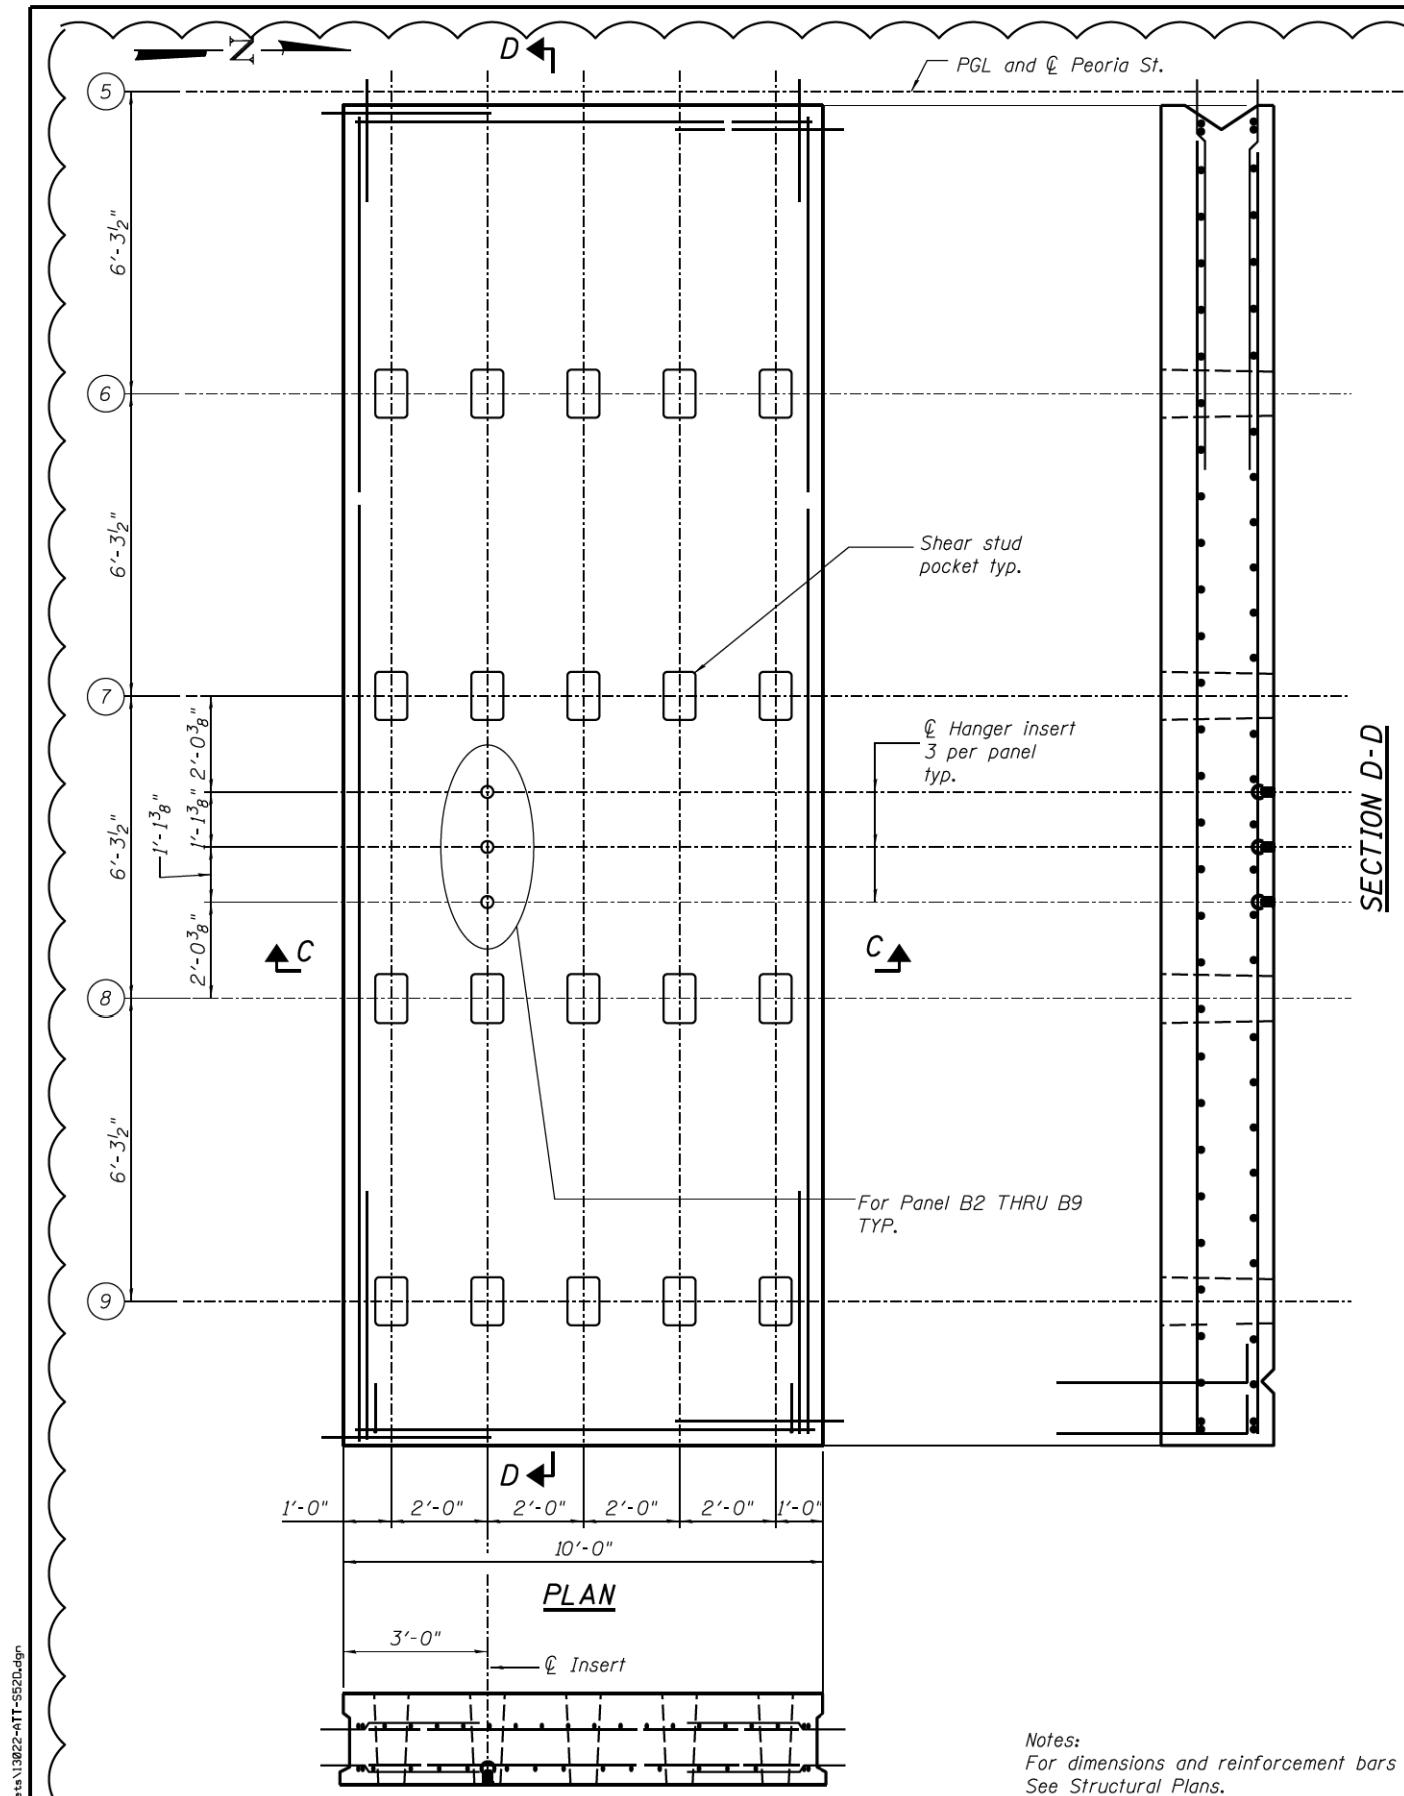

Notes:
For dimensions and reinforcement bars not shown.
See Structural Plans.

PRECAST PANEL DETAILS - AT&T HANGER INSERT

P:\projects\13022\081\NCADD Sheets\13022-ATT-5520.dgn



USER NAME = rjcherd.jew	DESIGNED - RD	REVISED - 12/18/2013 RJ
PLOT SCALE = None	CHECKED - TB	REVISED
PLOT DATE = 12/13/2013	DRAWN - RJ	REVISED
	CHECKED - TB	REVISED

**AT&T PEORIA STREET /I-190
OVERPASS CABLE RELOCATION PROJECT
RE: IDOT CIRCLE INTERCHANGE PROJECT**

**AT&T CONDUIT HANGERS
PRECAST PANEL DETAILS**
SHEET NO. 520 OF 55 SHEETS

MUN	SECTION	COUNTY	TOTAL SHEETS	SHEET NO.
2090	2012-11R	COOK	356	1840
CONTRACT NO. 60W29			ILLINOIS FED. AID PROJECT	



wangeng@wangeng.com
1145 N Main Street
Lombard, IL 60148
Telephone: 630 953-9928
Fax: 630 953-9938


BORING LOG 2082-B-02

WEI Job No.: 1100-04-01

Client **AECOM**
Project **Circle Interchange Reconstruction**
Location **Sections 16 and 17, T39N, R14E of 3rd PM**

Datum: NAVD 88
Elevation: 577.41 ft
North: 1897924.64 ft
East: 1170439.46 ft
Station: 3703+36.04
Offset: 47.69 LT

Page 1 of 2

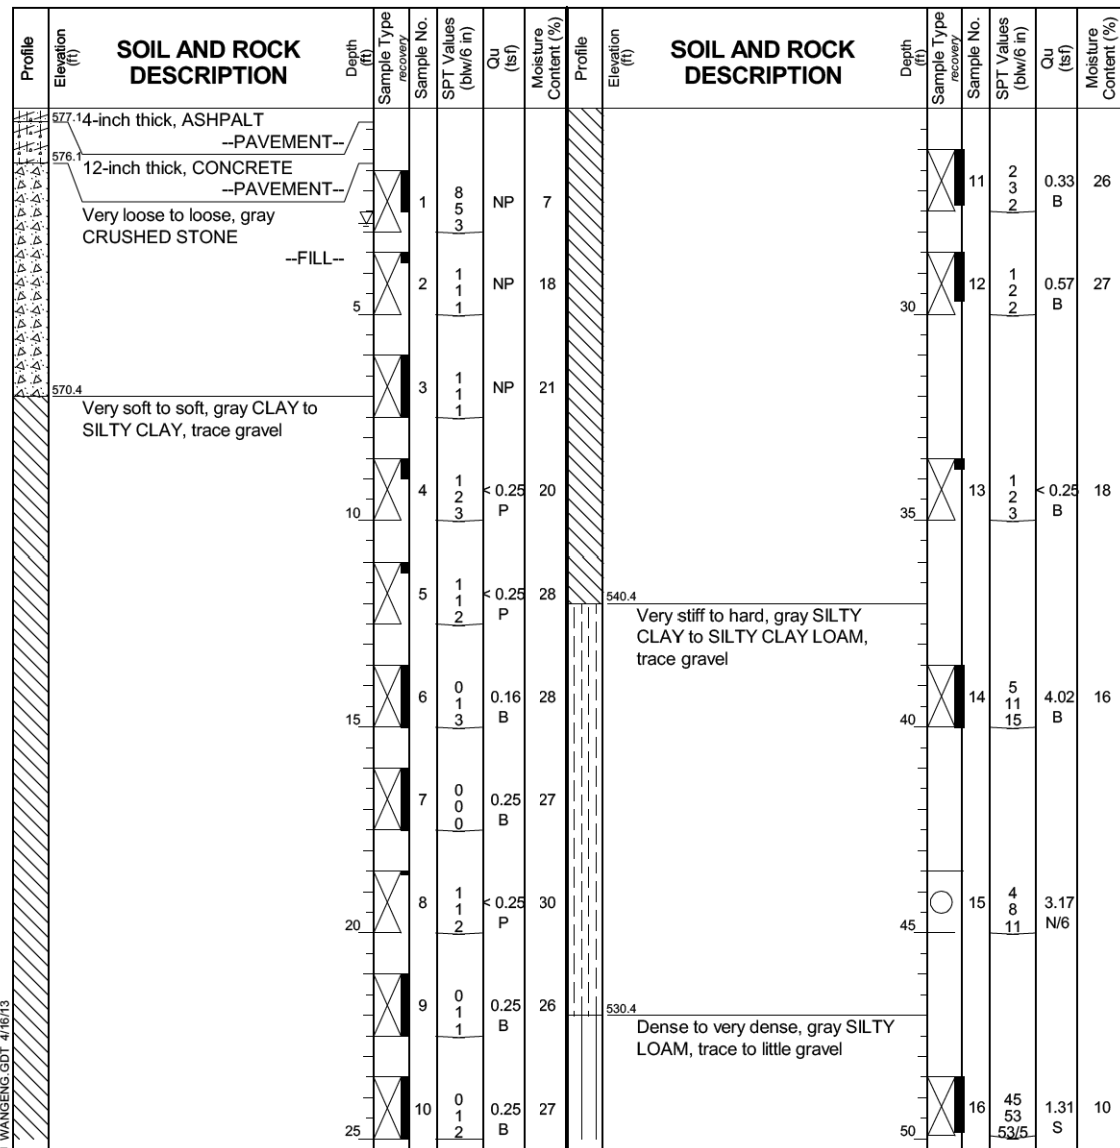

GENERAL NOTES		WATER LEVEL DATA	
Begin Drilling	03-17-2013	Complete Drilling	03-21-2013
Drilling Contractor	Wang Testing Services	Drill Rig	CME-55 TMR
Driller	R&J	Logger	D. Kolpacki
Checked by	C. Marin	Time After Drilling	NA
Drilling Method	2.25" SSA to 10', Mud Rotary 10' thereafter, boring	Depth to Water	NA
backfilled upon completion		The stratification lines represent the approximate boundary between soil types; the actual transition may be gradual.	
While Drilling	2.80 ft	At Completion of Drilling	MUD



wangeng@wangeng.com
1145 N Main Street
Lombard, IL 60148
Telephone: 630 953-9928
Fax: 630 953-9938


BORING LOG 2082-B-02

WEI Job No.: 1100-04-01

Client **AECOM**
Project **Circle Interchange Reconstruction**
Location **Sections 16 and 17, T39N, R14E of 3rd PM**

Datum: NAVD 88
Elevation: 577.41 ft
North: 1897924.64 ft
East: 1170439.46 ft
Station: 3703+36.04
Offset: 47.69 LT

Page 2 of 2

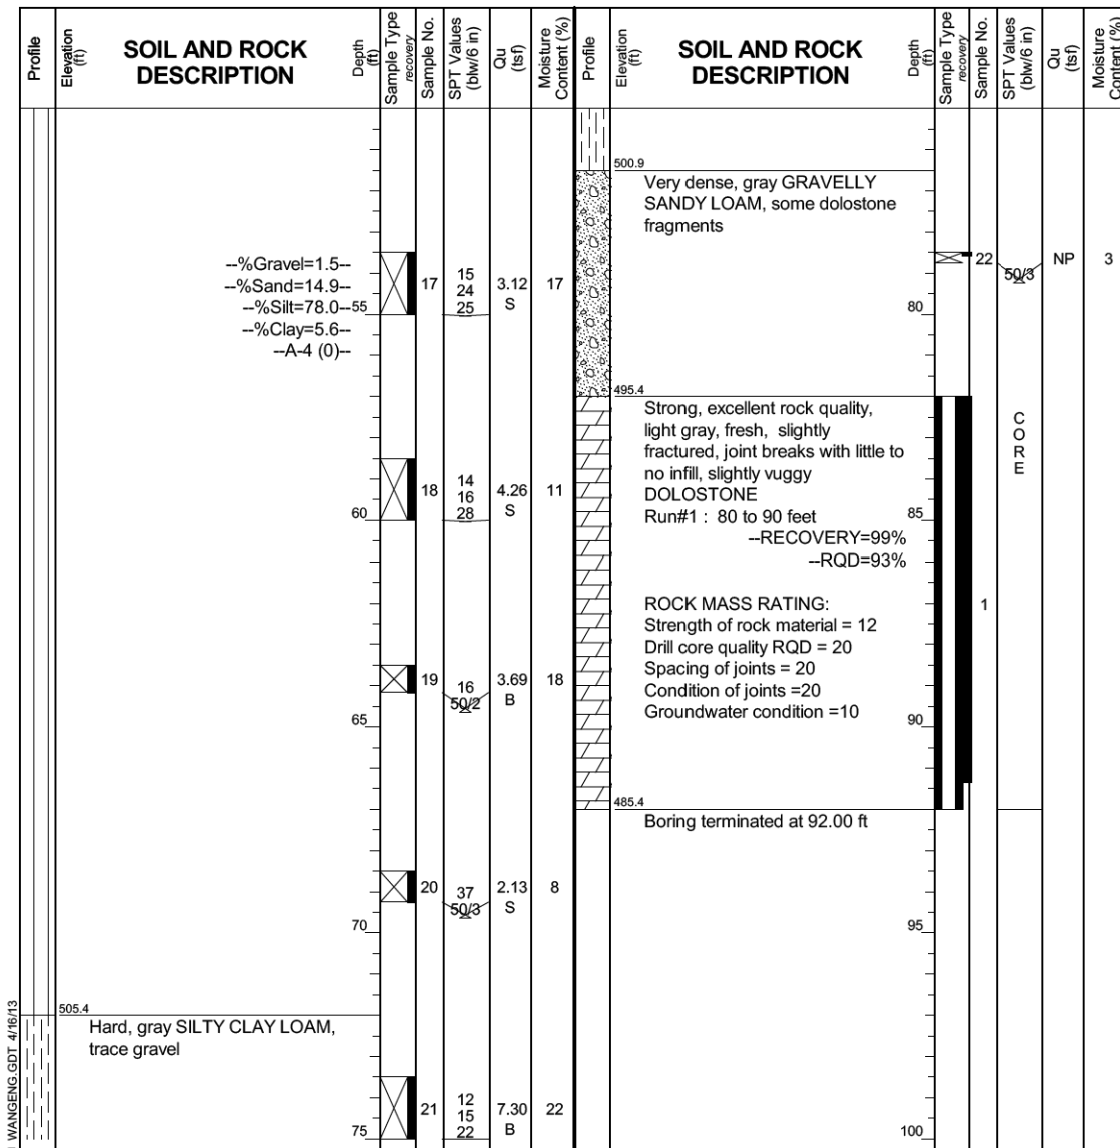

GENERAL NOTES		WATER LEVEL DATA	
Begin Drilling	03-17-2013	Complete Drilling	03-21-2013
Drilling Contractor	Wang Testing Services	Drill Rig	CME-55 TMR
Driller	R&J	Logger	D. Kolpacki
Checked by	C. Marin	Time After Drilling	NA
Drilling Method	2.25" SSA to 10', Mud Rotary 10' thereafter, boring	Depth to Water	NA
backfilled upon completion		The stratification lines represent the approximate boundary between soil types; the actual transition may be gradual.	
While Drilling	2.80 ft	At Completion of Drilling	MUD

9/10/09 PM 01:17:08 - 60W29-5054-Boring-Log2.dgn



USER NAME = BAWIort	DESIGNED RLS	REVISED
PLOT SCALE = 0x2.0000 '1' / 1in.	CHECKED KAH	REVISED
PLOT DATE = 10/28/2013	DRAWN RLS	REVISED
	CHECKED KAH	REVISED

STATE OF ILLINOIS
DEPARTMENT OF TRANSPORTATION

BORING LOGS 2
STRUCTURE NO. 016-1708

SHEET NO. 54 OF 55 SHEETS

MUN	SECTION	COUNTY	TOTAL SHEETS	SHEET NO.
2090	2013-011R	COOK	356	186
CONTRACT NO.			60W29	
ILLINOIS FED. AID PROJECT				



wangeng@wangeng.com
1145 N Main Street
Lombard, IL 60148
Telephone: 630 953-9928
Fax: 630 953-9938

BORING LOG 2082-B-03

WEI Job No.: 1100-04-01

Client: **AECOM**
Project: **Circle Interchange Reconstruction**
Location: **Sections 16 and 17, T39N, R14E of 3rd PM**

Datum: NAVD 88
Elevation: 595.34 ft
North: 1897847.44 ft
East: 1170487.25 ft
Station: 3702+57.39
Offset: 02.32 LT

Profile Elevation (ft)	SOIL AND ROCK DESCRIPTION	Depth (ft)	Sample No.	Sample No.	SPT Values (blows/6 in)	Qu (tsf)	Moisture Content (%)	Profile Elevation (ft)	SOIL AND ROCK DESCRIPTION	Depth (ft)	Sample No.	Sample No.	SPT Values (blows/6 in)	Qu (tsf)	Moisture Content (%)
594.3	12-inch thick CONCRETE --PAVEMENT--														
592.3	Very stiff, black and brown SILTY CLAY LOAM, little gravel and brick fragments		1	7	7	2.38	16				11	0	0.08	26	
	--FILL--														
	Loose to medium dense, black, brown and gray, fine SAND, some gravel and brick fragments		2	7	8	NP	6				12	0	0.25	26	
	--FILL--														
			3	2	2	NP	8								
			4	2	2	NP	7				13	0	0.08	26	
			5	6	6	NP	22								
			6	5	14	NP	19				14	1	0.08	24	
579.8	Very soft, gray CLAY, some gravel		7	1	2	0.16	20								
			8	2	1	0.08	22				15	2	0.25	28	
			9	1	1	0.08	22								
			10	1	2	0.08	21				16	1	0.25	23	

GENERAL NOTES				WATER LEVEL DATA			
Begin Drilling	03-18-2013	Complete Drilling	03-19-2013	While Drilling	DRY		
Drilling Contractor	Wang Testing Services	Drill Rig	D-50 TMR	At Completion of Drilling	DRY		
Driller	R&N	Logger	D. Wind	Time After Drilling	NA		
Checked by	C. Marin	Drilling Method	2.25" SSA to 10', Mud Rotary 10' thereafter, boring	Depth to Water	NA		
backfilled upon completion				The stratification lines represent the approximate boundary between soil types; the actual transition may be gradual.			



wangeng@wangeng.com
1145 N Main Street
Lombard, IL 60148
Telephone: 630 953-9928
Fax: 630 953-9938

BORING LOG 2082-B-03

WEI Job No.: 1100-04-01

Client: **AECOM**
Project: **Circle Interchange Reconstruction**
Location: **Sections 16 and 17, T39N, R14E of 3rd PM**

Datum: NAVD 88
Elevation: 595.34 ft
North: 1897847.44 ft
East: 1170487.25 ft
Station: 3702+57.39
Offset: 02.32 LT

Profile Elevation (ft)	SOIL AND ROCK DESCRIPTION	Depth (ft)	Sample No.	Sample No.	SPT Values (blows/6 in)	Qu (tsf)	Moisture Content (%)	Profile Elevation (ft)	SOIL AND ROCK DESCRIPTION	Depth (ft)	Sample No.	Sample No.	SPT Values (blows/6 in)	Qu (tsf)	Moisture Content (%)
543.3	Stiff to hard, gray SILTY CLAY, trace gravel							518.3	Very dense, gray SILTY LOAM, trace gravel						
			17	8	5	1.34	21				22	20	6.15	13	
			18	7	14	4.84	15				23	23	1.64	16	
			19	5	10	4.42	21				24	30	1.50	16	
			20	8	11	4.10	23				25	50/1'	NP	11	
			21	4	4	1.23	31								

GENERAL NOTES				WATER LEVEL DATA			
Begin Drilling	03-18-2013	Complete Drilling	03-19-2013	While Drilling	DRY		
Drilling Contractor	Wang Testing Services	Drill Rig	D-50 TMR	At Completion of Drilling	DRY		
Driller	R&N	Logger	D. Wind	Time After Drilling	NA		
Checked by	C. Marin	Drilling Method	2.25" SSA to 10', Mud Rotary 10' thereafter, boring	Depth to Water	NA		
backfilled upon completion				The stratification lines represent the approximate boundary between soil types; the actual transition may be gradual.			

9:10:14 PM 01/17/08-60W29-5055-Boring-Log3.dgn



USER NAME = BAWItoft	DESIGNED RLS	REVISED
PLOT SCALE = 0x2.0000 'x' / in.	CHECKED KAH	REVISED
PLOT DATE = 10/28/2013	DRAWN RLS	REVISED
	CHECKED KAH	REVISED



STATE OF ILLINOIS
DEPARTMENT OF TRANSPORTATION

BORING LOGS 3
STRUCTURE NO. 016-1708

SHEET NO. 55 OF 55 SHEETS

MUN	SECTION	COUNTY	TOTAL SHEETS	SHEET NO.
2090	2013-011R	COOK	356	187
ILLINOIS FED. AID PROJECT			CONTRACT NO.	60W29

Bench Mark: Chisel "X" on south flange bolt of first fire hydrant south of Van Buren Street on west side of Peoria Street. Elev. 594.37
 The road will be closed and traffic detoured during construction.

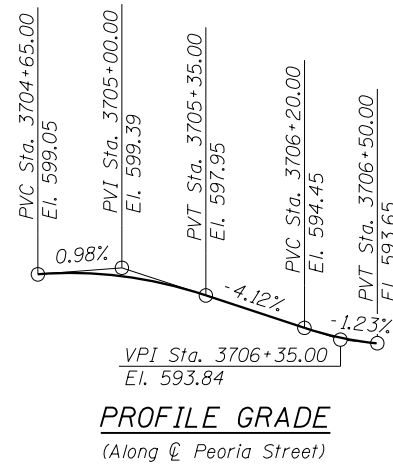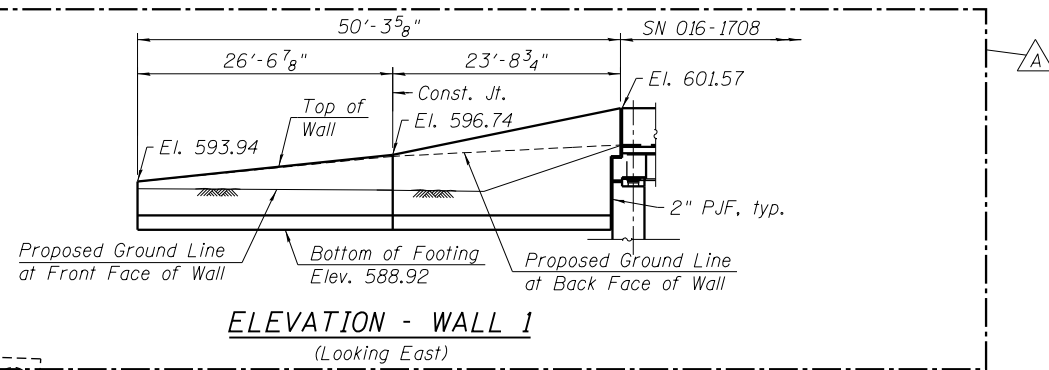

GENERAL NOTES

- Reinforcement bars designated (E) shall be epoxy coated.
- All construction joints shall be bonded.
- Minimum bar laps shall be:

Bar	Min. Lap
#4	2'-7"
#5	3'-3"
- Station and offsets are measured from the centerline of Peoria Street to the front face of the wall.
- Exposed concrete edges shall have a standard $\frac{3}{4}$ " chamfer unless otherwise noted. Chamfer on vertical edges shall be continued a minimum of 1 foot below the finished ground line.

INDEX OF SHEETS

- General Plan and Elevation
- Retaining Wall 1 Details

DESIGN SPECIFICATIONS


2012 AASHTO LRFD Bridge Design Specifications
 6th Edition, with 2013 Interim Revisions

DESIGN STRESSES

FIELD UNITS
 $f'_c = 3,500$ psi
 $f_y = 60,000$ psi (Reinforcement)


TOTAL BILL OF MATERIAL

Item	Unit	Quantity
Structural Excavation	Cu. Yd.	75
Concrete Structures	Cu. Yd.	28.9
Reinforcement Bars, Epoxy Coated	Pound	2,130
Concrete Sealer	Sq. Ft.	337
Geocomposite Wall Drain	Sq. Yd.	37
Granular Backfill for Structures	Cu. Yd.	36
Pipe Underdrains for Structures 4"	Foot	51

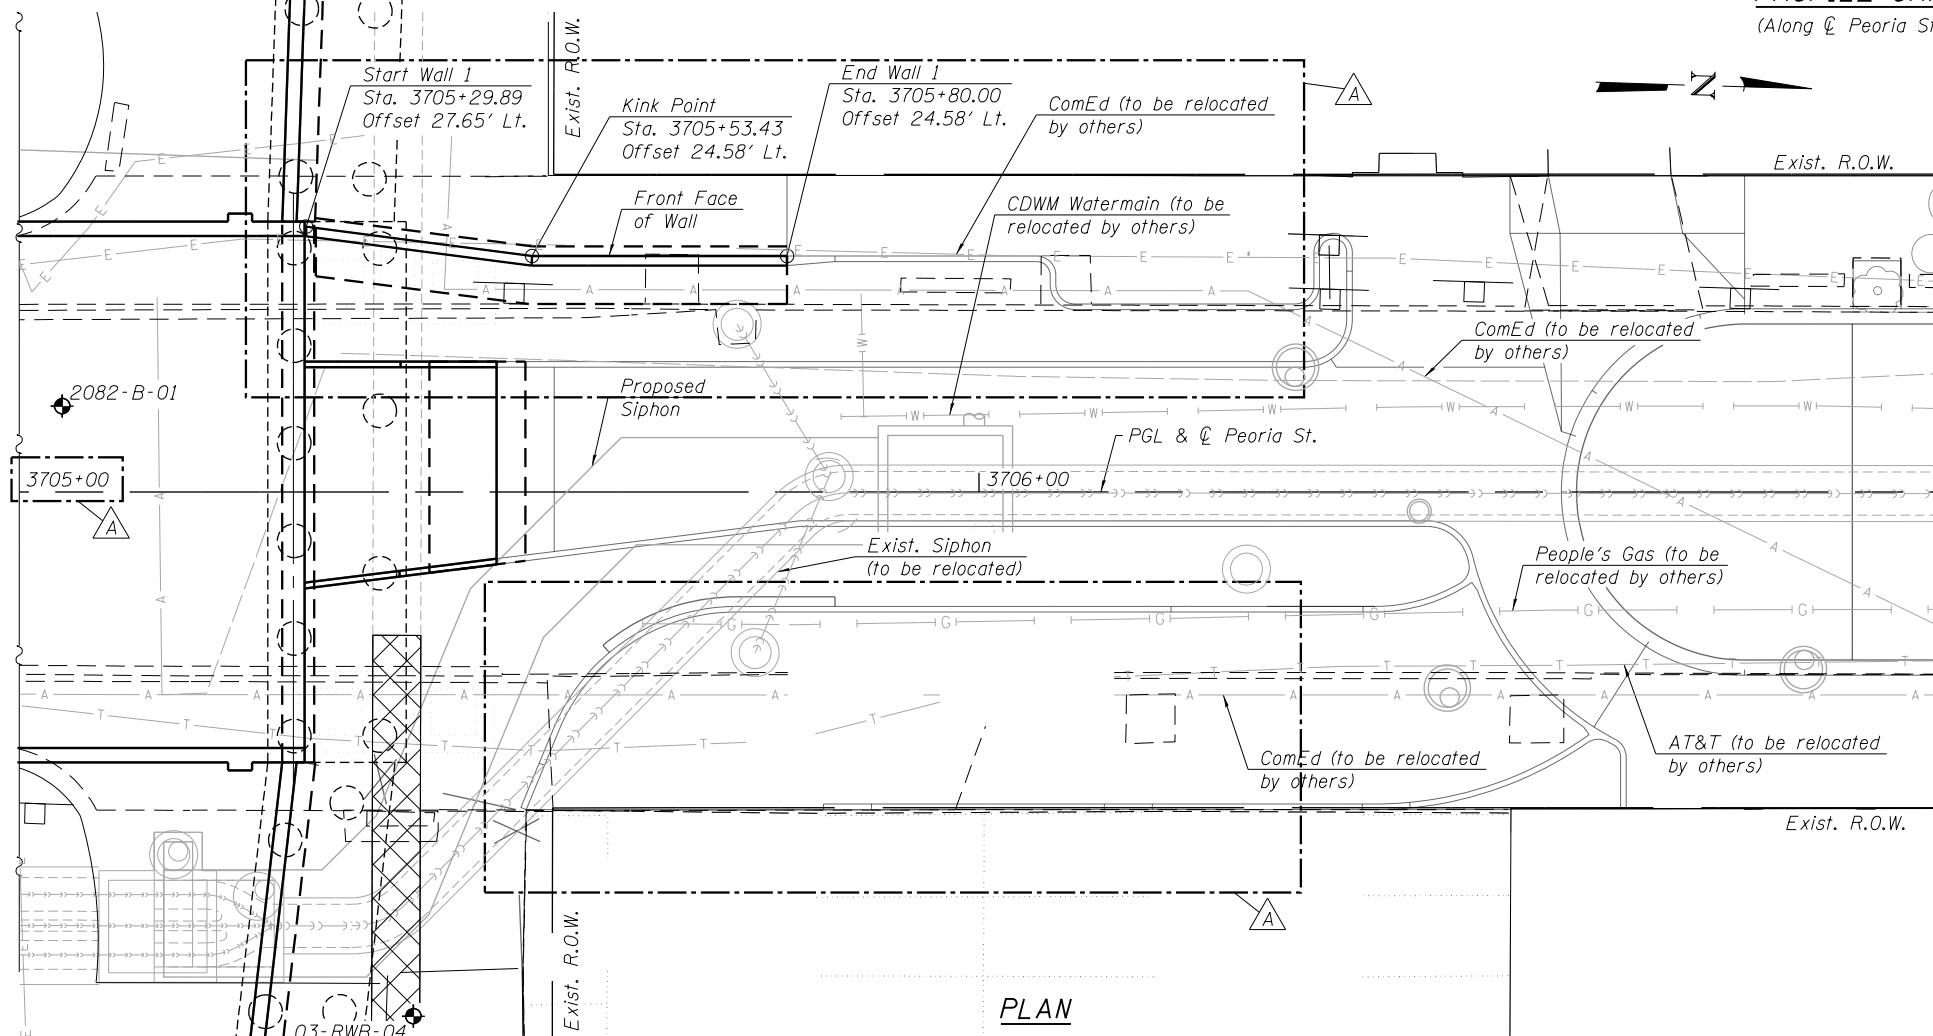

LEGEND

◆ Soil Boring Location

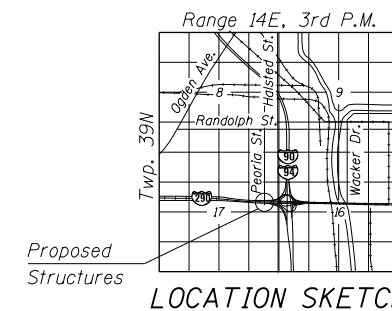

GENERAL PLAN AND ELEVATION
RETAINING WALL ALONG PEORIA STREET
MUN 2090 SECTION 2013-011R
COOK COUNTY

WALL 1-STATION 3705+29.89 TO 3705+80.00

10:34:29 AM
 0161708-GOW29-5164-RetWall_GP.dgn




USER NAME = BAWitorf	DESIGNED MDS	REVISED A 12/18/2013 WJC/MDS
PLOT SCALE = 20.0002' / in.	CHECKED KAH	REVISED
PLOT DATE = 12/19/2013	DRAWN WJC	REVISED
	CHECKED MDS	REVISED

STATE OF ILLINOIS
DEPARTMENT OF TRANSPORTATION


SHEET NO. 1 OF 2 SHEETS

MUN	SECTION	COUNTY	TOTAL SHEETS	SHEET NO.
2090	2013-011R	COOK	356	188
CONTRACT NO.			60W29	


ILLINOIS FED. AID PROJECT

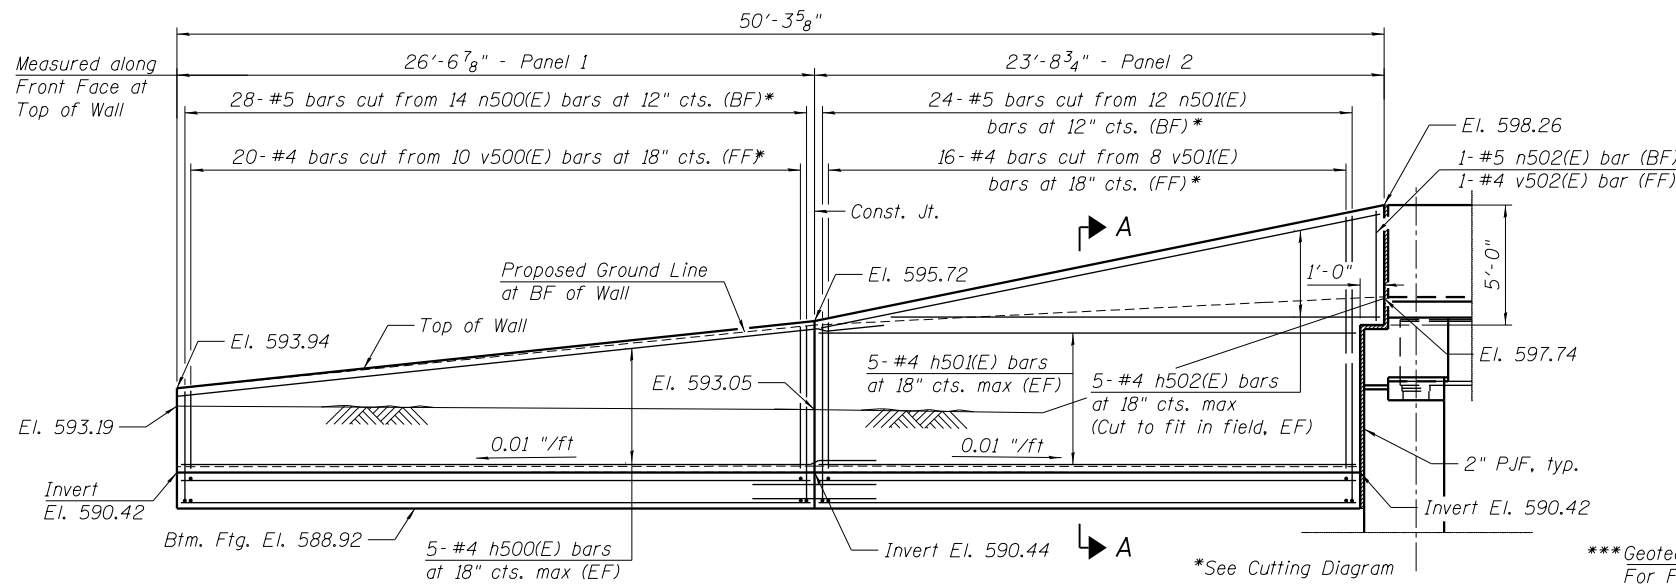


WALL 1 - ELEVATION
(Looking East)

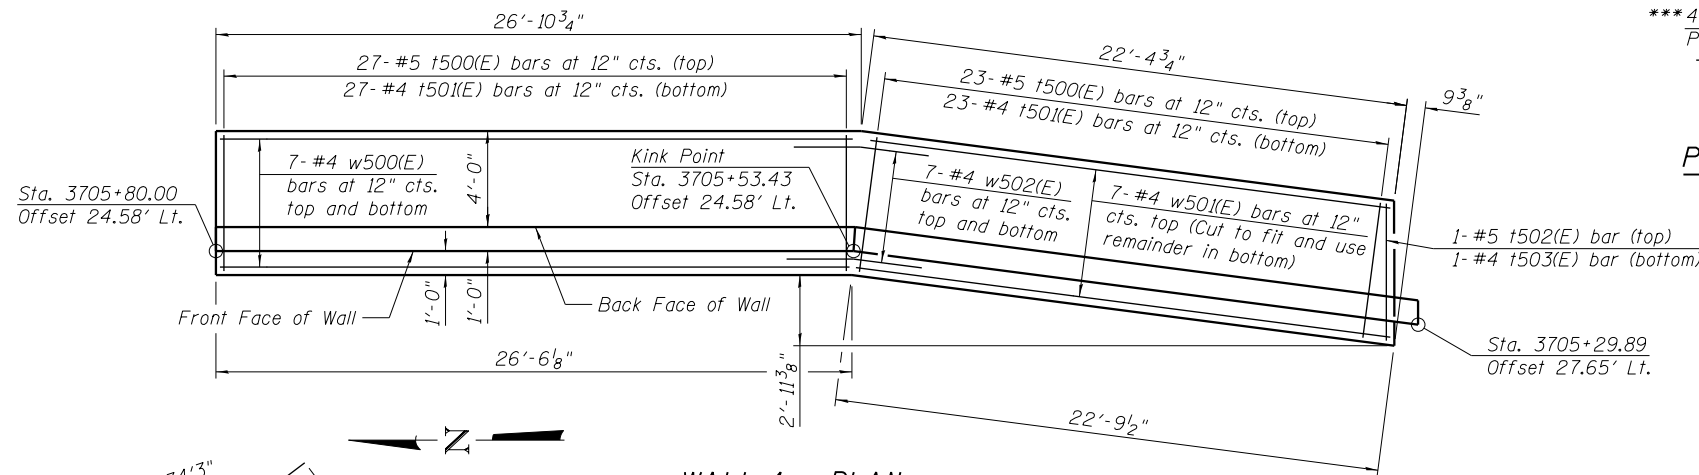


WALL 1 - PLAN

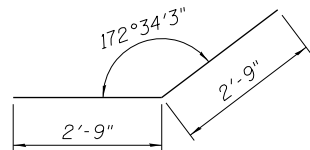

BAR w502(E)

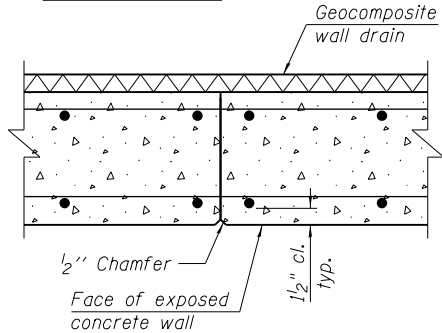

CONSTRUCTION JOINT DETAIL

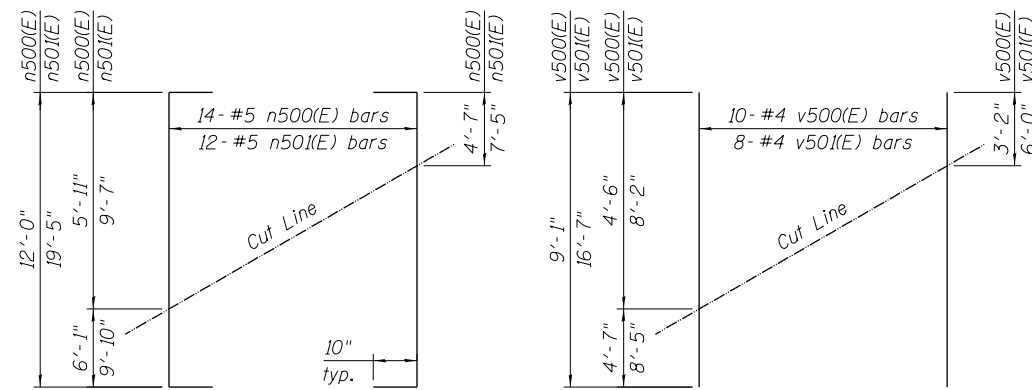


FIELD CUTTING DIAGRAM

Order bars full length.

FIELD CUTTING DIAGRAM

Order bars full length.

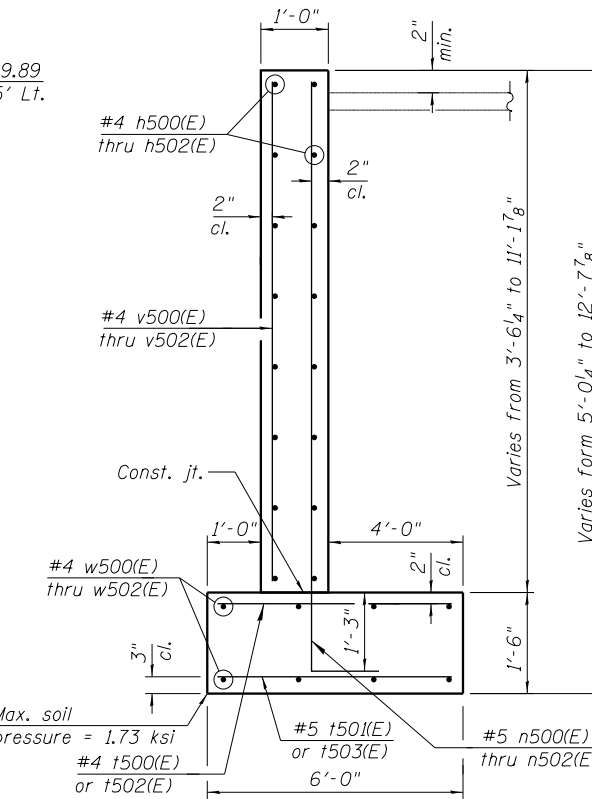


SECTION A-A

*** Included in the cost of Pipe Underdrains for Structures 4".


**** Backfill remainder of structure excavation and over excavation with same material specified for roadway embankment.

**** Over excavation beyond the limits of structure excavation. This area not measured for payment.

**** Structure Excavation See Section 502 of the Standard Specification

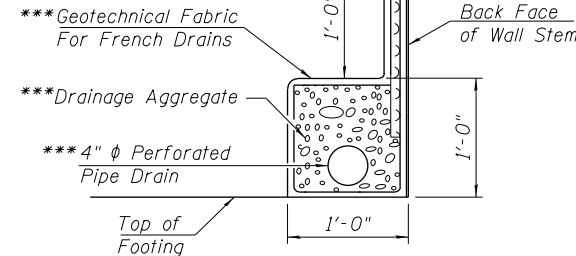

PIPE UNDERDRAIN DETAIL

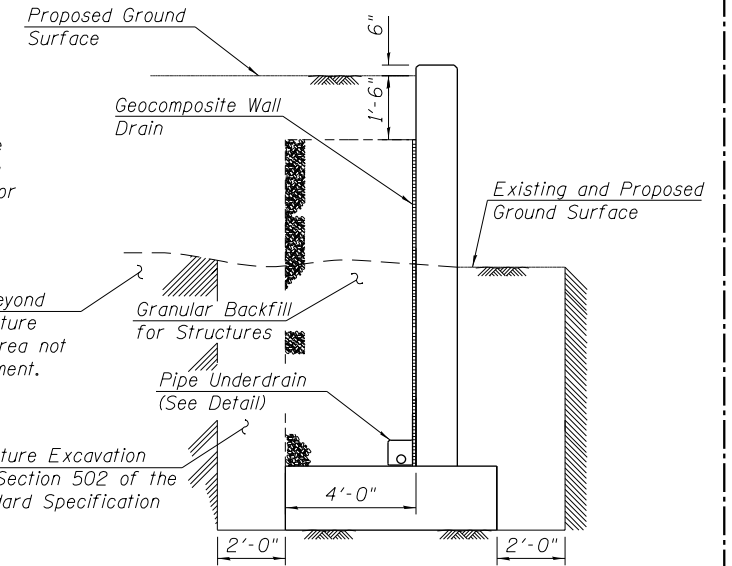

SECTION THRU WALL

BILL OF MATERIAL

Bar	No.	Size	Length	Shape
h500(E)	10	#4	29'-4"	—
h501(E)	10	#4	22'-5"	—
h502(E)	10	#4	23'-11"	—
n500(E)	14	#5	13'-8"	┌
n501(E)	12	#5	21'-1"	┌
n502(E)	1	#5	4'-7"	—
v500(E)	10	#4	9'-1"	—
v501(E)	8	#4	16'-7"	—
v502(E)	1	#4	4'-7"	—
t500(E)	50	#5	5'-8"	—
t501(E)	50	#4	5'-8"	—
t502(E)	1	#5	5'-11"	—
t503(E)	1	#4	5'-11"	—
w500(E)	14	#4	26'-7"	—
w501(E)	14	#4	22'-1"	—
w502(E)	14	#4	5'-6"	┘
Structure Excavation		Cu. Yd.	75	
Concrete Structures		Cu. Yd.	28.9	
Reinforcement Bars, Epoxy Coated		Pound	2,130	
Concrete Sealer		Sq. Ft.	337	
Geocomposite Wall Drain		Sq. Yd.	37	
Granular Backfill For Structures		Cu. Yd.	36	
Pipe Underdrains For Structures 4"		Foot	51	

**Cut to fit in field

10:34:31 AM 0161708-GOW29-S165-RetWall_SED.dgn



USER NAME = BAWIort	DESIGNED WJC	REVISED 12/18/2013 WJC/MDS
PLOT SCALE = 8x0.0000 ' / in.	CHECKED MDS	REVISED
PLOT DATE = 12/19/2013	DRAWN WJC	REVISED
	CHECKED MDS	REVISED

STATE OF ILLINOIS
DEPARTMENT OF TRANSPORTATION


RETAINING WALL 1
DETAILS

SHEET NO. 2 OF 2 SHEETS

MUN 2090	SECTION 2013-011R	COUNTY COOK	TOTAL SHEETS 356	SHEET NO. 189
CONTRACT NO. 60W29			ILLINOIS FED. AID PROJECT	


Bench Mark: Chisel "X" on south flange bolt of first fire hydrant south of Van Buren Street on west side of Peoria Street. Elev. 594.37
 The road will be closed and traffic detoured during construction.

A

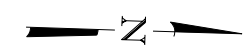


GENERAL NOTES

- Station and offsets are measured from the centerline of Peoria Street to the front face of the wall.

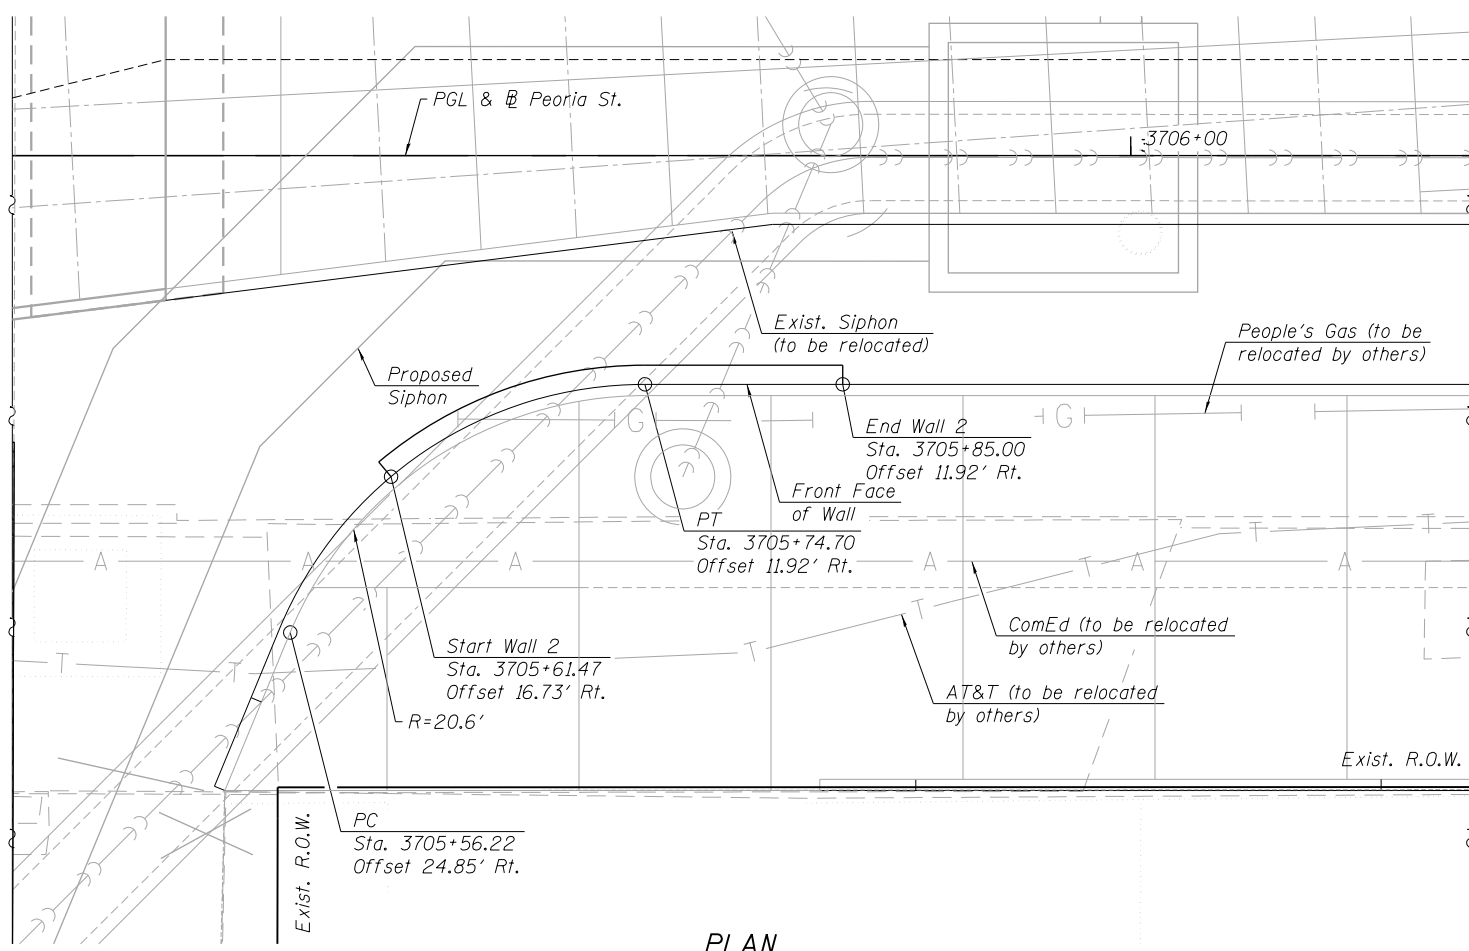


PLAN

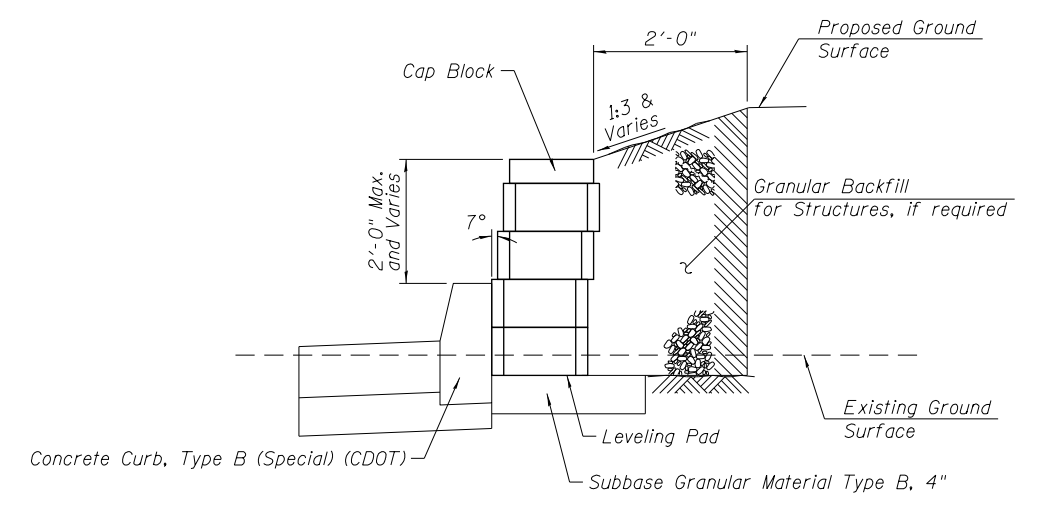


SECTION A-A

TOTAL BILL OF MATERIAL


Item	Unit	Quantity
Segmental Concrete Block Wall	Sq. Ft.	50

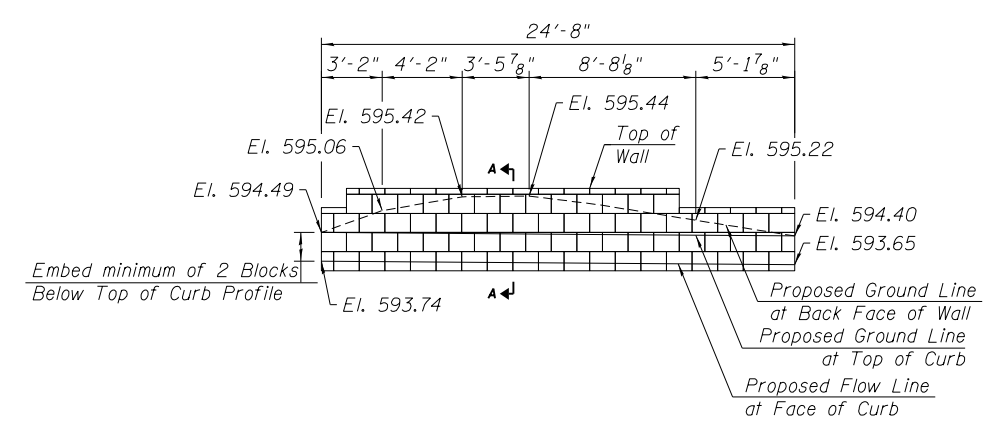

ELEVATION - WALL 2
(Looking West)

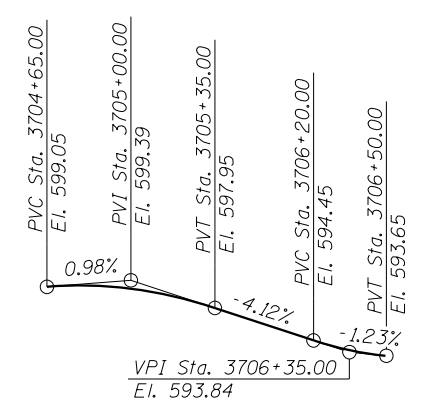

PROFILE GRADE
(Along Peoria Street)

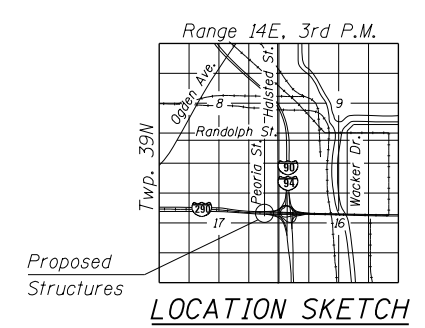

LOCATION SKETCH

**GENERAL PLAN AND ELEVATION
 RETAINING WALL ALONG PEORIA STREET
 MUN 2090 SECTION 2013-011R
 COOK COUNTY
 WALL 2-STATION 3705+61.47 TO 3705+85.00**

10:34:33 AM 0161708-60W29-5165A-Res+Wall2.dgn



USER NAME = BAWItoft	DESIGNED MDS	REVISION 12/18/2013 KAL/JMG
PLOT SCALE = 10.0001' / in.	CHECKED KAH	REVISION
PLOT DATE = 12/19/2013	DRAWN WJC	REVISION
	CHECKED MDS	REVISION

**STATE OF ILLINOIS
 DEPARTMENT OF TRANSPORTATION**


SHEET NO. 1 OF 1 SHEETS

MUN 2090	SECTION 2013-011R	COUNTY COOK	TOTAL SHEETS 356	SHEET NO. 190
CONTRACT NO. 60W29			ILLINOIS FED. AID PROJECT	

INTENTIONALLY LEFT BLANK

10:34:35 AM
0161708-60W29-S165B-Rev1Wall.DET



USER NAME = BAWtor+	DESIGNED WJC	REVISED  12/18/2013 KAL/JMG
	CHECKED MDS	REVISED
PLOT SCALE = 4:0.0000 ' / in.	DRAWN WJC	REVISED
PLOT DATE = 12/19/2013	CHECKED MDS	REVISED

**STATE OF ILLINOIS
DEPARTMENT OF TRANSPORTATION**

SHEET NO. 2 OF 2 SHEETS

MUN	SECTION	COUNTY	TOTAL SHEETS	SHEET NO.
2090	2013-011R	COOK	356	191
CONTRACT NO. 60W29				
ILLINOIS FED. AID PROJECT				

SHEET INDEX

GENERAL

G-001 SHEET INDEX
G-002 CODE MATRIX

STRUCTURAL

S-001 GENERAL NOTES
S-002 GENERAL NOTES, ABBREVIATIONS AND SYMBOLS
S-003 DRILLED SHAFT AND PILE CAP DETAILS
S-004 PARTIAL FOUNDATION AND PLATFORM DEMO PLANS
S-005 PLATFORM CANOPY DEMO PLAN
S-006 PLATFORM SHORING SECTIONS
S-007 STATION SHORING PLAN
S-008 STATION SHORING BUILDING SECTION
S-009 SHORING DETAILS
S-100 PARTIAL PLATFORM FOUNDATION PLAN
S-110 PARTIAL PLATFORM FRAMING PLAN
S-120 PARTIAL PLATFORM CANOPY FRAMING PLAN
S-130 STATION FRAMING PLAN
S-140 STATION ROOF FRAMING PLAN
S-200 ELEVATOR SHAFT SECTIONS
S-300 FOUNDATION SECTIONS AND DETAILS
S-301 FOUNDATION SECTIONS AND DETAILS
S-302 FOUNDATION SECTIONS AND DETAILS
S-500 STATION FLOOR SECTIONS AND DETAILS
S-501 STATION FLOOR SECTIONS AND DETAILS
S-502 STATION ROOF SECTIONS AND DETAILS
S-600 SCHEDULES AND DETAILS

ARCHITECTURAL

AD-001 DEMOLITION GENERAL NOTES
AD-100 DEMOLITION OVERALL PLATFORM FLOOR PLAN
AD-101 DEMOLITION PLATFORM FLOOR PLAN
AD-120 DEMOLITION STATION FLOOR PLAN
AD-121 DEMOLITION STATION REFLECTED CEILING PLAN
AD-130 DEMOLITION STATION ROOF PLAN
AD-200 DEMOLITION STATION ELEVATION
AD-201 DEMOLITION STATION ELEVATION
AD-202 DEMOLITION STATION ELEVATIONS
AD-300 DEMOLITION STATION SECTION
AD-301 DEMOLITION STATION SECTION
AD-302 DEMOLITION STATION SECTION
AD-700 INTENTIONALLY LEFT BLANK
A-001 GENERAL NOTES & PARTITION TYPES
A-002 ARCHITECTURAL SITE PLAN
A-100 OVERALL PLATFORM FLOOR PLAN
A-101 PARTIAL PLATFORM FLOOR PLAN
A-120 STATION FLOOR PLAN
A-121 STATION REFLECTED CEILING PLAN
A-130 STATION ROOF PLAN
A-200 STATION ELEVATION
A-201 STATION ELEVATION
A-202 STATION ELEVATIONS
A-300 STATION SECTION
A-301 STATION SECTION
A-302 STATION SECTIONS
A-400 ENLARGED RESTROOM AND AGENT KIOSK PLANS AND DETAILS
A-401 STATION INTERIOR ELEVATIONS
A-500 WEST STAIR DETAILS
A-501 ENLARGED ELEVATOR AND MACHINE ROOM PLANS
A-502 ENLARGED ELEVATOR AND MACHINE ROOM PLANS
A-503 EXTERIOR ELEVATOR ELEVATIONS
A-504 EXTERIOR ELEVATOR ELEVATIONS
A-505 ELEVATOR AND MACHINE ROOM SECTIONS
A-506 ELEVATOR AND MACHINE ROOM SECTIONS
A-510 ELEVATOR AND MACHINE ROOM SECTIONS
A-511 INTENTIONALLY LEFT BLANK
A-600 STATION DETAILS
A-601 STATION DETAILS
A-602 STATION DETAILS
A-603 STATION DETAILS
A-604 STATION DETAILS
A-605 STATION DETAILS
A-606 STATION DETAILS
A-607 STATION DETAILS
A-608 STATION DETAILS
A-609 STATION DETAILS

SHEET INDEX CONT.

ARCHITECTURAL

A-610 STATION DETAILS
A-611 STATION DETAILS
A-612 WINDOW, DOORS, LOUVER SCHEDULE
A-620 TACTILE PANEL PLAN, SECTION AND DETAILS
A-700 STATION SIGNAGE FLOOR PLAN
A-701 INTENTIONALLY LEFT BLANK
A-702 STATION SIGNAGE SCHEDULE
A-703 STATION SIGNAGE MOUNTING DETAILS
A-704 ELEVATOR CONTROL DETAILS
A-705 INTENTIONALLY LEFT BLANK
A-706 INTENTIONALLY LEFT BLANK

MECHANICAL

M-001 MECHANICAL STATION HOUSE & PARTIAL PLATFORM PLAN
M-002 DETAILS, NOTES AND SYMBOL LIST
M-003 MECHANICAL ELEVATOR ELEVATION

PLUMBING

P-001 PLUMBING STATION HOUSE & PARTIAL PLATFORM PLANS
P-002 PLUMBING NOTES, DIAGRAMS AND SYMBOL LIST
P-003 PLUMBING ELEVATOR ELEVATION
P-004 PLUMBING DETAILS

ELECTRICAL

E-001 ELECTRICAL SYMBOLS, ABBREVIATIONS AND NOTES
E-101 ELECTRICAL PLATFORM LEVEL POWER PLAN
E-102 ELECTRICAL PLATFORM LEVEL POWER PLAN
E-120 ELECTRICAL STATION HOUSE POWER PLAN
E-121 ELECTRICAL STATION HOUSE LIGHTING PLAN
E-122 ELECTRICAL REMOTE KIOSK PANEL
E-130 ELECTRICAL BRIDGE PLAN
E-200 ELECTRICAL SINGLE LINE DIAGRAM
E-201 ELECTRICAL PANEL SCHEDULES
E-202 ELECTRICAL LIGHTING FIXTURE SCHEDULES
E-203 ELECTRICAL CABLE/CONDUIT SCHEDULE PART 1
E-204 ELECTRICAL CABLE/CONDUIT SCHEDULE PART 2
E-205 ELECTRICAL INTERFACE TERMINAL CABINET & ALARM RELAY PANEL RCP
E-206 CONTROL DIAGRAMS ITC AND RCP PANELS
E-207 ELECTRICAL HEAT TRACE FREEZE PROTECTION PANEL (HTC-1)
E-208 ELECTRICAL CONTROL DIAGRAM HEAT TRACING PART 1
E-209 ELECTRICAL CONTROL DIAGRAM HEAT TRACING PART 2
E-210 ELECTRICAL CONTROL DIAGRAMS PART 1
E-211 ELECTRICAL CONTROL DIAGRAMS PART 2
E-212 ELECTRICAL CONTROL DIAGRAMS PART 3
E-213 ELECTRICAL BLOCK DIAGRAMS
E-214 ELECTRICAL DETAILS
E-300 CITY LOAD CALCS AND EXIT LTG CATALOG CUT
E-301 COMMUNICATION SYMBOLS, CONDUIT AND CABLE LEGENDS AND ABBREVIATIONS



COMMUNICATION

T-001 COMMUNICATION SYMBOLS, CONDUIT AND CABLE LEGENDS AND ABBREVIATIONS
T-002 COMMUNICATION GENERAL NOTES
T-110 COMMUNICATION PLATFORM LEVEL PLAN
T-111 COMMUNICATION PLATFORM LEVEL CENTER EQUIPMENT PLAN
T-112 COMMUNICATION PLATFORM LEVEL CENTER TO EAST EQUIPMENT PLAN
T-113 COMMUNICATION PLATFORM LEVEL EAST EQUIPMENT PLAN
T-120 COMMUNICATION STATION LEVEL EQUIPMENT PLAN
T-200 COMMUNICATIONS TELEPHONE SYSTEM BLOCK DIAGRAM
T-201 COMMUNICATION EXISTING EQUIPMENT WIRING DIAGRAM
T-300 COMMUNICATION EXISTING HUB DETAILS PART 1
T-301 COMMUNICATION EXISTING HUB DETAILS PART 2
T-302 COMMUNICATION EXISTING HUB DETAILS PART 3
T-303 COMMUNICATION STANDARD DETAILS COMMUNICATION HUB
T-304 COMMUNICATION CCTV CAMERA DETAILS
T-400 COMMUNICATION EQUIPMENT WIRING REQUIREMENT SCHEDULE
T-401 COMMUNICATION EQUIPMENT SCHEDULE PART 1
T-402 COMMUNICATION EQUIPMENT SCHEDULE PART 2

ABBREVIATIONS

#	POUND OR NUMBER	PLUMB	PLUMBING
&	AND	PLYD	PLYWOOD
@	AT	PT	PAINT OR PAINTED
ACT	ACOUSTIC CEILING TILE	PVC	POLYVINYL CHLORIDE
AFF	ABOVE FINISHED FLOOR	RBR	RUBBER
ALUM	ALUMINUM	RCP	REFLECTED CEILING PLAN
ANOD	ANODIZED	RD	ROOF DRAIN
BYND	BEYOND	REQD	REQUIRED
BOT	BOTTOM	RM	ROOM
CHNL	CHANNEL	SIM	SIMILAR
CJ	CONTROL JOINT	SPEC	SPECIFIED OR SPECIFICATION
CLG	CEILING	SSTL	STAINLESS STEEL
CLR	CLEAR	STL	STEEL
CMU	CONCRETE MASONRY UNIT	STRUCT	STRUCTURE OR STRUCTURAL
COL	COLUMN	TELE	TELEPHONE
COM	PRCOMPRESSIBLE	TLT	TOILET
CON	CONCRETE	TO	TOP OF
CONT	CONTINUOUS	TOC	TOP OF CONCRETE
CT	CERAMIC TILE	TOS	TOP OF STEEL
CTYD	COURTYARD	TYP	TYPICAL
DBL	DOUBLE	UNO	UNLESS NOTED OTHERWISE
DEMO	DEMOLISH OR DEMOLITION	VIF	VERIFY IN FIELD
DIA	DIAMETER	W/	WITH
DIM	DIMENSION		
DIMS	DIMENSIONS		
DN	DOWN		
DR	DOOR		
DWG	DRAWING		
EA	EACH		
EJ	EXPANSION JOINT		
EL	ELEVATION		
ELEC	ELECTRICAL		
EL	ELEVATOR OR ELEVATION		
EPDM	ETHYLENE PROPYLENE DIENE M-CLASS (ROOFING)		
EQ	EQUAL		
EXIST	EXISTING		
EXP JT	EXPANSION JOINT		
EXT	EXTERIOR		
FD	FLOOR DRAIN OR FIRE DEPARTMENT		
FIXT	FIXTURE		
FLR	FLOOR		
FO	FACE OF		
FND	FOUNDATION		
GA	GAUGE		
GALV	GALVANIZED		
GWB	GYPSUM WALL BOARD		
HM	HOLLOW METAL		
HP	HIGH POINT		
HR	HOUR		
HVAC	HEATING, VENTILATING, AND AIR CONDITIONING		
IRGWB	IMPACT RESISTANT GYPSUM WALL BOARD		
ILO	IN LIEU OF		
INSUL	INSULATED OR INSULATION		
INT	INTERIOR		
MAX	MAXIMUM		
MECH	MECHANICAL		
MIN	MINIMUM		
MTL	METAL		
NIC	NOT IN CONTRACT		
NO	NUMBER		
NOM	NOMINAL		
OC	ON CENTER		
OH	OPPOSITE HAND		

LEGEND

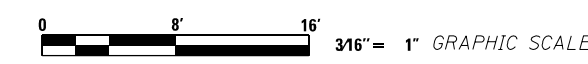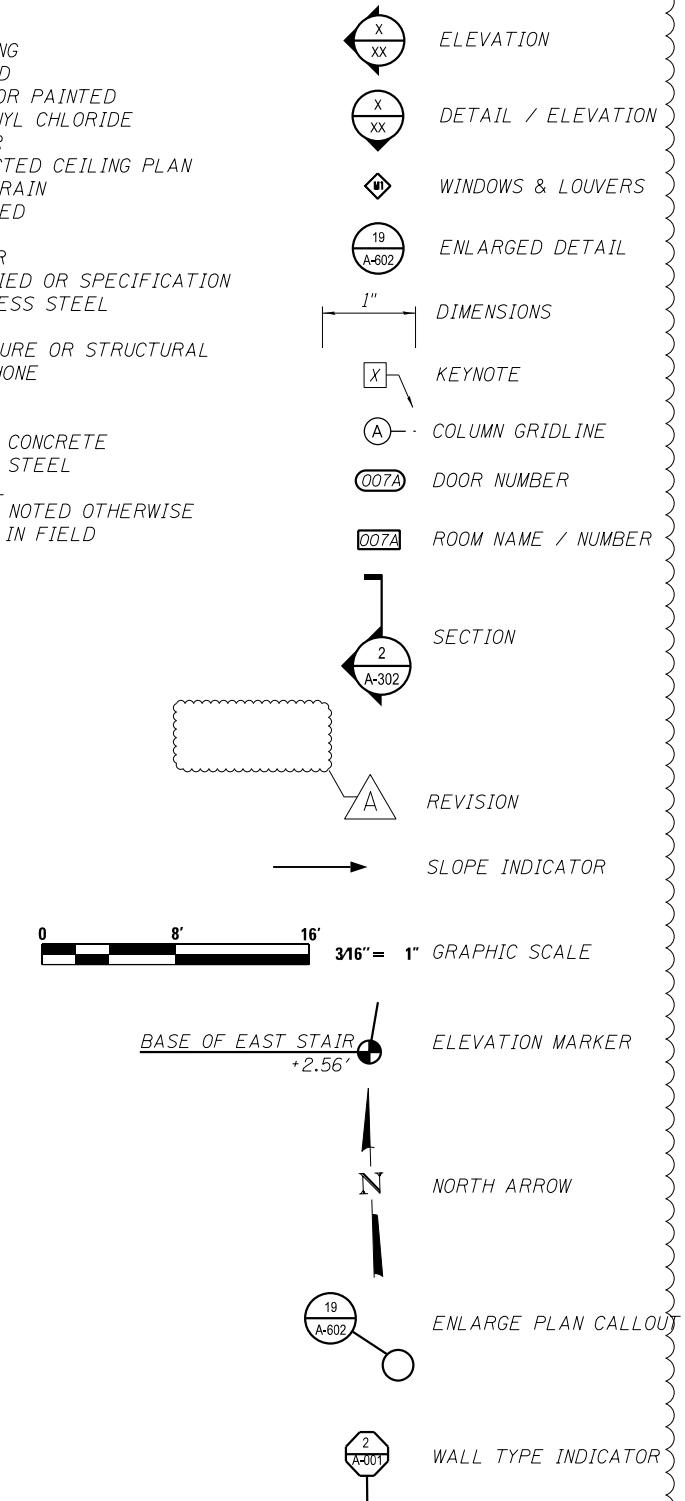

4/31/12 PM 0161708-60W29-g-001.dgn



USER NAME = whbruce	DESIGNED - WHB	REVISED 1/20/2014
	CHECKED - CRR	REVISED
PLOT SCALE = 2:0.0000 ins/in / in.	DRAWN - WHB	REVISED
PLOT DATE = 1/20/2014	CHECKED - CRR	REVISED

**STATE OF ILLINOIS
DEPARTMENT OF TRANSPORTATION**

**PEORIA STREET STATION
SHEET INDEX**

SHEET NO. G-001 OF 117 SHEETS

MUN	SECTION	COUNTY	TOTAL SHEETS	SHEET NO.
2090	2013-011R	COOK	356	191A
CONTRACT NO.			60W29	
ILLINOIS FED. AID PROJECT FED. AID PROJECT				

ITEM	ISSUE	CHAPTER/ARTICLE	ORDINANCE REQUIREMENT	ACTUAL	REQUIREMENT N/A	AGENCY	REMARKS
ZONING REQUIREMENTS							
1.01	Zoning District						
1.02	Lot Area						
1.03	Maximum Floor Area Ratio						
1.04	Total Building Area						
1.05	Building Height - No. of Floors						
1.06	Minimum Yards						
1.07	Grade Elevation (CCD)						
1.08	Off Street Loading						
1.09	Off Street Parking						
1.10	Landscaping						
1.11	Townhouse Ordinance						
BUILDING REQUIREMENTS							
2.01	Occupancy Classification (s)	3(13-56)	Class J, Misc. Bldgs and Structures				For general design purposes, requirements for Open Air Assembly Unit 4(13-88) used
2.02	Height and Area Limitation	5(13-48)					
	a) Exceptions to Area Limitations	5(13-48-090)			X		
	b) Mixed Occupancy Buildings	5(13-48-100)			X		
2.03	Types of Construction	6(13-60)	Type II - Non Combustible - No Sprinklers				
2.04	Mixed Occupancy Separations	3(13-56-280)			X		
2.05	Req. Hrs. of Fire Resistance	6(13-60-100)					
	Exterior Bearing Walls	Table 6(13-60-100)			X		Existing Condition
	Exterior Nonbearing Walls	Table 6(13-60-100)	N.C.	N.C.			
	Interior Bearing Walls	Table 6(13-60-100)	N.C.		X		Existing Condition
	Interior Nonbearing walls	Table 6(13-60-100)	N.C.	N.C.			
	Columns	Table 6(13-60-100)	N.C.	N.C.			
	Columns Supporting Roofs Only	Table 6(13-60-100)	N.C.	N.C.			
	Beams	Table 6(13-60-100)	N.C.	N.C.			
	Beams Supporting Roofs Only	Table 6(13-60-100)	N.C.	N.C.			
	Floor Construction	Table 6(13-60-100)	N.C.	N.C.			
	Roof Construction	Table 6(13-60-100)	N.C.		X		Existing Condition
2.06	Elevator Framing	6(13-60-130)	N.C.	N.C.			
2.07	Mezzanine Floors	6(13-60-160)			X		Existing Condition
2.08	Basement Construction	6(13-60-170)			X		Existing Condition
2.09	Driveways and Loading Spaces	6(13-60-210)			X		
2.10	Fire - Resistive Requirements	7(15-8)					
	a) Fire Walls - Construction	7(15-8-010)			X		Existing Condition
	b) Parapets	7(15-8-100)			X		Existing Condition
	c) Stairway Enclosures	7(15-8-140)	N.C.		X		Existing Condition
	d) Elevator Enclosures	7(15-8-150)	N.C.	N.C.			Assuming design application of Open Air Assembly Units Class D allowances.
	e) Enclosures of Heating Rooms	7(15-8-190)			X		Existing Condition
	f) Enclosures of Wells & Chutes	7(15-8-170)			X		Assuming design application of Open Air Assembly Units Class D allowances.
	g) Other Enclosures	7(15-8-240)	1HR, 2HR	2HR	X		Enclosure Not Required. Materials are non-combustible
	h) Interior Wall and Cloq. Finishes	7(15-8-380)	CLASS 1	CLASS 1			Service spaces are separated from public areas by 2 hour enclosures.
	i) Storage Room	7(15-8-240)(b)	2HR	2HR			
2.11	Fire - Resistive Materials and Construction	7(15-12)					
2.12	Accepted Engineering Practice, Recognized Agencies	7(15-12-050)				U.L.	
2.13	Fire Protection Equipment	9(15-16)			X		
	a) Sprinkler Systems	9(15-16-010)			X		
	b) Special Requirements	9(15-16-030)			X		
EXIT REQUIREMENTS							
3.01	Types of Exits	10(13-160-040)					
3.02	Minimum Number of Exits	10(13-160-050)	2 Exits	1	X		Existing Condition
3.03	Travel Distance to Exits	10(13-160-110)	300 feet out of station to public way per NFPA 130				Existing Condition
	a) Increases Permitted	10(13-160-150)			X		
	b) Dead End Corridor	10(13-160-160)	75 feet		X		Existing Condition
3.04	Capacity of Exits	10(13-160-210)	Per Open Air Assembly requirements, 8 inches = 100 Persons	Total Capacity = 2250 persons			
3.05	Minimum Width of Exit Doors	10(13-160-220)	Minimum exit door width shall be 3 feet.	5 feet minimum exit door width	X		Existing Condition
		10(13-88-160)(b)	Minimum width of stair shall be 44"	Total Capacity = 3489 persons			
			The aggregate width of exits shall be not less than eight inches for each 100 persons served		X		Existing Condition
3.06	Swing of Exit Doors	10(13-160-250)	In direction of egress for spaces with Occupant Load > 50		X		Existing Condition
3.07	Hardware	10(13-160-260)	All doors in connection with exits shall be keyless in the direction of egress. All handles for doors opening into service spaces from public spaces shall have knurled handles.		X		Existing Condition
3.08	Revolving Doors	10(13-160-270)			X		Existing Condition
3.09	Landings	10(13-160-310)	Maximum vertical rise between landings shall not exceed 9 feet. Landing lengths shall not be less than width of stairs. But is not required to be greater than 4 feet.		X		Existing Condition
3.10	Handrails	10(13-160-320)	2'-10" to top of handrail, handrails on both sides.		X		
3.11	Construction	10(13-160-330)	Non-combustible, solid risers, treads and landings.		X		Existing Condition
3.12	Stair and Elevator Enclosures	7(15-3-140)	Not required for Open Air Assembly Units	Non-combustible enclosure provided.			Provide for elevator, stair is existing
3.13	Head Room	10(13-160-350)	Not less than 7'	7'-6" min.			
ACCESSIBILITY							
	Illinois Accessibility Code (IAC) - Public Facilities Alteration	400.510	If the alteration costs 15% or less of the reproduction cost of the public facility, the element or space being shall comply with the applicable requirements for new construction.				New Items will comply fully with accessibility requirements.
STANDARD FOR TRANSIT AND PASSENGER RAIL SYSTEMS							
		All					NFPA 130 adopted by City of Chicago DOB for transit projects.
							Compliance as per agreement between CTA and City of Chicago DOB

1:59:41 PM
0161708-60W29-g-002.dgn



USER NAME = whbruce
DESIGNED - WHB
CHECKED - CRR
PLOT SCALE = 0:2.0000 '1" / 1n.
DRAWN - WHB
PLOT DATE = 12/17/2013
CHECKED - CRR

REVISED - 12/18/2013
REVISOR - [Symbol]
REVISED - [Symbol]
REVISED - [Symbol]
REVISED - [Symbol]

STATE OF ILLINOIS
DEPARTMENT OF TRANSPORTATION

PEORIA STREET STATION
CODE MATRIX

SHEET NO. G-002 OF 117 SHEETS

MUN	SECTION	COUNTY	TOTAL SHEETS	SHEET NO.
2090	2013-011R	COOK	356	191B
CONTRACT NO.			60W29	
ILLINOIS FED. AID PROJECT FED. AID PROJECT				

A

GENERAL NOTES:

GENERAL REQUIREMENTS:

- THE GENERAL STRUCTURAL NOTES ARE INTENDED TO AUGMENT THE DRAWINGS AND SPECIFICATIONS. SHOULD CONFLICTS EXIST BETWEEN THE DRAWINGS SPECIFICATIONS AND THE STRUCTURAL NOTES, THE STRICTEST PROVISION SHALL GOVERN.
- THE STRUCTURES ARE DESIGNED TO BE SELF-SUPPORTING AND STABLE AFTER THE BUILDING IS FULLY COMPLETED. IT IS THE CONTRACTOR'S SOLE RESPONSIBILITY TO DETERMINE ERECTION PROCEDURE AND SEQUENCE, TO INSURE THE SAFETY OF THE BUILDING AND ITS COMPONENT PARTS DURING ERECTION, AND TO PROVIDE TEMPORARY BRACING, GUYS, OR TIE-DOWNS AS NECESSARY FOR COMPLETION OF THE WORK. SUCH MATERIAL SHALL REMAIN THE CONTRACTOR'S PROPERTY AFTER COMPLETION OF THE WORK.
- FOLLOW ALL APPLICABLE SAFETY CODES AND REGULATIONS DURING ALL PHASES OF CONSTRUCTION.
- ALL CONDITIONS AND DIMENSIONS PERTAINING TO EXISTING UTILITIES AND CONSTRUCTION, AT THE SITE, SHALL BE VERIFIED BY THE CONTRACTOR BEFORE PROCEEDING WITH THE WORK. THIS ASSESSMENT SHALL BE CONDUCTED SUFFICIENTLY IN ADVANCE OF ANY PHASE OF CONSTRUCTION, TO THE MAXIMUM EXTENT POSSIBLE, TO AVOID DELAYS IN THE WORK.
- EQUIPMENT WEIGHTS AND STRUCTURAL ITEMS IN ANY WAY RELATED TO THE SUPPORT OF EQUIPMENT OR OPENINGS ARE INDICATED FOR INFORMATIONAL PURPOSES ONLY. VERIFY AND COORDINATE SIZE, LOCATION AND QUANTITY OF OPENINGS AND EQUIPMENT WEIGHTS REQUIRED FOR ARCHITECTURAL, MECHANICAL AND ELECTRICAL TRADES. OBTAIN APPROVAL OF AFFECTED TRADES BEFORE PROCEEDING WITH SUCH PORTION OF THE WORK. CHANGES REQUIRED BY EQUIPMENT IN EXCESS OF THE WEIGHT OR GEOMETRIC ALLOWANCES ARE THE CONTRACTOR'S RESPONSIBILITY.
- ALL LOADS AND REACTIONS ON DRAWINGS AND IN THESE GENERAL STRUCTURAL NOTES ARE UNFACTORED SERVICE LOADS UNLESS OTHERWISE NOTED. LOAD CASES WHICH INCLUDE COMBINED LOADS SHALL BE CALCULATED IN ACCORDANCE WITH THE MUNICIPAL CODE OF CHICAGO.
- IN GENERAL, ALL SECTIONS AND DETAILS SHOWN ON THE PLANS ARE INTENDED TO APPLY TO SIMILAR CONDITIONS, UNLESS SPECIFICALLY NOTED.
- SEE ARCHITECTURAL AND MECHANICAL REQUIREMENTS FOR EMBEDDED ITEMS NOT SHOWN HEREIN AND TO VERIFY SIZE AND LOCATION OF ALL OPENINGS.
- NO CORE DRILLING SHALL BE ALLOWED WITHOUT APPROVAL BY THE ENGINEER. BEFORE CORE DRILLING ANY HOLES, LOCATE THE REINFORCING STEEL IN EXISTING CONCRETE WITH R-METER. RELOCATE THE HOLE TO AVOID CUTTING ANY REBARS OR POST-TENSIONING TENDONS. DO NOT DRILL HOLES THROUGH EXISTING REBARS UNLESS ACCEPTABLE TO THE STRUCTURAL ENGINEER. DO NOT OVERCUT ANY HOLES.

FOUNDATION NOTES:


- FOUNDATIONS HAVE BEEN DESIGNED IN ACCORDANCE WITH THE RECOMMENDATIONS PROVIDED IN THE PROJECT SPECIFIC GEOTECHNICAL REPORT PERFORMED BY WANG ENGINEERING, REPORT NUMBER 1100-04-01 INCLUDING THE TECHNICAL MEMORANDUM DATED AUGUST 23, 2013.
- DRILLED SHAFTS HAVE BEEN DESIGNED FOR AN ALLOWABLE END-BEARING CAPACITY OF 13,500 PSF IN ACCORDANCE WITH THE GEOTECHNICAL CRITERIA INDICATED IN NOTE 1.
- CONTRACTOR SHALL FOLLOW RECOMMENDATIONS CONTAINED WITHIN THE GEOTECHNICAL REPORT IN PREPARATION OF THE SITE AND BUILDING FOUNDATIONS.
- PRIOR TO ANY EXCAVATION OPERATIONS, THE CONTRACTOR IS RESPONSIBLE FOR LOCATING ALL UNDERGROUND UTILITIES OR OTHER SUBSURFACE STRUCTURES WITHIN THE AREA TO BE EXCAVATED.
- ALL EXCAVATIONS WITHIN 2 FEET OF EXISTING STRUCTURES TO REMAIN SHALL BE REMOVED BY HAND. THE CONTRACTOR IS SOLELY RESPONSIBLE FOR TAKING ADEQUATE PRECAUTIONS NOT TO DAMAGE THE EXISTING INFRASTRUCTURE DURING ALL EXCAVATION, FILL AND COMPACTION OPERATIONS.

DEMOLITION:

- THE CONTRACTOR IS FULLY RESPONSIBLE FOR THE MEANS AND METHODS OF DEMOLITION AND THE INTEGRITY AND STABILITY OF THE EXISTING STRUCTURE DURING DEMOLITION UNTIL THE WORK IS COMPLETED. THE CONTRACTOR SHALL PROVIDE SHORING IN REQUIRED LOCATIONS WHERE EXISTING CONSTRUCTION IS TO REMAIN WILL BE AFFECTED BY DEMOLITION.
- THE EXISTING STRUCTURE IS INDICATED FOR REFERENCE ONLY AND IS TO BE FIELD VERIFIED BY THE CONTRACTOR. THE EXACT EXTENT OF DEMOLITION SHALL BE VERIFIED AT THE SITE. DETERMINE THE NATURE AND EXTENT OF DEMOLITION THAT WILL BE NECESSARY BY COMPARING THE DRAWINGS WITH THE EXISTING CONSTRUCTION. THE CONTRACTOR SHALL USE THESE DRAWINGS IN CONJUNCTION WITH THE ARCHITECTURAL AND MECHANICAL DEMOLITION DRAWINGS. IN THE EVENT OF CONFLICTS, THE CONTRACTOR SHALL IMMEDIATELY NOTIFY THE AUTHORITY.
- THE CONTRACTOR SHALL USE QUALIFIED, EXPERIENCED PERSONNEL FOR DEMOLITION AND REMOVAL OPERATIONS. DEMOLITION AND REMOVAL OPERATIONS SHALL BE PERFORMED IN A CAREFUL AND ORDERLY MANNER TO PREVENT HAZARDS TO PERSONS, DAMAGE TO PROPERTY AND THE SPREADING OF DUST AND/OR DEBRIS USING A VACUUM SYSTEM AND/OR WET METHODS.
- NO PORTIONS OF THE STRUCTURE SHALL BE PERMITTED TO FALL NOR SHALL ANY DEBRIS BE DROPPED EXCEPT BY METHODS WHICH WILL ENSURE INTEGRITY OF THE STRUCTURE.
- PRIOR TO THE START OF WORK, VERIFY THAT THE SCOPE OF DEMOLITION INDICATED ON THE DRAWINGS SHALL NOT DAMAGE, CUT OR DISRUPT SERVICE TO ANY MECHANICAL SYSTEM, COMMUNICATION SYSTEM, ELECTRICAL SYSTEM OR UTILITY EMBEDDED IN THE EXISTING STRUCTURE.
- DO NOT REMOVE MORE OF THE EXISTING STRUCTURE THAN IS INDICATED ON THE DRAWINGS. DO NOT DAMAGE, MAR, CUT OR DEFACE THE REMAINING STRUCTURE TO REMAIN, OR MATERIALS TO BE REUSED.
- THE CONTRACTOR SHALL INCLUDE IN THEIR BID THE COST OF REMOVING AND LEGALLY DISPOSING OF DEMOLISHED MATERIALS FROM THE SITE IN ACCORDANCE WITH ALL APPLICABLE LAWS, CODES AND REGULATIONS.
- WHERE NEW OPENINGS IN EXISTING CONCRETE SLABS ARE TO BE CREATED, THE DEMOLITION CONTRACTOR SHALL CORE HOLES AT THE OUTSIDE CORNERS OF THE NEW OPENING PRIOR TO DEMOLITION. SAW-CUTTING SHALL BE STRAIGHT AND SHALL NOT EXTEND INTO THE EXISTING REMAINING SLAB OR BEYOND THE HOLES CORED AT THE CORNERS OF THE NEW OPENING.
- A DEMOLITION PLAN IS TO BE SUBMITTED TO THE AUTHORITY FOR APPROVAL. DEMOLITION SHALL NOT COMMENCE UNTIL THE CONTRACTOR HAS RECEIVED WRITTEN APPROVAL FROM THE AUTHORITY.

DESIGN CRITERIA:

- REFERENCE STANDARDS:
MUNICIPAL CODE OF CHICAGO.
ASCE 7-05, MINIMUM DESIGN LOADS FOR BUILDINGS AND OTHER STRUCTURES
- BUILDING IMPORTANCE CATEGORY II
- LOADS:
LIVE LOADS:
PLATFORM LEVEL LIVE LOADS: 100 PSF
STATION LEVEL LIVE LOADS: 100 PSF
ROOF LIVE LOAD: 20 PSF (NON-REDUCIBLE)
- FUTURE STATION LOADS (GRIDS A.5/12 TO B/16.8)
STATION DEAD LOADS (SELFWEIGHT + SDL) 125 PSF
STATION LIVE LOADS (SLL) 100 PSF
STATION ROOF DEAD LOADS (RDL) 25 PSF
STATION ROOF LIVE LOADS (RLL) 20 PSF
STATION ROOF SNOW LOADS (RSL) 25 PSF
- WIND DESIGN CRITERIA:
BASIC WIND SPEED, V: 90 MPH
MWFRS PRESSURE: 20 PSF
COMPONENTS AND CLADDING PRESSURE: 25 PSF (30 PSF @ CORNERS)
CORNER DIMENSION: 3.6 FT
- SNOW LOADS:
FLAT ROOF SNOW LOAD: 25 PSF
DRIFT SNOW LOAD:
- ELEVATOR DESIGN CRITERIA:
ELEVATOR TOWER DESIGN IS BASED ON THE LOAD CRITERIA BELOW. ALL LOADS ARE UNFACTORED AND INCLUDE AN 100% IMPACT ADJUSTMENT. IF THE FINAL DESIGN LOADS ARE GREATER THAN 5% OF THE LOADS INDICATED, THEN THE ENGINEER OF RECORD SHALL BE NOTIFIED PRIOR TO FABRICATION.
TYPE: TRACTION
CAPACITY: 2,500 LB
IMPACT: 100%
MAXIMUM SHEAVE BEAM REACTIONS:
P₁= 22KIP
P₂= 15KIP
P₃= 8KIP
P₄= 6KIP

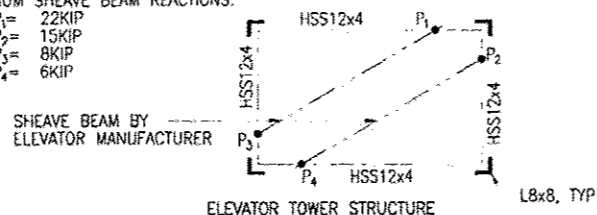

CAST-IN-PLACE CONCRETE NOTES:

- REFERENCE STANDARDS:
EXCEPT AS INDICATED, ALL CONCRETE WORK AND DETAILING, FABRICATION AND PLACING OF REINFORCING SHALL BE GOVERNED BY:
ACI 301, SPECIFICATIONS FOR STRUCTURAL CONCRETE FOR BUILDINGS, 2005.
ACI 305.1, HOT WEATHER CONCRETING, 2006.
ACI 308, COLD WEATHER CONCRETING, 2002.
ACI 315, DETAILS AND DETAILING OF CONCRETE REINFORCEMENT, 1999.
ACI 318, BUILDING CODE REQUIREMENTS FOR STRUCTURAL CONCRETE, 2008.
- MATERIALS:
ALL FOOTINGS, RETAINING WALLS, CAST-IN-PLACE WALLS AND SLABS ON GRADE: f_c = 4,000 PSI, AE, UNO
ALL OTHER BEAMS AND COLUMNS: f_c = 6,000 PSI, AE, UNO
- CONCRETE COVER REQUIREMENTS:
CONCRETE CAST DIRECTLY AGAINST EARTH: 3 IN
CONCRETE EXPOSED TO EARTH OR WEATHER, BUT CAST AGAINST FORMS:
(BARS > #5): 2 IN
(BARS <= #5): 1-1/2 IN
CONCRETE NOT EXPOSED TO WEATHER OR IN CONTACT WITH THE GROUND:
SLABS, WALLS, JOISTS: 3/4 IN
BEAMS, COLUMNS: 1-1/2 IN
- DURING PLACEMENT OF THE CONCRETE SLABS, TAKE ALL NECESSARY STEPS TO AVOID PLASTIC CRACKS DUE TO WEATHER CHANGES. CURE ALL CONCRETE ACCORDING TO ACI 308.1 AND SPECIFICATIONS.
- CORNER BEND DIAMETERS: #5 AND SMALLER: 4D
#6 AND LARGER: 6D
- WHERE NO REINFORCING IS INDICATED IN SLABS ON GRADE, PROVIDE WWR 4x4-W2.9xW2.9.
- WHERE ANY OPENING REQUIRED FOR THE WORK IS NOT INDICATED, OBTAIN APPROVAL FROM THE ENGINEER OF RECORD BEFORE PROCEEDING WITH THE WORK.
- PROVIDE 3/4" CHAMFER ON ALL EXPOSED EDGES OF CONCRETE EXCEPT AS INDICATED.
- ALL REINFORCING SHALL BE HELD SECURELY IN POSITION WITH STANDARD ACCESSORIES DURING CONCRETE PLACEMENT. REINFORCING SHALL NOT BE SUPPORTED ON BOOSTERS MADE OF CMU OR CONCRETE NOT SPECIFICALLY DESIGNED TO SUPPORT REINFORCING STEEL.
- WALLS AND PILASTERS SHALL BE CAST MONOLITHICALLY. CONTRACTOR SHALL LIMIT LENGTH OF CONTINUOUS WALL PLACEMENT TO 60 FEET.
- PROVIDE CONTINUOUS REINFORCEMENT WHEREVER POSSIBLE. SPLICE ONLY AS SHOWN OR APPROVED. STAGGER ALL SPLICES. USE CLASS "B" TENSION SPLICE UNLESS NOTED OTHERWISE. DOWELS SHALL MATCH SIZE AND SPACING OF THE SPECIFIED REINFORCEMENT AND SHALL BE LAPPED WITH TENSION SPLICES, UNLESS NOTED OTHERWISE. TENSION SPLICE LENGTHS SHALL BE AS FOLLOWS:

TENSION SPLICE LENGTHS, (IN)									
BAR SIZE	CONCRETE STRENGTH, F _c (PSI)	BAR SIZE			CONCRETE STRENGTH, F _c (PSI)				
		CLASS	3,000	4,000	5,000	CLASS	3,000	4,000	5,000
#4	A	22	19	17	#7	A	48	41	37
	B	29	25	22		B	63	53	48
#5	A	28	24	21	#8	A	55	47	42
	B	36	31	28		B	72	61	55
#6	A	33	29	26	#9	A	62	53	47
	B	43	37	33		B	80	69	61

- FOR HORIZONTAL REINFORCING WITH MORE THAN 12" OF CONCRETE BELOW, OR FOR VERTICAL REINFORCING, MULTIPLY THE SPLICE LENGTH INDICATED IN THE TABLE BY 1.3.
- THE TENSION SPLICES INDICATED ABOVE ARE FOR UNCOATED AND GALVANIZED REINFORCING.

STRUCTURAL ALUMINUM NOTES:

- REFERENCE STANDARDS:
EXCEPT AS INDICATED, ALL DESIGN, FABRICATION AND ERECTION OF STRUCTURAL ALUMINUM SHALL BE GOVERNED BY:
ALUMINUM ASSOC'S SPECIFICATION FOR ALUMINUM STRUCTURES, 2010.
AWS D1.2, STRUCTURAL WELDING CODE - ALUMINUM.
- MATERIALS:
ALUMINUM STRUCTURAL SECTIONS: 6061-T6; F_u = 42KSI, F_y = 36KSI
STAINLESS STEEL BOLTS: ASTM A193, TYPE 316
STAINLESS STEEL NUTS: ASTM A194, TYPE 316
STAINLESS STEEL WASHERS: TYPE 316
STAINLESS STEEL ANCHOR RODS: ASTM A320, TYPE 316
WELD FILLER MATERIAL: 4043
- ALL WELDED JOINTS SHALL BE IN ACCORDANCE WITH AWS D1.2. USE ONLY WELDERS CERTIFIED TO WELD ALUMINUM.
- WHERE THE CONTACT OF DISSIMILAR METALS MAY CAUSE ELECTROLYSIS OR WHERE ALUMINUM WILL COME IN CONTACT WITH CONCRETE, MORTAR OR PLASTER, THE ALUMINUM CONTACT SURFACE SHALL BE COATED WITH 1 COAT OF ZINC CHROMATE PRIMER AND ONE HEAVY COAT OF ALUMINUM PIGMENTED ASPHALT PAINT.


POST-INSTALLED ANCHORS:

- REFERENCE STANDARD: ACI 318-05, APPENDIX D.
- INSTALL ONLY WHERE SPECIFICALLY SHOWN IN THE PROJECT DETAILS.
- ALL POST-INSTALLED ANCHOR TYPES SHALL BE APPROVED BY THE ENGINEER OF RECORD AND SHALL HAVE A CURRENT ICC-ESR THAT PROVIDES RELEVANT DESIGN VALUES TO VALIDATE THE AVAILABLE STRENGTH.
- INSTALL ALL ANCHORS IN STRICT ACCORDANCE TO THE ICC-ESR AND MANUFACTURER'S INSTRUCTIONS.
- SPECIAL INSPECTIONS SHALL BE IN ACCORDANCE WITH THE REQUIREMENTS INDICATED IN THE SCHEDULE OF SPECIAL INSPECTIONS UNDER 1704.4 CONCRETE CONSTRUCTION.
- USE COMPRESSED AIR TO THOROUGHLY CLEAN THE ANCHOR HOLES.
- PROVIDE EPOXY ADHESIVE TYPE ANCHORS WITH THE FOLLOWING MINIMUM ALLOWABLE CAPACITIES AND MINIMUM EMBEDMENTS.

POST-INSTALLED ANCHORS						
ANCHOR DIA (IN)	EMB (IN)	CONCRETE		CMU		
		TENSION (KIP)	SHEAR (KIP)	TENSION (KIP)	SHEAR (KIP)	
0.375	3.375	3.06	4.46	0.880	1.13	
0.500	4.500	4.98	7.93	1.06	1.74	
0.625	5.625	8.41	12.4	1.37	2.12	
0.750	6.750	9.98	17.8	1.58	2.20	
1.000	9.000	14.8	24.3	-	-	

NOTES:
1. ANCHOR DIAMETERS AND EMBEDMENTS ARE IN INCHES.
2. ALLOWABLE CAPACITIES ARE IN KIPS.
3. ALLOWABLE CAPACITIES ARE BASED ON MINIMUM ALLOWABLE EDGE DISTANCES AND SPACINGS AND F_c = 4,000 PSI AND F_m = 1,500 PSI.

- ALL ANCHORS EMBEDDED IN CONCRETE OR MASONRY SHALL BE PROPORTIONED TO EXCEED THE STRENGTH OF THE CONNECTED HARDWARE. ALL ANCHORS SHALL BE SHOWN TO BE IN COMPLIANCE WITH ACI 318 APPENDIX D. MECHANICAL EXPANSION FASTENERS SHALL NOT BE USED IN CONDITIONS WHERE THEY WILL SEE TENSILE LOADS. POWDER DRIVEN ANCHORS SHALL NOT BE USED IN CONCRETE OR MASONRY.

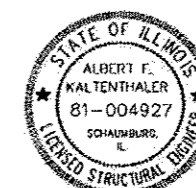

Albert F. Kaltenthaler
ALBERT F. KALTENTHALER DATE
LICENSE EXPIRES 11 / 30 / 2014
SHEET RANGE

PRELIMINARY NOT FOR CONSTRUCTION

STRUCTURAL STEEL NOTES:

- REFERENCE STANDARDS:
EXCEPT AS INDICATED, ALL DESIGN, FABRICATION AND ERECTION OF STRUCTURAL STEEL SHALL BE GOVERNED BY:
AISC MANUAL OF STEEL CONSTRUCTION – 14TH ED, 2011.
AISC CODE OF STANDARD PRACTICE FOR STEEL BUILDINGS AND BRIDGES, 2005.
AISC FCD QUALITY CERTIFICATION PROGRAM, 1995.
AWS D1.1, STRUCTURAL WELDING CODE – STEEL, 2004.
- PROVIDE STEEL CONSTRUCTION IN ACCORDANCE WITH CM, 2013.
- MATERIALS:
WIDE FLANGE SHAPES: ASTM A992, F_y = 50 KSI
RECTANGULAR HSS: ASTM A500 GRADE B, F_y = 46 KSI
ROUND HSS: ASTM A500 GRADE B, F_y = 42 KSI
PIPE: ASTM A53 GRADE B, F_y = 35 KSI
CHANNELS: ASTM A36, F_y = 36 KSI
ANGLES: ASTM A36, F_y = 36 KSI
HIGH STRENGTH PLATES: ASTM A572, F_y = 50 KSI
PLATES AND MISCELLANEOUS STEEL: ASTM A36, F_y = 36 KSI
WELDING ELECTRODES: AWS A5.1 OR A5.5 SERIES E70
HIGH STRENGTH BOLTS: ASTM A 325
ANCHOR RODS: ASTM F 1554, GRADE 36
- PROVIDE CONNECTIONS FOR MEMBERS PER TYPICAL DETAILS INDICATED ON SHEET S-600.
- WELDING SHALL BE PERFORMED ONLY BY OPERATORS QUALIFIED BY THE AWS STANDARD QUALIFICATION PROCEDURE TO PERFORM THE PARTICULAR TYPE OF WORK REQUIRED.
- MINIMUM SIZE OF ALL FILLET WELDS SHALL CONFORM TO AISC SPECIFICATIONS.
- ALL WELDS ALONG LENGTHS OF MEMBERS INDICATED ON ARCHITECTURAL OR STRUCTURAL DRAWINGS BUT NOT SIZED SHALL BE A MINIMUM OF 3/16"x3" FILLET WELD.
- ALL FASTENERS USED FOR CONNECTIONS BETWEEN STRUCTURAL STEEL MEMBERS SHALL BE DIRECT TENSION INDICATING BOLTS. FASTENERS MAY NOT BE REUSED ONCE INSTALLED.
- PAINT AND PROTECTION:
TOUCH UP PAINT ON FASTENERS, WELDS AND ABRADED AREAS AFTER ERECTION. ALL STEEL MEMBERS IN EXTERIOR APPLICATIONS SHALL BE HOT-DIPPED GALVANIZED AFTER FABRICATION IN ACCORDANCE WITH ASTM A123. ALL FASTENERS IN EXTERIOR APPLICATIONS SHALL BE GALVANIZED IN ACCORDANCE WITH ASTM A153.
- REPAIR OF DAMAGED AND UNCOATED AREAS OF GALVANIZED STEEL IN ACCORDANCE WITH ASTM A780. SUBMIT ALL PROPOSED REPAIR WORK FOR REPAIR.
- PREPARE ALL FAYING SURFACES BETWEEN NEW AND EXISTING AND BETWEEN ALL NEW SURFACES IN ACCORDANCE WITH THE SPECIFICATIONS.
- PROVIDE APPROVAL FROM THE ENGINEER OF RECORD FOR ANY OPENINGS IN MEMBERS NOT INDICATED IN THESE DOCUMENTS.
- GROUT UNDER BEARING PLATES SHALL BE OF NON-SHRINK, NON-METALLIC COMPOSITION.
- ANGLE FRAME MEMBERS AROUND OPENINGS SHALL BE MITERED, WELDED AND GROUND SMOOTH.
- FABRICATE STRUCTURAL STEEL MEMBERS WITH NATURAL CAMBER UP EXCEPT AS INDICATED.
- PUNCH, SUB-PUNCH AND REAM OR DRILL ALL BOLT HOLES. DO NOT USE A CUTTING TORCH TO ENLARGE BOLT HOLES, UNLESS APPROVAL IS OBTAINED FROM THE ENGINEER OF RECORD.
- CONNECTIONS FOR BEAMS WITH AXIAL FORCES SHALL BE DESIGNED WITH SLIP-CRITICAL BOLTS.
- SUBMIT CALCULATIONS FOR CONNECTION DESIGNS NOT DETAILED ON THE DRAWINGS. DESIGN CONNECTIONS UNDER SUPERVISION OF LICENSED STRUCTURAL ENGINEER WHO IS LICENSED IN ILLINOIS AND EMPLOYED BY THE STEEL FABRICATOR. DESIGN CALCULATIONS TO BE SEALED BY FABRICATOR'S REGISTERED PROFESSIONAL ENGINEER. SHOP DRAWINGS SUBMITTED WITHOUT COMPLETE DESIGN CALCULATIONS WILL NOT BE REVIEWED.

STEEL GRATING NOTES:

- REFERENCED STANDARDS:
MBG-12; METAL BAR GRATING ENGINEERING DESIGN GUIDE, 2012.
- STEEL GRATING SHALL BE 1"x3/8" GALVANIZED FLAT BEARING BARS AT 1 1/2" MAX SPACING WITH WELDED CROSS BARS AT 4" O.C., MAX SPACING.
- BAR GRATING SHALL BE FASTENED TO SUPPORTING STRUCTURE WITH A 3/8" x 1" FILLET WELD, EACH SIDE AT EVERY FOURTH BEARING BAR OR TYPICAL MANUFACTURE'S CLIPS AT 12" O.C., MAX SPACING.
- PROVIDE 1"x3/8" GALVANIZED FLAT BAR BANDS AT ALL GRATING PANEL ENDS AND AT ALL OPENINGS 6" AND LARGER.
- ALL BOLTS, NUTS AND WASHERS SHALL BE CADMIUM PLATED, ASTM A325 HEAVY HEX, UNLESS SHOWN OR NOTED OTHERWISE.

ARCHITECTURALLY EXPOSED STRUCTURAL STEEL NOTES:

- REFERENCE STANDARD:
WHERE COMPONENTS ARE INDICATED AS PART OF AN ARCHITECTURALLY EXPOSED STRUCTURAL STEEL (AESS) SYSTEM, THE DESIGN, FABRICATION AND ERECTION OF THE COMPONENTS SHALL BE IN ACCORDANCE WITH THE CONTRACT DOCUMENTS AND SECTION 10 OF THE AMERICAN INSTITUTE OF STEEL CONSTRUCTION, CODE OF STANDARD PRACTICE FOR STEEL BUILDINGS AND BRIDGES, 2010.
- ALL STEEL CONSTRUCTION EXPOSED TO THE PUBLIC VIEW SHALL BE PART OF THE AESS. WELDED CONNECTIONS THAT ARE PART OF THE AESS, SHALL BE GROUND SMOOTH AND UNIFORM IN APPEARANCE. THIS GRINDING SHALL NOT EFFECT THE OVERALL CONNECTION CAPACITIES.
- WELDS SHALL BE CAREFULLY MADE AND BE CLEAR AND UNIFORM IN APPEARANCE. WELD SPLATTER SHALL BE CAREFULLY REMOVED WITHOUT DAMAGING THE METAL SURFACE. THERE SHALL BE NO UNDERCUTS.
- WELD LAPS SHALL BE UNIFORM IN SIZE AND MADE IN A CONTINUOUS PATTERN TO THE MAXIMUM EXTENT POSSIBLE, WHERE A BREAK IS REQUIRED IN A WELD, THE BREAK SHALL OCCUR IN A LOCATION TO BE OBTAINED BY THE ADDITION OF SUBSEQUENT MEMBERS, ON TOP OF MEMBERS LOCATED MORE THAN 5'-6" ABOVE THE NEAREST POINT OF PUBLIC ACCESS AND ON THE BOTTOM OF MEMBERS LOCATED BELOW. A BREAK IN A VERTICAL WELD SHALL BE LOCATED BEHIND THE MEMBER AS SEEN FROM THE NEAREST POINT OF PUBLIC ACCESS.

PRECAST CONCRETE:

- REFERENCE STANDARDS:
EXCEPT AS INDICATED, DESIGN, MANUFACTURE AND ERECTION OF PRECAST CONCRETE SHALL BE GOVERNED BY:
ACI 315, DETAILS AND DETAILING OF CONCRETE REINFORCEMENT, 2004.
ACI 318, BUILDING CODE REQUIREMENTS FOR STRUCTURAL CONCRETE, 2011.
PCI MNL 117, MANUAL FOR QUALITY CONTROL FOR PLANTS AND PRODUCTION OF STRUCTURAL CONCRETE PRODUCTS, 4TH EDITION
PCI MNL 120, PCI DESIGN HANDBOOK – PRECAST AND PRESTRESSED CONCRETE.
AWS D1.3, STRUCTURAL WELDING CODE – SHEET STEEL, 1998.
- PROVIDE PRECAST CONCRETE CONSTRUCTION IN ACCORDANCE WITH CTA IDCM, 2013.
- MATERIALS:
CONCRETE, F_c: 4,000 PSI AT STRIPPING
6,000 PSI AT 28 DAYS
WELDING ELECTRODES: AWS A5.1, A5.5, OR A5.18, SERIES E70
REINFORCING: ASTM A-615, GR 60, GALVANIZED.
PRESTRESSING STRAND: GALV, 7-WIRE, ASTM A416, 270K, LOW-LAX
- THE HOLLOW-CORE MANUFACTURER SHALL SUBMIT CALCULATIONS AND SHOP DRAWINGS, BEARING THE SIGNED AND DATED SEAL OF A PROFESSIONAL ENGINEER REGISTERED IN THE STATE OF ILLINOIS, FOR ALL H/C PLANKS, INSERTS, PLATES, OPENINGS AND ANCHORS.
- CONCRETE OVERLAY SHALL HAVE A MINIMUM 28 COMPRESSIVE STRENGTH OF 4000 PSI. UNLESS OTHERWISE REQUIRED BY THE HOLLOW-CORE MANUFACTURER CONCRETE OVERLAY SHALL HAVE A MAXIMUM AGGREGATE SIZE OF 1/4".
- THE HOLLOW-CORE MANUFACTURER SHALL PROVIDE MINIMUM CLEAR COVER TO REINFORCING IN ACCORDANCE WITH ACI 318.
- ALL WELD PLATES, INSERTS, ANCHOR BOLTS, WELDING, LIFTING HARDWARE, GROUT SLEEVES, ETC. SHALL BE DESIGNED AND PROVIDED BY THE HOLLOW-CORE MANUFACTURER. UNLESS OTHERWISE NOTED, ALL CONNECTIONS EXPOSED TO WEATHER SHALL BE HOT DIP GALVANIZED IN ACCORDANCE WITH ASTM A 153.
- OPENINGS FOR MECHANICAL AND ELECTRICAL ITEMS SHALL BE CORE DRILLED THROUGH HOLLOW CELLS ONLY IN ACCORDANCE WITH THE HOLLOW-CORE MANUFACTURERS RECOMMENDATIONS. ADDITIONAL REINFORCEMENT SHALL BE PROVIDED AS REQUIRED BY THE HOLLOW-CORE MANUFACTURER.
- THE CONTRACTOR SHALL PROVIDE HOLES OR OTHER PROTECTIVE MEANS TO ALLOW THE HOLLOW CELLS TO DRAIN ANY WATER ACCUMULATION THAT MAY OCCUR DURING CONSTRUCTION.

SYMBOLS		
SYMBOL	DESCRIPTION	REMARKS
	SECTION CUT SHOWN ON PLANS	X= SECTION OR DETAIL NUMBER Y= SHEET REFERENCE
	DETAIL CALLOUT SHOWN ON PLANS	X= SECTION OR DETAIL NUMBER Y= SHEET REFERENCE
	ELEVATION CALLOUT SHOWN ON PLANS	X=ELEVATION NUMBER Y=SHEET REFERENCE
	ROOF TOP MECH EQUIP	SEE PLANS FOR LOCATIONS
	OPENING IN FLOOR, WALLS, OR FRAMING	VERIFY OPENING LOCATIONS W/ ARCH'L AND MECH DRAWINGS
	ARCH'L DOOR SIZE	REFER TO ARCH'L DRAWINGS FOR DOOR SCHEDULE.
	MOMENT CONNX	
	SLIP CONNECTION	
	BEAM CONTINUITY CONNX	
	SAG ROD	
	SPLICE LOCATION	
	BOTTOM FLANGE BRACE TO PARALLEL MEMBER	
	BOTTOM FLANGE BRACE TO PARALLEL MEMBER	
	SLOPES DOWN	
	[XX] SPOT ELEVATION	
	(X) QUANTITY OF WELDED SHEAR STUD CONNECTORS TO BE EVENLY SPACED IN THE SPAN INDICATED	
	INDICATES EXISTING MATERIAL AND/OR COMPONENTS	
	INDICATES EXISTING MATERIAL AND/OR COMPONENTS TO BE REMOVED OR DEMOLISHED	


PERFORMANCE ITEMS:

- THE CONTRACTOR SHALL ENGAGE OR RETAIN A LICENSED STRUCTURAL ENGINEER IN THE STATE OF ILLINOIS TO DESIGN AND DETAIL PERFORMANCE ITEMS AS PART OF THE BASE BUILDING STRUCTURE INDICATED IN THE CONTRACT DOCUMENTS INCLUDING, BUT NOT LIMITED TO:
 - CONCRETE MICROPILE DESIGN
 - PRECAST CONCRETE PANELS

ABBREVIATIONS			
AB	ANCHOR BOLT (ROD)	HCA	HEADED CONCRETE ANCHOR
ABC	AGGREGATE BASE COURSE	HORZ	HORIZONTAL
AC	AIR CONDITIONER	HSS	HOLLOW STRUCTURAL SECTION
AFF	ABOVE FINISHED FLOOR	IFW	INSIDE FACE OF WALL
AL	ALUMINUM	K (KIP)	1,000 POUNDS
ALT	ALTERNATE	L	ANGLE
ARCH	ARCHITECT	LL	LIVE LOAD
ARCH'L	ARCHITECTURAL	LBS (#)	POUNDS
ASD	ALLOWABLE STRESS DESIGN	LLH	LONG LEG HORIZONTAL
@	AT (MEASUREMENT)	LLV	LONG LEG VERTICAL
BM	BEAM	LDH	LONG DIMENSION HORIZONTAL
BFF	BELOW FINISHED FLOOR	LDV	LONG DIMENSION VERTICAL
BOB	BOTTOM OF BEAM	MFR('S)	MANUFACTURER(S)
BOD	BOTTOM OF DECK	MCJ (MAS CJ)	MASONRY CONTROL JOINT
BOF	BOTTOM OF FOOTING	MECH	MECHANICAL
BRG	BEARING	N/A	NOT APPLICABLE
CIP	CAST IN PLACE	NTS	NOT TO SCALE
CL	CENTERLINE	OC	ON CENTER
CL BM	CENTERLINE OF BEAM	OFW	OUTSIDE FACE OF WALL
CL COL	CENTERLINE OF COLUMN	OPP	OPPOSITE
CL FTG	CENTERLINE OF FOOTING	PC	PRECAST CONCRETE
CL WALL	CENTERLINE OF WALL	PLF	POUNDS PER LINEAR FOOT
CLR	CLEAR	PREFAB	PREFABRICATED
CONC	CONCRETE	PSF	POUNDS PER SQUARE FOOT
CONC CJ	CONCRETE CONTROL JOINT	PSI	POUNDS PER SQUARE INCH
CONC SJ	CONCRETE SAWCUT JOINT	RE:	REFERENCE TO
CMU	CONCRETE MASONRY UNIT	REINF	REINFORCING
CONNX	CONNECTION	SLH	SHORT LEG HORIZONTAL
CONT	CONTINUOUS	SLV	SHORT LEG VERTICAL
DL	DEAD LOAD	SIM	SIMILAR
DIA, Ø	DIAMETER	SQ	SQUARE
DN	DOWN	STD	STANDARD
DWG(S)	DRAWING(S)	TL	TOTAL LOAD
EOS	EDGE OF SLAB	TOB (T/ BM)	TOP OF BEAM
EOSS	EDGE OF STRUCTURAL STEEL	TOD	TOP OF DECK
ELEV	ELEVATION	TOF (T/ FTG)	TOP OF FOOTING
EQ	EQUAL	TOL	TOP OF LEDGER
EQUIP	EQUIPMENT	TOM (T/ CMU)	TOP OF MASONRY
EXP BOLT	EXPANSION BOLT	TOP (T/ R)	TOP OF PLATE
EXP JT (Ej)	EXPANSION JOINT	TOS (T/ STL)	TOP OF STEEL
EW	EACH WAY	TOW (T/ WALL)	TOP OF WALL
FF	FINISHED FLOOR	TYP	TYPICAL
FOM	FACE OF MEMBER	UNO	UNLESS NOTED OTHERWISE
FOS	FACE OF STEEL	VERT	VERTICAL
FOW	FACE OF WALL	VIF	VERIFY IN FIELD
GA	GAGE	WF	WIDE FLANGE
GALV	GALVANIZED	WWR	WELDED WIRE REINFORCING
GSN	GENERAL STRUCTURAL NOTES	W/	WITH
GLB	GLUED-LAMINATED BEAM	W/O	WITHOUT


LOCATION OF INFORMATION

- FOR MATERIAL STRENGTHS, SEE GENERAL STRUCTURAL NOTES.
- VERIFY ALL DIMENSIONS WITH ARCHITECTURAL DRAWINGS PRIOR TO START OF CONSTRUCTION.
- FOR CLARITY, ALL EXTERIOR SLABS AND SIDEWALKS MAY NOT BE SHOWN. FOR EXACT DIMENSIONS, LOCATIONS, JOINT AND SCORE LINES, SEE CIVIL DRAWINGS.
- FOR CLARITY, ALL OPENINGS MAY NOT BE SHOWN ON FRAMING PLANS. FOR EXACT SIZE, NUMBER, AND LOCATION OF OPENINGS, SEE ARCHITECTURAL, MECHANICAL, ELECTRICAL AND PLUMBING DRAWINGS. FOR FRAMING AT OPENINGS, SEE TYPICAL STRUCTURAL DETAILS. VERIFY ALL SIZES, WEIGHTS AND LOCATIONS OF MECHANICAL EQUIPMENT WITH MECHANICAL ENGINEER AND MECHANICAL CONTRACTOR THROUGH ARCHITECT.
- DETAILS MARKED "TYPICAL" MAY NOT BE CUT ON PLANS.
- C.J. – AS SHOWN ON PLAN INDICATES LOCATION OF EITHER KEYED OR SAW CUT CONTROL JOINT IN SLAB ON GRADE AT CONTRACTOR'S OPTION, SEE GENERAL STRUCTURAL NOTES AND PLANS.
- FOR CLARITY, DETAILS MAY SHOW ONLY ONE SIDE OF FRAMING CONDITION.
- CONTRACTOR TO VERIFY, AND BE RESPONSIBLE FOR VARIATIONS IN CONCRETE QUANTITY DUE TO CAMBER, CONSTRUCTION DEAD LOAD DEFLECTIONS AND/OR TOLERANCES OF STRUCTURAL STEEL ELEMENTS (i.e. BEAMS, JOISTS, COMPOSITE JOISTS & BEAMS, STEEL DECK, ETC.) AND PRECAST CONCRETE ELEMENTS.
- ALL SCHEDULE MARK DESIGNATIONS MAY NOT NECESSARILY BE FOUND ON THE PLANS WHERE THE SCHEDULES OCCUR. SCHEDULES ARE TYPICAL TO THE PROJECT.

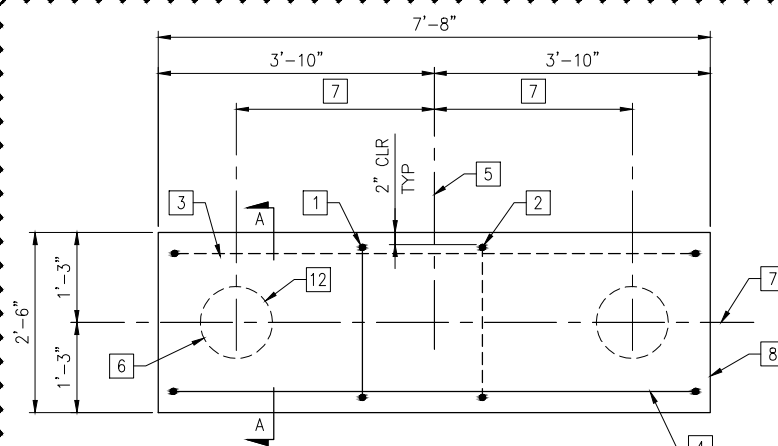


KEYED NOTES:

- (12) #5 TOP \square BARS EQUALLY SPACED.
- (12) #5 BOT \sqcup BARS EQUALLY SPACED.
- (9) #6 BOT \sqcup BARS EQUALLY SPACED.
- (9) #6 TOP \square BARS EQUALLY SPACED.
- PILE CAP \odot .
- CONCRETE MICROPILE BELOW.
- \odot PILE CAP AND CONCRETE MICROPILE BELOW.
- 4'-0" DEEP PC-2 PILE CAP.
- SEE SECTIONS ON S-301 FOR MICROPILES SPACING.
- (3) #5 SIDE BARS WITH STD ACI 90° HOOKS AT EACH END.
- EXTEND TYPICAL REINFORCING INTO PILE CAP OR MAT FOUNDATION A FULL EMBEDMENT LENGTH FOR COMPRESSION. EMBEDMENT LENGTH MAY BE REDUCED IF A STD ACI 90° HOOK IS PROVIDED.
- SPACE TOP BARS TO CLEAR COLUMN ANCHOR RODS.
- SPACE BOTTOM BARS TO CLEAR MICROPILE REINFORCING.

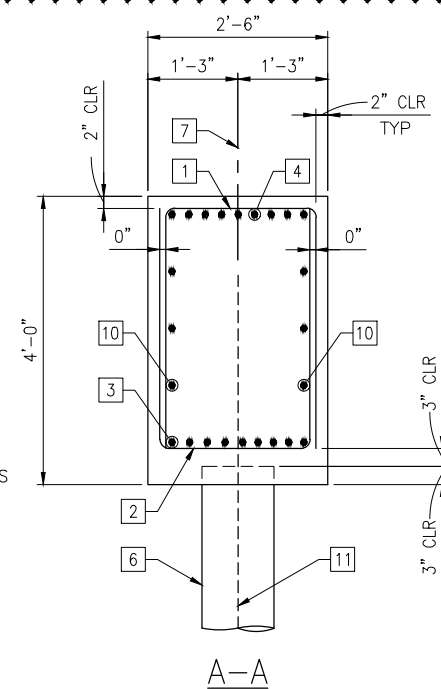

C1 PILE CAP PG-2 PLAN AND SECTION
NTS


BASE PLATE SCHEDULE													
MARK	SIZE AxB (INxIN)	STEEL YIELD (KSI)	THICK (IN)	NUMBER BOLTS "A" SIDE	NUMBER BOLTS "B" SIDE	BOLT DIAMETER (IN)	BOLT EDGE DISTANCE (IN)	BOLT GAGE (IN)	BOLT EMBED LENGTH (IN)	BOLT HOLE DIAMETER (IN)	WASHER SIZE (INxIN)	WASHER THICK (IN)	WELD SIZE (IN)
A	18x20	36	1	2	2	7/8	3	8 1/2	16	1 1/8	2 1/2 x 2 1/2	3/16	3/16

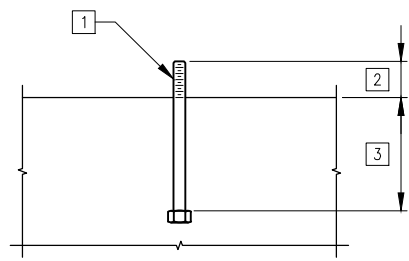

DETAIL KEYED NOTES:

- HEAVY HEX HEADED, ASTM F1554, GRADE 36 ANCHOR ROD.
- PROJECTION AS REQUIRED.
- EMBED PER BASE PLATE DETAILS.
- J-TYPE AND L-TYPE ANCHOR RODS ARE NOT ALLOWED.

A1 ANCHOR ROD DETAIL
NTS

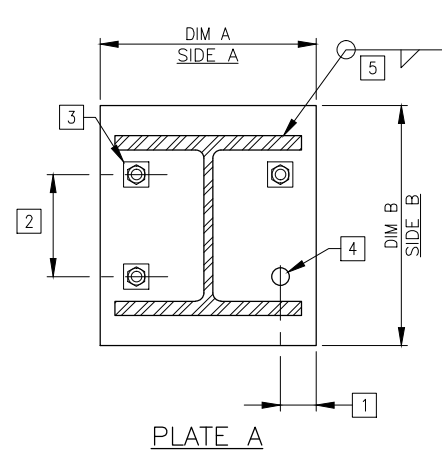

DETAIL KEYED NOTES:

- TYPICAL BOLT EDGE DISTANCE. SEE SCHEDULE FOR DIMENSION.
- BOLT GAGE DISTANCE. SEE SCHEDULE FOR DIMENSION.
- ADDITIONAL SQUARE PLATE WASHER AT EACH BOLT. SEE SCHEDULE FOR SIZE AND THICKNESS.
- OVER SIZED HOLE DIAMETER IN BASE PLATE. SEE SCHEDULE FOR HOLE DIAMETER.
- ALL-AROUND FILLET WELD. SEE SCHEDULE FOR SIZE.

A2 TYPICAL BASE PLATE DETAIL AND SCHEDULE
NTS

DRILLED SHAFTS NOTES:

- ALL DRILLED SHAFTS SHALL BEAR ON APPROVED VERY STIFF TO SOUND BEDROCK BEARING STRATA AS INSPECTED AND CERTIFIED BY A QUALIFIED SOIL TESTING FIRM.
- THE PROCEDURE AND CONSTRUCTION SEQUENCES RELATED TO PLACING CONCRETE, OR GROUT AND STEEL LINER WITHDRAWAL SHALL BE REVIEWED AND APPROVED BY THE ENGINEER OF RECORD.
- THE CONTRACTOR SHALL REVIEW ALL EXISTING SITE CONDITIONS AND THE GEOTECHNICAL EXPLORATION REPORTS, PROVIDED BY THE CONTRACTOR'S GEOTECHNICAL TESTING AGENCY, AND ESTABLISH SPECIFIC CONSTRUCTION PROCEDURES AND SEQUENCES FOR THE INSTALLATION OF THE DRILLED SHAFTS AND SUBMIT THESE FOR REVIEW AND APPROVAL BY THE ENGINEER OF RECORD. THE CONTRACTOR'S PROCEDURES AND METHODS OF DRILLED SHAFT INSTALLATION SHALL MINIMIZE SETTLEMENT OF ADJACENT CONSTRUCTION AND THE CONTRACTOR SHALL HAVE THE RESPONSIBILITY FOR ALL REMEDIAL WORK RESULTING FROM SUCH SETTLEMENT.
- THE BOTTOM OF EACH DRILLED SHAFT SHALL BE THOROUGHLY CLEANED OF ALL LOOSE MATERIALS.
- NO CONCRETE SHALL BE PLACED INTO A DRILLED SHAFT CONTAINING FREE WATER WITHOUT THE STRUCTURAL ENGINEER'S REVIEW AND APPROVAL.
- THE DRILLED SHAFT CONCRETE SHALL BE PLACED USING A HOPPER AND CHUTE PIPE AT THE TOP OF EACH DRILLED SHAFT EXCAVATION AND SHALL BE PLACED IMMEDIATELY AFTER CLEANING AND AFTER APPROVAL OF BEARING SURFACE IS OBTAINED. EXCAVATION SHALL NOT BE LEFT OPEN OVER NIGHT.
- ALL LAITANCE MATERIAL SHALL BE REMOVED FROM THE TOP OF EACH DRILLED SHAFT PRIOR TO FURTHER CONSTRUCTION.
- THE ANNULAR VOID AROUND THE STEEL LINER OF EACH DRILLED SHAFT SHALL BE FILLED PRIOR TO FURTHER CONSTRUCTION.
- ALL DRILLED SHAFT CONCRETE SHALL BE STONE CONCRETE (150 PCF) WITH MINIMUM 28 DAY COMPRESSIVE STRENGTH OF 4,000 PSI (U.N.O.).
- PROVIDE ALTERNATE CONCRETE DESIGN FOR TREME CONCRETE PLACEMENT.


POST-INSTALLED ANCHORS:

- REFERENCE STANDARD: ACI 318-05, APPENDIX D.
- INSTALL ONLY WHERE SPECIFICALLY SHOWN IN THE PROJECT DETAILS.
- ALL POST-INSTALLED ANCHOR TYPES SHALL BE APPROVED BY THE ENGINEER OF RECORD AND SHALL HAVE A CURRENT ICC-ESR THAT PROVIDES RELEVANT DESIGN VALUES TO VALIDATE THE AVAILABLE STRENGTH.
- INSTALL ALL ANCHORS IN STRICT ACCORDANCE TO THE ICC-ESR AND MANUFACTURER'S INSTRUCTIONS.
- SPECIAL INSPECTIONS SHALL BE IN ACCORDANCE WITH THE REQUIREMENTS INDICATED IN THE SCHEDULE OF SPECIAL INSPECTIONS UNDER 1704.4 CONCRETE CONSTRUCTION.
- USE COMPRESSED AIR TO THOROUGHLY CLEAN THE ANCHOR HOLES.
- PROVIDE EPOXY ADHESIVE TYPE ANCHORS WITH THE FOLLOWING MINIMUM ALLOWABLE CAPACITIES AND MINIMUM EMBEDMENTS.

ANCHOR DIA (IN)	EMB (IN)	CONCRETE		CMU	
		TENSIO N (KIP)	SHEAR (KIP)	TENSIO N (KIP)	SHEAR (KIP)
0.375	3.375	3.06	4.46	0.880	1.13
0.500	4.500	4.98	7.93	1.06	1.74
0.625	5.625	8.41	12.4	1.37	2.12
0.750	6.750	9.98	17.8	1.58	2.20
1.000	9.000	14.8	24.3	-	-

NOTES:
1. ANCHOR DIAMETERS AND EMBEDMENTS ARE IN INCHES.
2. ALLOWABLE CAPACITIES ARE IN KIPS.
3. ALLOWABLE CAPACITIES ARE BASED ON MINIMUM ALLOWABLE EDGE DISTANCES, MINIMUM SPACINGS, F'c = 4,000 PSI AND F'm = 1,500 PSI.

- ALL ANCHORS EMBEDDED IN CONCRETE OR MASONRY SHALL BE PROPORTIONED TO EXCEED THE STRENGTH OF THE CONNECTED HARDWARE. ALL ANCHORS SHALL BE SHOWN TO BE IN COMPLIANCE WITH ACI 318 APPENDIX D. MECHANICAL EXPANSION FASTENERS SHALL NOT BE USED IN CONDITIONS WHERE THEY WILL SEE TENSILE LOADS. POWDER DRIVEN ANCHORS SHALL NOT BE USED IN CONCRETE OR MASONRY.

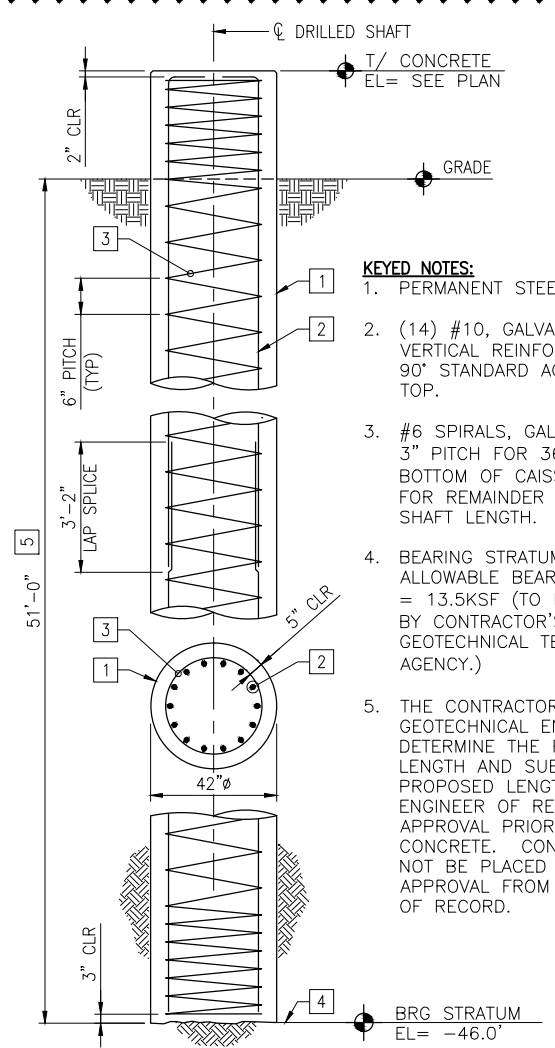


KEYED NOTES:

- PERMANENT STEEL CASING.
- (14) #10, GALVANIZED, VERTICAL REINFORCING WITH A 90° STANDARD ACI HOOK AT TOP.
- #6 SPIRALS, GALVANIZED, AT 3" PITCH FOR 36" AT TOP AND BOTTOM OF CAISSON, 6" PITCH FOR REMAINDER OF DRILLED SHAFT LENGTH.
- BEARING STRATUM FOR NET ALLOWABLE BEARING PRESSURE = 13.5KSF (TO BE VERIFIED BY CONTRACTOR'S GEOTECHNICAL TESTING AGENCY.)
- THE CONTRACTOR'S GEOTECHNICAL ENGINEER SHALL DETERMINE THE FINAL DESIGN LENGTH AND SUBMIT THE PROPOSED LENGTH TO THE ENGINEER OF RECORD FOR APPROVAL PRIOR TO PLACING CONCRETE. CONCRETE SHALL NOT BE PLACED WITHOUT APPROVAL FROM THE ENGINEER OF RECORD.

A3 42" DIAMETER DRILLED SHAFT
NTS

HAZARDOUS WORK CONDITIONS:


- THE CONTRACTOR IS WARNED OF THE PRESENCE OF AN ELECTRIFIED CONTACT RAIL (600 VOLTS DC) AND MOVING TRAINS ON THE CTA TRACKS AND SHALL TAKE ALL NECESSARY PRECAUTIONS TO PREVENT INJURY TO PERSONEL OR DAMAGE TO PROPERTY THROUGH CONTACT WITH THE ELECTRICAL OR OPERATION SYSTEMS.
- THE CONTRACTOR'S ATTENTION IS DIRECTED TO THE FACT THAT CONTACT WITH THE ELECTRIFIED CONTACT RAIL, CTA POWER CABLES OR TRAINS MAT RESULT IN A SEVERE BURN OR DEATH.
- ELEVATED STRUCTURES IS AT NEGATIVE RAIL POTENTIAL, AVOID CONTACT BETWEEN STRUCTURE AND EARTH GROUNDED OBJECTS. I.E. EDISON GROUNDS, WATER, PIPES, ETC.

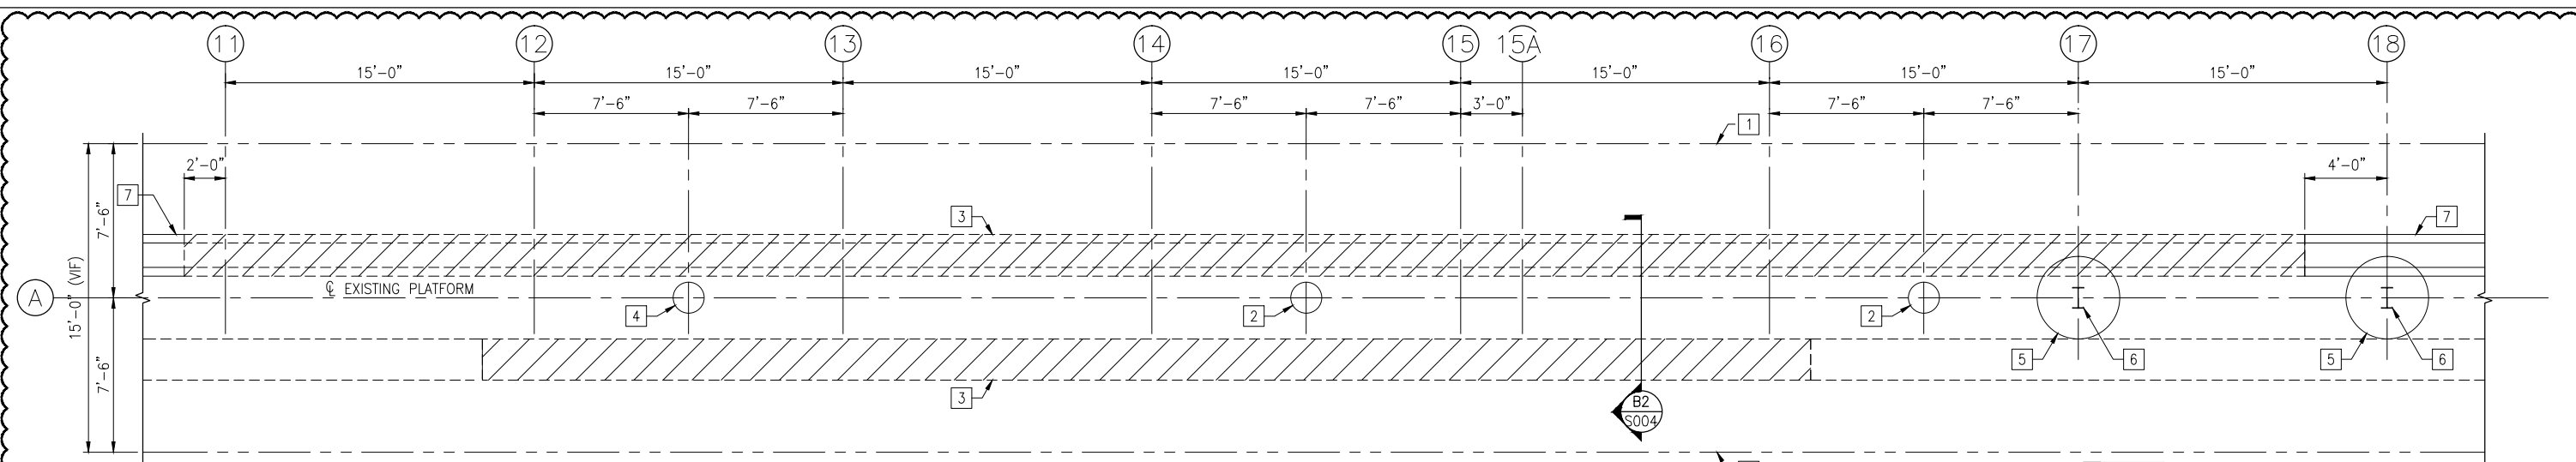

B1 PARTIAL FOUNDATION DEMO PLAN
SCALE: 1/4"=1'-0"

KEYED NOTES:


1. EDGE OF EXISTING PLATFORM ABOVE.
2. EXISTING CONCRETE DRILLED SHAFT TO REMAIN.
3. EXISTING DUCT BANK AND DRAINAGE TRENCH TO BE PARTIALLY REMOVED TO PROVIDE CONSTRUCTION CLEARANCE FOR THE NEW ELEVATOR PIT AND FOUNDATIONS.
4. EXISTING CONCRETE DRILLED SHAFT TO BE REMOVED TO 6" BELOW BOTTOM OF NEW ELEVATOR PIT MAT.
5. EXISTING 48" DRILLED SHAFT TO REMAIN.
6. EXISTING WF12 COLUMN TO REMAIN.
7. EXISTING DRAINAGE TRENCH TO REMAIN.

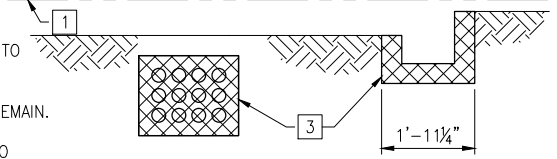

B2 EXISTING DUCT BANK AND DRAINAGE TRENCH
SCALE: NTS

SHEET NOTES:


1. ALL EXISTING DIMENSIONS AND ELEVATIONS ARE SHOWN FOR REFERENCE ONLY AND SHALL BE VERIFIED PRIOR TO COMMENCEMENT OF CONSTRUCTION AND/OR FABRICATION OF ANY MEMBERS TO DETERMINE ANY CRITICAL DIMENSIONS THAT MAY BE DEPENDANT ON THE EXISTING STRUCTURE.
2. SEE ARCHITECTURAL SHEET A-002 FOR AREA AVAILABLE FOR CONSTRUCTION LAYDOWN.
3. THE DEMOLITION AREAS SHOWN ARE THE MINIMUM REQUIRED. THE CONTRACTOR SHALL COORDINATE THE FINAL REMOVAL AREAS WITH THE APPROVED CONSTRUCTION PROCESS PLANS OUTLINING MEANS AND METHODS OF CONSTRUCTION.
4. ANY ADDITIONAL DEMOLITION THAT IS ELECTED TO BE DONE BY THE CONTRACTOR TO FACILITATE WORK ACCESS OR THEIR PREFERRED EQUIPMENT SHALL BE SUBMITTED FOR APPROVAL AS PART OF THE CONSTRUCTION PROCESS PLAN. SUBMISSION SHALL INCLUDE DETAILS FOR RESTORATION OF LARGER AREAS.
5. IF STRUCTURAL ELEMENTS ARE REMOVED THAT ARE NOT FULLY ENGINEERED AS PART OF THE WORK, THE CONTRACTOR SHALL PROVIDE SEALED DRAWINGS AND CALCULATIONS BY A STATE OF ILLINOIS REGISTERED STRUCTURAL ENGINEER FOR THE ADDITIONAL STRUCTURAL REPAIR AND COORDINATE ALL APPROVALS WITH THE CHICAGO DEPARTMENT OF BUILDINGS.
6. ANY ADDITIONAL ELECTIVE DEMOLITION WORK SHALL BE INCLUDED IN THE COST OF THE CONTRACT.
7. TO PERFORM THE NEW FOUNDATION WORK, IT WILL BE NECESSARY TO REMOVE AND REPLACE CERTAIN SECTIONS OF THE TRACK. THE CONTRACTOR SHALL FOLLOW THE REQUIREMENTS AS OUTLINED IN CTA STATION SPECIFICATION 34 11 00 BALLASTED TRACK CONSTRUCTION.

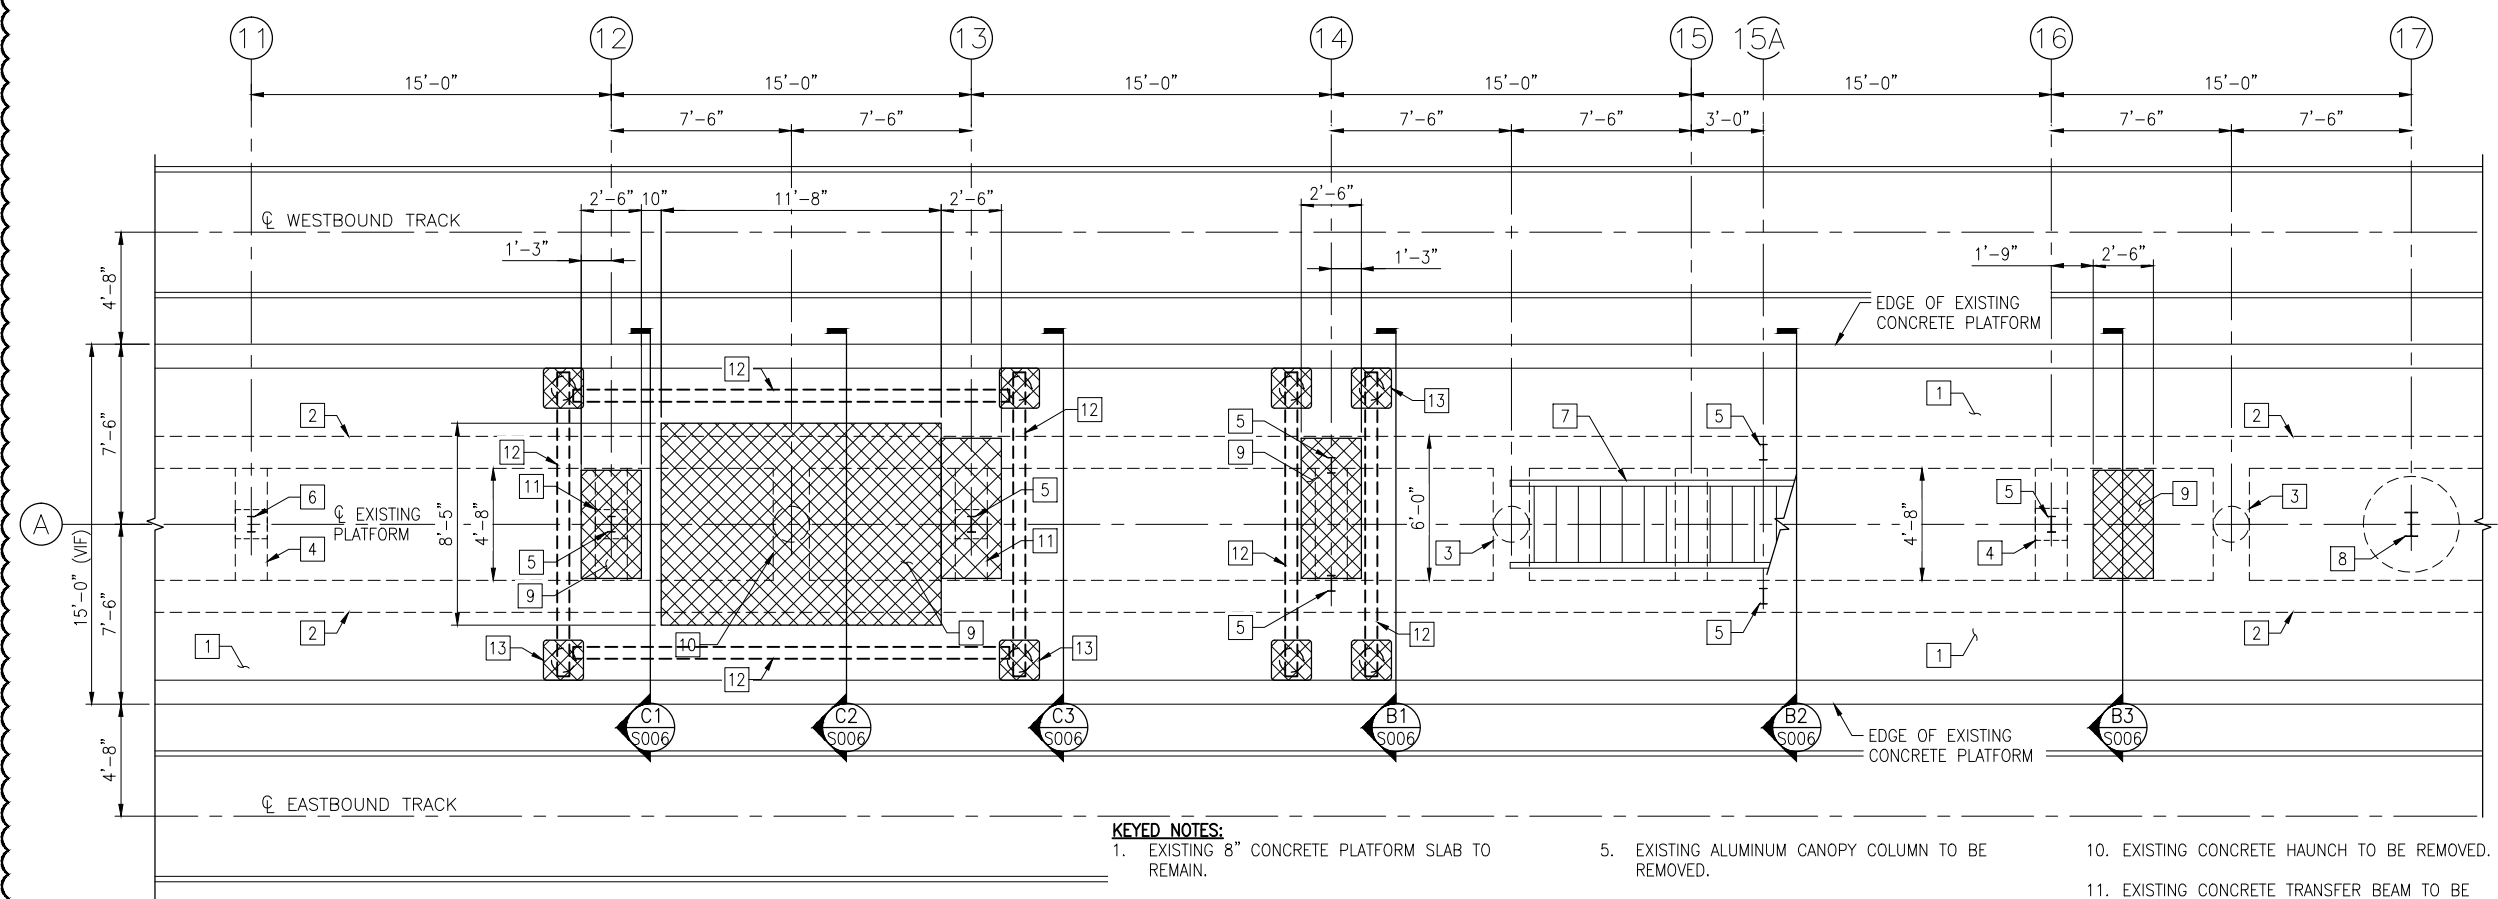

A1 PARTIAL PLATFORM DEMO PLAN
SCALE: 1/4"=1'-0"

KEYED NOTES:

1. EXISTING 8" CONCRETE PLATFORM SLAB TO REMAIN.
2. EXISTING 16" WIDE CONCRETE LONGITUDINAL PLATFORM BEAM TO REMAIN.
3. EXISTING CONCRETE HAUNCH AND DRILLED SHAFT TO REMAIN.
4. EXISTING CONCRETE TRANSFER BEAM BELOW PLATFORM TO REMAIN.
5. EXISTING ALUMINUM CANOPY COLUMN TO BE REMOVED.
6. EXISTING ALUMINUM CANOPY COLUMN TO REMAIN.
7. EXISTING STAIR TO BE REMOVED, TEMPORARILY STORED AND REINSTALLED.
8. EXISTING WF12 COLUMN TO REMAIN.
9. EXISTING 8" CONCRETE PLATFORM SLAB TO BE REMOVED.
10. EXISTING CONCRETE HAUNCH TO BE REMOVED.
11. EXISTING CONCRETE TRANSFER BEAM TO BE REMOVED.
12. PROVIDE TEMPORARY SHORING BEAM BELOW PLATFORM SEE C3/S-006.
13. ACCESS CUT INTO EXISTING PLATFORM SLAB. SEE DETAIL C1/S-008.

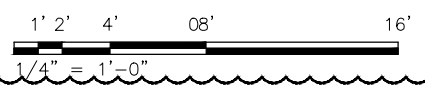


USER NAME = MAC	DESIGNED KLT	REVISED A 1/20/2014
	CHECKED AB	REVISED ---
PLOT SCALE =	DRAWN MAC	REVISED ---
PLOT DATE = 10/28/13	CHECKED KLT	REVISED ---

STATE OF ILLINOIS
DEPARTMENT OF TRANSPORTATION

PEORIA STREET STATION
PARTIAL FOUNDATION & PLATFORM DEMO PLANS

SHEET NO. S-004 OF 117 SHEETS

MUN	SECTION	COUNTY	TOTAL SHEETS	SHEET NO.
2090	2013-011R	COOK	356	195
CONTRACT NO. 60W29			ILLINOIS FED. AID PROJECT FED. AID PROJECT	

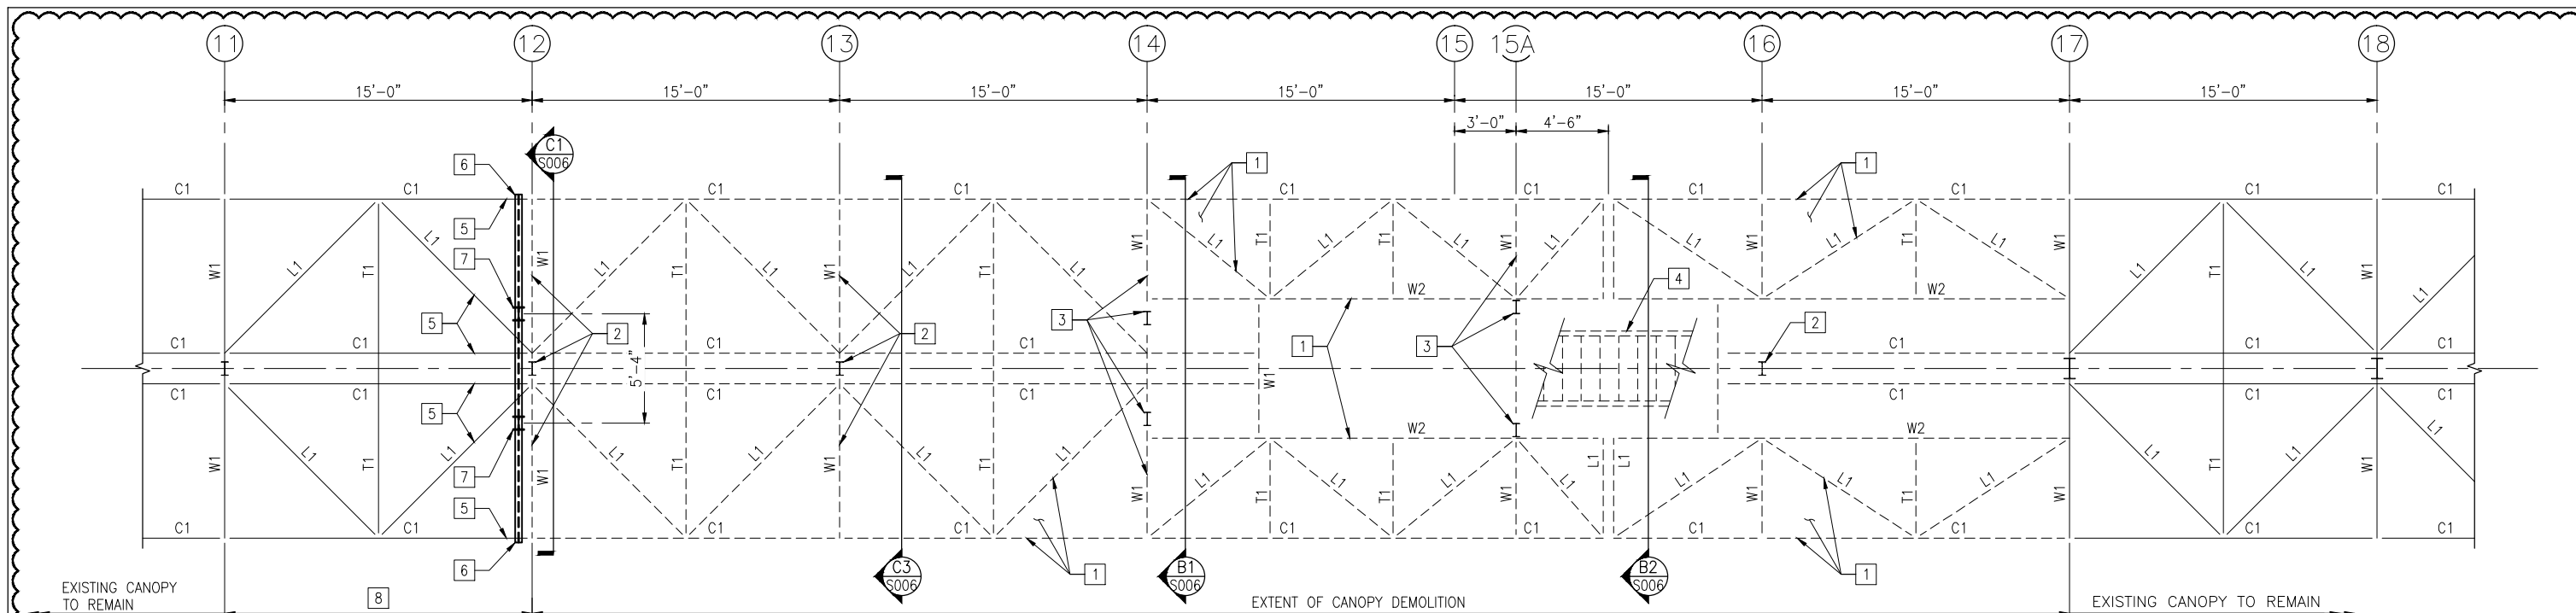


SHEET NOTE

- ALL EXISTING DIMENSIONS AND ELEVATIONS ARE SHOWN FOR REFERENCE ONLY AND SHALL BE VERIFIED PRIOR TO COMMENCEMENT OF CONSTRUCTION AND/OR FABRICATION OF ANY MEMBERS TO DETERMINE ANY CRITICAL DIMENSIONS THAT MAY BE DEPENDANT ON THE EXISTING STRUCTURE.
- TEMPORARY SHORING SHALL NOT INTERFERE WITH PASSENGER OR TRAIN OPERATIONS.

KEYED NOTES:

- REMOVE ALL EXISTING DECK ROOF BEAMS AND PURLINS FROM GRID 12 TO GRID 17.
- REMOVE EXISTING COLUMN BENT.
- REMOVE EXISTING DOUBLE COLUMN BENT.
- REMOVE EXISTING STAIRS, STORE AND RETAIN FOR REUSE.
- SHORE EXISTING CANOPY PURLINS UNTIL NEW CANOPY DOUBLE COLUMN BENT HAS BEEN CONSTRUCTED.
- TEMPORARY W12x26 SHORING BEAM.
- TEMPORARY W8x24 SHORING POST.
- CONTRACTOR'S OPTION TO ADD TEMPORARY SHORING AT GRID 12 AS INDICATED IN SECTION C1/S-006 OR REMOVE AND REPLACE OR REINSTALL EXISTING CANOPY FRAMING BETWEEN GRIDS 11 AND 12.


B1 PLATFORM CANOPY DEMO PLAN
SCALE: 1/4"=1'-0"

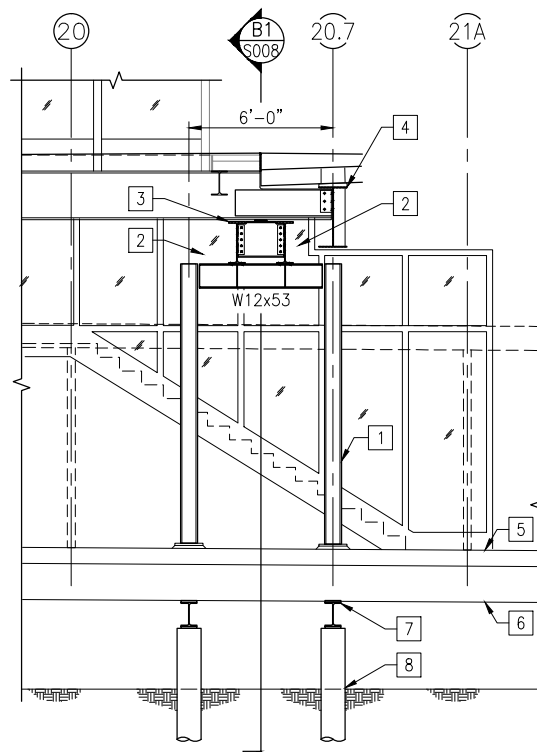

A1 SHORING ELEVATION
SCALE: 1/4" = 1'-0"

KEYED NOTES:

- SHORING TOWER AT SOUTHEAST CORNER OF EXISTING STATION.
- TEMPORARILY REMOVE EXISTING GLAZING AND FRAMES TO FACILITATE INSTALLATION OF TOWER SHORING BEAMS. SEE SHEET AD-200.
- (2) W12x68 TEMPORARILY SHORING BEAMS.
- LOCATION OF EXISTING AND NEW BRIDGE FASCIA PLATE GIRDER.
- EXISTING CONCRETE PLATFORM.
- EXISTING LONGITUDINAL CONCRETE PLATFORM SUPPORT BEAMS,
- TEMPORARY W12x40 TRANSVERSE SUPPORT BEAMS CENTERED UNDER SHORING TOWER POSTS.
- MICROPILES AT EACH END OF EACH TRANSVERSE SUPPORT BEAM.

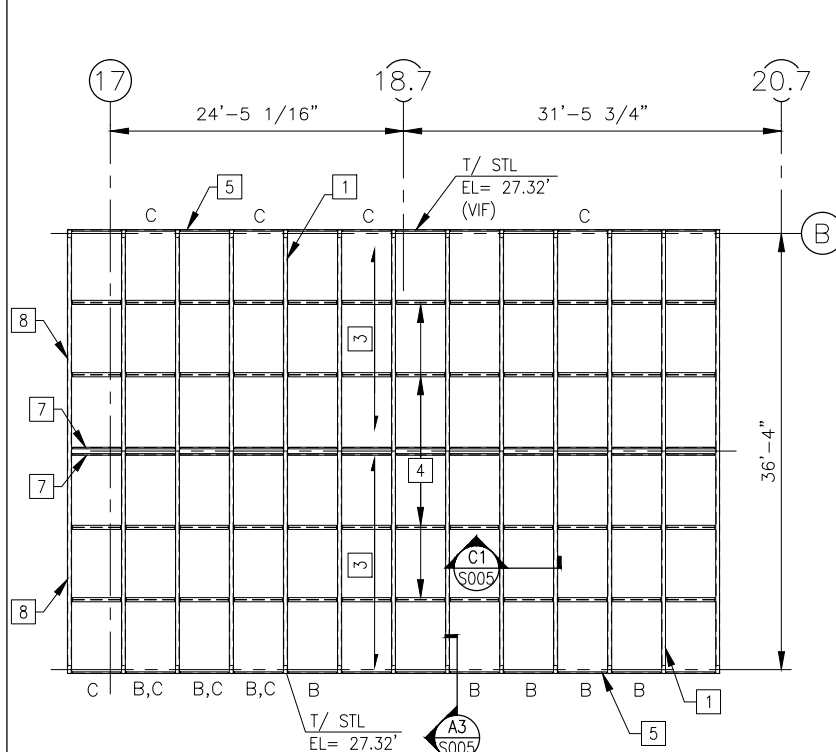


A2 EXISTING STATION ROOF PLAN
SCALE: 1/8"=1'-0"

A2 KEYED NOTES:


- EXISTING HSS8x4 BENT.
- EXISTING STEEL ANGLES. REMOVE AND GRIND SMOOTH. (1) AT EA. SIDE.
- REMOVE EXISTING FIBERGLASS SKYLIGHTS.
- EXISTING ROOF PURLINS TO REMAIN.
- EXISTING 1/2 BENT PLATE, TYP.
- EXISTING CONNECTION ANGLE.
- EXISTING DBL C4 AT RIDGE.
- REMOVE ALL HORIZONTAL DETERIORATED HSS3x3 MEMBERS BELOW THAT FRAME WINDOW OPENINGS AND REPLACE WITH NEW HSS3x3x $\frac{5}{16}$ MEMBERS.

LEGEND:


- B= REPLACE EXISTING DETERIORATED BENT PLATE, THIS LOCATION.
 - C= REPLACE EXISTING DETERIORATED CHANNEL, THIS LOCATION.
- REPLACE ALL EXISTING DETERIORATED MEMBERS THAT HAVE LOST MORE THAN 25% SECTION.

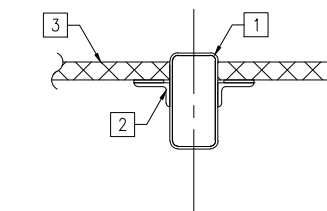

C1 DETAIL
SCALE: 1 1/2" = 1'-0"

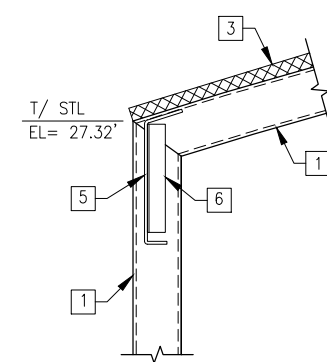

A3 DETAIL
SCALE: 3/4" = 1'-0"

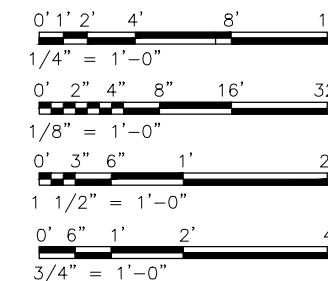


USER NAME = MAC	DESIGNED KLT	REVISED A 1/20/2014
PLOT SCALE =	CHECKED AB	REVISED ---
PLOT DATE = 10/28/13	DRAWN MAC	REVISED ---
	CHECKED KLT	REVISED ---

STATE OF ILLINOIS
DEPARTMENT OF TRANSPORTATION


PEORIA STREET STATION
PLATFORM CANOPY DEMO PLAN

SHEET NO. S-005 OF 117 SHEETS


MUN 2090	SECTION 2013-011R	COUNTY COOK	TOTAL SHEETS 356	SHEET NO. 196
				CONTRACT NO. 60W29
ILLINOIS FED. AID PROJECT FED. AID PROJECT				

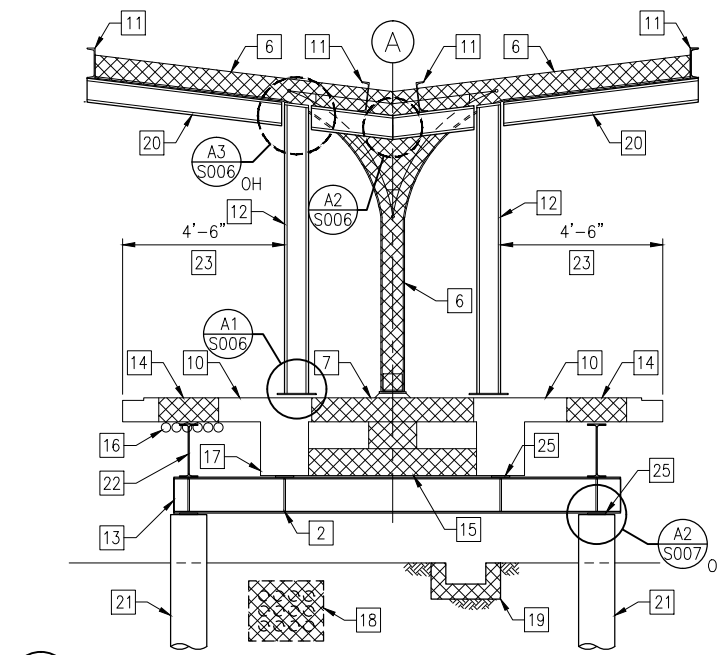


C1 SECTION AT GRID 12
3/8" = 1'-0"

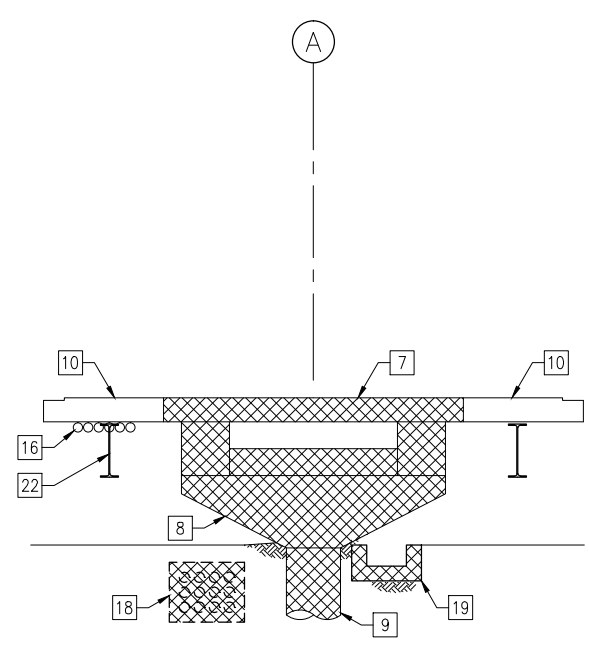


C2 SECTION AT GRID 12.5
3/8" = 1'-0"

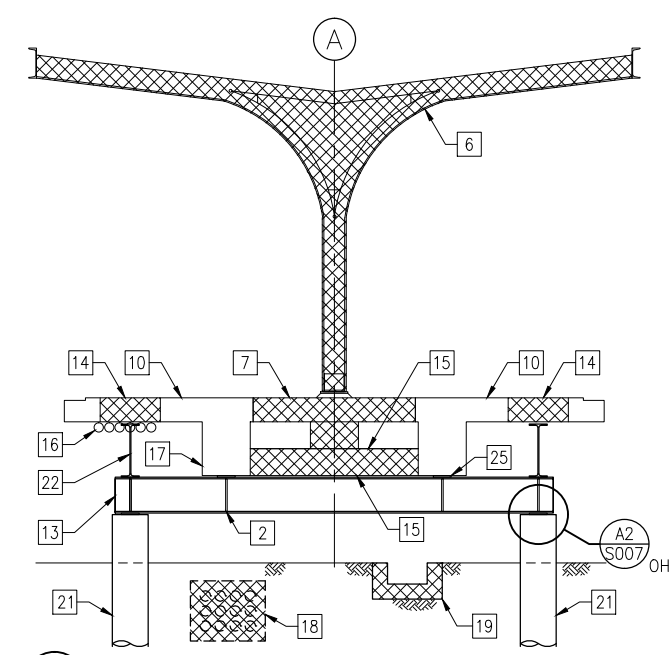


C3 SECTION AT GRID 13
3/8" = 1'-0"

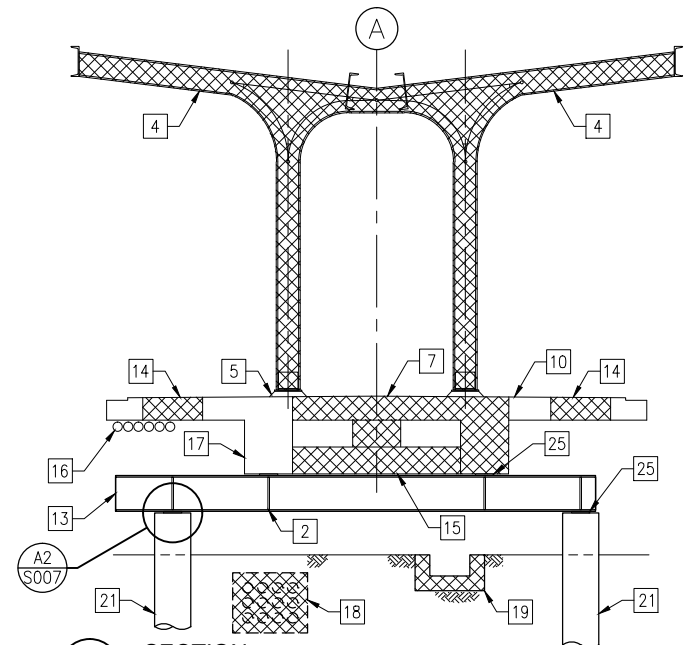


B1 SECTION
3/8" = 1'-0"

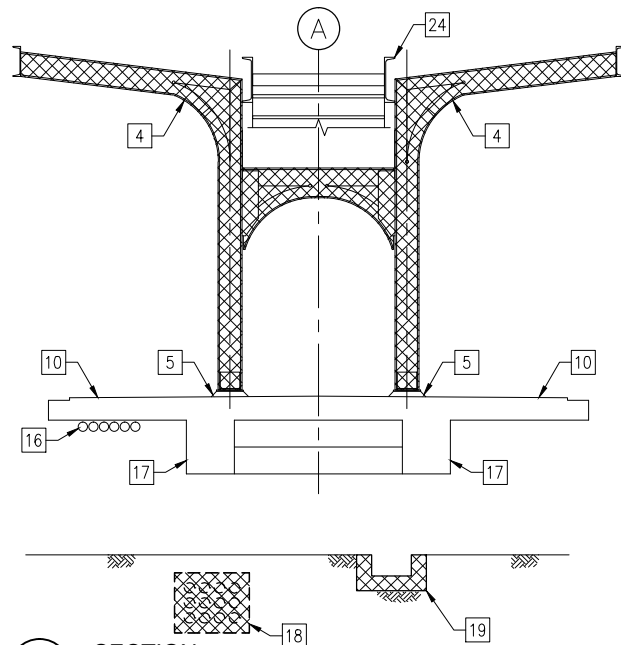


B2 SECTION
3/8" = 1'-0"

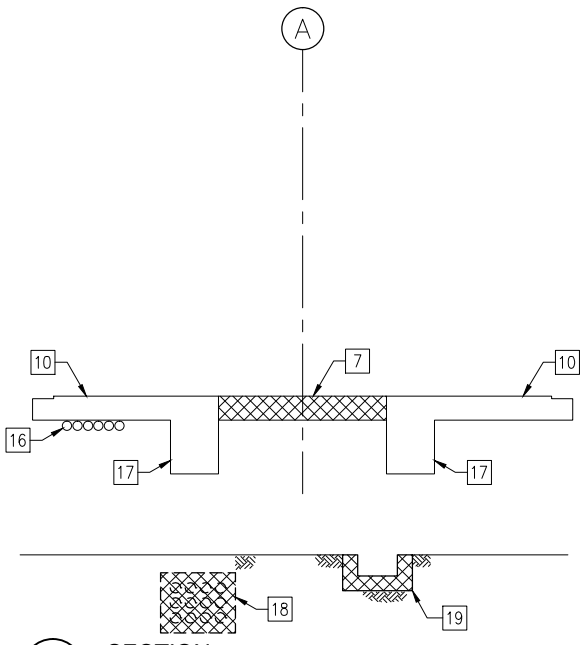


B3 SECTION
3/8" = 1'-0"

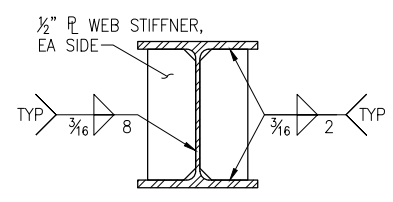


B4 SECTION
1-1/2" = 1'-0"

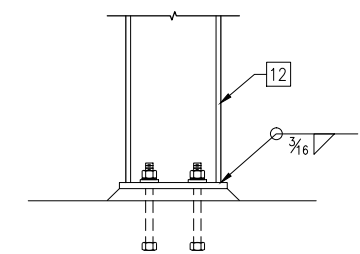


A1 SECTION
1 1/2" = 1'-0"

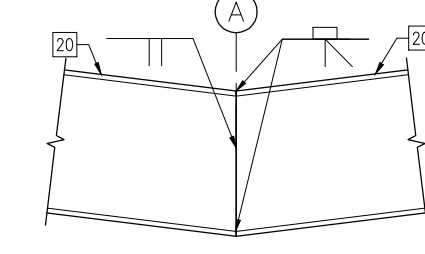

A2 SECTION
1 1/2" = 1'-0"

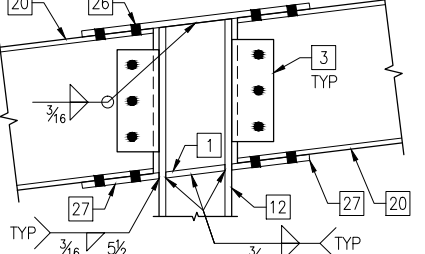

A3 SECTION
1 1/2" = 1'-0"

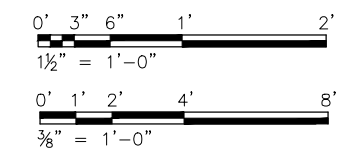

SHEET NOTES
1. ALL EXISTING DIMENSIONS AND ELEVATIONS ARE SHOWN FOR REFERENCE ONLY AND SHALL BE VERIFIED PRIOR TO COMMENCEMENT OF CONSTRUCTION AND/OR FABRICATION OF ANY MEMBERS TO DETERMINE ANY CRITICAL DIMENSIONS THAT MAY BE DEPENDENT ON THE EXISTING STRUCTURE.

- KEYED NOTES:**
1. $\frac{1}{2}$ " WEB STIFFENER AT EACH SIDE OF POST.
 2. $\frac{1}{2}$ " WEB STIFFENER, EACH SIDE OF EACH BEARING LOCATION. SEE B4/S006.
 3. SEE B1/S600 FOR TYPICAL SHEAR CONNECTION.
 4. REMOVE EXISTING DOUBLE ALUMINUM COLUMN BENT AND ROOF DECK.
 5. REMOVE EXISTING ANCHOR BOLTS. CUT BELOW SURFACE AND PATCH CONCRETE.
 6. REMOVE EXISTING SINGLE ALUMINUM COLUMN BENT AND ROOF DECK.
 7. REMOVE EXISTING 8" CONCRETE PLATFORM SLAB
 8. REMOVE EXISTING CONCRETE HAUNCH.
 9. REMOVE EXISTING CONCRETE CAISSON TO 6" BELOW NEW ELEVATOR PIT MAT FOUNDATION.
 10. EXISTING 8" PLATFORM SLAB TO REMAIN.
 11. SHORE EXISTING CANOPY PURLINS BEYOND UNTIL NEW DOUBLE COLUMN BENT HAS BEEN CONSTRUCTED AT GRID 13.
 12. TEMPORARY W8x24 SHORING POST FOR EXISTING CANOPY ROOF PURLINS, BEYOND.
 13. W12x40 TEMPORARY SHORING BEAM. LOCATIONS AS INDICATED ON SHEET S-004.
 14. CUT EXISTING CONCRETE PLATFORM SLAB TO PROVIDE ACCESS FOR INSTALLATION OF THE MICROPILES. COVER EXPOSED OPENING WITH $\frac{1}{2}$ ", OVERSIZED STEEL PLATE IF HOLE IS LEFT OPEN DURING OPERATING HOURS OF TRAINS.
 15. REMOVE EXISTING CROSS BEAM UNDER COLUMN.
 16. SEE ELECTRICAL DRAWINGS FOR REROUTING OF EXISTING ELECTRICAL CONDUITS.
 17. EXISTING LONGITUDINAL PLATFORM BEAM TO REMAIN, BOTH SIDES OF PLATFORM.
 18. EXISTING DUCT BANK TO BE REMOVED. SEE ELECTRICAL DRAWINGS FOR DUCT BANK CRITERIA.
 19. EXISTING DRAINAGE TRENCH TO BE REMOVED.
 20. W12x26 SHORING BEAM. DETERMINE AND MATCH EXISTING ROOF SLOPE. SEE S-600 FOR TYPICAL BEAM SHEAR CONNECTION.
 21. PROVIDE MICROPILES AT EACH END OF EACH SHORING BEAM WITH 32KIPS ASD CAPACITY.
 22. PROVIDE W18x35 TEMPORARY SHORING BEAM AT EACH SIDE OF EXISTING PLATFORM BETWEEN GRIDS 12 AND 13 ONLY. PROVIDE SHIMS AS REQUIRED.
 23. MAINTAIN A MINIMUM CLEARANCE OF 4'-6" DURING CONSTRUCTION.
 24. EXISTING STAIRS TO BE REMOVED, STORED AND REINSTALLED.
 25. 8"x8"x $\frac{1}{4}$ " FIBER REINFORCED ELASTOMERIC BEARING PADS AT ALL CONCRETE TO STEEL BEARING INTERFACES.
 26. $\frac{1}{2}$ "x6 x 1-9 WITH (4) $\frac{3}{4}$ " ϕ BOLTS, EACH END, 3 $\frac{1}{2}$ " GAGE, 3" SPACING, 1 $\frac{1}{4}$ " EDGE DISTANCE.
 27. $\frac{1}{2}$ "x6 x 0-6 $\frac{1}{2}$ WITH (4) $\frac{3}{4}$ " ϕ BOLTS, EACH SIDE, 3 $\frac{1}{2}$ " GAGE, 3" SPACING, 1 $\frac{1}{4}$ " EDGE DISTANCE.




USER NAME = MAC	DESIGNED KLT	REVISED Δ 1/20/2014
PLOT SCALE =	CHECKED AB	REVISED ---
PLOT DATE = 10/28/13	DRAWN MAC	REVISED ---
	CHECKED KLT	REVISED ---

STATE OF ILLINOIS
DEPARTMENT OF TRANSPORTATION

PEORIA STREET STATION
PLATFORM SHORING SECTIONS
SHEET NO. S-006 OF 117 SHEETS

MUN 2090	SECTION 2013-011R	COUNTY COOK	TOTAL SHEETS 356	SHEET NO. 197
				CONTRACT NO. 60W29
ILLINOIS FED. AID PROJECT FED. AID PROJECT				

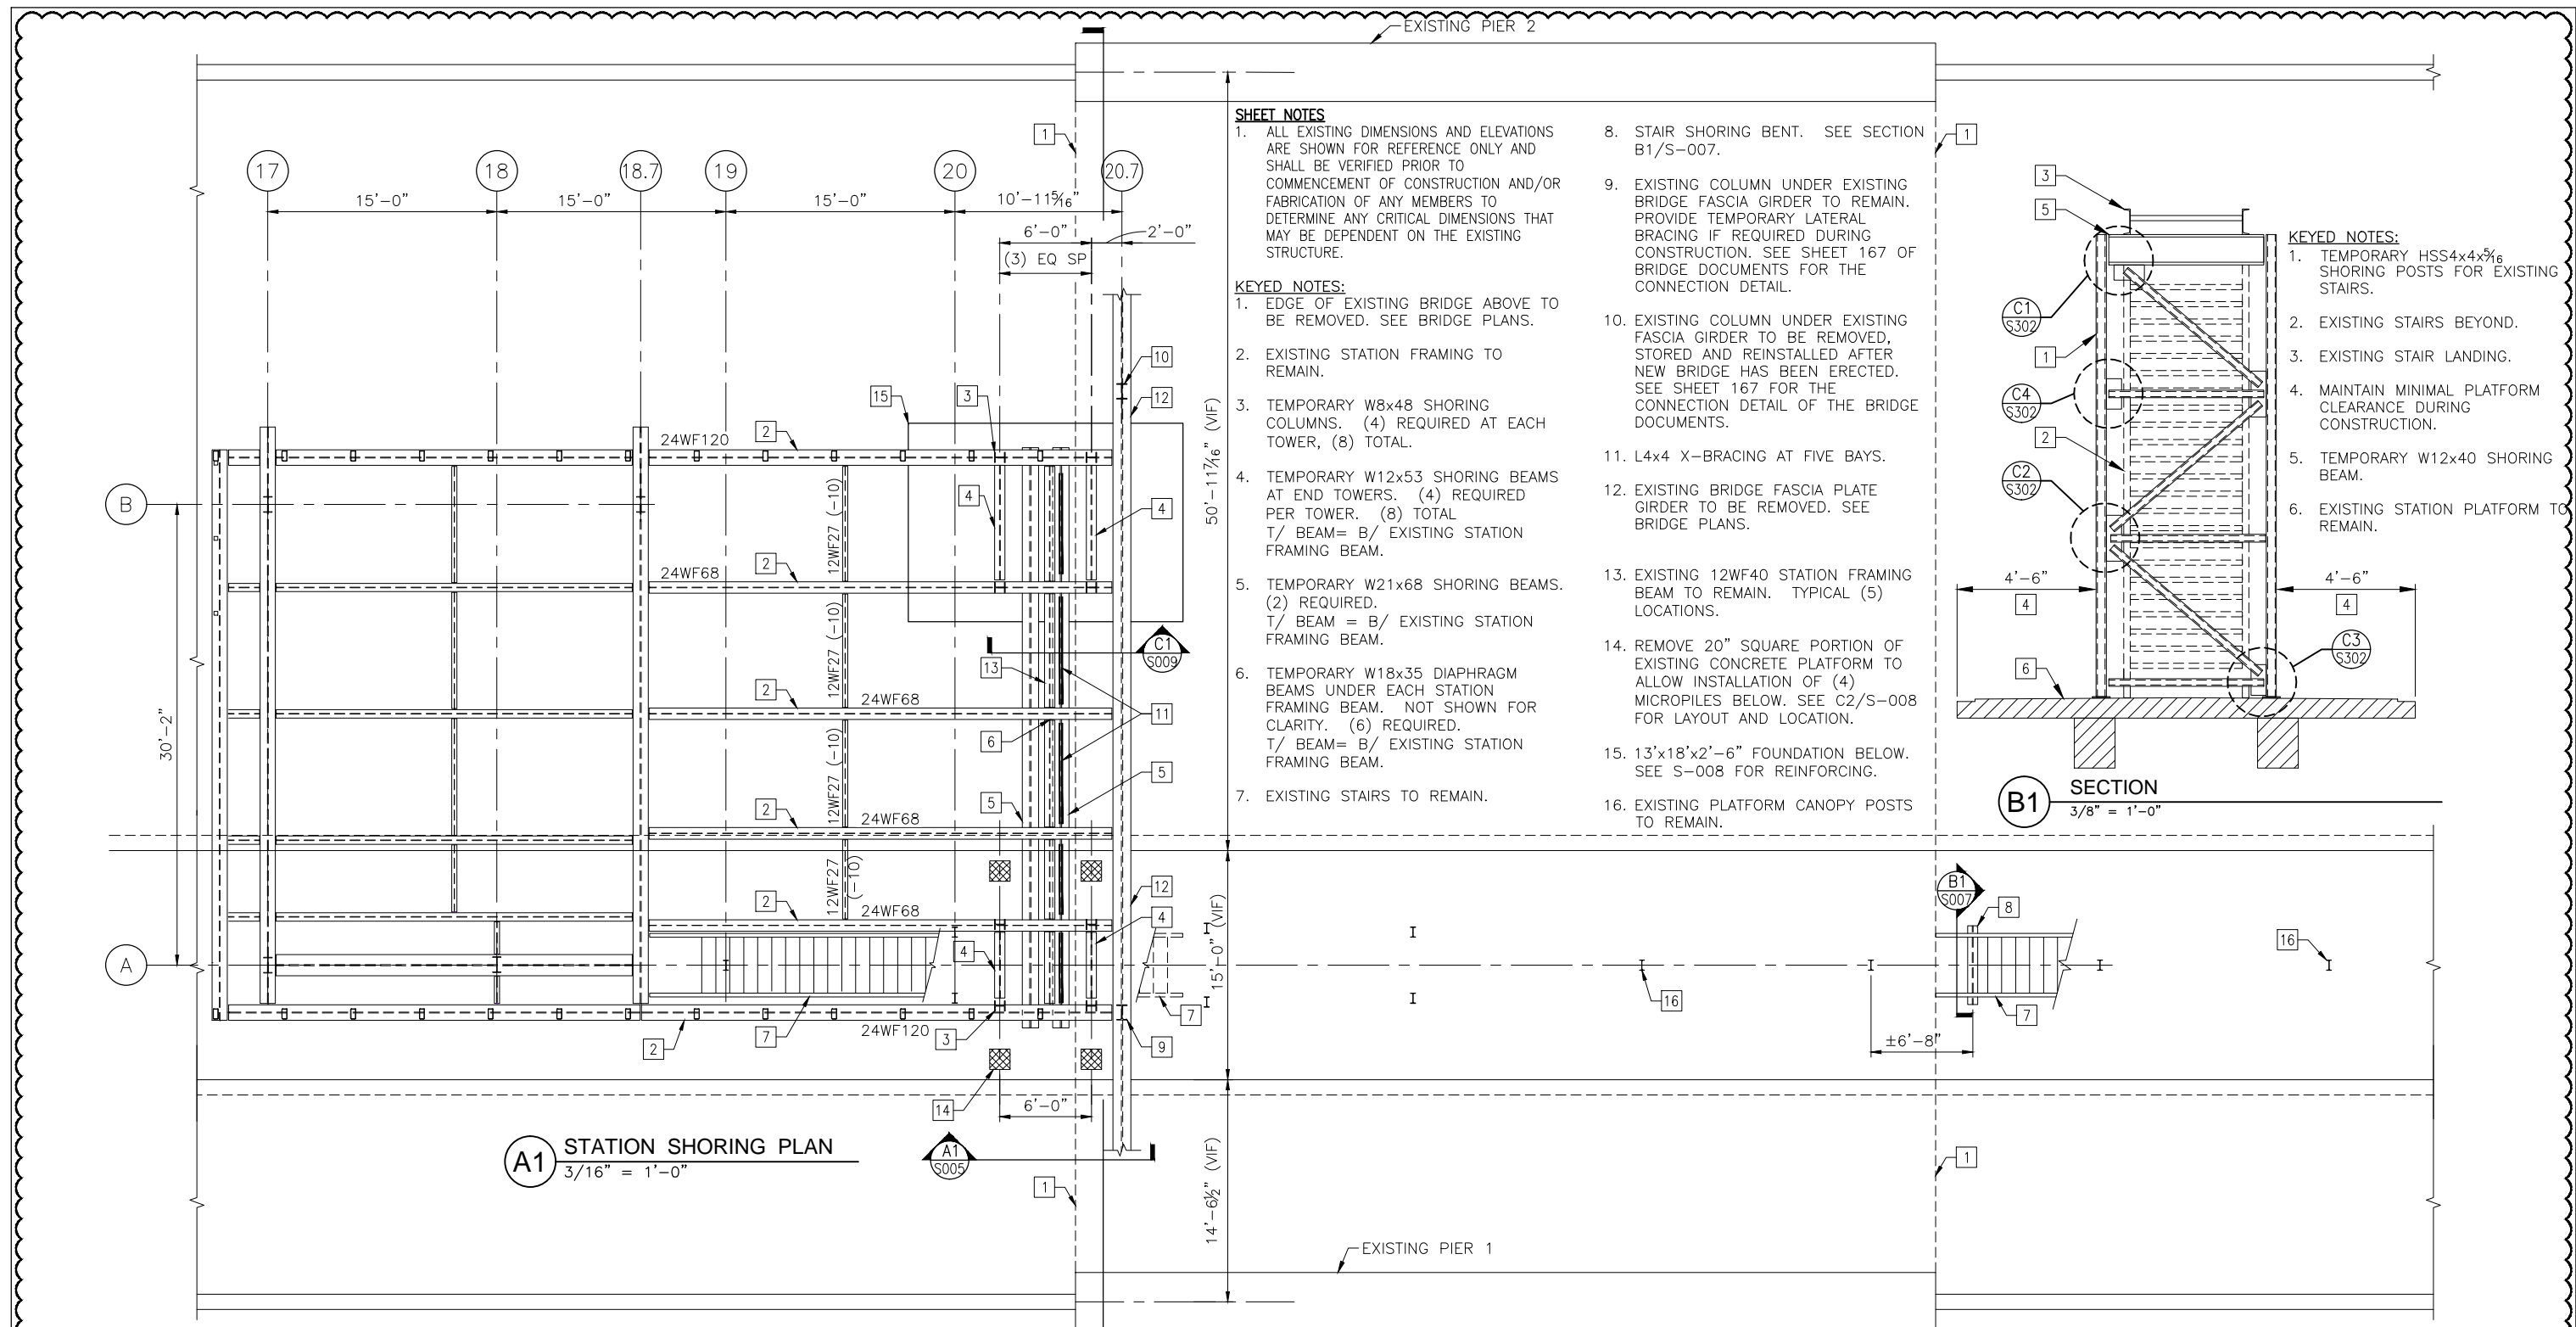


SHEET NOTES

- ALL EXISTING DIMENSIONS AND ELEVATIONS ARE SHOWN FOR REFERENCE ONLY AND SHALL BE VERIFIED PRIOR TO COMMENCEMENT OF CONSTRUCTION AND/OR FABRICATION OF ANY MEMBERS TO DETERMINE ANY CRITICAL DIMENSIONS THAT MAY BE DEPENDENT ON THE EXISTING STRUCTURE.
- EDGE OF EXISTING BRIDGE ABOVE TO BE REMOVED. SEE BRIDGE PLANS.
- EXISTING STATION FRAMING TO REMAIN.
- TEMPORARY W8x48 SHORING COLUMNS. (4) REQUIRED AT EACH TOWER, (8) TOTAL.
- TEMPORARY W12x53 SHORING BEAMS AT END TOWERS. (4) REQUIRED PER TOWER. (8) TOTAL
T/ BEAM = B/ EXISTING STATION FRAMING BEAM.
- TEMPORARY W21x68 SHORING BEAMS. (2) REQUIRED.
T/ BEAM = B/ EXISTING STATION FRAMING BEAM.
- TEMPORARY W18x35 DIAPHRAGM BEAMS UNDER EACH STATION FRAMING BEAM. NOT SHOWN FOR CLARITY. (6) REQUIRED.
T/ BEAM = B/ EXISTING STATION FRAMING BEAM.
- EXISTING STAIRS TO REMAIN.
- STAIR SHORING BENT. SEE SECTION B1/S-007.
- EXISTING COLUMN UNDER EXISTING BRIDGE FASCIA GIRDER TO REMAIN. PROVIDE TEMPORARY LATERAL BRACING IF REQUIRED DURING CONSTRUCTION. SEE SHEET 167 OF BRIDGE DOCUMENTS FOR THE CONNECTION DETAIL.
- EXISTING COLUMN UNDER EXISTING FASCIA GIRDER TO BE REMOVED, STORED AND REINSTALLED AFTER NEW BRIDGE HAS BEEN ERECTED. SEE SHEET 167 FOR THE CONNECTION DETAIL OF THE BRIDGE DOCUMENTS.
- L4x4 X-BRACING AT FIVE BAYS.
- EXISTING BRIDGE FASCIA PLATE GIRDER TO BE REMOVED. SEE BRIDGE PLANS.
- EXISTING 12WF40 STATION FRAMING BEAM TO REMAIN. TYPICAL (5) LOCATIONS.
- REMOVE 20" SQUARE PORTION OF EXISTING CONCRETE PLATFORM TO ALLOW INSTALLATION OF (4) MICROPILES BELOW. SEE C2/S-008 FOR LAYOUT AND LOCATION.
- 13'x18'x2'-6" FOUNDATION BELOW. SEE S-008 FOR REINFORCING.
- EXISTING PLATFORM CANOPY POSTS TO REMAIN.

KEYED NOTES:


- TEMPORARY HSS4x4x5/16 SHORING POSTS FOR EXISTING STAIRS.
- EXISTING STAIRS BEYOND.
- EXISTING STAIR LANDING.
- MAINTAIN MINIMAL PLATFORM CLEARANCE DURING CONSTRUCTION.
- TEMPORARY W12x40 SHORING BEAM.
- EXISTING STATION PLATFORM TO REMAIN.

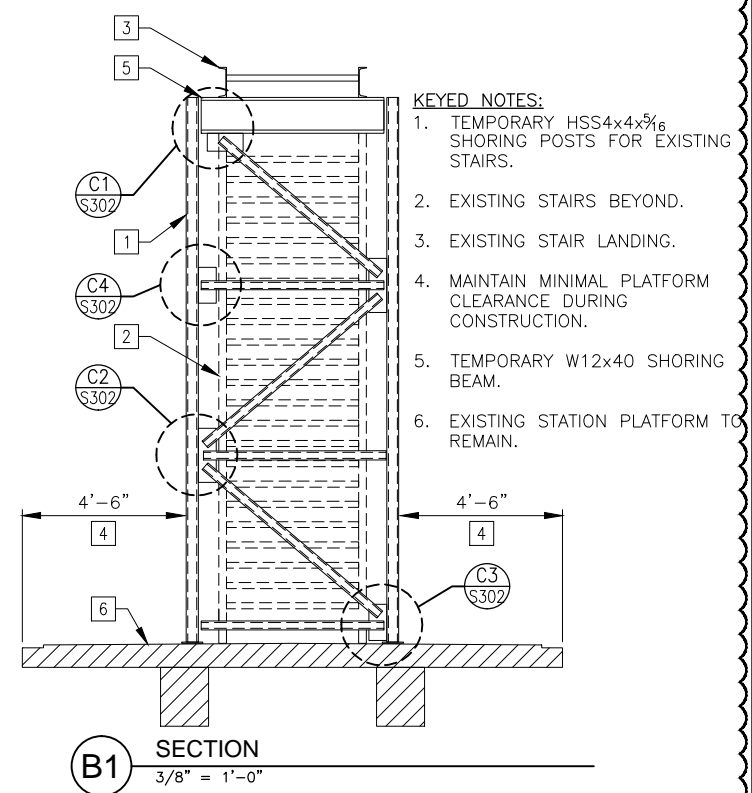

B1 SECTION
3/8" = 1'-0"


A1 STATION SHORING PLAN
3/16" = 1'-0"

A2 DETAIL
3/4" = 1'-0"

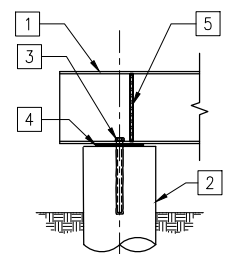

A2 KEYED NOTES

- W12x40 SHORING BEAM.
- MICROPILE AT EACH END OF EACH SHORING BEAM. SEE S-008 FOR REQUIREMENTS.
- (1) 3/4"Øx12" EMBEDMENT GALVANIZED ANCHOR ROD AT EACH SIDE.
- 8x8x1/4 FIBER REINFORCED ELASTOMERIC BEARING PAD AT EACH BEARING LOCATION.
- 1/2" WEB STIFFENER AT EACH SIDE AT EACH BEARING LOCATION. SEE B4/S-006.

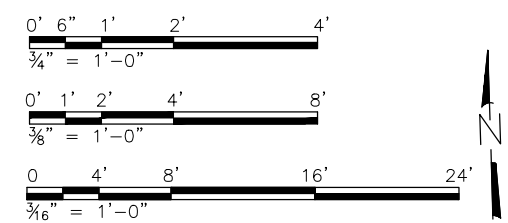


SHEET NOTES:

- ALL EXISTING DIMENSIONS AND ELEVATIONS ARE SHOWN FOR REFERENCE ONLY AND SHALL BE VERIFIED PRIOR TO COMMENCEMENT OF CONSTRUCTION AND/OR FABRICATION OF ANY MEMBERS TO DETERMINE ANY CRITICAL DIMENSIONS THAT MAY BE DEPENDANT ON THE EXISTING STRUCTURE.
- PROVIDE STEEL CONSTRUCTION IN ACCORDANCE WITH SPEC SECTION 05 10 30 AND IDCM, 2013 EXCEPT GALVANIZING IS NOT REQUIRED FOR TEMPORARY CONSTRUCTION.
- W21x68 SHORING BEAMS, TWO REQUIRED.
- SEE BRIDGE DRAWINGS FOR CLEARANCE THAT SHALL BE MAINTAINED THROUGHOUT CONSTRUCTION.
- EXISTING CONCRETE DECK BEYOND.
- EXISTING STATION FRAMING BEYOND TO REMAIN.
- W8x48 SHORING COLUMN, (4) REQUIRED AT EACH TOWER.
- W12x53 SHORING BEAM, (4) REQUIRED AT EACH TOWER.
- NOT USED.
- 13'x18' x 30" MAT FOUNDATION WITH #7 AT 11" O.C. EACH WAY, TOP AND BOTTOM.
T/ EXISTING CONCRETE SLAB
EL= ±19.00' (VIF)
- W12x68 SHORING BEAM, TWO REQUIRED. LINE UP DIRECTLY UNDER SHORING TOWER SUPPORT COLUMNS.
- PROVIDE (4) MICROPILES WITH 32KIP ASD LOAD CAPACITY PER PILE. SEE C2/S-008.
- MAXIMUM REACTION AT EACH SHORED BEAM. REACTIONS ARE BASED ON FACTORED, LRFD DESIGN LOADS.
- TYPICAL L4x4 TEMPORARY X-BRACING AT EAST END OF EXISTING STATION FLOOR FRAMING. BRACING SHALL BE INSTALLED PRIOR TO DISCONNECTING BEAMS FROM EXISTING BRIDGE GIRDER.
- W18x35 DIAPHRAGM BEAM UNDER EXISTING STATION FRAMING BEAM, (6) LOCATIONS.
- EXISTING 24WF STATION FRAMING BEAM, (6) LOCATIONS.
- MAINTAIN MINIMAL PLATFORM CLEARANCE DURING CONSTRUCTION.
- EXISTING STAIRS TO REMAIN.
- EXISTING UTILITY COLUMN. CONTRACTOR SHALL REMOVE, STORE AND REINSTALL COLUMN AFTER NEW BRIDGE HAS BEEN CONSTRUCTED. SEE SHEET 167 OF THE BRIDGE DRAWINGS FOR THE CONNECTION DETAIL.

KEYED NOTES:


- EDGE OF EXISTING CONCRETE PLATFORM.
- PROVIDE MINIMUM 3"Ø CORE AT EACH CORNER.
- PROVIDE SAW CUT TO OUTSIDE EDGE OF EACH CORED HOLE. ROUGHEN EXISTING CONCRETE TO ¼" AMPLITUDE.
- PROVIDE #5 GALV DOWELS AT 12" OC, MAX SPACING, EACH WAY. TOTAL DOWEL LENGTH SHALL BE TOTAL LENGTH OF OPENING. EMBED DOWELS 4" INTO EXISTING CONCRETE WITH AN APPROVED CHEMICAL ADHESIVE.
- APPLY CONCRETE BONDING AGENT PRIOR TO PLACING CONCRETE PATCH IN ACCORDANCE WITH THE MANUFACTURER'S CRITERIA.

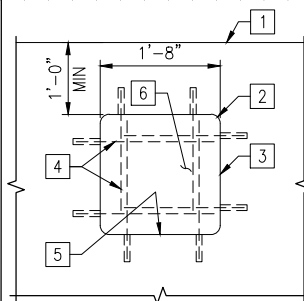


C1 CONCRETE REPAIR DETAIL
3/4" = 1'-0"

KEYED NOTES:

- EDGE OF EXISTING CONCRETE PLATFORM.
- PROVIDE MINIMUM 3"Ø CORE AT EACH CORNER.
- PROVIDE SAW CUT TO OUTSIDE EDGE OF EACH CORED HOLE. ROUGHEN EXISTING CONCRETE TO ¼" AMPLITUDE.
- PROVIDE #5 GALV DOWELS AT 12" OC, MAX SPACING, EACH WAY. TOTAL DOWEL LENGTH SHALL BE TOTAL LENGTH OF OPENING. EMBED DOWELS 4" INTO EXISTING CONCRETE WITH AN APPROVED CHEMICAL ADHESIVE.
- APPLY CONCRETE BONDING AGENT PRIOR TO PLACING CONCRETE PATCH IN ACCORDANCE WITH THE MANUFACTURER'S CRITERIA.
- APPLY NON-SHRINKING CONCRETE PATCH FLUSH WITH EXISTING ADJOINING CONCRETE SURFACE. MATCH FINISH OF EXISTING CONCRETE.

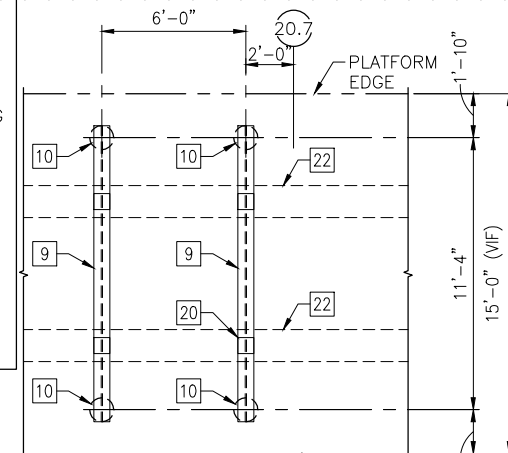


C2 PARTIAL PLAN
1/4" = 1'-0"

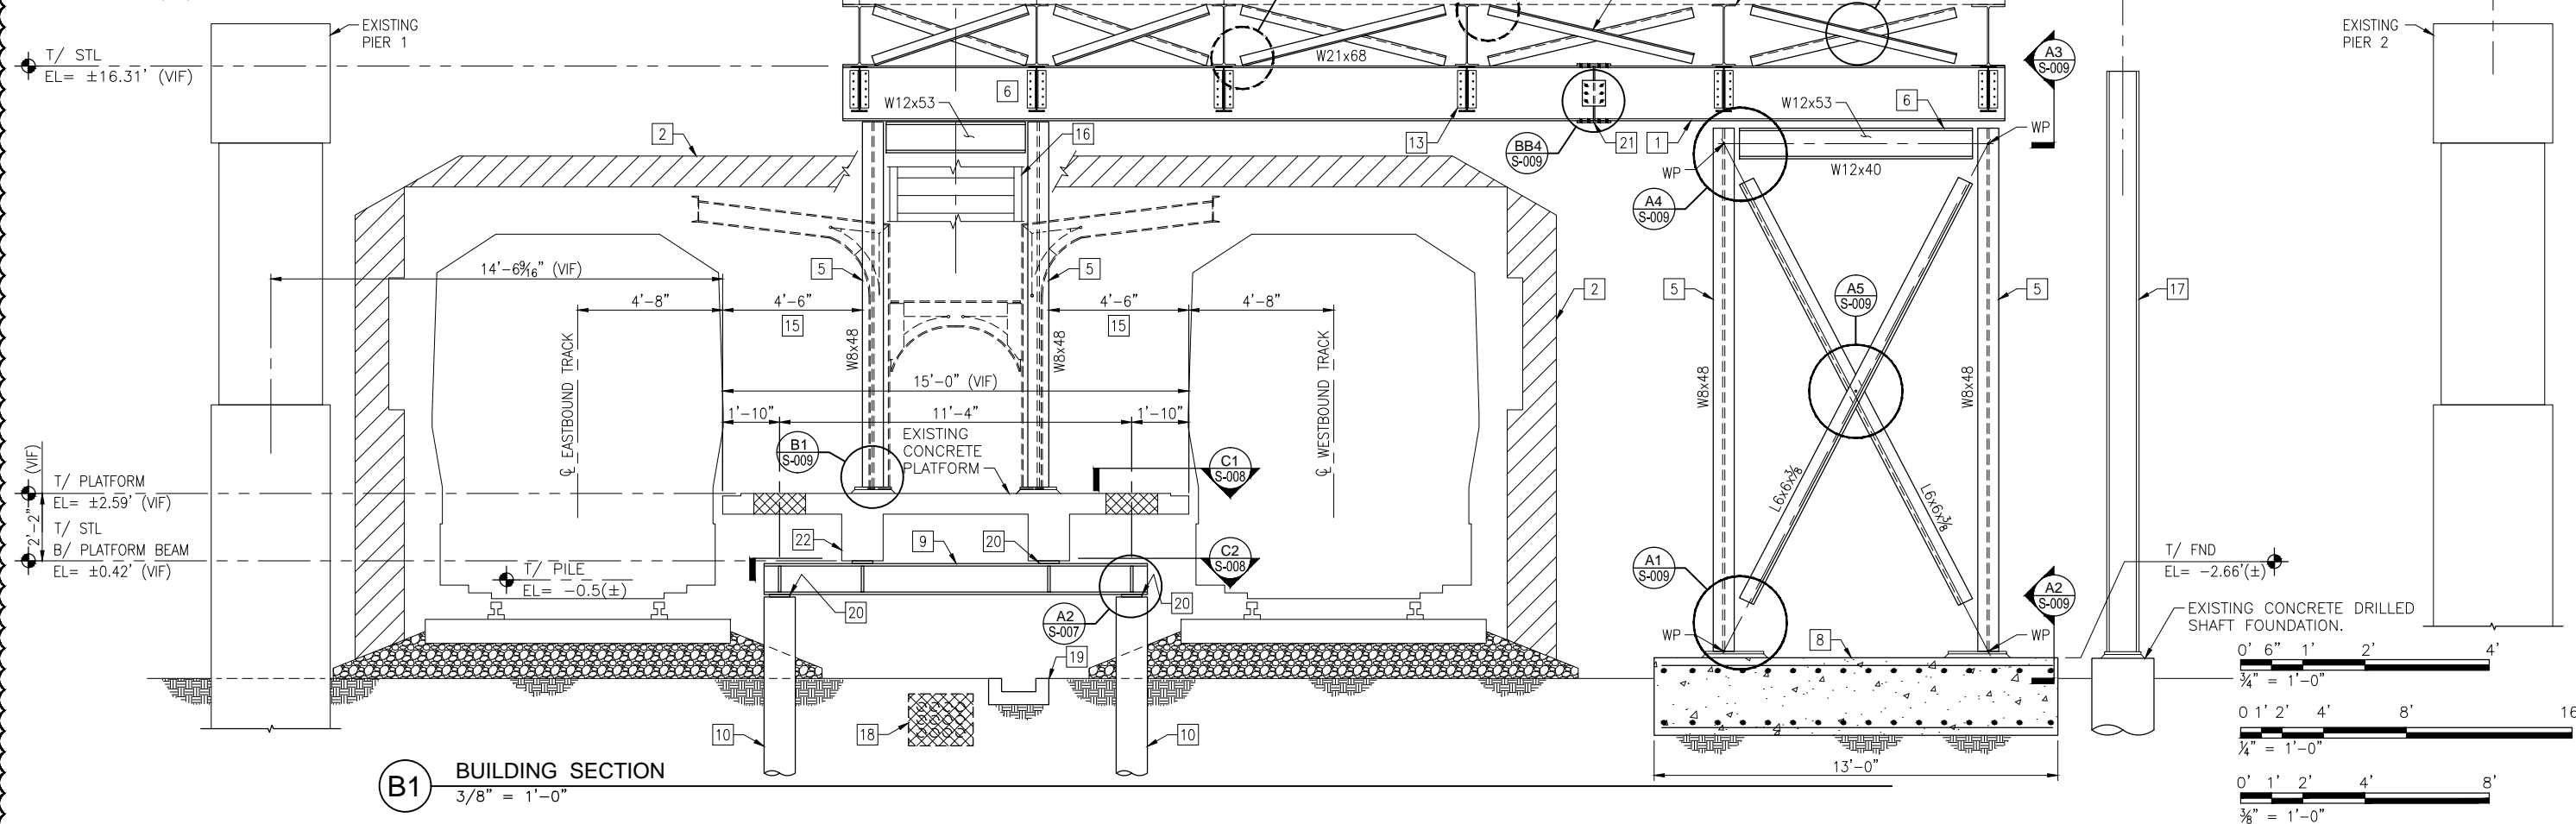

B1 BUILDING SECTION
3/8" = 1'-0"

- EXISTING PIER 1
- T/ STL
EL= ±16.31' (VIF)
- T/ PLATFORM
EL= ±2.59' (VIF)
- T/ STL
EL= ±0.42' (VIF)
- B/ PLATFORM BEAM
- T/ PILE
EL= -0.5(±)
- T/ FND
EL= -2.66'(±)

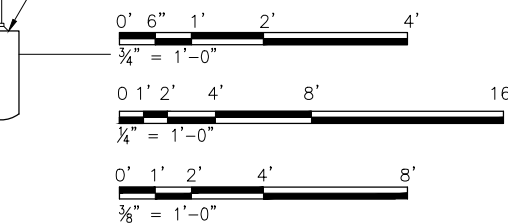


USER NAME = MAC	DESIGNED KLT	REVISED A 1/20/2014
CHECKED AB	REVISD ---	
DRAWN MAC	REVISD ---	
CHECKED KLT	REVISD ---	
PLOT DATE = 10/28/13		

STATE OF ILLINOIS
DEPARTMENT OF TRANSPORTATION

PEORIA STREET STATION
STATION SHORING BUILDING SECTION


SHEET NO. S-008 OF 117 SHEETS

MUN 2090	SECTION 2013-011R	COUNTY COOK	TOTAL SHEETS 356	SHEET NO. 199
CONTRACT NO. 60W29				
ILLINOIS FED. AID PROJECT FED. AID PROJECT				

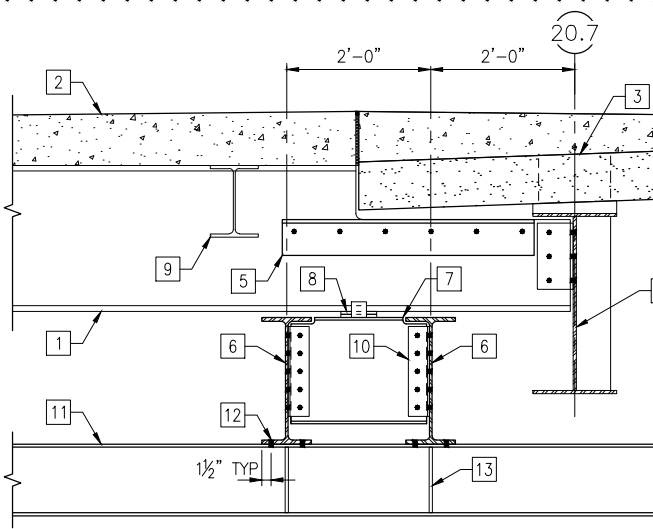


- KEYED NOTES (C1):**
- EXISTING 24WF STEEL BEAM. COPE TOP FLANGE TO CLEAR PRECAST PANEL SLABS FROM BRIDGE CONSTRUCTION. SEE SHEET 167 OF THE BRIDGE DOCUMENTS TO DETERMINE AMOUNT OF COPING REQUIRED AT EACH BEAM.
 - EXISTING CONCRETE.
 - NEW PRECAST PANELS. SEE BRIDGE DOCUMENTS FOR DETAILS.
 - NEW BRIDGE FASCIA PLATE GIRDER. SEE BRIDGE DOCUMENTS FOR DETAILS.
 - REINFORCED END CONDITION IN ACCORDANCE WITH SECTION C3/S-009.
 - W21x68 TEMPORARY SHORING BEAM, (2) REQUIRED.
 - W18x35 DIAPHRAGM BEAM UNDER EACH EXISTING STATION FLOOR FRAMING BEAM.
 - 6x6 SHIM PLATES, THICKNESS AS REQUIRED FOR FULL BEARING AT MID-DISTANCE BETWEEN W21x68 SHORING BEAMS. PROVIDE BEAM KEEPER CONNECTION, EACH SIDE.
 - EXISTING 12WF40 STATION FLOOR FRAMING BEAM.
 - TYPICAL SHEAR CONNECTION SEE C1/S-600.
 - W12x53 CROSS BEAM AT SHORING TOWER.
 - (4) 7/8"Ø BOLTS AT EACH BEARING LOCATION.
 - 1/2" STIFFNER PLATE, EACH SIDE, OF WEB AT EACH BEARING LOCATION. SEE B4/S-006

C1 CTA STATION CONNECTION
3/4" = 1'-0"

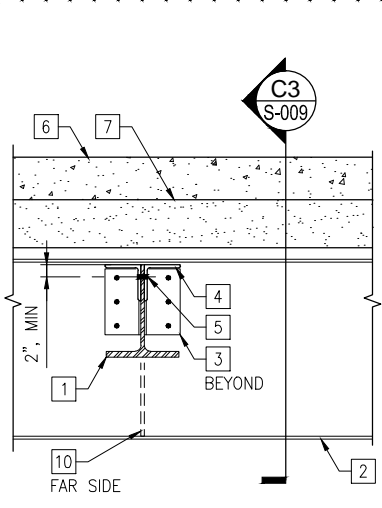

- KEYED NOTES:**
- SEE SECTION B2 FOR KEYED NOTES.


C2 CTA STATION CONNECTION
3/4" = 1'-0"

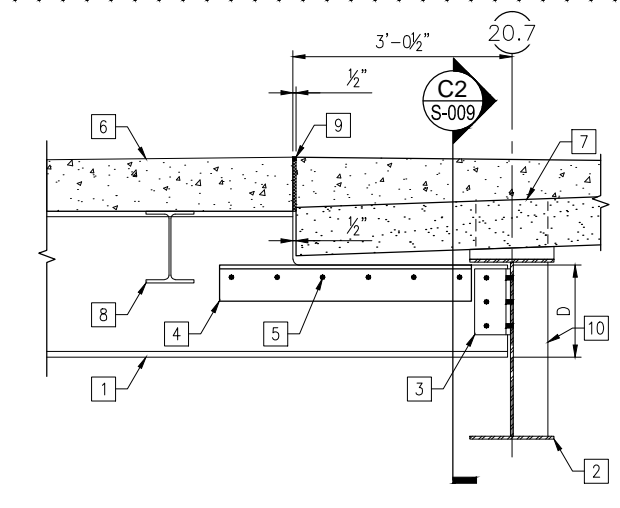

DO NOT COPE EXISTING BEAMS OR DRILL HOLES FOR NEW REINFORCING ANGLES TO EXISTING FLOOR FRAMING UNTIL AFTER THE STATION FRAMING HAS BEEN SHORED.


C3 CTA STATION CONNECTION
3/4" = 1'-0"

- KEYED NOTES (B1 AND B2):**
- EXISTING STEEL BEAM. COPE TOP FLANGE TO CLEAR PRECAST PANEL SLABS FROM BRIDGE CONSTRUCTION. COPE BEAM AFTER REINFORCING ANGLES HAVE BEEN INSTALLED.
 - NEW EXTERIOR FASCIA PLATE GIRDER BEAM. SEE SHEET 167 OF NEW BRIDGE DESIGN DOCUMENTS FOR PLATE GIRDER SIZE.
 - END BEAM SHEAR CONNECTION. SEE SHEET 167 OF THE BRIDGE DESIGN DOCUMENTS FOR CONNECTION DESIGN.
 - L6x6x1/2" x 3-6 REINFORCING ANGLE ON EACH SIDE. SEE BRIDGE DRAWINGS FOR REQUIRED COPE DEPTH. THE REINFORCED WEB HAS BEEN DESIGNED FOR A MINIMUM DEPTH, D, EQUAL TO 15.31". NOTIFY THE EOR IF THE ACTUAL DEPTH, D, IS REQUIRED TO BE LESS THAN 15.31".
 - PROVIDE (6) 3/4"Ø BOLTS, EQUALLY SPACED STARTING 2" FROM EACH END.
 - TOPPING CONCRETE. SEE BRIDGE DOCUMENTS FOR CRITERIA.
 - NEW PRECAST PANELS. SEE BRIDGE DOCUMENTS FOR DETAILS.
 - EXISTING 12WF40 STATION FLOOR FRAMING BEAM.
 - 1/2" EXPANSION JOINT MATERIAL. PROVIDE JOINT SEALANT AT TOP OF JOINT.
 - STIFFENER PLATE AT EACH CONNECTION LOCATION. SEE SHEET 167 OF THE BRIDGE DESIGN DOCUMENTS FOR STIFFENER PLATE SIZE.

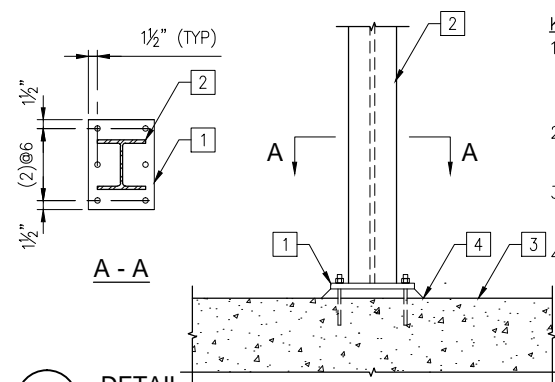


- KEYED NOTES (B1):**
- R3/4"x11 x 1-3 WITH (6) 1/2"Ø EXPANSION ANCHORS WITH 4 1/2" EMBEDMENT.
 - W8x48 TEMPORARY SHORING COLUMN.
 - EXISTING CONCRETE PLATFORM.
 - 1 1/2" NON-SHRINK, NON-METALLIC GROUT.

B1 DETAIL
3/4" = 1'-0"

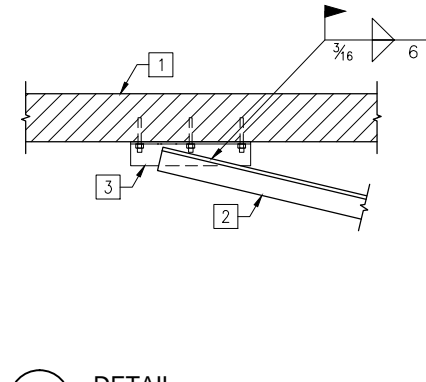


B2 DETAIL
3/4" = 1'-0"

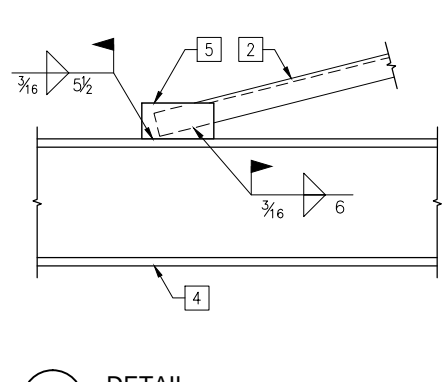


B3 DETAIL
3/4" = 1'-0"

- KEYED NOTES (B2, B3):**
- EXISTING CONCRETE DECK.
 - L4x4x3/8 DIAGONAL X-BRACING. SEE S-007 FOR LOCATION.
 - L6x4x3/8 (LLV) x 1-8 WITH (3) 1/2"Ø EXPANSION ANCHORS @ 8"O.C. EMBEDDED 4 1/2" INTO EXISTING CONCRETE DECK.
 - W21x68 TEMPORARY SHORING BEAM.
 - R3/8x6 x 1-0

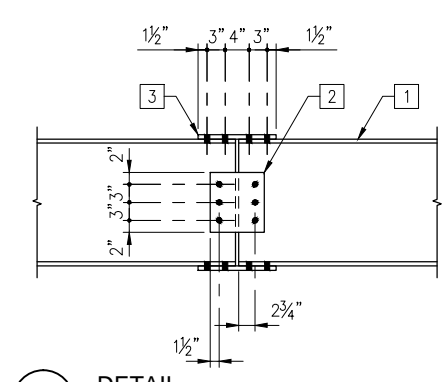


- KEYED NOTES (B4):**
- W21x68 SHORING BEAM.
 - R3/8x9 x 0-10 WITH (3) 3/4"Ø BOLTS, EACH SIDE.
 - R3/4x8 x 1-1 WITH (8) 3/4"Ø BOLTS, TOP AND BOTTOM.


B4 DETAIL
3/4" = 1'-0"

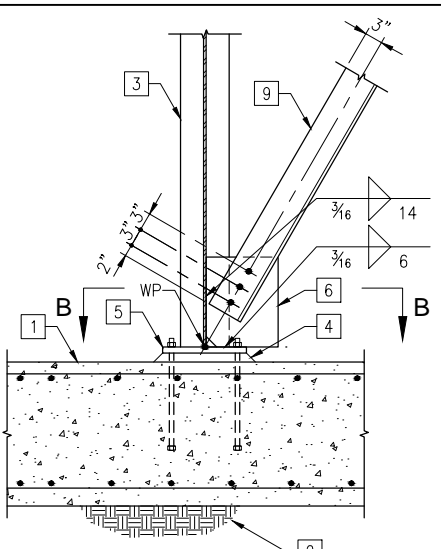


A1 DETAIL
3/4" = 1'-0"

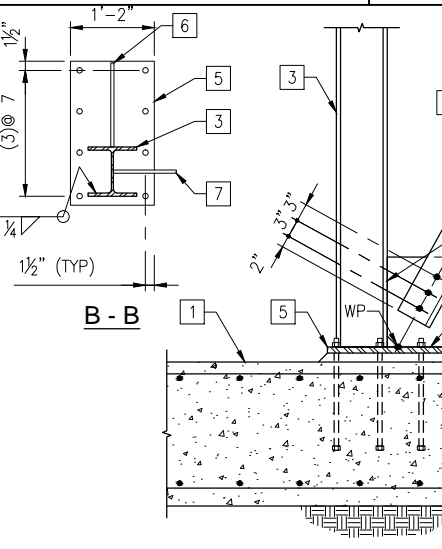


A2 DETAIL
3/4" = 1'-0"

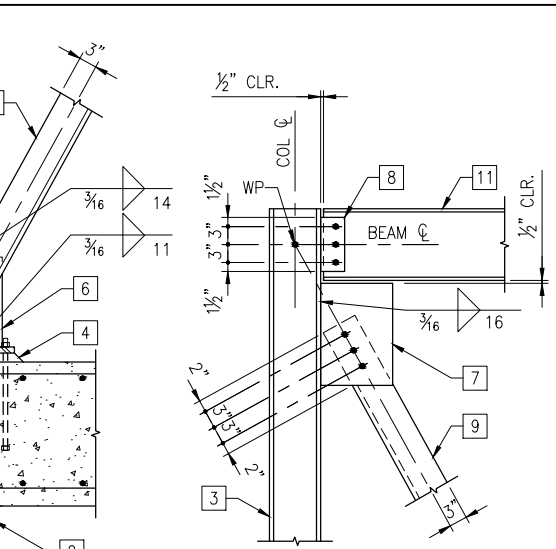

A3 DETAIL
3/4" = 1'-0"

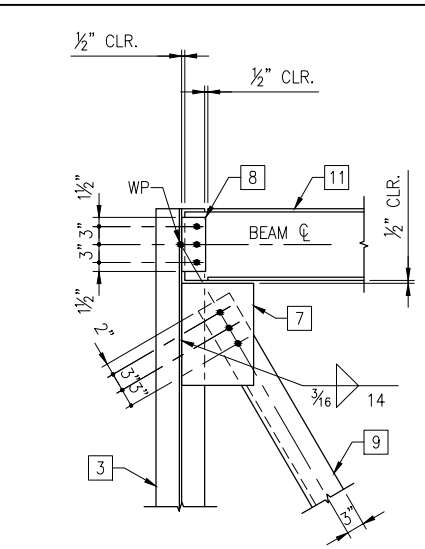


A4 DETAIL
3/4" = 1'-0"

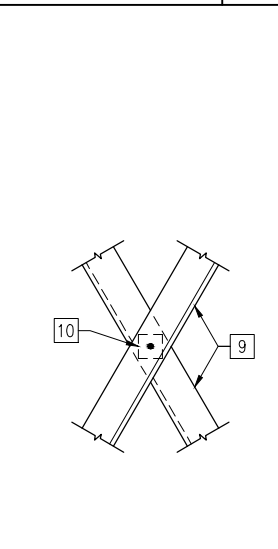

A5 DETAIL
3/4" = 1'-0"

- KEYED NOTES (A1 THRU A5):**
- CONCRETE MAT FOUNDATION. SEE SHEET S-008 FOR FOUNDATION THICKNESS AND REINFORCING.
 - COMPACTED SUBGRADE IN ACCORDANCE WITH THE GEOTECHNICAL REPORT RECOMMENDATIONS. CONTRACTOR SHALL VERIFY THROUGH ON-SITE GEOTECHNICAL TESTING THAT SUBGRADE HAS BEEN COMPACTED SUFFICIENTLY TO PROVIDE A 2,000 PSF BEARING CAPACITY.
 - W8x48 SHORING COLUMN.
 - 1 1/2" NON-SHRINK, NON-METALLIC GROUT.
 - R1x14 x 2-0 WITH (8) 3/4"Ø HEX HEAD ANCHOR RODS. EMBEDDED 14" INTO MAT FOUNDATION.
 - R1/2x12 x 1-3 WITH (3) 3/4"Ø BOLTS.
 - R1/2x12 x 1-5 WITH (3) 3/4"Ø BOLTS.
 - TYPICAL SHEAR CONNECTION. SEE C1/S-600.
 - L6x6x3/8 DIAGONAL BRACE.
 - 1/2" FILL PLATE WITH (1) 7/8"Ø BOLT.
 - W12x53 SHORING BEAM.

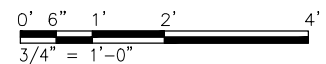

TranSystems	USER NAME = MAC	DESIGNED KLT	REVISED A 1/20/2014
	PLOT SCALE =	CHECKED AB	REVISED ---
	PLOT DATE = 10/28/13	DRAWN MAC	REVISED ---
		CHECKED KLT	REVISED ---

STATE OF ILLINOIS
DEPARTMENT OF TRANSPORTATION

PEORIA STREET STATION
SHORING DETAILS
SHEET NO. S-009 OF 117 SHEETS

MUN	SECTION	COUNTY	TOTAL SHEETS	SHEET NO.
2090	2013-011R	COOK	356	200
CONTRACT NO. 60W29			ILLINOIS FED. AID PROJECT FED. AID PROJECT	